


CLIFFORD INDUSTRIAL PARK
PHASE I
ALBUQUERQUE , NEW MEXICO

INDEX

SHEET NO.	DESCRIPTION	SHEET NO.	DESCRIPTION
1	TITLE SHEET	16	CORONA LOOP (E-W PORTION)
2-5	PLAT & COMPUTATIONS	17	CORONA LOOP (N-S PORTION)
6	GRADING PLAN (WEST)	18	PRIVATE ACCESS ROAD
7	GRADING PLAN (SOUTH)	19	OUTFALL SANITARY SEWER
8	GRADING PLAN (CENTRAL)	20	SWALE A STA. 0+40.00 - STA. 13+50.00
9	GRADING PLAN (NORTH)	21	SWALE A STA. 13+50.00 - STA. 18+73.80
		22	DRAINAGEWAY PLANS & PROFILES
10	SANITARY SEWER DESIGN	23	PRIVATE DRAINAGE EASEMENTS
11	WATER DESIGN	24	SWALE A OUTLET STRUCTURE
12	PAVING & STORM DRAINAGE DESIGN	25	SWALE A OUTLET STRUCTURE WING WALLS
13	WASHINGTON PLACE STA. 0+00.00 - STA. 12+69.21	26	CONFLUENCE DETAILS
14	WASHINGTON PLACE STA. 12+69.21 - STA. 23+62.34	27	DRAINAGE DETAILS
15	ANAHEIM AVENUE		

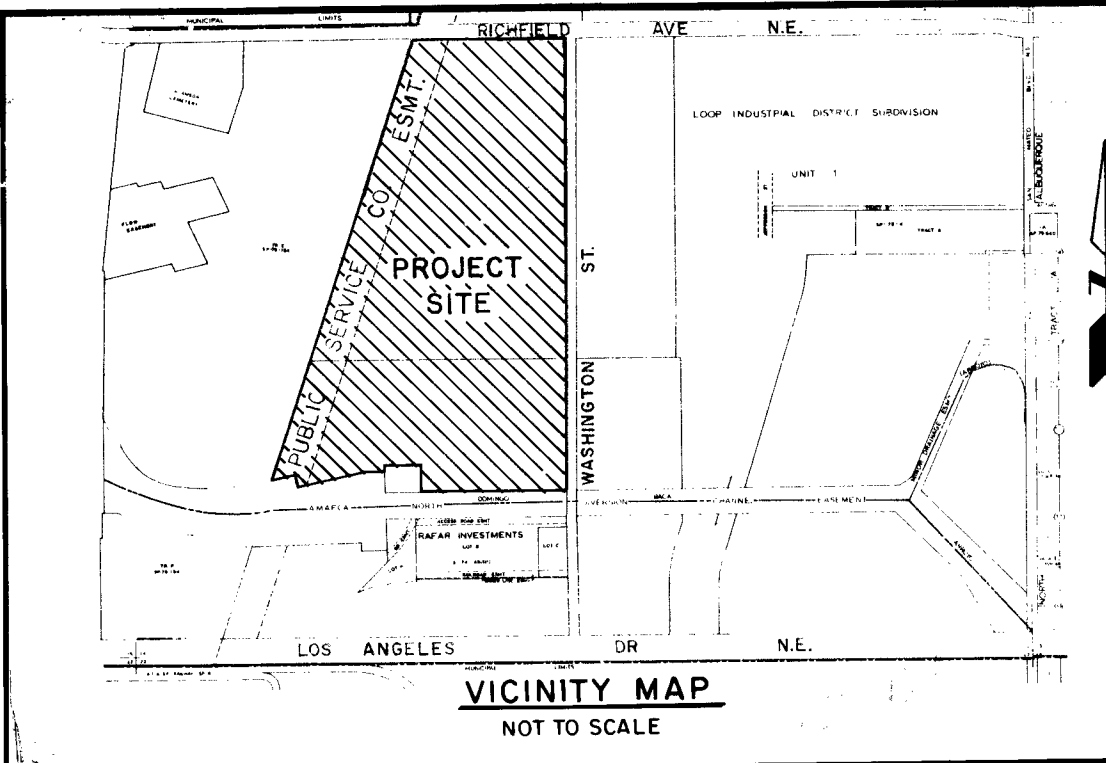

GENERAL NOTES

NOTICE TO CONTRACTORS


- NEW MEXICO STANDARD SPECIFICATIONS FOR PUBLIC WORKS CONSTRUCTION-1979 EDITION WILL BE REFERRED TO HEREON AS THE "STANDARD SPECIFICATION."
- ALL WORK DETAILED ON THESE PLANS TO BE PERFORMED UNDER CONTRACT SHALL, EXCEPT AS OTHERWISE STATED OR PROVIDED FOR HEREON, BE CONSTRUCTED IN ACCORDANCE WITH "CONTRACT DOCUMENTS FOR CITY-WIDE UTILITIES AND CASH PAVING NO. 31" AND THE STANDARD SPECIFICATION.
- TWO WORKING DAYS PRIOR TO ANY EXCAVATION, CONTRACTOR MUST CONTACT LINE LOCATING SERVICE, 765-1234, FOR LOCATION OF EXISTING UTILITIES.
- PRIOR TO CONSTRUCTION, THE CONTRACTOR SHALL EXCAVATE AND VERIFY THE HORIZONTAL AND VERTICAL LOCATIONS OF ALL OBSTRUCTIONS. SHOULD A CONFLICT EXIST, THE CONTRACTOR SHALL NOTIFY THE ENGINEER OR SURVEYOR SO THAT THE CONFLICT CAN BE RESOLVED WITH A MINIMUM AMOUNT OF DELAY.

THE FOLLOWING NOTES ALSO APPLY WHEN CHECKED

- ☒ ALL UTILITIES AND UTILITY SERVICE LINES SHALL BE INSTALLED PRIOR TO PAVING.
- ☒ BACKFILL COMPACTION SHALL BE ACCORDING TO SPECIFIED STREET USE.
- ☒ TACK COAT REQUIREMENTS SHALL BE DETERMINED BY THE CITY ENGINEER.
- ☐ SIDEWALKS AND WHEELCHAIR RAMPS WITHIN THE CURB RETURNS SHALL BE CONSTRUCTED WHEREVER A NEW CURB RETURN IS CONSTRUCTED.
- ☐ IF CURB IS DEPRESSED FOR A DRIVEPAD, THE DRIVEPAD SHALL BE CONSTRUCTED PRIOR TO ACCEPTANCE OF CURB AND GUTTER.
- ☐ ALL STORM DRAINAGE FACILITIES SHALL BE COMPLETED PRIOR TO FINAL ACCEPTANCE.
- ☒ THE REQUESTOR OR DEVELOPER SHALL BE RESPONSIBLE FOR REPAIR OR REPLACEMENT OF ALL CURB AND GUTTER OR SIDEWALK DAMAGED AFTER APPROVAL BY THE CITY ENGINEER OF WORK COMPLETED BY THE CONTRACTOR.
- ☒ PHASE II CONSTRUCTION UNDER PROJECT NUMBER 1625
- ☒ HOUSE NUMBER 2 - AS SHOWN ON PLAT 1

26 1564 0164

REV	SHEETS	CITY ENGINEER	DATE	USER	DEPT.	DATE	USER	DEPT.	DATE
APPROVAL OF REVISIONS									
						APPROVED FOR CONSTRUCTION C.E.			
PROJECT NUMBER 1564		SHEET 1 OF 27							

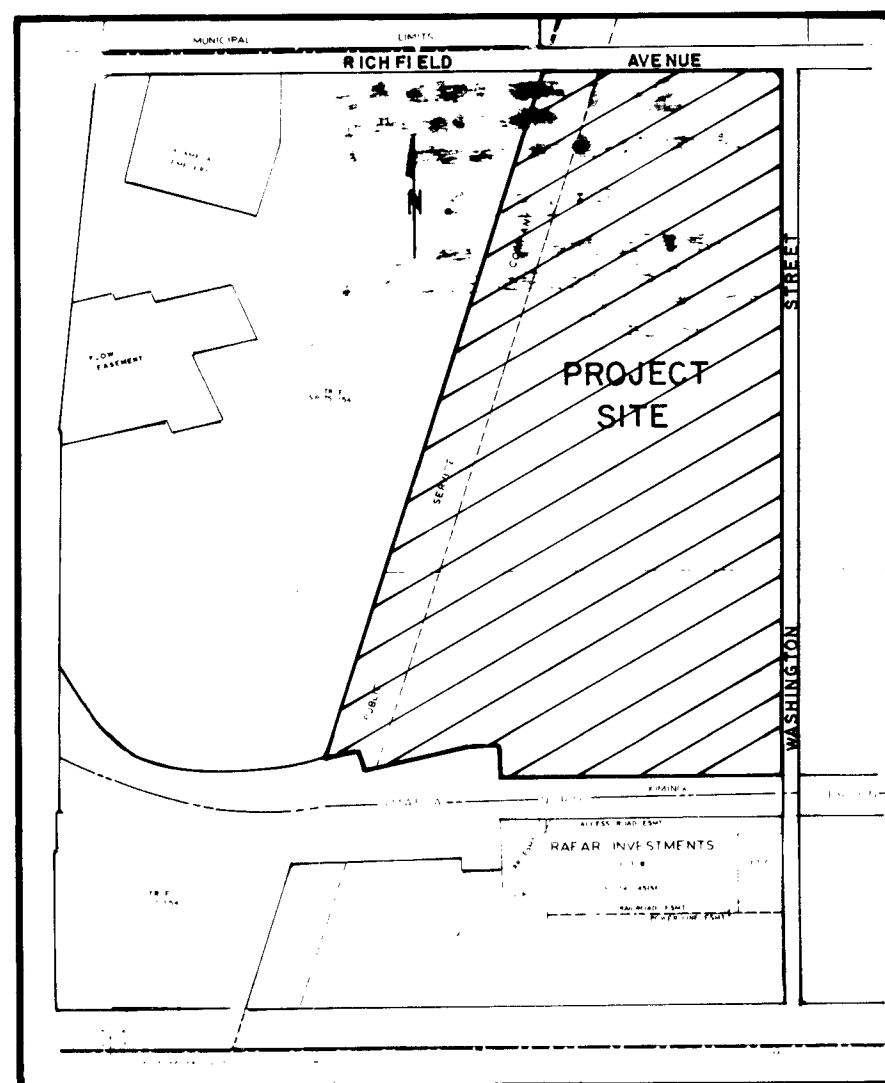

LOCATION MAP
ZONE ATLAS MAP NO. C-17-Z

SUBDIVISION DATA

1. ZONE ATLAS INDEX NO. C-17
2. GROSS SUBDIVISION ACREAGE: 81.8123 ACRES
3. TOTAL NUMBER OF LOTS CREATED: 66 LOTS
4. TOTAL MILEAGE OF FULL WIDTH STREETS CREATED: 0.8774 MILE
5. DATE OF SURVEY: JULY 1982

NOTES

1. BEARINGS ARE N.M. STATE PLANE GRID BEARINGS (CENTRAL ZONE).
2. DISTANCES ARE GROUND DISTANCES.
3. ELEVATIONS ARE FIELD ELEVATIONS (CITY OF ALBUQUERQUE DATUM).
4. NUMBER 5 REBAR WITH PLASTIC SURVEY CAP STAMPED PE & LS 2455 WERE SET ON CORNERS DESIGNATED BY A SMALL SOLID CIRCLE. ●
5. RECORD BEARINGS AND DISTANCES ARE SHOWN IN PARENTHESIS.
6. TRACT 54A IS INTENDED TO BE USED FOR FUTURE ACCESS TO THE LANDS NOW KNOWN AS TRACT E, LANDS OF SPRINGER CORPORATION, SHOULD IT BE USED FOR INDUSTRIAL OR COMMERCIAL PURPOSES.
7. THE PRIVATE DRAINAGE EASEMENTS SHALL BE MAINTAINED BY THE OWNER OF THE LOT UPON WHICH EACH EASEMENT IS LOCATED.
8. THE 30' EXISTING TEMPORARY ACCESS EASEMENT ON LOTS 39-43 SHALL BE ABANDONED UPON APPROVAL OF THE CITY PLANNING DIRECTOR, CITY ENGINEER, CITY TRAFFIC ENGINEER, DIRECTOR OF THE WATER RESOURCES DEPARTMENT, AND DIRECTOR OF THE PARKS AND RECREATION DEPARTMENT OR THEIR DESIGNEES. THIS ACTION SHALL BE TAKEN AT SUCH TIME AS THE STREET IMPROVEMENTS ARE COMPLETED IN ANAHEIM AVENUE AND WASHINGTON PLACE SOUTH OF ANAHEIM AVENUE.
9. THE AREAS OF LOTS WITHIN THE PUBLIC SERVICE COMPANY POWERLINE EASEMENT AND OUTSIDE OF THE PUBLIC DRAINAGE EASEMENT MAY BE SUBJECT TO FLOODING DURING A STANDARD PROJECT FLOOD IN THE DOMINGO BACA ARROYO.
10. THE TWENTY-FOUR (24) FOOT TEMPORARY PUBLIC ACCESS EASEMENT ON LOT FORTY-SEVEN (47) WILL BE VACATED WITH THE APPROVAL OF THE CITY DEVELOPMENT REVIEW BOARD WITHIN FIVE (5) YEARS OF THE FILING DATE OF THIS PLAT, OR WHEN THE CITY LANDFILL IS CLOSED, WHICHEVER OCCURS FIRST.

EASEMENTS

1. 10' UTILITY EASEMENTS ALONG THE STREET SIDE OF ALL LOTS AS SHOWN WITH A DASHED LINE.
2. ALL SWITCH GEAR EASEMENTS ARE 12' x 15'.

DESCRIPTION

A tract of land situate within the Elena Gallegos Grant in the W½ of Section 14, T11N, R3E, N.M.P.M., Bernalillo County, New Mexico, and being more particularly described by New Mexico State Plane Grid bearings (Central Zone) and ground distances as follows:

BEGINNING at the southeast corner, a point on the westerly right-of-way of Washington Street, being also a point on the northerly right-of-way of AMAFCA's Grant of Right-of-Way Easement for Drainage to the City of Albuquerque, filed on January 27, 1967, Vol. 143, Folio 613-615, whence the ACS Station Monument 8-C17 (New Mexico State Plane Coordinates for Central Zone: X = 396964.26 Y = 1520607.77) bears N00°43'01"E, 735.89 feet, and from said beginning point, leaving said westerly right-of-way, N89°33'39"W, 870.77 feet along said northerly right-of-way to the southeast corner of the City well site, filed in the office of the County Clerk of Bernalillo County, New Mexico, on September 24, 1973, BK D950, Folio 450-451, thence leaving said northerly right-of-way, N01°08'55"W, 200.00 feet along the easterly boundary of said well site to the northeast corner of said well site; thence, N89°33'39"W, 200.00 feet along the northerly boundary of said well site to the northwest corner of said well site; thence, S01°08'55"E, 79.14 feet along the westerly boundary of said well site to a point on the northerly right-of-way of AMAFCA's North Diversion Channel; thence leaving said westerly boundary and continuing along said northerly right-of-way, S88°51'05"W, 115.00 feet to a point; thence, S77°51'05"W, 500.00 feet to a point; thence, N12°08'55"W, 75.00 feet to a point; thence, S77°51'05"W, 99.38 feet to the southwest corner, a point on the westerly right-of-way of a 200-foot wide Public Service Company of New Mexico Utility Easement, being also the southeast corner of Tract E of Plat showing Tracts "A" through "F" inclusive of lands of Springer Corporation, filed in the office of the County Clerk of Bernalillo County, New Mexico, on July 11, 1975; thence, N18°16'41"E, 2717.21 feet along said westerly right-of-way and easterly boundary of said Tract E to the northwest corner, a point on the southerly right-of-way of Richfield Avenue; thence leaving said westerly right-of-way and said easterly boundary, S89°37'29"E, 903.40 feet along said southerly right-of-way to a point of curvature; thence leaving said southerly right-of-way, 78.51 feet along the arc of a curve to the right having a radius of 50.00 feet and a chord bearing S44°38'34"E, 70.69 feet to a point of tangency on said westerly right-of-way of Washington Street; thence, S00°20'21"W, 2597.87 feet along said westerly right-of-way to the point and place of beginning.

Tract contains 81.8123 acres, more or less.

DEDICATION

The subdivision of the land hereon shown is with free consent and in accordance with the desires of the undersigned owners and/or proprietors thereof, and said owners and/or proprietors do here by dedicate the public rights-of-way shown hereon, together with all easements shown on this plat. Tract "A" (0.0708 acre) is to be dedicated right-of-way for access to the City of Albuquerque well site. Power and communication easements are reserved where shown by dashed lines as noted, including the right of ingress and egress and the right to trim interfering trees.

JACK M. CLIFFORD AND COMPANY

BY Jack M. Clifford
Jack M. Clifford
President

LOOP DEVELOPMENT COMPANY

BY Jack M. Clifford
Jack M. Clifford
President

STATE OF NEW MEXICO)
COUNTY OF BERNALILLO)

The foregoing instrument was acknowledged before me this 11th day of January 19 82, by Jack M. Clifford, President of and on behalf of Jack M. Clifford and Company and President of and on behalf of Loop Development Company.

My Commission Expires: 6-16-84 Barbara Ann Bates
Notary Public

SANTA FE LAND IMPROVEMENT COMPANY

BY W.C. Meritt
STATE OF TEXAS
COUNTY OF PETER

The foregoing instrument was acknowledged before me this 29th day of SEPTEMBER 19 82, by W.C. MERITT on behalf of Santa Fe Land Improvement Company.

My Commission Expires: MAY 31, 1985 Eugene M. Unsworth
Notary Public

83-24548

CLIFFORD INDUSTRIAL PARK

ALBUQUERQUE, NEW MEXICO
SCALE: 1"=100' JULY 1982

S-83-11

APPROVALS

Eugene M. Bates 4-20-83
PLANNING DIRECTOR DATE

Ch. W. Entley 1-25-83
CITY ENGINEER DATE

Richard A. Inouye 1-25-83
TRAFFIC ENGINEER DATE

Paul C. Mott 1/13/83
CITY SURVEYOR DATE

Paul Beasler 1-25-83
PROPERTY MANAGEMENT DATE

Walt Vally 1-25-83
WATER RESOURCES DEPT. DATE
PARKS & RECREATION DEPT.

Doug Hendren 1-11-83
PUBLIC SERVICE COMPANY OF NEW MEXICO DATE

Barvin Osborn 1-12-83
GAS COMPANY OF NEW MEXICO DATE

Paul B. Quintana 8/16/82
MOUNTAIN BEL DATE

SURVEYOR'S CERTIFICATION

I, A. DWAIN WEAVER, UNDER THE LAWS OF NEW MEXICO, CERTIFY THAT I AM A REGISTERED LAND SURVEYOR, AND THAT THIS PLAT WAS PREPARED BY ME OR UNDER MY SUPERVISION, SHOWS ALL EASEMENTS OF RECORD, MEETS THE MINIMUM REQUIREMENTS FOR MONUMENTATION AND SURVEYS CONTAINED IN THE ALBUQUERQUE SUBDIVISION ORDINANCE, AND IS TRUE AND ACCURATE TO THE BEST OF MY KNOWLEDGE AND BELIEF.

A. Dwain Weaver AUG. 11, 1982
A. DWAIN WEAVER DATE
PLS No. 6544, NEW MEXICO

NOTE: The Endorsement of this plat by the Public Service Company of New Mexico is made with the understanding that all terms of the original Grant of Right-of-Way remain in effect for the 200 Public Service Company easement.

SHEET 1 OF 4 SHEETS

JOB NO. 20681




C21 44 1 of 4


DRAWING NO. 1564 REFERENCE 1625
SUBDIVISION PLAT SHEET 2 OF 27

26 1564 0284

LASON 1-505-344-9404
BEST COPY AVAILABLE

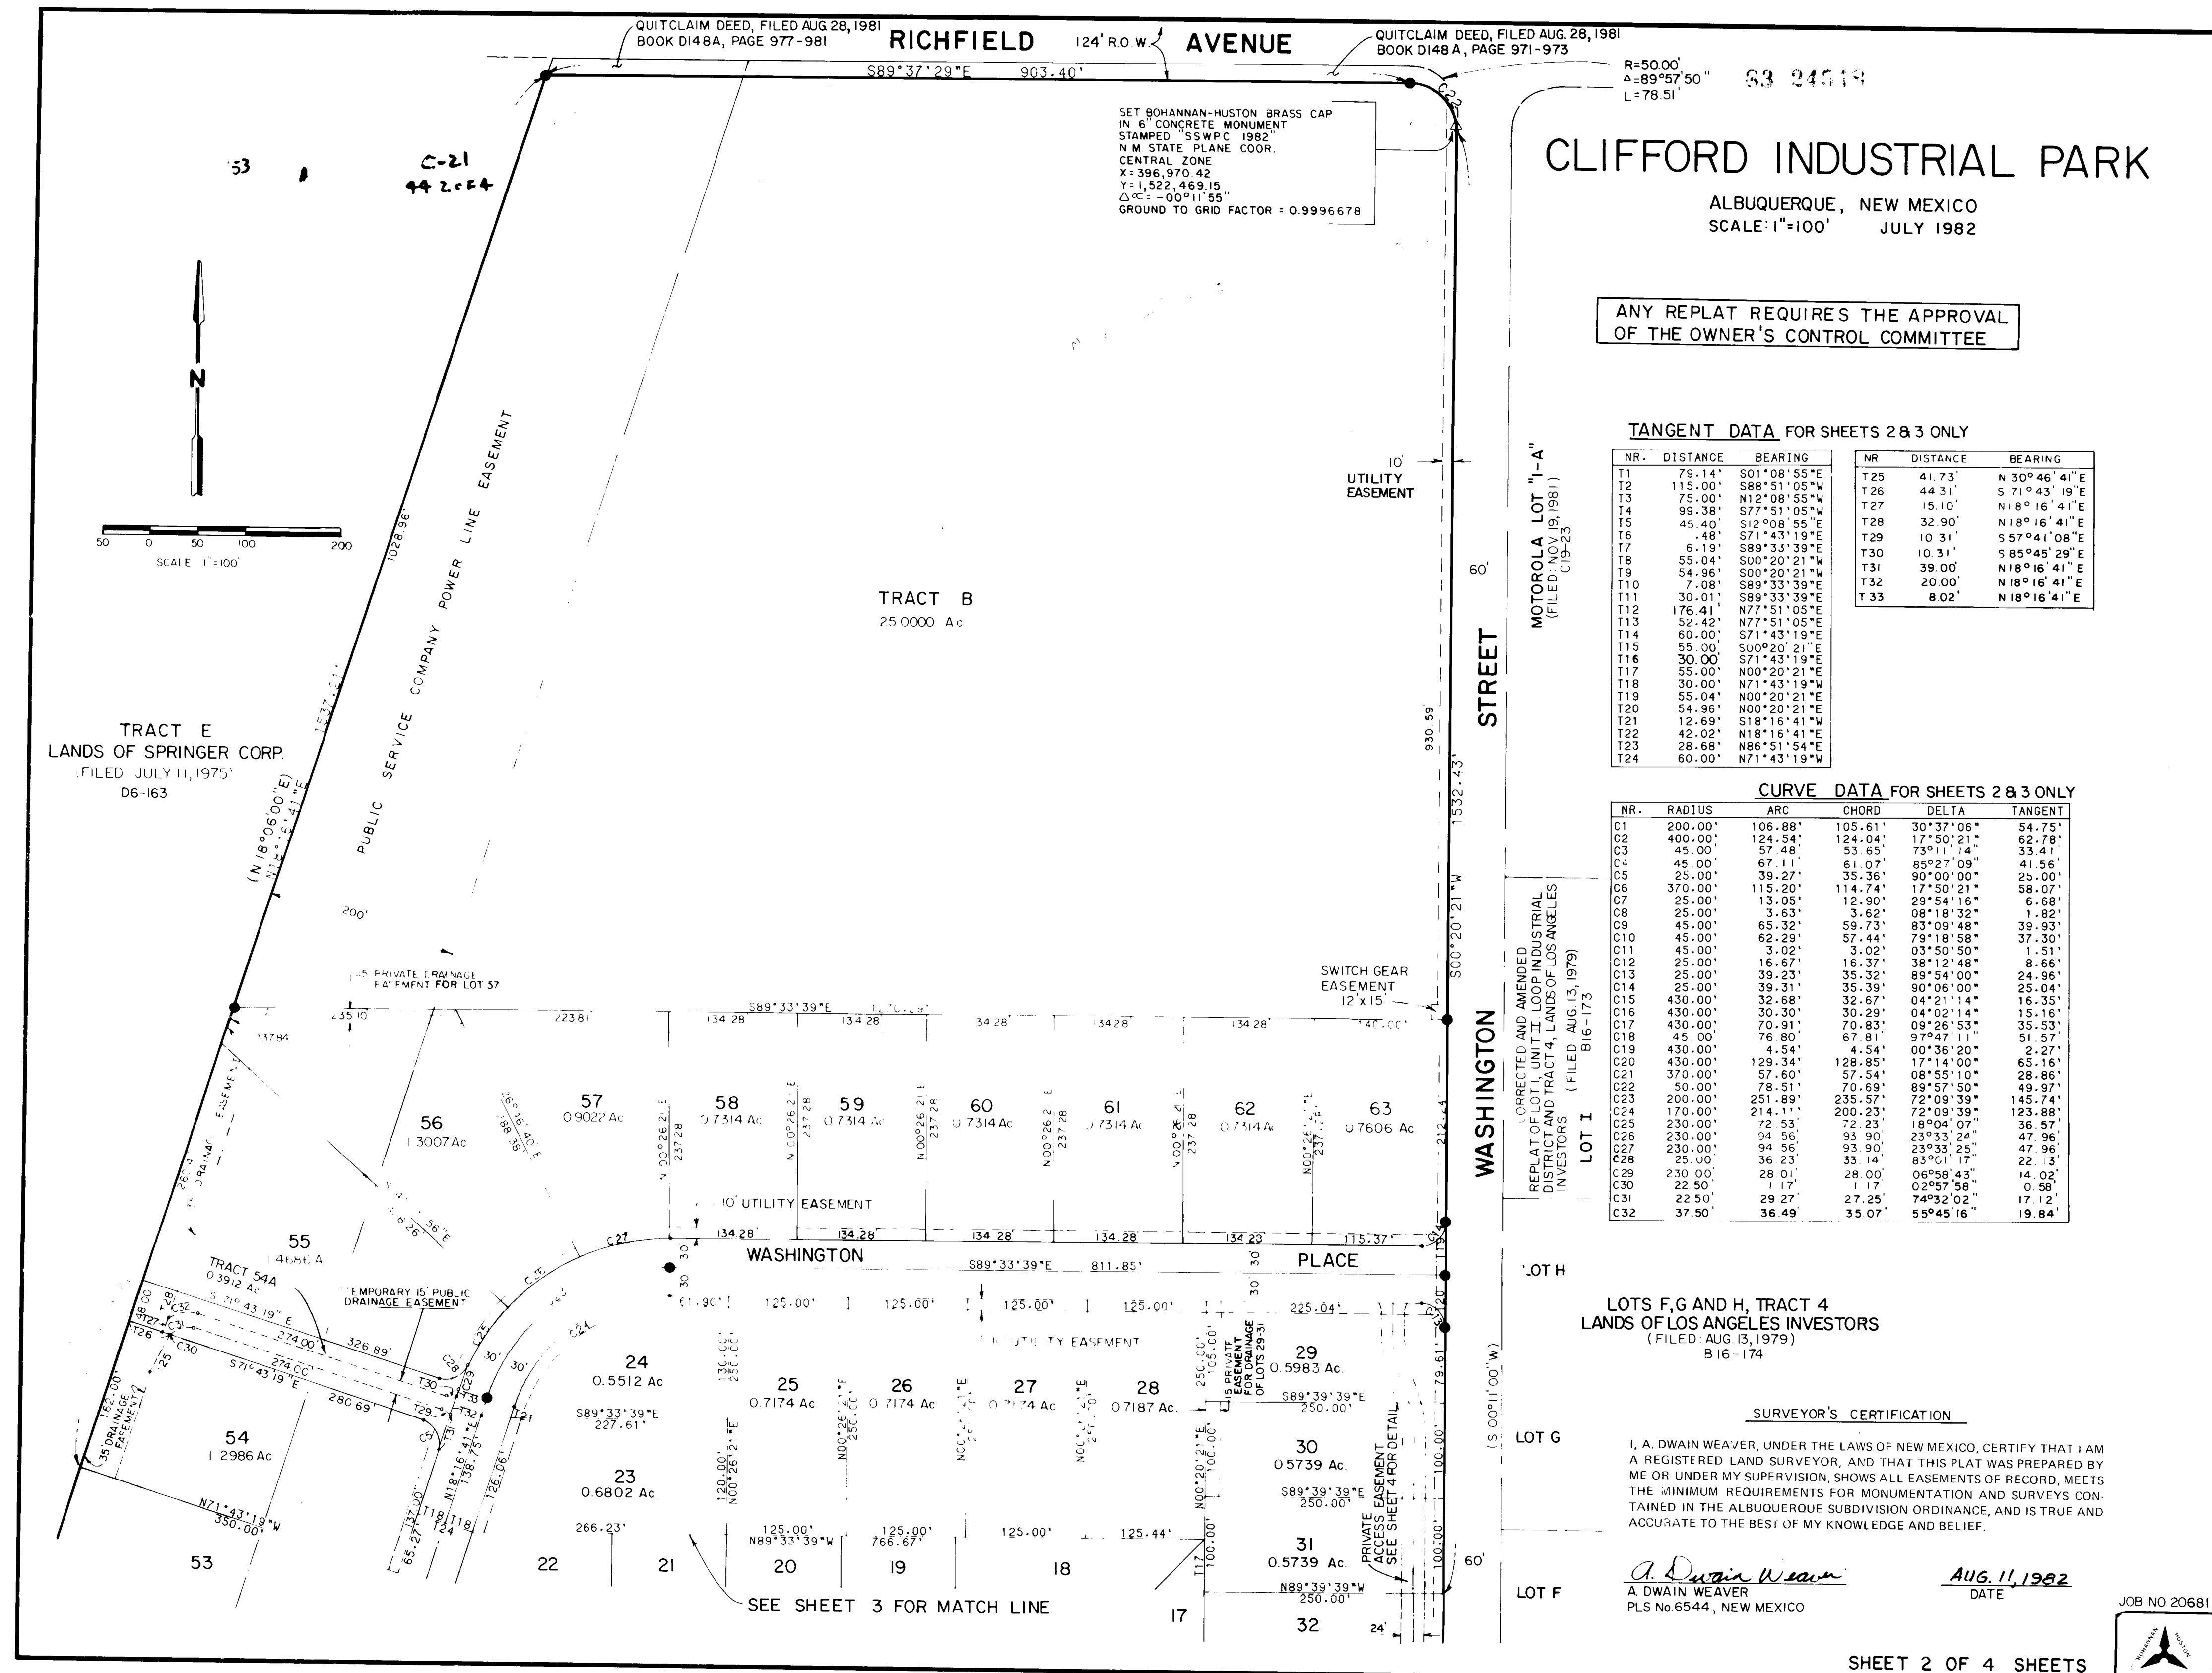

C21 44 3 of 4

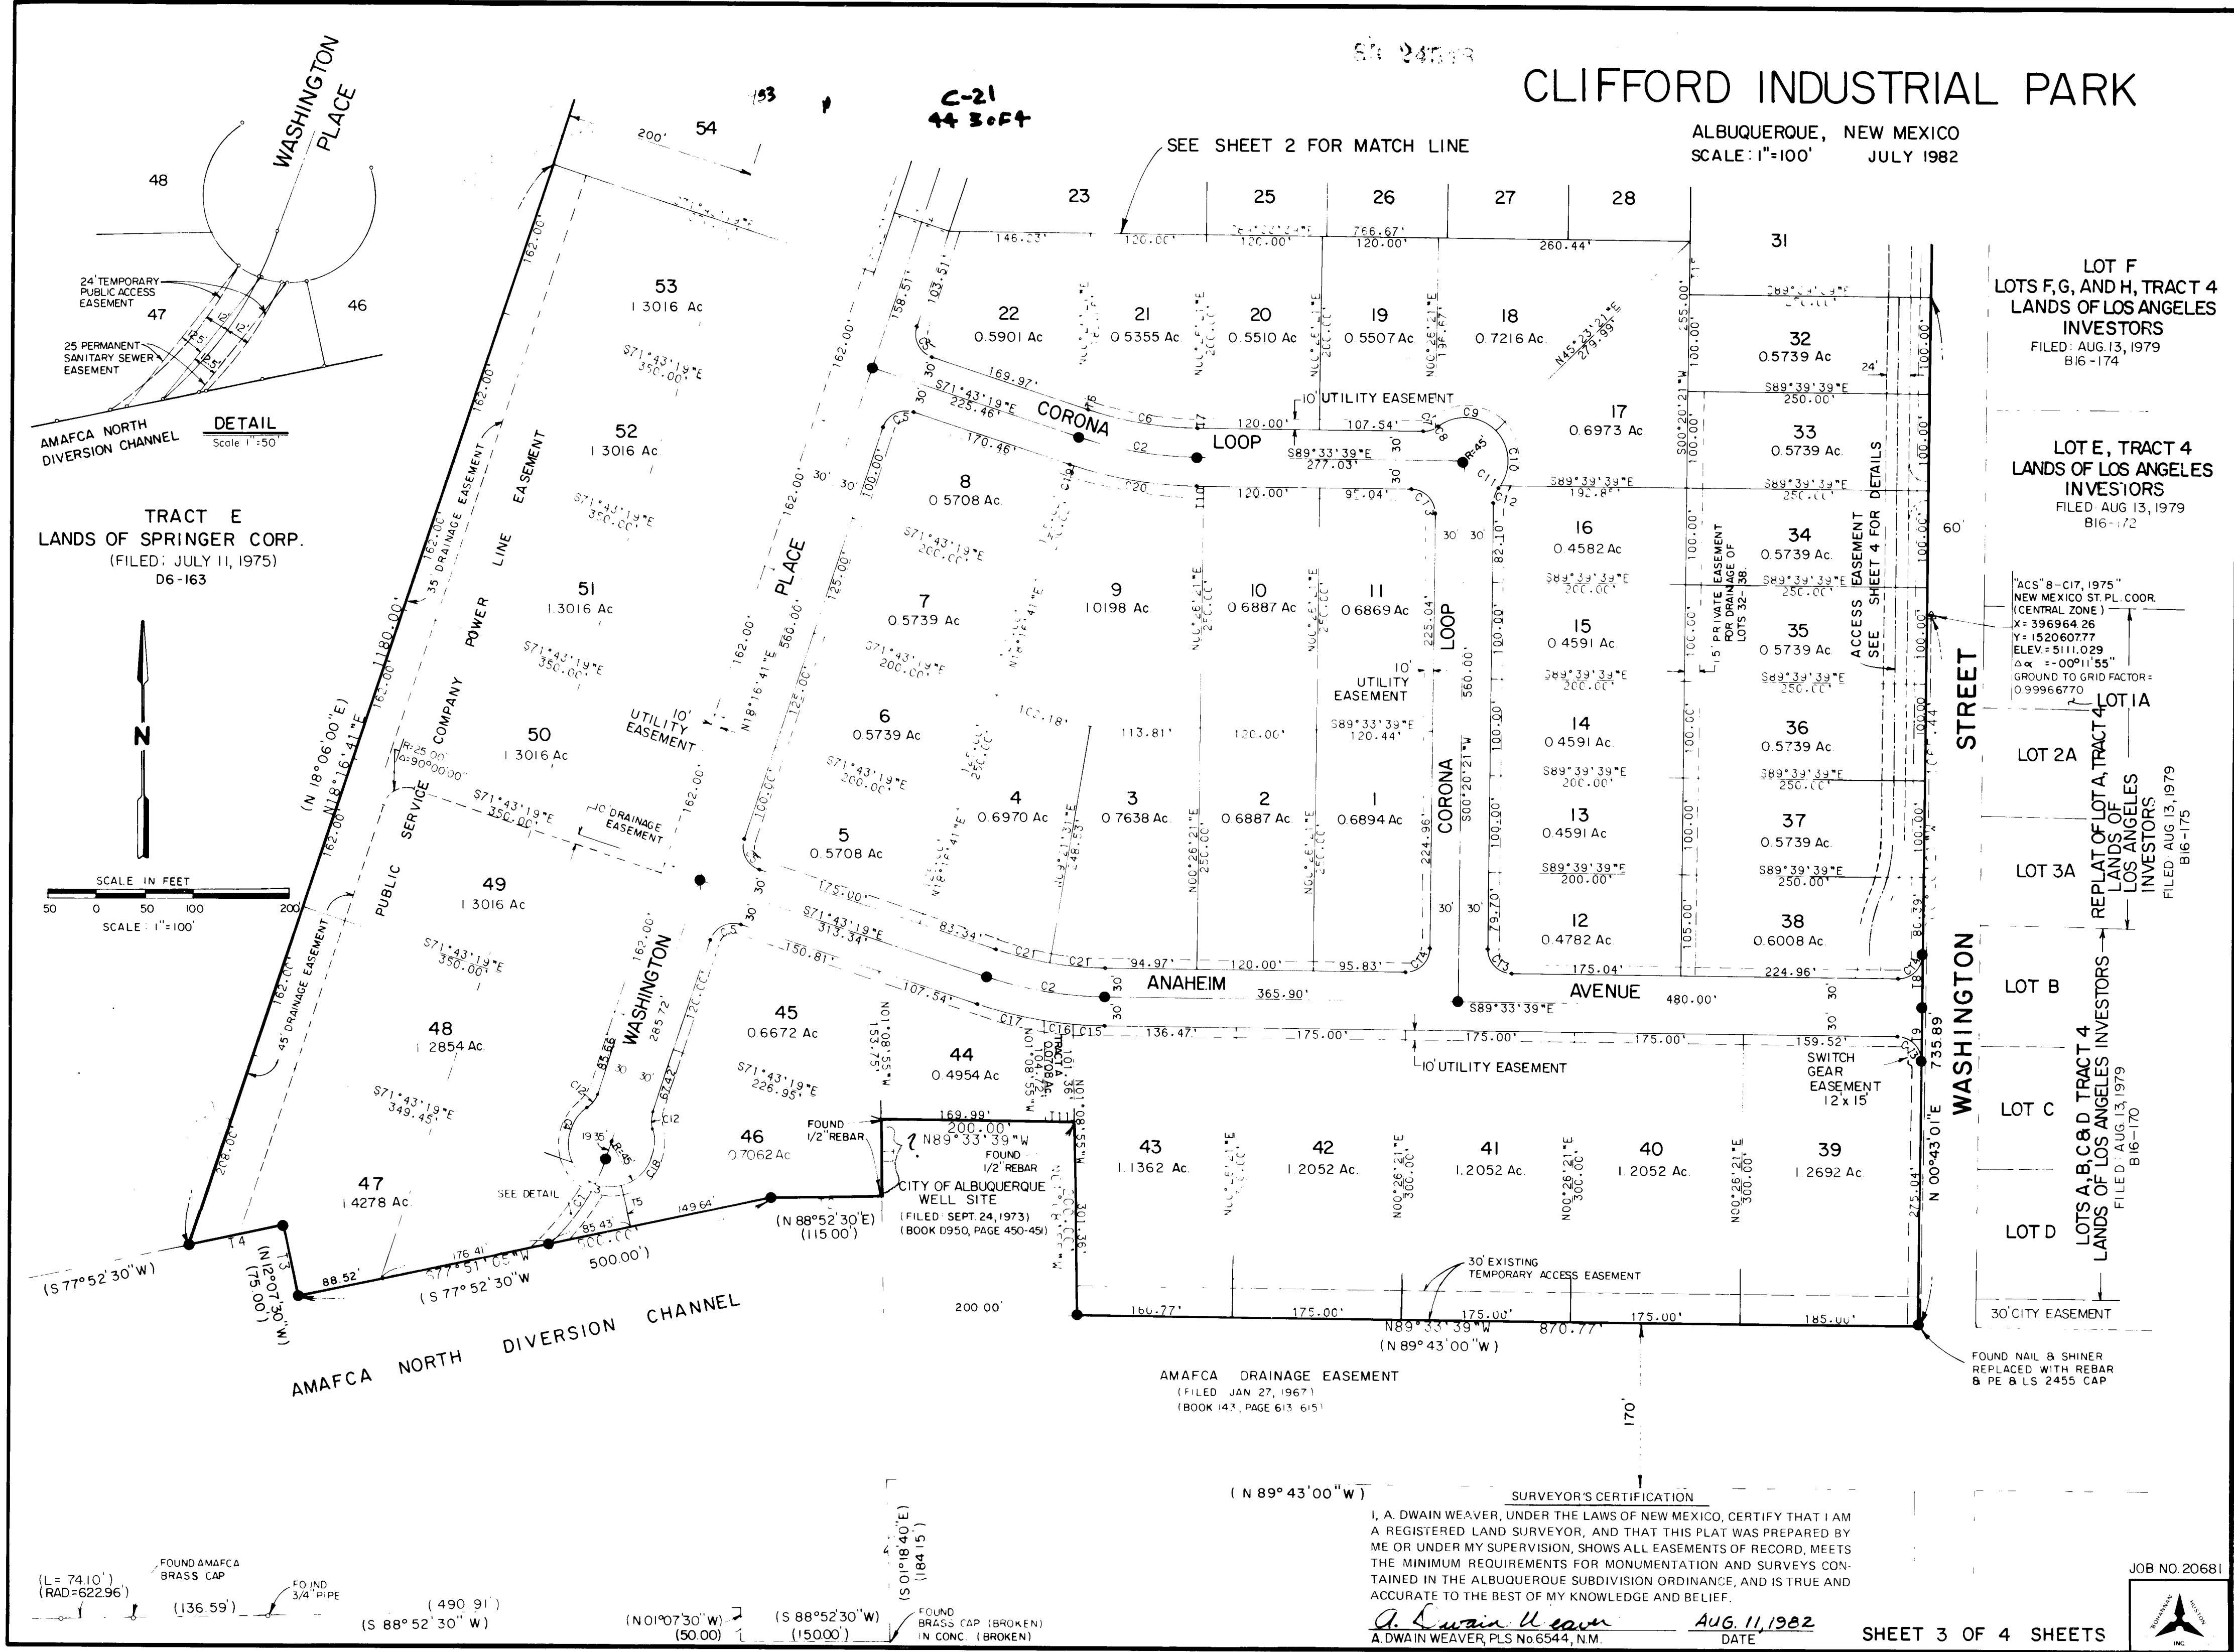

LASON 1-505-344-9404
BEST COPY AVAILABLE


C21 44 4 of 4

83 24548
CLIFFORD INDUSTRIAL PARK
ALBUQUERQUE, NEW MEXICO
SCALE: 1"=50' JULY 1982

153
C-2.1
44-4-4


TANGENT AND CURVE TABLES FOR THIS SHEET ONLY

VR.	DISTANCE	BEARING	NR.	RADIUS	ARC	CHORD	DELTA	TANGENT
T1	20.00'	N00°20'21"E	C1	20.00'	10.51'	10.39'	30°06'00"	5.38'
T2	20.11'	N00°20'21"E	C2	162.00'	63.85'	63.44'	22°34'54"	32.34'
T3	29.36'	S89°33'39"E	C3	138.00'	13.90'	13.89'	05°46'10"	6.95'
T4	14.66'	S89°33'39"E	C4	138.00'	40.49'	40.35'	16°48'44"	20.39'
T5	14.70'	S89°33'39"E	C5	138.00'	41.20'	41.05'	17°06'27"	20.76'
T6	20.00'	S00°20'21"W	C6	138.00'	13.18'	13.18'	05°28'27"	6.60'
T7	20.11'	S00°20'21"W	C7	20.00'	10.44'	10.32'	29°54'00"	5.34'
T8	29.36'	N89°33'39"W	C8	138.00'	54.39'	54.04'	22°34'54"	27.55'
T9	14.66'	N89°33'39"W	C9	162.00'	22.82'	22.80'	08°04'10"	11.43'
T10	14.70'	N89°33'39"W	C10	162.00'	41.03'	40.92'	14°30'44"	20.63'
T11	30.06'	N00°20'21"E	C11	162.00'	40.33'	40.23'	14°15'49"	20.27'
T12	15.35'	N89°33'39"W	C12	162.00'	23.52'	23.50'	08°19'05"	11.78'
T13	25.17'	N89°33'39"W	C13	150.00'	59.12'	58.74'	22°34'54"	29.95'
T14	20.00'	N89°33'39"W						
T15	24.99'	N89°33'39"W						
T16	15.29'	N89°33'39"W						

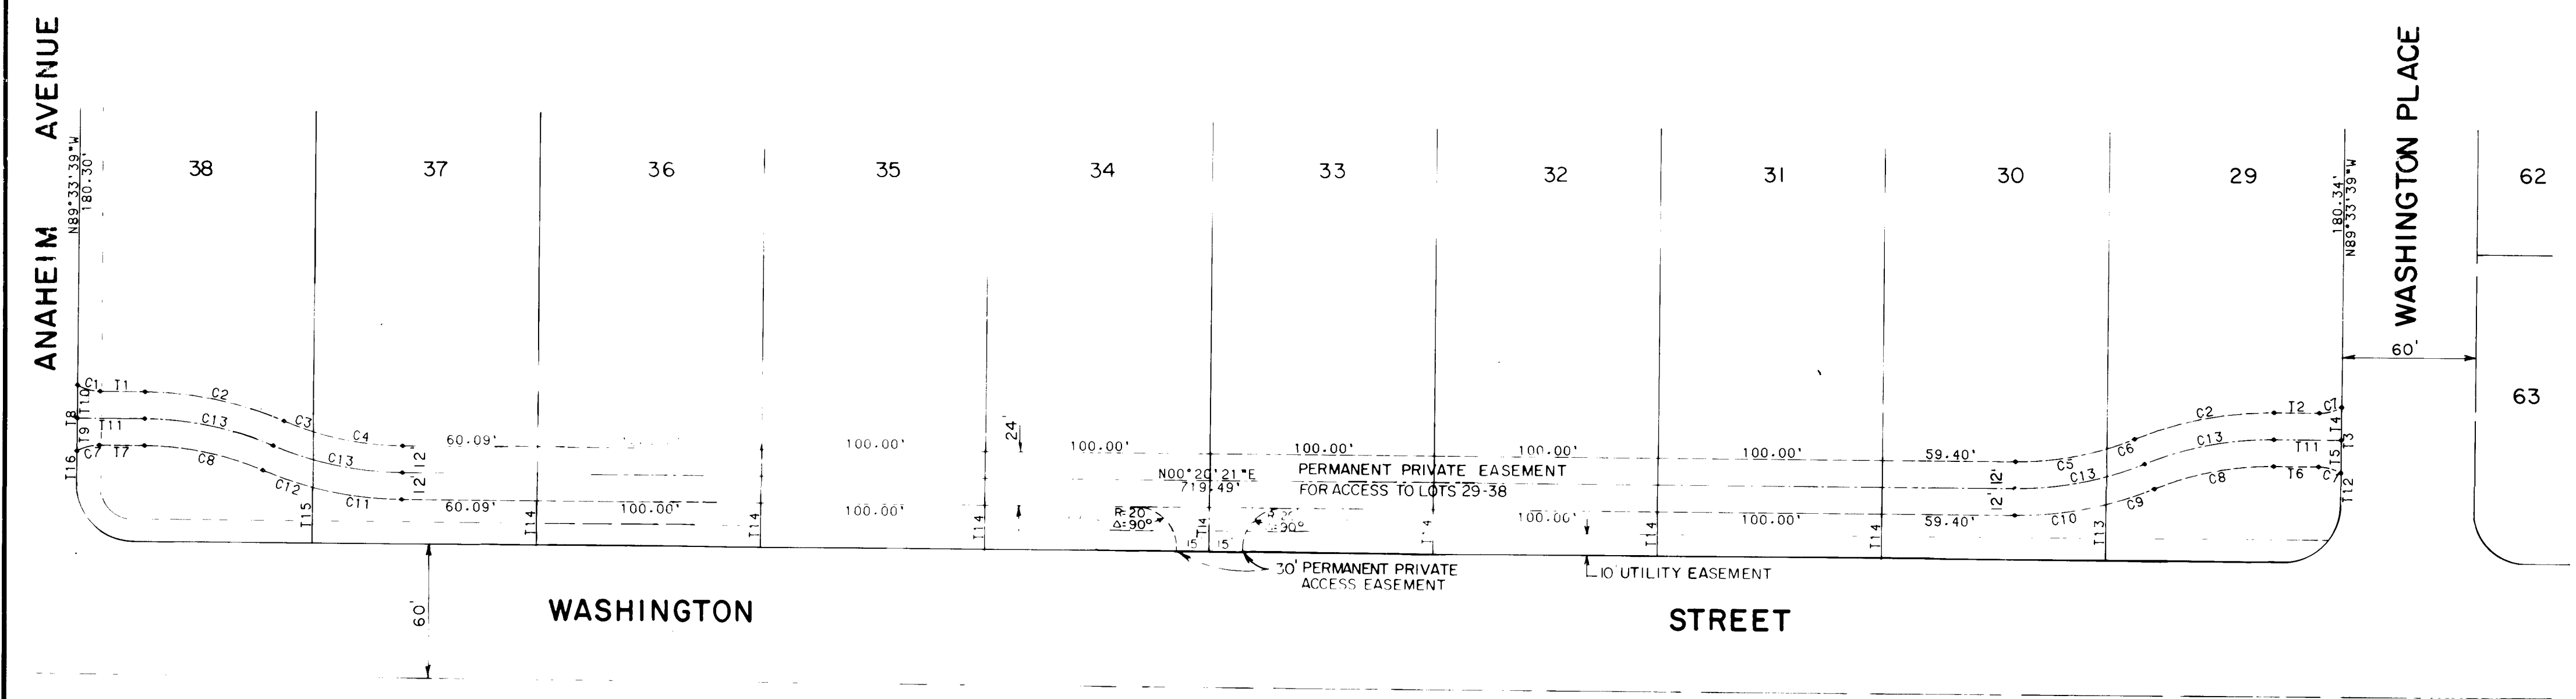

SURVEYOR'S CERTIFICATION
I, A. DWAIN WEAVER, UNDER THE LAWS OF NEW MEXICO, CERTIFY THAT I AM A REGISTERED LAND SURVEYOR, AND THAT THIS PLAT WAS PREPARED BY ME OR UNDER MY SUPERVISION, SHOWS ALL EASEMENTS OF RECORD, MEETS THE MINIMUM REQUIREMENTS FOR MONUMENTATION AND SURVEYS CONTAINED IN THE ALBUQUERQUE SUBDIVISION ORDINANCE, AND IS TRUE AND ACCURATE TO THE BEST OF MY KNOWLEDGE AND BELIEF.
A. DWAIN WEAVER
P.L.S. No. 6544, NEW MEXICO
DATE 7/16/1982

SHEET 4 OF 4 SHEETS



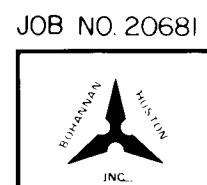


C21 44 4 of 4

DRAWING NO. 1564 REFERENCE 1625
SUBDIVISION PLAT SHEET 5 OF 27

26 1564 0584

42071
1204

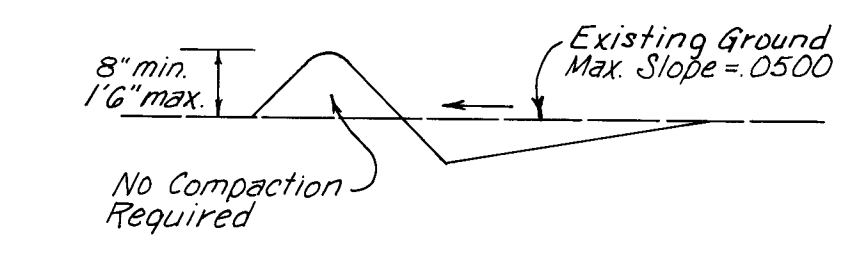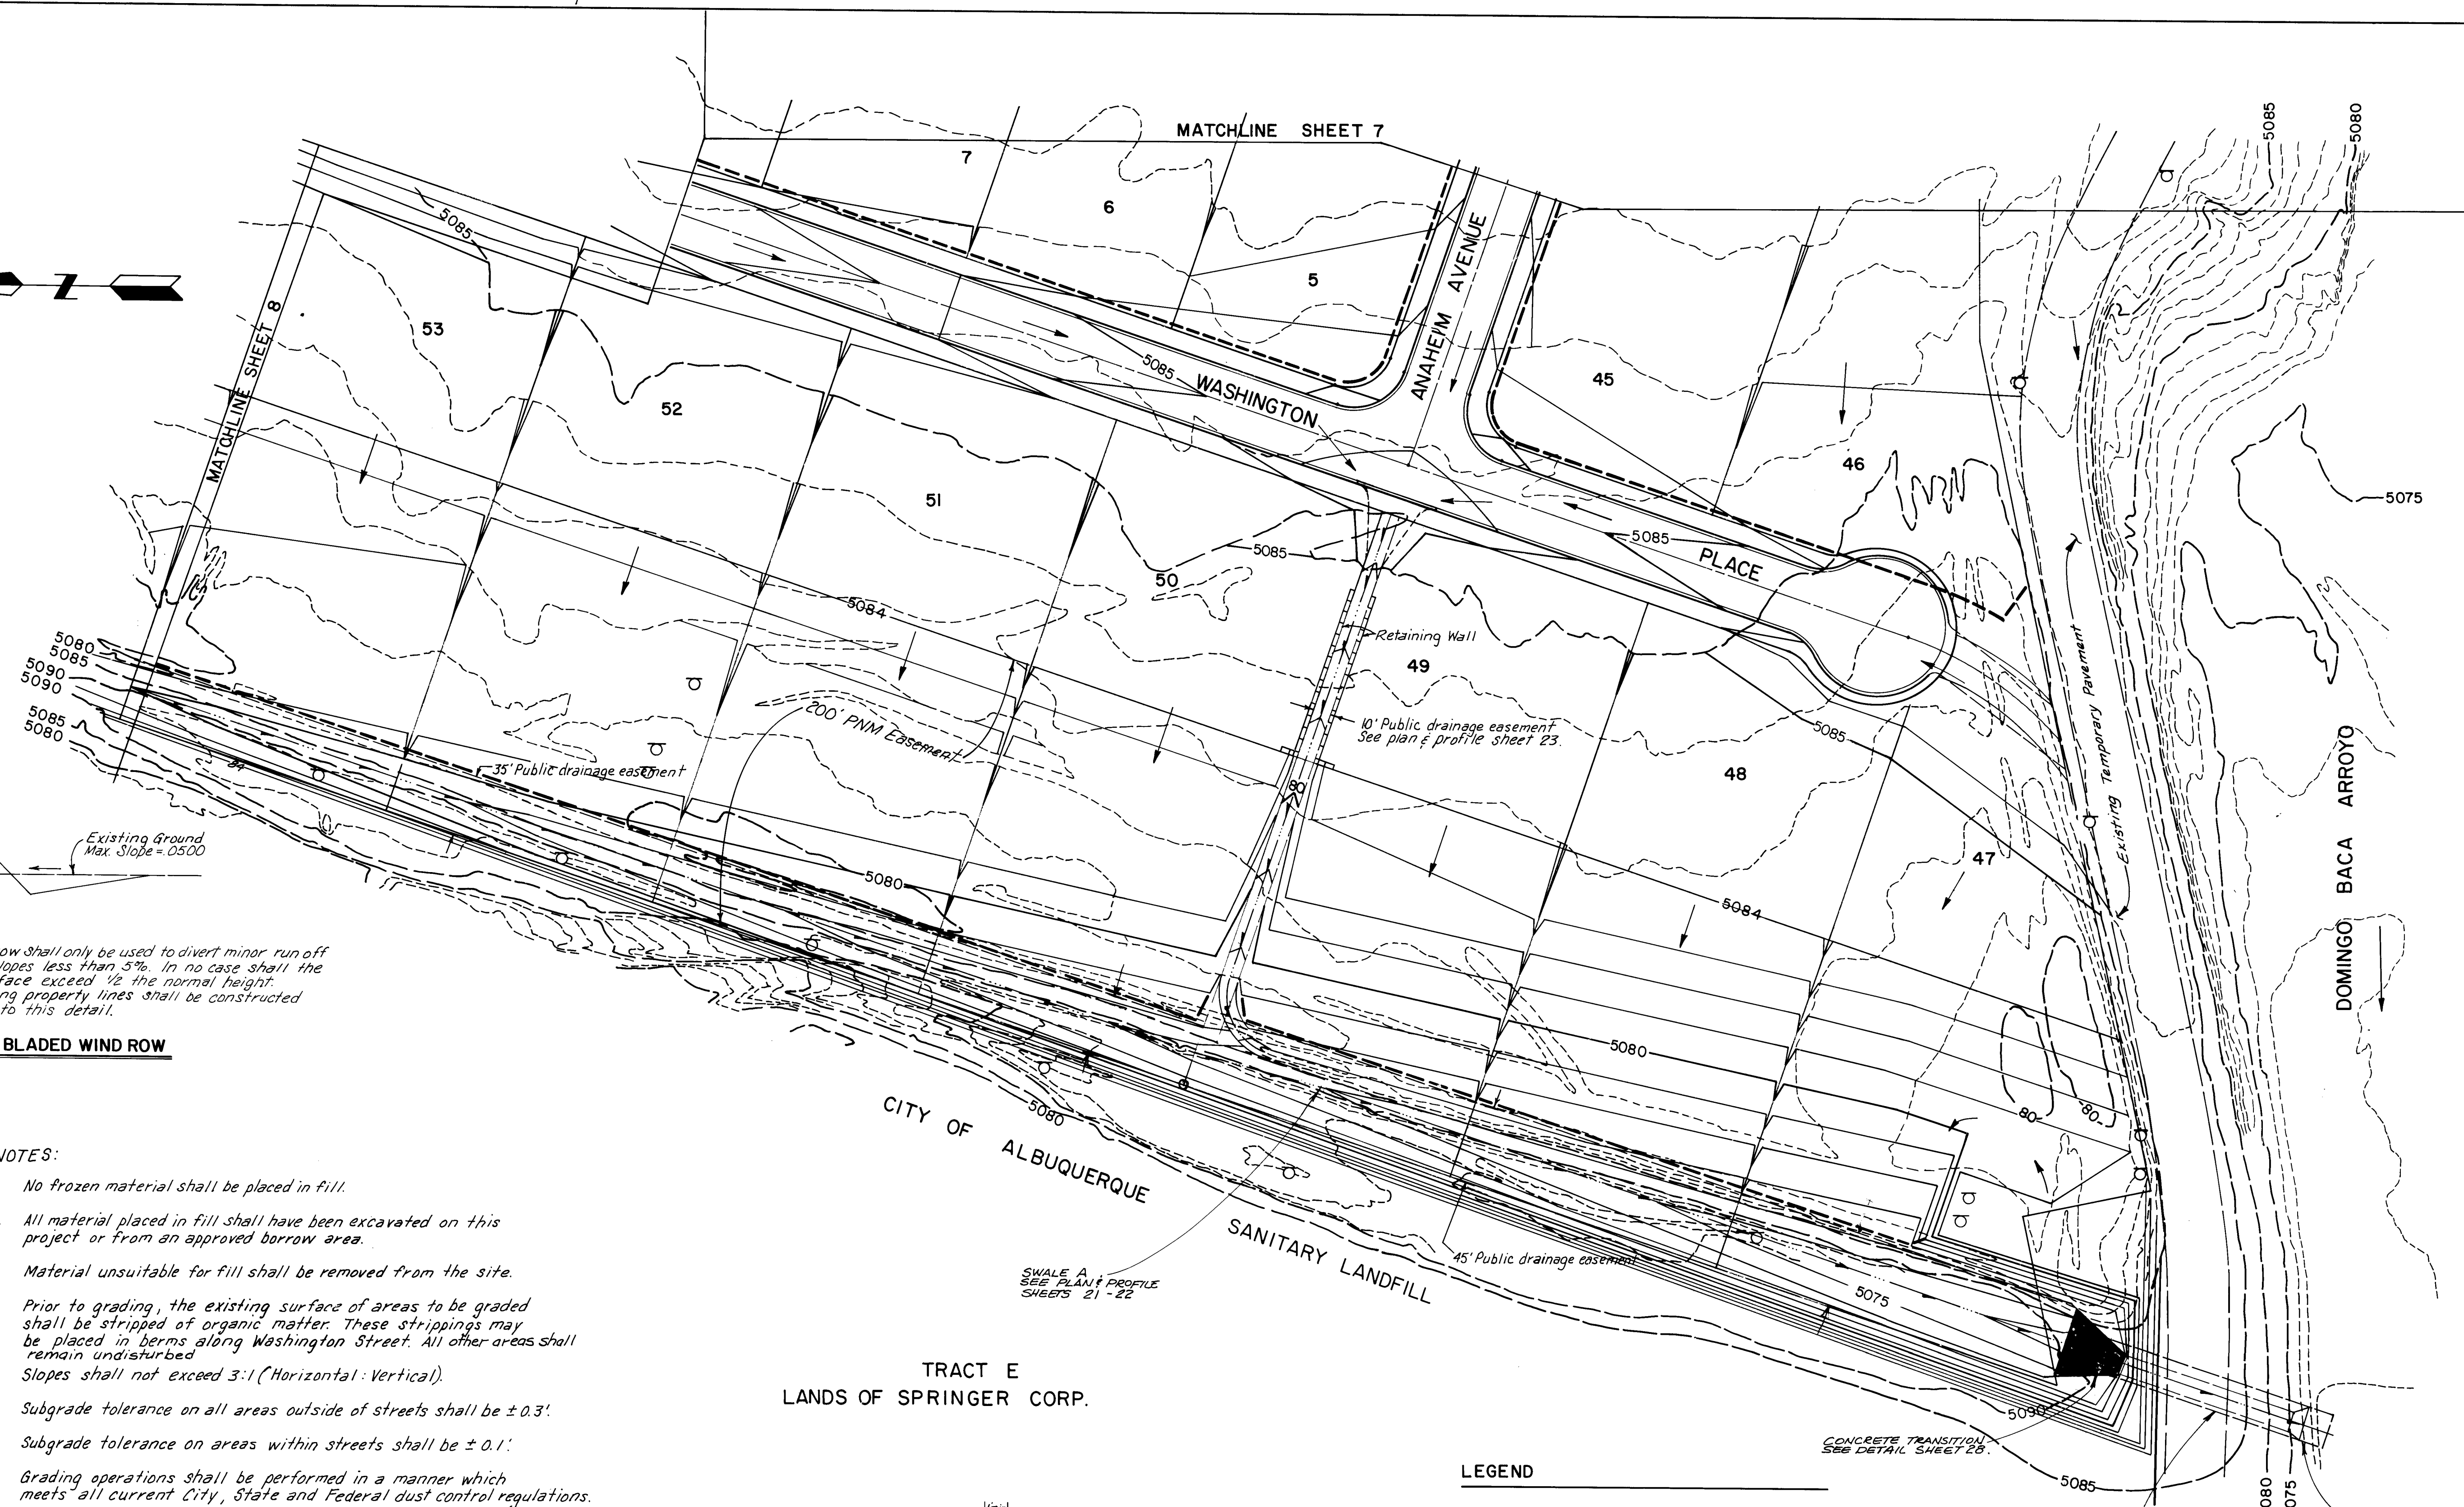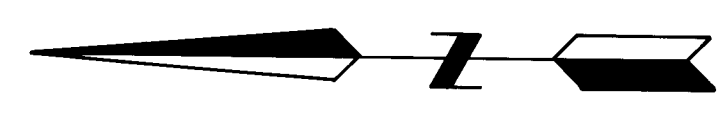


Notes: 1. This windrow shall only be used to divert minor runoff on cross slopes less than 5%. In no case shall the water surface exceed 1/2 the normal height.
2. Berms along property lines shall be constructed according to this detail.

TYPICAL BLADED WIND ROW
No Scale

- NOTES:
- No frozen material shall be placed in fill.
 - All material placed in fill shall have been excavated on this project or from an approved borrow area.
 - Material unsuitable for fill shall be removed from the site.
 - Prior to grading, the existing surface of areas to be graded shall be stripped of organic matter. These strippings may be placed in berms along Washington Street. All other areas shall remain undisturbed.
 - Slopes shall not exceed 3:1 (Horizontal:Vertical).
 - Subgrade tolerance on all areas outside of streets shall be $\pm 0.3'$.
 - Subgrade tolerance on areas within streets shall be $\pm 0.1'$.
 - Grading operations shall be performed in a manner which meets all current City, State and Federal dust control regulations.
 - Upon completion of grading a 9" high ($\pm 3"$) wind row shall be graded on each lot where it discharges to a swale or road. Individual wind rows may be removed upon development of corresponding lots. The intent is to pond runoff from minor storms to provide erosion control & minimize silting of the streets and drainage facilities.
 - Until a final Drainage solution is built no runoff will be discharged from the site. It will be retained within the West swale. The 100 year volume is 10.4 acre ft, the 10 year volume is 6.9 acre ft. These water surface elevations shall be 5082 and 5081 respectively.

**TRACT E
LANDS OF SPRINGER CORP.**

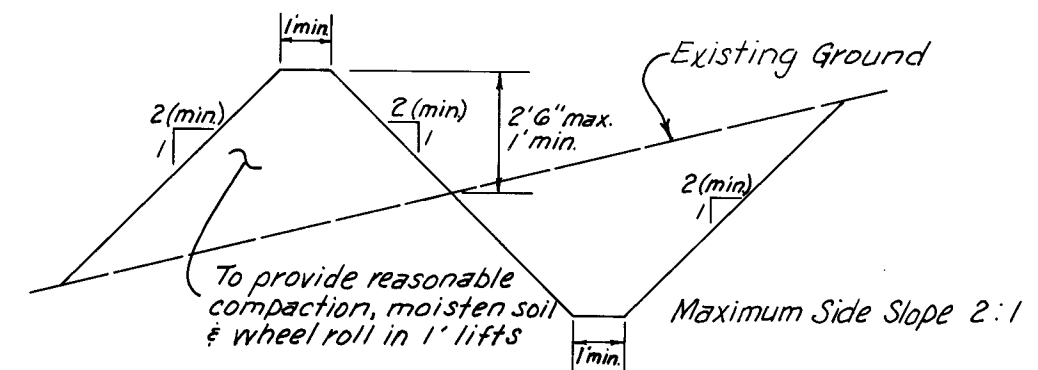


Note: Berms shown as --- shall be constructed according to this detail.

**TYPICAL SECTION OF TEMPORARY
DIVERSION BERM**
No Scale

- LEGEND**
- EXISTING CONTOUR
 - PROPOSED CONTOUR
 - DIRECTION OF FLOW
 - DRAINAGE SWALE
 - PROPOSED STANDARD CURB & GUTTER
 - EXISTING STANDARD CURB & GUTTER
 - TEMPORARY DIVERSION BERM
 - EXISTING UTILITY POLE


SCALE:
1" = 50'

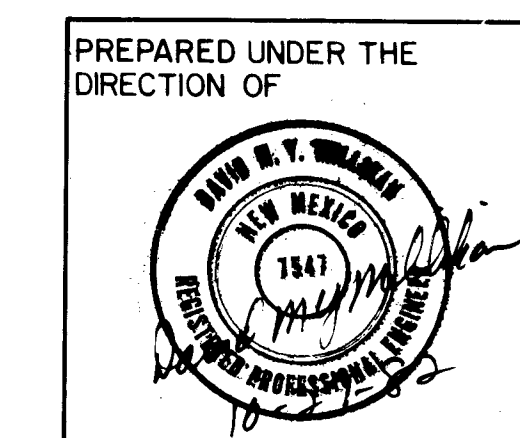

APPROVED FOR ROUGH GRADING
CITY ENGINEER DATE 6-24-82

CITY OF ALBUQUERQUE MUNICIPAL DEVELOPMENT DEPARTMENT ENGINEERING DIVISION					
TITLE: CLIFFORD INDUSTRIAL PARK GRADING PLAN (WEST)					
APPROVALS	ENGINEER	DATE	APPROVALS	ENGINEER	DATE
City Engineer	<i>A. J. Lopez</i>	7/7/82	Liquid Waste	N.A. Jones	7/7/82
A.C.E.-Design	<i>Alfred</i>	7/7/82	Traffic	N.A. Jones	7/7/82
A.C.E.-Hydrology	<i>Alfred</i>	7/7/82	Water	N.A. Jones	7/7/82
DRAWING NO. 1564					
SHEET 6 OF 27					


REFERENCES		SURVEY INFORMATION		BENCH MARKS		AS-BUILT INFORMATION	
MAP NO. C-17	EST. NO.	NO.	DATE	THE STATION IS A STANDARD ACS BRASS TABLET, STAMPED "8-CIT. 1975", CEMENTED IN A DRILL HOLE IN TOP OF THE WEST CONCRETE CURB 0.3 MILE NORTH OF LOS ANGELES BLVD. ON WASHINGTON ST. ELEV. = 5111.029	CONTRACTOR	WORK STAKED BY	DATE
						ACCEPTANCE BY	DATE
						FIELD CORRECTION BY	DATE
						REVISIONS	
						DESIGN	
						RECORDED BY	DATE
						NO.	

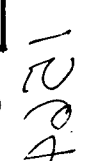




BRUNING 44.132.52753

- LEGEND
- EXISTING CONTOUR
 - PROPOSED CONTOUR
 - DIRECTION OF FLOW
 - DRAINAGE SWALE
 - PROPOSED STANDARD CURB & GUTTER
 - EXISTING STANDARD CURB & GUTTER
 - TEMPORARY DIVERSION BERM

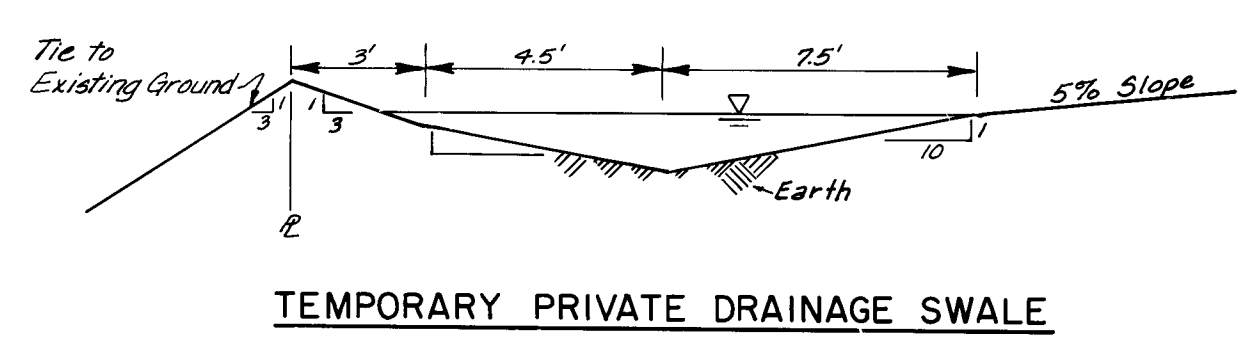

SCALE: 1" = 50'

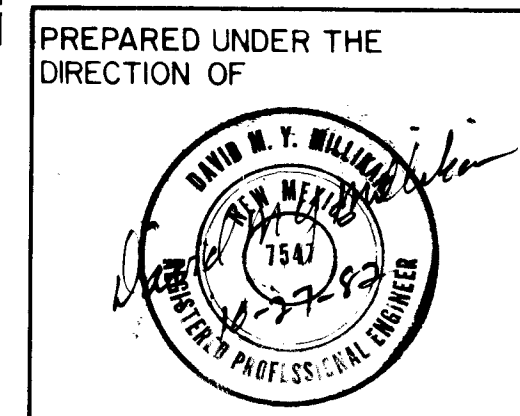


APPROVED FOR ROUGH GRADING
CITY ENGINEER
DATE 6-24-82

CITY OF ALBUQUERQUE MUNICIPAL DEVELOPMENT DEPARTMENT ENGINEERING DIVISION			
TITLE: CLIFFORD INDUSTRIAL PARK GRADING PLAN (CENTRAL)			
APPROVALS	ENGINEER	DATE	APPROVALS
City Engineer	C. N. Williams	7-27-82	Liquid Waste
A.C.E.-Design	Williams	7-27-82	Traffic
A.C.E.-Hydrology	Williams	7-27-82	Water
DRAWING NO. 1564		SHEET 8 OF 27	

REFERENCES				SURVEY INFORMATION				BENCH MARKS				AS-BUILT INFORMATION			
MAP NO. C-17	EST. NO.	W/O NO.	BY	NO.	DATE	THE STATION IS A STANDARD ACS BRASS TABLET, STAMPED "8-C7, 1975", CEMENTED IN A DRILL HOLE IN TOP OF THE CONCRETE CURB 0.3 MILE NORTH OF LOS ANGELES BLVD. ON WASHINGTON ST.	CONTRACTOR	WORK STARTED BY	DATE	ACCEPTANCE BY	DATE	RECORDED BY	DATE	NO.	
REVISIONS				DESIGN				MICRO-FILM INFORMATION							
NO.	DATE	REMARKS	BY	DESIGNED BY	DATE	DRAWN BY	DATE	CHECKED BY	DATE	NO.					
				DW	9/82	PE	9/82	DMYM	9/82						

BRUNING 44-13-12753

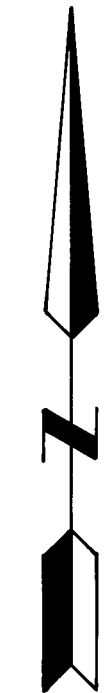

LEGEND

- EXISTING CONTOUR
- PROPOSED CONTOUR
- DIRECTION OF FLOW
- - - DRAINAGE SWALE
- PROPOSED STANDARD CURB & GUTTER
- EXISTING STANDARD CURB & GUTTER
- o EXISTING UTILITY POLE
- - - TEMPORARY DIVERSION BERM

SANITARY LANDFILL

Desilting Basin

TRACT B


STREET

WASHINGTON

INDUSTRIAL DISTRICT LOOP

MATCHLINE SHEET 8

1564 0984

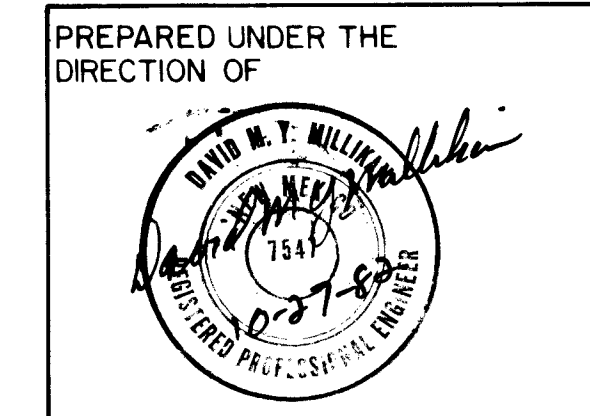

APPROVED FOR ROUGH GRADING

City Engineer Date

CITY OF ALBUQUERQUE
MUNICIPAL DEVELOPMENT DEPARTMENT
ENGINEERING DIVISION

TITLE: CLIFFORD INDUSTRIAL PARK
GRADING PLAN (NORTH)

APPROVALS	ENGINEER	DATE	APPROVALS	ENGINEER	DATE
City Engineer	<i>A. J. ...</i>	9/7/82	Liquid Waste	<i>N.A. ...</i>	7/27/82
A.C.E.-Design	<i>...</i>	9/7/82	Traffic	<i>N.A. ...</i>	7/27/82
A.C.E.-Hydrology	<i>...</i>	9/7/82	Water	<i>N.A. ...</i>	7/27/82

DRAWING NO. 1564 SHEET 9 OF 27

REFERENCES			SURVEY INFORMATION			BENCH MARKS			AS-BUILT INFORMATION		
MAP NO. C-17	EST. NO.	W.O. NO.	NO.	BY	DATE	THE STATION IS A STANDARD ACS BRASS TABLET STAMPED "8-C17 1975"	CONTRACTOR	DATE	CONTRACTOR	DATE	DATE
						CEMENTED IN A DRILL HOLE IN TOP OF THE WEST CONCRETE CURB 0.3 MILE NORTH OF LOS ANGELES BLVD. ON WASHINGTON ST.					
						ELEV = 5111.029					

REVISIONS			DESIGN			MICRO-FILM INFORMATION		
NO.	DATE	REMARKS	DESIGNED BY	DATE		RECORDED BY	DATE	
			DWM	9/7/82				
			PE	9/7/82				
			DNM	9/7/82				


REFERENCE 1625

12871 12874

TO BE CONSTRUCTED WITH PROJECT 1625

NOTES:


1. Water and Sewer Lines shall be installed per Supplemental General Conditions Section 181, Policy on the proximity of Water and Sewer Lines, New Mexico Standard Specifications for Public Works Construction, 1979 Edition.
2. Sewer Line construction shall comply with the City of Albuquerque "Contract Documents for City-Wide Utilities and Cash Paving #31 and the New Mexico Standard Specifications for Public Works Construction, 1979 Edition.
3. Sewer Services, other than those indicated, shall not tie-in to the Sewer Main at manholes.
4. Electronic Marker Disks shall be installed at all service tees and at all plugged ends as specified in Section 131 of the Supplemental Technical Specifications to the City of Albuquerque "Contract Documents for City Wide Utilities and Cash Paving #31."
5. Streets shall be graded to finish grade $\pm 1.0'$ Prior to installation of utilities.
6. For Sanitary Sewer service tee locations see sheets 13 through 18.
7. All service line stub-outs shall be perpendicular to the Sanitary Sewer Main. Stub outs shall be 4" CIP unless otherwise noted.
8. A water-tight plug and EMD shall be installed at the end of each stub-out.
9. Water line shall be a minimum 10' North or West of centerline of the Sanitary Sewer Line.
10. The Sanitary Sewer Main and laterals within the street right-of-ways will be maintained by the City of Albuquerque.
11. All encasement shall be constructed per City Standard Drawing S-10.
12. Deflections through manholes are 0"0'0" unless otherwise specified.
13. Sewer Service Laterals shall have between 2% and 10% slopes. Deep Laterals shall be constructed according to the Service Connection Detail below. The distance GC is specified in the plan view.
14. Sewer Service Lateral Plugs shall be located one Foot outside of the Right of Way. The Elevations given in the Profiles are at the Plugs.

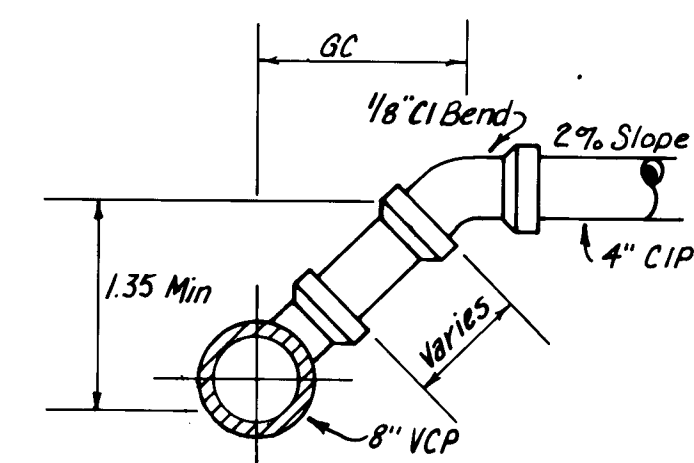

TYPICAL SERVICE CONNECTION
NO SCALE

LEGEND

- SAS— PROPOSED SANITARY SEWER LINE
- - -SAS- - - EXISTING SANITARY SEWER LINE
- PROPOSED MANHOLE
- EXISTING MANHOLE
- S— PROPOSED SERVICE LATERAL SHOWING GC DISTANCE
- - -S- - - EXISTING SERVICE LATERAL

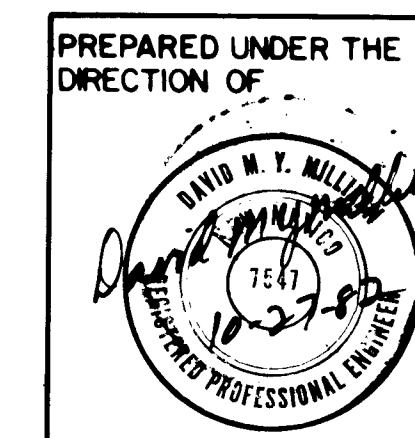

APPROVED FOR CONSTRUCTION

CITY ENGINEER DATE 12/16/82


CITY OF ALBUQUERQUE MUNICIPAL DEVELOPMENT DEPARTMENT ENGINEERING DIVISION			
TITLE: CLIFFORD INDUSTRIAL PARK-PHASE I LOTS 1-63 SANITARY SEWER DESIGN			
APPROVALS	ENGINEER	DATE	APPROVALS
City Engineer	David M. Y. Miller	12/16/82	Liquid Waste
A.C.E.-Design	James J. Miller	12/16/82	Traffic
A.C.E.-Hydrology	James J. Miller	12/16/82	Water
DESIGNED BY	DWM	DATE	9/82
DRAWN BY	PE	DATE	9/82
CHECKED BY	DWM	DATE	9/82

SCALE: 1"=100'

DRAWING NO. 1564

SHEET 10 OF 27

REFERENCE 1625

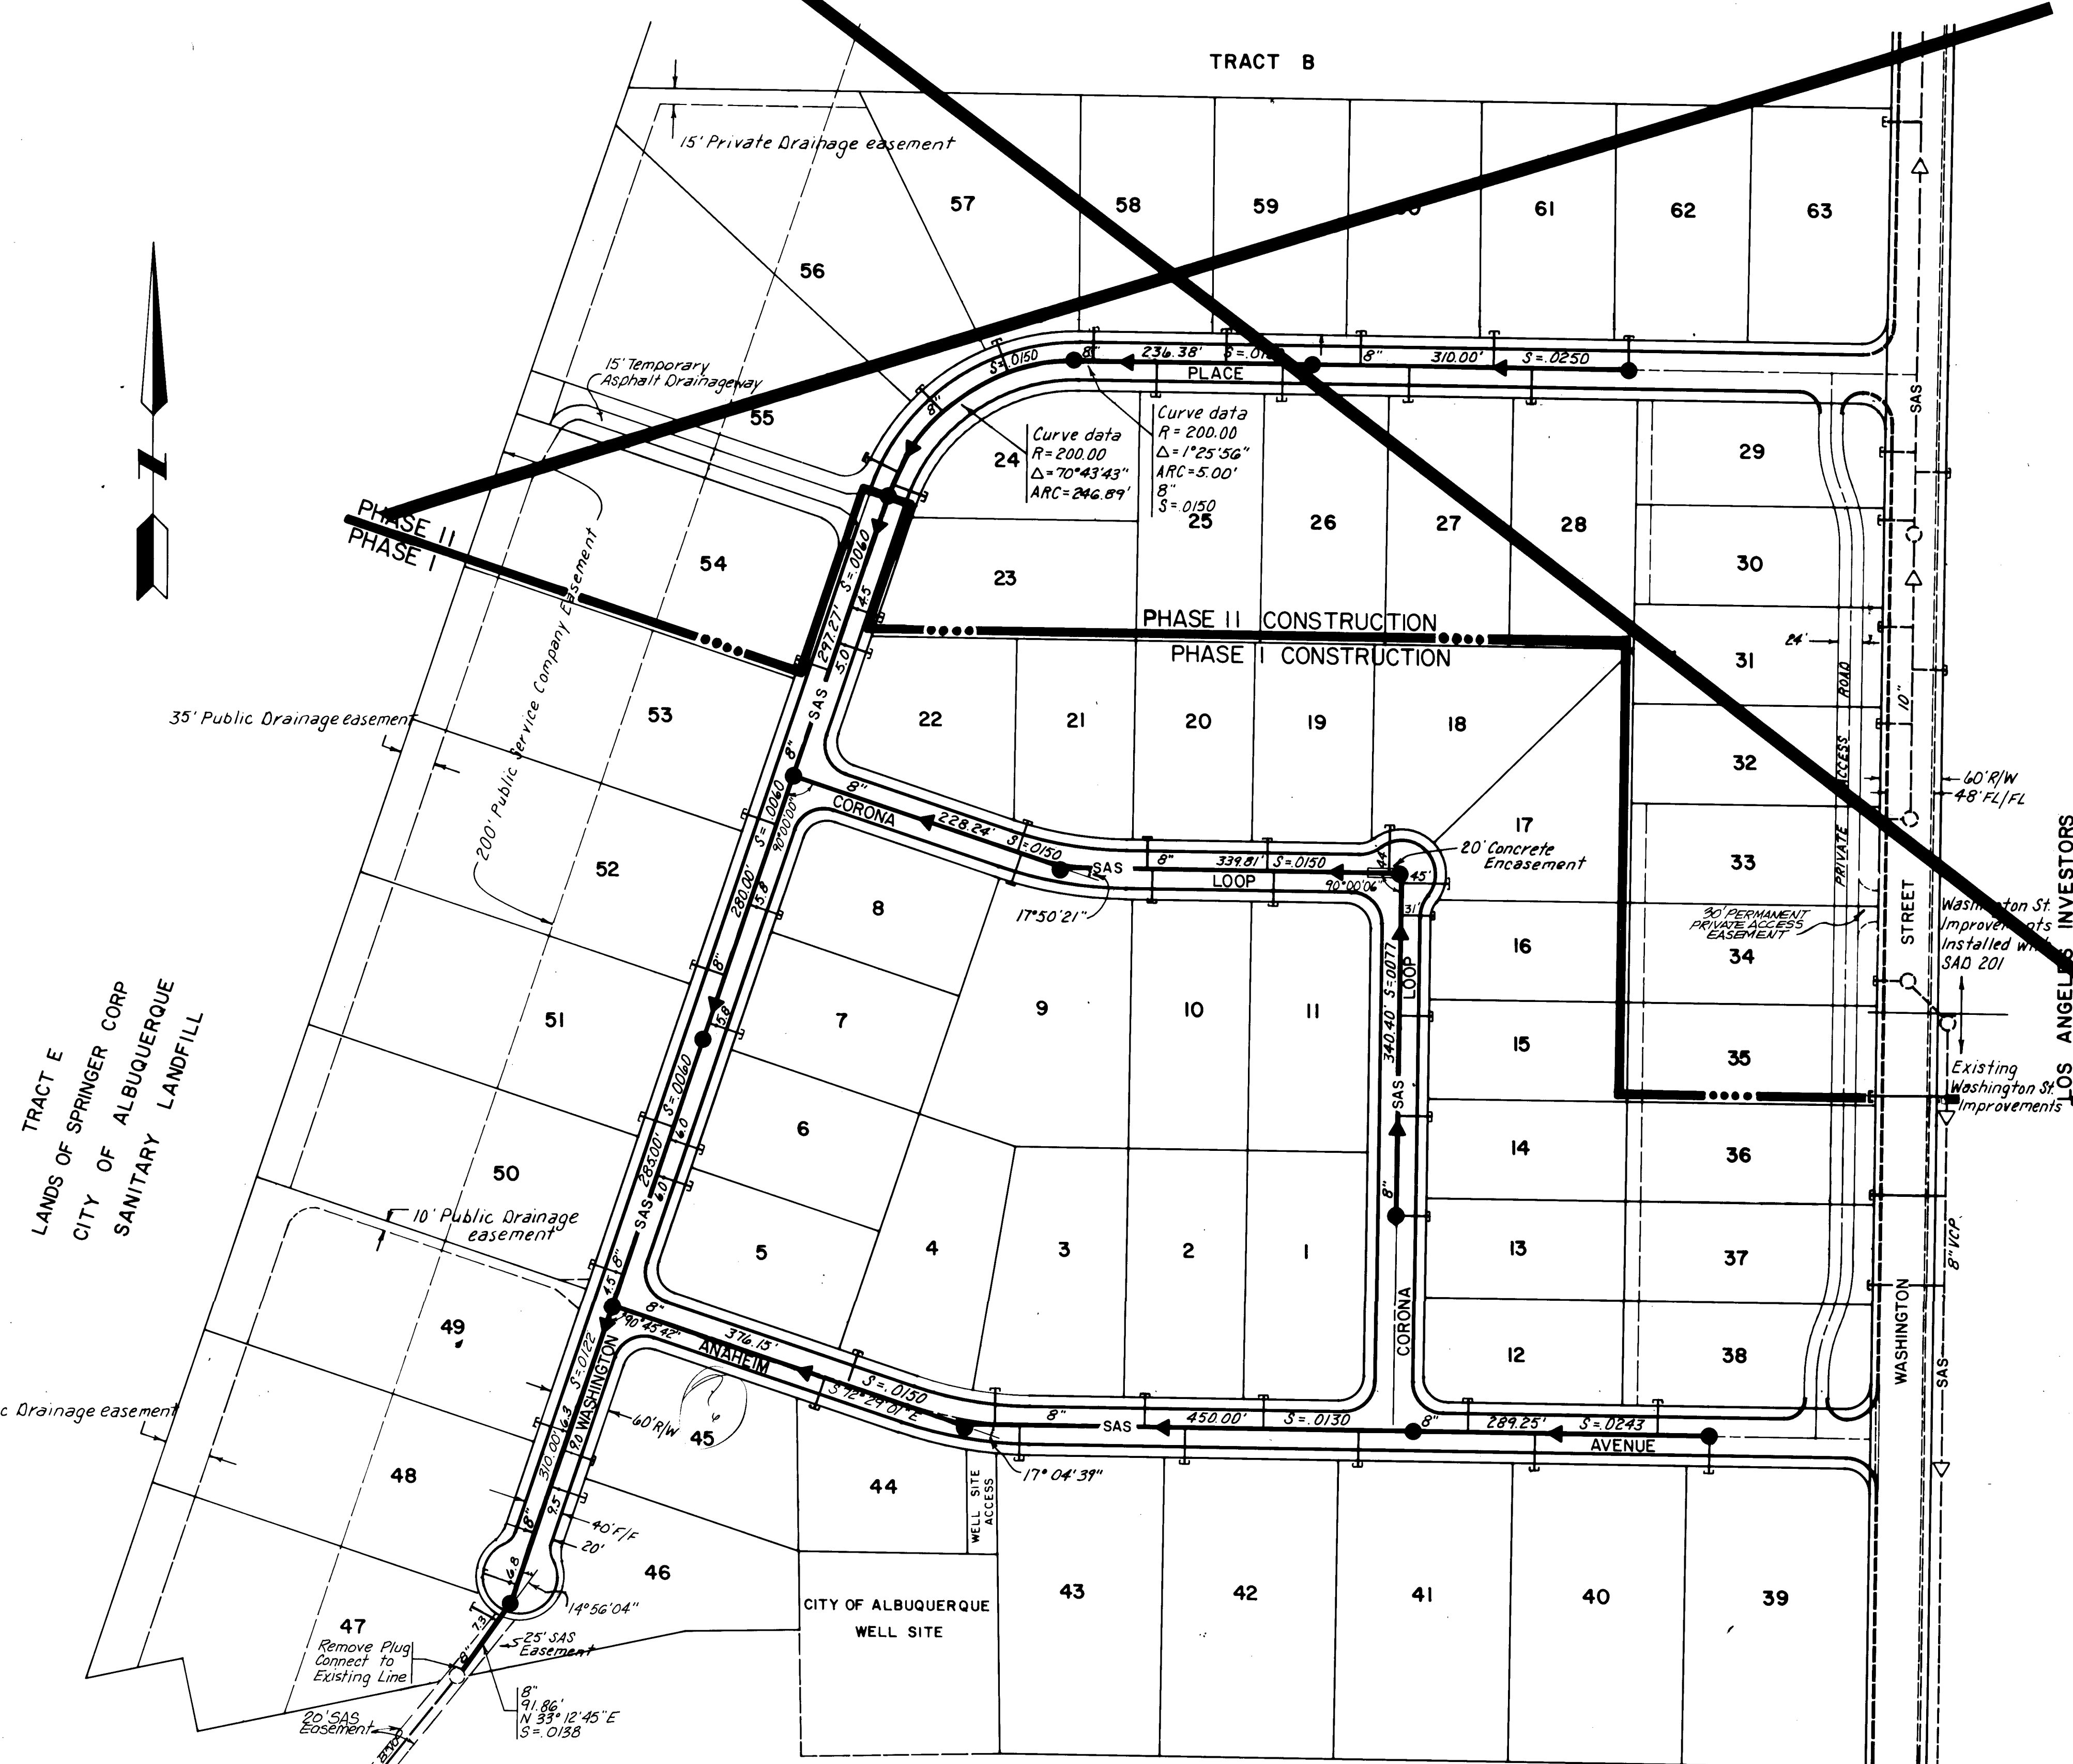


TRACT E
LANDS OF SPRINGER CORP
CITY OF ALBUQUERQUE
SANITARY LANDFILL

AMAFCA DRAINAGE RIGHT OF WAY

DOMINGO BACA ARROYO

BRUNING 44 132 52753

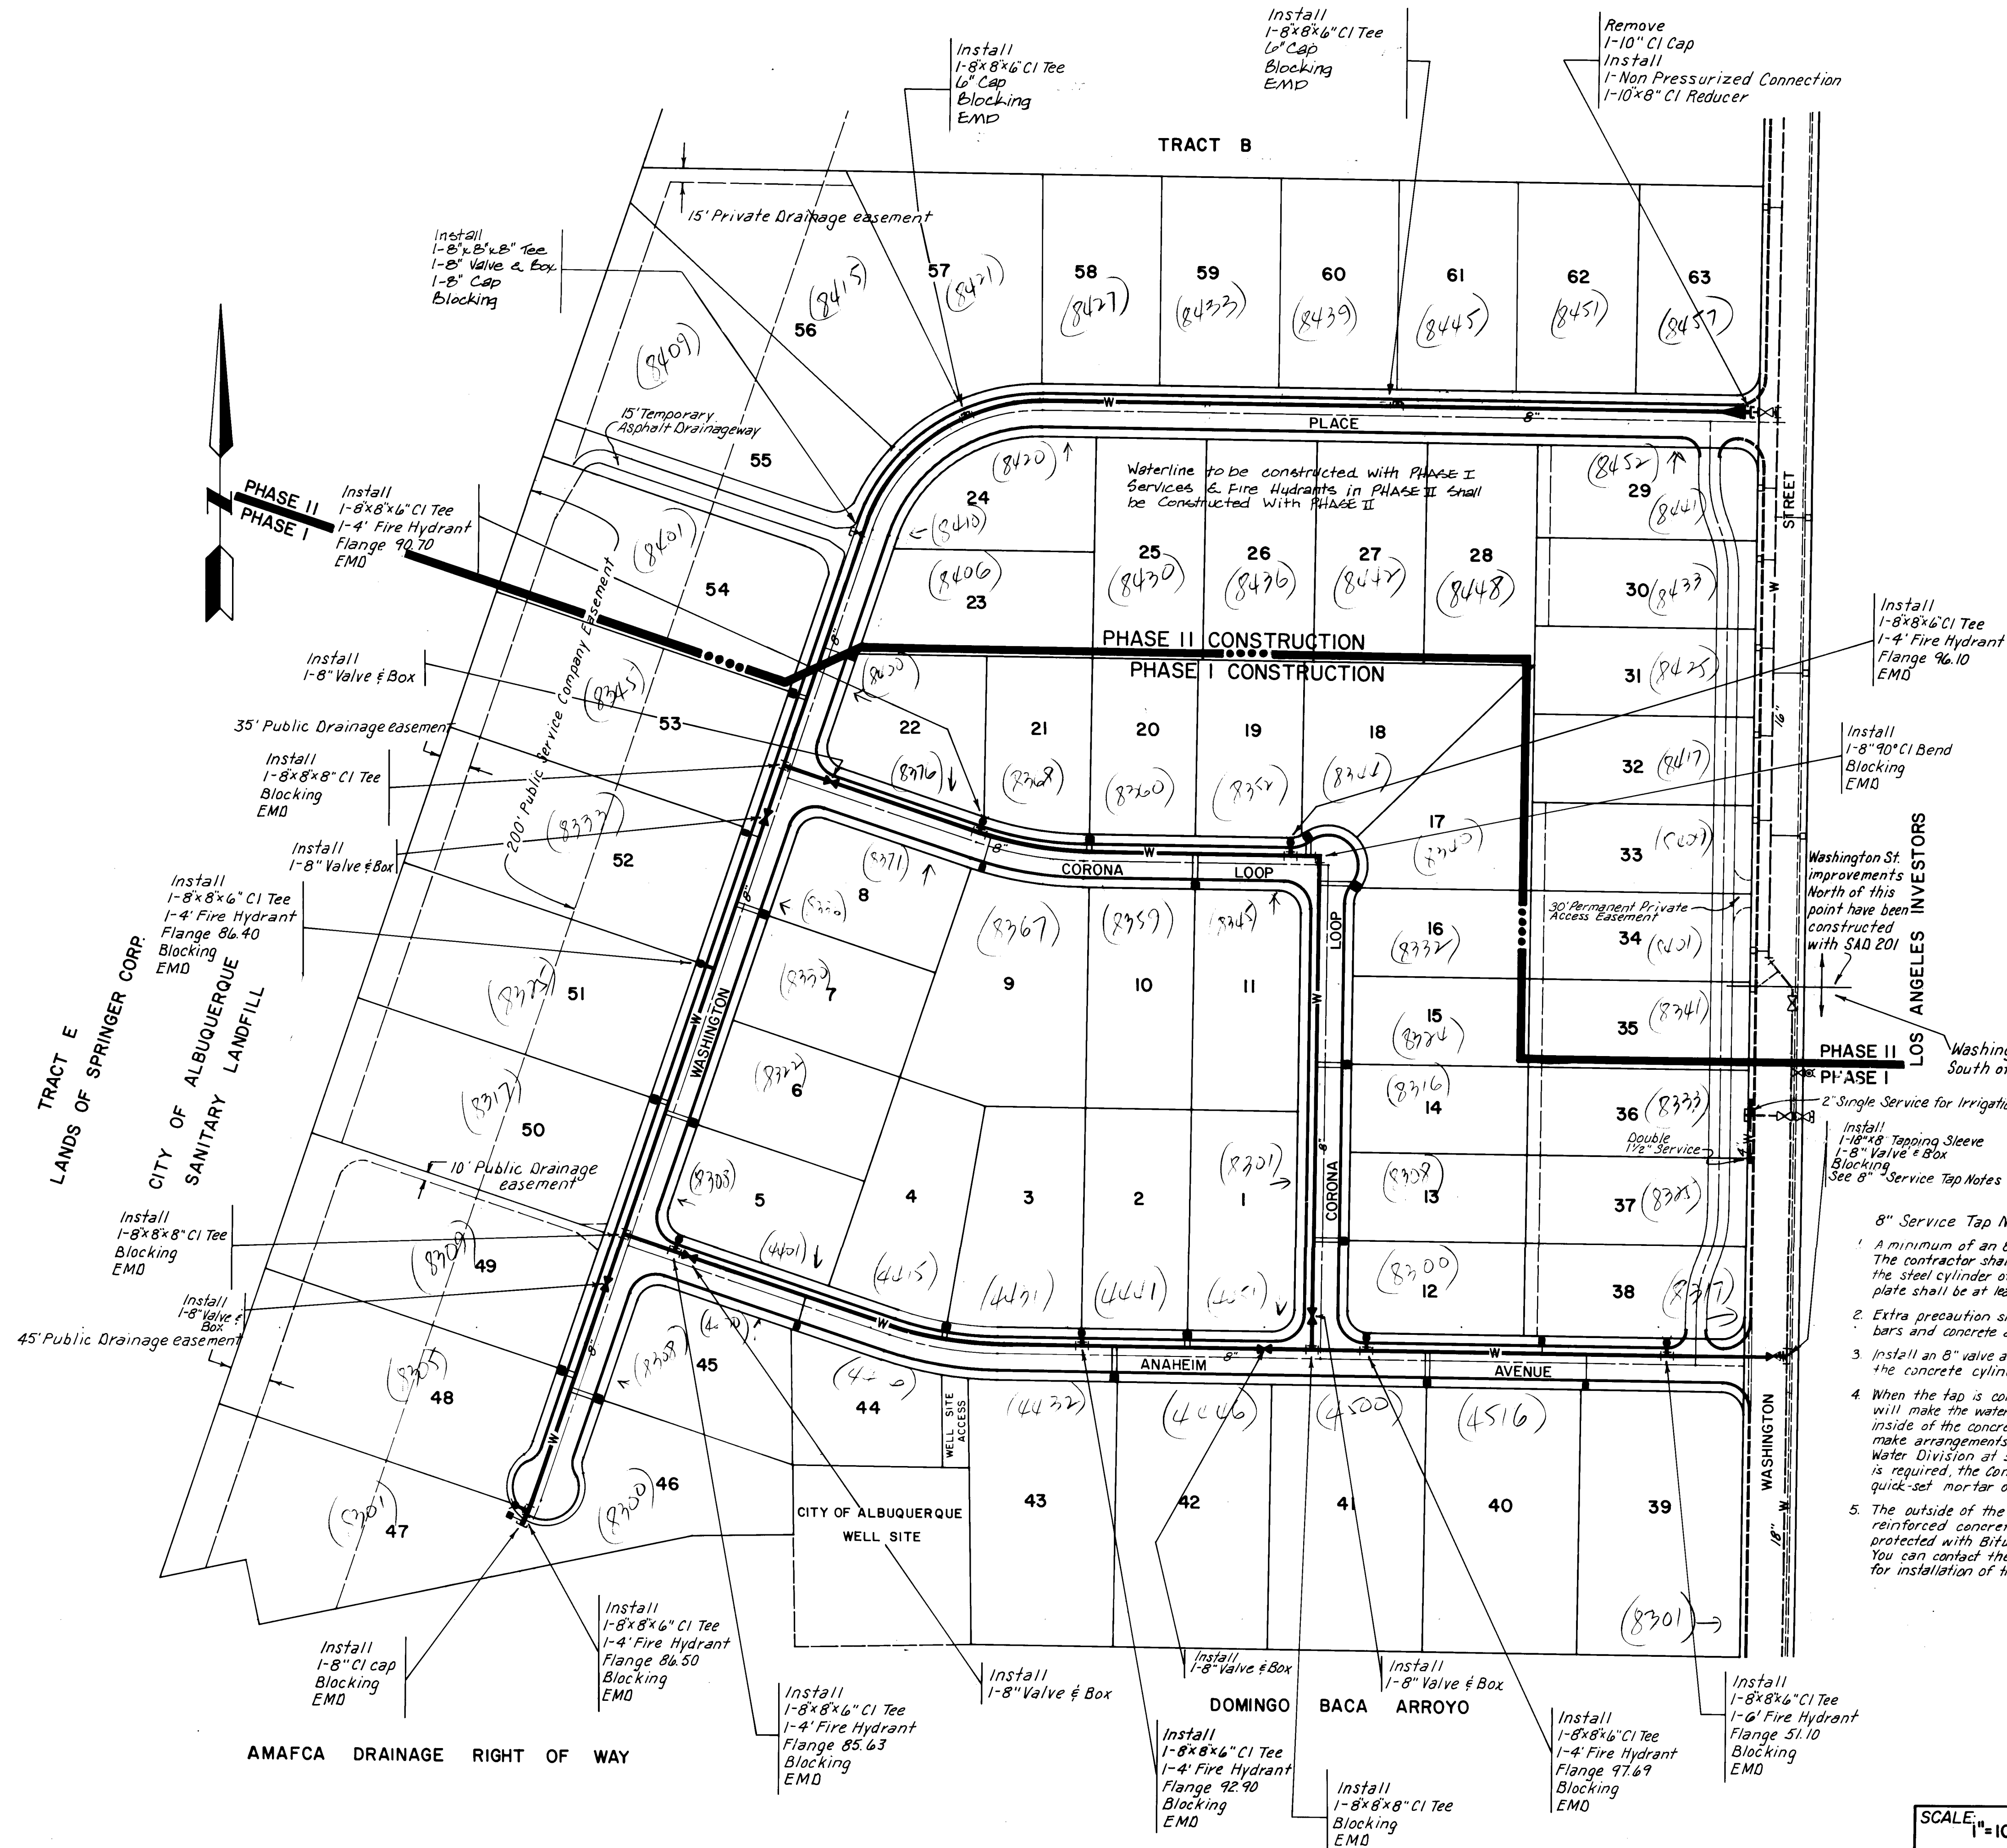

- Notes:
- Waterline Construction shall comply with the City of Albuquerque "Contract Documents for City-Wide Utilities and Cash Paving #31" and the New Mexico Standard Specifications for Public Works Construction 1979 Edition.
 - All Waterlines shall be located 10' North or West of the street centerline.
 - All Fire Hydrants shall be located at the PC of curb returns or at property lines.
 - All Water Valves shall be located at the PC of curb returns, or 5' after the PC when a Fire Hydrant occupies the PC.
 - All Water Valve Box Covers within the streets shall be identified as specified in "Special Order #18", from the City Engineer.
 - "Whenever possible, it is desirable to lay parallel water and sewer lines at least 10 feet apart horizontally, and the water line should be a higher elevation than the sewer. If this is not possible, separate trenches will be required in all cases (this shall be effective even though one line has been installed prior to the other), and the water line shall be at least 2 feet above the sewer. When water and sewer lines cross each other, the water line shall be at least 3 feet above the sewer, otherwise the sewer shall be of cast iron pipe. A preferred alternative is encasement in concrete as shown in the Standard Details for 10' on each side of the water line.
 - All Water Lines shall have a minimum of 3'8" bury from top of curb.
 - Streets shall be graded to Finished Grade $\pm 1'0"$ prior to installation of utilities.
 - The Utility Contractor shall be responsible for constructing water services from water main to curb stop including curb box along with street and utility improvements. Installation of water service from curb to property line shall be done by Utility Contractor when meters are set.
 - Electronic Marker Disks shall be installed at all valves, bends, caps, tees and service connections as specified in Section 131 of the Supplemental Technical Specifications to the City of Albuquerque Contract Documents for City Wide Utilities and Cash Paving #31.
 - Single Water Meter Locations will have 1/2" service lines and 1/2" Water Meters and one Water Meter Box and Cover.
 - Double Water Meter Locations will have two 1/2" service lines, two 1/2" Water Meters with one Water Meter Box and Cover.
 - Water Meter locations will be in accordance with City Standard Drawing # W-15-1.
 - Water Meters shall be grouped in pairs whenever possible.
 - All Waterlines and Services within easements shall be built to City of Albuquerque Standards and will be maintained by the City of Albuquerque.
 - Stationing of Valves and Bends shall be found on the plan and profile sheets of this plan set.








LEGEND

- W— EXISTING WATERLINE
- W— PROPOSED WATERLINE
- ⊥ TEE
- ⌒ BEND
- CAP
- ⊕ VALVE
- ⊕ FIRE HYDRANT
- DOUBLE 3/4" SERVICE
- SINGLE 3/4" SERVICE

8" Service Tap Notes:

- A minimum of an 8" service tap is to be installed. The contractor shall weld an 8" welded neck directly on the steel cylinder of the concrete cylinder pipe. The base plate shall be at least 14" (width) x 14" (length) x 1/2" (thickness).
- Extra precaution shall be exercised when the reinforced bars and concrete are removed.
- Install an 8" valve and make a direct pressurized tap on the concrete cylinder pipe.
- When the tap is completed, the Water Systems Division will make the water shut-off on the line and inspect the inside of the concrete cylinder pipe. The Contractor shall make arrangements for a water shut-off permit with the Water Division at 5501 Pino Rd. NE, 766-7100. If grouting is required, the contractor shall grout with a non-shrink, quick-set mortar or with Belzona quartz material.
- The outside of the 18" concrete cylinder pipe, where the reinforced concrete is removed, shall be grouted or protected with Bitumastic 50 and with magnesium anodes. You can contact the Water Resources Dept. to make arrangements for installation of the anodes.

HAWE NUMBER
24-1564-1184

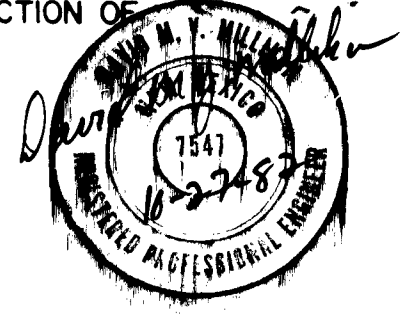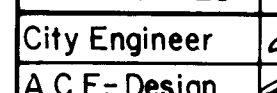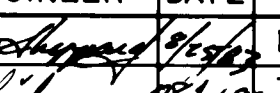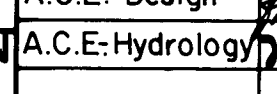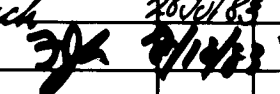
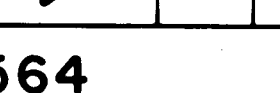
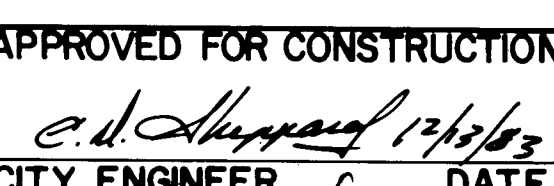
PREPARED UNDER THE DIRECTION OF 			CITY OF ALBUQUERQUE MUNICIPAL DEVELOPMENT DEPARTMENT ENGINEERING DIVISION		
TITLE: CLIFFORD INDUSTRIAL PARK-PHASE I LOTS 1-63 WATER DESIGN					
APPROVALS	ENGINEER	DATE	APPROVALS	ENGINEER	DATE
City Engineer		11/88	Liquid Waste		11/88
A.C.E.-Design		11/88	Traffic		11/88
A.C.E.-Hydrology		11/88	Water		11/88
APPROVED FOR CONSTRUCTION  CITY ENGINEER			DRAWING NO. 1564 SHEET 11 OF 27		

PLAN	DATE	BY
DESIGNED		
CHECKED		
NOTED		
DATE		

PROFILE	DATE	BY
DESIGNED		
CHECKED		
NOTED		
DATE		

RECORD DRAWING
I, Claude A.L. Pilley, N.M.P.E. & L.S. No. 4981,
hereby certify that this drawing has been
revised in accordance with information furnished
by KNC Inc. field surveys and that both the
revisions and field surveys were done under
my personal direction and control.

Claude A.L. Pilley
CLAUDE A.L. PILLEY

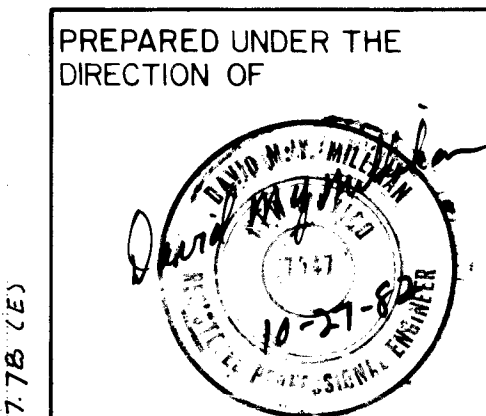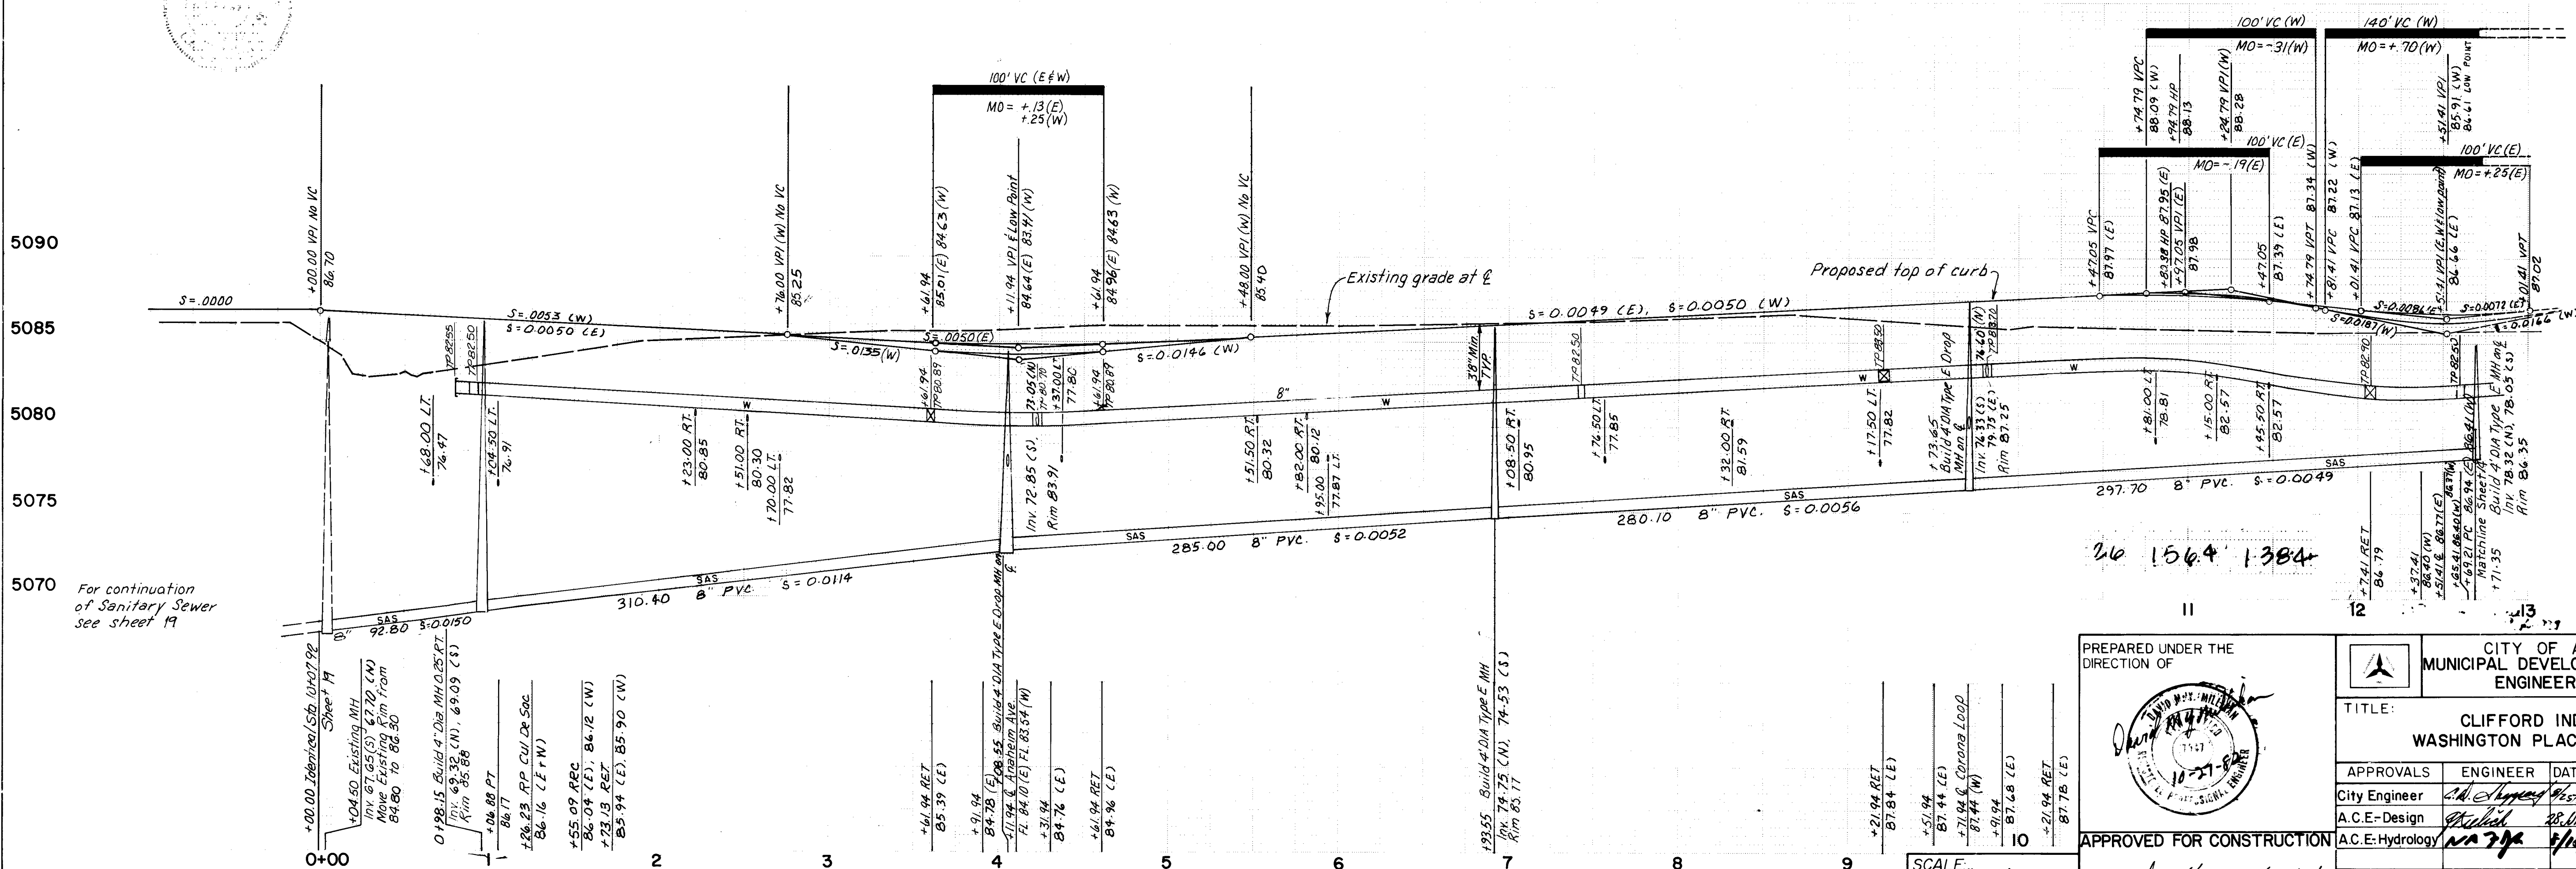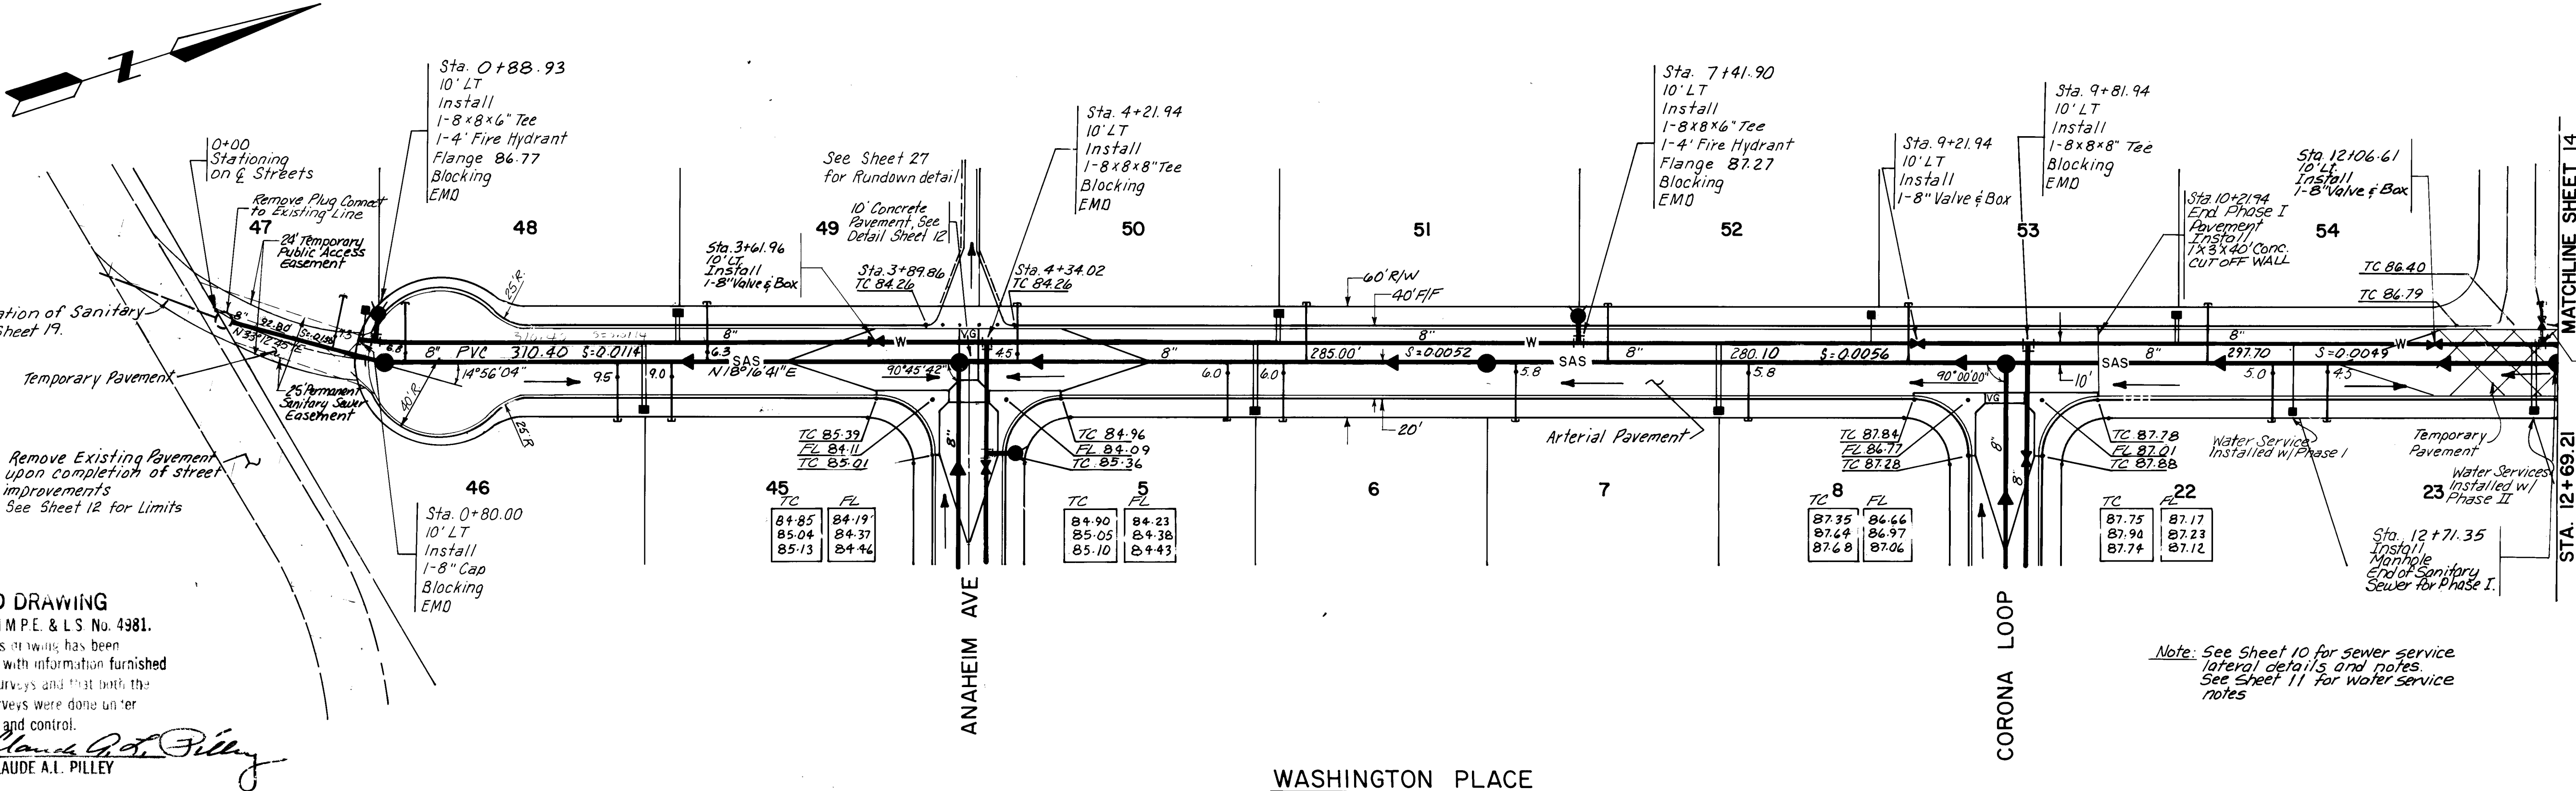

APPROVED FOR CONSTRUCTION
C. A. Pilley 12/3/82
CITY ENGINEER


CITY OF ALBUQUERQUE MUNICIPAL DEVELOPMENT DEPARTMENT ENGINEERING DIVISION			
TITLE: CLIFFORD INDUSTRIAL PARK-PHASE I WASHINGTON PLACE STA. 0+00-12+69.21			
APPROVALS	ENGINEER	DATE	APPROVALS
City Engineer	<i>C. A. Pilley</i>	12/3/82	Liquid Waste
A.C.E-Design	<i>Michael</i>	12/3/82	Traffic
A.C.E-Hydrology	<i>NA 7/8</i>	1/1/83	Water
DRAWING NO. 1564		SHEET 13 OF 27	

AS-BUILT INFORMATION	
CONTRACTOR	KNC, INC.
WORK STARTED BY	
DATE	
ACCEPTANCE BY	
DATE	
FIELD VERIFICATION BY	
DATE	
CORRECTED BY	M. POIL
DATE	12/28/82
MICRO-FILM INFORMATION	
RECORDED BY	
DATE	

SURVEY INFORMATION	
THE STATION IS A STANDARD ACS BRASS	
TABLET, STAMPED "8-C17, 1975", CEMENTED IN	
A DRILL HOLE IN TOP OF THE WEST CONCRETE	
CURB 0.3 MILE NORTH OF LOS ANGELES BLVD.	
ON WASHINGTON ST.	
ELEV. = 5111.029	
REFERENCES	
MAP NO. C-17	
EST. NO.	
W.O. NO.	
NO.	
BY	
DATE	
REVISIONS	
NO.	
DATE	
REMARKS	
DESIGN	
DESIGNED BY	
DATE	9/82
DRAWN BY	
DATE	9/82
CHECKED BY	
DATE	9/82


PLAN	DATE	BY	DATE	BY
SURVEYED				
PLOTTED				
ALIGNED				
CHECKED				
NO.				

PROFILE	DATE	BY	DATE	BY
SURVEYED				
PLOTTED				
ALIGNED				
CHECKED				
NO.				

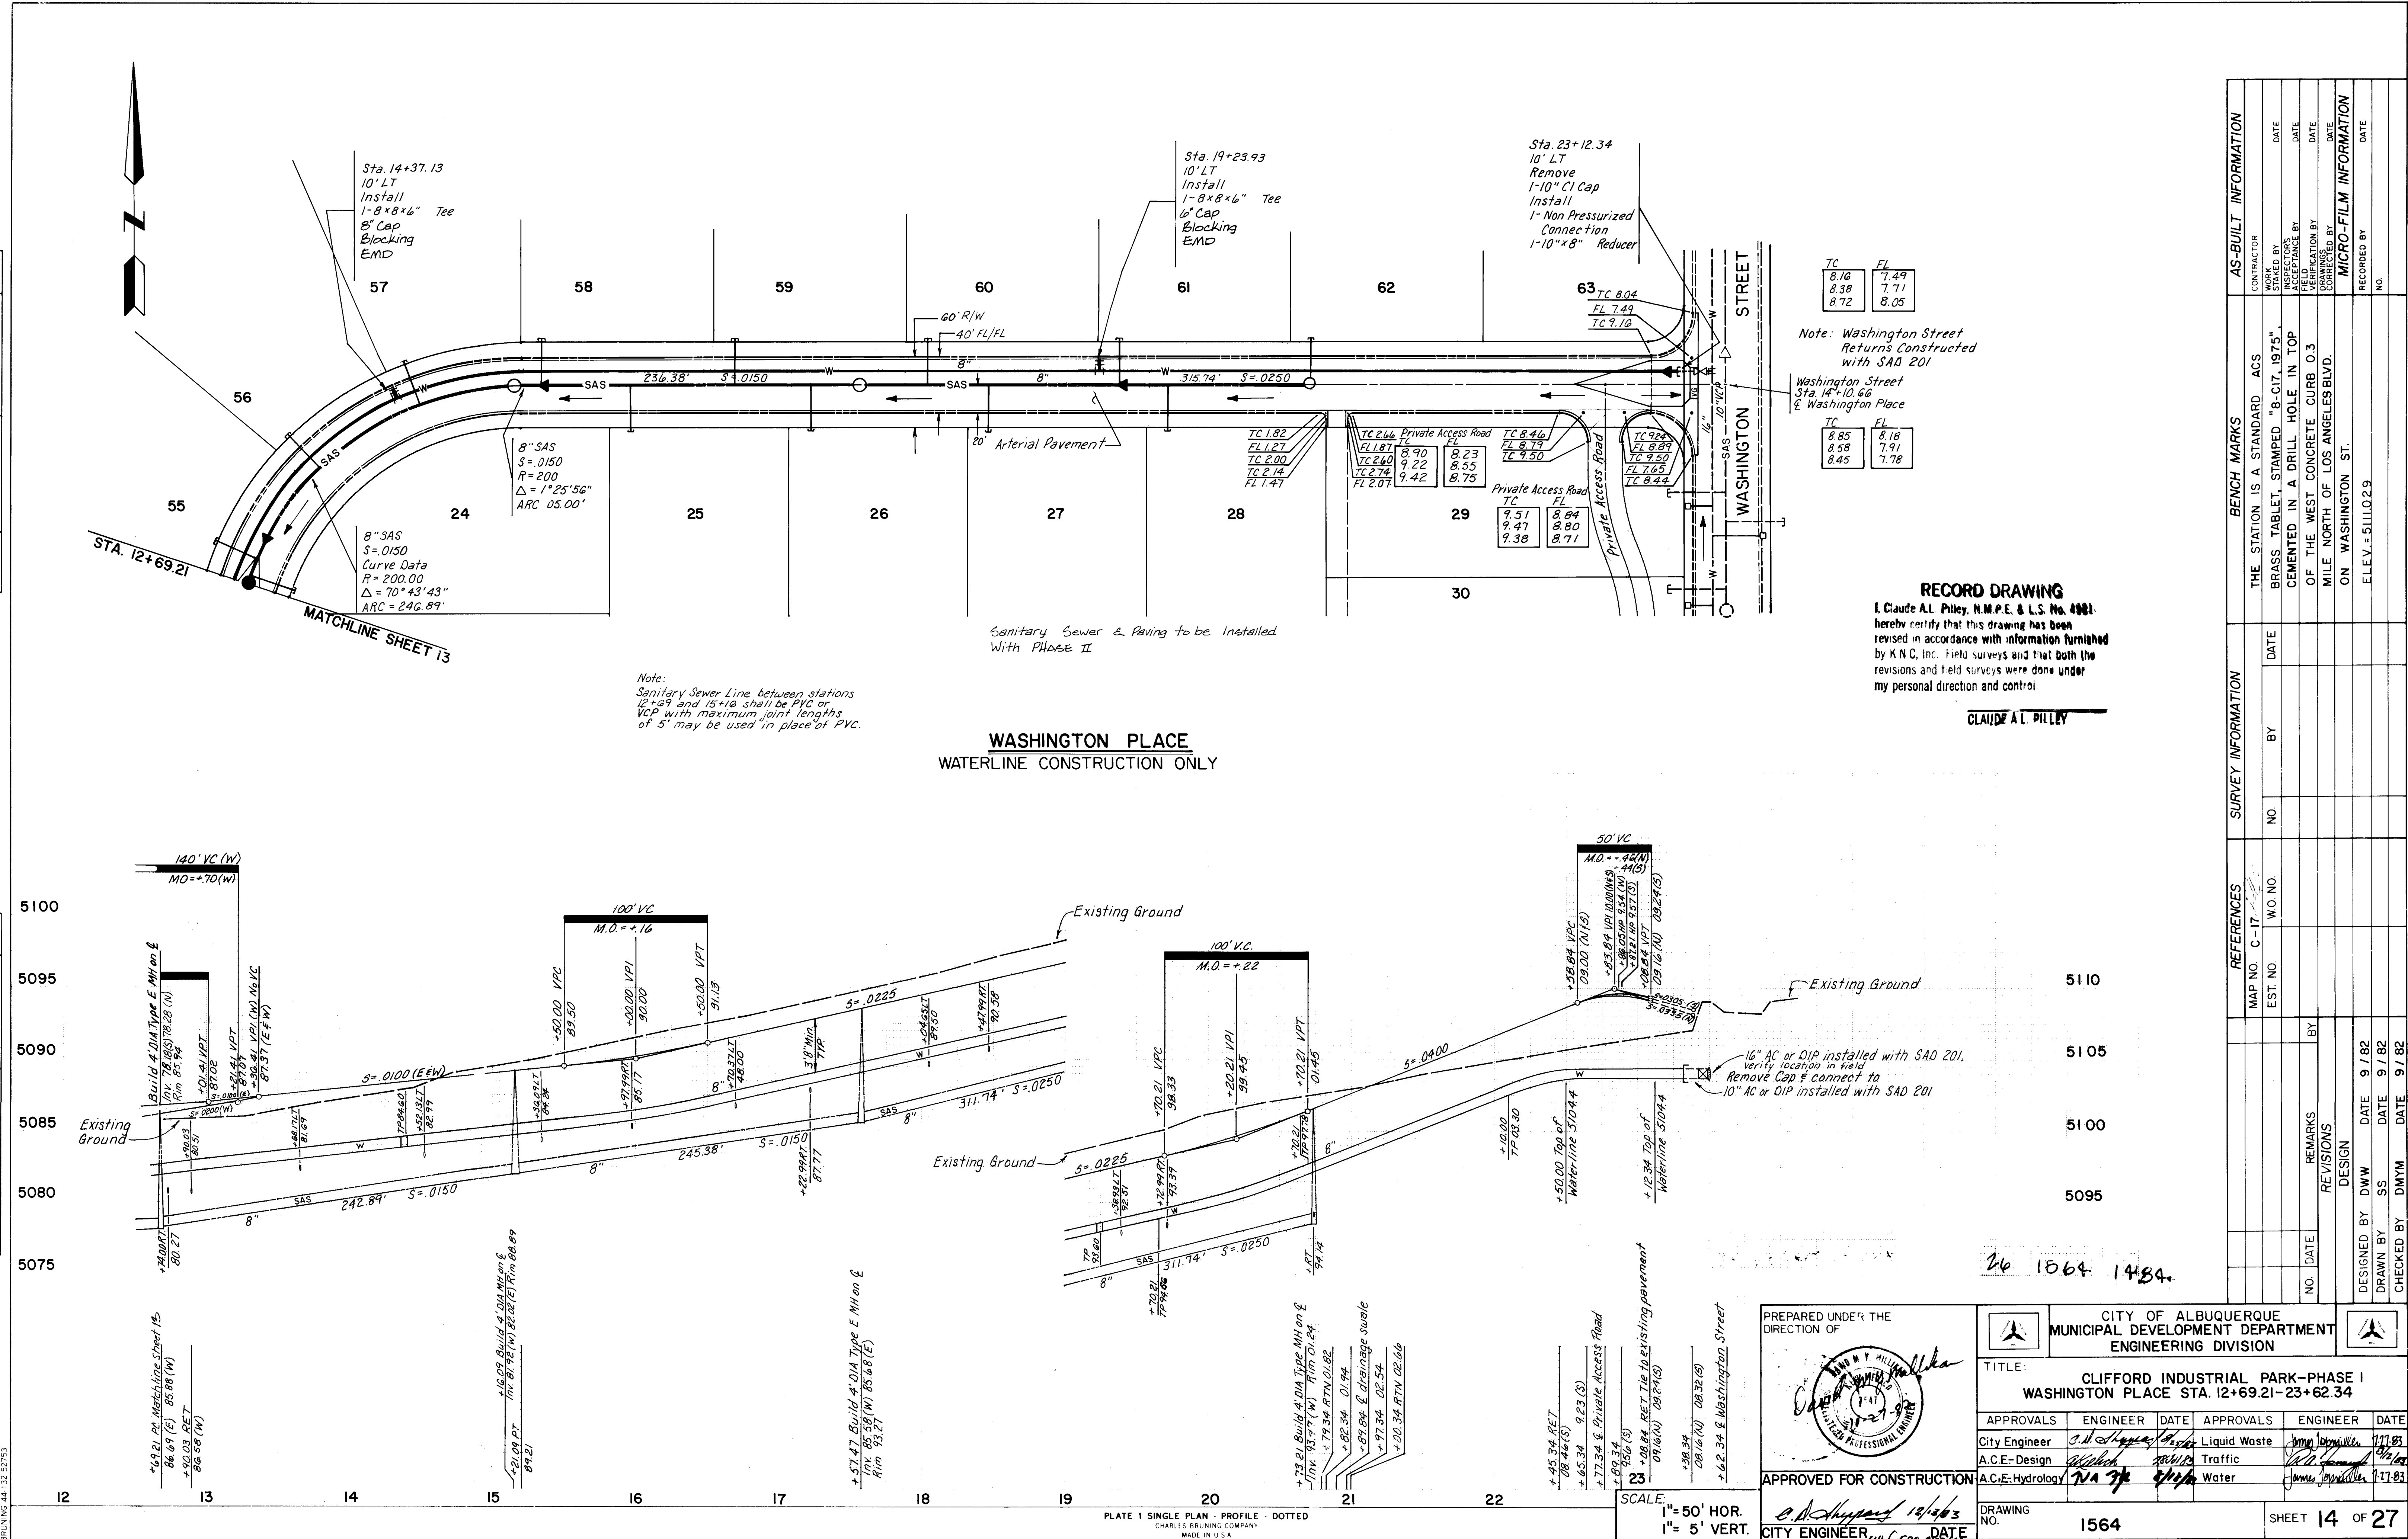


PLAN	DATE	BY
SURVEYED		
PLOTTED		
NOTED		
NO. OF MAP SHEETS		

PROFILE	DATE	BY
SURVEYED		
PLOTTED		
NOTED		
NO. OF MAP SHEETS		

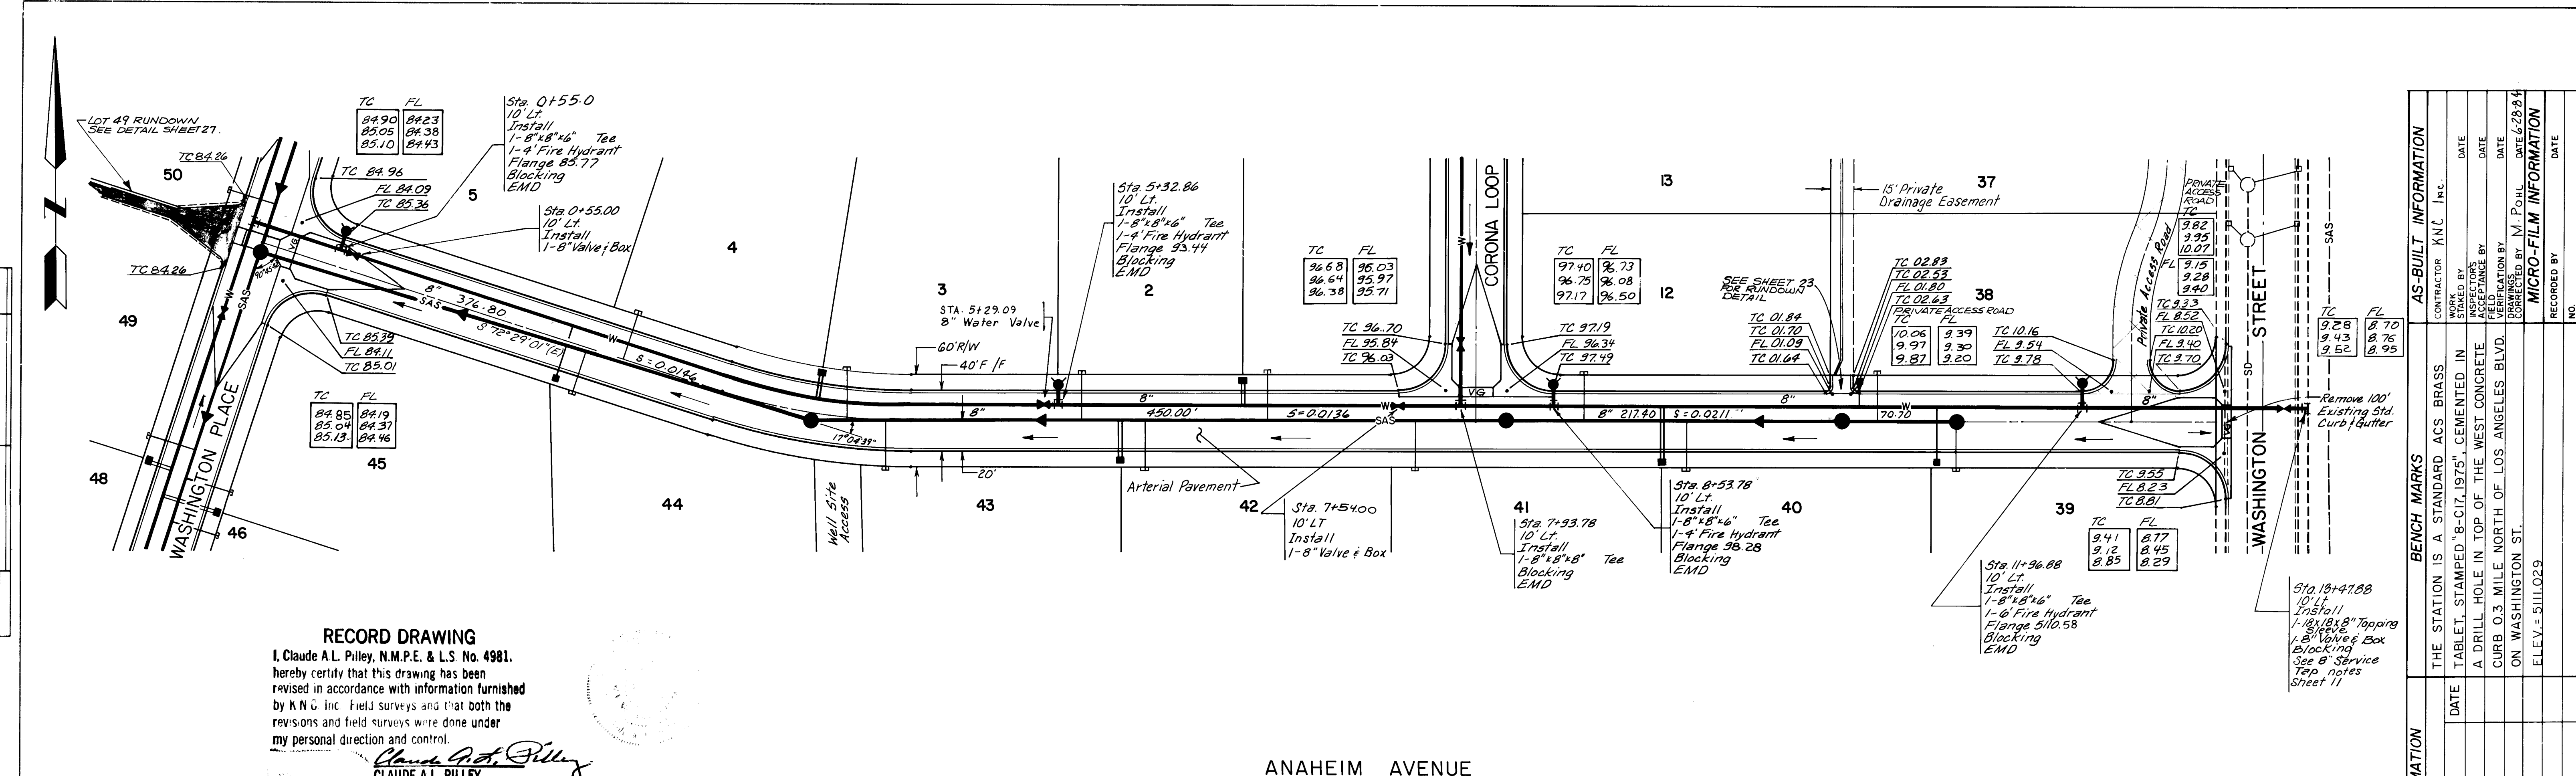

RECORD DRAWING
 I, Claude A.L. Pilley, N.M.P.E. & L.S. No. 4981,
 hereby certify that this drawing has been
 revised in accordance with information furnished
 by K N G Inc. Field surveys and that both the
 revisions and field surveys were done under
 my personal direction and control.
Claude A.L. Pilley
 CLAUDE A.L. PILLEY

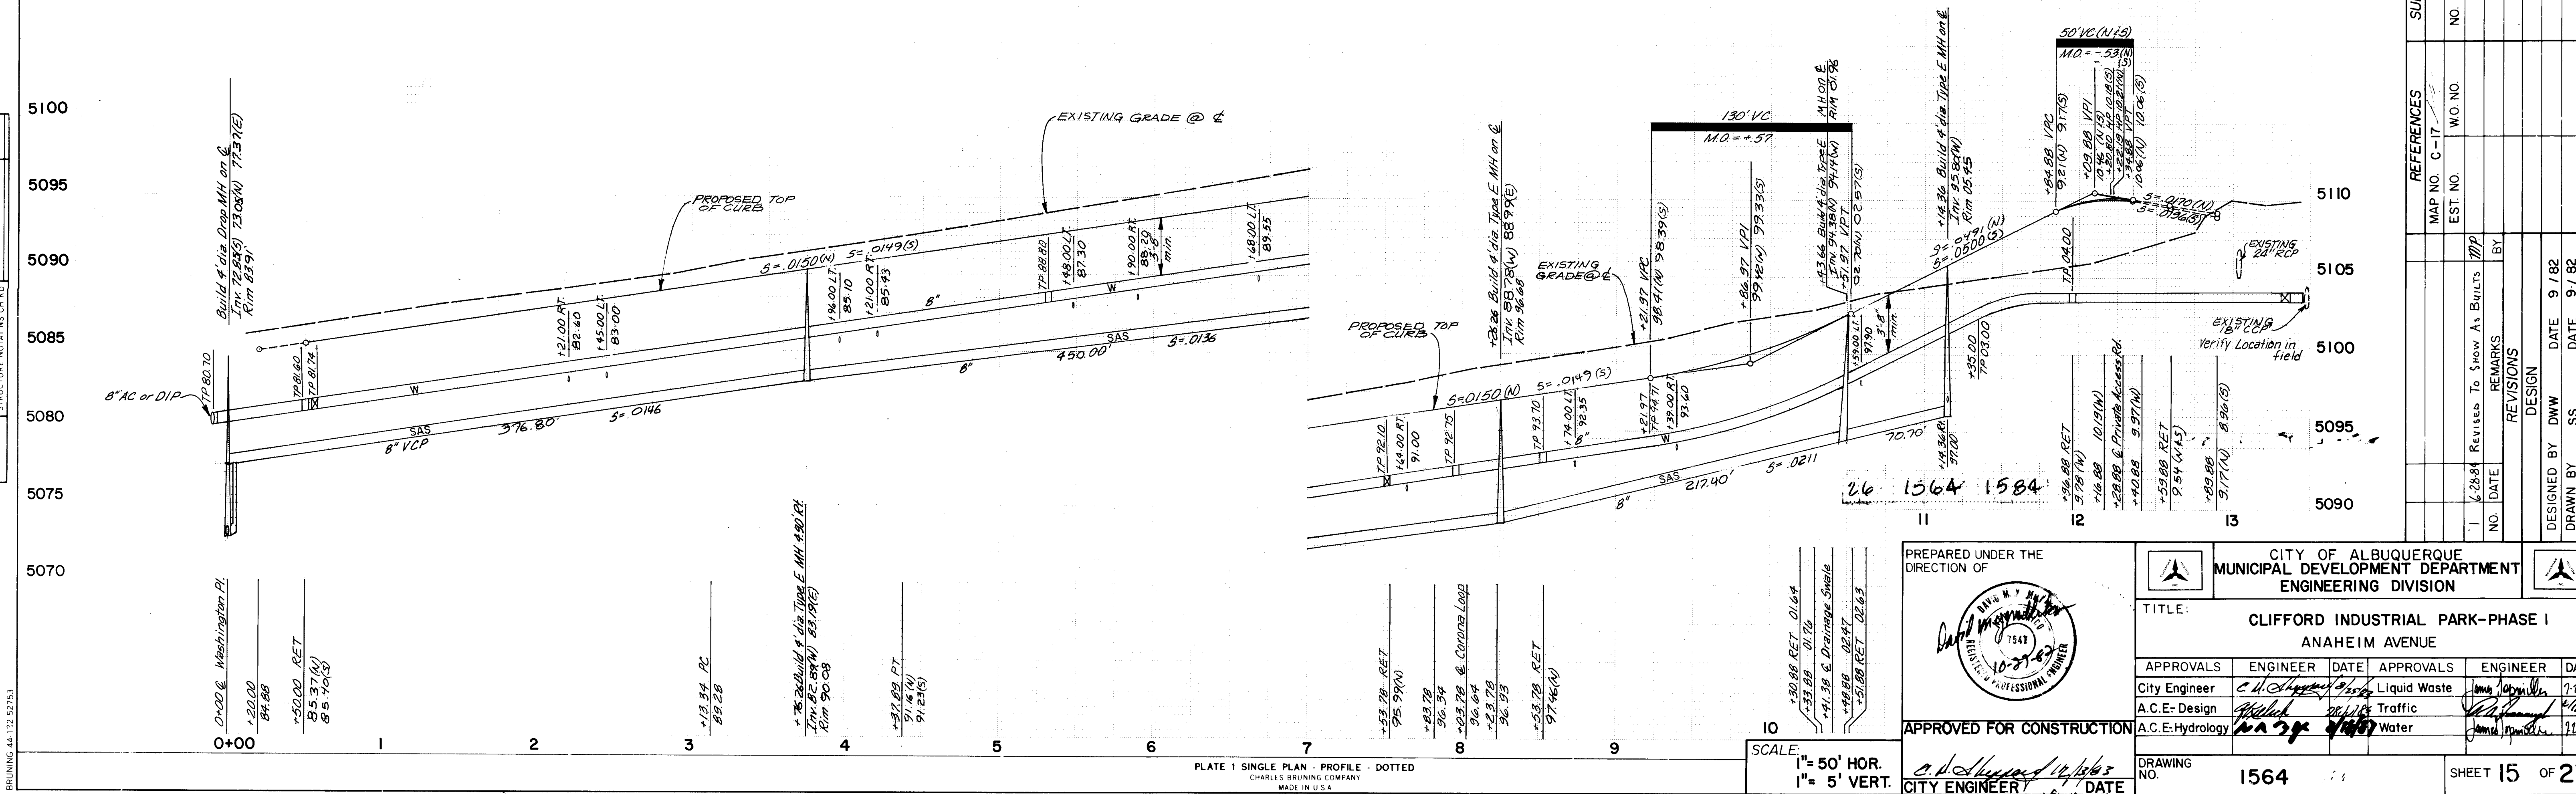


BENCH MARKS		AS-BUILT INFORMATION	
CONTRACTOR	KNC Inc.	WORK	TABLET, STAMPED "8-CIT, 1975", CEMENTED IN
DATE		DATE	A DRILL HOLE IN TOP OF THE WEST CONCRETE
DATE		DATE	CURB 0.3 MILE NORTH OF LOS ANGELES BLVD.
DATE		DATE	ON WASHINGTON ST.
DATE		DATE	ELEV. = 5111.029

SURVEY INFORMATION		REFERENCES	
DATE		MAP NO.	C-17
BY		EST. NO.	
NO.		NO.	
NO.		NO.	
NO.		NO.	

PREPARED UNDER THE DIRECTION OF		CITY OF ALBUQUERQUE MUNICIPAL DEVELOPMENT DEPARTMENT ENGINEERING DIVISION	
TITLE: CLIFFORD INDUSTRIAL PARK-PHASE I ANAHEIM AVENUE		DATE: 9/1/82	
APPROVALS	ENGINEER	DATE	APPROVALS
City Engineer	A.C.E. Design	9/1/82	City Engineer
A.C.E. Hydrology	A.C.E. Traffic	9/1/82	A.C.E. Hydrology
DRAWING NO. 1564		SHEET 15 OF 2	


PLAN	DATE	BY	DATE
SURVEYED			
PLOTTED			
CHECKED			
NO.			

PROFILE	DATE	BY	DATE
SURVEYED			
PLOTTED			
CHECKED			
NO.			

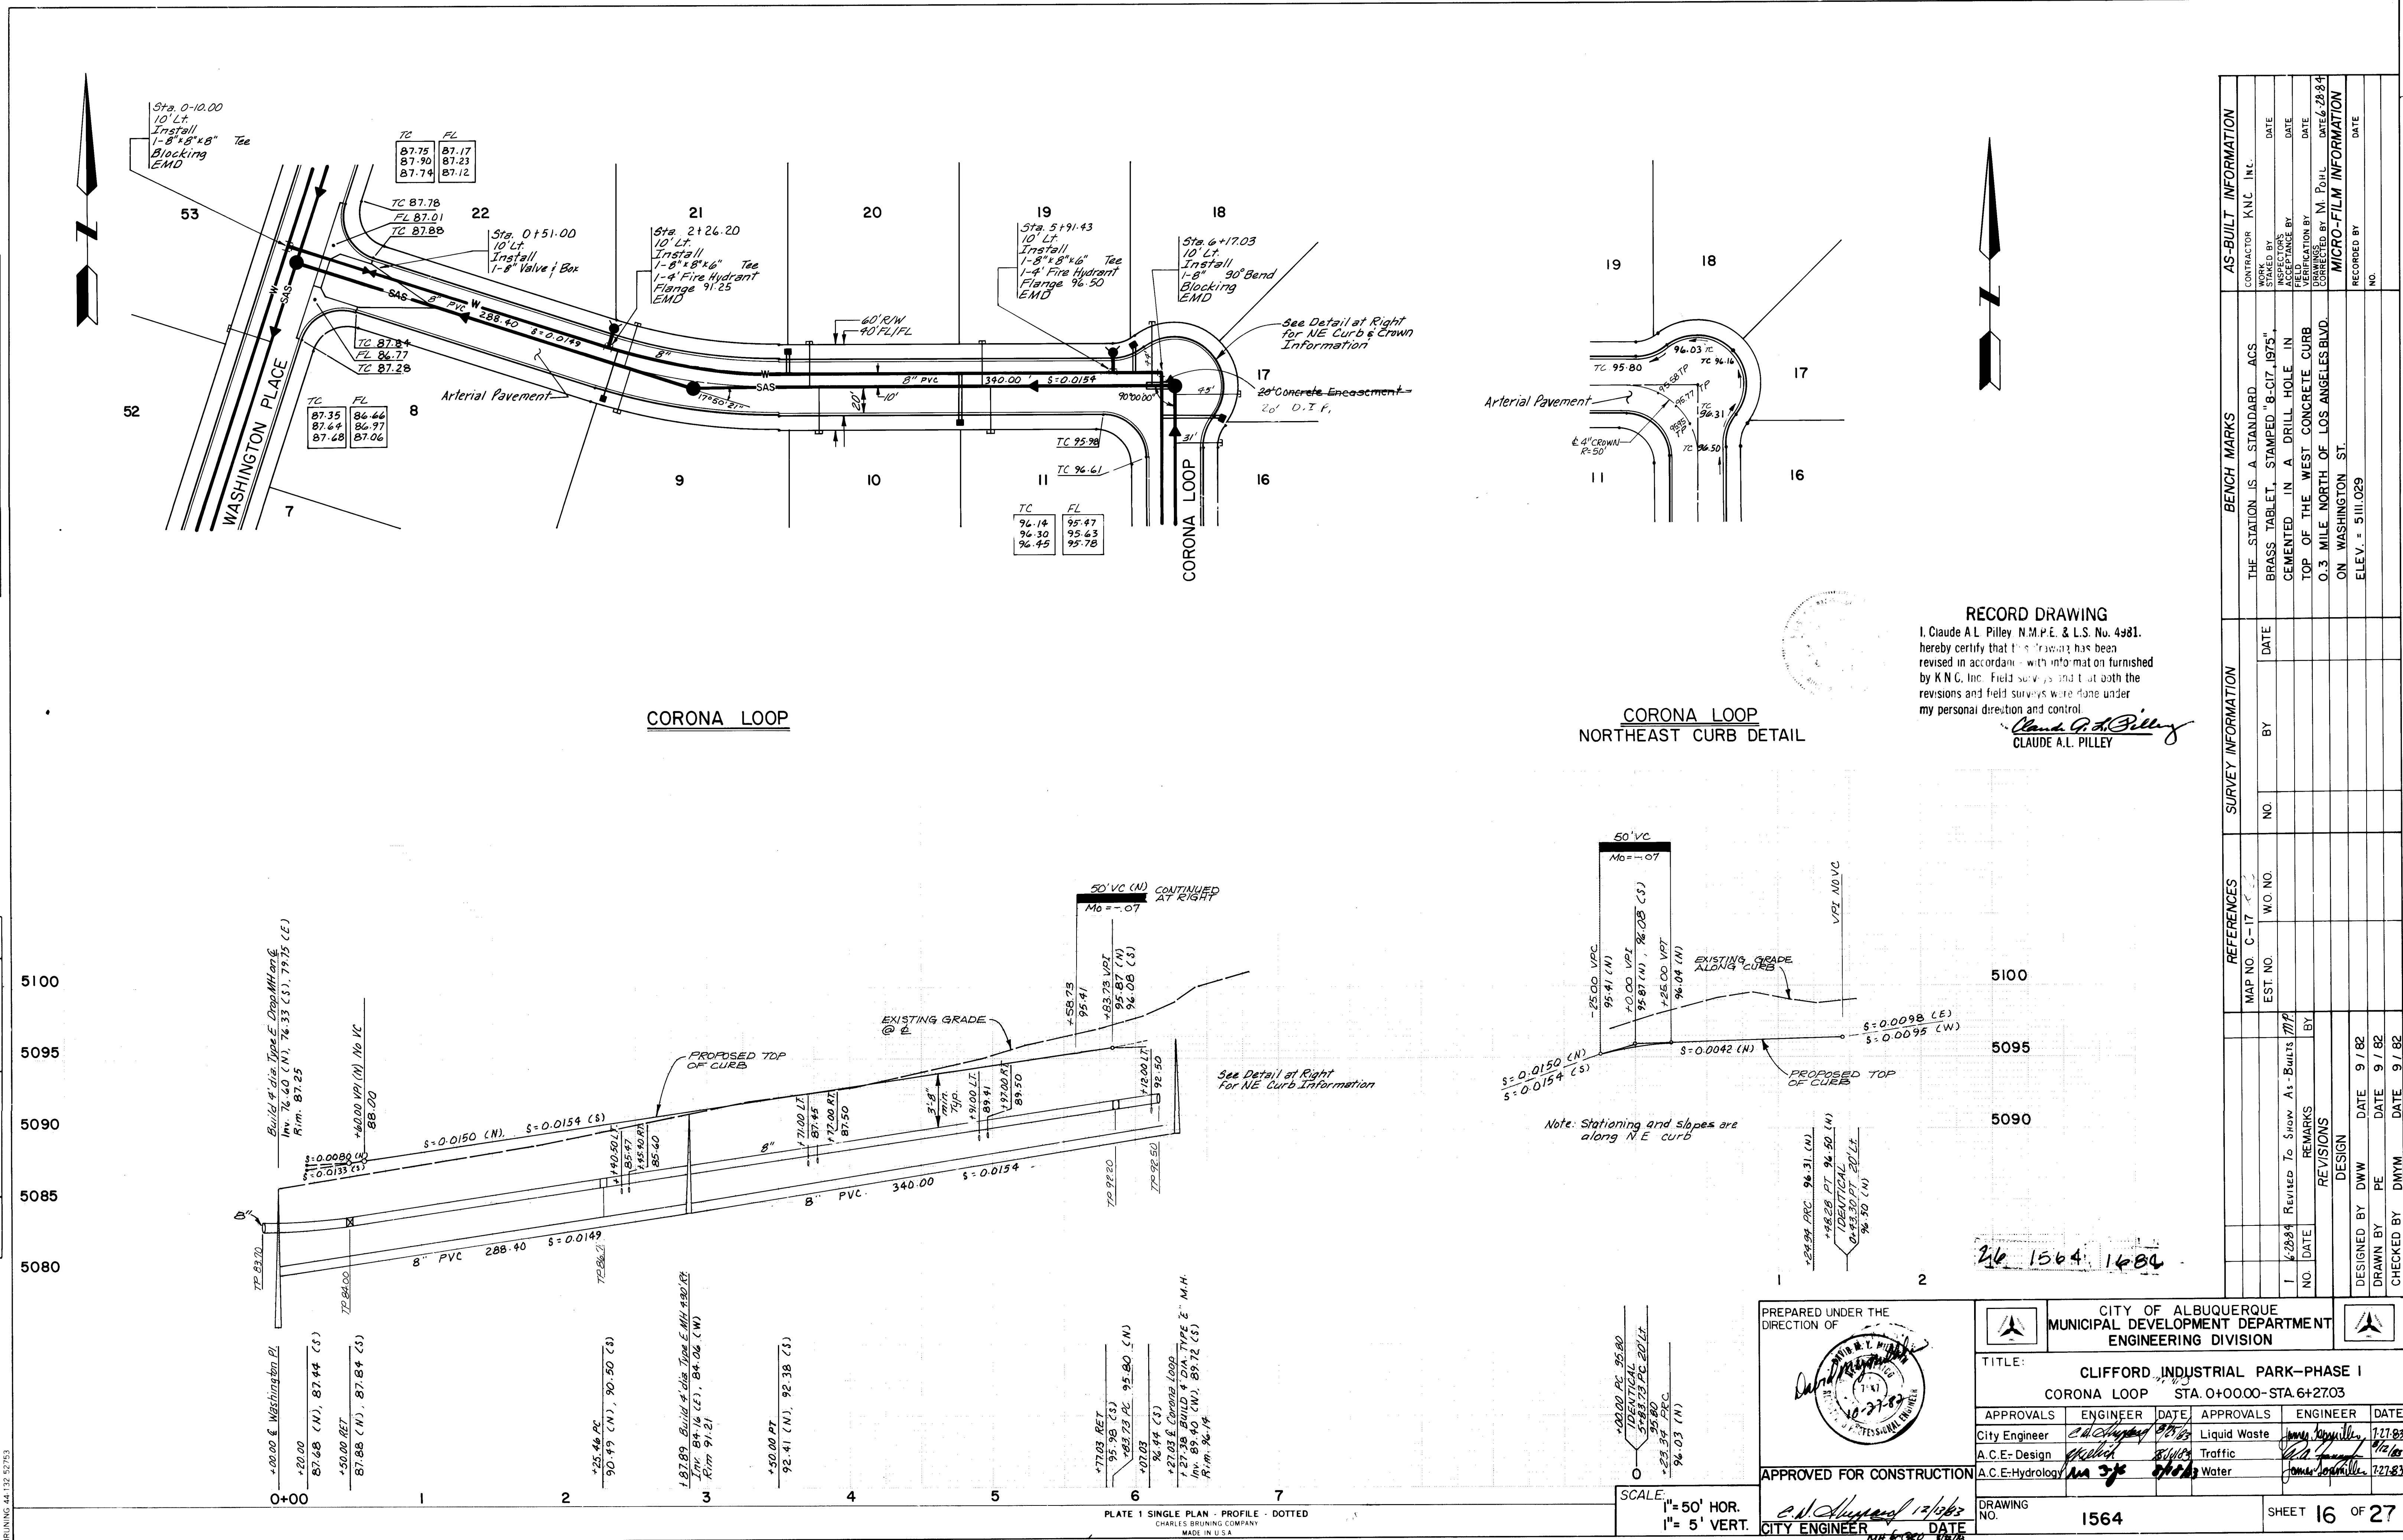


PLAN	DATE	BY
SURVEYED		
PLOTTED		
CHECKED		
NOTED		
NO		

PROFILE	DATE	BY
SURVEYED		
PLOTTED		
CHECKED		
NOTED		
NO		

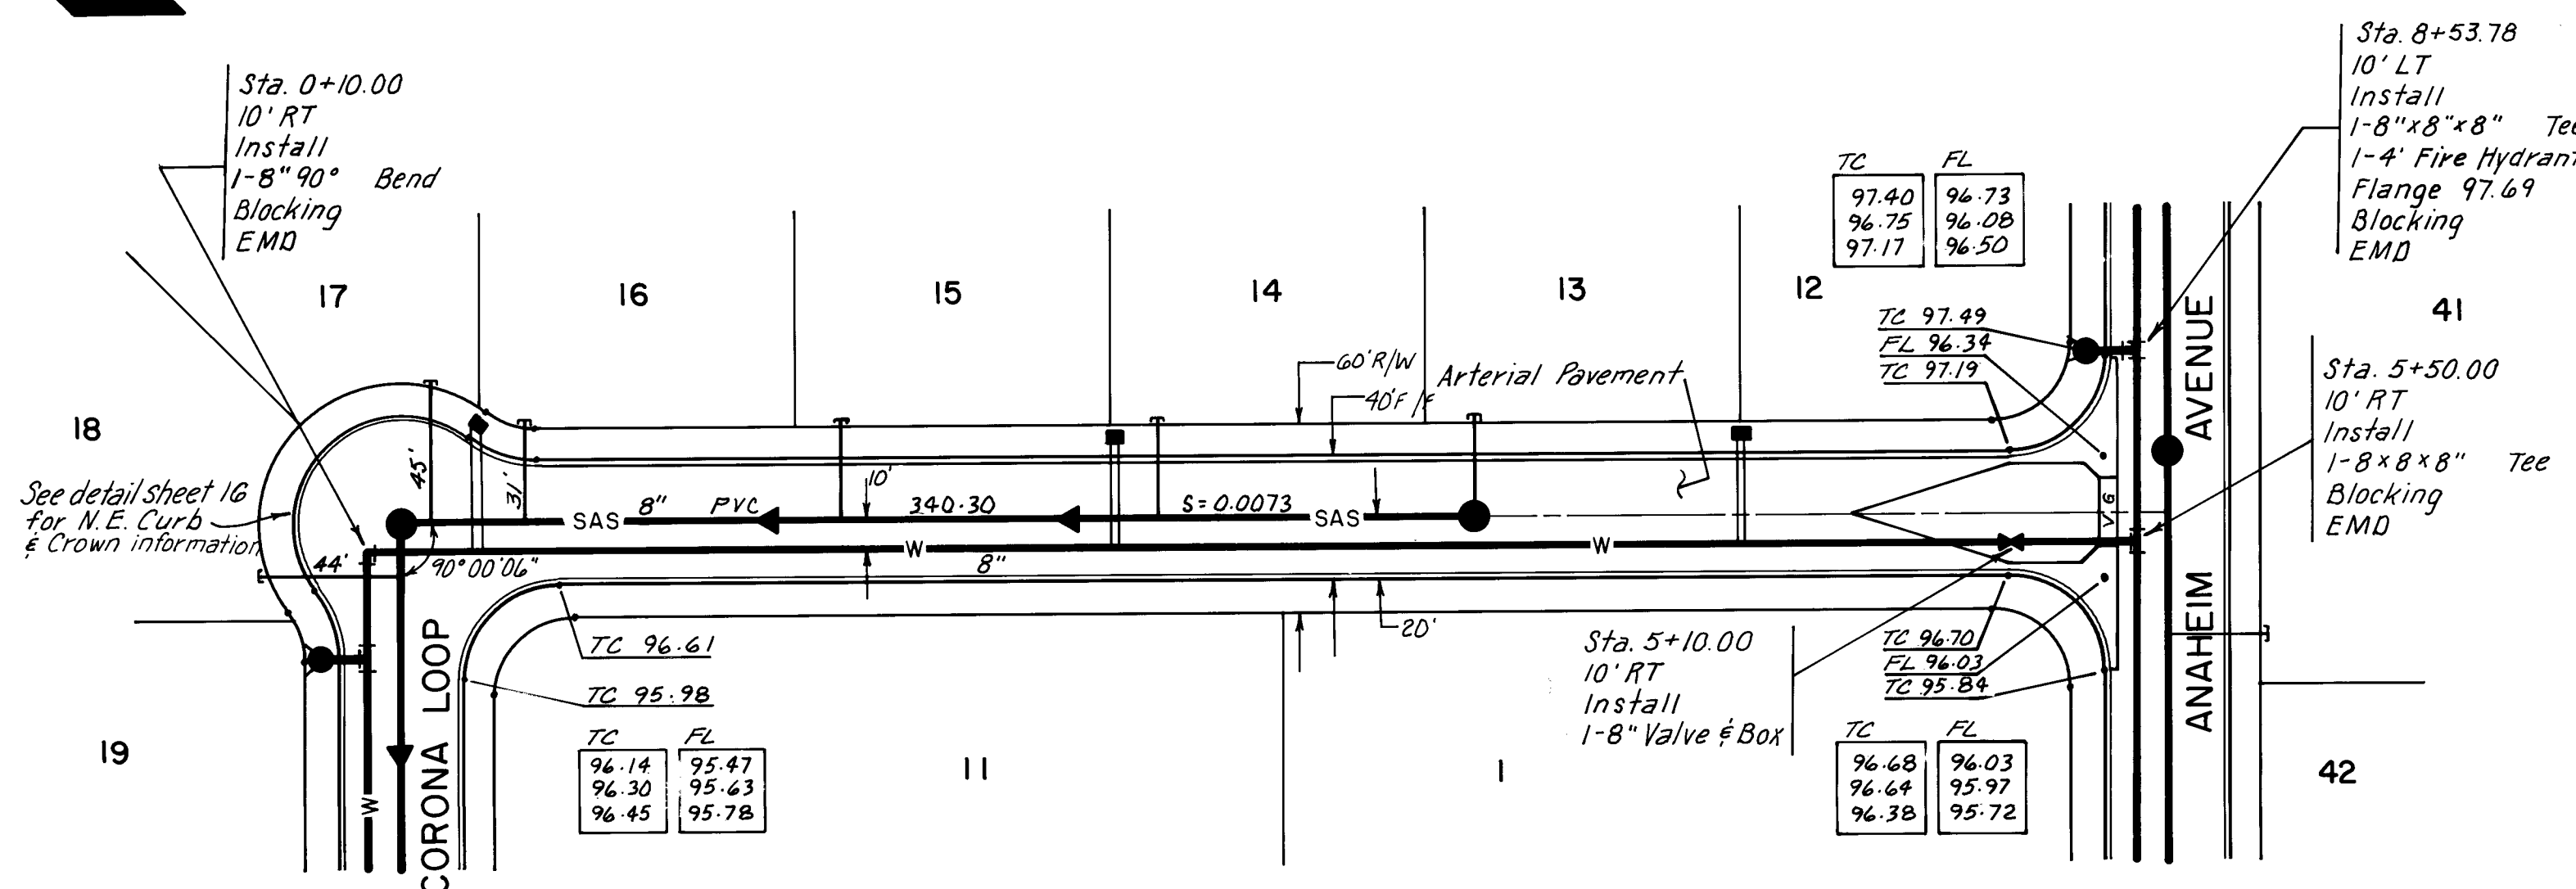


CORONA LOOP

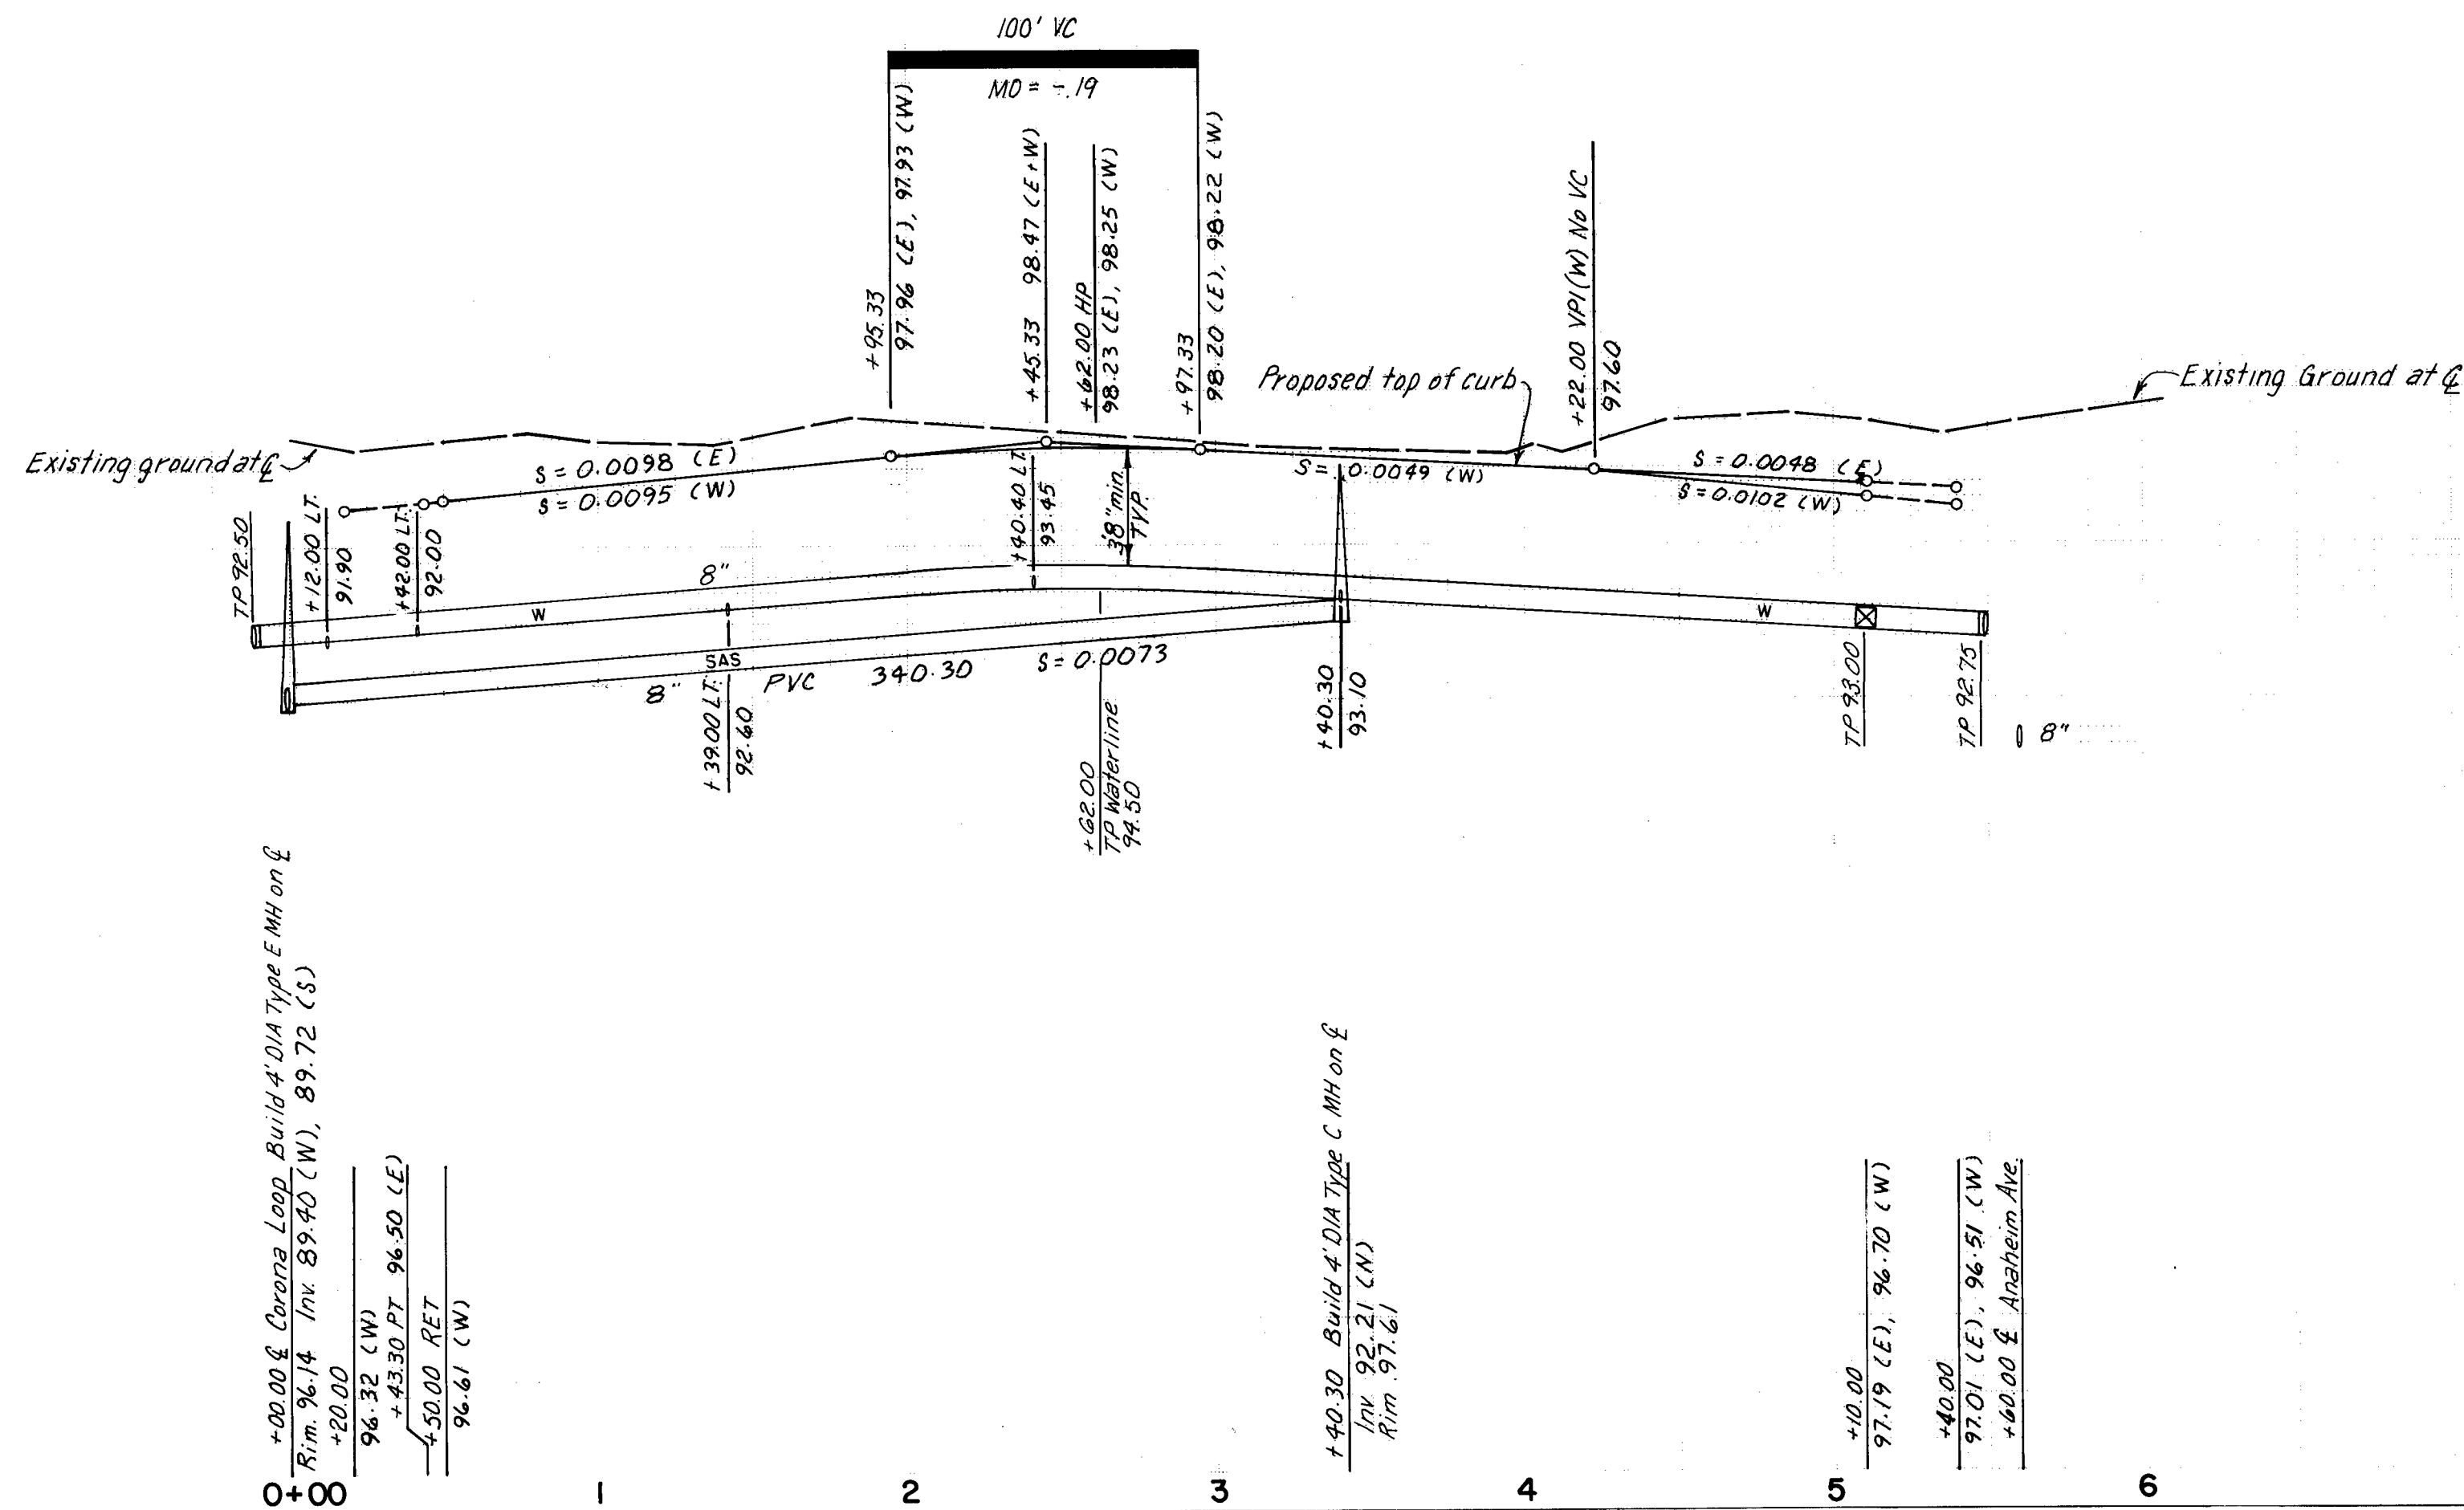

RECORD DRAWING
I, Claude A.L. Pilley, N.M.P.E. & L.S. No. 4981.
hereby certify that this drawing has been
revised in accordance with information furnished
by K & C, Inc. field surveys and that both the
revisions and field surveys were done under
my personal direction and control.


Claude A.L. Pilley
CLAUDE A.L. PILLEY

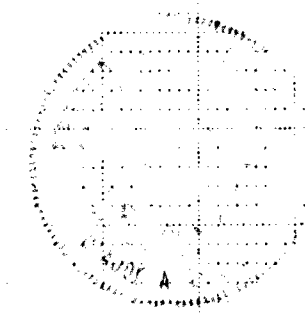

PREPARED UNDER THE DIRECTION OF		CITY OF ALBUQUERQUE MUNICIPAL DEVELOPMENT DEPARTMENT ENGINEERING DIVISION	
TITLE: CLIFFORD INDUSTRIAL PARK-PHASE I CORONA LOOP STA. 6+27.03-5+60.00			
APPROVALS	ENGINEER	DATE	APPROVALS
City Engineer	<i>Claude A.L. Pilley</i>	12/13/83	Liquid Waste
A.C.E.-Design	<i>John J. Pilley</i>	12/13/83	Traffic
A.C.E.-Hydrology	<i>John J. Pilley</i>	12/13/83	Water
APPROVED FOR CONSTRUCTION		DATE	
<i>Claude A.L. Pilley</i>		12/13/83	
CITY ENGINEER		DATE	
DRAWING NO. 1564		SHEET 17 OF 27	

PLAN	SURVEYED	BY	DATE
NO.	PLOTTED		
	ALIGNED		
	CHECKED		
	NOTED		

PROFILE	SURVEYED	BY	DATE
NO.	PLOTTED		
	GRADES		
	CHECKED		
	STRUCTURE		
	NOTATIONS		

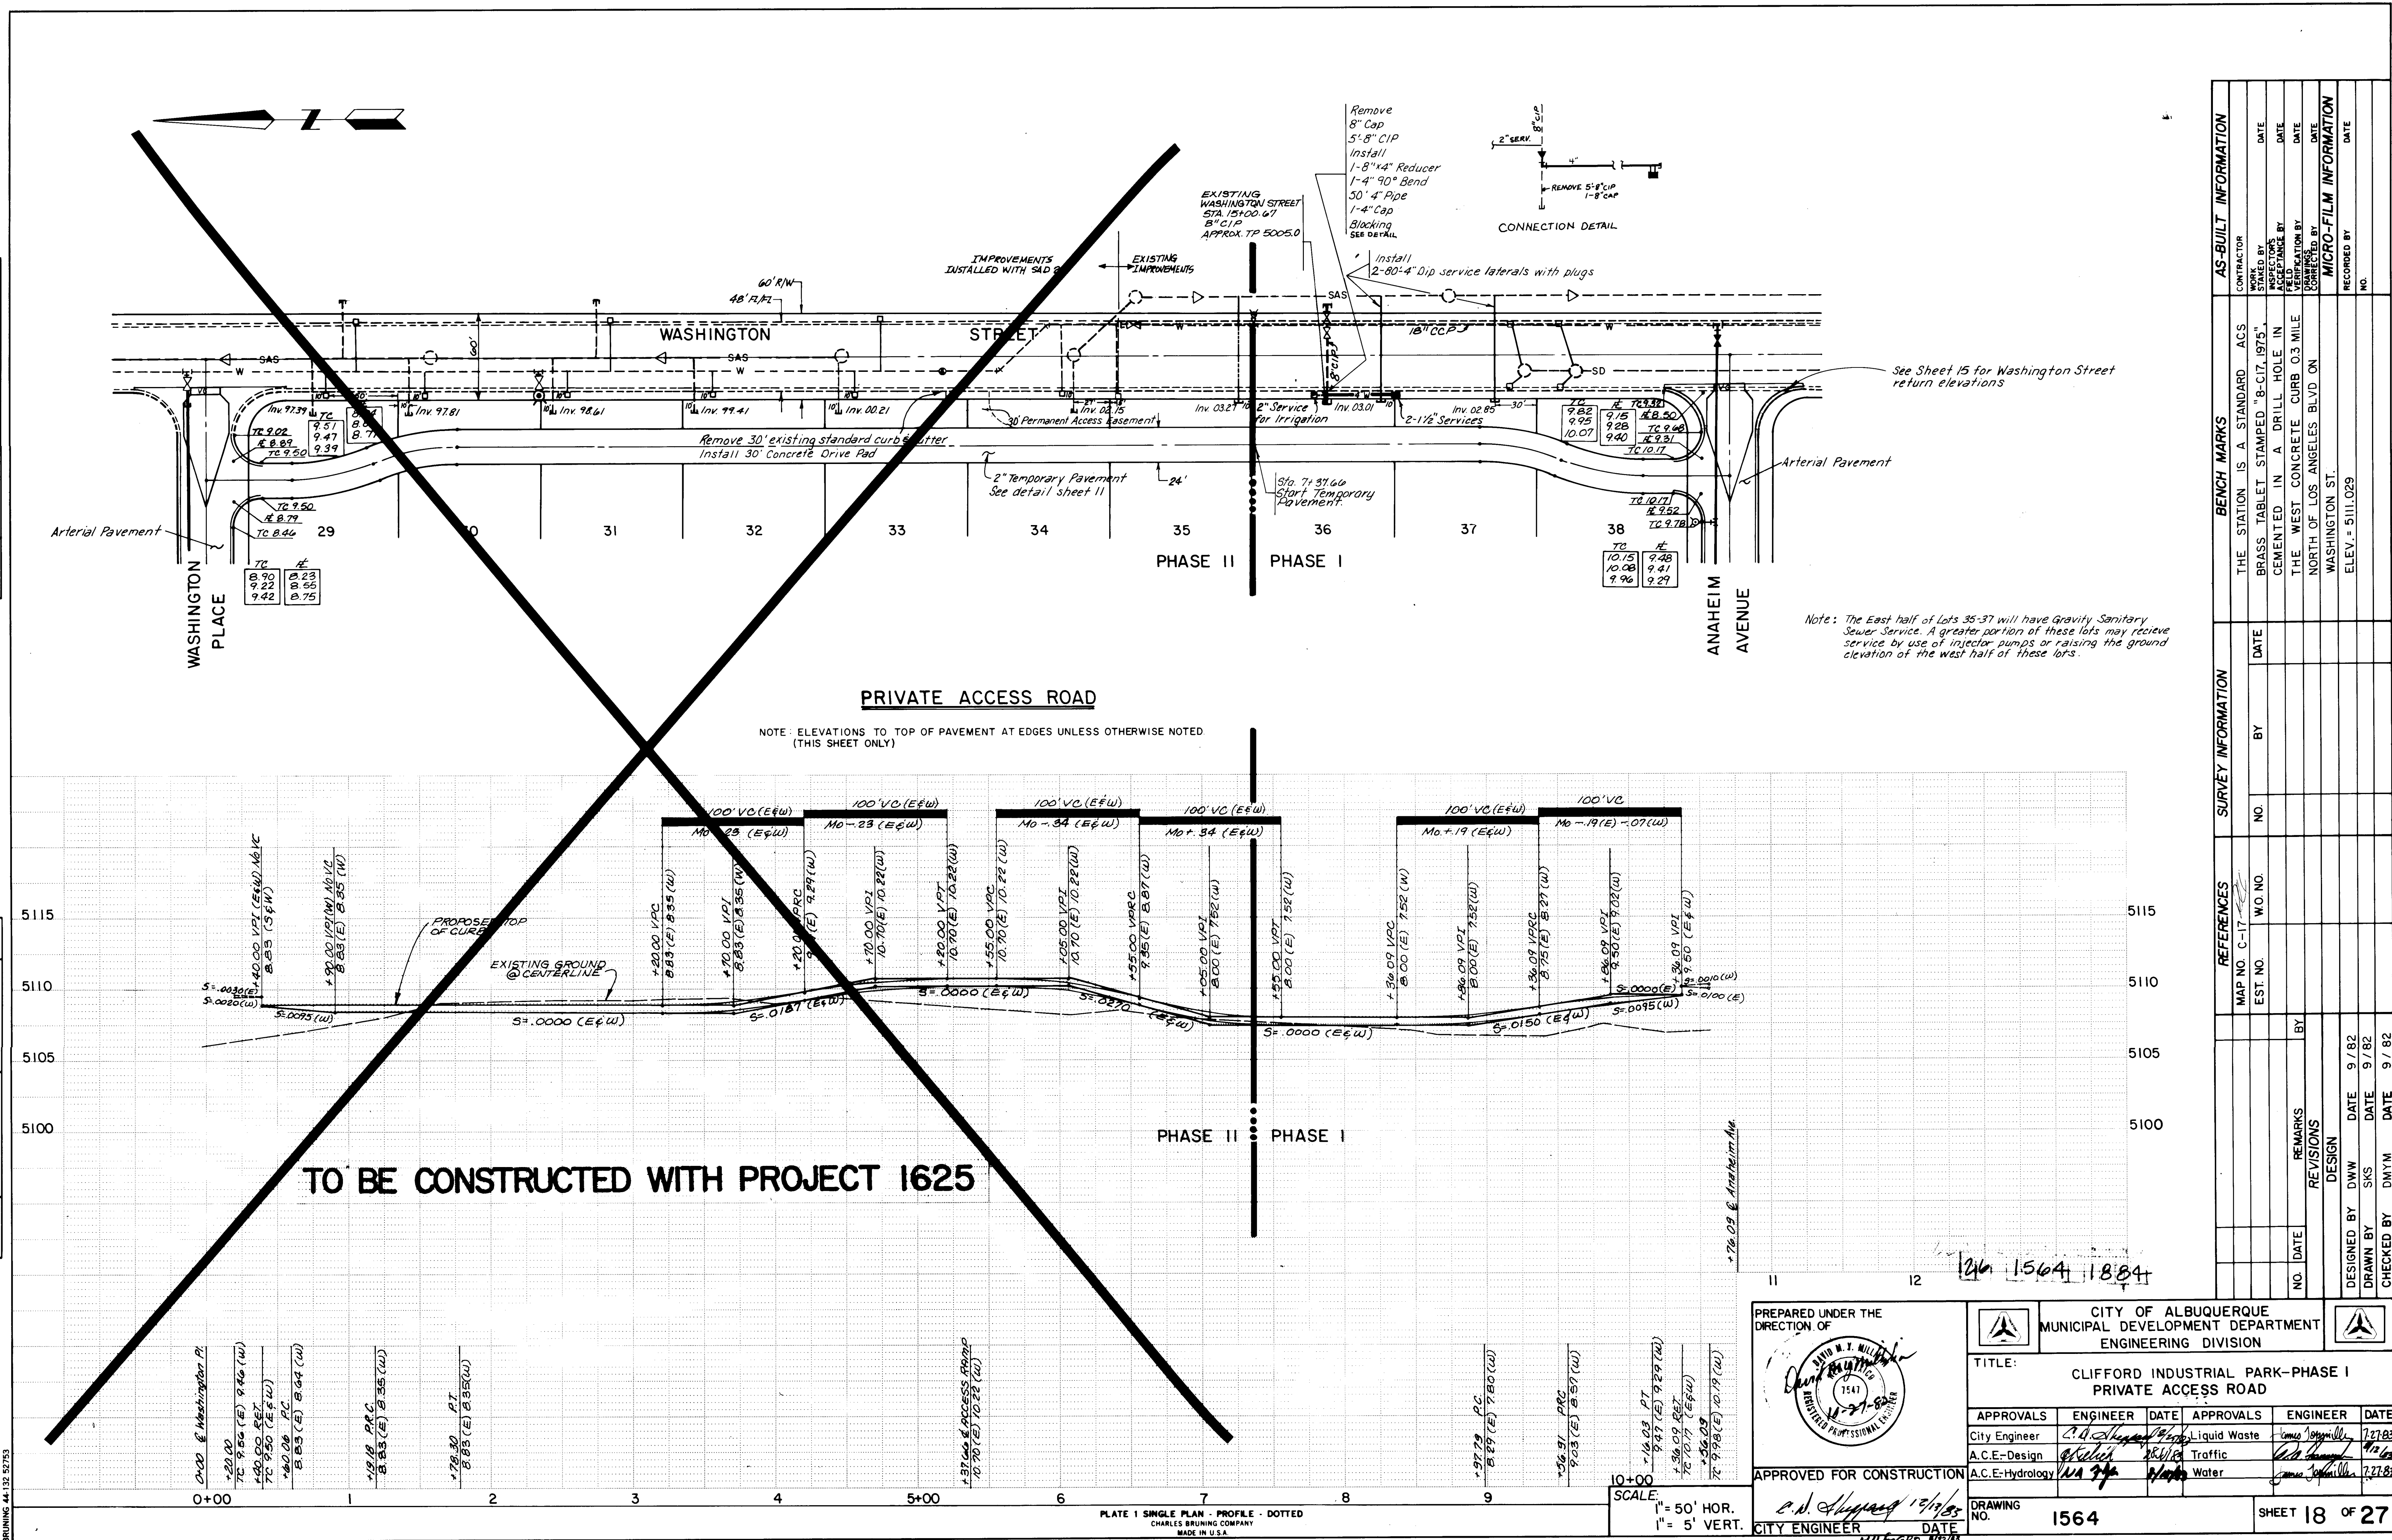

AS-BUILT INFORMATION			
CONTRACTOR	THE STATION IS A STANDARD	ACS	
WORK BY	BRASS TABLET STAMPED "8-CIT. 1975"		
INSPECTORS	CEMENTED IN A DRILL HOLE IN		
DATE	THE WEST CONCRETE CURB 0.3 MILE		
DATE	NORTH OF LOS ANGELES BLVD ON		
DATE	WASHINGTON ST.		
DATE	ELEV. = 5111.029		
MICRO-FILM INFORMATION			
NO.			
DATE			

SURVEY INFORMATION			
MAP NO. C-17	DATE		
EST. NO.	BY		
NO.	NO.		
REFERENCES			
NO.	DATE		
REMARKS			
DESIGN			
DESIGNED BY	DWM	DATE	9/82
DRAWN BY	SKS	DATE	9/82
CHECKED BY	DYM	DATE	9/82

PREPARED UNDER THE DIRECTION OF

CITY OF ALBUQUERQUE
MUNICIPAL DEVELOPMENT DEPARTMENT
ENGINEERING DIVISION

TITLE: CLIFFORD INDUSTRIAL PARK-PHASE I
PRIVATE ACCESS ROAD

APPROVALS	ENGINEER	DATE	APPROVALS	ENGINEER	DATE
City Engineer	<i>[Signature]</i>	12/1/82	Liquid Waste	<i>[Signature]</i>	7/27/83
A.C.E.-Design	<i>[Signature]</i>	12/1/82	Traffic	<i>[Signature]</i>	7/27/83
A.C.E.-Hydrology	<i>[Signature]</i>	12/1/82	Water	<i>[Signature]</i>	7/27/83



APPROVED FOR CONSTRUCTION

CITY ENGINEER *[Signature]* DATE 12/1/82

DRAWING NO. 1564 SHEET 18 OF 27

PLAN	DATE	BY	SURVEYED	BY	DATE
NOTE BOOK			PLOTTED		
			CHECKED		
			BY		


PROFILE	DATE	BY	SURVEYED	BY	DATE
NOTE BOOK			PLOTTED		
			CHECKED		
			BY		

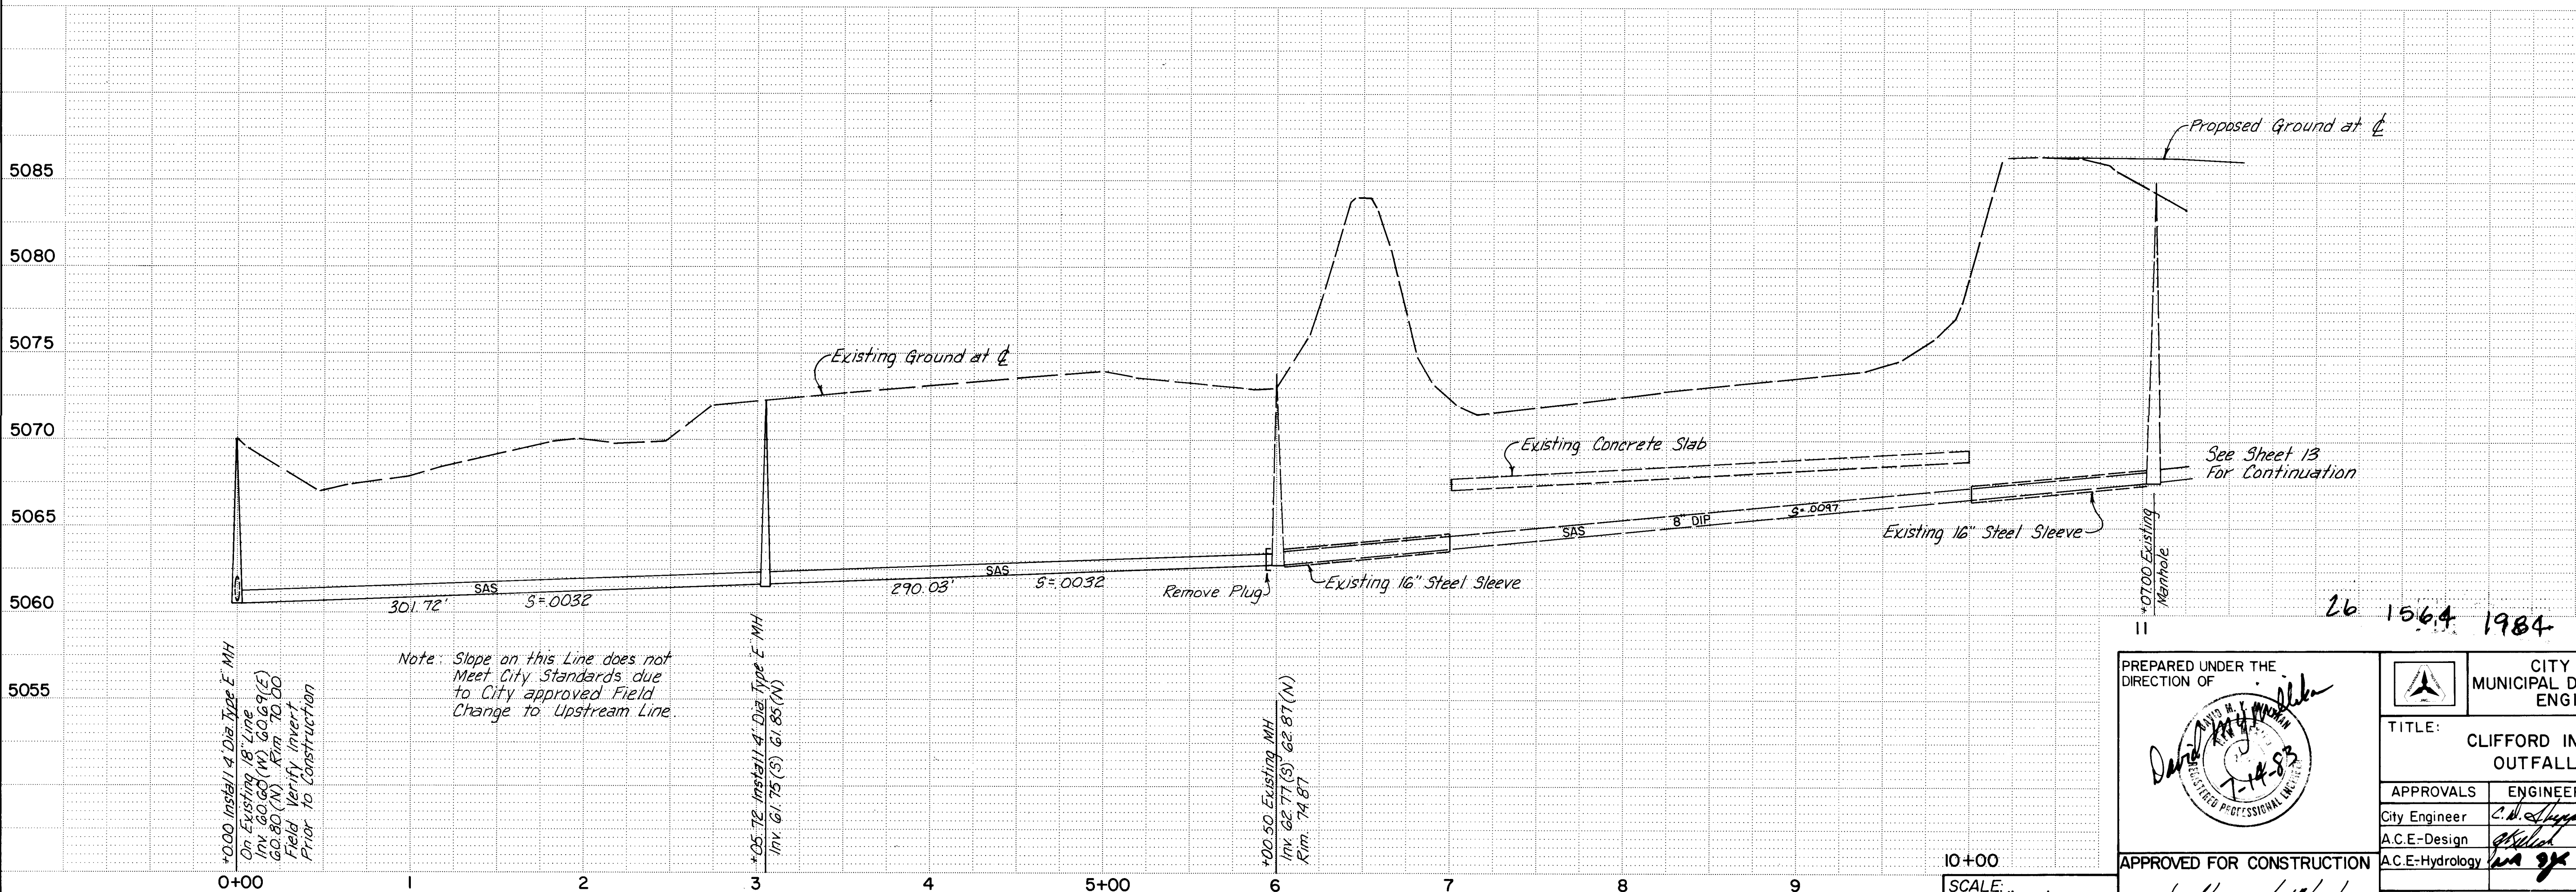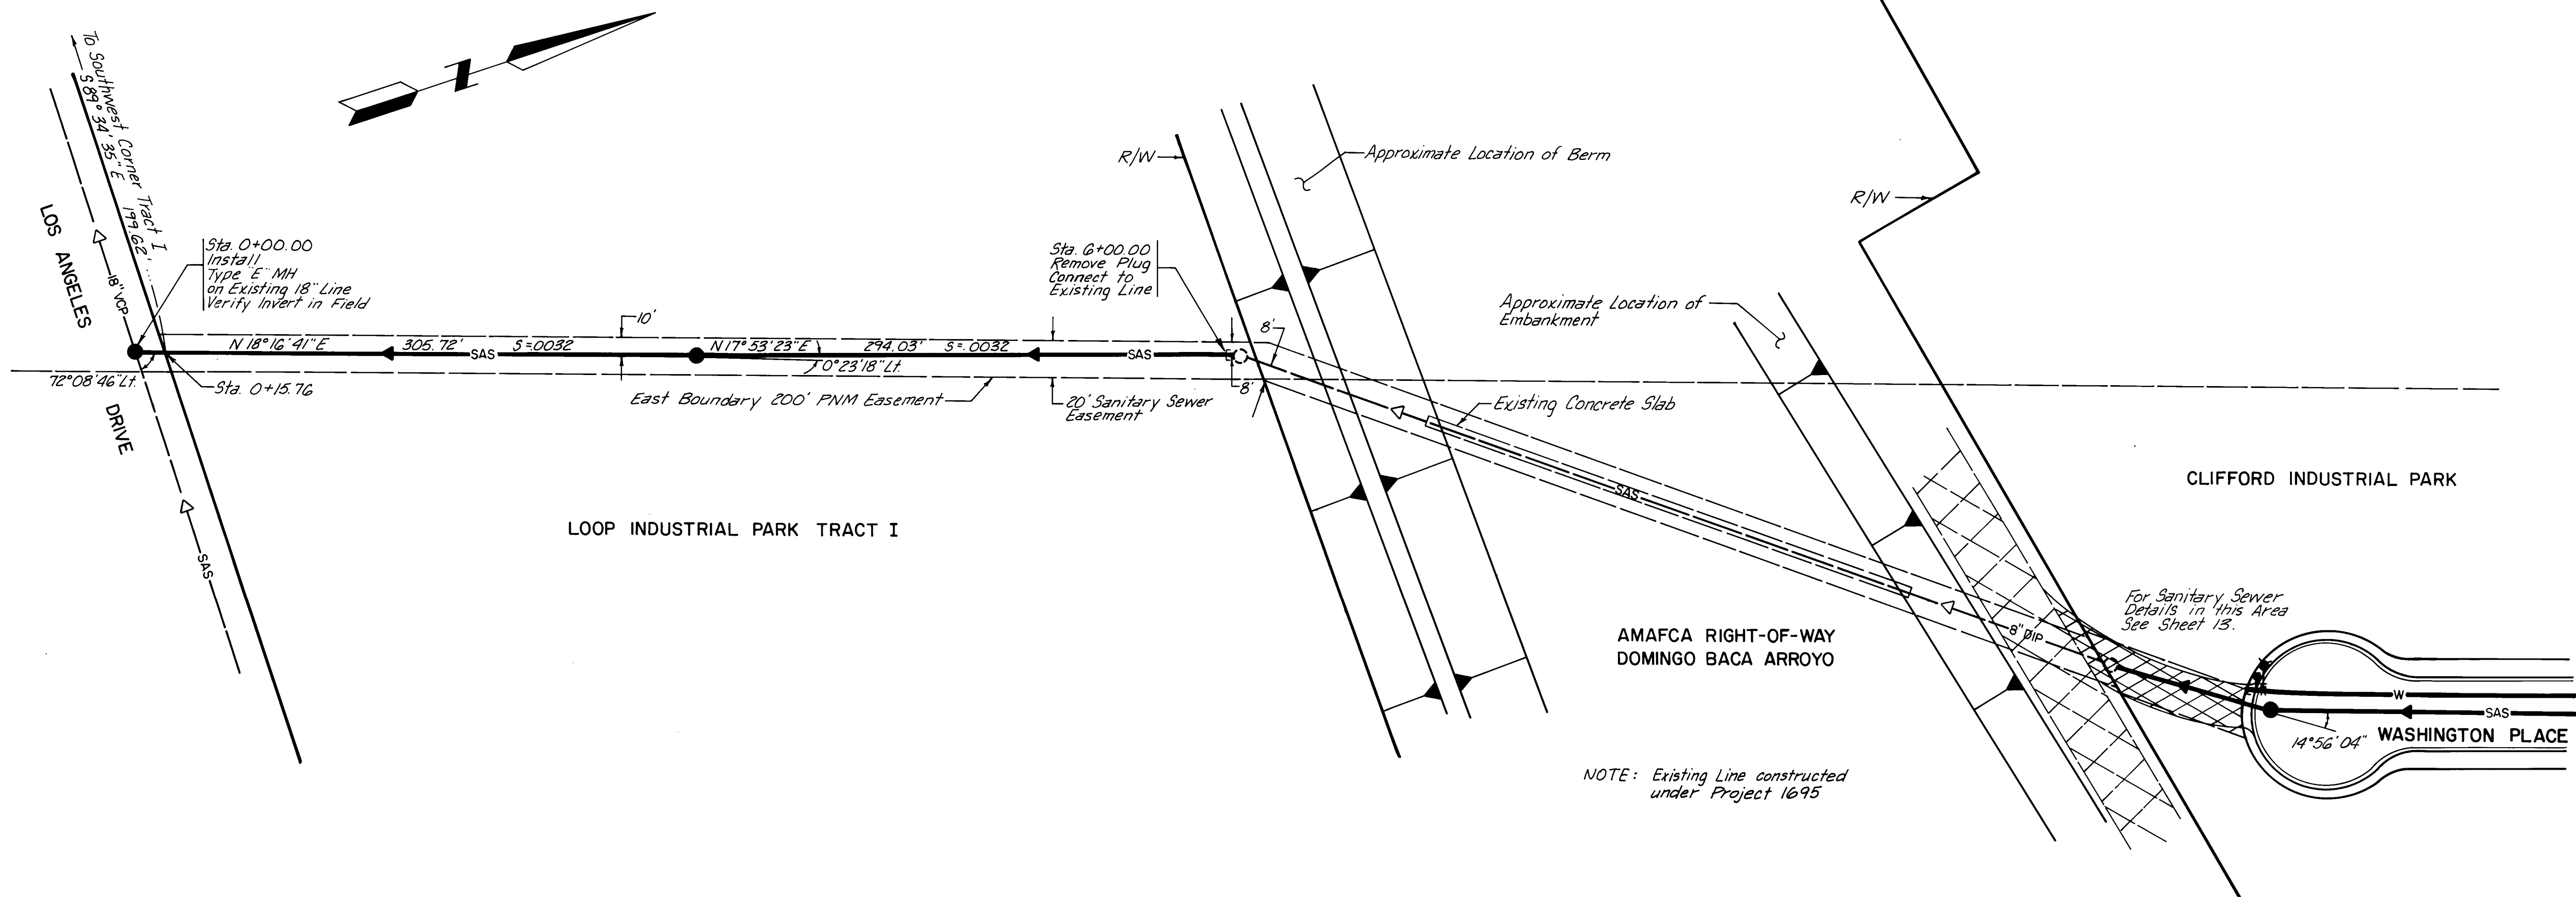

OUTFALL SANITARY SEWER

PLATE 1 SINGLE PLAN - PROFILE - DOTTED
CHARLES BRUNING COMPANY
MADE IN U.S.A.

10+00
SCALE:
1"=50' HOR.
1"=5' VERT.

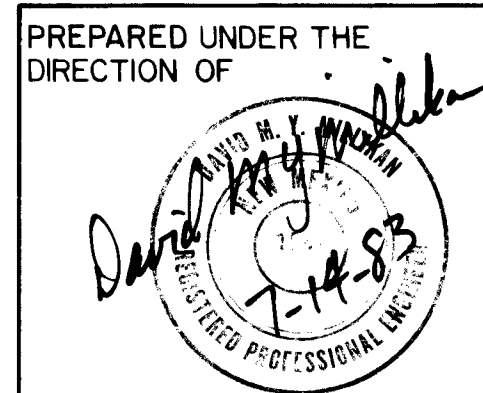

APPROVED FOR CONSTRUCTION
CITY ENGINEER
DATE 12/13/83
1564

CITY OF ALBUQUERQUE MUNICIPAL DEVELOPMENT DEPARTMENT ENGINEERING DIVISION					
TITLE: CLIFFORD INDUSTRIAL PARK-PHASE I OUTFALL SANITARY SEWER					
APPROVALS	ENGINEER	DATE	APPROVALS	ENGINEER	DATE
City Engineer	C. M. Huppert	12/13/83	Liquid Waste	James J. ...	12/13/83
A.C.E.-Design	...	...	Traffic	N.A. ...	...
A.C.E.-Hydrology	...	...	Water	James J. ...	12/13/83
DRAWING NO. 1564 SHEET 19 OF 27					


REFERENCES			SURVEY INFORMATION			BENCH MARKS			AS-BUILT INFORMATION		
MAP NO.	C-17		NO.			THE STATION IS A STANDARD ACS BRASS	CONTRACTOR		WORK		
EST. NO.			BY			TABLET, STAMPED "8-CIT, 1975", CEMENTED IN	STAMPED BY		DATE		
						A DRILL HOLE IN TOP OF THE WEST CONCRETE	DATE				
						CURB 0.3 MILE NORTH OF LOS ANGELES BLVD.	FIELD				
						ON WASHINGTON ST.	ACCEPTANCE BY				
						ELEV. = 5111.029	DATE				
							CORRECTED BY				
							DATE				
							RECORDED BY				
							DATE				

1204



PLAN	SURVEYED	BY	DATE
NOTE BOOK	PLOTTED		
NO. 1	ALIGNMENT CHECKED		
	AT 1/2" = 1' HORIZ.		

PROFILE	SURVEYED	BY	DATE
NOTE BOOK	PLOTTED		
NO. 1	GRADES CHECKED		
	STRUCTURE NOTATIONS CHWD		

TRACT E
LANDS OF SPRINGER CORP.
CITY OF ALBUQUERQUE SANITARY LANDFILL

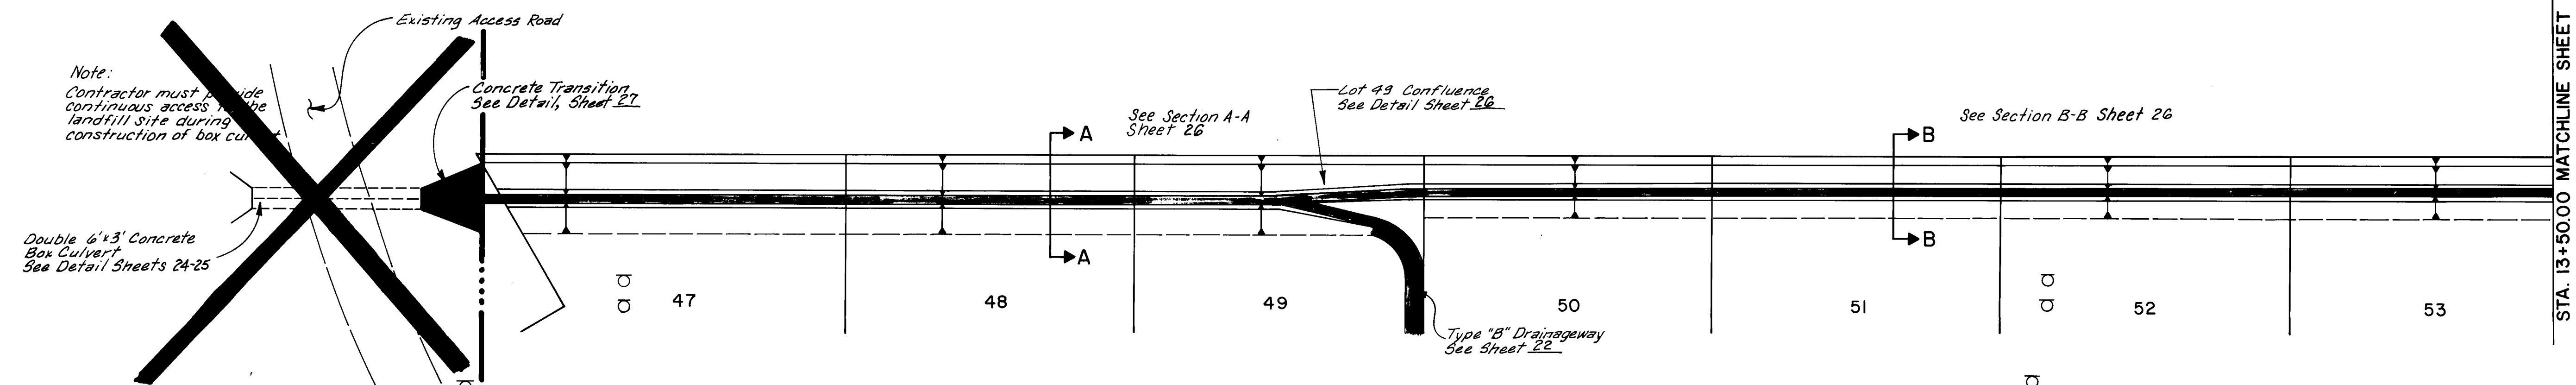



RECORD DRAWING
I, Claude A.L. Pilley, N.M.P.E. & L.S. No. 4981,
hereby certify that this drawing has been
revised in accordance with information furnished
by K.N.C., Inc. Field surveys and that both the
revisions and field surveys were done under
my personal direction and control.
Claude A.L. Pilley
CLAUDE A.L. PILLEY

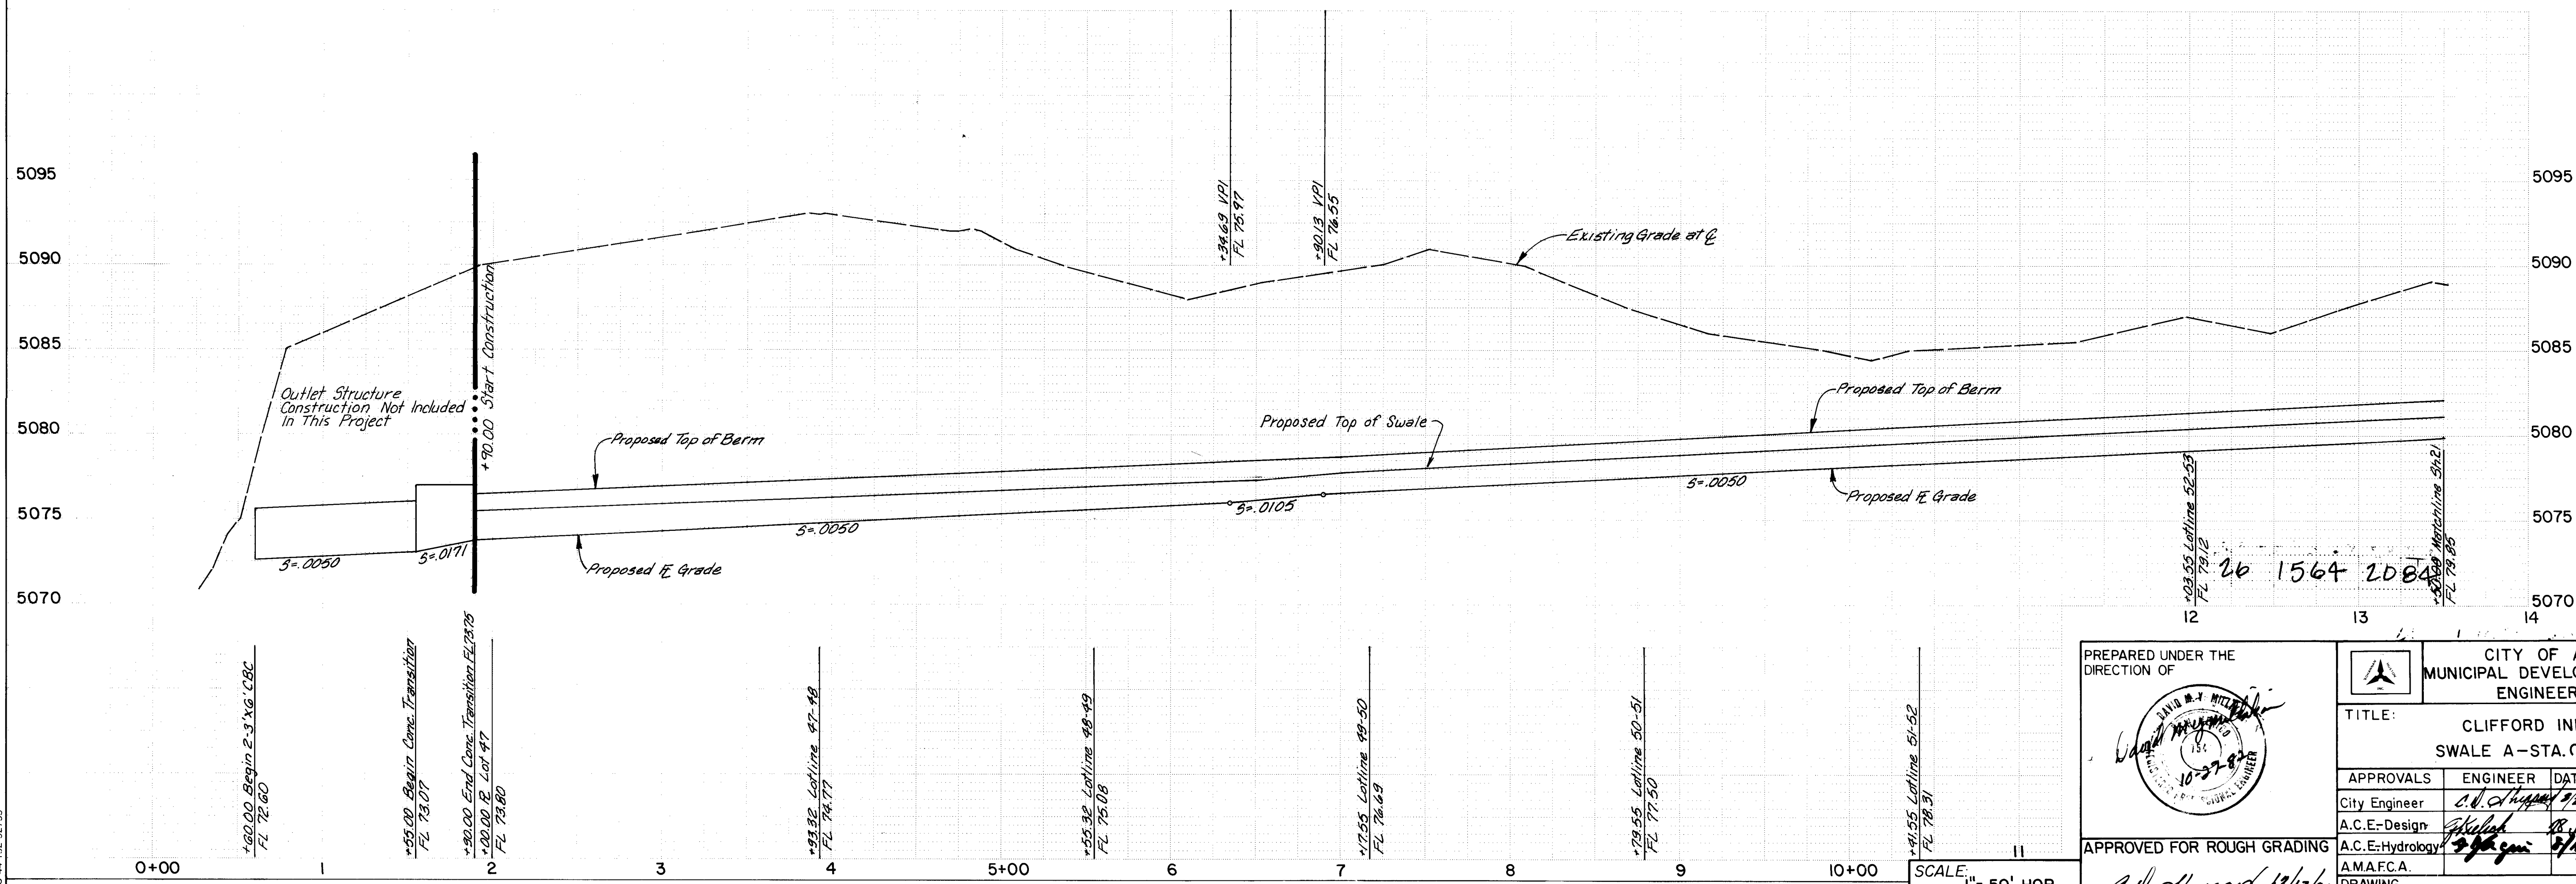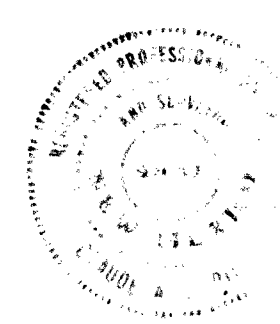

PREPARED UNDER THE DIRECTION OF		CITY OF ALBUQUERQUE MUNICIPAL DEVELOPMENT DEPARTMENT ENGINEERING DIVISION	
TITLE: CLIFFORD INDUSTRIAL PARK-PHASE I SWALE A-STA. 0+40 TO STA. 13+50			
APPROVALS	ENGINEER	DATE	APPROVALS
City Engineer	<i>C. W. Chapman</i>	12/17/82	Liquid Waste
A.C.E.-Design	<i>Philip</i>	12/17/82	Traffic
A.C.E.-Hydrology	<i>Philip</i>	12/17/82	Water
A.M.A.F.C.A.			
DRAWING NO.	1564	CITY ENGINEER	DATE

REFERENCES				SURVEY INFORMATION				BENCH MARKS				AS-BUILT INFORMATION			
MAP NO.	C-17	EST. NO.	W.O. NO.	NO.	BY	DATE		THE STATION IS A STANDARD ACS BRASS	CONTRACTOR	WORK	STARTED BY	DATE	DATE	DATE	DATE
								TABLET, STAMPED "8-C17, 1975", CEMENTED IN		ACCEPTANCE BY	DATE	DATE	DATE	DATE	DATE
								A DRILL HOLE IN TOP OF THE WEST CONCRETE		FIELD	DATE	DATE	DATE	DATE	DATE
								CURB 0.3 MILE NORTH OF LOS ANGELES BLVD.		CONNECTIONS	DATE	DATE	DATE	DATE	DATE
								ON WASHINGTON ST.		MICRO-FILM INFORMATION	NO.	NO.	NO.	NO.	NO.
								ELEV. = 5111.029							

PLATE 1 SINGLE PLAN - PROFILE - DOTTED
CHARLES BRUNING COMPANY
MADE IN U.S.A.

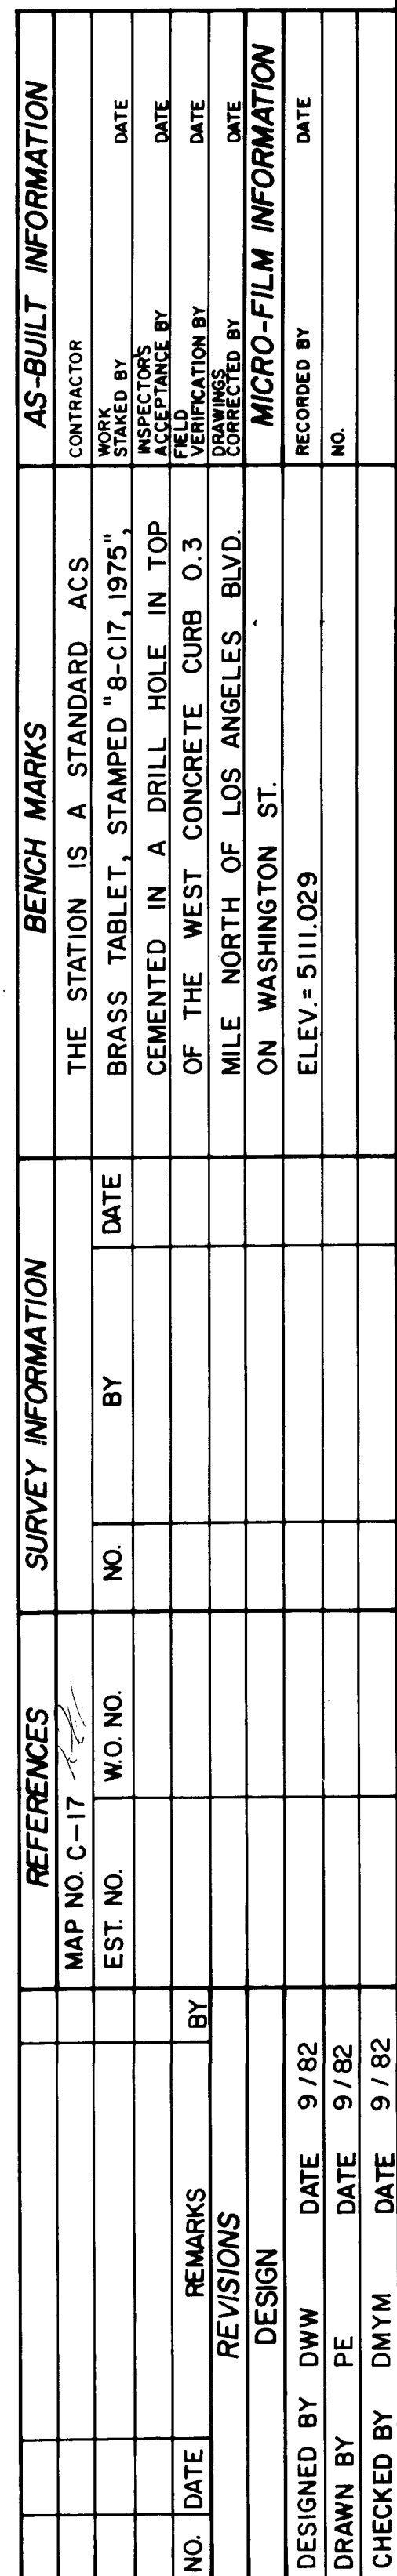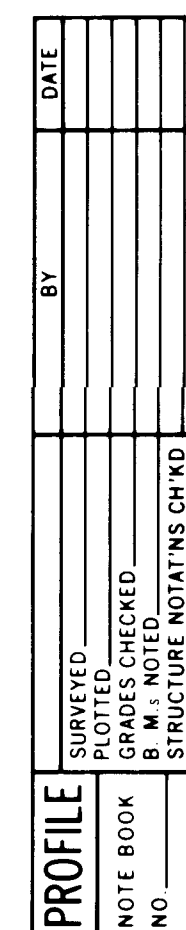

REFERENCE 1625


PLAN	SURVEYED	BY	DATE
NOTE BOOK	ALIGNED CHECKED		
	BY WAY CHECKED		

PROFILE	SURVEYED	BY	DATE
NOTE BOOK	PLOTTED CHECKED		
	BY NOTE NOTATIONS CHECKED		

RECORD DRAWING
I. Claude A.L. Pilley, N.M.P.E. & L.S. No. 4981.
hereby certify that this drawing has been revised in accordance with information furnished by KNC, Inc. Field surveys and that both the revisions and field surveys were done under my personal direction and control.

Claude A.L. Pilley
CLAUDE A.L. PILLEY


TRACT E
LANDS OF SPRINGER CORP.

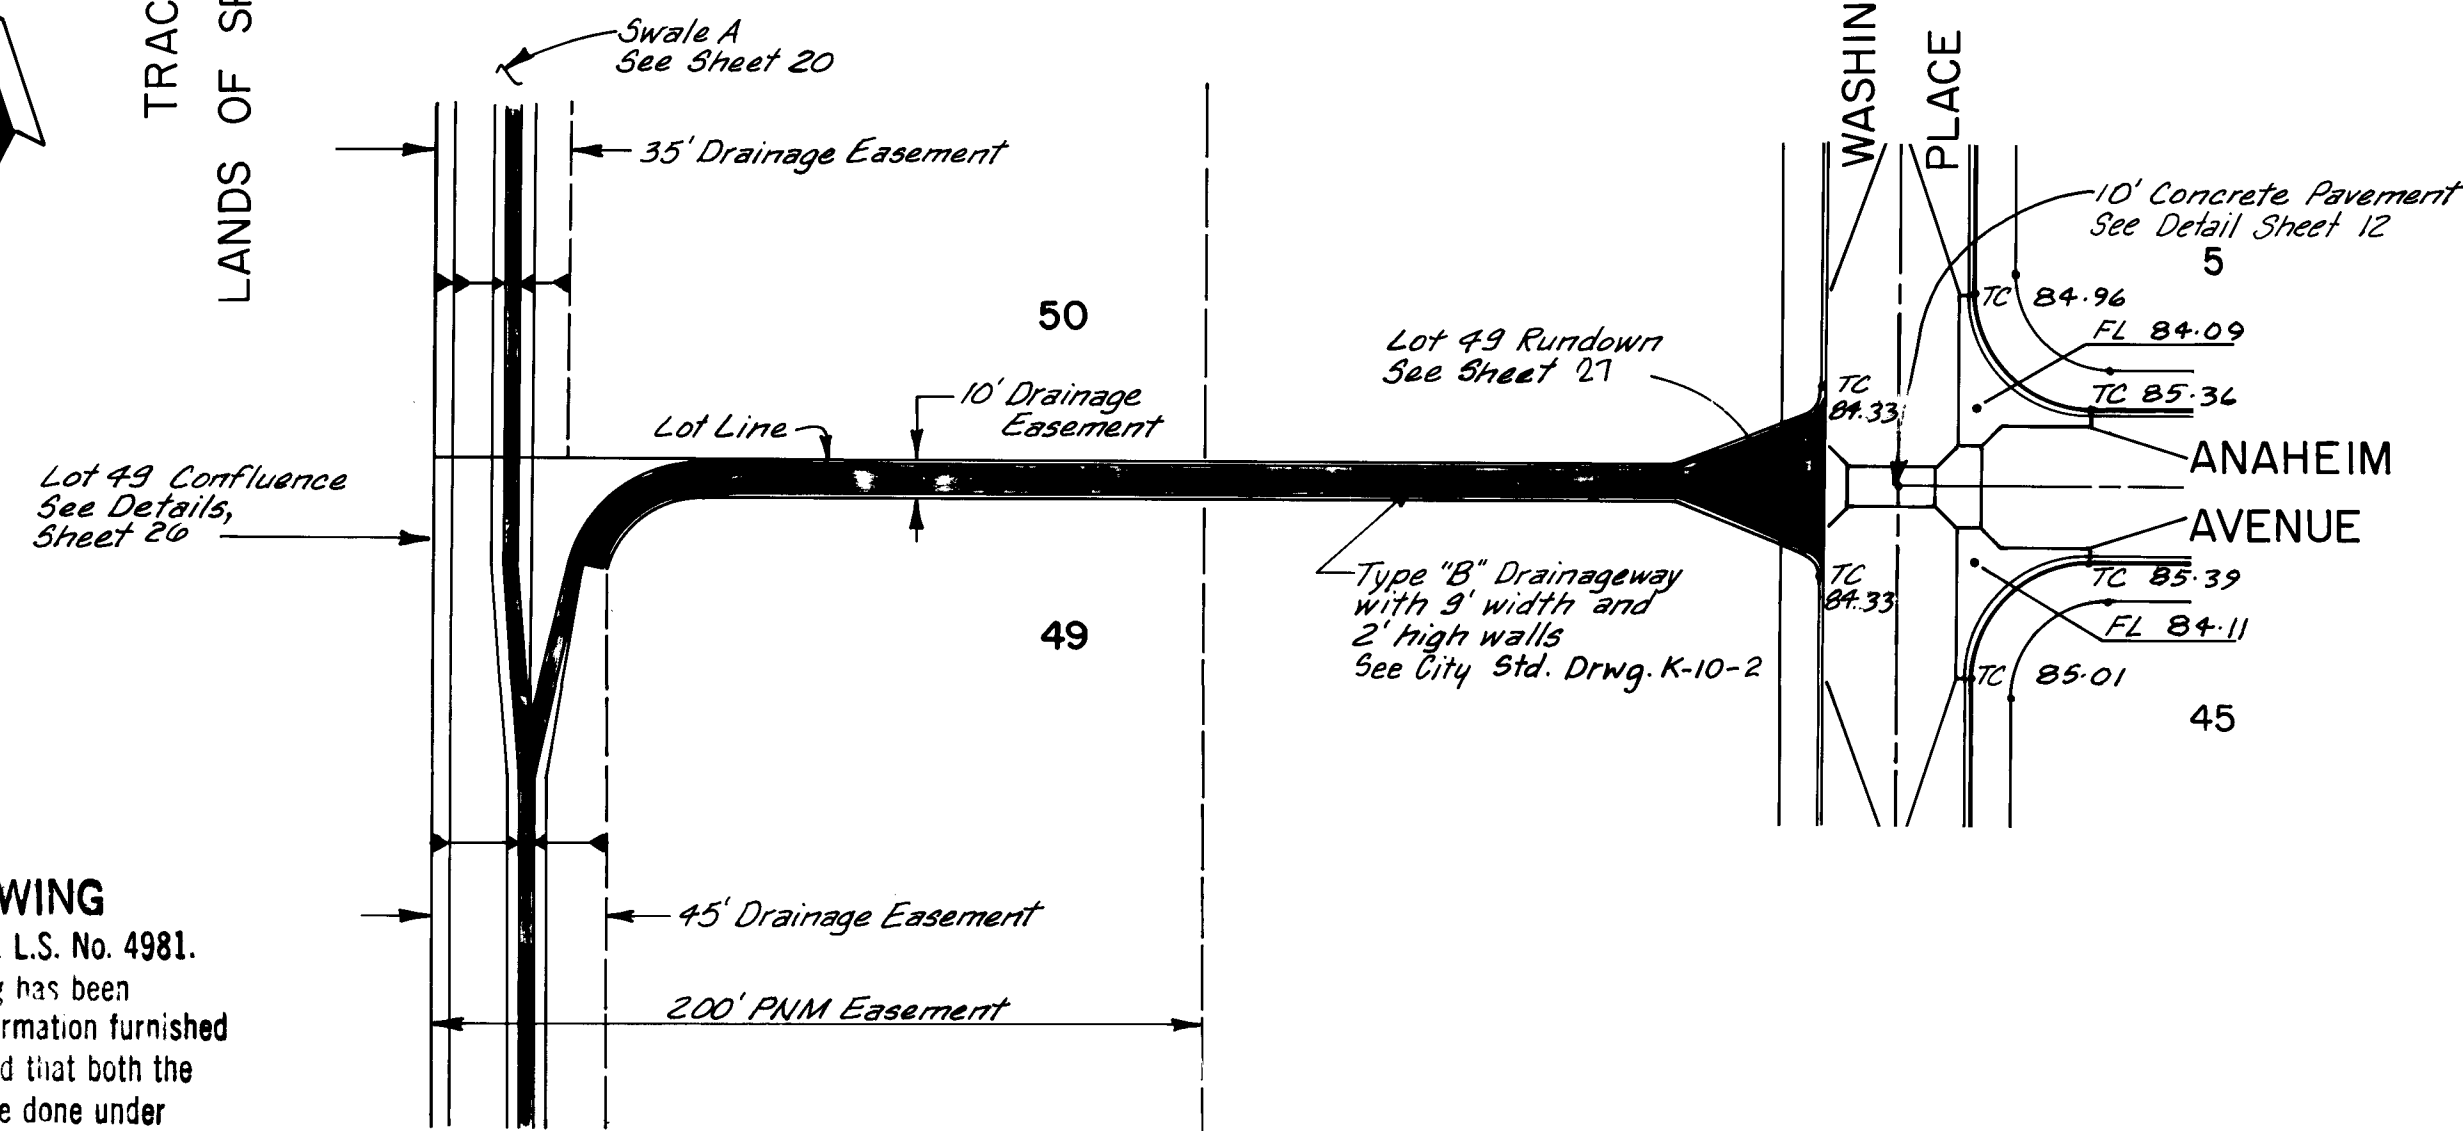

LOT 49 DRAINAGEWAY

TO BE CONSTRUCTED WITH PROJECT 1625

TRACT E
LANDS OF SPRINGER CORP.

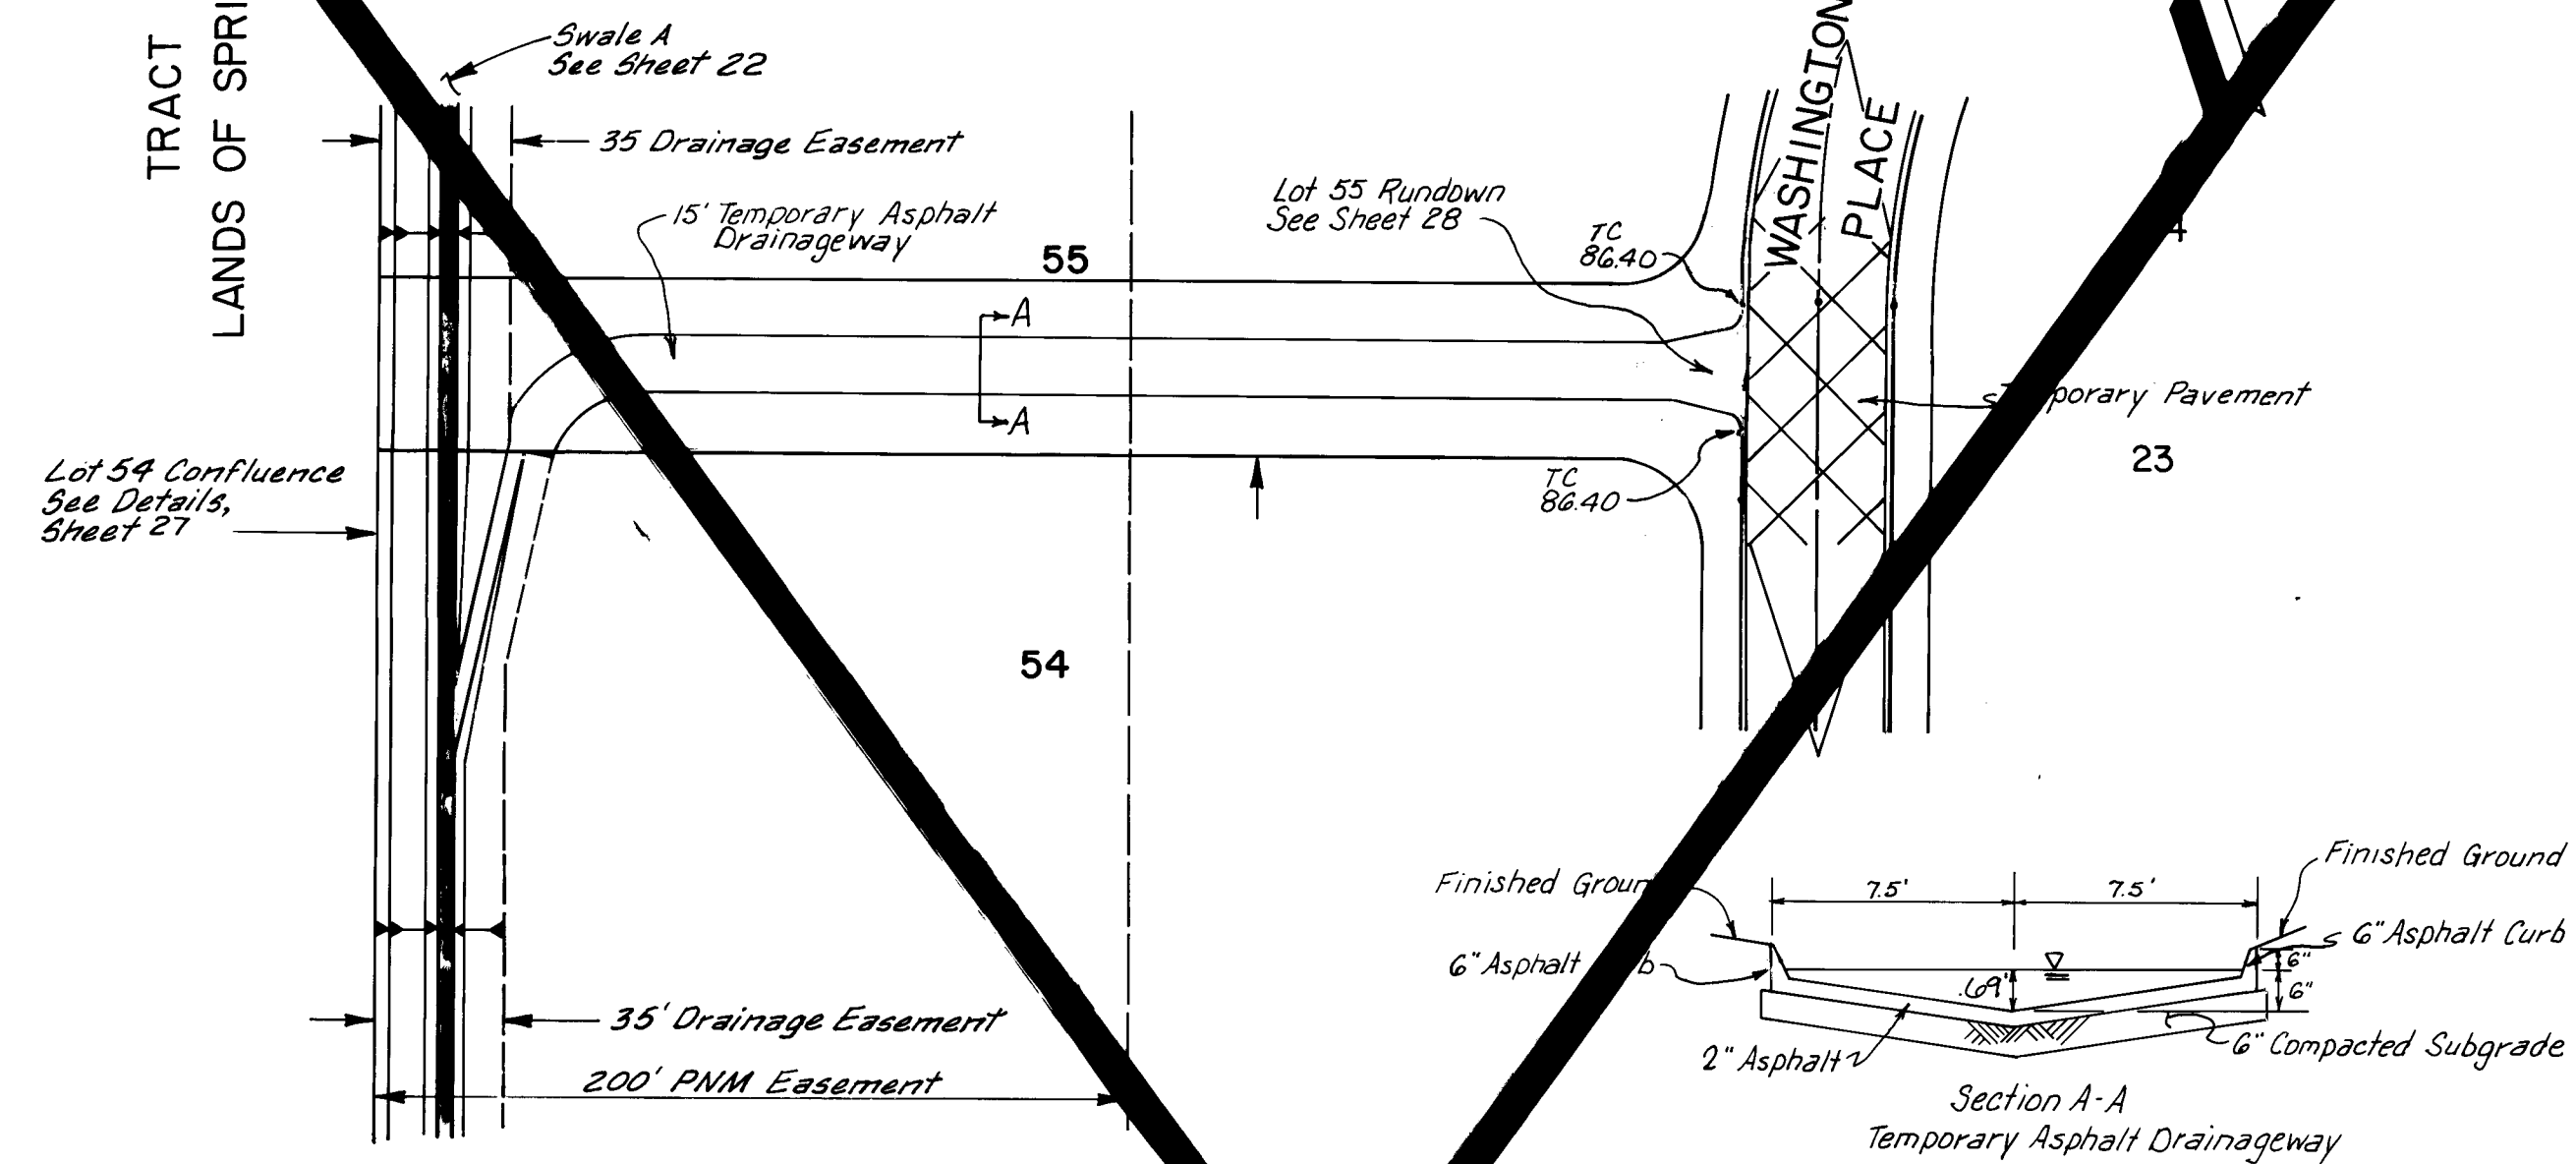

LOT 55 DRAINAGEWAY

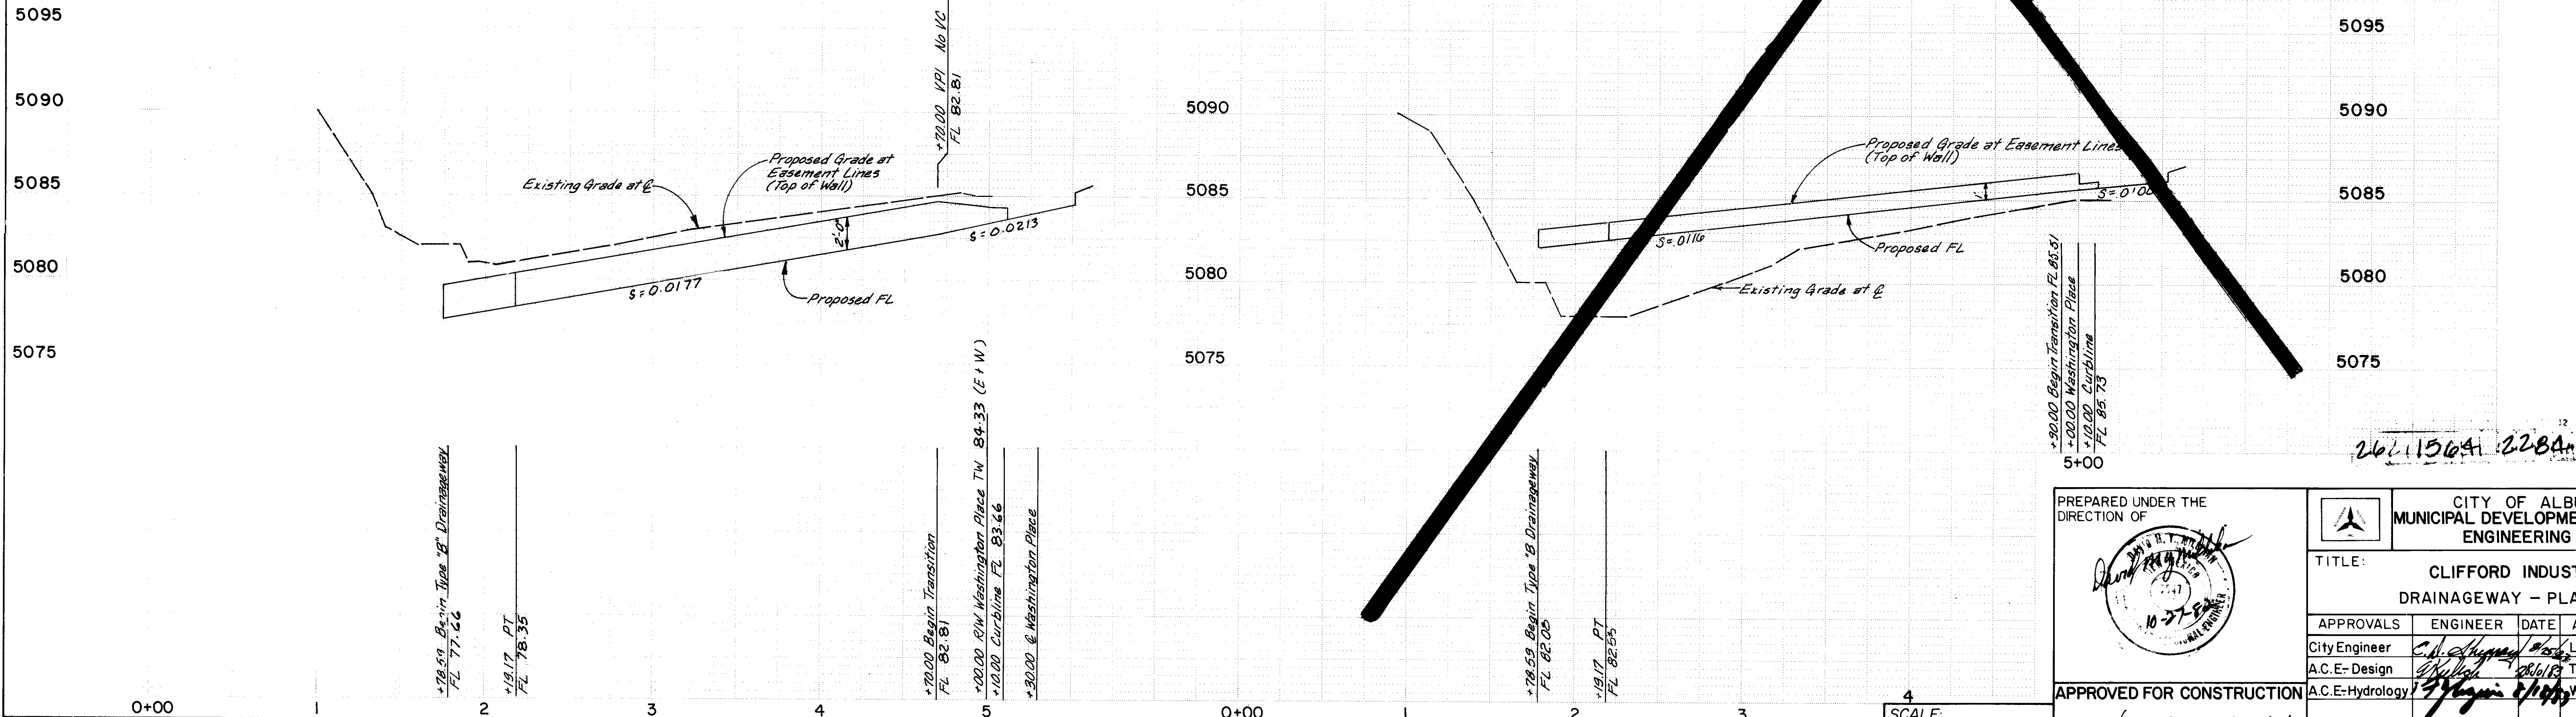


PLATE 1 SINGLE PLAN - PROFILE - DOTTED
CHARLES BRUNING COMPANY
MADE IN U.S.A.

SCALE:
1" = 50' HOR.
1" = 5' VERT.

PREPARED UNDER THE DIRECTION OF
[Signature]
APPROVED FOR CONSTRUCTION
[Signature] 12/13/82
CITY ENGINEER


CITY OF ALBUQUERQUE
MUNICIPAL DEVELOPMENT DEPARTMENT
ENGINEERING DIVISION

TITLE: CLIFFORD INDUSTRIAL PARK-PHASE I
DRAINAGEWAY - PLANS & PROFILES

APPROVALS	ENGINEER	DATE	APPROVALS	ENGINEER	DATE
City Engineer	<i>[Signature]</i>	12/13/82	Liquid Waste	N.A. James J.	7-27-83
A.C.E.-Design	<i>[Signature]</i>	12/13/82	Traffic	N.A. James J.	7-27-83
A.C.E.-Hydrology	<i>[Signature]</i>	12/13/82	Water	N.A. James J.	7-27-83

DRAWING NO. 1564
SHEET 22 OF 27

PROFILE	SURVEYED _____	BY _____	DATE _____
	PLOTTED _____		
	GRADES CHECKED _____		
	B. M. NOTED _____		
	NO _____	STRUCTURE NOTATIONS CH'KD _____	




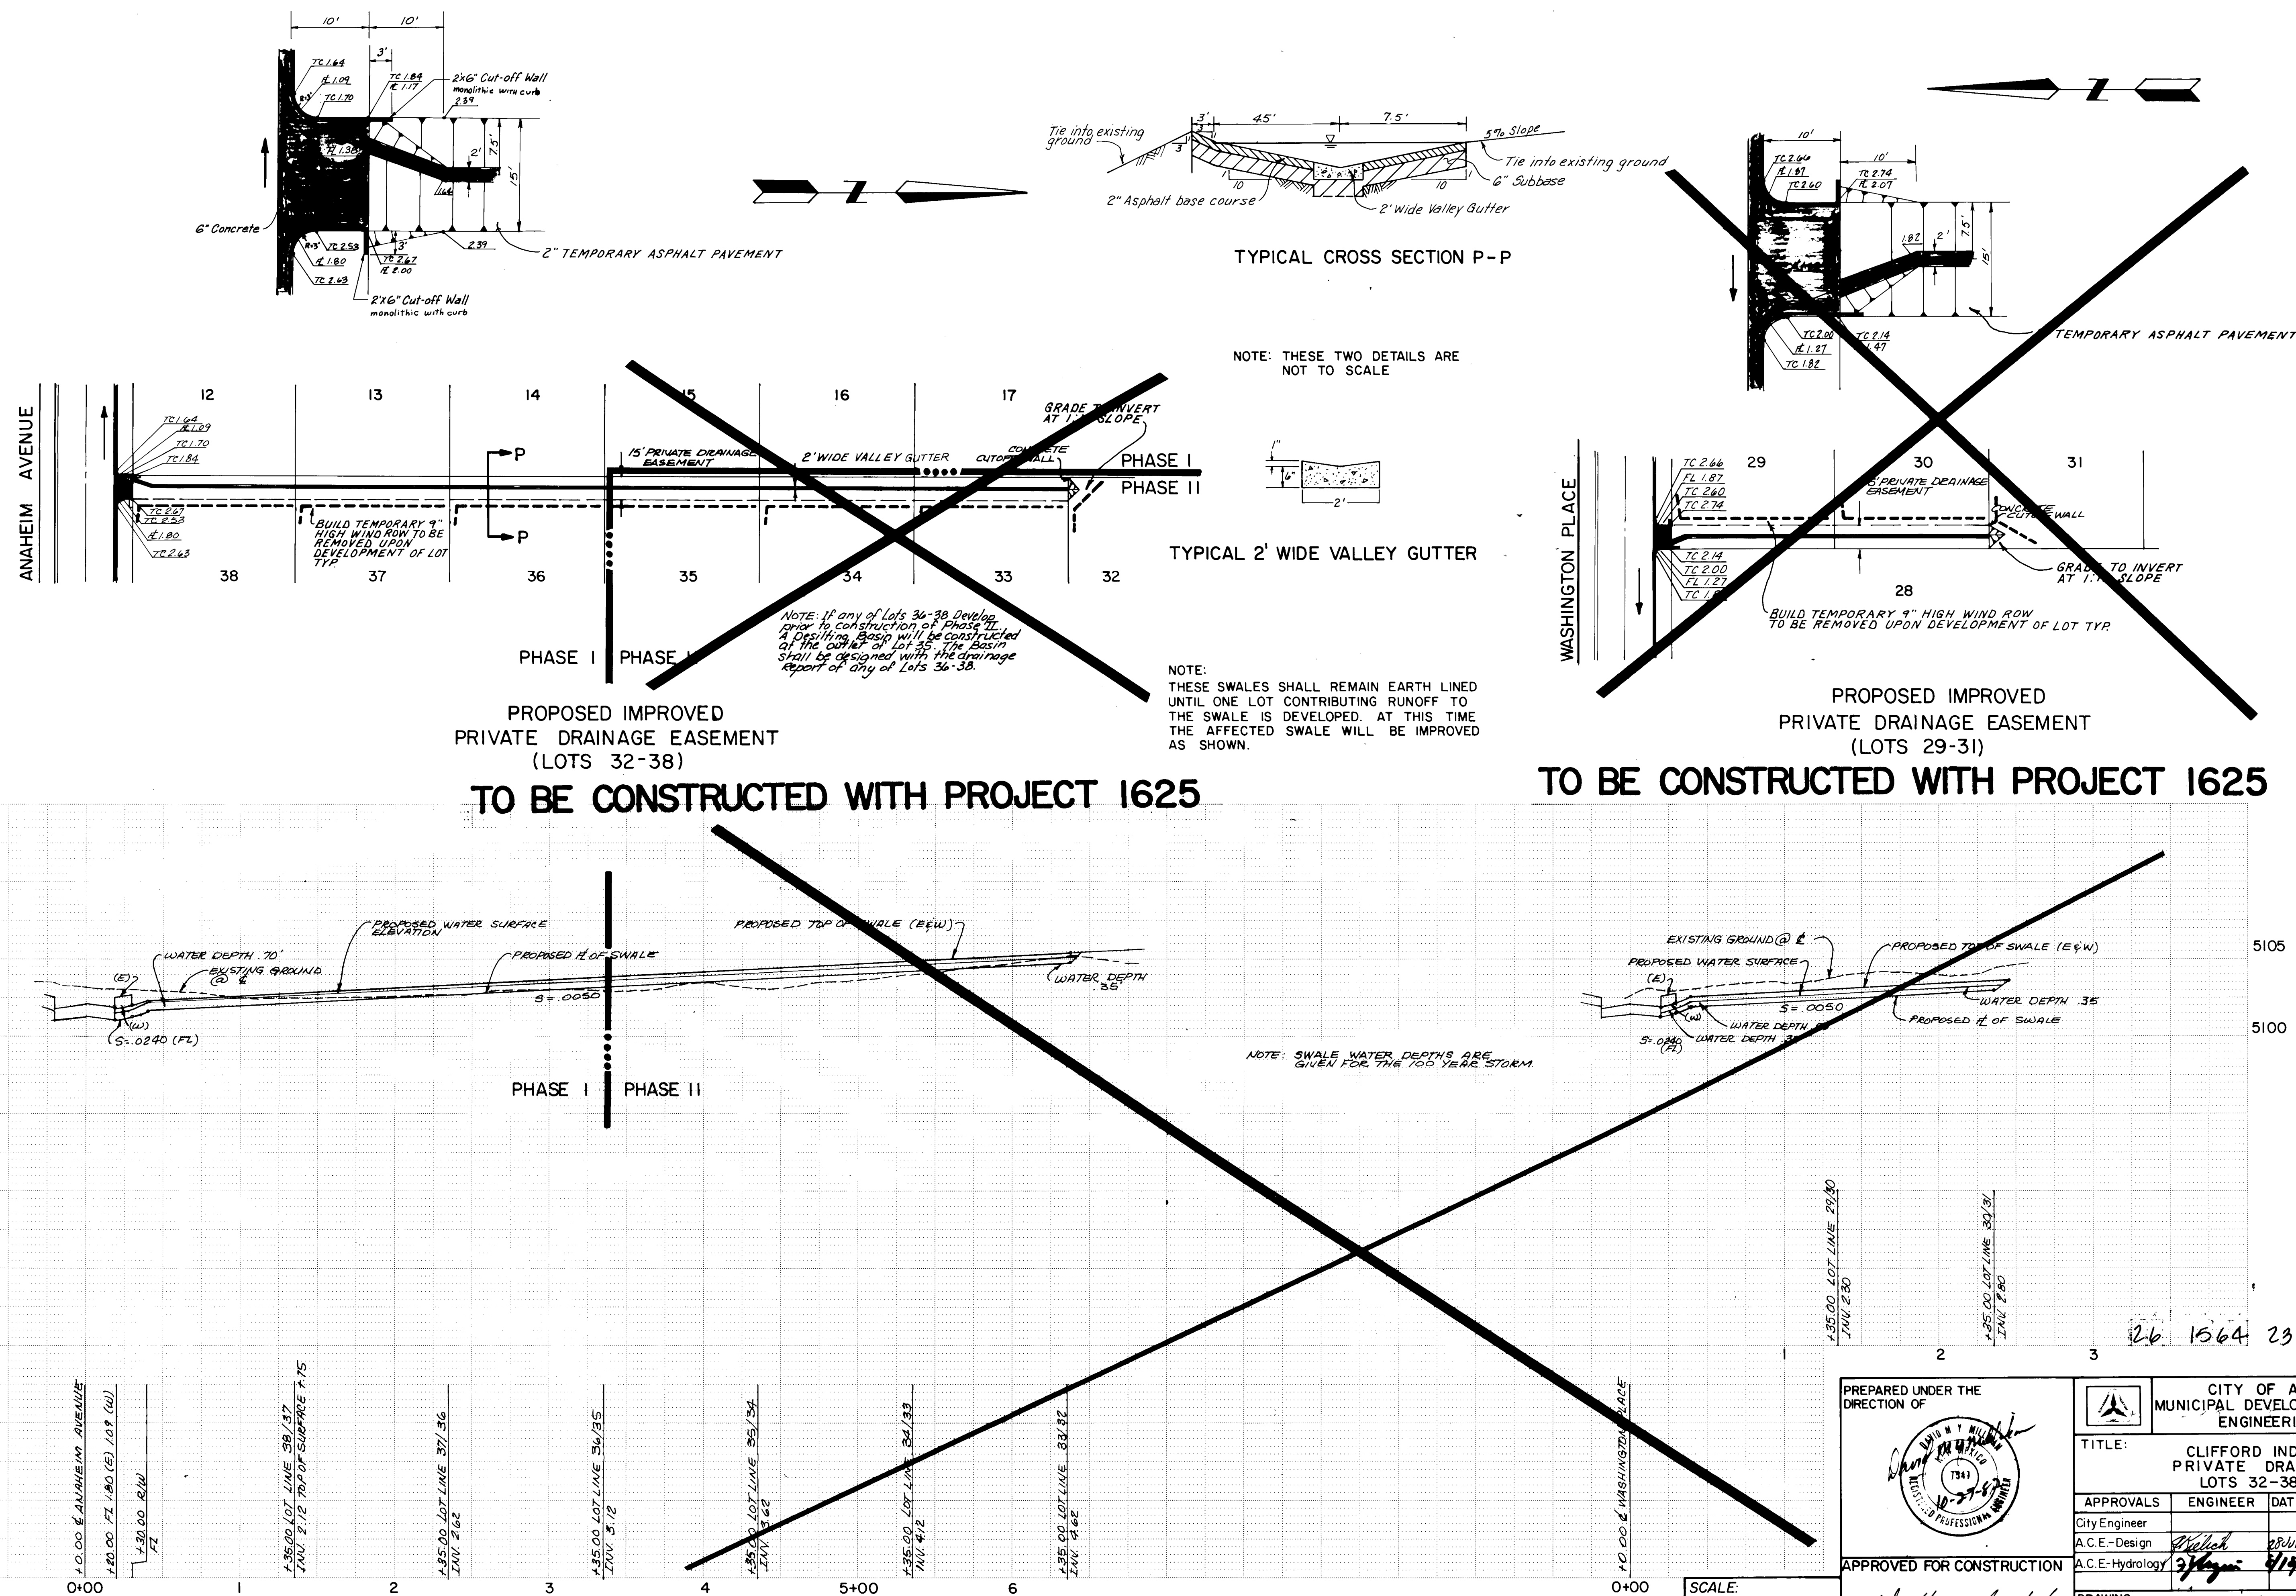


				REFERENCES		SURVEY INFORMATION			BENCH MARKS		AS-BUILT INFORMATION				
				MAP NO. C-17	<i>9-82</i>						THE STATION IS A STANDARD ACS BRASS TABLET, STAMPED "8-CIT, 1975," CEMENTED IN A DRILL HOLE IN TOP OF THE CONCRETE CURB 0.3 MILE NORTH OF LOS ANGELES BLVD. ON WASHINGTON ST.		CONTRACTOR		
				EST. NO.		W.O. NO.		NO.	BY	DATE			WORK STARTED BY	DATE	
													INSPECTORS ACCEPTANCE BY	DATE	
													VERIFICATION BY	DATE	
				BY									CORRECTED BY	DATE	
REVISIONS															
DESIGN															
				DESIGNED BY	DWW	DATE	9 / 82								
				DRAWN BY	PE	DATE	9 / 82								
				CHECKED BY	DMM	DATE	9 / 82								
													RECORDED BY	DATE	
													NO.		

PREPARED UNDER THE DIRECTION OF 	 CITY OF ALBUQUERQUE MUNICIPAL DEVELOPMENT DEPARTMENT ENGINEERING DIVISION 																								
TITLE: CLIFFORD INDUSTRIAL PARK-PHASE I PRIVATE DRAINAGE EASEMENTS LOTS 32-38 & LOTS 29-31																									
<table border="1" style="width: 100%; border-collapse: collapse;"> <thead> <tr> <th style="width: 15%;">APPROVALS</th> <th style="width: 25%;">ENGINEER</th> <th style="width: 15%;">DATE</th> <th style="width: 15%;">APPROVALS</th> <th style="width: 20%;">ENGINEER</th> <th style="width: 10%;">DATE</th> </tr> </thead> <tbody> <tr> <td>City Engineer</td> <td></td> <td></td> <td>Liquid Waste</td> <td>N.A. James J.</td> <td>7-27-84</td> </tr> <tr> <td>A.C.E.-Design</td> <td><i>[Signature]</i></td> <td>8/14/84</td> <td>Traffic</td> <td>N.A. [Signature]</td> <td></td> </tr> <tr> <td>A.C.E.-Hydrology</td> <td><i>[Signature]</i></td> <td>8/14/84</td> <td>Water</td> <td>N.A. James J.</td> <td>7-27-84</td> </tr> </tbody> </table>		APPROVALS	ENGINEER	DATE	APPROVALS	ENGINEER	DATE	City Engineer			Liquid Waste	N.A. James J.	7-27-84	A.C.E.-Design	<i>[Signature]</i>	8/14/84	Traffic	N.A. [Signature]		A.C.E.-Hydrology	<i>[Signature]</i>	8/14/84	Water	N.A. James J.	7-27-84
APPROVALS	ENGINEER	DATE	APPROVALS	ENGINEER	DATE																				
City Engineer			Liquid Waste	N.A. James J.	7-27-84																				
A.C.E.-Design	<i>[Signature]</i>	8/14/84	Traffic	N.A. [Signature]																					
A.C.E.-Hydrology	<i>[Signature]</i>	8/14/84	Water	N.A. James J.	7-27-84																				
APPROVED FOR CONSTRUCTION <i>C.D. Hayward</i> 12/16/83 CITY ENGINEER DATE																									
DRAWING NO. 1564																									
SHEET 23 OF 27																									

DESIGN	MAXIMUM COVER	S = CLEAR SPAN	H = CLEAR HEIGHT	DIMENSIONS							QUANTITIES				REINFORCING BARS																																																																																																																																																																																																																																																																																																																																																																																																																																																																																																																																																																																																																																																																																																																																																																																								
				TT	TS	TB	SO	HO	Y	Z	PER LINEAR FT.		AT ONE END		a1			a2			b1			b2			c1		c2		c3			c4			m			n			d			e			Ta			Tb			Tc			Ts			g, h																																																																																																																																																																																																																																																																																																																																																																																																																																																																																																																																																																																																																																																																																																																																										
											Reinf. Steel Lbs./Lin. Ft.	Concrete Cu. Yd./Lin. Ft.	Reinforcing Steel-Lbs.	Concrete Cu. Yds.	Size	Length	Spacing	Size	Length	Spacing	Size	Length

* Quantities at one end include parapet, cut-off, and barrel beyond length L.
Wing Wall quantities are not included.

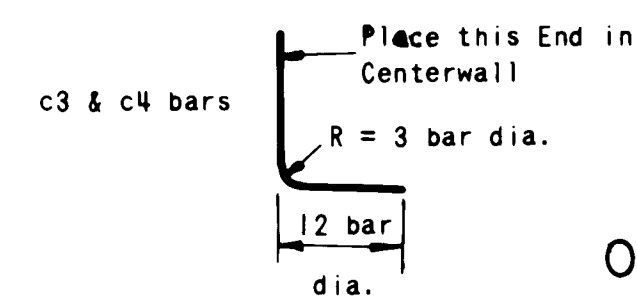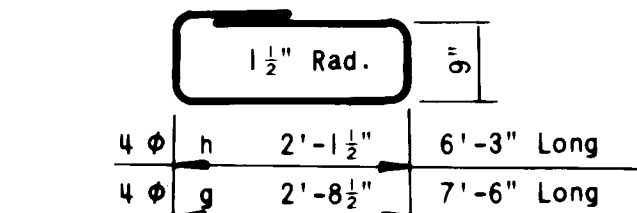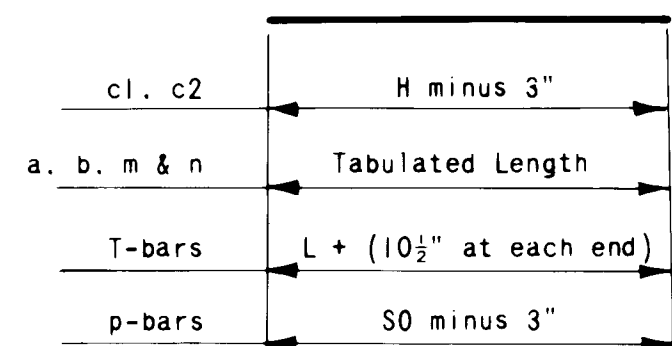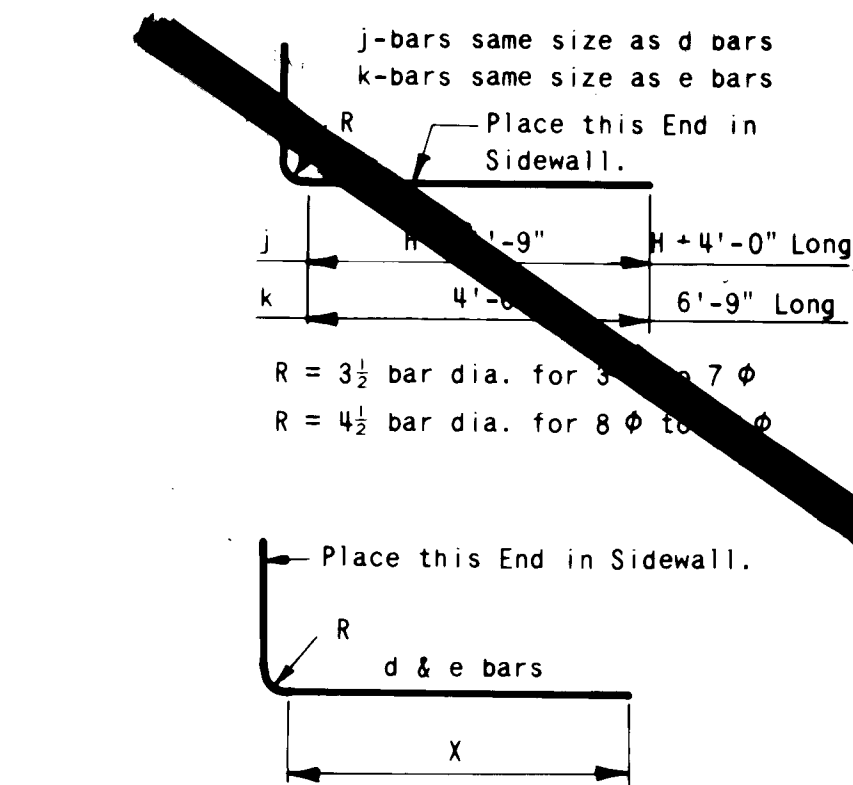

NUMBER OF BARS REQUIRED
a2, b2, c2, d & e bars: 24L ÷ Spacing
a1, b1, m & n bars: 12L ÷ Spacing
p-bars: 12 for cutoff & parapet at each end
cl. c3 & c4 bars: (24L ÷ Sp.) plus 2 at each end
j & k bars: 1 each for cutoff & parapet at each end
Other bars: See table
L = Length of Barrel in

BAR DETAILS



Concrete Class	Minimum Design Compressive Strength 28 Days	Minimum Cement Content per Cu. Yd.	Maximum Water Content Per Bag of Cement	Consistency (Vibrated) Slump AASHTO T 119	Size of Coarse Aggregate U.S. Customary	Approximate Aggregate Weights in 4 cu. yd. of Concrete
A	3000	564	6.0	2-4	1 1/2" max	185
B	3000	564	6.0	2-4	1 1/2" max	185
C	2200	470	5.0	2-4	1 1/2" max	200
D	3000	611	6.5	2-4	1 1/2" max	212
	4000	658	7.0	5-5	1 1/2" max	238

* Not to be considered specification requirements.
** Concrete will be designed and the cement content increased to meet or exceed minimum values.

D-BARS		CLEAR SPAN		SIZE	
		6"		5"	



VOID OUTLET STRUCTURE UNDER DESIGN BY THE CITY OF ALBUQUERQUE

DETAIL-CONCRETE BOX AND CHANNEL JUNCTION

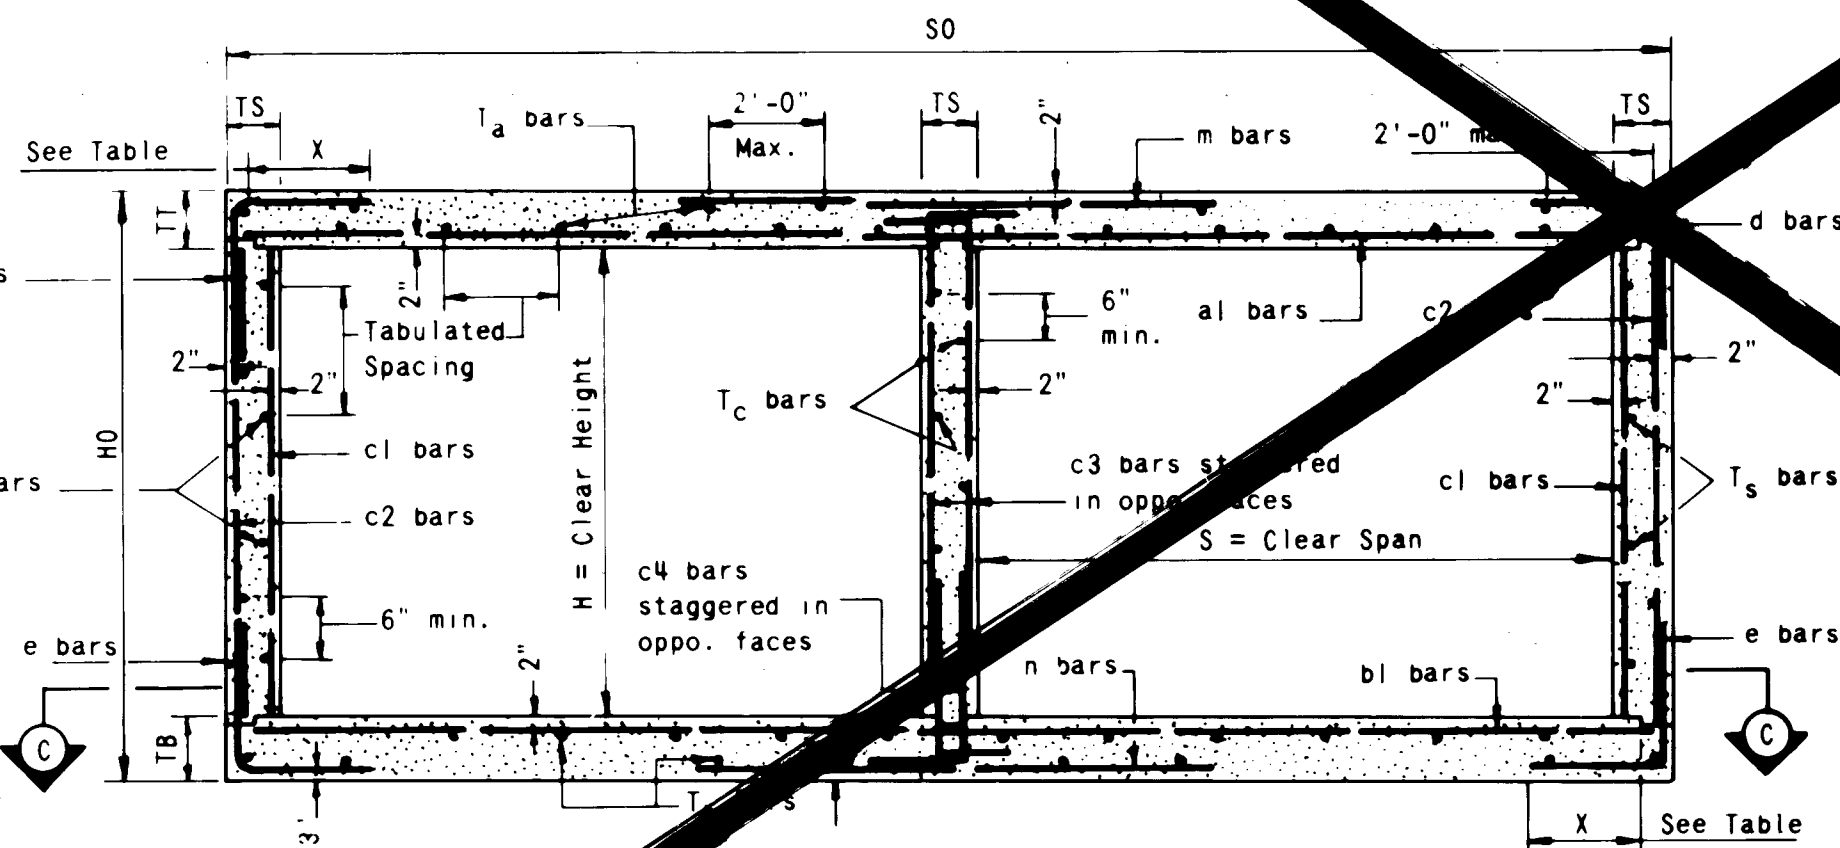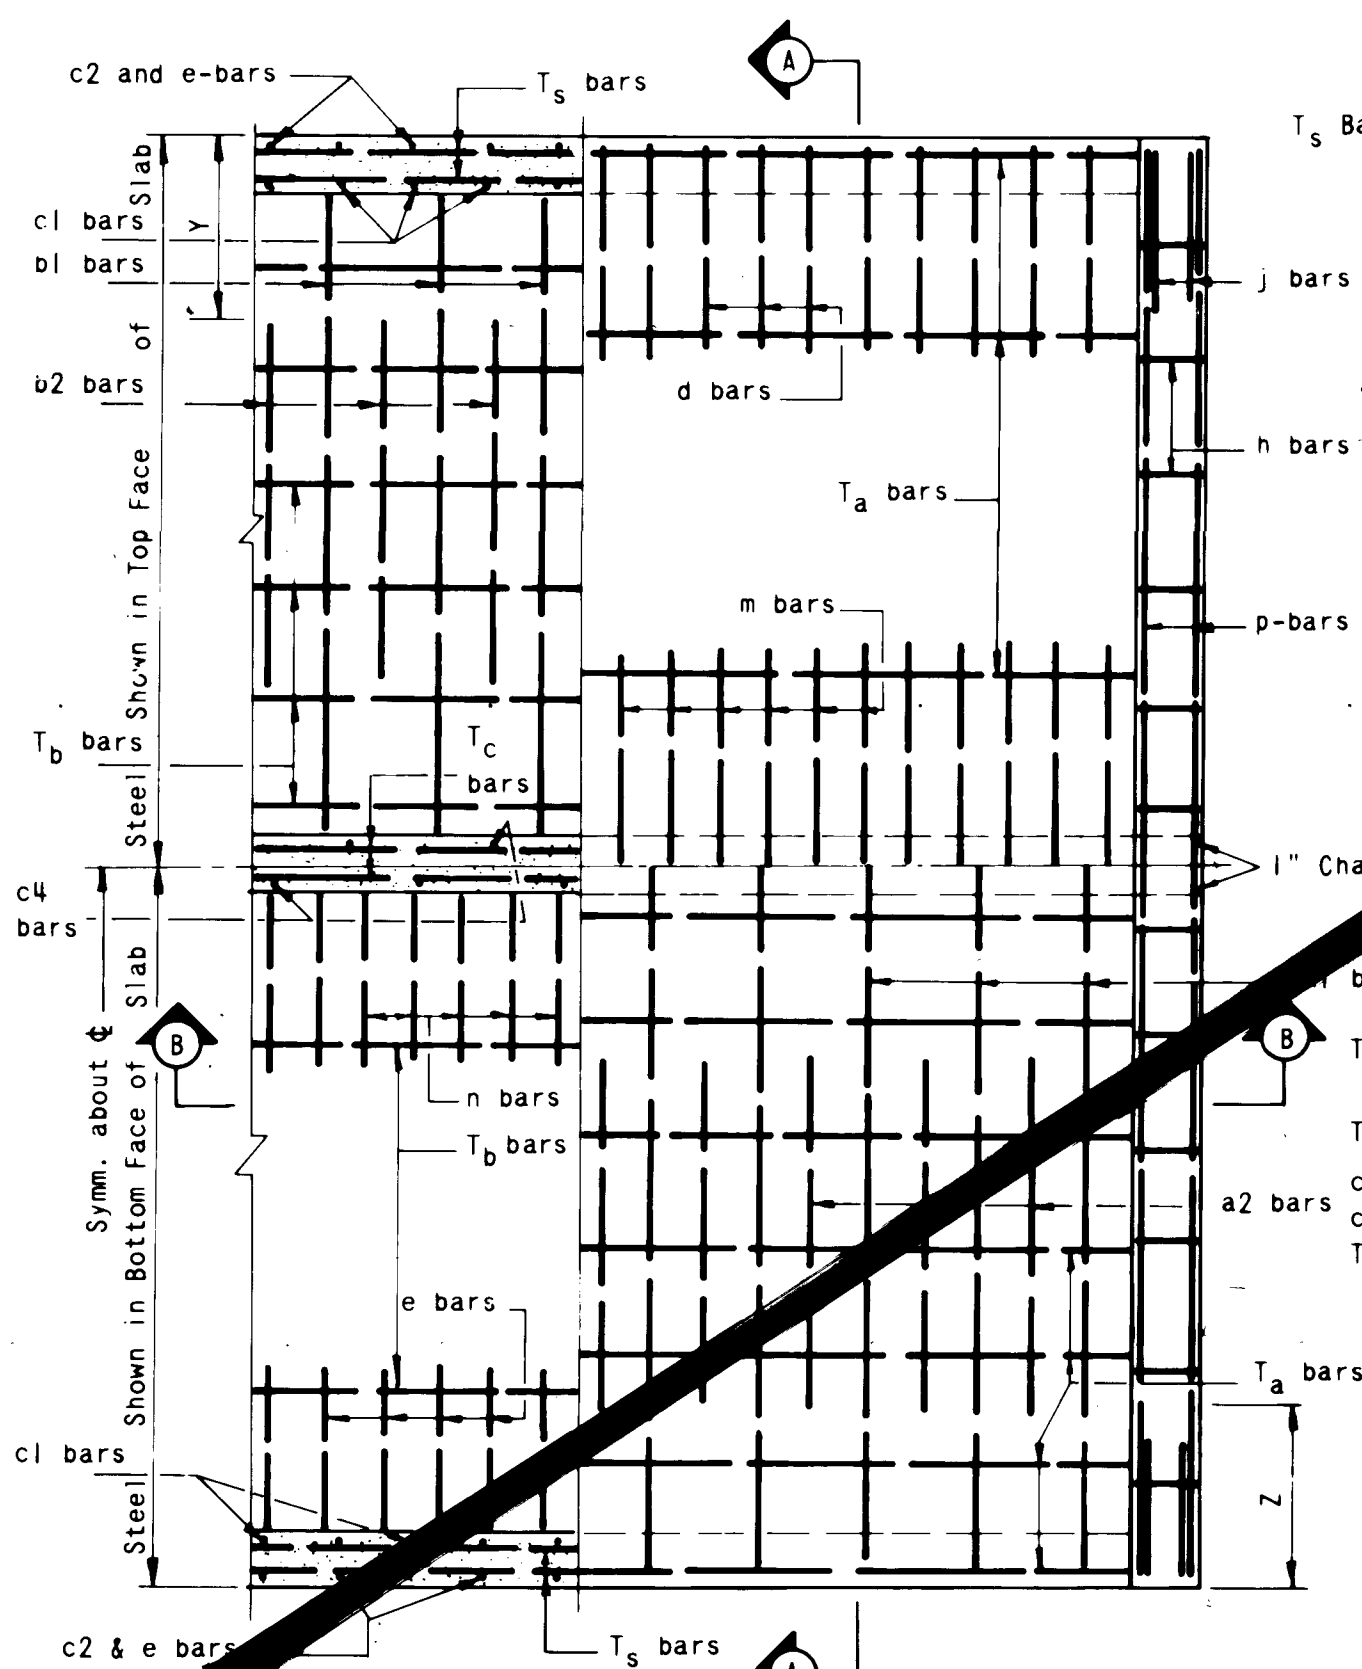

SECTION A-A

DETAIL OF CONSTRUCTION JOINTS

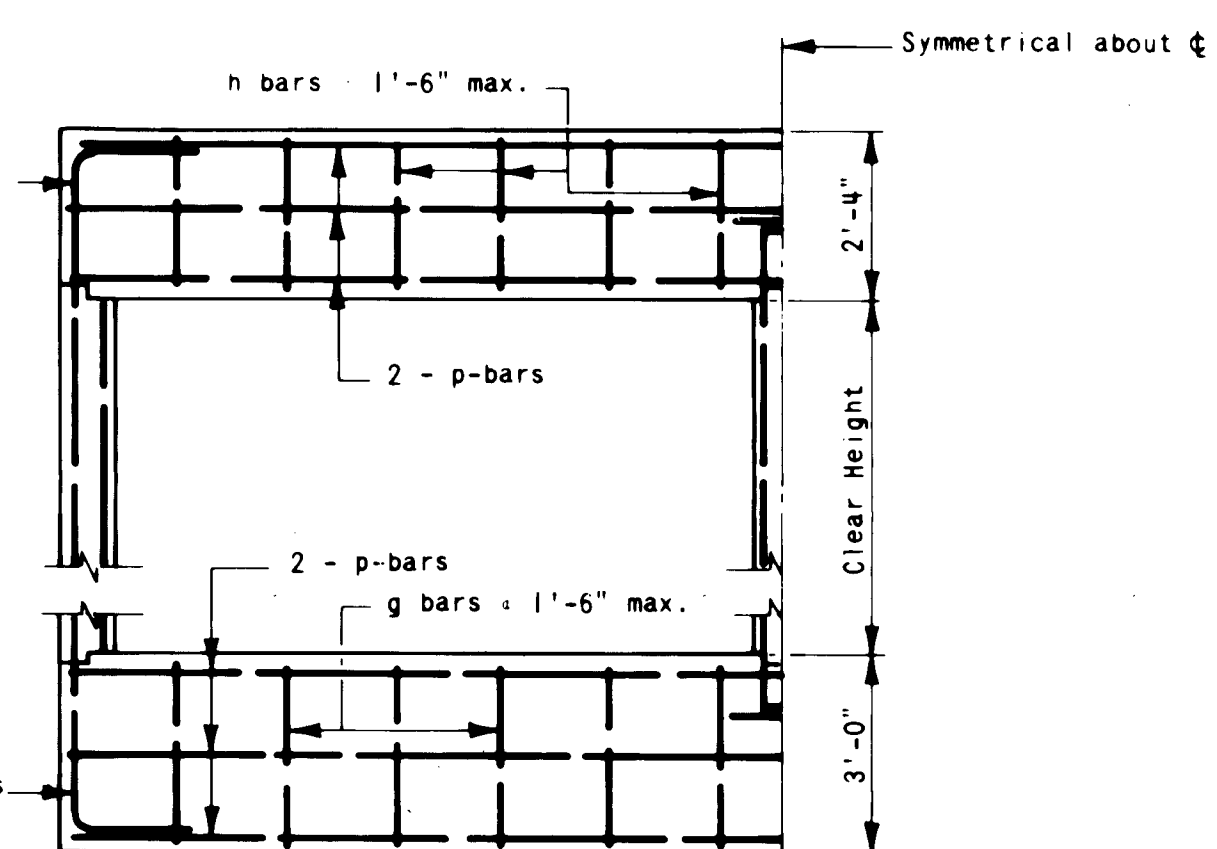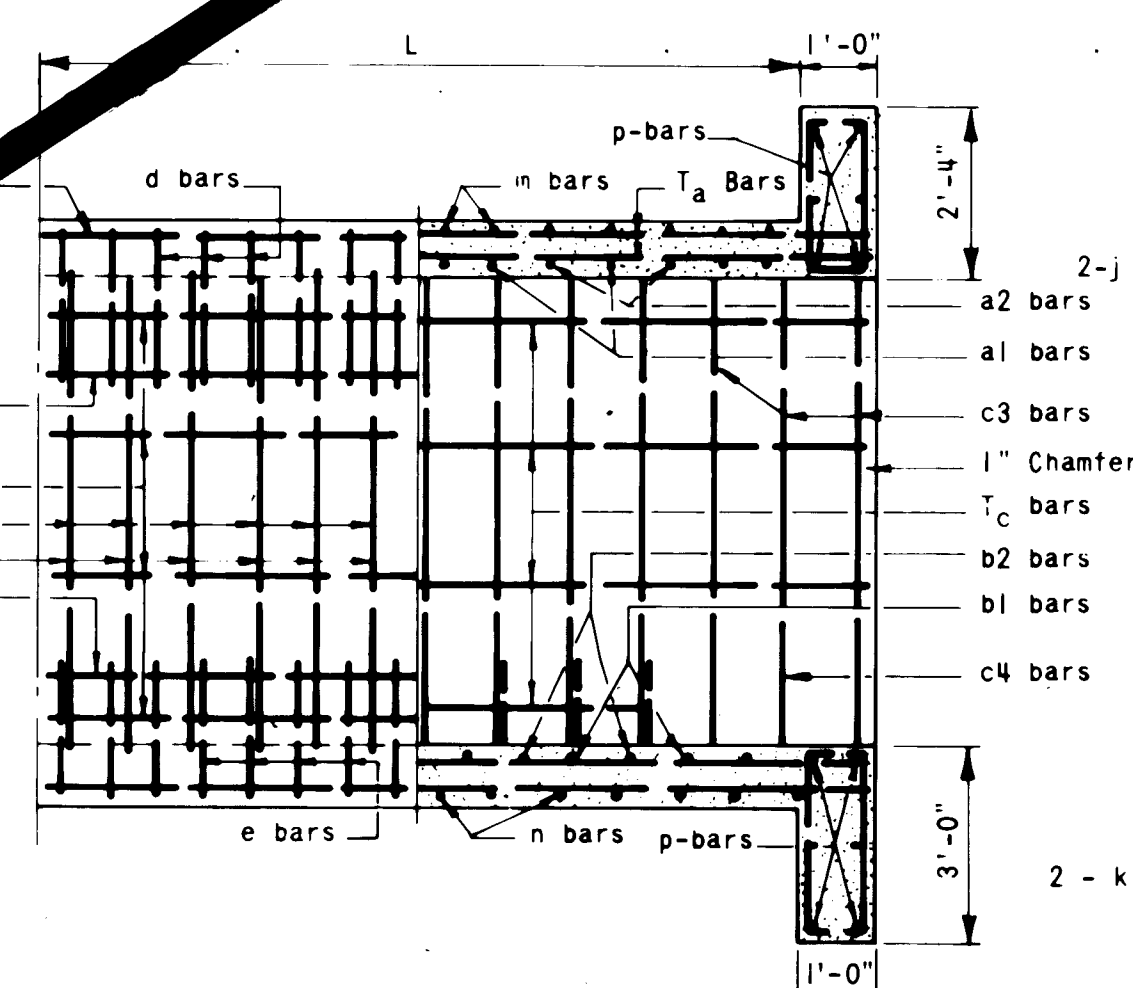

PART ELEVATION

PART SECTION B-B

PART END ELEVATION

PART SECTION C-C


PART PLAN TOP SLAB

GENERAL NOTES:


- Workmanship and materials shall conform to City of Albuquerque Standards.
- All concrete to be Class "A". Chamfer all exposed edges 1/2 inch except as noted.
- All reinforcing steel to be deformed bars, intermediate grade, conforming to A.S.T.M. Specifications A-15 and A-305. All dimensions refer to φ of bar.
- T-bars may be spliced, when necessary, by lapping at least 20 bar diameters. Pay weight for reinforcing steel does not include splices. Cost of splice material to be included in unit price bid for reinforcing steel.
- Volume of concrete = (L)(x)(concrete quantity per lin. ft.) plus concrete at ends. (Pay item).
- Weight of reinforcing steel = (L)(wt. of reinf. steel/lin. ft.) plus weight at ends. (No payment for this item. It is to be considered incidental to concrete pay item).
- Place T_a-bars on a-bars and T_b-bars under b-bars, spaced as shown in the table. The remaining T_a- and T_b-bars are to be placed adjacent to d-, e-, m- and n-bars, as indicated in Section A-A.
- Place T_c-bars next to cl bars, spaced as shown in the table. The remaining T_c-bars to be placed in sidewalk next to c2, d- & e-bars. When cl bars are not required, place all T_c-bars next to c2, d- & e-bars.
- "Cover" is height of fill from top of box to finished grade.
- p-bars to be from #9 φ.
- For design transition, extend T_a, T_b, T_c, and T_d bars from box of lesser design 5'-0" beyond station of design change.

DESIGN DATA

Design according to A.A.S.H.O. Specifications, 1973.
Live Load: H20-S16-44 & Interstate Alternate Loading.
Weight of fill on top of box: 84#/cu. ft.
Horizontal Earth Pressure = 30#/cu. ft., 2' surcharge.
Design Stresses: f'_c = 3000 p.s.i., f_c = 1200 p.s.i.,
f_s = 20,000 p.s.i., n = 10.

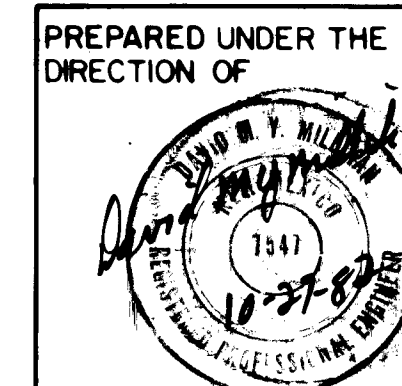


CITY OF ALBUQUERQUE MUNICIPAL DEVELOPMENT DEPARTMENT ENGINEERING DIVISION					
TITLE: CLIFFORD INDUSTRIAL PARK-PHASE I SWALE A-OUTLET STRUCTURE					
APPROVALS	ENGINEER	DATE	APPROVALS	ENGINEER	DATE
City Engineer			Liquid Waste	N.A. J. J. J.	7/27/82
A.C.E. Design			Traffic	N.A. J. J. J.	7/27/82
A.C.E. Hydrology			Water	N.A. J. J. J.	7/27/82
A.M.A.F.C.A.					
APPROVED FOR CONSTRUCTION			DRAWING NO. 1564		
CITY ENGINEER			SHEET 24 OF 27		
DATE			REFERENCE 1625		

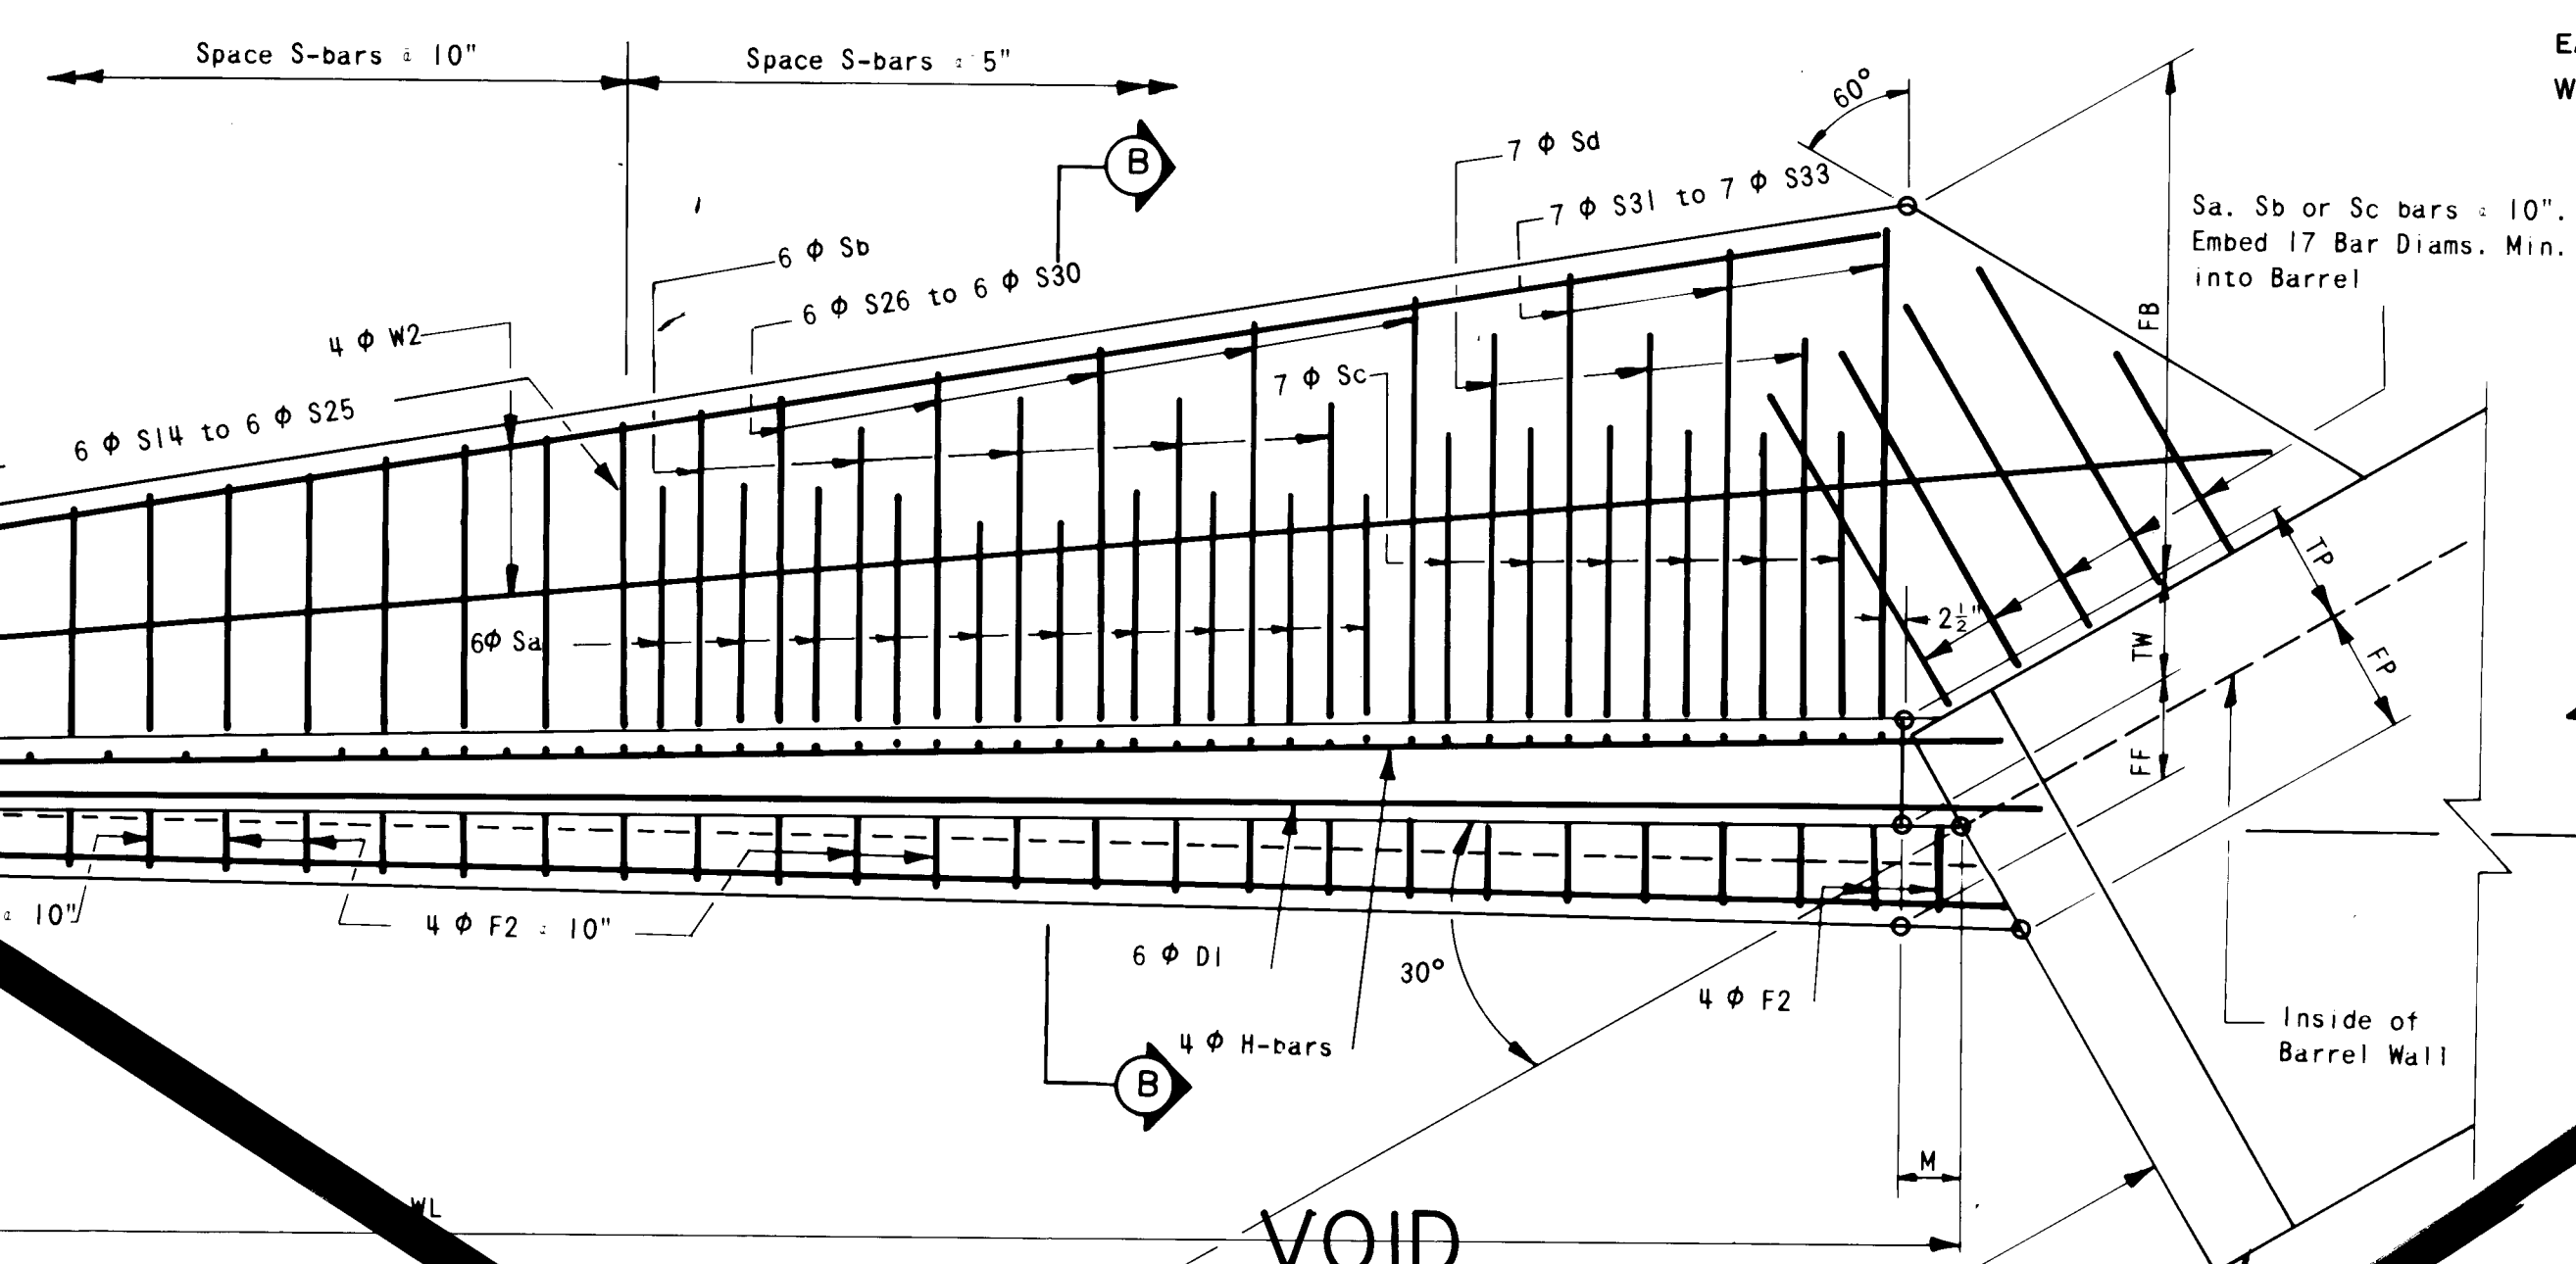

PLAN

Right wing shown; left wing opp. hand.

OUTLET STRUCTURE UNDER DESIGN BY
THE CITY OF ALBUQUERQUE

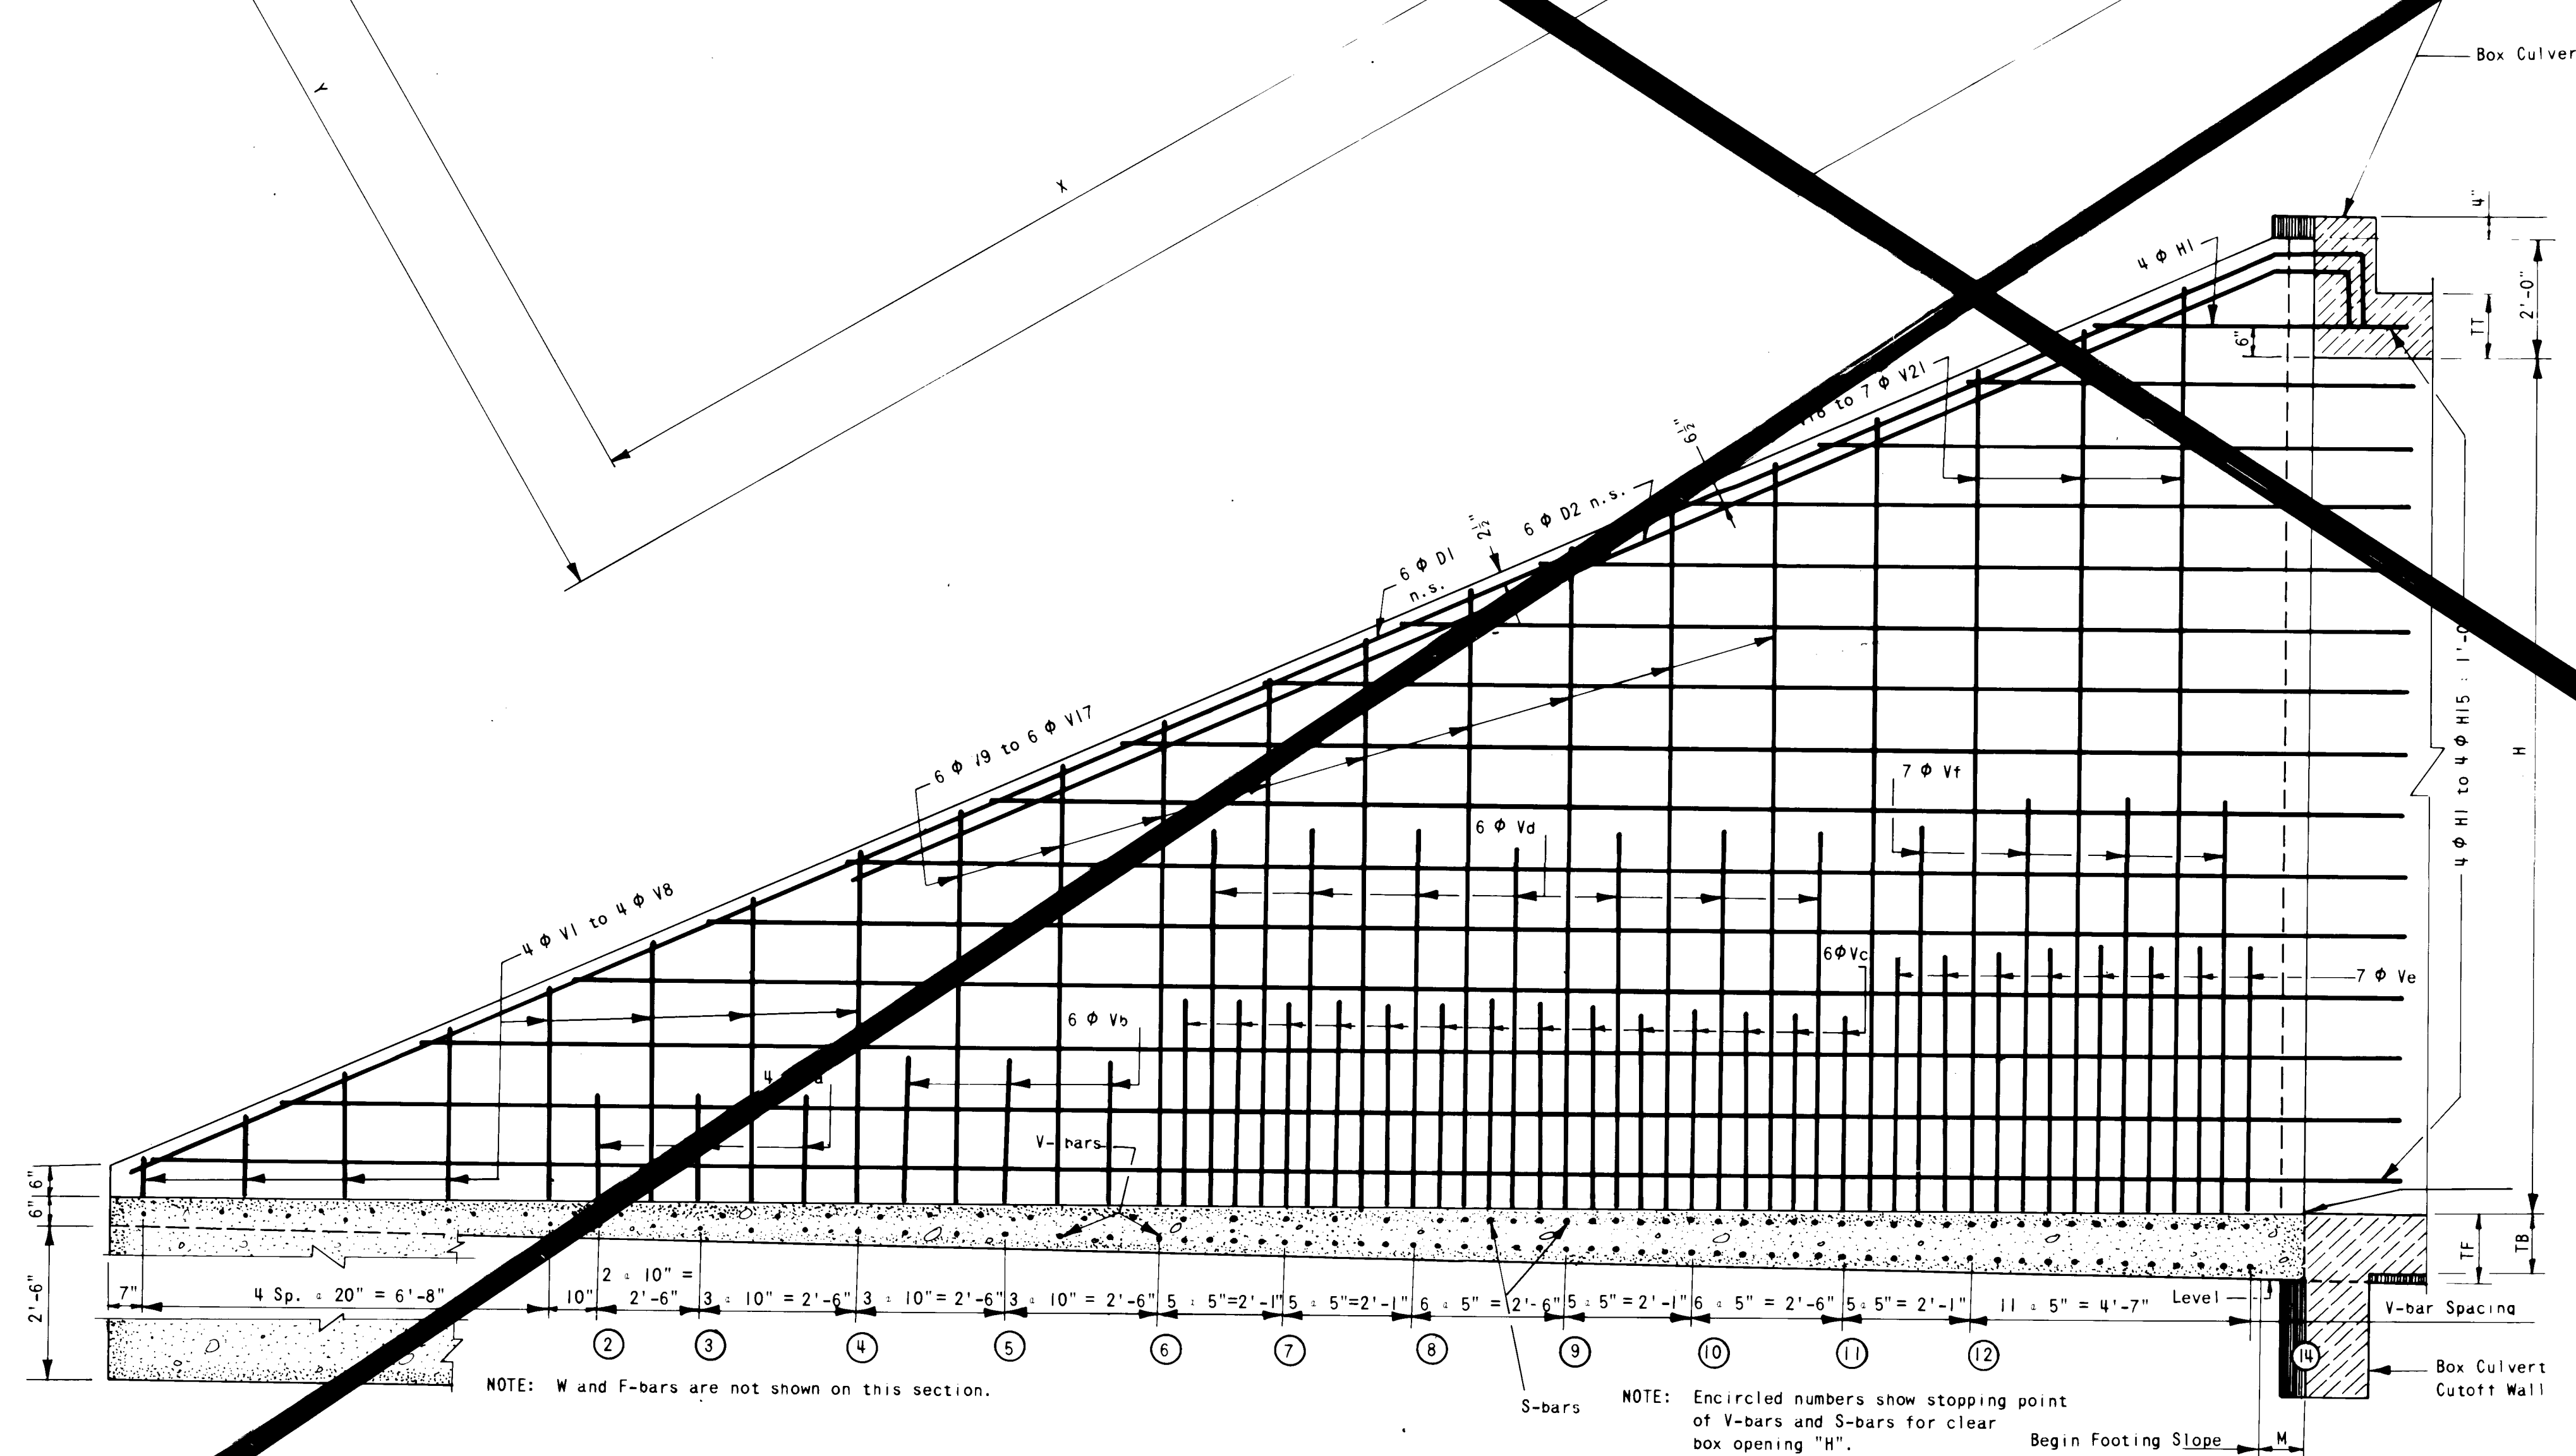

SECTION AA

NOTE: SEE SHEET 27 FOR LOCATION OF WING WALLS AND DETAILS OF OUTLET STRUCTURE

DESIGN DATA
Design according to AASHTO Specifications 1981
Horizontal Earth Pressure: Equivalent fluid pressure
36 lb./cu.ft. 2' surcharge
Design Stresses: $f'_c = 3000$ psi at 28 days $f'_c = 1200$ psi
 $f_s = 20,000$ psi; $n=10$

WINGWALL DIMENSIONS											
H	WL	X	Y	TW	FF	FB	TF	M	TP	FP	
3'	8'-6"	7'-4"	4'-3"	0'-6"	0'-11"	0'-8 1/2"	1'-1"	0'-6 1/2"	0'-6 1/2"	1'-0 1/2"	
3'	15'	12'-11"	7'-6"	0'-6"	0'-11"	0'-8 1/2"	1'-1"	0'-6 1/2"	0'-6 1/2"	1'-0 1/2"	


NOTE: Wingwalls may be built with a uniform thickness of "TW" throughout their entire length, providing vertical reinforcing in back face is kept 2" from back face of the concrete and the back of the footing is kept at least wide enough to prevent the wall from projecting beyond the footing, and providing this modification is made at no additional cost to the state. Pay quantities to remain the same as shown on the standard plans.

GENERAL NOTES:


- Workmanship and materials shall conform to City of Albuquerque Standards.
- All concrete shall be Class "A", Class exposed edges 3/4".
- All reinforcing steel shall be deformed bars, intermediate grade, conforming to AASHTO Specifications M-31 and M-137. Dimensions refer to 6 of bar.
- Wing walls are to be cast monolithic with barrel.
- Estimated quantities for each end of box culvert.
Reinforcing Steel: 314 lb.
Concrete: 2.76 cu yd.
- Payment shall be based upon quantity of concrete. Steel reinforcing shall be considered incidental to the concrete pay item and no payment shall be made for steel reinforcing.

Concrete Class	*Minimum Design Compressive Strength 28 Days	**Minimum Cement per Cu. Yd.		Maximum Water Content Per Bag of Cement	Consistency (Vibrated) Slump AASHTO T 119 in.	Size of Coarse Aggregate U.S. Customary	Approximate Aggregate Weights lb/94 lb Bag of Cement	
		psi	lb.	hgs			Fin (1)	Coarse (2)
A	3 000	564	6.0	6.0	2-4	1" - #4	185	317
B	3 000	564	6.0	6.0	2-4	1 1/2" - #4	185	320
C	3 000	611	6.5	6.0	2-4	2" - #4	200	443
D	4 000	658	7.0	5.5	1-3	3/4" - #4	172	238

*Not to be considered specification requirements.
**Concrete will be designed and the cement content increased to meet or exceed minimum values.

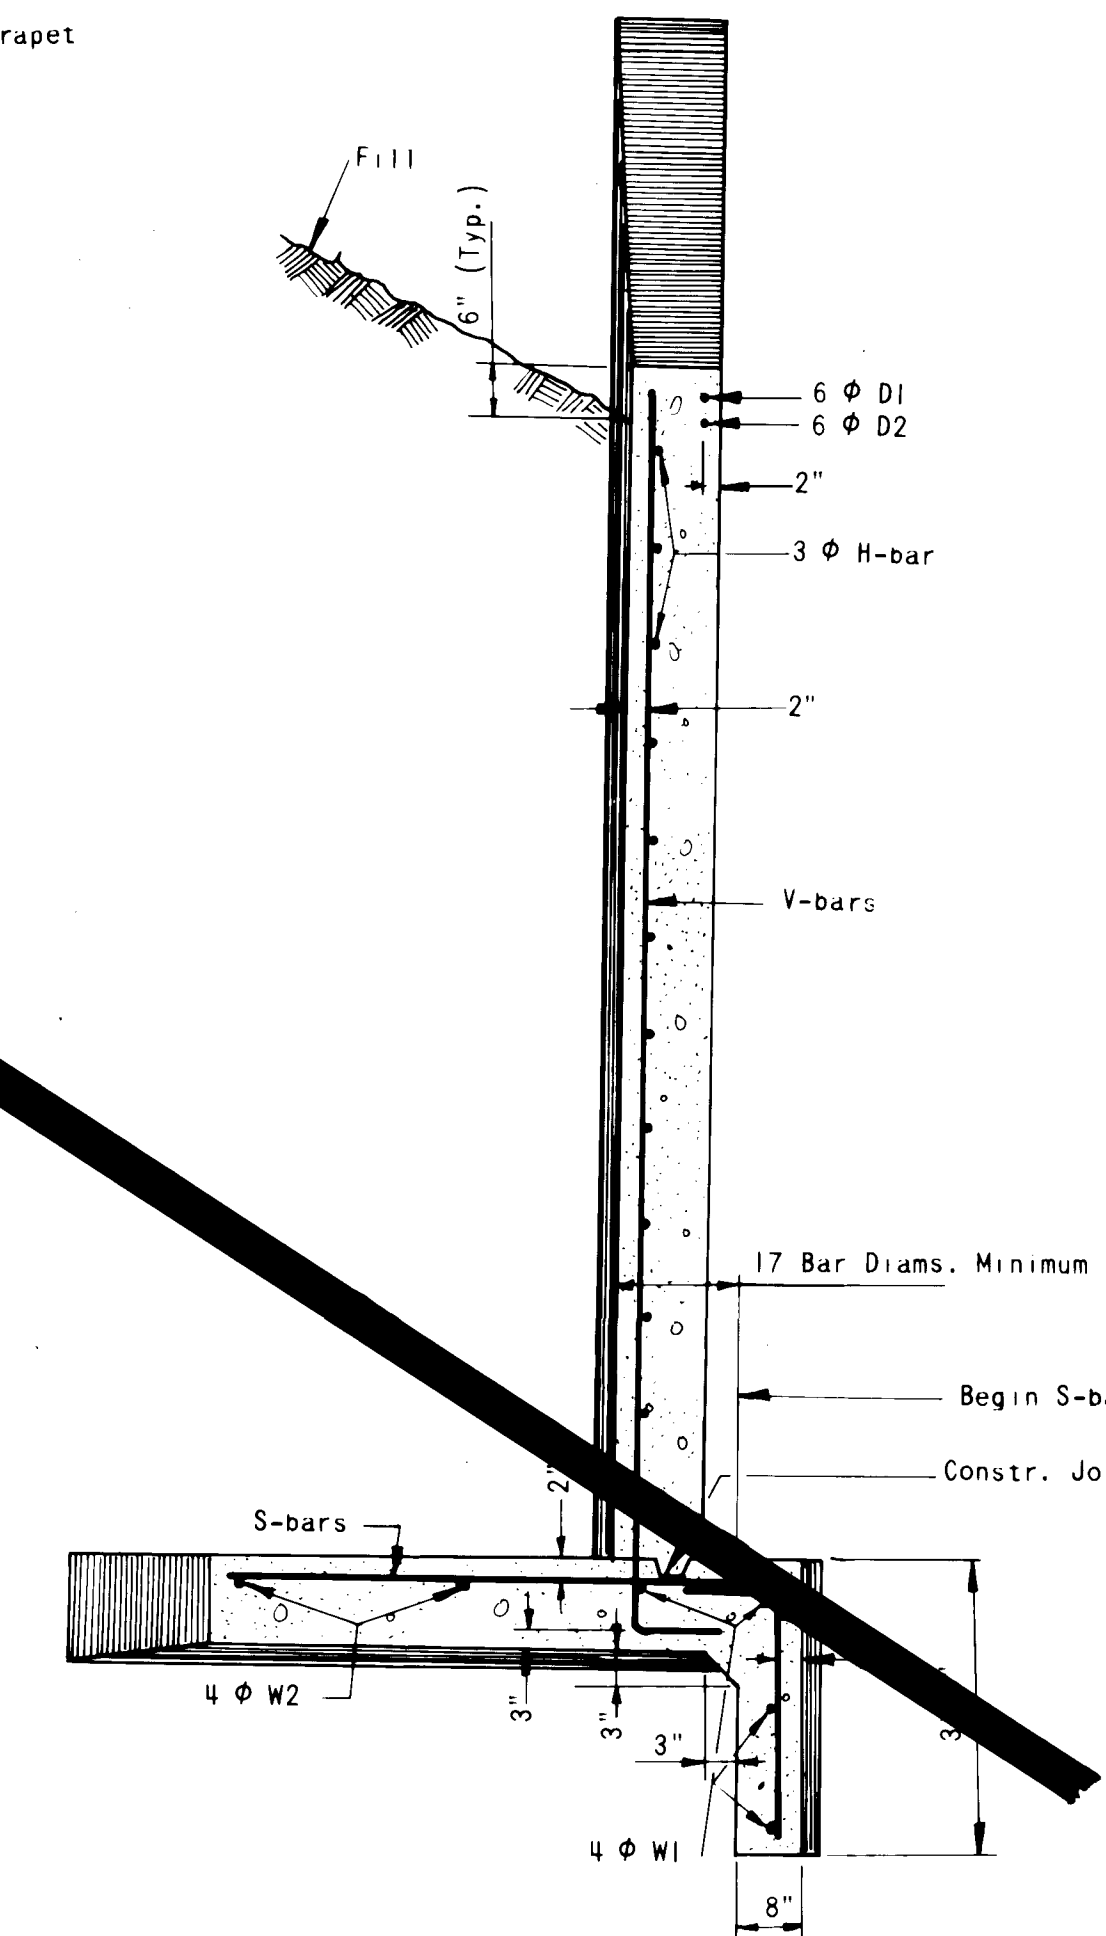


SECTION BB

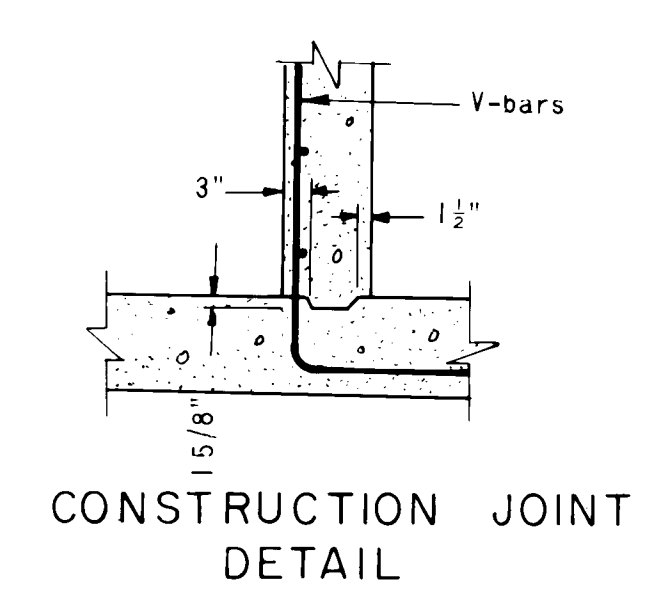

CONSTRUCTION JOINT DETAIL

AS-BUILT INFORMATION				BENCH MARKS				SURVEY INFORMATION				REFERENCES				REVISIONS			
CONTRACTOR				THE STATION IS A STANDARD ACS				MAP NO C-17				EST NO				NO. DATE			
WORK STARTED BY				BRASS TABLET, STAMPED "B-C17, 1975"				BY				W.O. NO				REMARKS			
ACCEPTED BY				CEMENTED IN A DRILL HOLE IN				DATE								BY			
FIELD CHECKED BY				TOP OF THE WEST CONCRETE CURB												NO. DATE			
DRAWING CORRECTED BY				0.3 MILE NORTH OF LOS ANGELES BLVD.												REVISIONS			
MICRO-FILM INFORMATION				ON WASHINGTON ST.												DESIGN			
RECORDED BY				ELEV. = 5111.029												DESIGNED BY DWG DATE 9 / 82			
NO.																DRAWN BY PE DATE 9 / 82			
																CHECKED BY DMYM DATE 9 / 82			


26 1564 2584

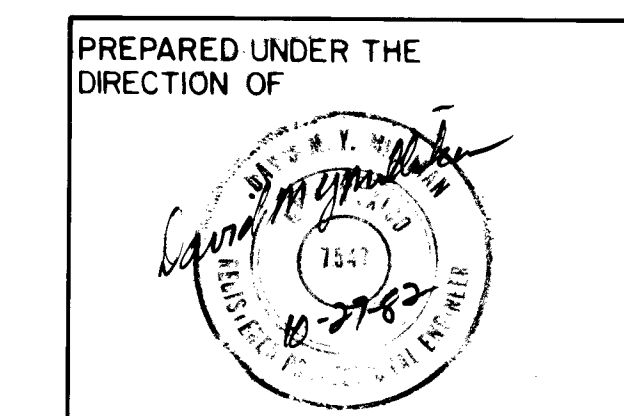

CITY OF ALBUQUERQUE MUNICIPAL DEVELOPMENT DEPARTMENT ENGINEERING DIVISION				TITLE: CLIFFORD INDUSTRIAL PARK-PHASE I SWALE A-OUTLET STRUCTURE WING WALLS			
APPROVALS	ENGINEER	DATE	APPROVALS	ENGINEER	DATE	APPROVALS	ENGINEER
City Engineer	<i>[Signature]</i>	12/2/82	Liquid Waste	<i>[Signature]</i>	12/2/82		
A.C.E.-Design	<i>[Signature]</i>	12/2/82	Traffic	<i>[Signature]</i>	12/2/82		
A.C.E.-Hydrology	<i>[Signature]</i>	12/2/82	Water	<i>[Signature]</i>	12/2/82		
A.M.A.F.C.A.							
DRAWING NO.	1564		SHEET	25	OF	27	


SCALE: NONE

APPROVED FOR CONSTRUCTION
CITY ENGINEER
DATE 12/2/82
MA for G.W. 8/11/83

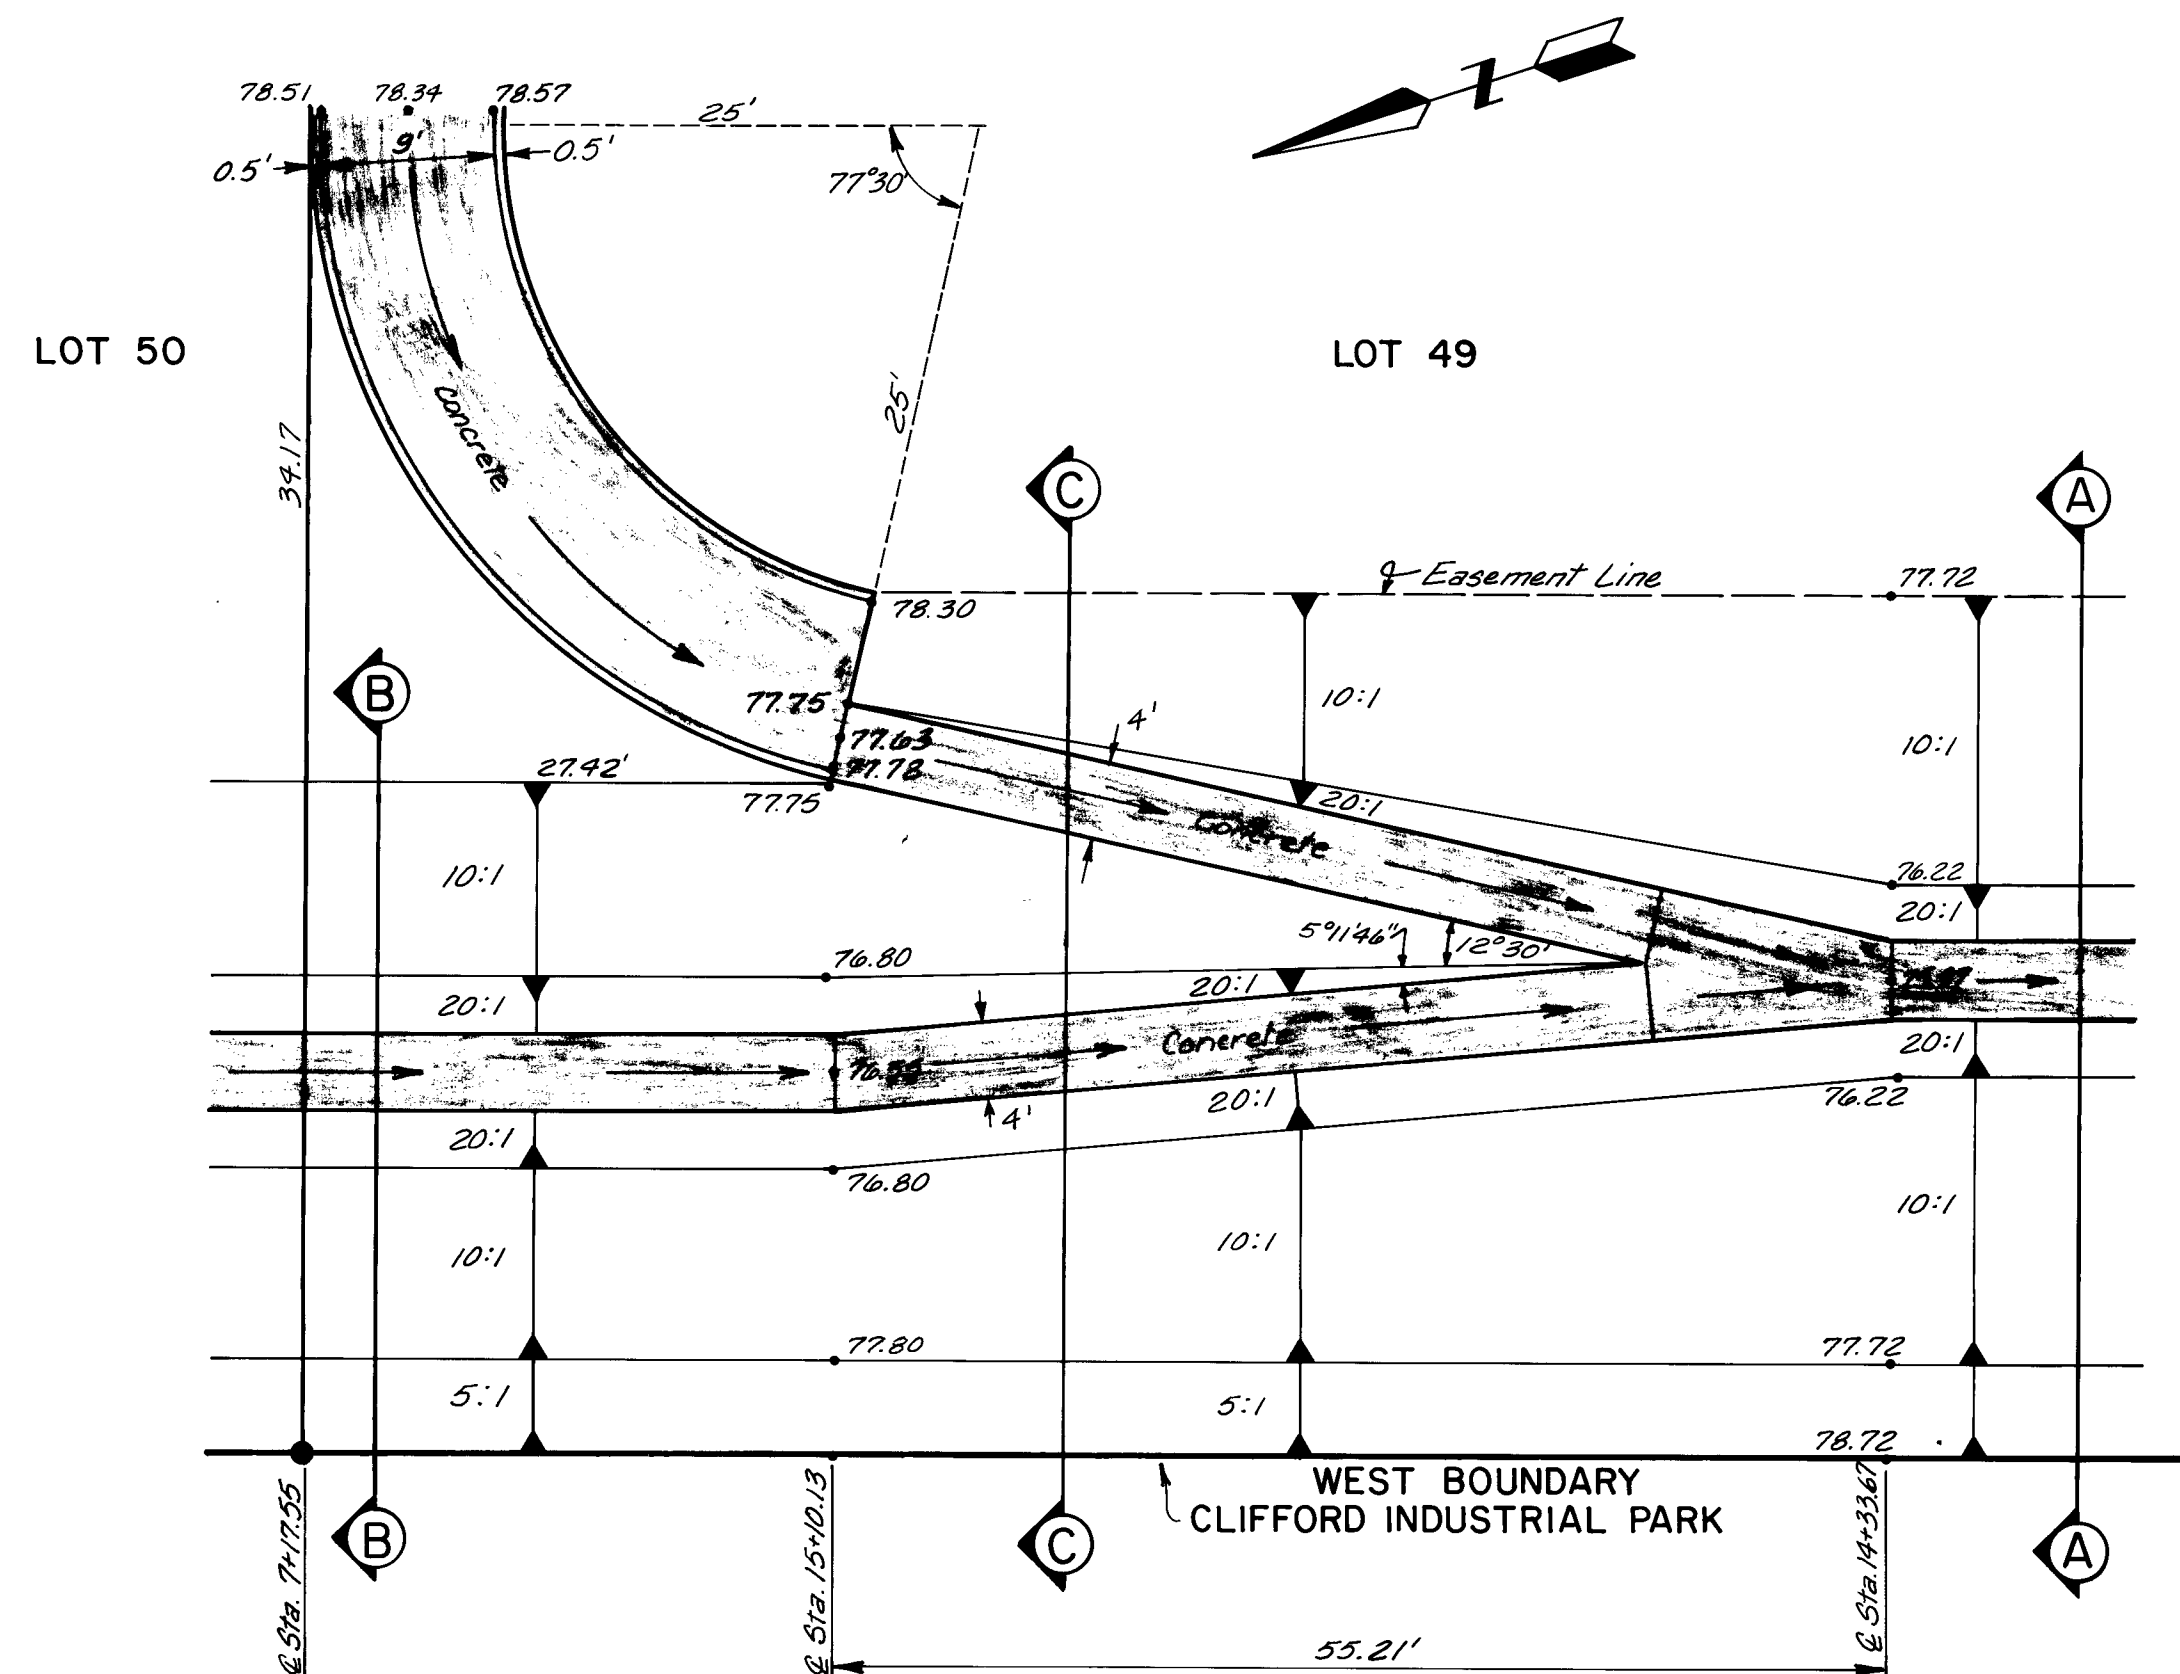

LOT 49 CONFLUENCE DETAIL


SCALE: 1" = 10'

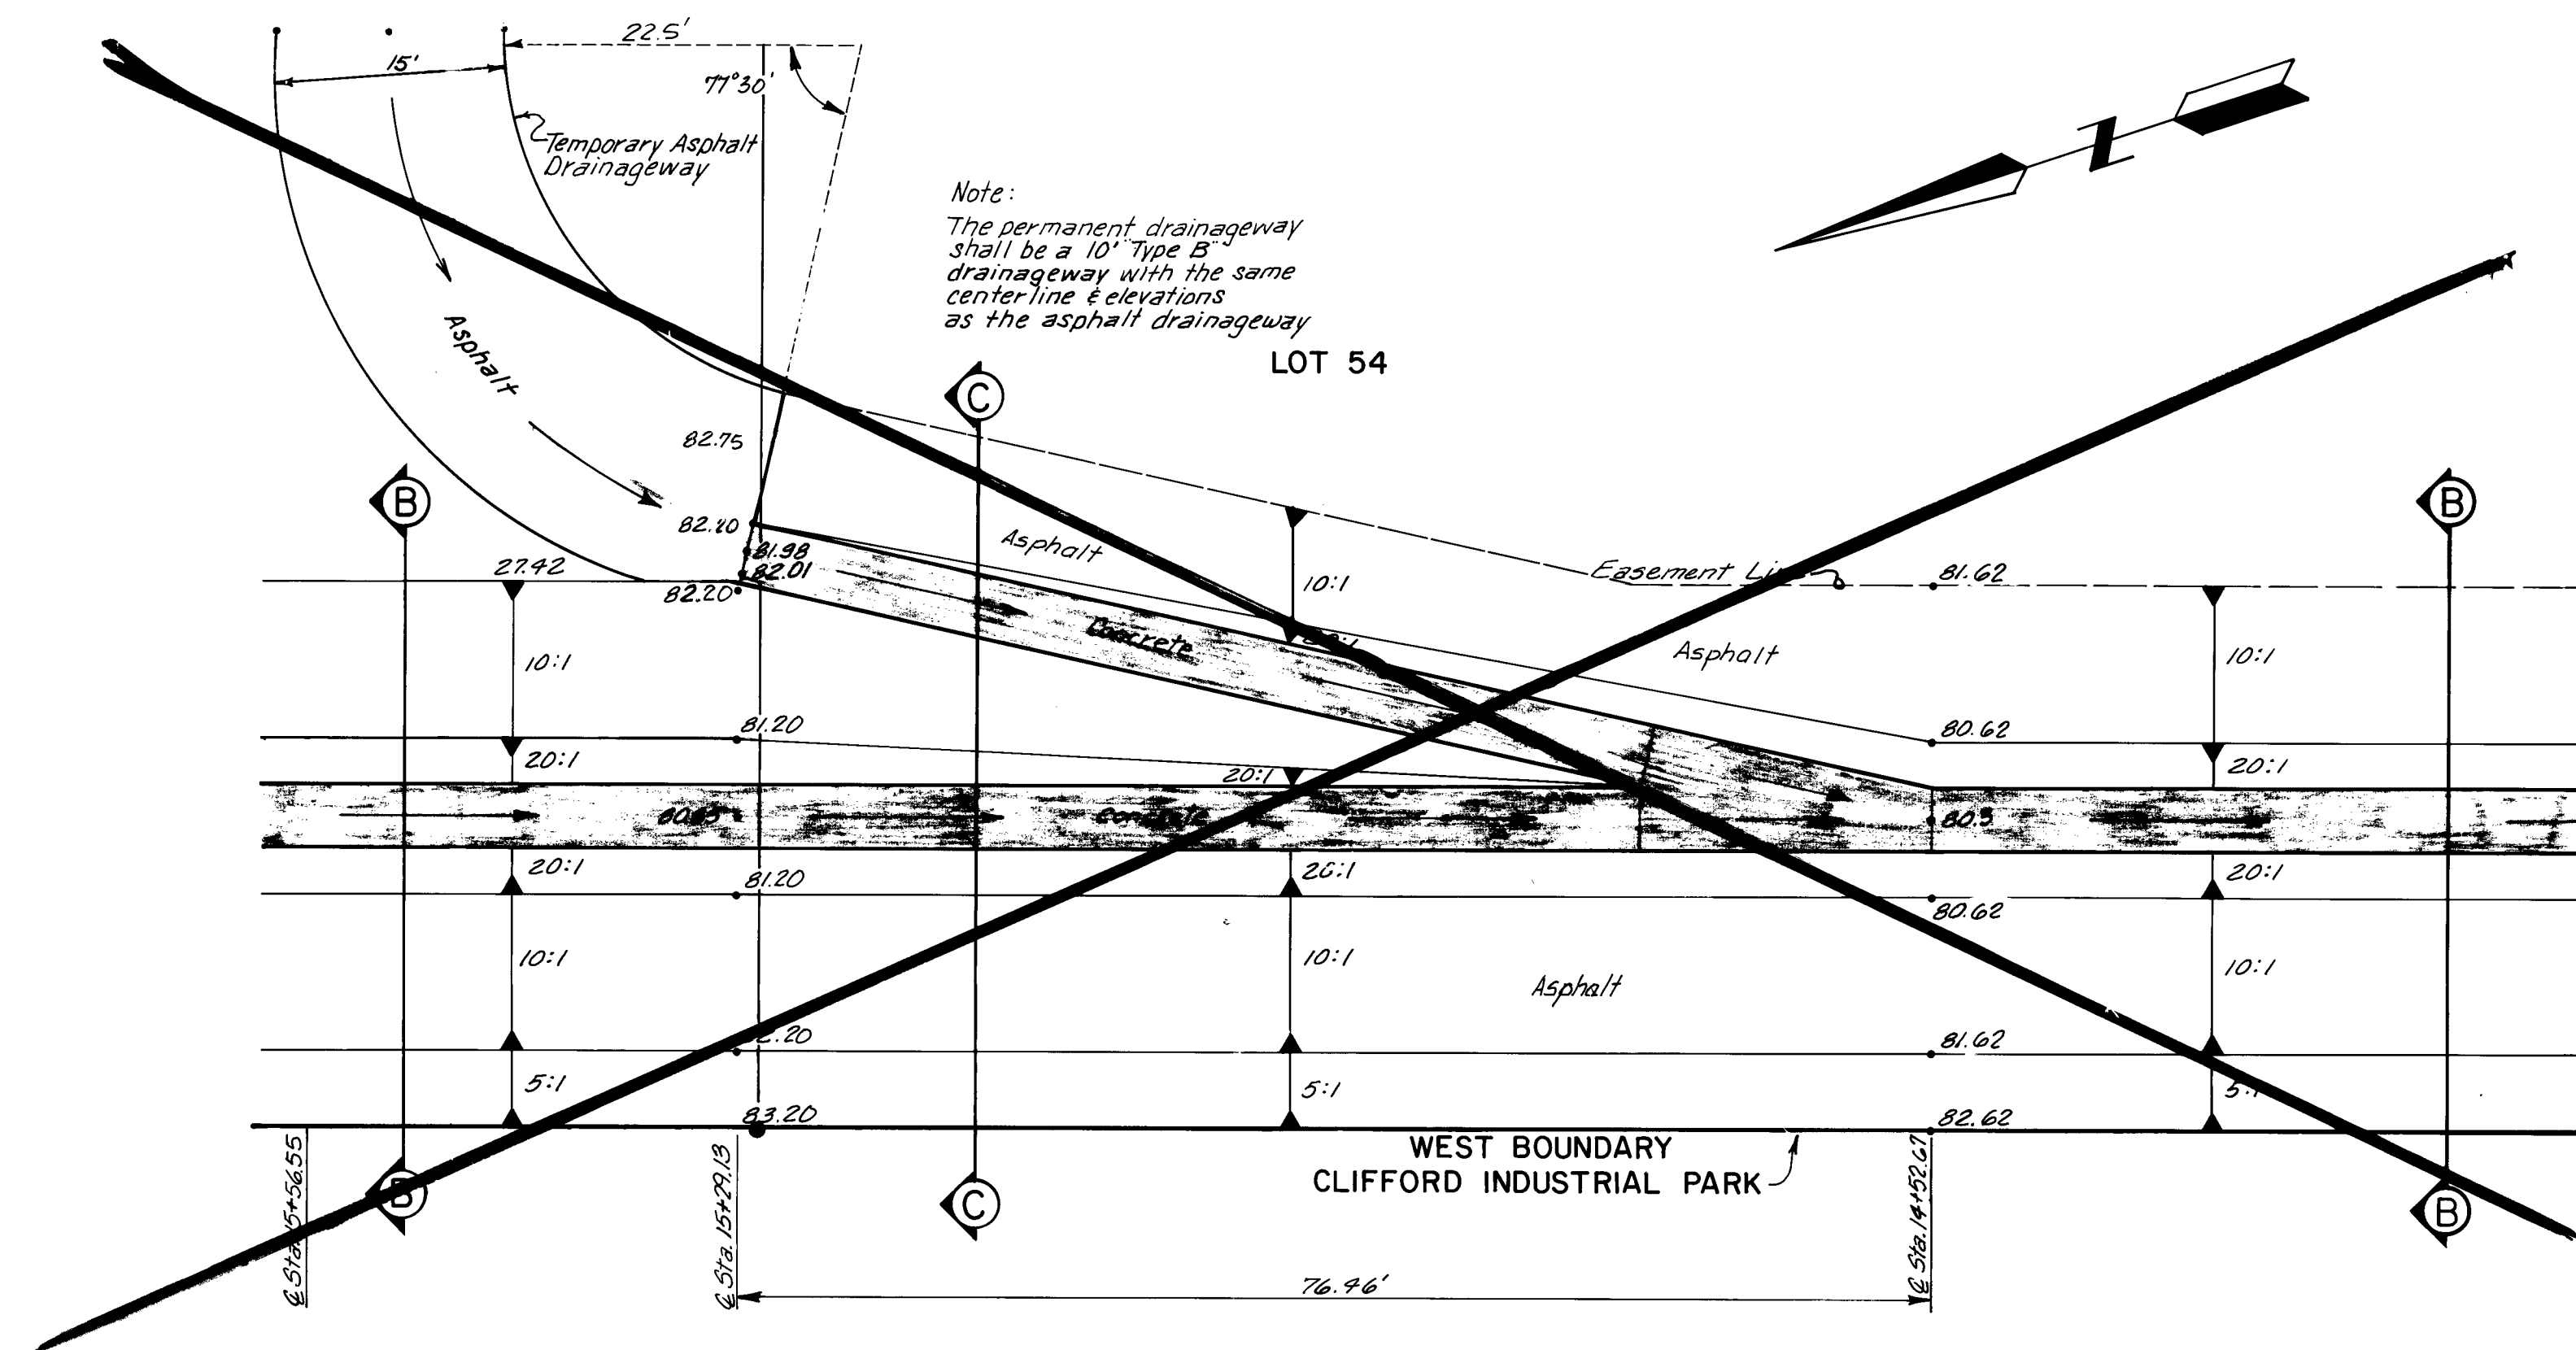

LOT 54 CONFLUENCE DETAIL


SCALE: 1" = 10'

TO BE CONSTRUCTED WITH PROJECT 1625

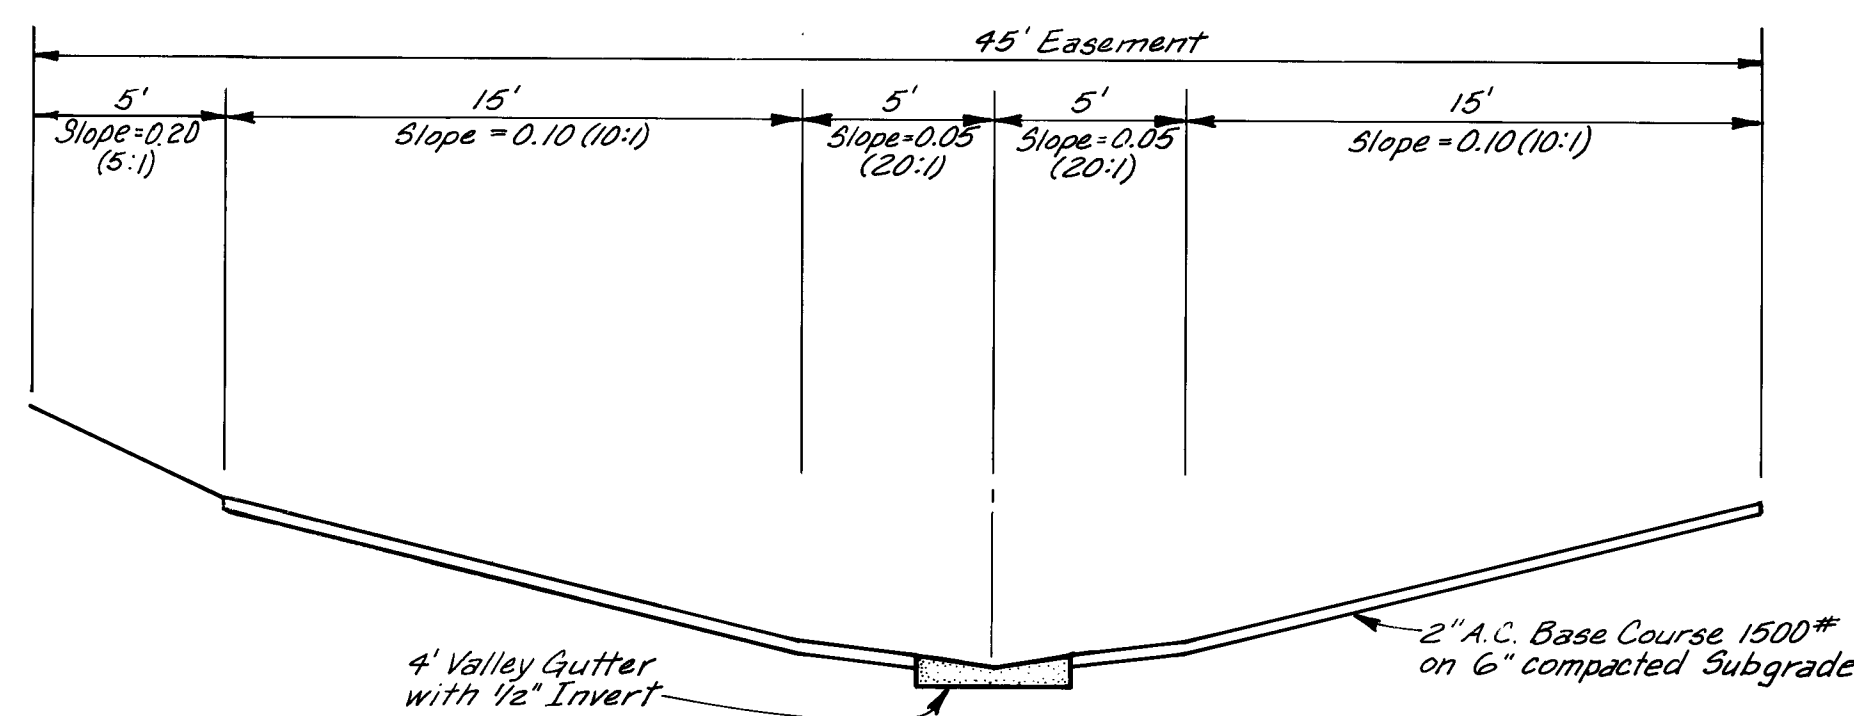


SECTION A-A

SCALE: 1" = 5' HOR.
1" = 2' VERT.

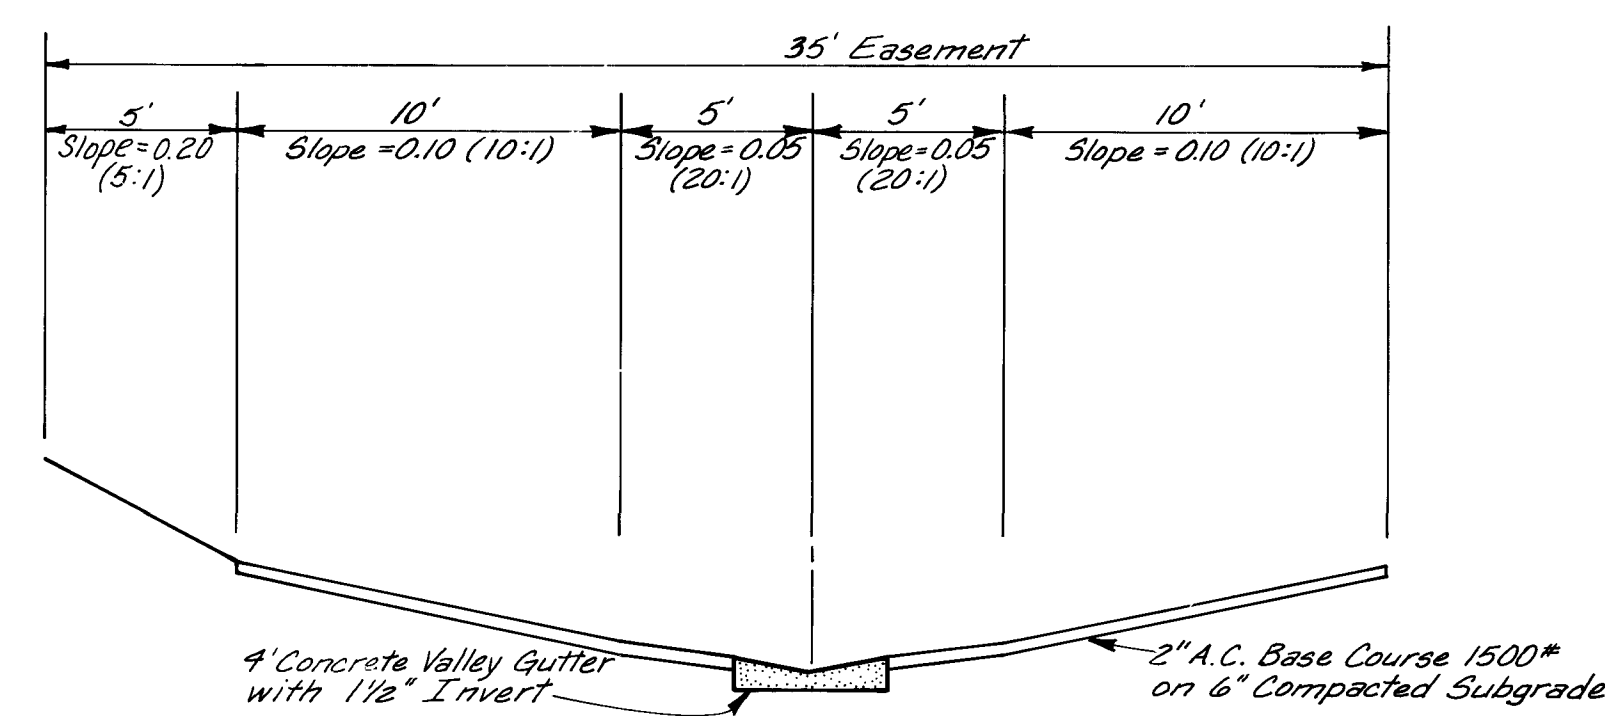

SECTION B-B

SCALE: 1" = 5' HOR.
1" = 2' VERT.

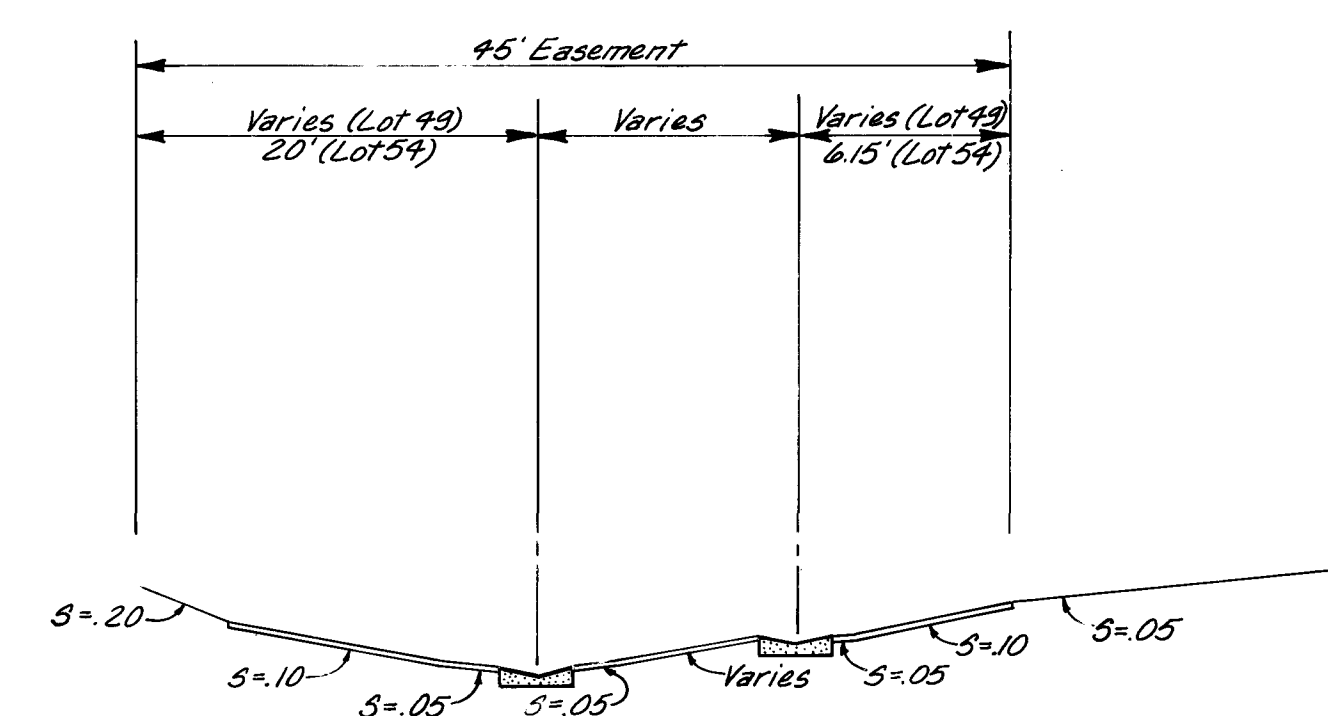

SECTION C-C

SCALE: 1" = 10' HOR.
1" = 5' VERT.

AS-BUILT INFORMATION			BENCH MARKS			SURVEY INFORMATION			REFERENCES			REVISIONS			DESIGN		
CONTRACTOR	WORK BY	DATE	CONTRACTOR	WORK BY	DATE	MAP NO.	EST. NO.	W/O NO.	BY	DATE	NO.	DATE	NO.	DATE	NO.	DATE	NO.
	INSPECTOR	DATE		INSPECTOR	DATE												
	ACCEPTANCE BY	DATE		ACCEPTANCE BY	DATE												
	VERIFICATION BY	DATE		VERIFICATION BY	DATE												
	DRAMA	DATE		DRAMA	DATE												
	COLLECTED BY	DATE		COLLECTED BY	DATE												
	RECORDED BY	DATE		RECORDED BY	DATE												
	NO.			NO.													

PREPARED UNDER THE DIRECTION OF

David M. Miller
10-27-83

CITY OF ALBUQUERQUE
MUNICIPAL DEVELOPMENT DEPARTMENT
ENGINEERING DIVISION

TITLE: CLIFFORD INDUSTRIAL PARK-PHASE I
CONFLUENCE DETAILS

APPROVALS	ENGINEER	DATE	APPROVALS	ENGINEER	DATE
City Engineer	<i>E. D. Thompson</i>	10/27/83	Liquid Waste	<i>N. A. Jones</i>	7/17/83
A.C.E.-Design	<i>E. D. Thompson</i>	10/27/83	Traffic	<i>N. A. Jones</i>	7/17/83
A.C.E.-Hydrology	<i>E. D. Thompson</i>	10/27/83	Water	<i>N. A. Jones</i>	7/17/83

APPROVED FOR CONSTRUCTION

E. D. Thompson 10/27/83


CITY ENGINEER DATE

DRAWING NO. 1564


SHEET 26 OF 27

SCALE
AS SHOWN


REFERENCE 1625

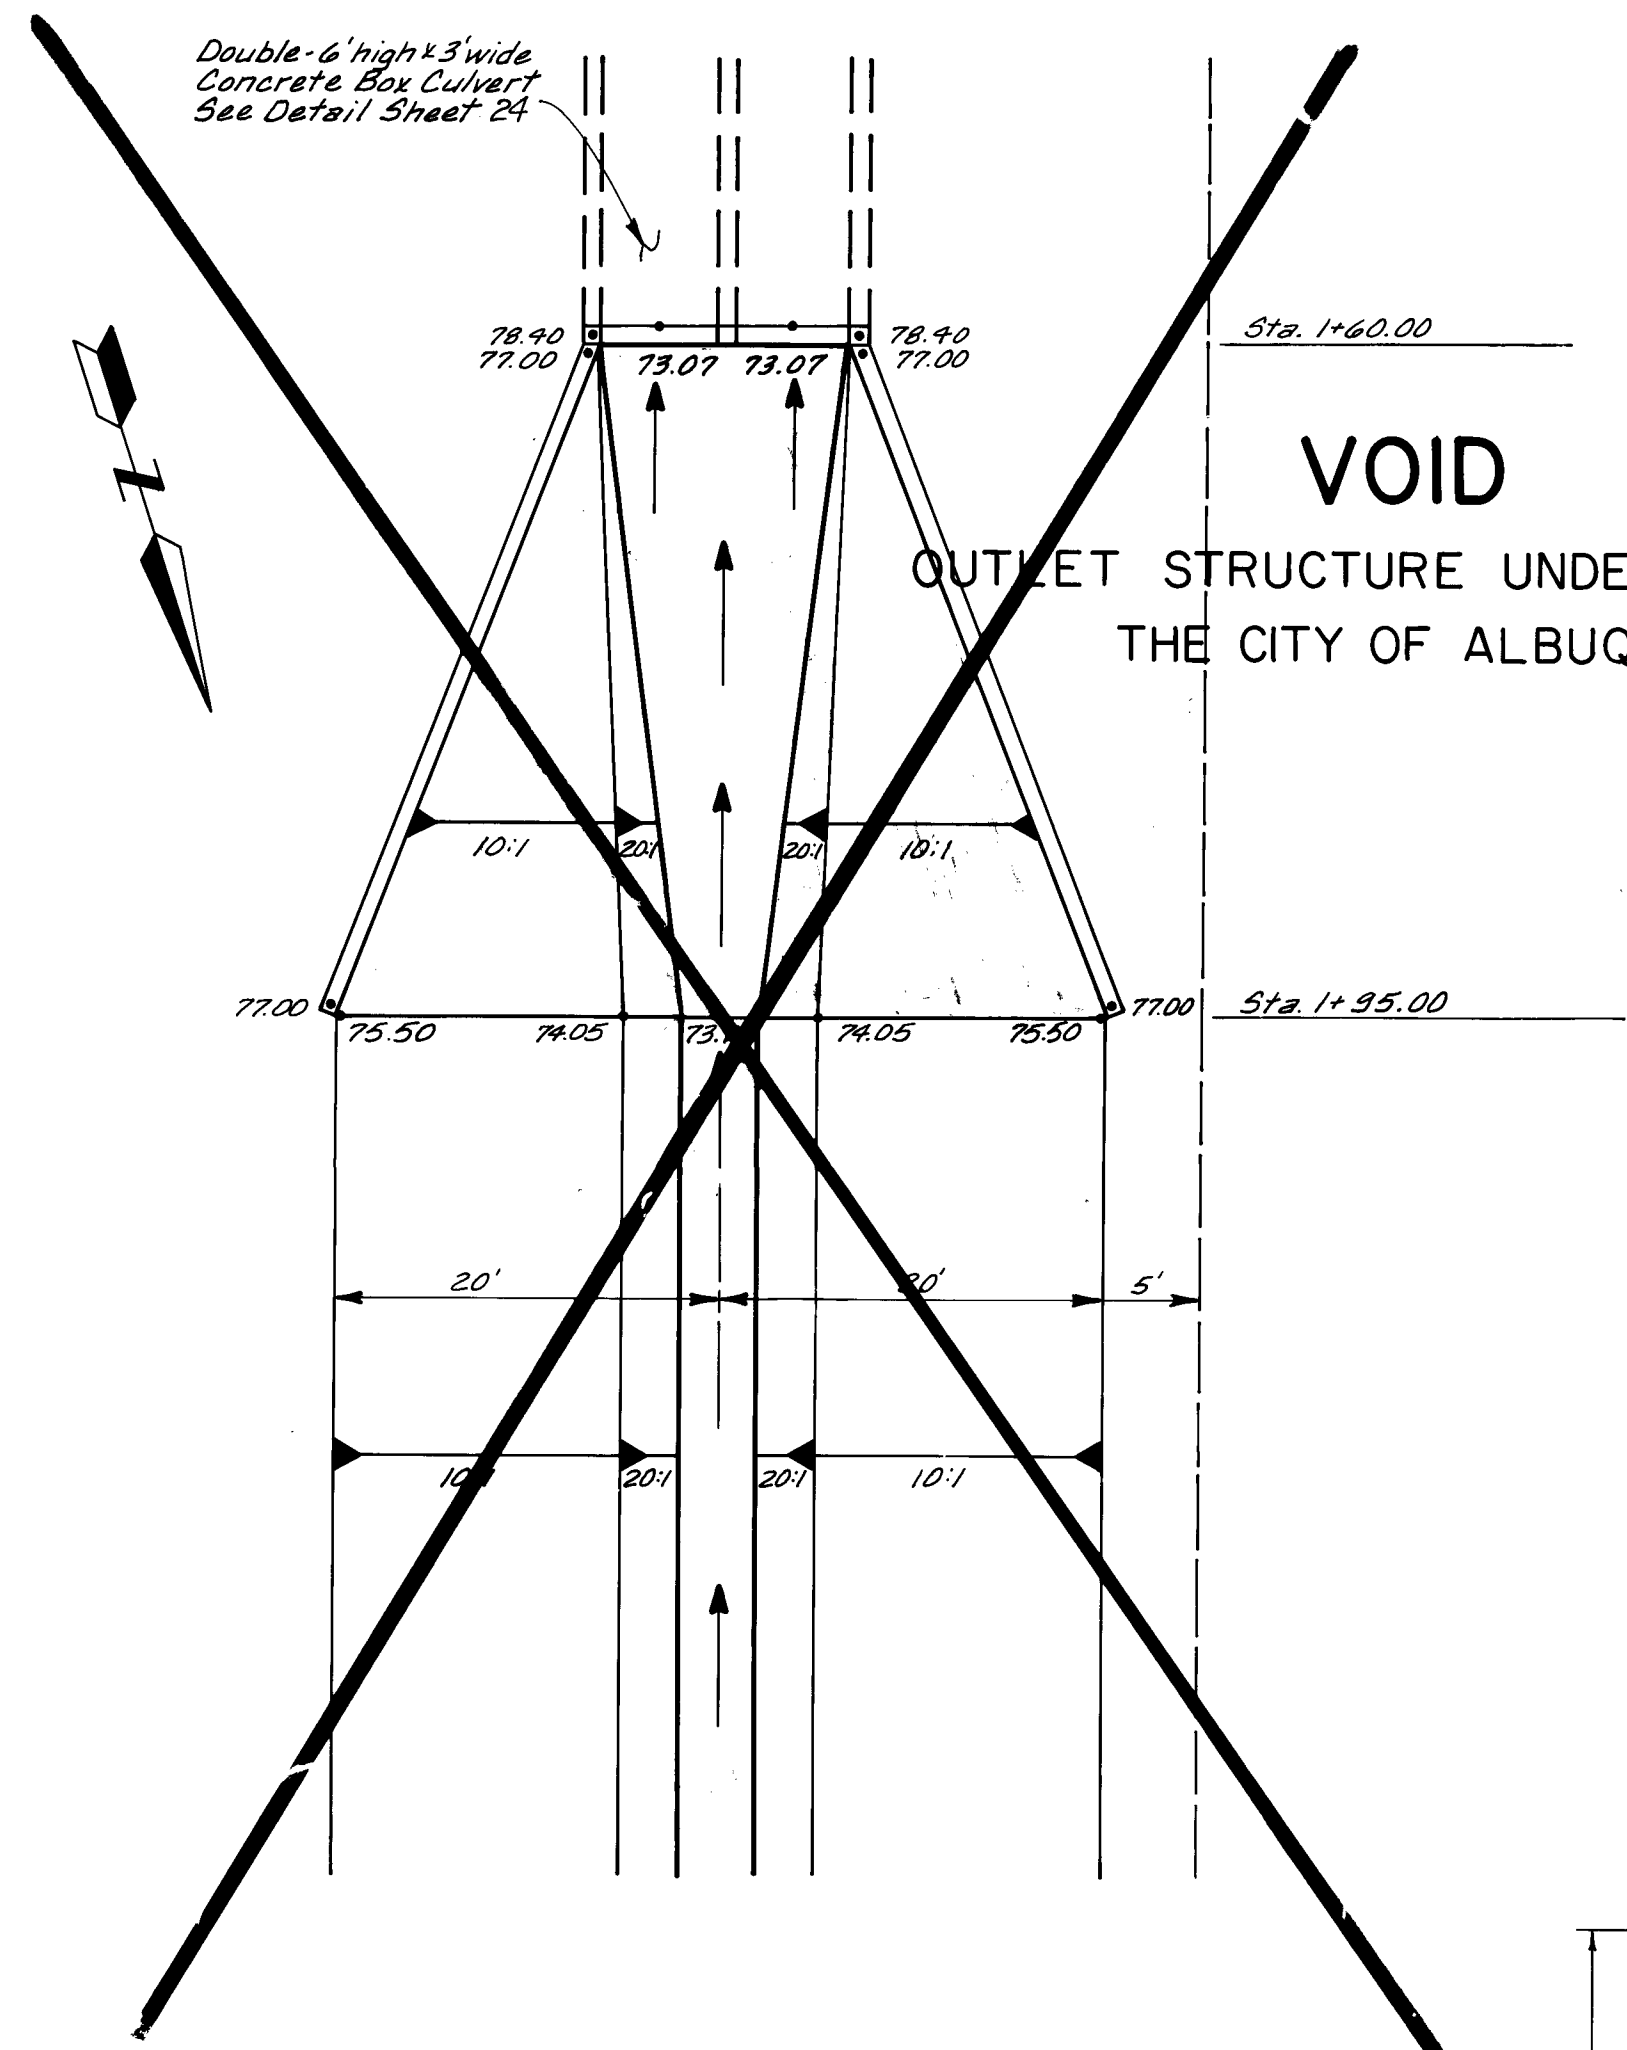


CONCRETE TRANSITION DETAIL
SCALE: 1"=10'

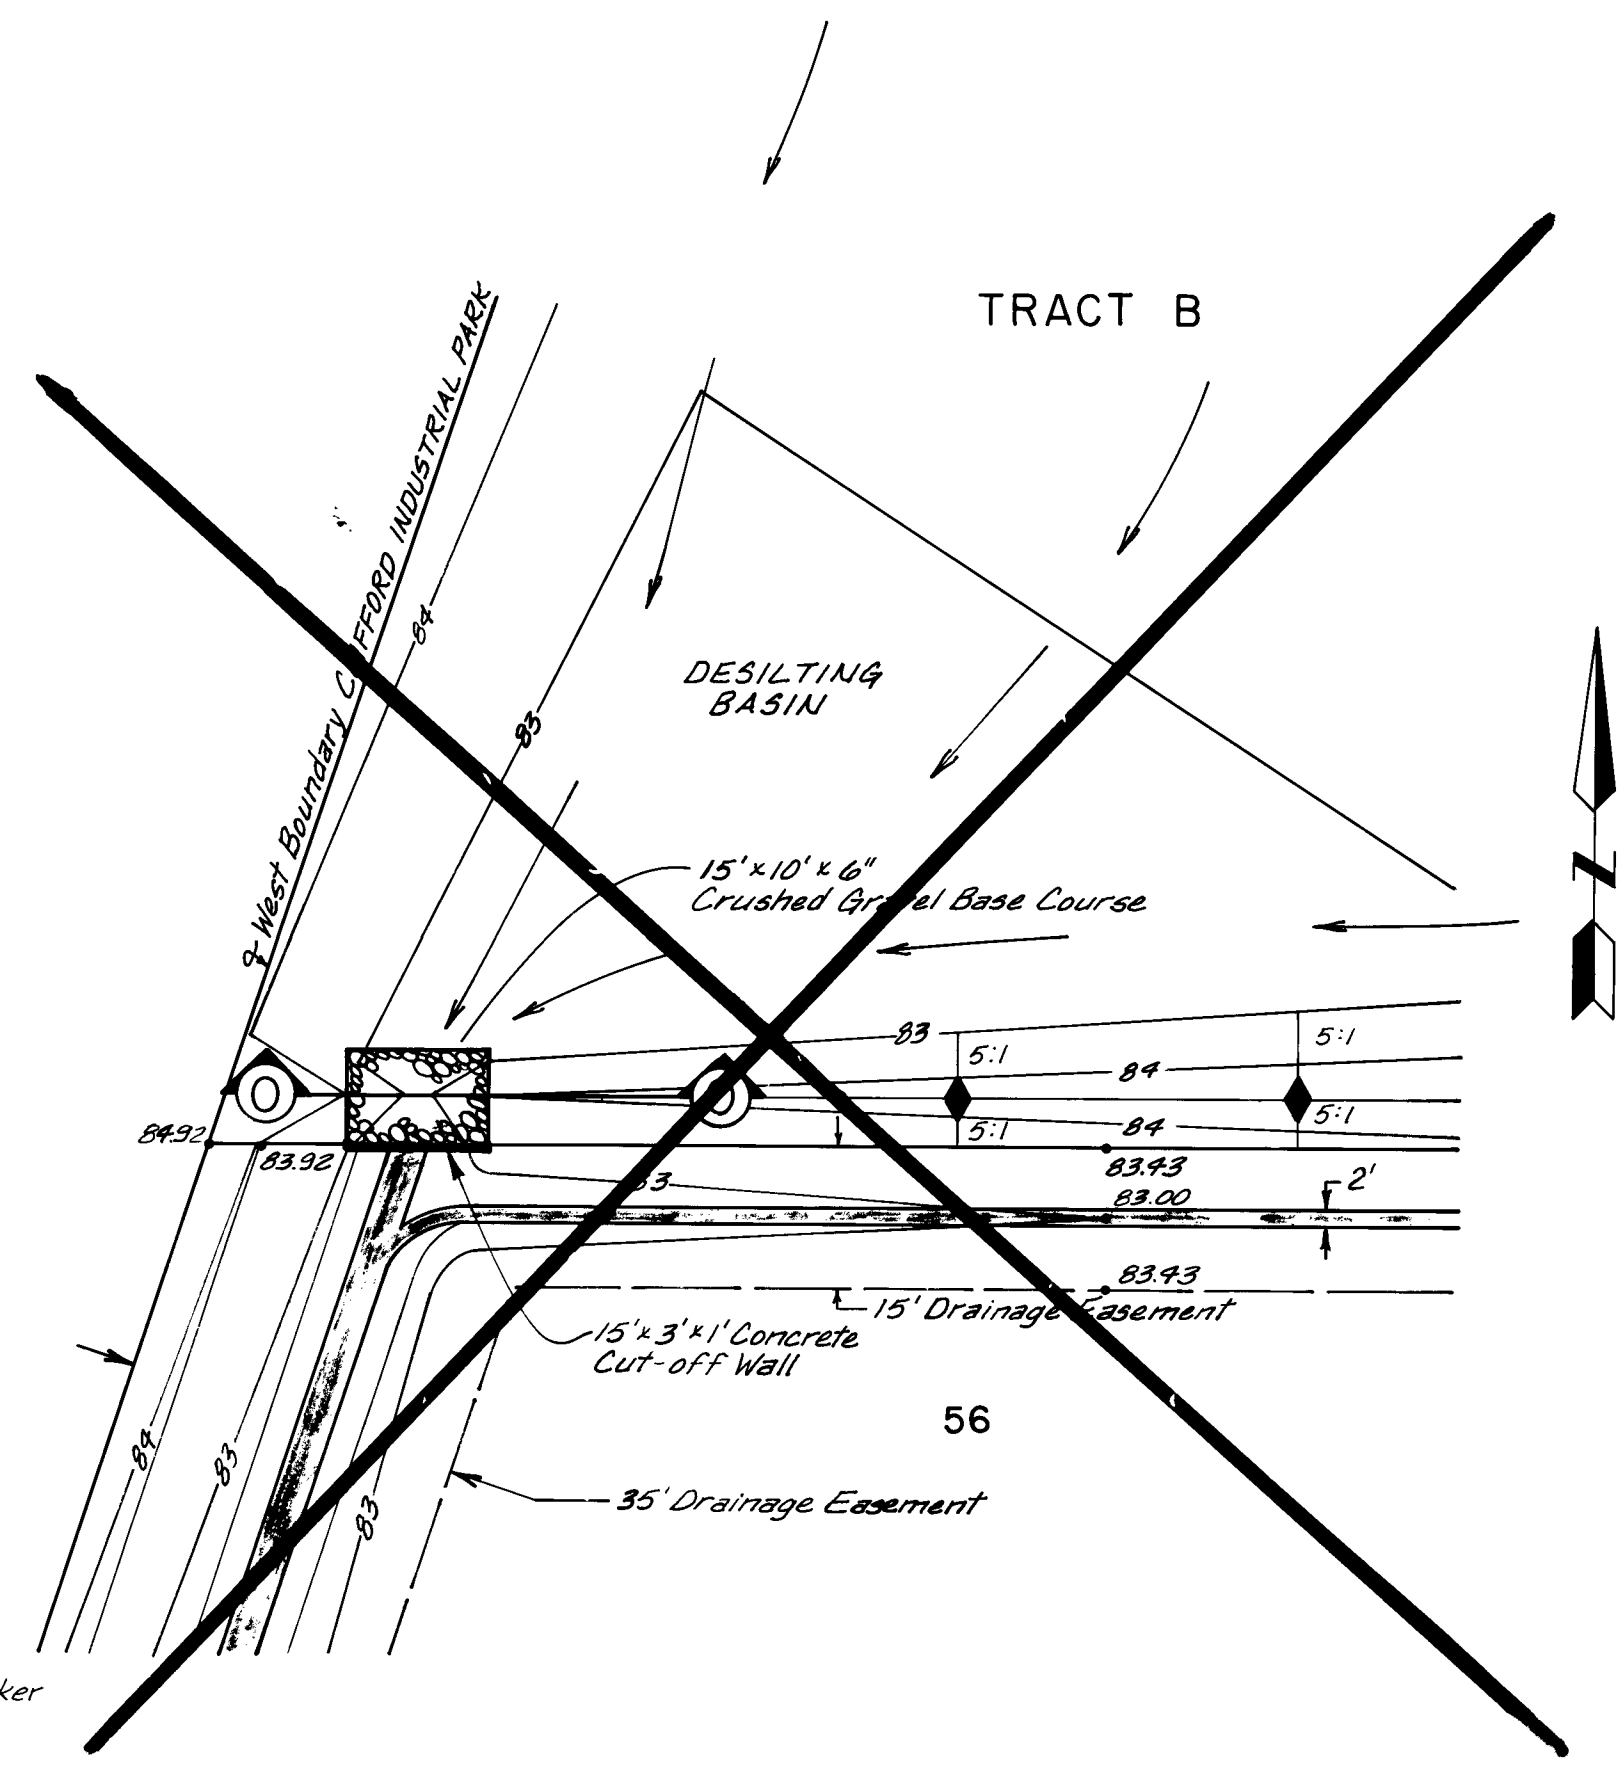


DESILTING BASIN DETAIL
SCALE: 1"=20'

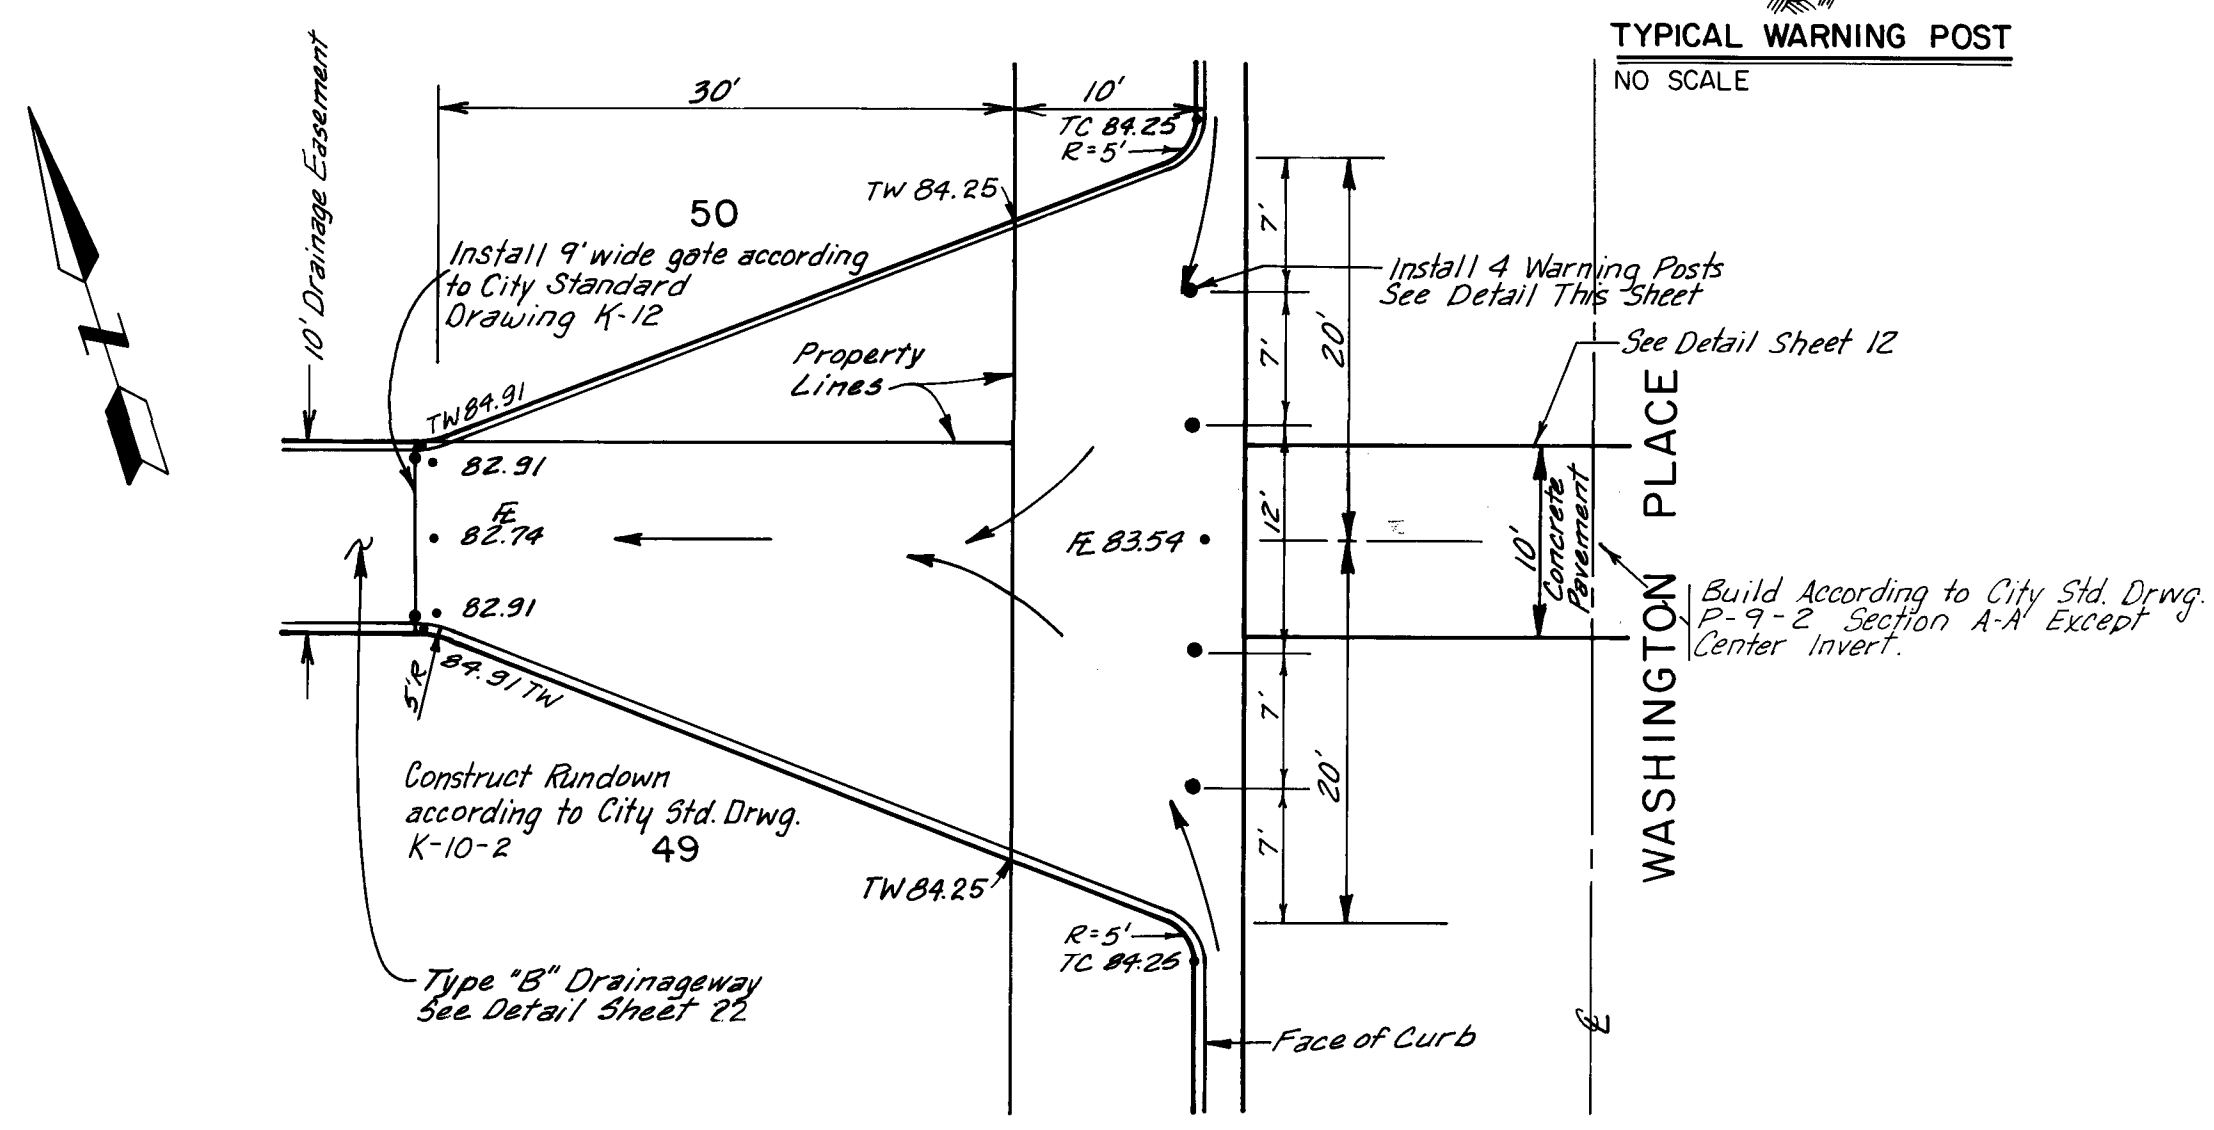


LOT 49 RUNDOWN DETAIL
SCALE: 1"=10'

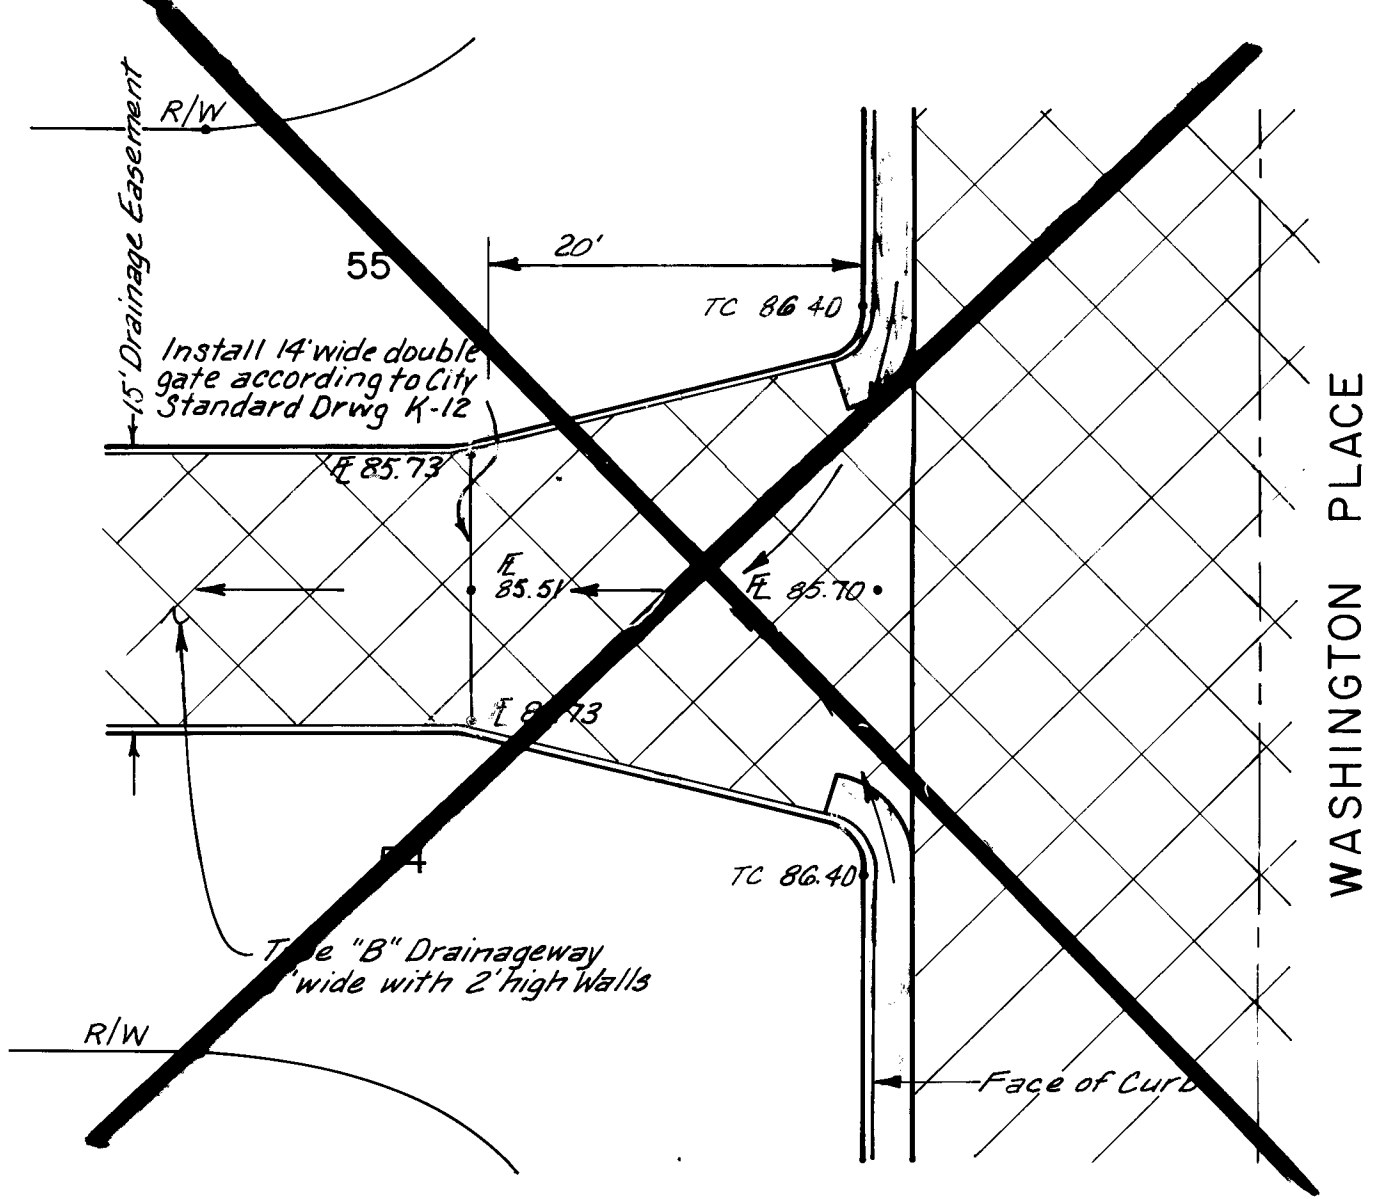

LOT 55 RUNDOWN DETAIL
SCALE: 1"=10'

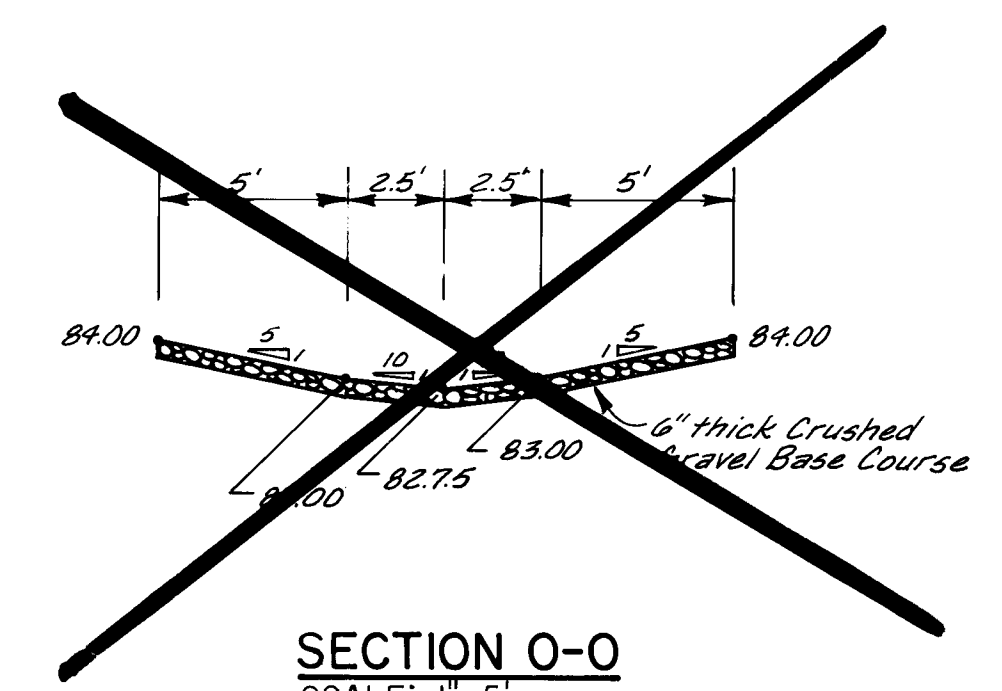

SWALE A OUTLET STRUCTURE DETAIL
SCALE: 1"=10'

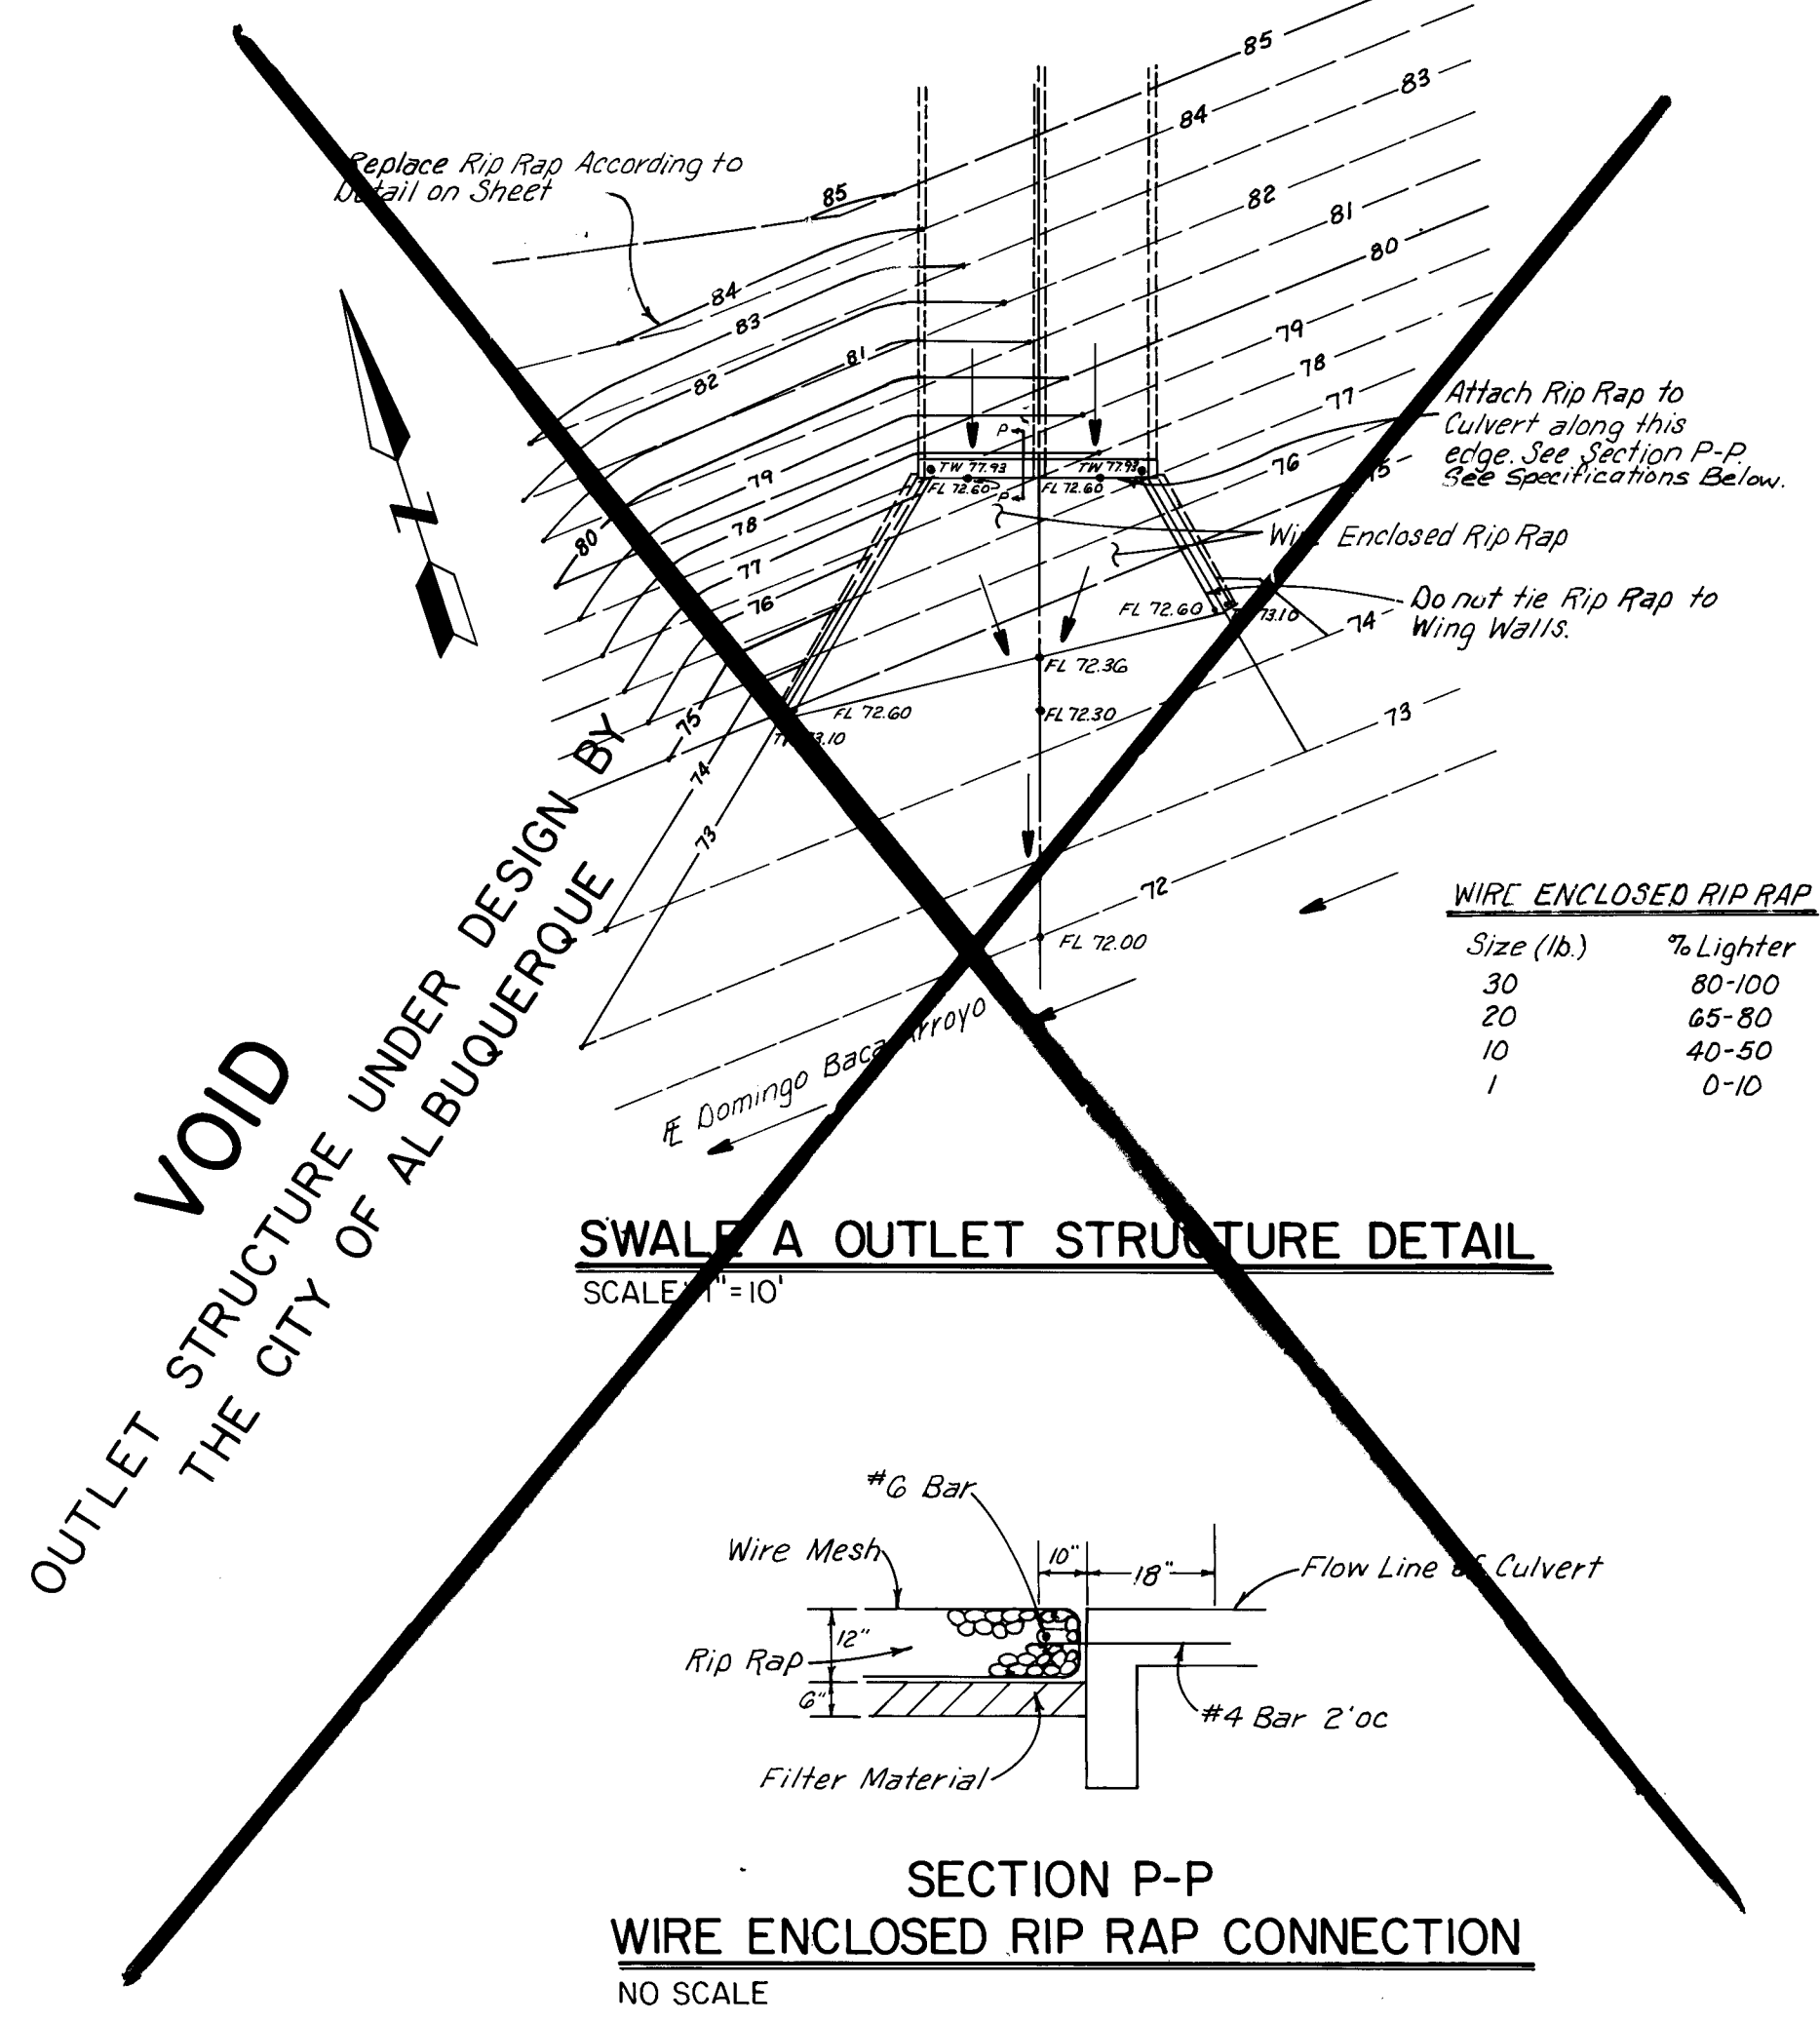

SECTION P-P
WIRE ENCLOSED RIP RAP CONNECTION
NO SCALE

AS-BUILT INFORMATION		BENCH MARKS		SURVEY INFORMATION		REFERENCES		REVISIONS		DESIGN	
CONTRACTOR	DATE	THE STATION IS A STANDARD ACS	DATE	MAP NO. C-17	W.O. NO.	EST. NO.	BY	NO.	DATE	DESIGNED BY	DATE
WORK	DATE	BRASS TABLET, STAMPED "8-CIT, 1975"	DATE							DRAWN BY	DATE
INSPECTOR'S	DATE	CEMENTED IN A DRILL HOLE IN TOP	DATE							CHECKED BY	DATE
ACCEPTANCE BY	DATE	OF THE WEST CONCRETE CURB 0.3	DATE								
VERIFICATION BY	DATE	MILE NORTH OF LOS ANGELES BLVD.	DATE								
LOGGING	DATE	ON WASHINGTON ST.	DATE								
CONTRACT	DATE	ELEV. = 5111.029	DATE								
MICRO-FILM INFORMATION											
NO.	DATE										

PREPARED UNDER THE DIRECTION OF		CITY OF ALBUQUERQUE MUNICIPAL DEVELOPMENT DEPARTMENT ENGINEERING DIVISION	
TITLE: CLIFFORD INDUSTRIAL PARK-PHASE I DRAINAGE DETAILS			
APPROVALS	ENGINEER	DATE	APPROVALS
City Engineer	<i>C. A. Shupard</i>	12/13/83	Liquid Waste
A.C.E.-Design	<i>C. A. Shupard</i>	12/13/83	Traffic
A.C.E.-Hydrology	<i>C. A. Shupard</i>	12/13/83	Water
APPROVED FOR CONSTRUCTION		DATE	
<i>C. A. Shupard</i>		12/13/83	
CITY ENGINEER		DATE	
DRAWING NO.		1564	
SHEET		27 OF 27	

TO BE CONSTRUCTED WITH PROJECT 1625