



SEWER & WATER REPLACEMENT III GARFIELD DRIVE

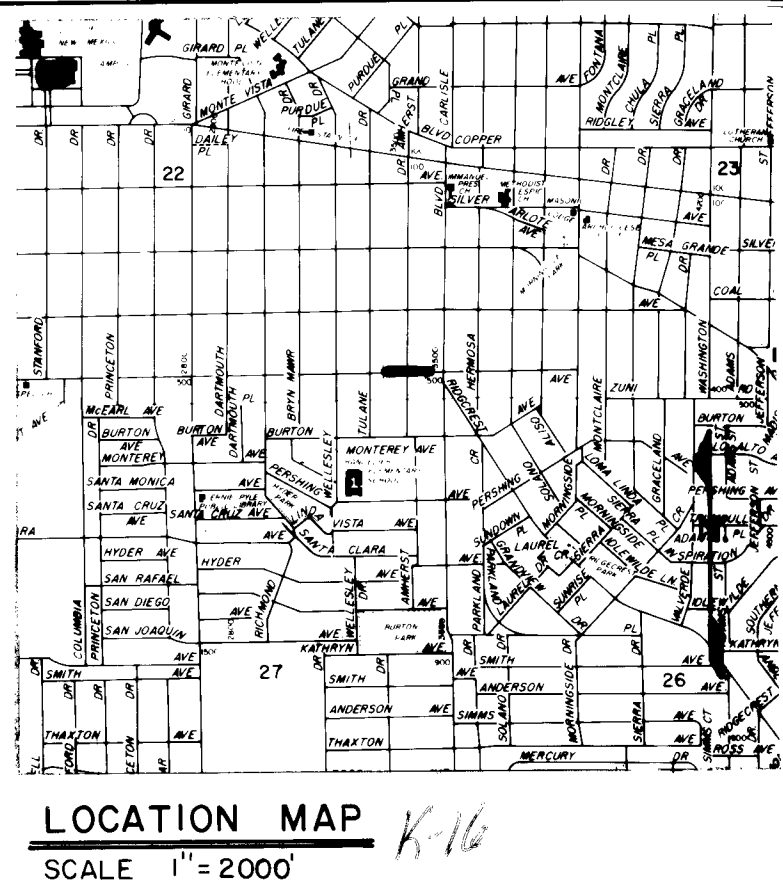

6" WATERMAIN AMHERST-CARLISLE S.E.
8" WATERMAIN - GARFIELD DRIVE SE.
8" SANITARY SEWER-GARFIELD DRIVE SE.

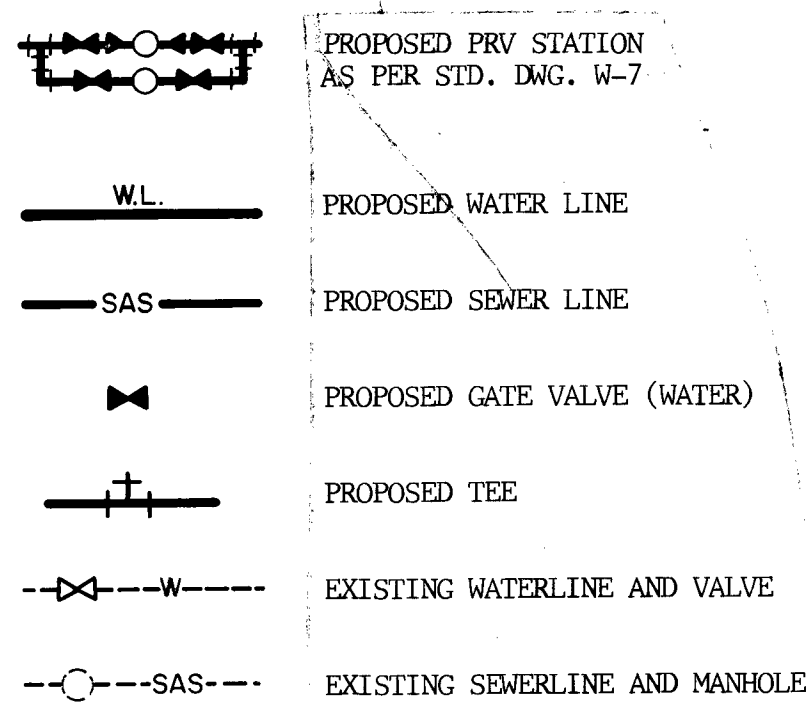


SEPTEMBER 1982

GENERAL NOTES

1. WATER AND SEWER LINE CONSTRUCTION SHALL COMPLY WITH THE CITY OF ALBUQUERQUE "CONTRACT DOCUMENTS FOR CITY-WIDE UTILITIES AND CASH PAVING #31" AND THE NEW MEXICO STANDARD SPECIFICATIONS FOR PUBLIC WORKS CONSTRUCTION 1979 EDITION.
2. THE LOCATION OF ALL EXISTING UTILITIES, AS SHOWN ON THE DRAWINGS, ARE APPROXIMATE LOCATIONS. THE CONTRACTOR SHALL BE RESPONSIBLE FOR MAKING FINAL UTILITY LOCATION DETERMINATION IN THE FIELD DURING CONSTRUCTION.
3. THE CONTRACTOR SHALL NOTIFY ALL UTILITY COMPANIES BY CALLING "BLUESTAKES" AT 765-1234 AT LEAST 48 WORKING HOURS PRIOR TO COMMENCING WORK.
4. THE CONTRACTOR SHALL BE RESPONSIBLE FOR PROTECTING AND MAINTAINING IN SERVICE ALL EXISTING UTILITIES.
5. A DISPOSAL SITE FOR ALL EXCESS EXCAVATION MATERIALS SHALL BE OBTAINED BY THE CONTRACTOR AND APPROVED BY THE ENGINEER. ALL COSTS INCURRED IN OBTAINING A DISPOSAL SITE, HAULING THERETO AND PROPER DISPOSAL THEREOF SHALL BE CONSIDERED INCIDENTAL TO CONSTRUCTION AND NO DIRECT PAYMENT WILL BE MADE THEREFOR.
6. WRAP ALL BENDS, TEES, AND OTHER FITTINGS WITH POLYETHYLENE.
7. WATER SYSTEMS DIVISION SHALL BE THE ONLY AUTHORIZED PERSONNEL TO OPERATE EXISTING VALVES, FIRE HYDRANTS, ETC. ALL WORK SHUTOFFS MUST BE COORDINATED WITH SAID DIVISION THREE (3) FULL WORKING DAYS PRIOR TO PROPOSED SHUTOFFS. CALL 766-7100.
8. WATER SYSTEMS DIVISION SHALL HAVE THE AUTHORITY TO CANCEL ALL SCHEDULED SHUTOFFS IF THE CONTRACTOR IS NOT PREPARED TO START WORK.

246 1568 0184


REV	SHEETS	CITY	ENGR.	DATE	USER	DEPT.	DATE	USER	DEPT.	DATE
APPROVAL OF REVISIONS										

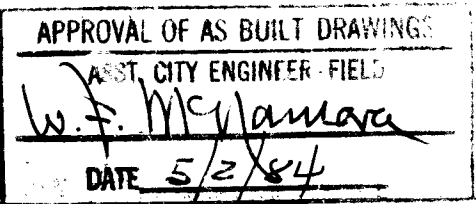

APPROVED FOR CONSTRUCTION	APPROVED FOR CONSTRUCTION
<i>Handwritten signature</i>	<i>Handwritten signature</i>
PROJECT 1568 NO. WRD 8, 10	SHEET 1 OF 2

CITY OF ALBUQUERQUE BERNALILLO COUNTY WATER RESOURCES DEPARTMENT

1202

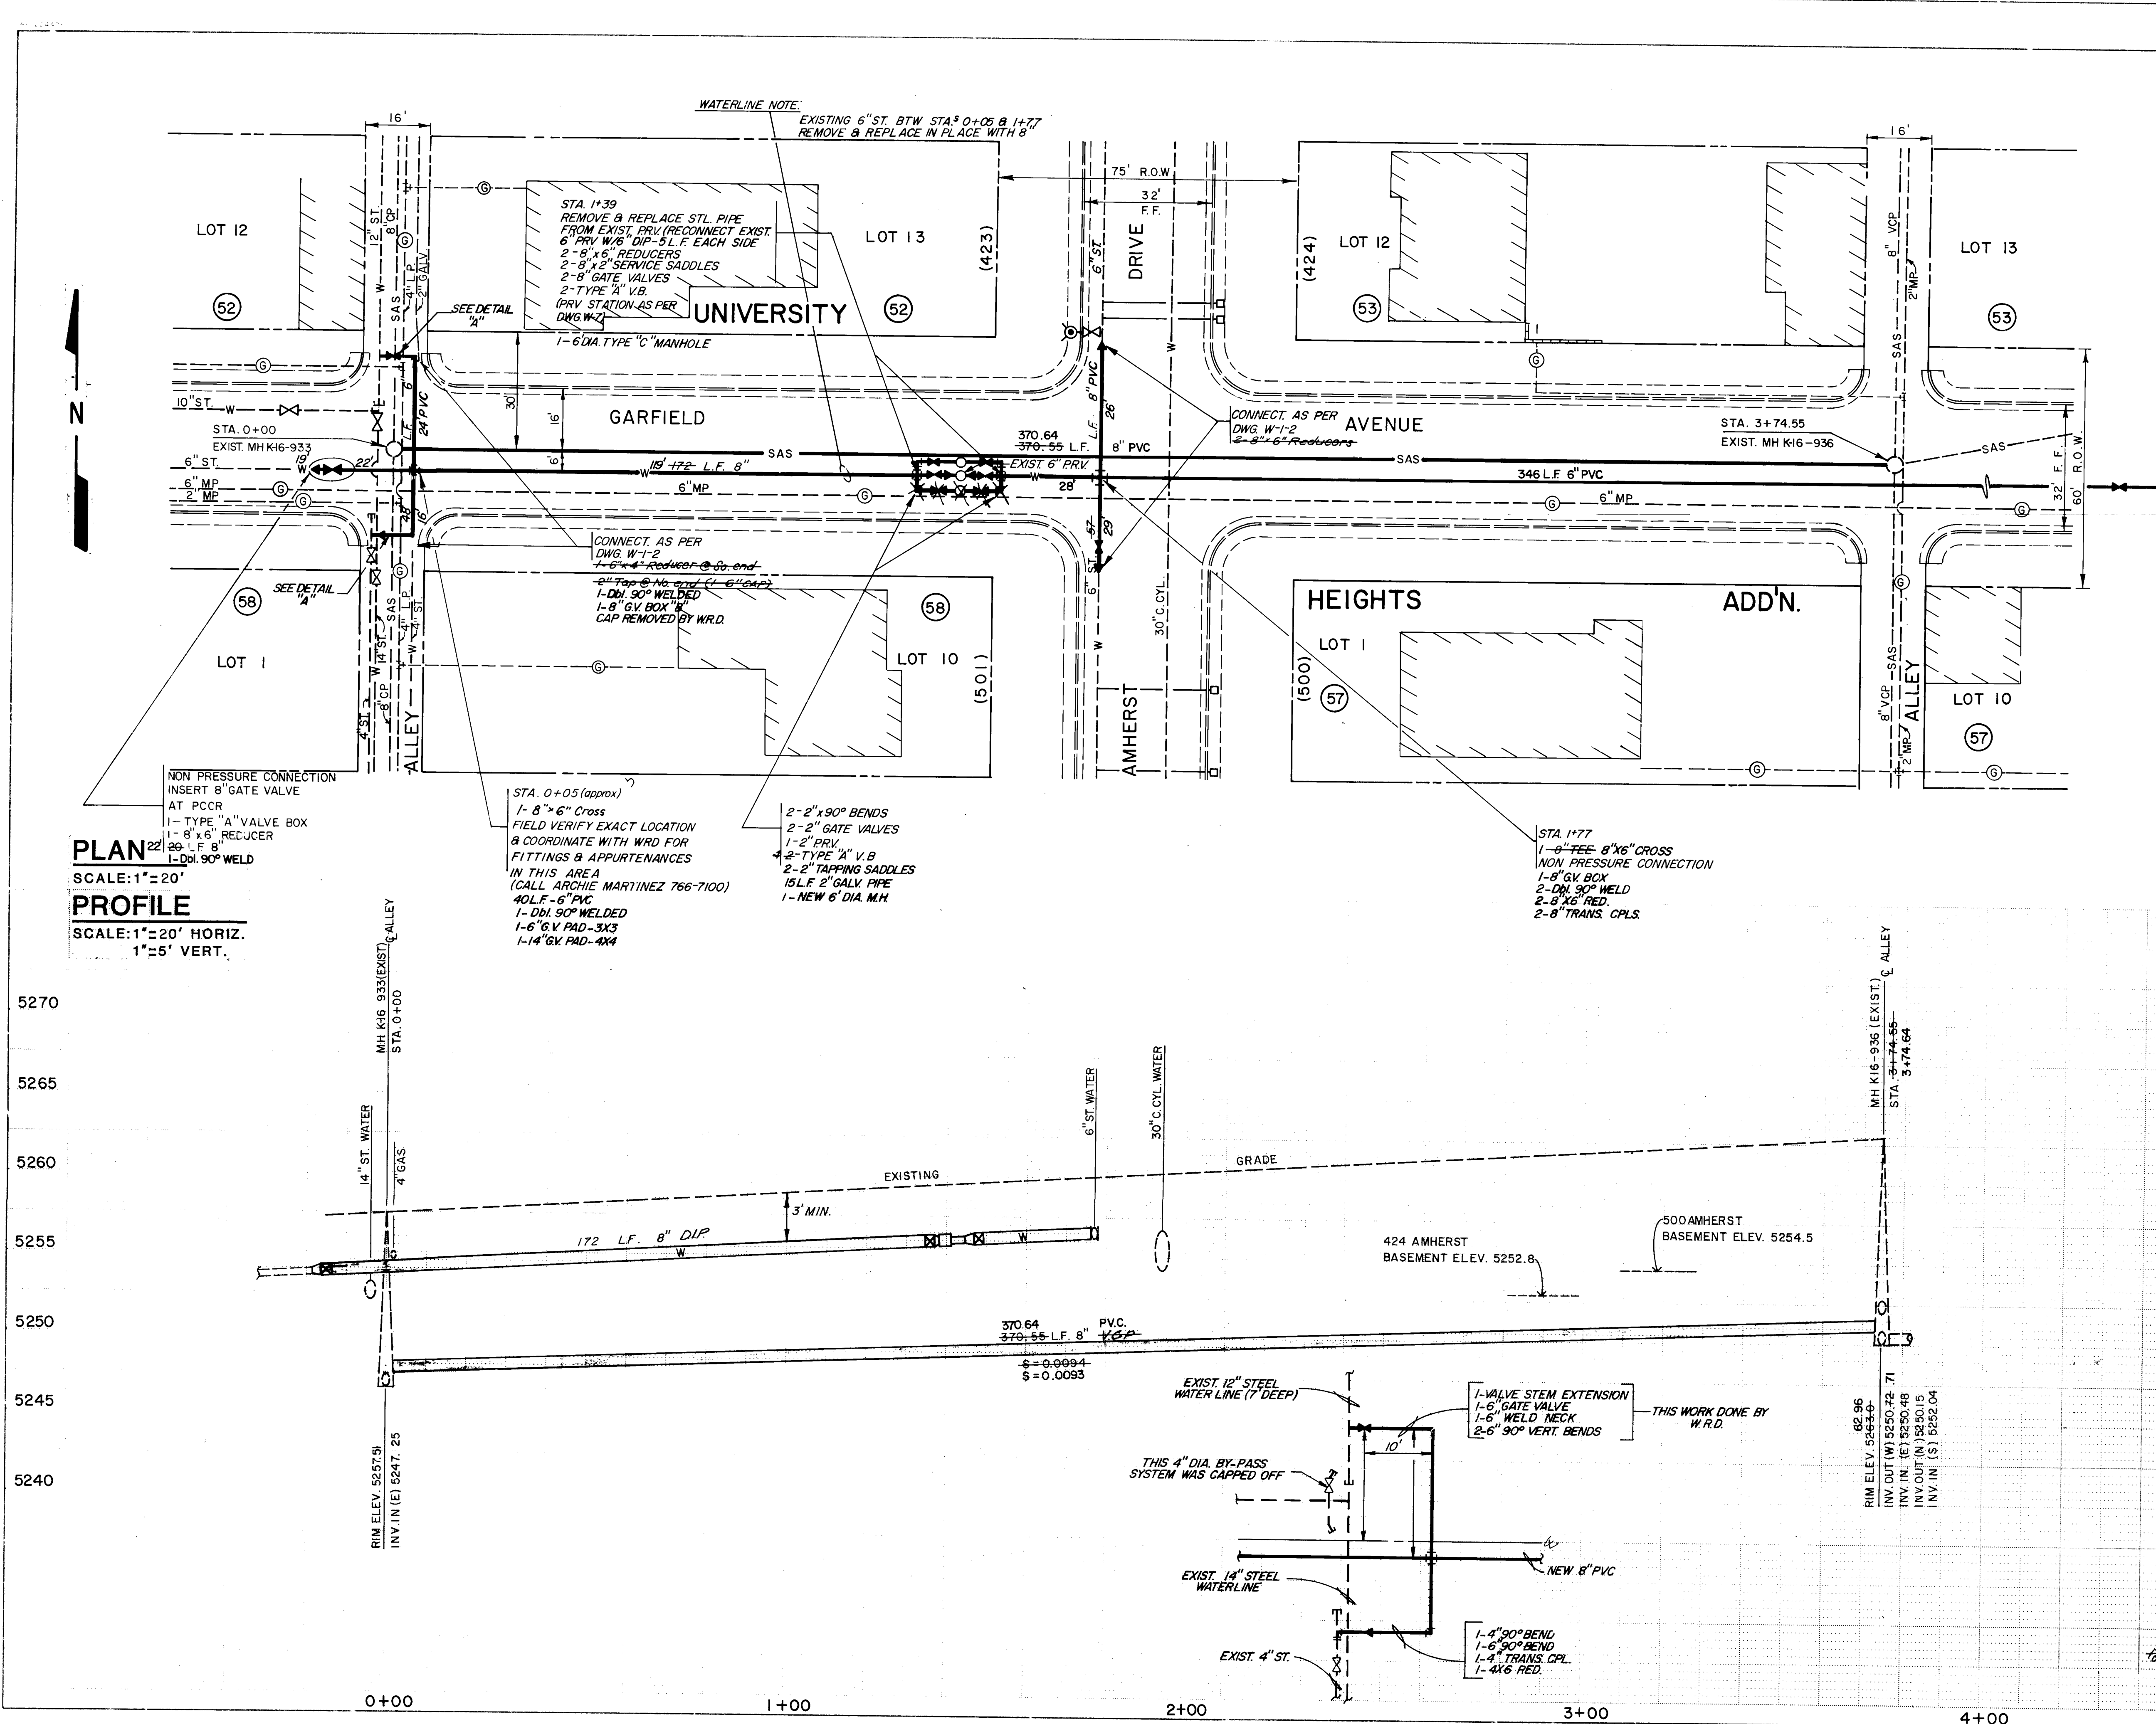

PLAN
SCALE: 1"=20'
PROFILE
SCALE: 1"=20' HORIZ.
1"=5' VERT.

SURVEY INFORMATION		BENCH MARKS		AS BUILT INFORMATION	
NO.	BY	DATE	16-16 LOCATED AT THE INTERSECTION OF AMHERST DRIVE, S.E. AND BURTON AVE. SE., A SQUARE CHISELED IN TOP OF CONCRETE CURB AT THE WSW RETURN ELEV. 5274.17	DATE	DATE
REVISIONS		NO.	DATE	DATE	DATE
DESIGNED BY		DATE	DATE	DATE	DATE
DRAWN BY		DATE	DATE	DATE	DATE
CHECKED BY		DATE	DATE	DATE	DATE
MICRO-FILM INFORMATION		DATE	DATE	DATE	DATE
CORRECTED BY		DATE	DATE	DATE	DATE
RECORDED BY		DATE	DATE	DATE	DATE
NO.		DATE	DATE	DATE	DATE

CITY OF ALBUQUERQUE MUNICIPAL DEVELOPMENT DEPARTMENT ENGINEERING DIVISION					
TITLE: SAS EXTENSION AT GARFIELD AVE. SE. BTW M.H. 933 & 936 / WATERLINE REPLACEMENT AT GARFIELD AVE. BTW. AMHERST DR. & WEST ALLEY WAY					
APPROVALS	ENGINEER	DATE	APPROVALS	ENGINEER	DATE
City Engineer	3/25/82	3/25/82	Liquid Waste	3/25/82	3/25/82
ACE - Design	3/25/82	3/25/82	Traffic	3/25/82	3/25/82
ACE - Hydrology	3/25/82	3/25/82	Water	3/25/82	3/25/82
MOD/ENG. QA	3/25/82	3/25/82	2-28-83		
DRAWING NO.	WRD 81-10	1568	MAP NO.	K-16	SHEET 2 OF 2