



THE EAST-CENTRAL MULTI-SERVICE CENTER

THE BURNS/PETERS GROUP, P.A.
ARCHITECTS PLANNERS


PROJECT MANAGER
ROBERT W. BIGGERS

CONSULTANTS:
COUPLAND/POWELL/MORAN/ASSOCIATES
BACCHUS CONSULTING ENGINEERING
TOM MANN ASSOCIATES
CRAIG CAMPBELL ASSOCIATES


PLUMBING/MECHANICAL/ELECTRICAL
STRUCTURAL
CIVIL
LANDSCAPE ARCHITECTS

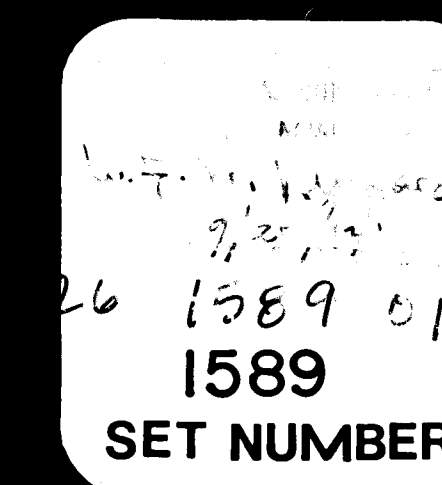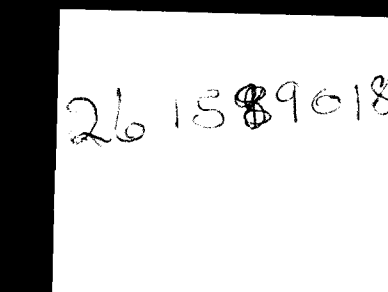


THE HUMAN SERVICES DEPARTMENT CITY OF ALBUQUERQUE, NEW MEXICO

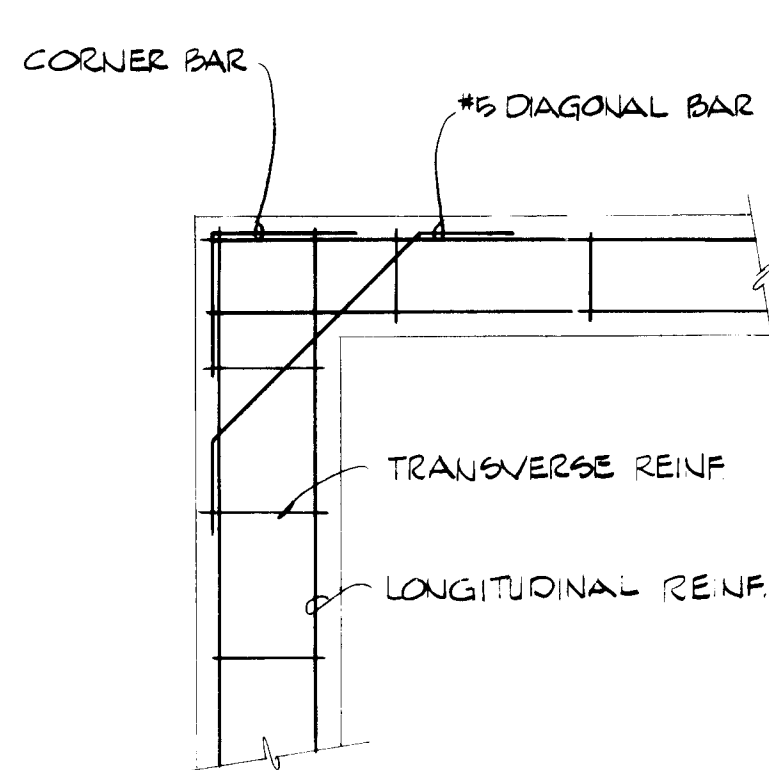


DETAIL F1

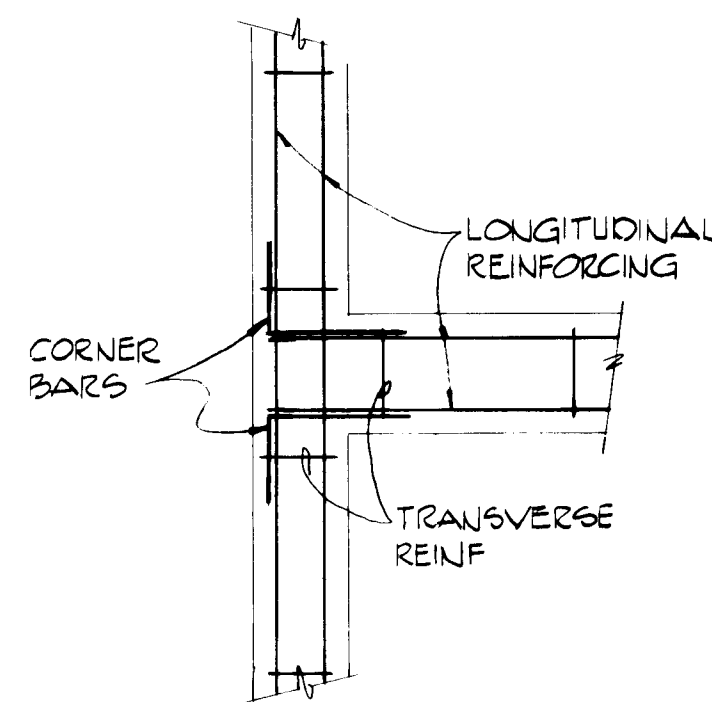

DETAIL F2

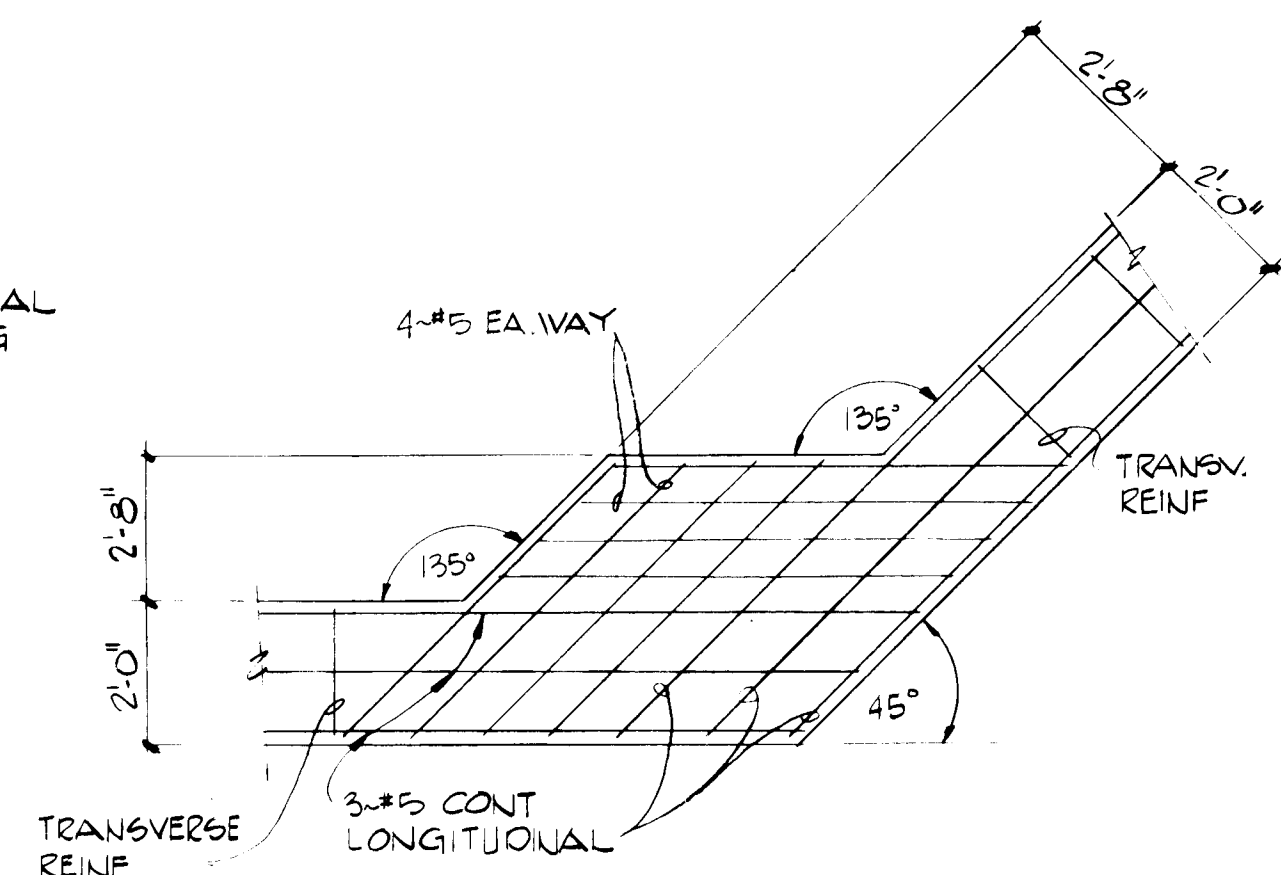

DETAIL F3

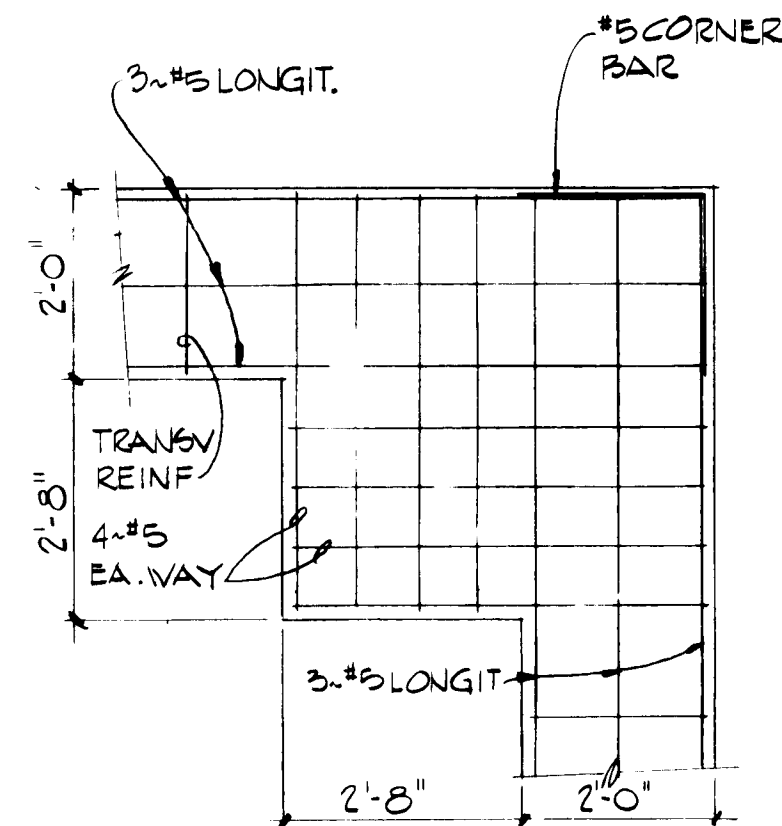


DETAIL F4


GENERAL NOTES - FOOTING DETAILS

- Except as otherwise shown, all strip footings are 12" thick and are centered under the walls they support. See FOUNDATION PLAN, Sheet S-1, for footing widths.
- Reinforcing shown in footing details F1 through F4 is at bottom of footing. See foundation sections on Sheet S-3 for top of footing reinforcing.
- Dowels to walls are not shown. See foundation sections on Sheet S-3 and masonry details this sheet for required wall reinforcing.
- Provide #5 corner and diagonal bars at locations shown in footing details. Legs of corner bars shall be not less than 24 inches in length and tails of diagonal bars shall be not less than 16 inches in length.
- Except as otherwise shown, bottom of footing reinforcing shall be as follows.


Footing Width	Longitudinal Reinforcing	Transverse Reinforcing
1'-8" and less	2-#5	#4 @ 32" o/c
1'-9" through 2'-8"	3-#5	#4 @ 24" o/c
2'-9" through 3'-8"	4-#5	#4 @ 12" o/c

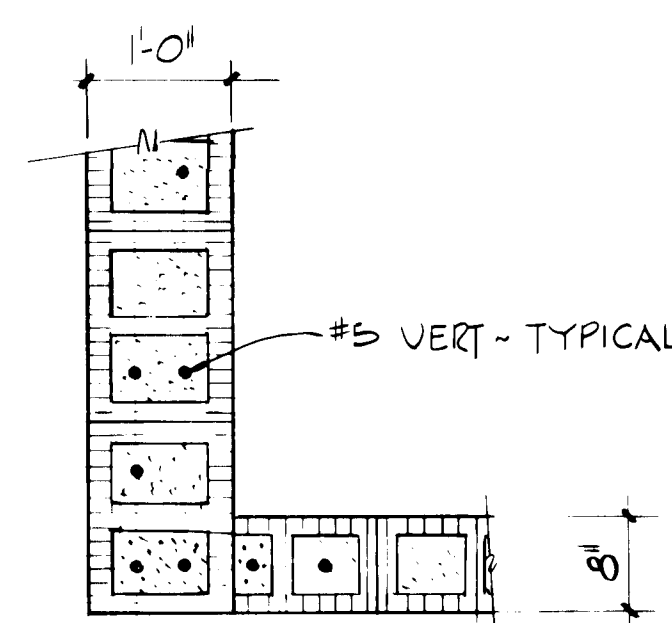


DETAIL M5

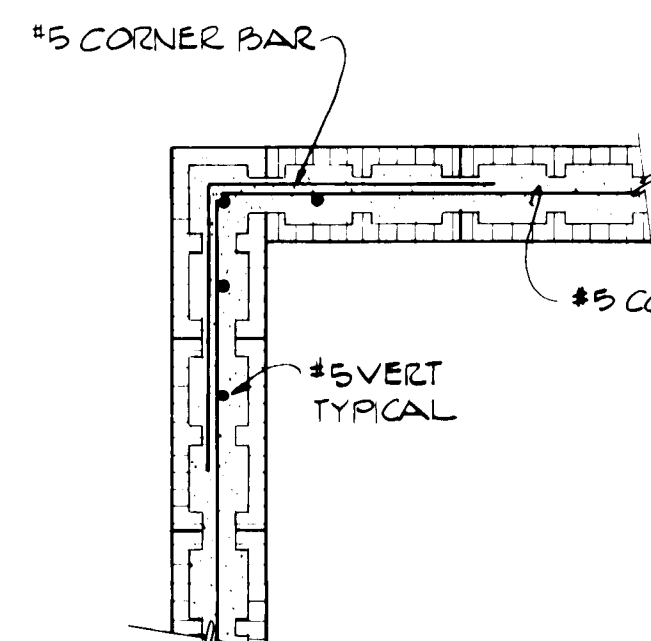


DETAIL M1

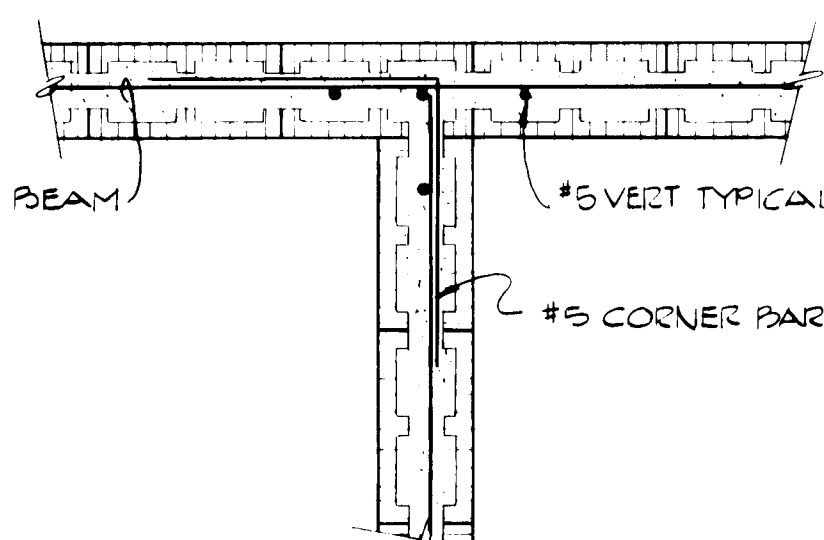

DETAIL M2

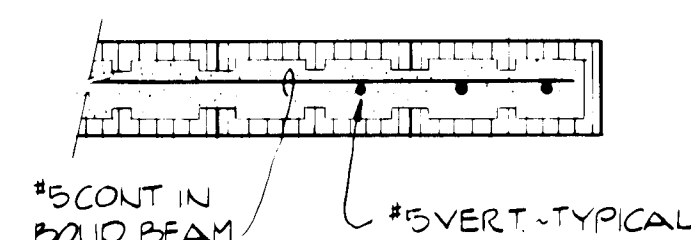

DETAIL M3

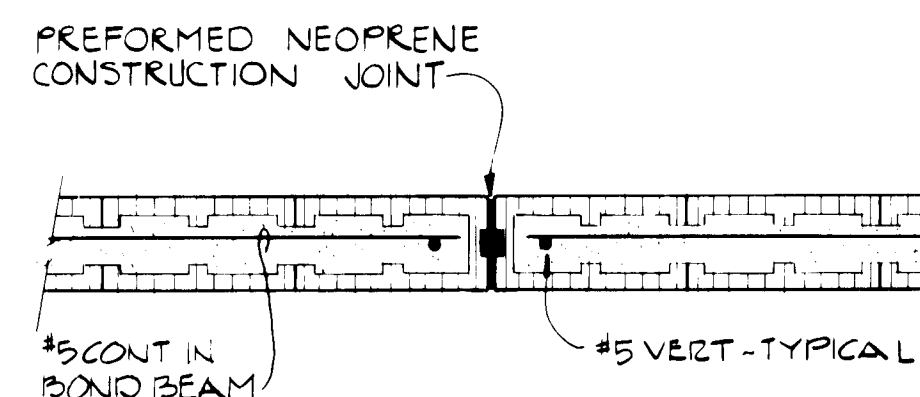

DETAIL M4

NOTE: TYPICAL AT END OF WALL OR JAMB OF OPENING.

NOTE: STOP MASONRY AND BOND BEAM REINFORCING, EXCEPT AT JOIST BEARING, AT CONTROL JOINT.

SCALE: F1-F4 3/8" = 1'-0"
M1-M5 3/4" = 1'-0"

GENERAL NOTES - CONCRETE CONSTRUCTION

- GENERAL.** Except as otherwise shown, reinforcing shall be placed in accordance with the latest edition of the CRSI Placing Manual.
- PLACEMENT OF REINFORCING AND OTHER ITEMS.** Reinforcing, dowels, bolts and any other inserts shall be fastened into position before concrete is placed. Drilled-in expansion anchors shall not be used except where specifically shown on the drawings. Vertical reinforcing in walls shall be placed at the center of the wall except as otherwise shown. The spacings shown for reinforcing and other anchorage and embedded items are maximums. Provide and install a sufficient number of items so that the spacings shown are not exceeded. The first and last items in a group of uniformly spaced items shall be located at not more than one-half the typical spacing nor 12 inches from the end of a structural element.
- CONTINUITY OF REINFORCING.**
 - General. Except where lengths of reinforcing are given, reinforcing shall be continuous for the full length or width of a structural element. Hooks in reinforcing which are not otherwise detailed shall be standard ACI hooks. Splices in reinforcing which are not otherwise detailed shall be ACI Class C splices.
 - Vertical Reinforcing. No splices permitted except as shown.
- JOINTS.**
 - Slabs on grade: Joints shall be located where shown on the drawings except as otherwise approved by the Architect.
 - Footings, stem walls: Joints shall be placed at locations to be selected by the Contractor subject to the following restrictions. There shall be no joints within 4 feet of any corner or intersection. Joints in walls shall be offset from joints in footings by not less than 4 feet. Splices in reinforcing shall not be located within 4 feet of any joint in the concrete. Provide horizontal and vertical keys at all joints in walls or footings or between walls and footings.
- CONTINUITY OF REINFORCING.** (Continued)
 - Horizontal Reinforcing:
 - Footings, stem walls, turned-down slab edges: Bars shall be lapped not less than 32 bar diameters nor 24 inches. Additional reinforcing shall be provided at corners, intersections and other discontinuities as shown in the details on this sheet and elsewhere on the drawings.
 - Concrete slabs: Welded wire fabric shall be lapped not less than one-and-one half meshes nor 8 inches on all sides.

GENERAL NOTES - MASONRY CONSTRUCTION

- REINFORCING.**
 - Vertical Reinforcing. Except as otherwise shown in the masonry details (M1 through M4) on this sheet and the FOUNDATION PLAN, Sheet S-1, provide #5 @ 32" o/c, bars to be placed at the center of the wall. Place bars in lengths as long as practical; lap bars not less than 24 inches at splices. Provide #5 dowels from footings at all vertical bars with 8 inch (minimum) horizontal legs and 32" (minimum) vertical legs.
 - Horizontal Reinforcing. Bond Beams. Reinforce with 1-#5 continuous. Lap bars not less than 24 inches at splices. Use #5 corner bars with 24 inch legs at all corners and intersections as shown in details M1 and M2 on this sheet. Provide continuous bond beams at tops of walls, at joist bearings, at roof level along non-bearing walls, and at the following elevations (measured to the top of the bond beam): 0'-0", 7'-4" and 8'-0". Where bond beams must be stepped to follow slope of roof, steps shall be 8 inches. Overlap bond beams and reinforcing not not less than 2'-8" at steps. Bearing and Lintel Beams. Provide and reinforce as shown on the roof framing sections. Joint Reinforcing. Provide type as specified at alternate courses. Maintain continuity at corners and intersections by use of prefabricated items or other approved means. Lap not less than 8" at splices in straight runs. Stop joint reinforcing at masonry control joints. See detail M4 this sheet.
- MASONRY UNITS.** Except as otherwise shown, provide units with manufacturer's standard finishes and colors at all locations, including construction below grade, where masonry will not be exposed to view after construction is complete. In other locations provide units with surface textures and colors as indicated on the building elevations on Sheets A2 and A2.5.
- ANCHOR BOLTS AND EXPANSION ANCHORS.** Drilled-in expansion anchors shall not be used except where specifically shown on the drawings. Anchor bolts and expansion anchors shall be firmly anchored in grout with both the cell containing the anchor and the cell below grouted solid. Where anchors are uniformly spaced, the first and last anchors shall be spaced at not more than half the typical spacing nor 16 inches from the end of a wall or beam.
- CONTROL JOINTS.** Control joints in masonry walls shall be located where shown on the foundation plan and the building elevations. Horizontal reinforcing masonry shall be stopped at control joints except at bond beams at joist bearings. Provide 1-#5 vertical on each side of each control joint as shown in detail M on this sheet.
- GROUT.** Grout lifts and free fall of grout in cmu wall shall not exceed 4 feet. Grout shall be placed using the low lift grouting method. Before grouting, cells and cavities to be grouted shall be cleaned of all trash, mortar droppings and fins, and standing water. All cells below finish floor shall be grouted solid. Except at the tops of walls, shear keys shall be provided at the top course of all cells containing vertical reinforcing by stopping the grout pour at midheight of the top course being grouted. Masonry beams shall be grouted in one lift with no construction joints permitted. Mortar shall not be used as grout.

THE BURNS/PETERS GROUP
ARCHITECTS PLANNERS

8000 PENNSYLVANIA CIRCLE N.E. ALBUQUERQUE, NM 87110 505/265-3645

BURNS/PETERS GROUP ARCHITECTS

RECORD DRAWING

DATE: 12 SEPT 94

Charles Bacchus

REVISIONS

Charles Bacchus

ENGINEER

STATE OF NEW MEXICO

RONALD L. PETERS

REGISTERED ARCHITECT

ARCHITECT

THE EAST-CENTRAL MULTI-SERVICE CENTER

PROJECT NO. 8205

DATE MAY '93

S2


SHEET 9 OF 26

26 1589 0984

THE BUREAU OF THE ARMY AND NAVY

NOTES

LASON 1-505-344-9404
BEST COPY AVAILABLE

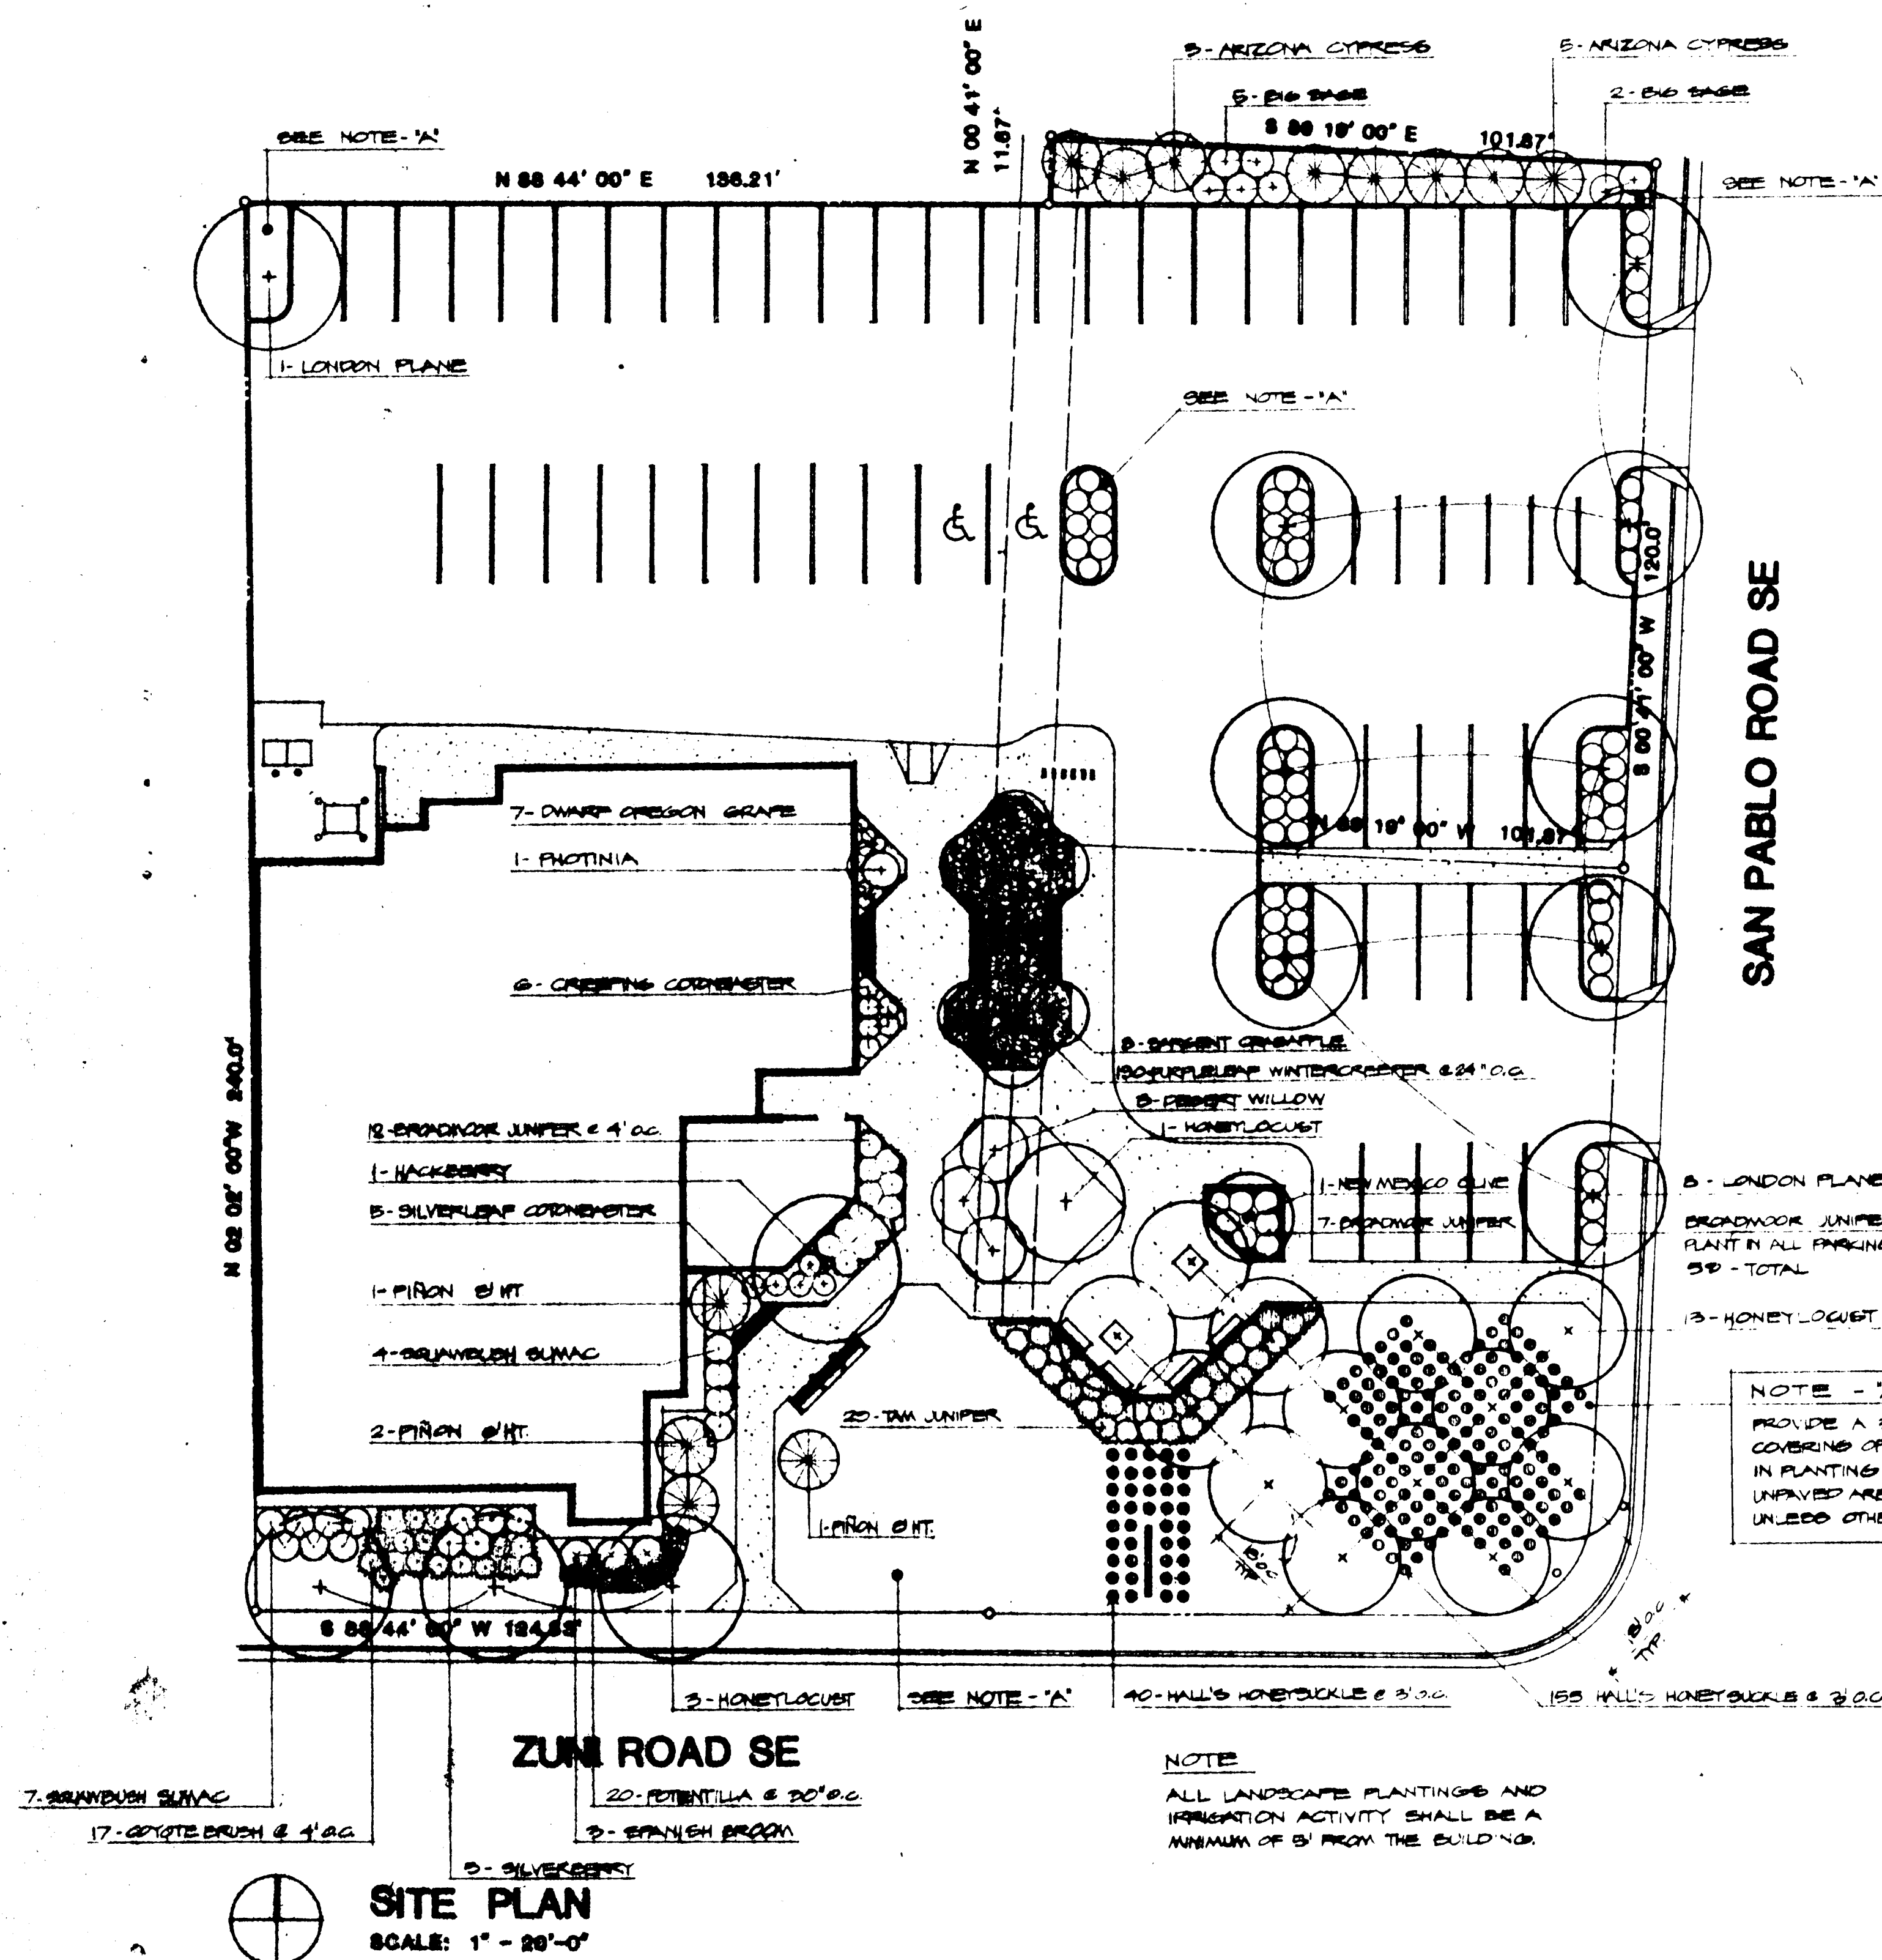

QTY	COMMON NAME	BOTANICAL NAME	SIZE	NOTES
8	ARIZONA CYPRRESS	CUPRESSUS ARIZONICA	5-GAL	MIN 4' HT, FULL
7	BIG DAZE	ARTEMISIA TRIDENTATA	3-GAL	MIN 12" HT
78	BROADLEAF JUNIPER	JUNIPERUS SPACHIA BROADLEAF	5-GAL	MIN 18" SPREAD
17	COTONE DRAKE	BACCHARIS PULCHRA	1-GAL	
8	CREeping COTONEASTER	COTONEASTER ADIFESUS	5-GAL	MIN 18" SPREAD
3	DESERT WILLOW	CHILIPES LINARS	15-GAL	MIN 5' HT
7	DWARF CRESON GRAPE	VITIS AQUIFOLIUM COMPACTA	5-GAL	MIN 10' HT AND FULL
1	HACKBERRY	CELTIS OCCIDENTALIS	2 1/2-GAL	B&B MIN 10' HT
17	HONEYLOCUST	GLYCYTHA TRIACANTHOS SHADOWER	2 1/2-GAL	B&B MATCHED 2 1/2' MIN HT, 6" TO LOWEST BRANCH
9	LONDON PLANE	PLATANUS ACERIFOLIA	2 1/2-GAL	B&B 2' MIN HT
125	MULBERRY HONEYLOCUST	LONICERA AFRICA HALLIANA	1-GAL	
1	NEW MEXICO OLIVE	PERESTIERA NEOMEXICANA	3' HT	MIN 5 STEMS AND CAL 1 1/4"
1	PHOTINIA	PHOTINIA FRASER	5-GAL	MIN 3' HT, FULL
4	PIÑON PINE	PIÑUS EDULIS	SEE NOTE	2 1/2' 3' HT 2 1/2' 3' HT
20	POTENTILLA	POTENTILLA FRUTICOSA GOLD DROP	3-GAL	MIN 12" HT
190	PURPLE LEAF WINTERCREEPER	EDYMWIE FORTUNE COLORATA	1-GAL	18" MIN SPREAD
8	SARGENT CRANAPPLE	MALUS FARGENTI	2-GAL	B&B MATCHED
5	SILVERCHERRY	ELAEGNUS FURGENS	5-GAL	MIN 5' HT
5	SILVERLEAF COTONEASTER	COTONEASTER ARGENTIFOLIUS	5-GAL	
3	SPANISH BROOM	GENISTA HISPANICA	5-GAL	
11	SUNNIBUSH SUMAC	RHUS TRILOBATA	5-GAL	MIN 18" HT
20	TAM JUNIPER	JUNIPERUS SPACHIA TAMARISCIFOLIA	5-GAL	

NOTE: TOP OF GRAVEL MULCH SHALL BE FLUSH WITH ADJACENT PAVED SURFACES.

AS BUILT JUNE 1, 1984
PLANTING PLAN

BURNS/PETERS GROUP-ARCHITECTS
RECORD DRAWING
DATE: 12 SEPT 84
Charles New

REVISIONS



ENGINEER

ABSTRACT

THE EAST · CENTRAL MULTI · SERVICE CENTER

PROJECT NO.
8205

DATE SEPT. 1 83

LE OF



NOTES

- ① 4" REINF. CONC. POSTLINE AT 10' ON @ 3' WIDE (TYPICAL)

NOTE: ALL LANDSCAPE PLANTINGS AND IRRIGATION ACTIVITY SHALL BE MIN. 5' FROM THE BLDG. PERIMETER



IRRIGATION LEGEND

●▲▲	"WEATHERMATIC" JET IRRIGATOR #104, FULL, HALF & QUARTER HEADS ON NO. 94-P HI-RISER
□	"WEATHERMATIC" BUBBLER HEAD #103
●	"WEATHERMATIC" 11024 SERIES REMOTE CONTROL VALVE SIZE AS NOTED ON PLAN. (A) VALVE REFERENCE LABEL
□	"RAINBIRD" RC-7A "AB" DUAL PROGRAM ELECTRO-MECHANICAL CONTROLLER. INSTALL IN NEMA STEEL ENCLOSURE W/LOCK
---	LATERAL LINE PVC CLASS 200
---	MAIN LINE PVC 2" Ø SCHEDULE 40
---	SLEEVE PVC CLASS 160 SIZE 1" LARGER DIA. THAN PIPE
---	"RAINBIRD" AVB-200 2" ATMOSPHERIC VACUUM BREAKER BACKFLOW PREVENTER

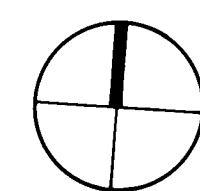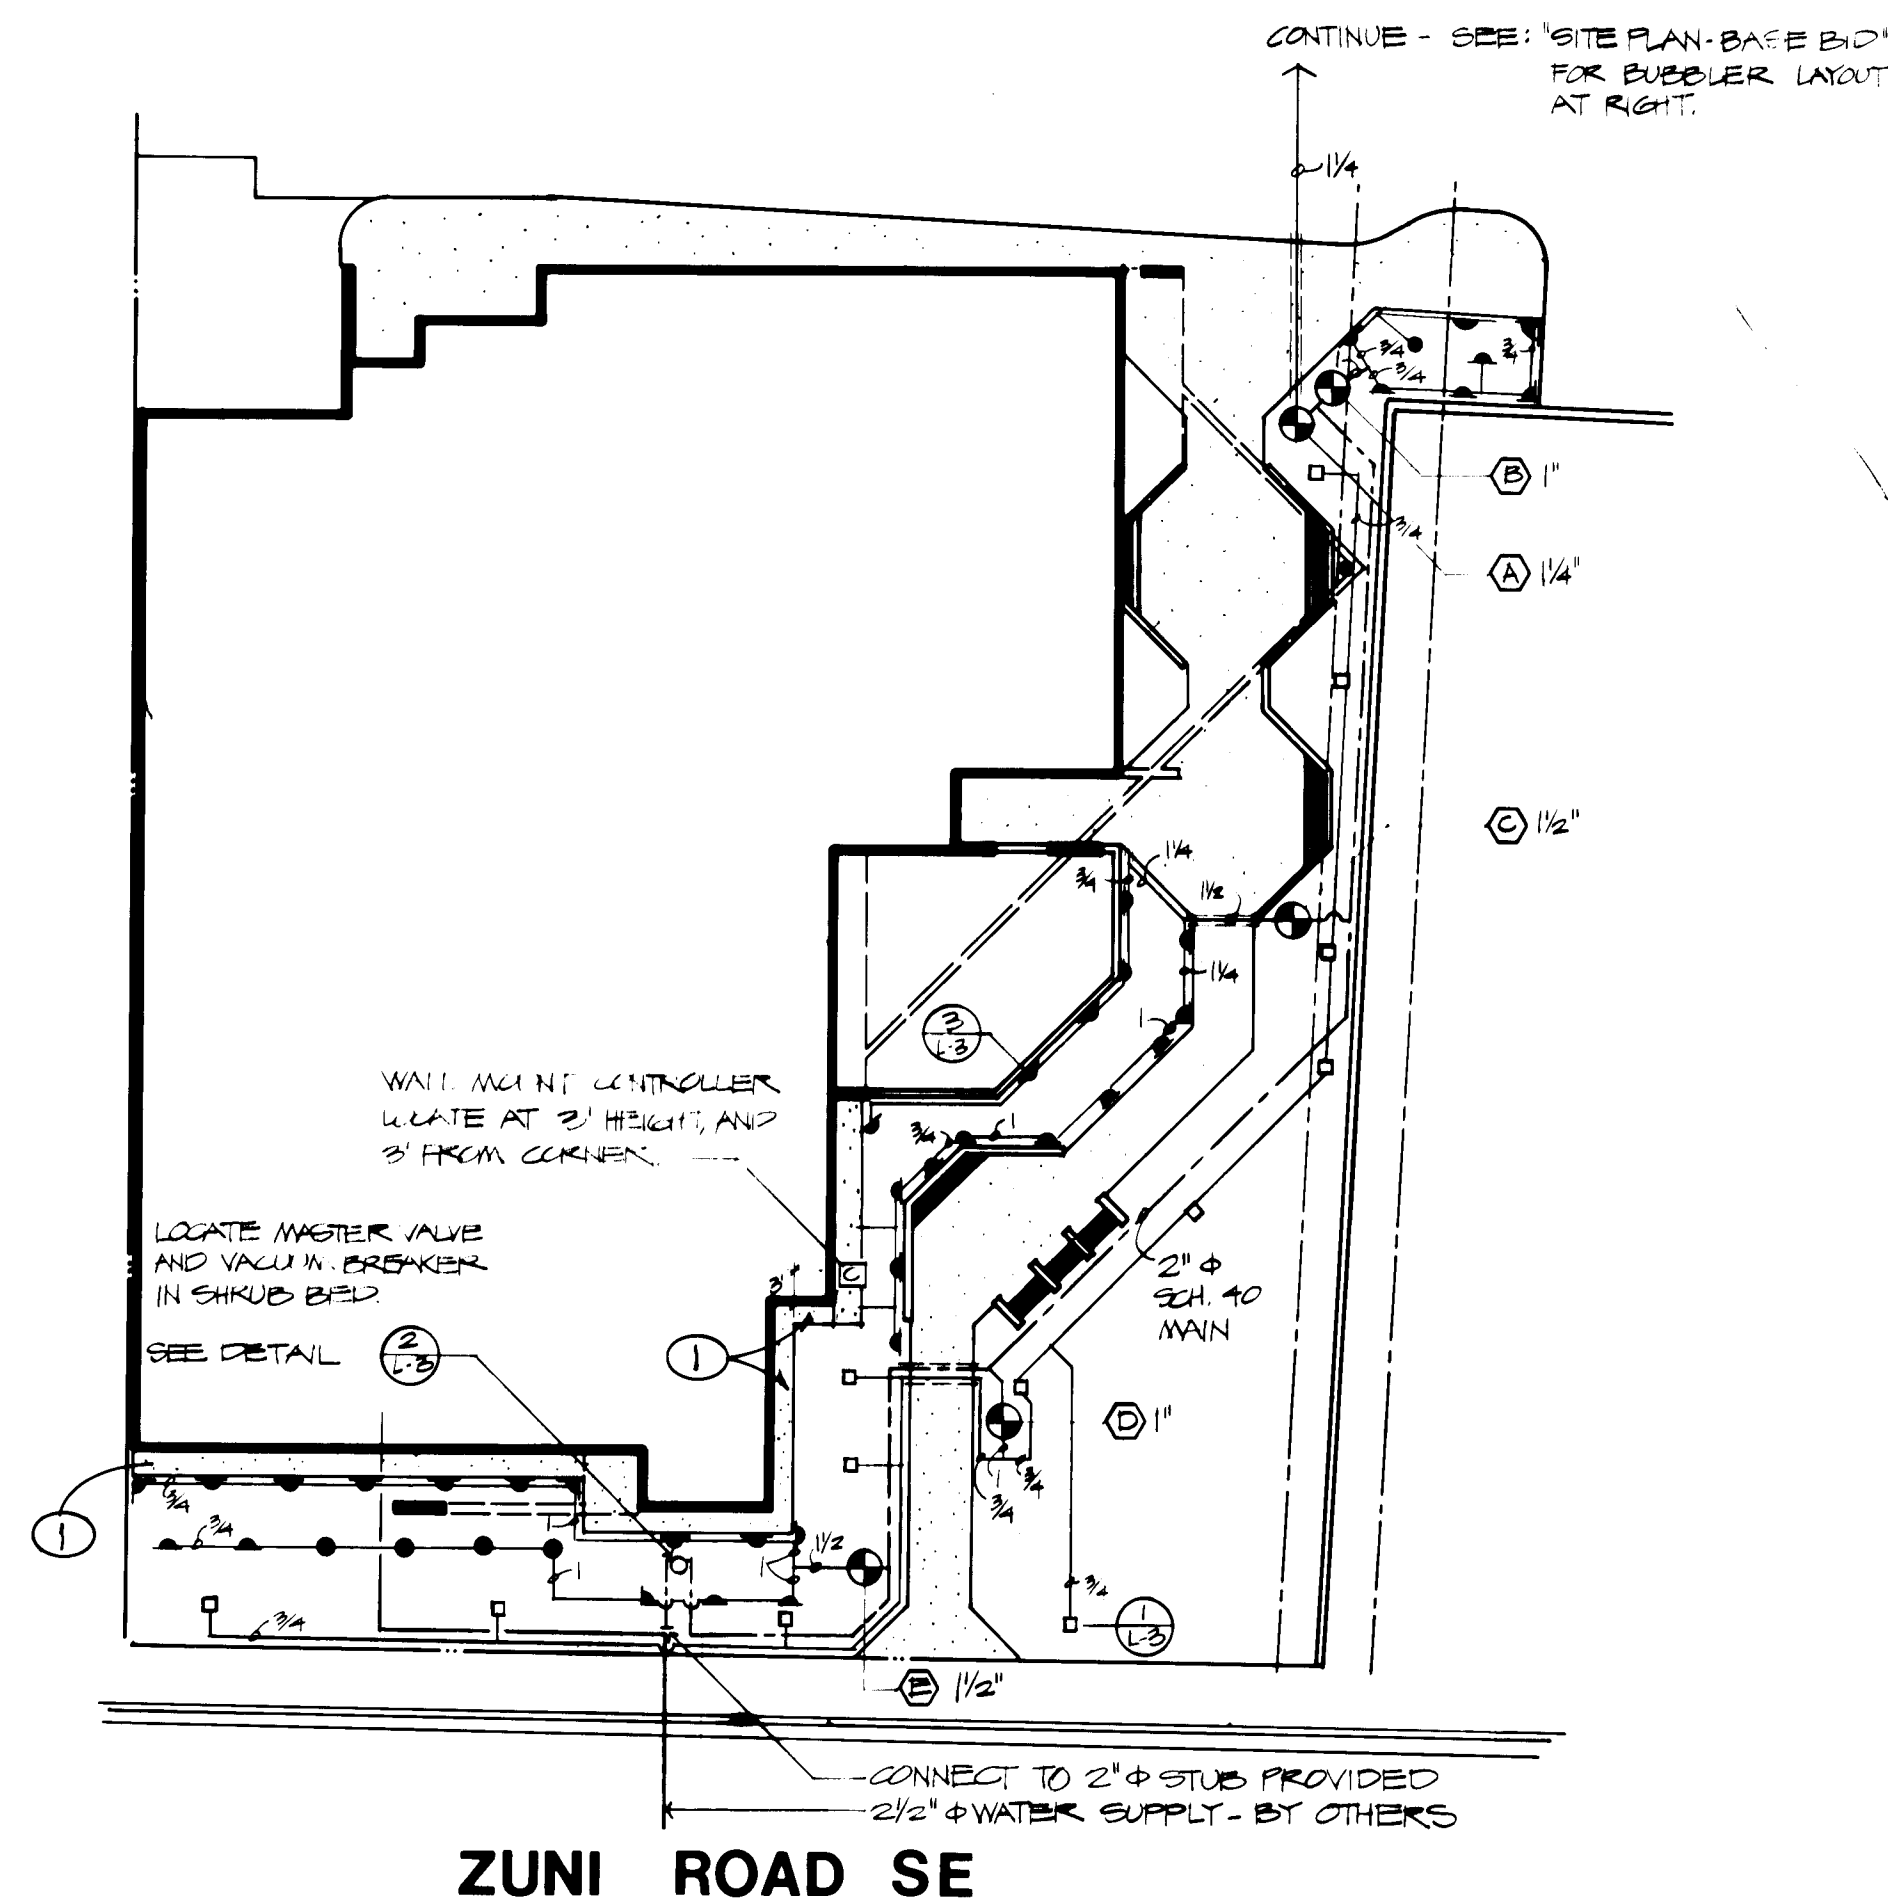

Site Plan - Alternate #1

Scale: 1" = 20'

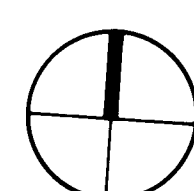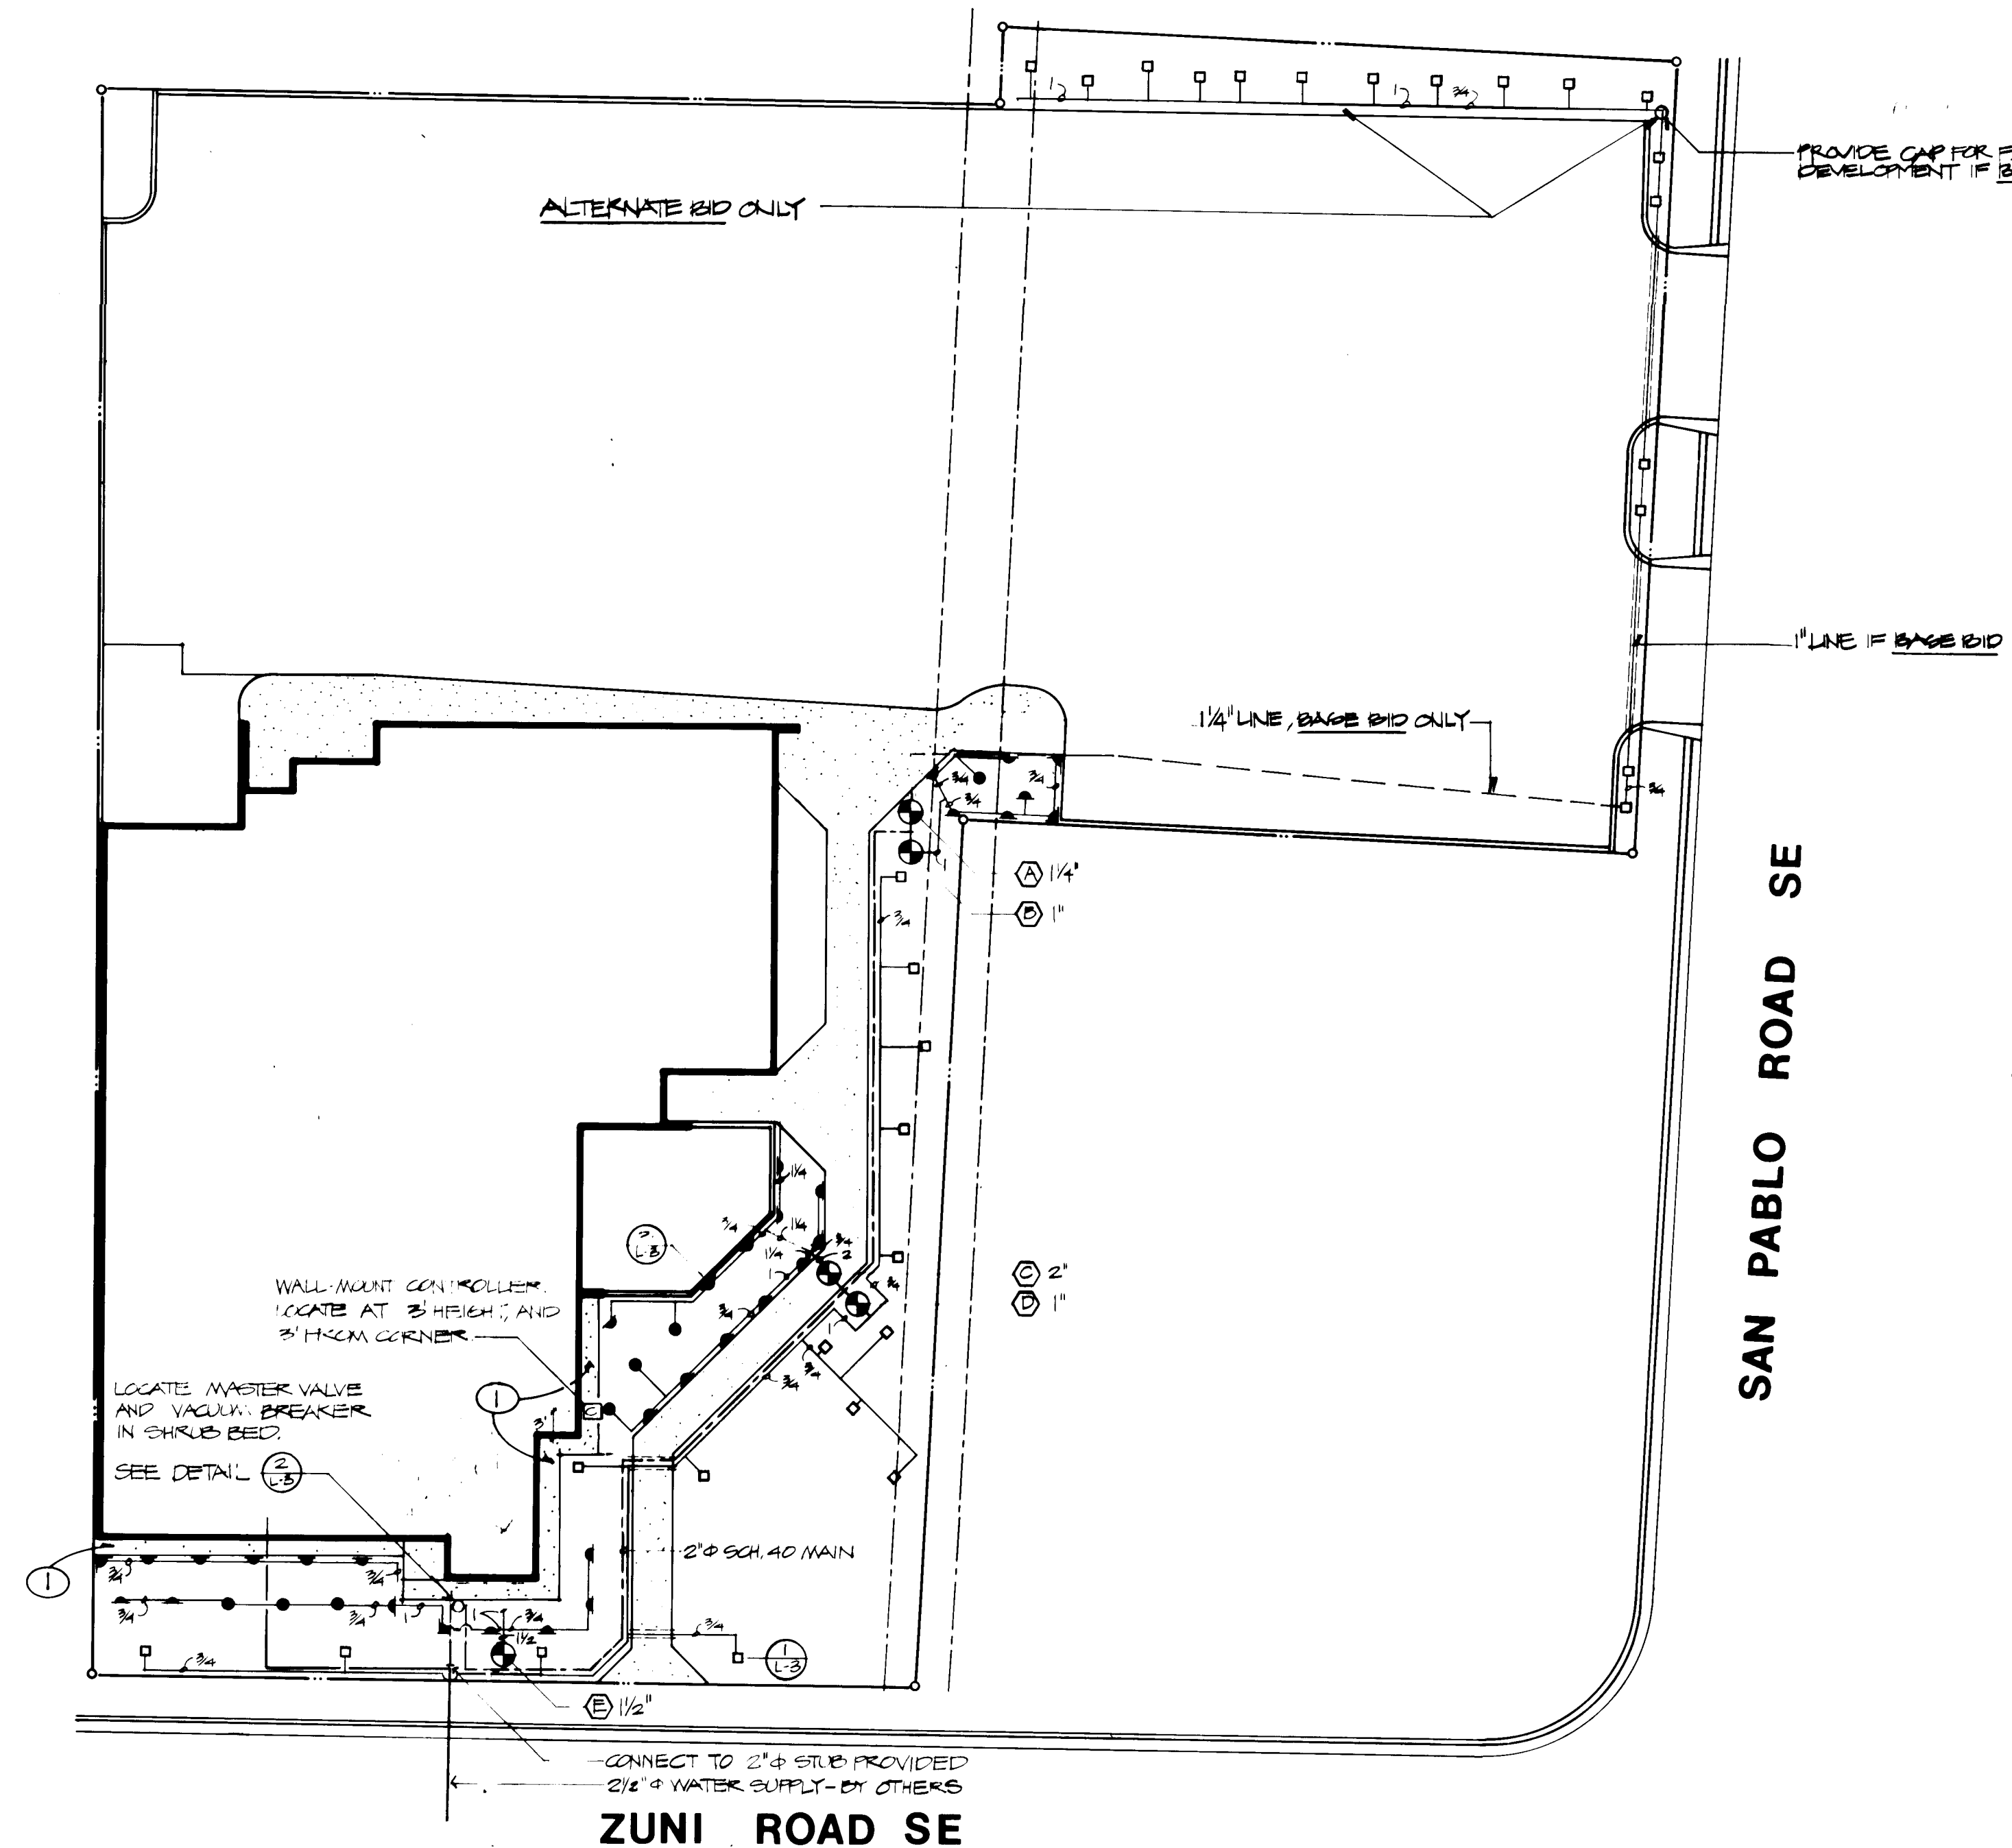

Site Plan - Base Bid

Scale: 1" = 20'

REVISIONS

ENGINEER



THE EAST-CENTRAL
MULTI-SERVICE
CENTER

PROJECT NO. 8205 DATE MAY 88



NOTE:
PROVIDE SLEEVES FOR ALL BRIGTON LINES UNDER ALL PAVED SURFACES.

AS BUILT JUNE 1, 1984
IRRIGATION PLAN

**Craig
Campbell
Associates**
landscape architecture
site planning
416 Central Avenue SE
Albuquerque, NM 87102
(505) 242-9928

NOTES

2615890784

26 1589 2764

BURNS/PETERS GROUP-ARCHITECTS

RECORD DRAWING

DATE: 12 SEPT 84
Charles Oates

REVISIONS

ENGINEER

15

THE EAST · CENTRAL MULTI · SERVICE CENTER

PROJECT NO.
8205

DATE 08-11-88

L2
SHEET OF

STRUCTURAL DESIGN CRITERIA

BUILDING CODE: Uniform Building Code, 1982 edition

VERTICAL DESIGN LOADS

Location	Dead	Live
Roof	30 psf	20 psf
(See ROOF FRAMING PLAN for weights of roof-top mechanical units)		
Floor on grade		200 psf

SEISMIC DESIGN FACTORS

Zone Factor (zone 2)	Z = 0.375
Structural System Factor	K = 1.33
Importance Factor	I = 1.00
Combined Building Period and Soil-Structure Interaction Factor	CS = 0.14

WIND DESIGN CRITERIA


Wind Speed Region	70 mph
Exposure C	
Stagnation Pressure (q_s) at 30 feet above grade	13 psf
Height zone	0 - 20 feet
Importance Factor	I = 1.00
Combined Height, Exposure and Gust Factor	$C_e = 1.2$
Analysis Method 1 (normal force method)	
Pressure Coefficients (C_p)	
Primary Framing System	
Windward Wall	0.8 inward
Leeward Wall	0.5 outward
Roof	0.7 upward
Building Elements and Components	
Walls (except as listed below)	1.2 inward, 1.1 outward
Parapets	1.3 inward or outward
Roof (except as listed below)	1.1 upward
Local areas at discontinuities	
Wall corners	2.0 outward
Roof edges at building corners	3.0 upward
Roof edges except at corners	2.0 upward

DESIGN SOIL BEARING PRESSURES

Normal Loading (dead plus 50% roof live loads)	2000 psf
Combined Vertical and Lateral (wind, seismic) Loading	2500 psf
Lateral Pressures	
Active	35 psf/foot
Passive	350 psf/foot
Coefficient of friction between bottom of footing and ground	0.40

GENERAL NOTES - EARTHWORK

- GENERAL. Footings are to be placed on natural soil which has been prepared and compacted as noted below and as specified. Because of site topography, footing steps are required. See FOUNDATION PLAN for locations of steps and Section 7/5-3 for construction. Interior slabs on grade are to be placed on compacted fill/backfill on prepared subgrade. At Contractor's option, a 4 inch granular drainage fill may be used directly under the slab as a working base. If drainage fill is used, all specification requirements shall be met.
- SITE CLEARING. All vegetation and other organic matter, existing construction and man-made fill, and any other unsuitable material shall be removed from the site and properly disposed of.
- EXCAVATION AND PROTECTION OF EXCAVATIONS. Excavate as necessary to remove loose surface material but to a depth of not less than 18 inches or as required to permit the placing of footings at the depths indicated. Excavation for wall footings shall be not less than 10 feet wide centered on the footing. Excavation for spot footings shall be not less than 12 feet square centered on the footing. After excavations are complete, notify the Architect and obtain his approval of the work before proceeding. Provide positive surface drainage away from excavations and promptly remove any water which may enter the excavations.
- PREPARATION OF SUBGRADE. After excavation is complete and approved, scarify the top 12 inches of the subgrade, moisten or dry as required to achieve optimum moisture content and compact to not less than 95% of nominal maximum density. See note 7 below.
- FILL. All fill material shall be clean, free of organic or frozen matter, and any other unsuitable material, and is to be approved by the Architect before use. No rocks or clods larger than 6 inches in any dimension shall be used nor any material larger than 3 inches within 12 inches of finish grade or the bottoms of footings. General fill shall be a non-expansive material with a plasticity index not exceeding 15. Clean site material may be used as general fill if all requirements are met.
- BACKFILL. Backfill shall be placed as soon as possible after footings have been constructed and walls brought up to grade but not without the prior approval of the Architect. Where backfill is required on both sides of a wall it shall be brought up symmetrically. Material for backfill shall meet the same requirements as for fill at the same elevation.
- PLACING AND COMPACTION OF FILL AND BACKFILL. Fill and backfill shall be placed in layers of approximately uniform thickness not to exceed 8 inches before compaction. Fill beneath the elevations of bottoms of the footings or turned down slab edges shall be compacted to not less than 95% of nominal maximum density. Other fill, interior backfill and exterior backfill adjacent to the buildings shall be compacted to not less than 90% of nominal maximum density. All compaction shall be performed when the material to be compacted is at optimum moisture content (+/- 2 percentage points). Water shall be added to the soil to be compacted away from the building site before placement. All compaction shall be performed using appropriate mechanized equipment as necessary to achieve the specified density levels without damage to existing construction or other property. Ponding, jetting and similar methods of compaction shall not be used.
- QUALITY CONTROL. Nominal maximum densities and optimum moisture contents shall be determined in accordance with ASTM D1557. Density of in-place material shall be determined in accordance with ASTM D1556 or D2922. Gradation of materials shall be determined in accordance with ASTM D422. Liquid limits, plastic limits and plasticity indices shall be determined in accordance with ASTM D423 and D424.

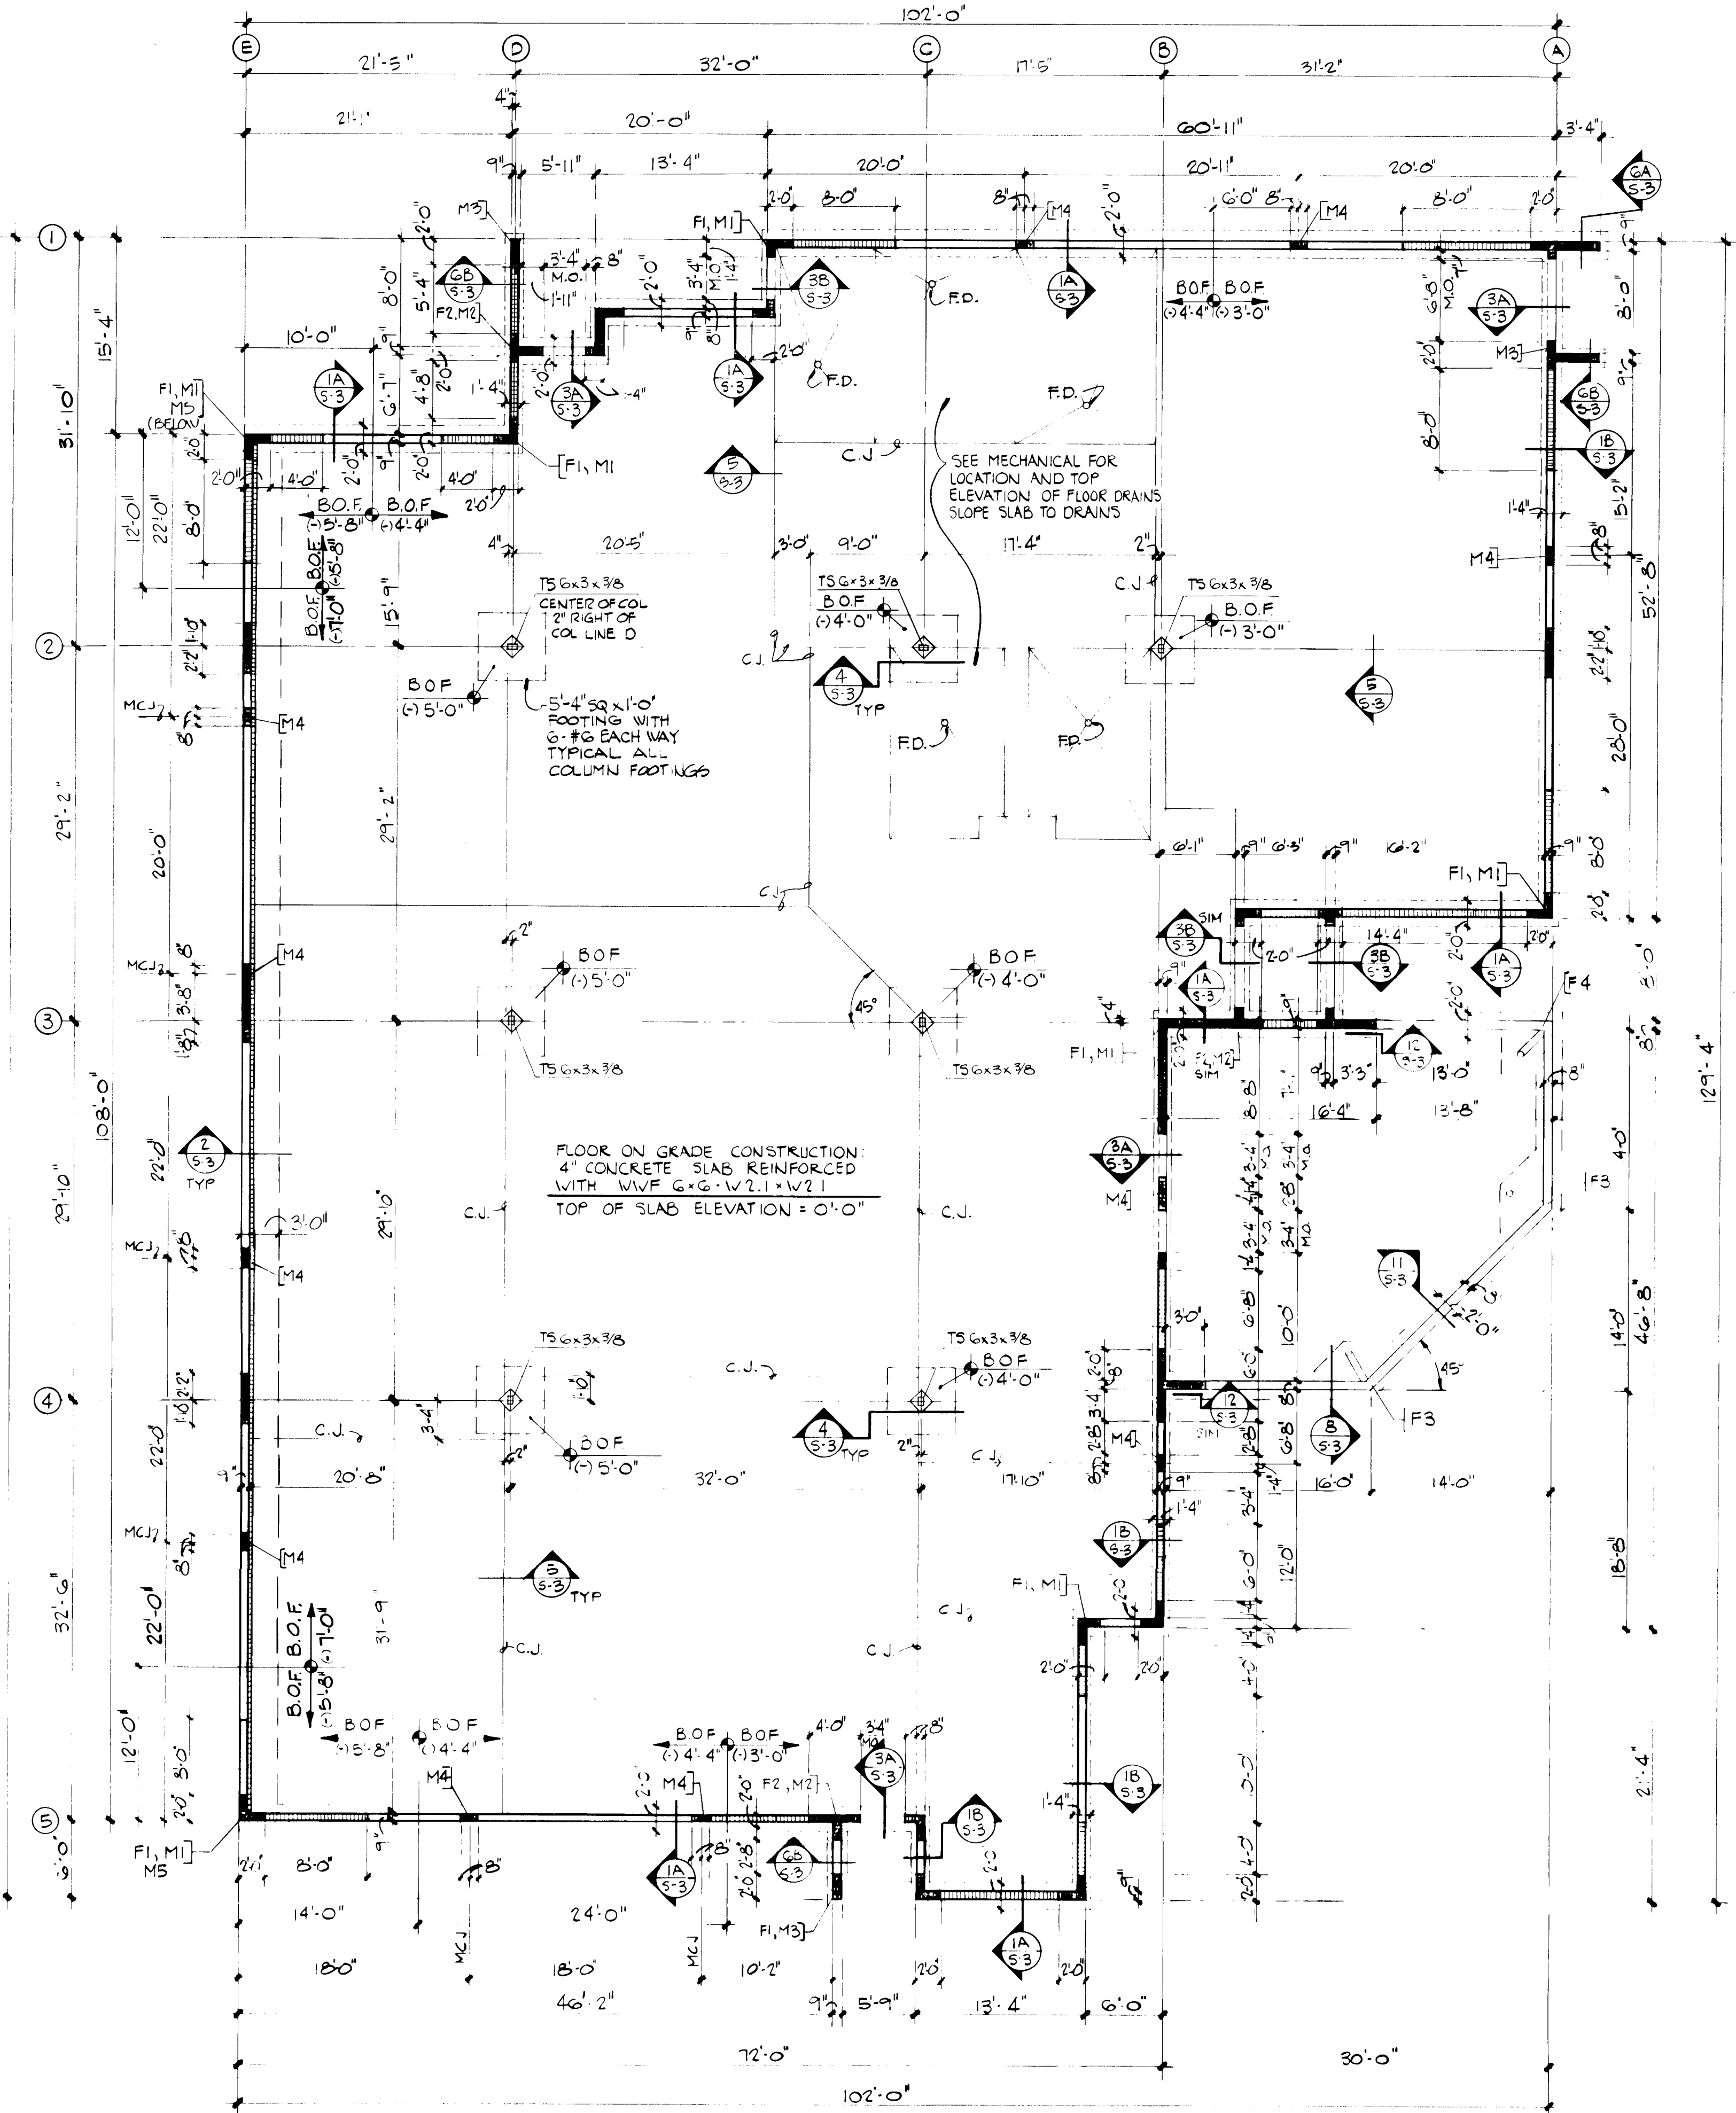

FOUNDATION PLAN (BASE BID)

1/8" = 1'-0"

STRUCTURAL MATERIALS

CONCRETE
Compressive strength (standard cylinder strength at 28 days)
Footings: $f'_c = 3000$ psi
Interior slabs on grade: $f'_c = 4000$ psi
Exterior work: $f'_c = 3500$ psi
Cement: ASTM C150, type I/II
Aggregates: ASTM C33
Admixtures: As specified
Nominal unit weight: 145 pcf

CONCRETE MASONRY UNITS: See Architectural drawings and specifications for required finishes.
Hollow units: ASTM C90, grade N-1, $f'_m = 1350$ psi
Solid units: ASTM C145, grade N-1, $f'_m = 1080$ psi

MASONRY MORTAR AND GROUT
Mortar: ASTM C476, type PL, $f'_m = 2500$ psi
Grout: ASTM 476, $f'_m = 2000$ psi

REINFORCING STEEL
Bars: ASTM A615, grade 60, deformed
Welded wire fabric: ASTM A185
Masonry joint reinforcing: Standard truss type with #9 deformed side and truss wires; wire to conform to ASTM A82

STRUCTURAL AND MISCELLANEOUS STEEL
Structural tubing: ASTM A500, grade B, $f_y = 46,000$ psi
Pipe: ASTM A53, type E or S, grade B, standard weight as otherwise shown, $f_y = 35,000$ psi
Other: ASTM A36, $f_y = 36,000$ psi

STEEL JOISTS
SJI/AISC H Series

STEEL ROOF DECK
1-1/2" deep x 20 gage wide rib (type B), primer painted, $I = 0.208$ in⁴/ft (minimum), $S = 0.233$ in⁴/ft (minimum)

BOLTS
Steel-to-steel connections: ASTM A325 direct tension-indicating bolts with lengths as required to exclude threads from shear planes
Other: ASTM A307, grade A, hexagonal nuts and bolt heads

LIGHT-GAGE STEEL FRAMING (Cold-Formed)
16 gage and heavier: ASTM A570 (modified) or ASTM A607, $f_y = 50,000$ psi
18 gage and lighter: ASTM A611, $f_y = 33,000$ psi

THE BURNS/PETERS GROUP
ARCHITECTS PLANNERS

8000 PENNSYLVANIA CIRCLE N.E. ALBUQUERQUE, NM 87110 (505) 265-3645

GENERAL NOTES - FOUNDATION PLAN

- Local datum for all elevations is top of interior slab on grade = reference elevation 0'-0". See site plan for true elevation of datum.
- Footings are to be placed on compacted subgrade at the elevation shown on the FOUNDATION PLAN. See EARTHWORK NOTES this sheet and specifications for requirements for earthwork.
- Granular drainage fill under slabs on grade may be used at the Contractor's option. If used, such fill shall meet the requirements given in the EARTHWORK NOTES and the project specifications.
- Details of construction of footing corners and intersections are indicated by F1 through F4. Details of construction of masonry walls are indicated by M1 through M4. Details are drawn on Sheet S-2.
- Floor on grade shall be a 4 inch thick concrete slab reinforced with WWP 6x6-W2.1xW2.1.
- Slope slabs as indicated to floor drains. See mechanical drawings for exact locations of drains and for elevations of tops of drains.
- Shading indicates cmu walls which are to be reinforced in all cells with #5 vertical. Cross lining indicates cmu walls which are to be reinforced with #5 vertical @ 32" o/c. See notes and details on Sheet S-2 for other requirements for masonry construction.

26 1584 0884

BURNS/PETERS GROUP ARCHITECTS
RECORD DRAWING
DATE: 12 SEPT 81
[Signature]


REVISIONS

Charles Bacchus
ENGINEER
Ronald L. Peterson
REGISTERED ARCHITECT
STATE OF NEW MEXICO
NO. 788


THE EAST-CENTRAL
MULTI-SERVICE
CENTER

PROJECT NO. 8200 DATE MAY '83


S1
SHEET 5 OF 26

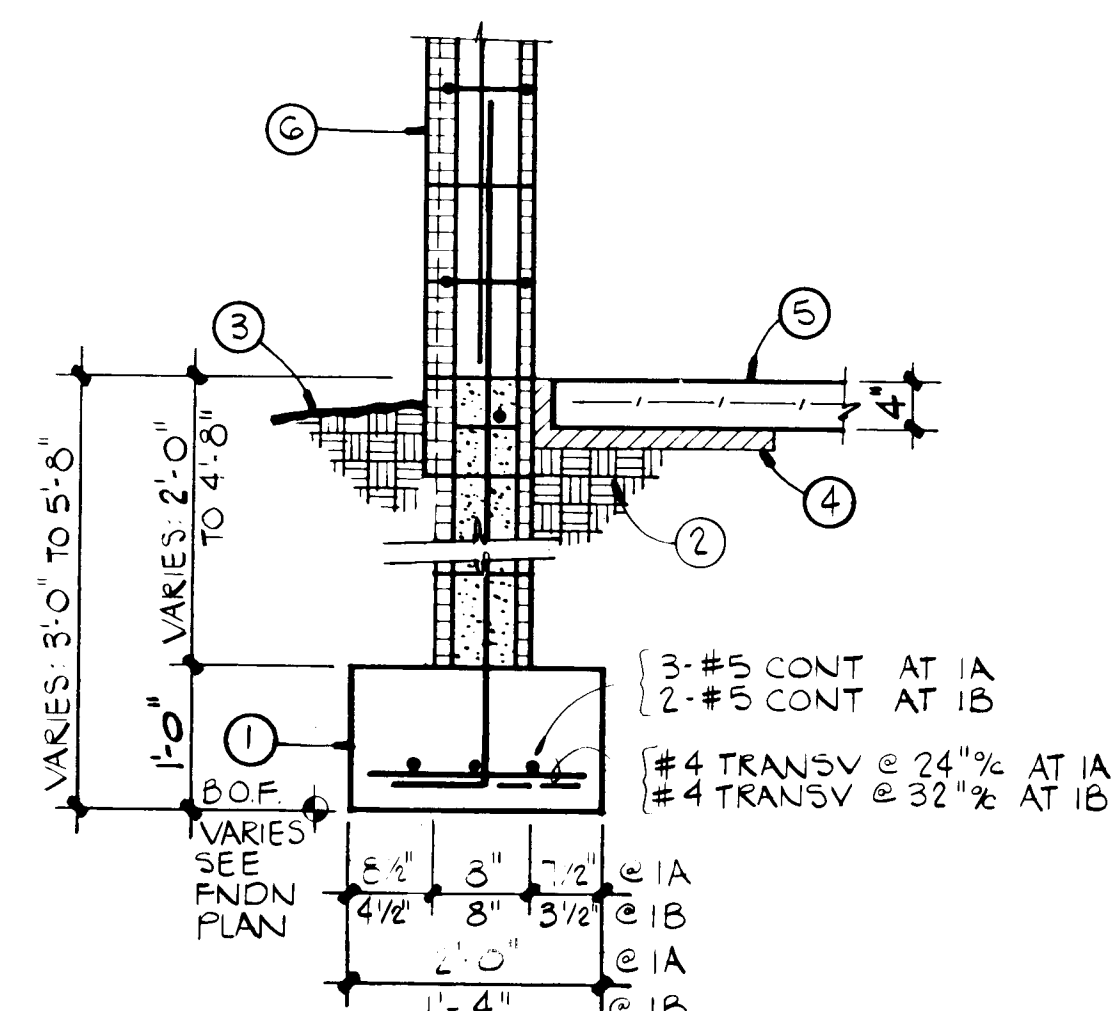


SECTIONS 1A, 1B

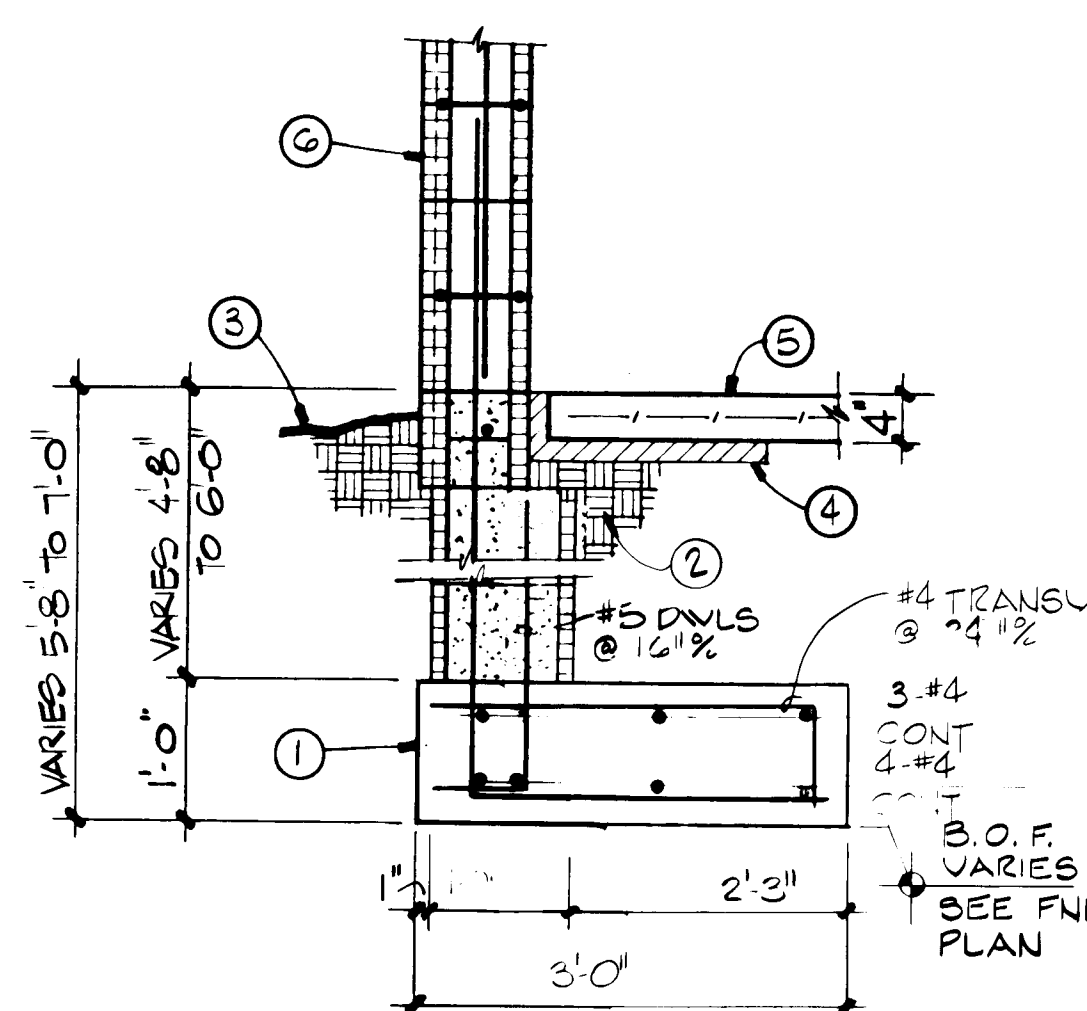


SECTION 2

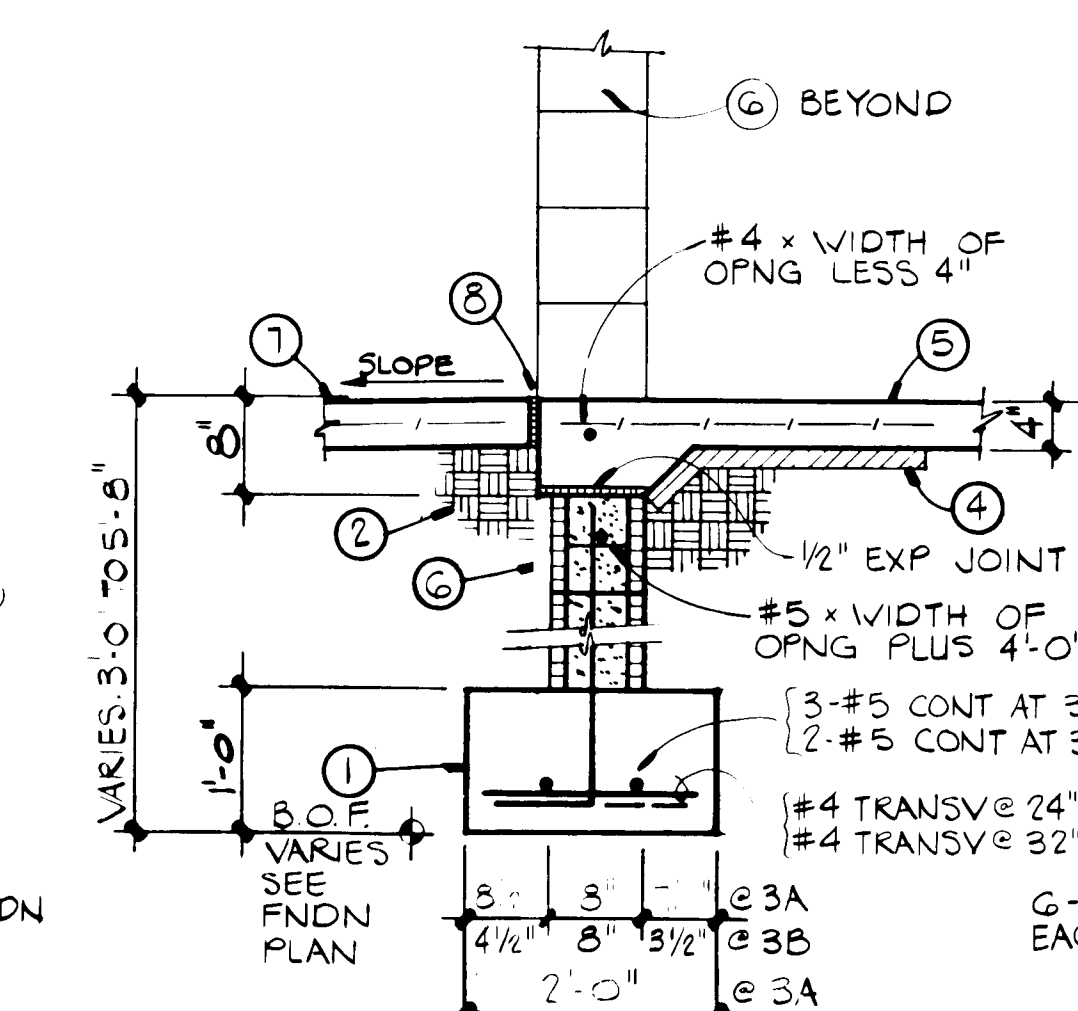


SECTIONS 3A, 3B

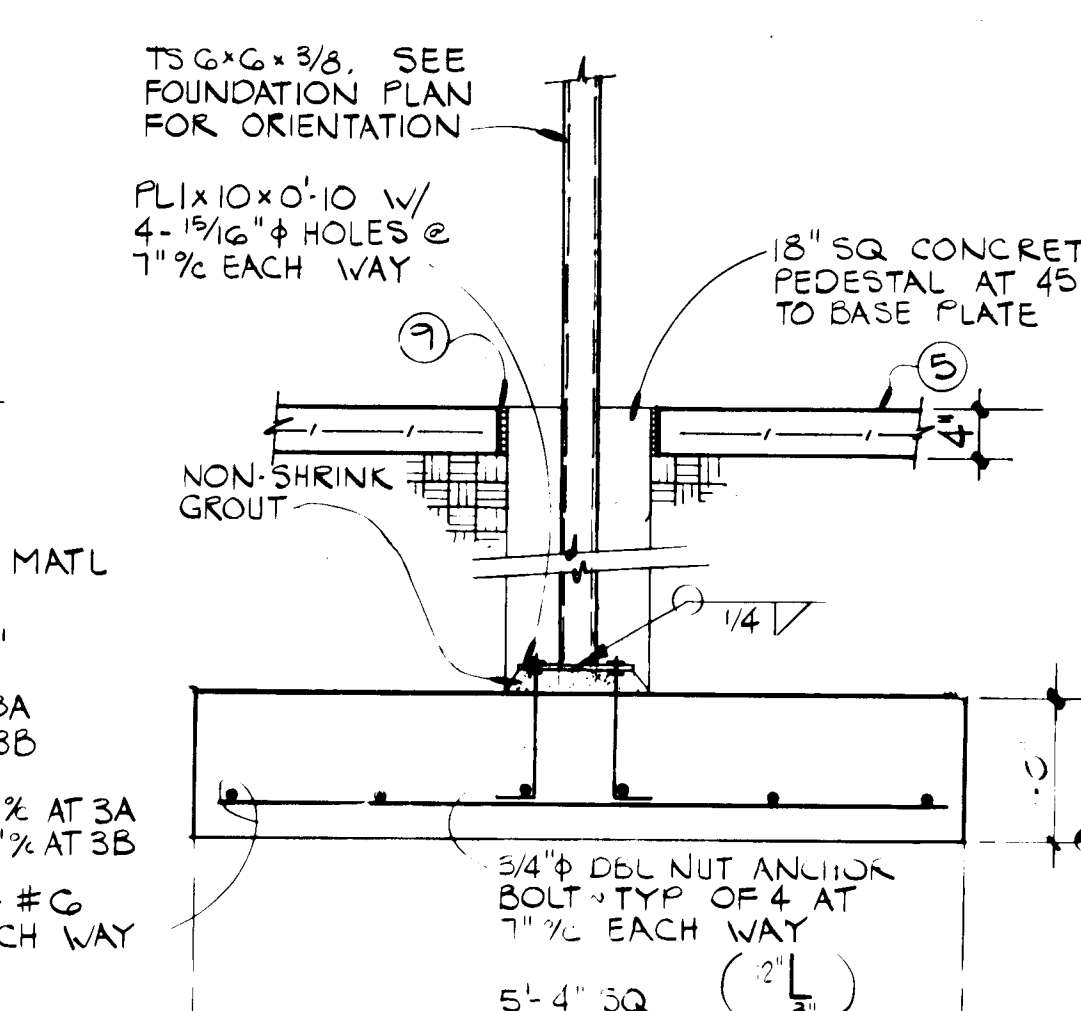


SECTION 4

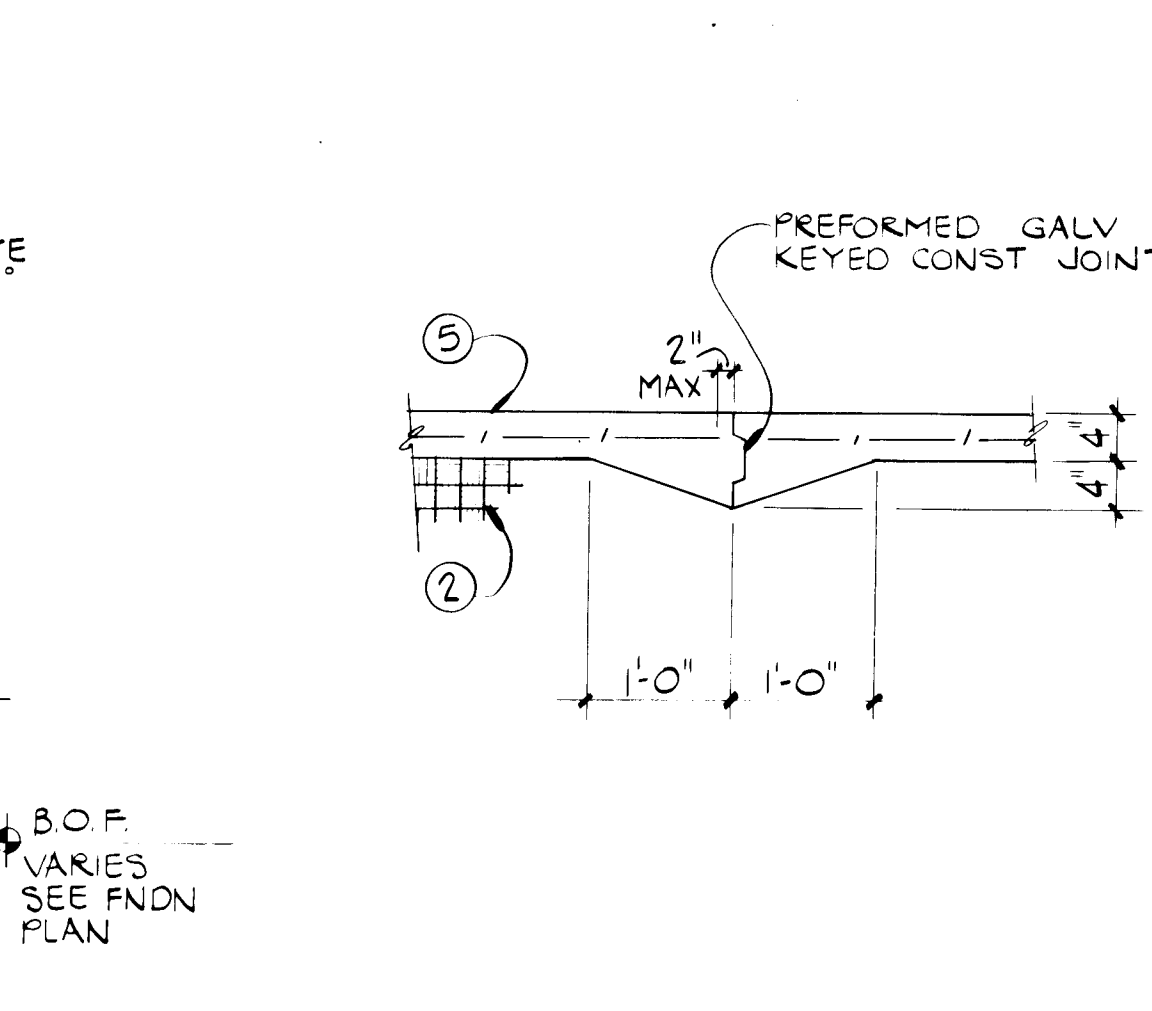


SECTION 5

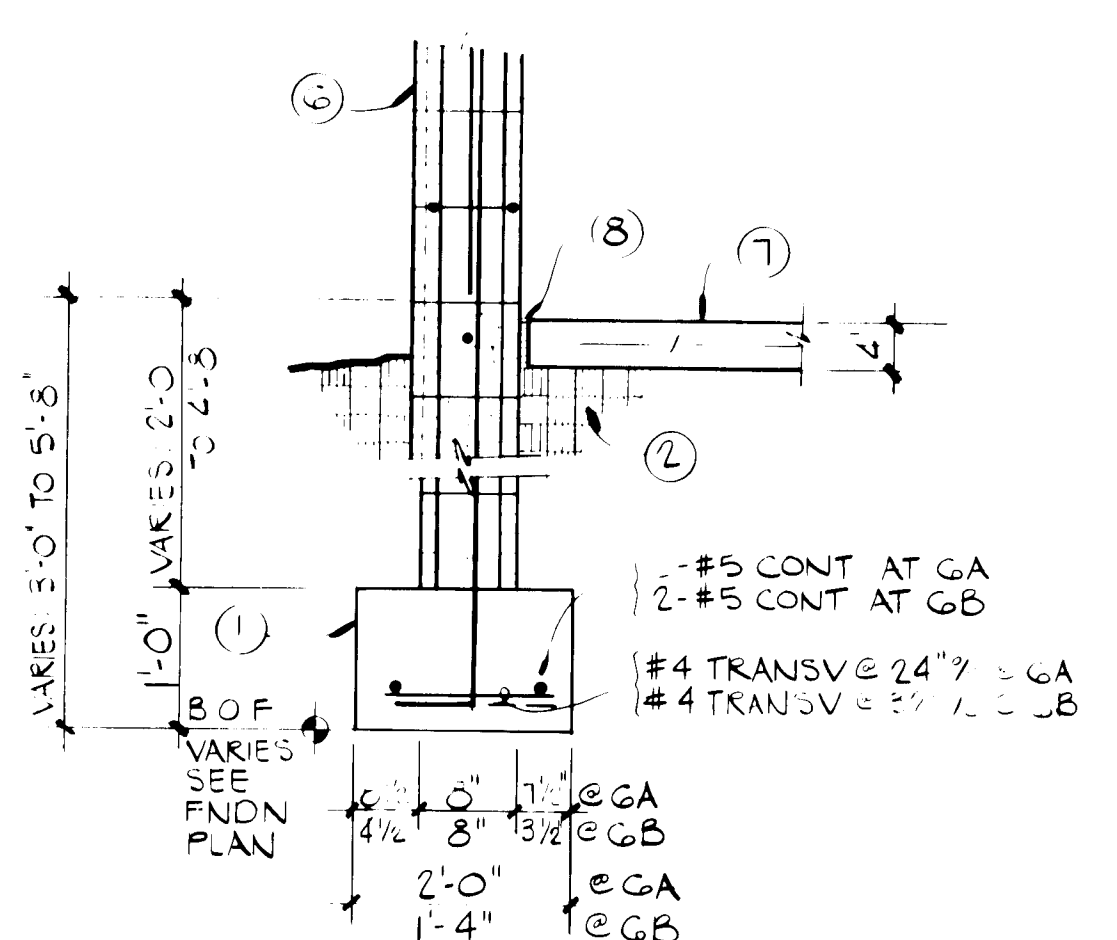


SECTIONS 6A, 6B

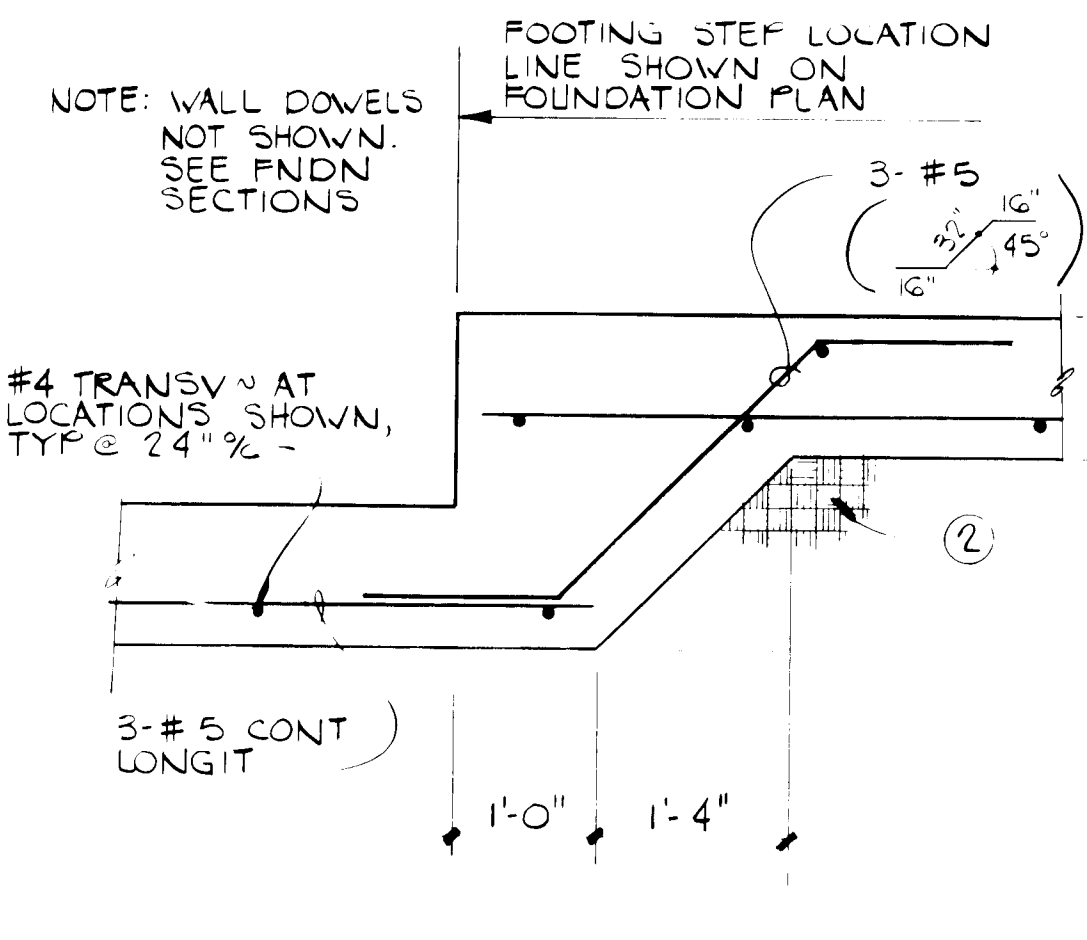


SECTION 7
(TYPICAL FOOTING STEP)

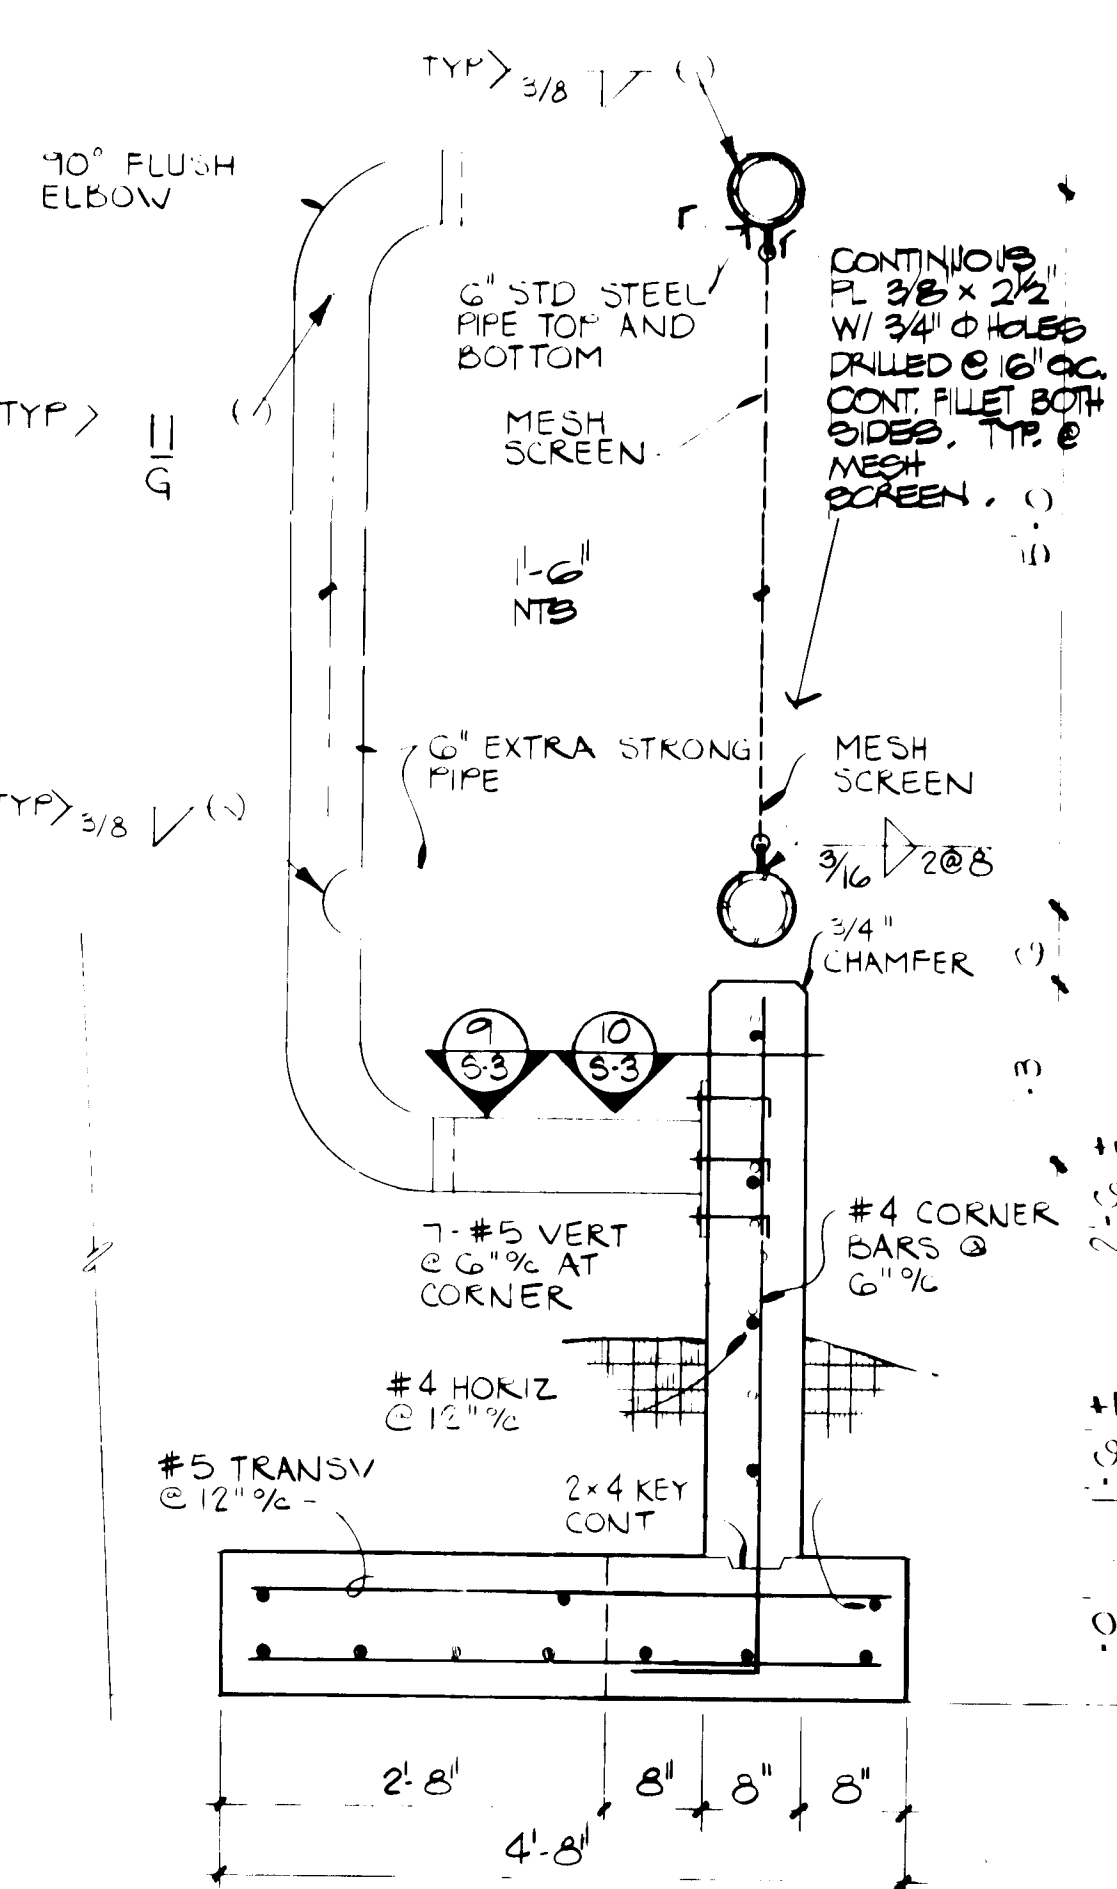


SECTION 8

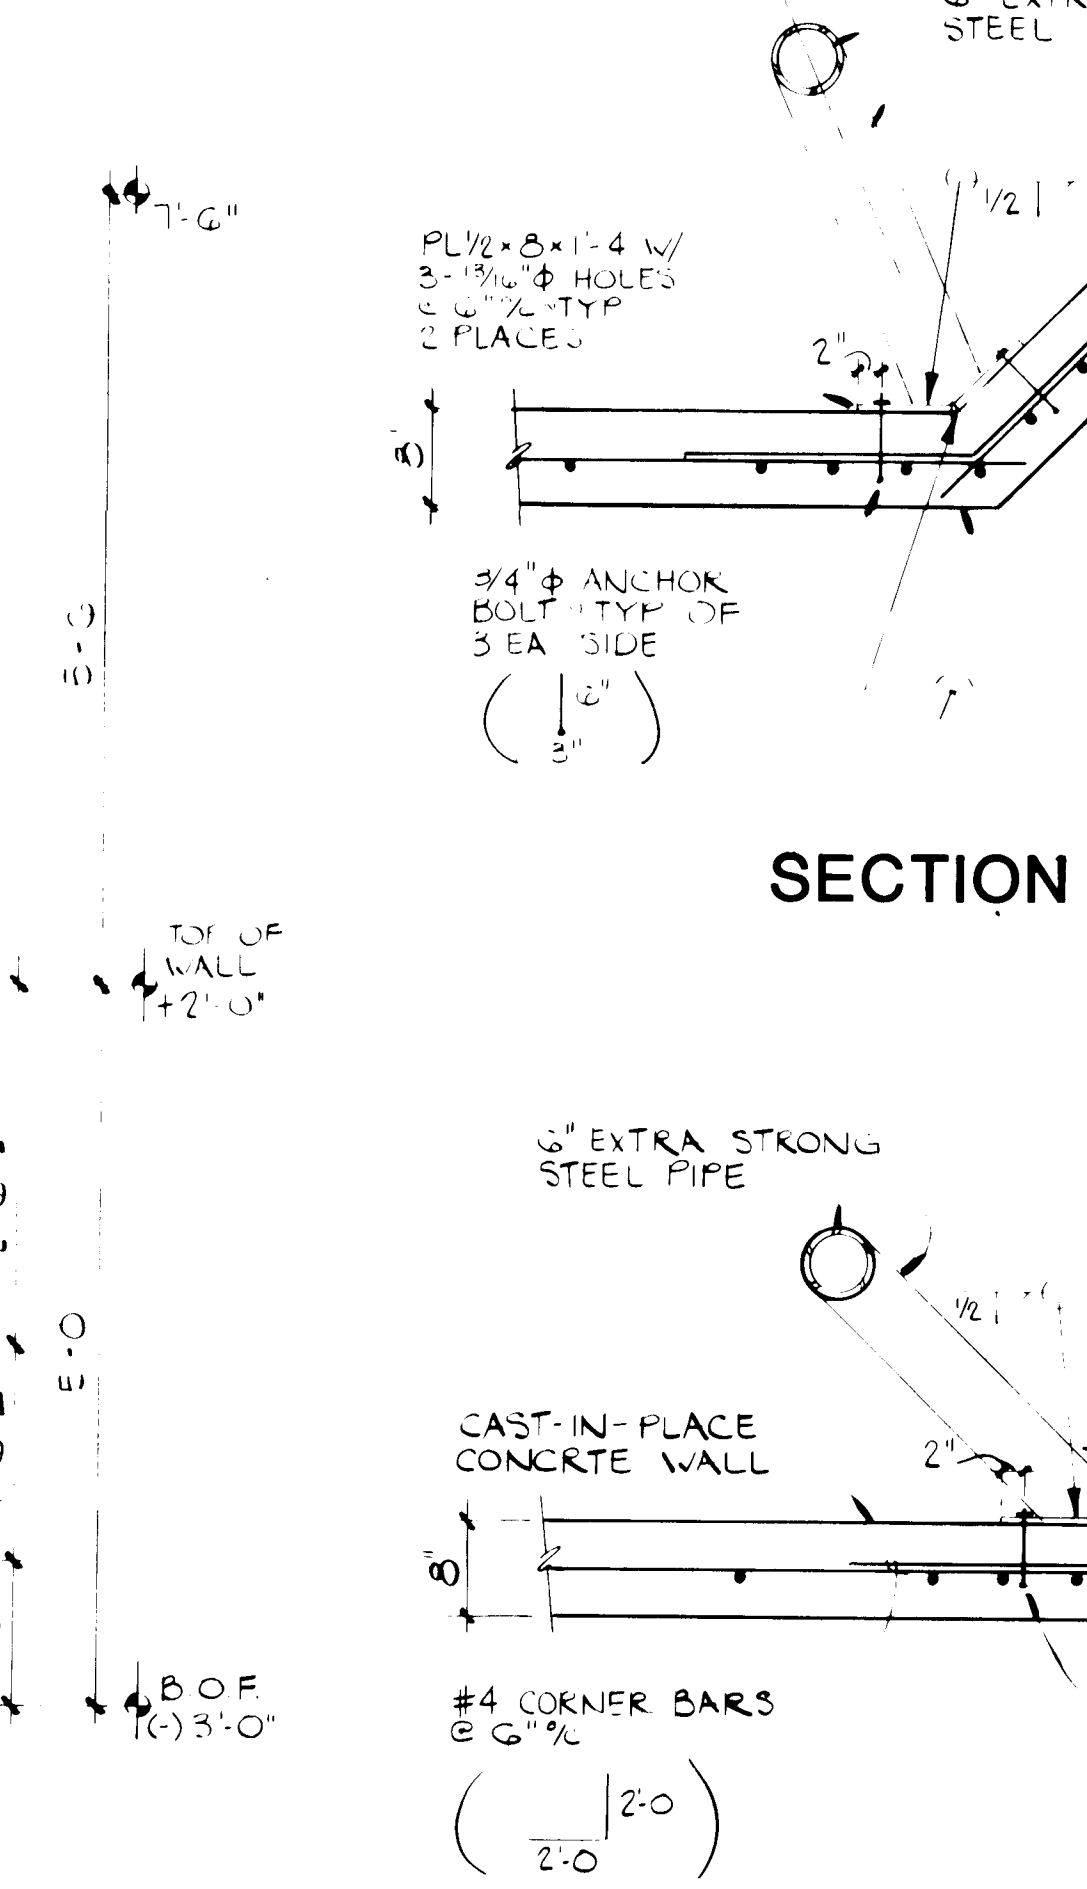


SECTION 9

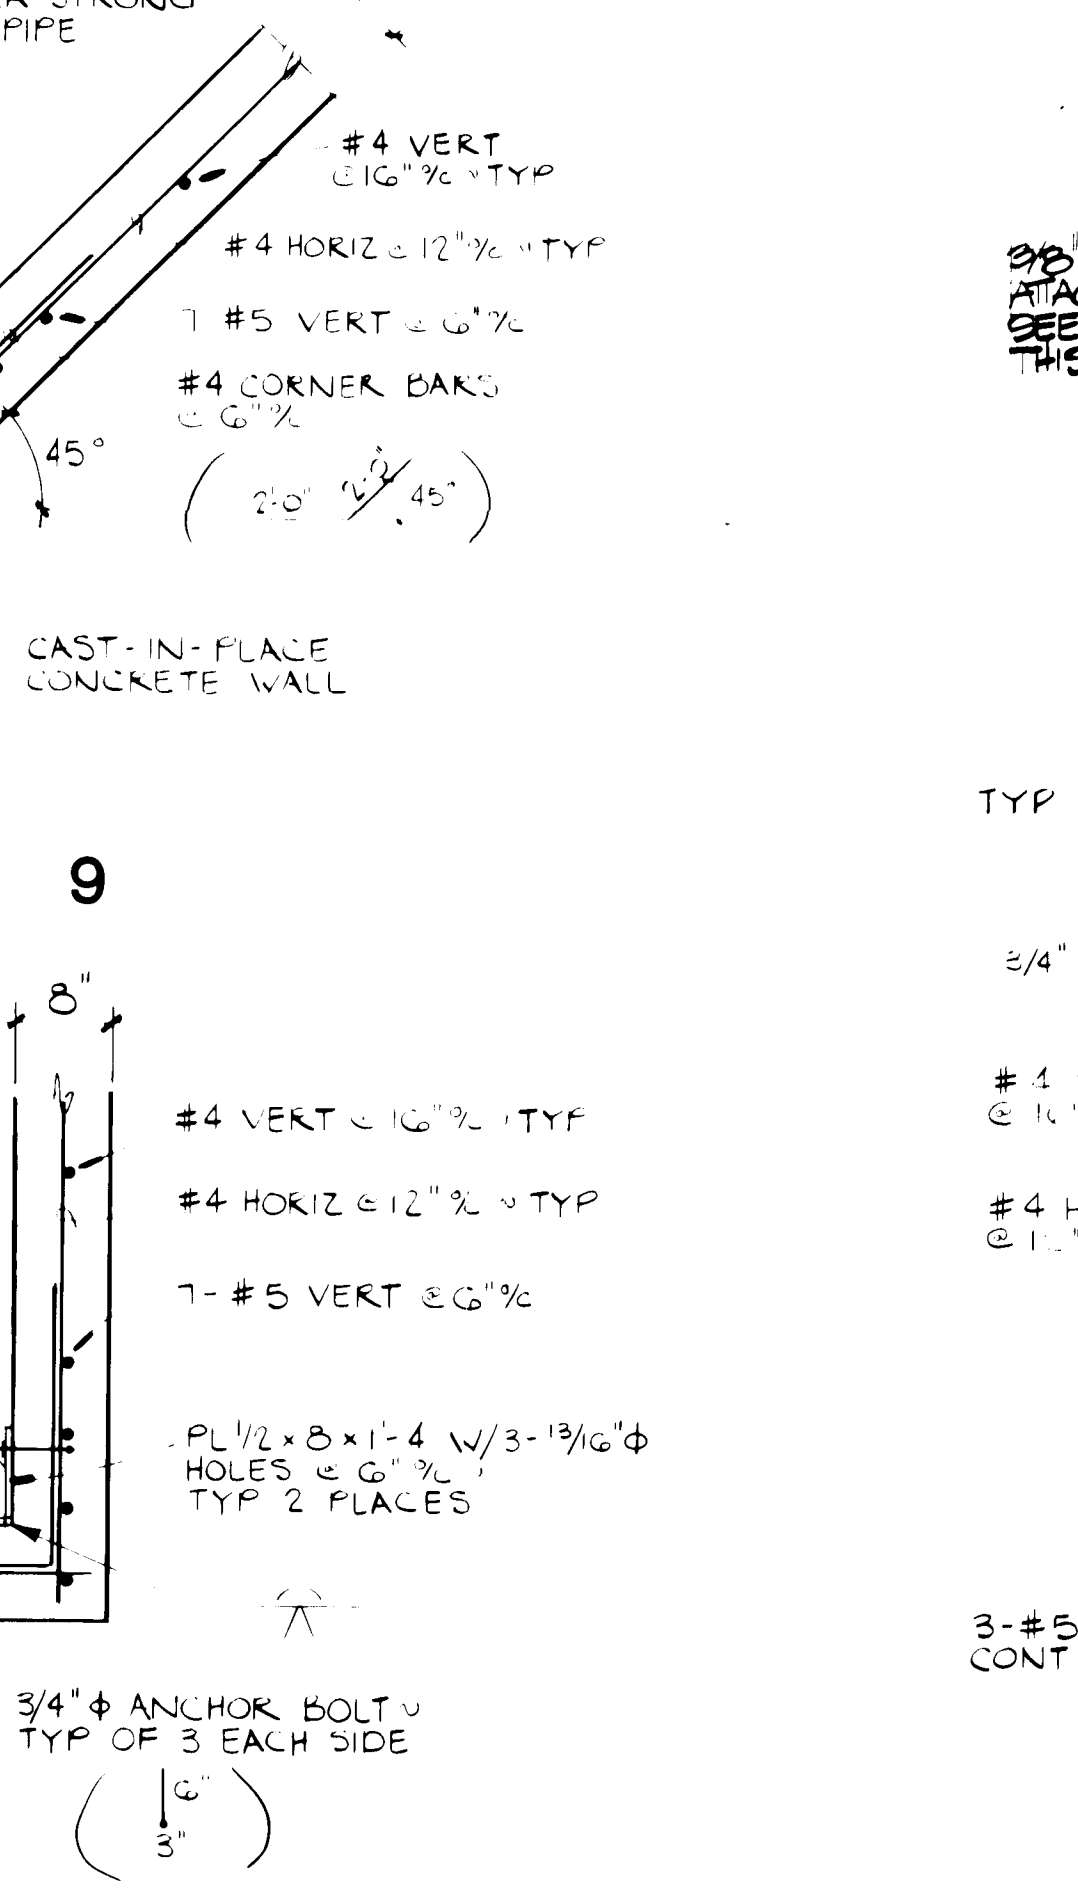

SECTION 10

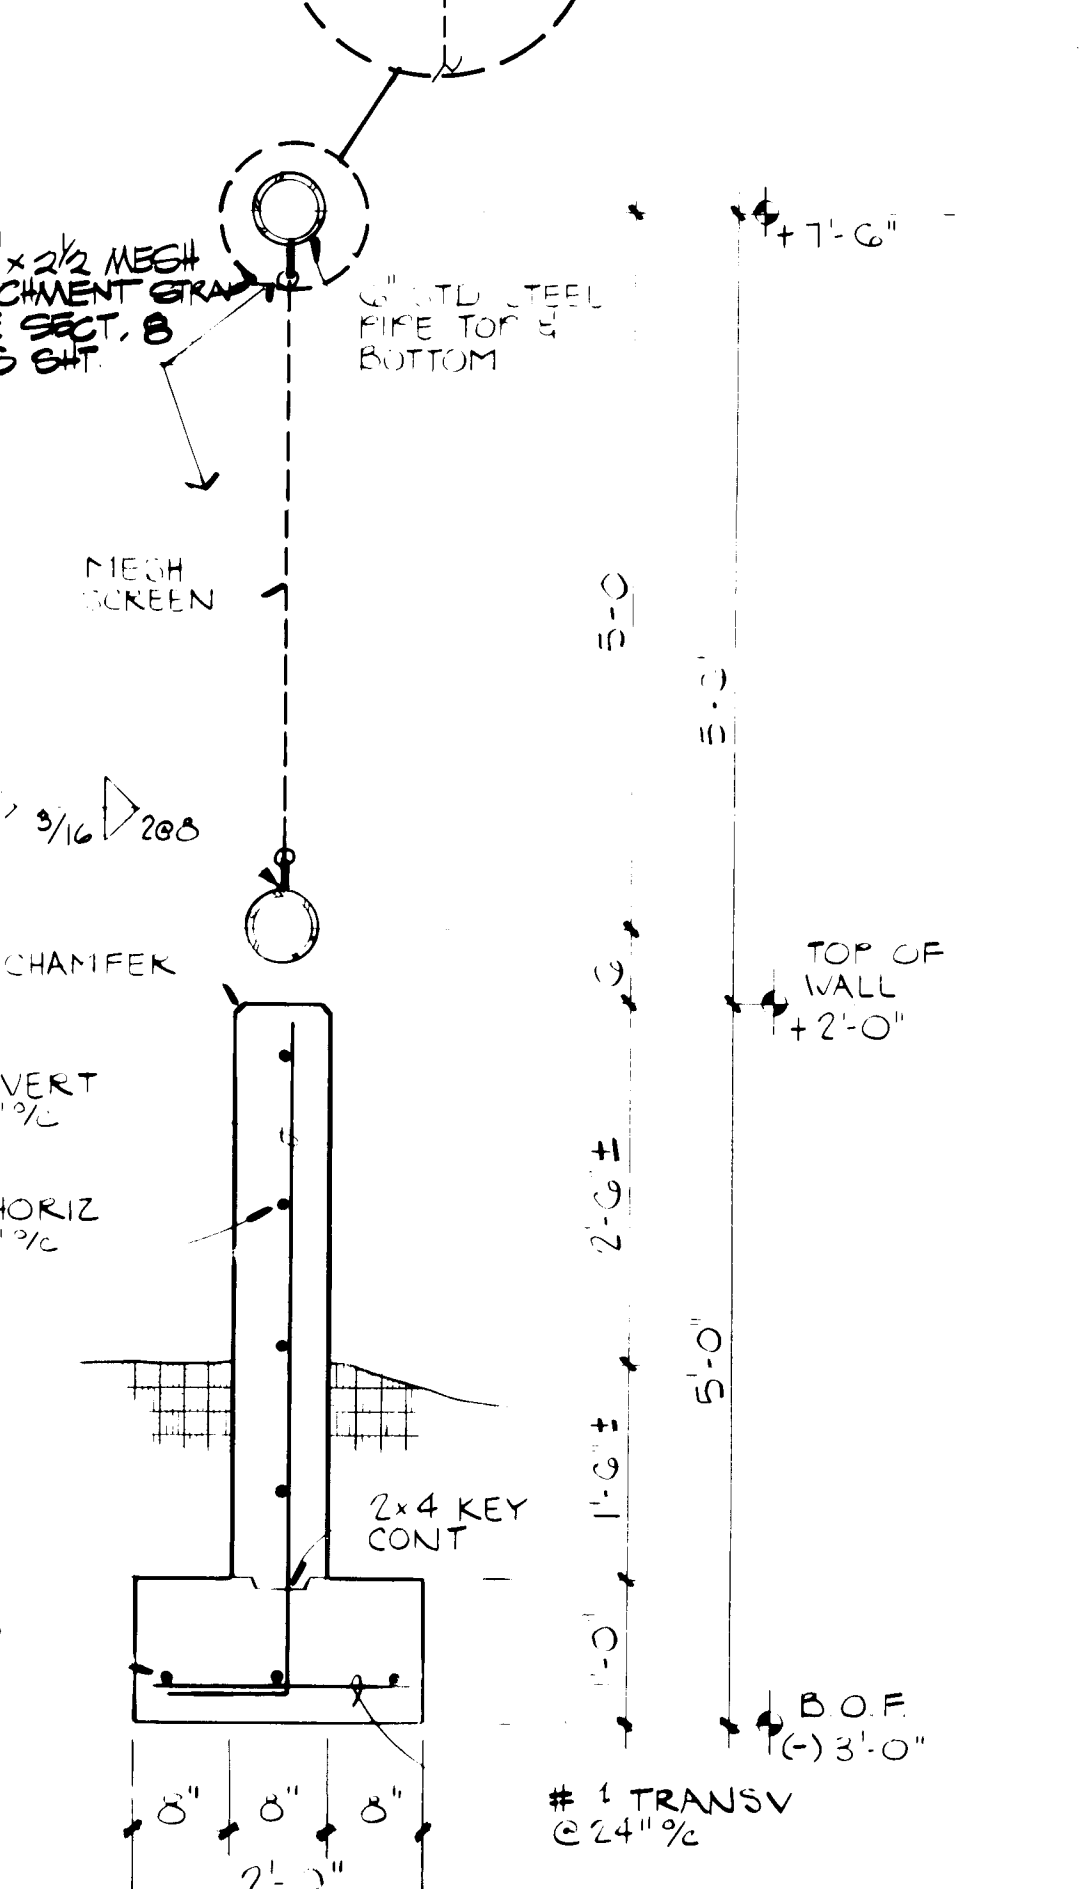

SECTION 11

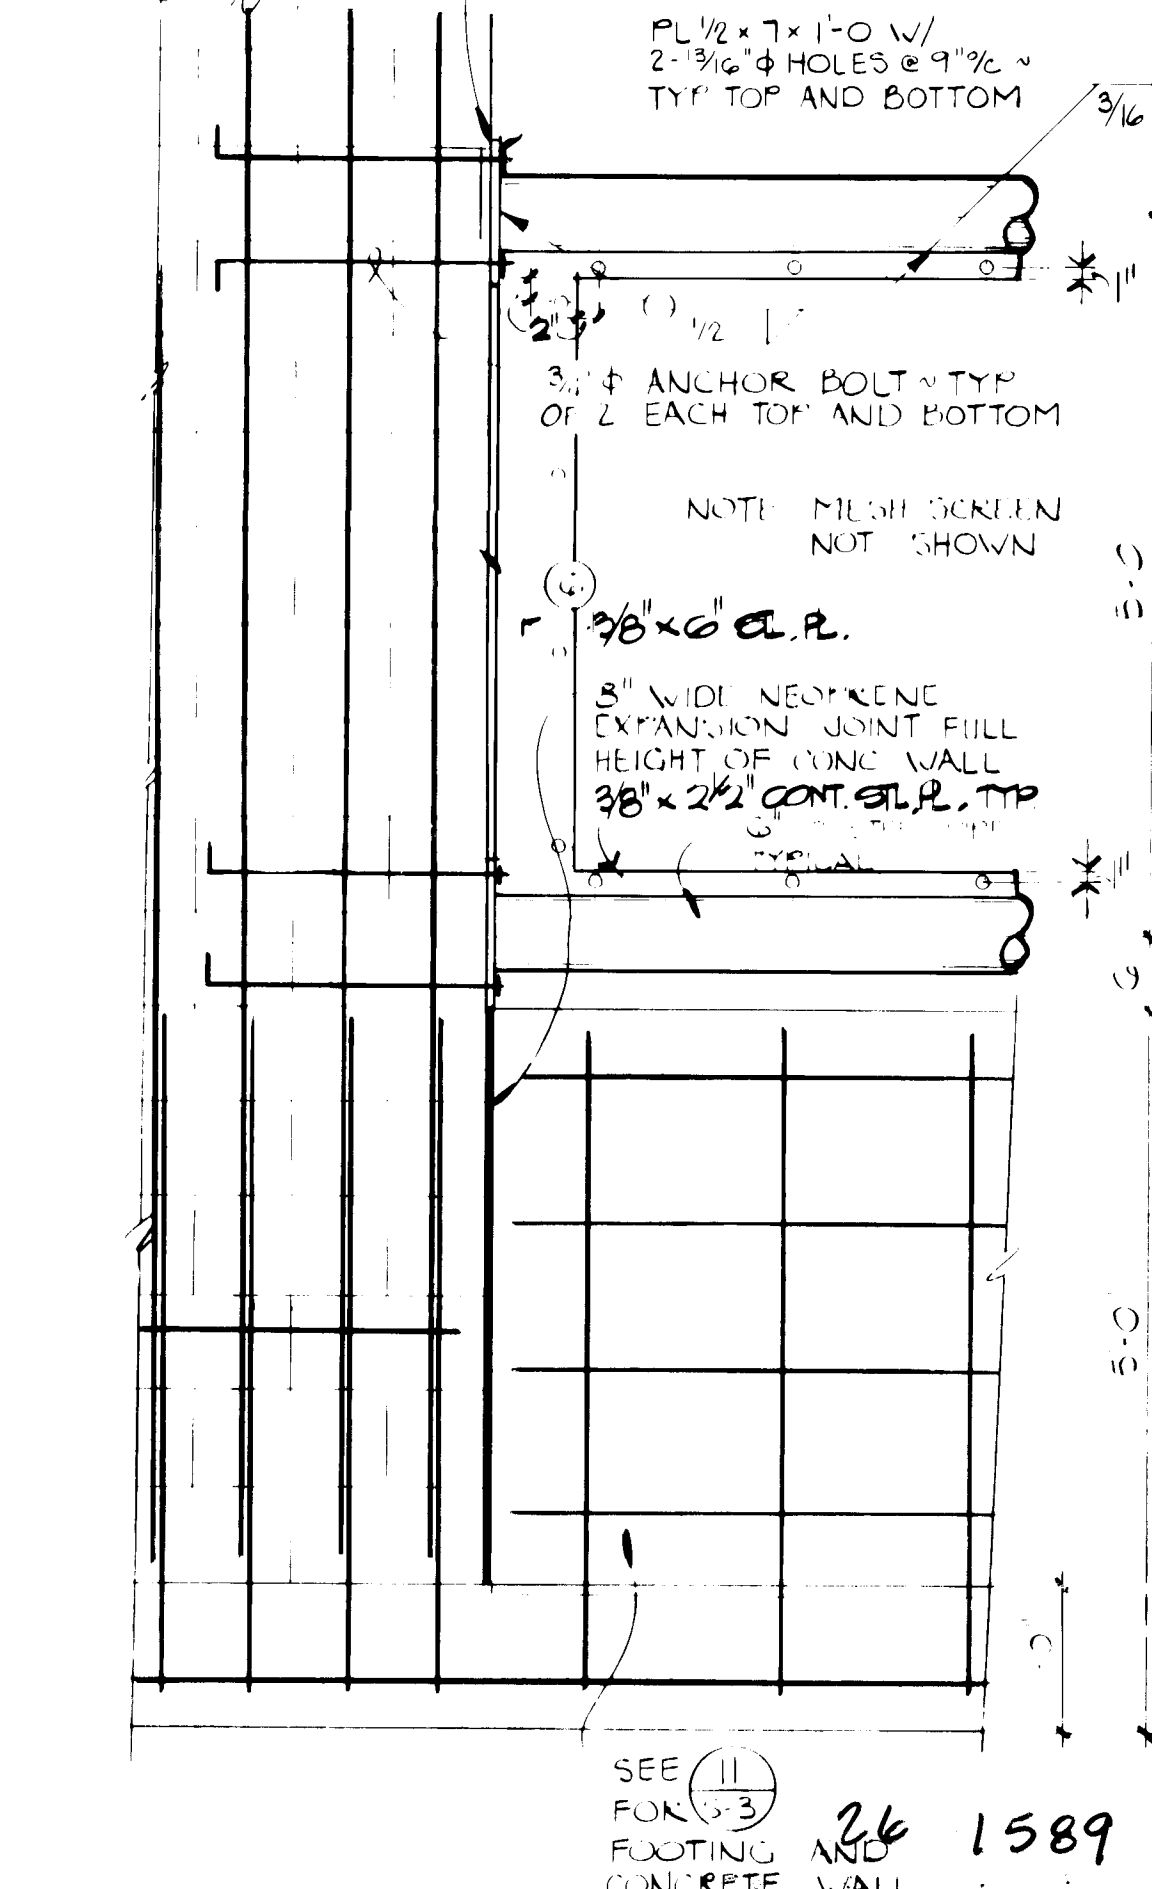

SECTION 12

SCALE: 3/4" = 1'-0"



KEYED NOTES - FOUNDATION SECTIONS


- Continuous concrete footing reinforced as shown. See also notes and details on Sheet S-2.
- Compacted fill/backfill. See notes on Sheet S-1 and specifications for requirements.
- Exterior backfill. See site plan for finish grade.
- Subgrade rigid perimeter insulation, R=5 (minimum).
- 4" thick concrete slab on grade reinforced with WWP 6x6-W2.1xW2.1.
- Concrete masonry wall. See notes and details on Sheet S-2 for reinforcing. See building elevation for type of unit required.
- 4" concrete sidewalk reinforcing with WWP 6x6-W1.4xW1.4.
- 1/2" expansion joint.
- 30# felt isolation joint.

BURNS/PETERS GROUP ARCHITECTS
RECORD DRAWING
DATE 12 SEPT 84
WILLIAM L. PETERS

REVISIONS

Charles Bacchus

ENGINEER

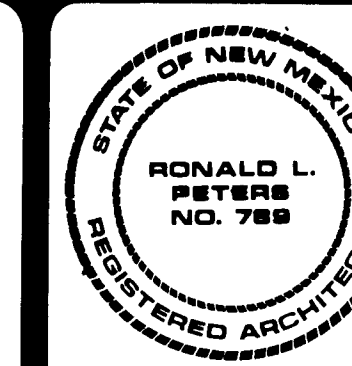


ARCHITECT


THE EAST-CENTRAL
MULTI-SERVICE
CENTER

PROJECT NO. 20205 DATE MAY '83


S3
SHEET 10 OF 22

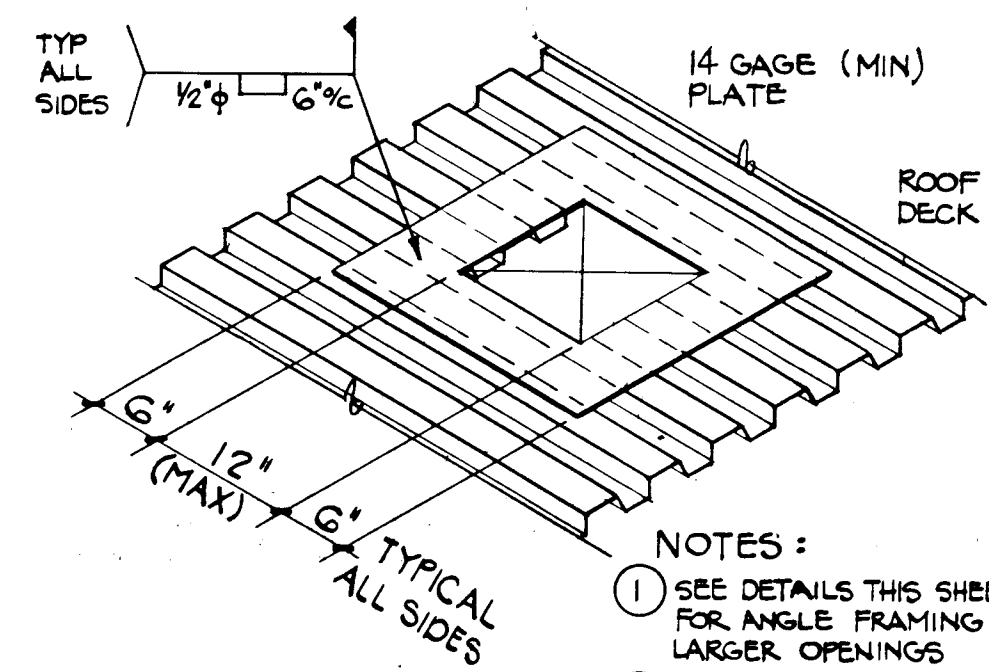


REINFORCING DETAIL - SMALL OPENINGS IN ROOF DECK
NO SCALE

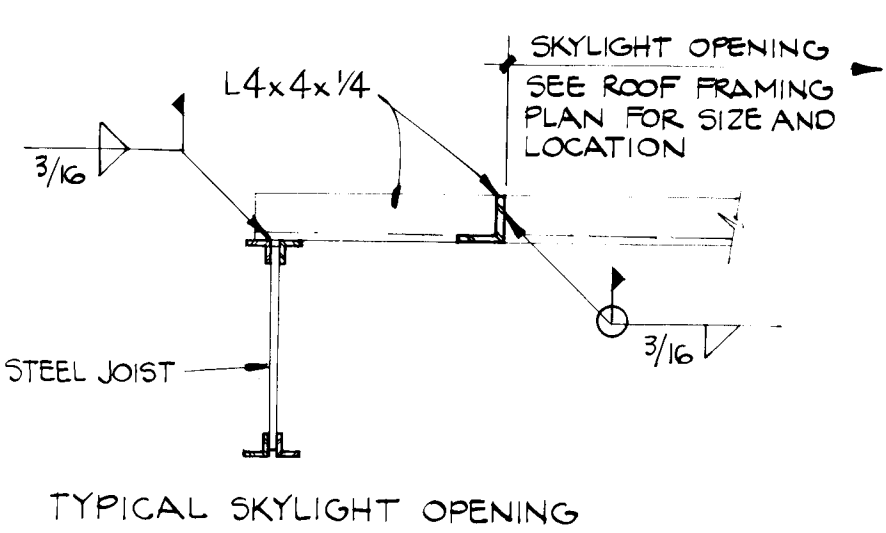

SECTION 1

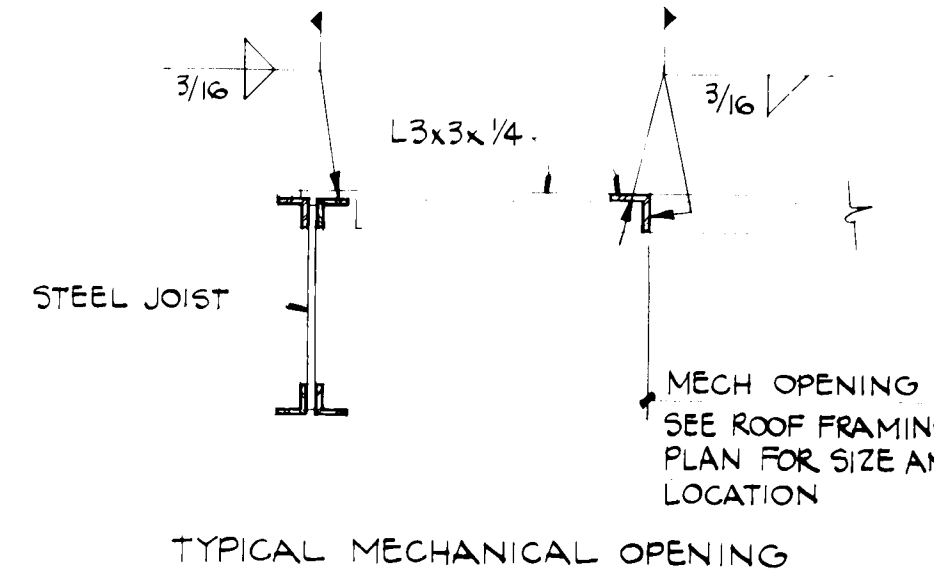


SECTION 2

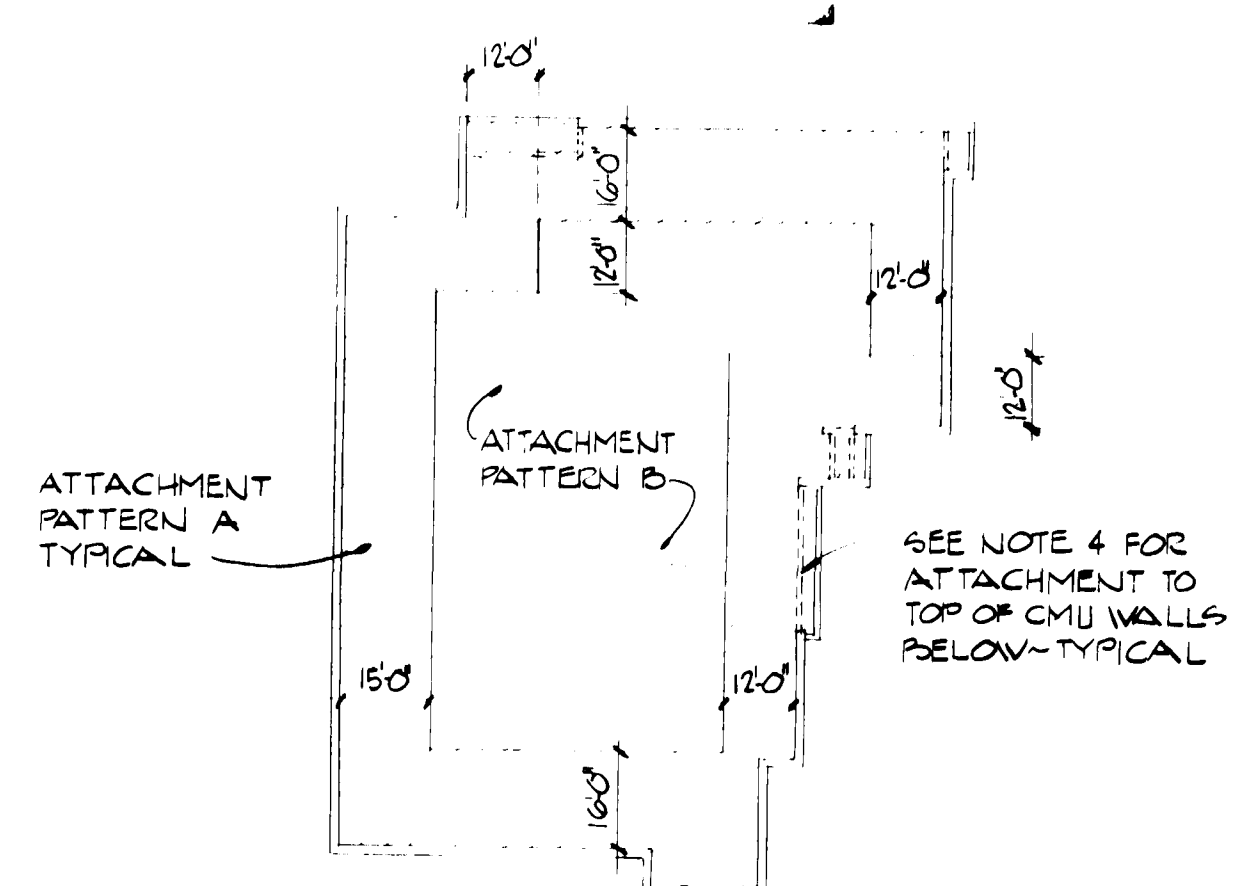

KEY PLAN - ROOF DECK ATTACHMENT

NOTES - ATTACHMENT OF ROOF DECK

- GENERAL. Roof deck shall be attached to the supporting framework using 1/2" #8 (minimum) puddle welds, spaced as noted below. Standard welding washers are required. Deck units shall be attached to each other by button punching at intervals noted below.
- ATTACHMENT PATTERN "A".
 - Deck units to supporting members: Weld at all deck valleys including valleys at side laps; weld at 18" o/c maximum along perimeter angles parallel to span of units.
 - Deck units to each other: Button punch over each support and at 12" o/c maximum between supports.
- ATTACHMENT PATTERN "B".
 - Deck units to supporting members: Weld at side valleys between units and at alternate valleys between; weld all valleys at end laps between units.
 - Deck units to each other: Button punch over each support and, at 24" o/c maximum between supports.
- DECK TO CMU WALLS. Connect using 3/8" #4 x 4" drilled anchors at each side valley between deck units and at alternate valleys between (12" o/c maximum).

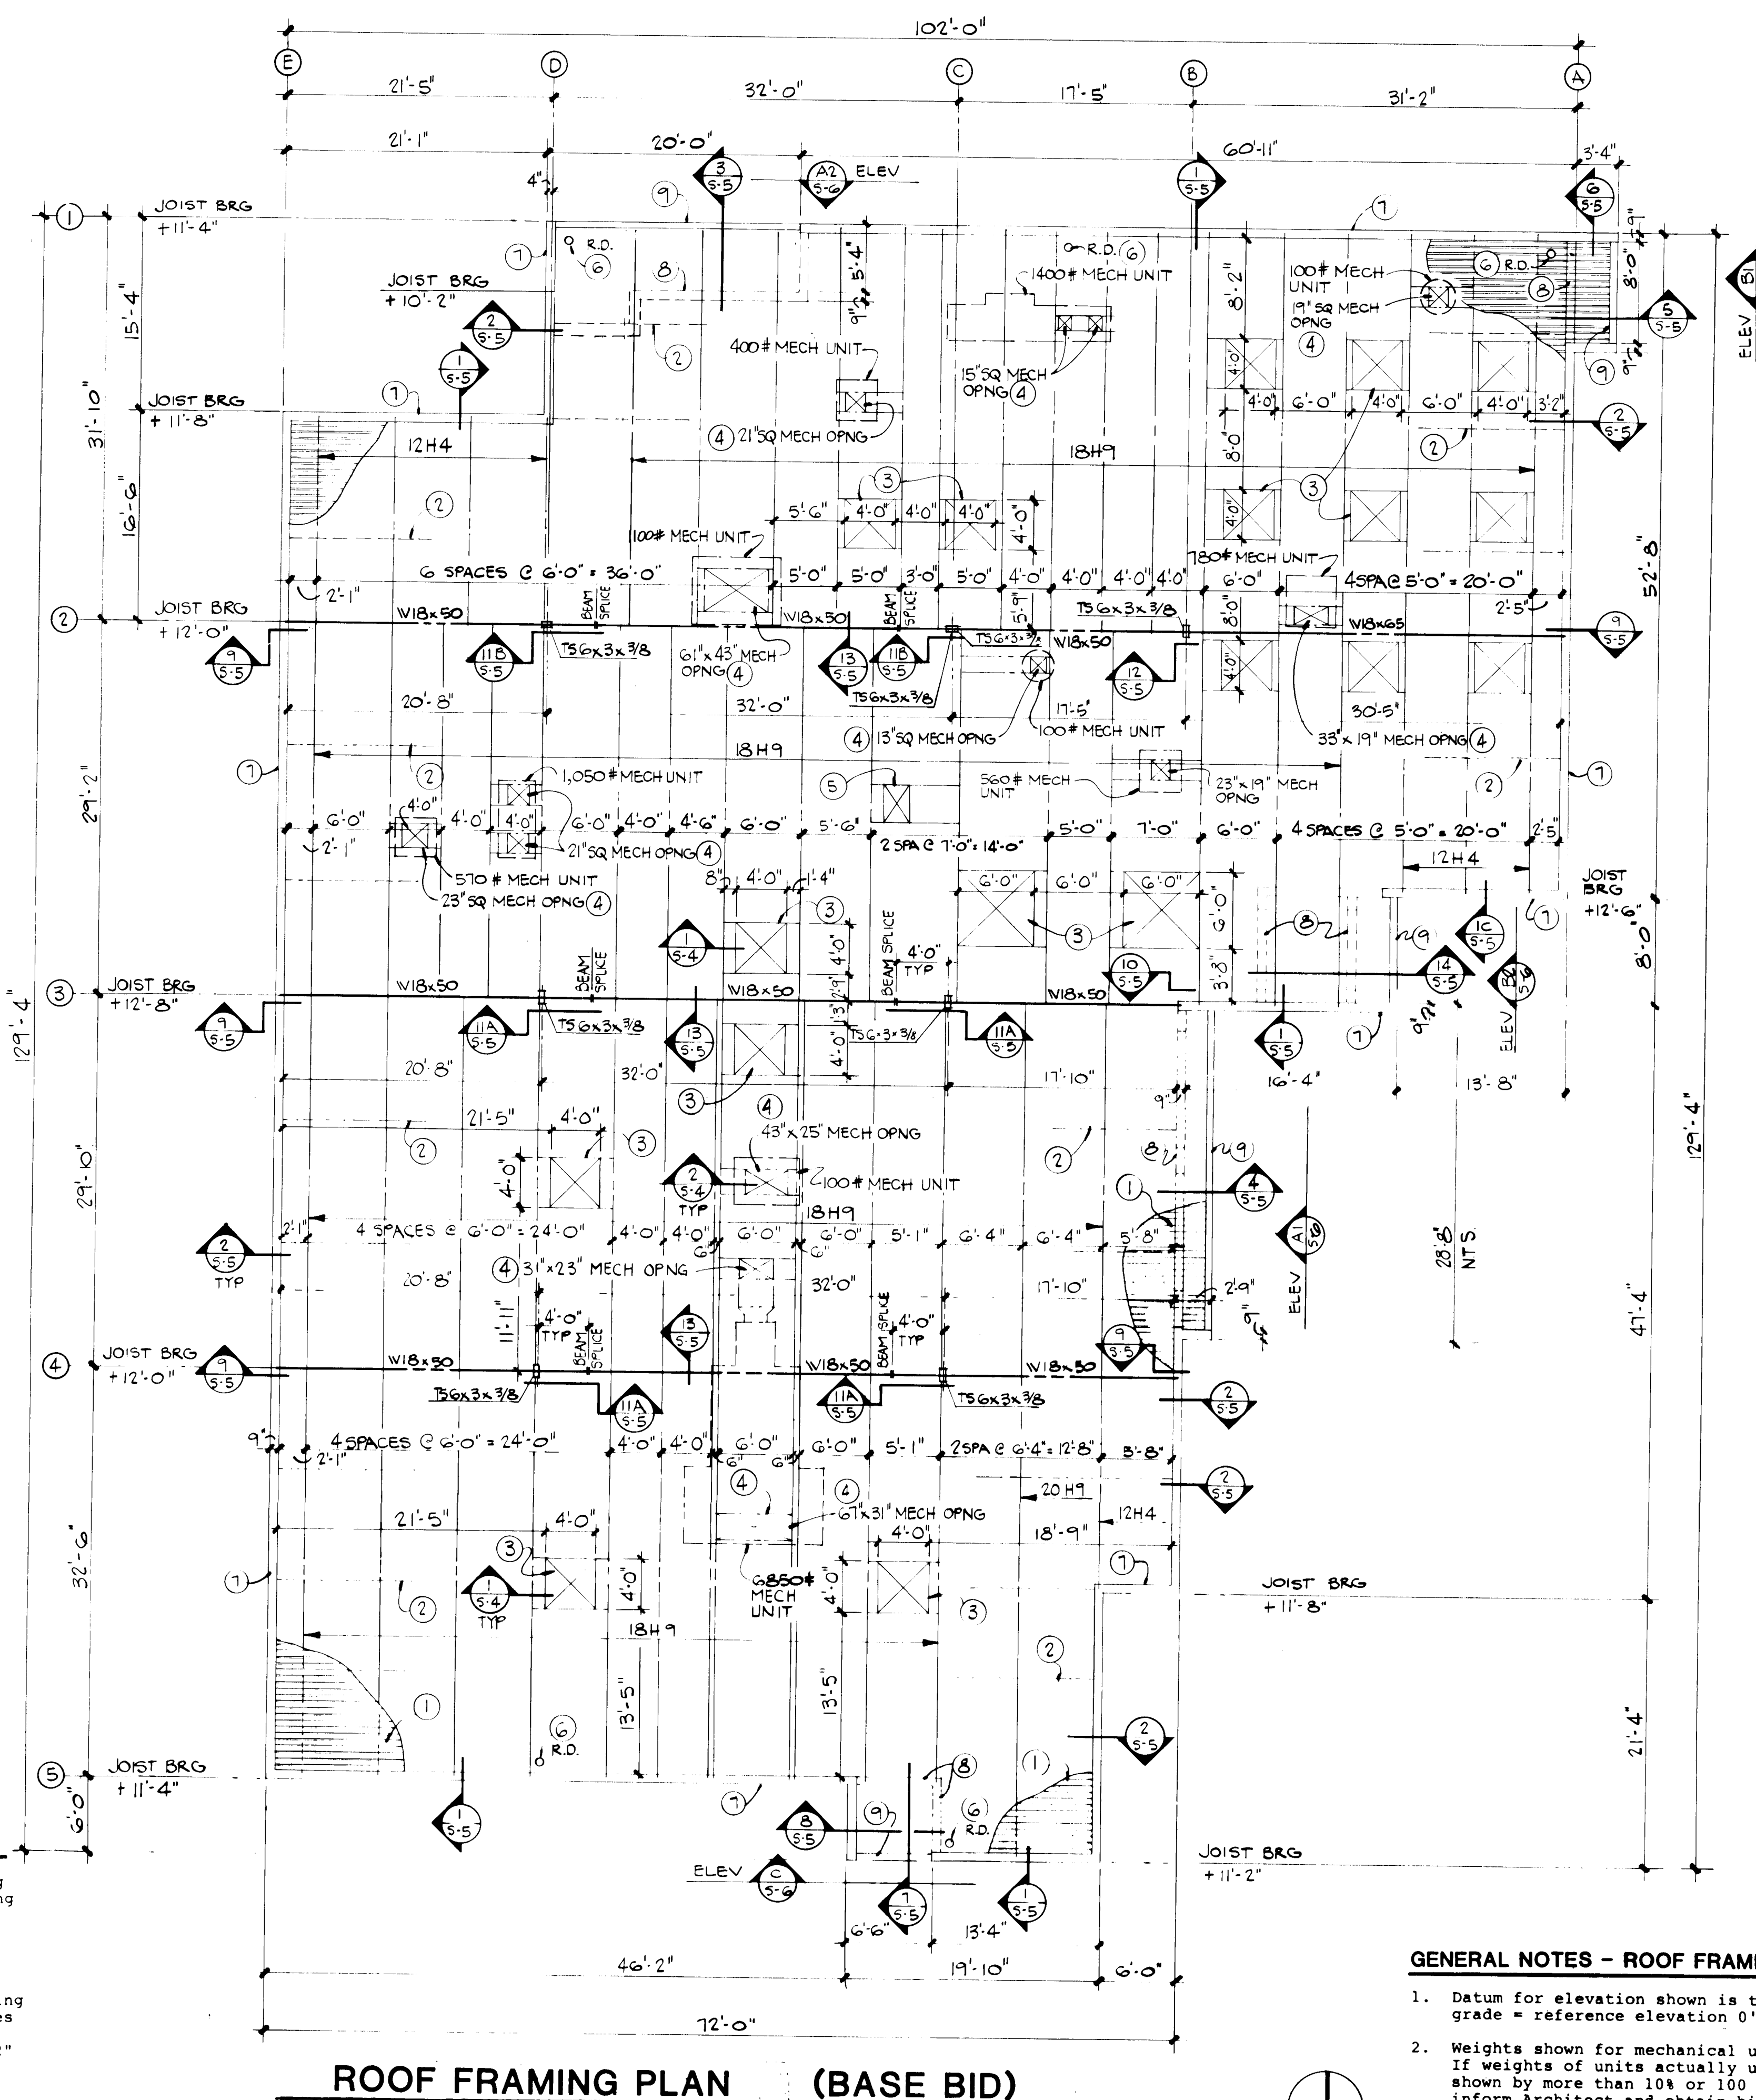


ROOF FRAMING PLAN (BASE BID)

1/8" = 1'-0"

GENERAL NOTES - ROOF FRAMING PLAN

- Datum for elevation shown is top of interior slab on grade = reference elevation 0'-0".
- Weights shown for mechanical units are design weights. If weights of units actually used exceed weights shown by more than 10% or 100 lbs whichever is greater, inform Architect and obtain his instructions before installing the overweight unit(s).
- See Sheet S-7 for framing if alternate bid is accepted.

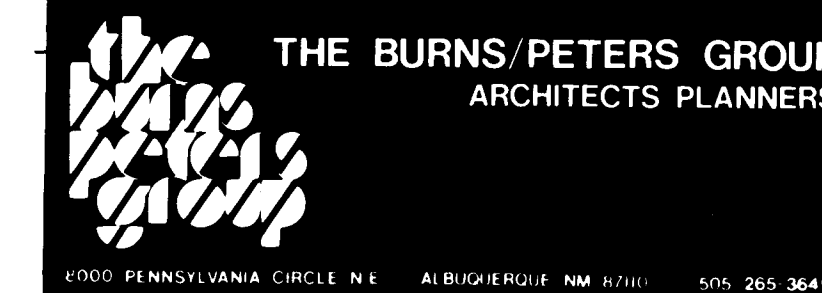


KEYED NOTES - ROOF FRAMING PLAN

- 20 gage type B steel roof deck. See notes and detail this sheet for connections. See typical detail this sheet for reinforcing around small openings in deck.
- 1-1/4x1-1/4x1/8 continuous angle horizontal joist bridging at top and bottom chords. Number and approximate location of rows as shown. See roof framing sections on Sheet S-5 for attachment to joists and walls.
- 4'-0" square (nominal), except as shown otherwise, rough opening for skylight. Verify exact size of opening with skylight details. See section 1 this sheet for framing around opening.
- Mechanical opening, size as indicated to be verified with mechanical contractor. See section 2 this sheet for framing around opening.
- Opening for 2'-0"x3'-0" roof hatch. Verify exact size with hatch detail. See section 1 this sheet for framing.
- Roof drain. See typical detail this sheet for required reinforcing at opening. Verify details with mechanical drawings.
- Concrete masonry wall. See notes and details on S-2 and FOUNDATION PLAN, Sheet S-1 for reinforcing. See building elevations for type of units required.
- Concrete masonry wall below with top elevation as shown on framing sections. See also note 7 above.
- Light gage steel framed fascia. See Sheet S-6 for notes and details of construction.

BURNS/PETERS GROUP ARCHITECTS
RECORD DRAWING
DATE 12 SEPT 84
Charles Bacchus

REVISIONS

Charles Bacchus
ENGINEER

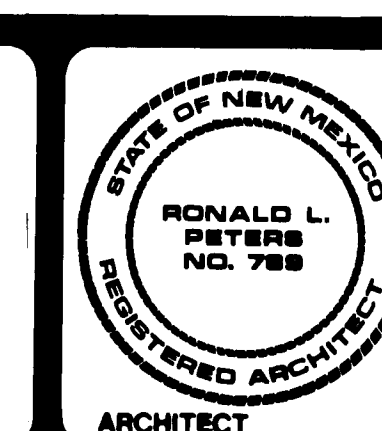


THE EAST-CENTRAL MULTI-SERVICE CENTER

PROJECT NO. 8105 DATE MAY '83

S4
SHEET 11 OF 26

26 1589 1184

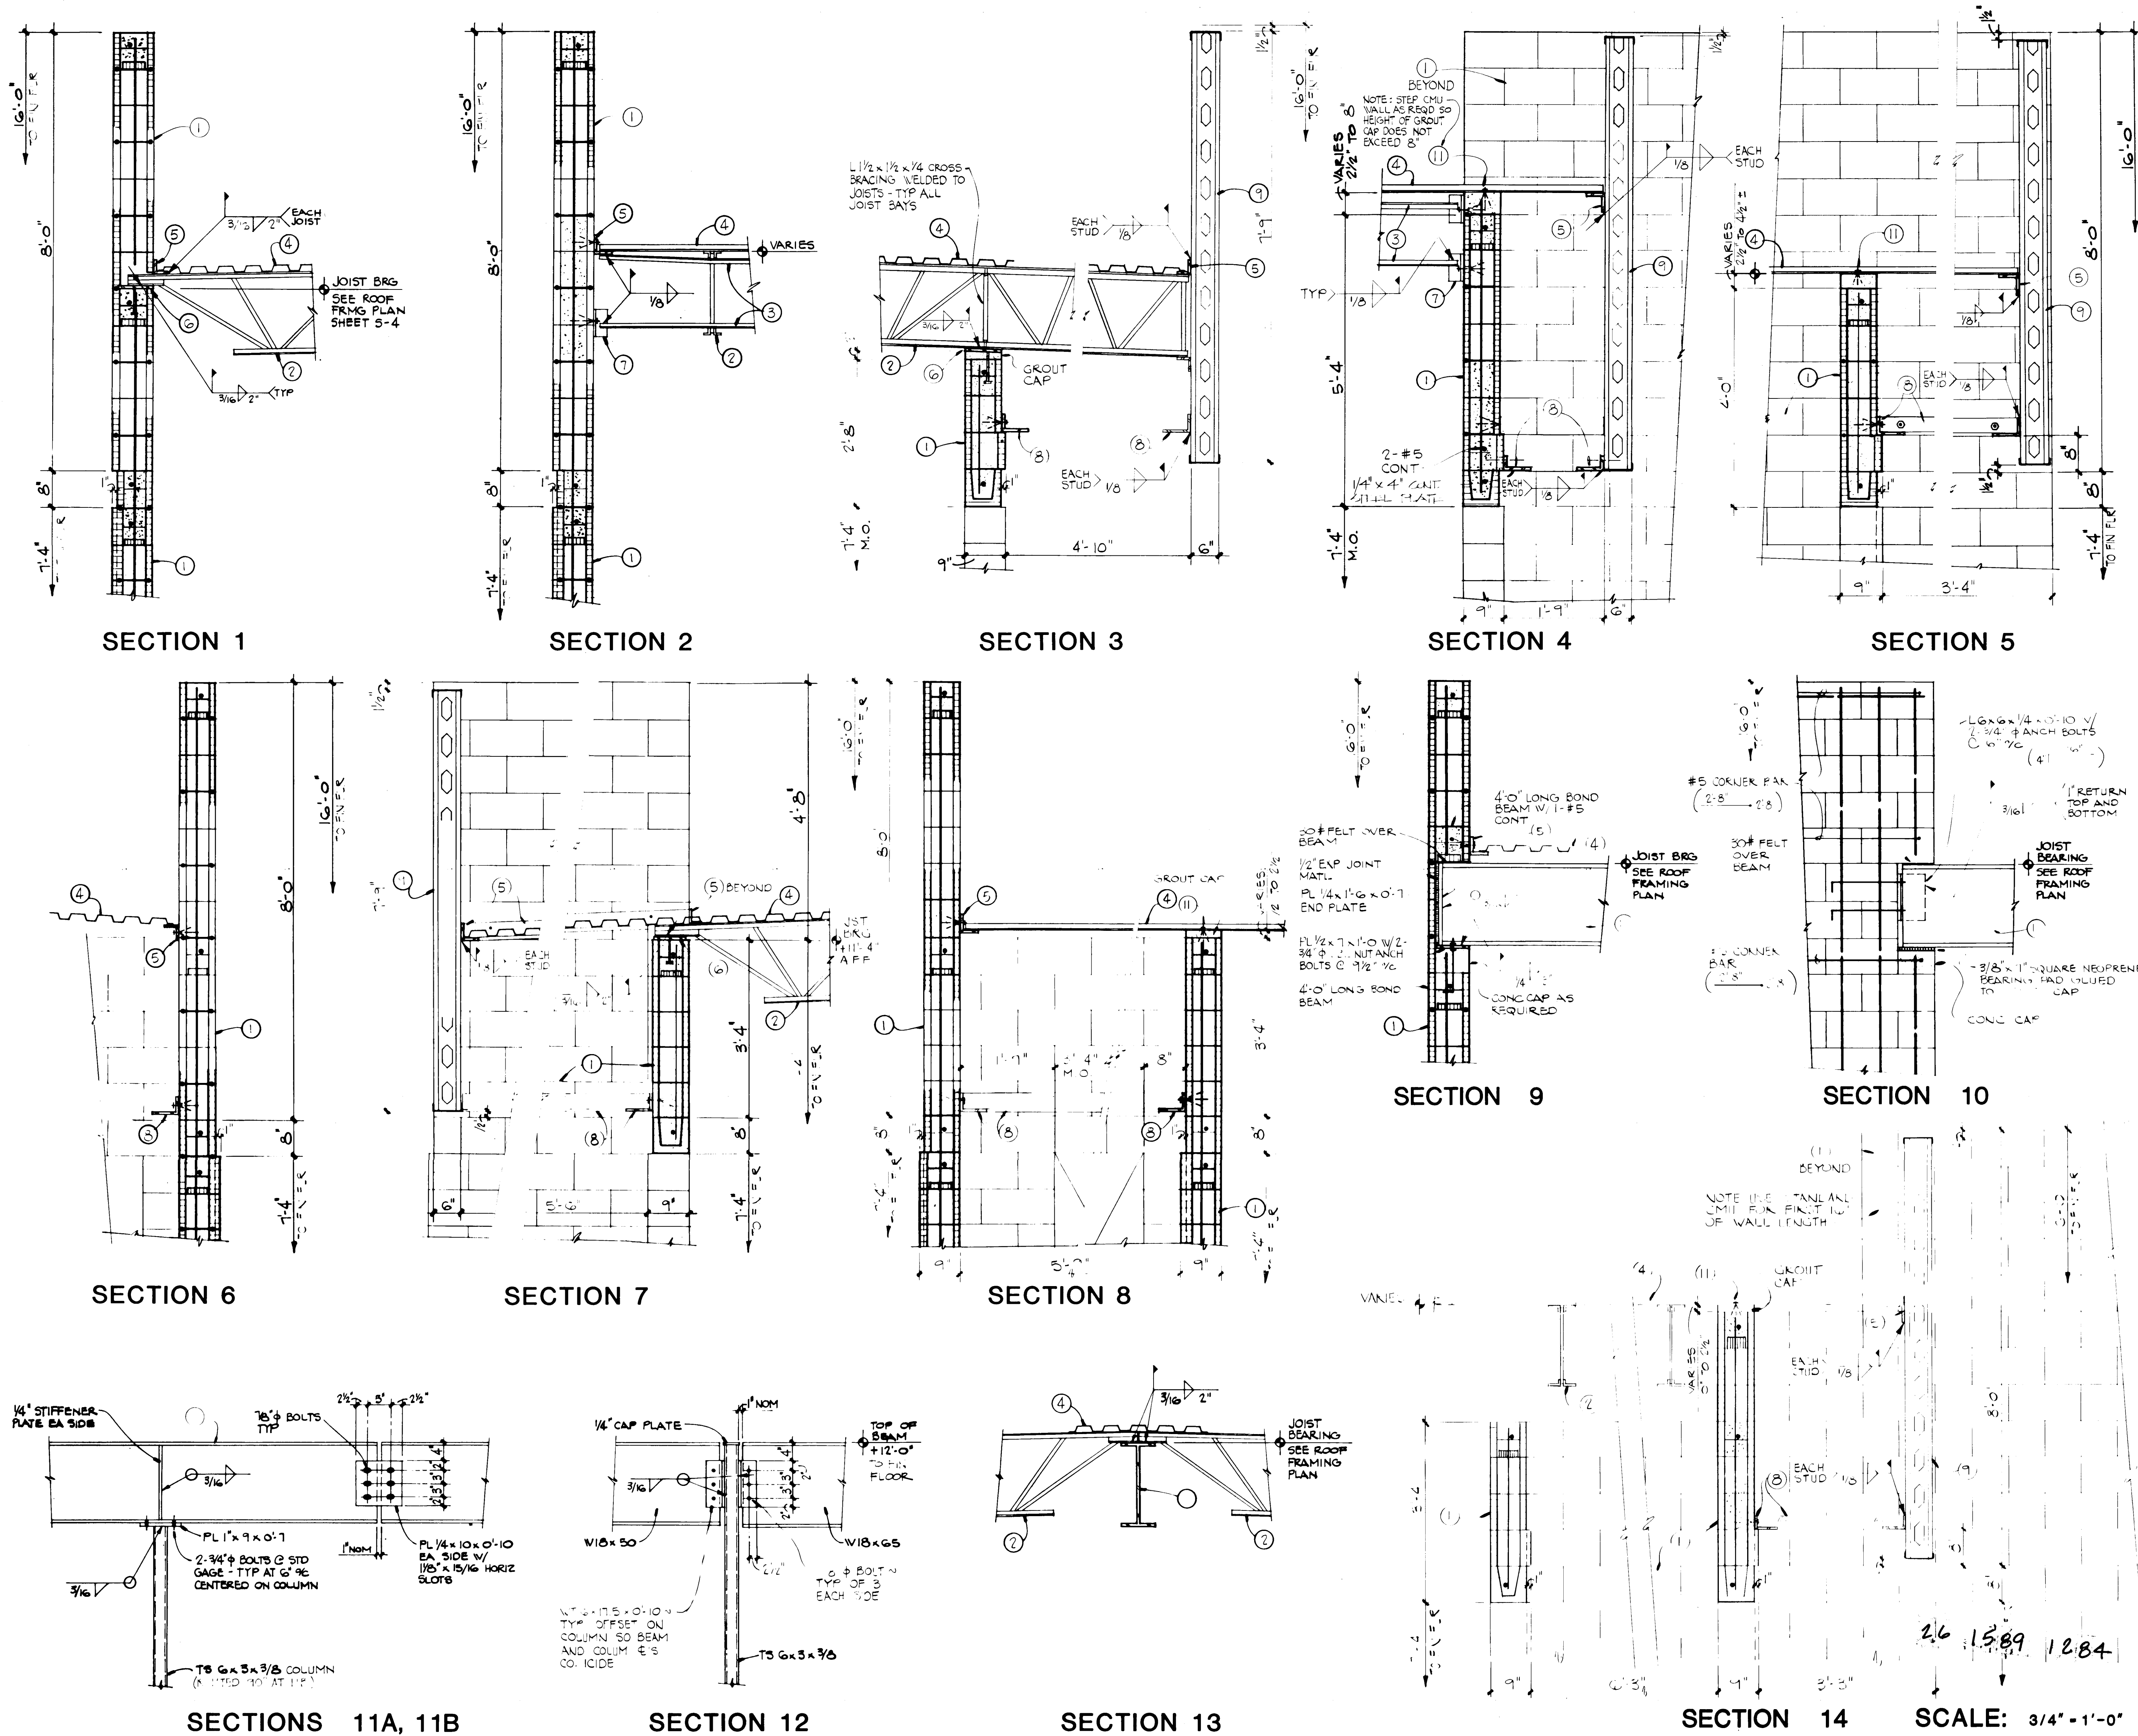

THE BURNS/PETERS GROUP
ARCHITECTS PLANNERS

1000 PENNSYLVANIA CIRCLE, N.E. ALBUQUERQUE, N.M. 87102 505/265-3645

**KEYED NOTES
ROOF FRAMING SECTIONS**

- Concrete masonry wall. See notes and details on Sheet S-2 for reinforcing. See building elevations for type of unit required.
- H series open web steel joists. See ROOF FRAMING PLAN, Sheet S-4, for size, spacing and length.
- Joist bridging. See ROOF FRAMING PLAN, Sheet S-4, for number and location of rows.
- Steel roof deck. See Sheet S-4 for connection to supporting members.
- Continuous 4x4x1/4 steel perimeter angle. Connect to steel members as indicated; connect to cmu walls with 1/2" x 6" drilled expansion anchors @ 32" o/c.
- 3/8x7x1'-0" steel bearing plate with 2-1/2" x 6" drilled expansion anchors @ 32" o/c.
- 3x3x1/4x0'-6" angle with 3/8" x 4" drilled expansion anchor - typical at each line of joist bridging.
- 6x3-1/2x3/8 steel soffit support angle. Connect to steel framing as indicated. Connect to cmu walls with 1/2" x 6" drilled expansion anchors @ 24" o/c.
- Light gage structural steel framing. See sheet S-6 for notes and details of construction.
- Steel beam. See ROOF FRAMING PLAN, Sheet S-4, for size.
- 3/8" x 4" drilled expansion anchor - typical at each side lap valley between units and at alternate valleys (12" o/c maximum) between.

BURNS/PETERS GROUP ARCHITECTS

RECORD DRAWING

DATE: 12 SEPT 81

Charles Bacchus

REVISIONS

Charles Bacchus

ENGINEER

ARCHITECT


RONALD L. PETERS
P.E. 788
REGISTERED ARCHITECT

THE EAST-CENTRAL MULTI-SERVICE CENTER


PROJECT NO. 8105 DATE MAY '83

S5


SHEET 12 OF 36

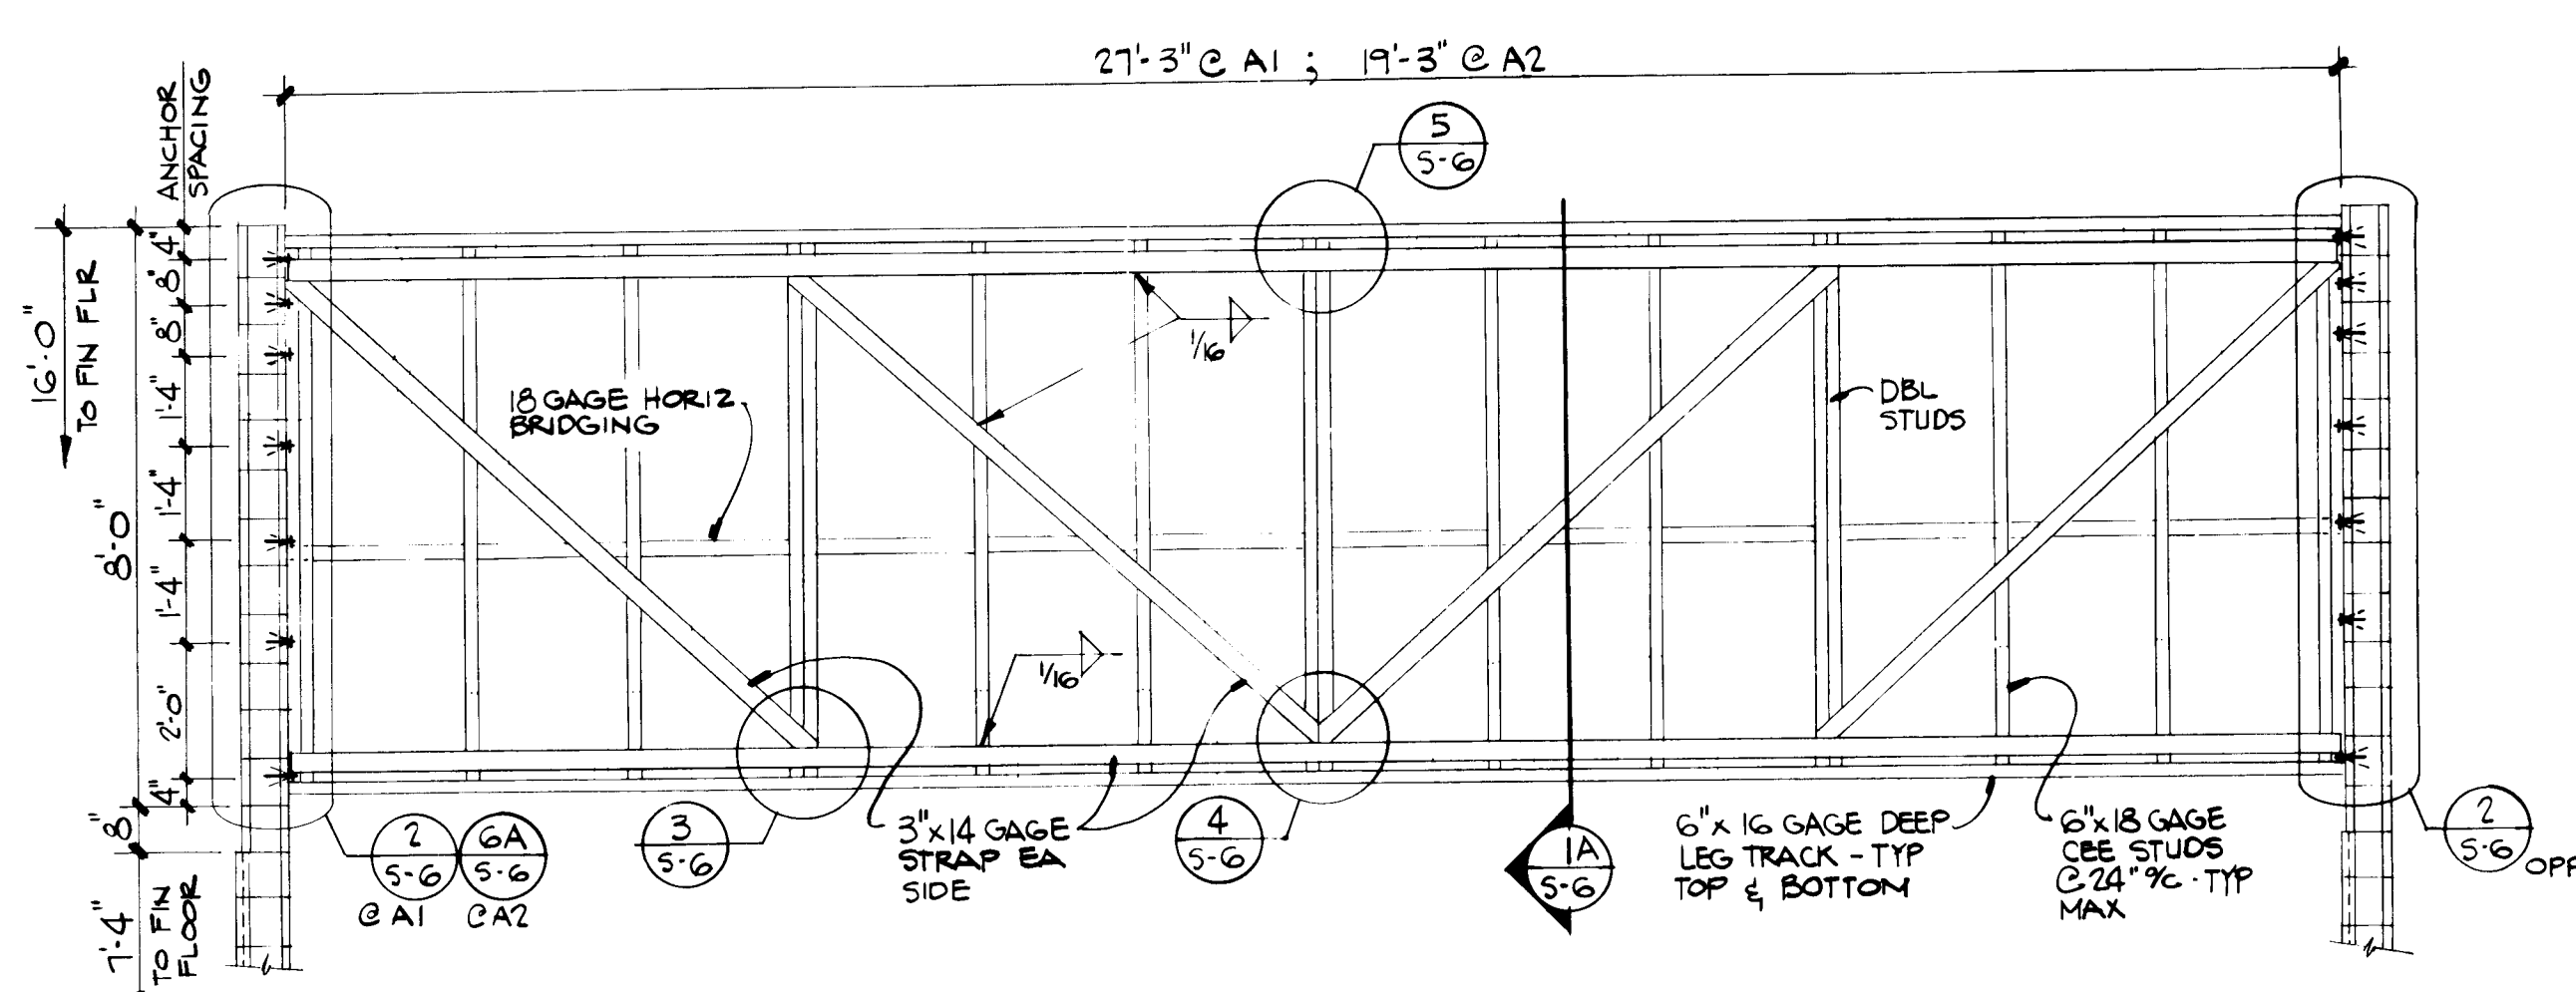


ELEVATION A1 / A2

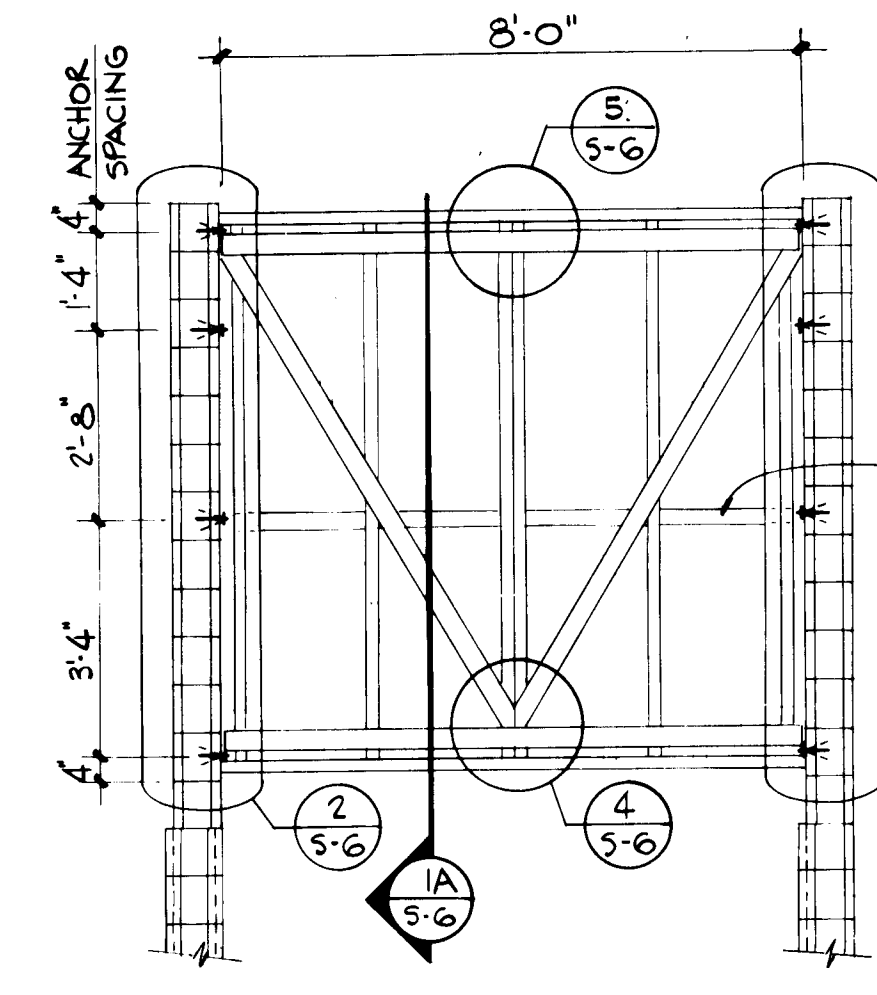


ELEVATION B1 / B2

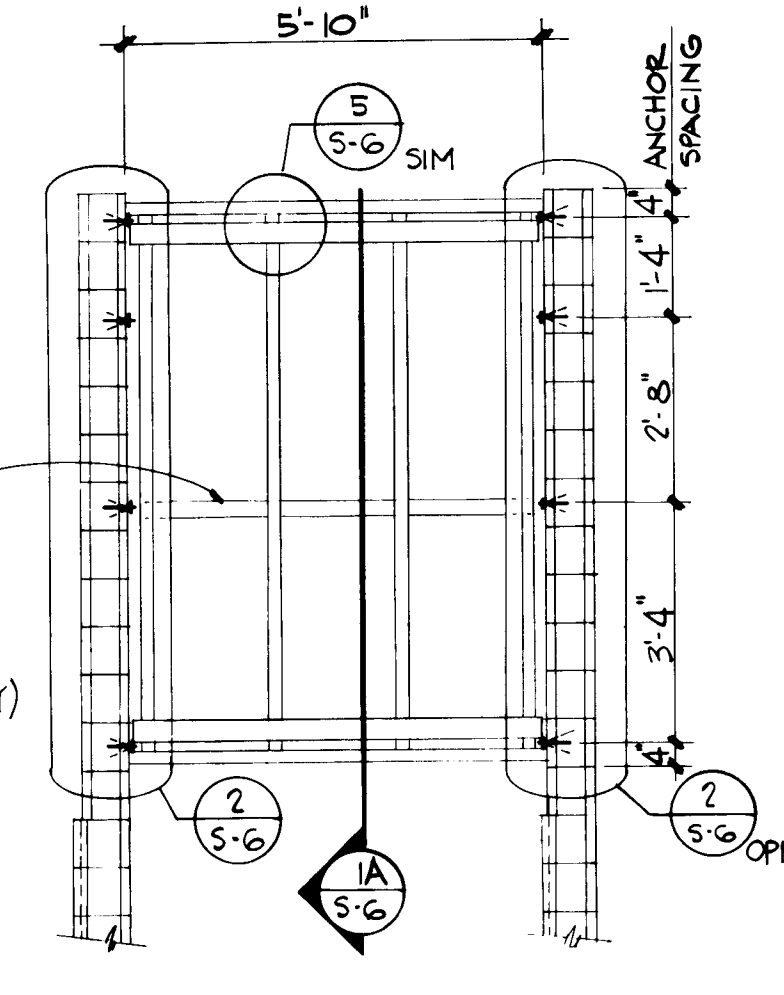


ELEVATION C

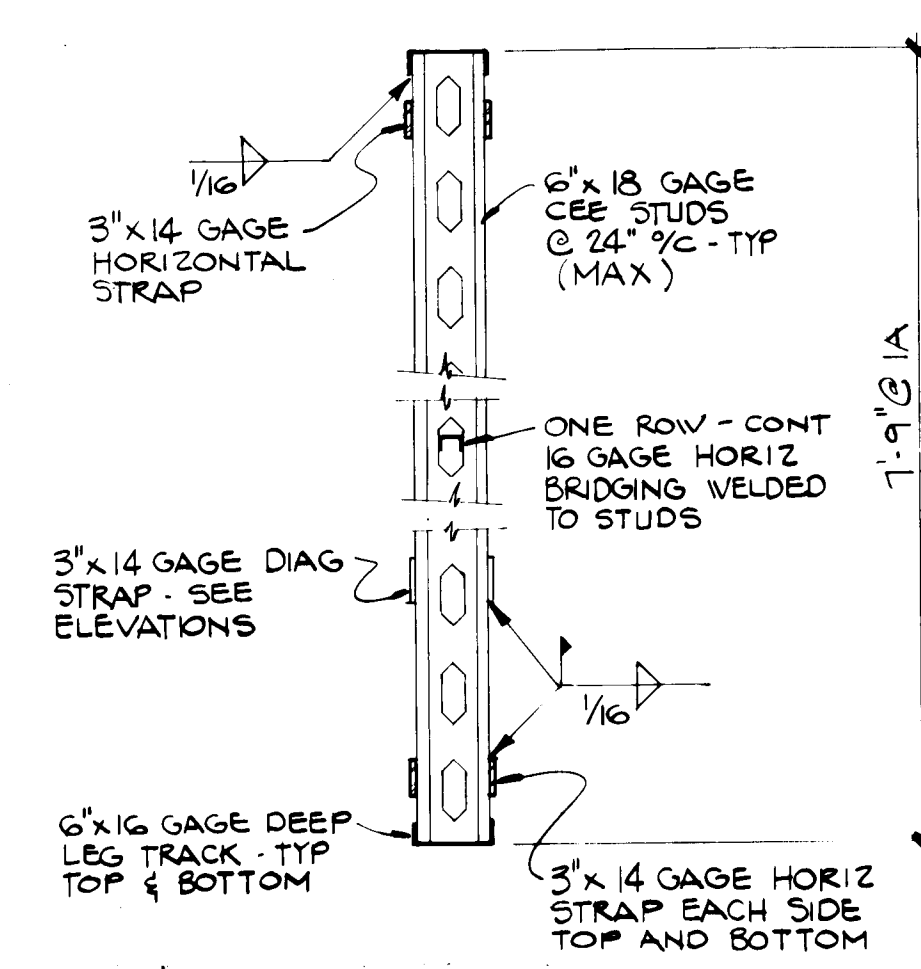


SECTIONS 1A, 1B

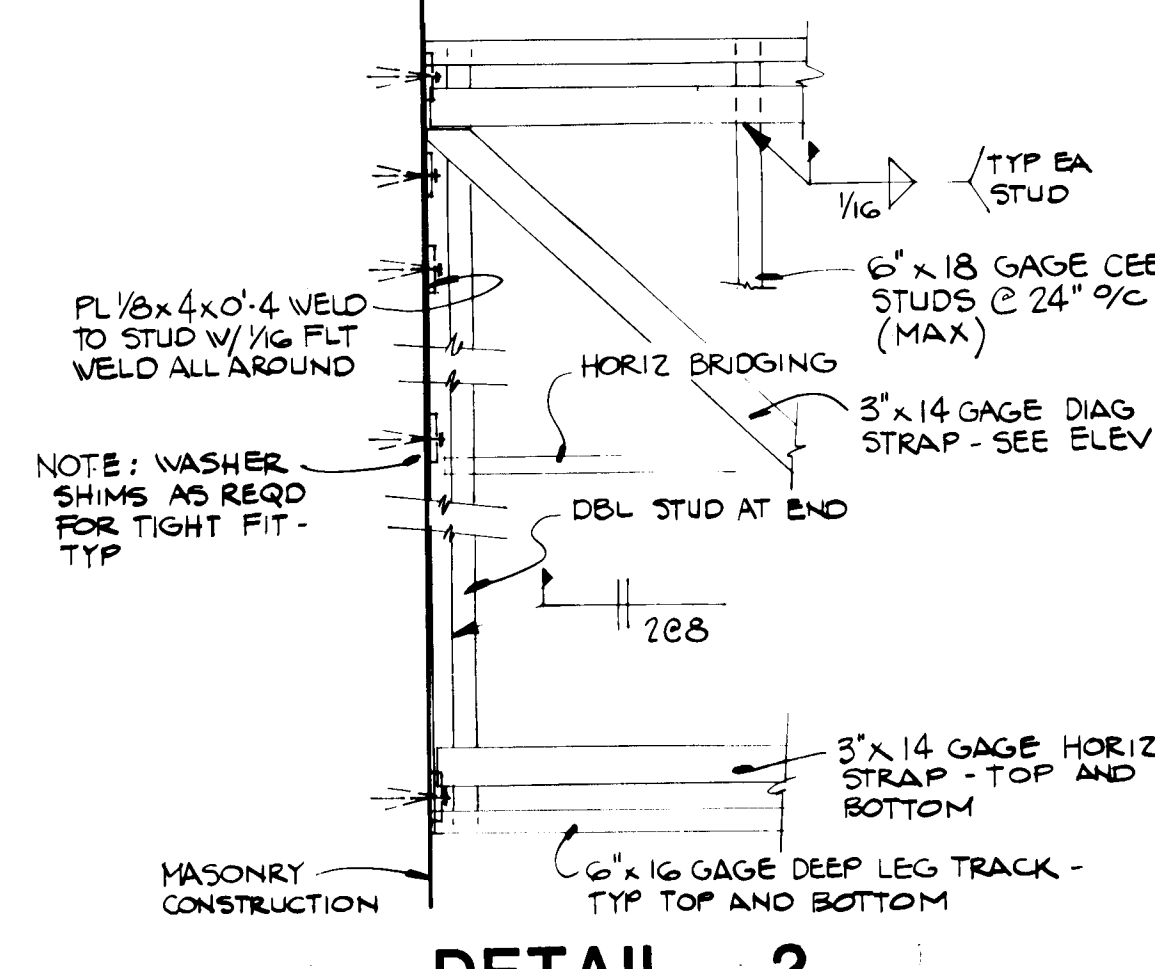


DETAIL 2

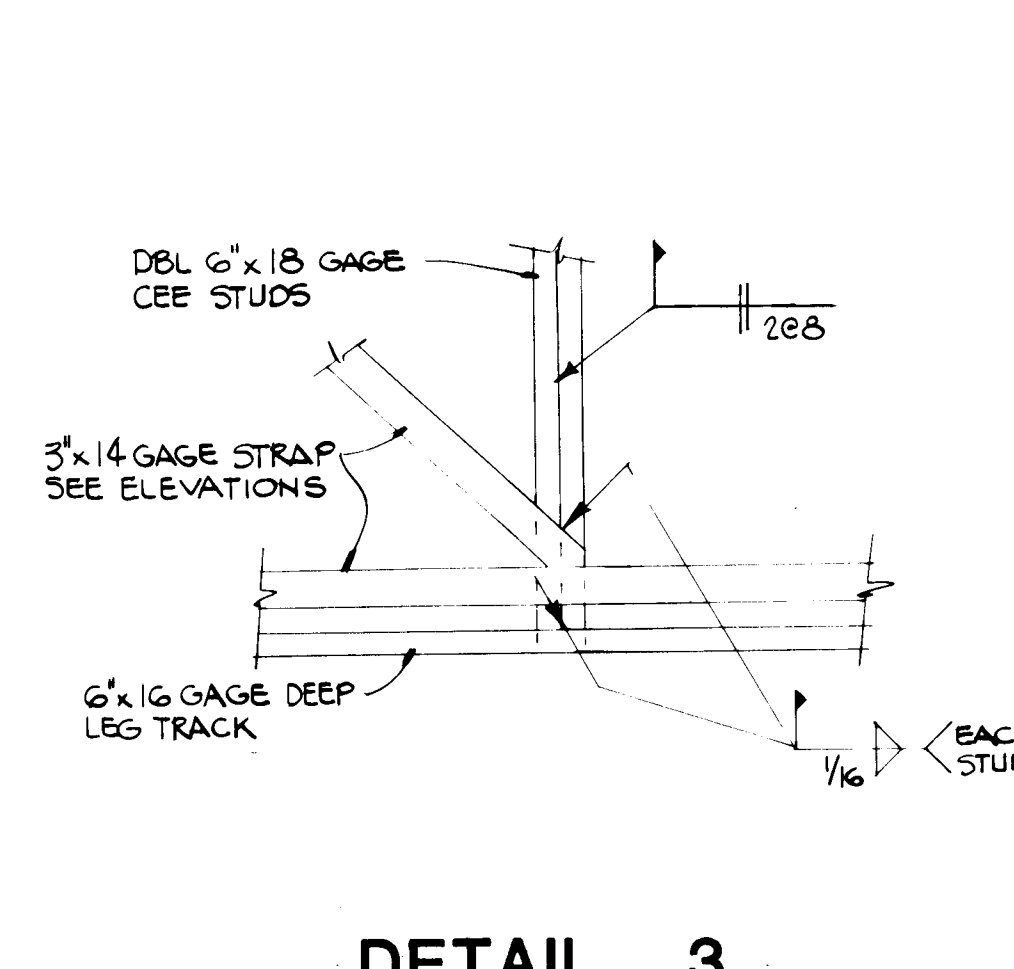


DETAIL 3

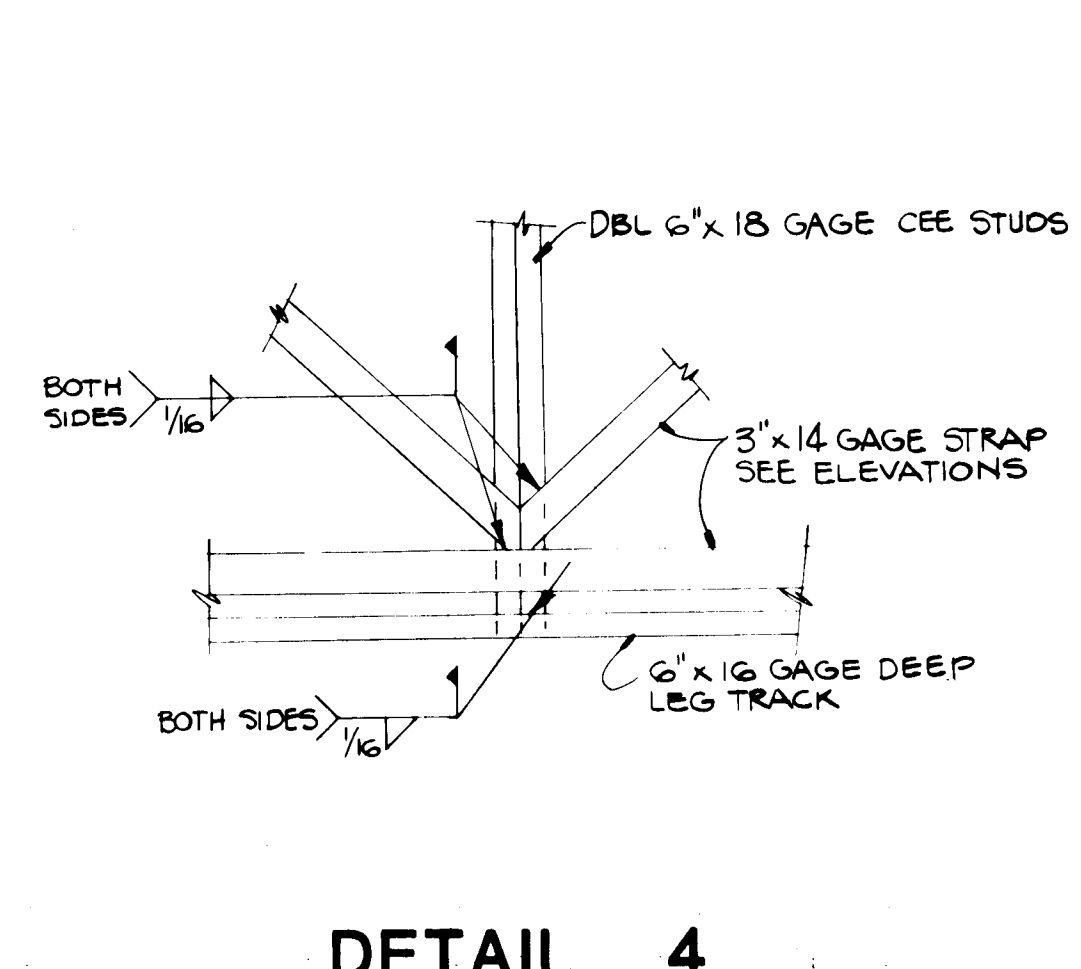


DETAIL 4

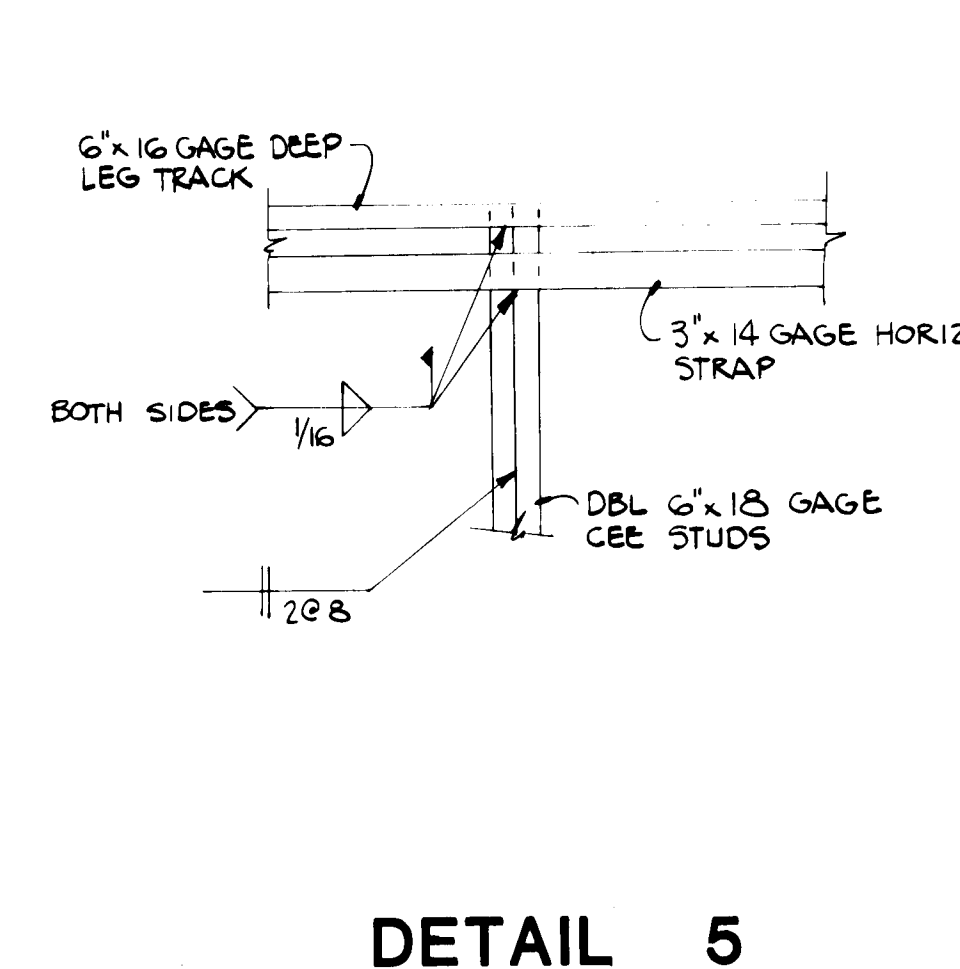


DETAIL 5

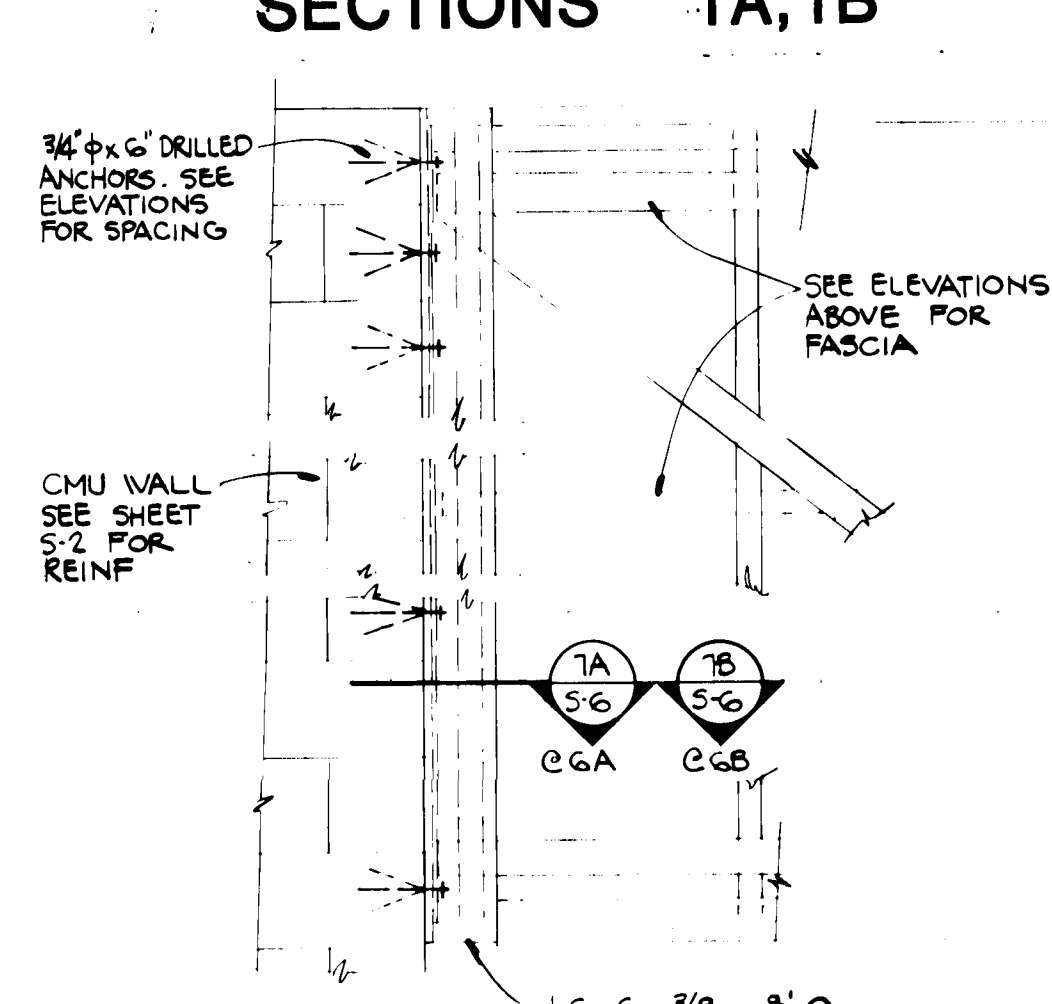


SECTION 6A, 6B

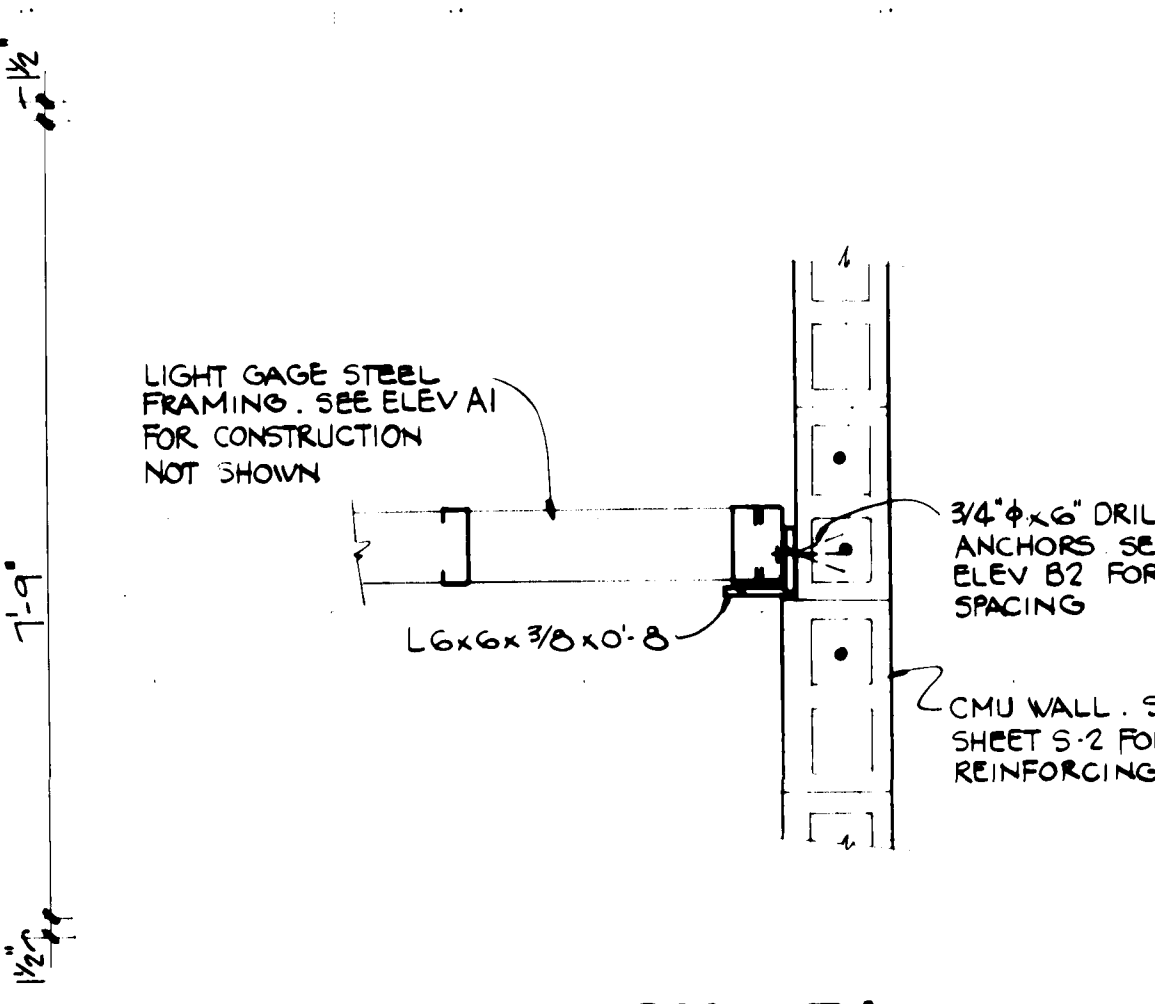

SECTION 7A

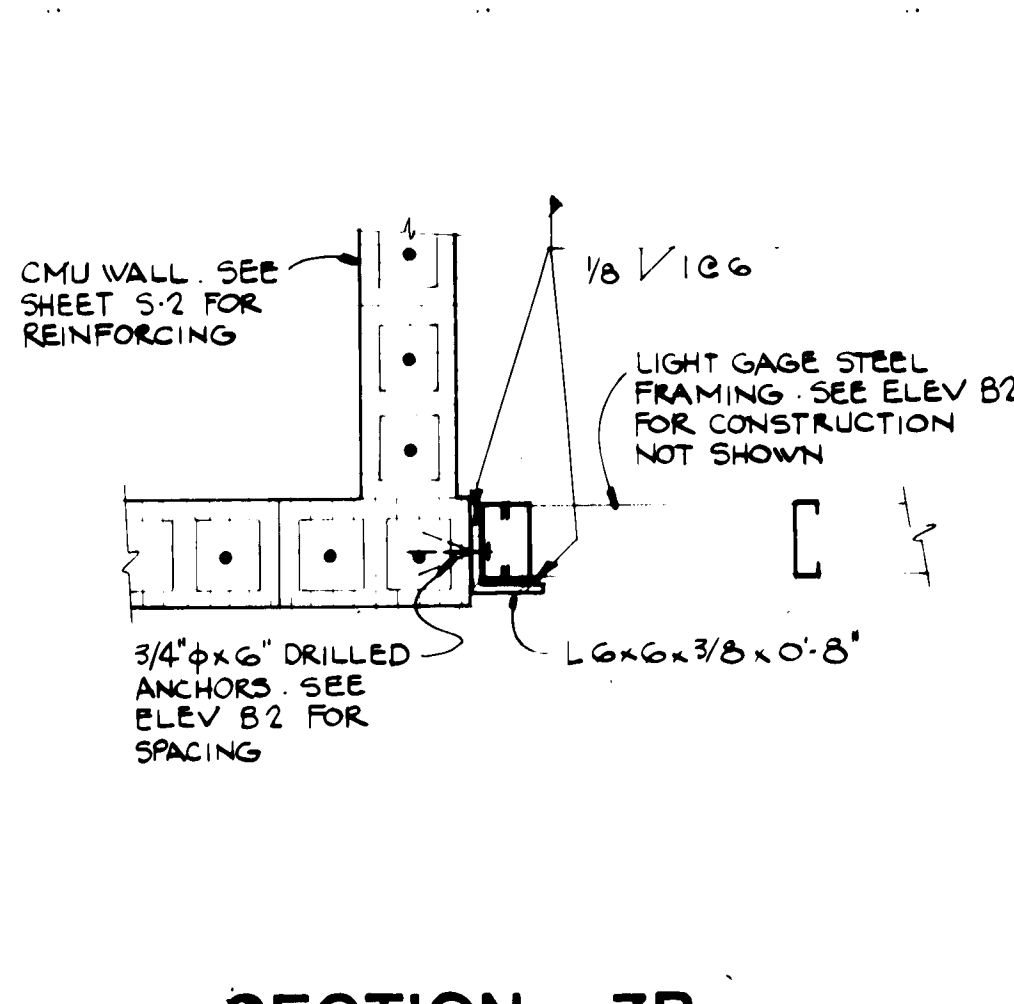


SECTION 7B

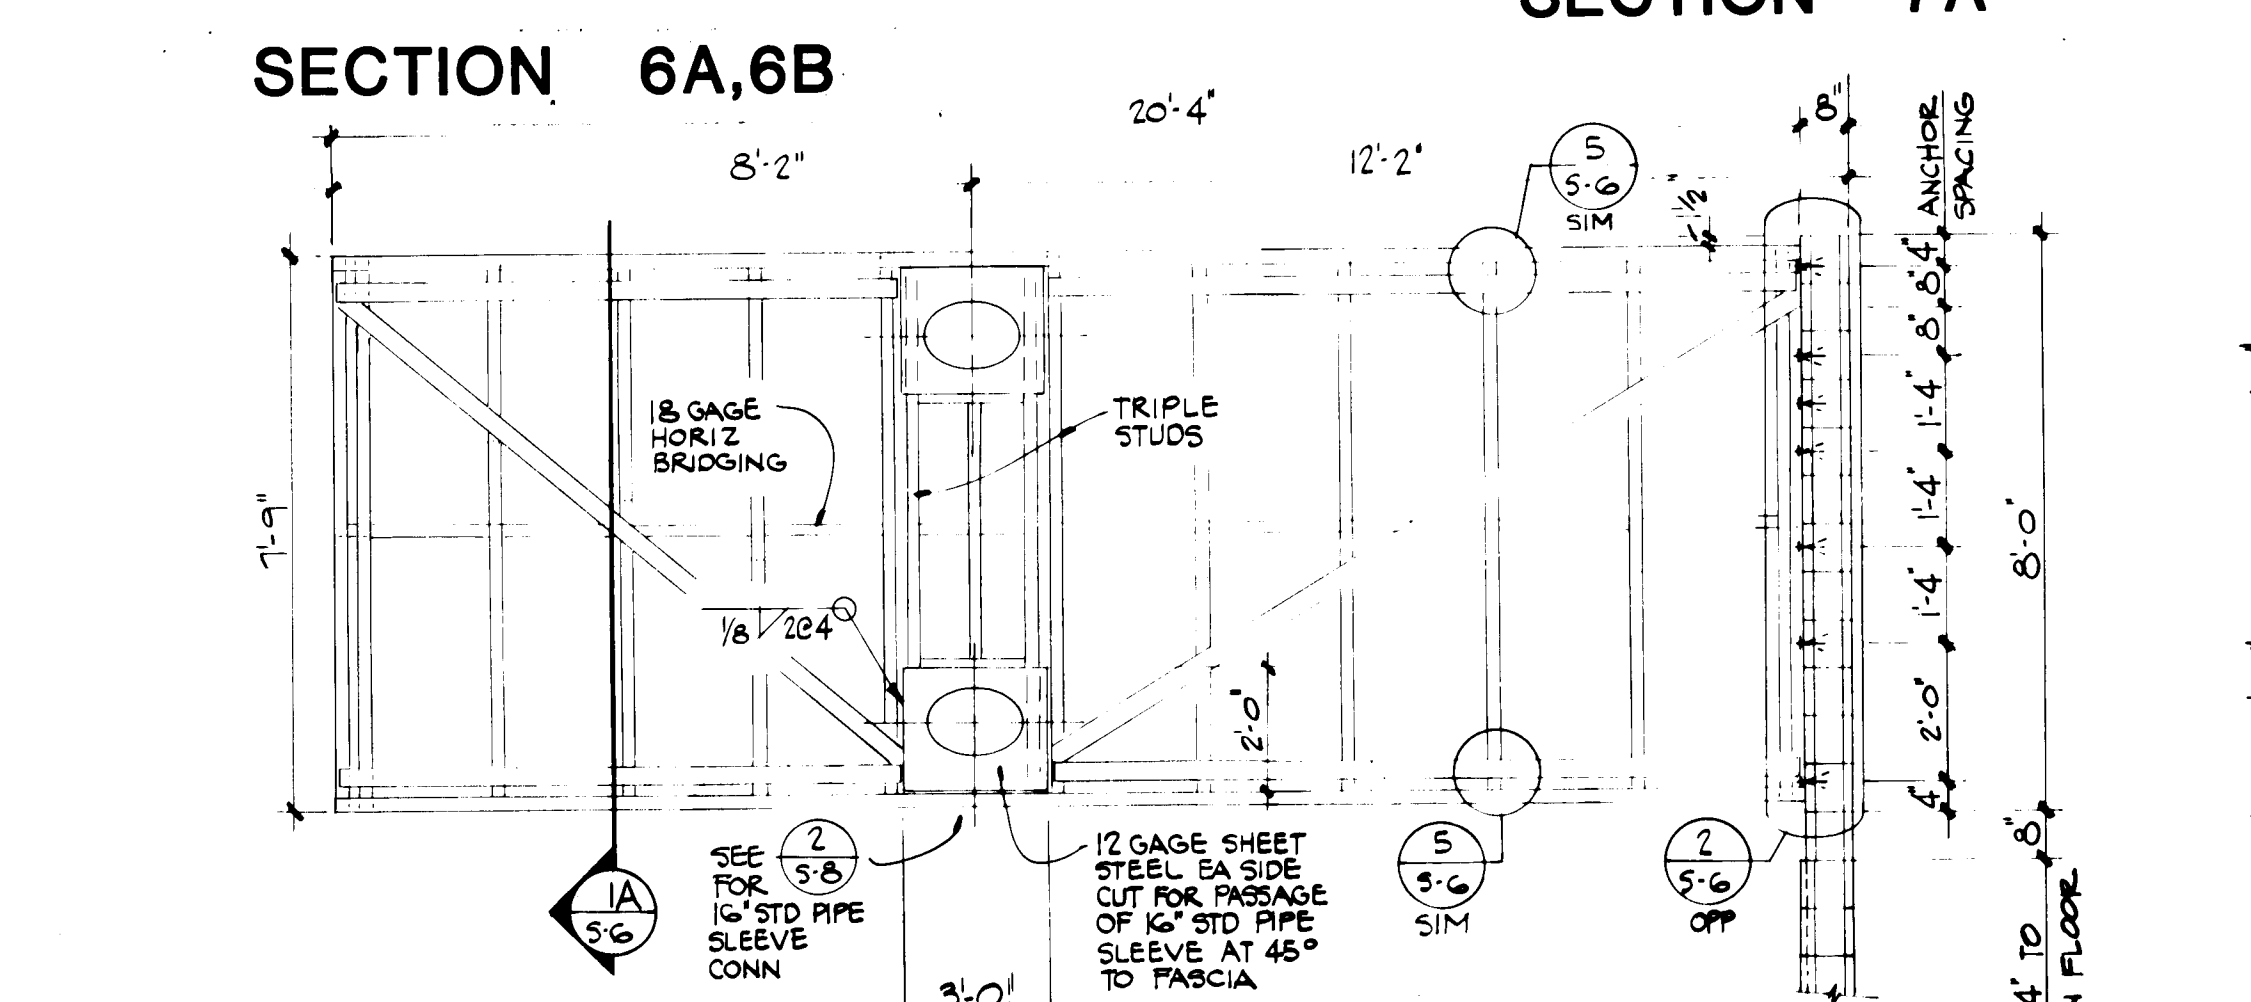


ELEVATION D

(ALTERNATE BID)

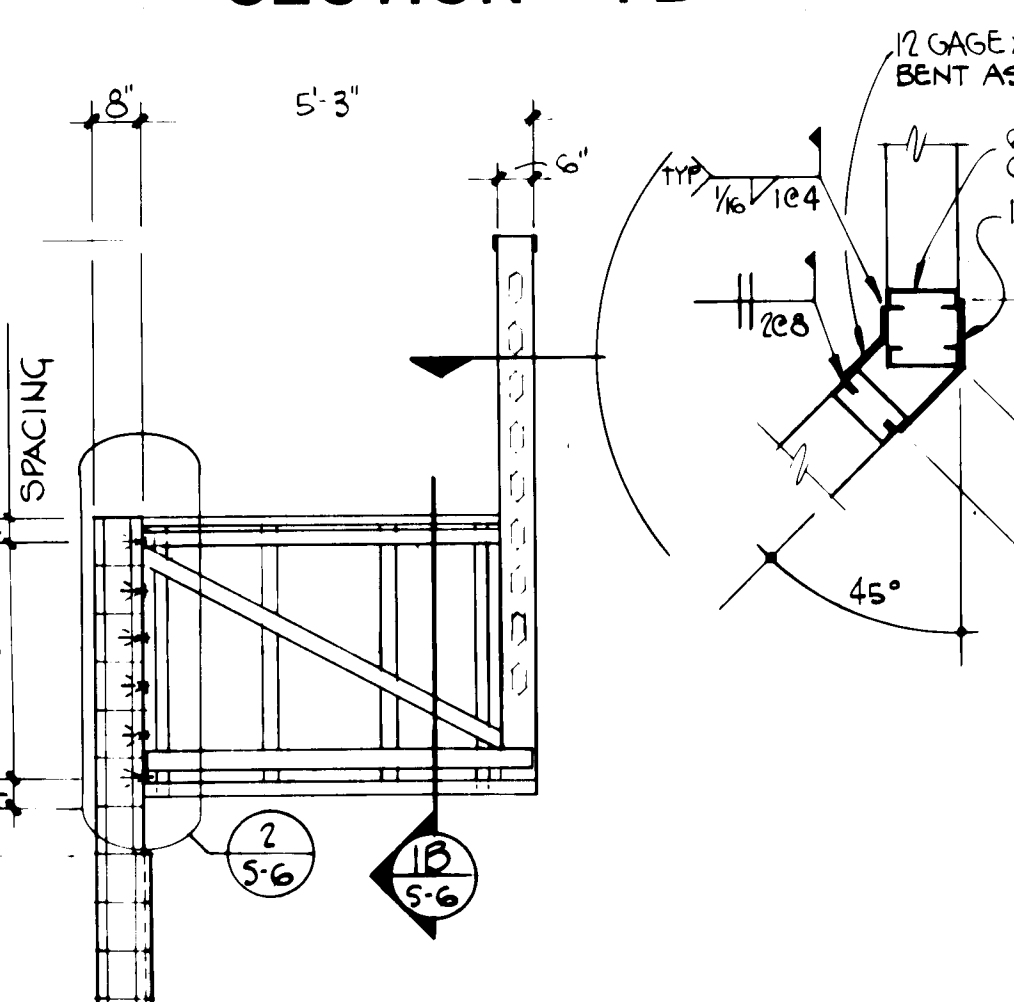

ELEVATION E

(ALTERNATE BID)

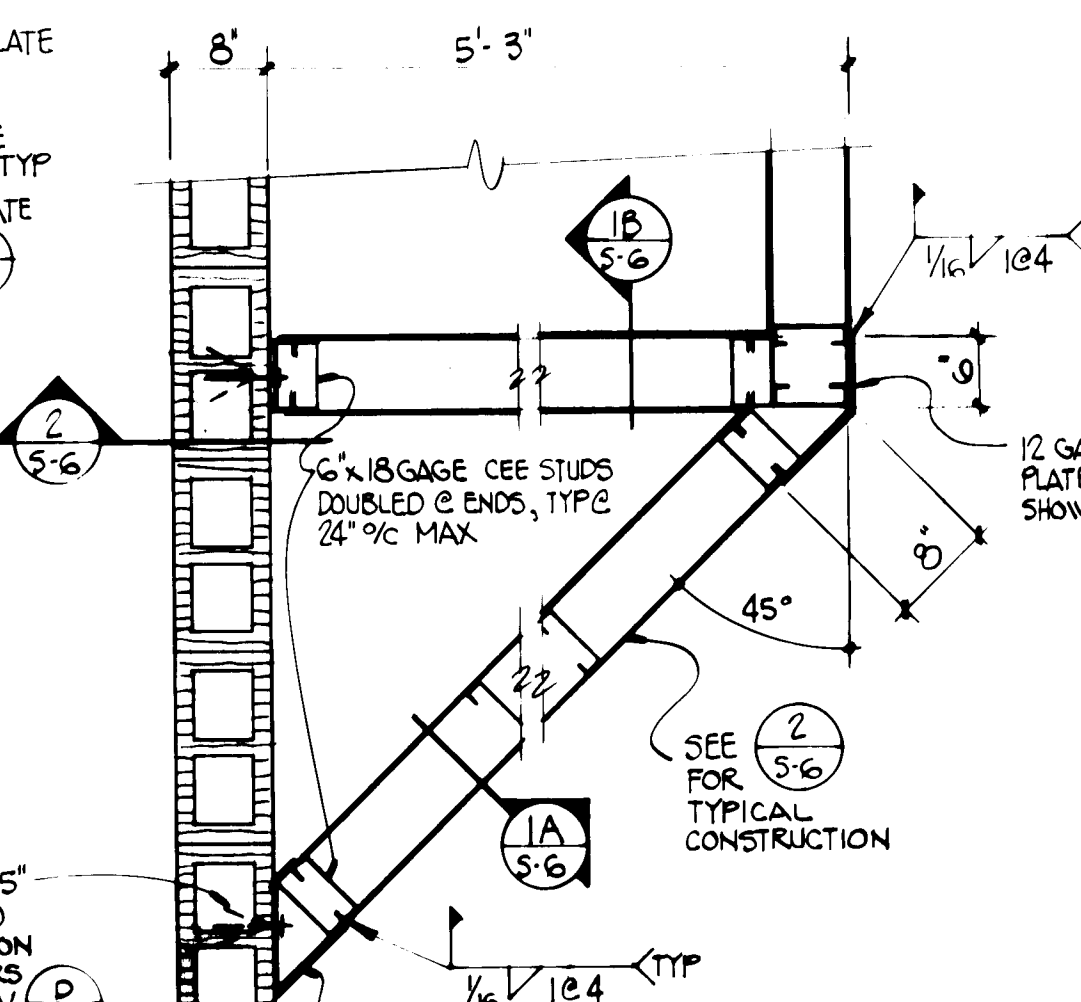

DETAIL 8

SCALE: ELEVATIONS 3/8" = 1'-0"
SECTIONS / DETAILS 3/4" = 1'-0"



GENERAL NOTES - LIGHT GAGE STEEL FRAMING

- Member Properties. Except as specifically shown otherwise, light gage steel framing members shall have the following minimum member section properties. See STRUCTURAL MATERIALS, Sheet S-1, for required section properties.
 - 6" cee studs: Punched or unpunched; 16 gage; 1-5/8" flanges; 1/2" flange returns; A = 0.36 in²; I_x = 1.15 in⁴.
 - 6" tracks: Unpunched; 16 gage; 1-5/16" flanges; A = 0.51 in²; I_x = 2.46 in⁴.
- Connections. All connections, except as specifically shown otherwise, shall be welded. Welders shall be performed by welders currently certified and using welding processes approved by the American Welding Society (AWS) and the American Iron and Steel Institute (AISI).


BURNS/PETERS GROUP ARCHITECTS
RECORD DRAWING
DATE: 12 SEPT 84
Charles Bachus

REVISIONS
Charles Bachus
ENGINEER
RONALD L. PETERS
ARCHITECT


THE EAST-CENTRAL
MULTI-SERVICE
CENTER

PROJECT NO. 0105 DATE MAY '83

S6
SHEET 12 OF 26

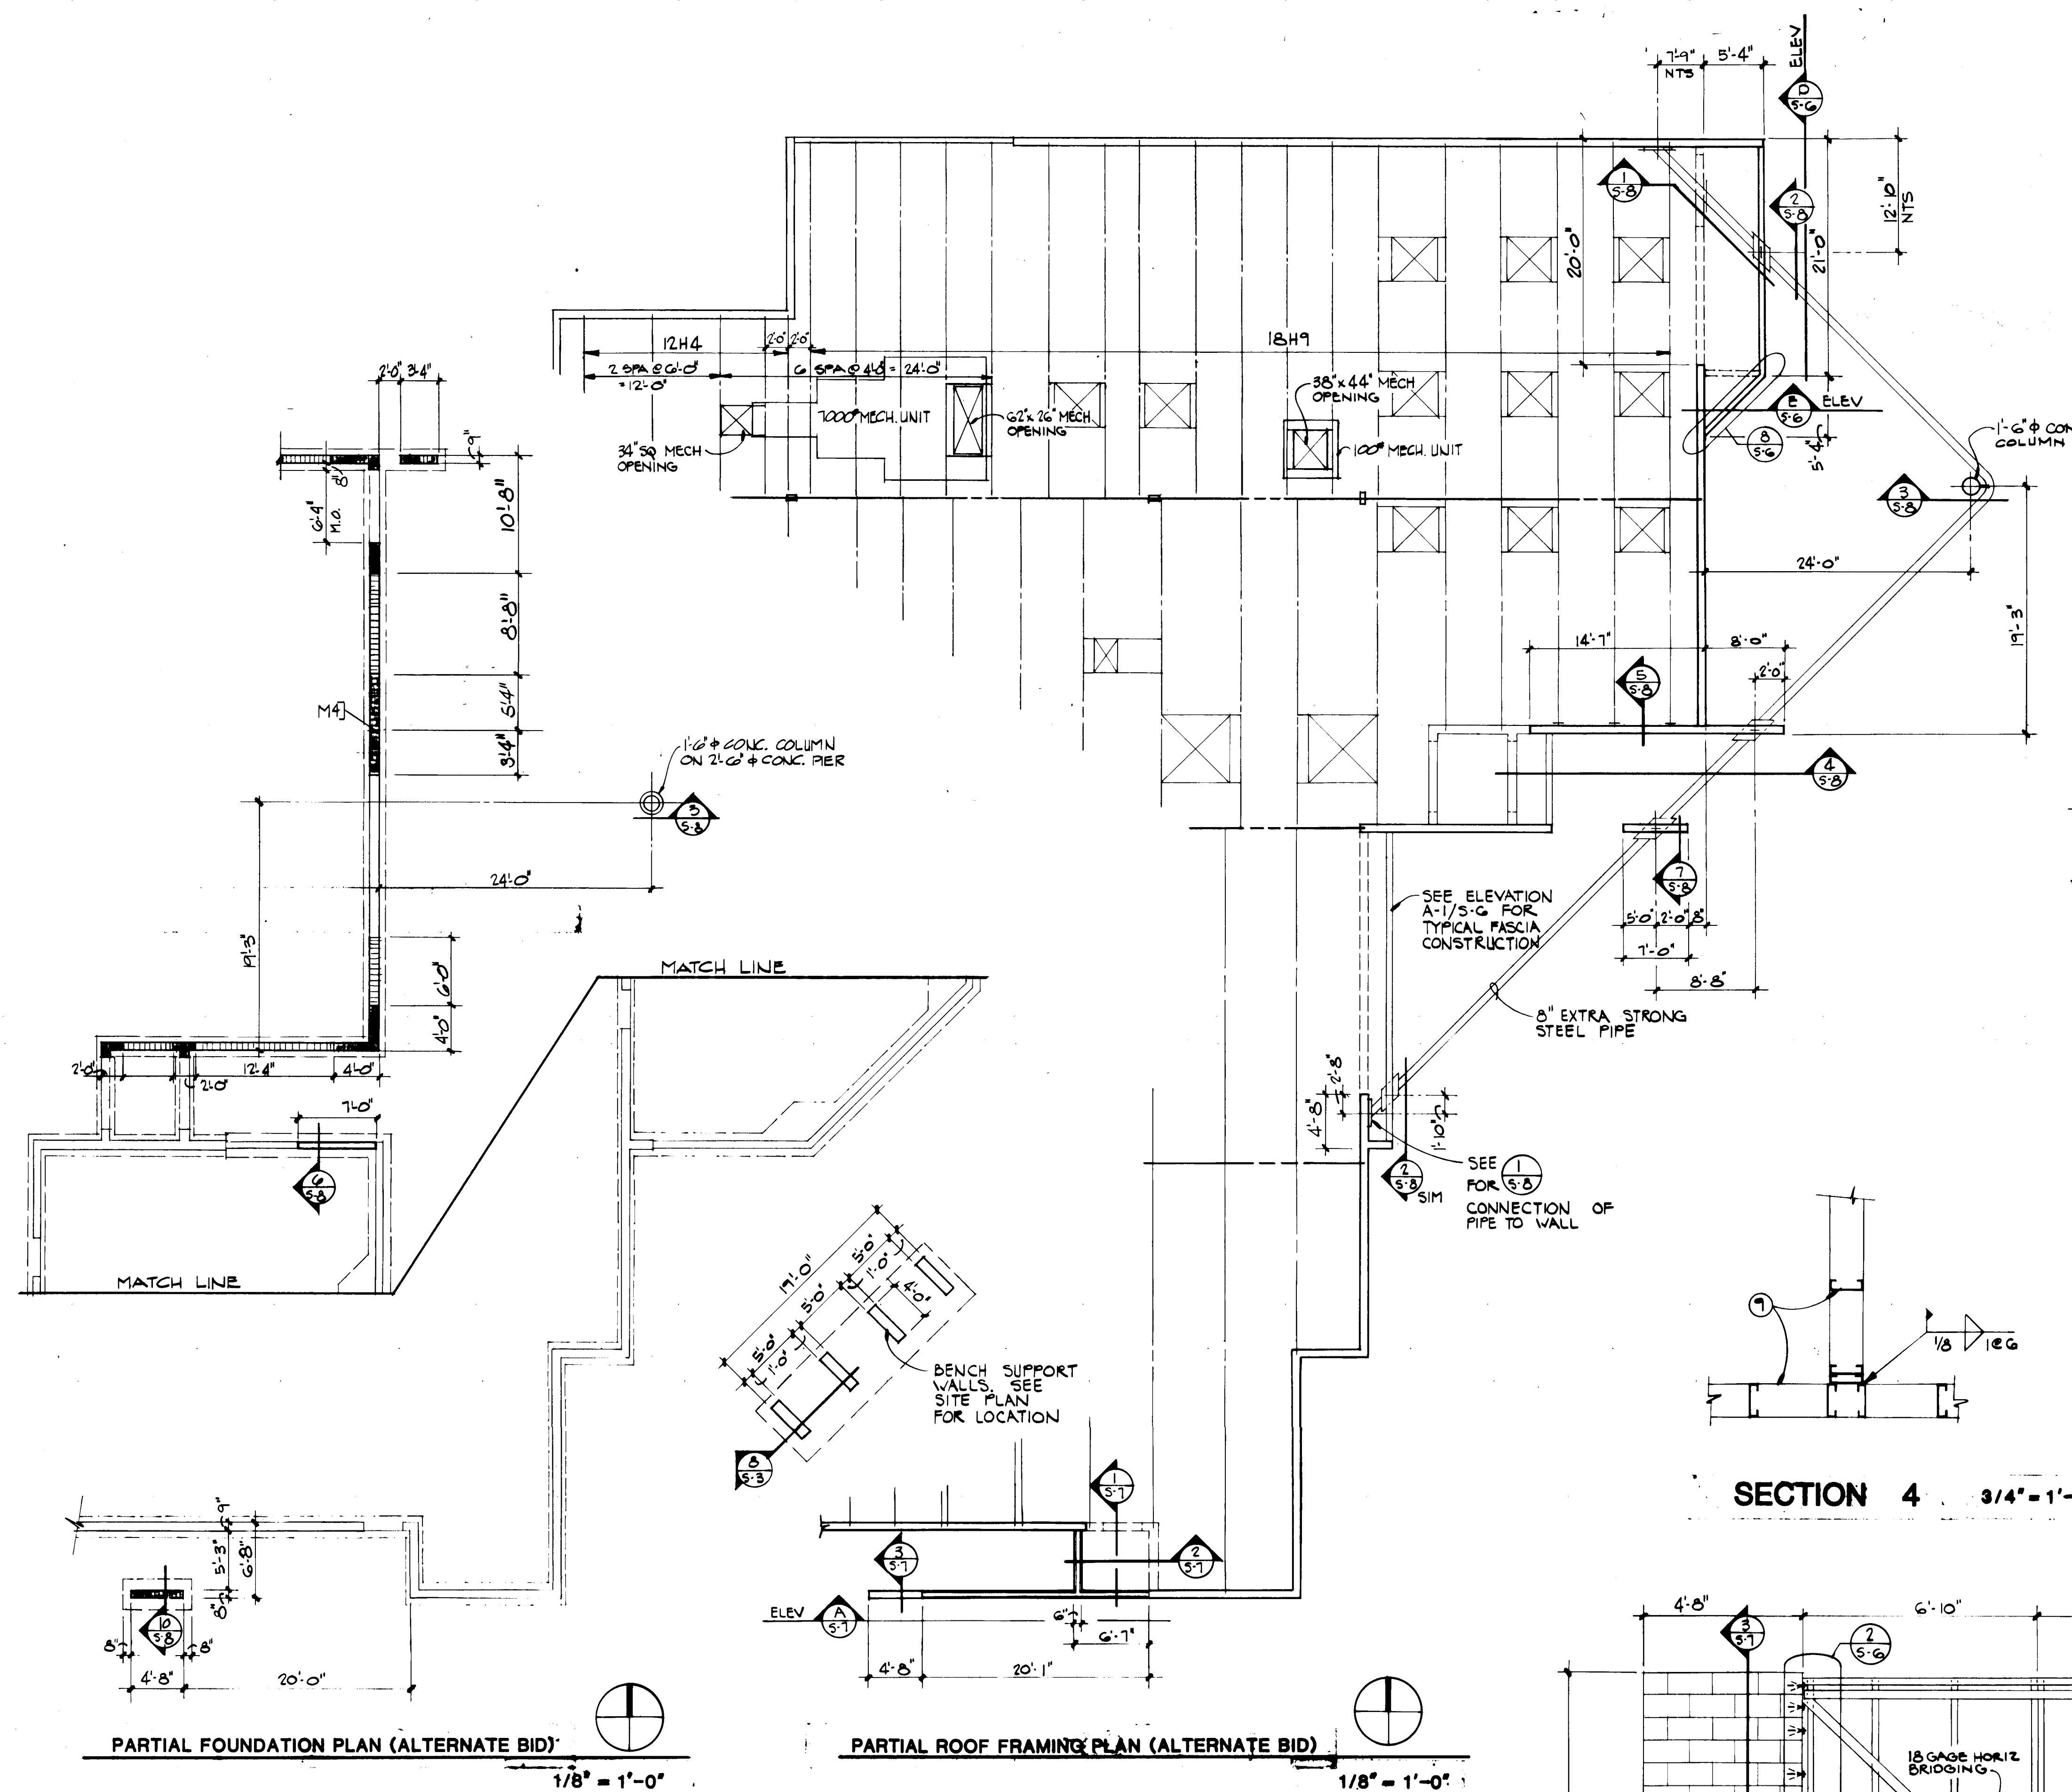

GENERAL NOTE: ALTERNATE BID FOUNDATION AND ROOF FRAMING PLANS
 Except as otherwise shown, construction shall be as shown on base bid FOUNDATION and ROOF FRAMING PLANS, Sheets S-1 and S-4, respectively.

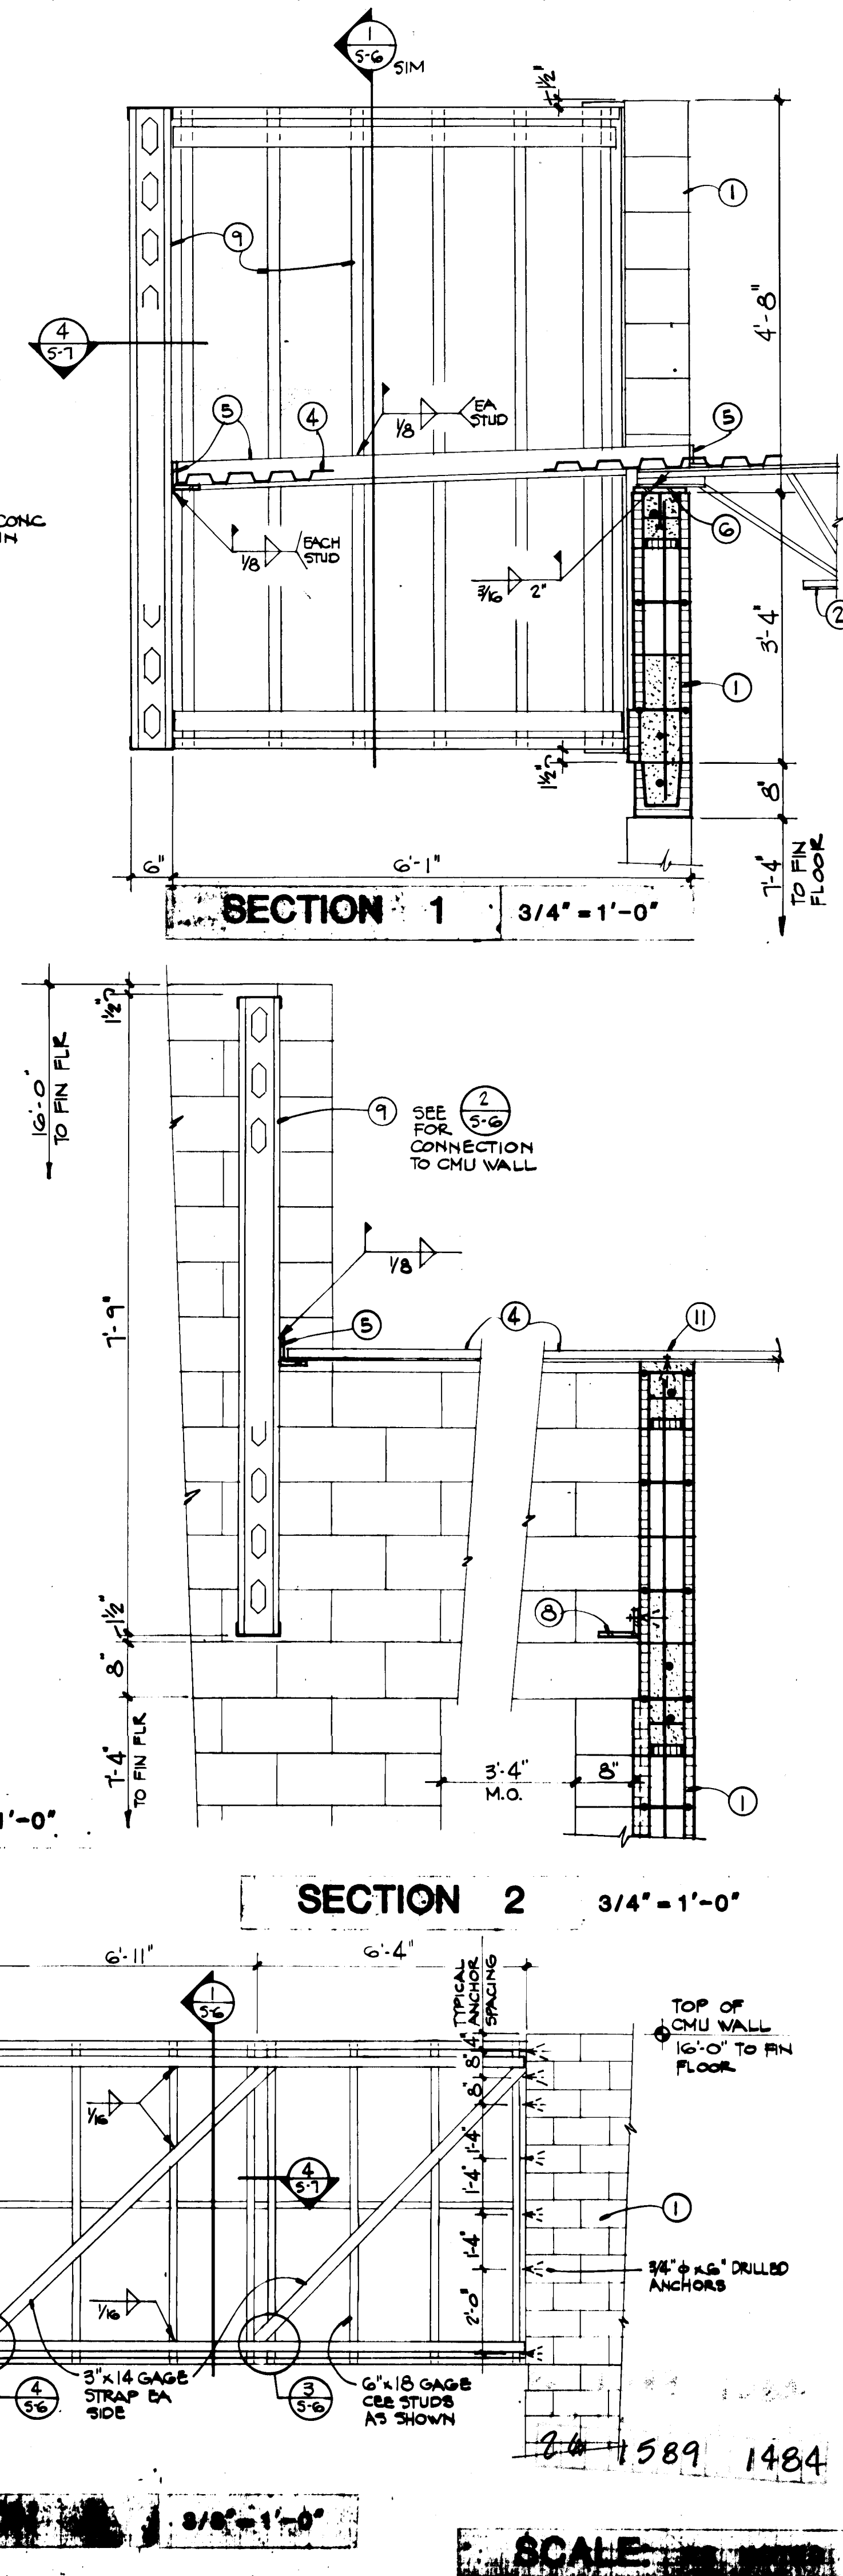

**KEYED NOTES
 ALTERNATE BID SECTIONS**

- 1 Concrete masonry wall. See notes and details on Sheet S-2 for reinforcing. See building elevations for type of unit required.
- 2 H series open web steel joists. See ROOF FRAMING PLAN, Sheet S-4, for size, spacing and length.
- 3 Not used.
- 4 Steel roof deck. See Sheet S-4 for connection to supporting members.
- 5 Continuous 4x4x1/4 steel perimeter angle. Connect to steel members as indicated; connect to cmu walls with 1/2"x6" drilled expansion anchors @ 32" o/c.
- 6 3/8"x1'-0" steel bearing plate with 2-1/2"x6" drilled expansion anchors @ 32" o/c.
- 7 Not used.
- 8 6x3-1/2x3/8 steel soffit support angle. Connect to steel framing as indicated. Connect to cmu walls with 1/2"x6" drilled expansion anchors @ 24" o/c.
- 9 Light gage structural steel framing. See sheet S-6 for notes and details of construction.
- 10 Not used.
- 11 3/8"x4" drilled expansion anchor - typical at each side lap valley between units and at alternate valleys (12" o/c maximum) between.

BURNS/PETERS GROUP ARCHITECTS
RECORD DRAWING
 DATE **12 SEPT 94**
Charles Two













REVISIONS

1	10/1/94	1	10/1/94
2	10/1/94	2	10/1/94

**THE EAST-CENTRAL
 MULTI-SERVICE
 CENTER**

PROJECT NO. **2008** DATE **MAY '93**

S7
 SHEET 14 OF 36

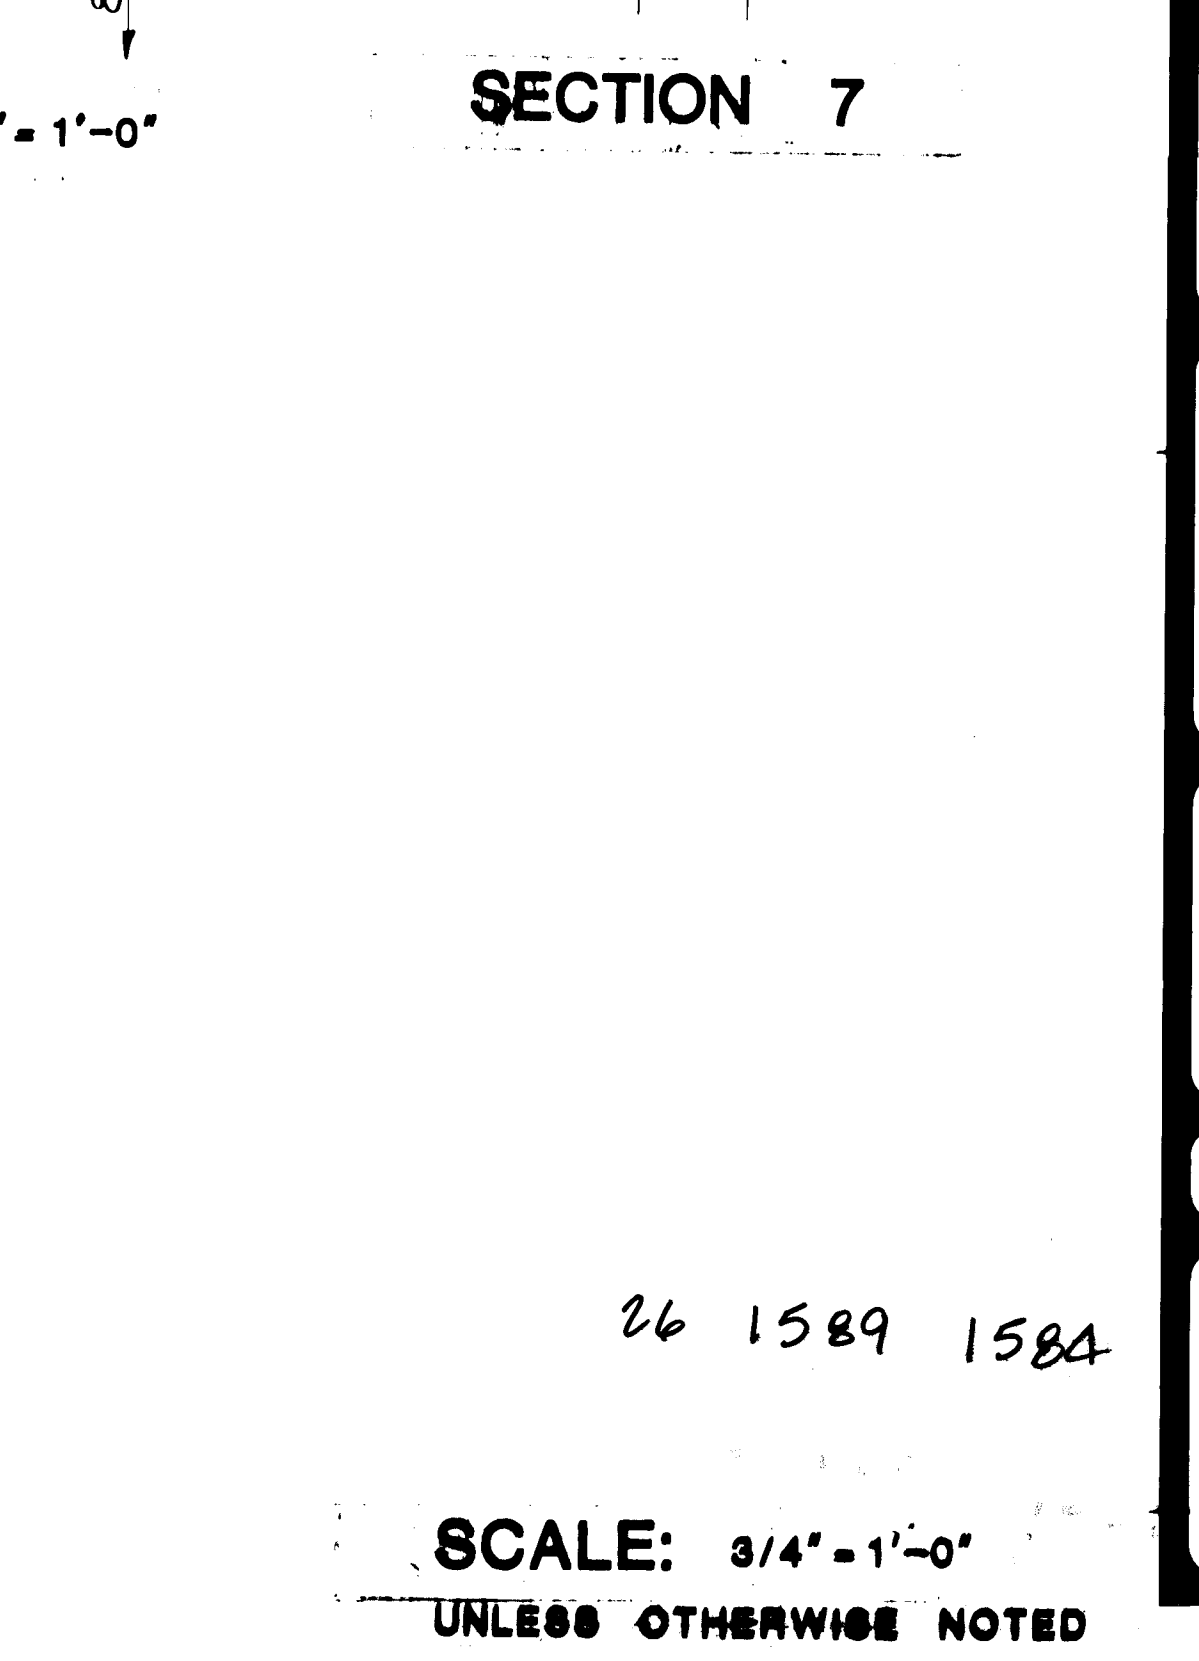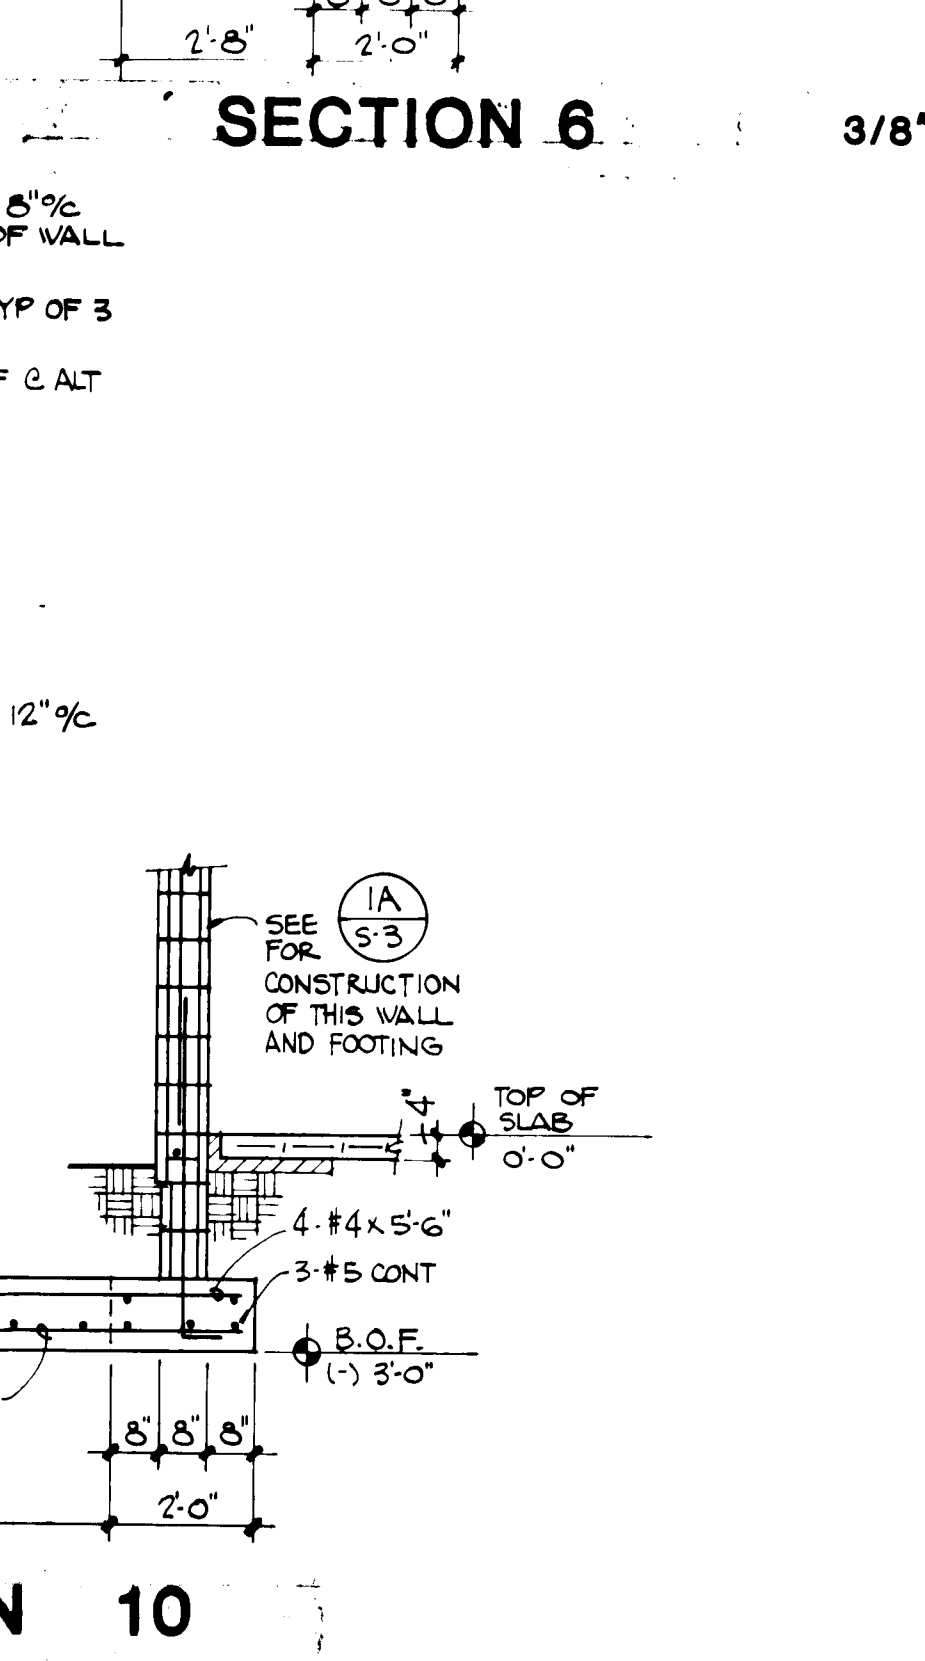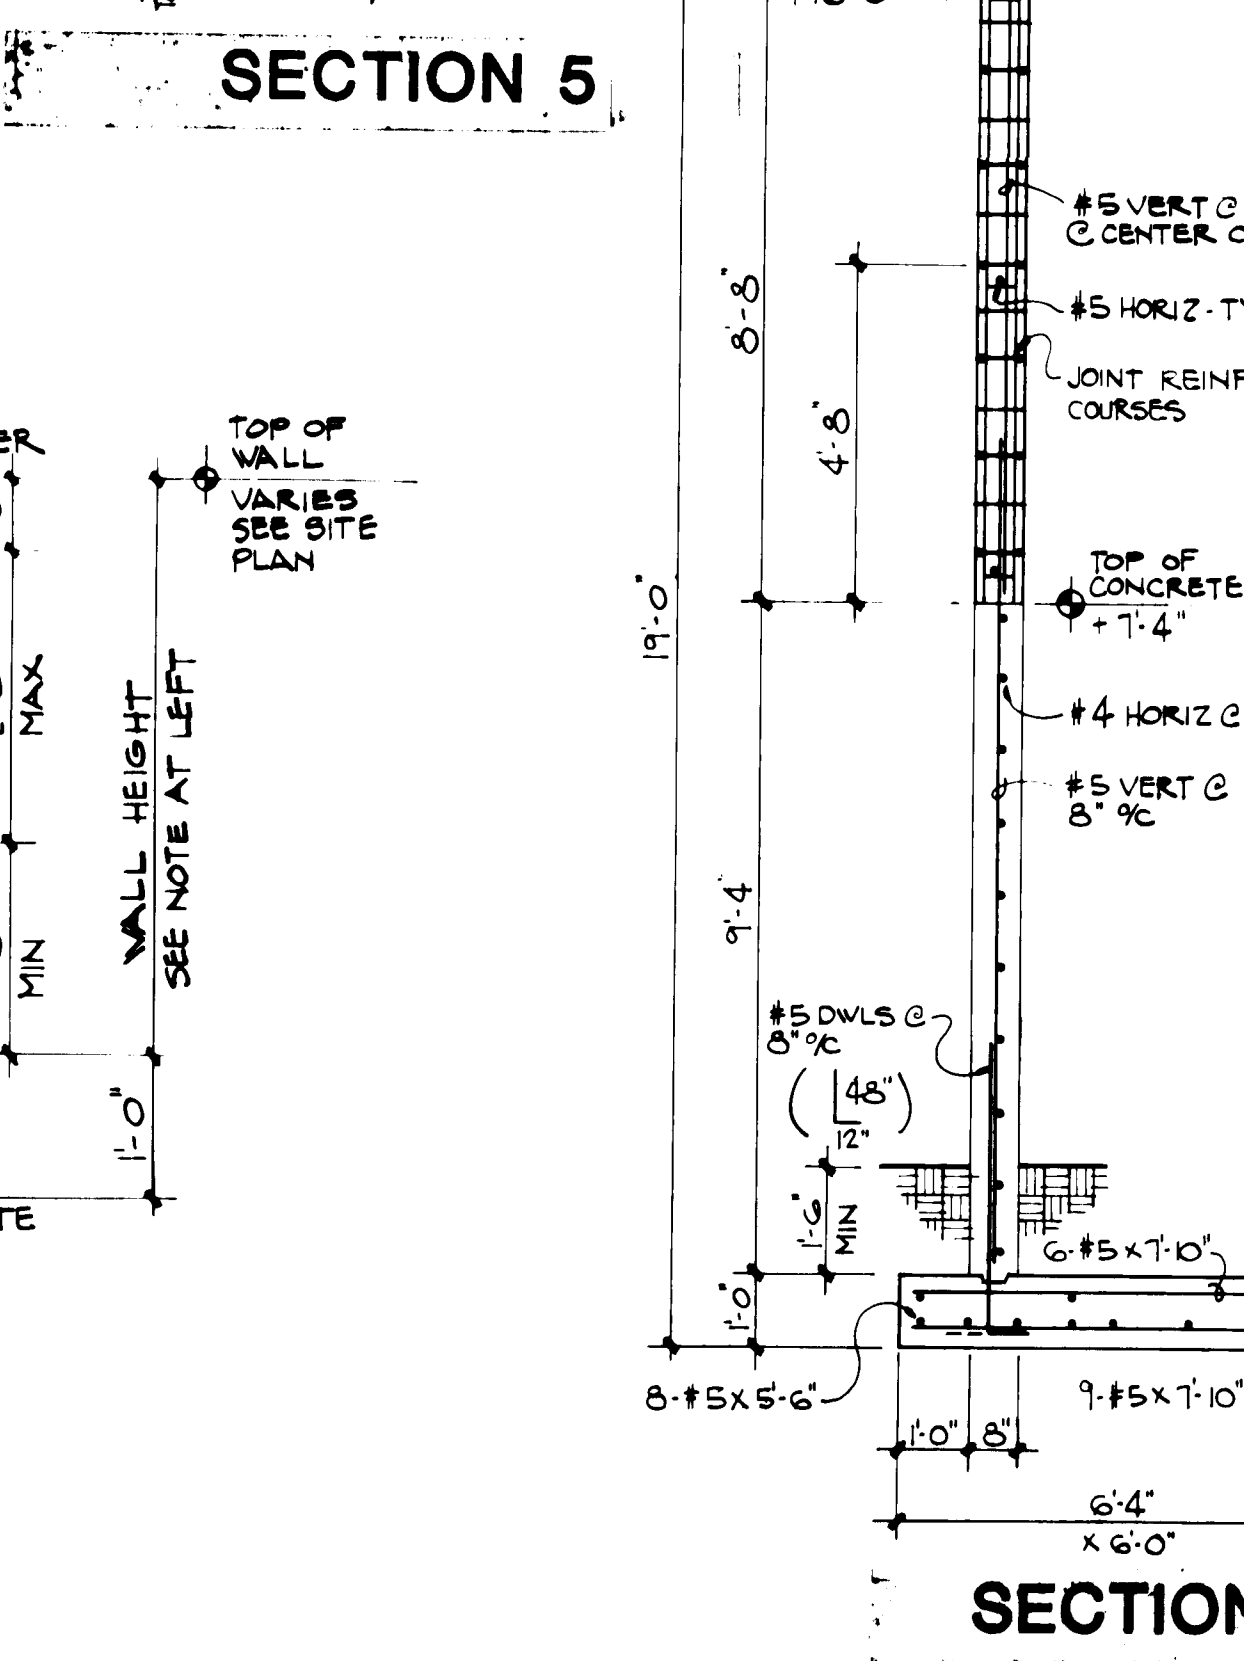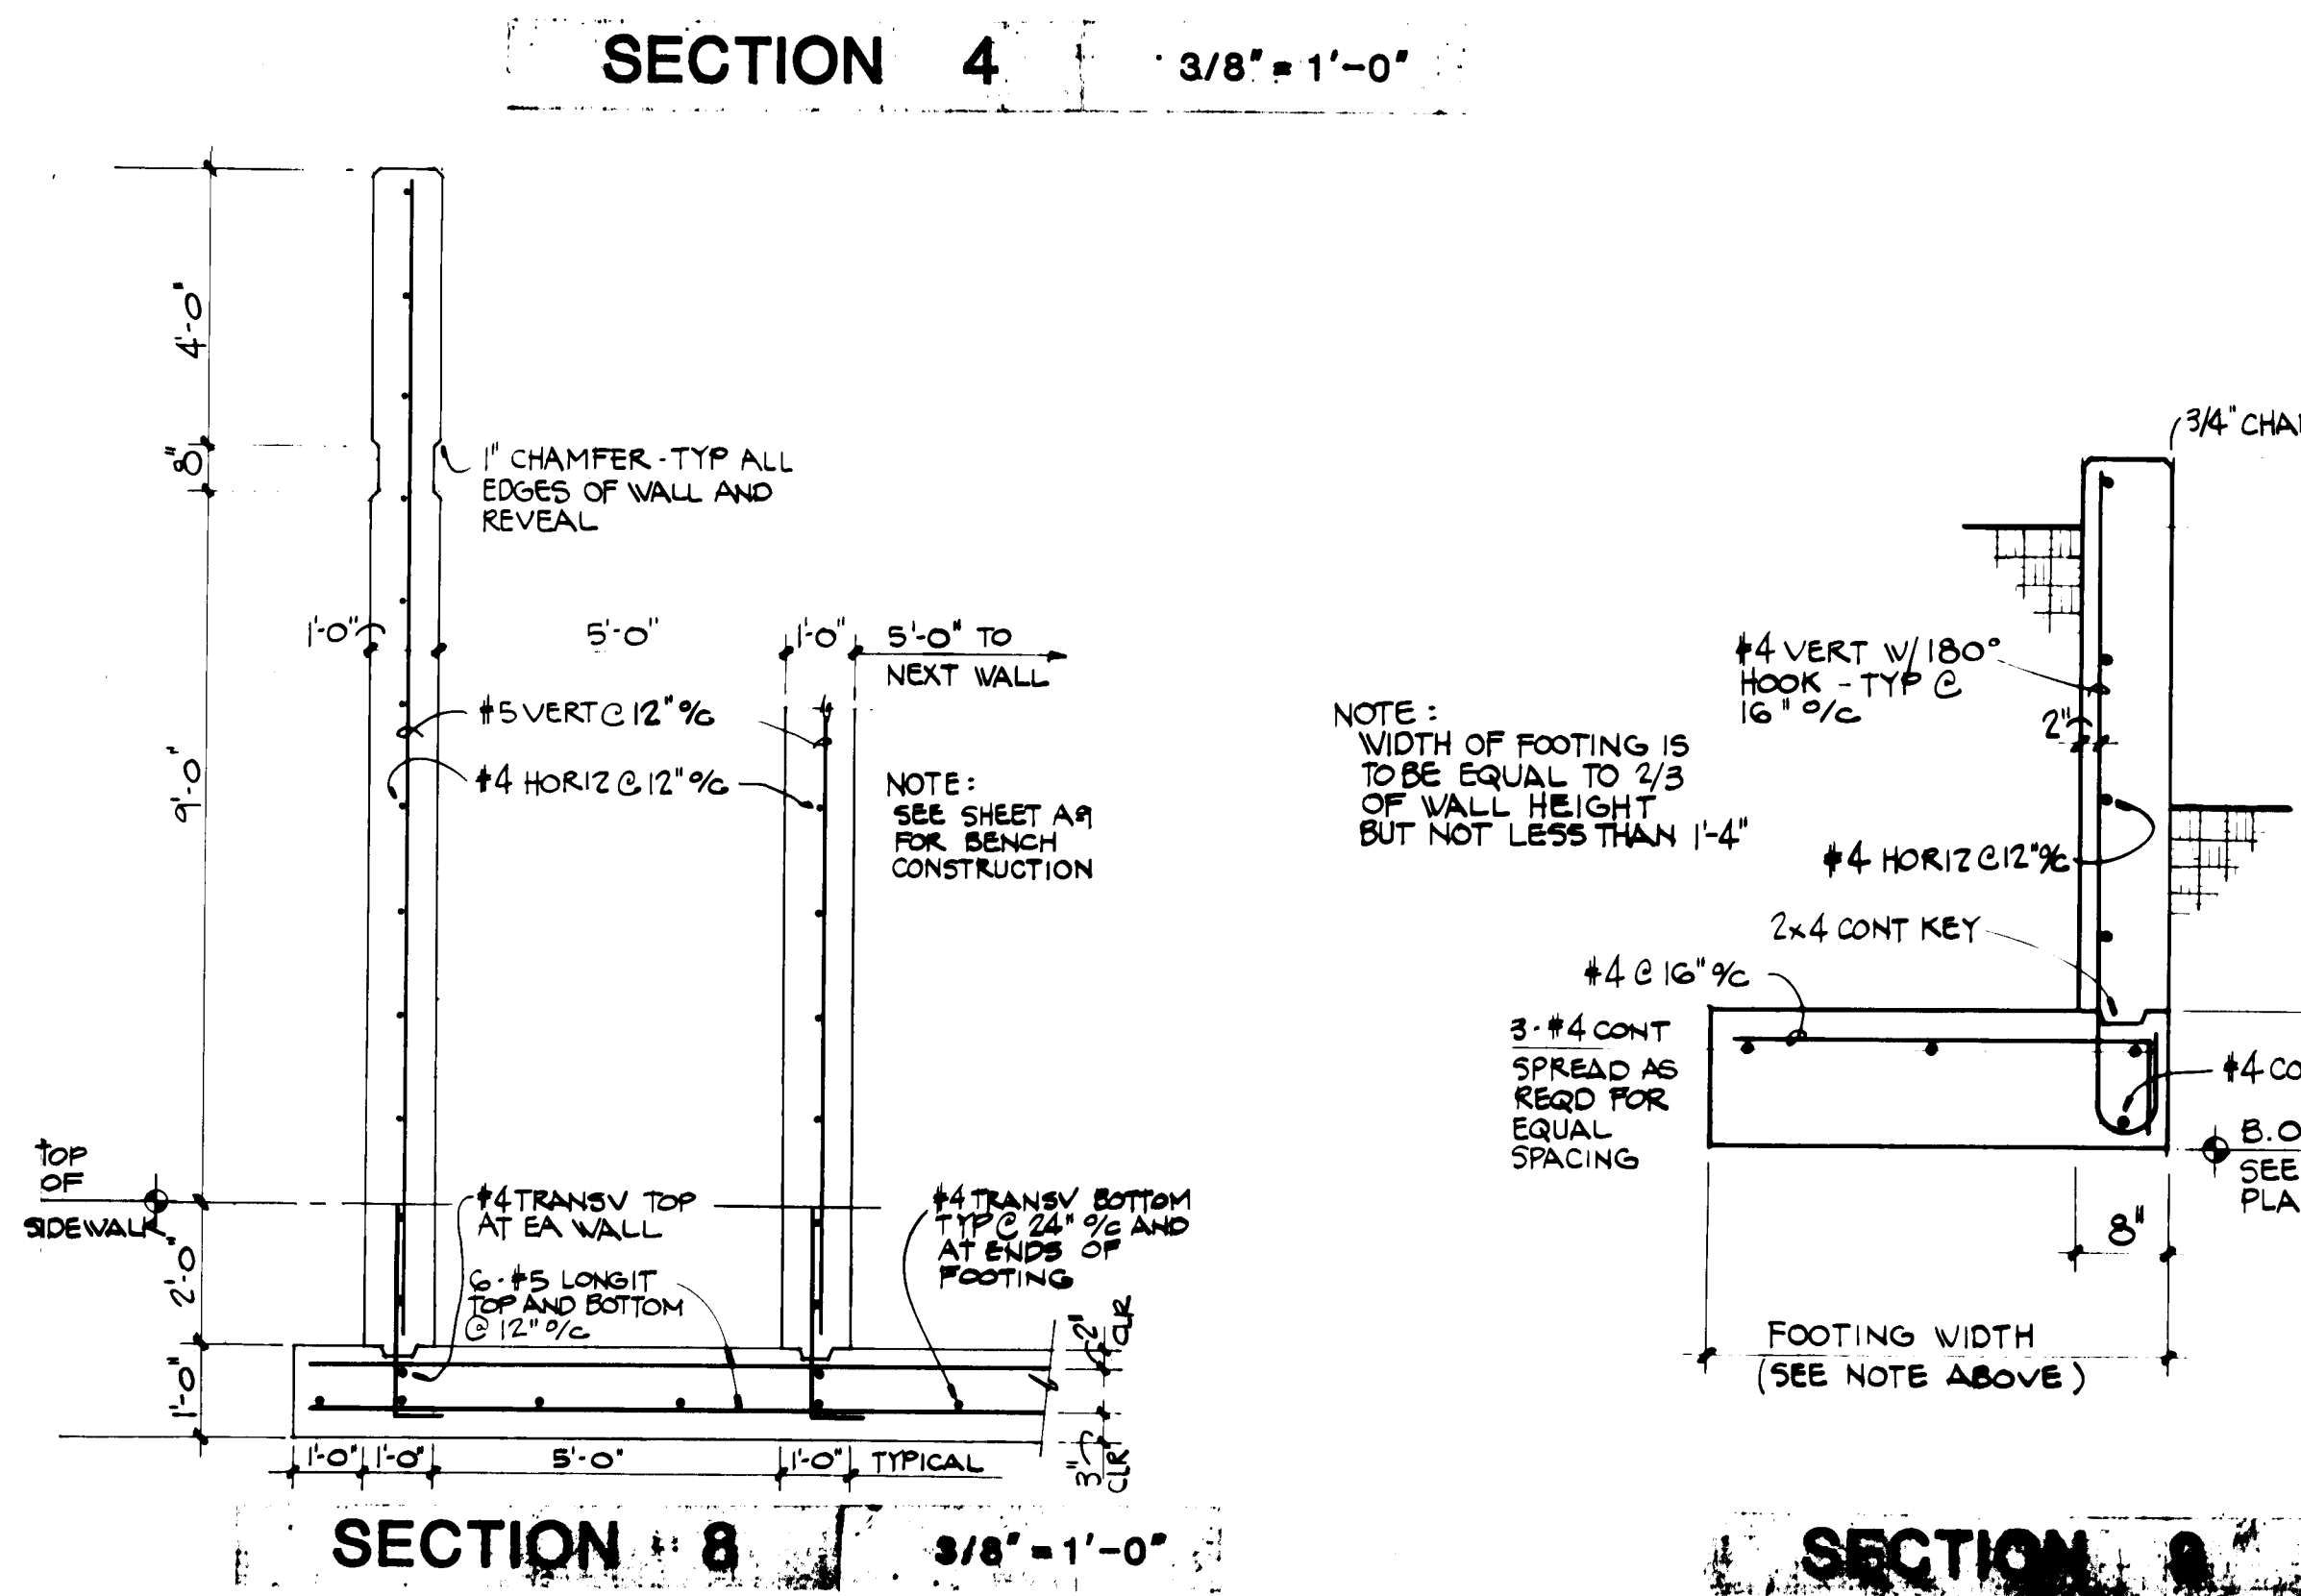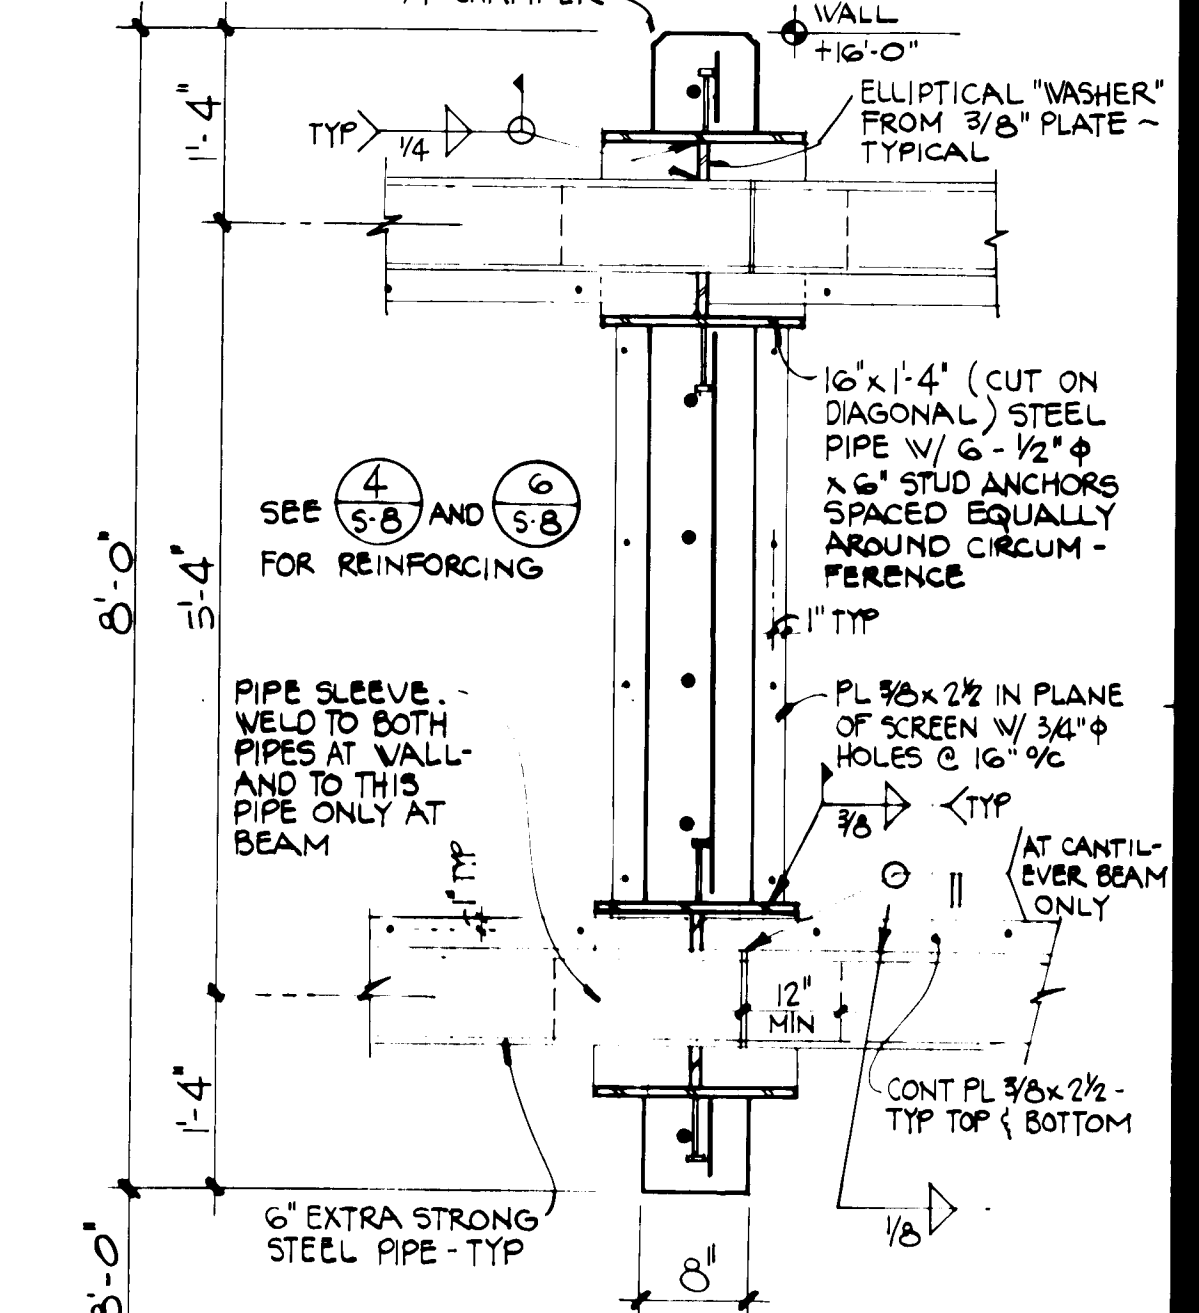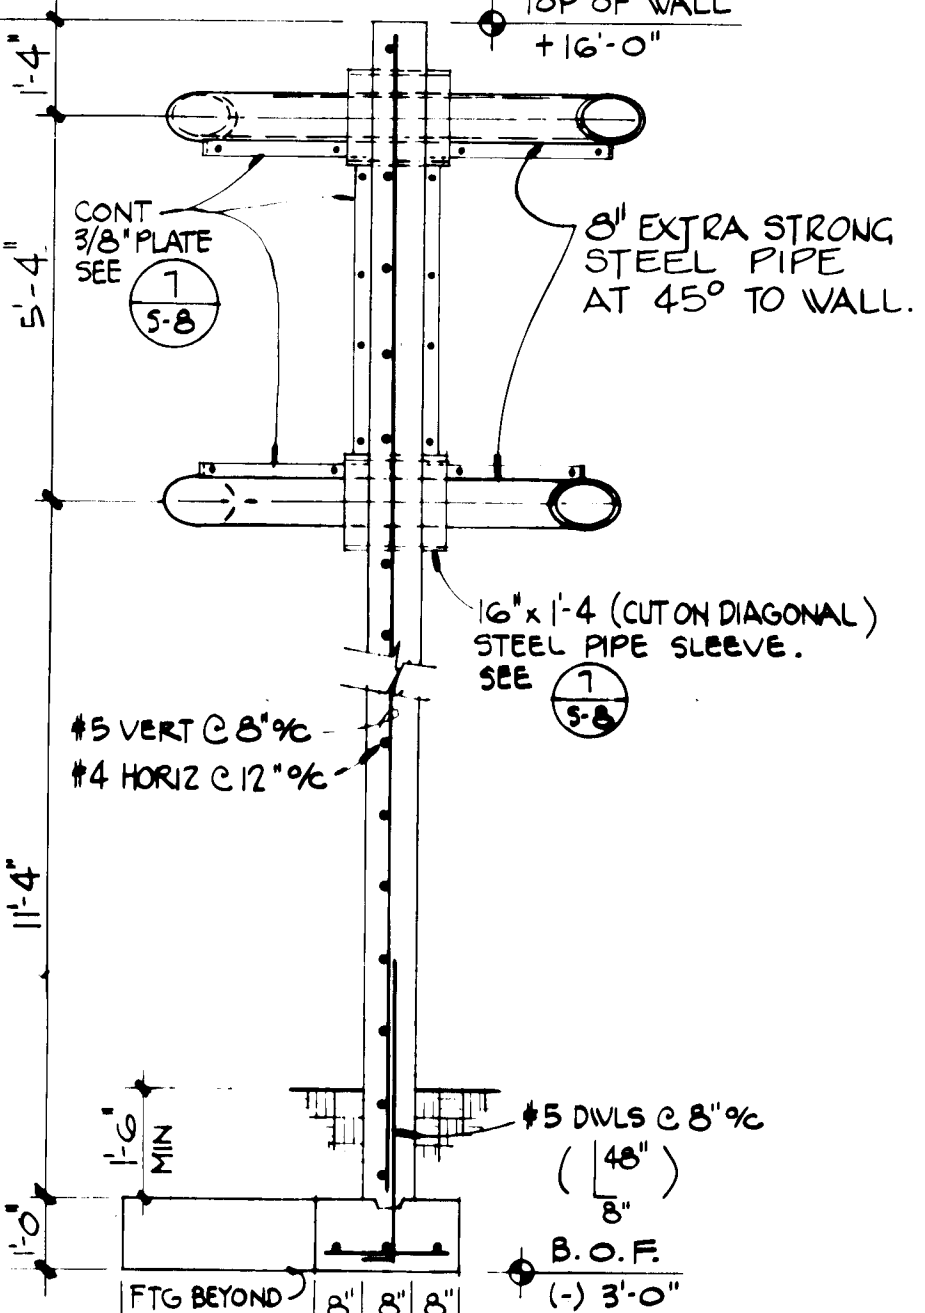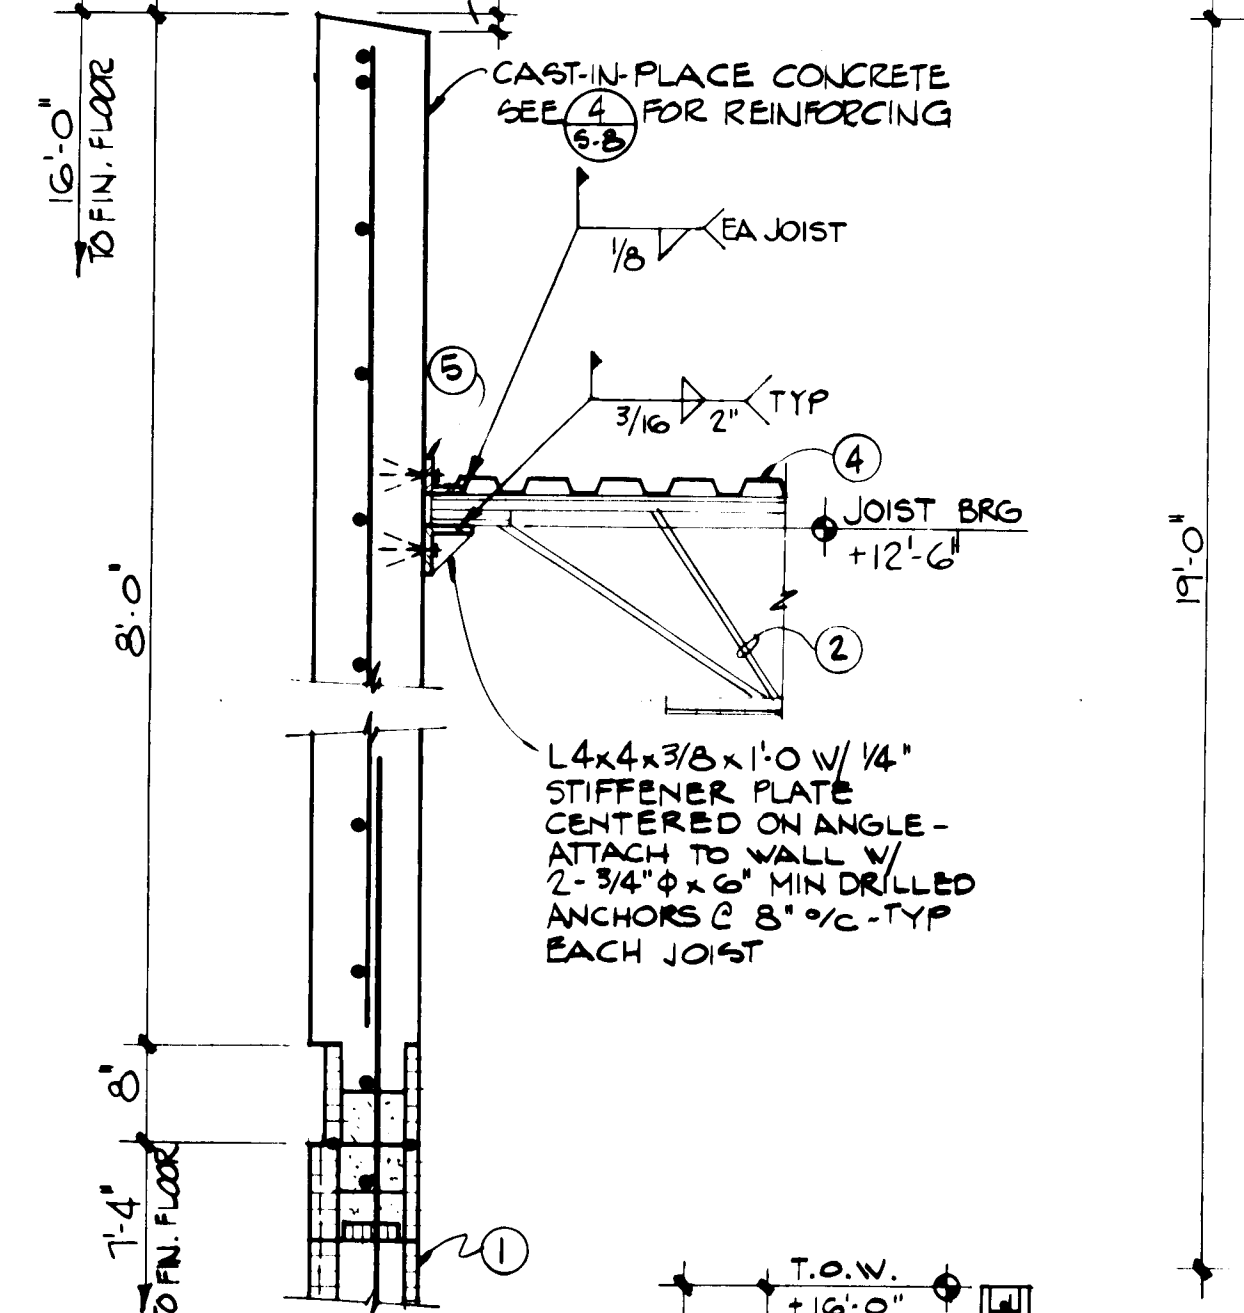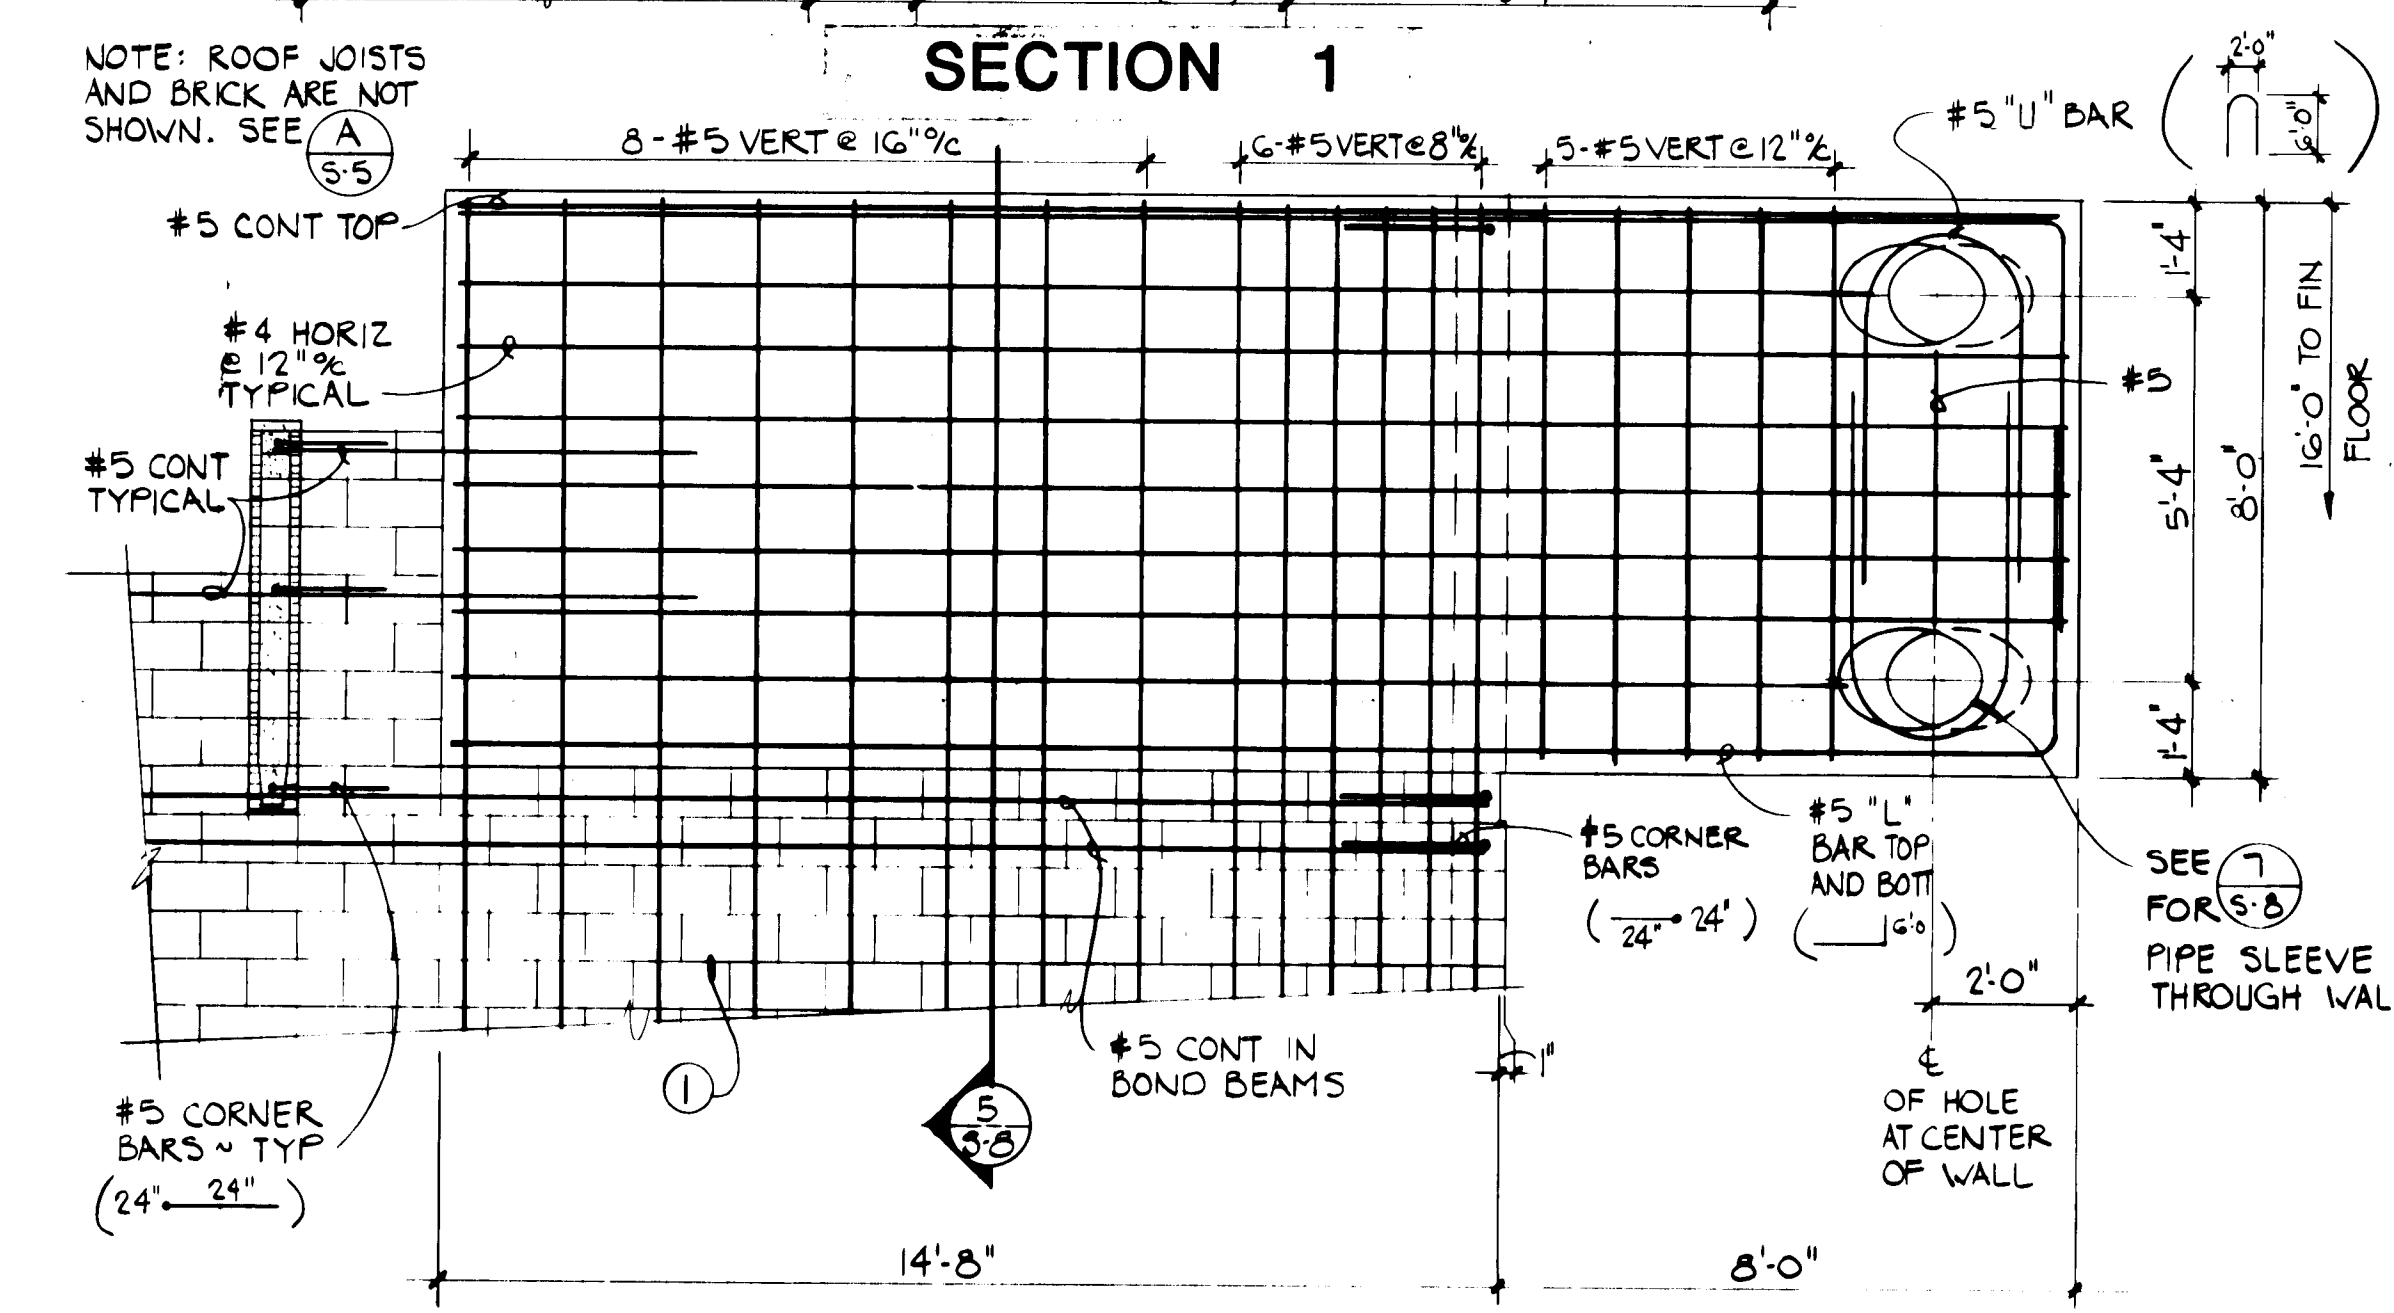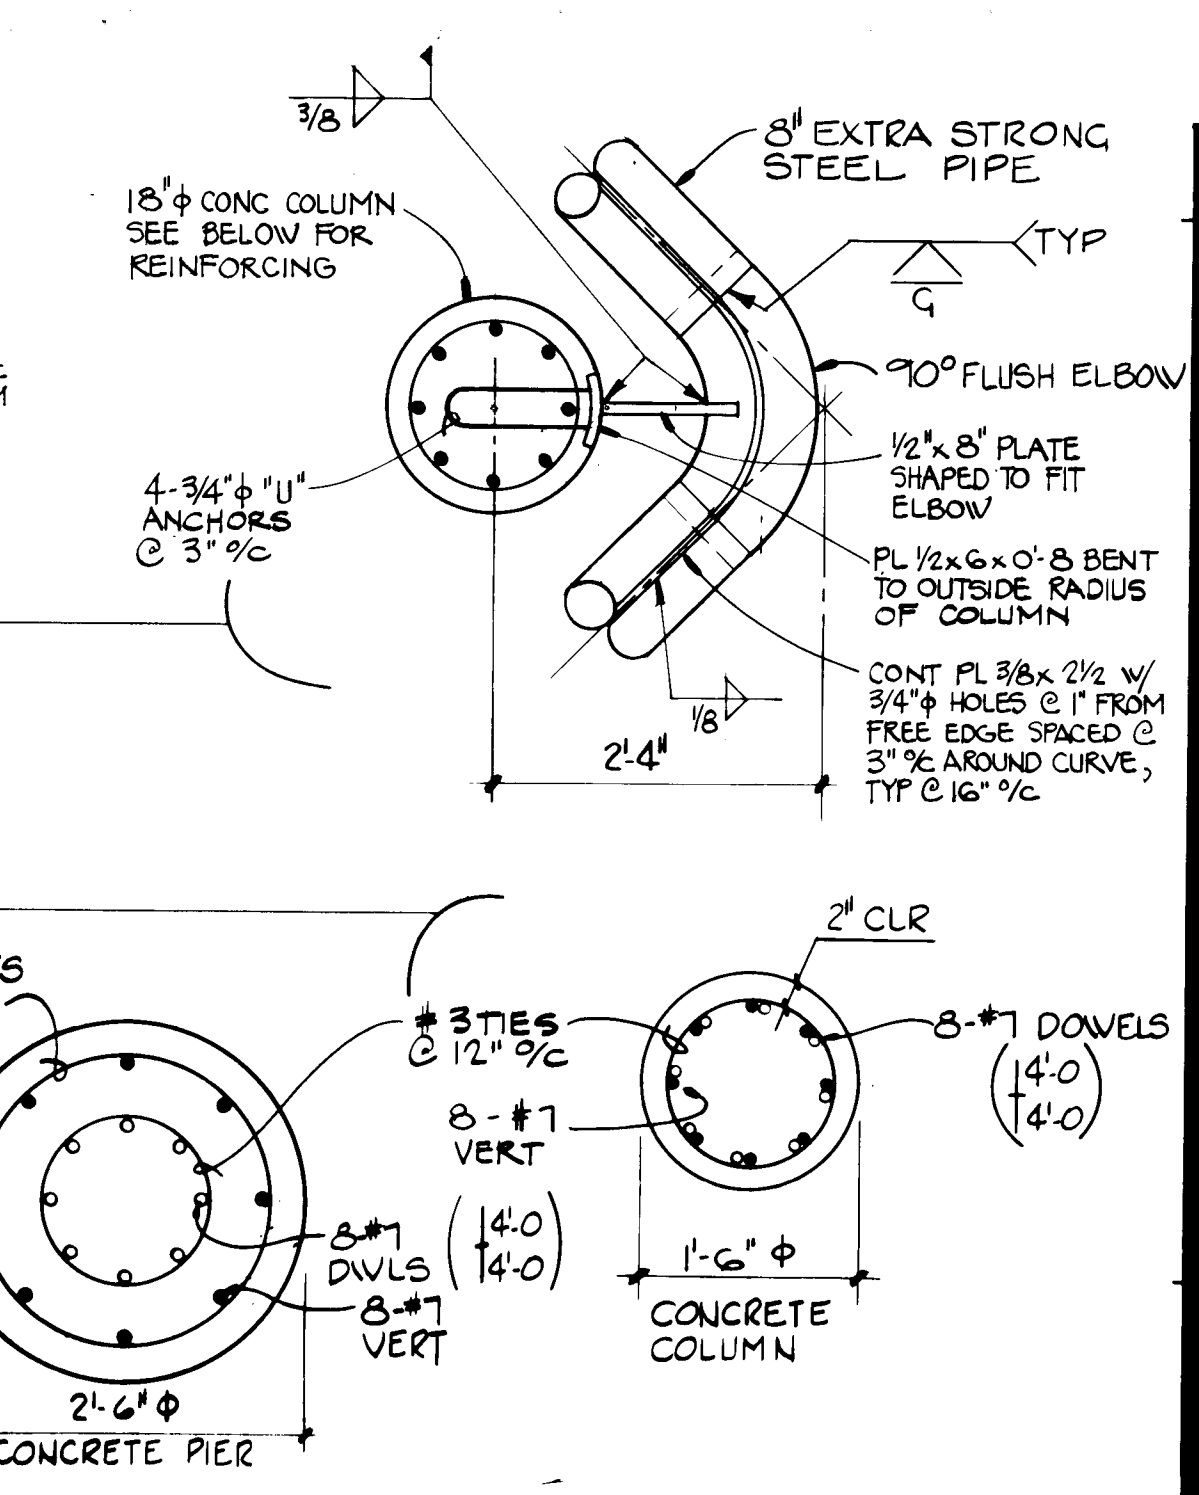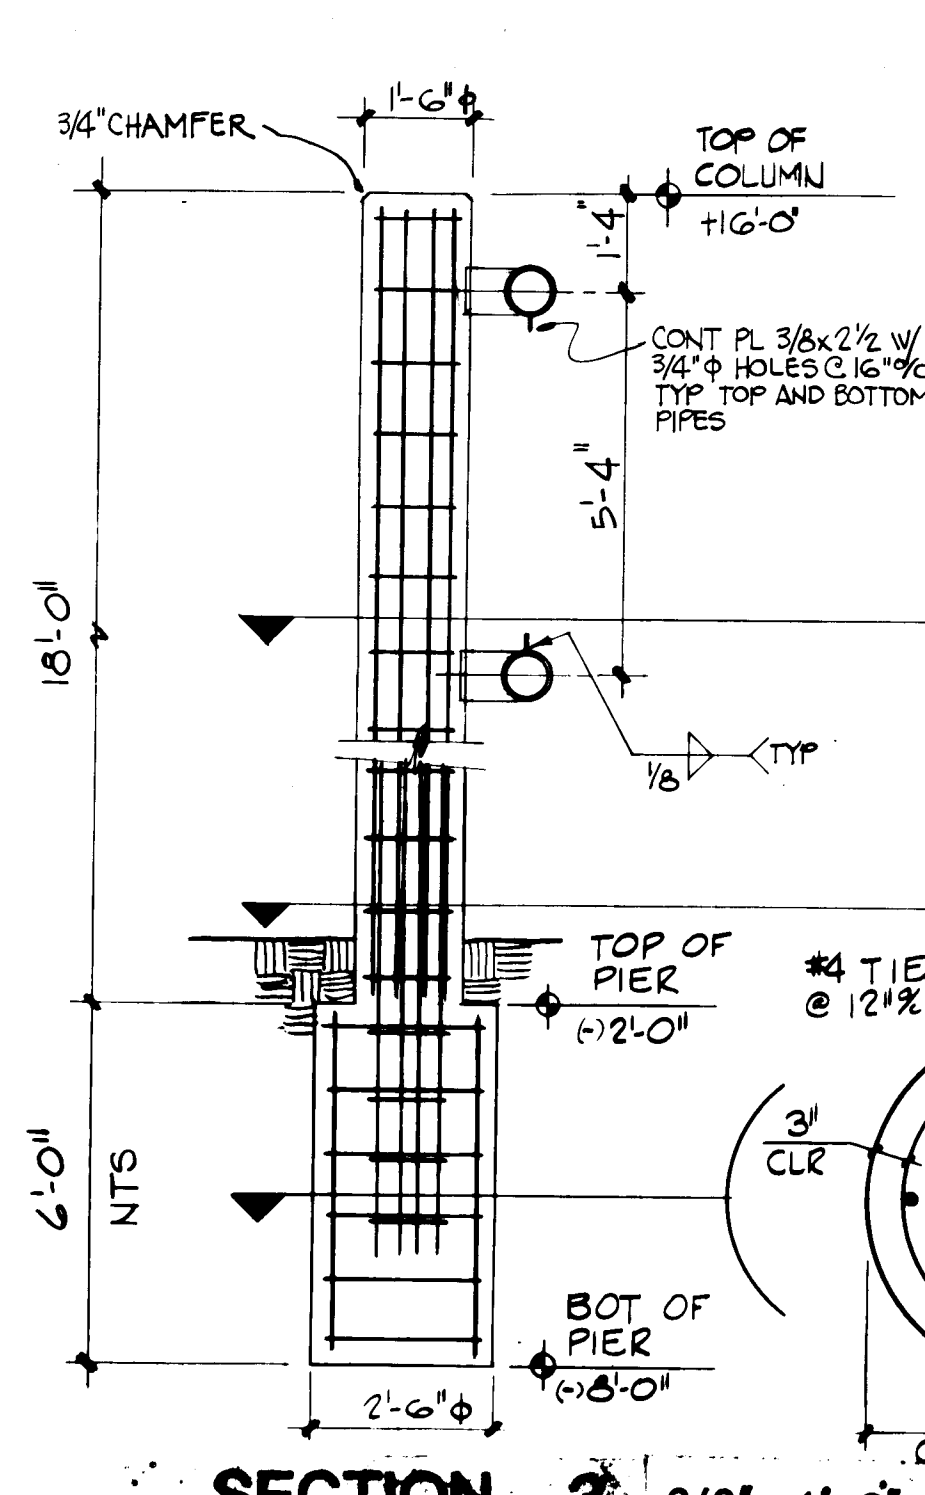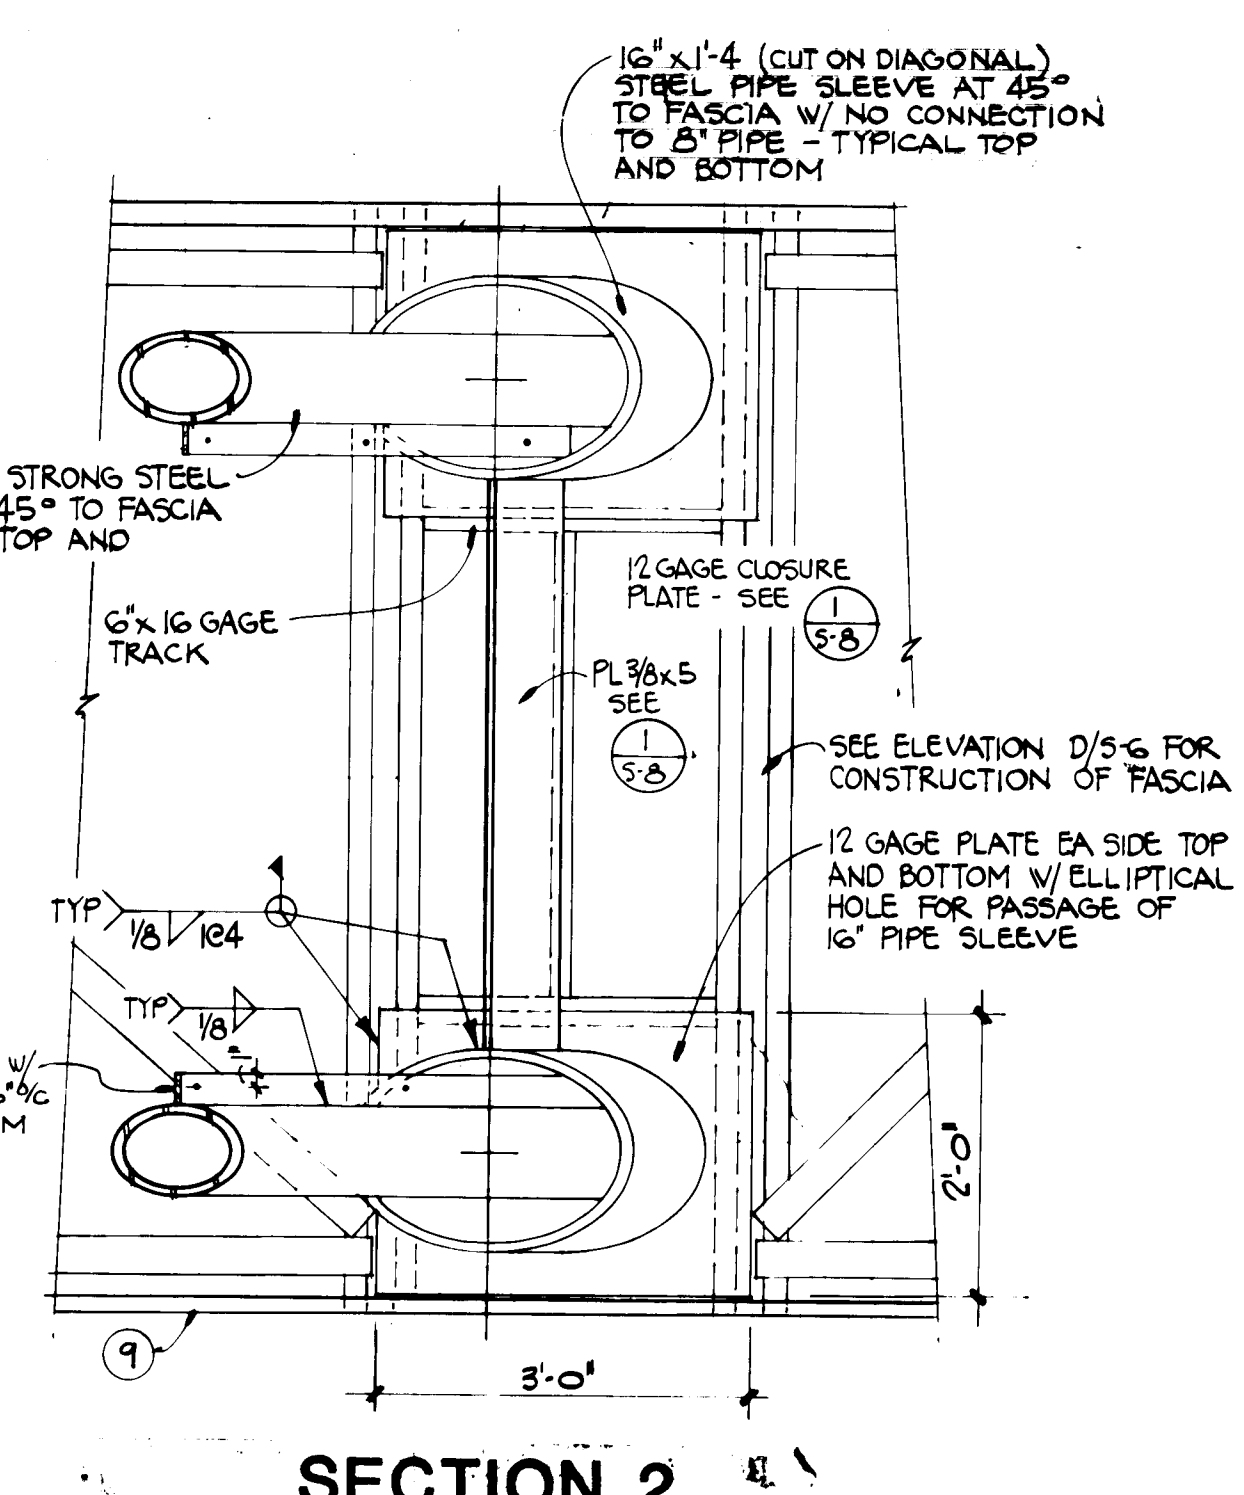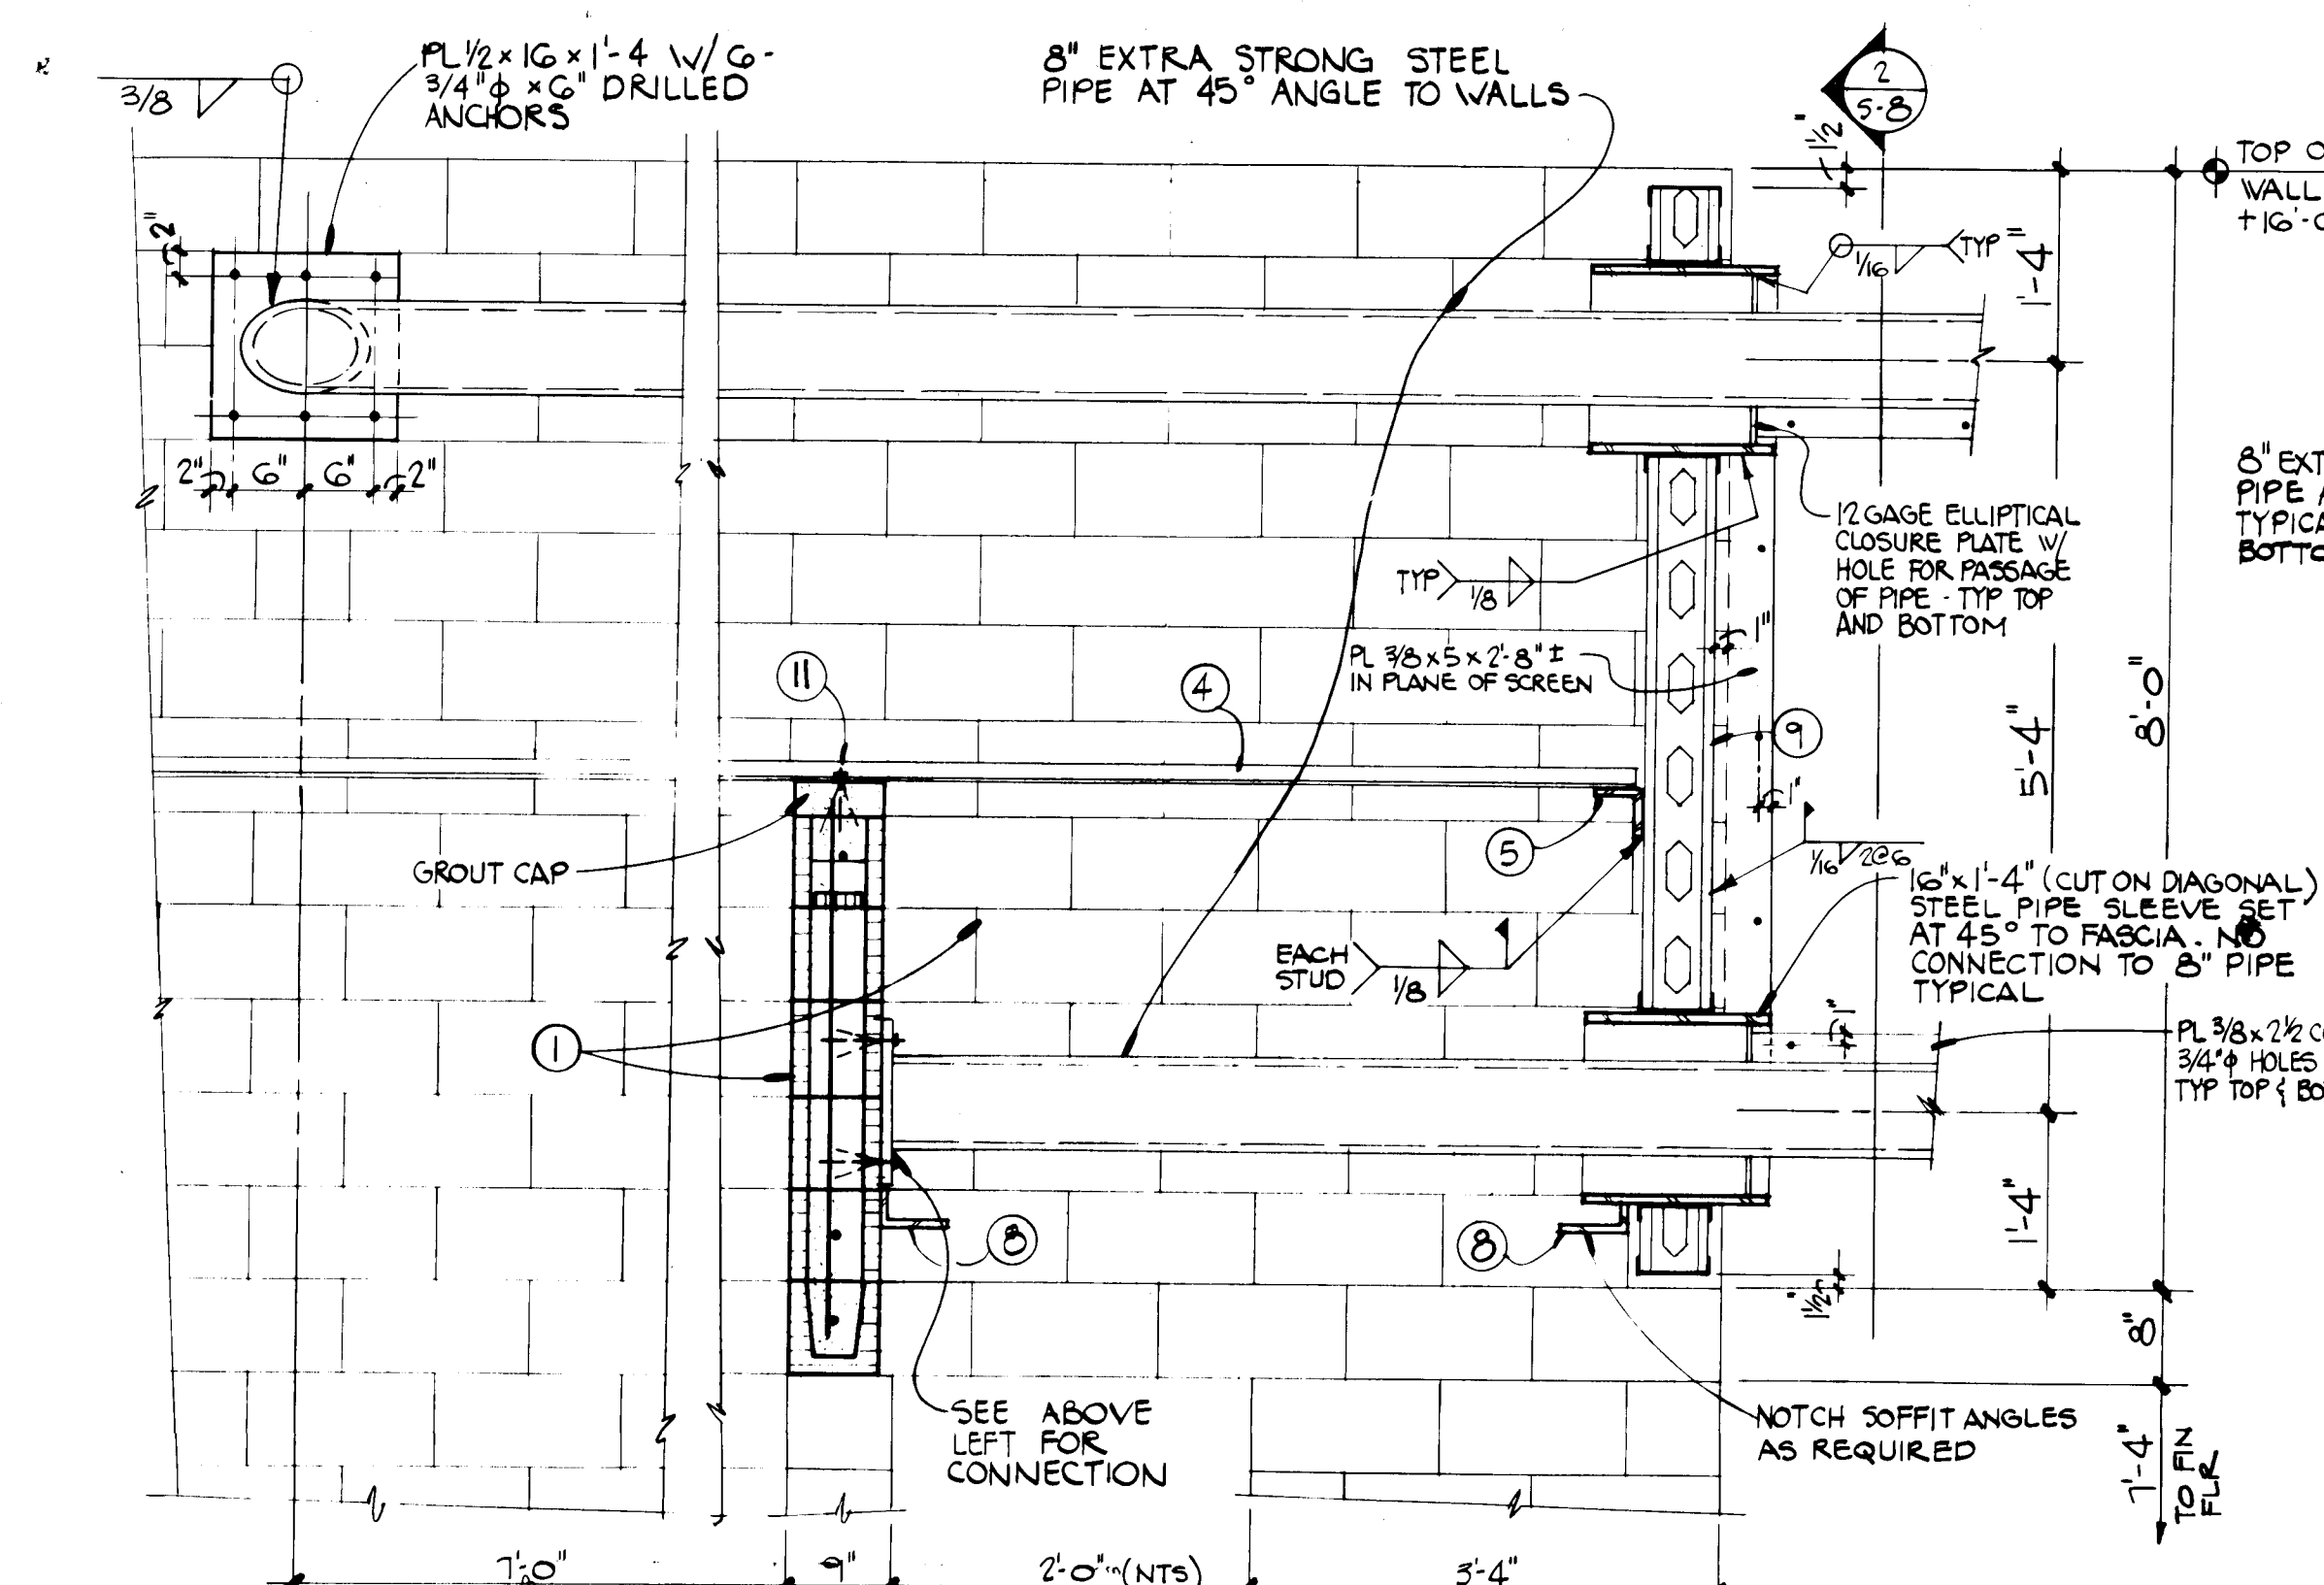

THE BURNS PETERS GROUP
ARCHITECTS PLANNERS

KEYED NOTES
ALTERNATE BID SECTIONS

- Concrete masonry wall. See notes and details on Sheet S-2 for reinforcing. See building elevations for type of unit required.
- H series open web steel joists. See ROOF FRAMING PLAN, Sheet S-4, for size, spacing and length.
- Not used.
- Steel roof deck. See Sheet S-4 for connection to supporting members.
- Continuous 4x4x1/4 steel perimeter angle. Connect to steel members as indicated; connect to cmu walls with 1/2" x 6" drilled expansion anchors @ 32" o/c.
- 3/8"x1'-0" steel bearing plate with 2-1/2" x 6" drilled expansion anchors @ 32" o/c.
- Not used.
- 6x3-1/2x3/8 steel soffit support angle. Connect to steel framing as indicated. Connect to cmu walls with 1/2" x 6" drilled expansion anchors @ 24" o/c.
- Light gauge structural steel framing. See sheet S-6 for notes and details of construction.
- Not used.
- 3/8" x 4" drilled expansion anchor - typical at each side lap valley between units and at alternate valleys (12" o/c maximum) between.

BURNS/PETERS GROUP ARCHITECTS
RECORD DRAWING
DATE: 12 SEPT 81
Pauline Prew

REVISIONS




ENGINEER	ARCHITECT
----------	-----------

THE EAST-CENTRAL MULTI-SERVICE CENTER

PROJECT NO. 21205 DATE MAY 83

S8
SHEET 15 OF 26

26 1589 1584
SCALE: 3/4" = 1'-0"
UNLESS OTHERWISE NOTED

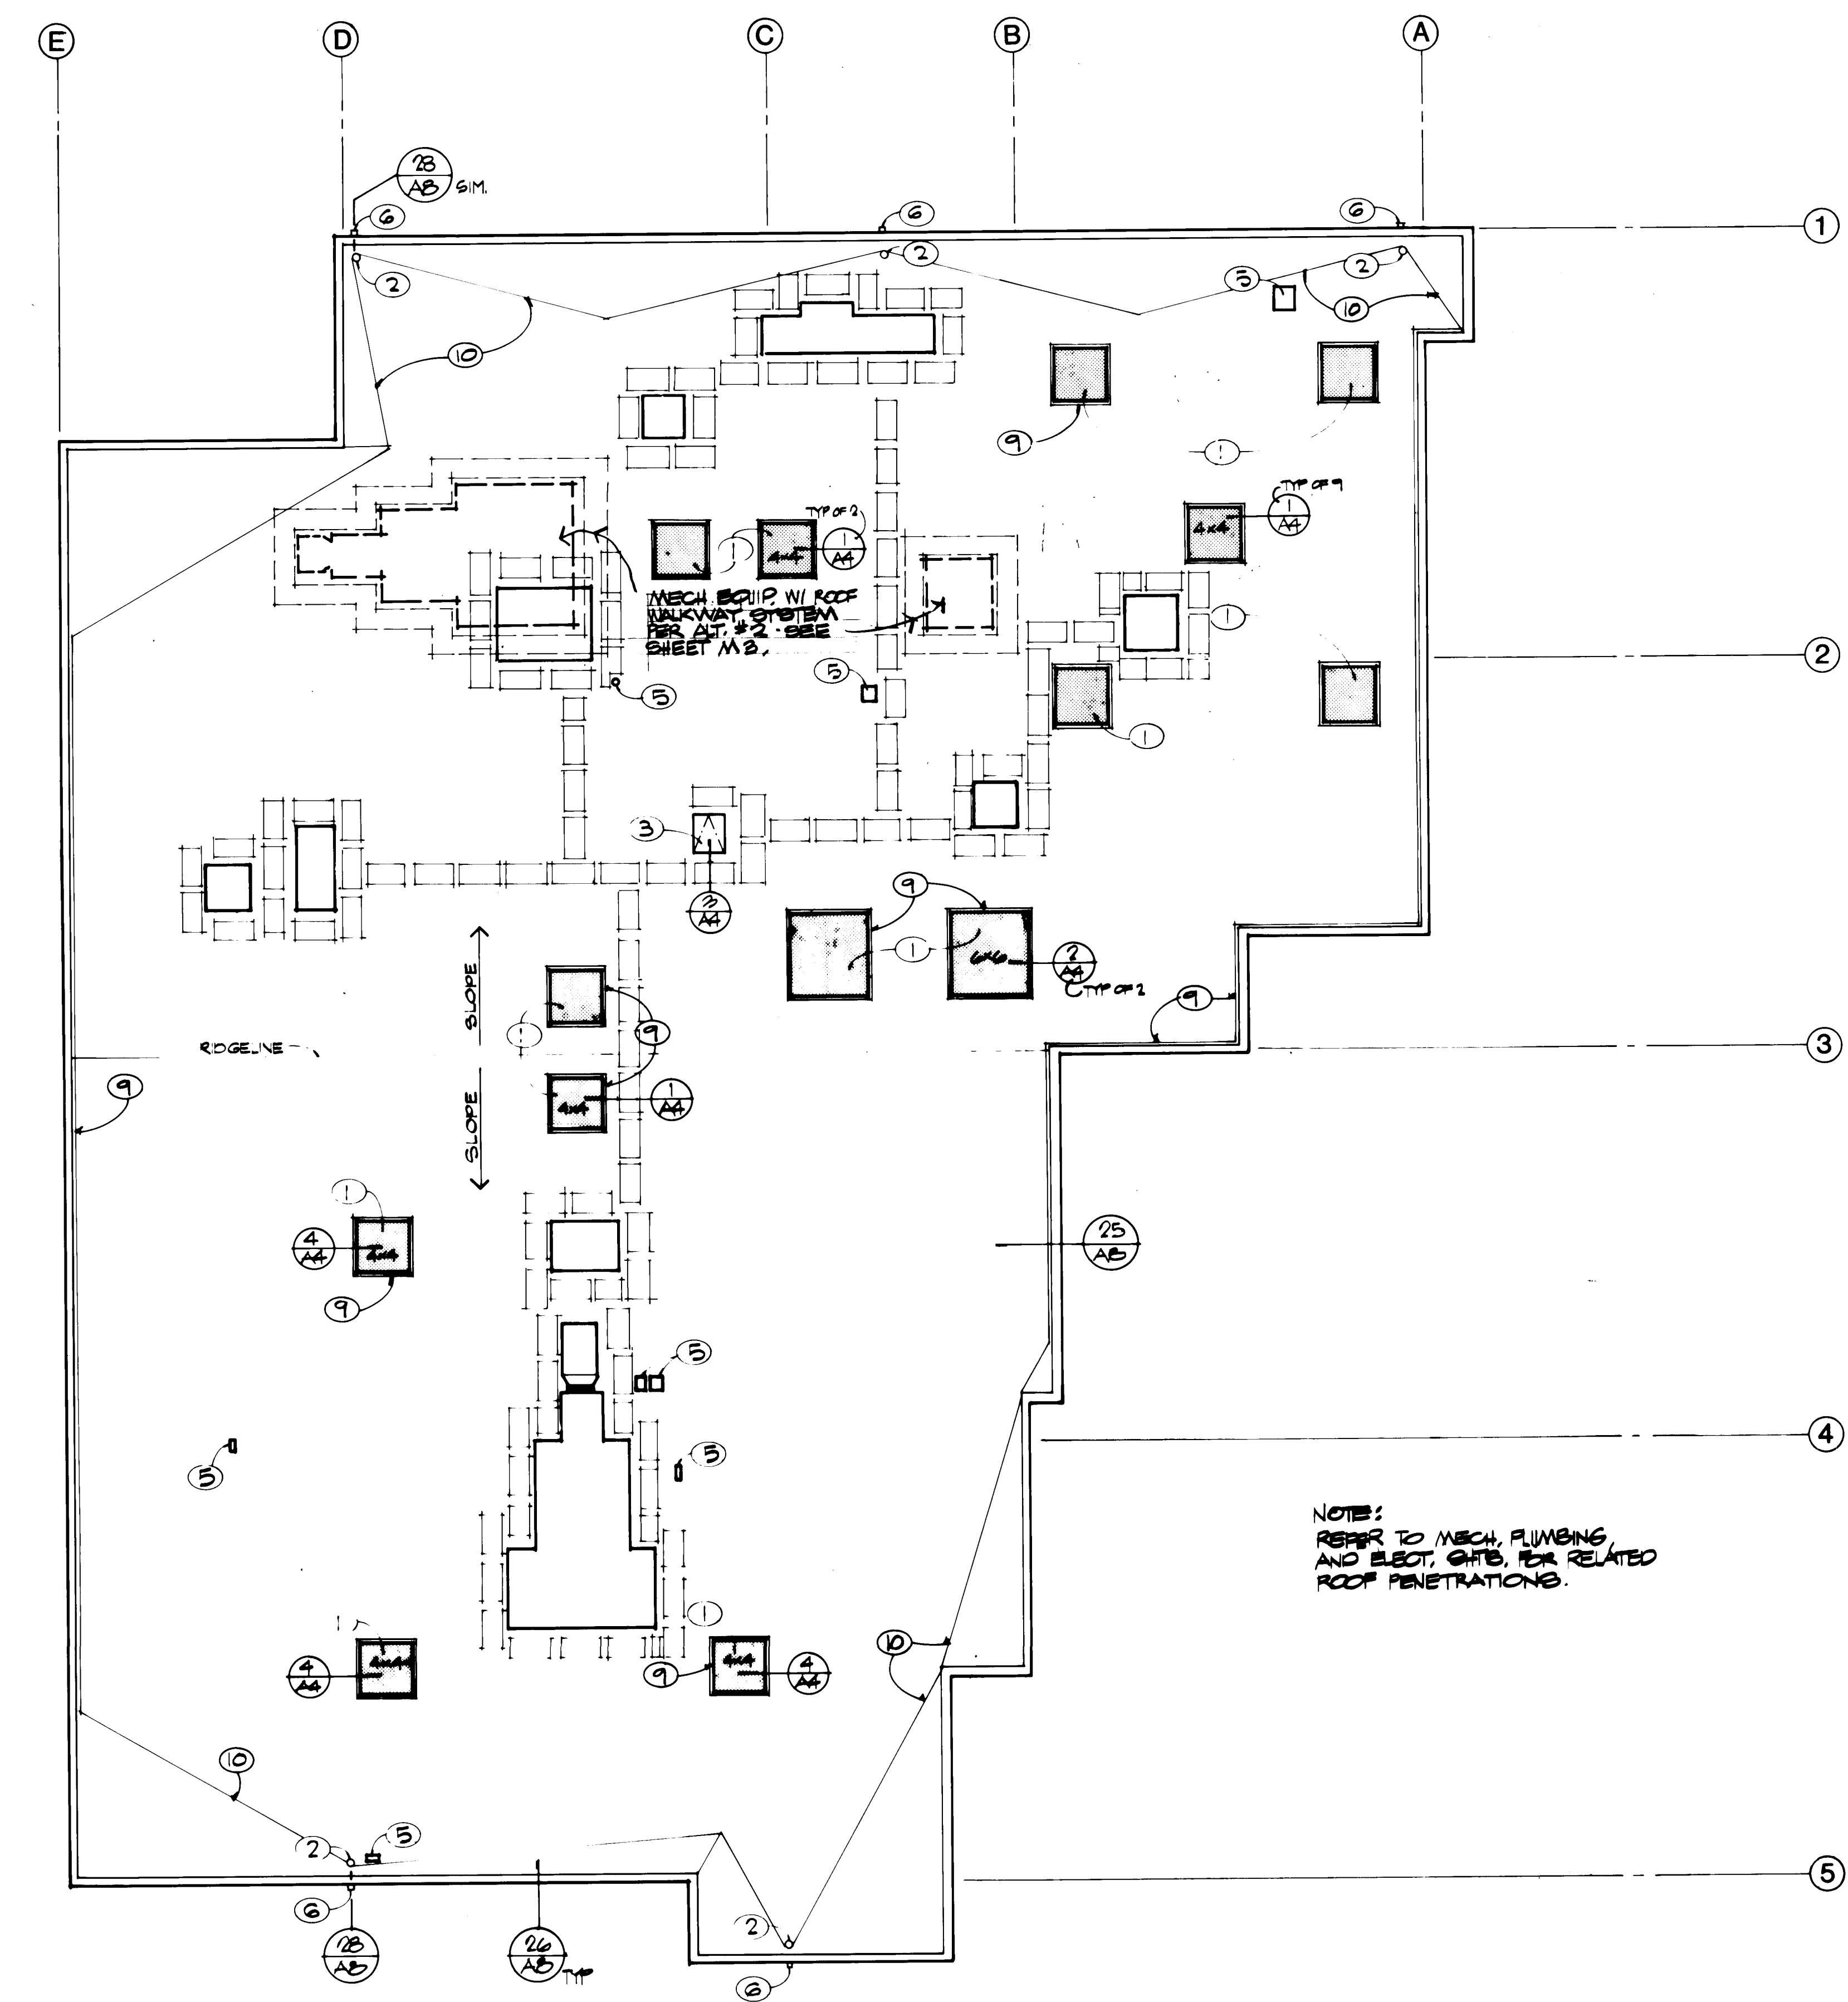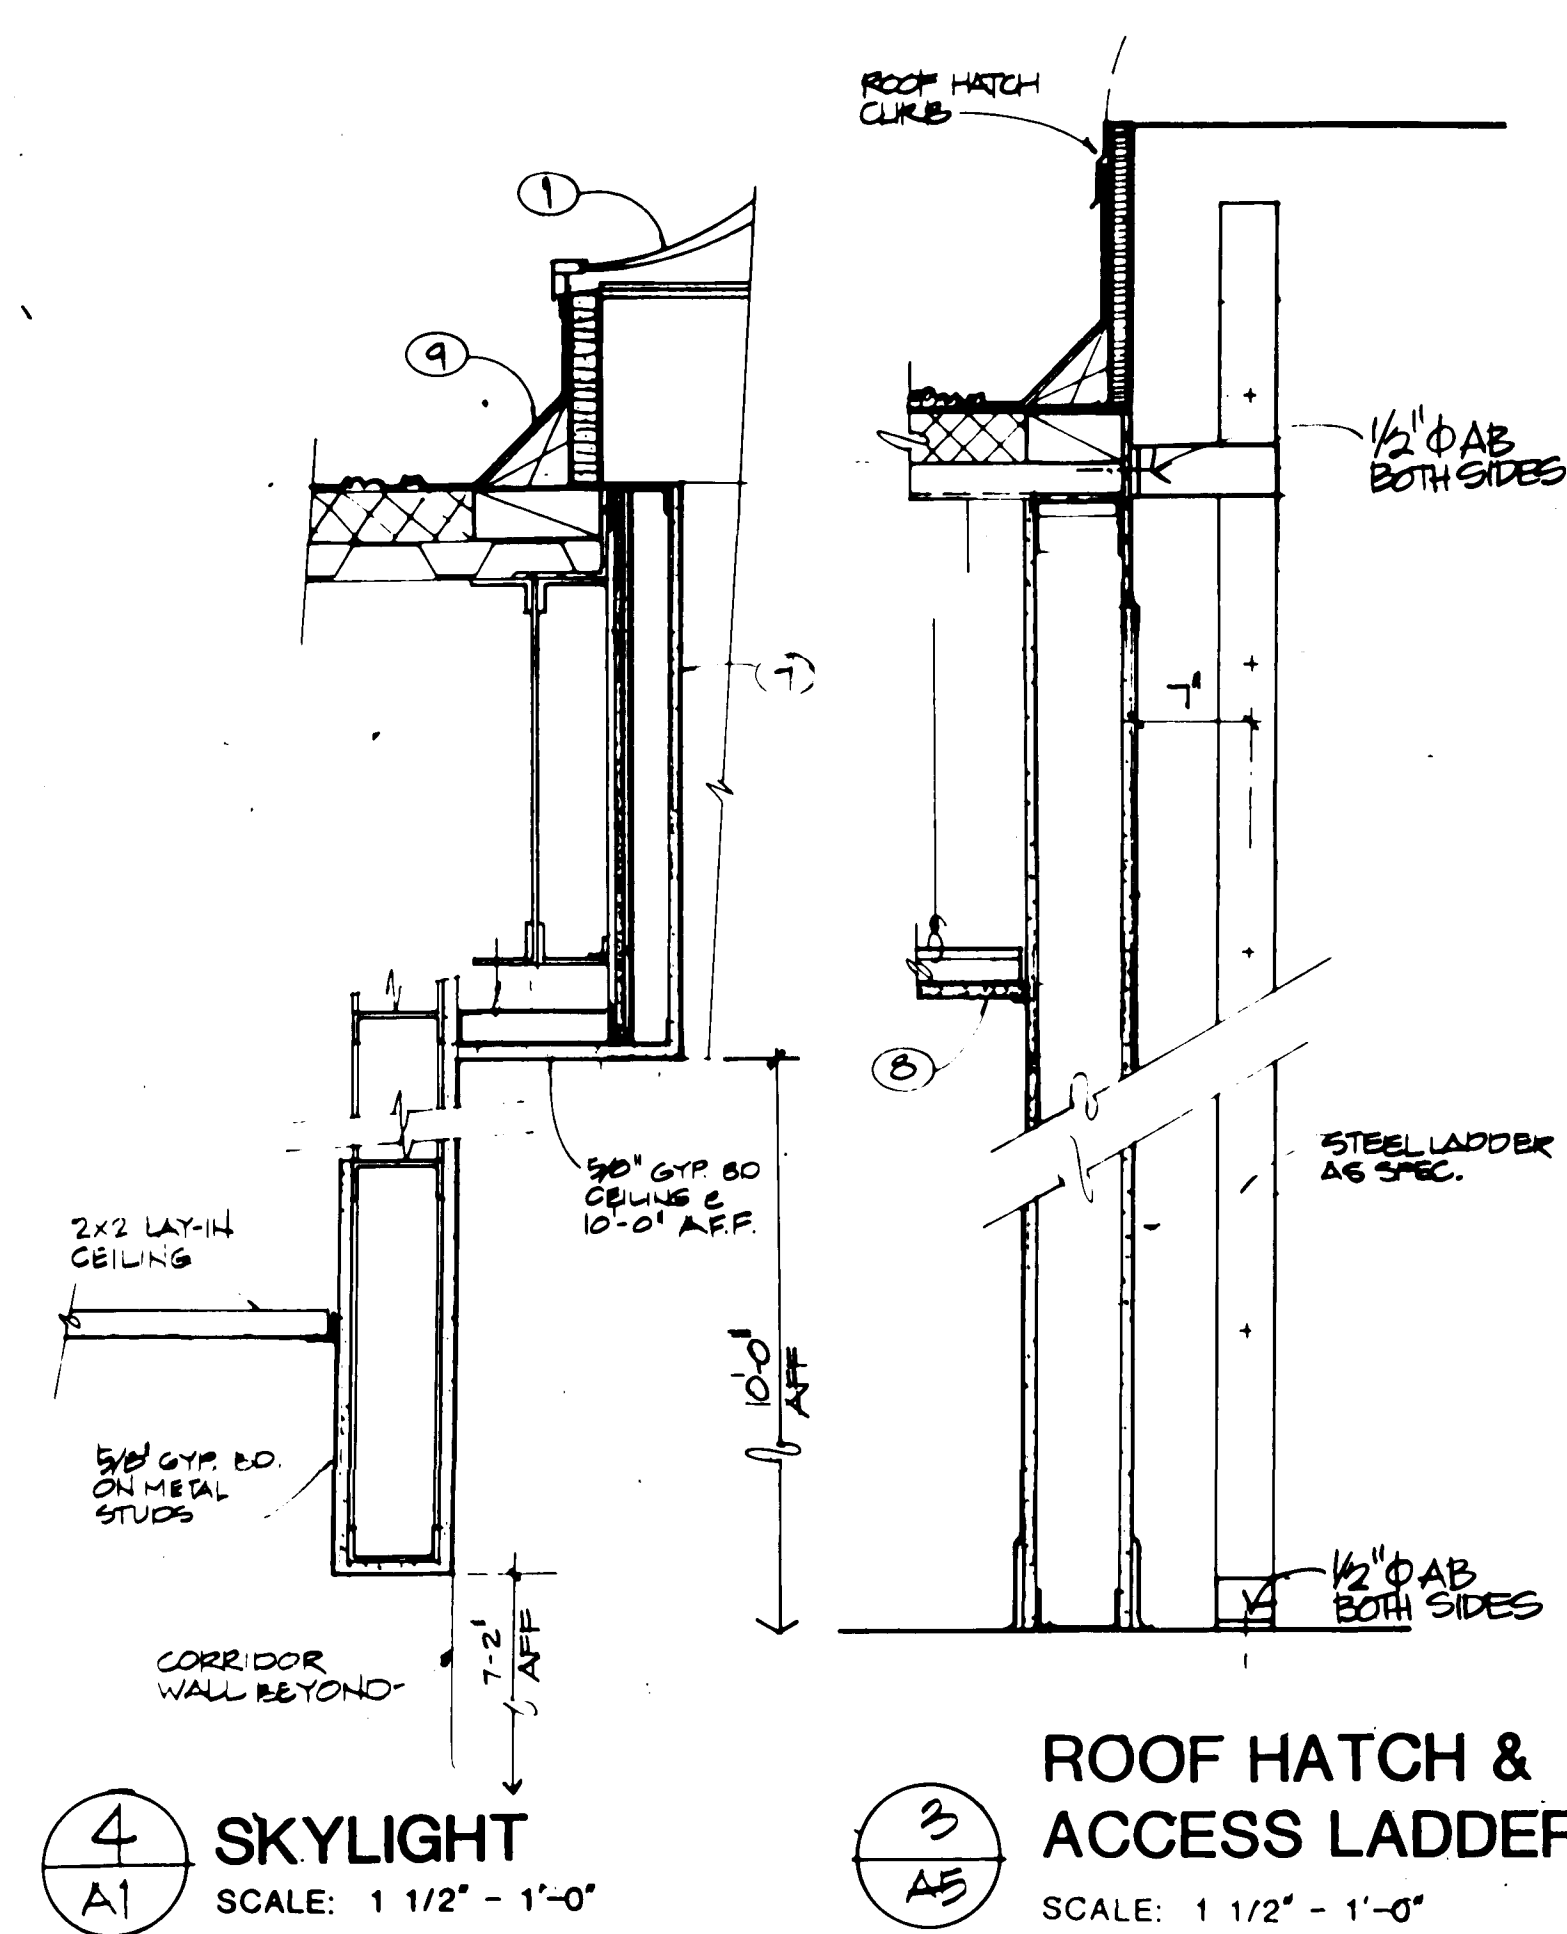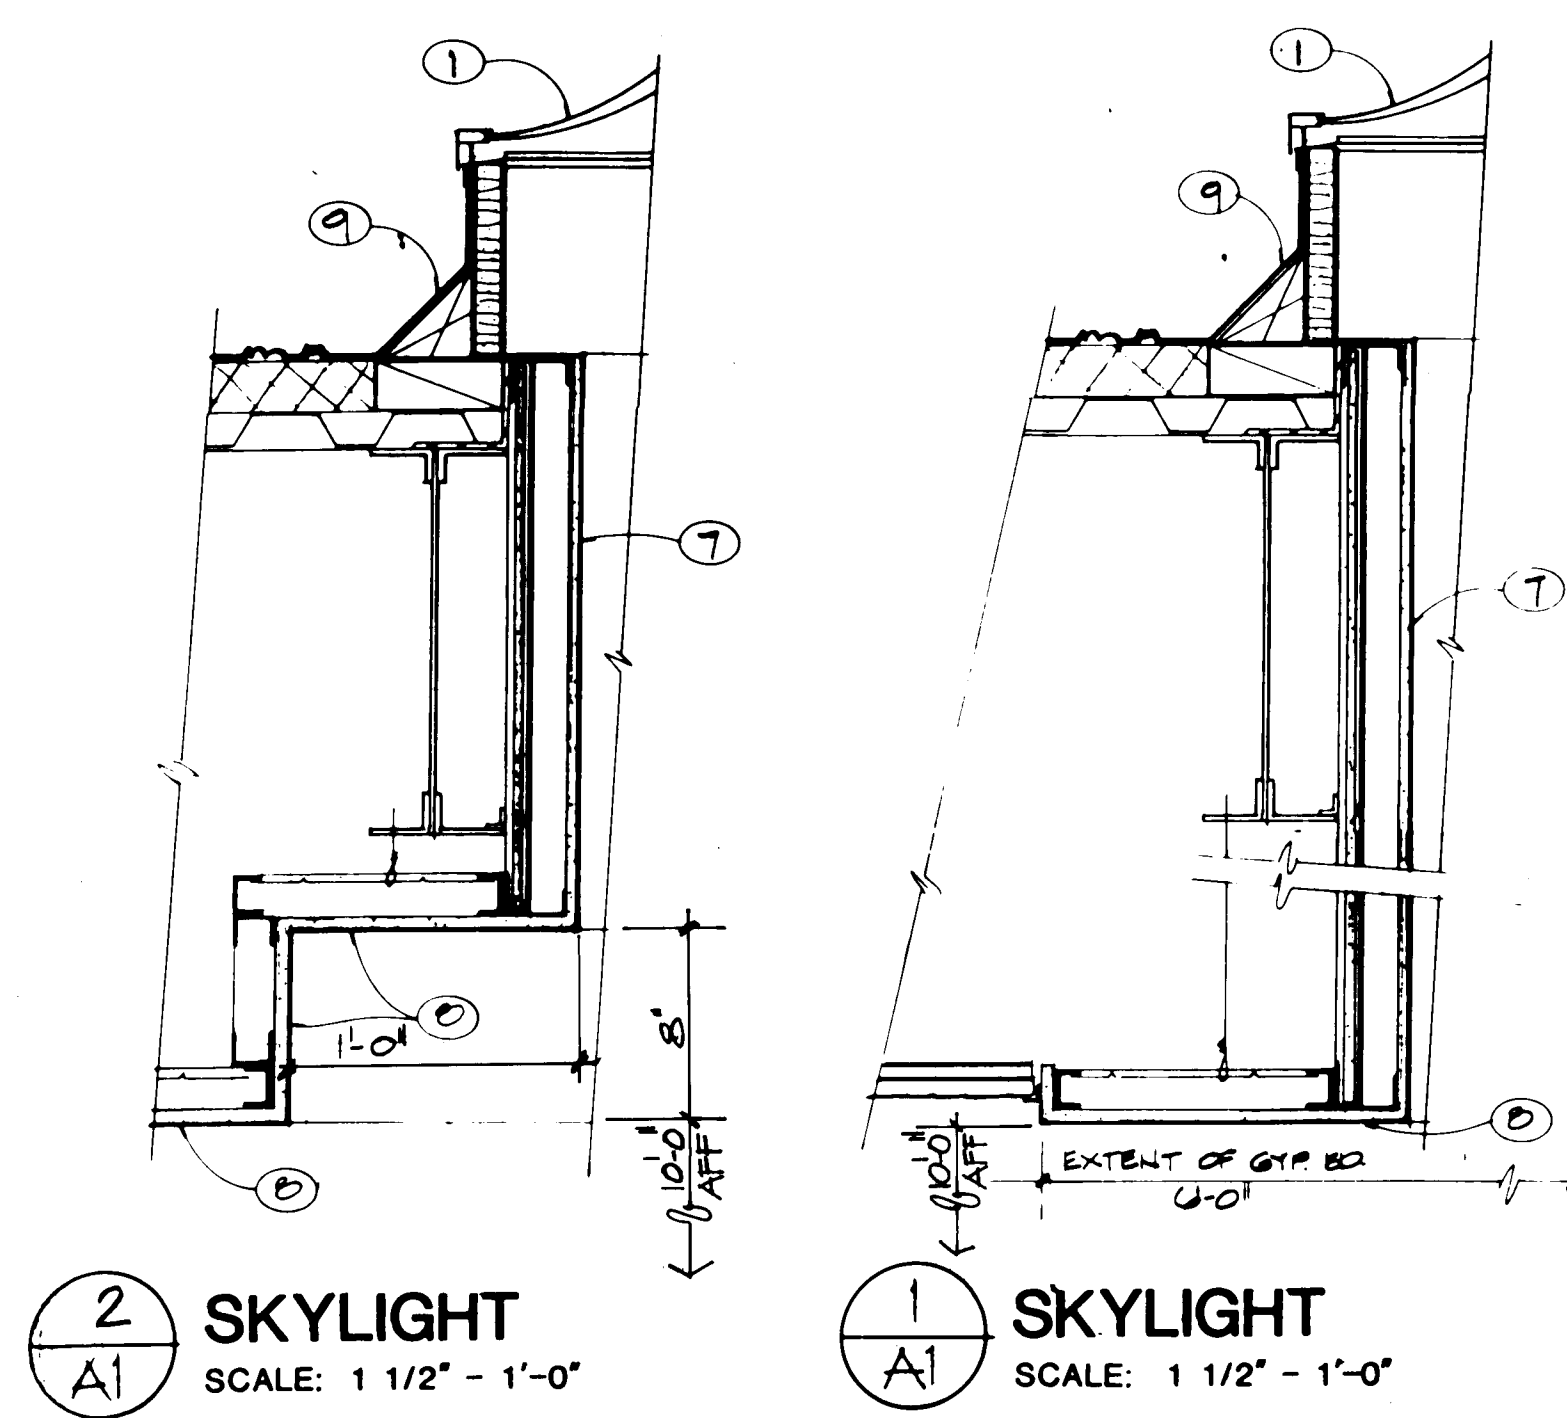

THE BURNS/PETERS GROUP
ARCHITECTS PLANNERS

1000 PENNSYLVANIA CIRCLE, N.E. ALBUQUERQUE, NM 87102 505-253-3645

NOTES

1. SKYLIGHTS AS PER SPEC. SEE DET. 514 FOR LOCATIONS.
2. ROOF DRAIN - SEE YECB.
3. ROOF HATCH - SEE SPEC.
4. ROOF PROTECTION WALKWAY SYSTEM - SEE SPEC.
5. ROOF PENETRATIONS, SEE MECH. ENGINEER.
6. OVERFLOW ROOF DRAIN.
7. 1 HR. GRAFT WALL.
8. 5/8" GYP BRD ON METAL TRACKS.
9. CANT STRIP.
10. CONCRETE.

REVISIONS




BURNS/PETERS GROUP-ARCHITECTS
RECORD DRAWING
DATE: 12 SEPT 84
Ken L. Brown

THE EAST-CENTRAL MULTI-SERVICE CENTER

PROJECT NO. 8100 DATE MAY '88

A4
SHEET 20 OF 22

26' 15"89 20'84

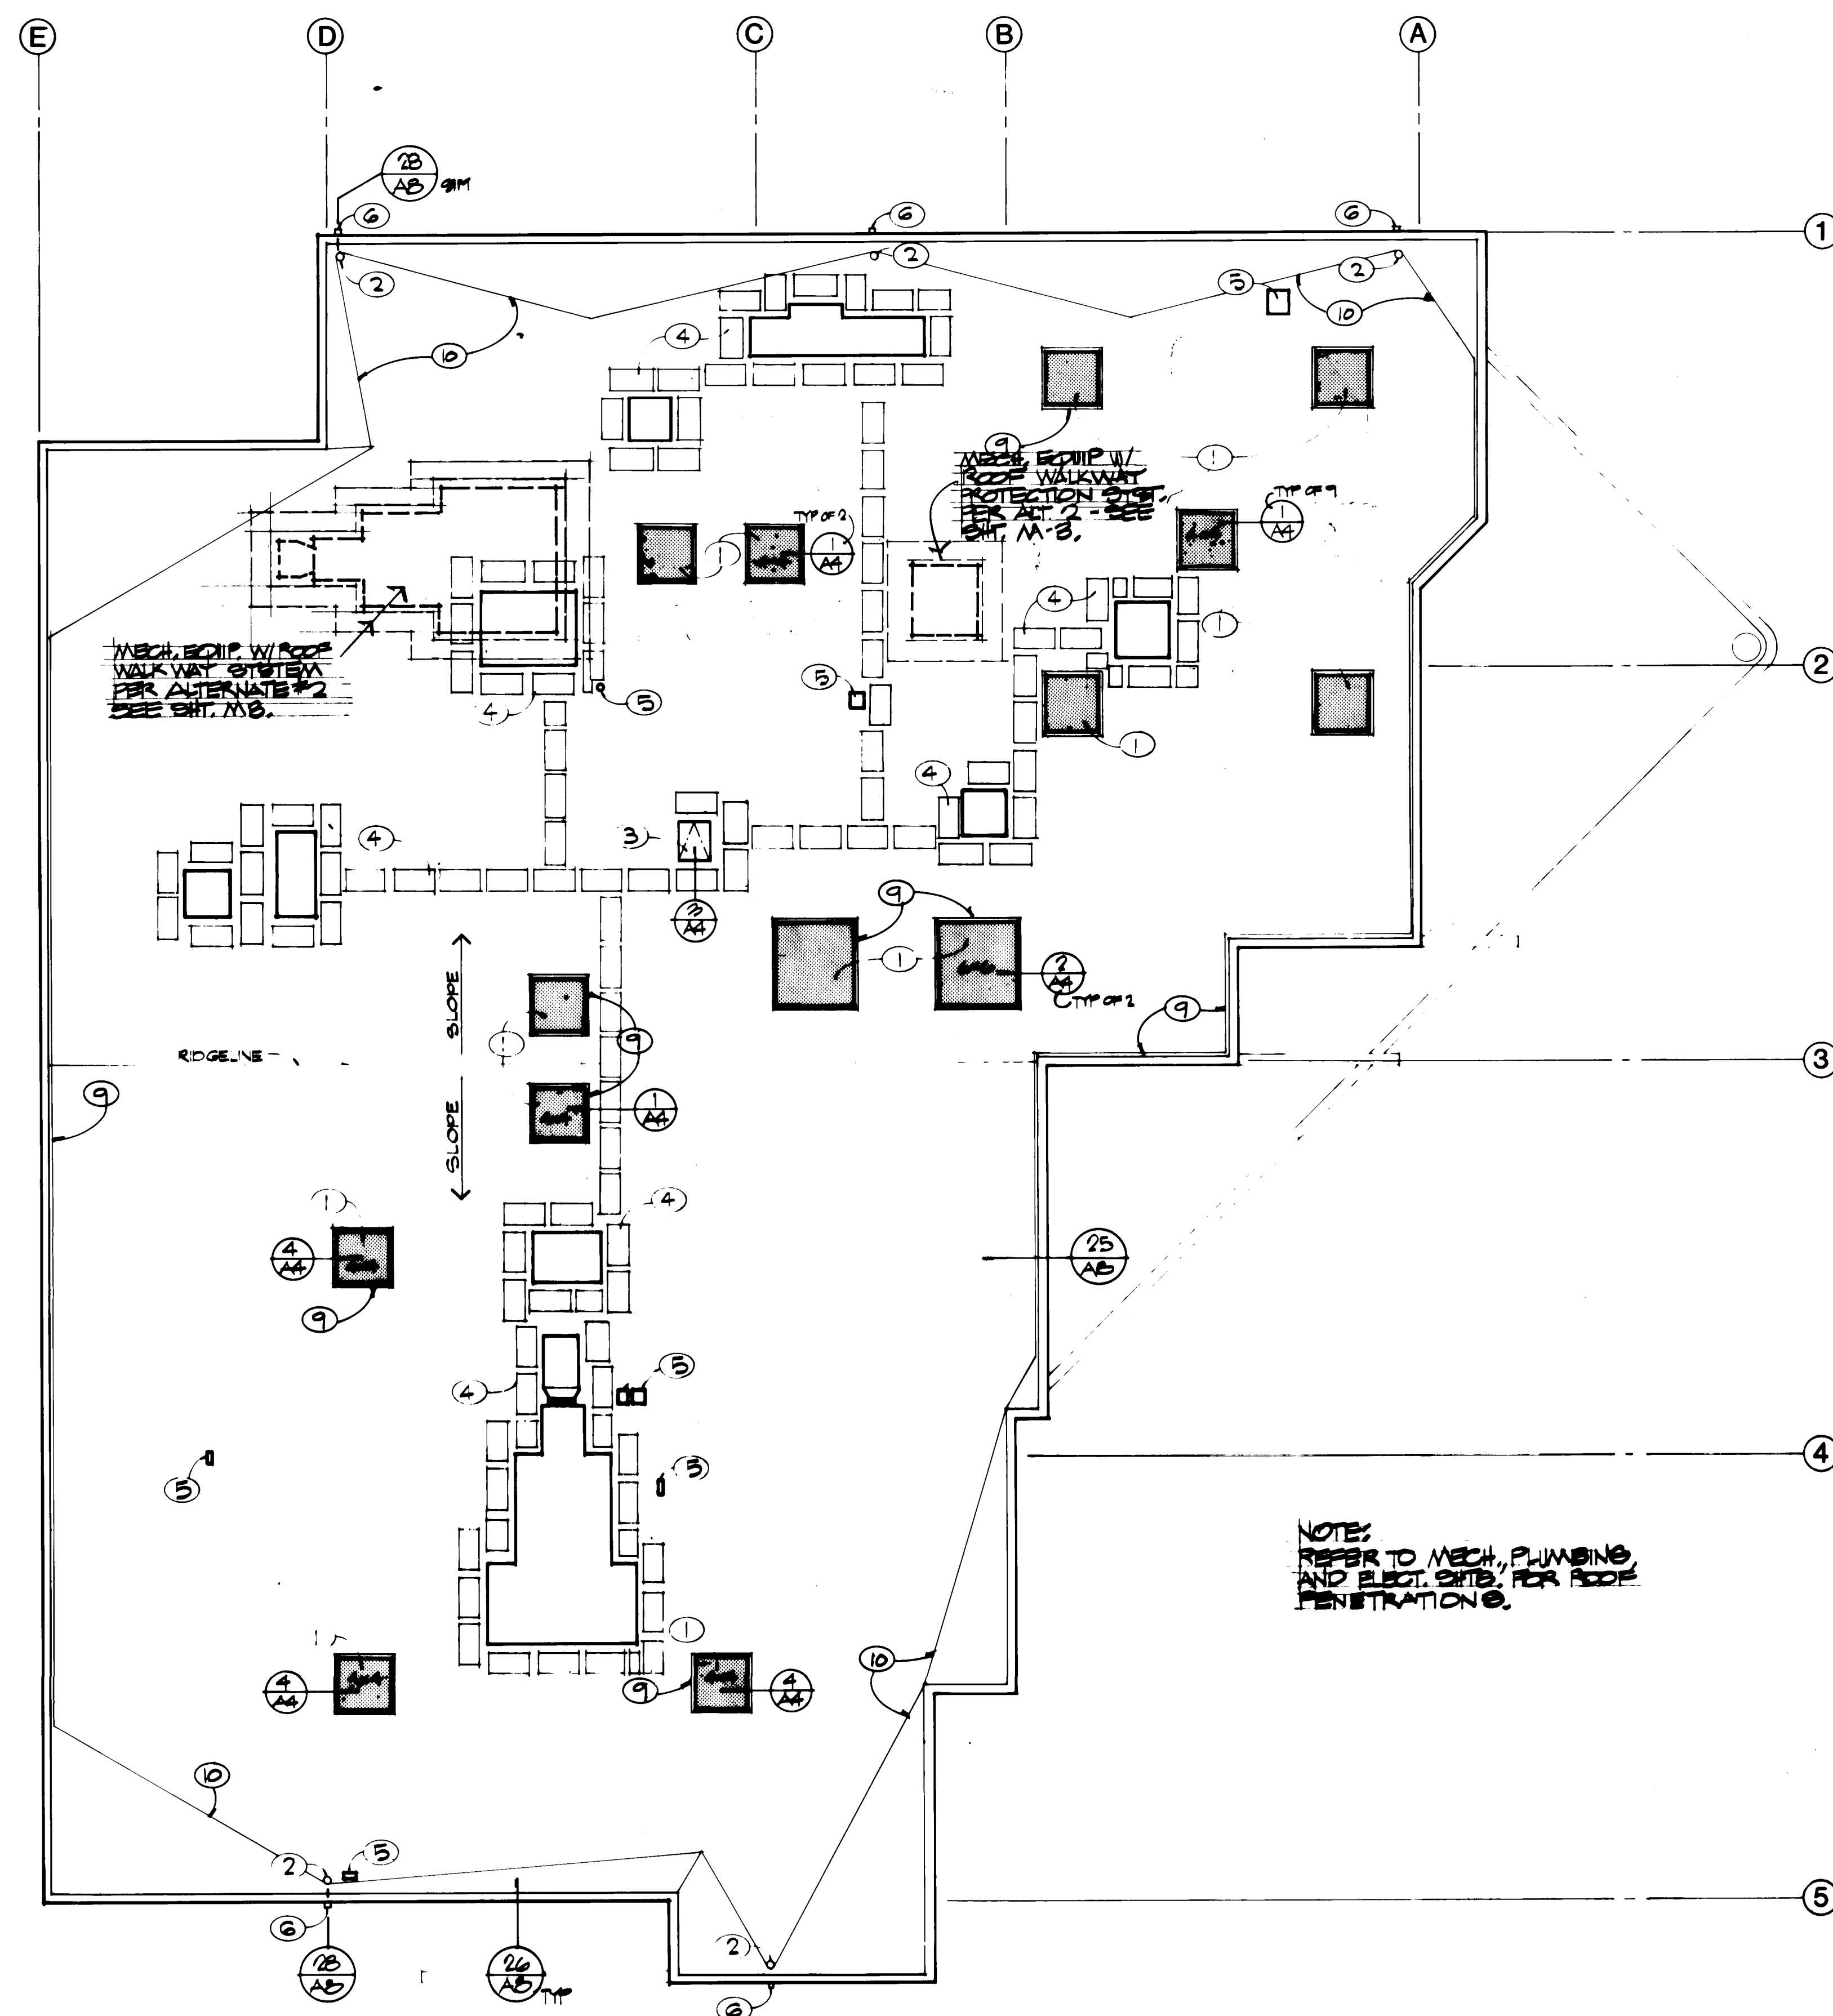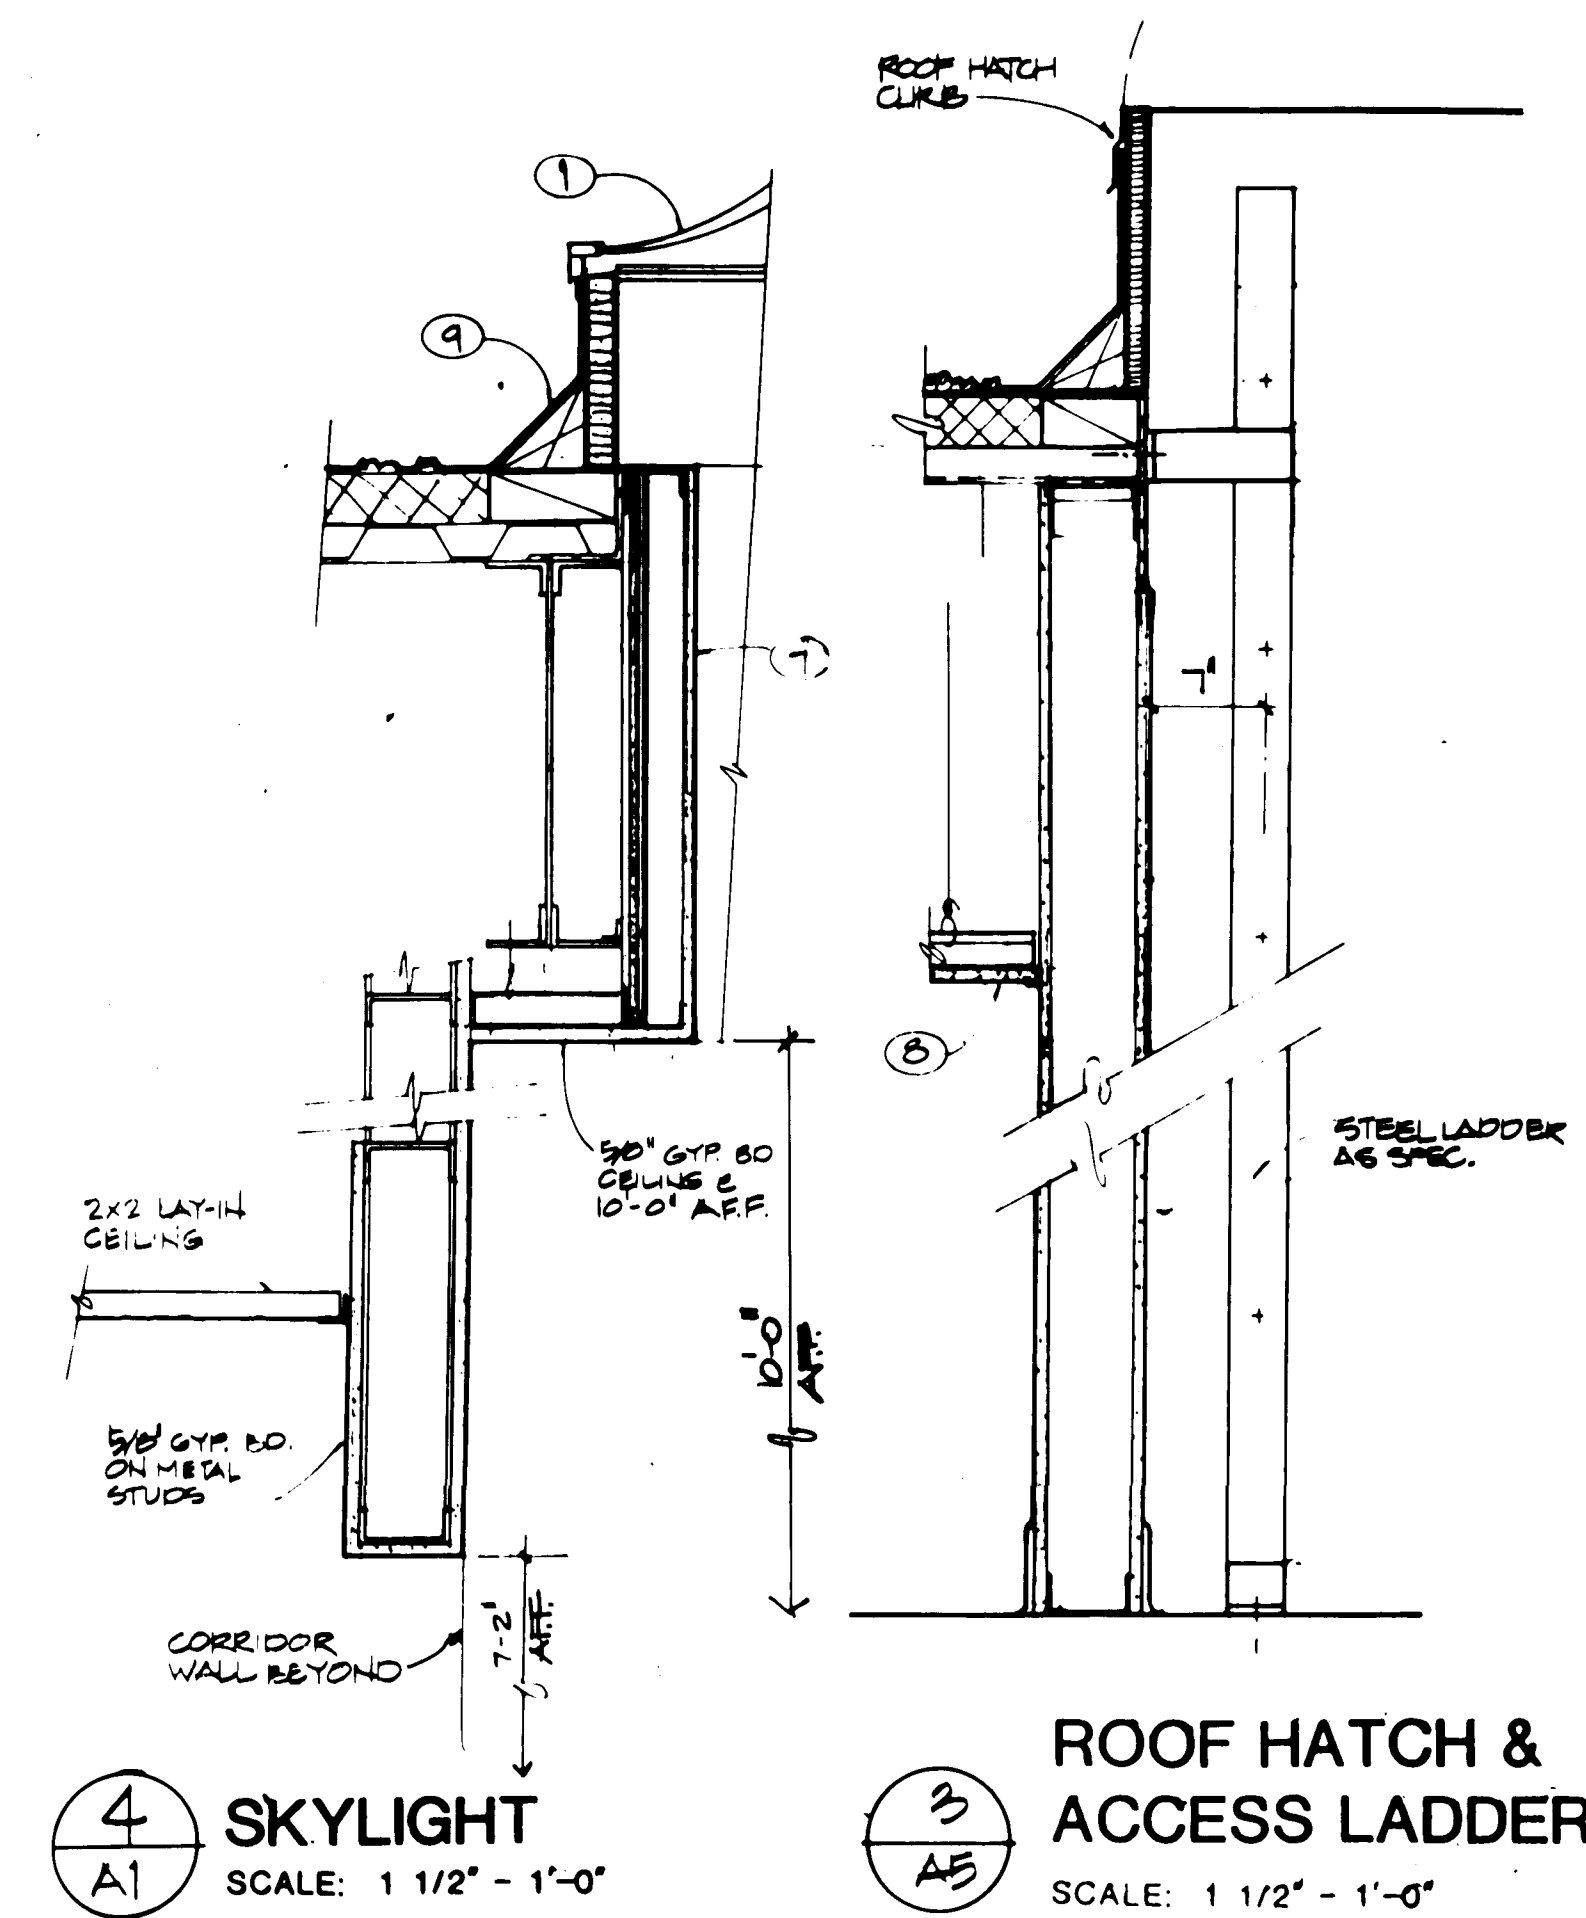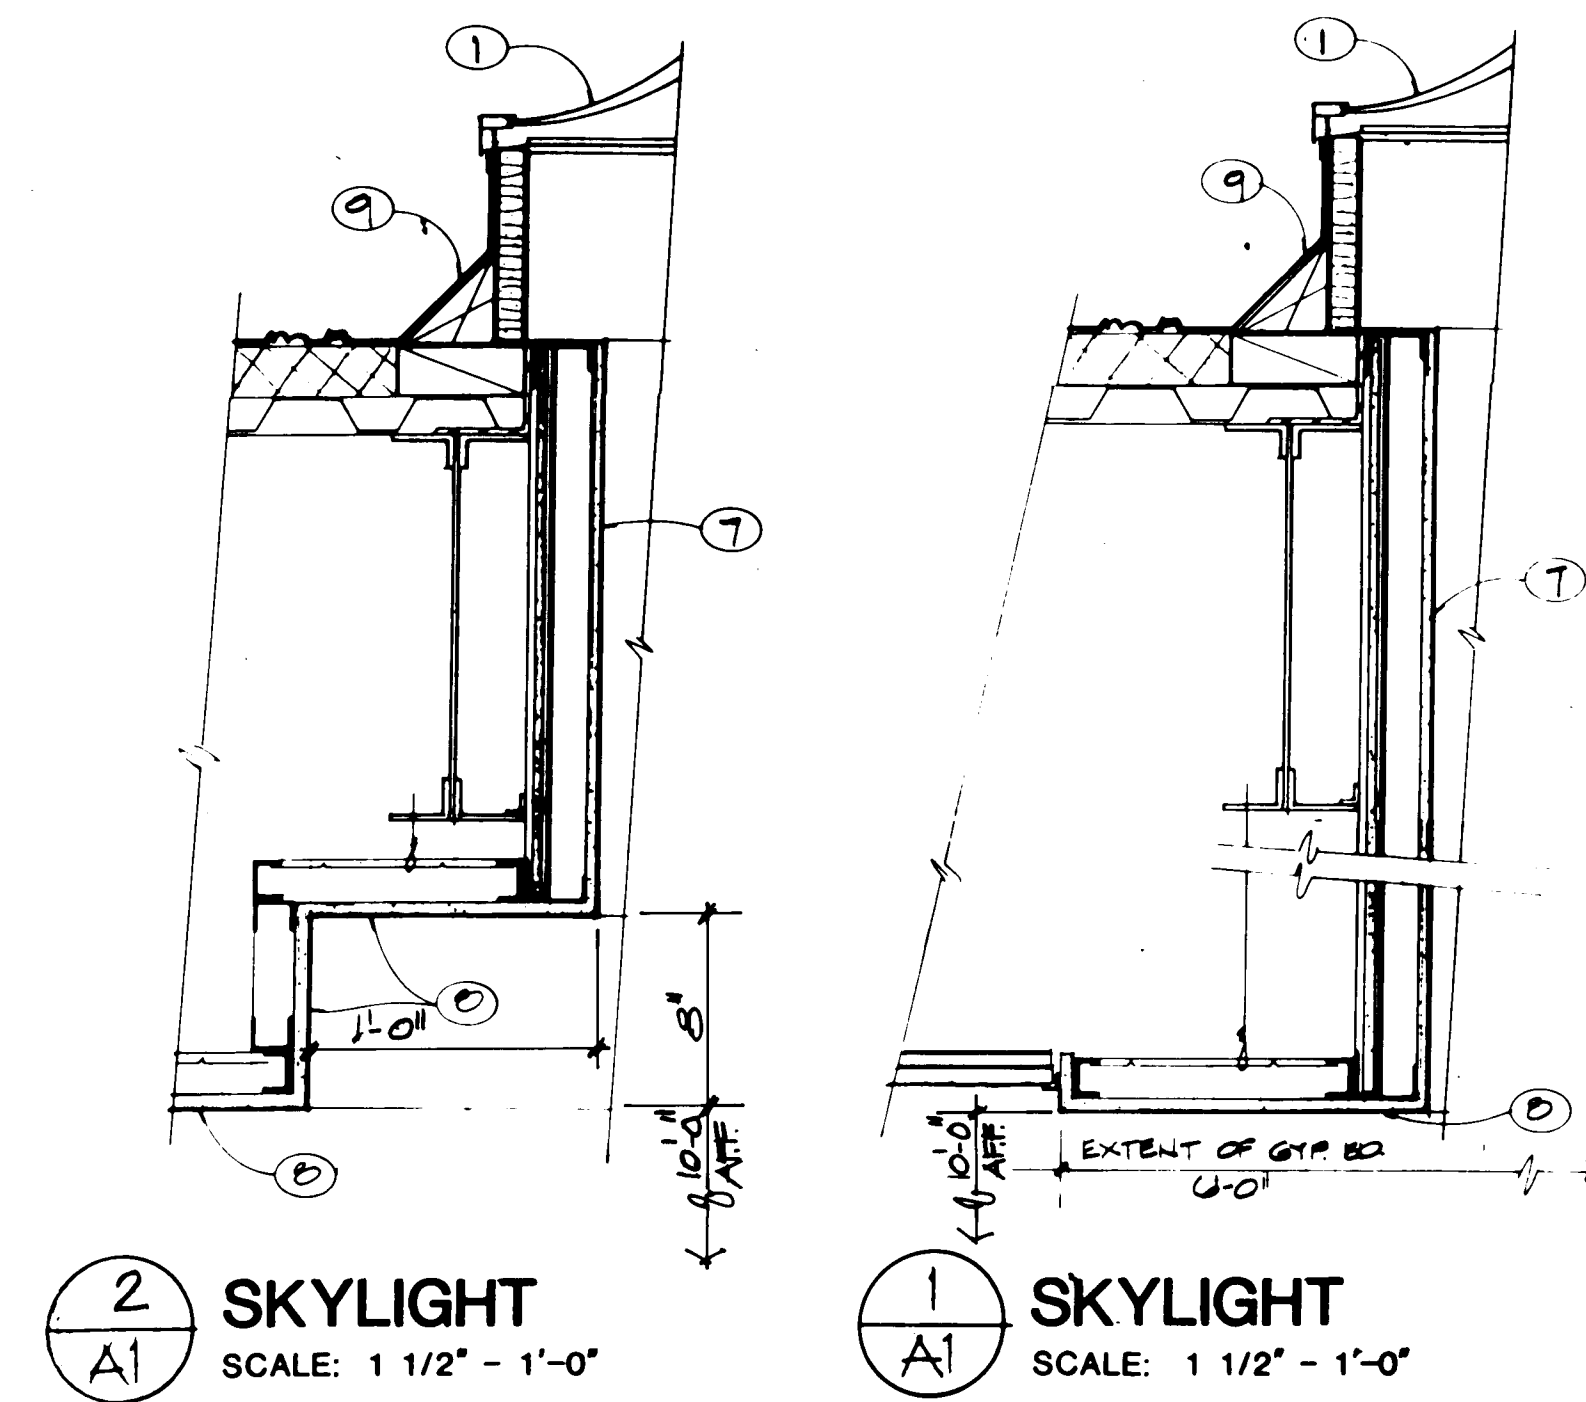

THE BURNS PETERS GROUP
ARCHITECTS PLANNERS

NOTES

- 1 SKYLIGHTS AS PER SPEC. SEE DET. NO. 8 FOR LOCATION.
- 2 ROOF DRAIN - SEE TECH.
- 3 ROOF HATCH - SEE SPEC.
- 4 ROOF PROTECTION WALKWAY SYSTEM - SEE SPEC.
- 5 ROOF PENETRATIONS, SEE MECH. DRWG.
- 6 OVERFLOW ROOF SCUMPER
- 7 1 HR. CHASE WALL
- 8 3/8" GYP BRD ON METAL TRACKS
- 9 4" GYP STUCCO
- 10 CONCRETE

BURNS/PETERS GROUP-ARCHITECTS
RECORD DRAWING
DATE: 12 SEPT 84
JULIUS EW

REVISIONS


ENGINEER

ARCHITECT

THE EAST-CENTRAL MULTI-SERVICE CENTER

PROJECT NO. 8203 DATE MAY '88

A4.5
SHEET 21 OF 26

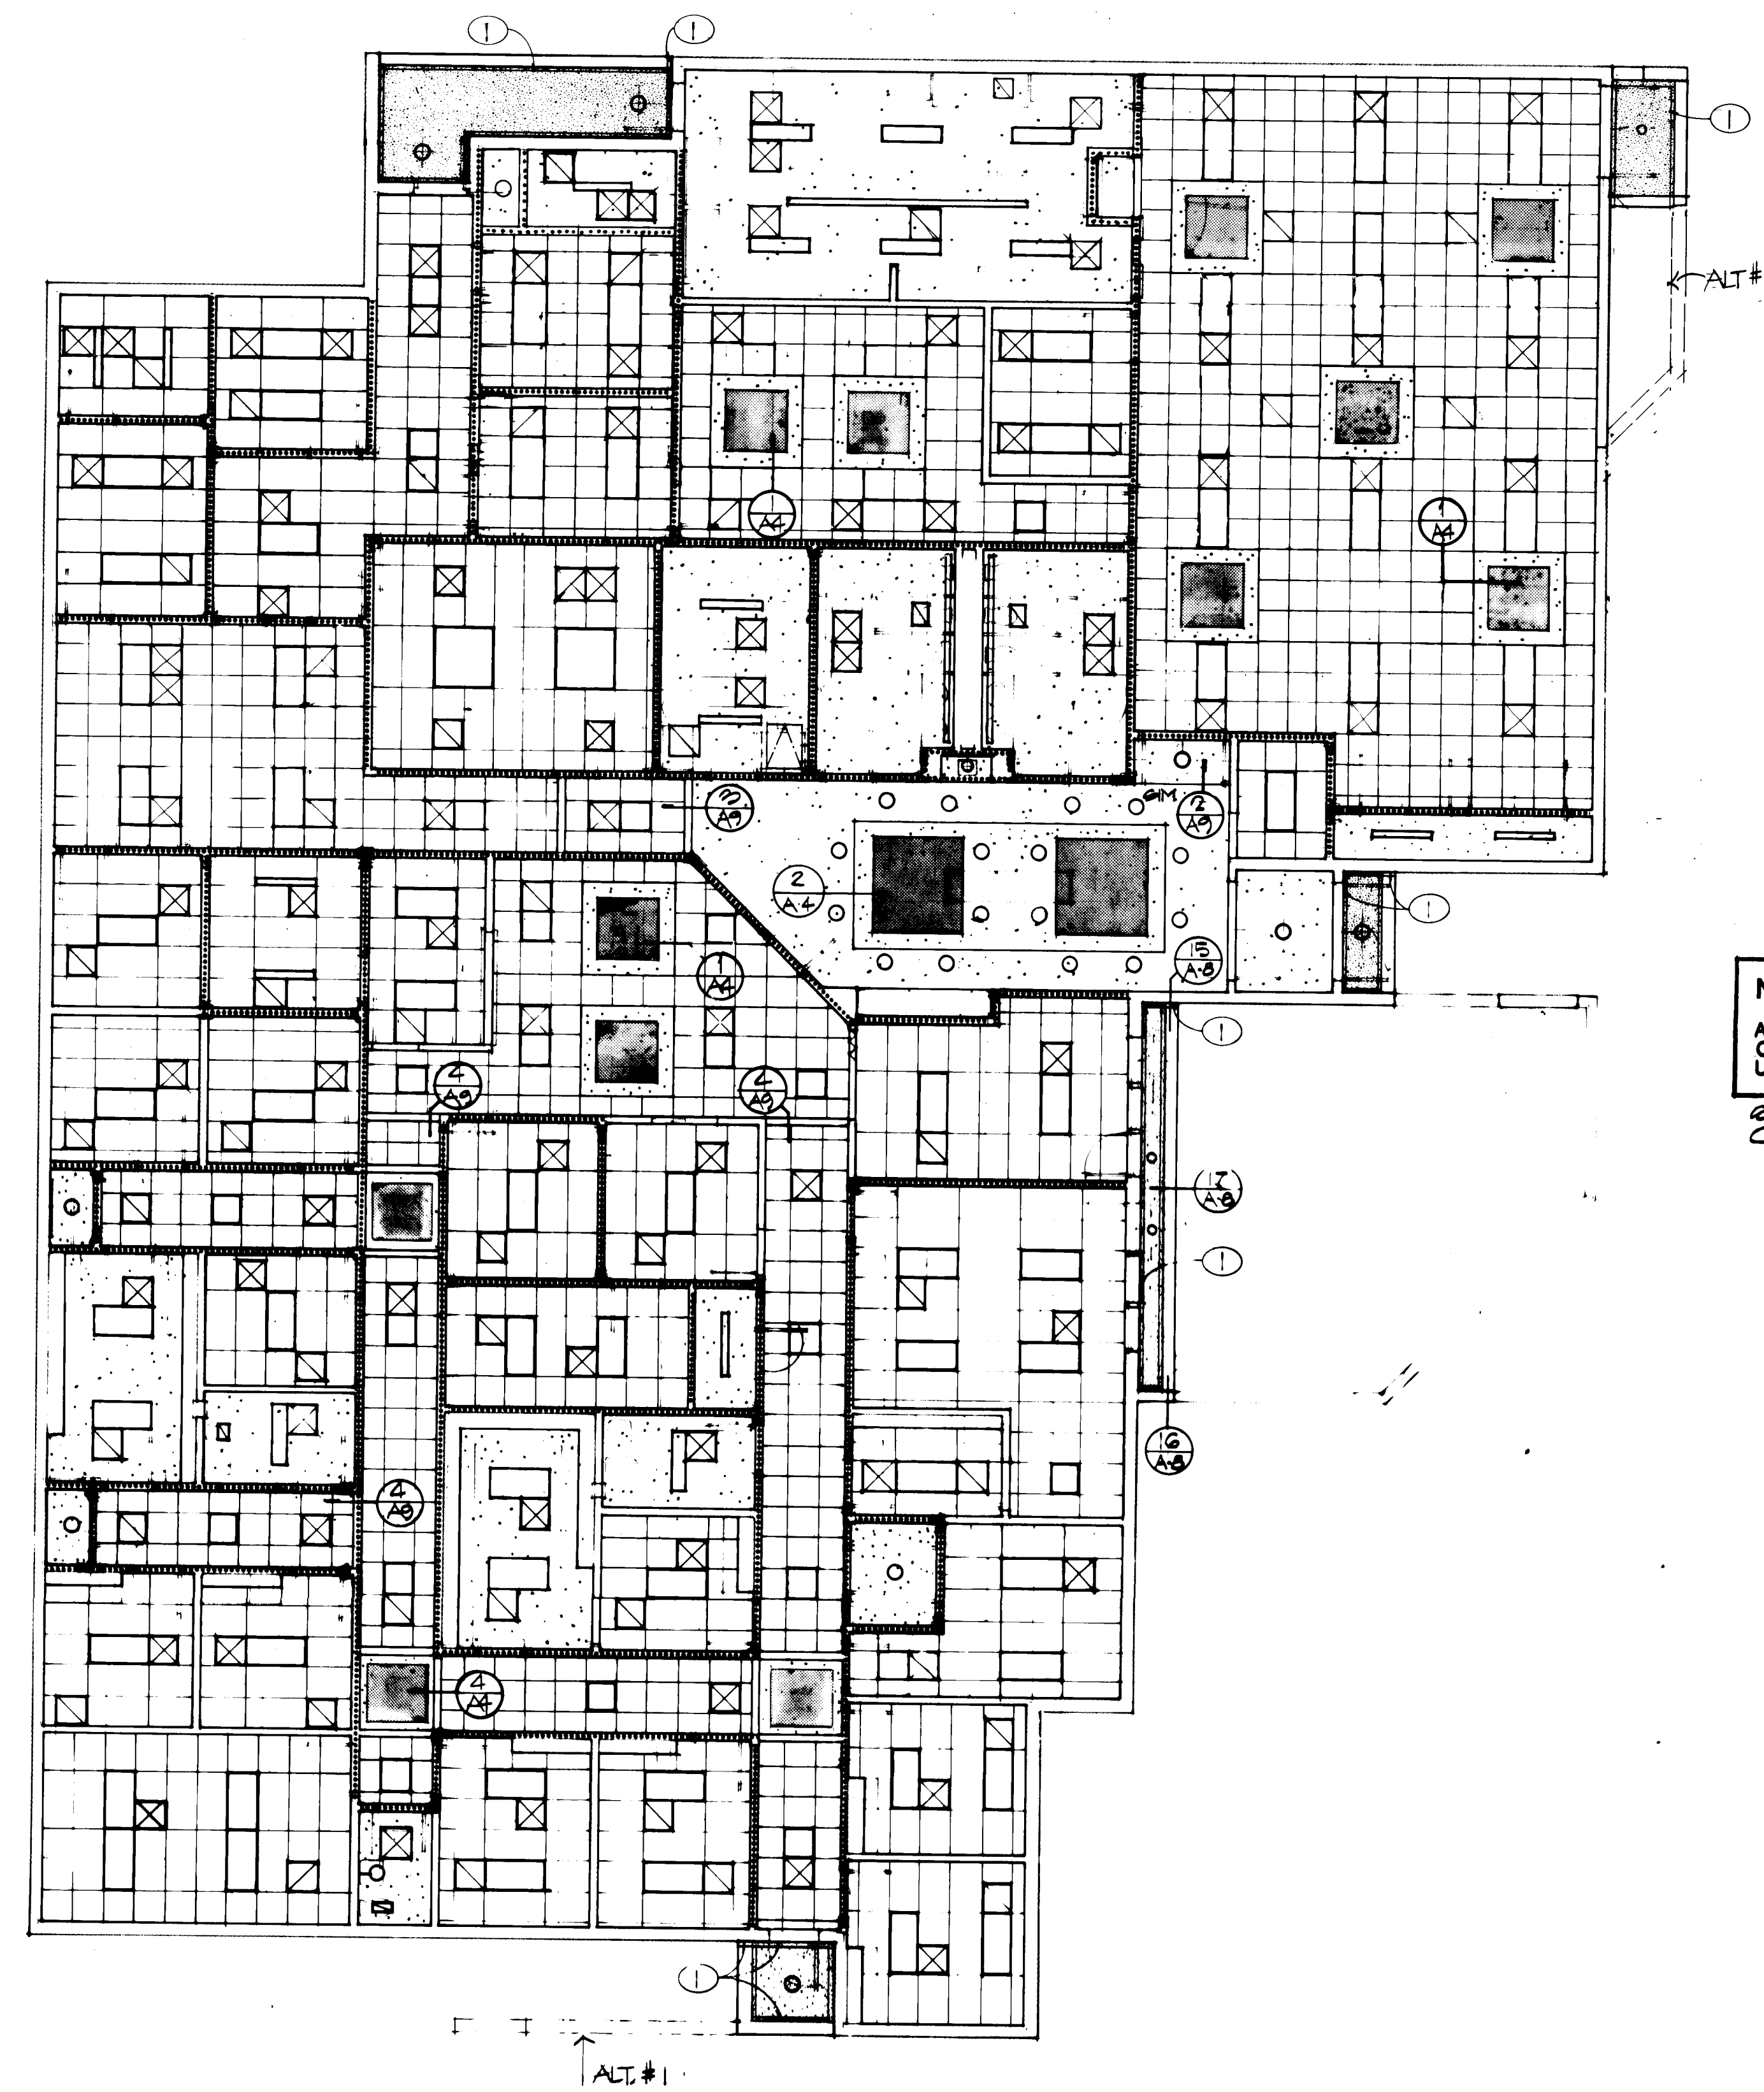

NOTE :
ALL FIXTURES PENETRATING 1 HR.
CEILING ASSEMBLIES SHALL CONFORM TO
UL FIRE RESISTANCE RATING DESIGN NO. P209
SEE SHT A-1 FOR WALL SCHEDULES
CEILING SCHEDULE *

PLAN - REFLECTED CEILING
SCALE: 1/8" = 1'-0"

THE BURNS PETERS GROUP
ARCHITECTS PLANNERS

NOTES

① SCOFFIT REVEAL

1 HR. WALL TO BOTTOM OF ROOF DECK

ROOF SCUTTLE

EXHAUST AIR GRILLE

RETURN AIR GRILLE

SUPPLY AIR DIFFUSER

RECESSED CAN LIGHT

1x4 FLUORESCENT LIGHT FIXTURE

2x2 FLUORESCENT LIGHT FIXTURE

2x4 FLUORESCENT LIGHT FIXTURE

2x2 SUSPENDED CEILING

2x4 SUSPENDED CEILING

SKYLIGHT

GYPSUM BOARD CEILING

CEMENTITIOUS FINISH EXTERIOR ROOFING

BURNS/PETERS GROUP ARCHITECTS

RECORD DRAWING

DATE: 12 SEPT 84

Charles Peters

REVISIONS

ENGINEER

ARCHITECT

THE EAST-CENTRAL MULTI-SERVICE CENTER













PROJECT NO. 8205

DATE: MAR 88

A5

SHEET 22 OF 26

26 1589 2284

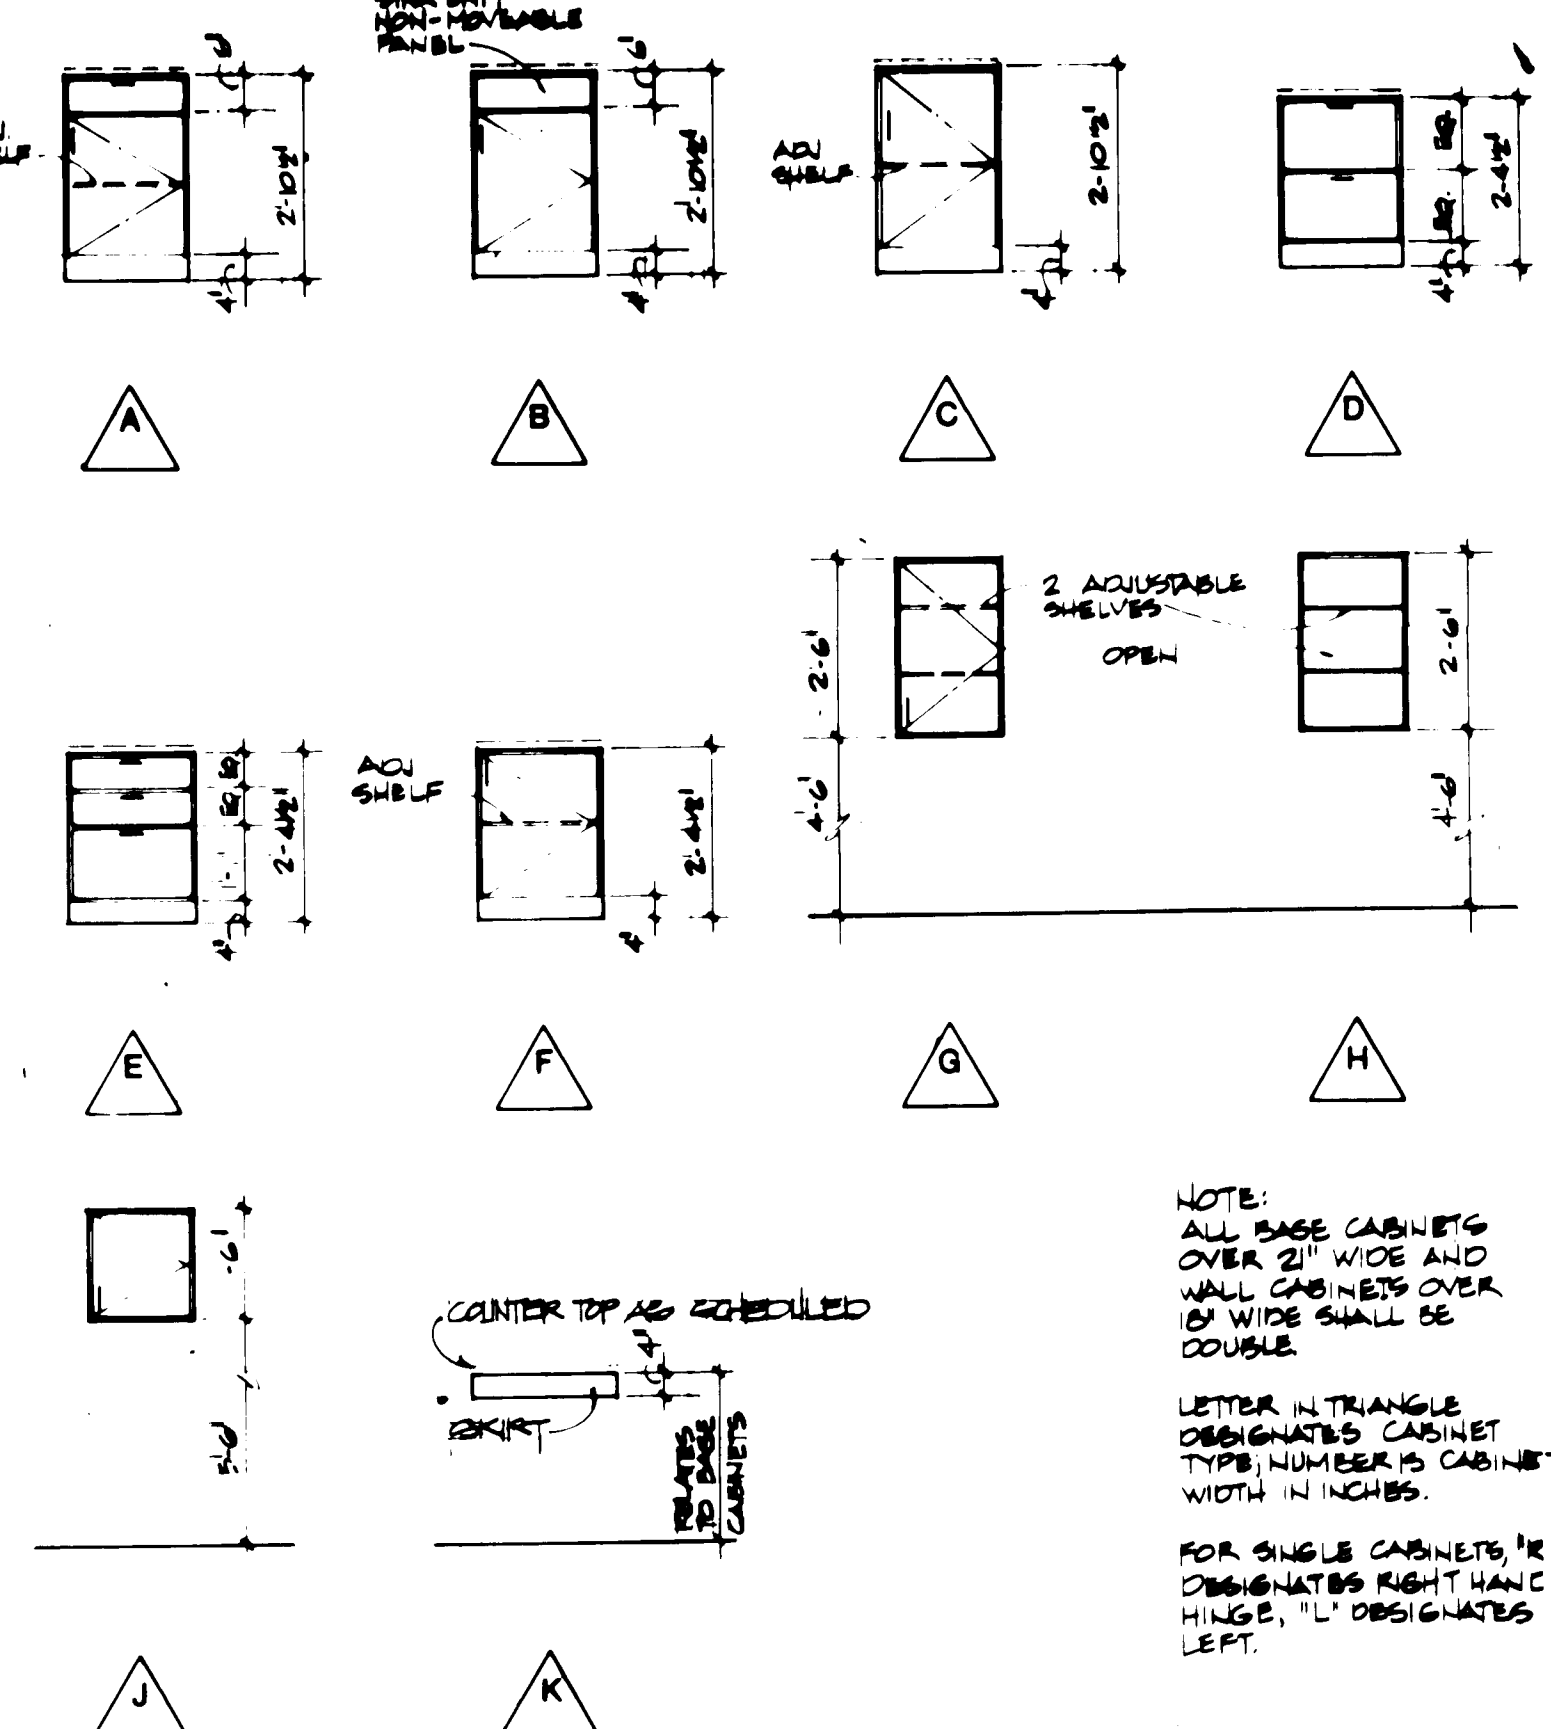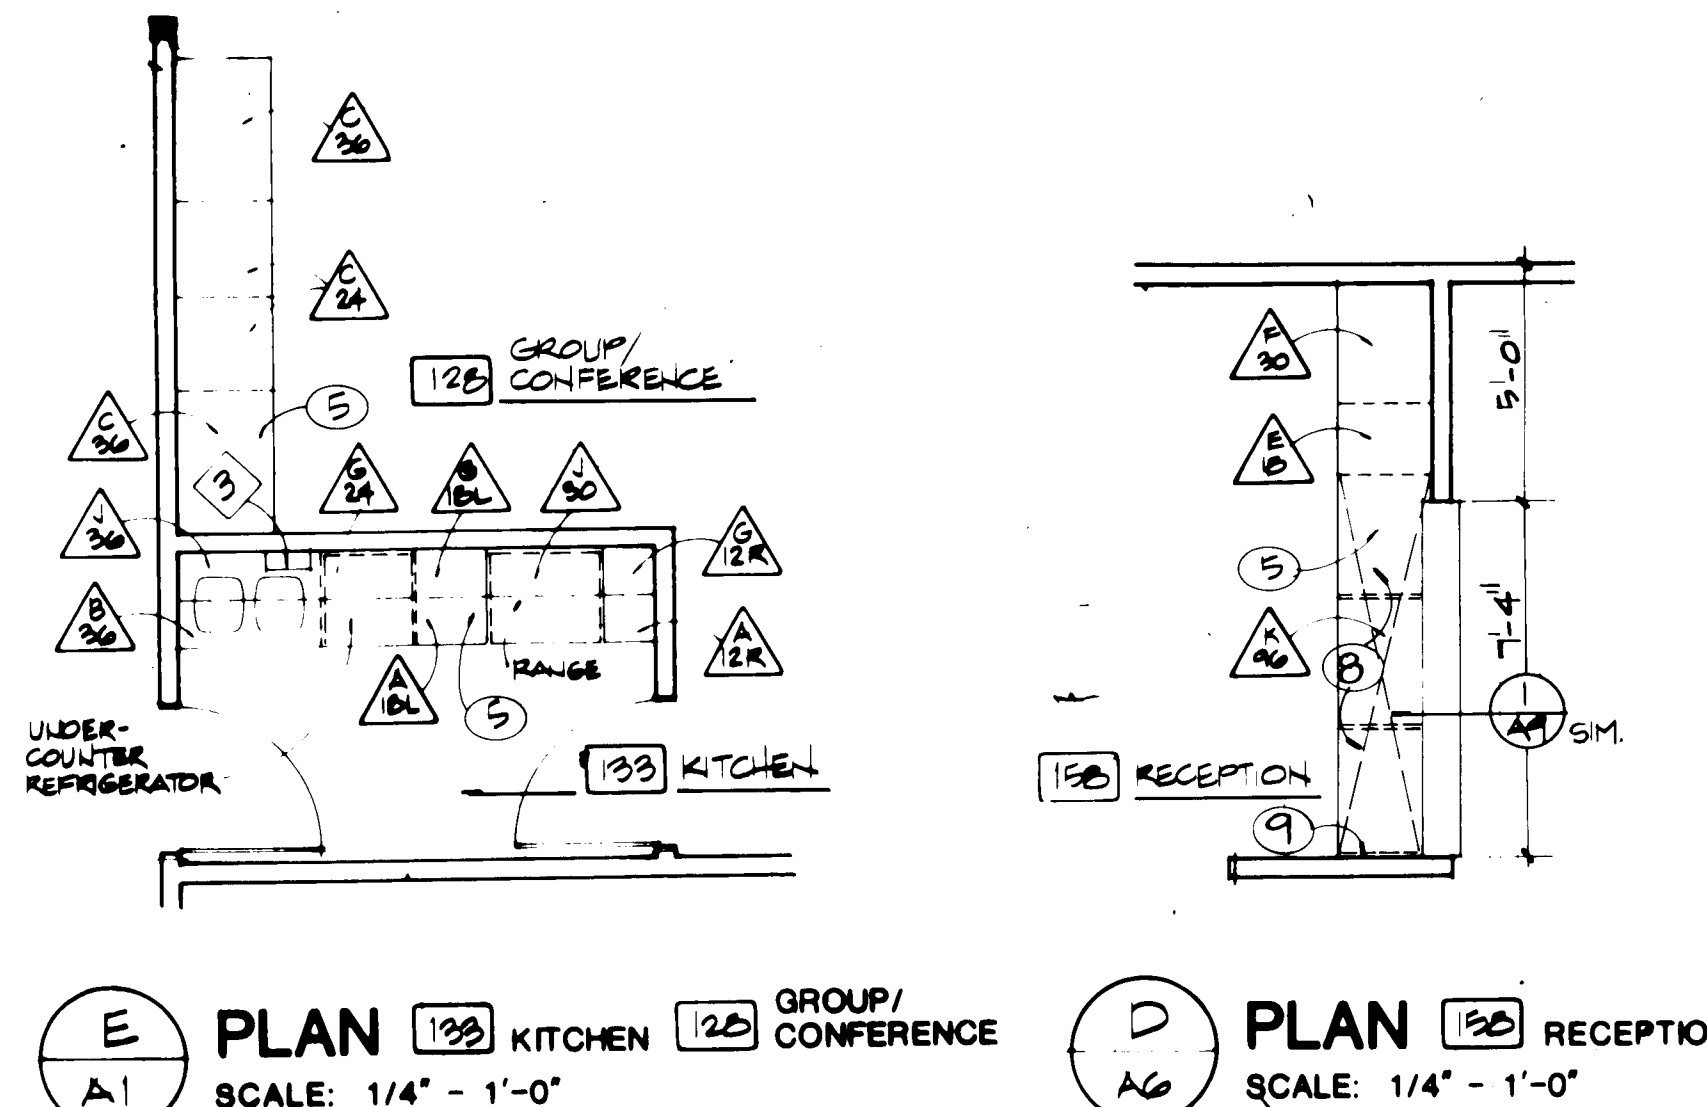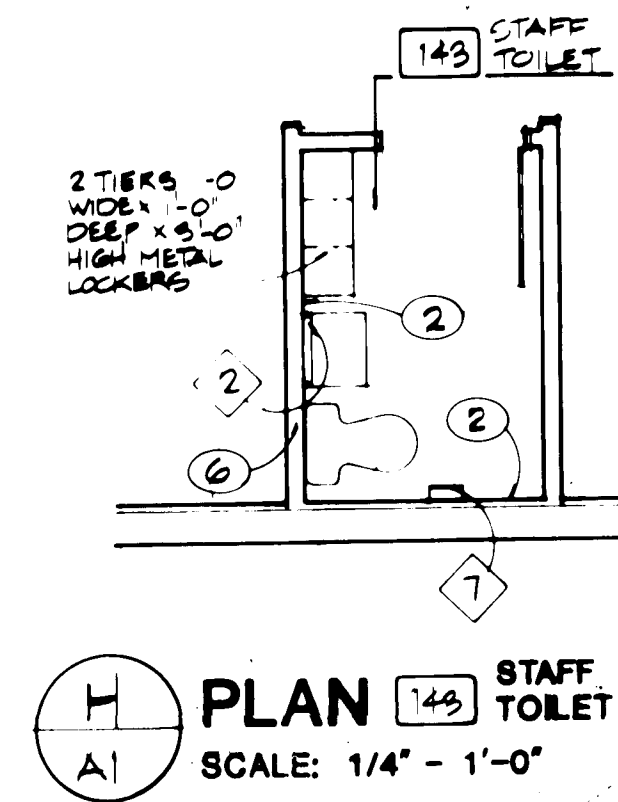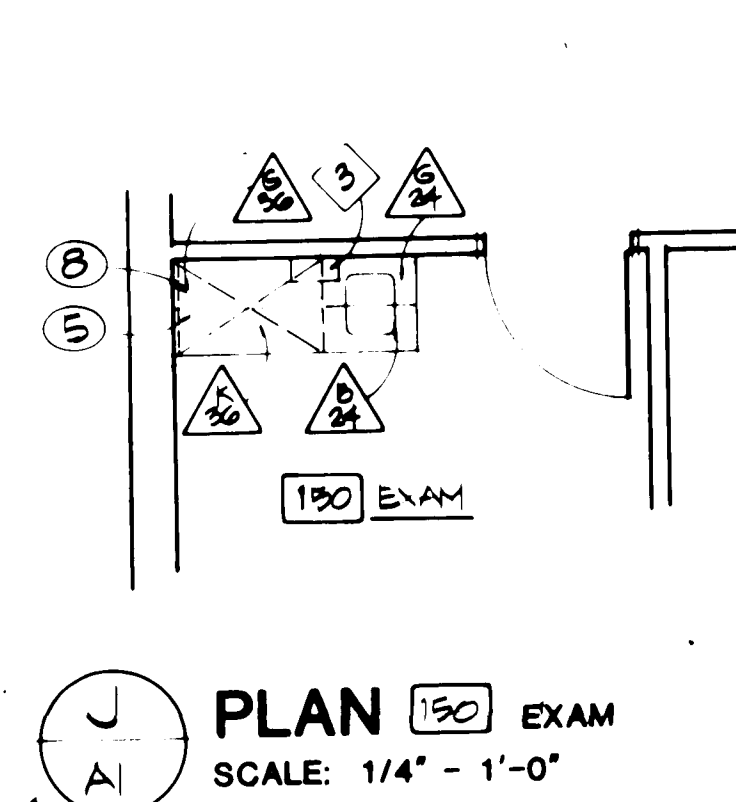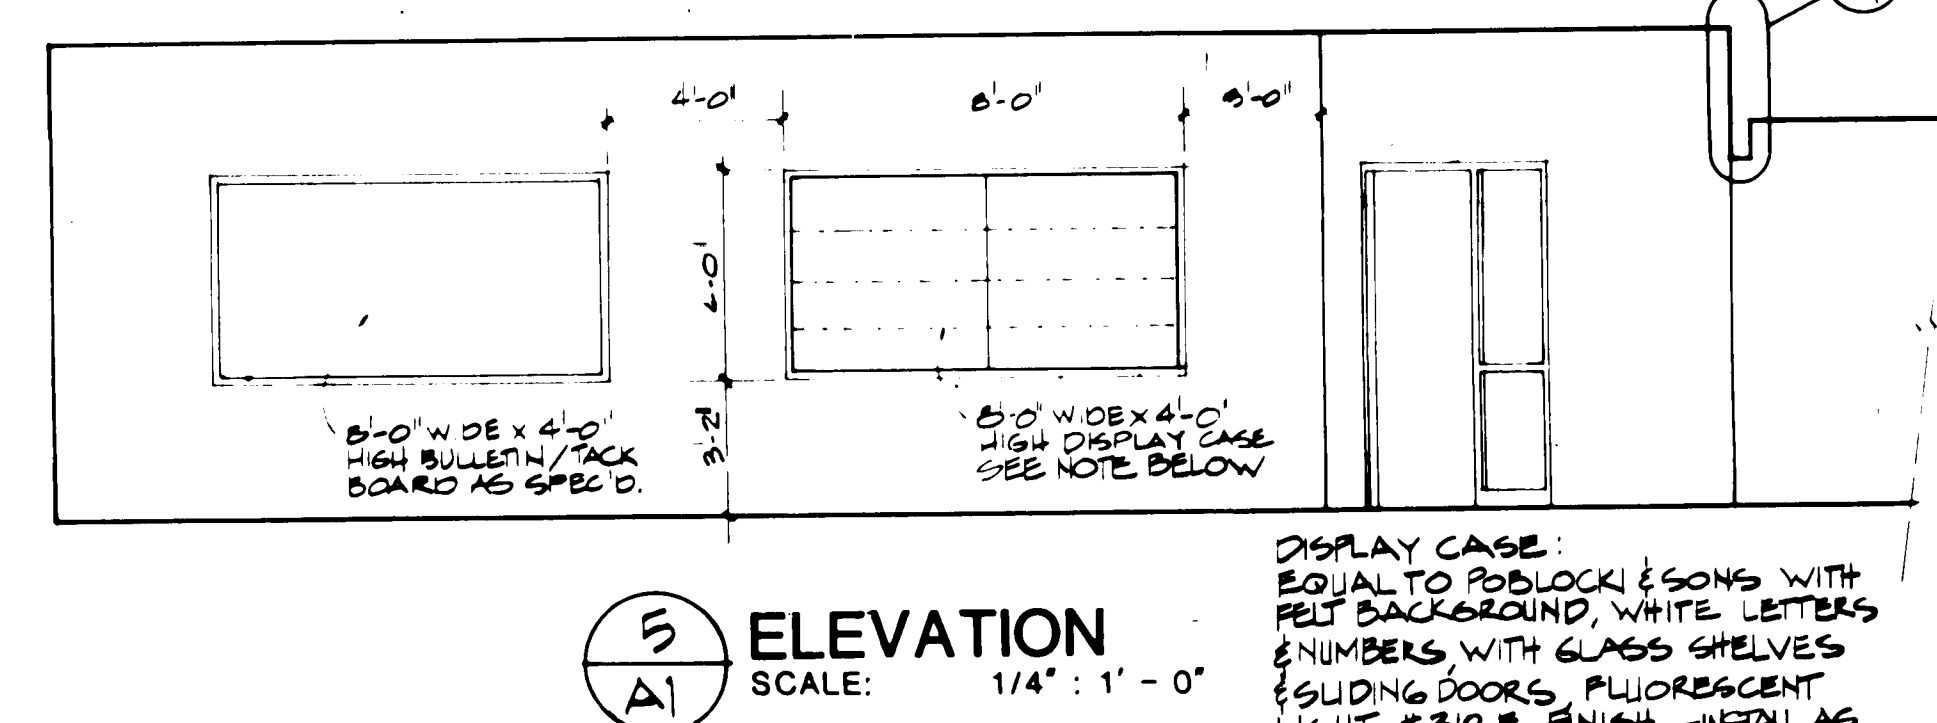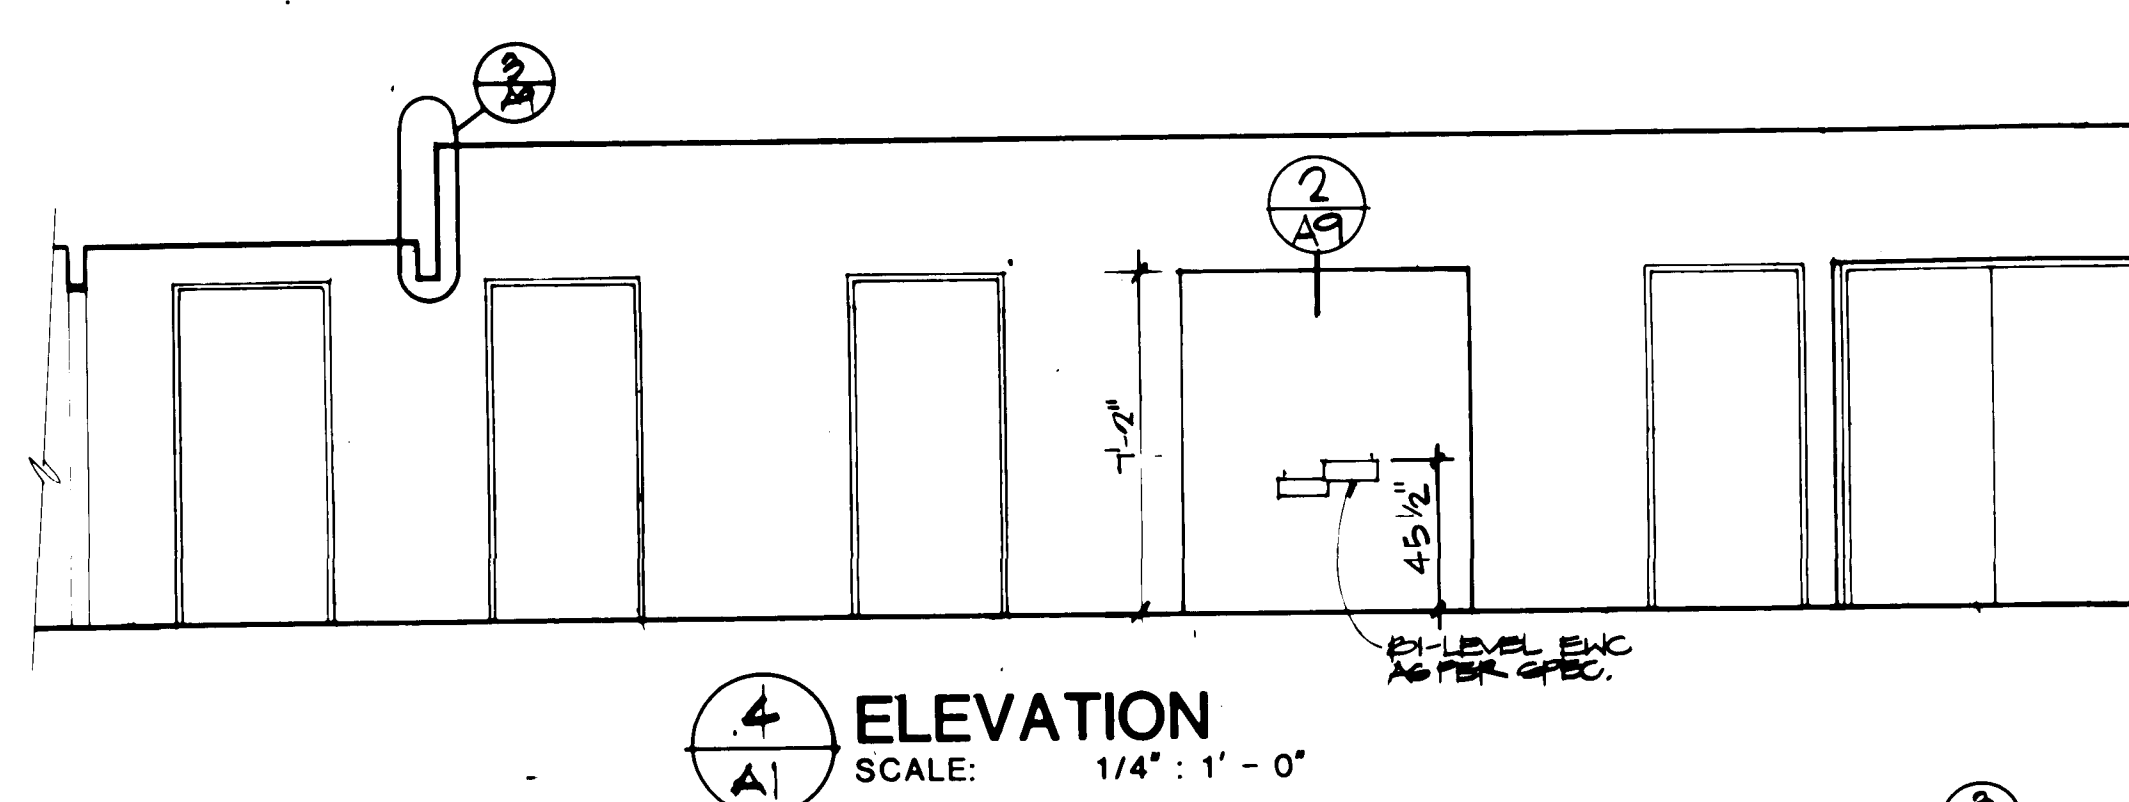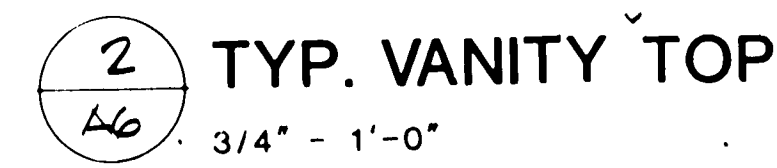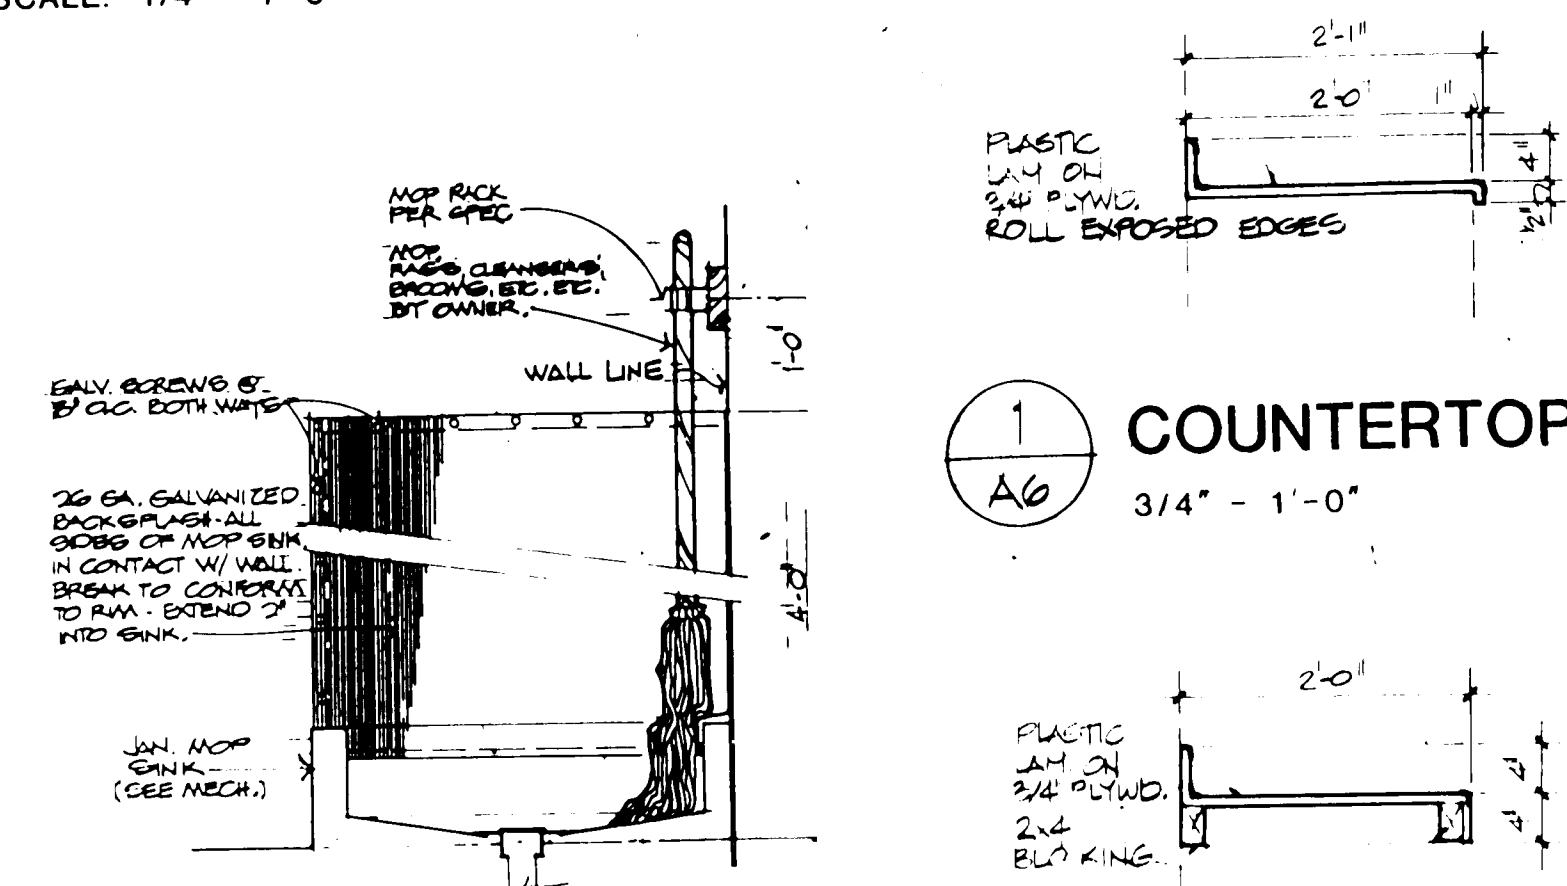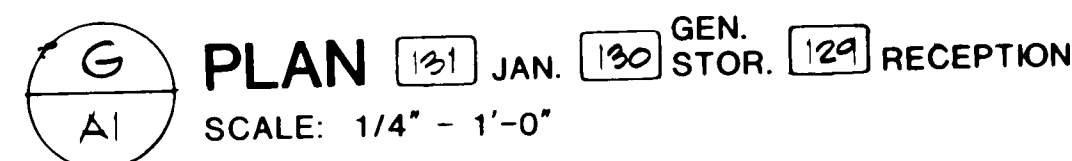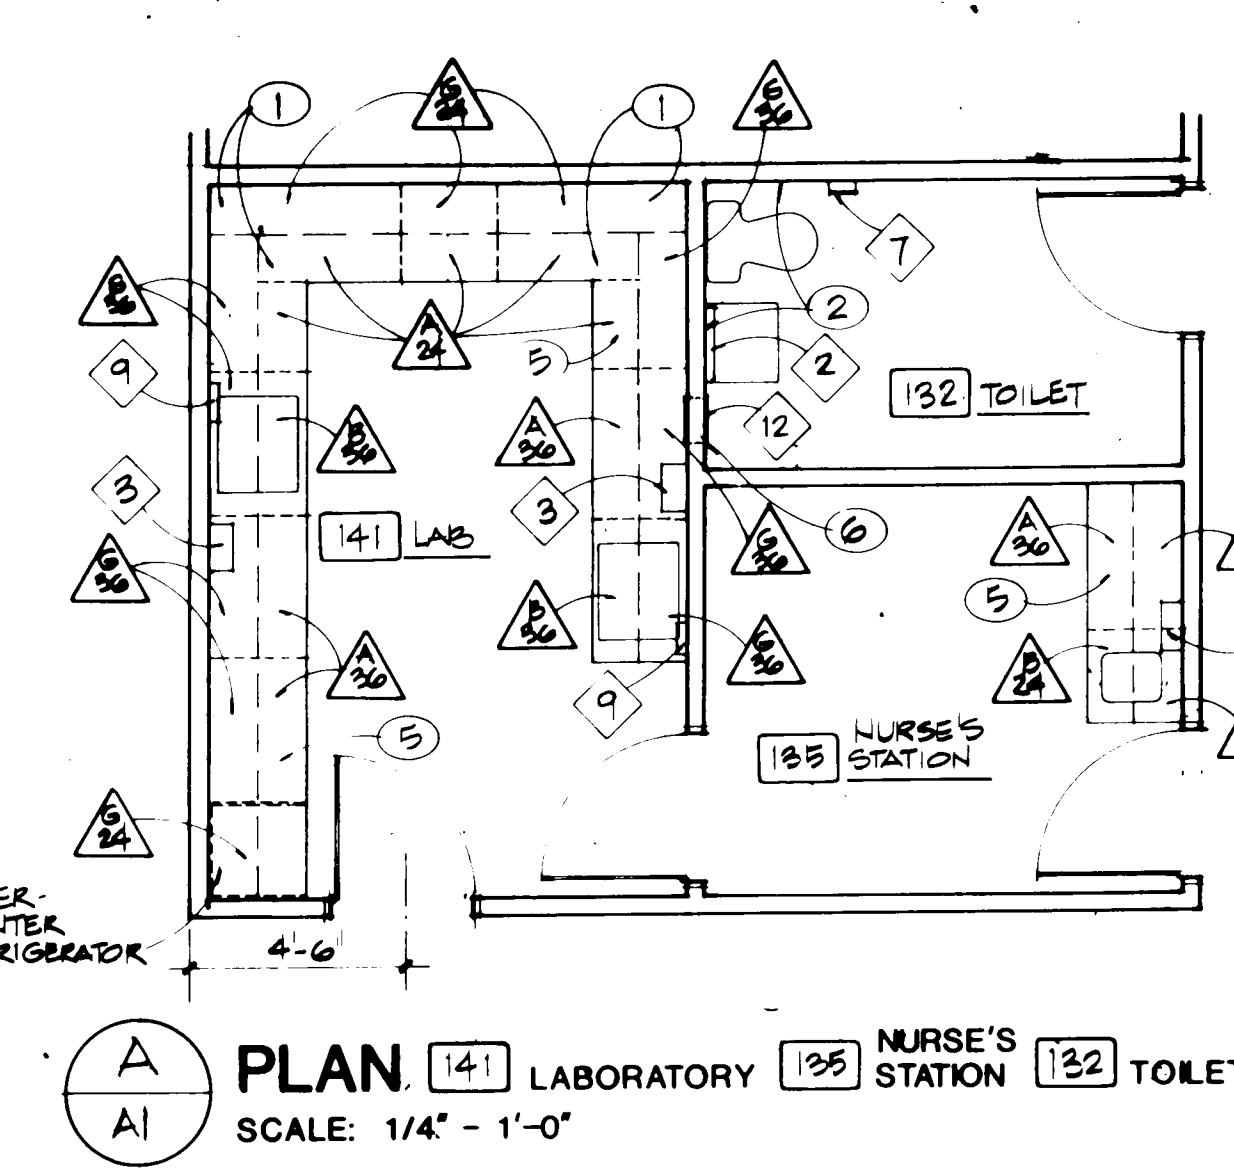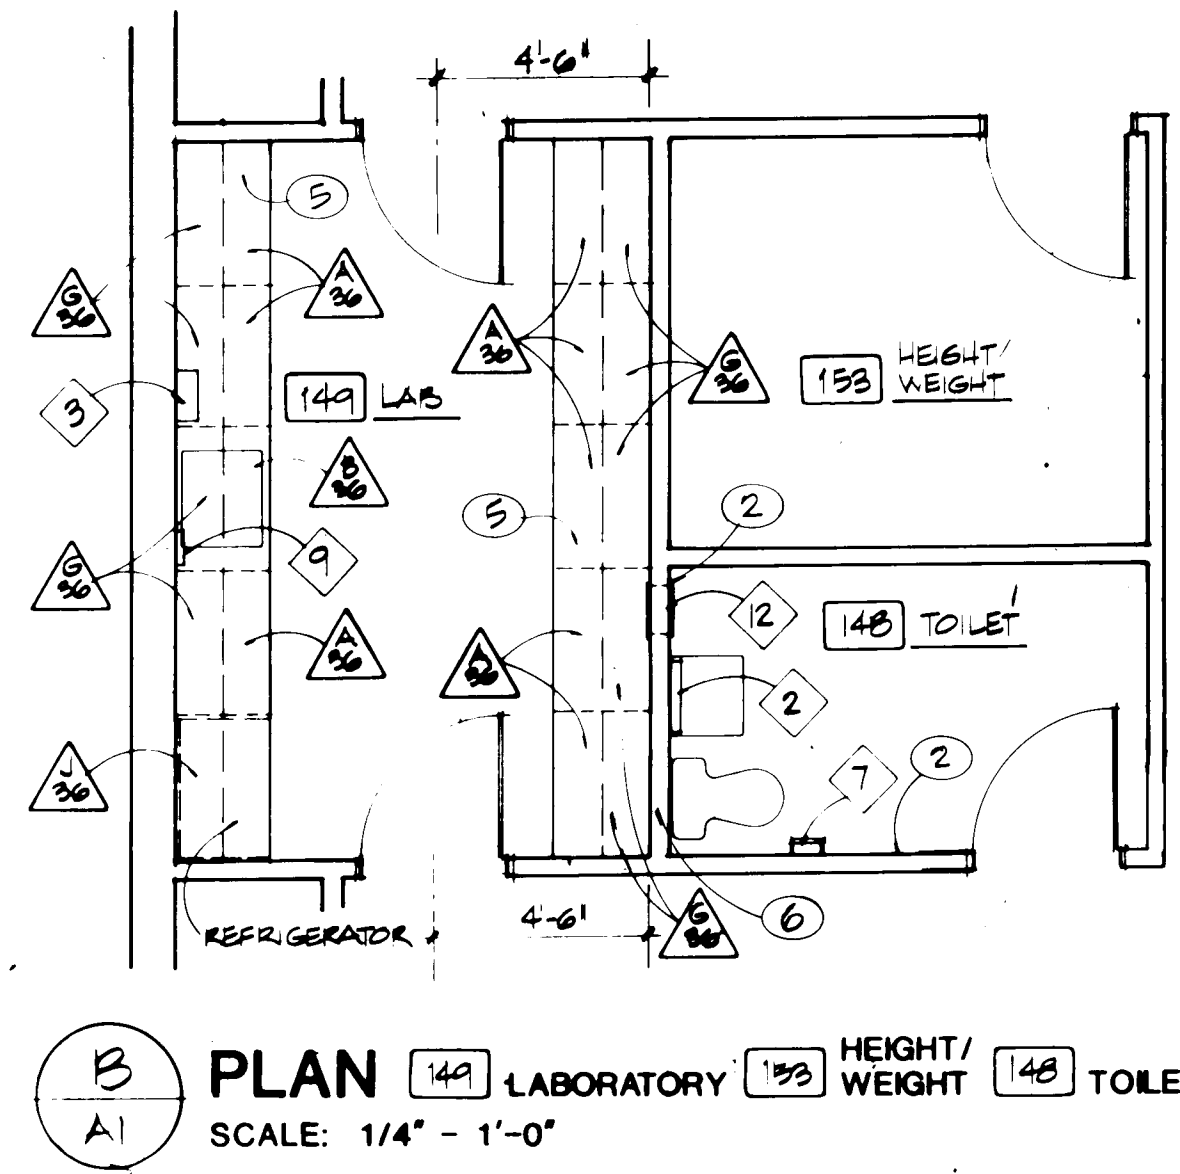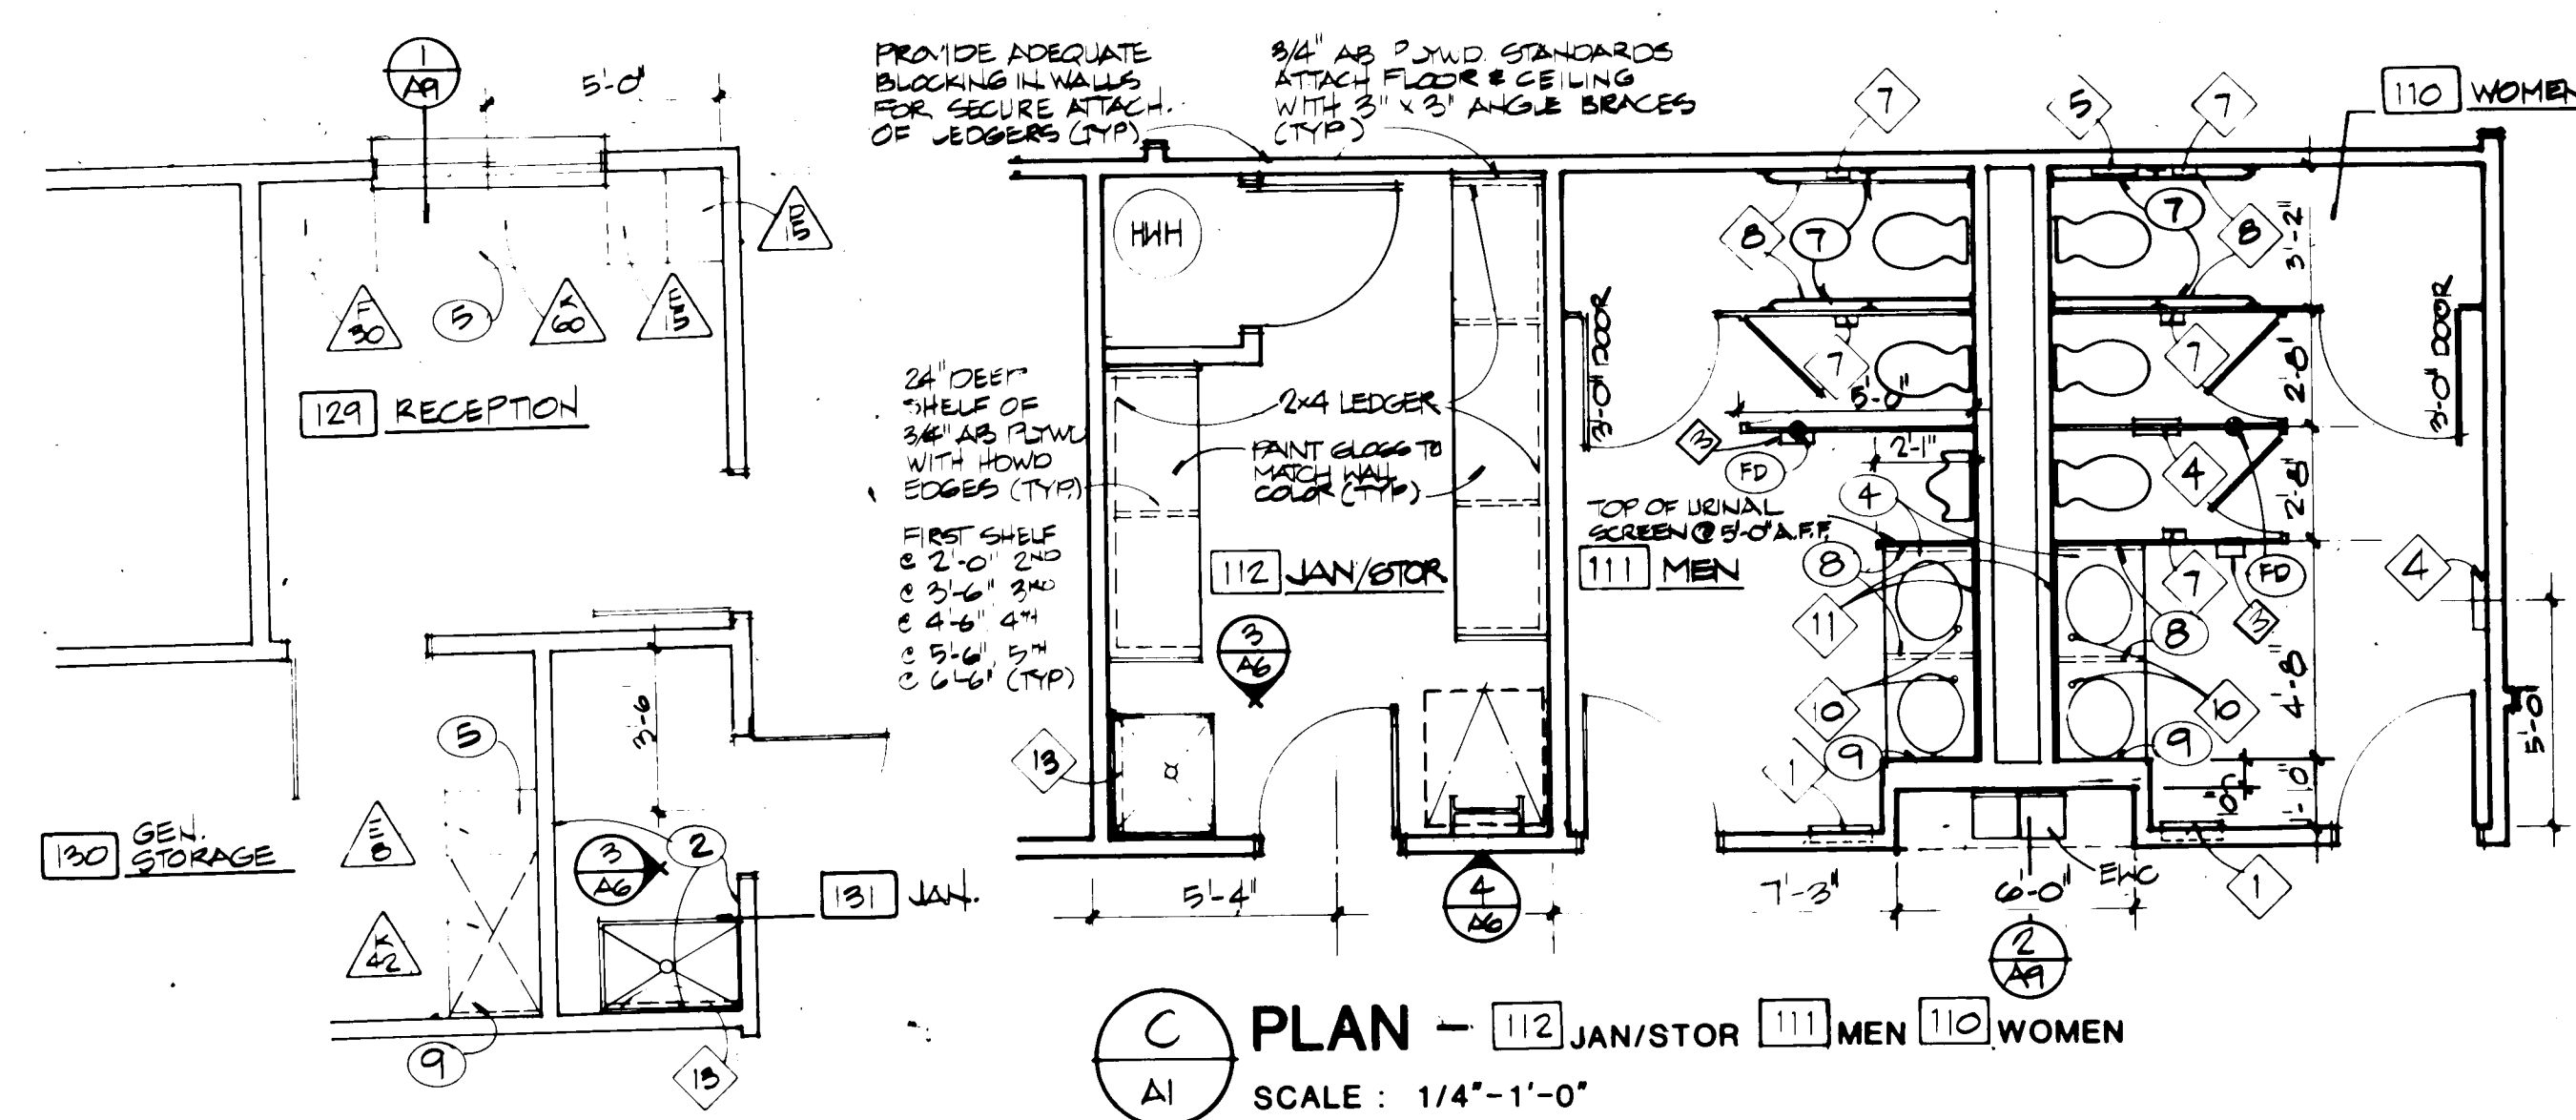

TOILET ACCESSORY SCHEDULE *


- [illegible]

* NOTE: MODEL NUMBERS LISTED ARE "BOBRICK" ACCESSORIES- SEE SPECS FOR OTHER ACCEPTABLE MANUFACTURERS.

NOTE:
ALL BASE CABINETS
OVER 21" WIDE AND
WALL CABINETS OVER
18" WIDE SHALL BE
DOUBLE.

LETTER IN TRIANGLE
DESIGNATES CABINET
TYPE; NUMBER IS CABINET
WIDTH IN INCHES.

FOR SINGLE CABINETS, 'R'
DESIGNATES RIGHT HAND
HINGE, 'L' DESIGNATES
LEFT.

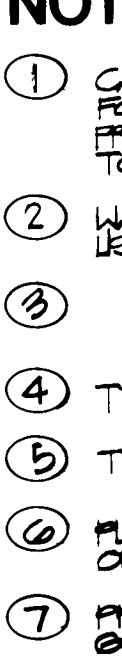

THE BURNS PETERS GROUP
ARCHITECTS PLANNERS

NOTES

- ① CABINET OPENINGS SHOWN ARE FOR EXPOSED SURFACES - THAVE OF CABINET EXTENDED TO CORNER.
- ② WATER RESISTANT GYP BKG TO BE USED ON THIS WALL
- ③
- ④ TYP VANTY TOP - SEE 2/46
- ⑤ TYP COUNTER TOP - SEE 1/46
- ⑥ PLUMBING WALL 1/2" GYP BKG ON 2 MT L STUDS.
- ⑦ PROVIDE BLOCKING AS REQUIRED @ GRADE BRACE
- ⑧ PROVIDE KNEE BRACE @ EQUAL INTERVALS, NUMBER AS SHOWN.
- ⑨ PROVIDE 2x2 LEADER SUPPORT AT WALL

BURNS/PETERS GROUP-ARCHITECTS

RECORD DRAWING

DATE 12 SEPT 84

Revised

REVISIONS



ENGINEER

ARCHITECT


THE EAST-CENTRAL MULTI-SERVICE CENTER

PROJECT NO. 6206


DATE MAY 83.

A6

SHEET 122 OF 26

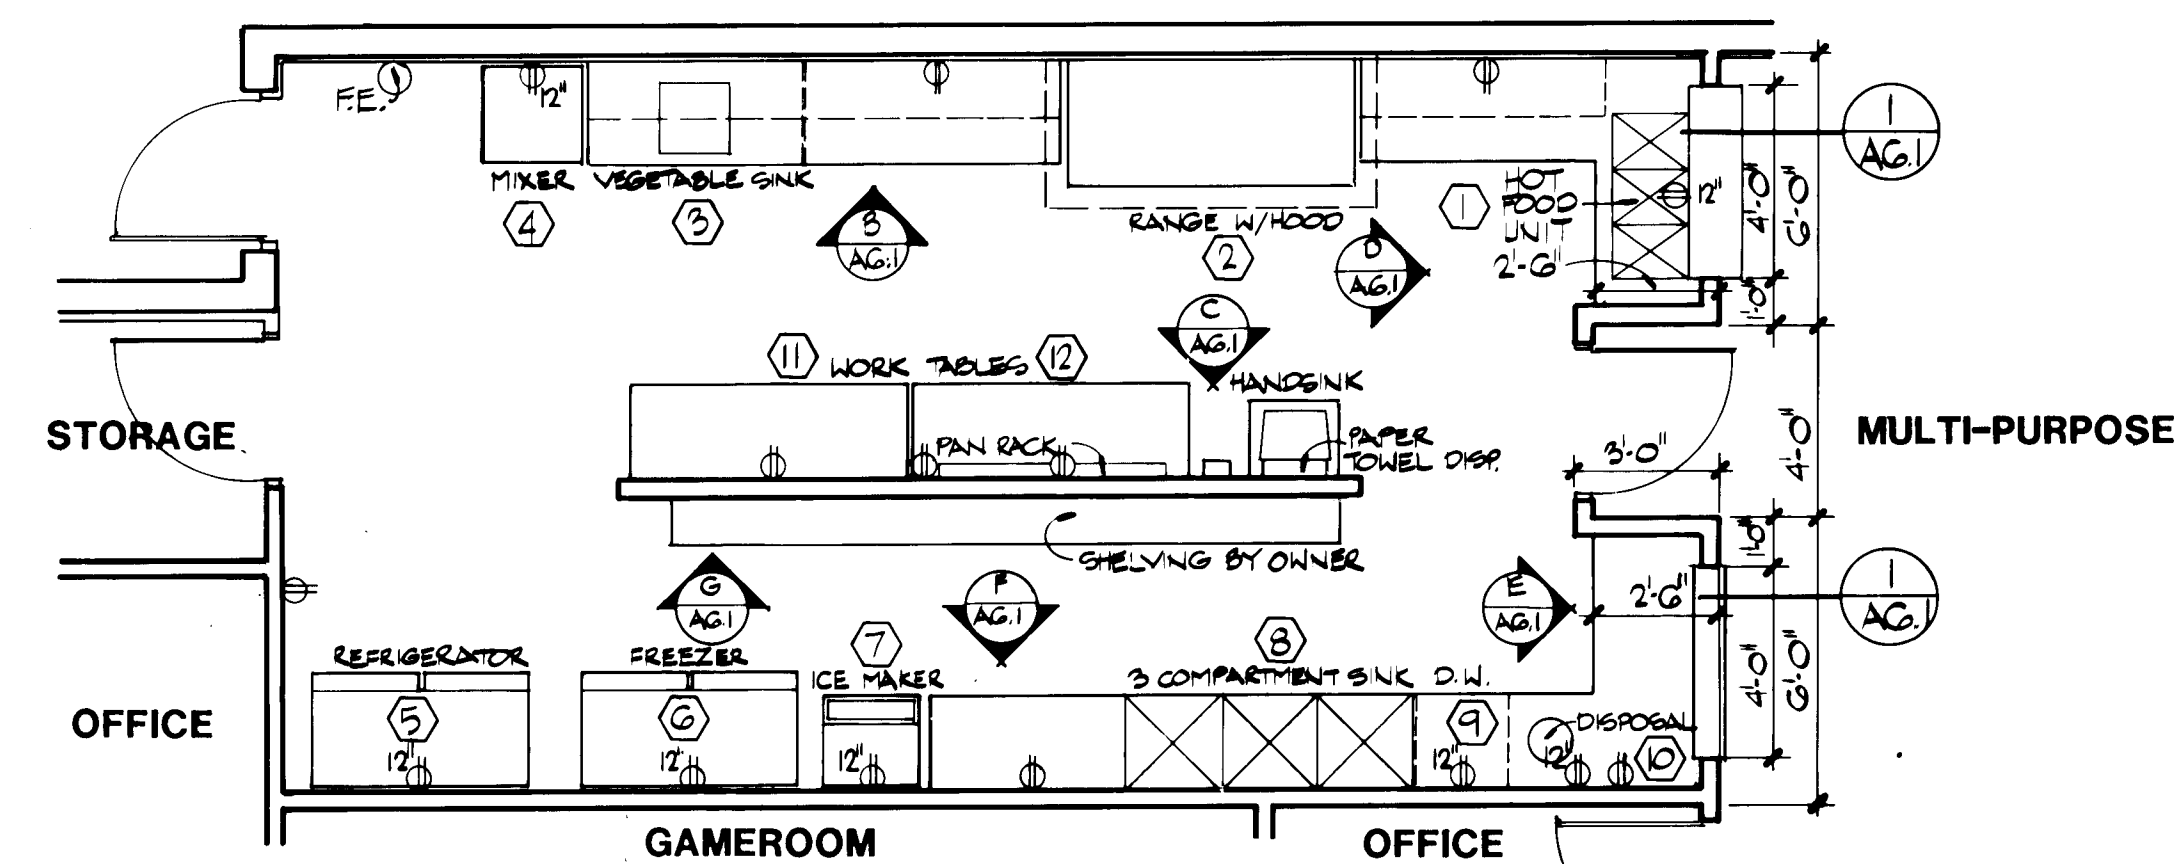


ELECTRICAL OUTLETS - NOTE:
OUTLETS ARE AT 48" ABOVE FINISHED FLOOR UNLESS OTHERWISE NOTED.
OUTLETS ARE SHOWN FOR REFERENCE ONLY SEE ELECTRICAL PLANS FOR CIRCUITS AND POWER REQUIREMENTS.

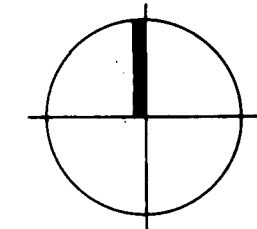


KITCHEN PLAN
SCALE: 1/4" = 1' - 0"

NO.	DESCRIPTION
1	HOT FOOD DROP N. (ELECTRIC) DUKE MANUF. CO.
2	RESTAURANT GAS RANGE DOUBLE OVEN U.S. RANGE CO. PF 12-2428A
3	STAINLESS STEEL ONE COMPARTMENT VEGETABLE SINK WITH 18" DRAIN BOARDS BOTH SIDES
4	20 QUART BENCH MODEL MIXER HOBART MODEL A-200
5	47.8 CUBIC FOOT TWO SECTION REFRIGERATOR HOBART MODEL HU-2
6	47.0 CUBIC FOOT FREEZER
7	AUTOMATIC ICE CUBE MAKER 90-7516 CAPACITY MANITOWOC
8	STAINLESS STEEL THREE (3) COMPARTMENT SINK DUKE MANUF. CO. DRAIN BOARD ONE SIDE ONLY (SEE PLAN)
9	DISHWASHER HOBART MODEL WMP-5-2
10	DISPOSAL IN SINK ERATOR TYPE B' BOWL ASSEMBLY MODEL SS-150
11	STAINLESS STEEL WORKTABLE 72" X 30" X 34" H. NO UNDERSHELF
12	STAINLESS STEEL WORKTABLE 72" X 30" X 34" H. WITH UNDERSHELF AND DRAWER AND PAN RACK (UNATTACHED)


NOTE: ALL EQUIPMENT IN THE ABOVE LIST WILL BE PROVIDED BY OWNER. SCHEDULE IS FOR REFERENCE ONLY.

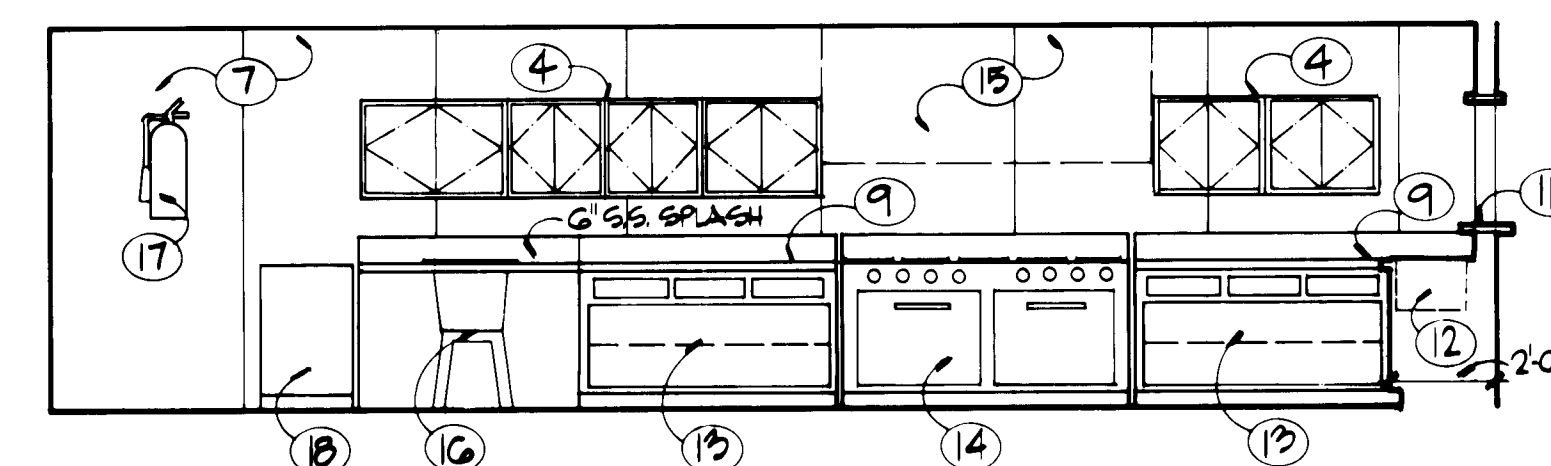


ELEVATION B
SCALE: 1/4" = 1' - 0"

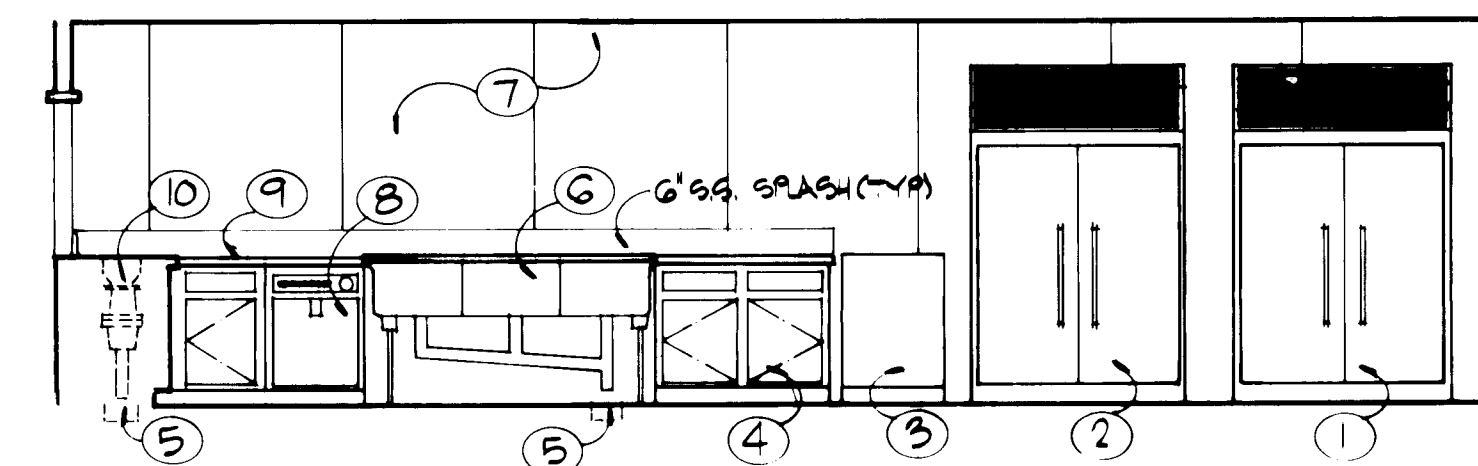


ELEVATION F
SCALE: 1/4" = 1' - 0"

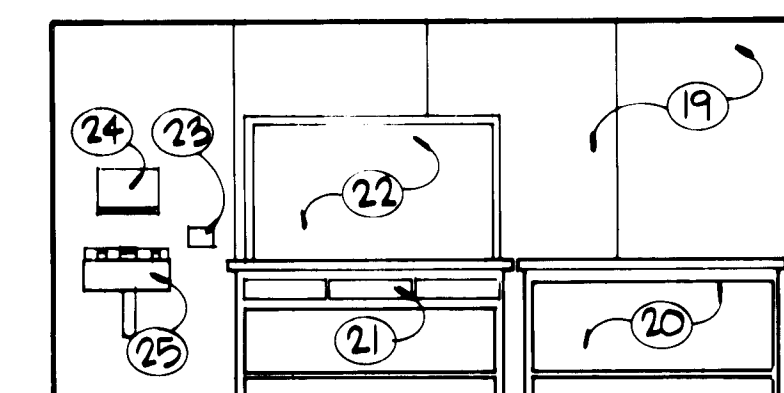


ELEVATION C
SCALE: 1/4" = 1' - 0"

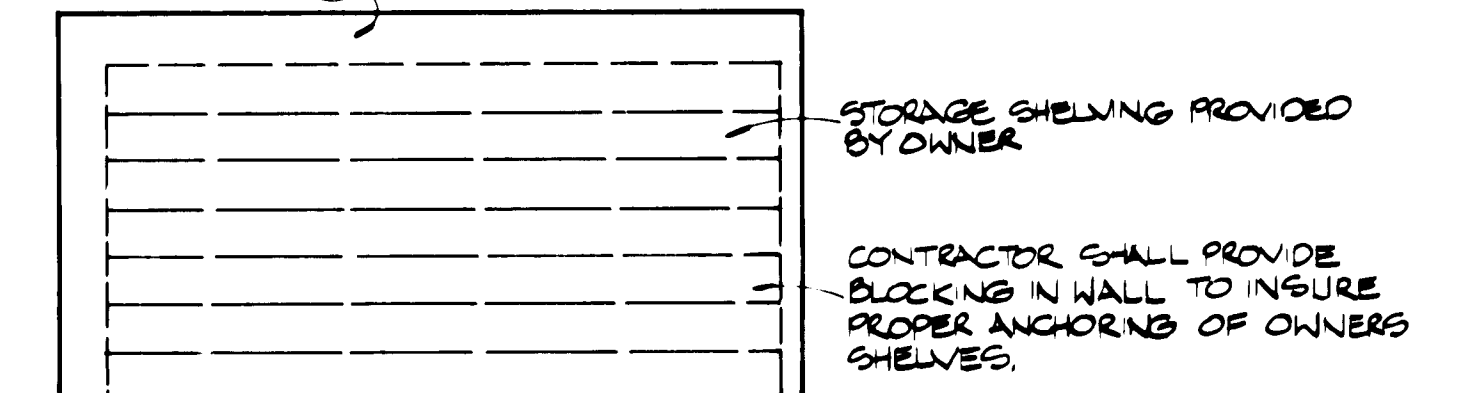


ELEVATION G
SCALE: 1/4" = 1' - 0"

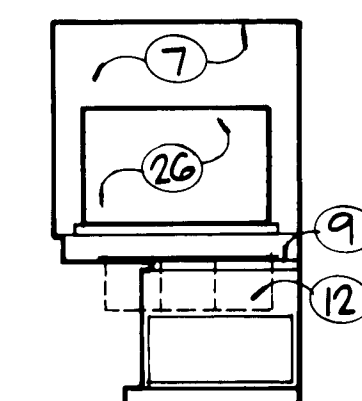

ELEVATION D
SCALE: 1/4" = 1' - 0"

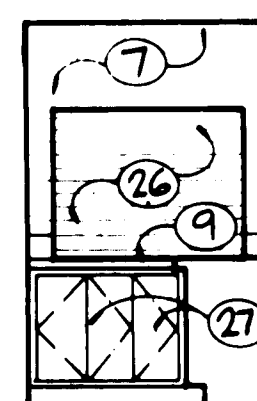

ELEVATION E
SCALE: 1/4" = 1' - 0"

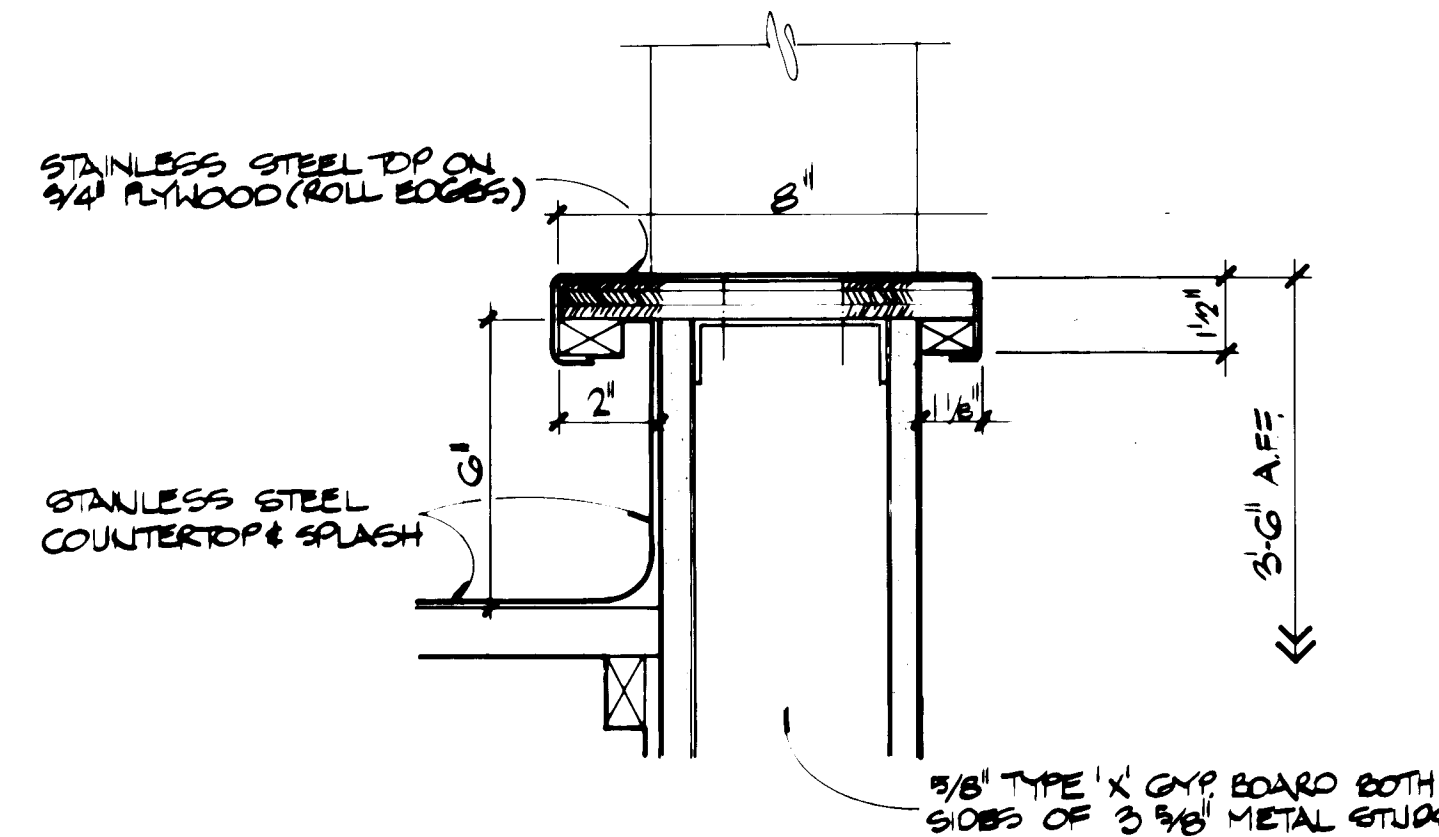

DETAIL I
SCALE: 3" = 1' - 0"

GENERAL NOTE:
CONTRACTOR IS RESPONSIBLE FOR THE FINAL HOOKUP AND INSTALLATION OF OWNER PROVIDED EQUIPMENT.

- NOTES**
1. REFRIGERATOR SEE EQUIPMENT SCHED
 2. FREEZER SEE EQUIPMENT SCHED
 3. ICE MAKER SEE EQUIPMENT SCHED
 4. CABINETS
 5. FLOOR DRAIN
 6. 3 COMPARTMENT SINK SEE EQUIP. SCHED
 7. WATER RESISTANT GYP BOARD
 8. DISHWASHER SEE EQUIPMENT SCHED
 9. STAINLESS STEEL COUNTERTOP/SPLASH
 10. DISPOSAL SEE EQUIPMENT SCHED
 11. STAINLESS STEEL PASS-THRU
 12. HOT FOOD UNIT SEE EQUIP. SCHED
 13. SHELVING
 14. RANGE SEE EQUIPMENT SCHED
 15. RANGE HOOD SEE MECHANICAL
 16. VEGETABLE SINK SEE EQUIP. SCHED
 17. FIRE EXTINGUISHER
 18. MIXER SEE EQUIPMENT SCHED
 19. MASONITE OR EQUAL
 20. WORKTABLE - NO DRAWERS (BY OWNER)
 21. WORKTABLE - WITH DRAWERS (BY OWNER)
 22. PAN RACK SEE EQUIPMENT SCHED
 23. SOAP DISPENSER
 24. PAPER TOWEL DISPENSER
 25. HANDSINK
 26. ROLLING COUNTER DOOR
 27. LOCKING CASE CABINETS

BURNS/PETERS GROUP ARCHITECTS
RECORD DRAWING
DATE: 12 SEPT 84
R. L. BURNS

REVISIONS

ENGINEER


ARCHITECT

THE EAST-CENTRAL MULTI-SERVICE CENTER



PROJECT NO. 8203 DATE MAY '88

A6.1
SHEET 24 OF 26

26.1589 2484

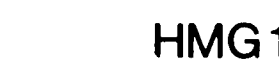

DOOR TYPES
SCALE: 1/4" = 1'-0"

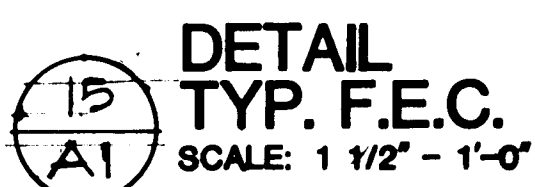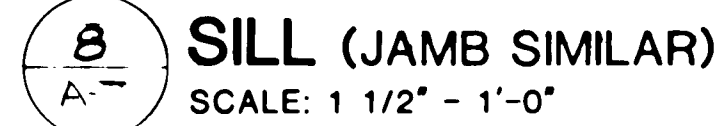

DOOR SCHEDULE														
DR. NO.	DOOR							FRAME		FRAME DETAILS			REMARKS	
	SIZE			MATL	TYPE	HW	RTG	GLASS	MATL	TYPE	HEAD/JAMB/SILL			
	W	H	T								HEAD	JAMB		SILL
1	3'-0"	7'-0"	1 3/4"	HM	HWG	1	1	1/4" WIRE	HM	E	3/A-T	7/A-T	4/A-T	'MULTI-PURPOSE'
2	3'-0"	7'-0"	1 3/4"	HM	HWG	1	1	1/4" WIRE	HM	E	3/A-T	7/A-T	4/A-T	
3	3'-0"	7'-0"	1 3/4"	SCND	FL	1	1		HM	A	6/A-T	13/A-T		
4	3'-0"	7'-0"	1 3/4"	SCND	FL	1	1		HM	A	6/A-T	13/A-T		
5	3'-0"	7'-0"	1 3/4"	SCND	FL	1	1		HM	A	6/A-T	13/A-T		
6	3'-0"	7'-0"	1 3/4"	HM	FL	1	1	1/4" WIRE	HM	E	3/A-T	7/A-T	4/A-T	
7	3'-0"	7'-0"	1 3/4"	SCND	FV	1	1		HM	A	6/A-T	13/A-T		
8	3'-0"	7'-0"	1 3/4"	HM	FL	1	1	1/4" WIRE	HM	E	3/A-T	7/A-T	4/A-T	
9	3'-0"	7'-0"	1 3/4"	SCND	FL	1	1		HM	A	6/A-T	13/A-T		
10	3'-0"	7'-0"	1 3/4"	SCND	FL	1	1		HM	A	6/A-T	13/A-T		
11	3'-0"	7'-0"	1 3/4"	SCND	FL	1	1		HM	A	6/A-T	13/A-T		'WOMEN'
12	3'-0"	7'-0"	1 3/4"	SCND	FL	1	1		HM	A	6/A-T	13/A-T		
13	3'-0"	7'-0"	1 3/4"	SCND	FL	1	1		HM	A	6/A-T	13/A-T		
14	3'-0"	7'-0"	1 3/4"	SCND	FL	1	1		HM	A	6/A-T	13/A-T		
15	3'-0"	7'-0"	1 3/4"	SCND	FL	1	1		HM	A	6/A-T	13/A-T		
16	3'-0"	7'-0"	1 3/4"	SCND	FL	1	1		HM	A	6/A-T	13/A-T		
17	3'-0"	7'-0"	1 3/4"	SCND	FL	1	1		HM	A	6/A-T	13/A-T		
18	3'-0"	7'-0"	1 3/4"	SCND	FL	1	1		HM	A	6/A-T	13/A-T		
19	3'-0"	7'-0"	1 3/4"	SCND	FL	1	1		HM	A	6/A-T	13/A-T		
20	3'-0"	7'-0"	1 3/4"	SCND	FL	1	1		HM	A	6/A-T	13/A-T		
21	3'-0"	7'-0"	1 3/4"	SCND	FL	1	1		HM	A	6/A-T	13/A-T		'MEN'
22	3'-0"	7'-0"	1 3/4"	SCND	FL	1	1		HM	A	6/A-T	13/A-T		
23	3'-0"	7'-0"	1 3/4"	SCND	FL	1	1		HM	A	6/A-T	13/A-T		
24	3'-0"	7'-0"	1 3/4"	SCND	FL	1	1		HM	A	6/A-T	13/A-T		
25	3'-0"	7'-0"	1 3/4"	SCND	FL	1	1		HM	A	6/A-T	13/A-T		
26	3'-0"	7'-0"	1 3/4"	SCND	FL	1	1		HM	A	6/A-T	13/A-T		
57	3'-0"	7'-0"	1 3/4"	SCND	FL	1	1		HM	A	6/A-T	13/A-T		
58	3'-0"	7'-0"	1 3/4"	SCND	FL	1	1		HM	A	6/A-T	13/A-T		
59	3'-0"	7'-0"	1 3/4"	SCND	FL	1	1		HM	A	6/A-T	13/A-T		
60	3'-0"	7'-0"	1 3/4"	SCND	FL	1	1		HM	A	6/A-T	13/A-T		
61	3'-0"	7'-0"	1 3/4"	SCND	FL	1	1		HM	A	6/A-T	13/A-T		'DEADEND LOCK'
62	3'-0"	7'-0"	1 3/4"	SCND	FL	1	1		HM	A	6/A-T	13/A-T		
63	3'-0"	7'-0"	1 3/4"	HM	HWG	1	1	1/4" WIRE	HM	F	3/A-T	7/A-T	4/A-T	
64	3'-0"	7'-0"	1 3/4"	WOOD	FL	1	1		HM	D	2/A-T			
65	3'-0"	7'-0"	1 3/4"	HM	HWG	1	1	1/4" WIRE	HM	F	3/A-T	7/A-T	4/A-T	
66	3'-0"	7'-0"	1 3/4"	HM		1	1		HM	A	6/A-T	13/A-T		
67	3'-0"	7'-0"	1 3/4"	HM		1	1		HM	A	6/A-T	13/A-T		
68	3'-0"	7'-0"	1 3/4"	HM		1	1		HM	A	6/A-T	13/A-T		
69	3'-0"	7'-0"	1 3/4"	HM		1	1		HM	A	6/A-T	13/A-T		
70	3'-0"	7'-0"	1 3/4"	HM		1	1		HM	A	6/A-T	13/A-T		

* SIGNAGE & ACCENT COLOR AS PER SPEC

THE BURNS/PETERS GROUP
ARCHITECTS PLANNERS

NOTES

- (1) 9" SPLIT - FACE BLOCK
- (2) 6" CERAMIC FACED ON 4" AS SPEC.
- (3) CHALKLINE
- (4) 4" MTFL FRAME - GROUT SOLID
- (5) INSULATION @ 1" PD. SYSTEM
- (6) 3/8" STP BD - PAINT AS SPEC.
- (7) 1/8" WIRE GLASS
- (8) SYNTHETIC PLASTER FINISH ON 3/4" EXTERIOR TYPE GYP SD
- (9) REVEAL - PAINT AS SPEC.
- (10) DOOR AS SCHEDULED
- (11) 1" FUITEED BLOCK - GRAN AS SPEC.
- (12) CEILING AS SCHEDULED.
- (13) INTERIOR FINISH AS SCHEDULED - A-1
- (14) 9" EXT. WALL - ALT 1" 1/2" CONC. & BRK BD AT 1" G/L
- (15) 1" CHAMFER IF ALT END
- (16) 2" HOLLOW MTFL FRAME - GROUT MLL.
- (17) TREATED AND BURNED AS REQD. FOR SOILING TRUCK ACCESSAGE
- (18)
- (19)
- (20) 3/8" METAL STUDS
- (21)
- (22) 2" HOLLOW METAL FRAME AS SPEC.
- (23)
- (24) 1/2" 1/4" GALT G/LT. BARS, WELDED TO NUTS OF OPENINGS. ALL WELDS @ 1/8" REINFORCATED TO BE FINISHED GALT. M. PAINTED & PAINTED PER SPEC.
- (25) NEOPRENE GUTLINE GASKET W/ GUTLINE LOCKING TO GUTFL.
- (26) TRAC - @ PLASTER CHANNEL PER SPEC.
- (27) FOLDING DOOR AS SPEC.
- (28) HOSPITAL CURTAIN AS SPEC.
- (29) HARDWARE BY MFR.
- (30) DOUBLE METAL STUD - TYP.
- (31) 8" FL. CD. - SEE STRUCT.

BURNS/PETERS GROUP-ARCHITECTS

RECORD DRAWING

DATE: 12 SEPT 84

REVISIONS









ENGINEER

THE EAST-CENTRAL MULTI-SERVICE CENTER

PROJECT NO. BOCE

DATE MAY 1 1988

A7
SHEET 25 OF 36

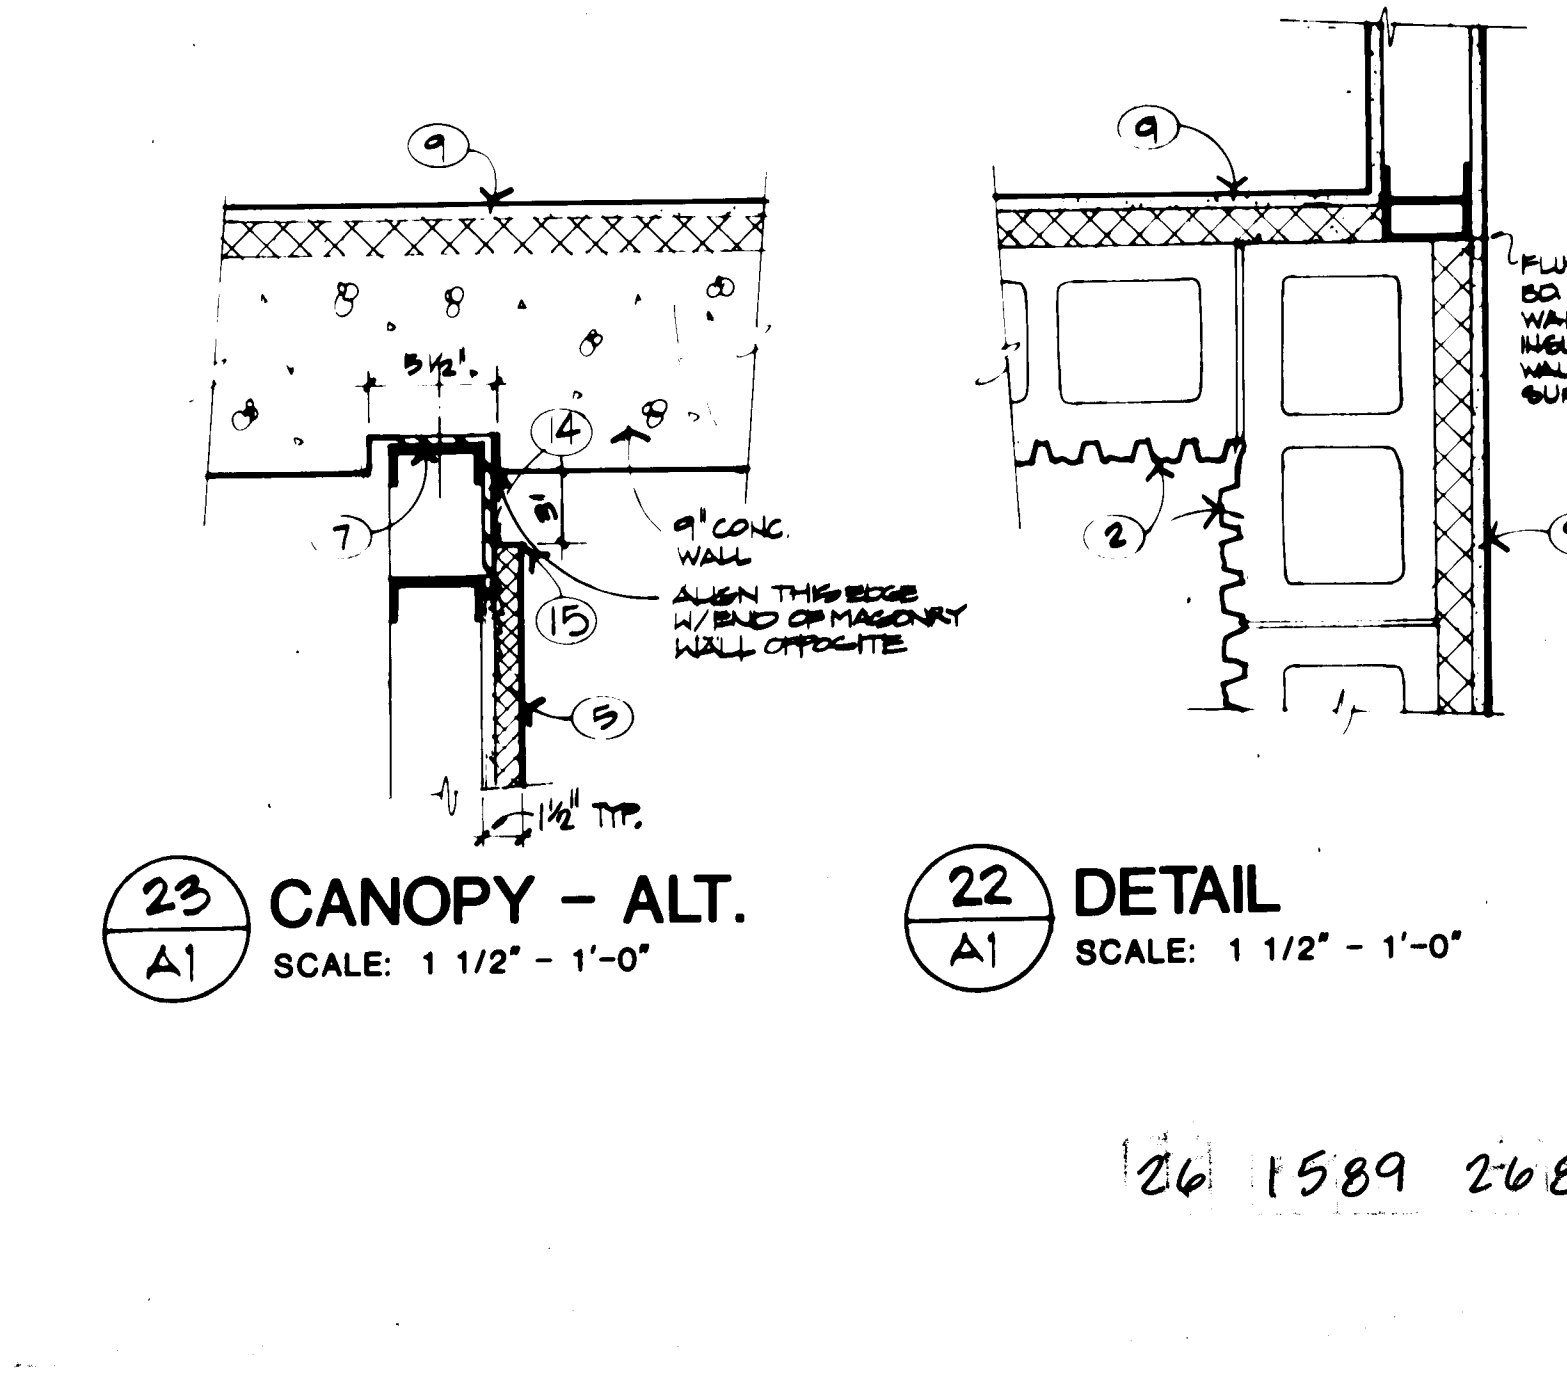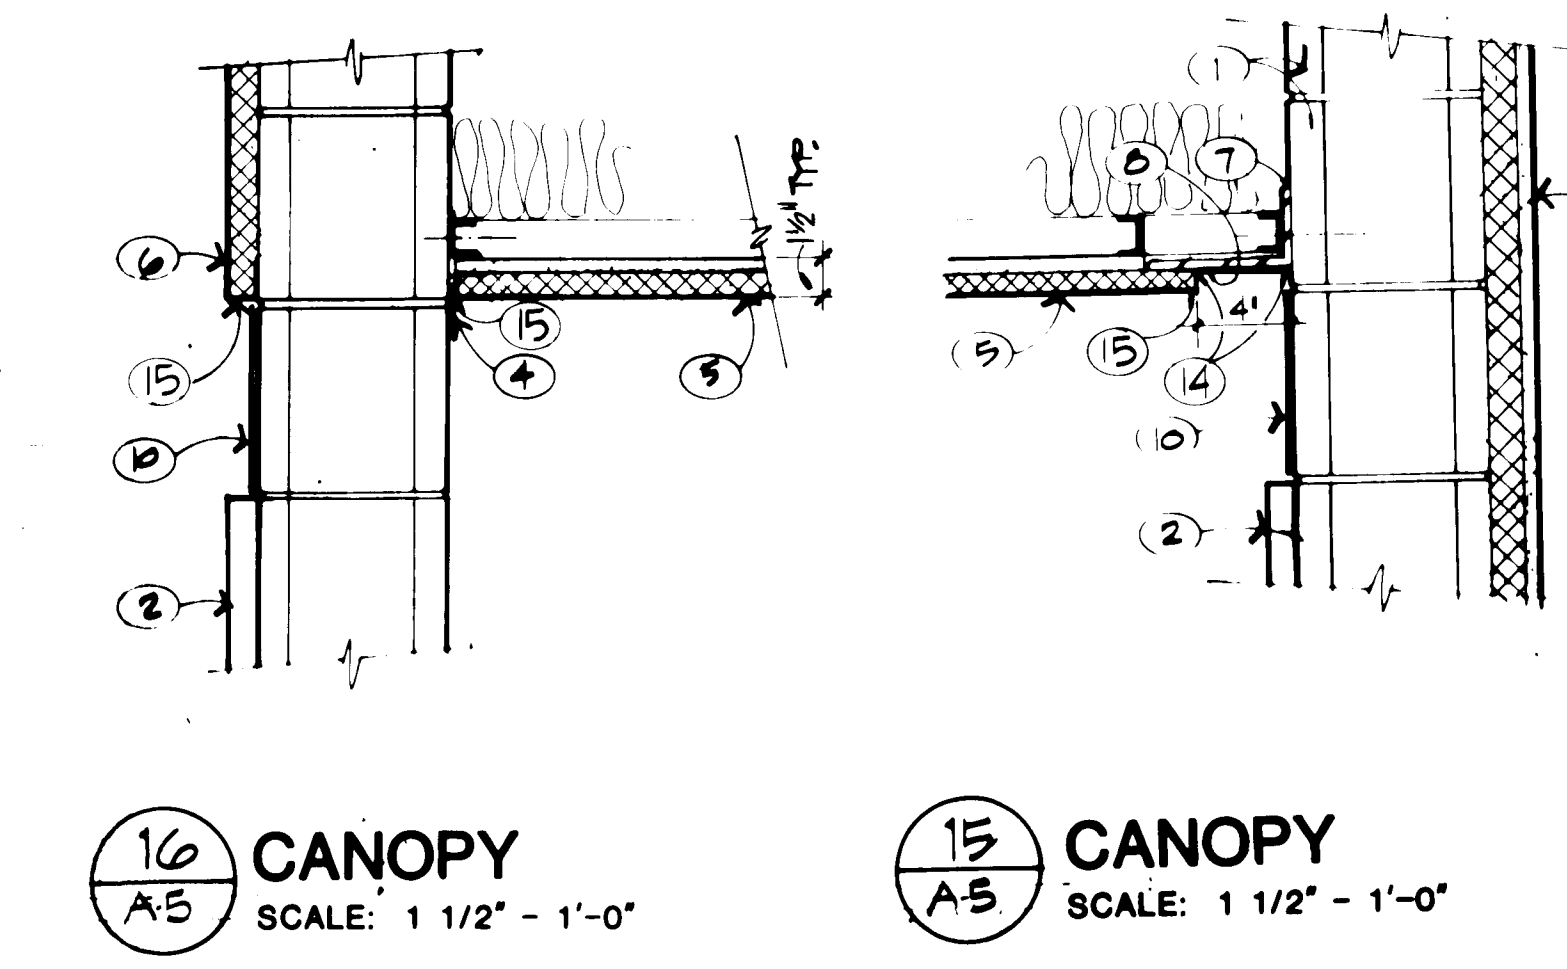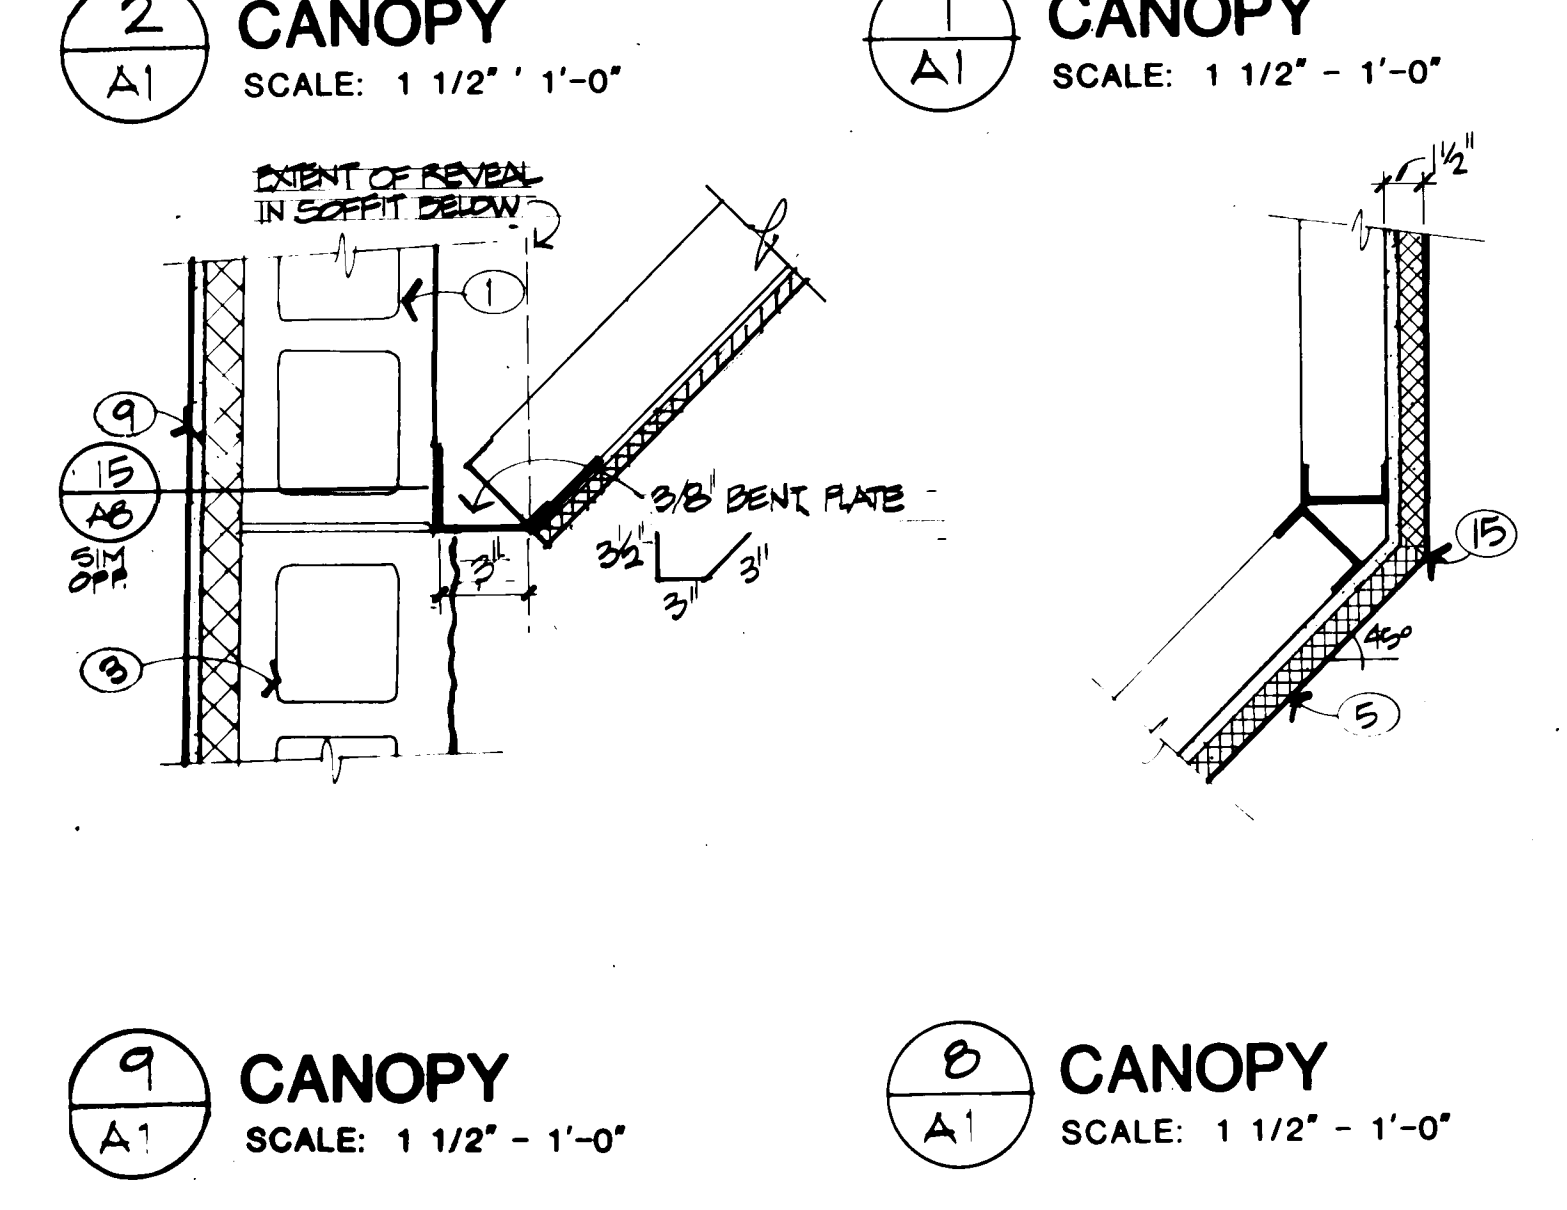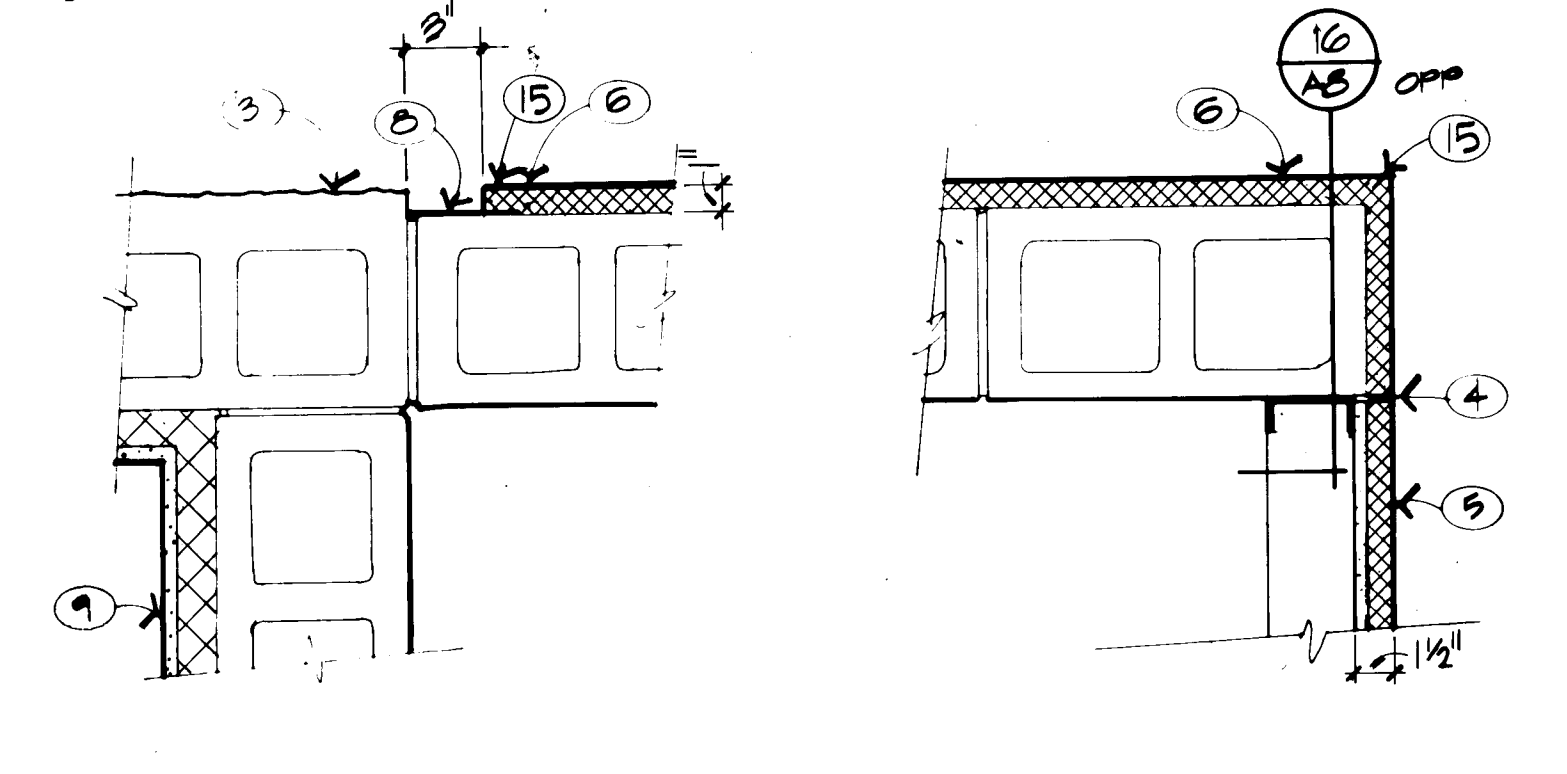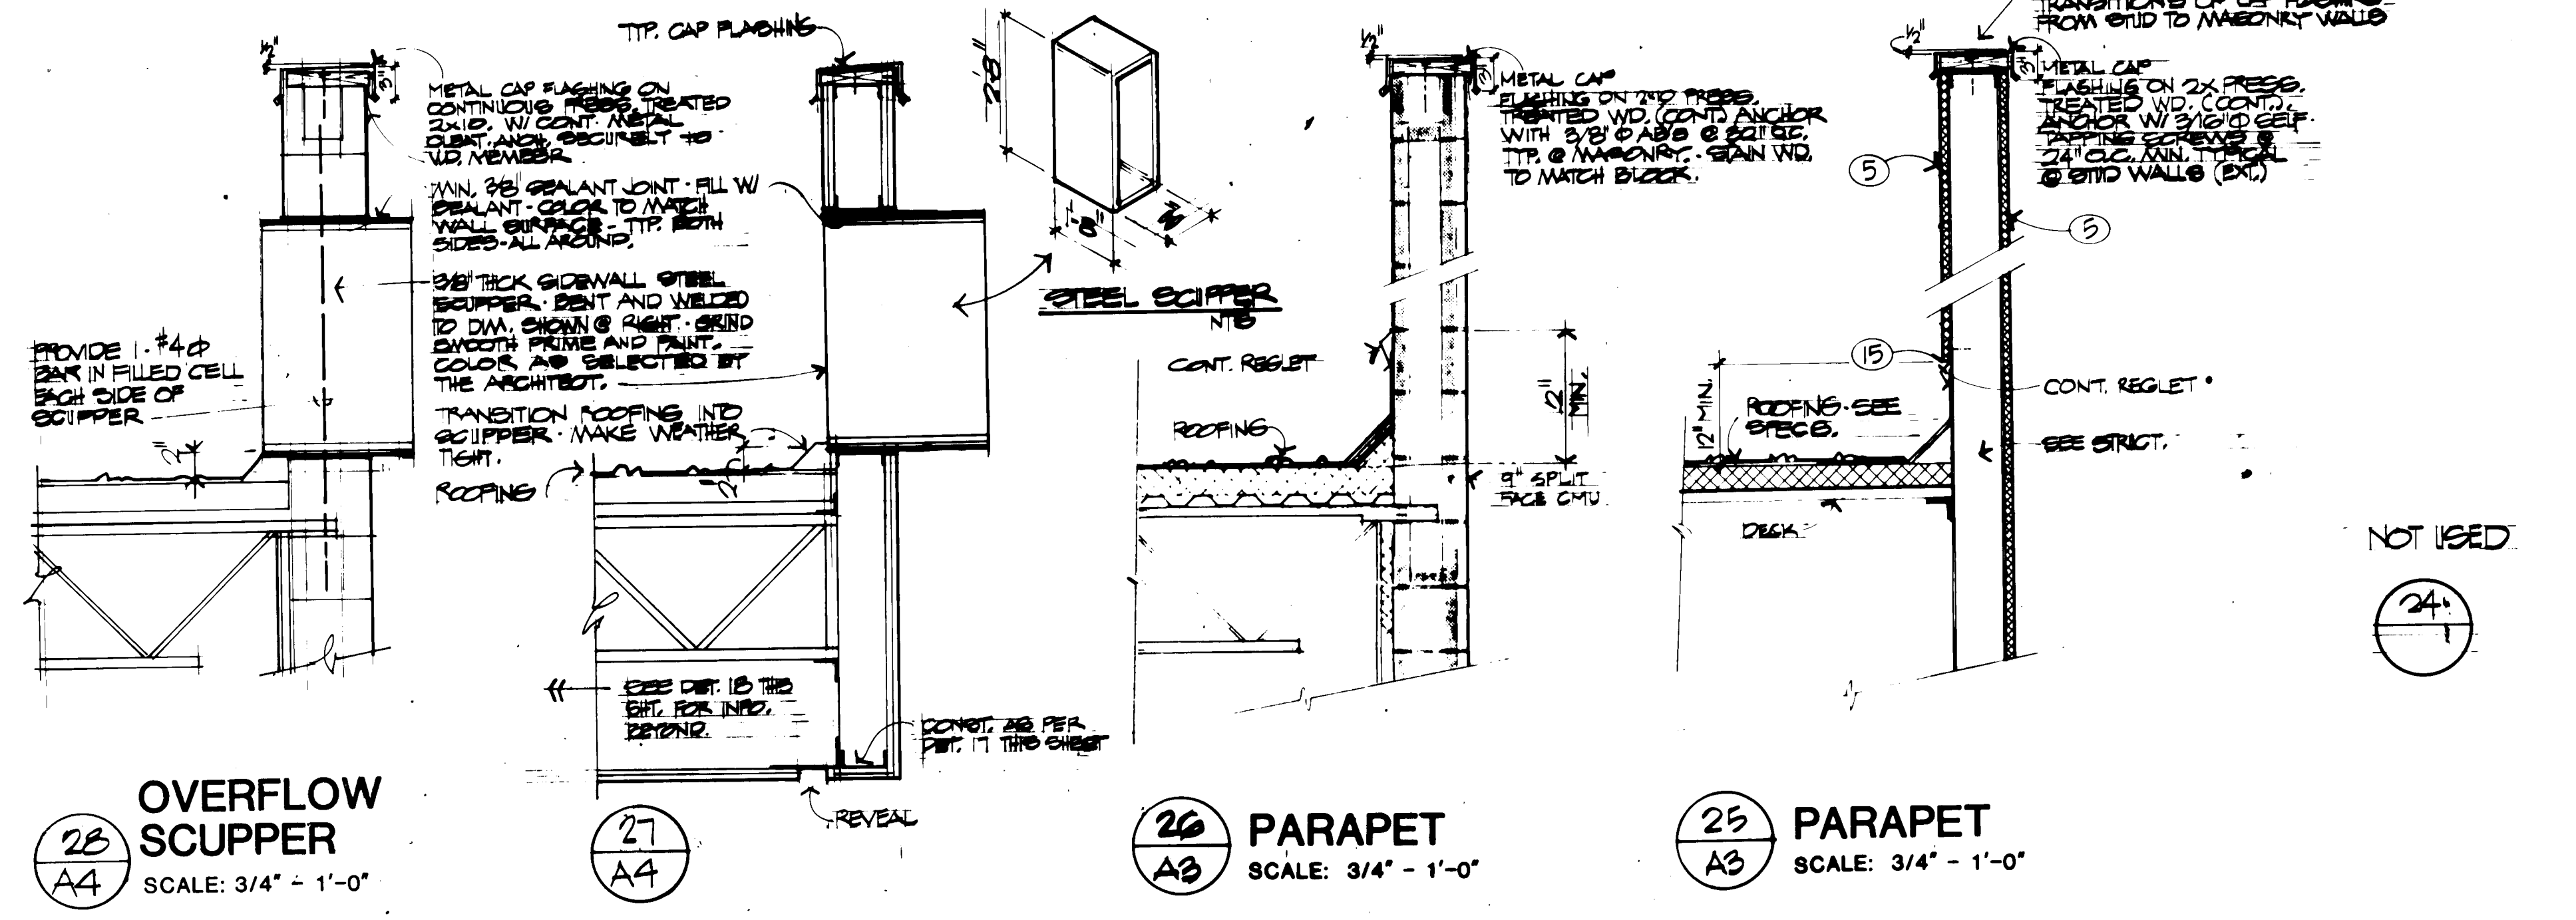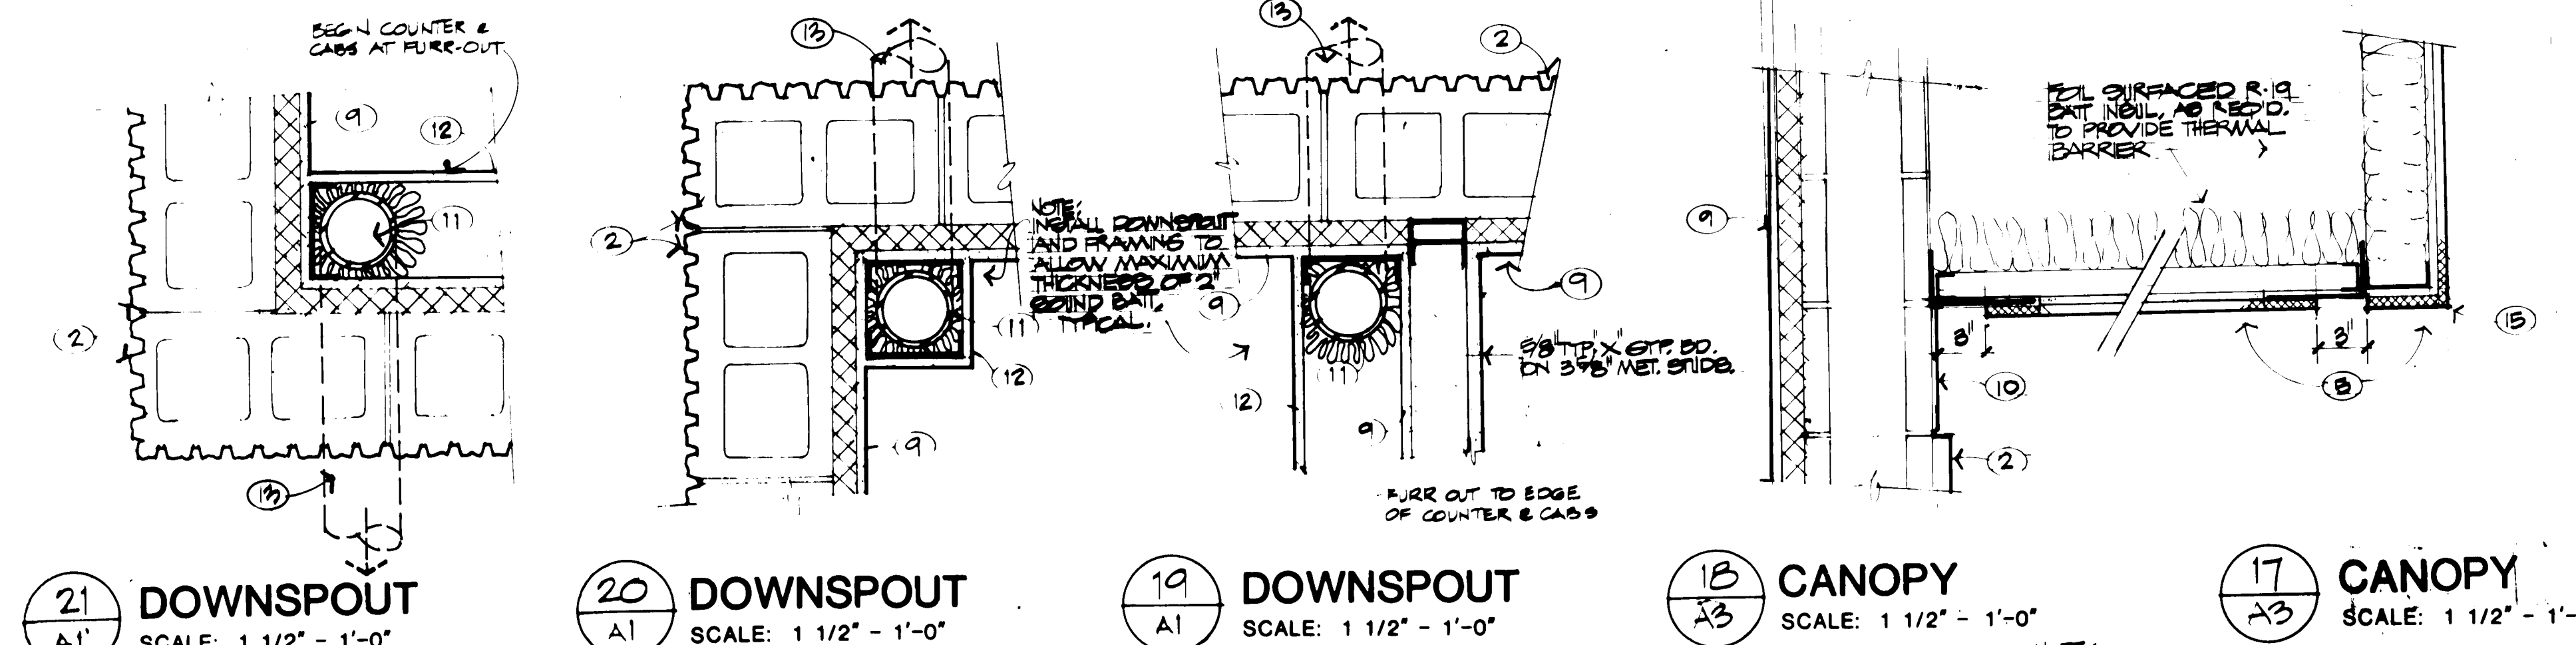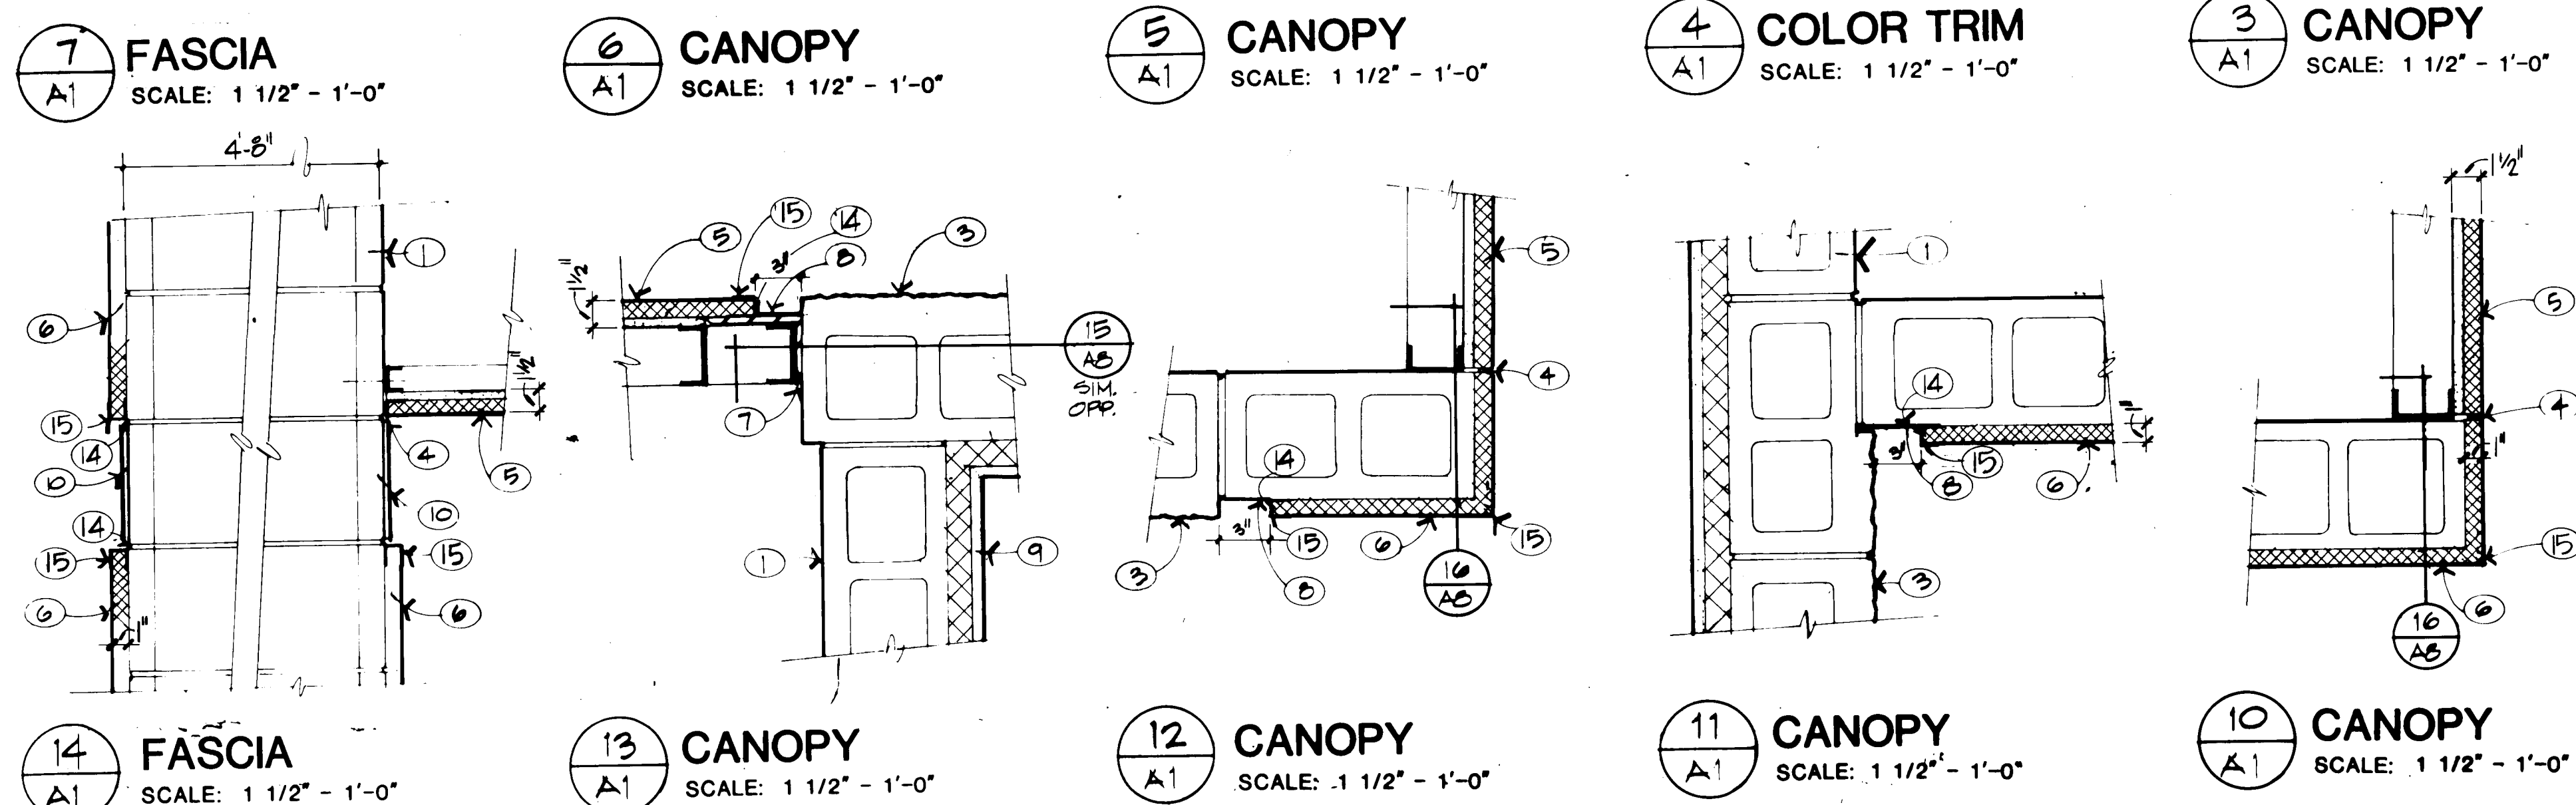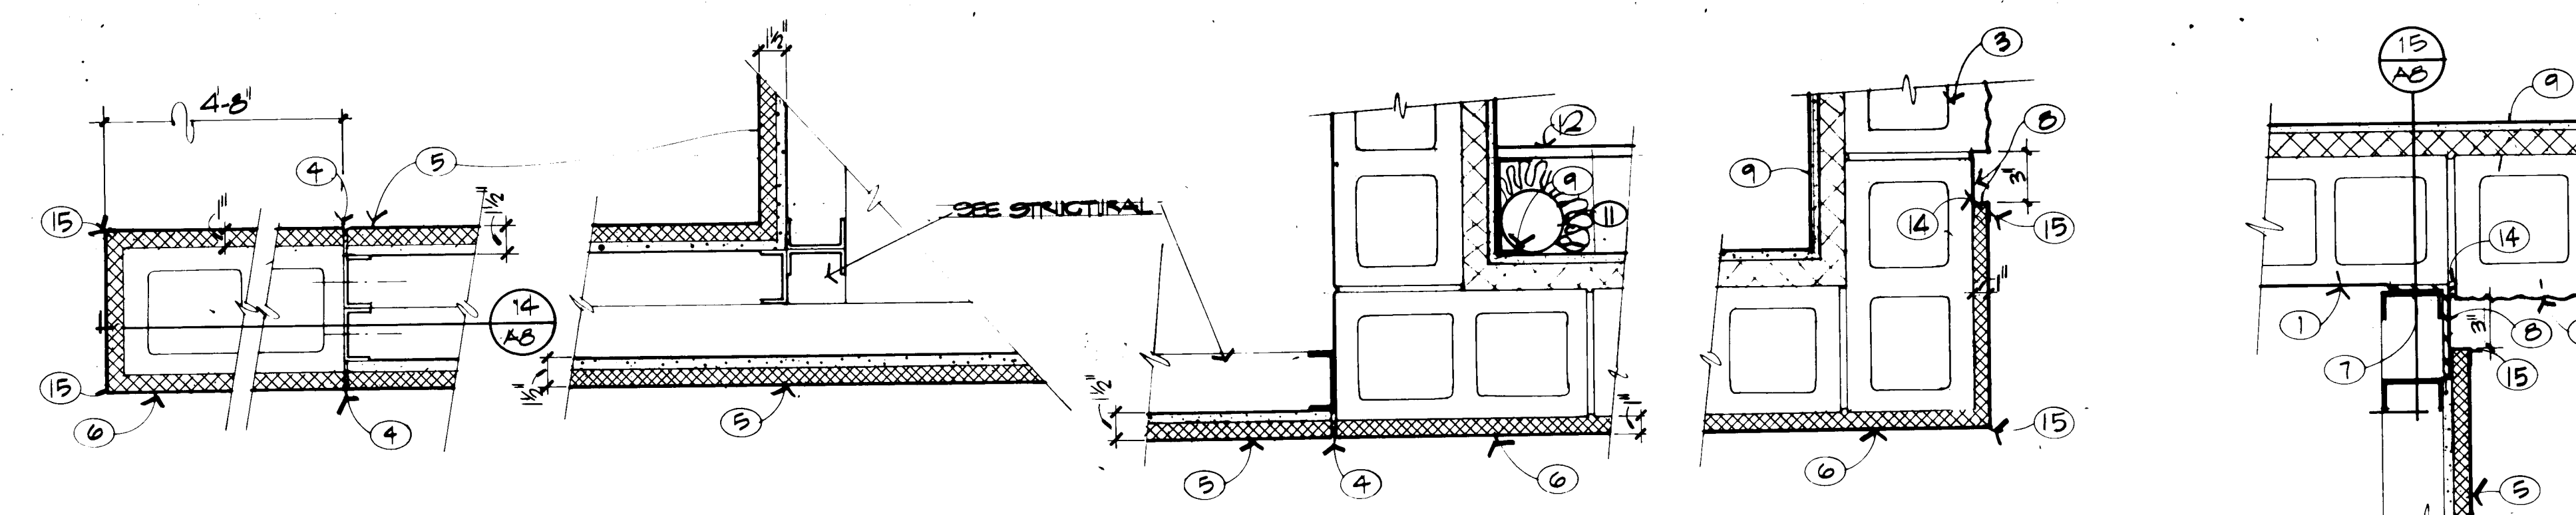

- NOTES**
1. 2" COMMON G.M.I.L.
 2. 1" FILLED G.M.I.L.
 3. 1" SPLIT-FACE G.M.I.L.
 4. EXPANSION J.T. W/ SEALANT.
 5. SYNTHETIC PLASTER FINISH ON EXPOSED SURFACES OF COMMON CHIL.
 6. SYNTHETIC PLASTER FINISH ON EXPOSED SURFACES OF COMMON CHIL.
 7. 1" SPLIT-FACE G.M.I.L.
 8. 1" SPLIT-FACE G.M.I.L.
 9. 1" SPLIT-FACE G.M.I.L.
 10. 1" SPLIT-FACE G.M.I.L.
 11. 1" SPLIT-FACE G.M.I.L.
 12. 1" SPLIT-FACE G.M.I.L.
 13. 1" SPLIT-FACE G.M.I.L.
 14. 1" SPLIT-FACE G.M.I.L.
 15. 1" SPLIT-FACE G.M.I.L.

BURNS/PETERS GROUP ARCHITECTS
RECORD DRAWING
DATE 12 SEPT 81
R. L. PETERS

REVISIONS













ENGINEER

ARCHITECT

THE EAST-CENTRAL
MULTI-SERVICE
CENTER

PROJECT NO. 81003 DATE MAY 83

A8
SHEET 20 OF 20

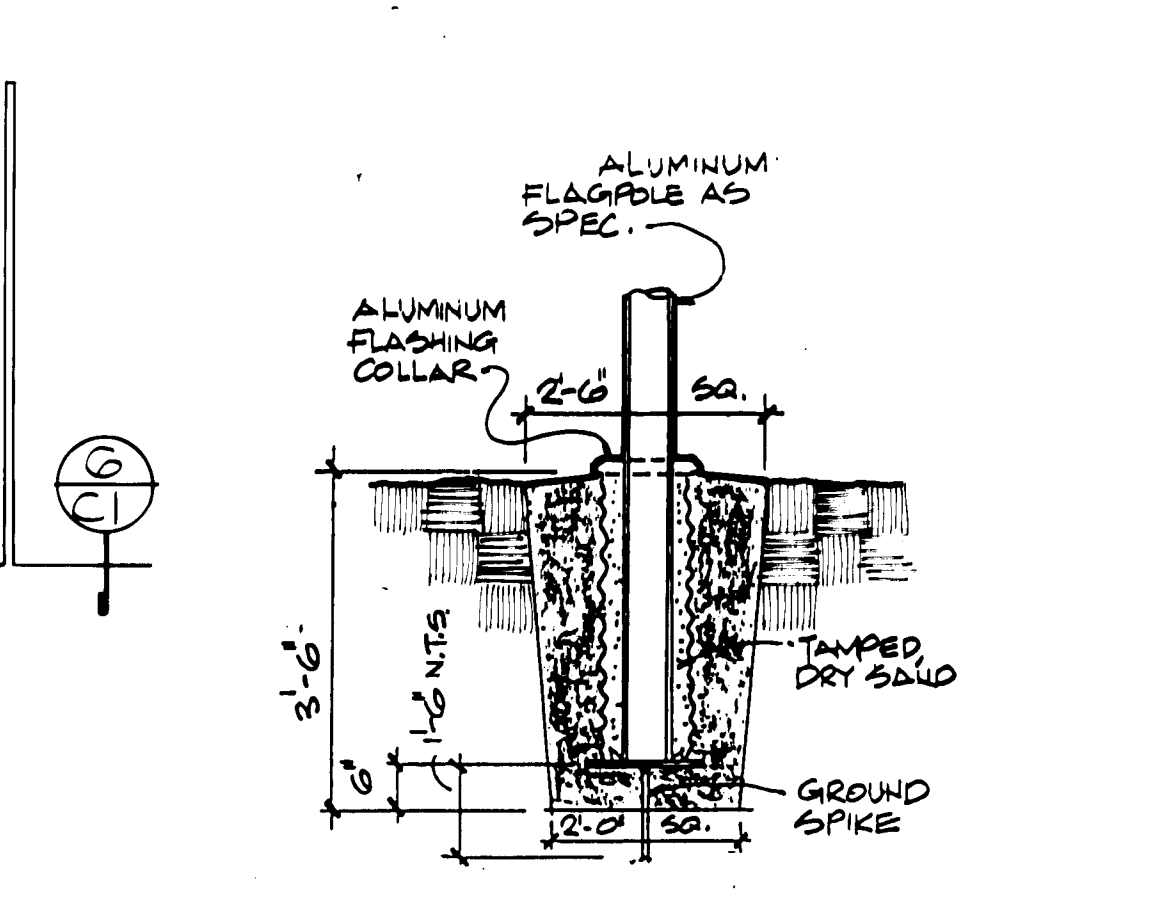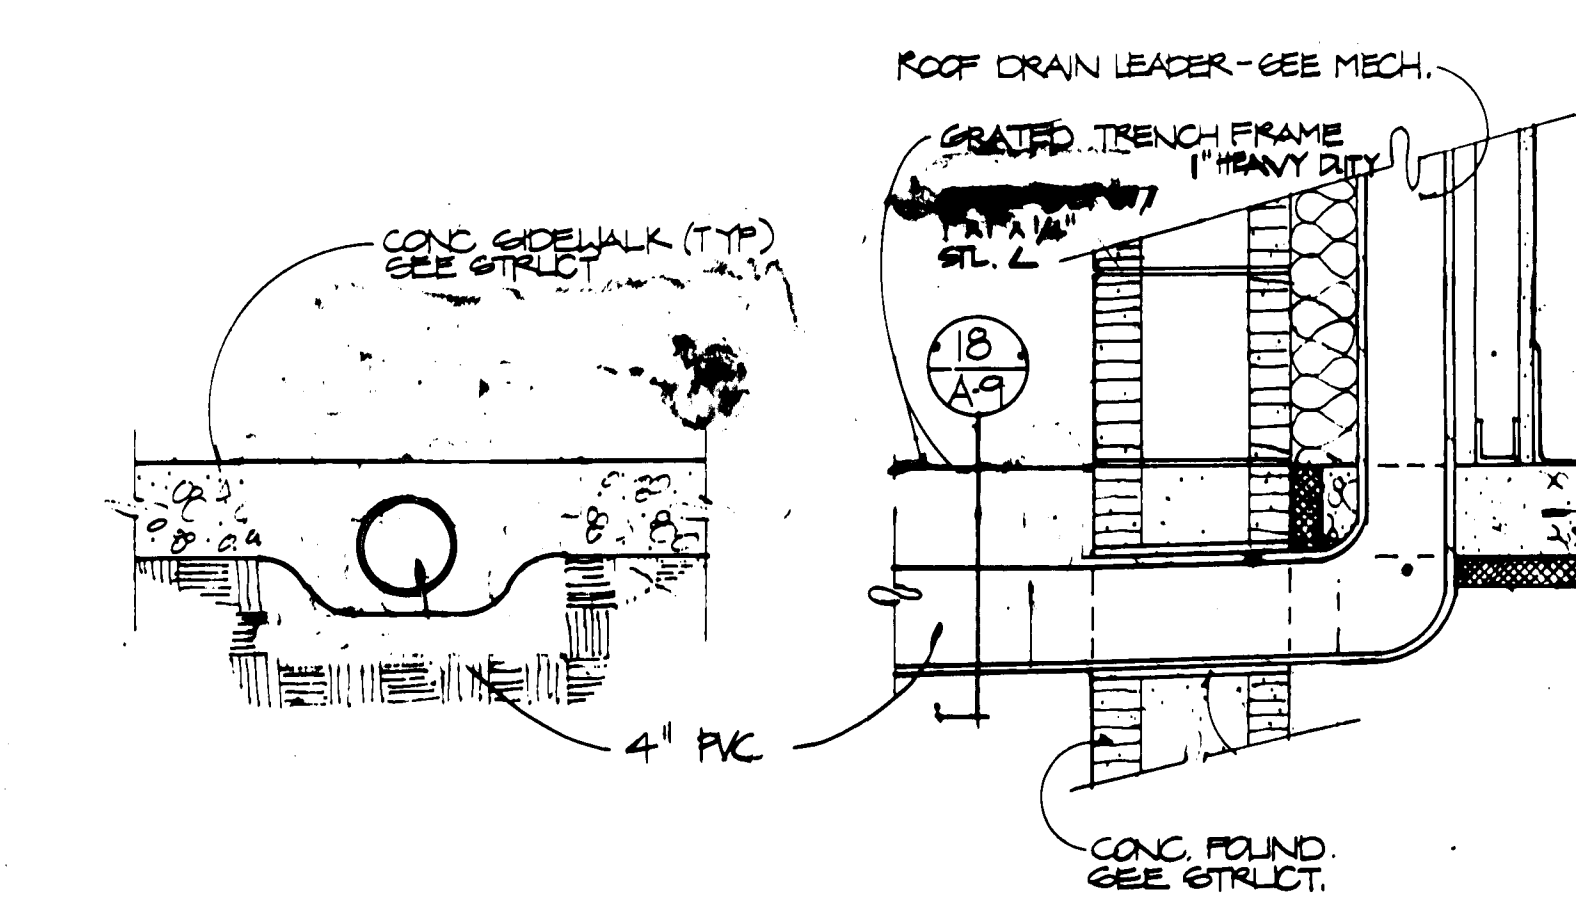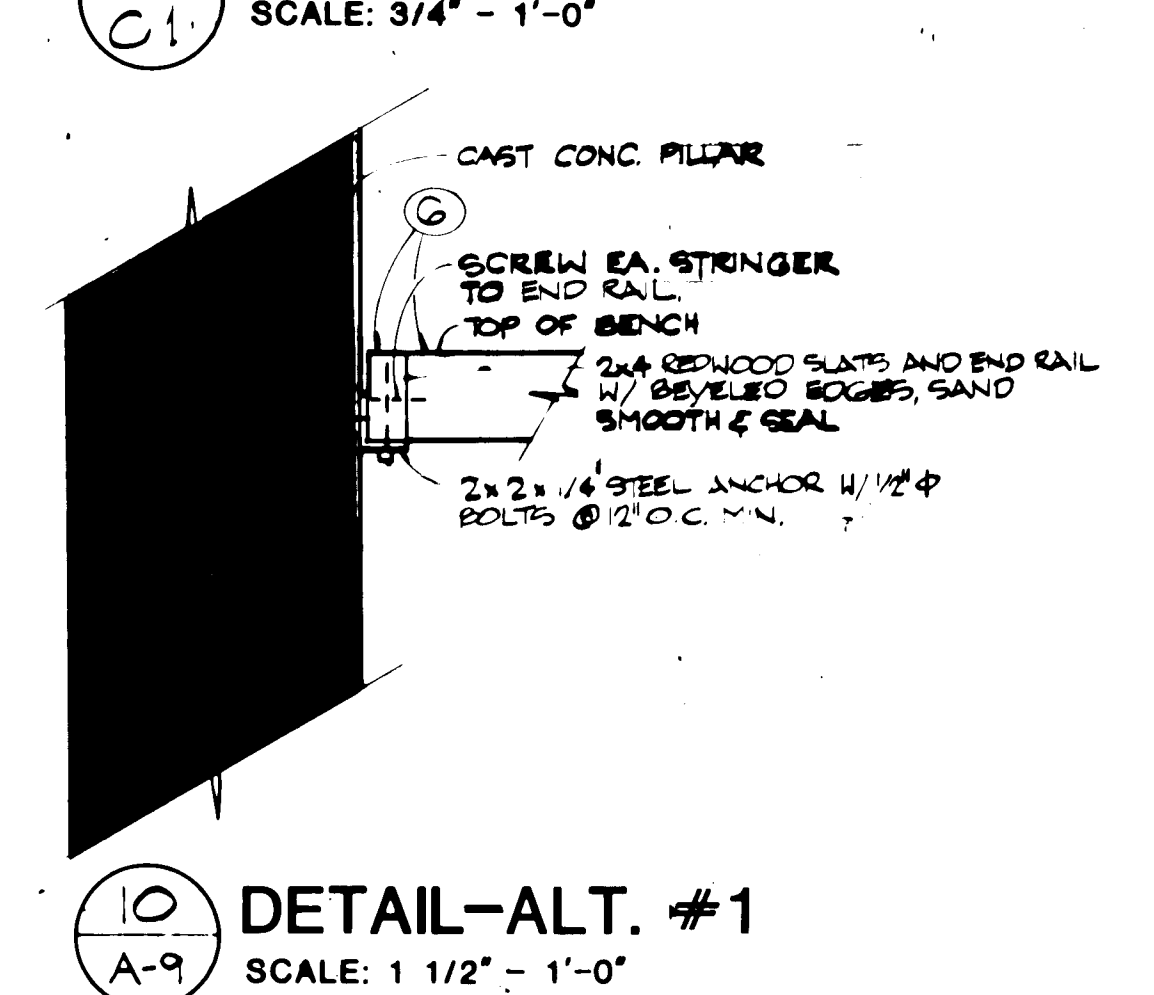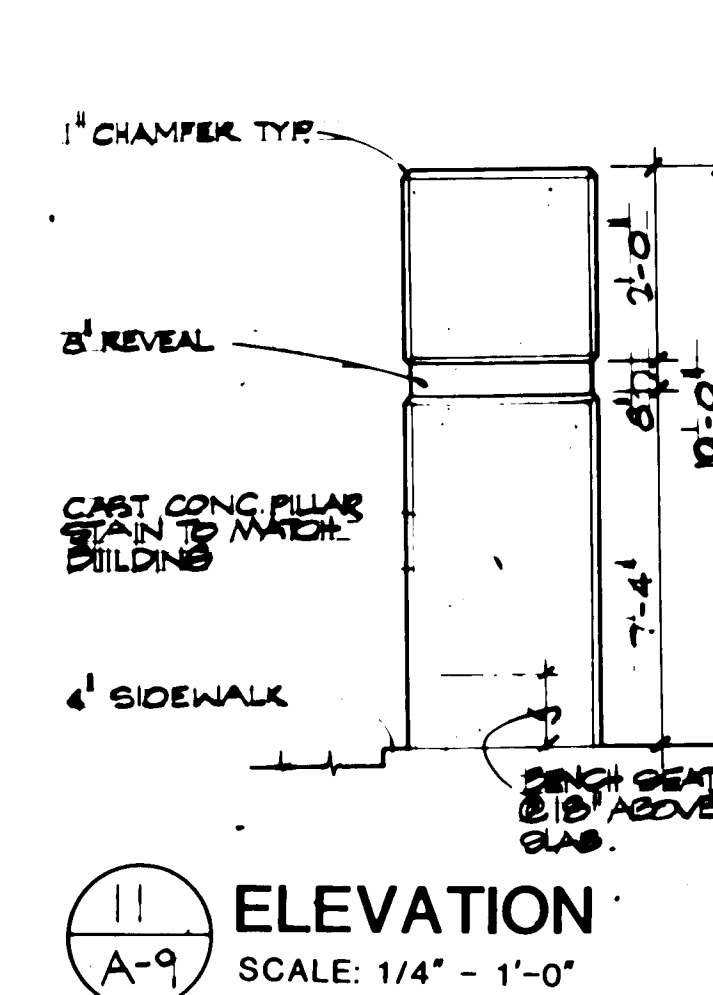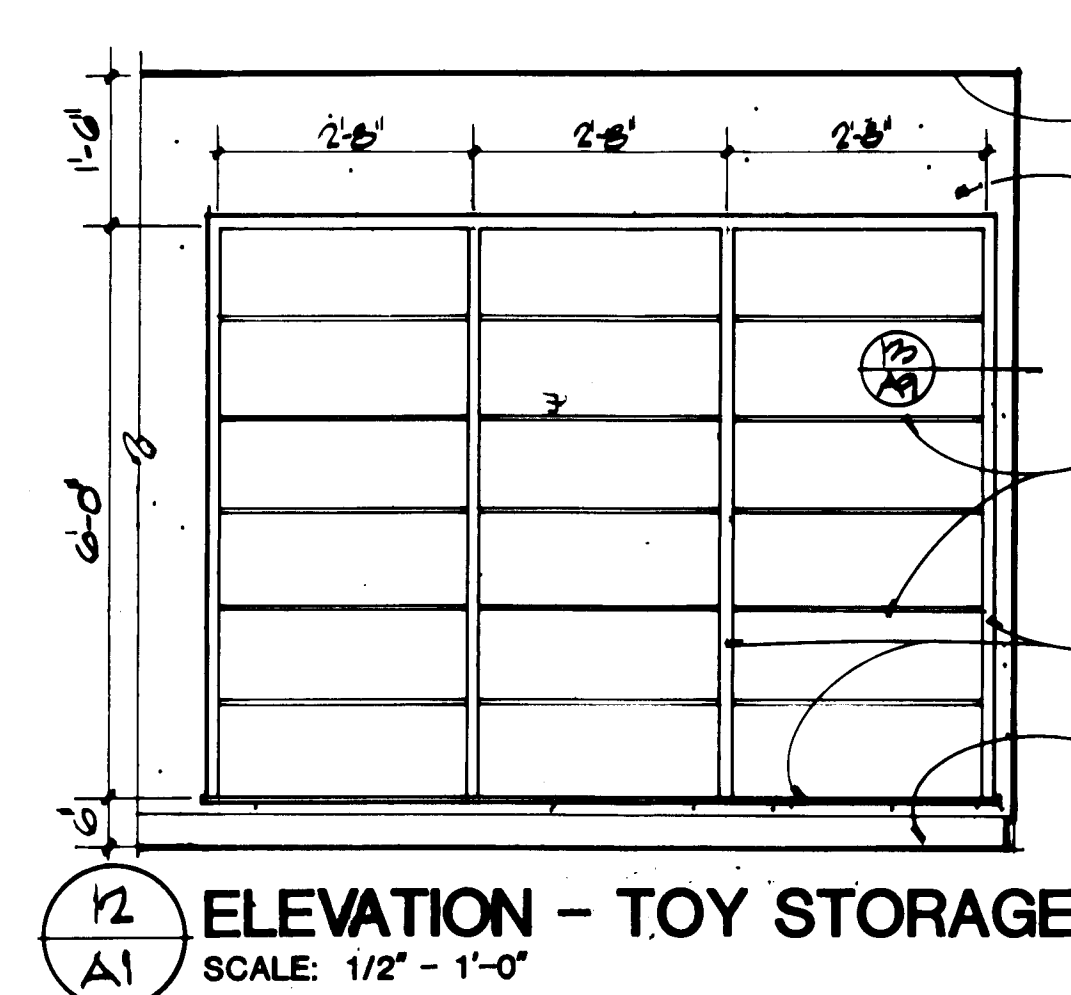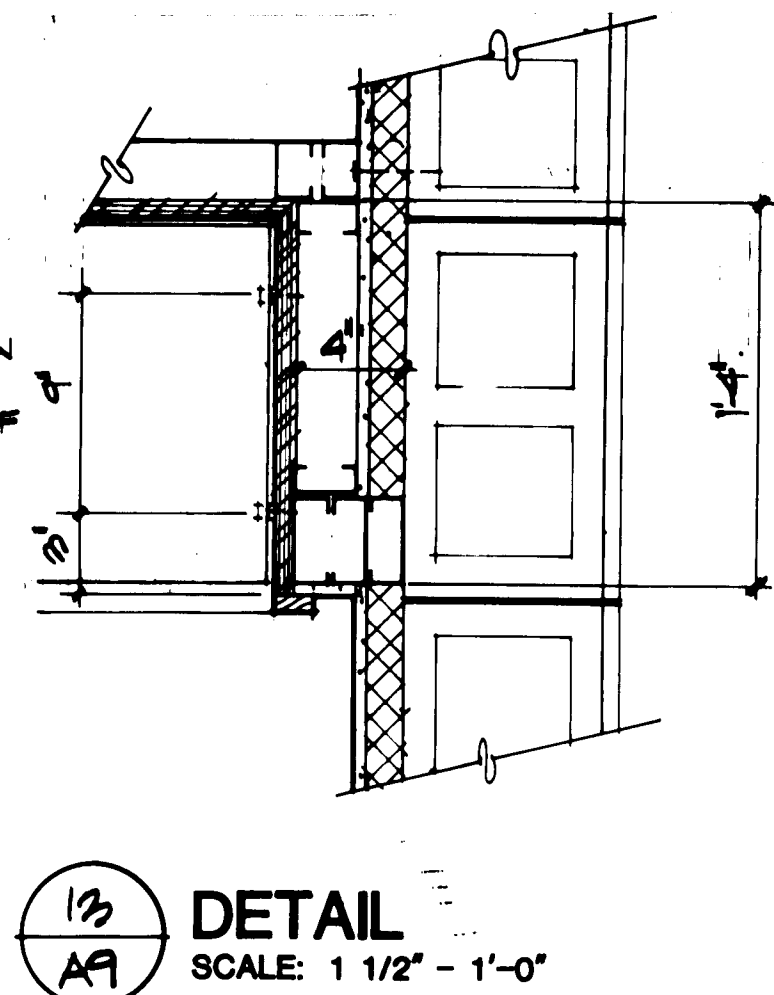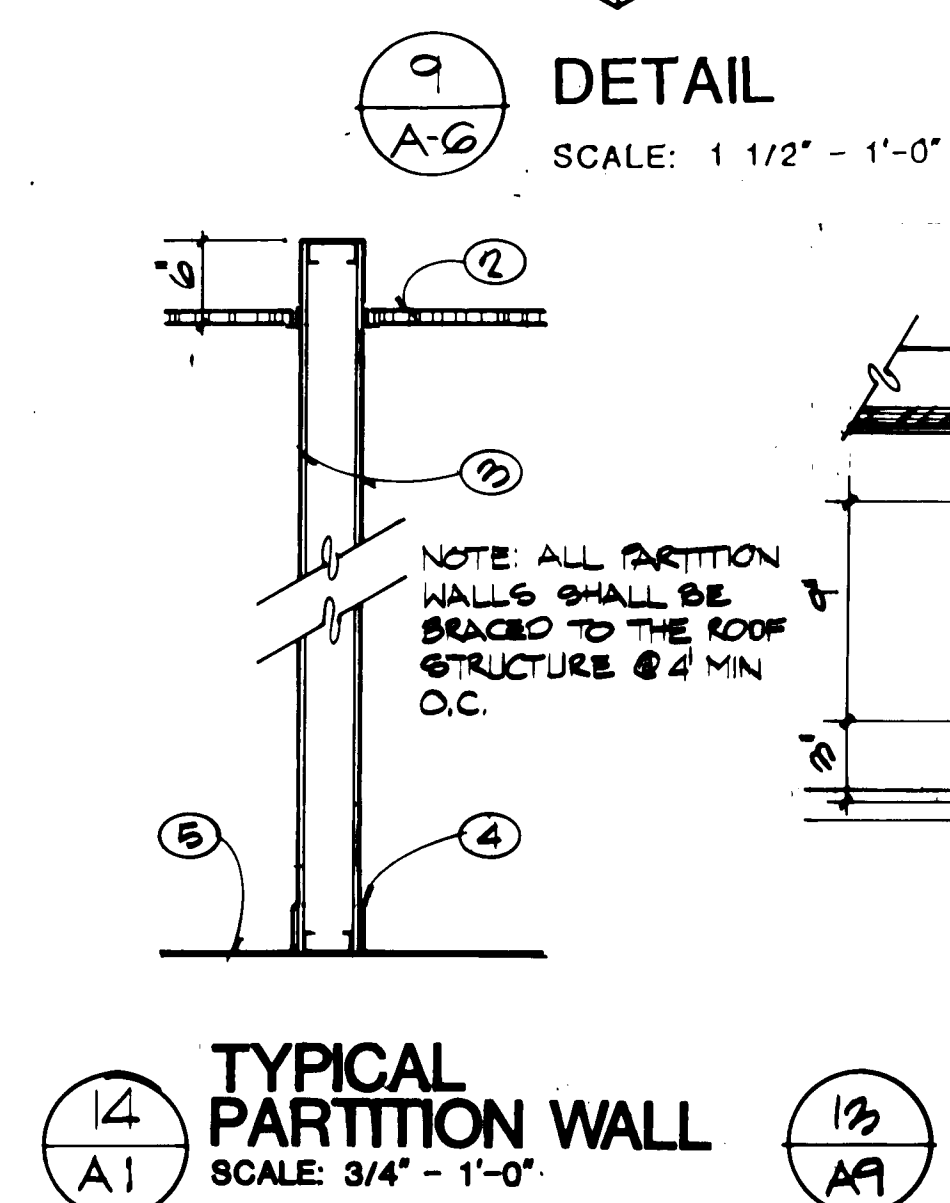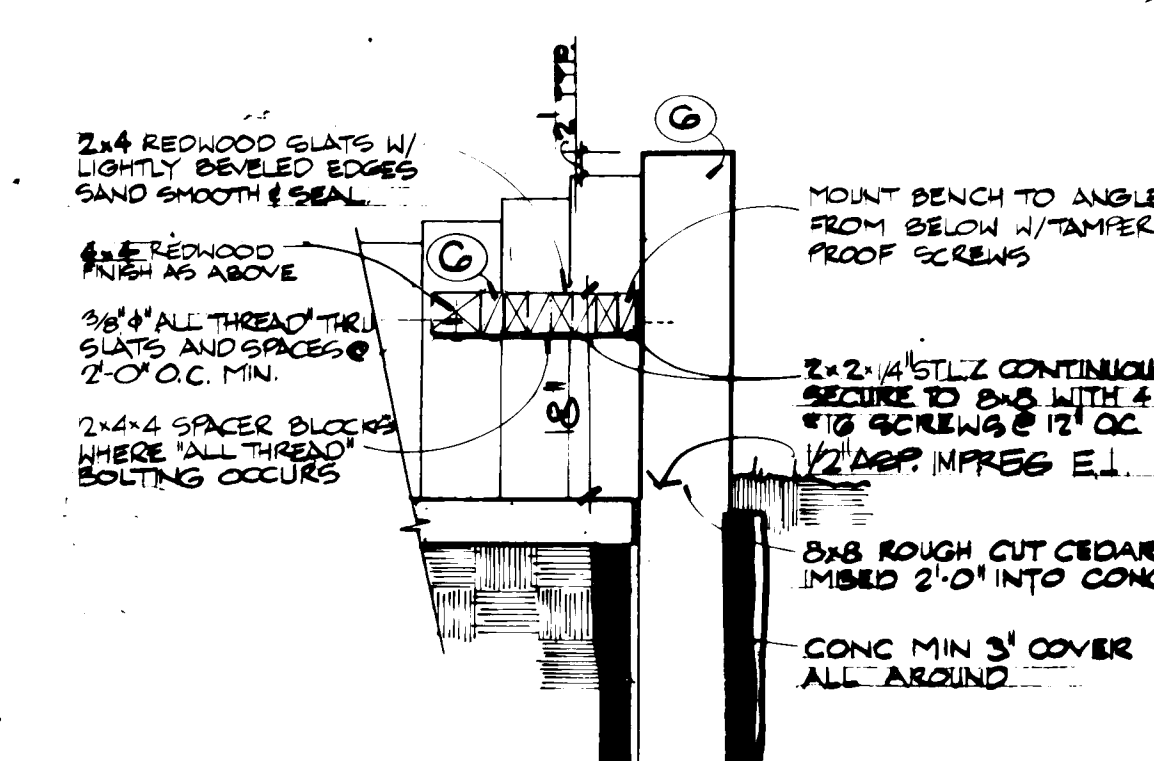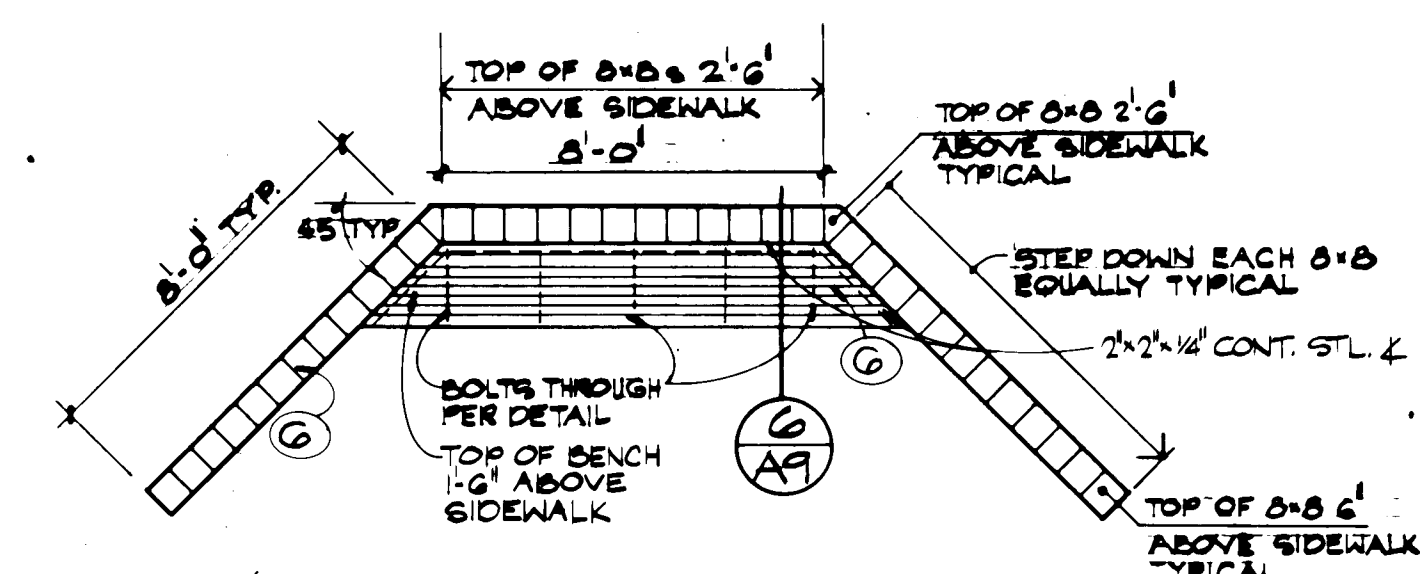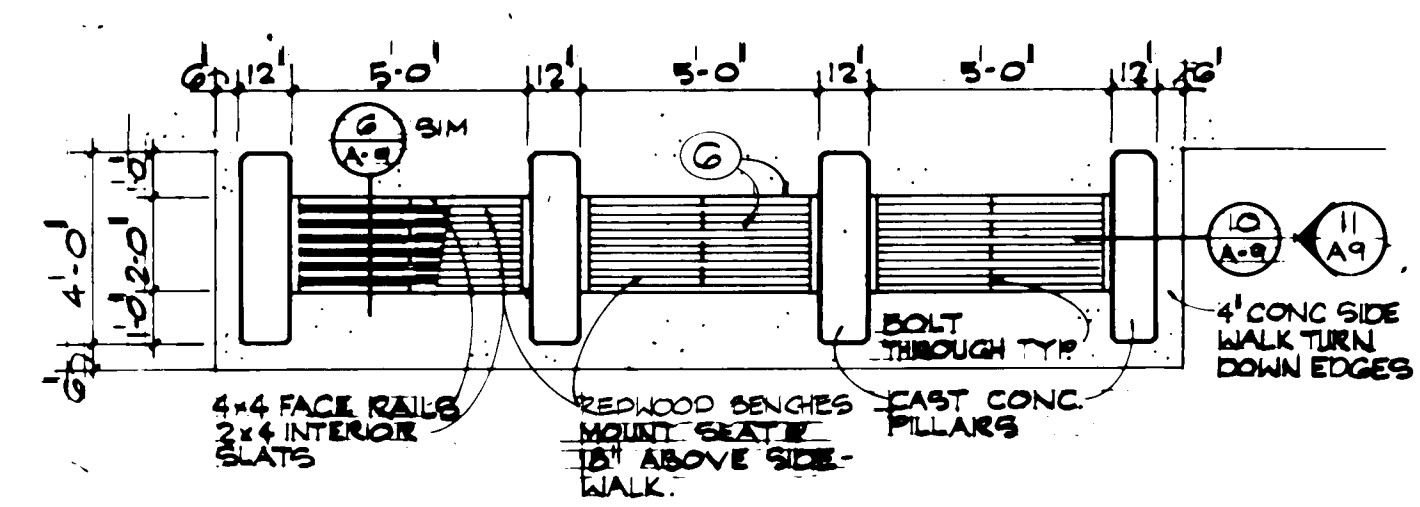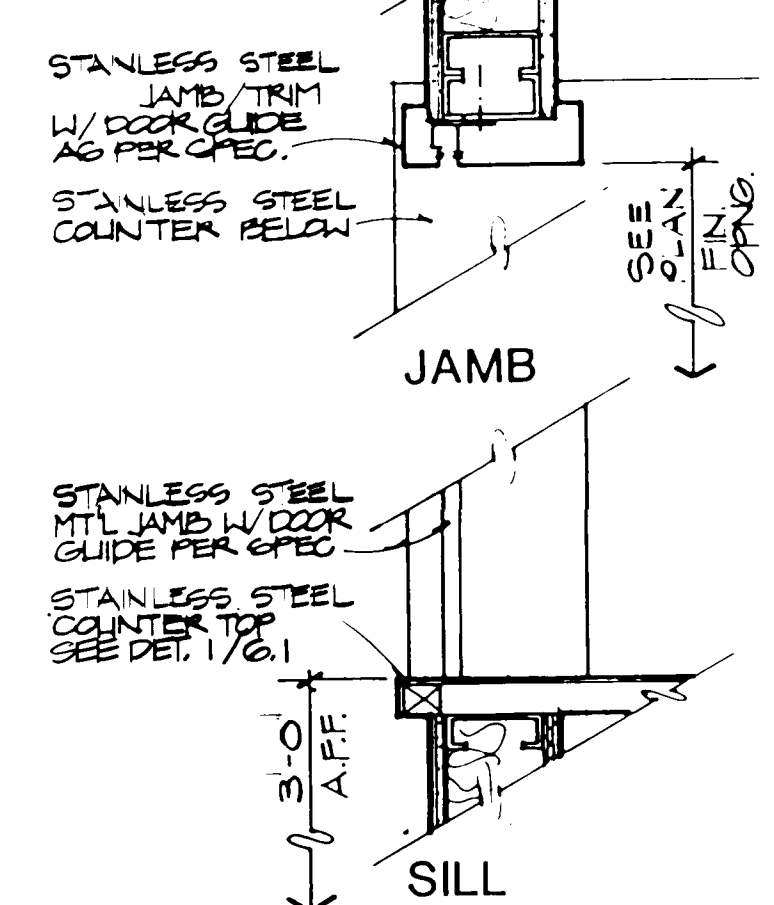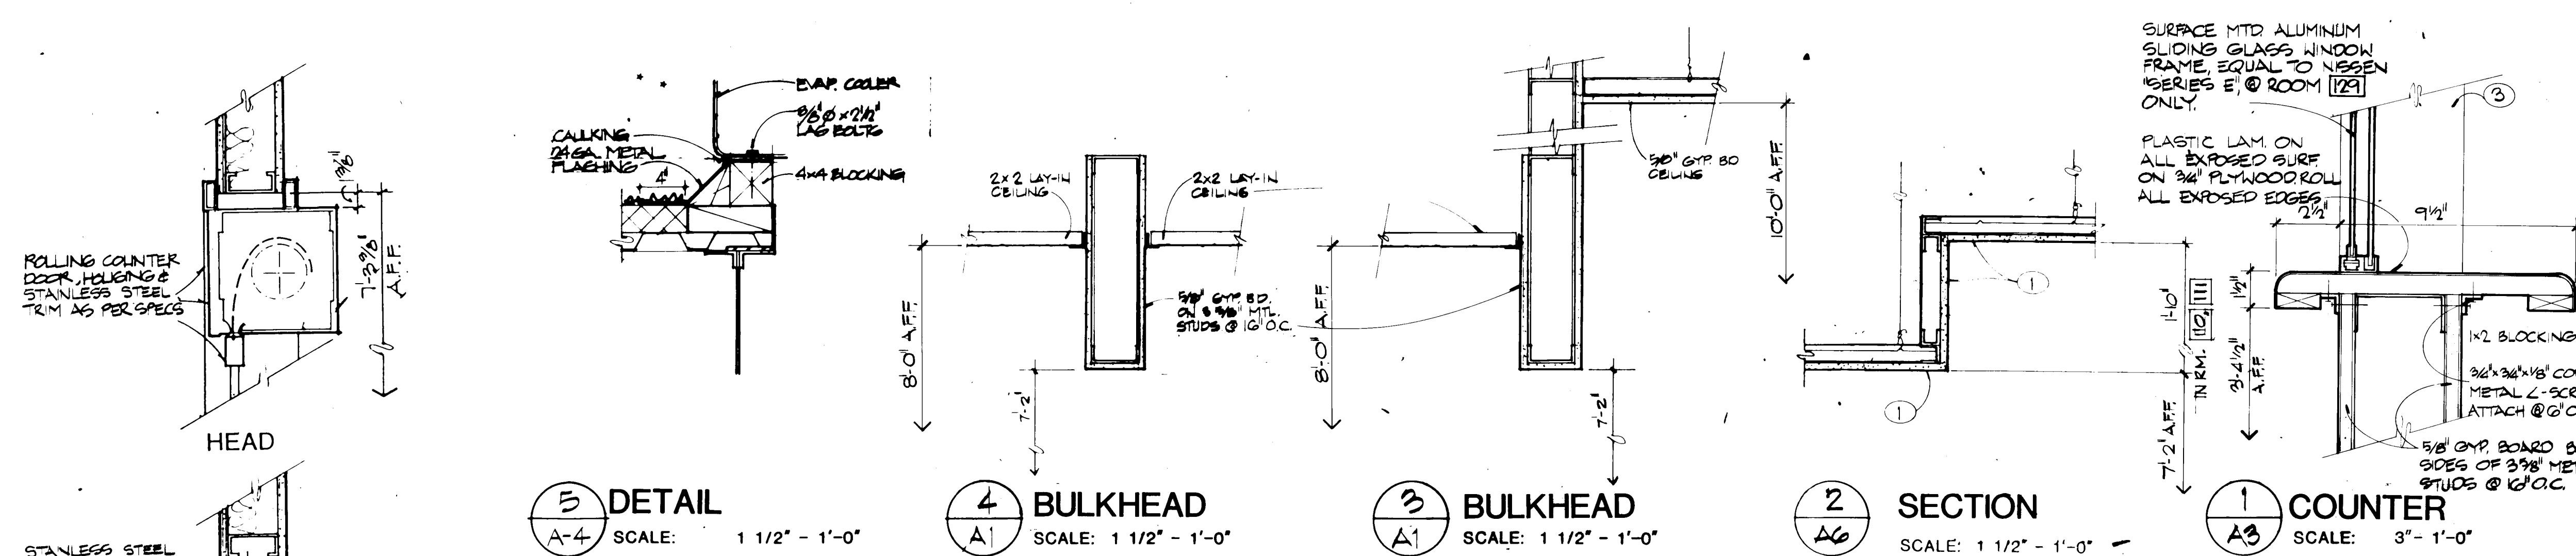

- ## NOTES
- ① 3/8" GYP BRD. ON MT'L SUPPORT SYSTEM
 - ② CEILING AS SCHEDULED
 - ③ 3/8" GYP BRD. ON MT'L STUDS
 - ④ BASE AS SCHEDULED.
 - ⑤ FLOOR FINISH AS SCHEDULED.
 - ⑥ FINISH ALL EXTERIOR WOODWORK WITH CLEAR FINISH EQUAL TO "WOODLIFE"

BURNS/PETERS GROUP ARCHITECTS

RECORD DRAWING:

17 SEPT 84

Chas in two

REVISIONS

ENGINEER

STATE OF NEW MEXICO
 RONALD L. PETERS
 NO. 788
 REGISTERED ARCHITECT
 ARCHITECT

THE EAST-CENTRAL MULTI-SERVICE CENTER

PROJECT NO. 8705

DATE MAY '83

A9

SHEET 27 OF 30

26 1589 2184

NOTES (○)

- 1 TO CIRCUIT INDICATED THROUGH LIGHTING CONTACTOR IN BOTTOM SKIRT OF PANEL "A". USE #10 CONDUCTORS.
- 2 POLE FIXTURE, 25' POLE. CROUSE-HINDS #2/RAL25OLEC WITH POLE #D5206.00A250P2/2. FURNISH WITH 1-250W HPS LAMP. BASE SHALL BE SAME AS TYPE "5" ON CONTRACT DRAWINGS.
- 3 POLE FIXTURE, 25' POLE. CROUSE-HINDS #2/RAL25OLEC WITH POLE #D5206.00A250P2. FURNISH WITH 1-250W HPS LAMP. BASE SHALL BE SAME AS TYPE "5" ON CONTRACT DRAWINGS.
- 4 POLE FIXTURE 10' POLE. EMCO #JU70 HPS-55S10-120V-06. BASE SHALL BE SAME AS TYPE "RM" ON CONTRACT DRAWINGS.
- 5 2" TELEPHONE CONDUIT TO TELEPHONE PEDESTAL AS SHOWN.
- 6 4" PRIMARY CONDUIT TO RISER POLE AS SHOWN.
- 7 FLUSH MOUNTED WP JUNCTION BOX FOR CONNECTION TO SPRINKLER SYSTEM CONTROLLER. EXTEND TO SPARE 20A/1P CIRCUIT BREAKER IN PANEL "A".
- 8 WP JUNCTION BOX FOR CONNECTION OF SIGN LIGHTING.
- 9 TO SWITCH LOCATED IN VESTIBULE IN MAIN ENTRANCE. LABEL SWITCH "SIGN LIGHTS".


BURNS/PETERS GROUP-ARCHITECTS

RECORD DRAWING 3

DATE: 12 SEPT 84

Charlie Chubb

REVISIONS AS BUILT AUG. 1984

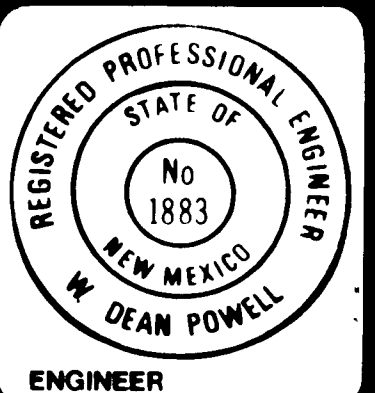



THE
EAST · CENTRAL
MULTI · SERVICE
CENTER

PROJECT NO.
8205

ATE
OCT 1 83

U1

SHEET 28 OF 36

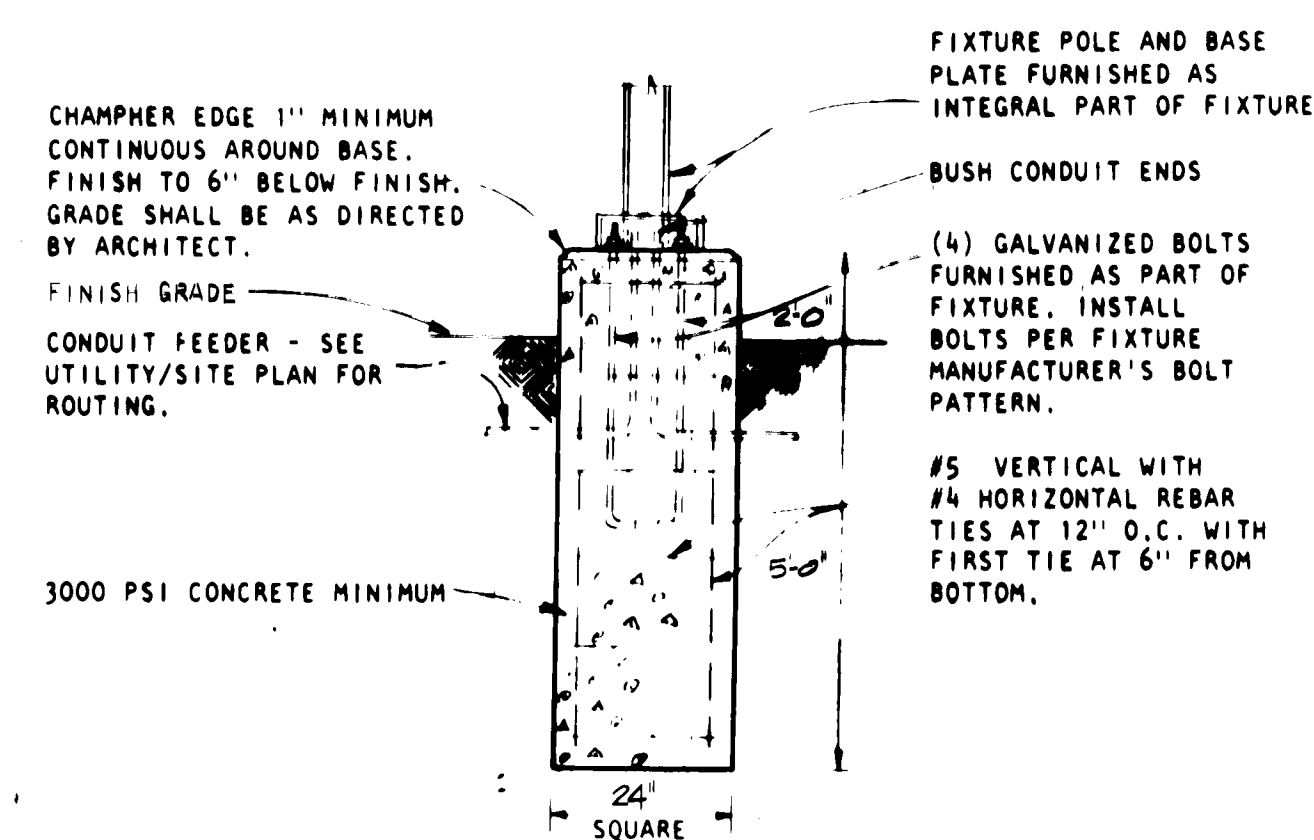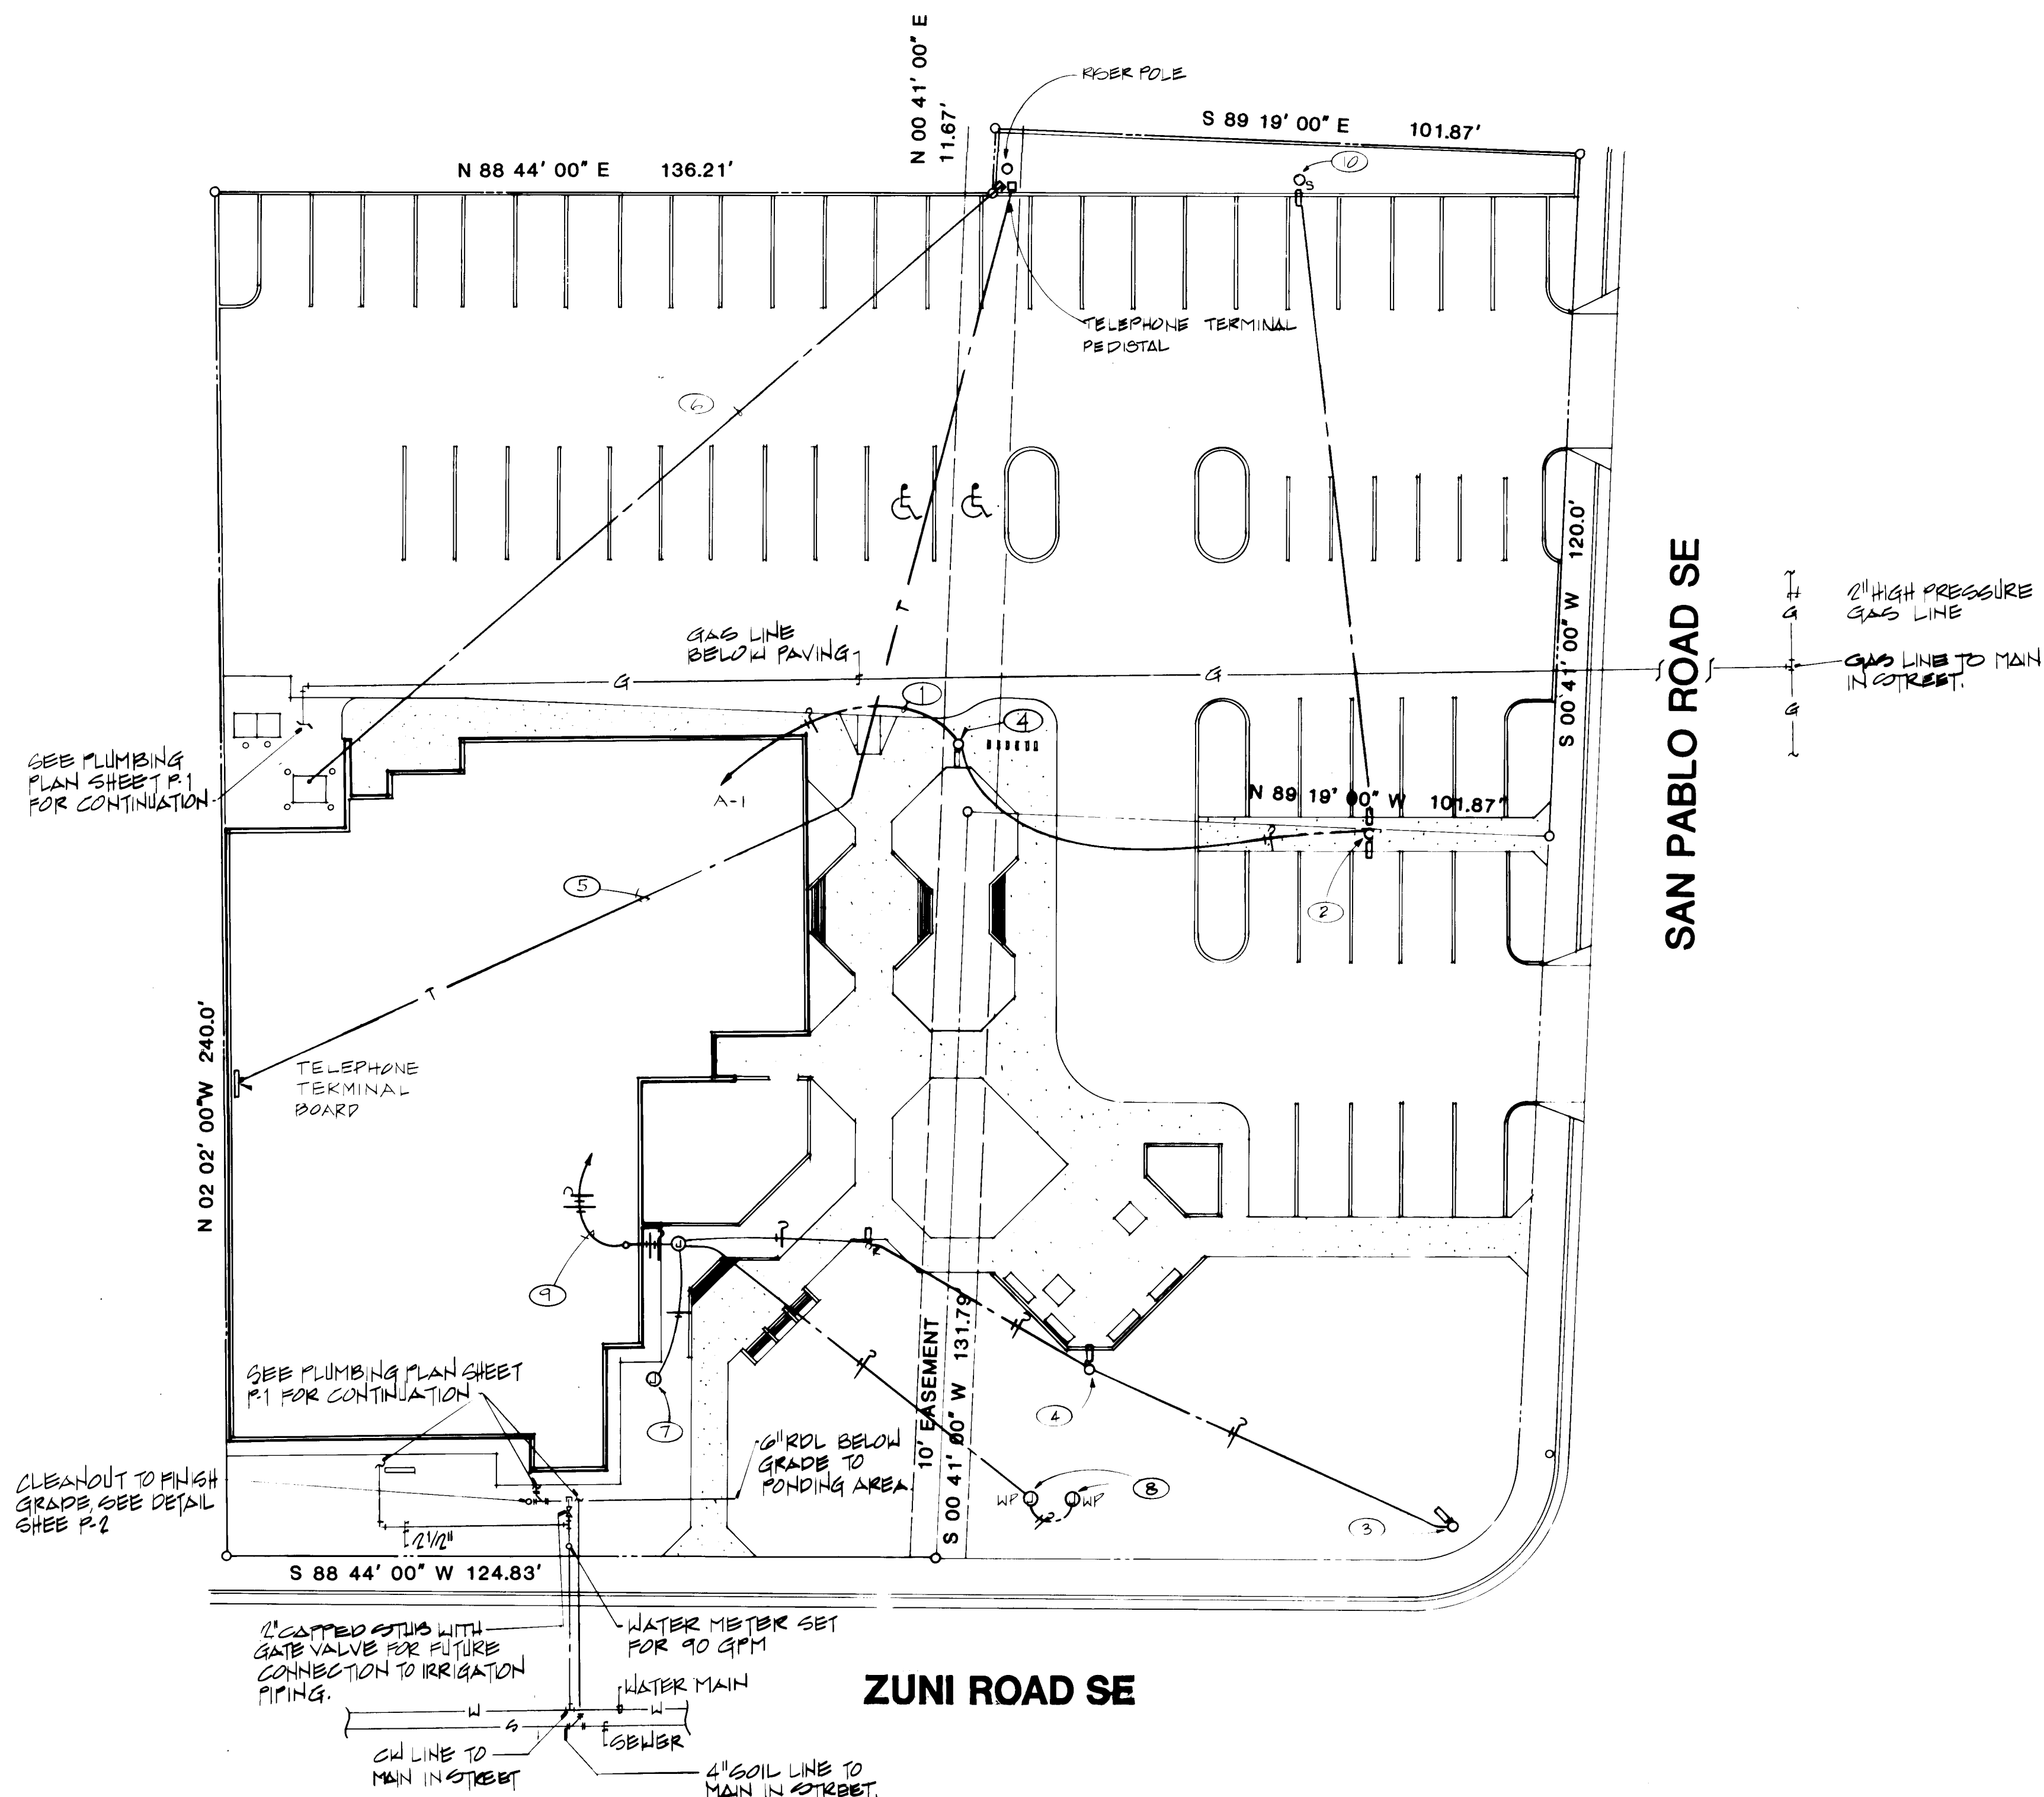


FIXTURE TYPE "S" MOUNTING DETAIL


SITE PLAN-UTILITIES

SCALE: 1" - 20'-0"


26 1589 2884

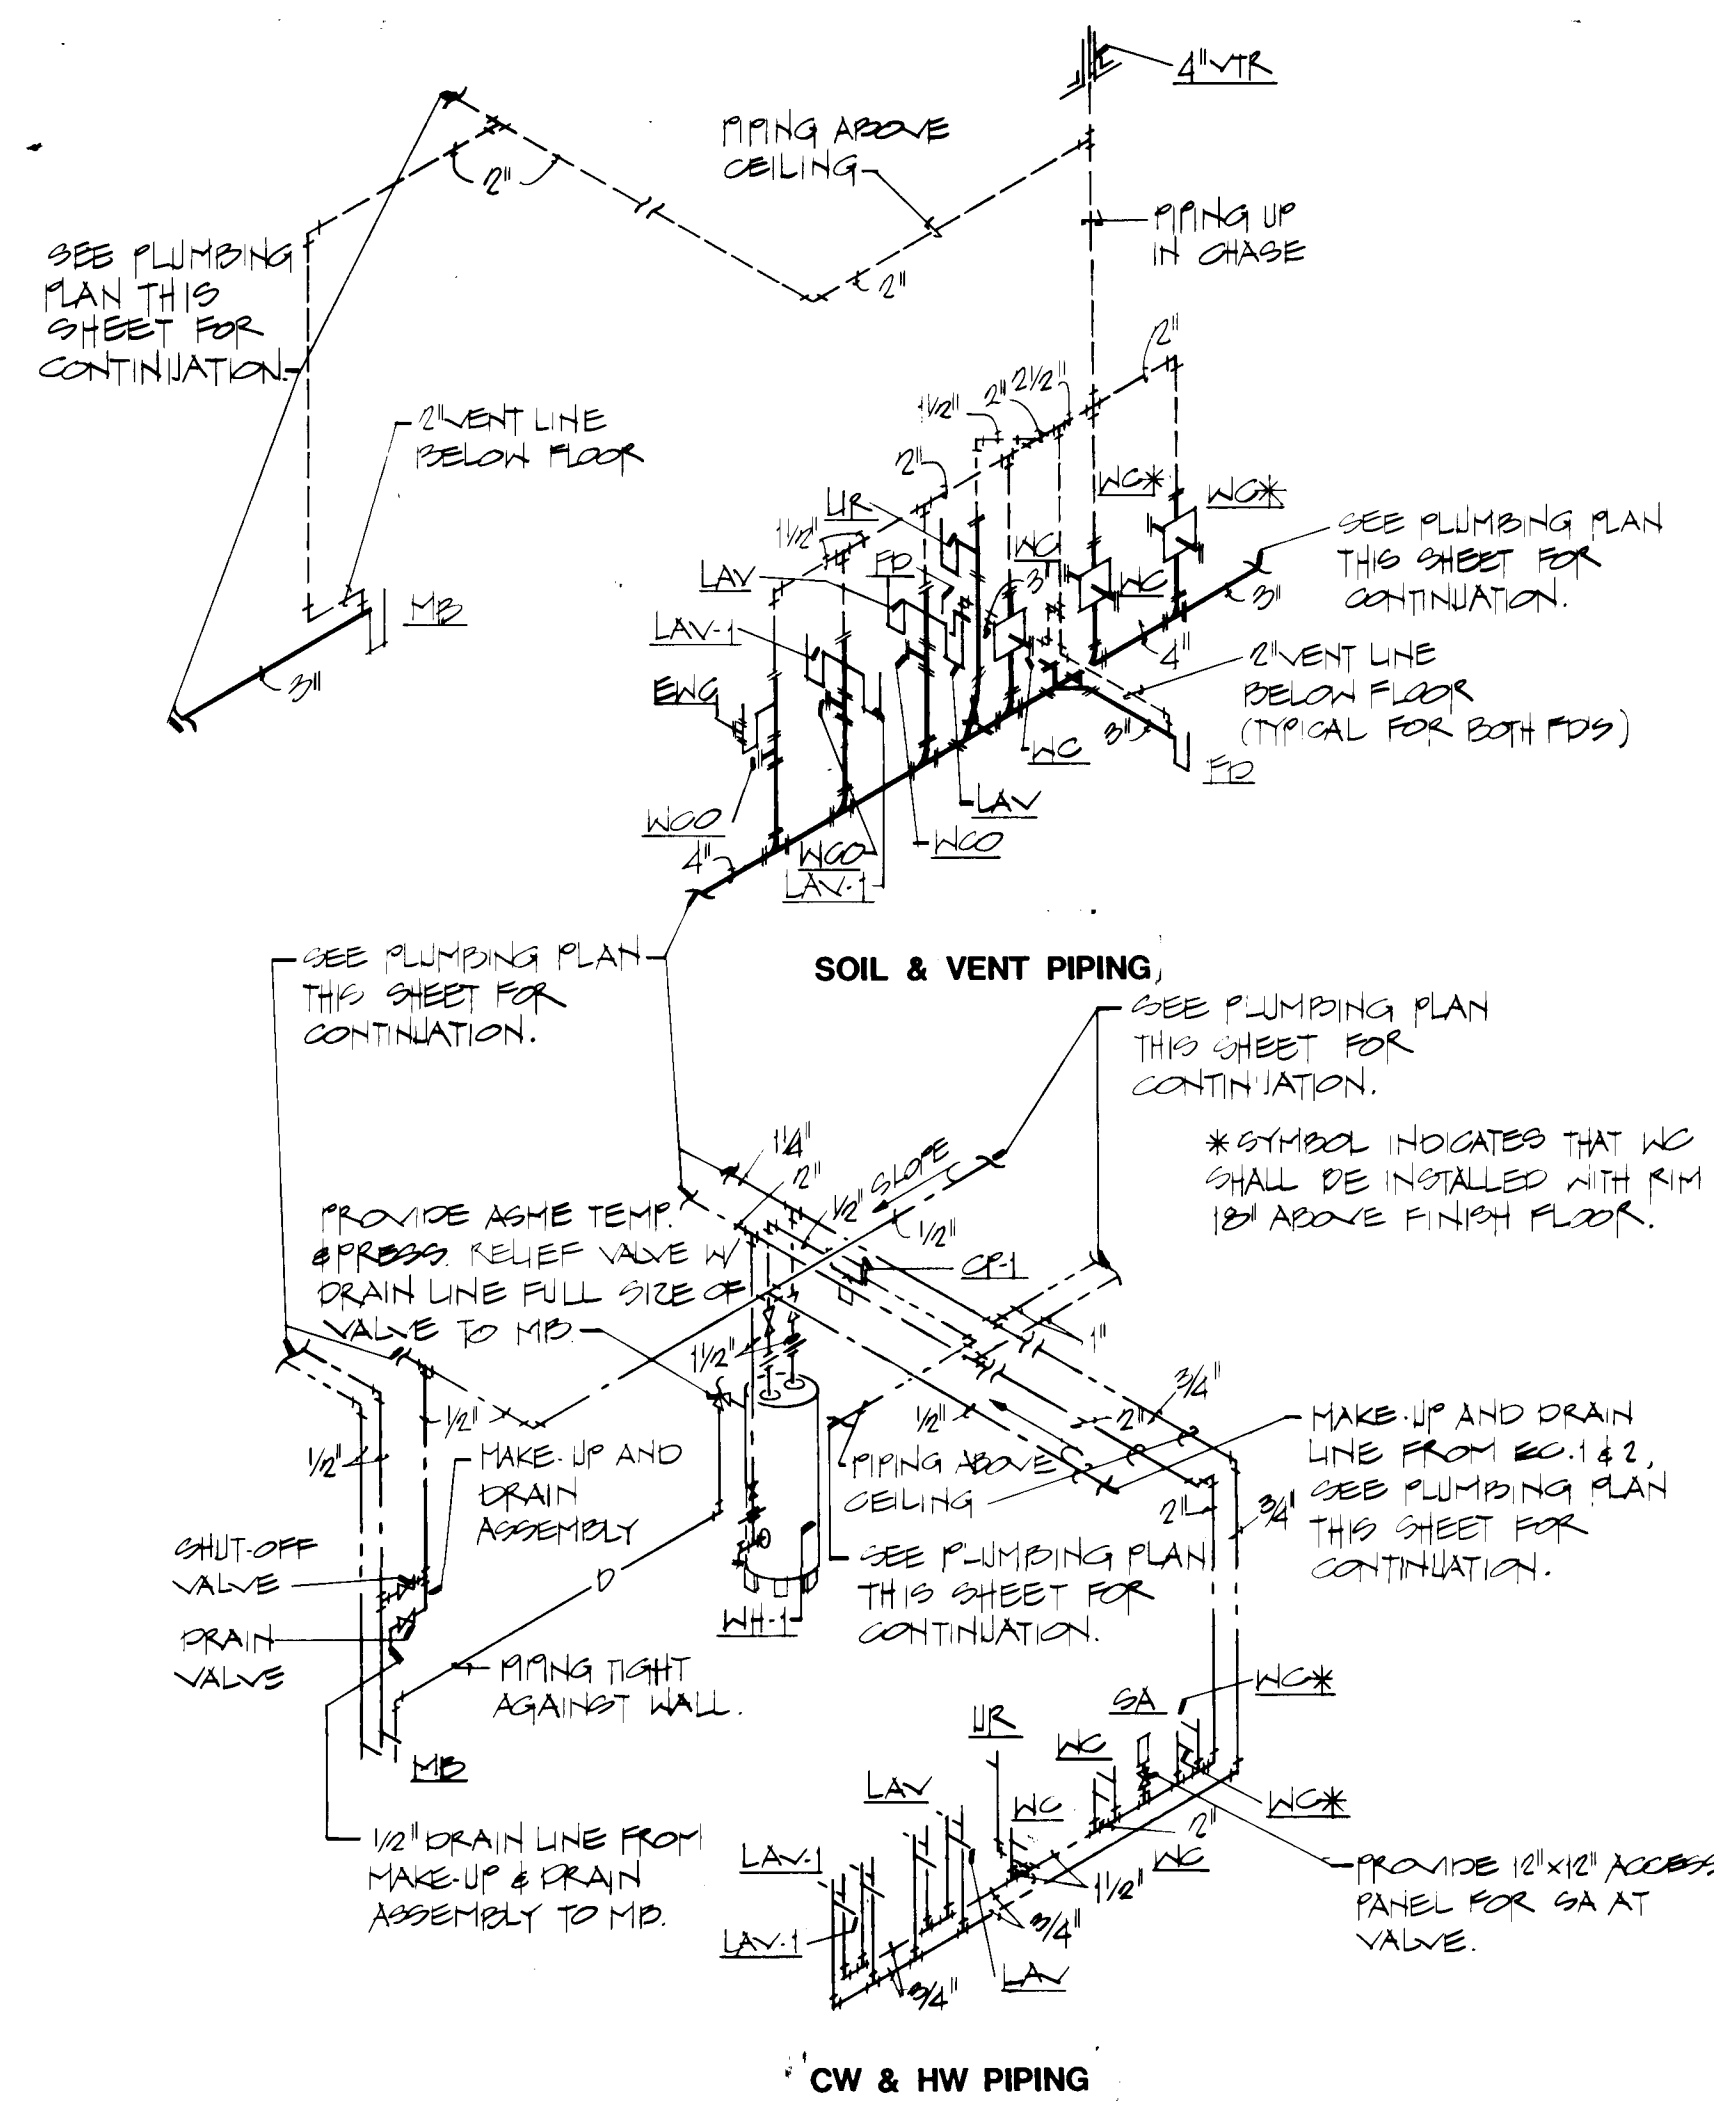


PLUMBING SCHEMATIC "A"
SCALE NONE

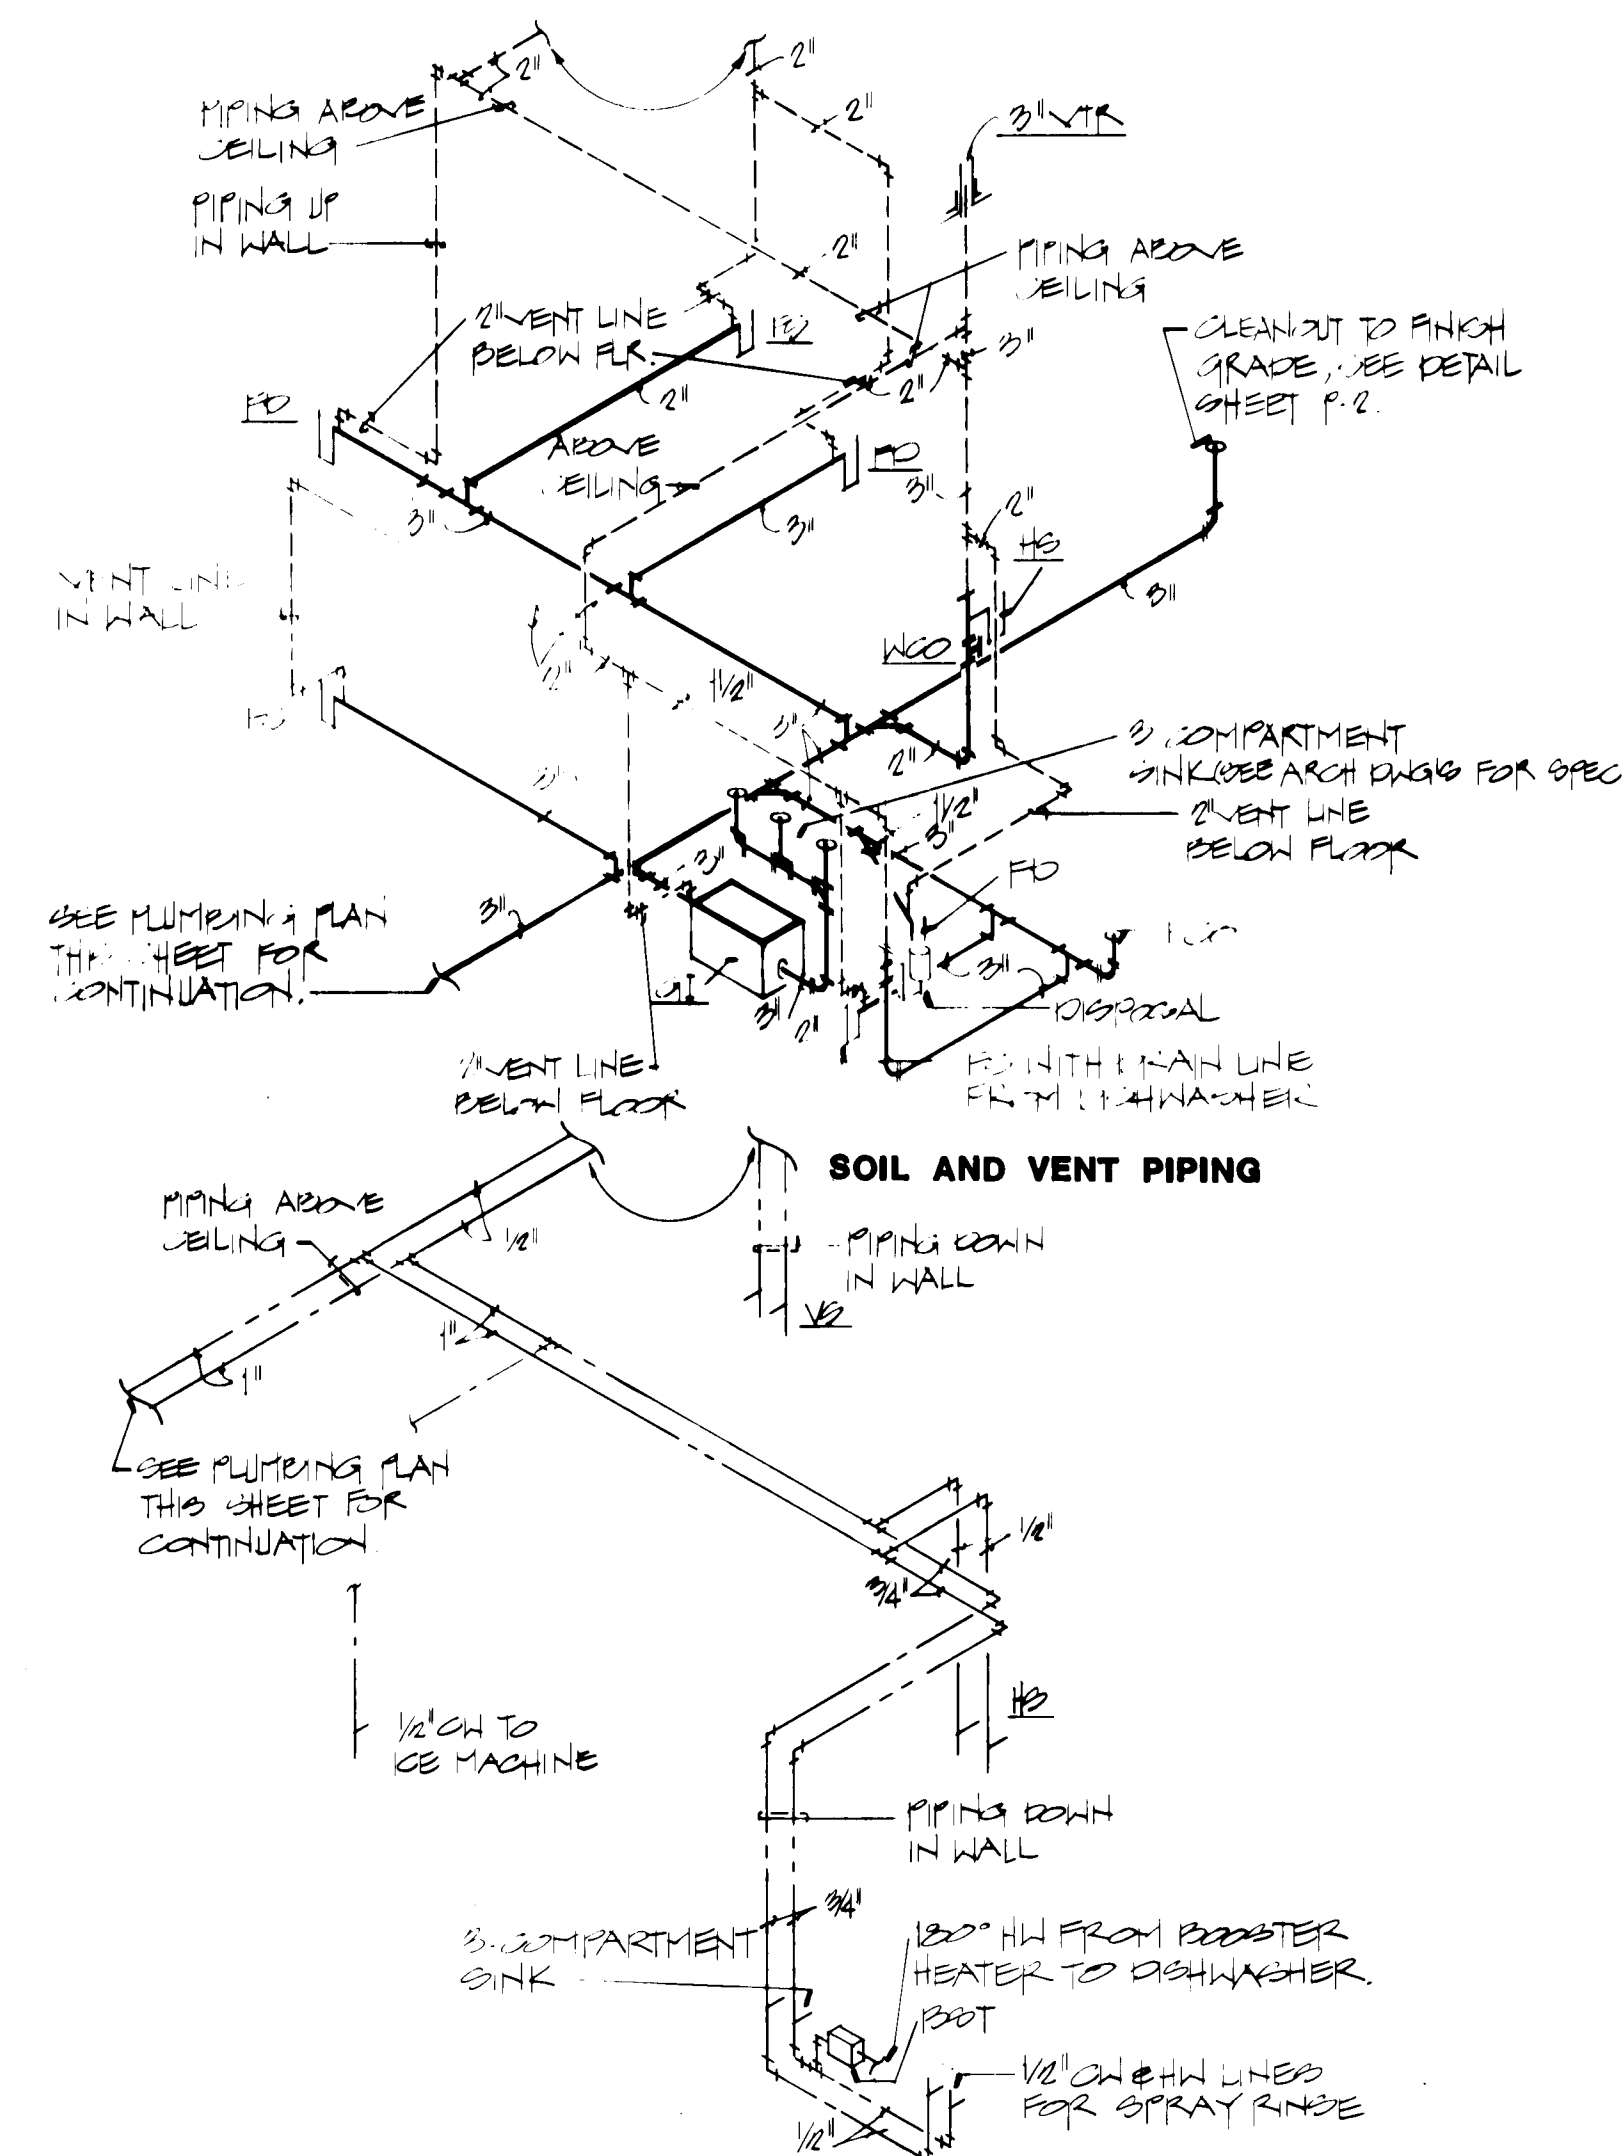

PLUMBING SCHEMATIC "B"
SCALE NONE

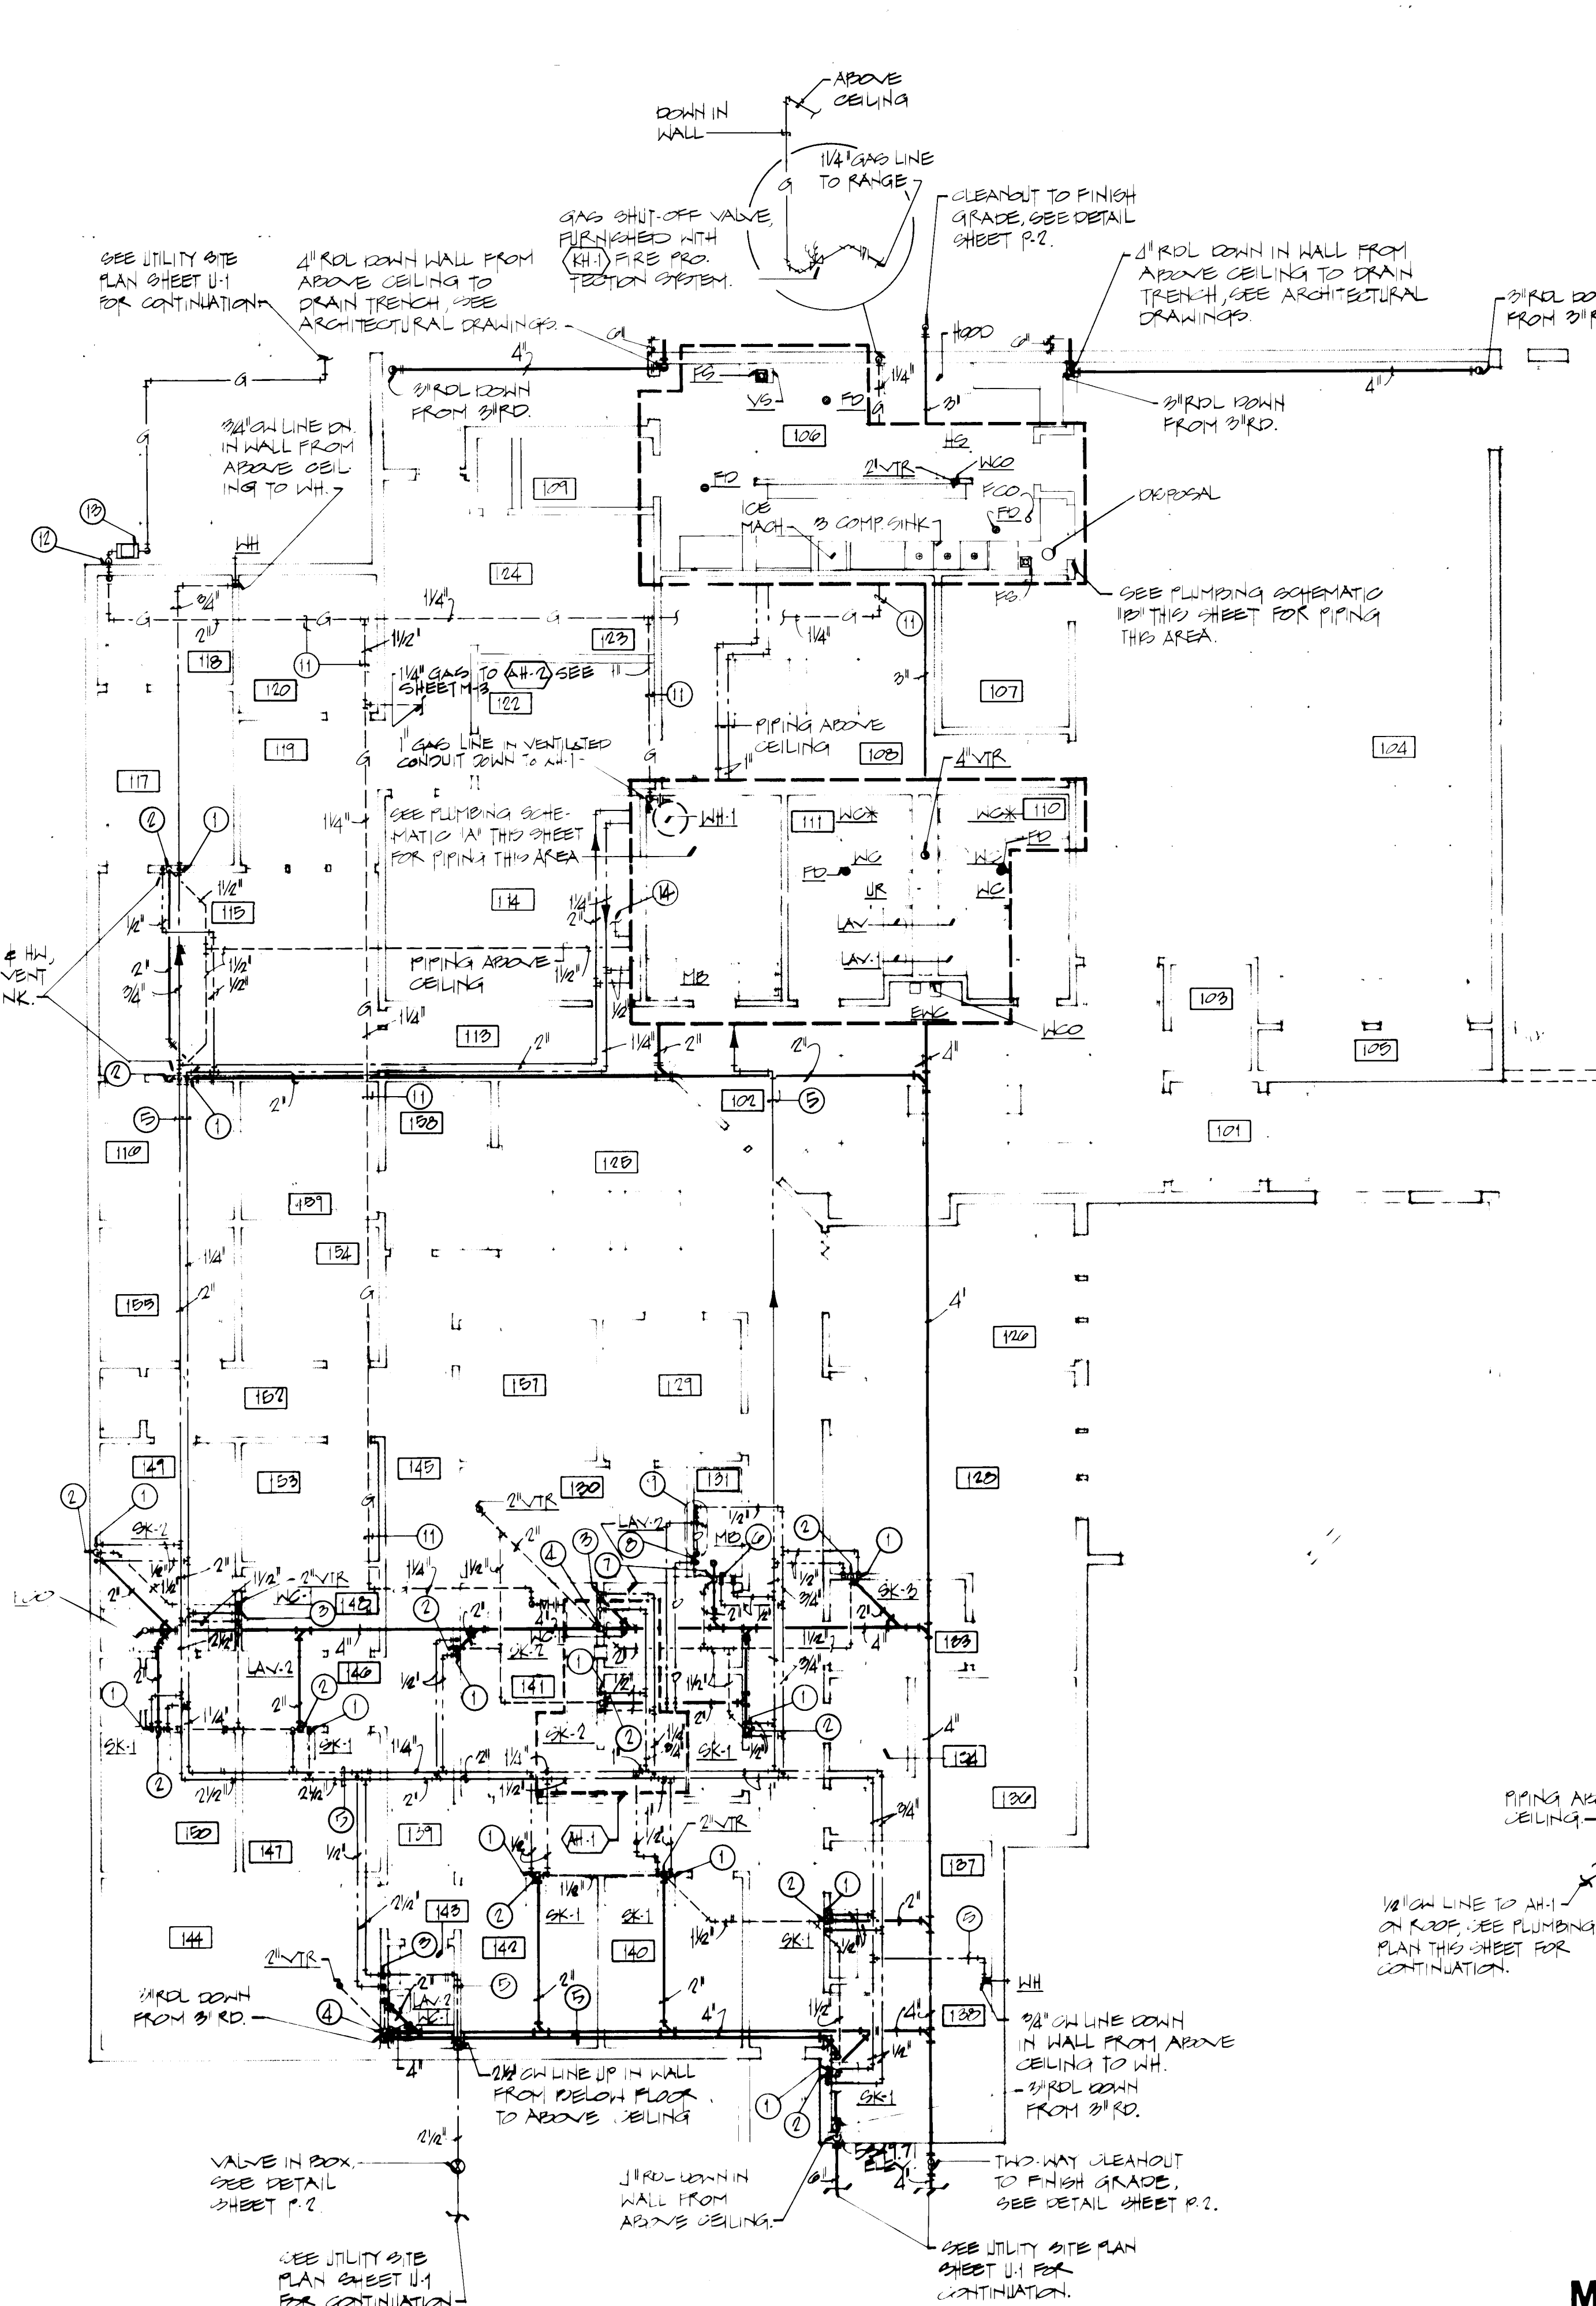

PLAN - PLUMBING
SCALE: 1/8" = 1'-0"

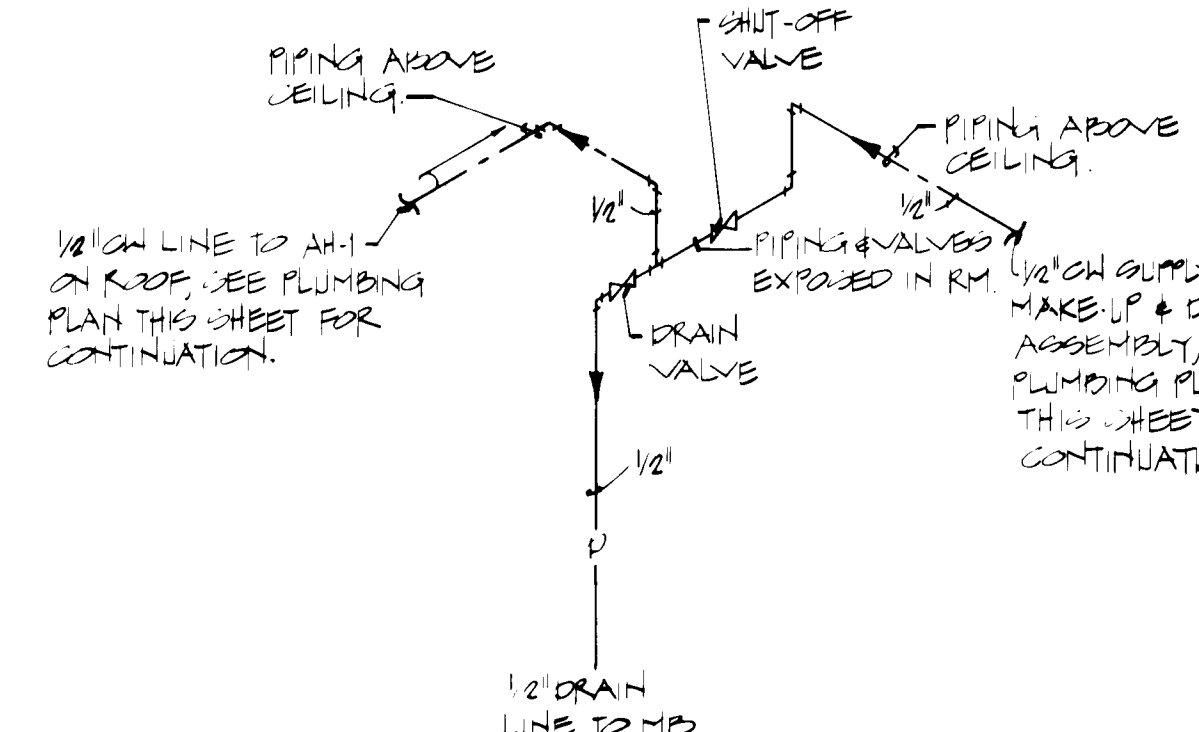

MAKE - UP & DRAIN ASSEMBLY DETAIL
SCALE NONE

26.1589.2984


NOTES

- 1/2" CW AND HW LINES DOWN IN WALL FROM ABOVE CEILING TO SINK.
- 1-1/2" VENT LINE UP IN WALL TO ABOVE CEILING.
- 1-1/2" CW AND 1/2" HW LINES DOWN IN WALL FROM ABOVE CEILING WITH 1" CW LINE TO WC-1 AND 1/2" CW AND HW LINES TO LAV-2.
- 2 VENT LINE UP IN WALL FROM WC-1, OFF-SET ABOVE CEILING TO 2 VTR.
- PIPING ABOVE CEILING.
- 1/2" CW AND HW LINES DOWN IN WALL FROM ABOVE CEILING SPACE TO ME.
- 2" VENT LINE UP IN WALL FROM ME TO ABOVE CEILING.
- 1" DRAIN LINE SERVING ME-1 ON ROOF DOWN ALONG WALL FROM ABOVE CEILING TO ME.
- MAKE-UP AND DRAIN ASSEMBLY, SEE SCHEMATIC THIS SHEET.
- 1/2" CW LINE UP TO ROOF FROM ME-1, OFF-SET ABOVE CEILING TO 2 VTR.
- GAS PIPING ON ROOF SUPPORT ON 4" X 4" TREATED WOOD SKIDS AT 10'-0" O.C.
- 2" GAS LINE UP ALONG WALL TO ROOF TOP. SUPPORT PIPING ON WALL AS REQUIRED.
- NEW GAS METER AND PRESSURE REGULATOR SET FOR 600 OPH AT 1" LEAVING WATER COLUMN. METER AND HIGH PRESSURE PIPING SHALL BE INSTALLED BY GAS COMPANY OF NEW MEXICO. MECHANICAL CONTRACTOR SHALL INCUR ALL COSTS OF METER AND HIGH PRESSURE PIPING.
- 1/2" CW LINE FOR ALTERNATE UNIT ME-2. SEE ALTERNATE PLAN SHEET P-2.

GENERAL NOTES

- PROVIDE WALL CLEANOUT BELOW ALL LAV-2, SINK, AND WC-1'S.
- COORDINATE ALL PIPING IN CEILING SPACE WITH SKYLIGHTS.
- FOR FIXTURE SCHEDULE, SEE SHEET P-2.
- FOR PLUMBING DETAILS, SEE SHEET P-2.
- FOR SYMBOL LEGEND, SEE SHEET P-2.




REVISIONS AS BUILT - AUG. 1984

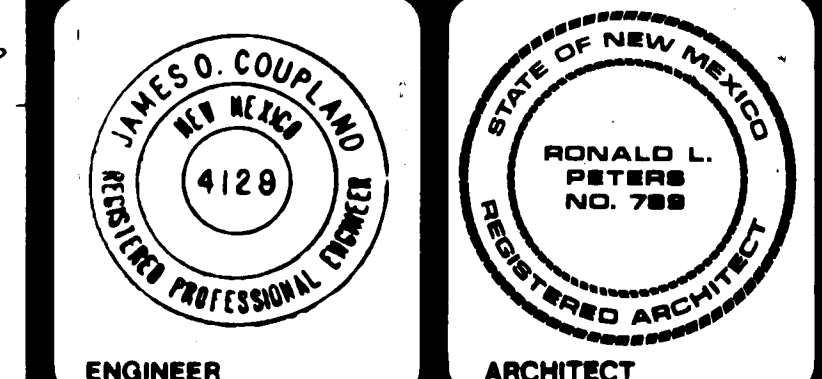

THE EAST-CENTRAL MULTI-SERVICE CENTER

PROJECT NO. 2906 DATE MAY 83

P1
SHEET 29 OF 30

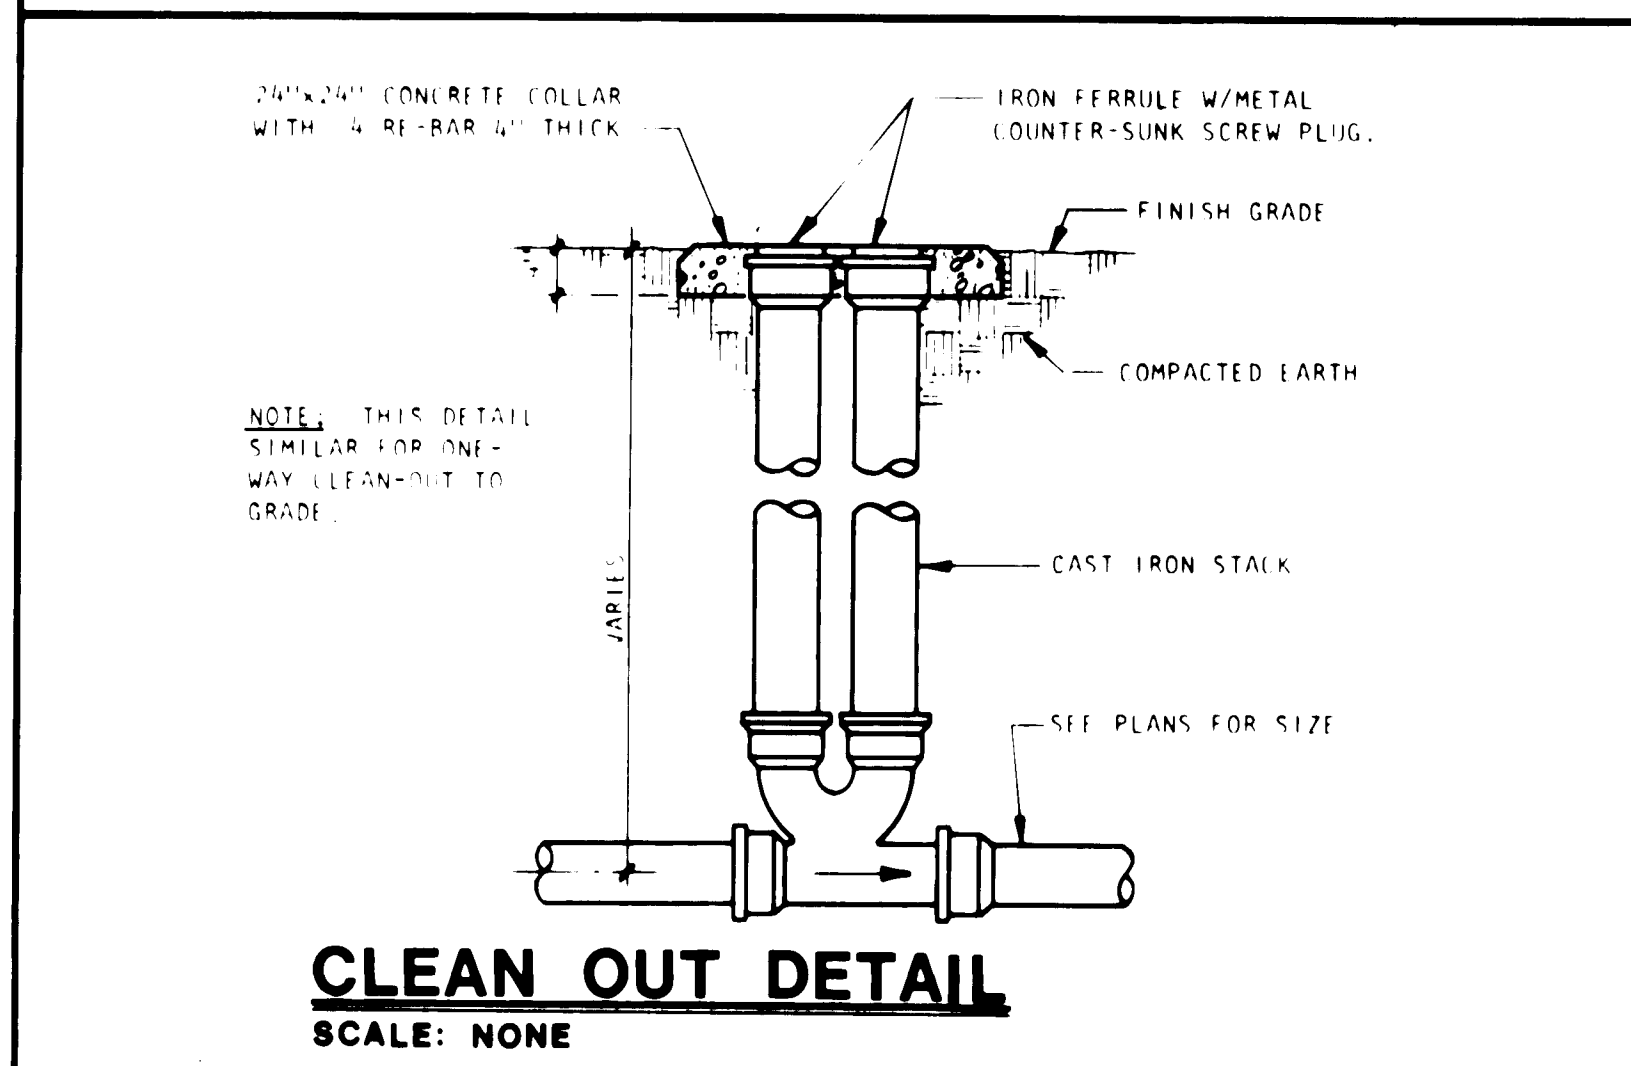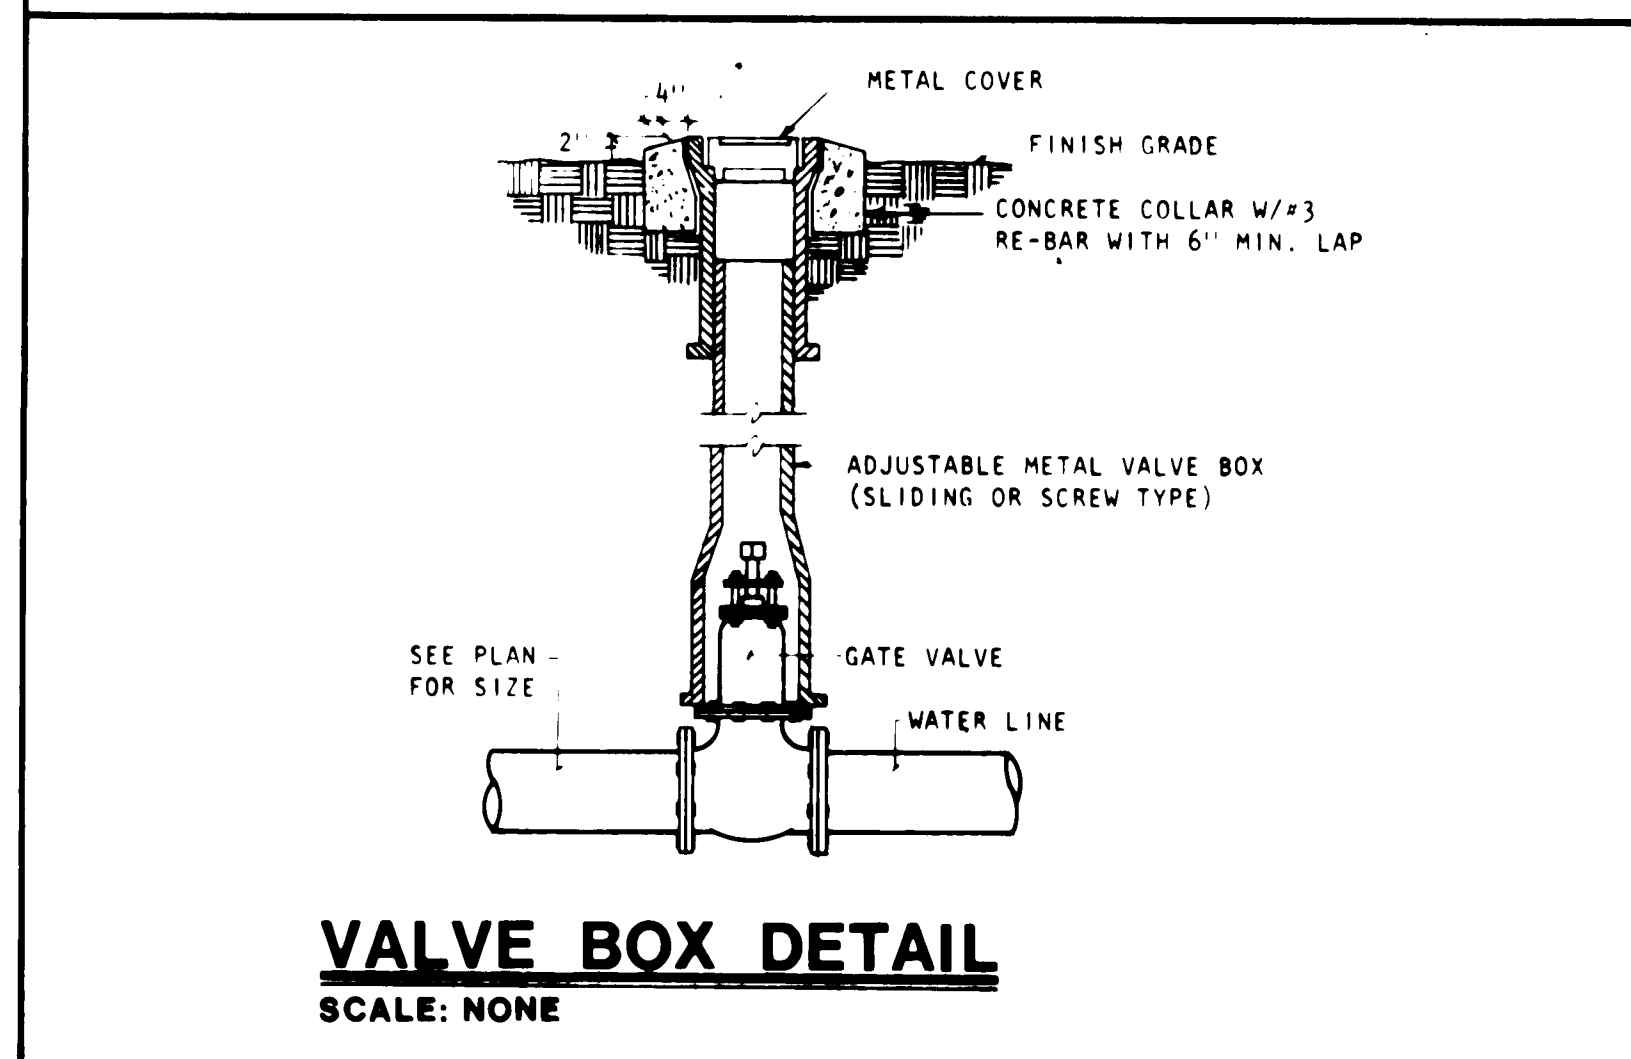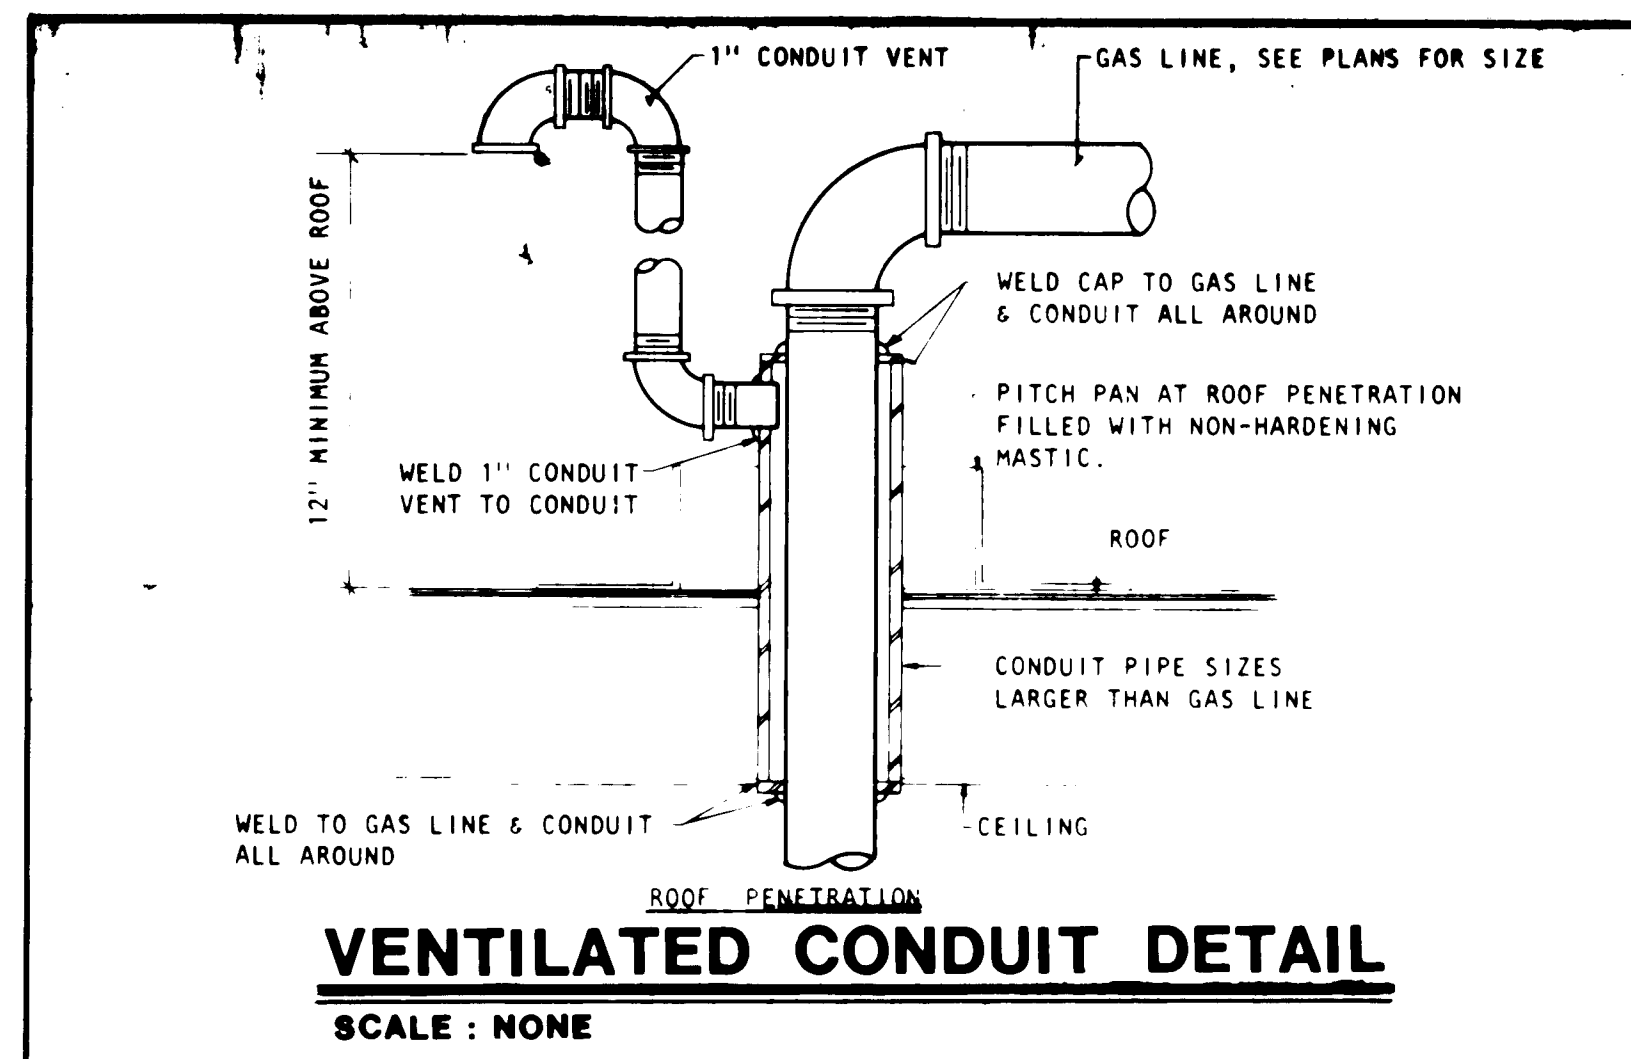

FIXTURE SCHEDULE			
SYMBOL	DESCRIPTION	SYMBOL	DESCRIPTION
SA	SHOCK ABSORBER: J.K. SMITH SERIES STAINLESS STEEL, SEALED AIR CHARGE, 1" IPS, PROPERLY SIZED FOR FIXTURE LOAD AT POINT OF INSTALLATION.	WC	WATER CLOSET: AMERICAN STANDARD "AFWALL" 2477.016 RIM FED SIPHON JET, ELONGATED RIM, 1 1/2" TOP SPUD, WALL HUNG BOWL, SLOW "ROYAL" 110-5 FLUSH VALVE WITH VACUUM BREAKER, 1" SCREWDRIVER ANGLE STOP AND FLUSH CONNECTION, SOLID WHITE PLASTIC SEAT WITH OPEN FRONT, EXTENDED BACK AND CHECK HINGE, LESS COVER, AND CONCEALED CLOSET CARRIER WITH 4" S.P.S. OUTLET CONNECTION.
RD	ROOF DRAIN: J.K. SMITH #1010 CAST IRON SUMP WITH FLANGE, EXTENSION, CAST IRON DERRIS DOME, DECK CLAMP, FLASHING RING & GRAVEL STOP. SIZE AS SHOWN ON DRAWINGS.	WC-1	WATER CLOSET: AMERICAN STANDARD "MADERA" 2221.018, WATER SAVER, SIPHON JET, VITREOUS CHINA, ELONGATED RIM, BOLT CAPS, 1 1/2" TOP SPUD, SLOW "ROYAL" 110-5 FLUSH VALVE WITH VACUUM BREAKER, 1" SCREWDRIVER ANGLE STOP AND FLUSH CONNECTION, SOLID WHITE PLASTIC SEAT WITH OPEN FRONT, EXTENDED BACK AND CHECK HINGE, LESS COVER.
WH	WALL HYDRONET: J.K. SMITH #1010 NON-PRESSURE ANTI-SIPHON, WITH POLISHED BRONZE FACE, BRASS CASTING AND REMOVABLE KEY.	UR	URINAL: AMERICAN STANDARD "VINTROOK" 6530.018, VITREOUS CHINA, BLOW-OUT WALL URINAL WITH INTEGRAL EXTENDED SHIELDS, FLUSHING RIM, 1 1/4" TOP SPUD, J.K. SMITH #1010 FLOOR SUPPORTED CARRIER, SLOW "ROYAL" 180 FLUSH VALVE WITH VACUUM BREAKER, SCREWDRIVER ANGLE STOP AND FLUSH CONNECTION.
WH-1	WATER HEATER: A.O. SMITH MODEL BT-100 "CONSERVATIONIST", GLASS-LINED TANK, AUTOMATIC SAFETY SHUT OFF, MAGNESIUM ANODE ROD, DRAIN VALVE, BIASED ENAMEL FINISH, A.G.A. CERTIFIED, GLASS FIBER INSULATION BETWEEN TANK AND SHELL, UNIT SHALL BE 100 GALLON STORAGE, WITH 72 GPM RECOVERY AT 100 DEGREE RISE WITH 80,000 BTU/H SEA LEVEL INPUT, 10 YEAR WARRANTY, COMPLETE WITH ANODE TEMPERATURE & PRESSURE RELIEF VALVE.	LAV	LAVATORY: AMERICAN STANDARD "AQUALYN" 0476.028 VITREOUS CHINA, SELF RIMMING COUNTERTOP LAVATORY WITH OVAL BASIN AND FRONT OVERFLOW, WITH ROYAL BRASS 1105A VANDALPROOF SLO-CLOS PUSHBUTTON FAUCET WITH 1/2 GPM FLOW RESTRICTOR, 2411.015 DRAIN WITH PERFORATED OPEN STRAINER, ANGLE SUPPLIES WITH LOOSE KEY STOP, ADJUSTABLE "PM" TRAP WITH WASTE-TO-WALL, LAVATORY SIZE 20" X 17".
CP-1	CIRCULATING PUMP: ALL BRONZE CONSTRUCTION, CARTRIDGE TYPE, IN LINE PUMP CAPABLE OF 3 GPM AGAINST 6 FOOT HEAD WITH 1/40 H.P., 120 V, SINGLE PHASE MOTOR, A.O. SMITH MODEL 45-10 PROVIDE ADJUST-STAT WITH UNIT.	LAV-1	LAVATORY: AMERICAN STANDARD "AQUALYN" 0476.028 VITREOUS CHINA, SELF RIMMING COUNTERTOP LAVATORY WITH OVAL BASIN AND FRONT OVERFLOW, WITH ROYAL BRASS 1105A VANDALPROOF SLO-CLOS PUSHBUTTON FAUCET WITH 1/2 GPM FLOW RESTRICTOR, 2411.015 DRAIN WITH PERFORATED OPEN STRAINER, ANGLE SUPPLIES WITH LOOSE KEY STOP, ADJUSTABLE "PM" TRAP WITH WASTE-TO-WALL, LAVATORY SIZE 20" X 17".
BST	BOOSTER: A.O. SMITH MODEL 471-1 BOOSTER HEATER SET TO DELIVER 180" WATER. 9 KW.	LAV-2	LAVATORY: AMERICAN STANDARD "AQUALYN" 0476.028 VITREOUS CHINA LAVATORY WITH BACK, RECTANGULAR BASIN, SPLASH LIP, FRONT OVERFLOW, SOAP DEPRESSION, DRILLED FOR J.K. SMITH #1010 FLOOR SUPPORTED CARRIER WITH CONCEALED ARMS, ROYAL BRASS 1105A VANDALPROOF SLO-CLOS PUSH BUTTON FAUCET WITH 1/2 GPM FLOW RESTRICTOR, 2411.015 DRAIN WITH PERFORATED STRAINER, ANGLE SUPPLIES WITH LOOSE KEY STOP, AND CAST BRASS ADJUSTABLE "PM" TRAP WITH WASTE TO WALL, LAVATORY SIZE 20" X 18".
SYMBOL LEGEND			
SYMBOL	DESCRIPTION	SYMBOL	DESCRIPTION
---	FIRE PROTECTION	VER	VENT THRU ROOF
---	COLD WATER LINE	FD	FIRE DAMPER
---	HOT WATER LINE	FC	FLEXIBLE CONNECTION
---	CIRCULATING HOT WATER	AL	ACOUSTICAL LINING
---	VENT PIPING	TV	TURNING VANES
---	SOIL LINE	AD	ACCESS DOOR
---	SOIL LINE (EXISTING)	GV	GATE VALVE
---	GAS LINE	GV	GLOBE VALVE
---	GAS LINE (EXISTING)	CV	CHECK VALVE
---	WATER LINE	BV	BALANCING OR PLUG VALVE
---	WATER LINE (EXISTING)	WV	WELDED VALVE
---	ADMITTED AIR	WV	WELDED VALVE
---	DRAIN LINE	WV	WELDED VALVE
---	CHILLED WATER SUPPLY	WV	WELDED VALVE
---	CHILLED WATER RETURN	WV	WELDED VALVE
---	HOT WATER SUPPLY	WV	WELDED VALVE
---	HOT WATER RETURN	WV	WELDED VALVE
---	CONDENSING WATER SUPPLY	WV	WELDED VALVE
---	CONDENSING WATER RETURN	WV	WELDED VALVE
---	REFRIGERANT SUCTION	WV	WELDED VALVE
---	REFRIGERANT LIQUID	WV	WELDED VALVE
---	REFRIGERANT HOT GAS	WV	WELDED VALVE
---	ROOF DRAIN LEADER	WV	WELDED VALVE
---	OVER FLOW LEADER	WV	WELDED VALVE
---	BALANCING DAMPER	WV	WELDED VALVE

SYMBOL	DESCRIPTION	SYMBOL	DESCRIPTION
WC	WATER CLOSET: AMERICAN STANDARD "AFWALL" 2477.016 RIM FED SIPHON JET, ELONGATED RIM, 1 1/2" TOP SPUD, WALL HUNG BOWL, SLOW "ROYAL" 110-5 FLUSH VALVE WITH VACUUM BREAKER, 1" SCREWDRIVER ANGLE STOP AND FLUSH CONNECTION, SOLID WHITE PLASTIC SEAT WITH OPEN FRONT, EXTENDED BACK AND CHECK HINGE, LESS COVER, AND CONCEALED CLOSET CARRIER WITH 4" S.P.S. OUTLET CONNECTION.	WC-1	WATER CLOSET: AMERICAN STANDARD "MADERA" 2221.018, WATER SAVER, SIPHON JET, VITREOUS CHINA, ELONGATED RIM, BOLT CAPS, 1 1/2" TOP SPUD, SLOW "ROYAL" 110-5 FLUSH VALVE WITH VACUUM BREAKER, 1" SCREWDRIVER ANGLE STOP AND FLUSH CONNECTION, SOLID WHITE PLASTIC SEAT WITH OPEN FRONT, EXTENDED BACK AND CHECK HINGE, LESS COVER.
UR	URINAL: AMERICAN STANDARD "VINTROOK" 6530.018, VITREOUS CHINA, BLOW-OUT WALL URINAL WITH INTEGRAL EXTENDED SHIELDS, FLUSHING RIM, 1 1/4" TOP SPUD, J.K. SMITH #1010 FLOOR SUPPORTED CARRIER, SLOW "ROYAL" 180 FLUSH VALVE WITH VACUUM BREAKER, SCREWDRIVER ANGLE STOP AND FLUSH CONNECTION.	LAV	LAVATORY: AMERICAN STANDARD "AQUALYN" 0476.028 VITREOUS CHINA, SELF RIMMING COUNTERTOP LAVATORY WITH OVAL BASIN AND FRONT OVERFLOW, WITH ROYAL BRASS 1105A VANDALPROOF SLO-CLOS PUSHBUTTON FAUCET WITH 1/2 GPM FLOW RESTRICTOR, 2411.015 DRAIN WITH PERFORATED OPEN STRAINER, ANGLE SUPPLIES WITH LOOSE KEY STOP, ADJUSTABLE "PM" TRAP WITH WASTE-TO-WALL, LAVATORY SIZE 20" X 17".
LAV	LAVATORY: AMERICAN STANDARD "AQUALYN" 0476.028 VITREOUS CHINA, SELF RIMMING COUNTERTOP LAVATORY WITH OVAL BASIN AND FRONT OVERFLOW, WITH ROYAL BRASS 1105A VANDALPROOF SLO-CLOS PUSHBUTTON FAUCET WITH 1/2 GPM FLOW RESTRICTOR, 2411.015 DRAIN WITH PERFORATED OPEN STRAINER, ANGLE SUPPLIES WITH LOOSE KEY STOP, ADJUSTABLE "PM" TRAP WITH WASTE-TO-WALL, LAVATORY SIZE 20" X 17".	LAV-1	LAVATORY: AMERICAN STANDARD "AQUALYN" 0476.028 VITREOUS CHINA, SELF RIMMING COUNTERTOP LAVATORY WITH OVAL BASIN AND FRONT OVERFLOW, WITH ROYAL BRASS 1105A VANDALPROOF SLO-CLOS PUSHBUTTON FAUCET WITH 1/2 GPM FLOW RESTRICTOR, 2411.015 DRAIN WITH PERFORATED OPEN STRAINER, ANGLE SUPPLIES WITH LOOSE KEY STOP, ADJUSTABLE "PM" TRAP WITH WASTE-TO-WALL, LAVATORY SIZE 20" X 17".
LAV-1	LAVATORY: AMERICAN STANDARD "AQUALYN" 0476.028 VITREOUS CHINA, SELF RIMMING COUNTERTOP LAVATORY WITH OVAL BASIN AND FRONT OVERFLOW, WITH ROYAL BRASS 1105A VANDALPROOF SLO-CLOS PUSHBUTTON FAUCET WITH 1/2 GPM FLOW RESTRICTOR, 2411.015 DRAIN WITH PERFORATED OPEN STRAINER, ANGLE SUPPLIES WITH LOOSE KEY STOP, ADJUSTABLE "PM" TRAP WITH WASTE-TO-WALL, LAVATORY SIZE 20" X 17".	LAV-2	LAVATORY: AMERICAN STANDARD "AQUALYN" 0476.028 VITREOUS CHINA LAVATORY WITH BACK, RECTANGULAR BASIN, SPLASH LIP, FRONT OVERFLOW, SOAP DEPRESSION, DRILLED FOR J.K. SMITH #1010 FLOOR SUPPORTED CARRIER WITH CONCEALED ARMS, ROYAL BRASS 1105A VANDALPROOF SLO-CLOS PUSH BUTTON FAUCET WITH 1/2 GPM FLOW RESTRICTOR, 2411.015 DRAIN WITH PERFORATED STRAINER, ANGLE SUPPLIES WITH LOOSE KEY STOP, AND CAST BRASS ADJUSTABLE "PM" TRAP WITH WASTE TO WALL, LAVATORY SIZE 20" X 18".
SK-1	SINK: J.K. SMITH #1010 2477.016 SINGLE COMPARTMENT SINK, 18 GAUGE TYPE 302 STAINLESS STEEL, SELF RIMMING, UNDERSIDE UNDERCOATED, SINGLE FAUCET HOLE, J.K. SMITH #1010 DUAL HANDLE FAUCET WITH GOOSENECK SWING SPOUT, 2-35 DRAIN STRAINER WITH BASKET, ANGLE SUPPLIES WITH LOOSE KEY STOP, INDIRECT WASTE TO FLOOR SINK, SINK SIZE 22" X 22" X 12" DEEP.	SK-2	SINK: J.K. SMITH #1010 2477.016 SINGLE COMPARTMENT 18 GAUGE TYPE 304 STAINLESS STEEL, SELF RIMMING, UNDERSIDE UNDERCOATED, J.K. SMITH #1010 DUAL HANDLE FAUCET WITH GOOSENECK SWING SPOUT, 2-35 DRAIN STRAINER WITH BASKET, ANGLE SUPPLIES WITH LOOSE KEY STOP, INDIRECT WASTE TO FLOOR SINK, SINK SIZE 22" X 22" X 12" DEEP.
SK-2	SINK: J.K. SMITH #1010 2477.016 SINGLE COMPARTMENT 18 GAUGE TYPE 304 STAINLESS STEEL, SELF RIMMING, UNDERSIDE UNDERCOATED, J.K. SMITH #1010 DUAL HANDLE FAUCET WITH GOOSENECK SWING SPOUT, 2-35 DRAIN STRAINER WITH BASKET, ANGLE SUPPLIES WITH LOOSE KEY STOP, INDIRECT WASTE TO FLOOR SINK, SINK SIZE 22" X 22" X 12" DEEP.	SK-3	SINK: J.K. SMITH #1010 2477.016 DOUBLE COMPARTMENT 18 GAUGE TYPE 304 STAINLESS STEEL, SELF RIMMING, UNDERSIDE UNDERCOATED, J.K. SMITH #1010 DUAL HANDLE FAUCET WITH GOOSENECK SWING SPOUT, 2-35 DRAIN STRAINER WITH BASKET, ANGLE SUPPLIES WITH LOOSE KEY STOP, INDIRECT WASTE TO FLOOR SINK, SINK SIZE 22" X 22" X 12" DEEP.
MB	MOP BASIN: J.K. SMITH #1010 2477.016 MOP BASIN, 36" X 24" X 10" DEEP, CONSTRUCTED OF MOLDED STONE, UNIT SHALL HAVE 10" HIGH WALLS, NOT LESS THAN 1" WIDE SHOULDERS, COMPLETE WITH DRAIN BODY WITH LOCKOUT, NEOPRENE GASKETS AND COMBINATION DOME STRAINER-LINT BASKET CONSTRUCTED OF 302 16-GAUGE STAINLESS STEEL, T-18V-10 SUPPLY FITTING WITH VACUUM BREAKER, INTEGRAL STOP, ADJUSTABLE WALL BRACE, PAIL HOOK AND 3/4" HOSE THREAD ON SPOUT AND T-40 MOP HANGER.	ENC	ELECTRIC WATER COOLER: J.K. SMITH #1010 2477.016 UNIT SHALL BE CONSTRUCTED OF 18 GAUGE TYPE 304 STAINLESS STEEL, SOLID BRASS "M" BUBBLER, SELF-CLOSING VALVE WITH DUAL LEVER HANDLES, HERMETICALLY SEALED 1/4 HP, 115 VOLT, SINGLE PHASE COMPRESSOR, CAPABLE OF DELIVERING 7.5 GPM OF 50°F WATER AT A ROOM TEMPERATURE OF 90°F. ANGLE SUPPLY WITH LOOSE KEY STOP, ADJUSTABLE "PM" TRAP WITH WASTE TO WALL, UNIT SHALL BE COMPLETELY FACTORY PIPED, WIRED AND ASSEMBLED.
HS	LAVATORY: AMERICAN STANDARD "AQUALYN" 0476.028 VITREOUS CHINA LAVATORY WITH BACK, RECTANGULAR BASIN, SPLASH LIP, FRONT OVERFLOW, SOAP DEPRESSION, DRILLED FOR J.K. SMITH #1010 FLOOR SUPPORTED CARRIER WITH CONCEALED ARMS, ROYAL BRASS 1105A VANDALPROOF SLO-CLOS PUSH BUTTON FAUCET WITH 1/2 GPM FLOW RESTRICTOR, 2411.015 DRAIN WITH PERFORATED STRAINER, ANGLE SUPPLIES WITH LOOSE KEY STOP, AND CAST BRASS ADJUSTABLE "PM" TRAP WITH WASTE TO WALL, LAVATORY SIZE 20" X 18".	VS	VEGETABLE SINK: SAME AS SK-2 ABOVE EXCEPT 24" X 18" MODEL.
VS	VEGETABLE SINK: SAME AS SK-2 ABOVE EXCEPT 24" X 18" MODEL.	G1	GREASE INTERCEPTOR: J.K. SMITH #1010 2477.016 CAPABLE OF 20 GPM AND 40 POUNDS OF GREASE, COMPLETE WITH FLOW CONTROL FITTING AND ALL ACCESSORIES REQUIRED FOR A COMPLETE OPERATING UNIT, COMPLETE WITH EXTENSION AS REQUIRED. 3" INLET, 3" OUTLET.
FD	FLOOR DRAIN: J.K. SMITH #1010 2477.016 CAST IRON BODY WITH NICKEL BRASS STRAINER, CLAMPING COLLAR AND VANDALPROOF SCREWS.	FS	FLOOR SINK: J.K. SMITH #1010 2477.016 CAST IRON, ACID RESISTING ENAMEL INTERIOR, ALUMINUM DOME STRAINER & NICKEL BRASS TOP, GRATE AS NOTED ON DRAWINGS.
WCO	WALL CLEANOUT: J.K. SMITH #1010 2477.016 C.O. TEE WITH BRASS PLUG AND ROUND STAINLESS STEEL ACCESS COVER WITH VANDALPROOF SCREW.	FDO	FLOOR CLEANOUT: J.K. SMITH #1010 2477.016 CAST IRON, WITH ROUND NICKEL BRASS SODIATED TOP AND VANDALPROOF SCREWS.

THE BURNS PETERS GROUP
ARCHITECTS PLANNERS

NOTES

REVISIONS AS BUILT - AUG. 1984

BURNS/PETERS GROUP ARCHITECTS
RECORD DRAWING
DATE 12 SEPT 84
R. L. BURNETT

ENGINEER


ARCHITECT

THE EAST-CENTRAL MULTI-SERVICE CENTER

PROJECT NO. 8205 DATE MAR 83

P2
SHEET 30 OF 36

26 1589 3084

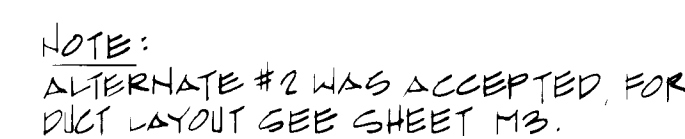

BURNS/PETERS GROUP-ARCHITECTS
RECORD DRAWING
DATE: 12 SEPT 84

GENERAL NOTES


- REQUIRE EXHAUSTIVE DOORS TO SHADE WITH AN ONE LAG MOLTS 16
- REQUIRED SEC MECHANICAL DRAWING FOR DUCT DETAIL
- DUCTWORK FROM $(N-1)$ SHALL BE LINED WITH 1" ADDITIONAL LINING. THE CONDITIONS ON THE DRAWINGS SHALL BE CLEAR INSIDE DIMENSION OF THE DUCT WITH ADDITIONAL LINING, NOT THE OUTSIDE DIMENSION OF THE SHEATHING.
- NOT MORE THAN 5'-0" SECTION OF FLEXIBLE DUCT SHALL BE USED.
- COORDINATE CEILING OF PLUMBING WITH CEILING GRID & LIGHTING
- COORDINATE ALL DUCT RUNS WITH STRUCTURAL

26 1589 3184

NOTES ()

- 1 ED-1 10" x 12" 350 CFM EACH.
2
3 ~~10" x 12" EXHAUST DUCT THRU ROOF~~
4 ~~TO~~
5 ~~10" x 12" EXHAUST DUCT THRU ROOF~~
6 ~~TO~~
7 ~~10" x 12" EXHAUST DUCT THRU ROOF~~
8 ~~TO~~
9 ~~10" x 12" EXHAUST DUCT THRU ROOF~~
10 ~~TO~~
11 ~~10" x 12" EXHAUST DUCT THRU ROOF~~
12 ~~TO~~
13 ~~10" x 12" EXHAUST DUCT THRU ROOF~~
14 ~~TO~~
15 ~~10" x 12" EXHAUST DUCT THRU ROOF~~
16 ~~TO~~
17 ~~10" x 12" EXHAUST DUCT THRU ROOF~~
18 ~~TO~~
19 ~~10" x 12" EXHAUST DUCT THRU ROOF~~
20 ~~TO~~
21 (2) 10" x 4" COMBUSTION AIR DUCTS
22 TERMINATE @ 12" BELOW CEILING, THE OTHER @ 12"
23 BELOW FINISH FLOOR.
24 10" x 12" EXHAUST DUCT THRU ROOF
25 10" x 12" EXHAUST DUCT THRU ROOF
REVISIONS AS BUILT - AUG - 1984

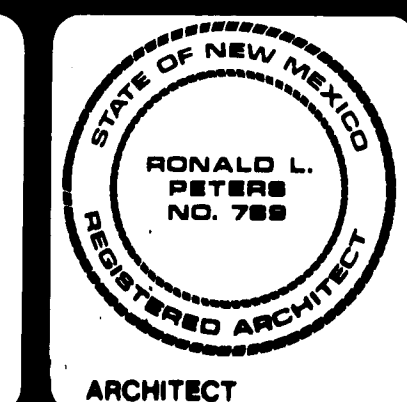


**THE
EAST-CENTRAL
MULTI-SERVICE
CENTER**

PROJECT NO. 8705

DATE MAY 1 88

M1
SHEET 31 OF 36

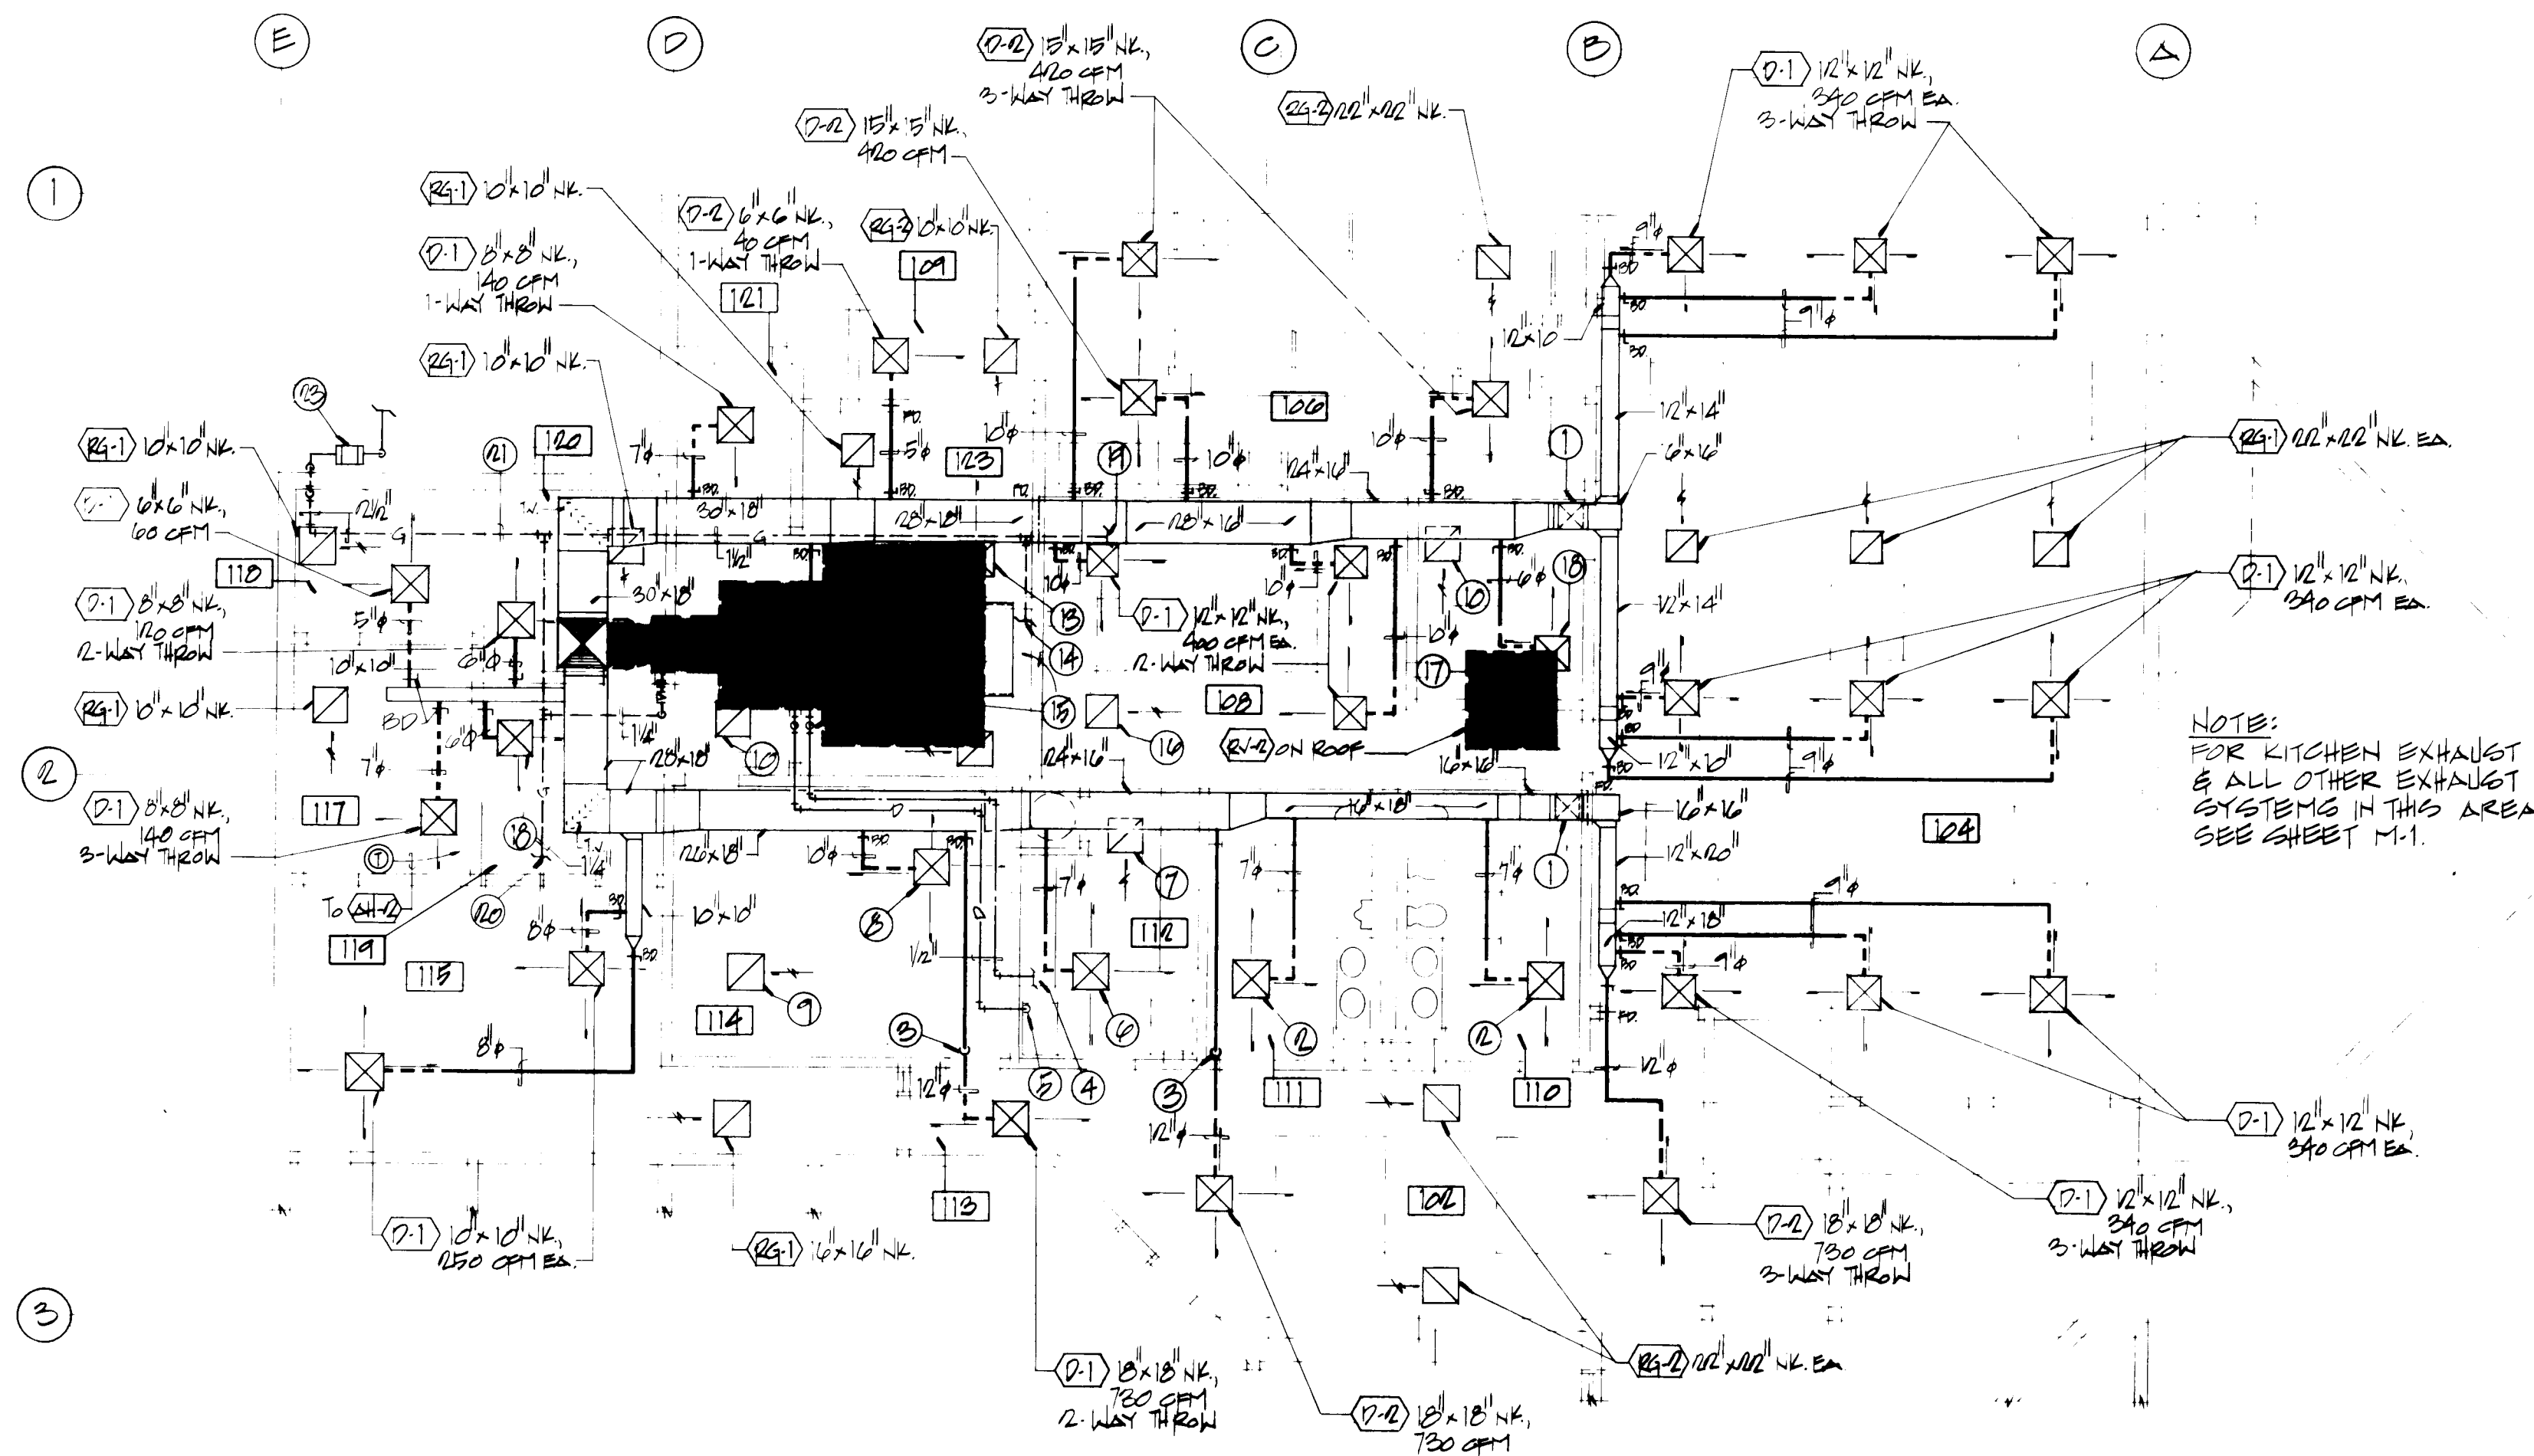

PARTIAL PLAN-MECHANICAL-ALTERNATE NO 2
SCALE: 1/8" = 1'-0"

NOTES

- 1 RISE 16"x16" SUPPLY DUCT UP BETWEEN JOISTS.
- 2 D-2 9"x9" NK., 185 CFM. 3-WAY THROW.
- 3 RISE 12" FLEXIBLE DUCT UP IN JOIST SPACE OVER TO CEILING DIFFUSER.
- 4 1/2" CW LINE RUN IN CEILING SPACE TO AH-2 ON ROOF. SEE SHEET P-1.
- 5 1/2" DRAIN LINE RUN IN CEILING SPACE FROM AH-2 DOWN IN WALL TO MOP BASIN.
- 6 D-2 9"x9" NK., 190 CFM. 3-WAY THROW.
- 7 RG-2 10"x10" NK.
- 8 D-1 12"x12" NK., 370 CFM.
- 9 RG-1 14"x14" NK.
- 10 RG-1 10"x10" NK.
- 11 1/2" CW & DRAIN LINE THRU ROOF TO AH-2 ON ROOF.
- 12 D-1 8"x8" NK., 130 CFM. 2-WAY THROW.
- 13 D-1 8"x8" NK., 140 CFM. 2-WAY THROW.
- 14 1" GAS LINE TO WH-1 SAME AS ON PLUMBING PLAN SHEET P-1.
- 15 60"x24" RETURN AIR DUCT THRU ROOF TO 60"x24" SOUND BOOT W/1 A.L. W/90° ELBOW BELOW JOISTS.
- 16 RG-1 22"x22" NK.
- 17 42"x36" RELIEF AIR OPENING THRU ROOF TO RV-2 ON ROOF.
- 18 D-1 8"x8" NK., 120 CFM. 2-WAY THROW.
- 19 1/4" GAS LINE TO KITCHEN RANGE SAME AS ON PLUMBING PLAN SHEET P-1.
- 20 1/4" GAS LINE TO AH-1 SAME AS ON PLUMBING PLAN SHEET P-1.
- 21 GAS PIPING ON ROOF SUPPORT ON 4"x4" TREATED WOOD SKIDS AT 10'-0" O.C.
- 22 32"x32" THRU ROOF BETWEEN JOISTS TO AH-2 ON ROOF.
- 23 SAME AS NOTE 13 ON PLUMBING PLAN SHEET P-1.


BURNS/PETERS GROUP-ARCHITECTS

RECORD DRAWING

DATE 12 SEPT 84

BY J. C. C. ELO

REVISIONS AS BUILT AUG. 1984

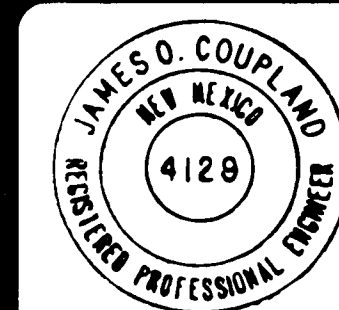

ENGINEER

ARCHITECT

**THE EAST-CENTRAL
MULTI-SERVICE
CENTER**

PROJECT NO.

DATE

MAY 88

M3

SHEET 28 OF 28

26 1589 3384

* 1-HOUR ROOF CEILING ASSEMBLY
* * SEE ENLARGED PLAN FOR EXTENT OF WR GYP PL.

SEE RHT A5 FOR REFLECTED
CEILING PLAN




 1/2" HOLE
 3/8" METAL STUD
 PER GAF WP 20


 1/2" AREA FOR
 GAME CONSTRUCTION

26 1580 1684

NOTES

① CABINETRY SIMILAR, OR OPPOSITE, TO
EXAM OFF. 1/A/2

- _____

100

1

ENGINEER

F


C

PROJECT


1

1


On

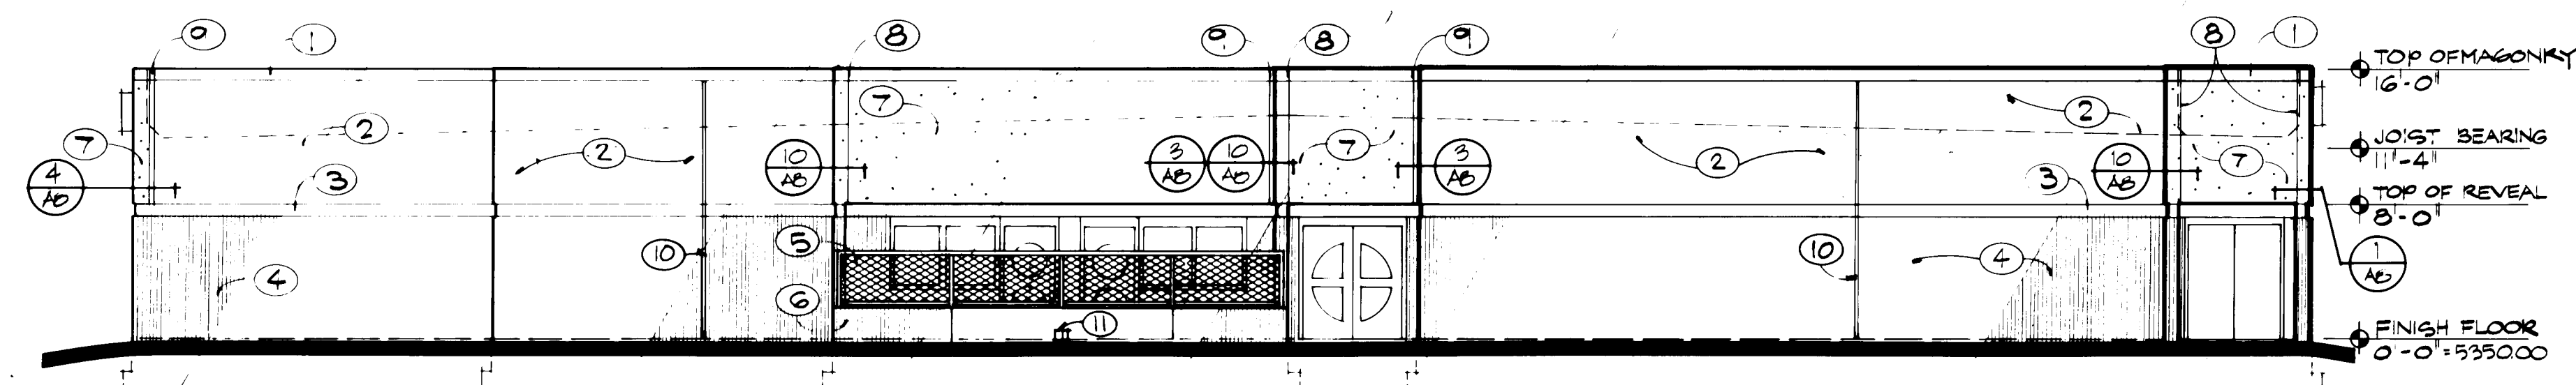


EAST ELEVATION - BASE BID
SCALE: 1/8" = 1'-0"

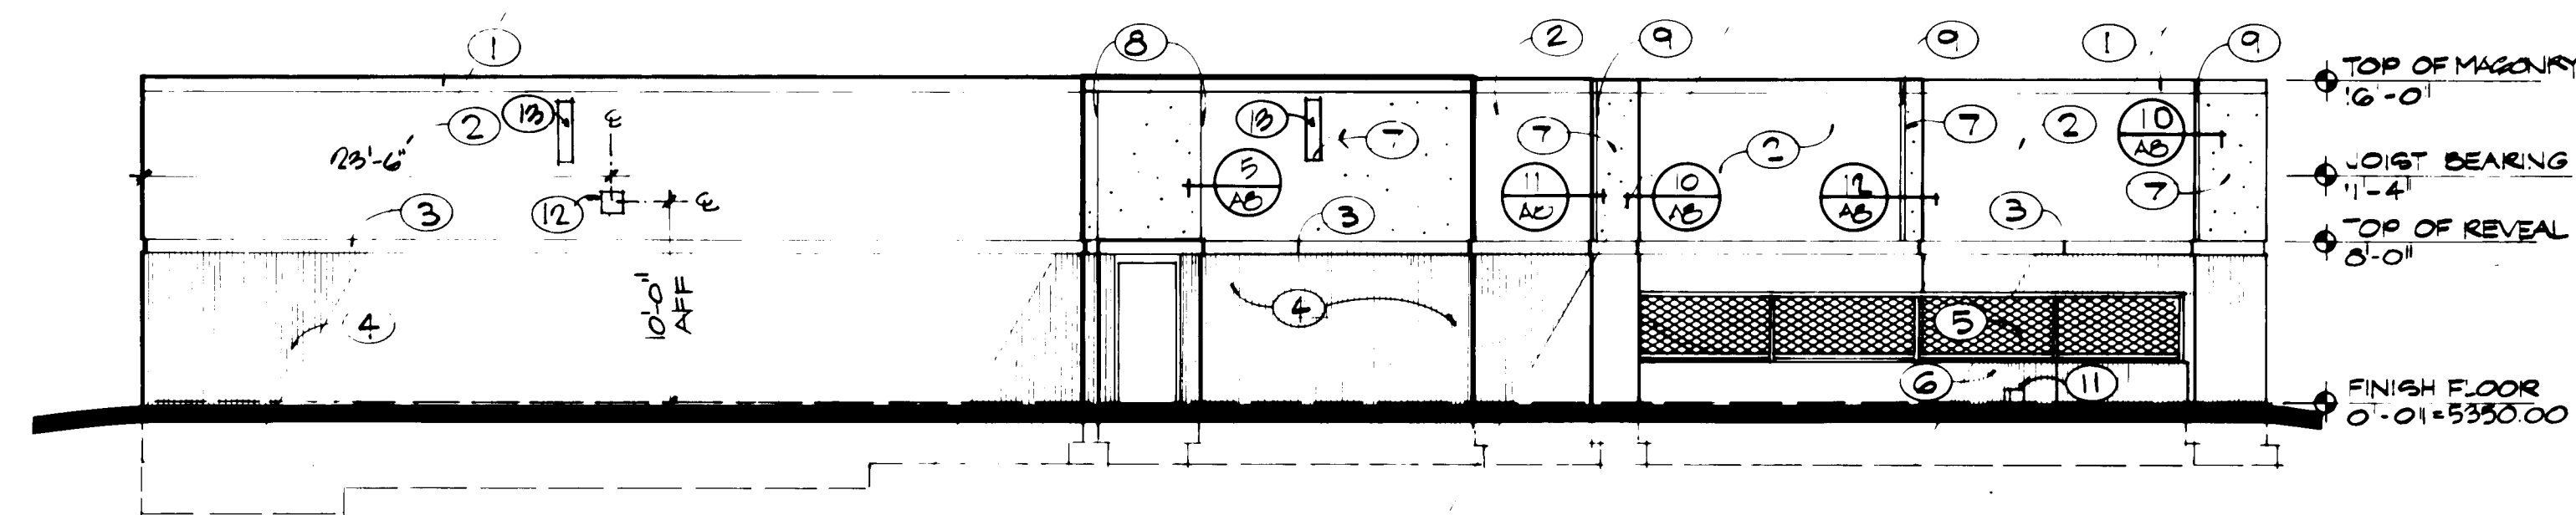

SOUTH ELEVATION - BASE BID
SCALE: 1/8" = 1'-0"

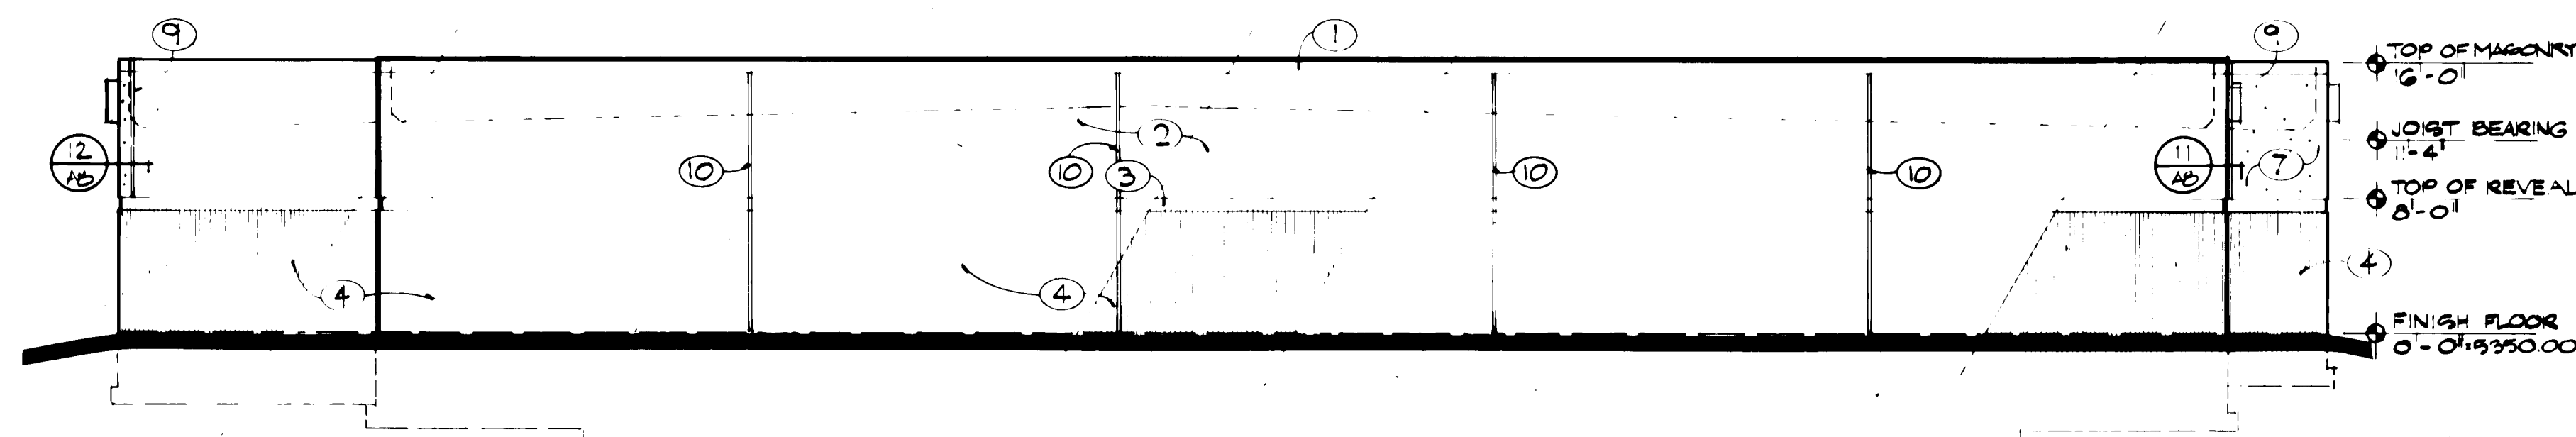

WEST ELEVATION - BASE BID
SCALE: 1/8" = 1'-0"

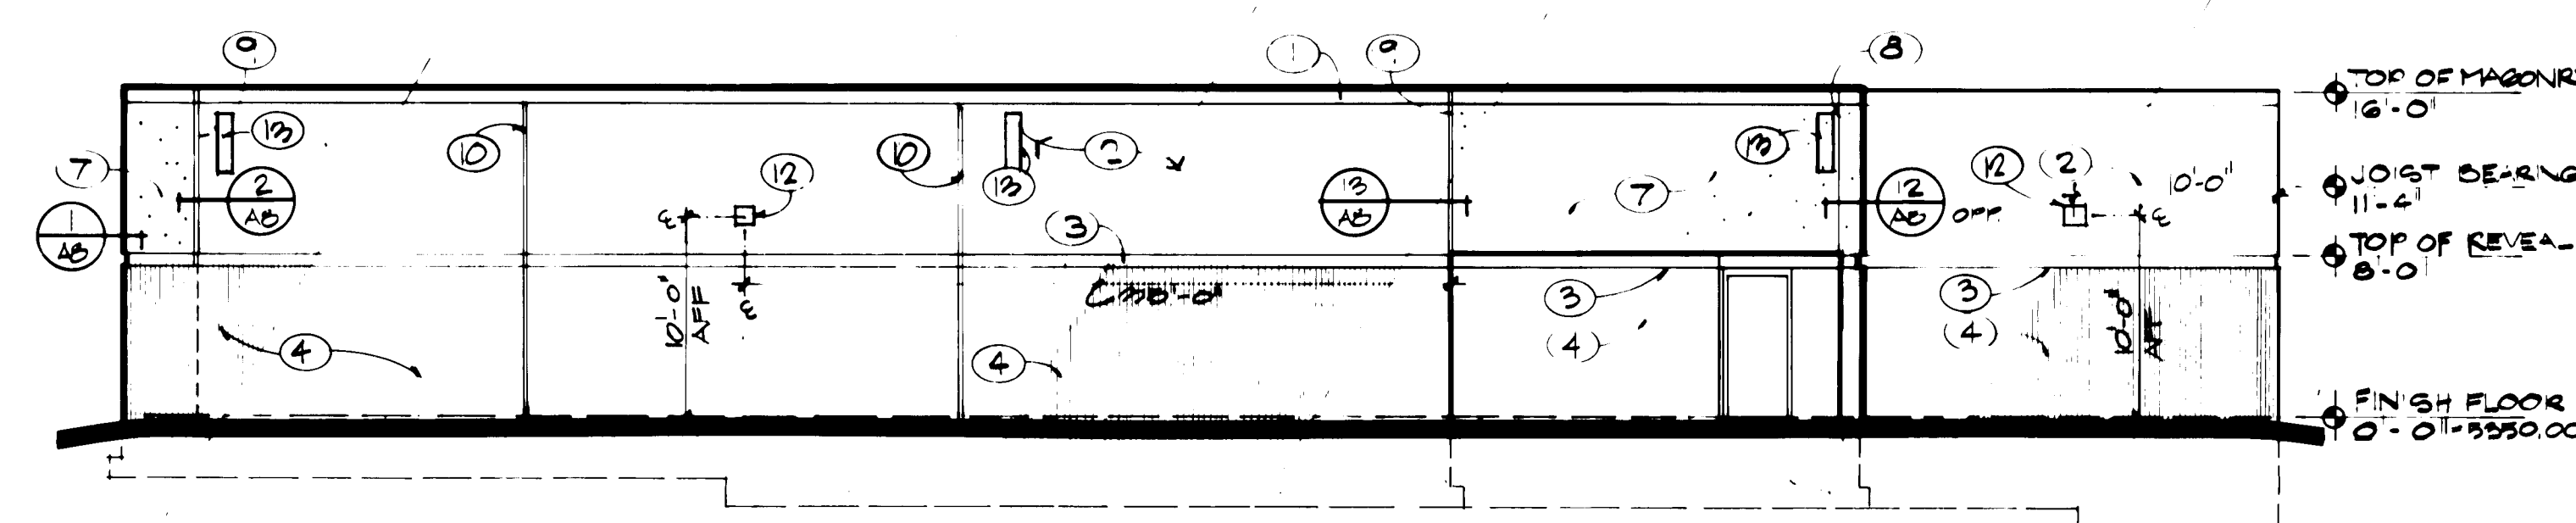

NORTH ELEVATION - BASE BID
SCALE: 1/8" = 1'-0"

26' 1589 1784

THE BURNS, PETERS GROUP
ARCHITECTS PLANNERS

1000 PENNSYLVANIA CIRCLE, N.E. ALBUQUERQUE, NM 87102 505.261.3445

NOTES

1. MTL CAP FLASHING.
2. 9" FLUTED CMU, STAIN AG PER SPEC.
3. CERAMIC-TIRED CMU, SEE SPEC.
4. 9" FLUTED CMU, STAIN AG PER SPEC.
5. GALV CHAIN LINK FENCE 6'-0" HIGH, EAGE BID ONLY - SEE GENERAL NOTE BELOW.
6. 2" CLIP CONC WALL - SEE STRUCT.
7. SYNTHETIC PLASTER FINISH ON 3/8" EXTERIOR GYP BD.
8. CONTROL JOINT
9. 2" REVEAL
10. MASONRY CONTROL JOINT - SEE GHT. CH. FOR LOCATIONS
11. PLAYAREA SCULPTED CHAIN 8'-0" HIGH X 8' WIDE BLOCKOUT IN CONC.
12. SURFACE MOUNTED SECURITY LIGHT FIXTURE UNIT - SEE ELEC.
13. OVERFLOW ROOF SCUMPER 1/4" X 6 1/2" DIA, GALV METAL SCULPTED SIM TO 707 20/40.

NOTE: CONTRACTOR AND/OR VINYL COVERED FENCING SUPPLIER TO PROVIDE SHOPDRAWINGS ILLUSTRATING ANCHORING AND CONSTRUCTION METHODS FOR ARCHITECTS APPROVAL PRIOR TO INSTALLATION.

BURNS/PETERS GROUP ARCHITECTS
RECORD DRAWING
DATE: 12 SEPT 01
Paul Peters


REVISIONS

ENGINEER	ARCHITECT
----------	-----------


THE EAST-CENTRAL MULTI-SERVICE CENTER

PROJECT NO. 2205 DATE MAY 00


A2
SHEET 17 OF 20

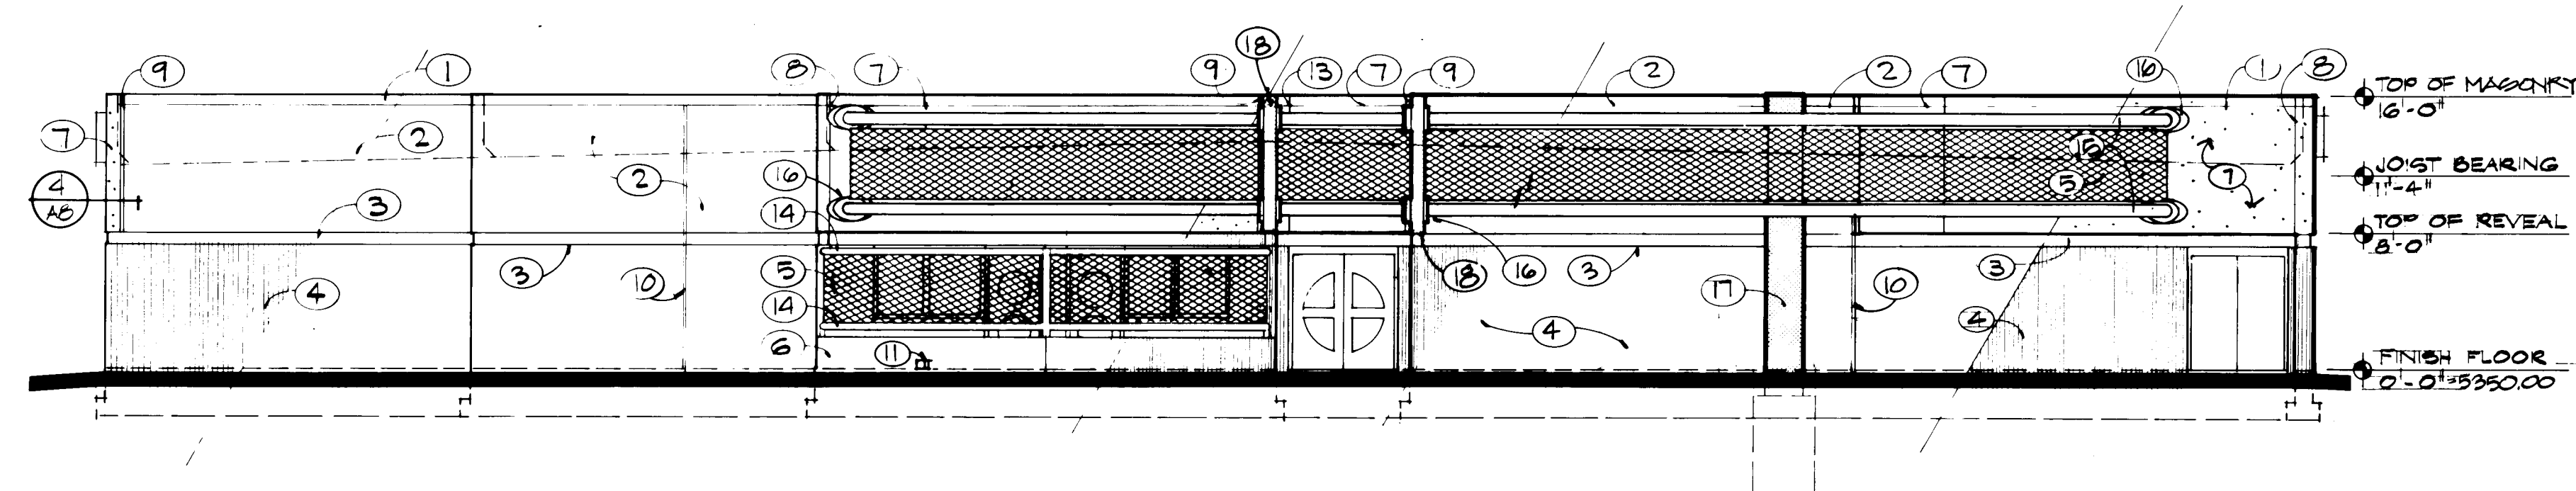


EAST ELEVATION - ALTERNATE # 1
SCALE: 1/8" = 1'-0"

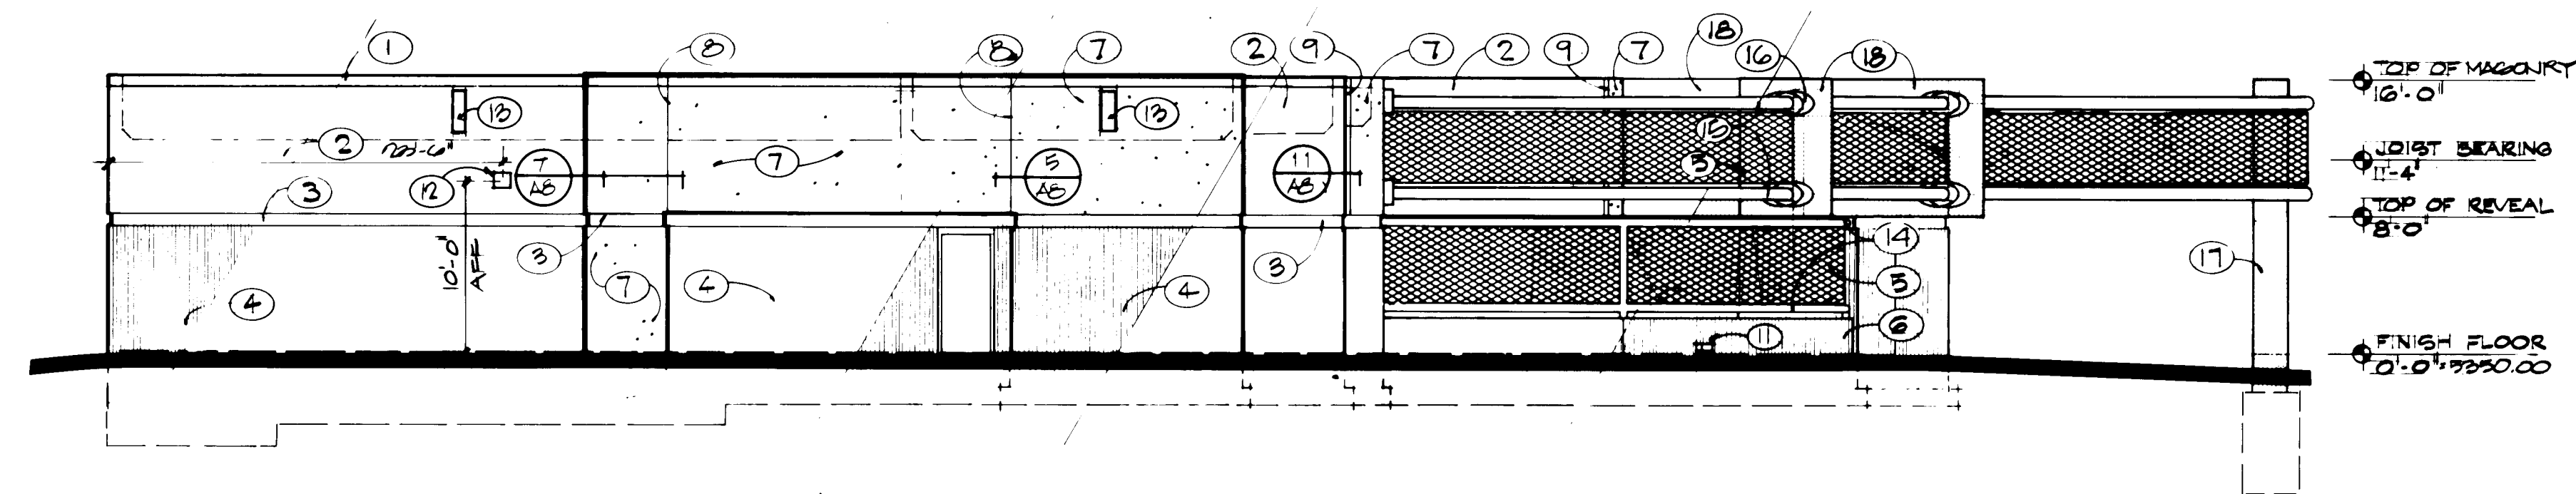


SOUTH ELEVATION - ALTERNATE # 1
SCALE: 1/8" = 1'-0"

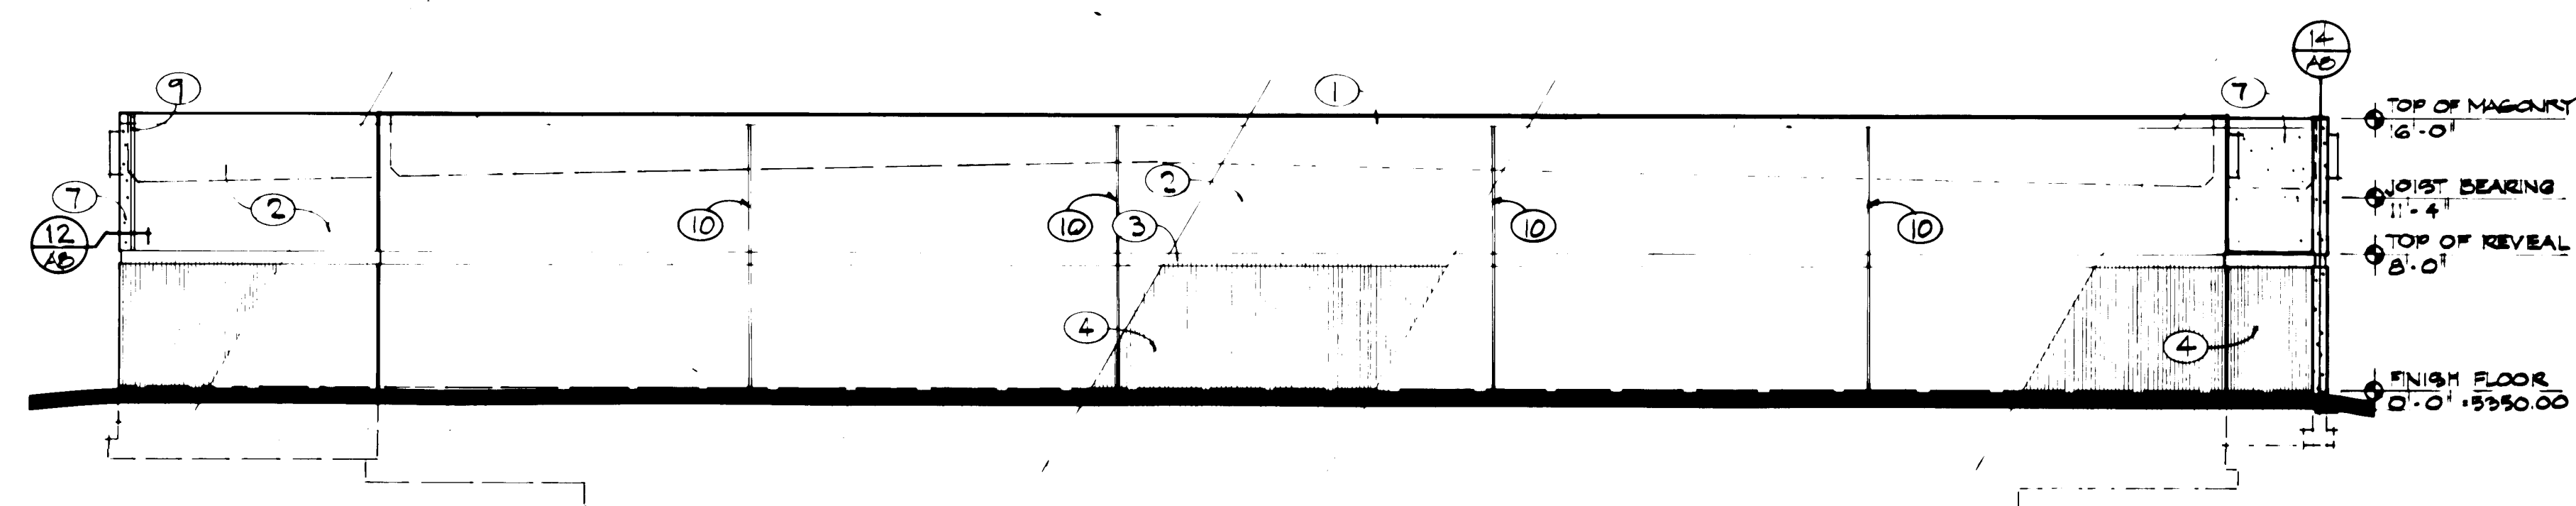

WEST ELEVATION - ALTERNATE # 1
SCALE: 1/8" = 1'-0"

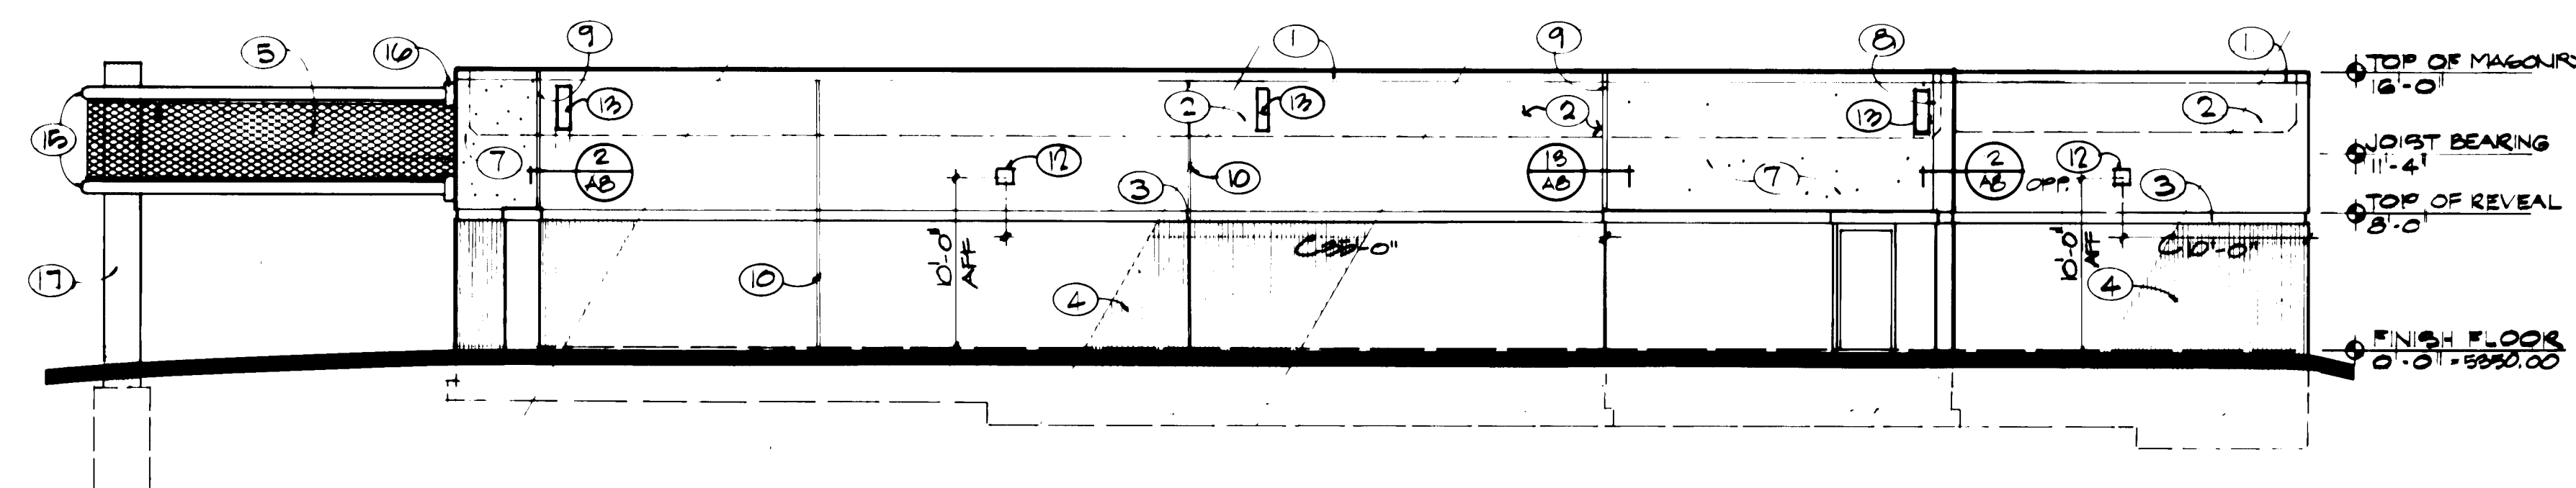

NORTH ELEVATION - ALTERNATE # 1
SCALE: 1/8" = 1'-0"

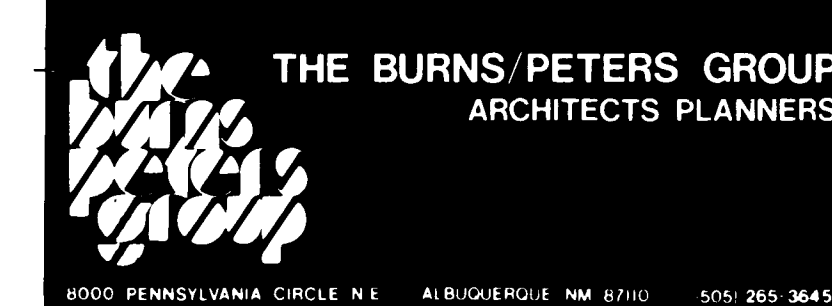


NOTES

- ① MET. CAP FLASHING
- ② 2" x 4" FENCE CHIL. SPAN 12' PER SPEC.
- ③ CERAMIC - MASON CHIL. SEE SPEC.
- ④ 3" FILT'D CHIL. STAIN AS PER SPEC.
- ⑤ VINT. COATED SCREEN MESH SEE SPEC. & STRUCT. DRAWING.
- ⑥ 2" CLIP CONC. WALL - SEE STRUCT.
- ⑦ SYNTHETIC PLASTER FINISH
- ⑧ CONTROL JOINT
- ⑨ 2" REVEAL
- ⑩ MASONRY CONTROL JOINT - SEE DET. 2-1
- ⑪ PLAYAREA SCULPTURE DRAIN 2" HIGH 18" WIDE BLOCKOUT IN CONC.
- ⑫ SURFACE MOUNTED SECURITY LIGHT FIXTURE UNIT - SEE ELEC.
- ⑬ OVERLAP ROOF SCULPTURE - SEE 2B/26
- ⑭ 2" x 2" STEEL PIPE, PAINT AS PER SPEC. SEE STRUCT. DRAWING.
- ⑮ 2" x 2" STEEL PIPE, PAINT AS PER SPEC. SEE STRUCT. DRAWING.
- ⑯ 12" x 12" STEEL PIPE, PAINT AS PER SPEC. SEE STRUCT. DRAWING.
- ⑰ CLIP CONC. COLUMN - SEE STRUCT. DRAWING.
- ⑱ CLIP CONC. - SEE STRUCT. DRAWING.

NOTE:
CONTRACTOR AND/OR VINYL
COVERED FLOORING SUPPLIER
SHALL PROVIDE SHOP DRAWINGS
OF CONST. AND ATTACHMENT
METHODS FOR ARCHITECT'S
APPROVAL PRIOR TO CONST.

BURNS/PETERS GROUP ARCHITECTS
RECORD DRAWING
DATE 12 SEPT 84
[Signature]

REVISIONS

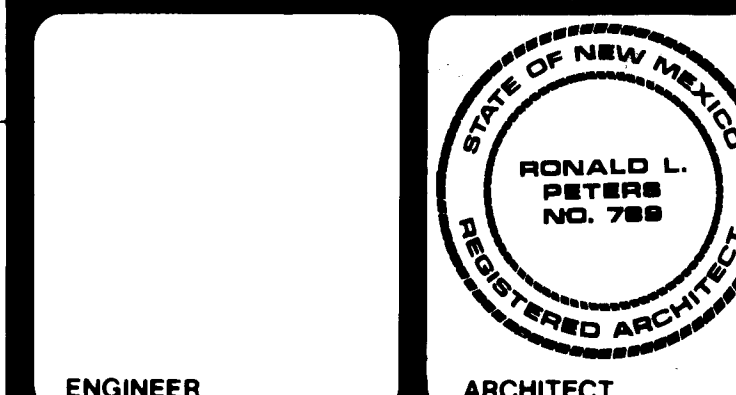


THE
EAST-CENTRAL
MULTI-SERVICE
CENTER


PROJECT NO. 8203 DATE MAY 1983

A2.5
SHEET 16 OF 26


26 1589 1864

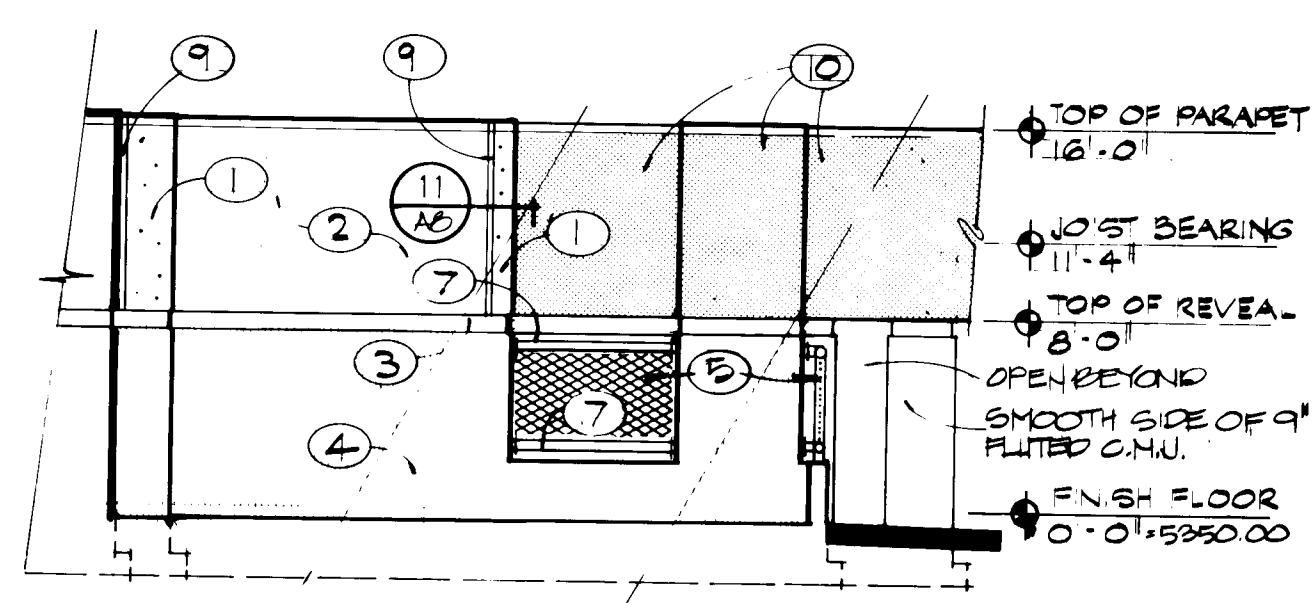


3
A1 SOUTH ELEVATION - ALT. # 1
SCALE: 1/8" = 1'-0"
NOTE: VINYL COATED SCREEN MESH AND STEEL
PIPE SUPPORTS NOT SHOWN FOR CLARITY

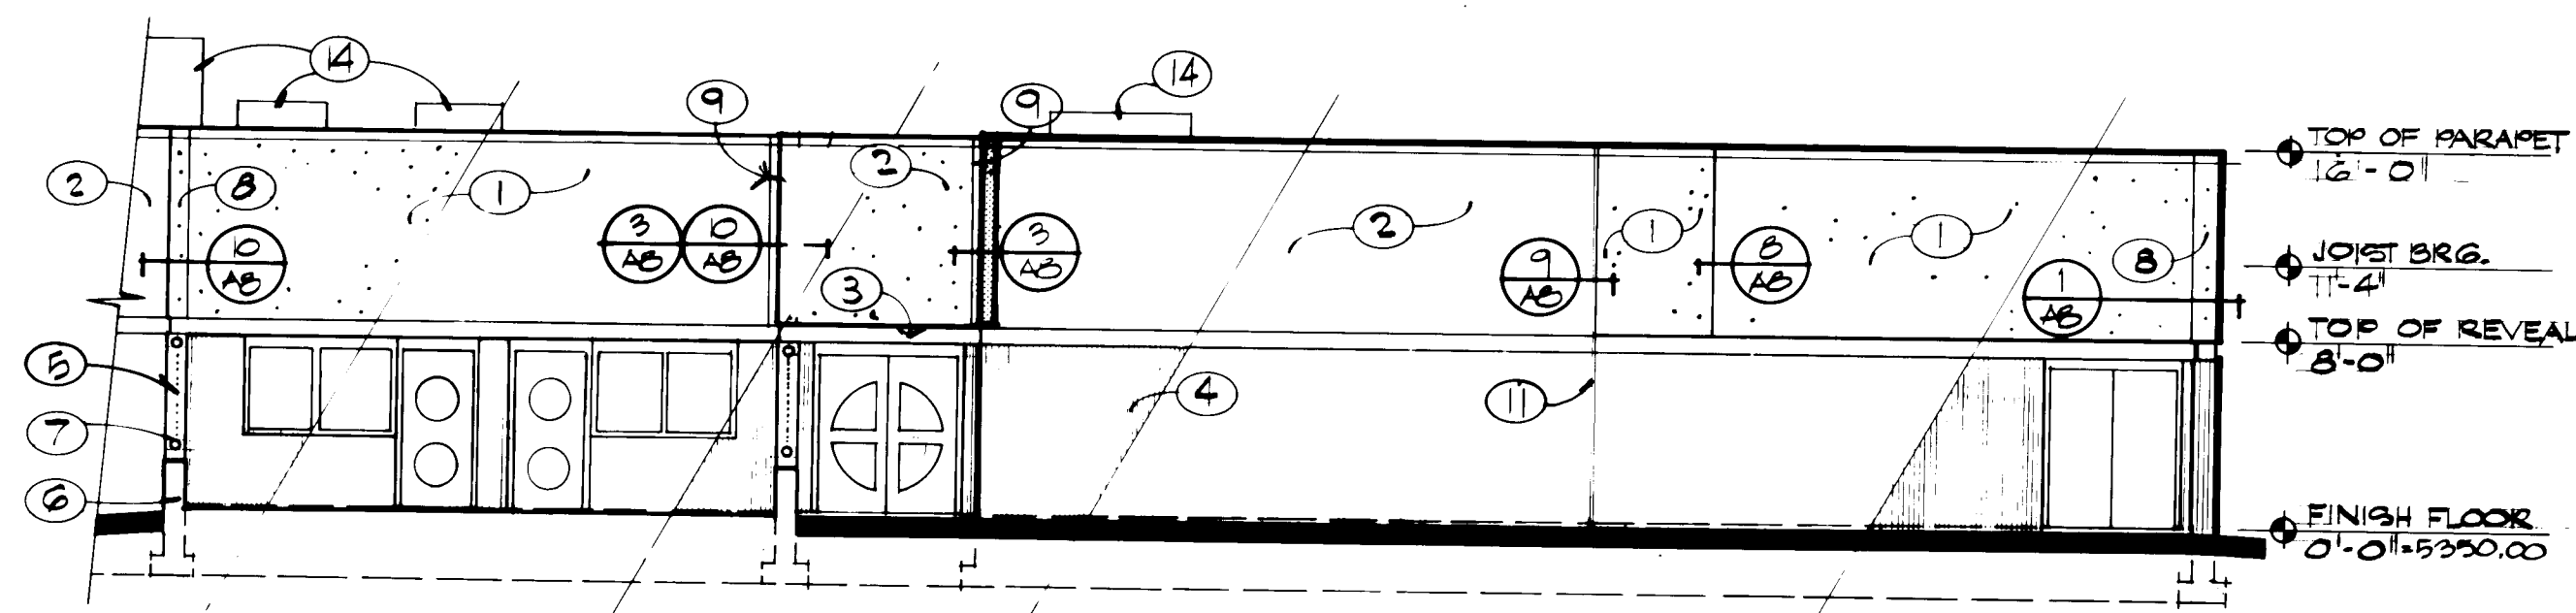


2
A1 EAST ELEVATION - ALTERNATE # 1
SCALE: 1/8" = 1'-0"
NOTE: VINYL COATED SCREEN MESH AND STEEL
PIPE SUPPORTS NOT SHOWN FOR CLARITY

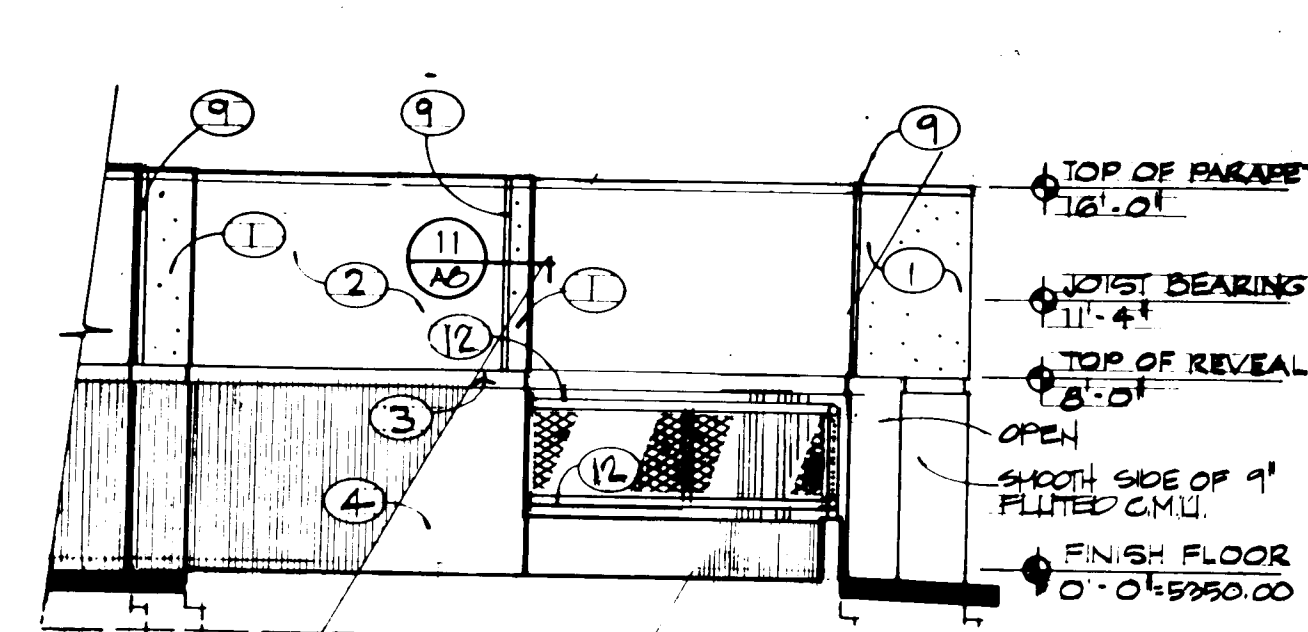

1
A1 SOUTH ELEVATION - BASE BID
SCALE: 1/8" = 1'-0"

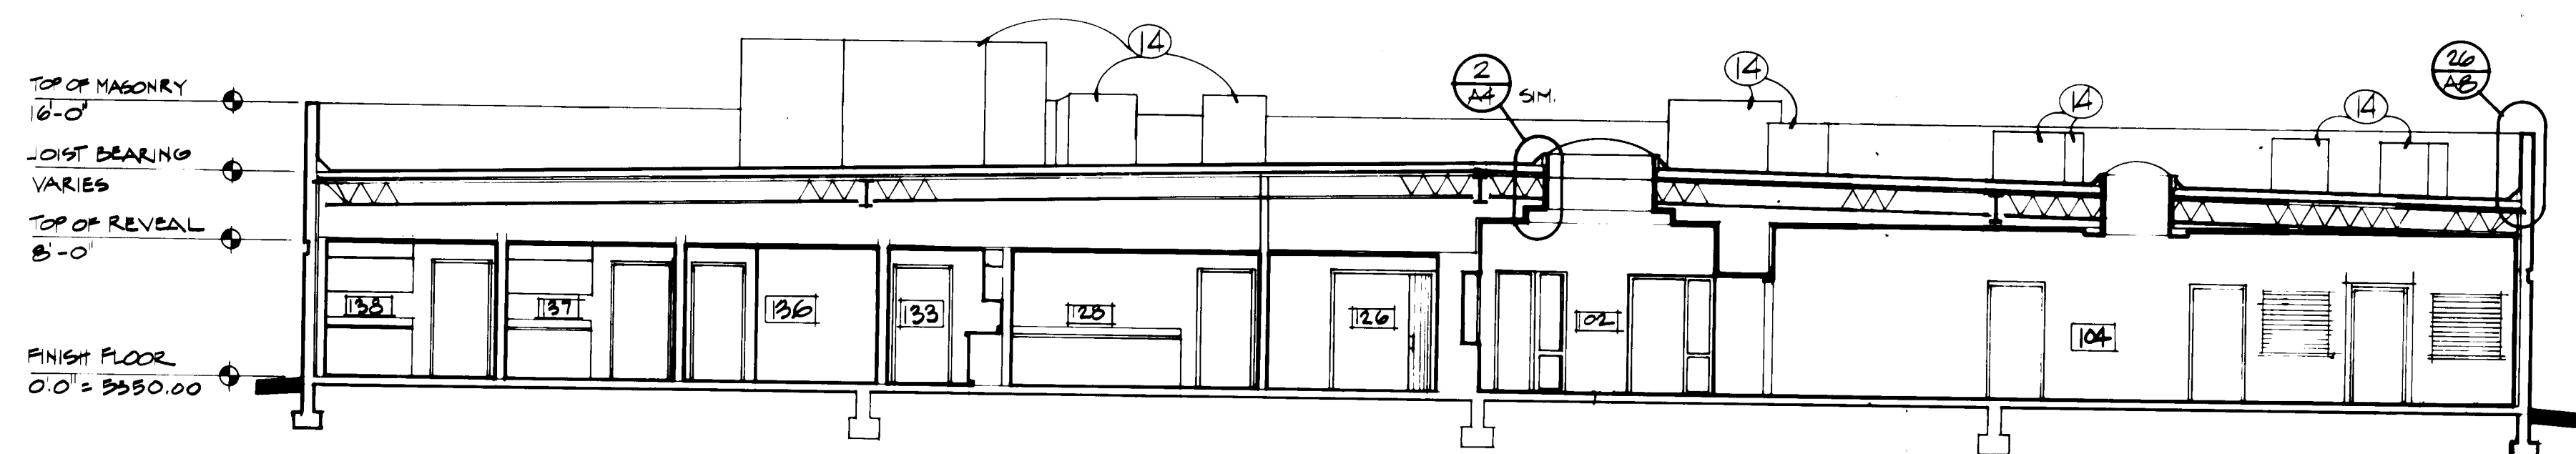

A
A1 SECTION
SCALE: 1/8" = 1'-0"

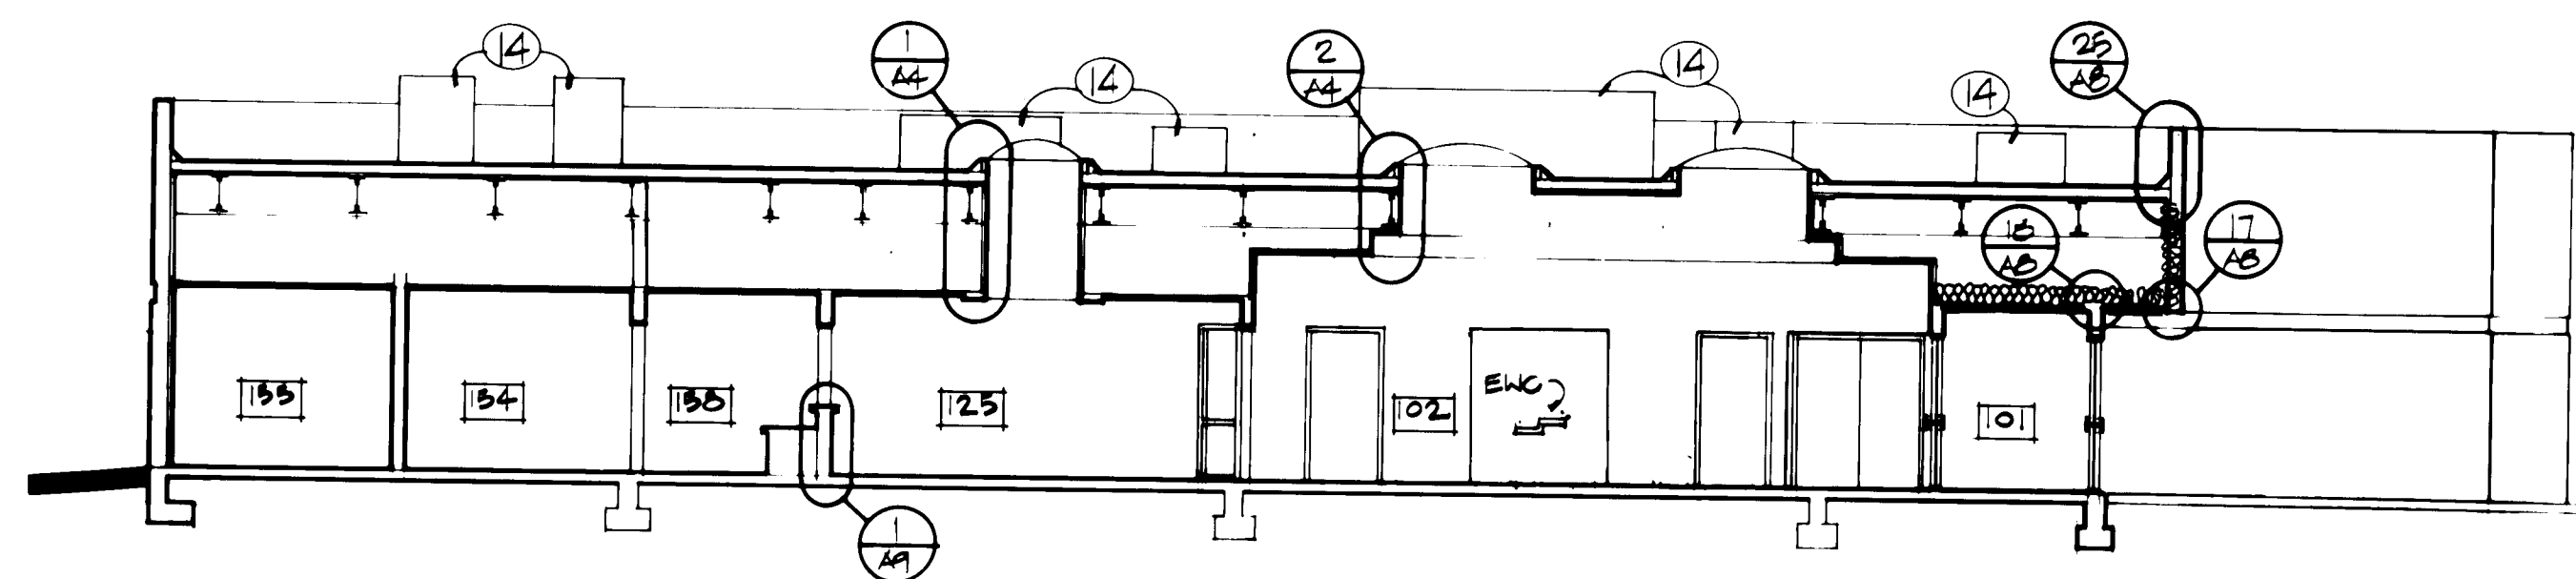

B
A1 SECTION
SCALE: 1/8" = 1'-0"



NOTES

- ① SYNTHETIC PLASTER FINISH
- ② 4" SPILT-POUR C.M.U. - STAIN
AS PER SPEC.
- ③ 8" CERAMIC FACED C.M.U. - SEE
SPEC.
- ④ 4" FLUTE C.M.U. - STAIN AS
PER SPEC.
- ⑤ VINYL COATED SCREEN MESH -
SEE SPEC.
- ⑥ 6" CLIP CONG. WALL - SEE
STRUCT. DRAWINGS
- ⑦ 4" STEEL PIPE - PAINT AS PER
SPEC. - SEE STRUCT. DRWG.
- ⑧ CONTROL JOINT
- ⑨ 8" REVEAL
- ⑩ CLIP CONG. - SEE STRUCT. DRWG.
- ⑪ MASONRY CONTROL JOINT -
SEE INT. G1
- ⑫ GALV. CHAIN LINK FENCE @
8'-0" HIGH - BASE BID ONLY - SEE DTL. A9
- ⑬ NOT USED
- ⑭ MECH. EQUIPMENT BEYOND SEE
ROOF PLAN SHEET A1/15

THE BURNS PETERS GROUP ARCHITECTS
RECORD DRAWING
12 SEPT 84
Constr. Unit

REVISIONS

ENGINEER


ARCHITECT
RONALD L. PETERSON
NO. 788
REGISTERED ARCHITECT

THE
EAST-CENTRAL
MULTI-SERVICE
CENTER

PROJECT NO. 8205 DATE MAY 83

A3
SHEET 19 OF 36

26.1.1989 1984

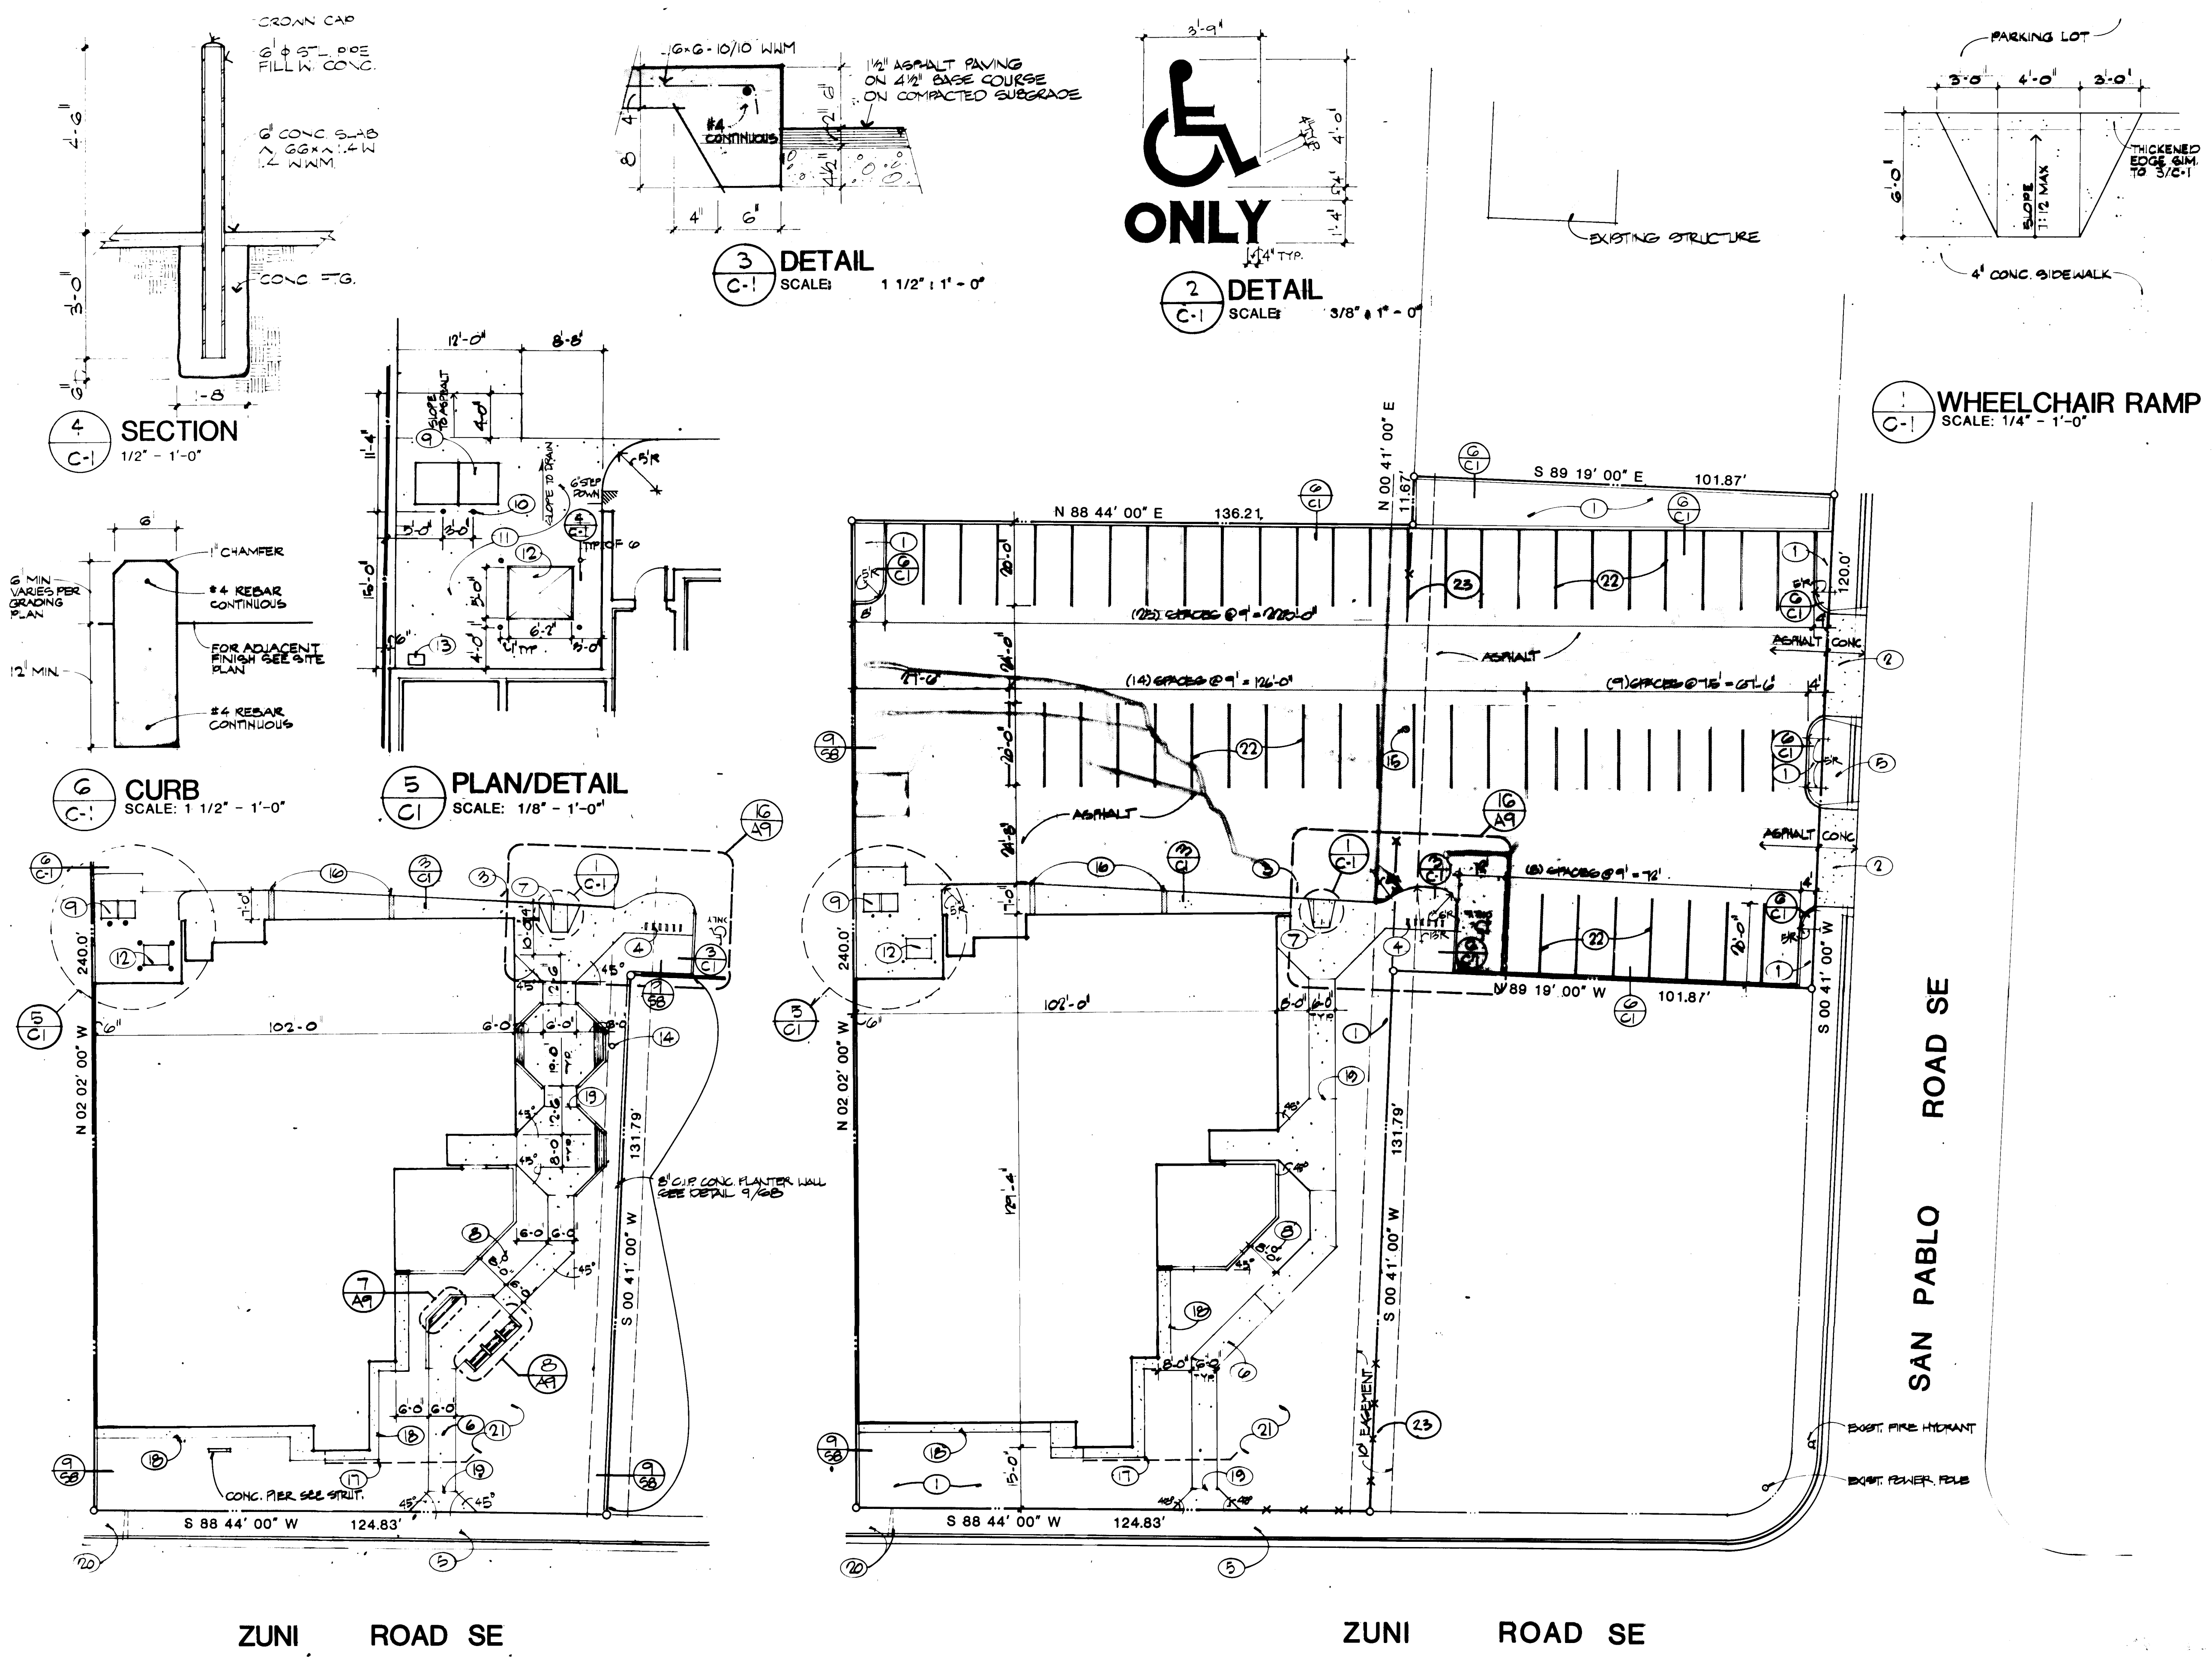

SITE PLAN - ALTERNATE #1
SCALE: 1" = 20'-0"

SITE PLAN - BASE BID
SCALE: 1" = 20'-0"

THE BURNS PETERS GROUP
ARCHITECTS PLANNERS

NOTES

- ① LANDSCAPE AREA - SEE L1
- ② NEW 24" CURB CUT FOR CITY OF ALBUQUERQUE SPEC.
- ③ PASSENGER DROP-OFF ZONE
- ④ 4" CONC. SIDEWALK - 1/2" GR. SAND SET UNDER 1" TOP FINISH DIVIDERS ANCHOR BOSTING @ CONC. SIDEWALK, CURE IN GUTTER
- ⑤ 4" CONC. SIDEWALK
- ⑥ WHEELCHAIR RAMP
- ⑦ FLAG POLE AS SPEC. SEE DETAIL 15A
- ⑧ TRASH CONTAINER BY OWNER
- ⑨ 6" Ø STL PIPE GALV
- ⑩ 4" REIN. CONC. GRAB
- ⑪ 4" REIN. CONC. RAIL PER FM SPEC. CONTRACTOR TO COORDINATE W/ R/W
- ⑫ GAS METER - SEE MECH.
- ⑬ CONC. COL/SCREEN SUPPORT - SEE STRUCT. ENGINEER
- ⑭ BOLLARD POLE TO BE RELOCATED BY OWNER
- ⑮ SIDEWALK TRENCHES - SEE 17A
- ⑯ 24" Ø DRAIN LINE TO WATER RETENTION BASIN BY R/WING CONT. SEE MECH.
- ⑰ 4" REIN. CONC. MORTAR LAYERS @ WIDE (TYPICAL) 2" IN REINFORCED CONCRETE IN DETAIL 3-1-1 EXPANSION JOINTS @ 20' O.C. MAX. E. THROUGH JOINTS @ 6' O.C. MAX. TYP.
- ⑱ REMOVE EXISTING CURB CUT & REPLACE @ SIDEWALK, CURB & GUTTER. AG. REQ. THE CITY OF ALBUQUERQUE SPEC.
- ⑲ LOCATION OF 15' FOR THE NOTES SIGNATURE TO BE PROVIDED BY OTHERS
- ⑳ 4" WIDE PARKING LOT STRIPPING PAINTED TO "WELBORN VALLEY" YELLOW TRAFFIC PAINT
- ㉑ EXISTING STL FENCE TO BE REMOVED BY PREVIOUS LAND OWNER

BURNS/PETERS GROUP ARCHITECTS
RECORD DRAWING
DATE: 12 SEPT 84
Charles Peters

REVISIONS

NO.	DESCRIPTION

ENGINEER

THE EAST-CENTRAL MULTI-SERVICE CENTER

ARCHITECT

THE EAST-CENTRAL MULTI-SERVICE CENTER

PROJECT NO. 0205

DATE MAY '83

C1

SHEET 3 OF 36

24 1589 0384

CALCULATIONS

Ground Cover Information

1. From SCS Bernalillo County Soil Survey, Plate 31: MMA
Maduroz Sink Association
Hydrologic Soil Group B

Rational Method

1. Discharge: $Q = CIA$
where C varies
 $i = P_2(6.84) T_c^{-0.51} = 4.97$ in/hr
 $P_2 = 2.35$ in (DPM Plate 22.2 D-1)
 $T_c = 10$ min. (minimum)
 $A =$ area, Acres

2. Volume: $V = (C P_2 A(1/12))$
where C varies
 $P_2 = 2.35$ in (DPM Plate 22.2 D-1)
 $A =$ area, sf

Existing Condition

$A_p = 1$ Ac
 $\% \text{ Impervious} = 0$
 $C = 0.34$ (DPM Plate 22.2 C-1)
 $Q_{100} = CIA = 0.34(4.97)(1.00) = 1.7$ cfs
 $Q_{100} = CP_2 A = 0.34(2.35/12)(43,560) = 2900$ cf

Developed Condition

1. Basin 1
 $A_p = 30,990$ sf = 0.71 Ac
 $A_{imp} = 28,900$ sf
 $\% \text{ Impervious} = 28,900/30,990 = 93\%$
 $C = 0.89$ (DPM Plate 22.2 C-1)
 $Q_{100} = CIA = 0.89(4.97)(0.71) = 3.1$ cfs
 $Q_{100} = CP_2 A = 0.89(2.35/12)(30,990) = 5401$ cf
 $V_{pond} = \frac{1}{2}(A_{47.5} + A_{48})(48-47.5) + \frac{1}{2}(A_{48} + A_{49})(49-48)$
 $= \frac{1}{2}(47500)(0.5) + \frac{1}{2}(50012)(1) = 6695$ cf
 $Q_{release} = CA/2gh$ (Orifice Equation)
let $h = 1.25$
 $A = 0.0855$ sf (4" pipe)
 $C = 0.8$
 $g = 32.2$ ft/sec²
 $Q_{release} = 0.6$ cfs

2. Basin 2
 $A_p = 4600$ sf = 0.11 Ac
 $A_{imp} = 4600$ sf
 $\% \text{ Impervious} = 100\%$
 $C = 0.95$
 $Q_{100} = 0.5$ cfs, $V_{100} = 856$ cf


3. Basin 3
 $A_p = 6250$ sf = 0.14 Ac
 $A_{imp} = 2200$ sf
 $\% \text{ Impervious} = 35\%$
 $C = 0.50$ (DPM Plate 22.2 C-1)
 $Q_{100} = 0.35$ cfs, $V_{100} = 612$ cf
 $V_{pond} = \frac{1}{2}(A_{47} + A_{48})(48-47.9) + \frac{1}{2}(A_{48} + A_{49})(49-48)$
 $= \frac{1}{2}(47500)(0.1) + \frac{1}{2}(5201620)(1.0)$
 $= 1096$ cf
 $Q_{release} = CA/2gh$
let $h = 0.67$
 $A = 0.0855$ sf
 $C = 0.8$
 $g = 32.2$ ft/sec²
 $Q_{release} = 0.4$ cfs
 $Q_{release} = 0.35$ cfs and no ponding occurs.

4. Basin 4
 $A_p = 1530$ sf = 0.04 Ac
 $A_{imp} = 300$ sf
 $\% \text{ Impervious} = 20\%$
 $C = 0.43$ (DPM Plate 22.2 C-1)
 $Q_{100} = 0.1$ cfs, $V_{100} = 129$ cf
No Pond Provided

Comparison

1. To San Pablo S.E.
 $Q_{100} - Q_{release} = 0 - 0.60 = 0.6$ cfs increase

2. To Zuni S.E.
 $Q_{100} - Q_{release} = 1.7 - (0.54012 + 0.1) = 0.75$ cfs decrease

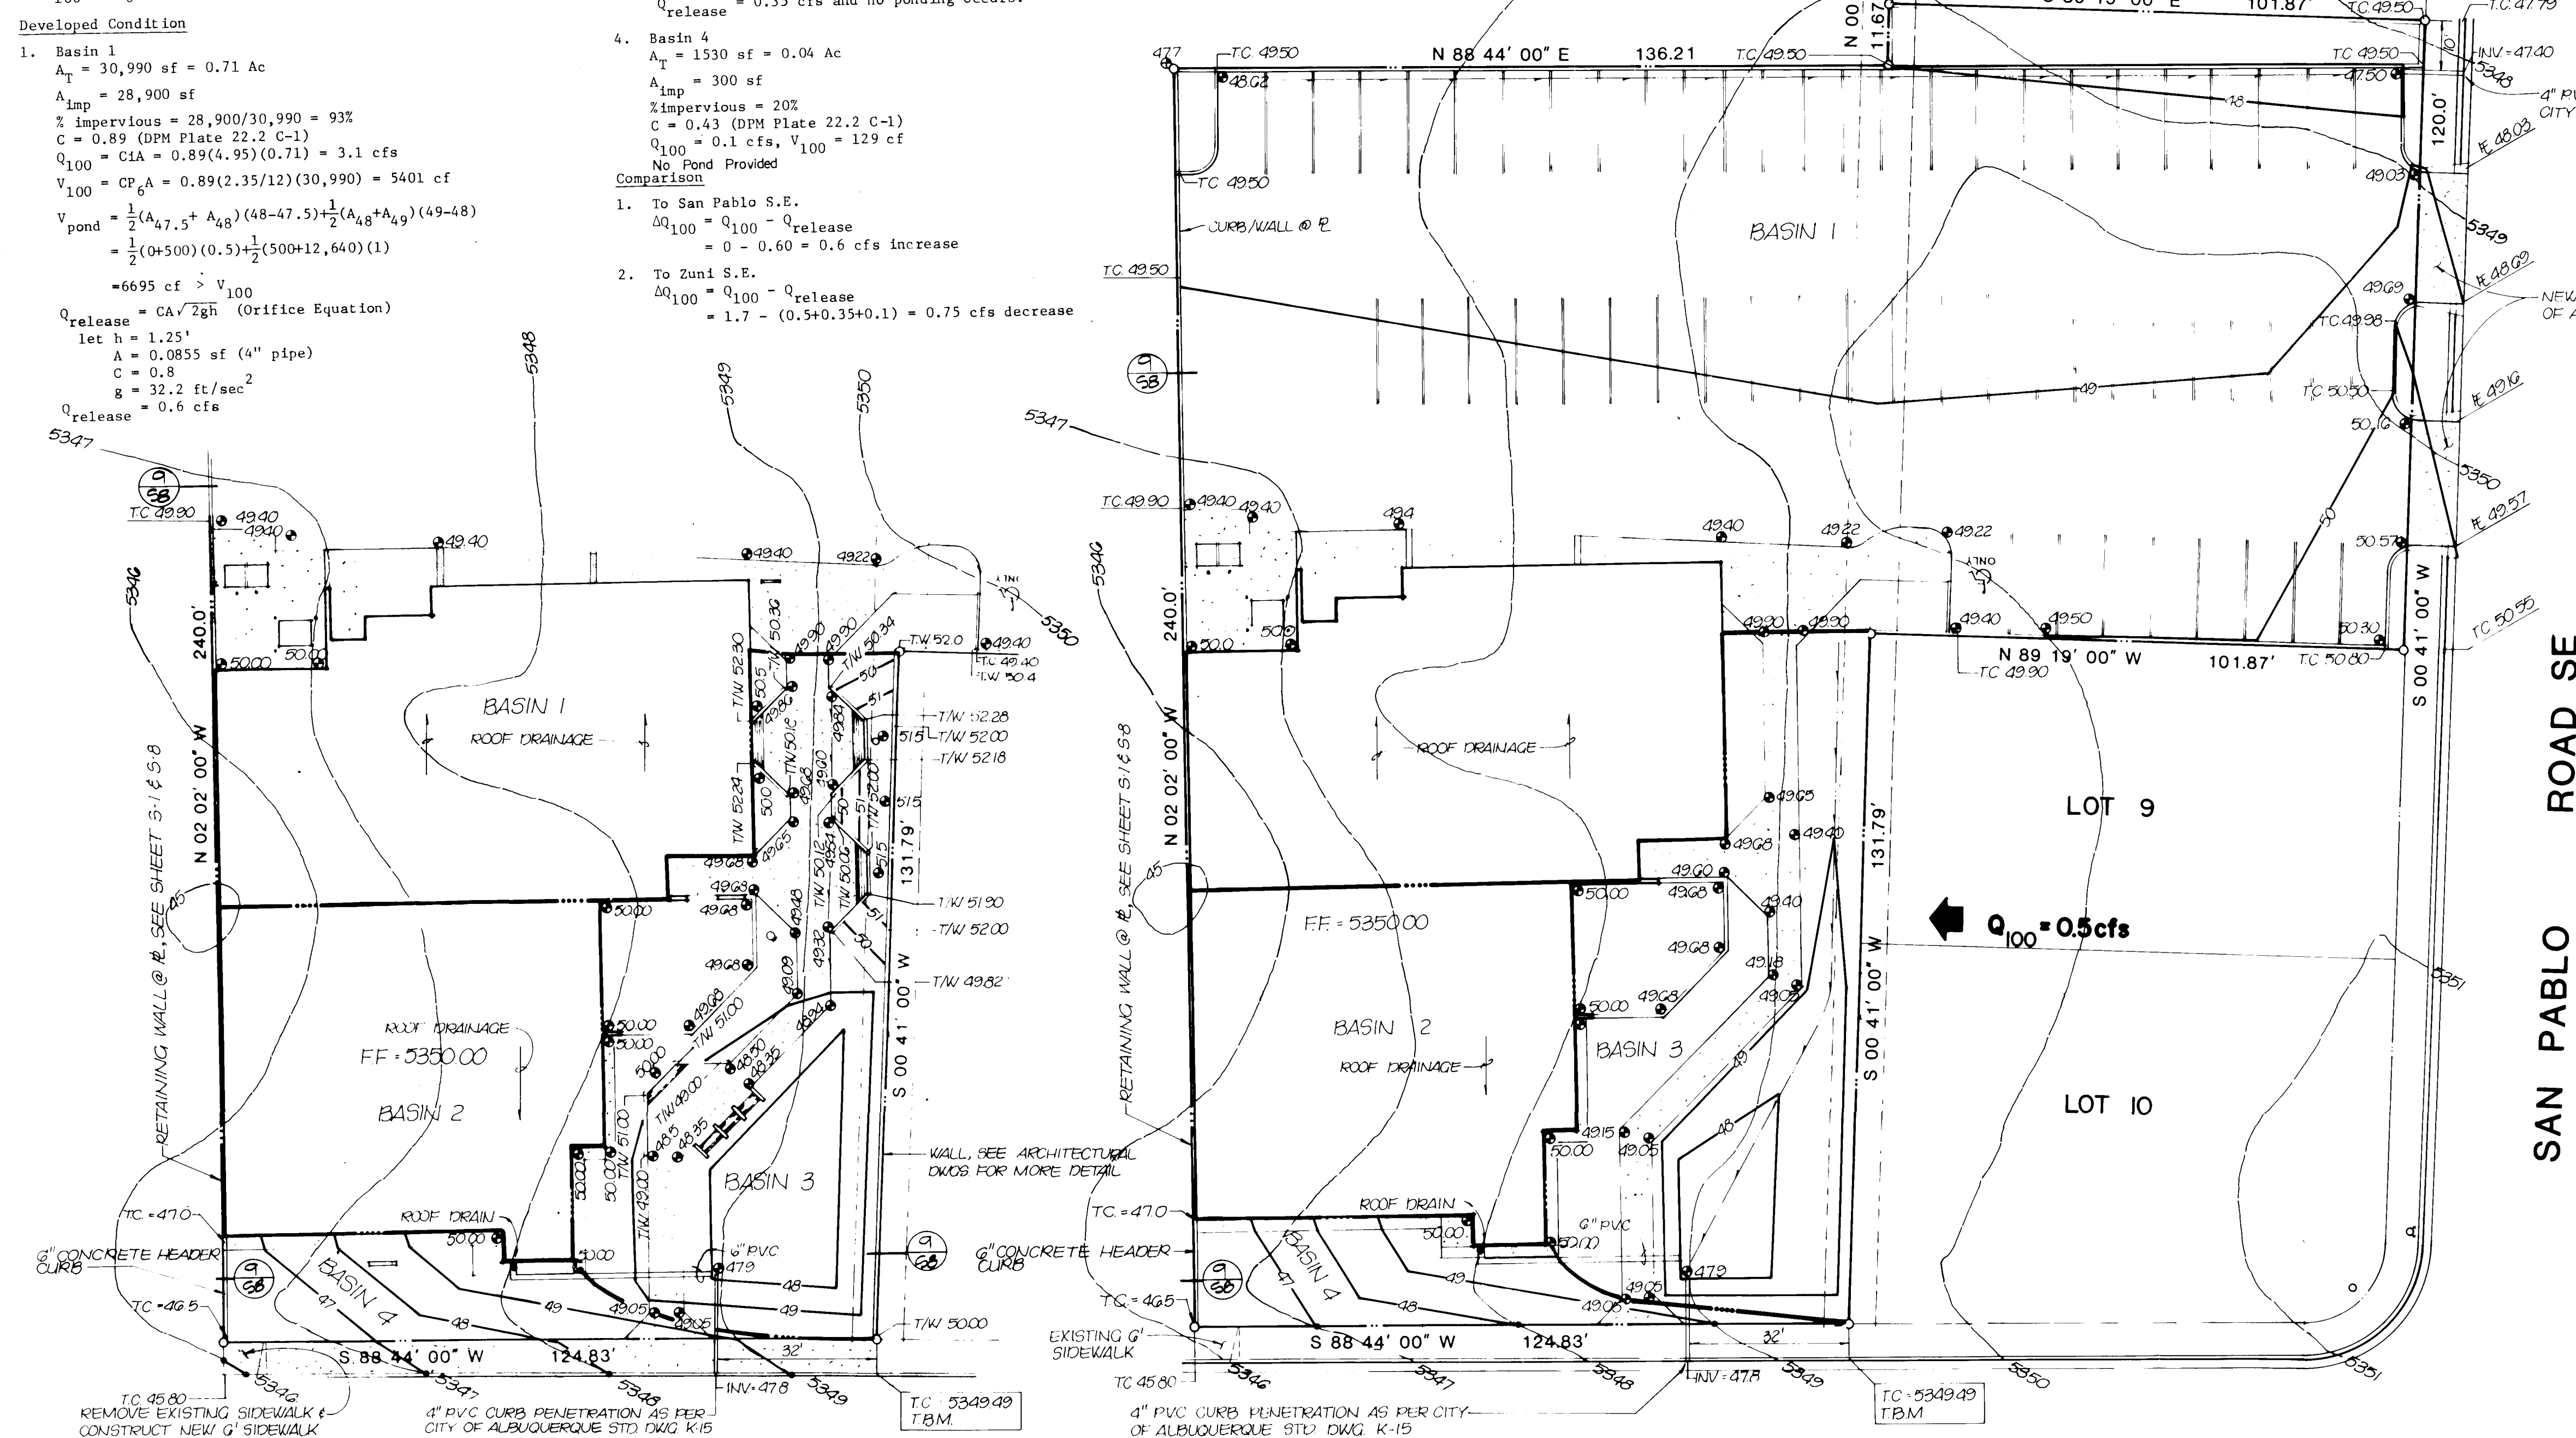

ZUNI ROAD SE

LEGEND

• 43.47 EXISTING SPOT ELEVATION
• 48.47 PROPOSED SPOT ELEVATION
- - - - - EXISTING CONTOUR
- - - - - PROPOSED CONTOUR
- - - - - SWALE


LEGAL ADDRESS:

STREET ADDRESS:

PROJECT BENCHMARK: TBM
TOP OF CURB ELEVATION AT THE S.E.
OF PARCEL AS SHOWN ABOVE
ELEVATION: 5349.49 FEET (M.S.L.D)

ZUNI ROAD SE

SITE PLAN - BASE BID
SCALE: 1" = 20'-0"

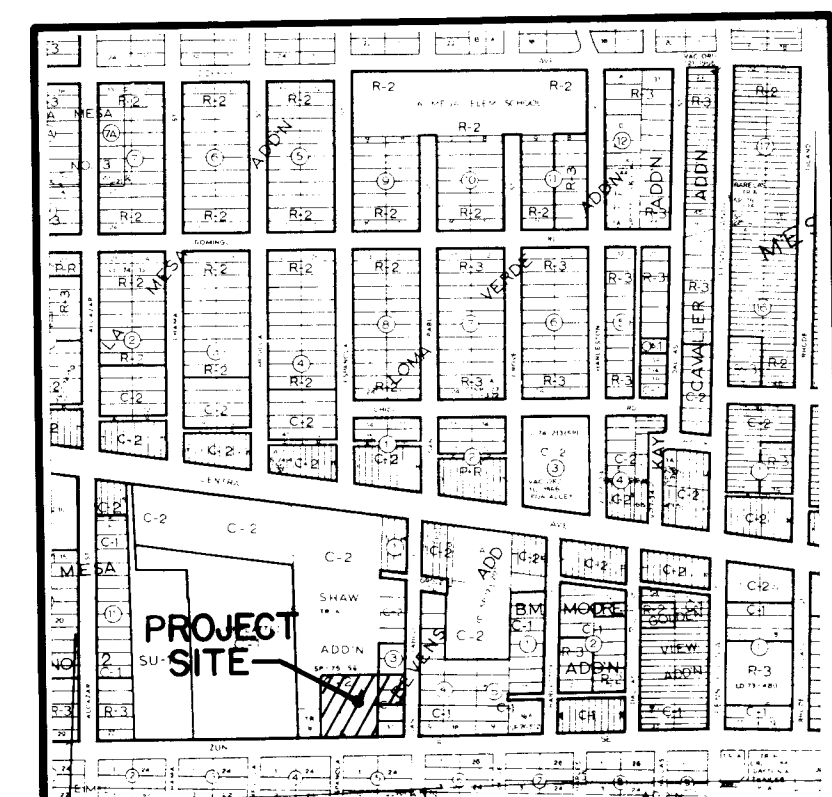

VICINITY MAP
SCALE: 1" = 800'

THE BURNS/PETERS GROUP
ARCHITECTS PLANNERS

6000 PENNSYLVANIA CIRCLE N.E. ALBUQUERQUE, NM 87110 505/263-3843

DRAINAGE PLAN

The following items concerning the East Central Multi-Service Center grading and drainage plan are contained herein: 1) Vicinity Map 2) Grading Plan 3) Calculations. The proposed improvements, as shown by the Vicinity Map, are located at the northwest corner of the intersection of Zuni Road S.E. and San Pablo Road S.E. The site is presently undeveloped. The adjacent sites to the north and west are developed.

This site does not lie within a designated flood-hazard zone. However, flooding is anticipated along Zuni Road, as indicated by Plate R19 of the Albuquerque Master Drainage Study. Because of this, the runoff from the site will be positively discharged into the streets.

The Grading Plan shows 1) existing and proposed grades indicated by spot elevations and contours at 1'0" intervals 2) continuity between proposed and existing grades 3) the limit and character of proposed improvements and 4) two different grading schemes for Basins 3 and 4. The different grading schemes for Basins 3 and 4 were necessitated by an alternate bid situation requested by the City (CIP). The analysis of these Basins considers only the 'worst' possible case to be conservative.

The calculations which appear below analyze both the existing and developed conditions for the 100-year, 6-hour rainfall event. The Rational method has been used for this analysis in accordance with the City of Albuquerque Development Process Manual Volume II. Pond volume calculations are based on the average end-area method. Pond discharge rate calculations are based on the orifice equation. As shown by these calculations, the amount of runoff discharged to the west and into Zuni Road will be decreased by development. The quantity of runoff which will be discharged into San Pablo Road will increase by only 0.6 cfs. The off-site flow from Lots 9 and 10 are estimated to be 0.5 cfs. These lots are presently undeveloped and will contribute only sheet flow.

NOTES:

1. BASIN 2 (ROOF AREA) DRAINS VIA 2-4" ROOF DRAINS & 2-4" PVC DRAIN LINES TO THE POND IN BASIN 3. BASIN 3 DRAINS VIA 1-4" PVC CURB PENETRATION TO ZUNI RD SE.

2. NO ROOF DRAINAGE SHALL BE PERMITTED TO FLOW TO THE WEST.

BURNS/PETERS GROUP ARCHITECTS

RECORD DRAWING
DATE: 12 SEPT 84

REVISIONS

ENGINEER 2-3-83
ARCHITECT

THE EAST-CENTRAL MULTI-SERVICE CENTER

PROJECT NO. 8205 DATE MAY '83

C2
SHEET 4 OF 36

NOTES

DRAINAGE PLAN

The following items concerning the East Central Multi-Service Center Drainage Plan are contained hereon:

1. Vicinity Map
2. Grading Plan
3. Calculations


The proposed improvements, as shown by the Vicinity Map, are located at the intersection of Zuni Road S.E. and San Pablo Road S.E. The site is presently under construction. The adjacent sites to the north and west are developed. The purpose of this plan is to update the previously approved plan due to an increase in the scope of the project.

This site does not lie within a designated flood-hazard zone. However, flooding is anticipated along Zuni Road, as indicated by Plate K19 of the Albuquerque Master Drainage Study. Because of this, the runoff from the site will be positively discharged into the streets.

The Grading Plan shows 1) existing and proposed grades indicated by spot elevations and contours at 1'0" intervals, 2) continuity between proposed and existing grades, and 3) the limit and character of proposed improvements.

The calculations which appear below analyze both the existing and developed conditions for the 100-year, 6-hour rainfall event. The Rational method has been used for this analysis in accordance with the City of Albuquerque Development Process Manual, Volume II. Pond volume calculations are based on the average end-area method. Pond discharge rate calculations are based on the orifice equation. As shown by these calculations, the amount of runoff discharged to the west and into Zuni Road will be decreased by development. The quantity of runoff which will be discharged into San Pablo Road will increase by only 0.6 cfs. There are no off site flows affecting this site. An offsite flow with a magnitude of 0.5 cfs affected the previous submittal. This flow was generated by the southeast quadrant of the current site. Now that that parcel of land has been incorporated into the site, it is no longer an offsite flow. Lastly, it appears that the flows in San Pablo Road and Zuni Road are confined to the street right-of-way.

REVISIONS

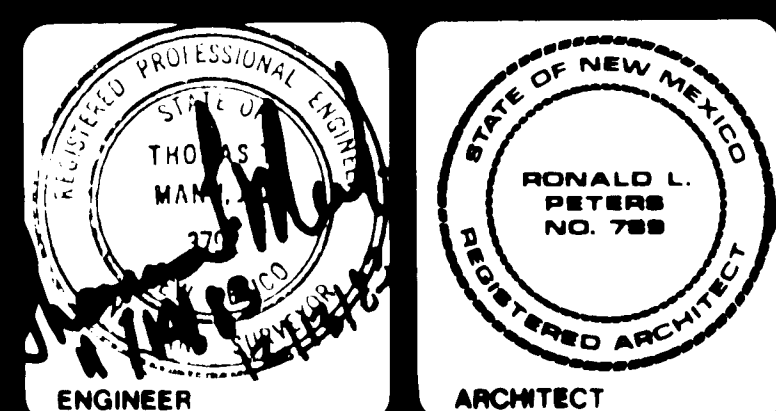

THE EAST CENTRAL MULTI-SERVICE CENTER

PROJECT NO. 8203 DATE 8/2/83

C2.1
SHEET OF

CALCULATIONS

Ground Cover Information

1. From SCS Bernalillo County Soil Survey, Plate 31:
MWA - Madurez Wink Association
Hydrologic Soil Group B

Rational Method

1. Discharge: $Q = CiA$

where C varies

$$i = P_6 (6.84) T_c^{-0.51} = 4.97 \text{ in/hr}$$

$$P_6 = 2.35 \text{ in (DPM Plate 22.2 D-1)}$$

$$T_c = 10 \text{ min. (minimum)}$$

$$A = \text{area, Acres}$$

2. Volume: $V = CP_6A(1/12)$

where C varies

$$P_6 = 2.35 \text{ in (DPM Plate 22.2 D-1)}$$

$$A = \text{area, sf}$$

Existing Condition

$$A_T = 1.3 \text{ Ac}$$

$$\% \text{ impervious} = 0$$

$$C = 0.34 \text{ (DPM Plate 22.2 C-1)}$$

$$Q_{100} = CiA = 0.34(4.97)(1.3) = 2.2 \text{ cfs}$$

$$V_{100} = CP_6A = 0.34(2.35/12)(1.3)43,560 = 3770 \text{ cf}$$

Developed Condition

1. Basin 1

$$A_T = 38,500 \text{ sf} = 0.88 \text{ Ac}$$

$$A_{\text{imp}} = 36,400 \text{ sf}$$

$$\% \text{ impervious} = 36,400/38,500 = 95\%$$

$$C = 0.92 \text{ (DPM Plate 22.2 C-1)}$$

$$Q_{100} = CiA = 0.92(4.95)(0.88) = 4.0 \text{ cfs}$$

$$V_{100} = CP_6A = 0.92(2.35/12)(38,500) = 6936 \text{ cf}$$

$$V_{\text{pond}} = \frac{1}{2}(A_{47.5} + A_{48})(48 - 47.50) + \frac{1}{2}(A_{48} + A_{49})(49 - 48) = \frac{1}{2}(0 + 500)(0.5) + \frac{1}{2}(500 + 12,640)(1) = 6695 \text{ cf} < V_{100}$$

$$Q_{\text{release}} = CA\sqrt{2gh} \text{ (Orifice Equation)}$$

$$\text{let } h = 1.25'$$

$$A = 0.0873 \text{ sf (4" dia. pipe)}$$

$$C = 0.75$$

$$g = 32.2 \text{ ft/sec}^2$$

$$Q_{\text{release}} = 0.6 \text{ cfs}$$

2. Basin 2

$$A_T = 16,600 \text{ sf} = 0.38 \text{ Ac}$$

$$A_{\text{imp}} = 6900 \text{ sf}$$

$$\% \text{ impervious} = 6900/16,600 = 42\%$$

$$C = 0.54 \text{ (DPM Plate 22.2 C-1)}$$

$$Q_{100} = 0.54(4.97)(0.38) = 1.0 \text{ cfs}$$

$$V_{100} = 0.54(2.35/12)(16,600) = 1755 \text{ cf}$$

$$V_{\text{pond}} = \frac{1}{2}(A_{47.7} + A_{48})(48 - 47.7) + \frac{1}{2}(A_{48} + A_{49})(49 - 48) = \frac{1}{2}(0 + 1080)(0.3) + \frac{1}{2}(1080 + 5000)(1.0) = 3360 \text{ cf}$$

$$Q_{\text{release}} = CA\sqrt{2gh}$$

$$\text{let } h = 49 - 47.9 - 0.17 = 0.9'$$

$$A = 0.0873 \text{ sf}$$

$$C = 0.70$$

$$g = 32.2 \text{ ft/sec}^2$$

$$Q_{\text{release}} = 0.5 \text{ cfs}$$

4. Basin 3

$$A_T = 1530 \text{ sf} = 0.04 \text{ Ac}$$

$$A_{\text{imp}} = 300 \text{ sf}$$

$$\% \text{ impervious} = 20\%$$

$$C = 0.43 \text{ (DPM Plate 22.2 C-1)}$$

$$Q_{100} = 0.1 \text{ cfs}, V_{100} = 129 \text{ cf}$$

No Pond provided as per previously approved plan.


Comparison

1. To San Pablo S.E.

$$\Delta Q_{100} = Q_{100} - Q_{\text{release}} = 0 - 0.60 = 0.60 \text{ cfs (increase)}$$

2. To Zuni S.E.

$$\Delta Q_{100} = Q_{100} - Q_{\text{release}} = 2.2 - (0.5 + 0.1) = 1.6 \text{ cfs (decrease)}$$

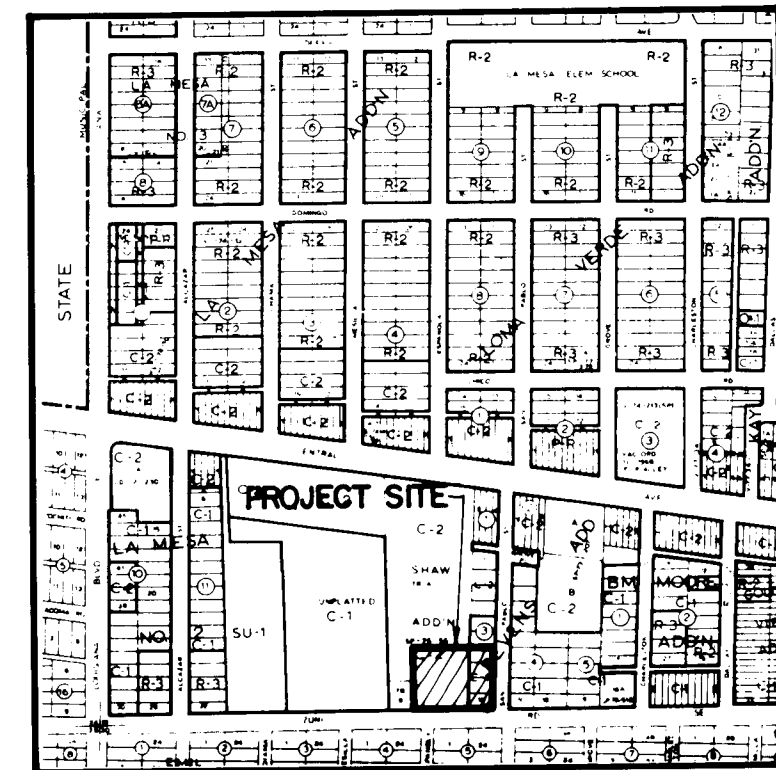


VICINITY MAP
SCALE: 1" = 800'

LEGEND
 48.47 EXISTING SPOT ELEVATION
 48.47 PROPOSED SPOT ELEVATION
 53.46 EXISTING CONTOUR
 48 PROPOSED CONTOUR
 SWALE
 PROPERTY LINE
 DRAINAGE BASIN BOUNDARY

LEGAL ADDRESS:
TRACT C-1 LOT 9

STREET ADDRESS:
7525 ZUNI RD SE

PROJECT BENCHMARK: TBM
TOP OF CURB ELEVATION AT THE SE CORNER OF TRACT C-1 AS SHOWN ABOVE
ELEVATION: 5349.49 FEET (MSLD)

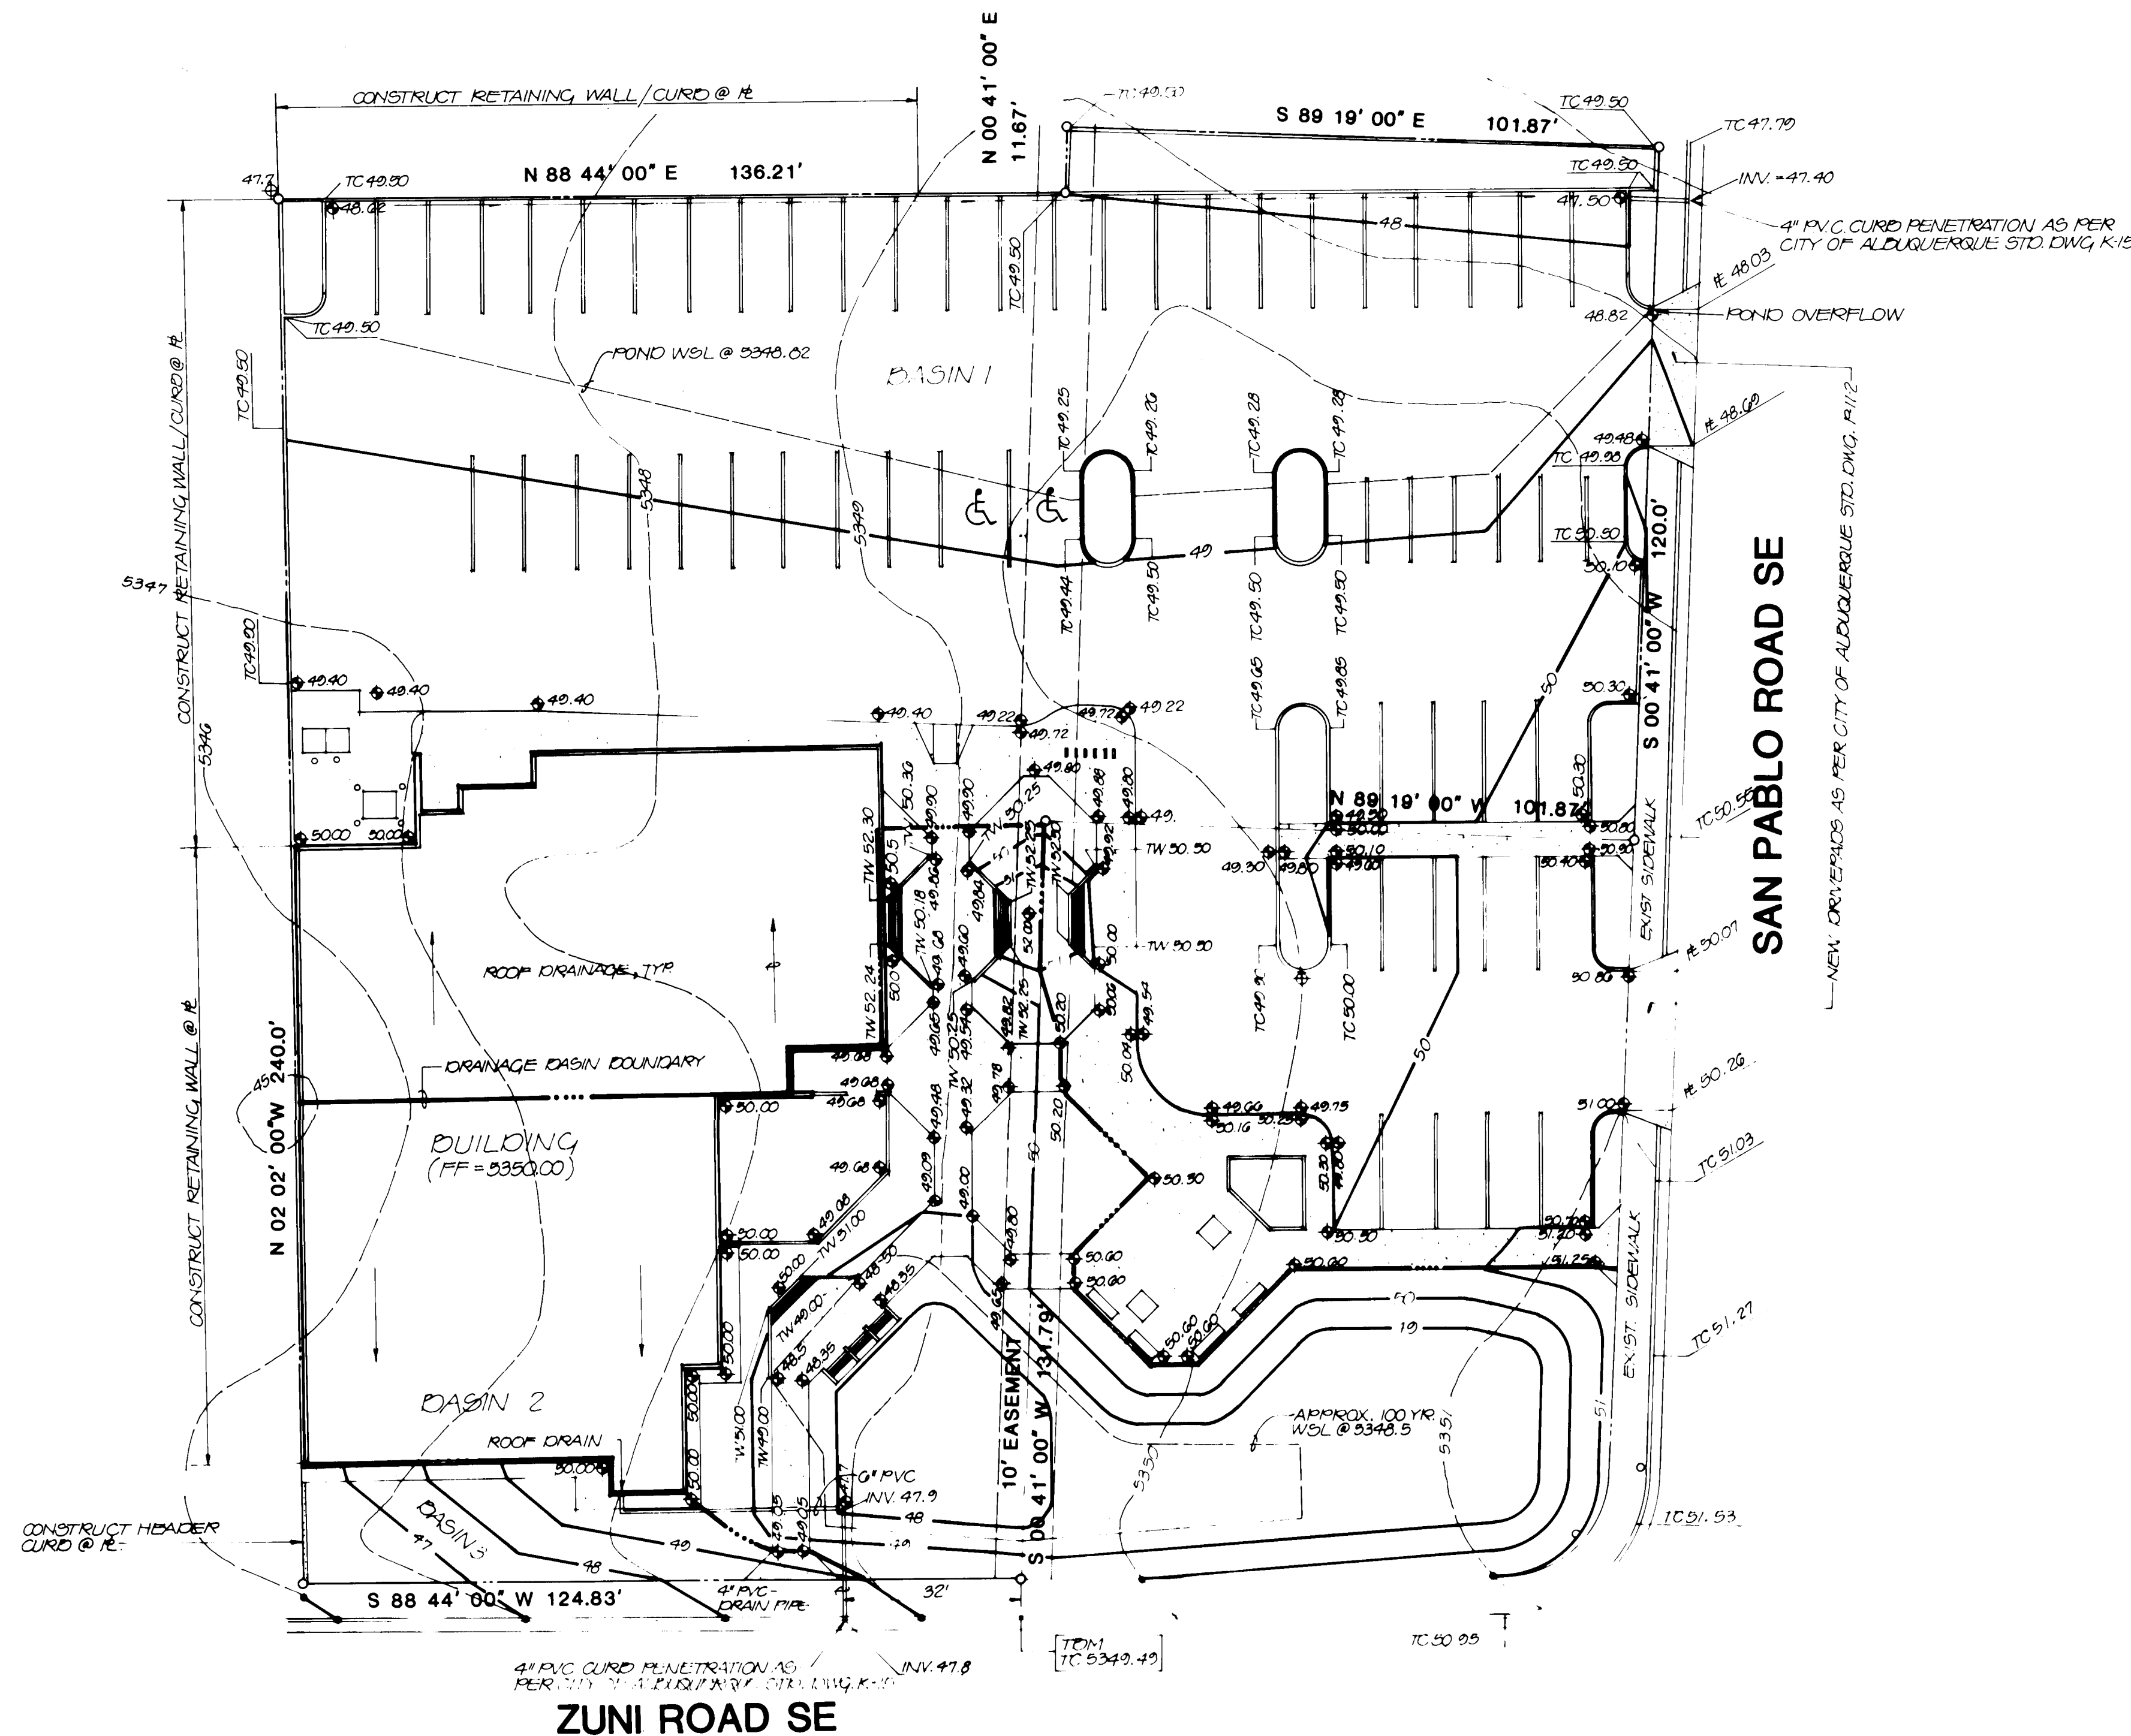


SITE PLAN
SCALE: 1" = 20'-0"

NOTE:

- PROVIDE A 3" DEEP UNIFORM COVERING OF 3/8" Ø GRAVEL IN PLANTING AREAS AND ALL UNPAVED AREAS OF THE SITE, UNLESS OTHERWISE NOTED.

QUANTITY BASE BID:	QUANTITY ALTERNATE BID:	COMMON NAME	BOTANICAL NAME	SIZE	NOTES
	8	ARIZONA CYPRESS	CYPRESSUS ARIZONICA	8-GAL.	MIN. 4' HT., FULL
	8		ARTEMISIA TRIDENTATA	3-GAL.	MIN. 12" HT.
15	15	BLANKET FLOWER	GAILLARDIA PULCHELLA	1-GAL.	
15	15	BLUE FLAX	LINUM PERENNE SEF. LEWISII	1-GAL.	MIN. 8" HT.
21	12	BROADLEAF JUNIPER	JUNIPERUS SABINA BROADLEAF	5-GAL.	MIN. 18" SPREAD
20	15	COYOTE BRUSH	BACCHARIS PILLARIS	1-GAL.	
		CREeping COTONEASTER	COTONEASTER ADPRESSUS	5-GAL.	MIN. 18" SPREAD
6	3	DESERT WILLOW	CHILOPSIS LINEARIS	15-GAL.	MIN. 5' HT.
		DWARF OREGON GRAPE	MAHONIA AQUIFOLIUM COMPACTA	5-GAL.	MIN. 10" H" AND FULL
2	2	HACKBERRY	CELTIS OCCIDENTALIS	2 1/2-GAL.	B+B, MIN. 10' HT.
3		HEAVENLY BAMBOO	NANDINA DOMESTICA	5-GAL.	MIN. 18" HT. & SPREAD
4	4	HONEYLOCUST	GLADITEIA TRACANTHOS 'SHADEMASTER'	2 1/2-GAL.	B+B
3	4	LONDON PLANE TREE	PLATANUS ACERIFOLIA	2 1/2-GAL.	B+B
5	3	NEW MEXICO OLIVE	FORESTIERA NEOMEXICANA	6" HT.	MIN. 5 STEMS, AVG. DIL 1 1/4"
		PHOTINIA	PHOTINIA FRASERI	5-GAL.	MIN. 1" 2', FULL
2	4	PIÑON	PIÑON EDULIS	8 HT./10 HT.	B+B, FREE PLANT
60	60	POTENTILLA	POTENTILLA FRUTICOSA 'GOLD DROP'	3-GAL.	12" MIN. HT.
4	5	SILVERBERRY	ELAEAGNUS RURGENS	5-GAL.	MIN. HT. 2'
5	4	SILVERLEAF COTONEASTER	COTONEASTER BUXIFOLIOUS	5-GAL.	
8	3	SPANISH BROOM	GENISTA HISPANICA	5-GAL.	
7	15	SQUARELEAF SUMAC	RHUS TRILOBATA	5-GAL.	18" MIN. HT.
		PURPLELEAF WINTERCREEPER	ELONVIOLE FORTUNEI COCCURATA	1-GAL.	2" MIN. SPREAD

NOTE.
ALTERNATE BID ONLY

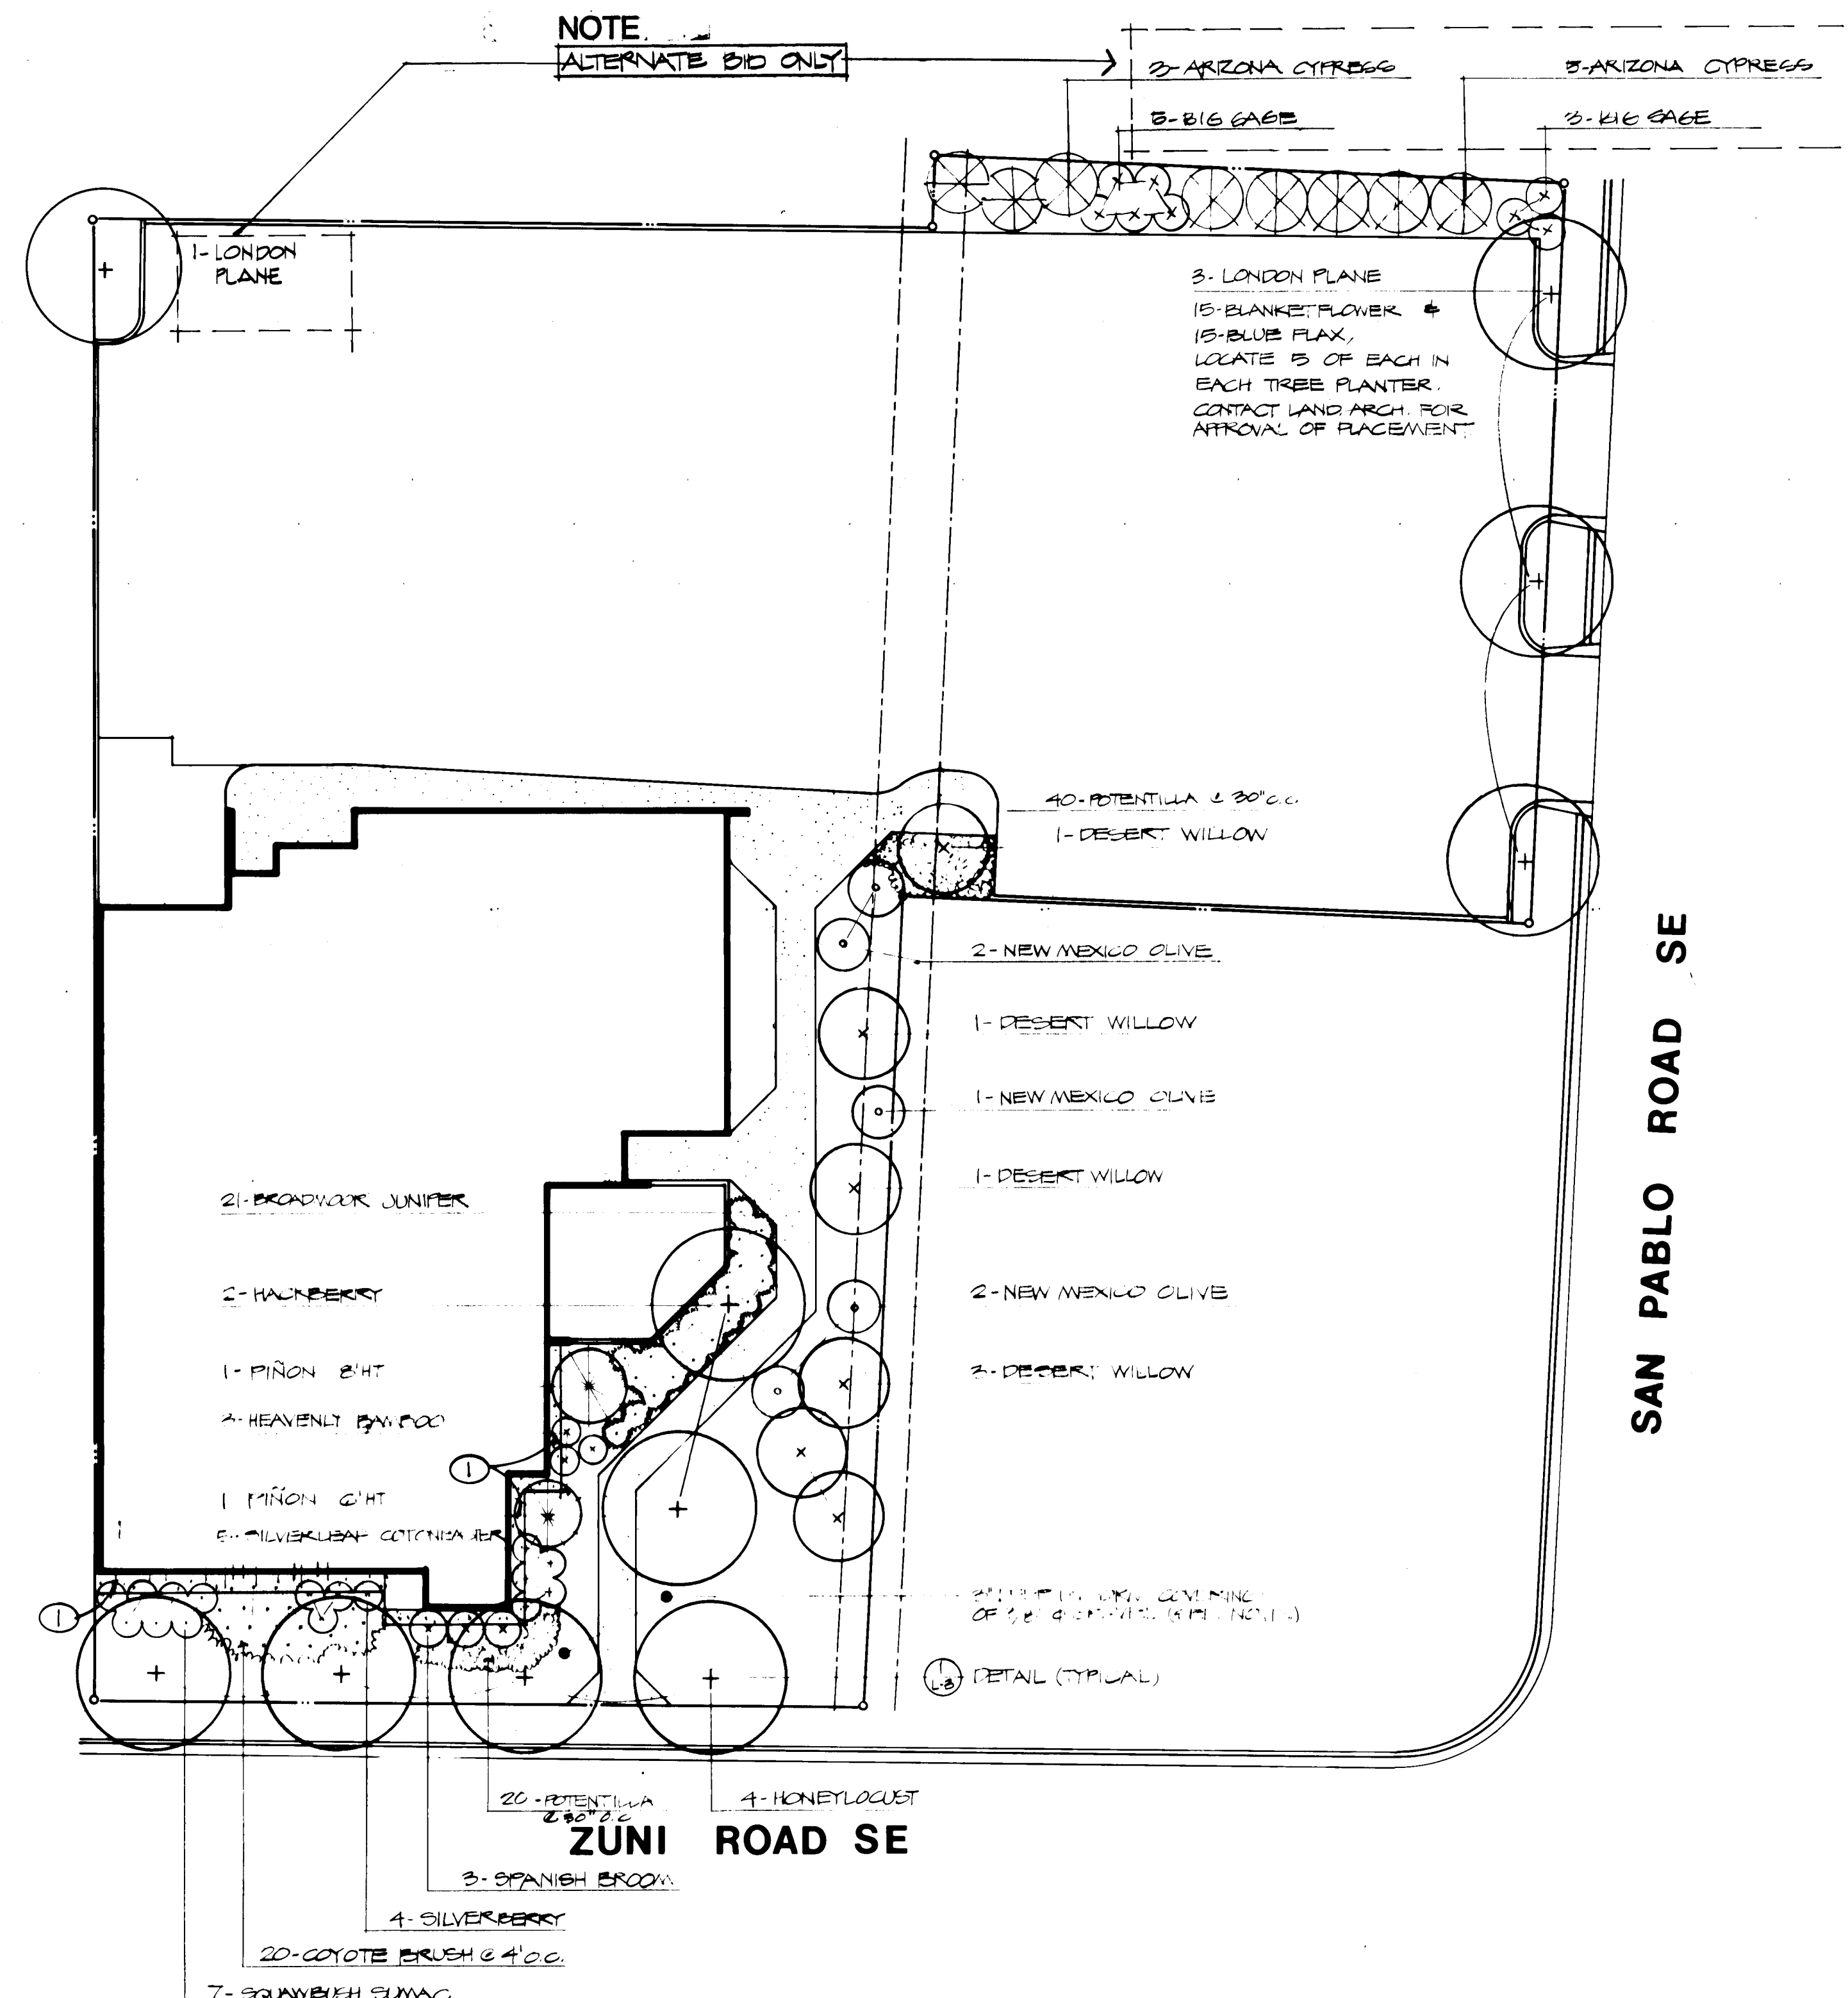

PLANTING IN PARKING LOT

40- POTENTILLA @ 30' O.C.
1- DESERT WILLOW

2- NEW MEXICO OLIVE

1- DESERT WILLOW

1- DESERT WILLOW

1- NEW MEXICO OLIVE

2- HAWK BERRY

DRIVEWAY COVERING OF GRASS & SAND (SEE NOTE 1)

1- DETAIL (TYPICAL)

12- BROADMOOR JUNIPER

4- SILVERLEAF COTONEASTER

1- PINON GHT

8- SQUAWBUSH SUMAC

3- PINON GHT

20- POTENTILLA @ 30' O.C.

4- HONEYLOCUST

3- SILVERBERRY

15- COYOTE BRUSH @ 4' O.C.

7- SQUAWBUSH SUMAC

ZUNI ROAD SE

3-SPANISH BROOM


 **Site Plan – Base Bid**
Scale: 1" = 20'

① 4" REINF CONC. MOISTURE
APRON @ 3' WIDE (TYPICAL)


11

SHEET 5 OF 26


Craig Campbell + Associates
LANDSCAPE ARCHITECTS SITE PLANNERS

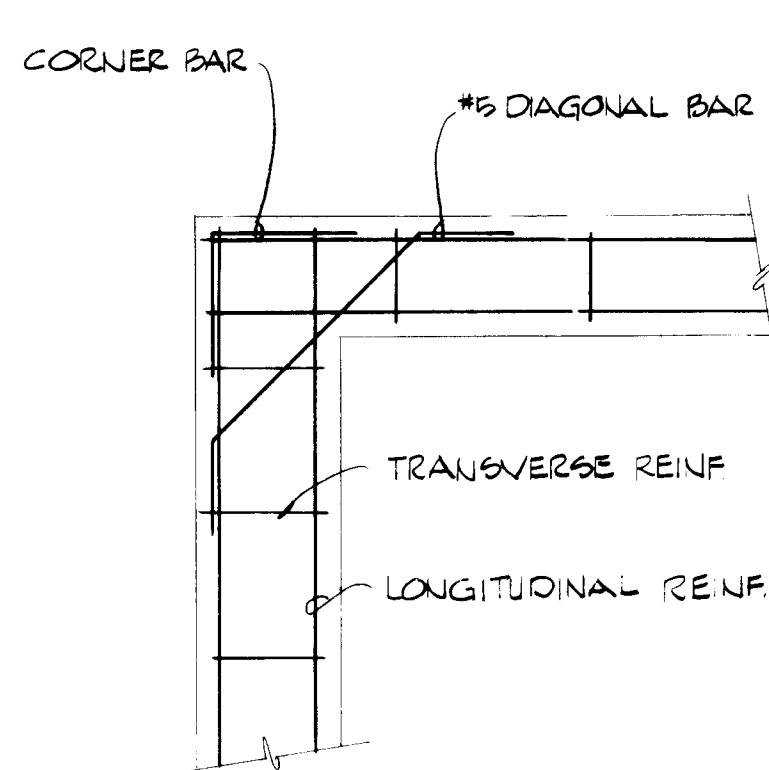


DETAIL F1

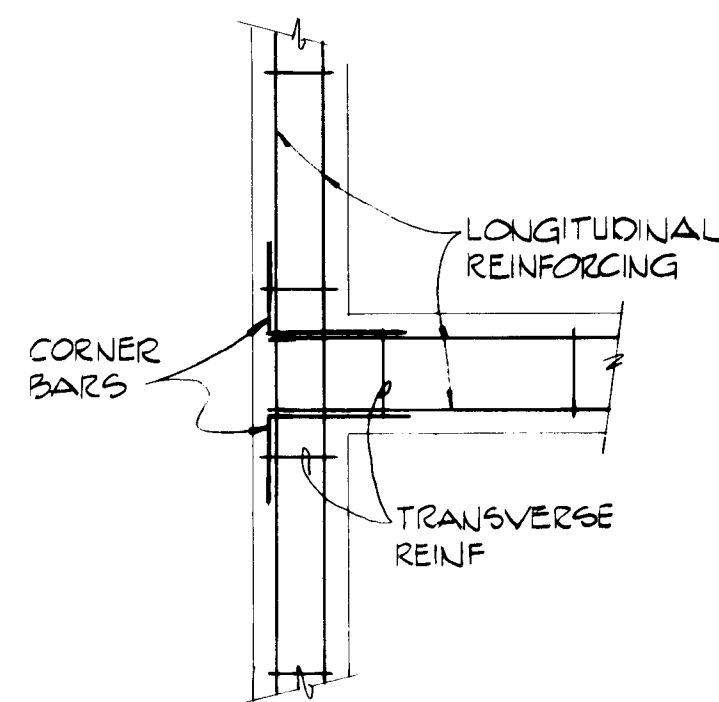

DETAIL F2

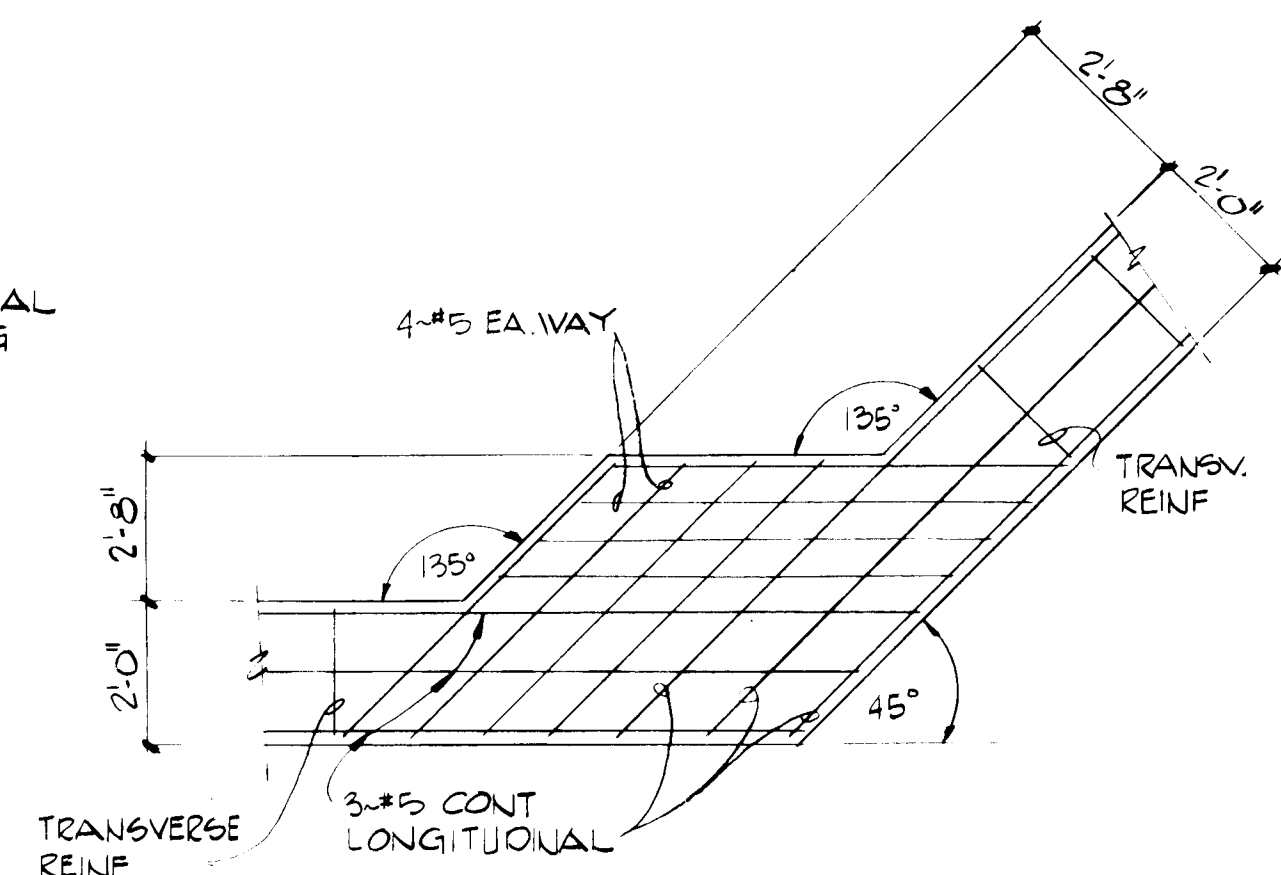

DETAIL F3

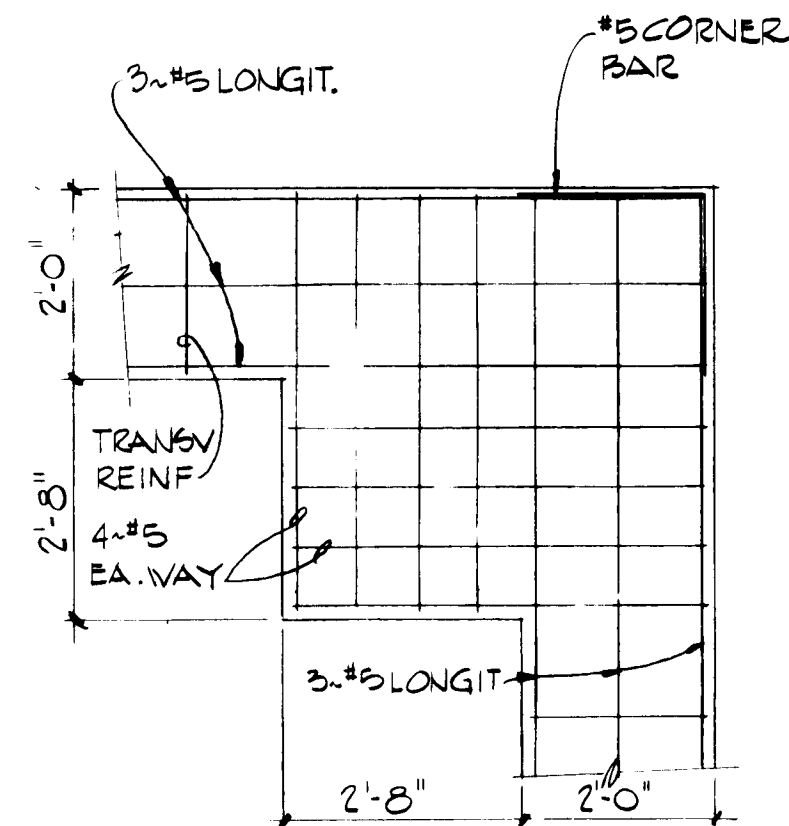


DETAIL F4


GENERAL NOTES - FOOTING DETAILS

- Except as otherwise shown, all strip footings are 12" thick and are centered under the walls they support. See FOUNDATION PLAN, Sheet S-1, for footing widths.
- Reinforcing shown in footing details F1 through F4 is at bottom of footing. See foundation sections on Sheet S-3 for top of footing reinforcing.
- Dowels to walls are not shown. See foundation sections on Sheet S-3 and masonry details this sheet for required wall reinforcing.
- Provide #5 corner and diagonal bars at locations shown in footing details. Legs of corner bars shall be not less than 24 inches in length and tails of diagonal bars shall be not less than 16 inches in length.
- Except as otherwise shown, bottom of footing reinforcing shall be as follows.


Footing Width	Longitudinal Reinforcing	Transverse Reinforcing
1'-8" and less	2-#5	#4 @ 32" o/c
1'-9" through 2'-8"	3-#5	#4 @ 24" o/c
2'-9" through 3'-8"	4-#5	#4 @ 12" o/c

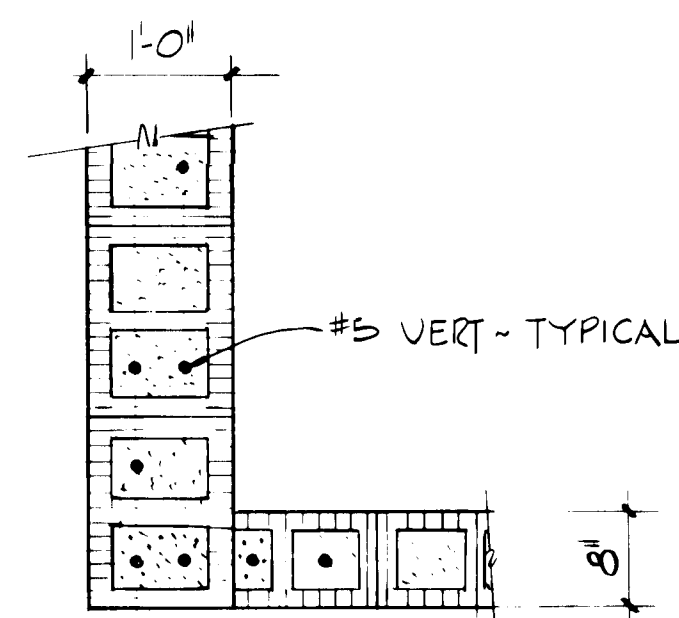


DETAIL M5

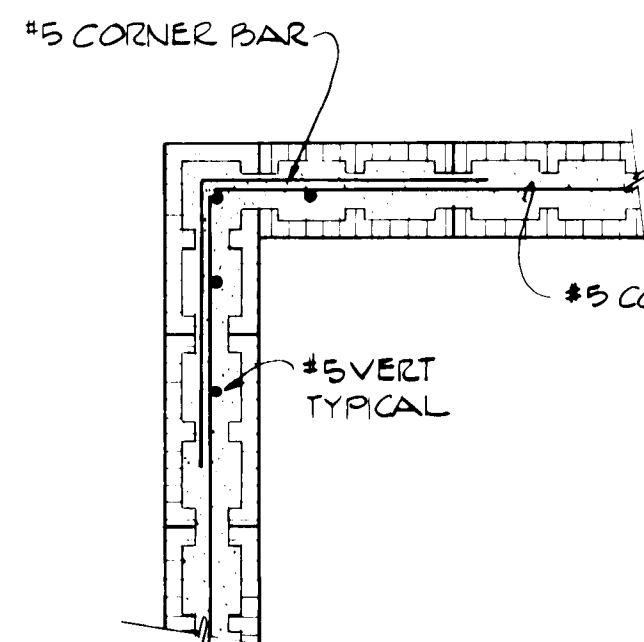


DETAIL M1

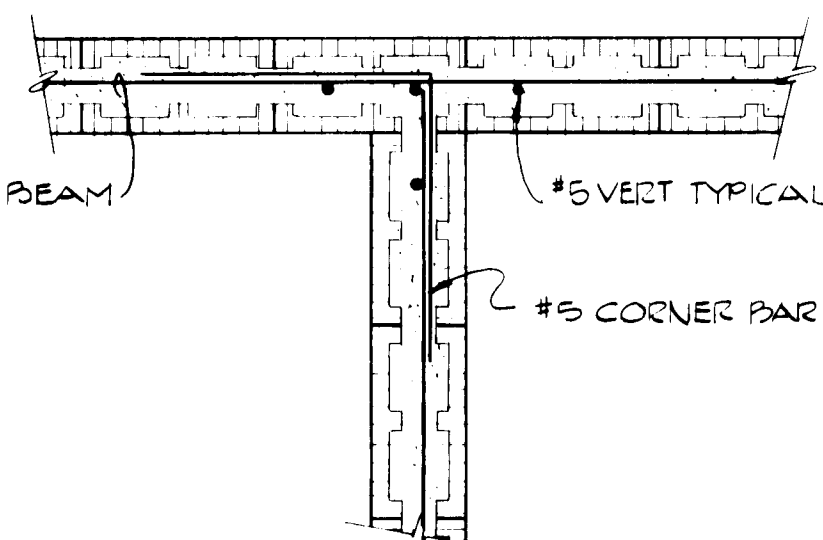

DETAIL M2

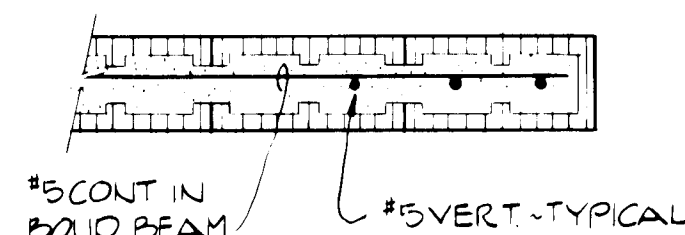

DETAIL M3

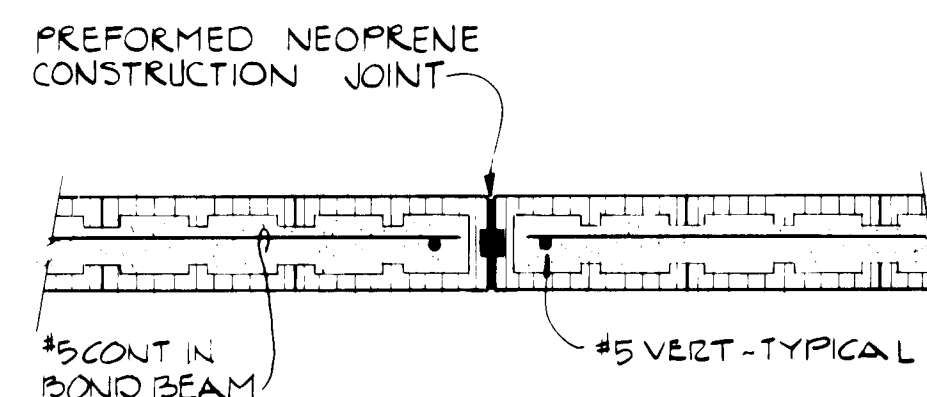

DETAIL M4

NOTE: TYPICAL AT END OF WALL OR JAMB OF OPENING.

NOTE: STOP MASONRY AND BOND BEAM REINFORCING, EXCEPT AT JOIST BEARING, AT CONTROL JOINT.

SCALE: F1-F4 3/8" = 1'-0"
M1-M5 3/4" = 1'-0"

GENERAL NOTES - CONCRETE CONSTRUCTION

- GENERAL.** Except as otherwise shown, reinforcing shall be placed in accordance with the latest edition of the CRSI Placing Manual.
- PLACEMENT OF REINFORCING AND OTHER ITEMS.** Reinforcing, dowels, bolts and any other inserts shall be fastened into position before concrete is placed. Drilled-in expansion anchors shall not be used except where specifically shown on the drawings. Vertical reinforcing in walls shall be placed at the center of the wall except as otherwise shown. The spacings shown for reinforcing and other anchorage and embedded items are maximums. Provide and install a sufficient number of items so that the spacings shown are not exceeded. The first and last items in a group of uniformly spaced items shall be located at not more than one-half the typical spacing nor 12 inches from the end of a structural element.
- CONTINUITY OF REINFORCING.**
 - General.** Except where lengths of reinforcing are given, reinforcing shall be continuous for the full length or width of a structural element. Hooks in reinforcing which are not otherwise detailed shall be standard ACI hooks. Splices in reinforcing which are not otherwise detailed shall be ACI Class C splices.
 - Vertical Reinforcing.** No splices permitted except as shown.

3. CONTINUITY OF REINFORCING. (Continued)

- Horizontal Reinforcing:**
 - Footings, stem walls, turned-down slab edges: Bars shall be lapped not less than 32 bar diameters nor 24 inches. Additional reinforcing shall be provided at corners, intersections and other discontinuities as shown in the details on this sheet and elsewhere on the drawings.
 - Concrete slabs: Welded wire fabric shall be lapped not less than one-and-one half meshes nor 8 inches on all sides.
- JOINTS.**
 - Slabs on grade: Joints shall be located where shown on the drawings except as otherwise approved by the Architect.
 - Footings, stem walls: Joints shall be placed at locations to be selected by the Contractor subject to the following restrictions. There shall be no joints within 4 feet of any corner or intersection. Joints in walls shall be offset from joints in footings by not less than 4 feet. Splices in reinforcing shall not be located within 4 feet of any joint in the concrete. Provide horizontal and vertical keys at all joints in walls or footings or between walls and footings.

GENERAL NOTES - MASONRY CONSTRUCTION

- REINFORCING.**
 - Vertical Reinforcing.** Except as otherwise shown in the masonry details (M1 through M4) on this sheet and the FOUNDATION PLAN, Sheet S-1, provide #5 @ 32" o/c, bars to be placed at the center of the wall. Place bars in lengths as long as practical; lap bars not less than 24 inches at splices. Provide #5 dowels from footings at all vertical bars with 8 inch (minimum) horizontal legs and 32" (minimum) vertical legs.
 - Horizontal Reinforcing.**
 - Bond Beams.** Reinforce with 1-#5 continuous. Lap bars not less than 24 inches at splices. Use #5 corner bars with 24 inch legs at all corners and intersections as shown in details M1 and M2 on this sheet. Provide continuous bond beams at tops of walls, at joist bearings, at roof level along non-bearing walls, and at the following elevations (measured to the top of the bond beam): 0'-0", 7'-4" and 8'-0". Where bond beams must be stepped to follow slope of roof, steps shall be 8 inches. Overlap bond beams and reinforcing not not less than 2'-8" at steps.
 - Bearing and Lintel Beams.** Provide and reinforce as shown on the roof framing sections.
 - Joint Reinforcing.** Provide type as specified at alternate courses. Maintain continuity at corners and intersections by use of prefabricated items or other approved means. Lap not less than 8" at splices in straight runs. Stop joint reinforcing at masonry control joints. See detail M4 this sheet.
- MASONRY UNITS.** Except as otherwise shown, provide units with manufacturer's standard finishes and colors at all locations, including construction below grade, where masonry will not be exposed to view after construction is complete. In other locations provide units with surface textures and colors as indicated on the building elevations on Sheets A2 and A2.5.
- ANCHOR BOLTS AND EXPANSION ANCHORS.** Drilled-in expansion anchors shall not be used except where specifically shown on the drawings. Anchor bolts and expansion anchors shall be firmly anchored in grout with both the cell containing the anchor and the cell below grouted solid. Where anchors are uniformly spaced, the first and last anchors shall be spaced at not more than half the typical spacing nor 16 inches from the end of a wall or beam.
- CONTROL JOINTS.** Control joints in masonry walls shall be located where shown on the foundation plan and the building elevations. Horizontal reinforcing masonry shall be stopped at control joints except at bond beams at joist bearings. Provide 1-#5 vertical on each side of each control joint as shown in detail M on this sheet.
- GROUT.** Grout lifts and free fall of grout in cmu wall shall not exceed 4 feet. Grout shall be placed using the low lift grouting method. Before grouting, cells and cavities to be grouted shall be cleaned of all trash, mortar droppings and fins, and standing water. All cells below finish floor shall be grouted solid. Except at the tops of walls, shear keys shall be provided at the top course of all cells containing vertical reinforcing by stopping the grout pour at midheight of the top course being grouted. Masonry beams shall be grouted in one lift with no construction joints permitted. Mortar shall not be used as grout.

THE BURNS/PETERS GROUP
ARCHITECTS PLANNERS

8000 PENNSYLVANIA CIRCLE N.E. ALBUQUERQUE, NM 87110 505/265-3645

BURNS/PETERS GROUP ARCHITECTS

RECORD DRAWING

DATE: 12 SEPT 94

Charles Bacchus

REVISIONS

Charles Bacchus

ENGINEER

STATE OF NEW MEXICO

RONALD L. PETERS

REGISTERED ARCHITECT

NO. 788

THE EAST-CENTRAL MULTI-SERVICE CENTER

PROJECT NO. 8205

DATE MAY '88

S2

SHEET 9 OF 26




THE BURNS PETERS GROUP
ARCHITECTS PLANNERS


4000 PENNSYLVANIA AVENUE, N.E. ALBUQUERQUE, N.M. 87110 TEL. 265-3645

NOTES

1. TWO (2) SWITCHES, Sa SHALL CONTROL CENTER LAMP AND Sb SHALL CONTROL TWO OUTSIDE LAMPS IN ALL 2' X 4' FIXTURES IN THIS ROOM.
2. TWO (2) SWITCHES, Sa SHALL CONTROL CENTER PAIR OF LAMPS AND Sb SHALL CONTROL TWO OUTSIDE PAIR OF LAMPS IN 4' X 4' FIXTURES IN THIS ROOM.
3. SEE SITE PLAN FOR CONTINUATION.
4. FURNISH AND INSTALL 30A/2P LIGHTING CONTACTOR FOR CONTROL OF EXTERIOR LIGHTING. INSTALL CONTACTOR IN BOTTOM SKIRT OF PANEL "A". CONTACTOR SHALL BE CONTROLLED BY PHOTO-CELL ABOVE PANEL "A".
5. EXTEND TO CIRCUIT INDICATED THRU LIGHTING CONTACTOR. USE #10 CONDUCTORS.
6. LIGHT FIXTURES SHOWN SHALL ONLY BE INSTALLED UNDER ADDITIVE ALTERNATE. REFER TO ARCHITECTURAL DRAWINGS A-2 FOR DETAILS.

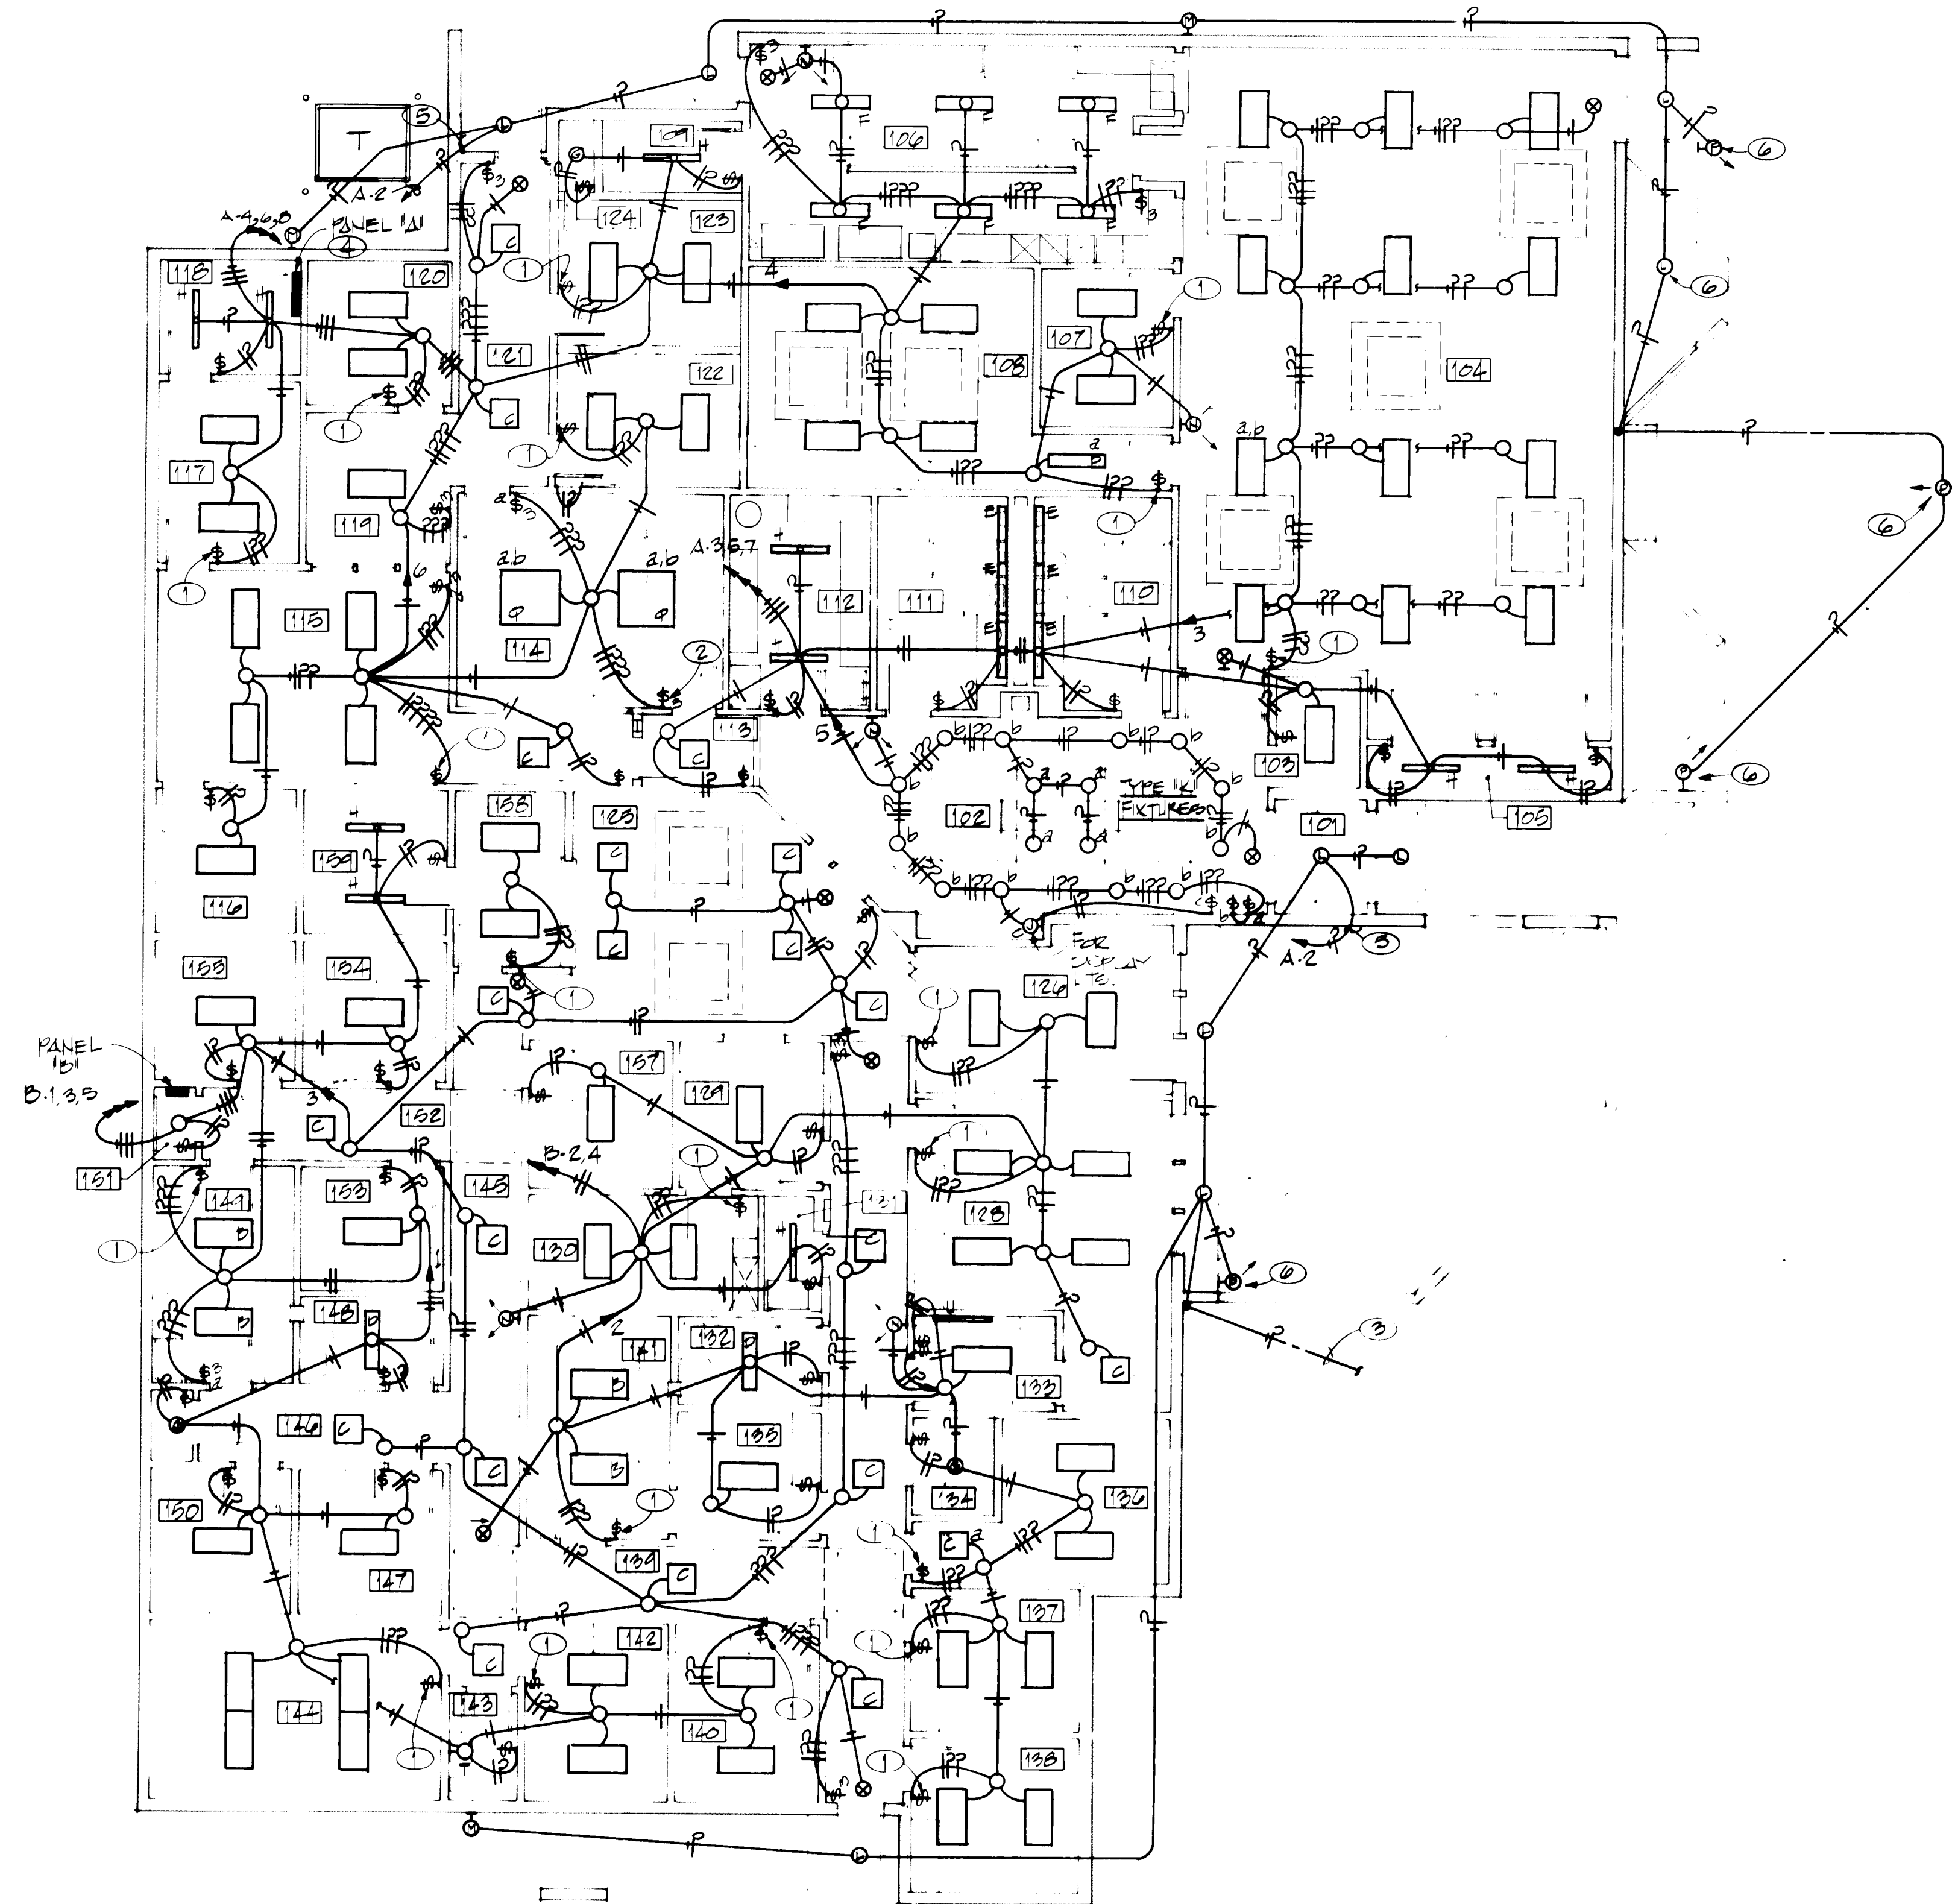

NOTE: REFER TO ARCHITECTURAL REFLECTED
CEILING PLAN FOR EXACT LOCATION OF
LIGHT FIXTURES.

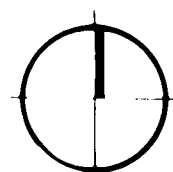

PLAN - LIGHTING

SCALE: 1/8" = 1'-0"

NOTE: ALL 2' X 4' FIXTURES SHALL BE TYPE
"A" UNLESS OTHERWISE INDICATED.



BURNS/PETERS GROUP-ARCHITECTS

RECORD DRAWING

DATE: 12 SEPT 84

Charlie Lew

REVISIONS AS BUILT AUG 1984

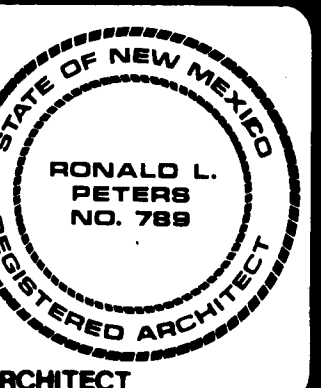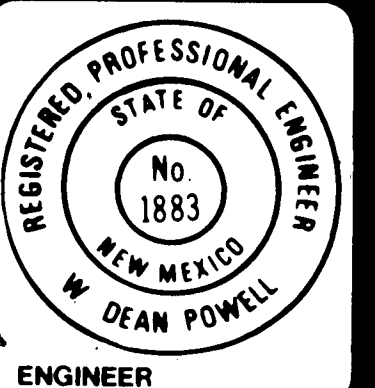

THE
EAST-CENTRAL
MULTI-SERVICE
CENTER

PROJECT NO. 8205

DATE MAY 88

E1
SHEET 34 OF 36

26 1584 0484

NOTES



- SERVICE ENTRANCE EQUIPMENT, SEE SITE PLAN RISER DIAGRAM FOR DETAILS.
- 4' X 8' X 3/4" PLYWOOD TELEPHONE BACKBOARD WITH #6 GROUND PER MOUNTAIN BELL REQUIREMENTS.
- 2" C. TO PROPERTY LINE. SEE SITE PLAN FOR DETAILS.
- J-BOX FOR CONNECTION OF FIRE PROTECTION SYSTEM. CONNECT TO GAS SOLENOID VALVE AND FIRE PROTECTION SYSTEM.
- NOT USED
- EXTEND TO LIGHT FIXTURE.
- LABEL SWITCH "TOILET EXHAUST".
- PROVIDE AND INSTALL 12"x12"x4" D CABINET WITH 24V CONTROL TRANSFORMER AND RELAYS AS SHOWN IN CONTROL DIAGRAMS.
- NUMBER OF CONTROL WIRES AS REQUIRED IN CONDUIT.
- 120V, 10, 30A.
- J-BOX FOR CONNECTION OF KITCHEN HOOD.
- J-BOX FOR CONNECTION OF ALARM SYSTEM ANNUNCIATOR.
- 1" CONDUIT FOR FUTURE ALARM SYSTEM.
- J-BOX FOR CONNECTION TO ALARM SYSTEM. VERIFY LOCATION WITH OWNER PRIOR TO ROUGH-IN.
- J-BOX FOR CONNECTION TO 120V POWER FOR FUTURE ALARM SYSTEM.

BURNS/PETERS GROUP-ARCHITECTS

RECORD DRAWING

DATE 12 SEPT 84
Charlie L. Peters

REVISIONS AS BUILT AUG 1984

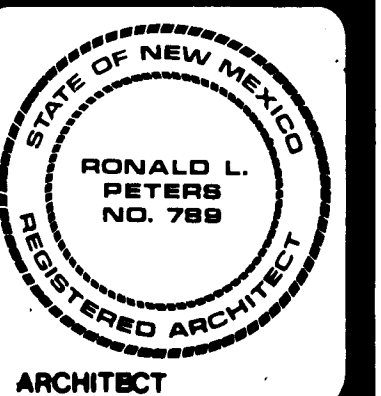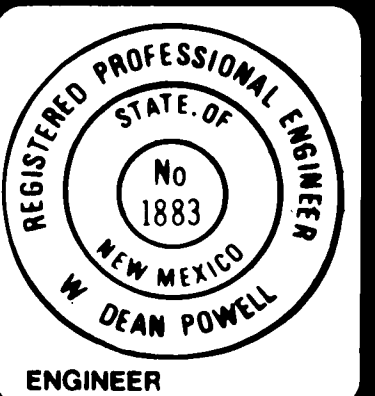


THE
EAST-CENTRAL
MULTI-SERVICE
CENTER


PROJECT NO. 8205

DATE MAY 88



E2
SHEET 35 OF 36

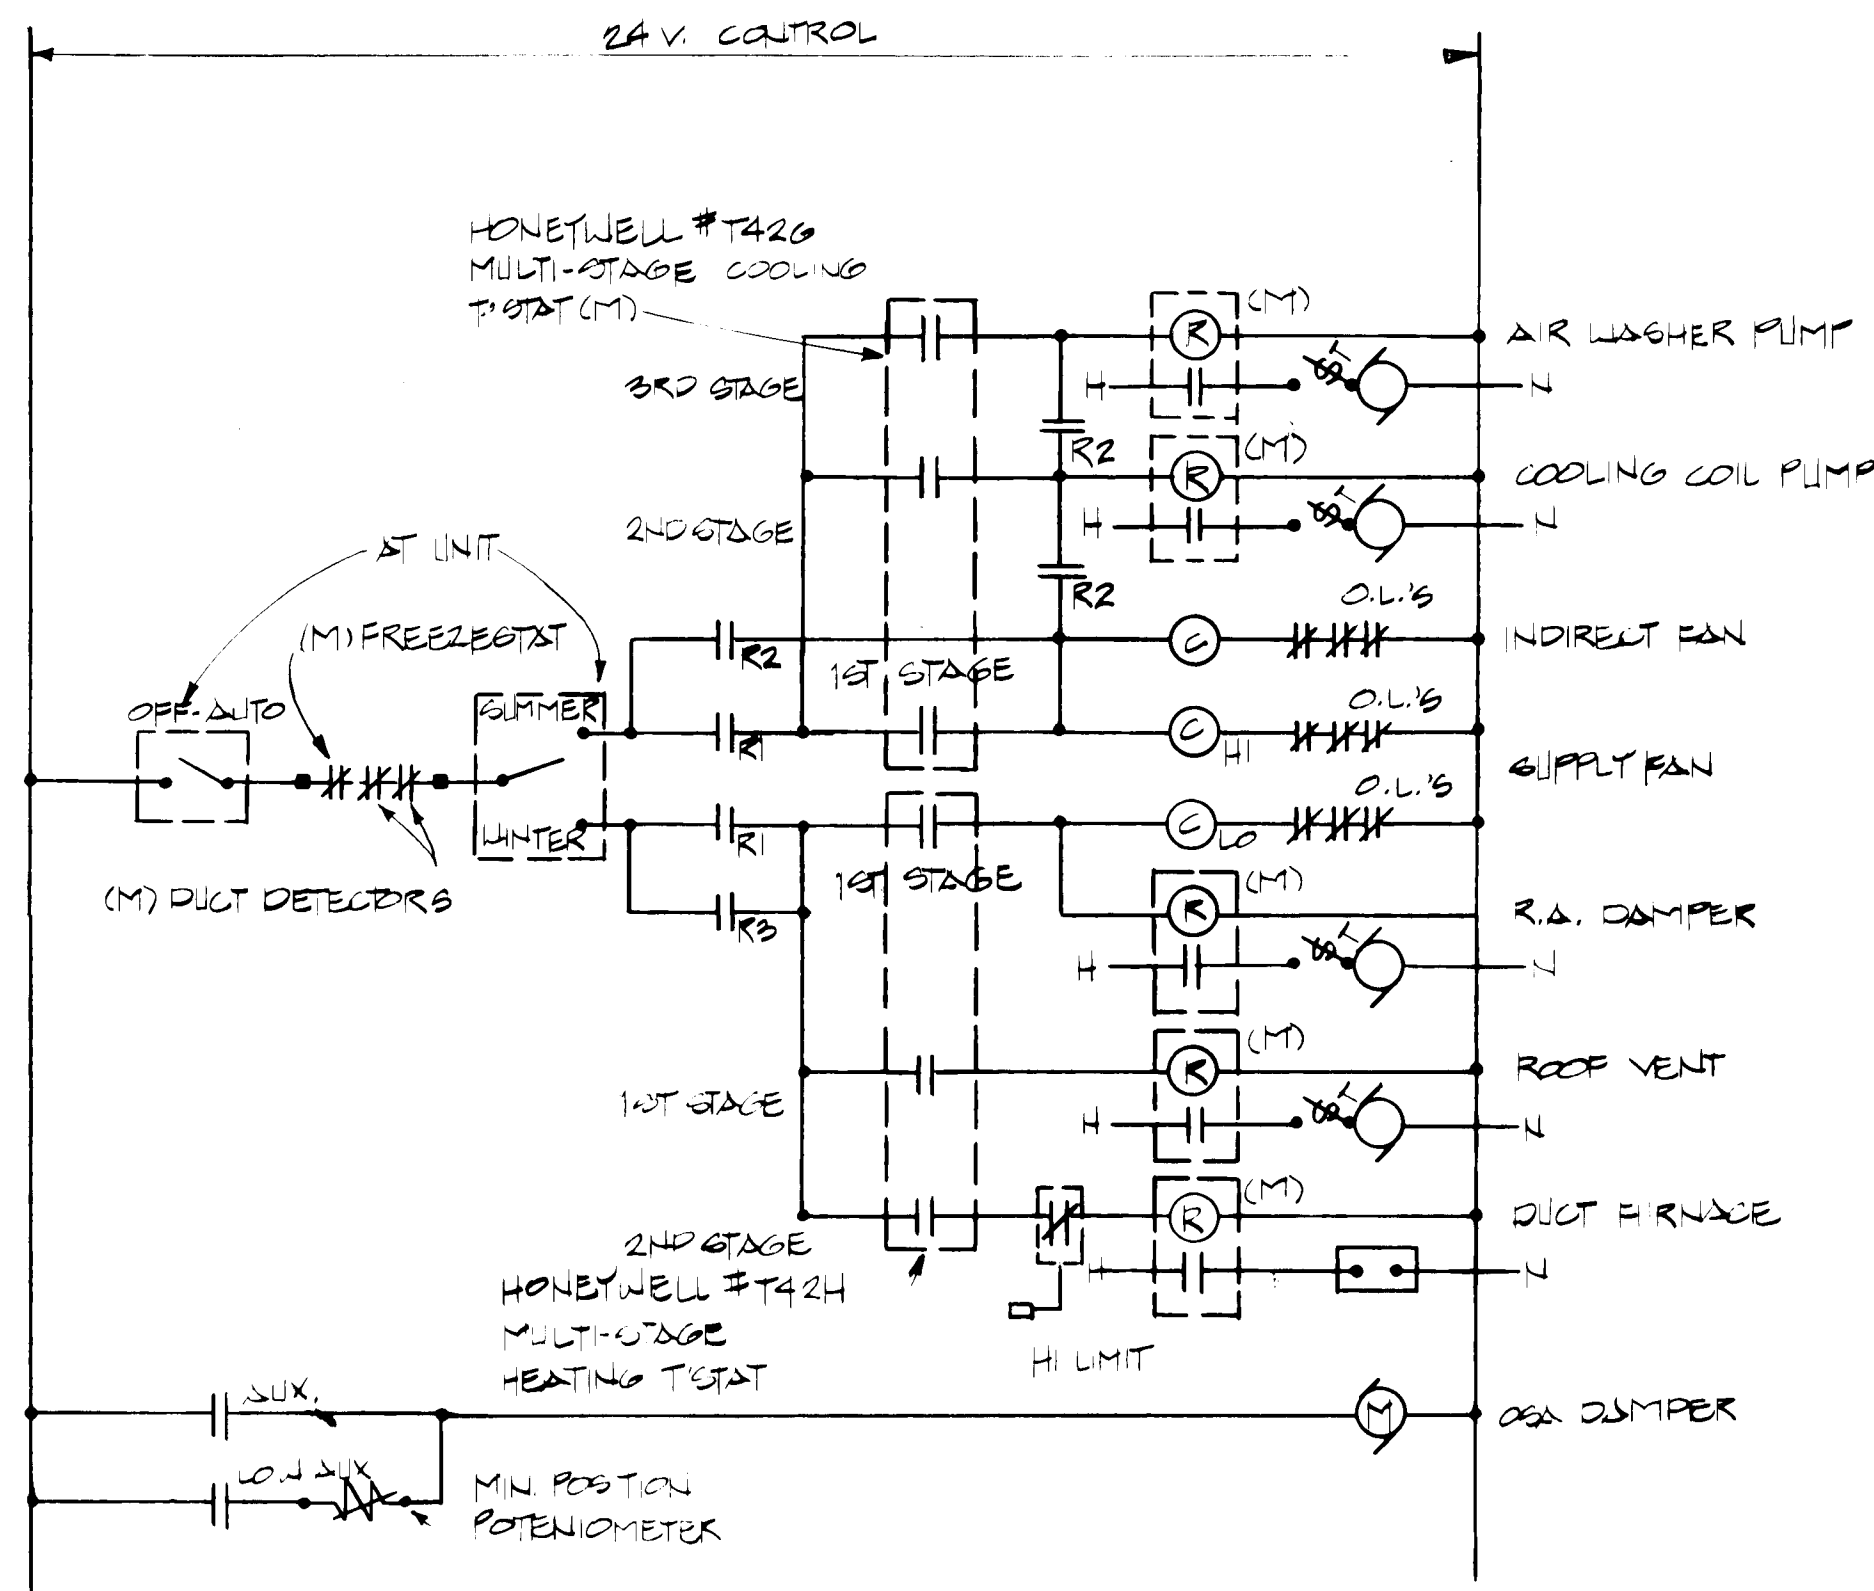


AIR HANDLING UNIT (AH-1) (AH-2)

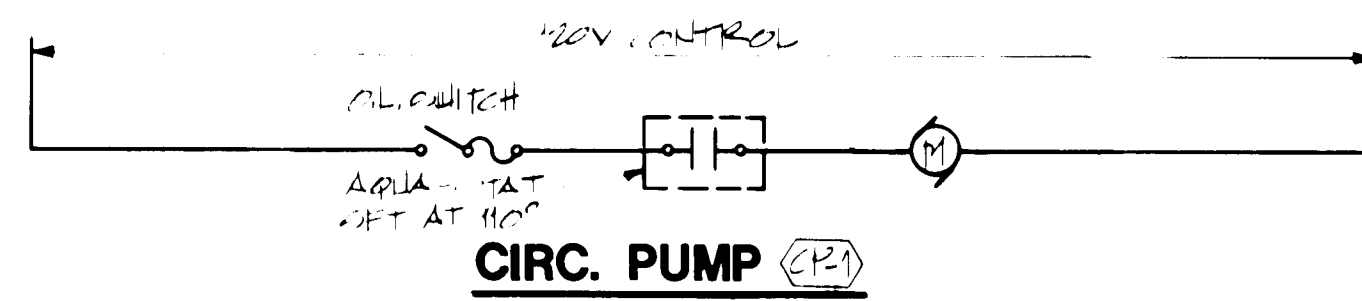

CIRC. PUMP (C-1)

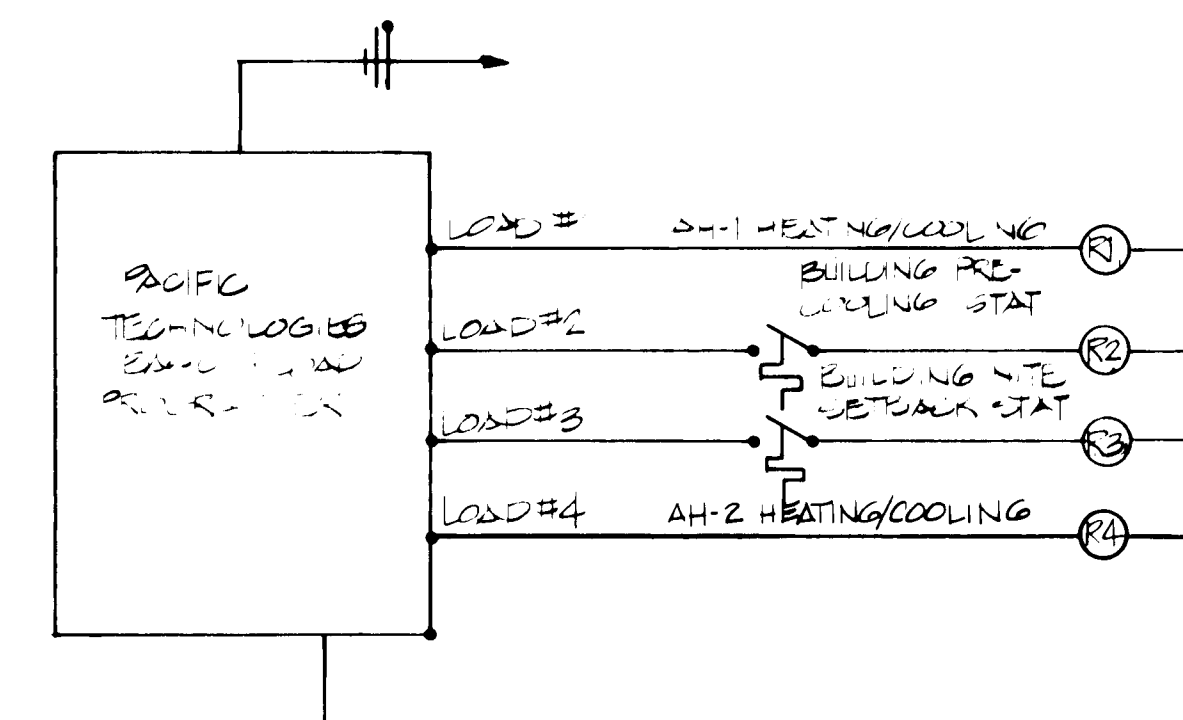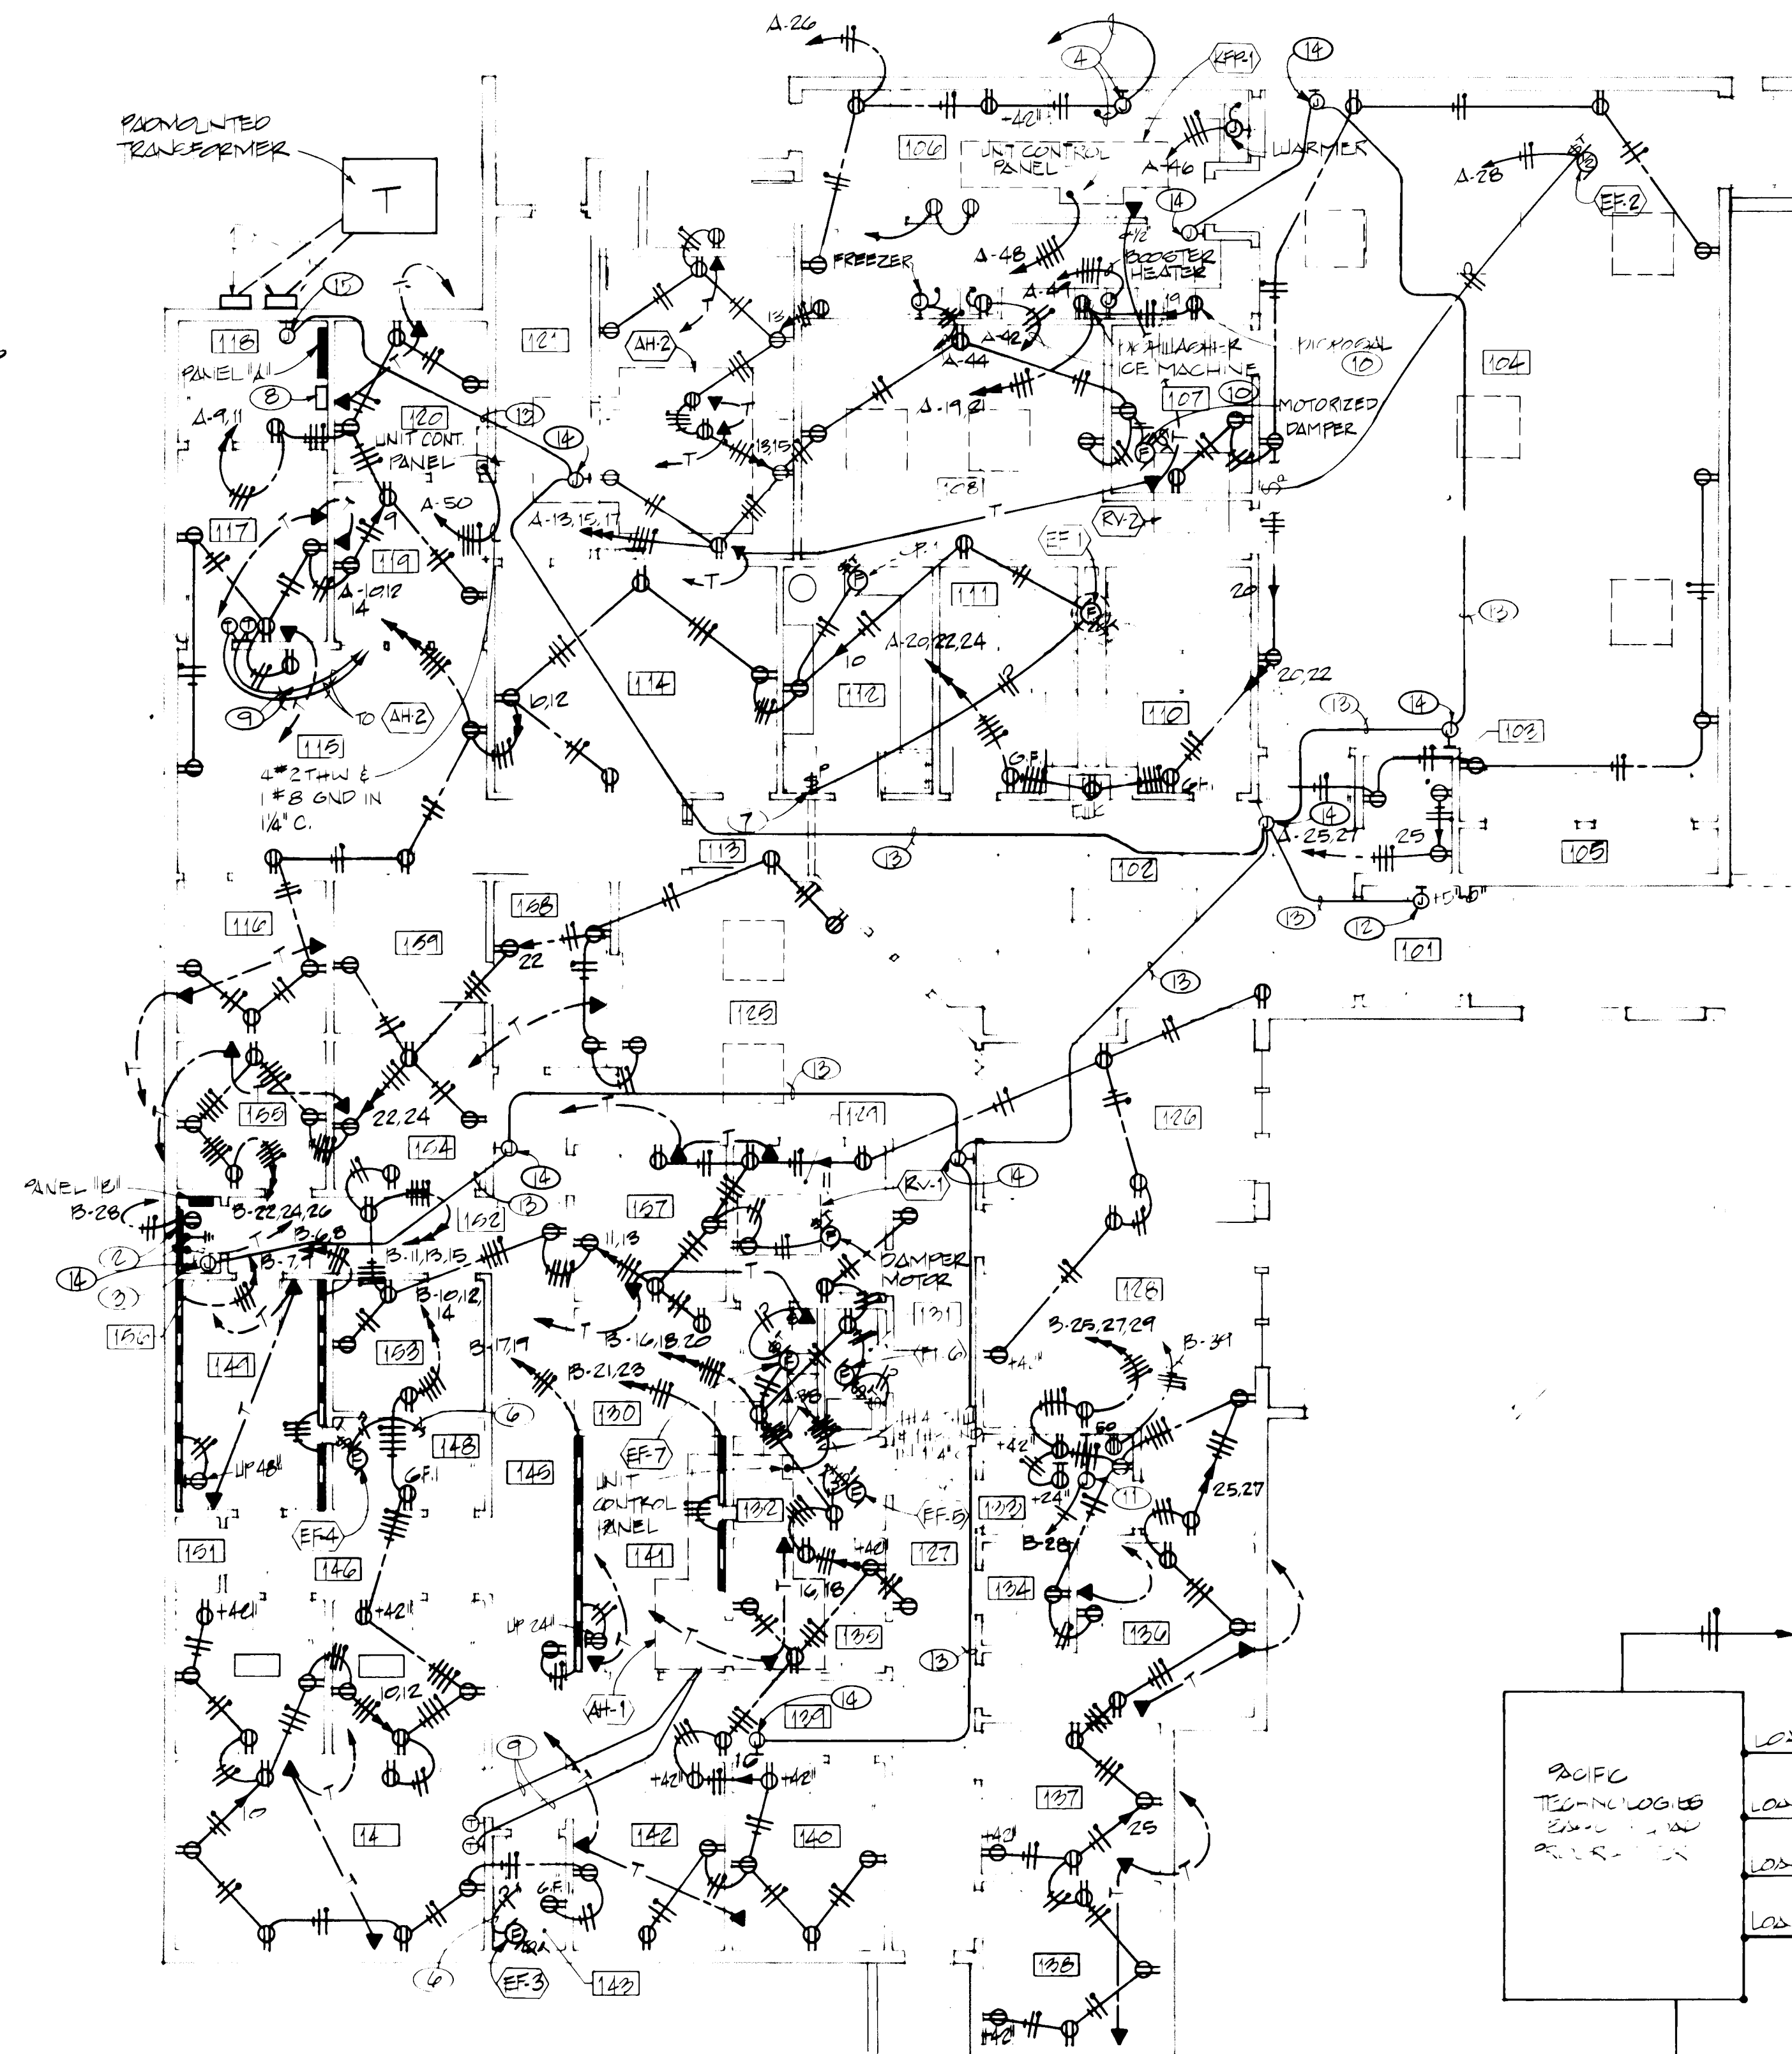

LOAD PROGRAMMER DIAGRAM

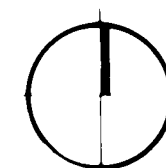

PLAN - POWER & SPECIAL SYSTEMS
SCALE: 1/8" = 1'-0"

CONTROL DIAGRAMS

26 1589 35B4

PANEL SCHEDULE					FIXTURE SCHEDULE			SYMBOL LEGEND		
PANEL DESCRIPTION	CCT. NO.	C/B	WIRE	LOAD DESCRIPTION	TYPE	DESCRIPTION	LAMPS	MOUNTING	SYMBOL	DESCRIPTION
PANELS 120/208V - 3Ø, 4W, 225A MLO, SURFACE MOUNTED, BOTTOM FEED, FULL SKIRTS.	PANEL "A" 2 SECTION				A	BENJAMIN #AGA-7234-4	3/F40/CW	RECESSED	⊙	CEILING OUTLET AND FIXTURE.
	1 THRU 41	20A/1P	#12	LIGHTING, RECEPT. MISC. MECHANICAL & SPARE.	B	BENJAMIN #AFA-7234-4	3/F40/CW	RECESSED	⊙	BRACKET OUTLET AND FIXTURE.
	42-44	30A/1P	#10	MECH. & KITCHEN EQUIPMENT	C	BENJAMIN #AGA-7224-2	2/U40/CW	RECESSED	⊙	FLUORESCENT OUTLET AND FIXTURE.
	46	20A/2P	#12	KITCHEN EQUIPMENT	D	BENJAMIN #AGA-2224-4	2/F40/CW	RECESSED	⊙	EVAPORATIVE COOLER SWITCHES, ONE "ON-OFF" FOR FAN AND ONE "ON-OFF" FOR PUMP.
	48	20A/3P	#12	MECHANICAL	E	LITE CONTROL #WD-66-2-4-RS-CWM	2/F40/CW	WALL/CEILING INTERSECTION	⊙	SINGLE POLE WALL SWITCH.
	49	30A/3P	#10		F	LITE CONTROL #S-DE-21-2-4-RS	2/F40/CW	SURFACE	⊙	THREE WAY WALL SWITCH.
	51 THRU 54	1 POLE	---	SPACES	G	PORCELAIN LAMPHOLDER	1/75W/1F	SURFACE	⊙	PILOT SWITCH.
	50	100A/3P	#2	MECHANICAL EQUIPMENT	H	UTILITY STRIP	2/F40/CW	SURFACE	⊙	THERMAL SWITCH, WEATHERPROOF IF INSTALLED IN WET OR EXTERIOR LOCATIONS.
	45, 47	30A/1P		SPARE	K	PRESCOLITE #79-832	1/75W/ER30 FLOOD	RECESSED	⊙	JUNCTION BOX FLUSH IN WALL, HEIGHT AS NOTED WITH CONNECTION TO EQUIPMENT.
	PANEL "B"				L	PRESCOLITE #9056-70HPS-M71-120V	1/70W/HPS	RECESSED	⊙	DUPLEX GROUNDING TYPE CONVENIENCE OUTLET INSTALLED WITHIN ELECTRIC WATER COOLER ENCLOSURE.
	1 THRU 37	20A/1P	#12	LIGHTING, RECEPTACLES, SPARES	M	MOLDCAST #89020-12-82-00	1/70W/HPS		⊙	DUPLEX CONVENIENCE OUTLET, UP 15" OR AS INDICATED. WP DENOTES WEATHERPROOF.
	39	50A/2P	#6	RANGE	N	DUAL-LITE #CPL2-0	FURNISH W/ FIXT.	BRK. UP +7'-0"	⊙	250 VOLT, 3 WIRE RANGE TYPE OUTLET, FLUSH MOUNTED AT HEIGHT INDICATED AND FURNISHED. FOR RATED AMPERAGE.
	38	100A/3P	#1/0	AH-1	P	MC PHILBEN #3W-436	1/100W/MV GE DLX WH	SEE PLANS	⊙	THERMOSTAT, UP 48" UNLESS OTHERWISE INDICATED.
					Q	BENJAMIN #AGB-27264-4	6/F40/CW	RECESSED	⊙	CLOCK, FLUSH MOUNTED AT HEIGHT AS INDICATED.
					R	MOLDCAST #3105-A-70-120V-10' ②	1/70W/HPS	POLE 10'-0"	⊙	SPECIAL CABINET, TELEPHONE TYPE OR AS NOTED.
				S	KIM #1B-EKG40J/250HPS120/BLE/ PKG-25-BLE	1/250W/HPS	POLE 25'-0"	⊙	ELECTRIC PANEL, SEE PANEL SCHEDULE FOR CHARACTERISTICS.	
				T	ARTMETAL #9000	2/60W/1F	BKT. OVER MIRROR	⊙	MOTOR CONNECTION WITH HP INDICATED.	
				U	ALKCO#	2	UNDER CABINET	⊙	MOTOR CON. HOLLER, SIZE AND POLES FOR MOTOR FURNISHED, IN NEMA 1 ENCLOSURE UNLESS OTHERWISE NOTED.	
				⊗	DEVINE #GS80SR SERIES WITH ARROWS AS SHOWN	FURNISH W/ FIXT.	CEILING SURFACE	⊙	SAFETY SWITCH, TO HAVE POLES AND RATING REQUIRED, TO BE NEMA 3R IF INSTALLED OUTDOORS.	
								⊙	MOTOR CONNECTION FOR FRACTIONAL HP MOTOR (LESS THAN 1/3 HP). PROVIDE THERMAL O.L. SWITCH ADJACENT TO ALL MOTORS UNLESS SWITCH IS SHOWN ELSEWHERE ON PLAN.	
								⊙	JUNCTION BOX INSTALLED ABOVE CEILING WITH FLEXIBLE CONDUIT CONNECTION TO LAY-IN FIXTURES. MINIMUM 4'-0" LENGTH OF CONDUIT WITH CONDUCTORS REQUIRED ALONG WITH GREEN WIRE GROUND.	
								⊙	PHOTOCELL LIGHTING CONTROLLER, PRECISION #T-15 MOUNTED ON 1/2" RIGID CONDUIT STUBBED 12" ABOVE ROOF WITH WINDOW FACING NORTH.	
								⊙	BRANCH CIRCUIT IN WALLS OR CEILING WITH CONDUCTORS INDICATED.	
								⊙	BRANCH CIRCUIT IN WALLS OR UNDER FLOOR WITH CONDUCTORS INDICATED.	
								⊙	HOME RUN TO PANEL, WITH BRANCH CIRCUIT NUMBERS INDICATED.	
								⊙	TELEPHONE CONDUIT, MINIMUM 3/4" WITH PULL WIRE.	
								⊙	1" CONDUIT WITH PULL WIRE TO TELEPHONE TERMINAL CABINET.	
								⊙	TELEPHONE OUTLET, UP 15" OR AS INDICATED.	
								⊙	"WIREMOLD" #20GA618 WIRED FOR 2 CIRCUITS. SURFACE MOUNTED. INSTALL ON WALL ON TOP OF SPLASH.	

LOAD SUMMARY - 120/208V, 3Ø, 4W

	CONNECTED	EST. DEMAND
PANEL "A" -	61 KW (171A)	50 KW (139A)
PANEL "B" -	48 KW (130A)	43 KW (119A)

SHORT CIRCUIT AVAILABILITY

BASED ON MAXIMUM BUILDING TRANSFORMER S.C. LET THRU WITH UNLIMITED PRIMARY S.C. CURRENT.


(PANEL "A")	
ASSUME BUILDING TRANSFORMER	150 KVA
TRANSFORMER IMPEDANCE %	7
S.C.A. @ SWITCH	20,833 AMPS
LOAD SIDE SWITCH	4,800 AMPS
(PANEL "B")	
ASSUME BUILDING TRANSFORMER	150 KVA
TRANSFORMER IMPEDANCE %	7
S.C.A. @ SWITCH	20,833 AMPS
LOAD SIDE SWITCH	4,800 AMPS
PROVIDE MINIMUM 10,000 AMP BRACING IN PANEL "A" & "B".	

ENERGY CONSERVATION

THE PLANS AND SPECIFICATIONS AS DESIGNED ARE IN CONFORMANCE WITH THE STATE OF NEW MEXICO ELECTRICAL CODE, ARTICLE 290 ENERGY CONSERVATION. LIGHTING BUDGET:

17,400 WATTS / 10,136 SQ. FT. 1.72 W/SQ. FT.

W. DEAN POWELL
P.E. #1883

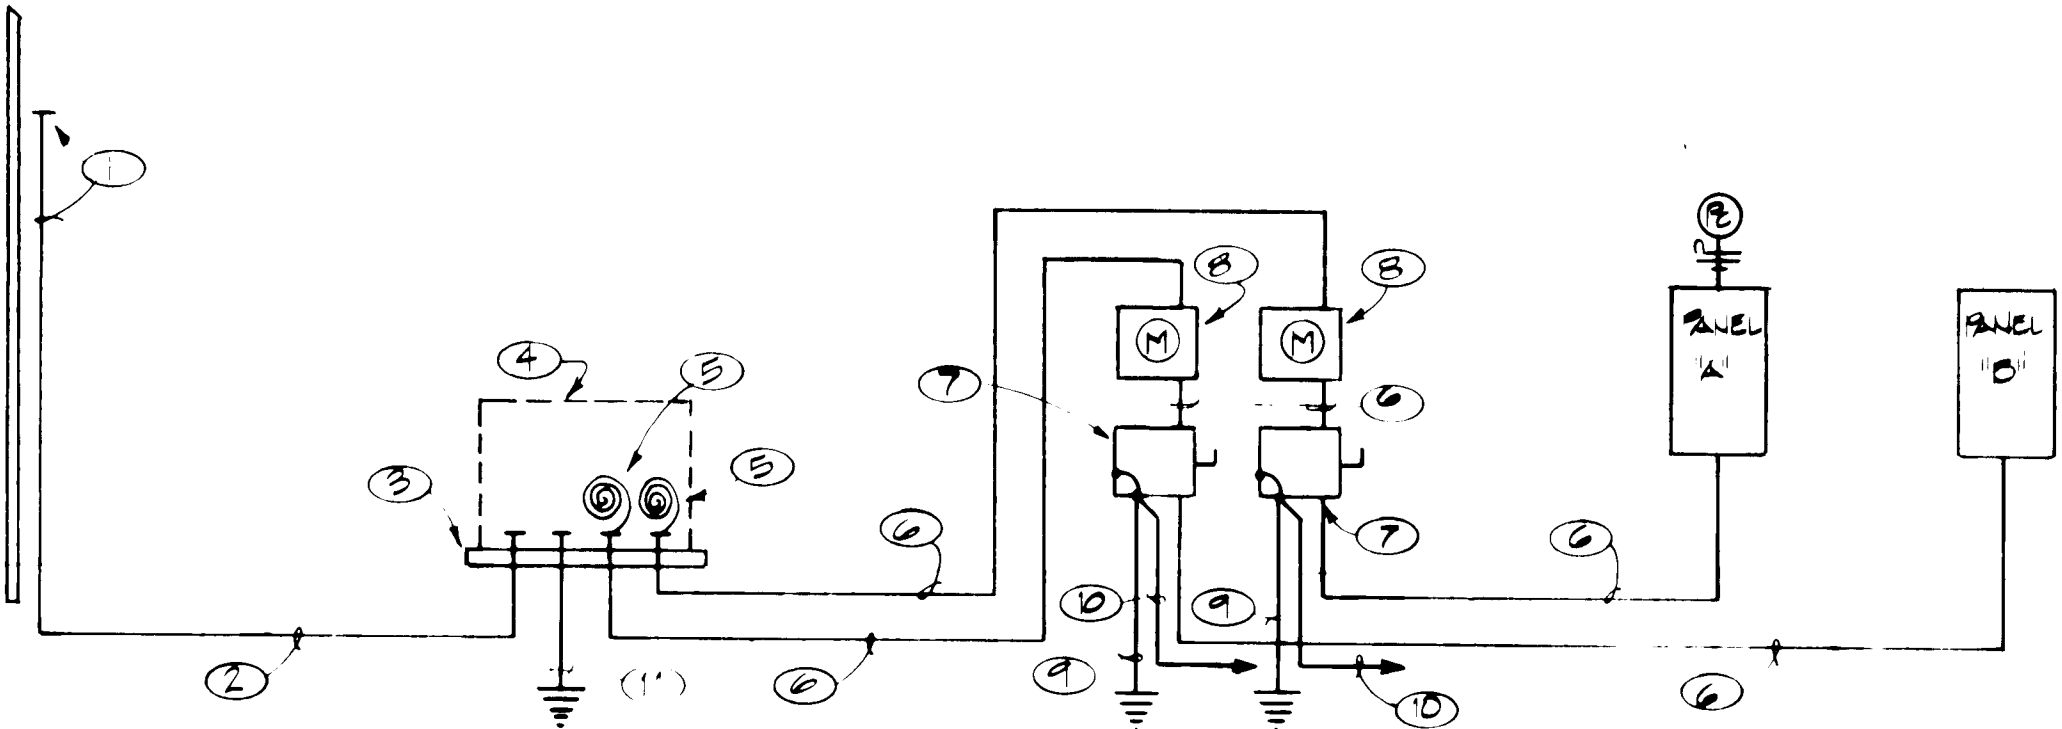

POWER RISER DIAGRAM

NOTES

1. RISER PER PUBLIC SERVICE CO. OF NEW MEXICO REQUIREMENTS.
2. 4" C. FOR PRIMARY PER PNM REQUIREMENTS.
3. TRANSFORMER PAD PER PNM DRAWING #DS-7-16.4.
4. TRANSFORMER BY PNM.
5. COIL 6' OF EXCESS CONDUCTORS FOR CONNECTION BY PNM.
6. 4#3/0 THW & 1#4 GRND. IN 1/2" C.
7. 200A/3P+GN WITH GROUND LUGS, 250V, FUSIBLE DISCONNECT SWITCH IN NEMA 3R ENCLOSURE. FUSE SWITCH WITH 200AMP BUSS LPN-RK FUSES.
8. METERING PER PNM REQUIREMENTS.
9. 1-4 BSD CU. SERVICE GROUND.
10. 1-6 BSD CU. GROUND TO NEAREST COLD WATER PIPE.
11. GROUND ROD.
12. POLE BASE TO BE SIMILAR TO FIXTURE "S" EXCEPT 12" SQUARE TOP FLUSH W/GRND. 3' FT. DEEP.



BURNS/PETERS GROUP ARCHITECTS

RECORD DRAWING

DATE: 12 SEPT 84

Charlie Faw

REVISIONS 40 BUILT AUG. 1984

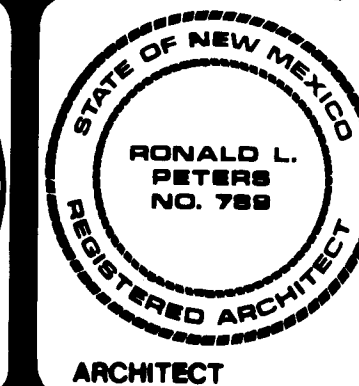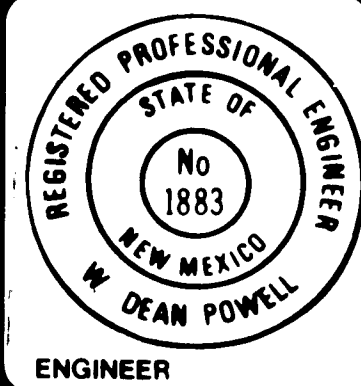

THE
EAST-CENTRAL
MULTI-SERVICE
CENTER

PROJECT NO.

8205

DATE

MAY 88

E3

SHEET 30 OF 36

26 1589 3684