


DECELERATION LANES FOR LOS PASTORES SHOPPING CENTER

INDEX	
SHEET 1	TITLE PAGE
SHEET 2	PLAN AT WYOMING & MONTGOMERY
SHEET 3	PLAN FROM GUTIERREZ SOUTH ON WYOMING
SHEET 4	PLAN AT WYOMING & MONTGOMERY

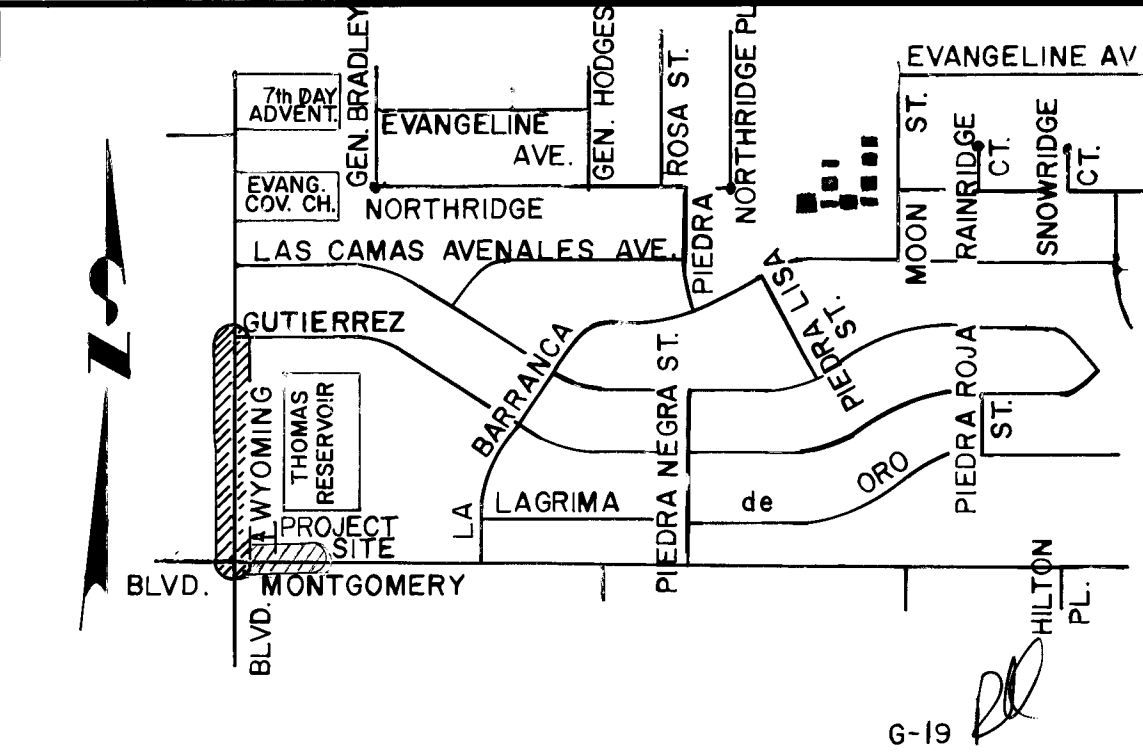


LOCATION MAP

- "NOTICE TO CONTRACTOR"**
- All work detailed on these plans to be performed under contract shall, except as otherwise stated or provided for hereon, be constructed in accordance with the New Mexico Standard Specifications for Public Works Construction-1979 Edition (referred to herein as the Standard Specifications) and the Contract Documents for City-Wide Utilities and Cash Paving No. 31.
 - Two (2) working days prior to any excavation, contractor must contact Line Locating Service, 765-1234, for location of existing utilities.
 - Prior to construction, the contractor shall excavate and verify the horizontal and vertical locations of all obstructions. Should a conflict exist, the contractor shall notify the engineer or surveyor so that the conflict can be resolved with minimum amount of delay.
- THE FOLLOWING NOTES APPLY WHEN CHECKED.**
- ☒ All utilities and utility service lines shall be installed prior to paving.
 - ☒ Backfill compaction shall be according to specified street use. (ARTERIAL PAVING)
 - ☒ Tack coat requirements shall be determined by the City Engineer.
 - ☒ Sidewalks and wheelchair ramps within the curb returns shall be constructed wherever a new curb return is constructed.
 - ☒ If curb is depressed for a drivepad or a handicap ramp, the drivepad or ramp shall be constructed prior to acceptance of the curb and gutter.
 - ☐ All storm drainage facilities shall be completed prior to final acceptance.

14 1592 0183

11/1/13

REV.	SHEETS	CITY ENGR.	DATE	USER DEPT.	DATE	USER DEPT.	DATE
APPROVAL OF REVISIONS							
		CITY OF ALBUQUERQUE		APPROVED FOR CONSTRUCTION			
		1592		Richard S. Hill		CITY ENGR. 4/14/13	
				SHEET 1 OF 4			

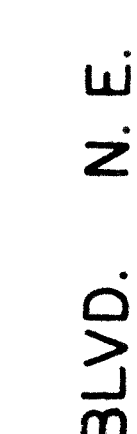


WYOMING

REFERENCES		SURVEY INFORMATION		BENCH MARKS		AS BUILT INFORMATION	
MAP NO. 6-19		FIELD NOTES		B.M. 5-620 LOCATED AT THE INTERSECTION OF MONTGOMERY BLVD. AND WYOMING. A SQUARE, CHISELED ON TOP OF CONCRETE CURB AT THE ESE RETURN. ELEV. 5432.34		AS BUILT INFORMATION	
EST NO.		NO.		DATE		DATE	
NO.	DATE	REMARKS	BY				
DESIGN							
DESIGNED BY	DATE						
DRAWN BY E. D. FEGETTE	DATE						
CHECKED BY	DATE						



CITY OF ALBUQUERQUE MUNICIPAL DEVELOPMENT ENGINEERING DIVISION						MR 80-2
TITLE: DECELERATION LANES WYOMING AND MONTGOMERY FOR LOS PASTORES SHOPPING CENTER						
APPROVALS	ENGINEER	DATE	APPROVALS	ENGINEER	DATE	
City Engineer			Liquid Waste			
A CE - Design	<i>[Signature]</i>	<i>11-2-80</i>	Traffic	<i>[Signature]</i>	<i>11-3-80</i>	
A CE - Hydrology			Water			
DRAWING NO. 1592			SHEET 2 OF 4			

APPROVED FOR
CONSTRUCTION
Richard S. Hill 4/16/88
CITY ENGINEER DATE



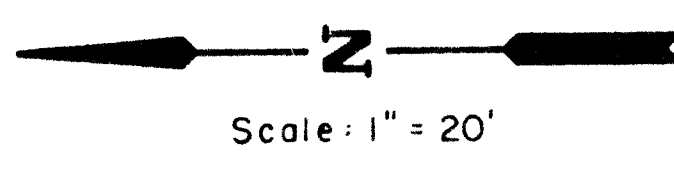


2	6	1	5	9	2	0	3	8	3
---	---	---	---	---	---	---	---	---	---

CITY OF ALBUQUERQUE					MR 80-2	
MUNICIPAL DEVELOPMENT						
ENGINEERING DIVISION						
TITLE: DECELERATION LANES						
WYOMING AND MONTGOMERY FOR LOS PASTORES						
SHOPPING CENTER						
APPROVALS	ENGINEER	DATE	APPROVALS	ENGINEER	DATE	
City Engineer			Liquid Waste			
ACE - Design	<i>[Signature]</i>	12/1/80	Traffic			
ACE - Hydrology			Water			
DRAWING NO. 1592			SHEET 3 OF 4			

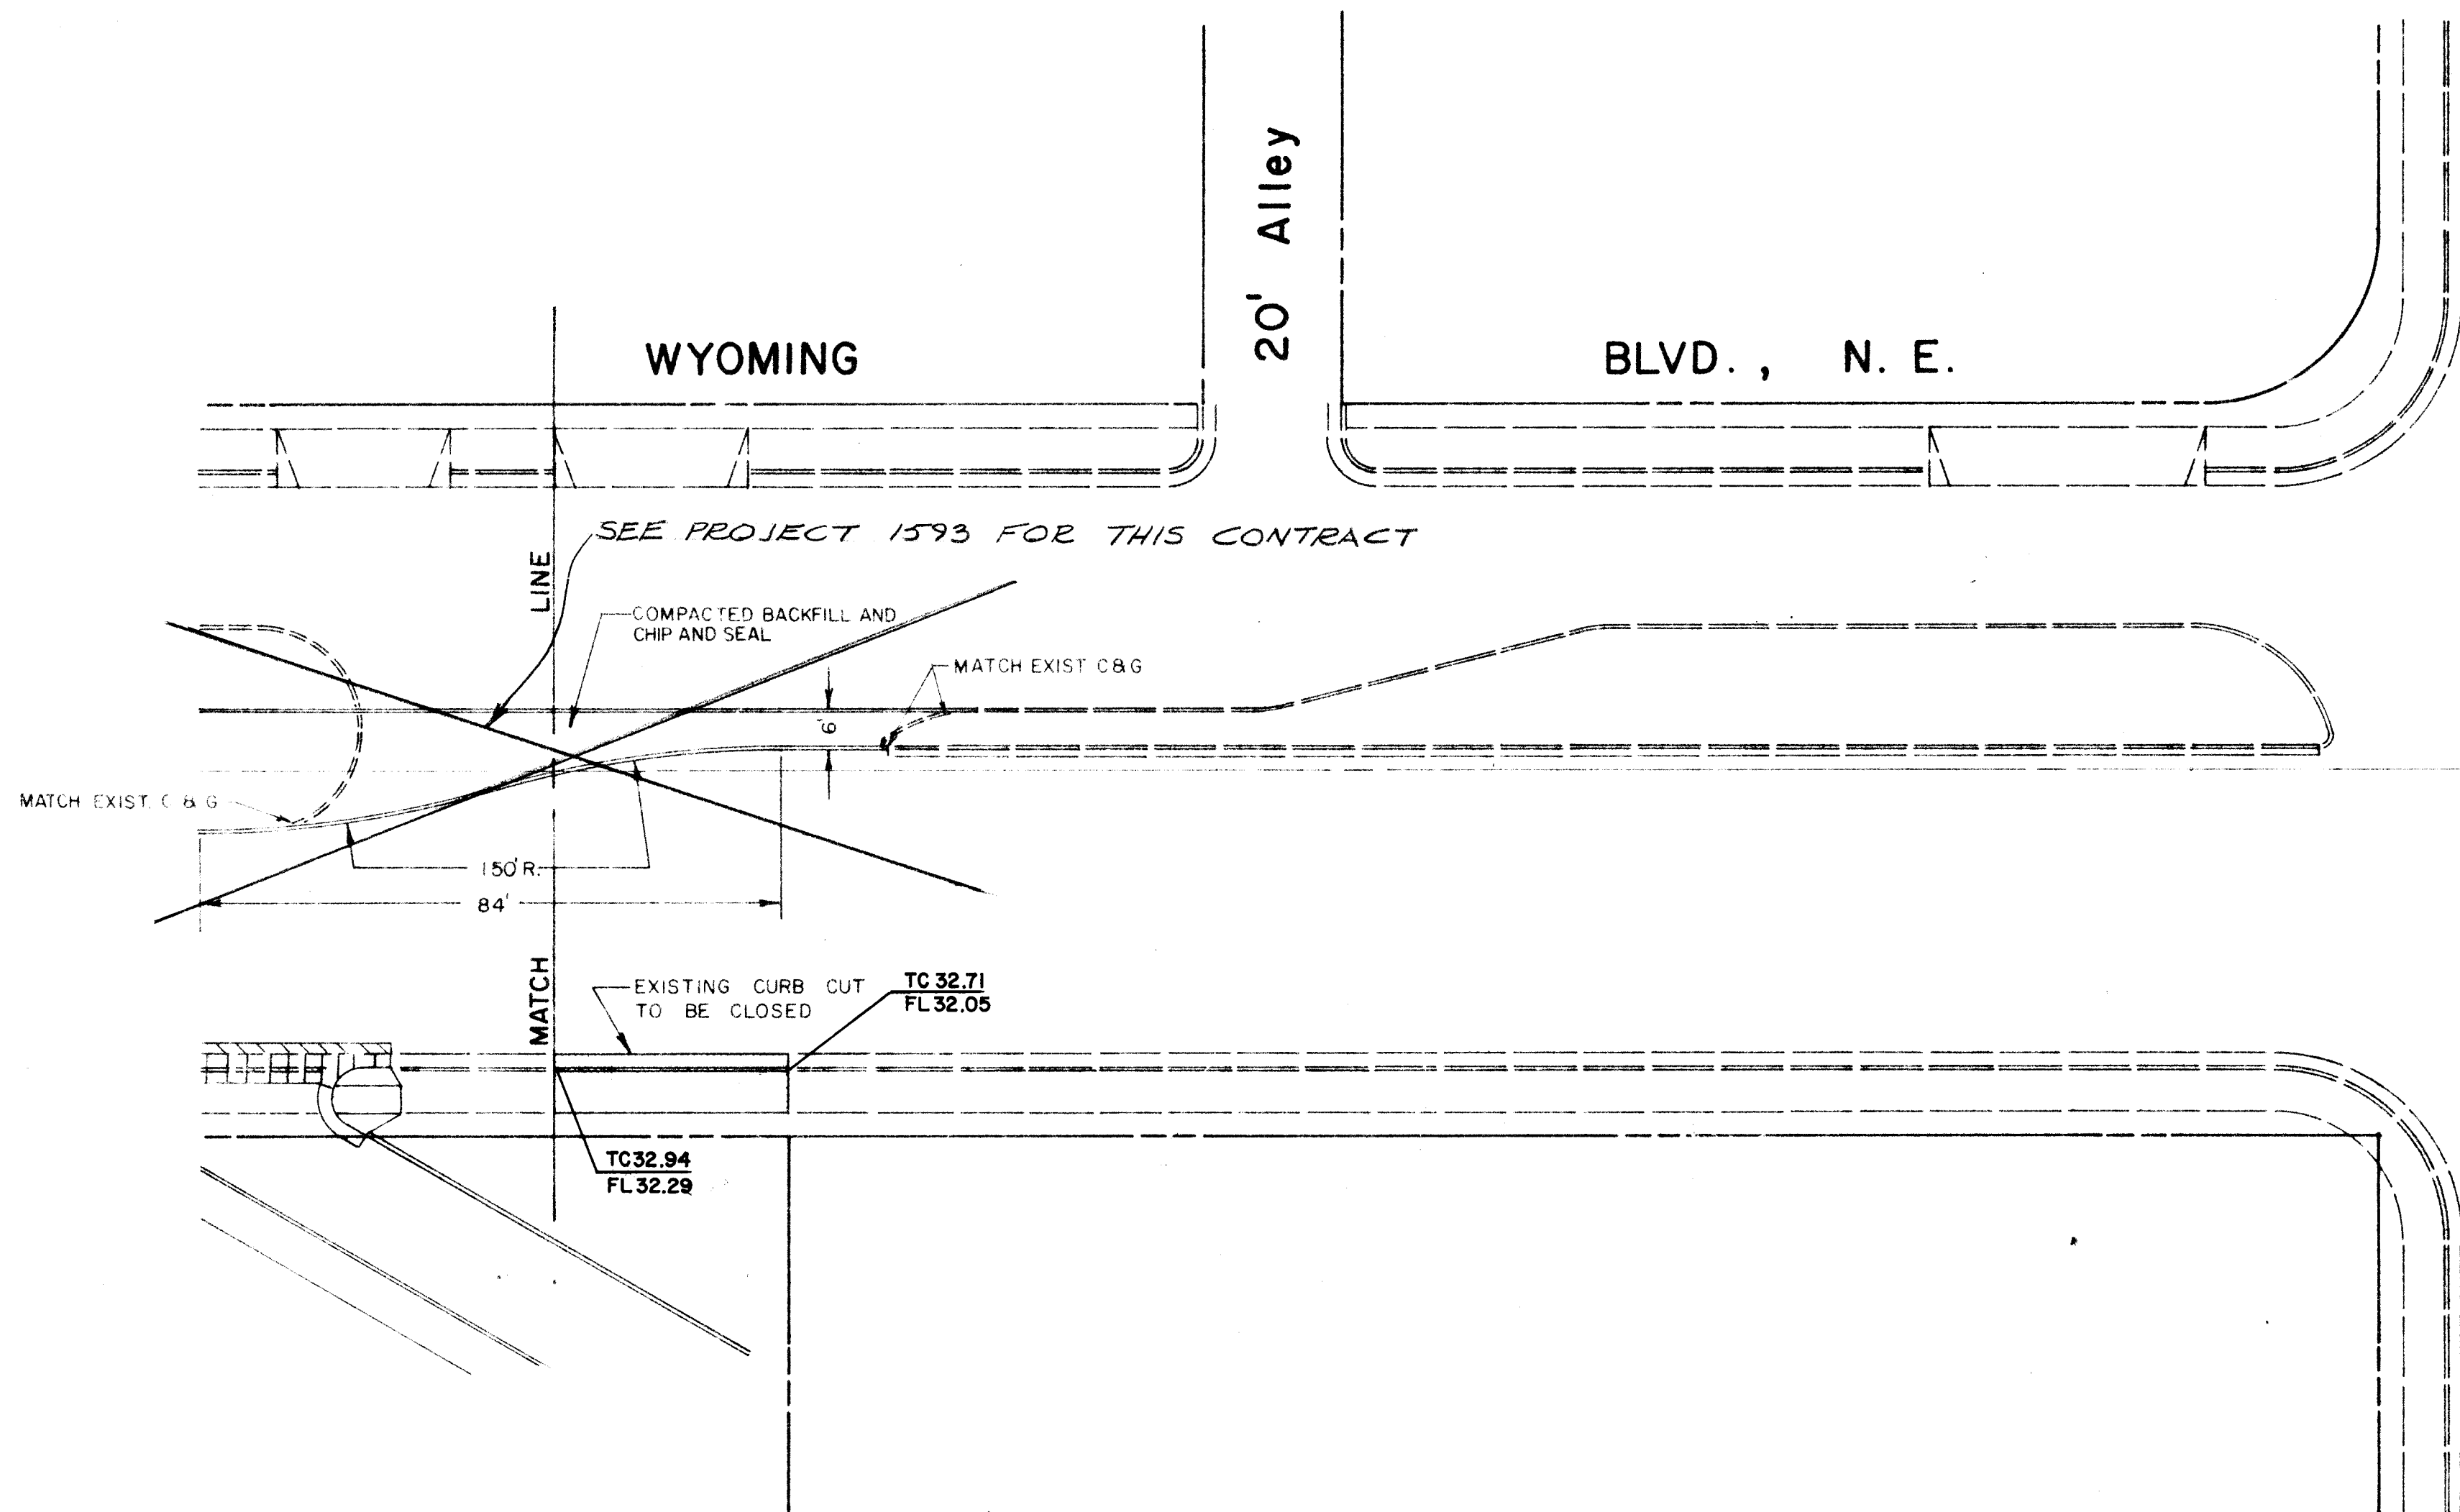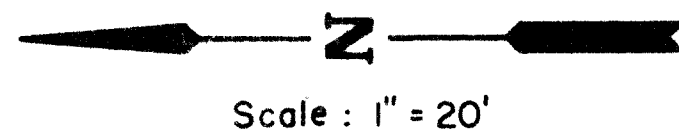

Legend

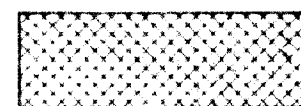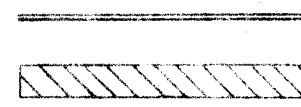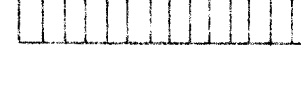-  AREA TO BE REMOVED & PAVED
-  NEW CONCRETE CURB, GUTTER & SIDEWALK
-  NEW EXTRUDED ASPHALT CURB
-  PAVING REMOVAL 1'
-  NEW VALLEY GUTTER

TRAFFIC HANDLING NOTES

- CONTRACTOR MUST SUBMIT A CONSTRUCTION SIGNING AND BARRICADING PLAN TO TRAFFIC ENGINEERING DIVISION AND RECEIVE A BARRICADING PERMIT PRIOR TO CONSTRUCTION.
- ALL CONSTRUCTION SIGNING AND BARRICADING TO COMPLY WITH MANUAL ON UNIFORM TRAFFIC CONTROL DEVICES, 1978 EDITION.
- CONTRACTOR'S OPERATION, BARRICADING AND SIGNING SHALL NOT AFFECT THRU LANES OF MONTGOMERY OR WYOMING BETWEEN 7 AM AND 9 AM OR 4 PM AND 6 PM.

APPROVED FOR
CONSTRUCTION
Richard S. Hall 4/10/83
CITY ENGINEER DATE

26 1592 0483

CITY OF ALBUQUERQUE MUNICIPAL DEVELOPMENT ENGINEERING DIVISION						MR 80-2
TITLE: DECELERATION LANES WYOMING AND MONTGOMERY FOR LOS PASTORES SHOPPING CENTER						
APPROVALS	ENGINEER	DATE	APPROVALS	ENGINEER	DATE	
City Engineer	<i>[Signature]</i>	4/10/83	Liquid Waste			
A.C.E. - Design	<i>[Signature]</i>	4/10/83	Traffic			
A.C.E. - Hydrology			Water			
DRAWING NO.	1592		SHEET		4 OF 4	

REFERENCES		SURVEY INFORMATION		BENCH MARKS		AS BUILT INFORMATION	
MAP NO.	EST. NO.	NO.	BY	DATE	NO.	DATE	NO.
G-19	26						
REVISIONS		FIELD NOTES		B.M. LOCATED AT THE INTERSECTION OF MONTGOMERY BLVD. AND WYOMING. 5+820 A SQUARE, CHISELED ON TOP OF CONCRETE CURB AT THE ESE RETURN. ELEV. 5432.34		INSPECTED BY DATE 7/83	
NO.	DATE	BY		DATE		DRAWINGS BY DATE 10/83	
						MICRO-FILM INFORMATION	
DESIGNED BY		DATE		RECORDED BY		DATE	
E. D. FEGETTE		4/10/83					
DRAWN BY		DATE					
CHECKED BY		DATE					