


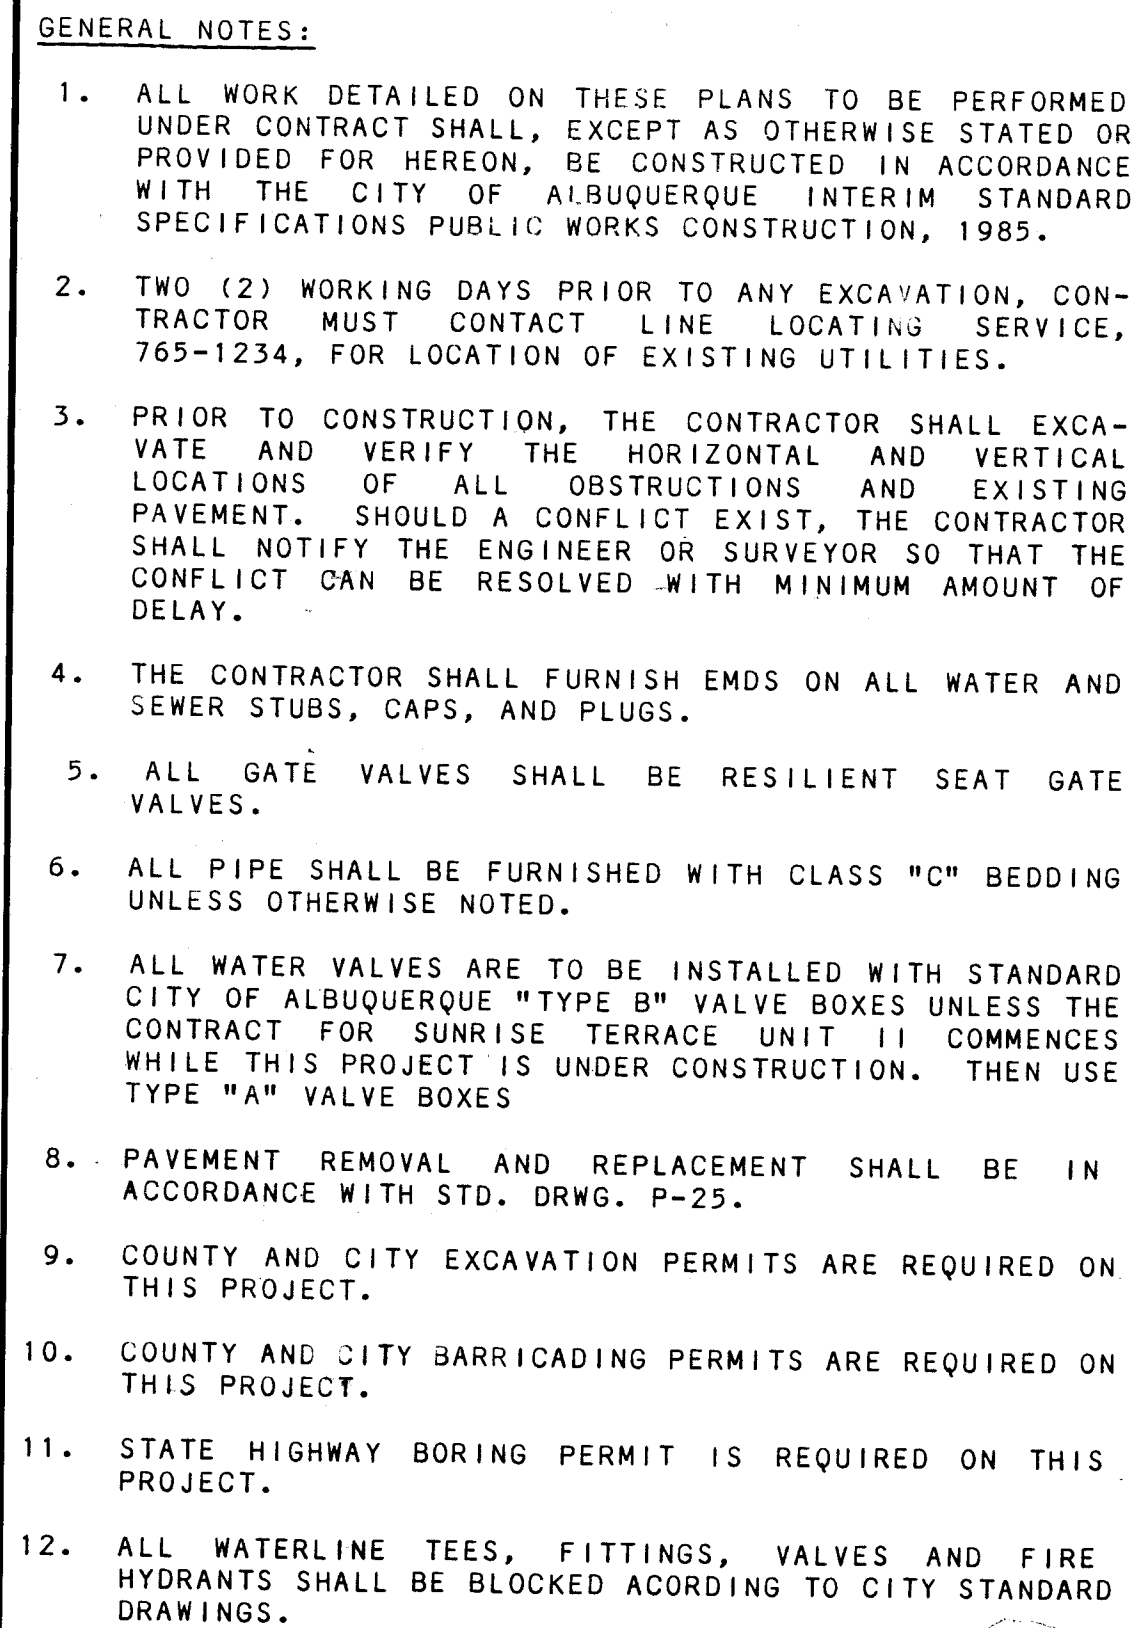


6								
15, 16, 17, 18								
REV.	SHEETS	CITY ENGINEER	DATE	USER	DEPARTMENT	DATE	USER	DEPARTMENT
APPROVAL OF REVISIONS								

1	2	3	4	5	6	7	8	9	10	11	12
26			1	5	9	9	0	1	8	8	

APPROVED FOR
CONSTRUCTION
James H. [Signature]
CITY ENGINEER
11/6/86
DATE

SHEET 1 OF 2


PLAN	DATE	BY
SURVEYED		
NOTED		
ALIGNED		
CHECKED		
NO		

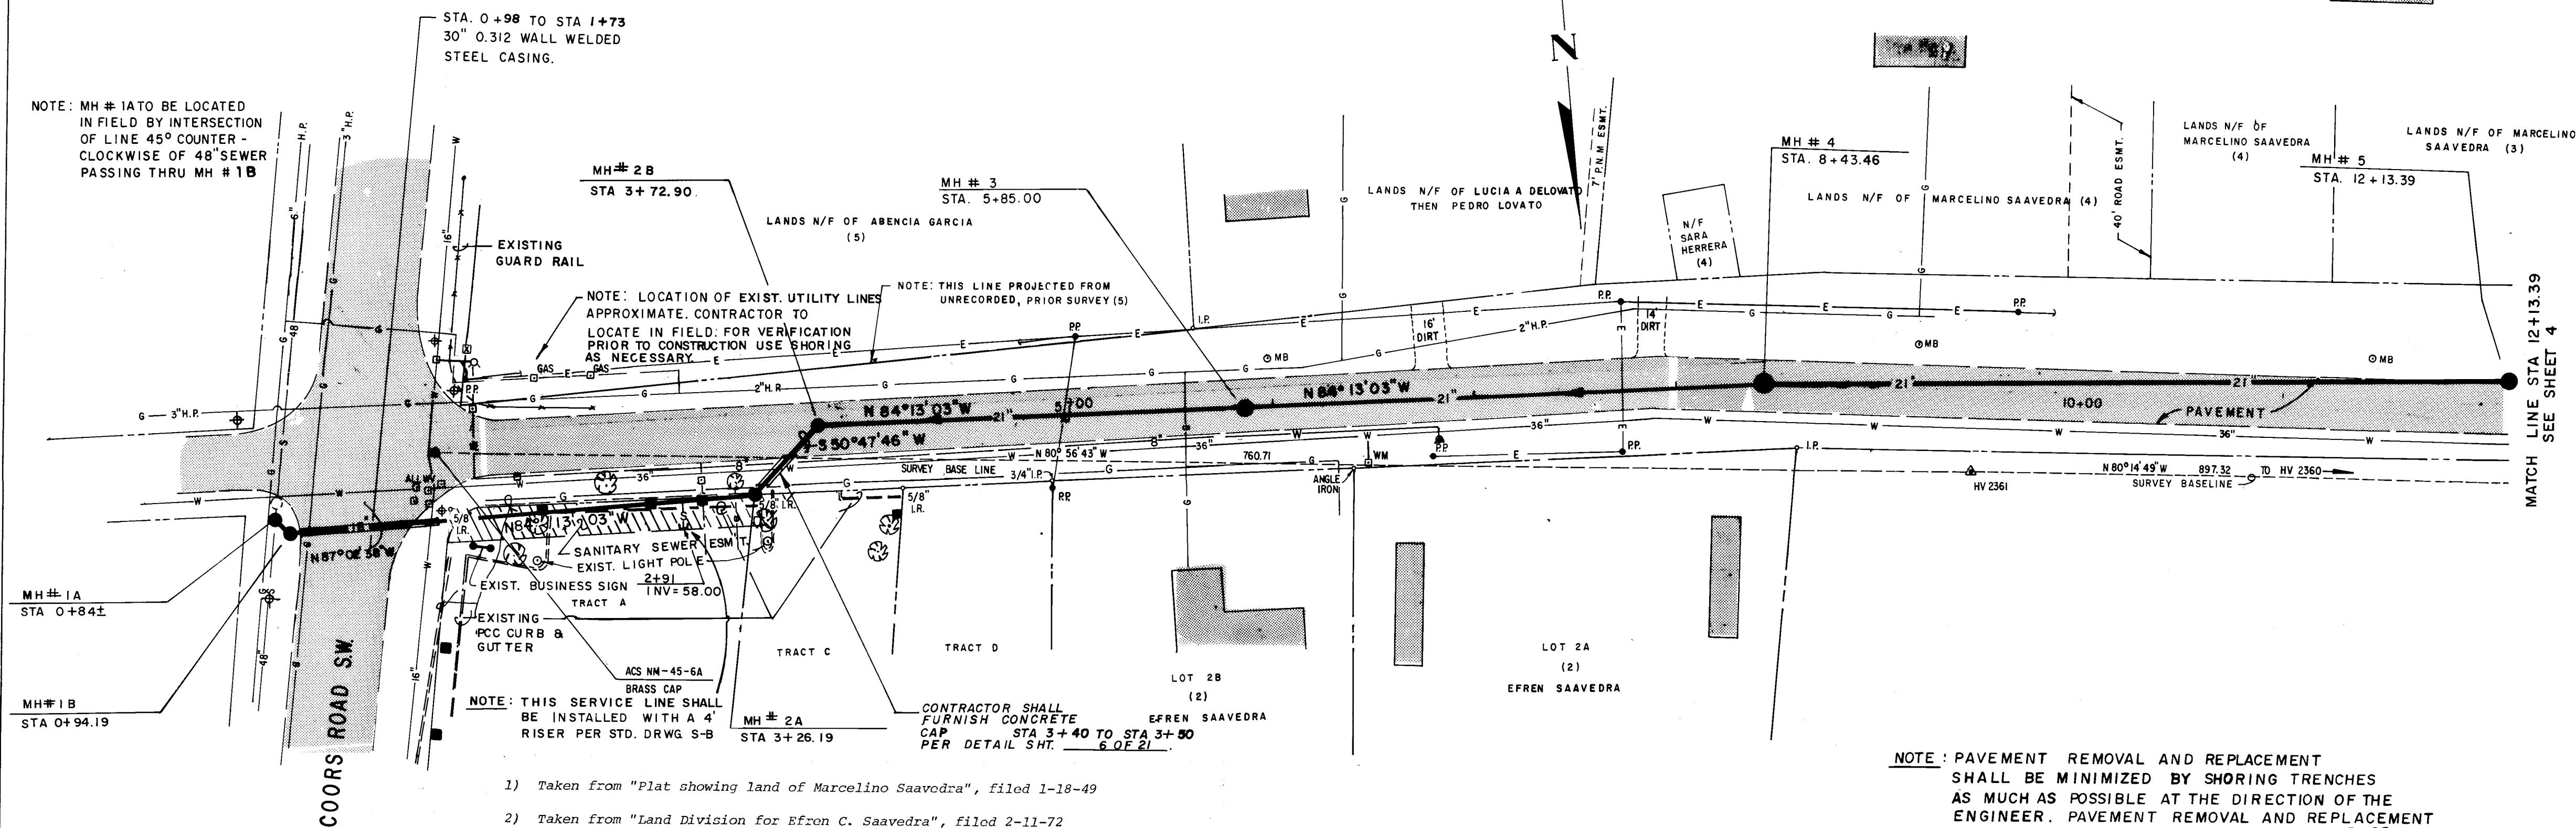


NOTE: TRAFFIC CONTROL PLAN FOR CONSTRUCTION AT THIS INTERSECTION SHALL INCLUDE TEMPORARY TRAFFIC LIGHT SIGNALS AT THE DIRECTION OF THE COUNTY ROAD DEPARTMENT.

- 1) Taken from "Plat showing land of Marcelino Saavedra", filed 1-18-49
- 2) Taken from "Land Division for Efron C. Saavedra", filed 2-11-72
- 3) Projected from Plat (see note 4, below)
- 4) Taken from Land Division Plat for Marcelino & Florentina Saavedra, filed 3-23-77
- 5) Taken from result of survey plat prepared by Peto Sandoval, N.M.L.S. No. 240 (unrecorded). Surveyed on 3-24-59

ARENAL RD. S.W.
SHOWN FOR INFORMATION ONLY-NOT A PART OF THIS CONTRACT

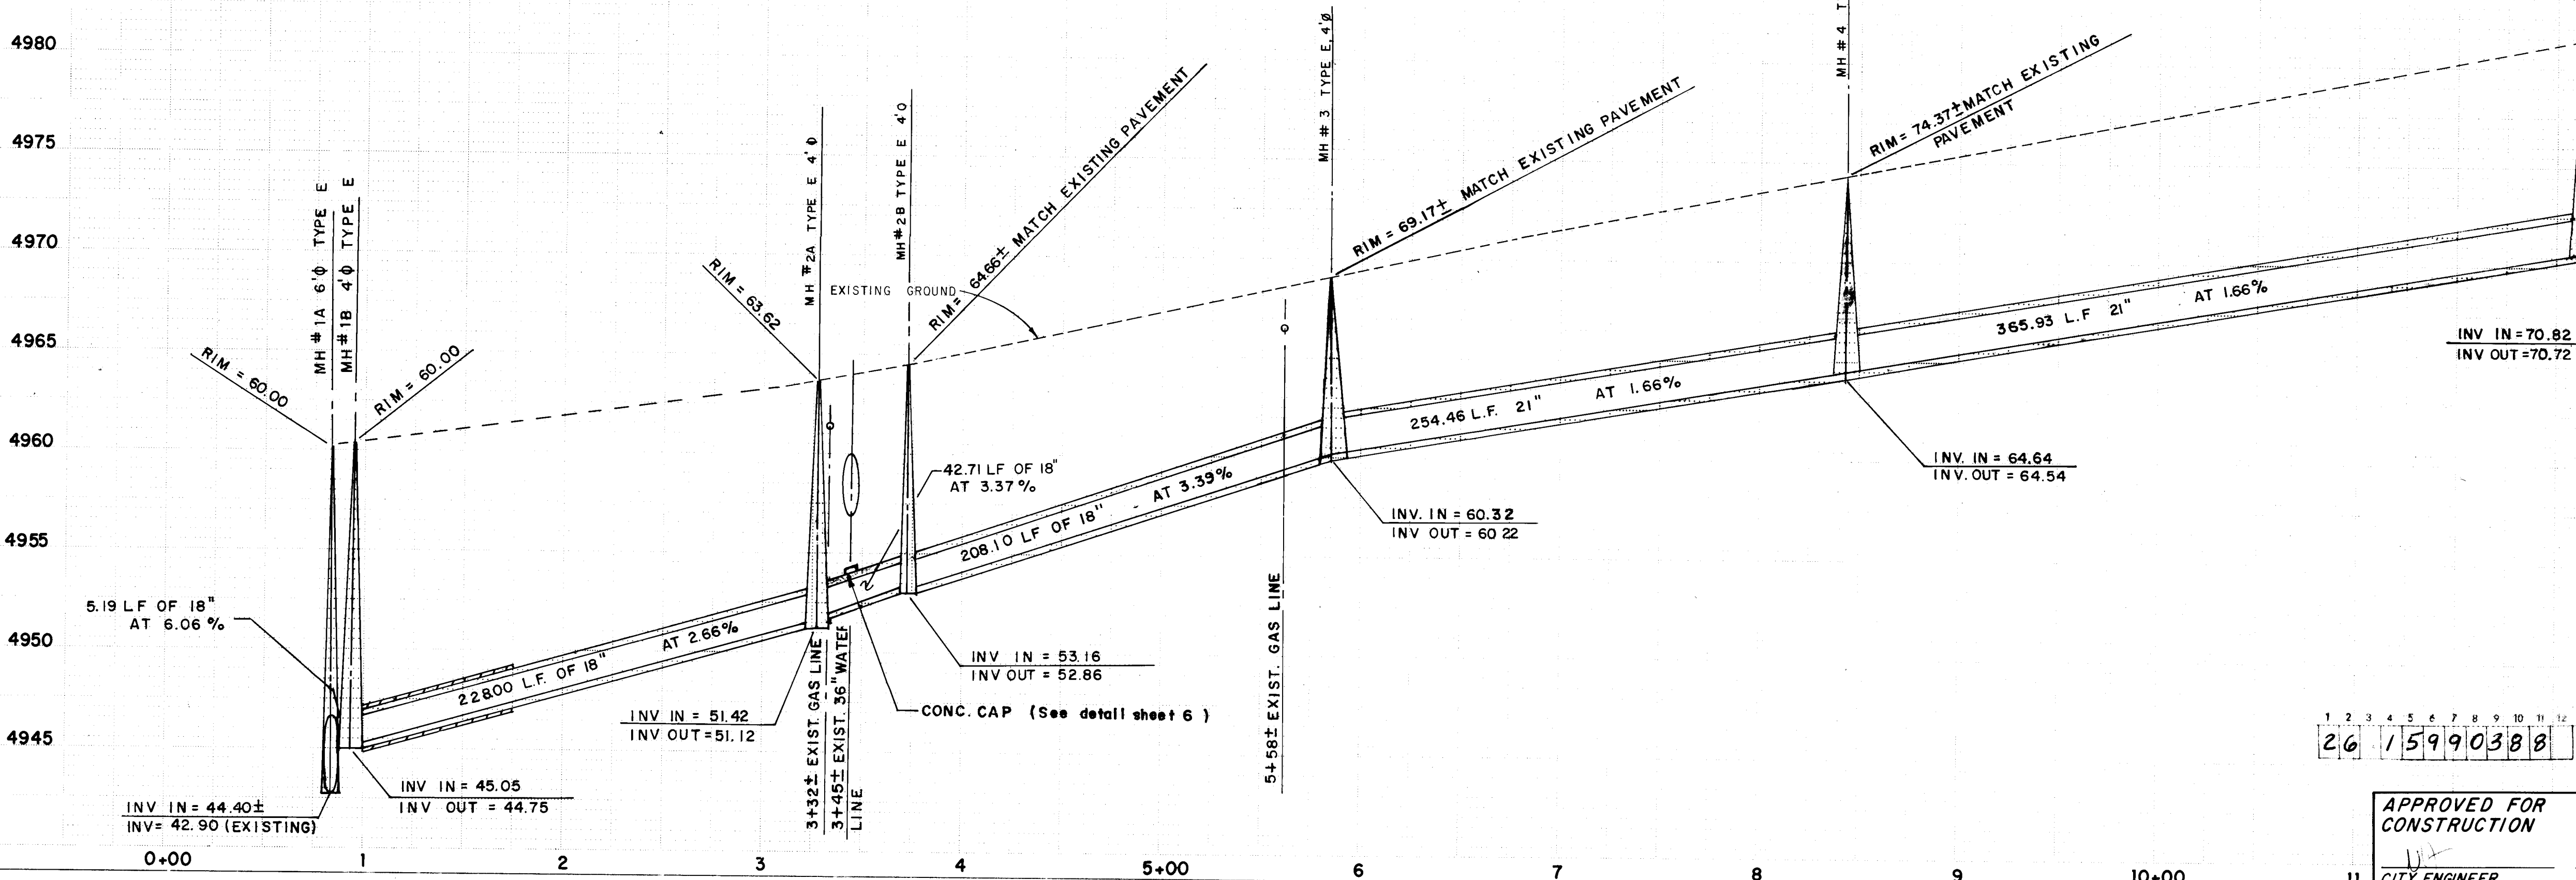

- LEGEND**
- Sanitary Sewer Easement
 - Existing Trees
 - Underground Sprinkler Boxes
 - Existing Power Line
 - Existing Sewer w/ size
 - Existing Water w/ size
 - Existing Gas w/ size
 - Found survey point
 - Set Traverse point
 - Albuquerque City Survey monument
 - Power/Telephone pole w/ guy wire
 - Light standard at intersection
 - Gas valve
 - Traffic control box
 - Existing Fire Hydrant
 - Water valve/meter
 - Dwelling & Existing asphalt pmt.
 - Traffic Signal Poles

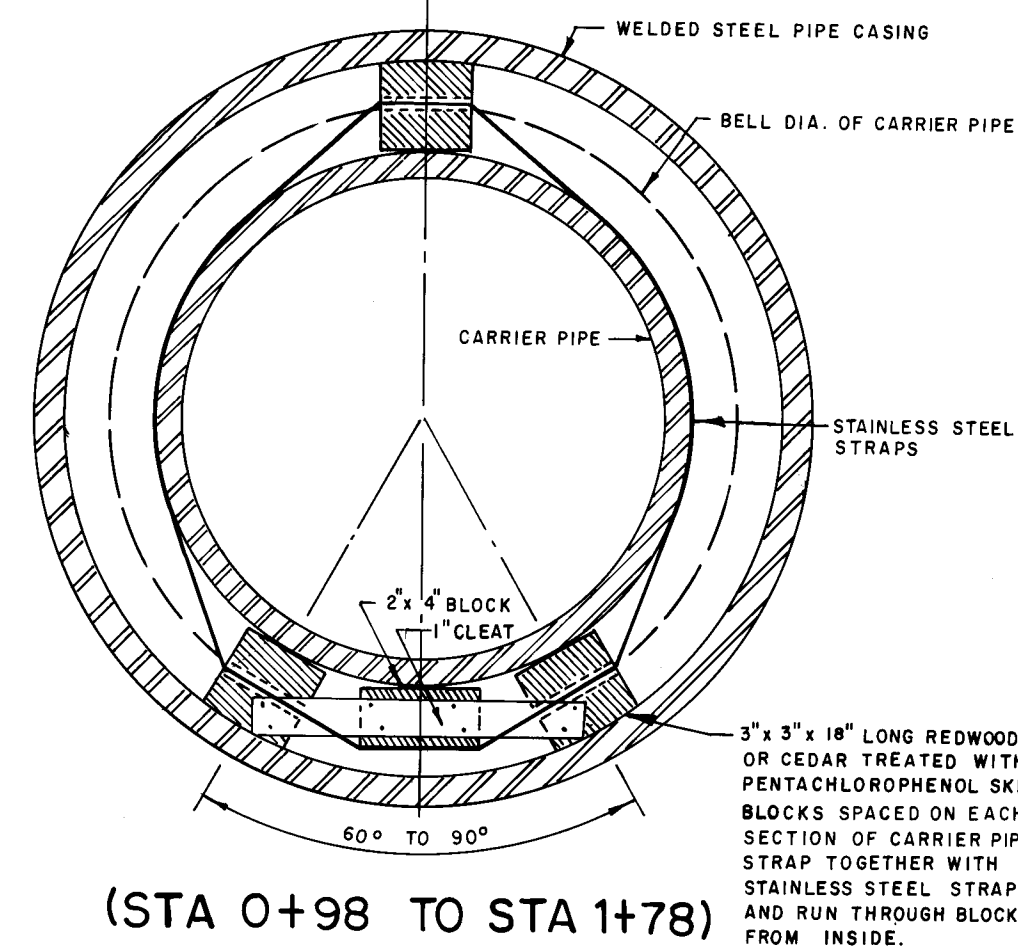

(STA 0+98 TO STA 1+78)
TYPICAL SECTION
BORING INSTALLATION
(SEE DWG. W-6)

SCALE: 1" = 50' HORIZ.
1" = 5' VERT.

AS BUILT INFORMATION			BENCH MARKS			SURVEY INFORMATION			ENGINEERS SEAL		
CONTRACTOR	DATE	BY	NO.	DATE	BY	NO.	DATE	BY	NO.	DATE	BY
REVISIONS			DESIGN			DESIGN			DESIGN		
NO			DATE			NO			DATE		
BY			DATE			BY			DATE		
DESIGNED BY			DATE			DESIGNED BY			DATE		
DRAWN BY			DATE			DRAWN BY			DATE		
CHECKED BY			DATE			CHECKED BY			DATE		

CITY OF ALBUQUERQUE
MUNICIPAL DEVELOPMENT DEPARTMENT
ENGINEERING DIVISION

TITLE: ARENAL/TOWER ROAD SEWER AND SUNRISE TERRACE
MASTER PLAN WATER
STA. 0+80 - STA. 12+13.39 (MH #1A - MH #5)

APPROVALS	ENGINEER	DATE	APPROVALS	ENGINEER	DATE
City Engineer		8/15/86	Liquid Waste	N/A	8/15/86
A.C.E. Design		8/15/86	Traffic	N/A	8/15/86
A.C.E. Hydrology		8/15/86	Water Utilities	N/A	8/15/86
County Rd. Dept.		8/15/86			


DRAWING NO. 1599 MAP NO. M-11 SHEET 3 OF 21

APPROVED FOR CONSTRUCTION


CITY ENGINEER DATE

PLAN	DATE	BY
SURVEYED		
NOTED		
RT OF WAY CHECKED		
NO		

PROFILE	DATE	BY
SURVEYED		
NOTED		
GRADES CHECKED		
STRUCTURE NOTATIONS OK		
NO		

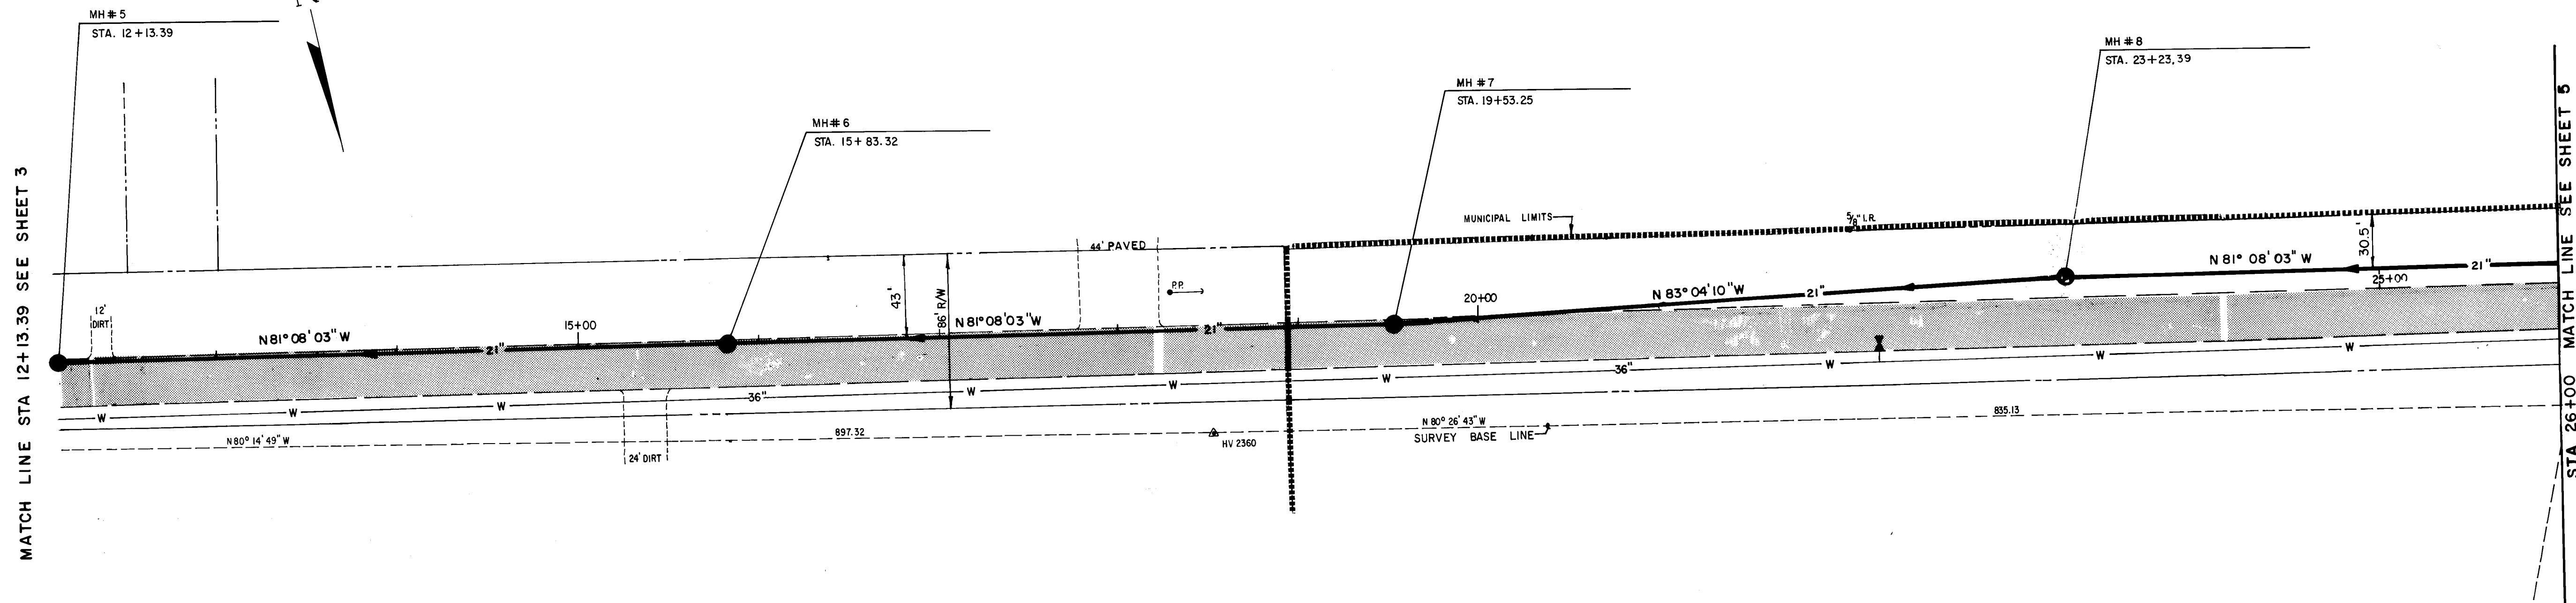

ARENAL ROAD S.W.
SHOWN FOR INFORMATION ONLY - NOT A PART OF THIS CONTRACT

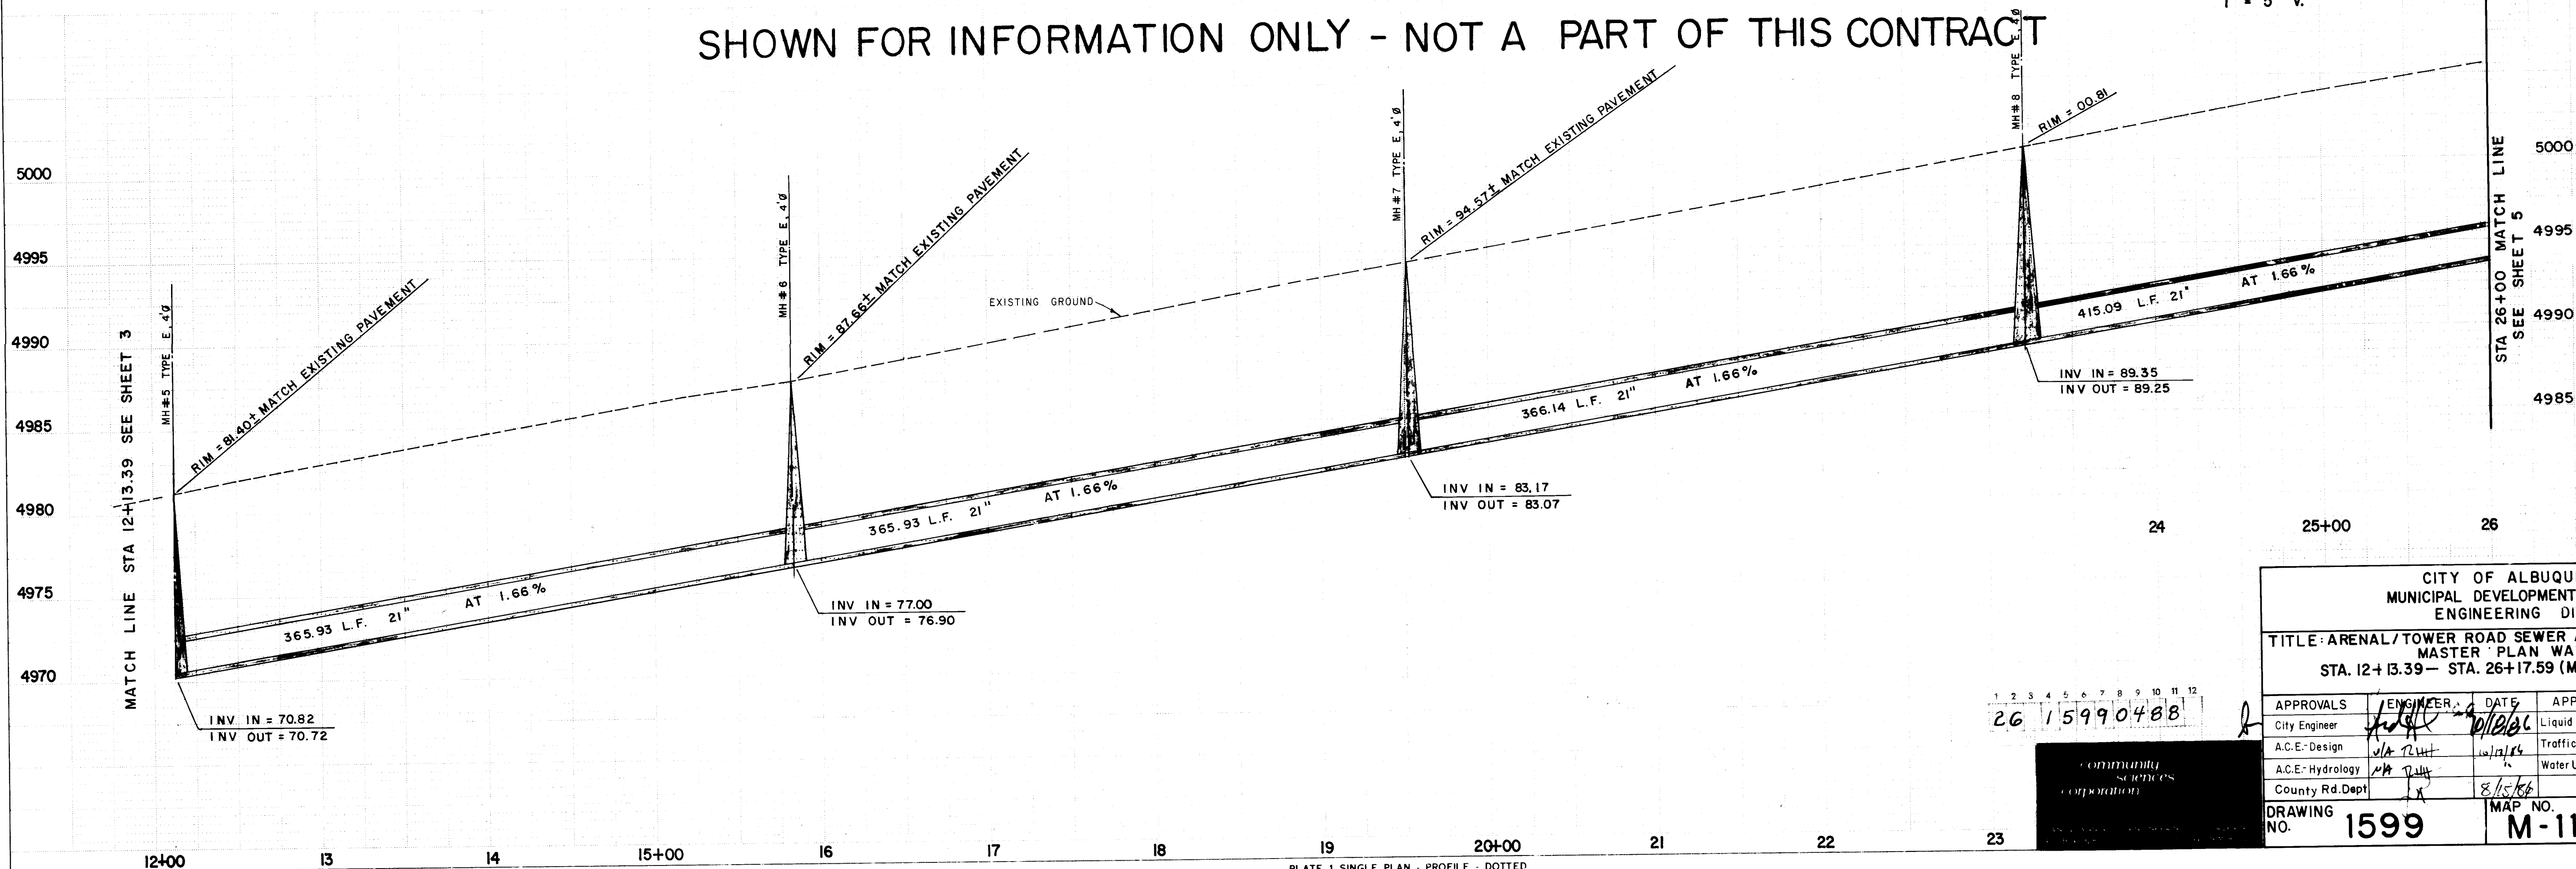


26 15990488

community sciences corporation

CITY OF ALBUQUERQUE MUNICIPAL DEVELOPMENT DEPARTMENT ENGINEERING DIVISION					
TITLE: ARENAL/TOWER ROAD SEWER AND SUNRISE TERRACE MASTER PLAN WATER					
STA. 12+13.39 - STA. 26+17.59 (MH#5 - MH#8)					
APPROVALS	ENGINEER	DATE	APPROVALS	ENGINEER	DATE
City Engineer	<i>[Signature]</i>	8/15/86	Liquid Waste	N/A W/W	8/15/86
A.C.E. Design	<i>[Signature]</i>	8/15/86	Traffic	N/A W/W	8/15/86
A.C.E. Hydrology	<i>[Signature]</i>	8/15/86	Water Utilities	N/A W/W	8/15/86
County Rd. Dept	<i>[Signature]</i>	8/15/86			
DRAWING NO. 1599		MAP NO. M-11		SHEET 4 OF 21	


ENGINEERS SEAL			SURVEY INFORMATION		BENCH MARKS		AS BUILT INFORMATION	
			FIELD NOTES		SEE SHEET 2		CONTRACTOR	
			NO.	BY	DATE		WORK	DATE
							STAKED BY	DATE
							ACCEPTANCE BY	DATE
							FIELD LOCATION BY	DATE
							DRAWINGS	DATE
							CORRECTED BY	DATE
							RECORDED BY	DATE
							NO.	DATE

6/25/86

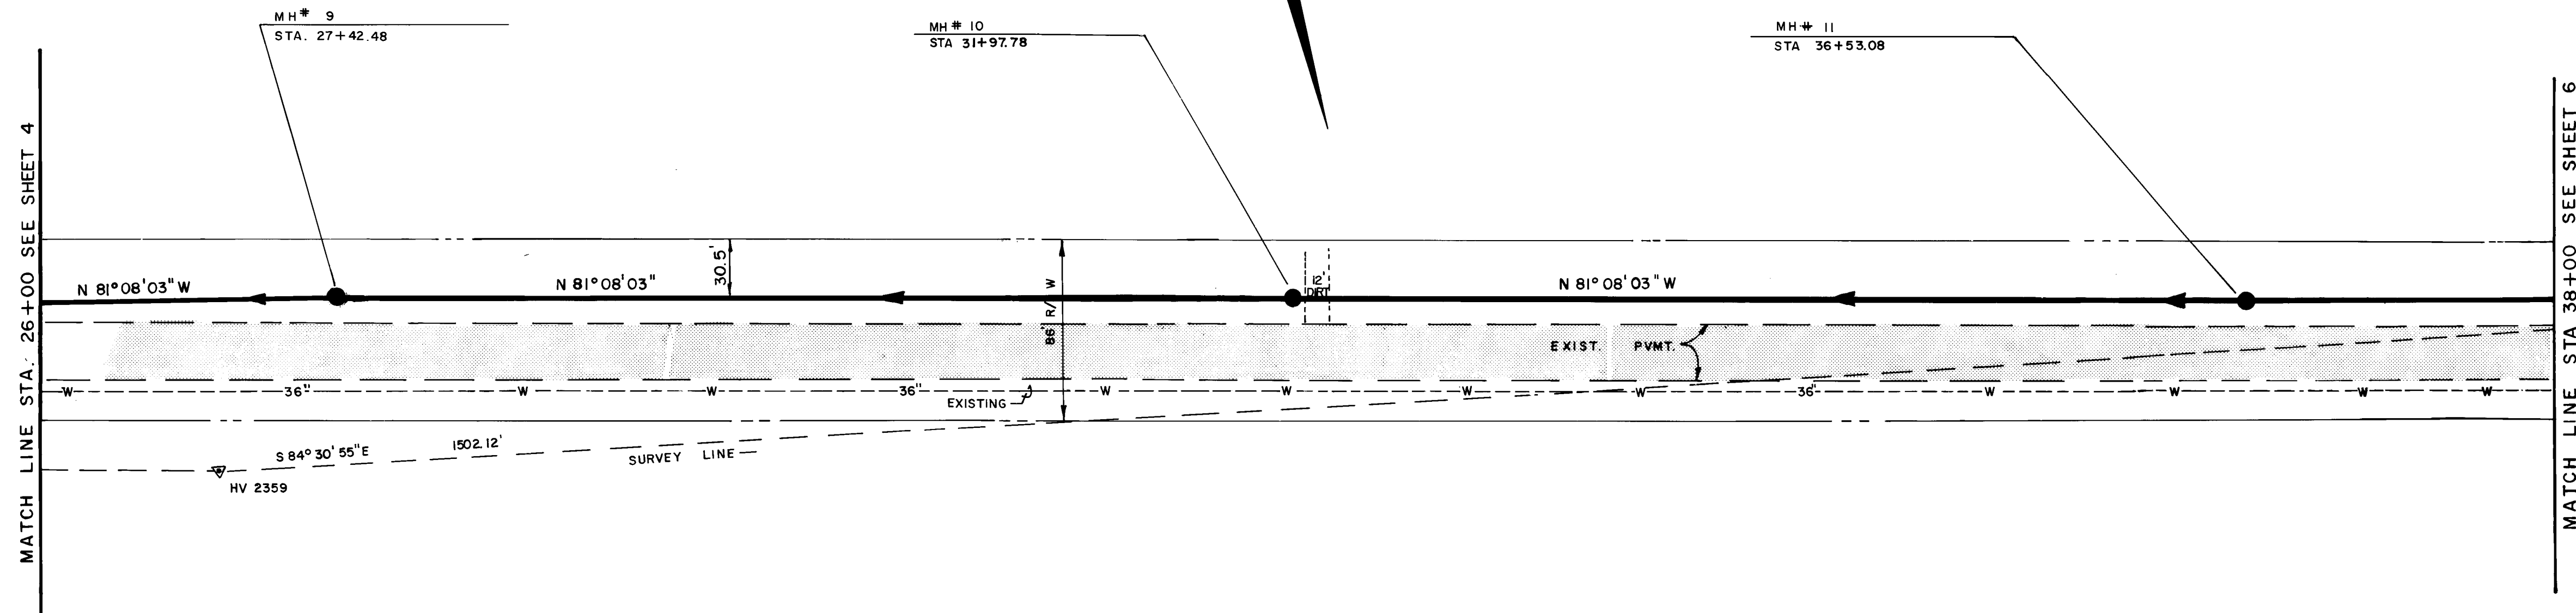

SHOWN FOR INFORMATION ONLY - NOT A PART OF THIS CONTRACT

ARENAL ROAD, S.W.

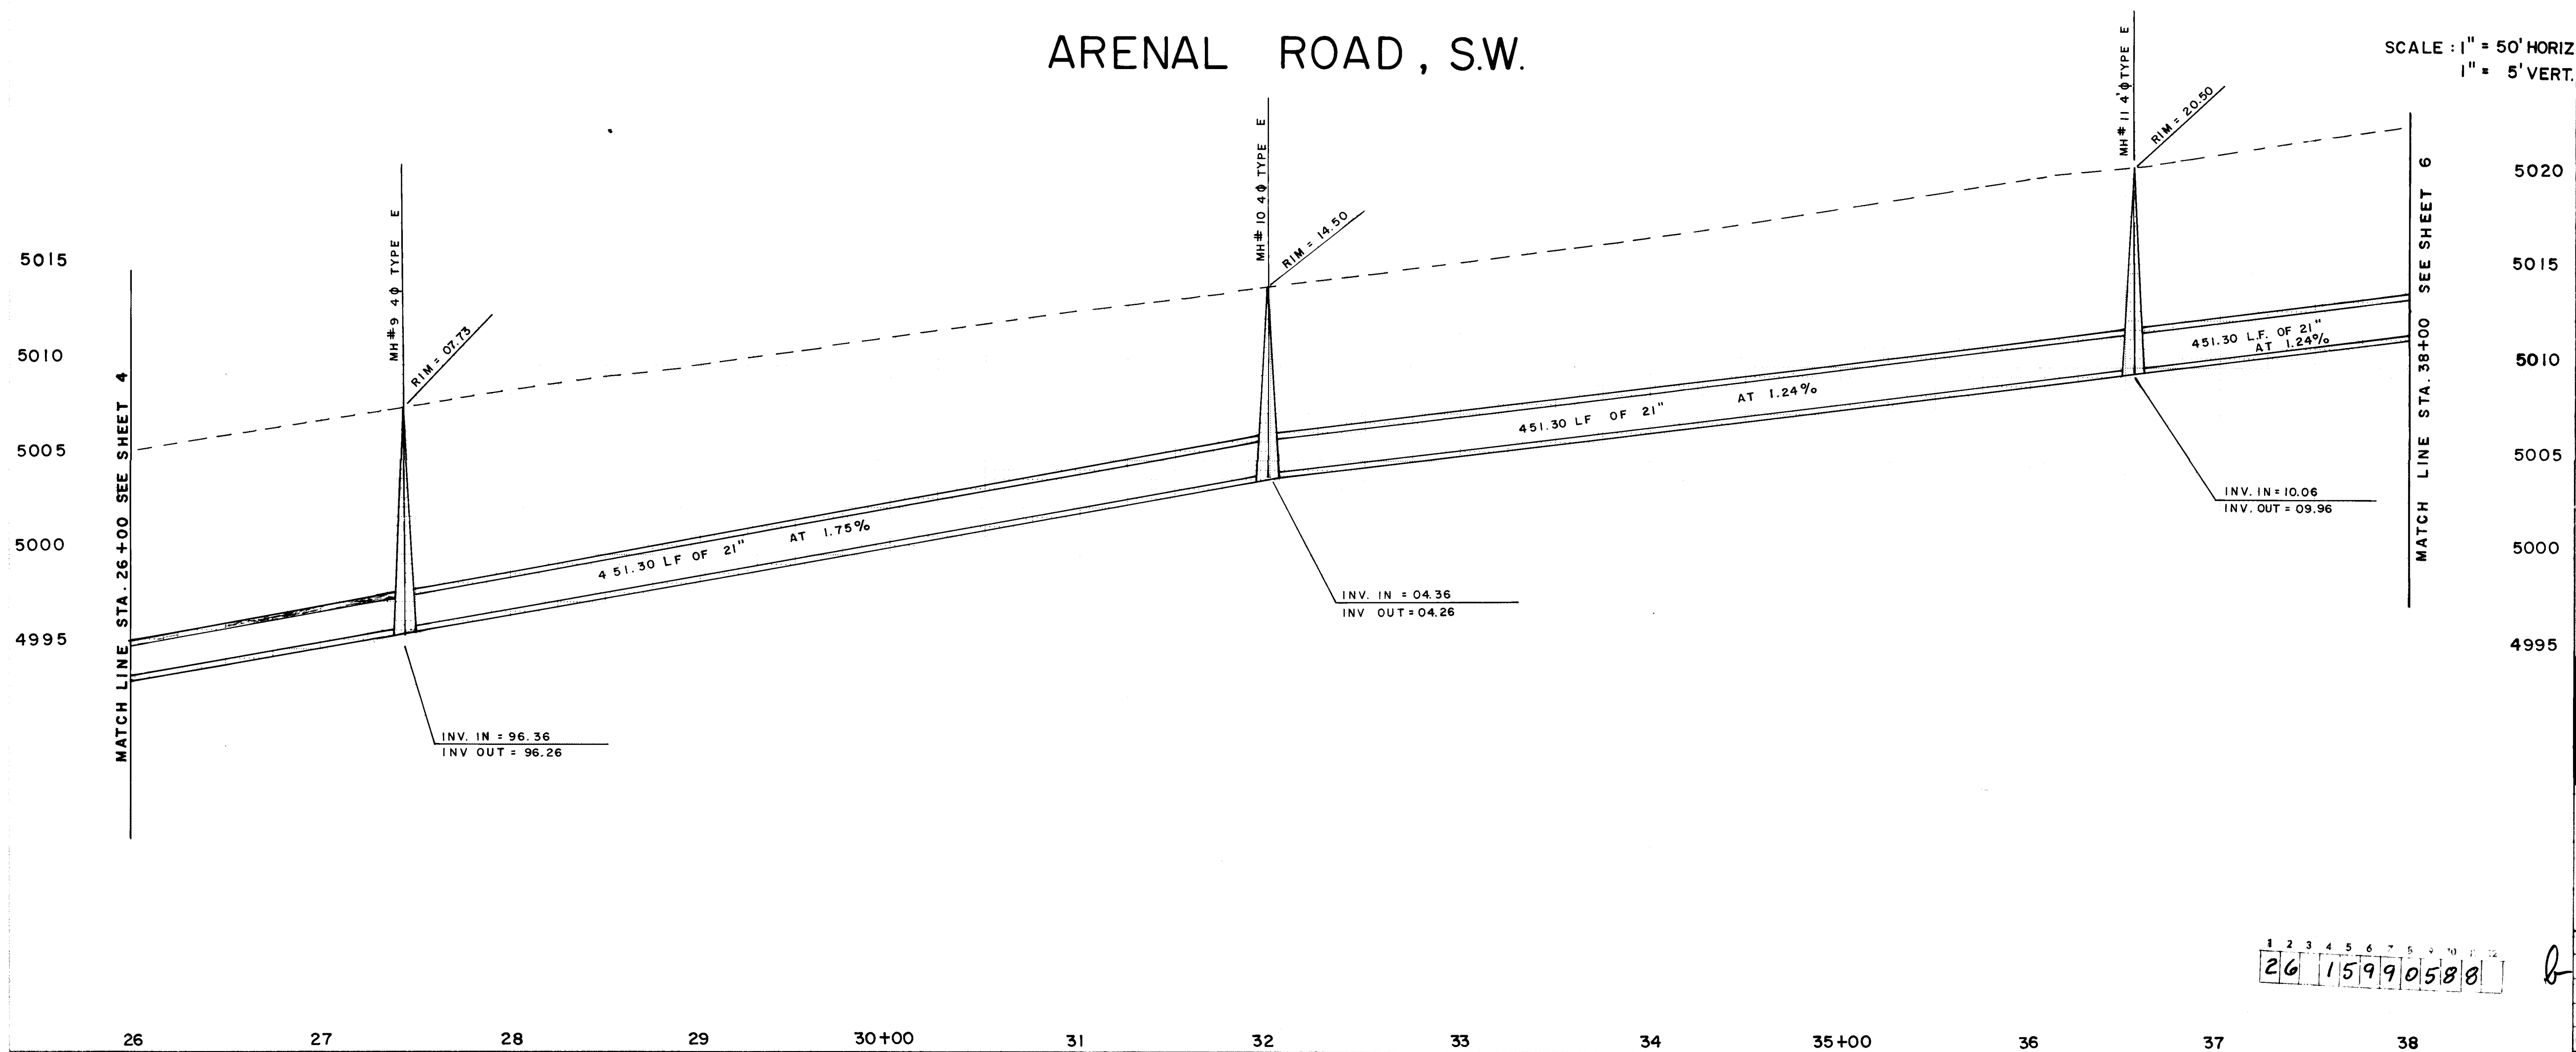

CITY OF ALBUQUERQUE MUNICIPAL DEVELOPMENT DEPARTMENT ENGINEERING DIVISION					
TITLE: ARENAL/TOWER ROAD SEWER AND SUNRISE TERRACE MASTER PLAN WATER STA. 26+00 - STA 38+00 (MH# 9 - 38+00.00)					
APPROVALS	ENGINEER	DATE	APPROVALS	ENGINEER	DATE
City Engineer	<i>[Signature]</i>	8/15/86	Liquid Waste	N/A WJW	8/15/86
A.C.E. - Design	<i>[Signature]</i>	8/15/86	Traffic	N/A WJW	8/15/86
A.C.E. - Hydrology	<i>[Signature]</i>	8/15/86	Water Utilities	N/A WJW	8/15/86
County Rd. Dept.	<i>[Signature]</i>	8/15/86			
DRAWING NO.	1599	MAP NO.	M-10	SHEET	5 OF 21


NO.	DATE	REMARKS	BY
		DESIGN	
DESIGNED BY	M.J.Y.	DATE	6-86
DRAWN BY	W.V.W.	DATE	6-86
CHECKED BY	K.M.W.	DATE	6-86

ENGINEER'S SEAL: *[Signature]* 6/25/86

AS BUILT INFORMATION: *[Blank]*

BENCH MARKS: *[Blank]*

SEE SHEET 2

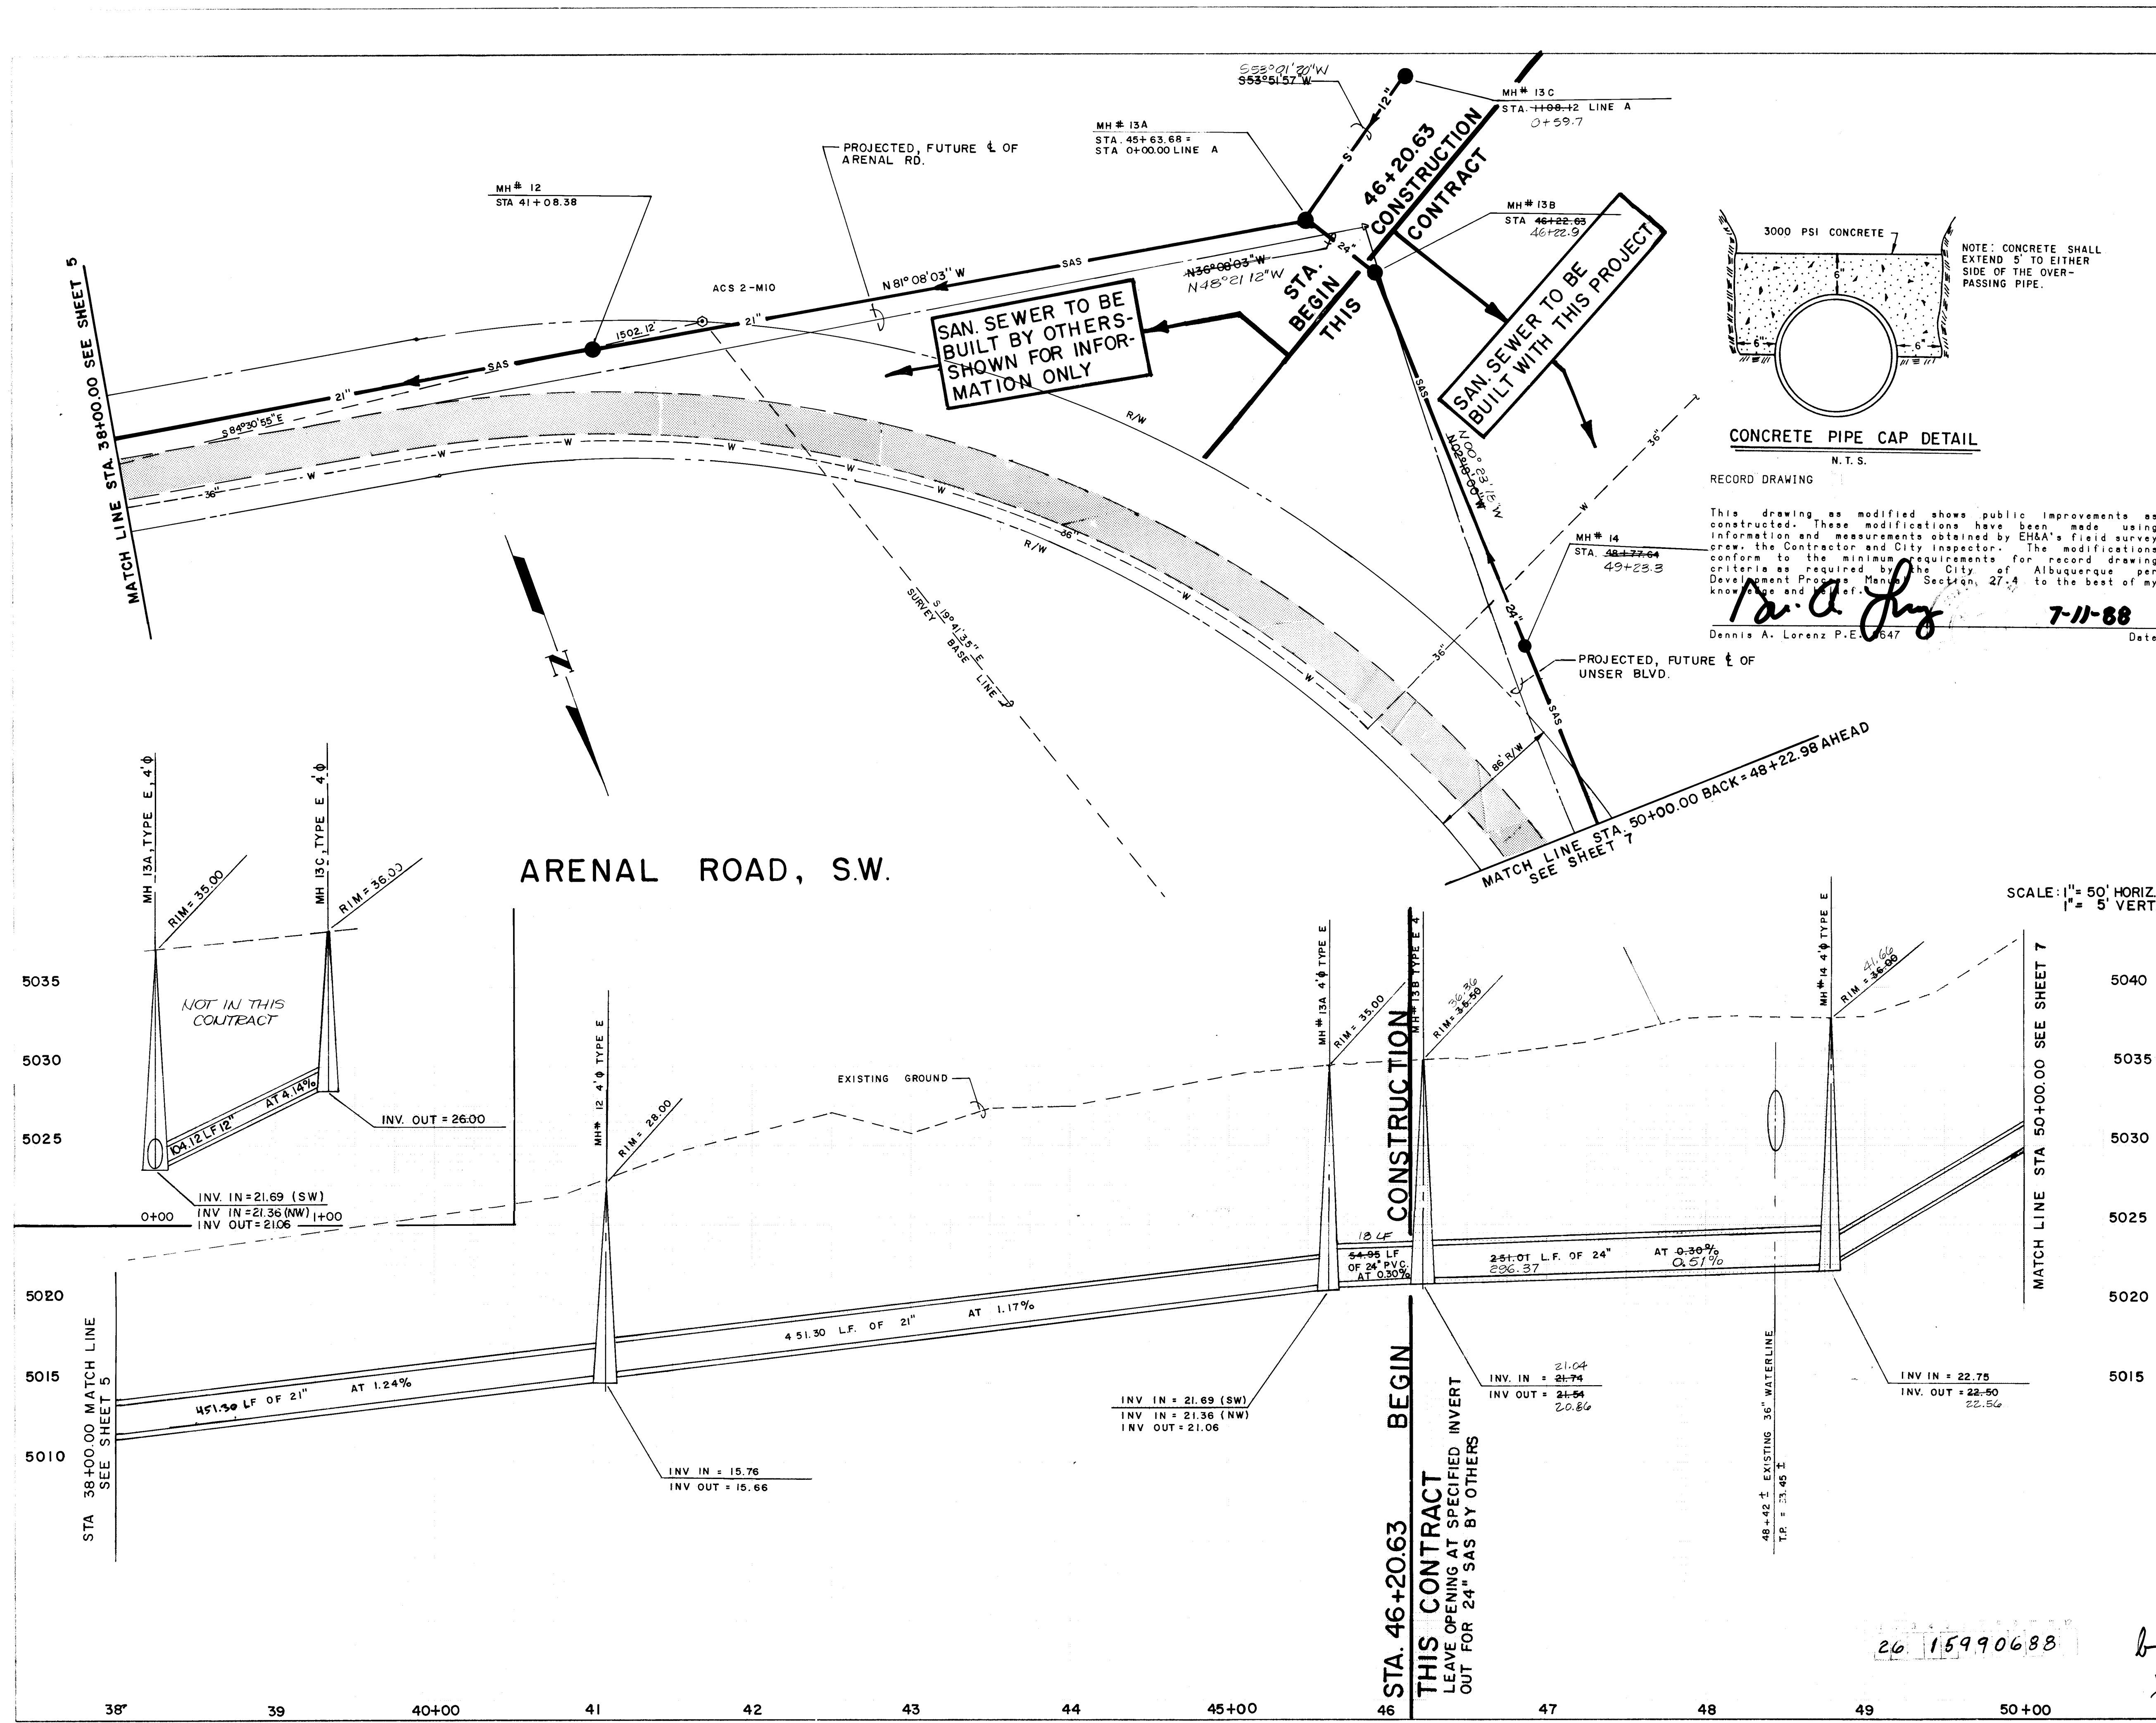

AS BUILT INFORMATION		BENCH MARKS		SURVEY INFORMATION		ENGINEER'S SEAL	
DATE	BY	SEE SHEET	MARKS	NO.	FIELD NOTES	DATE	BY
7/11/88	EH#4	2					
				REVISIONS			
				DESIGN			
				CHECKED BY			
				DATE			
				DATE			


CITY OF ALBUQUERQUE
MUNICIPAL DEVELOPMENT DEPARTMENT
ENGINEERING DIVISION

TITLE: ARENAL/TOWER ROAD SEWER AND SUNRISE TERRACE
MASTER PLAN WATER
STA. 38+00.00 - STA. 50+00.00 BACK, STA 48+22.98 AHEAD

APPROVALS: ENGINEER, DATE 8/15/86, APPROVALS: ENGINEER, DATE 8/15/86
City Engineer, Liquid Waste, Traffic, Water Utilities, County Rd. Dept.
ACE-Design, ACE-Hydrology, County Rd. Dept.

DRAWING NO. 1599, MAP NO. M-10, SHEET 6 OF 21

PROFILE			BY _____	DATE _____
	SURVEYED _____			
	PLOTTED _____			
NOTE BOOK	GRADES CHECKED _____			
NO _____	B. M. NOTED _____			
	STRUCTURE LOCATING CHAND _____			

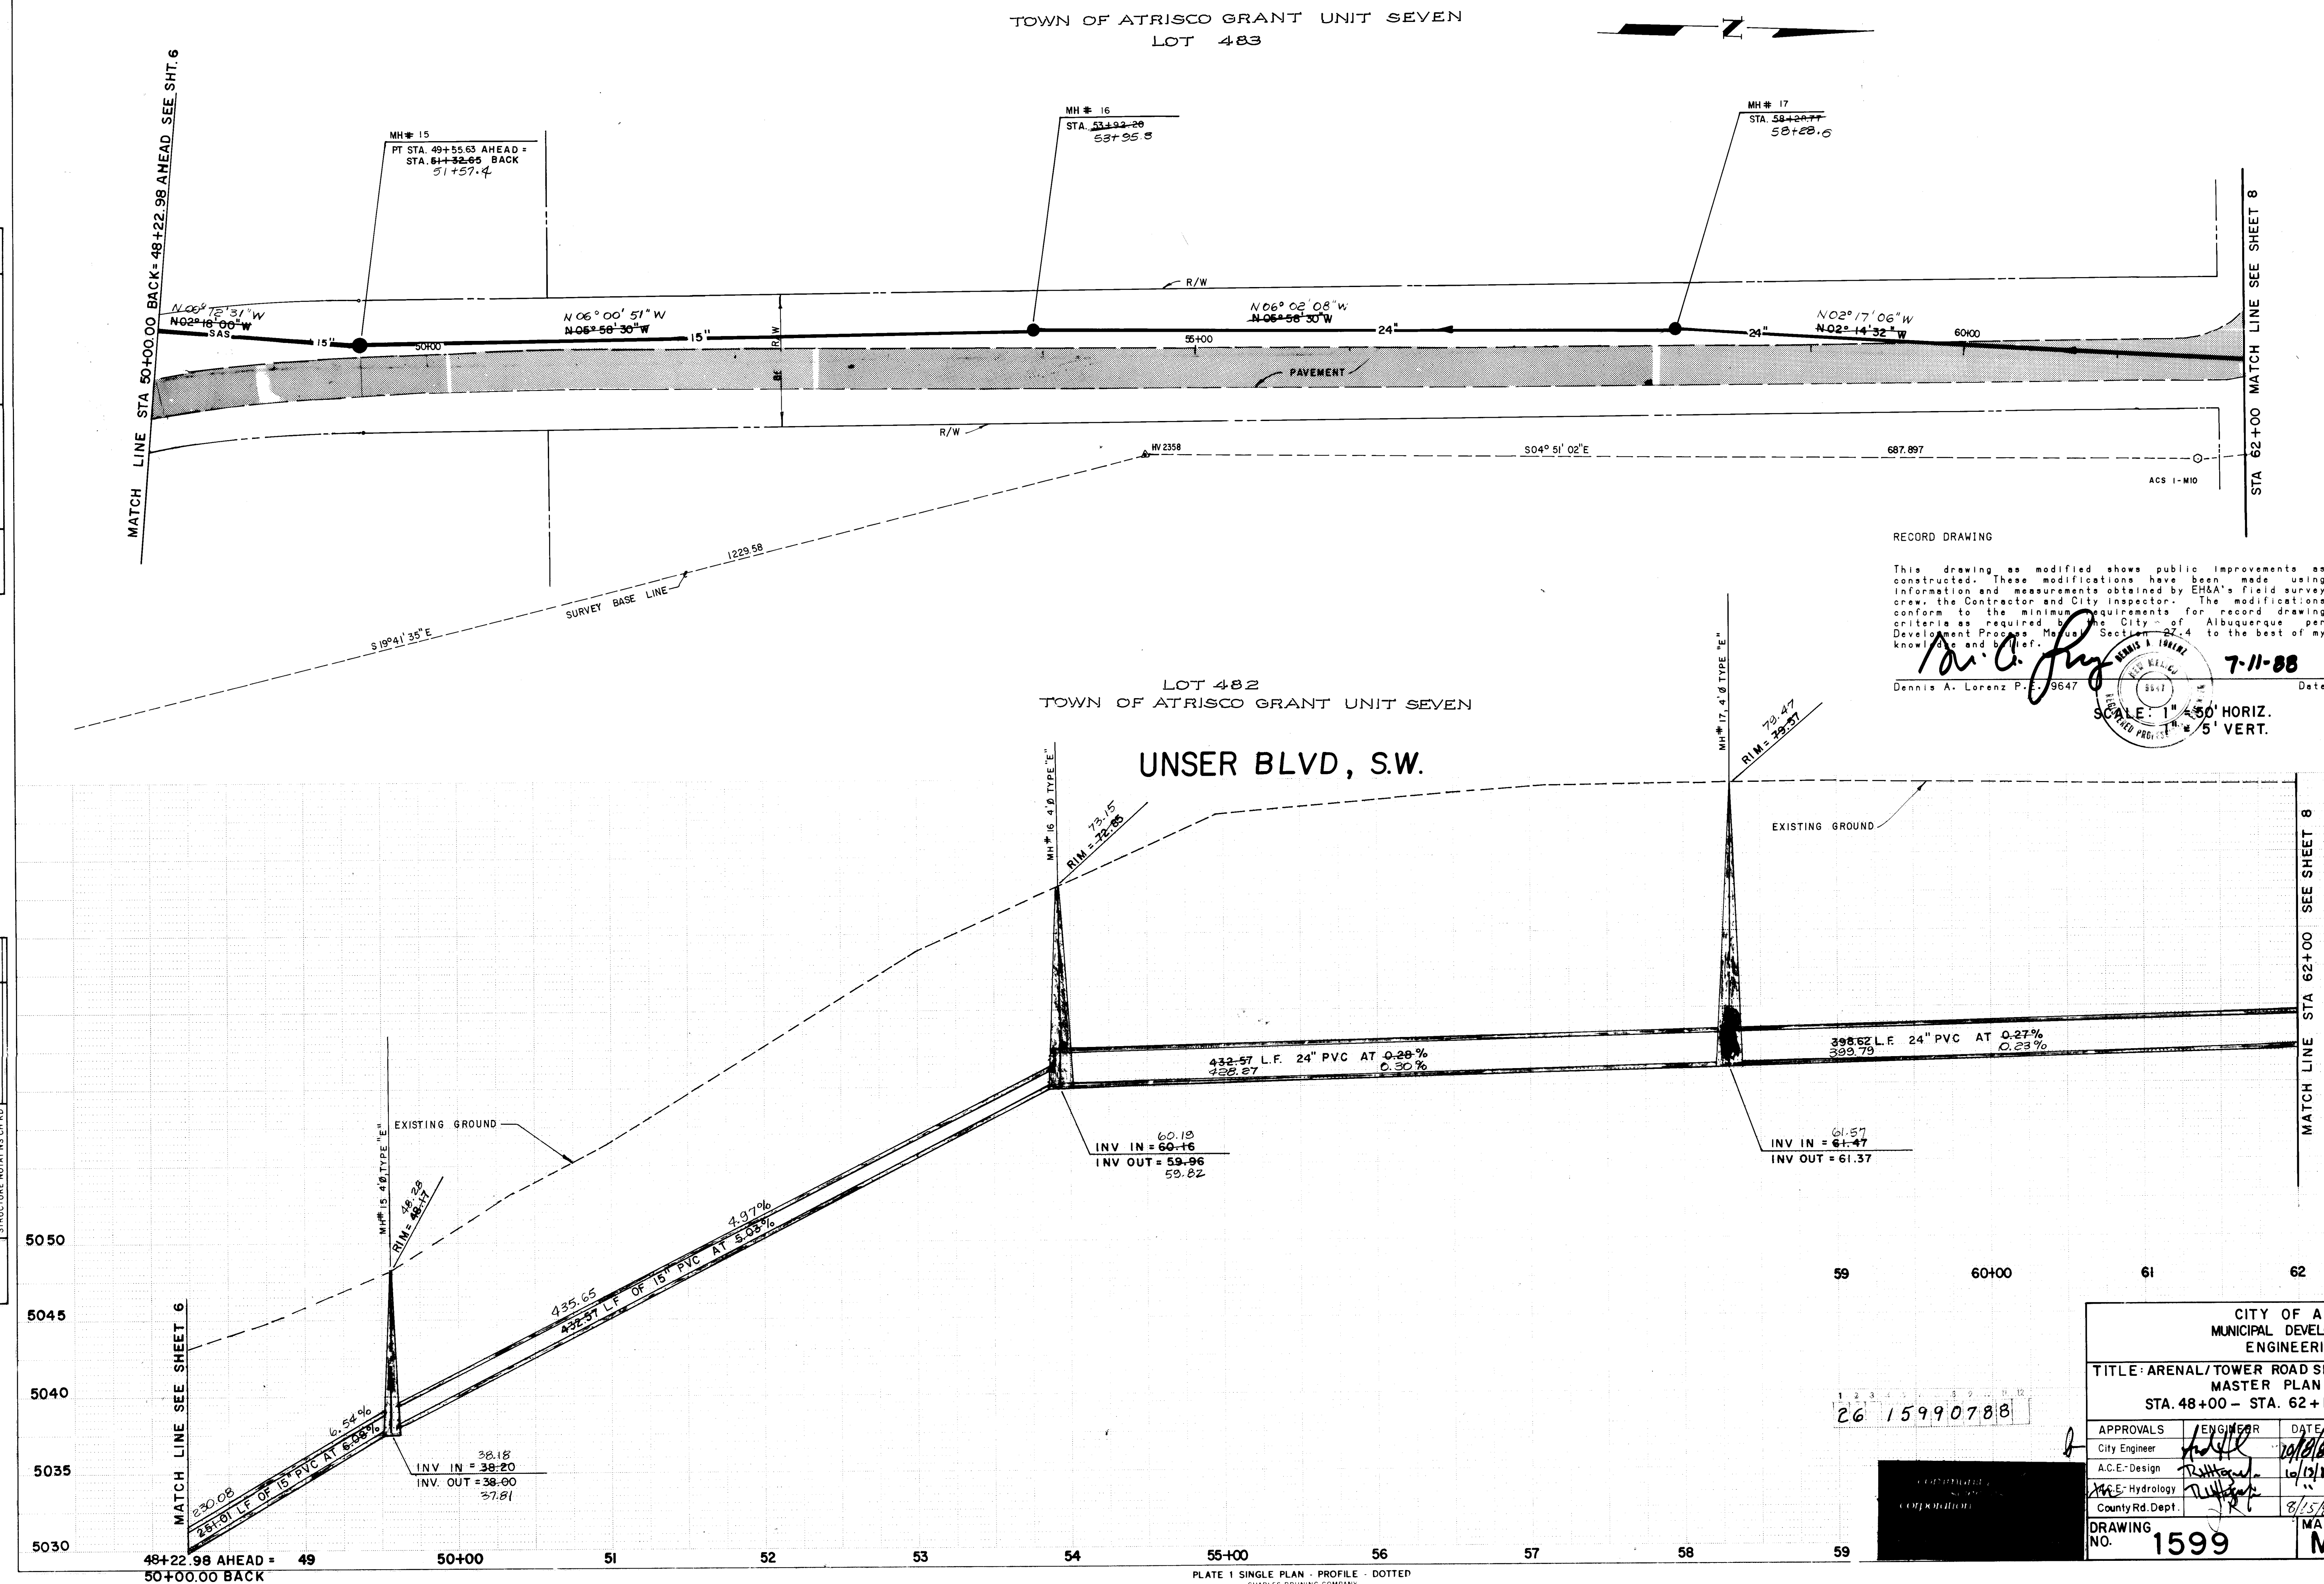

ENGINEERS				SEAL	SURVEY INFORMATION		BENCH MARKS		AS BUILT INFORMATION	
					FIELD NOTES		SEE SHEET 2			
					NO.	BY	DATE			
									CONTRACTOR	COM
									STAKED BY	ELH A
									INSPECTOR'S	DATE '87
									FIELD OFFICE BY	
									VERIFICATION BY	ELH A
									CONTRACTED BY	ELH A
									DATE '88	
									MICRO-FILM INFORMATION	
									RECORDED BY	DATE
										NO.

Michael J. Glast



6/25/86

DESIGNED BY	KMW	DATE	8-80
DRAWN BY	KC W	DATE	8-80
CHECKED BY	PTW	DATE	8-80

CITY OF ALBUQUERQUE MUNICIPAL DEVELOPMENT DEPARTMENT ENGINEERING DIVISION					
TITLE: ARENAL/TOWER ROAD SEWER AND SUNRISE TERRACE MASTER PLAN WATER					
STA. 48+00 - STA. 62+12.16 (MH # 15 - MH # 17)					
APPROVALS	ENGINEER	DATE	APPROVALS	ENGINEER	DATE
City Engineer	<i>[Signature]</i>	10/12/86	Liquid Waste	<i>[Signature]</i>	8/15/86
A.C.E.-Design	<i>[Signature]</i>	10/15/86	Traffic	NADWH	10/15/86
M.E.-Hydrology	<i>[Signature]</i>		Water Utilities	<i>[Signature]</i>	8/15/86
County Rd. Dept.	<i>[Signature]</i>	8/15/86			
DRAWING NO.	1599		MAP NO.	M-10	
			SHEET	7	OF 21

PLAN	SURVEYED	BY	DATE
	NOTED		
NOTE BOOK	PLOTTED		
	GRADES CHECKED		
NO.	STRUCTURE NOTATIONS CHKD		

PROFILE	SURVEYED	BY	DATE
	NOTED		
NOTE BOOK	PLOTTED		
	GRADES CHECKED		
NO.	STRUCTURE NOTATIONS CHKD		

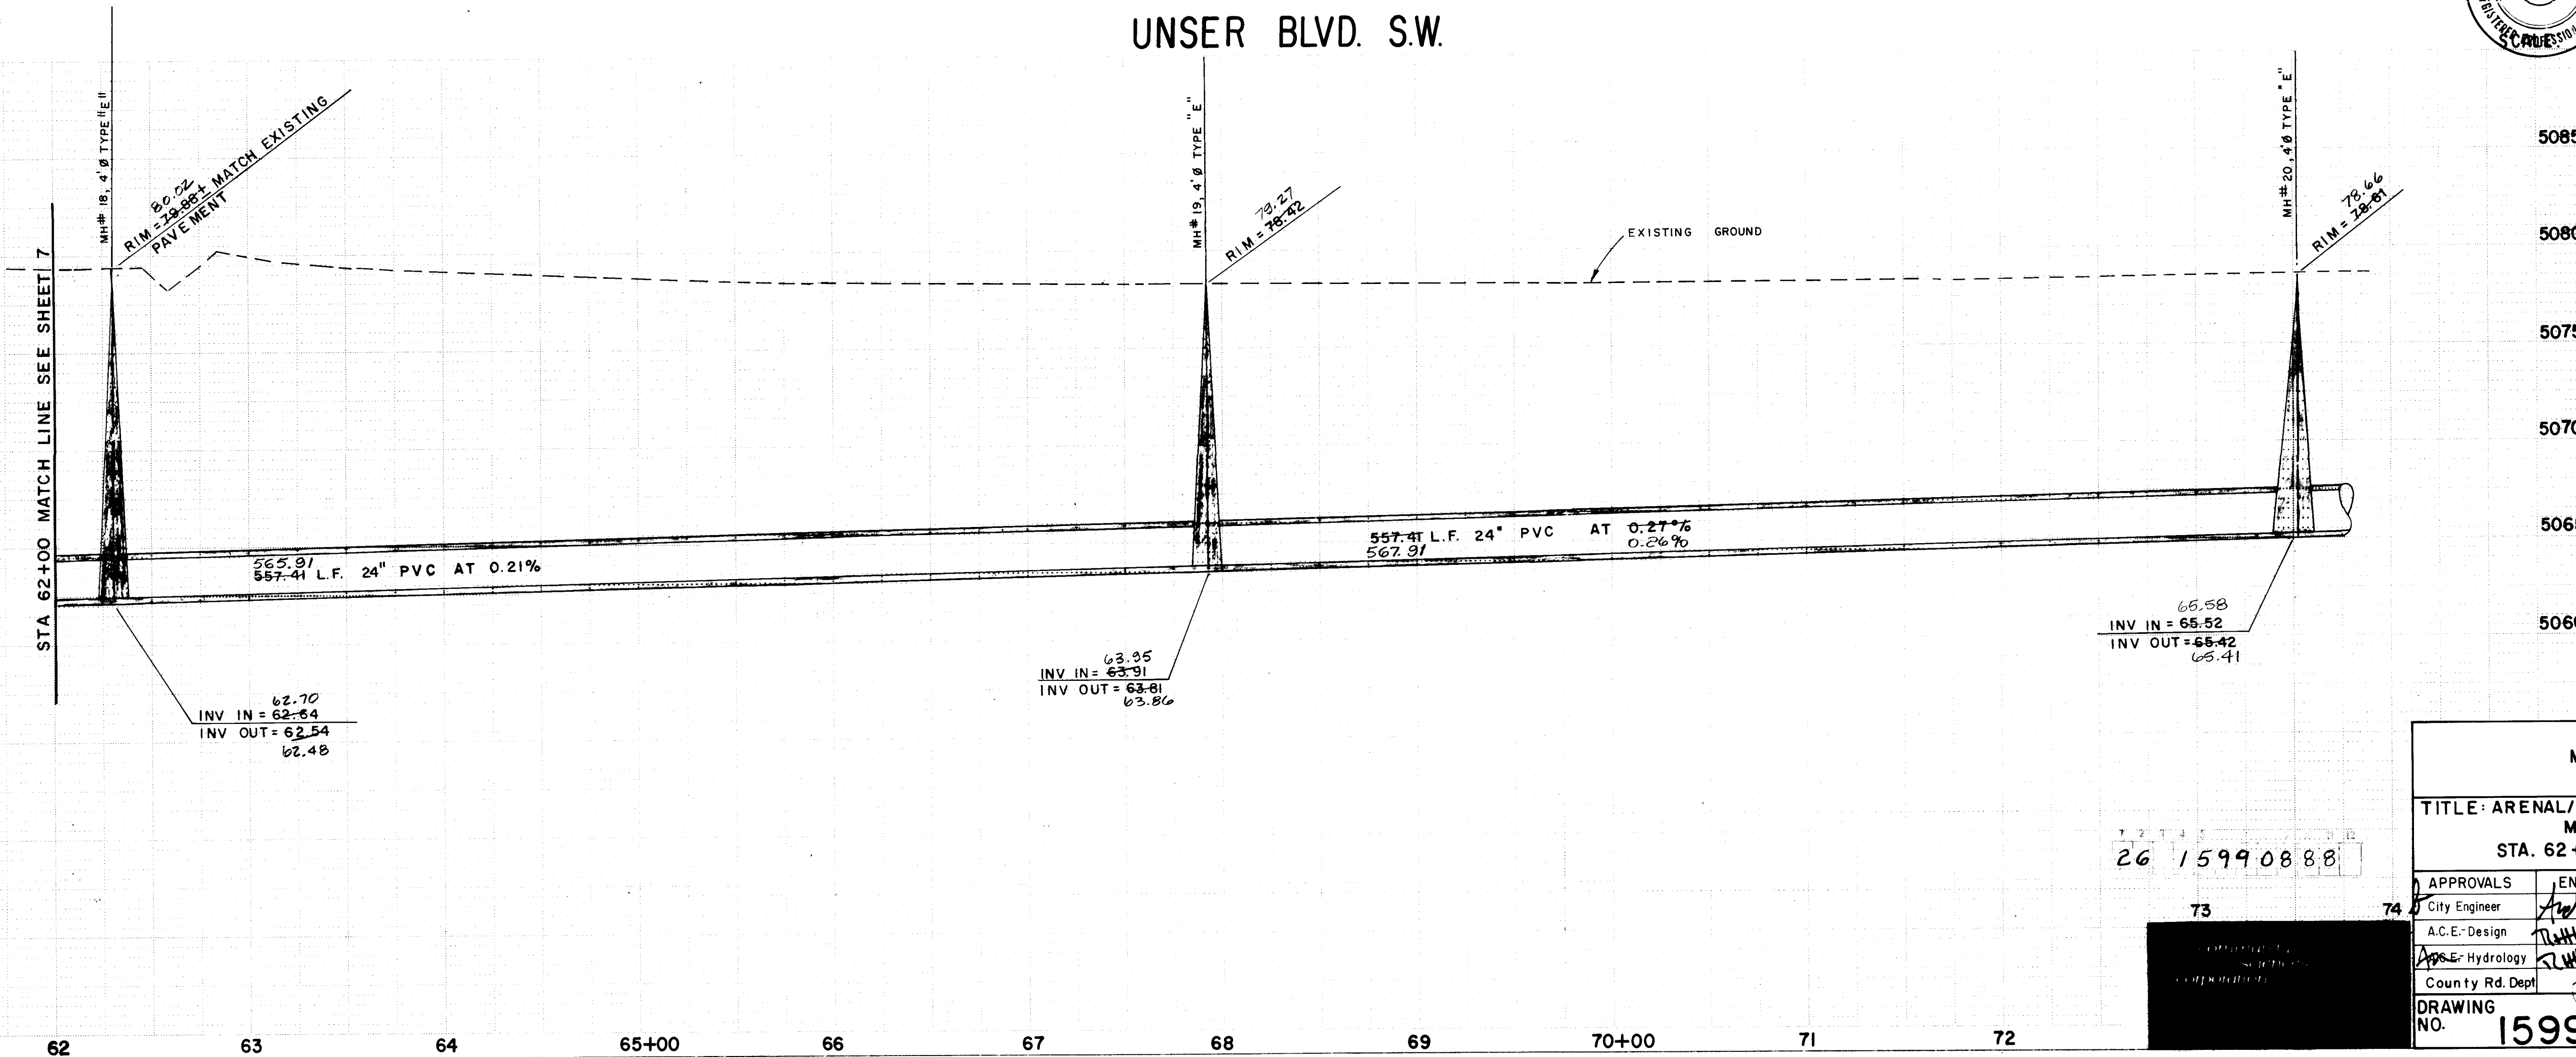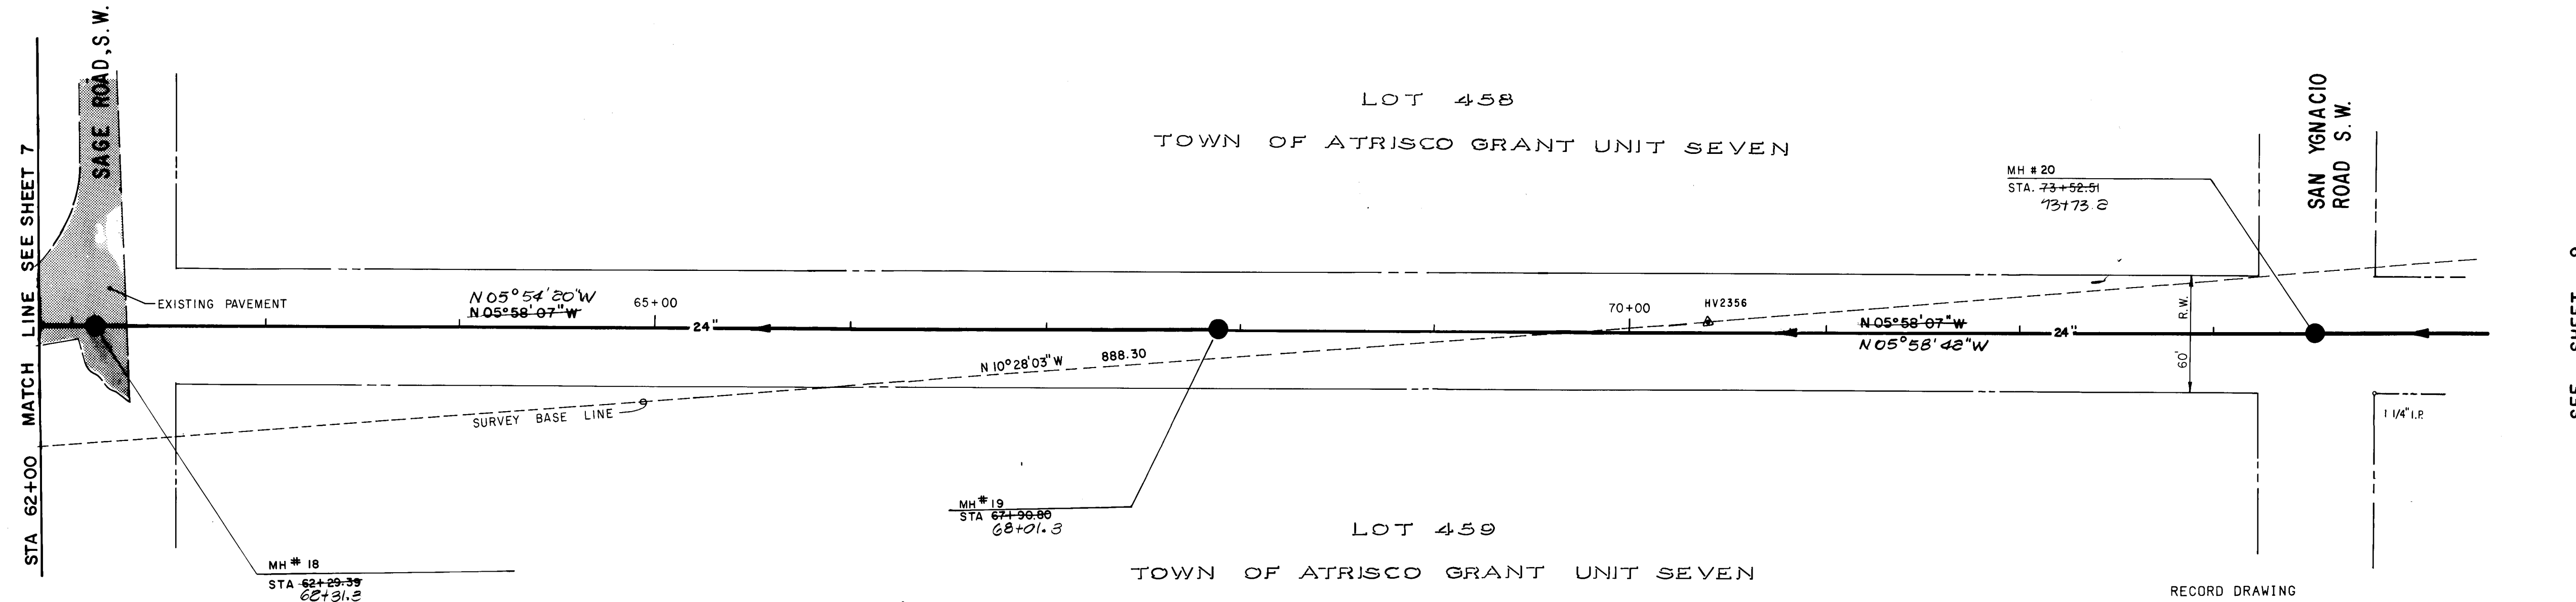

RECORD DRAWING

This drawing as modified shows public improvements as constructed. These modifications have been made using information and measurements obtained by EHA's field survey crew, the Contractor and City Inspector. The modifications conform to the minimum requirements for record drawing criteria as required by the City of Albuquerque per Development Process Manual Section 10.1.1. The best of my knowledge and belief.


Dennis A. Lorenz P.E. 6547

6/25/86

CITY OF ALBUQUERQUE MUNICIPAL DEVELOPMENT DEPARTMENT ENGINEERING DIVISION					
TITLE: ARENAL/TOWER ROAD SEWER AND SUNRISE TERRACE MASTER PLAN WATER STA. 62+00.00— STA. 73+52.51 (MH#18—MH#20)					
APPROVALS	ENGINEER	DATE	APPROVALS	ENGINEER	DATE
City Engineer	<i>[Signature]</i>	8/13/86	Liquid Waste	<i>[Signature]</i>	8/13/86
A.C.E.-Design	<i>[Signature]</i>	8/13/86	Traffic	<i>[Signature]</i>	7/5/86
App. Hydrology	<i>[Signature]</i>	8/13/86	Water Utilities	<i>[Signature]</i>	8/15/86
County Rd. Dept	<i>[Signature]</i>	8/15/86			
DRAWING NO.	1599	MAP NO.	L-10	SHEET	8 OF 21

PLAN	DATE
SURVEYED	BY
PLOTTED	DATE
CHECKED	DATE
AT	DATE
NO.	

PROFILE	DATE
SURVEYED	BY
PLOTTED	DATE
CHECKED	DATE
AT	DATE
NO.	

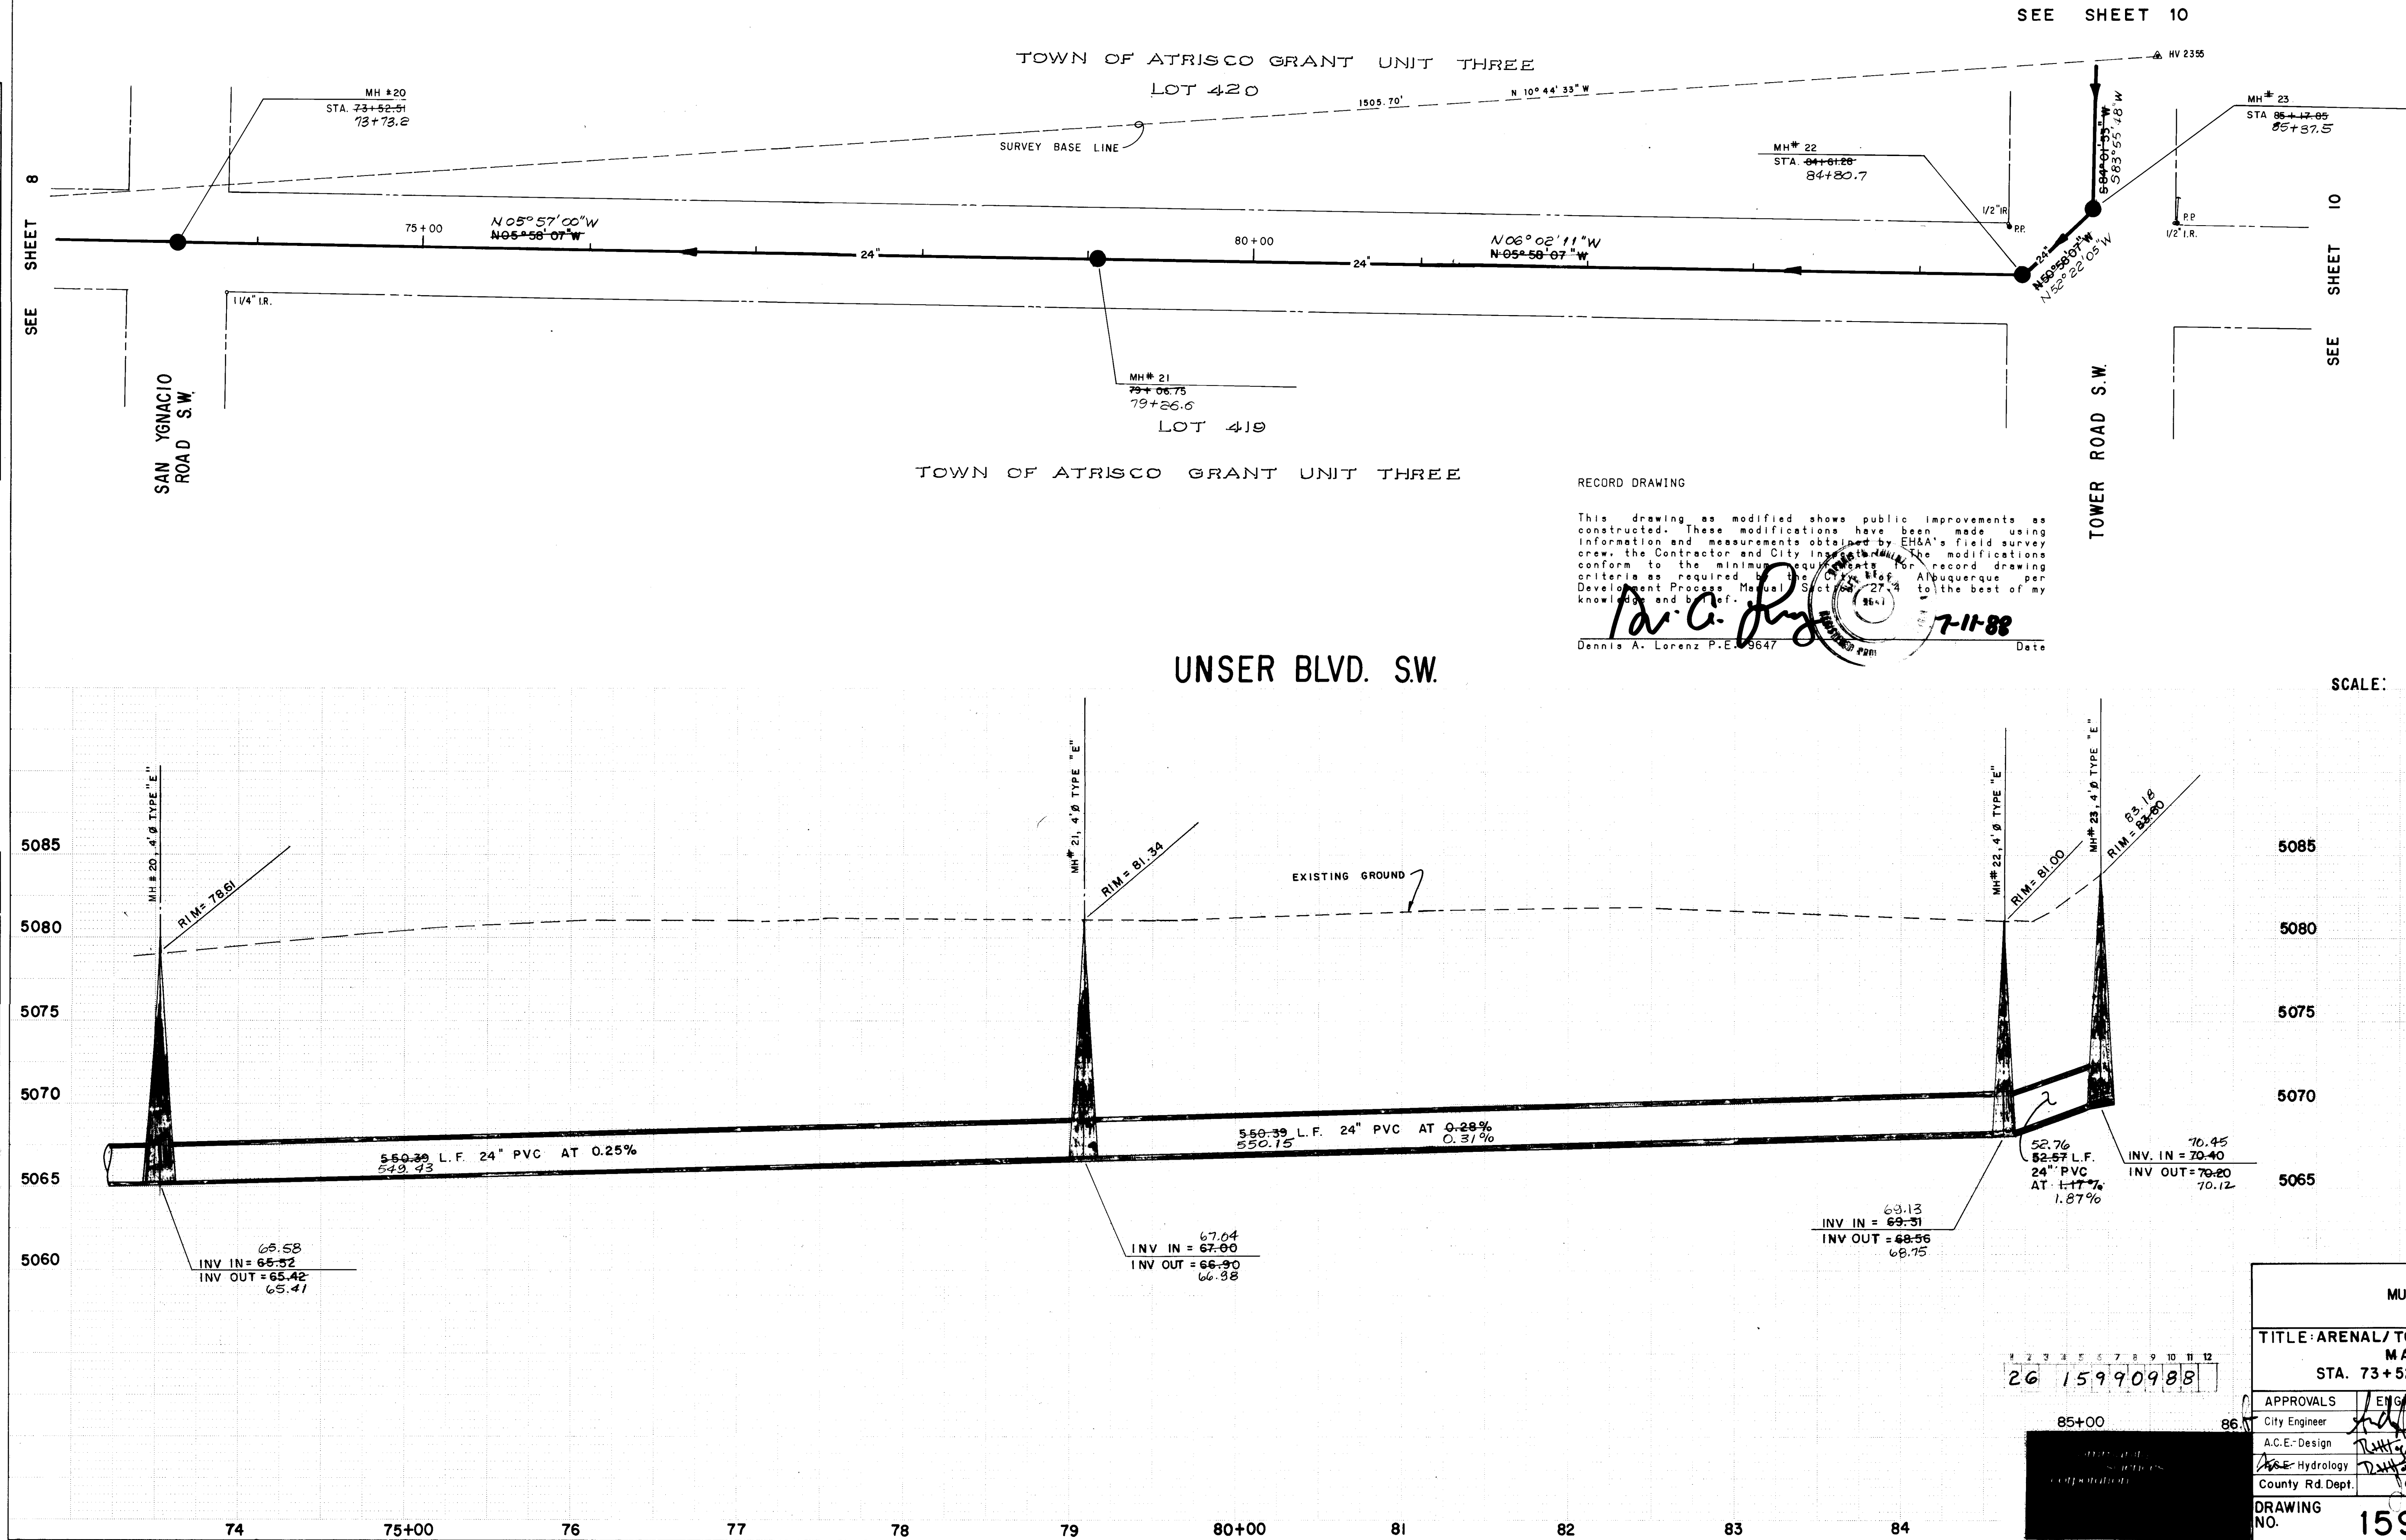

RECORD DRAWING

This drawing as modified shows public improvements as constructed. These modifications have been made using information and measurements obtained by EHA's field survey crew, the Contractor and City Inspector. The modifications conform to the minimum requirements for record drawing criteria as required by the City of Albuquerque per Development Process Manual Section 27.4 to the best of my knowledge and belief.


Dennis A. Lorenz
Dennis A. Lorenz P.E. 95647
Date 7-11-88

SCALE: 1" = 50' HORIZ.
1" = 5' VERT.

CITY OF ALBUQUERQUE MUNICIPAL DEVELOPMENT DEPARTMENT ENGINEERING DIVISION			
TITLE: ARENAL/TOWER ROAD SEWER AND SUNRISE TERRACE MASTER PLAN WATER STA. 73+52.51 - STA. 85+17.85 (MH #20 - MH #23)			
APPROVALS	ENGINEER	DATE	APPROVALS
City Engineer	<i>[Signature]</i>	8/12/86	Liquid Waste
A.C.E. Design	<i>[Signature]</i>	10/15/86	Traffic
Hydrology	<i>[Signature]</i>	1/11	Water Utilities
County Rd. Dept.	<i>[Signature]</i>	8/15/86	
DRAWING NO. 1599		SHEET 9 OF 21	

--	--	

PROFILE		BY	DATE
SURVEYED			
PLOTTED			
GRACES CHECKED			
B.M. NOTED			
STRUCTURE NOTATIONS CH'KD			

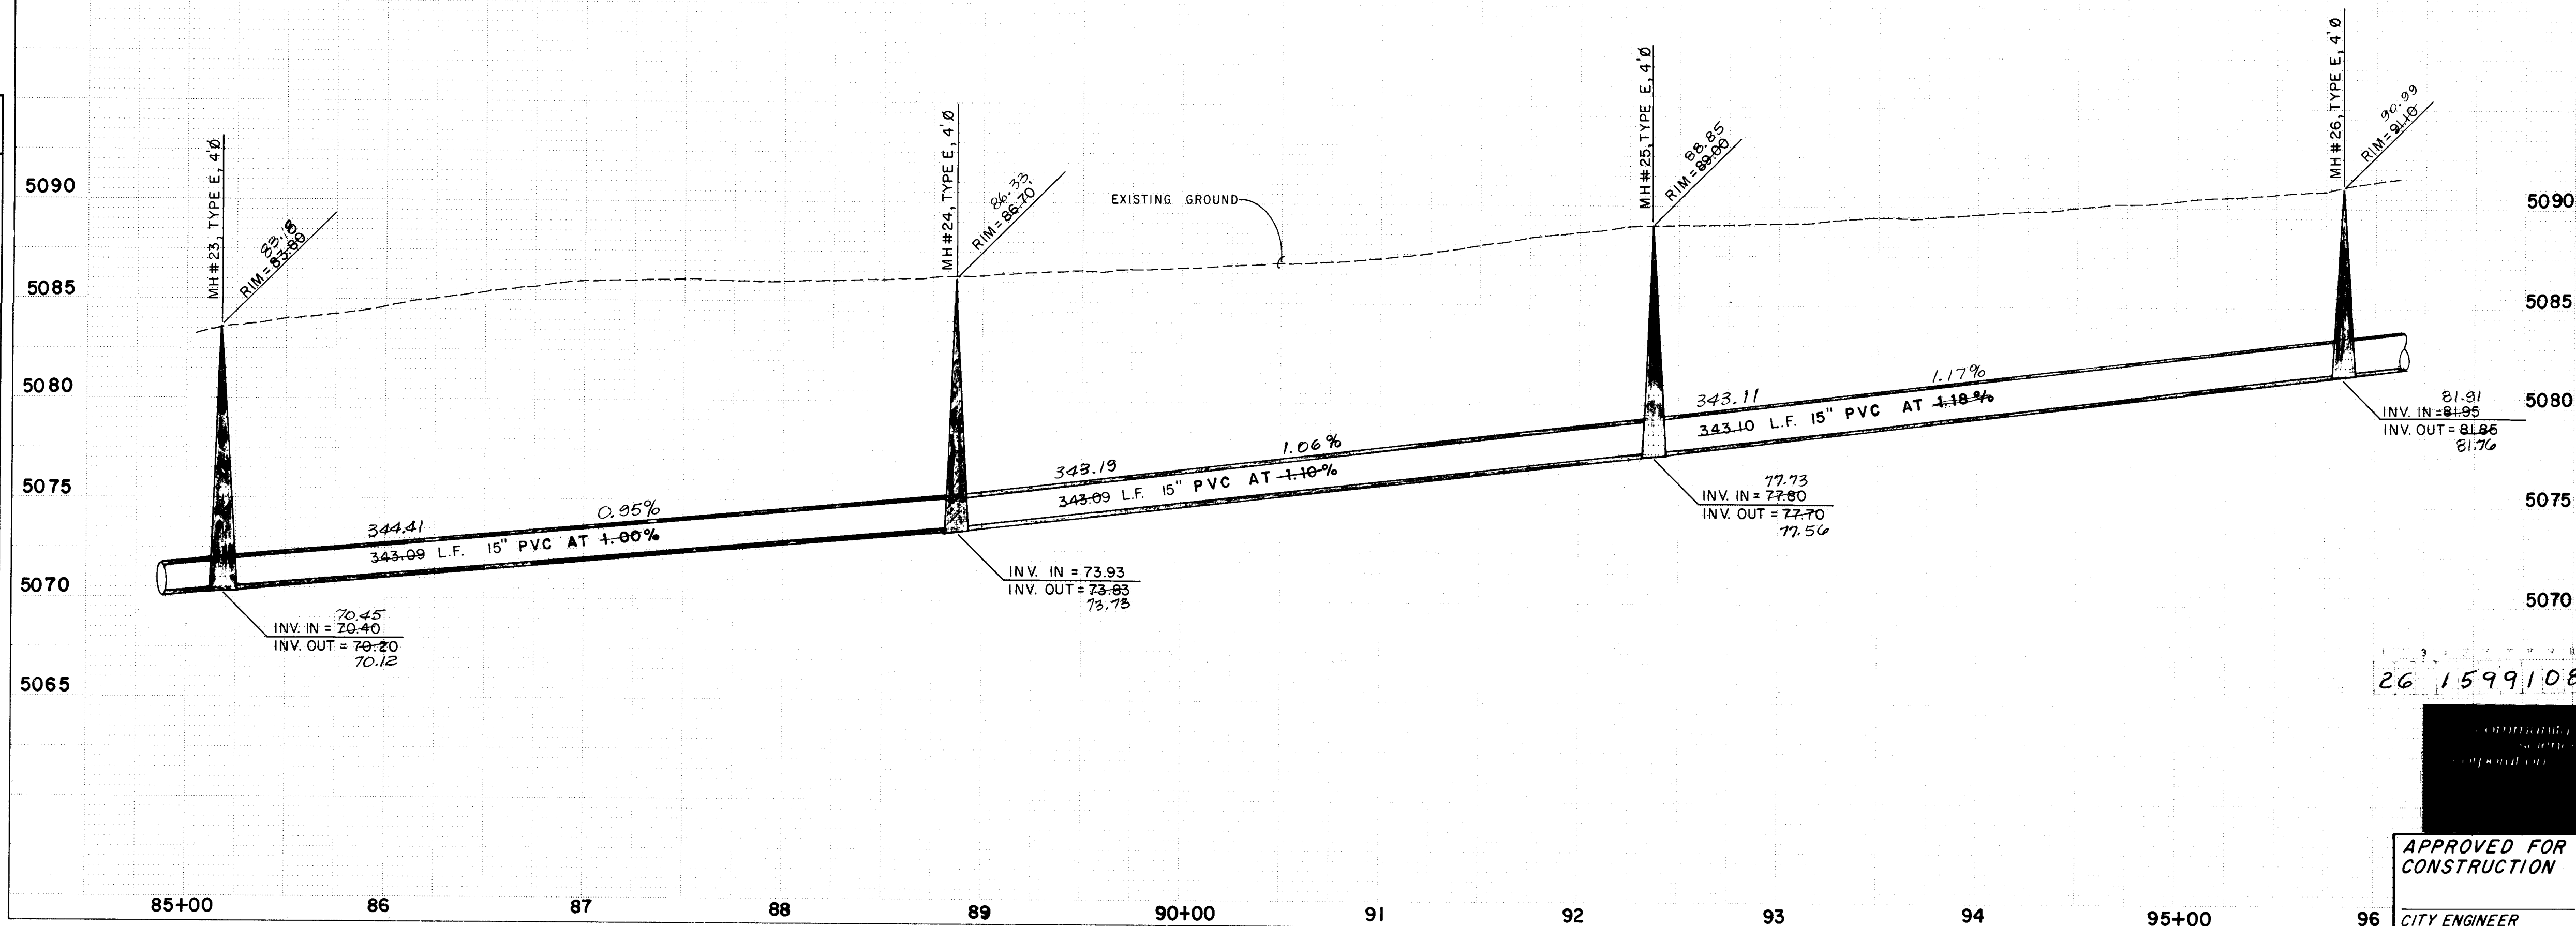

SCALE : 1" = 50' HORIZ.
1" = 5' VERT.

[illegible]

PROFILE		BY	DATE
SURVEYED			
PLOTTED			
GRADES CHECKED			
B. M. NOTED			
STRUCTURE NOTATIONS CHKD			
NO			
NOTE BOOK			

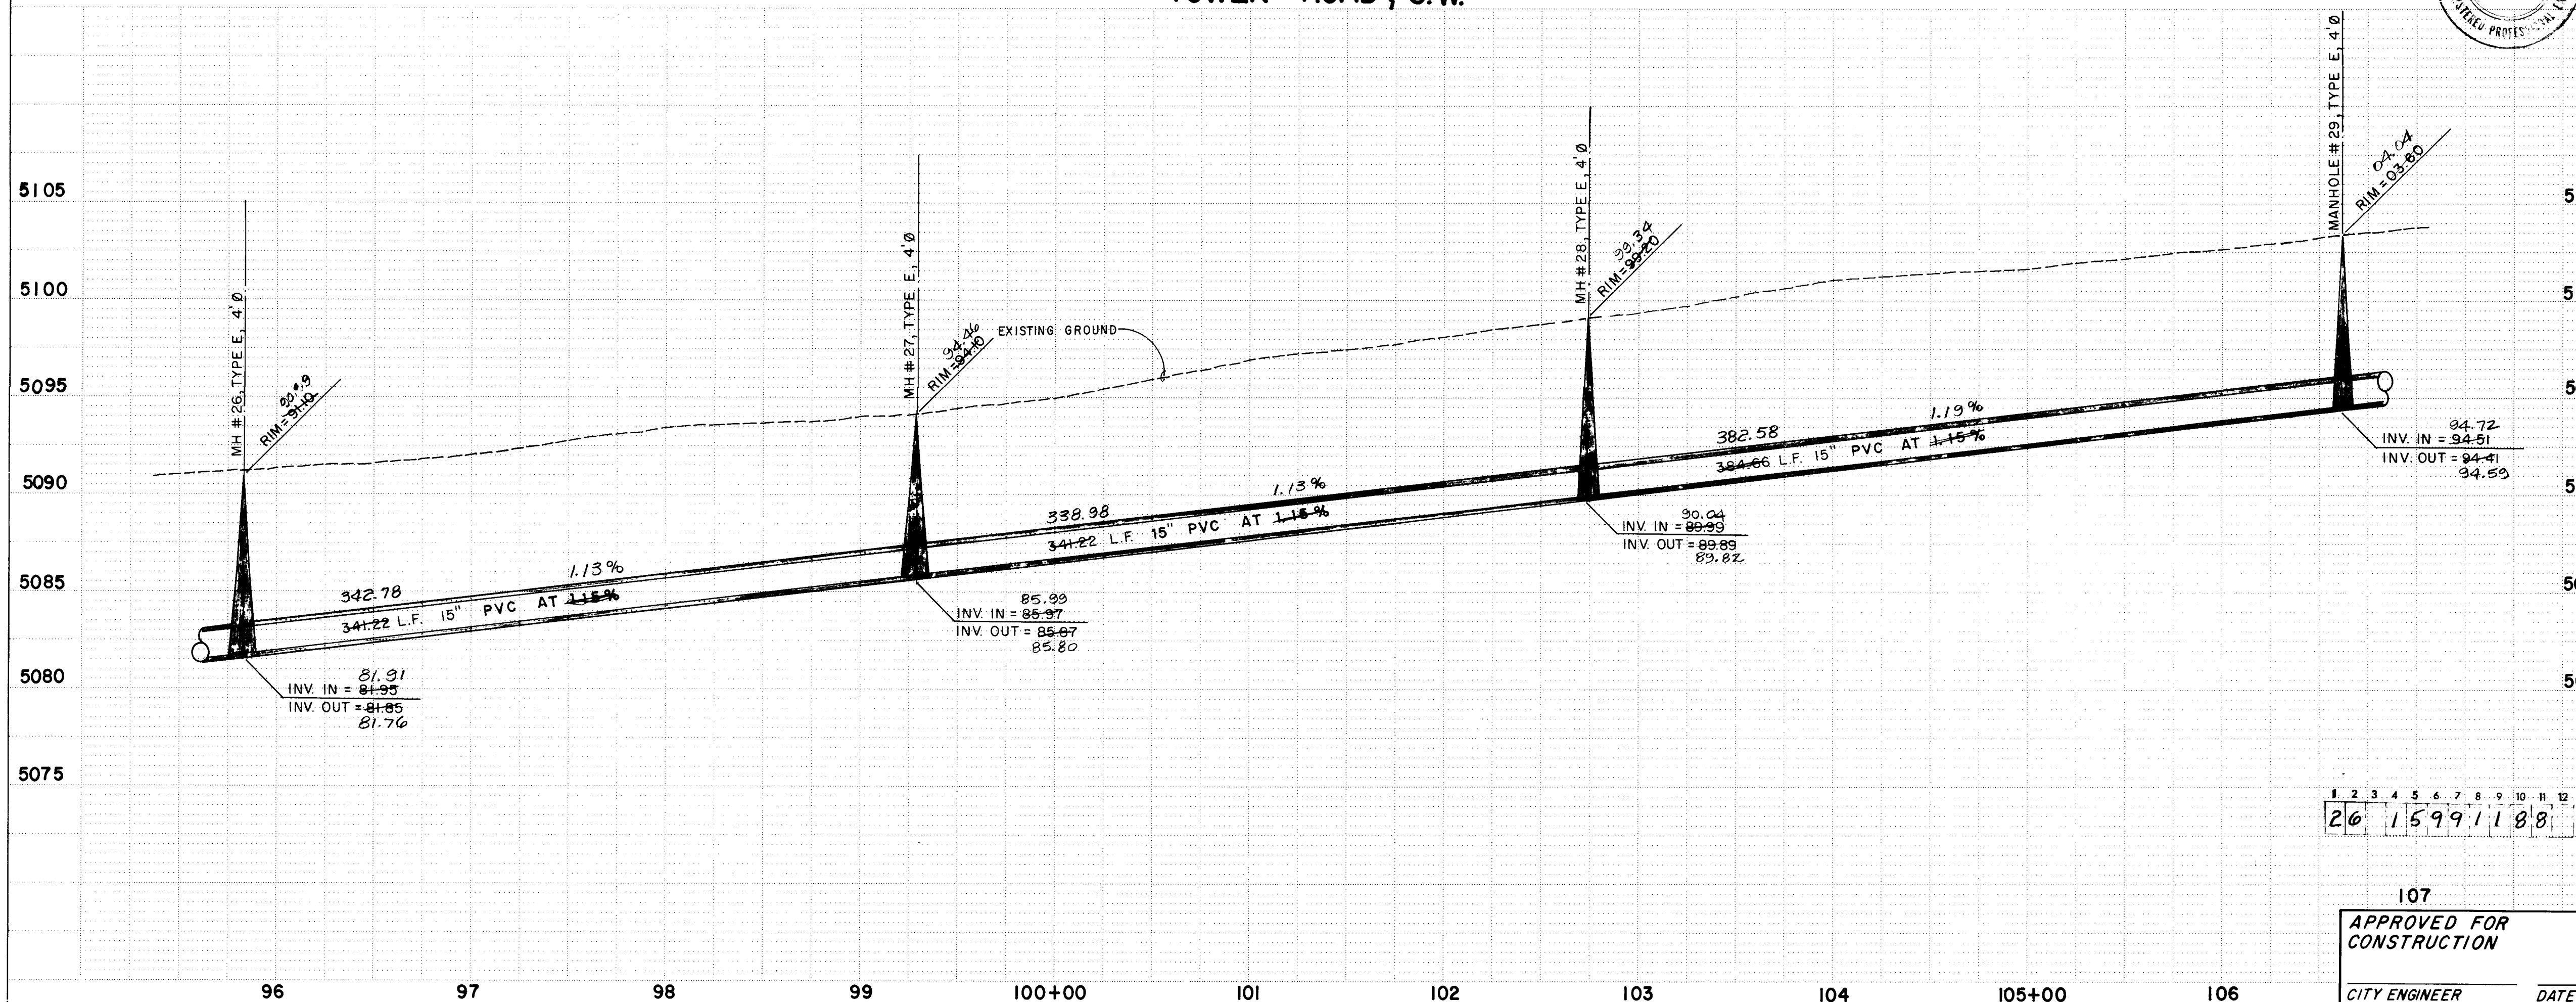

This drawing as modified shows public improvements as constructed. These modifications have been made using information and measurements obtained by EH&A's field survey crew, the Contractor and City Inspector. The modifications conform to the minimum requirements for record drawing criteria set forth in the City of Albuquerque's Engineering Department's Manual Section 100.00. To the best of my knowledge and belief.

Dennis A. Lorenz


Stamp: PROFESSIONAL ENGINEER, STATE OF NEW MEXICO, 7-11-88, 5047

Dennis A. Lorenz P.E. 5047 Date

SCALE : 1" = 50' HORIZ.
1" = 5' VERT.

[illegible]

PROFILE	SURVEYED	BY	DATE
	PLOTTED		
	GRADES CHECKED		
	B. M. : NOTED		
	STRUCTURE NOTATIONS CH'KD		

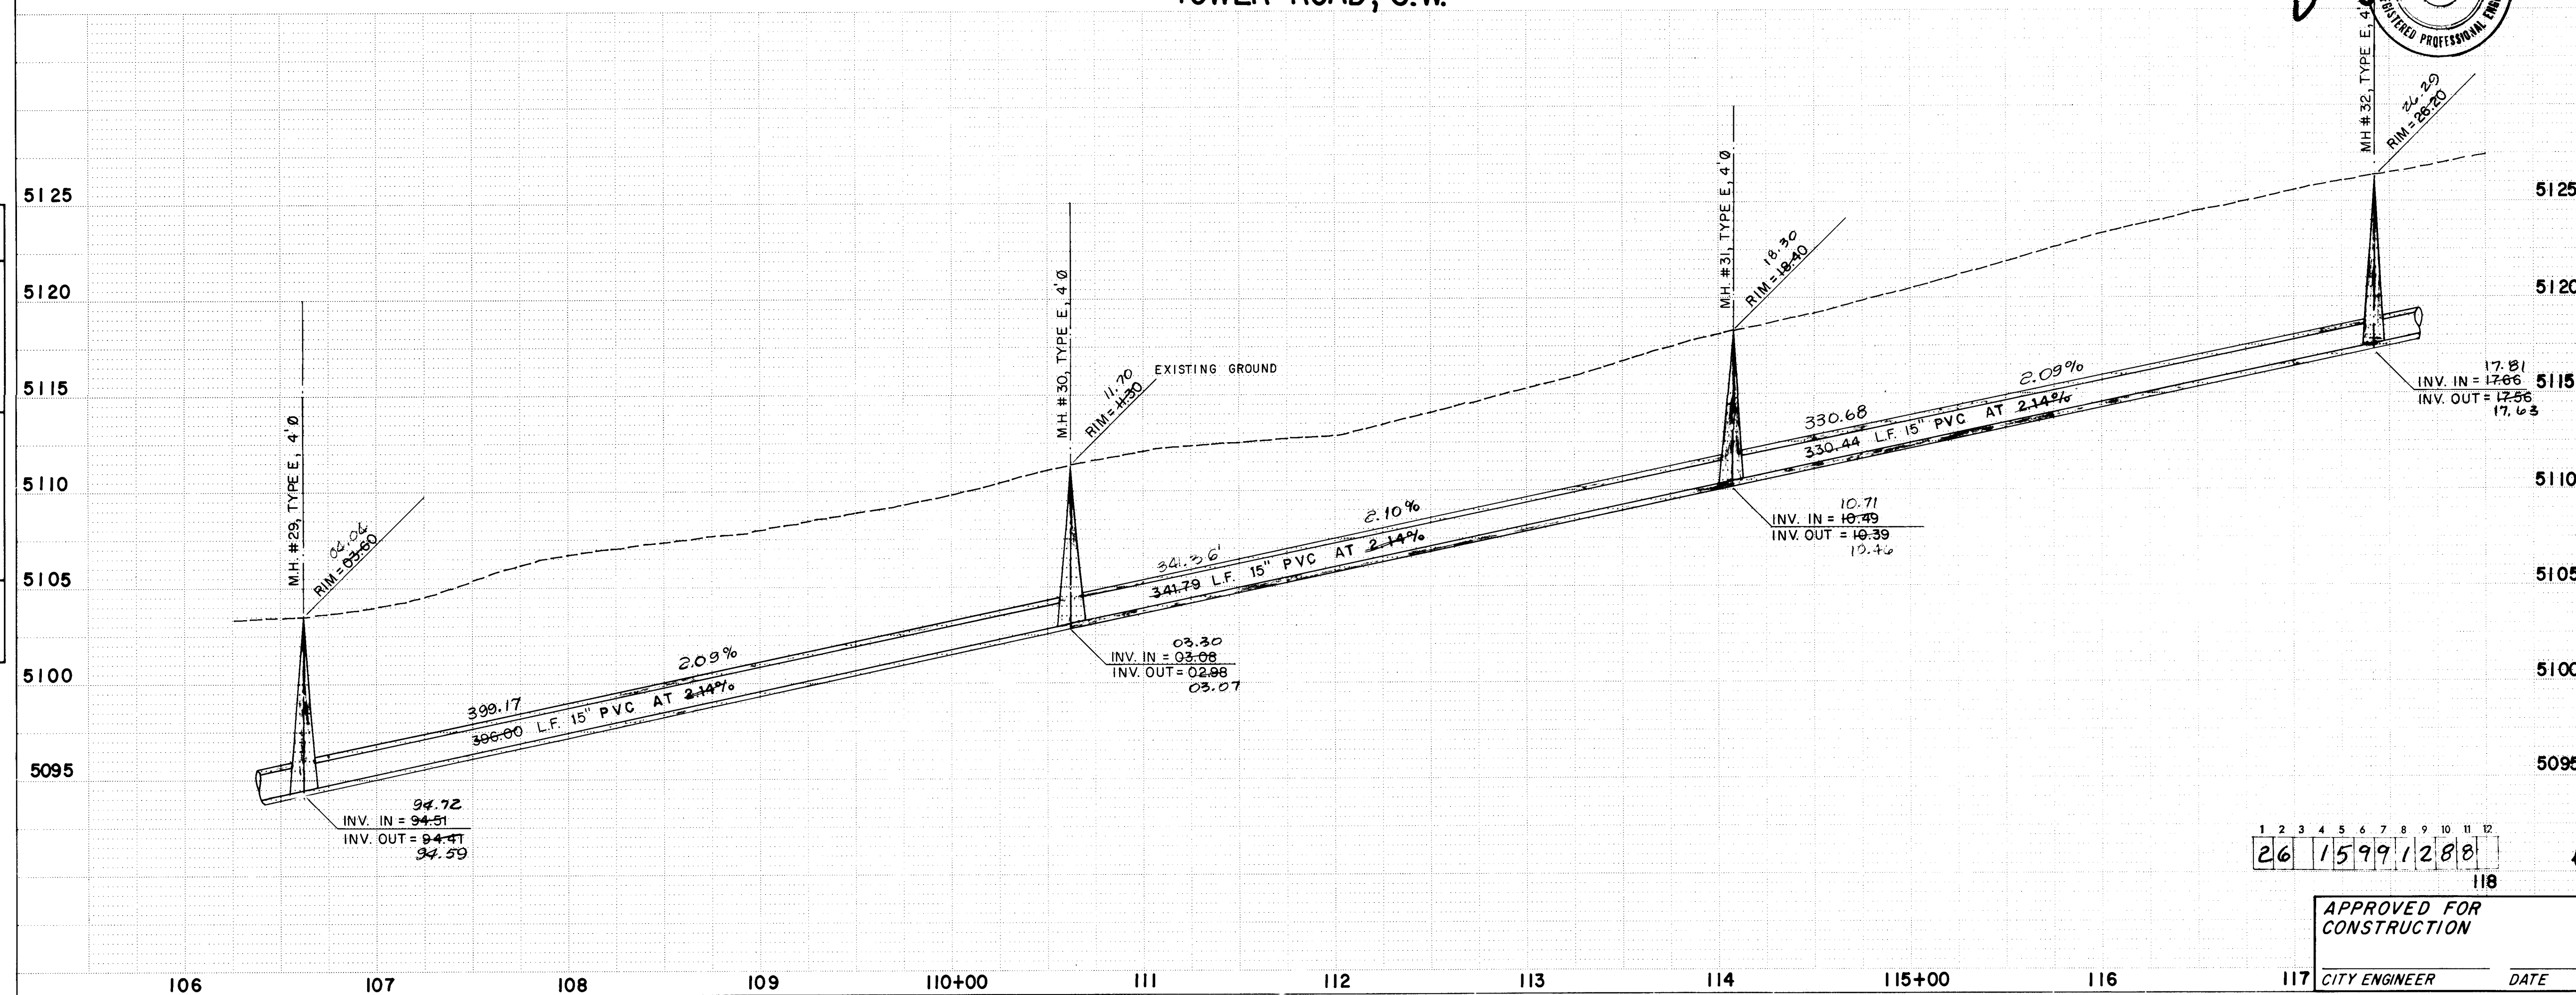

This drawing as modified shows public improvements as constructed. These modifications have been made using information and measurements obtained by EHMA's field survey crew, the Contractor and City Inspector. The modifications conform to the minimum requirements for record drawing criteria as required by the City of Albuquerque per Development Process Manual Section 10000.0 to the best of my

Development Projects Manual Section 101-11.1 to the
knowledge and belief.

Dennis A. Lorenz


Dennis A. Lorenz P.E. 9547

REGISTERED PROFESSIONAL ENGINEER
NEW MEXICO
1967

SCALE: 1" = 50' HORIZ.
1" = 5' VERT.


[illegible]

PROFILE		BY	DATE
SUPERVISED _____			
PLOTTED _____			
GRADES CHECKED _____			
B.M.'S NOTED _____			
STRUCTURE NOTATIONS CH'KD _____			
NOTE BOOK			
NO. _____			

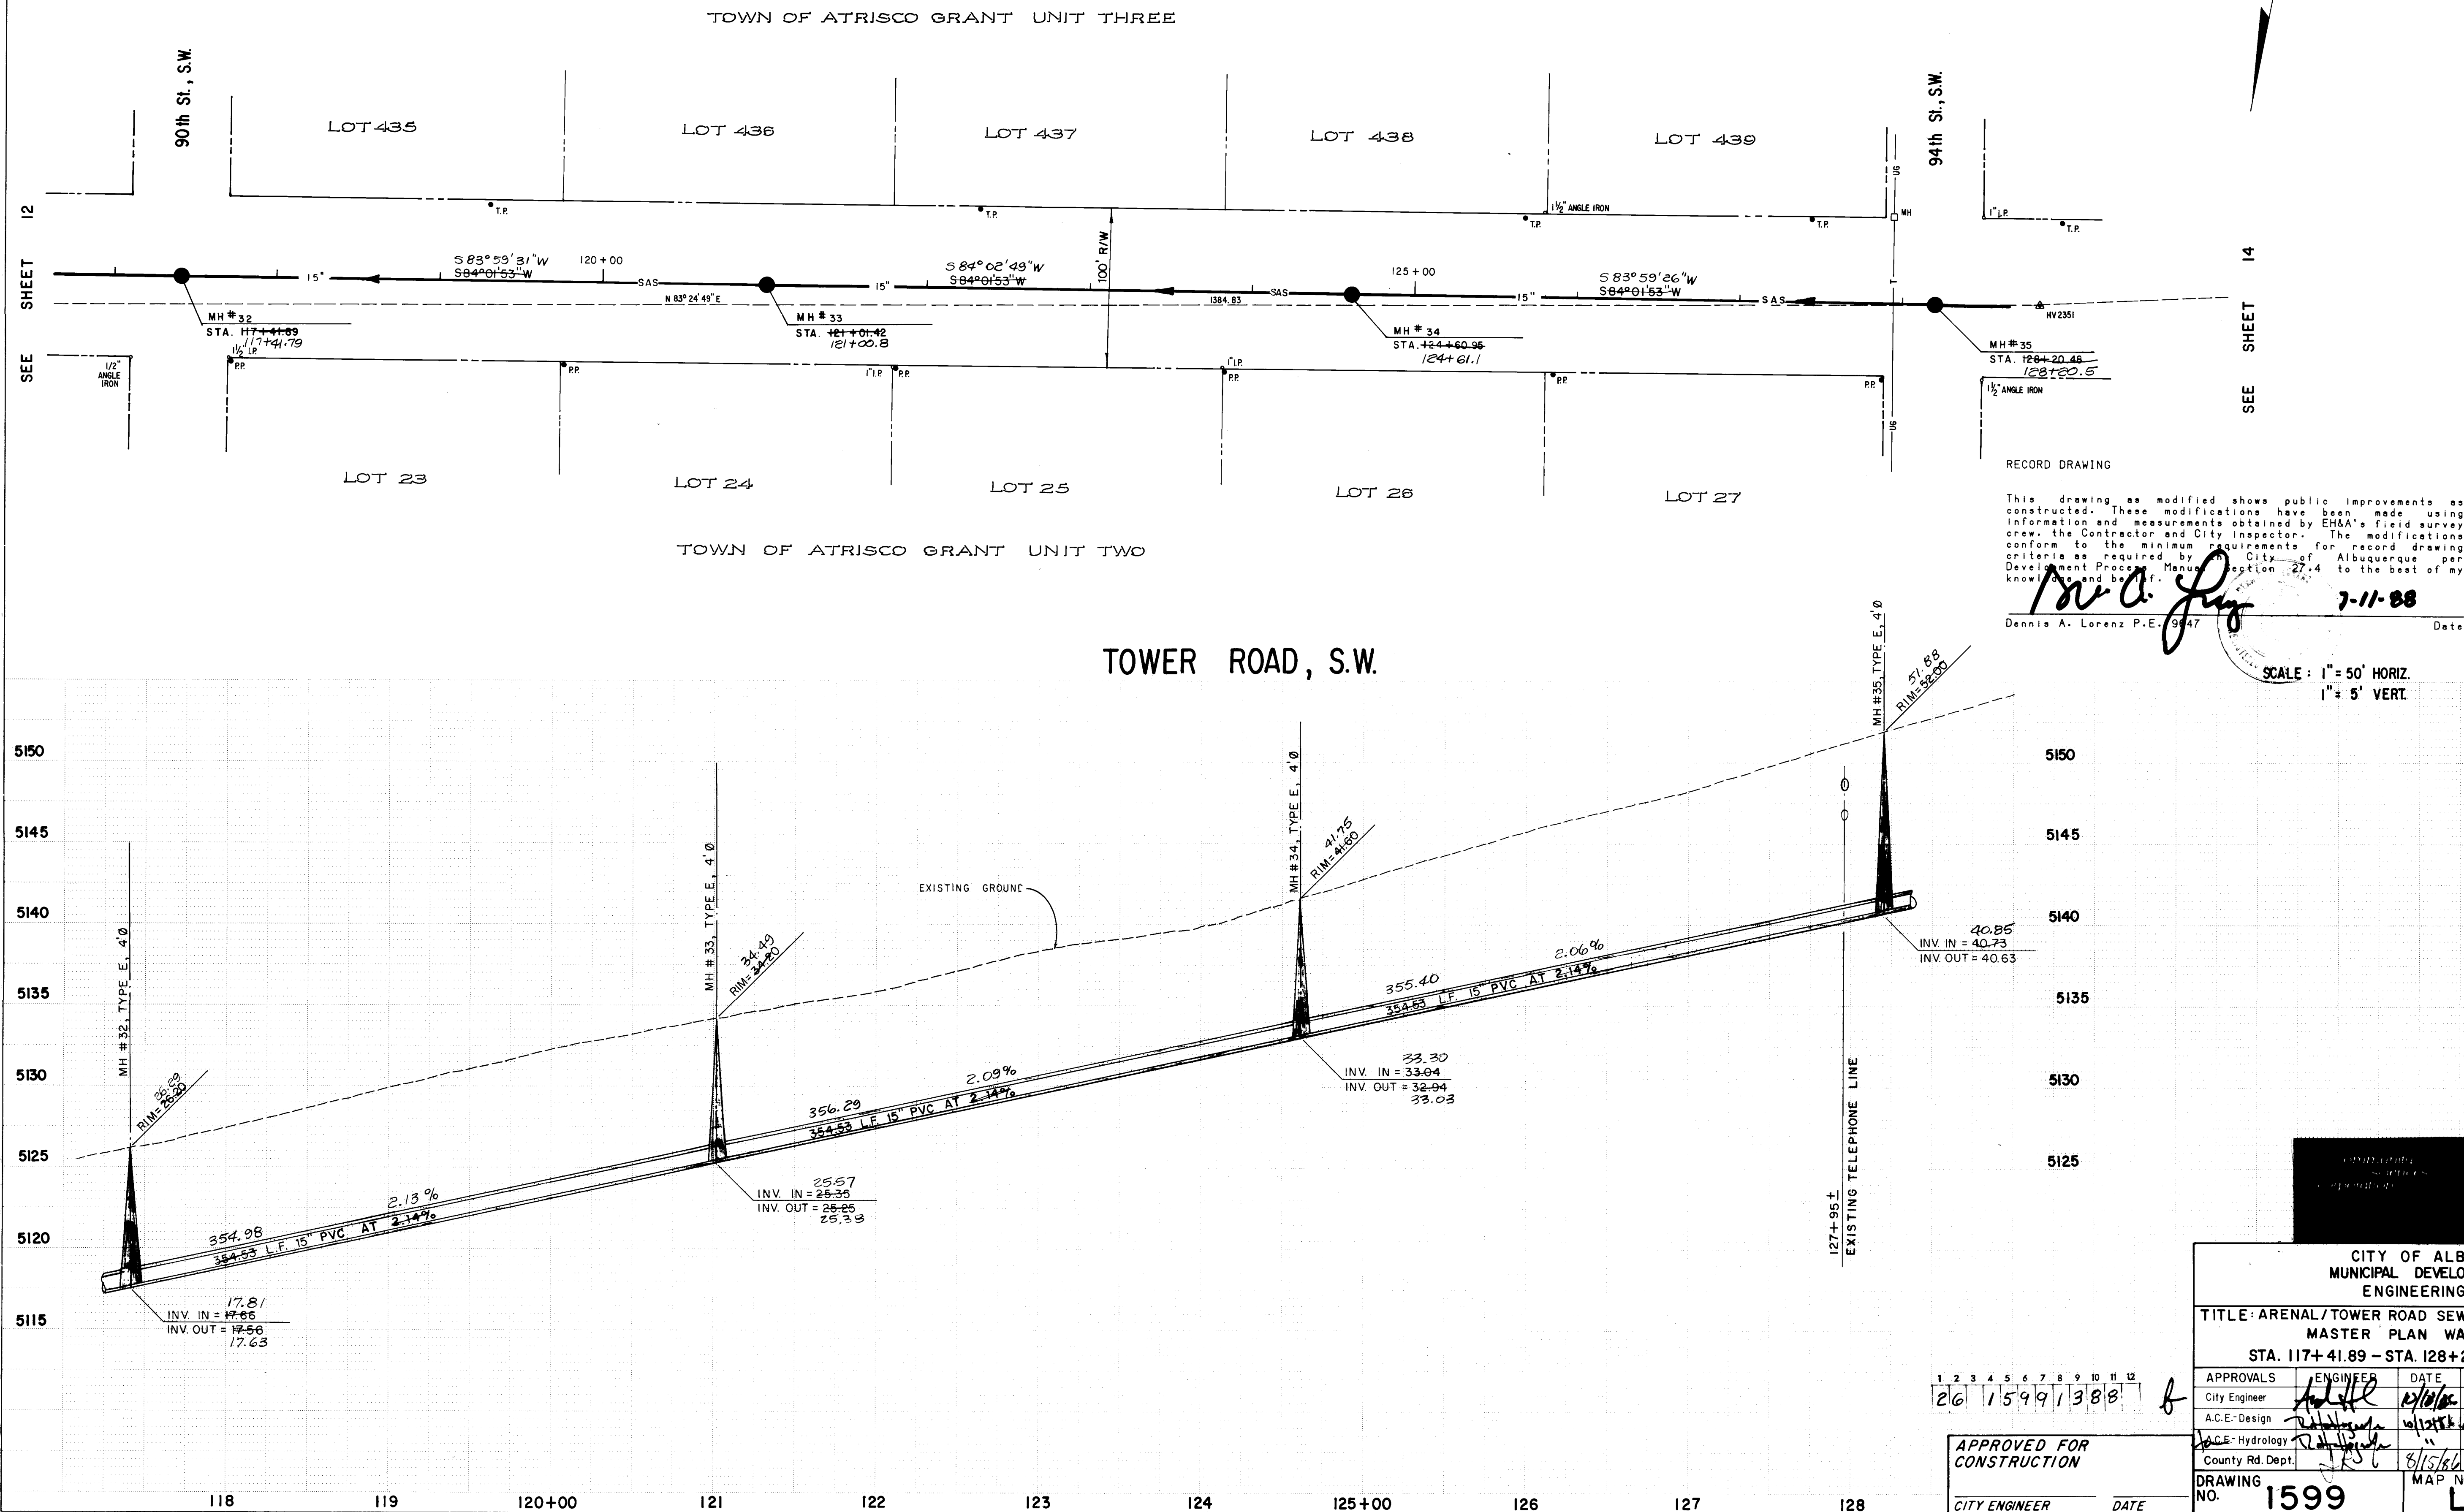[illegible]

PLAN	DATE
SURVEYED	BY
PLOTTED	DATE
NOTED	DATE
NO.	DATE

PROFILE	DATE
SURVEYED	BY
PLOTTED	DATE
NOTED	DATE
NO.	DATE

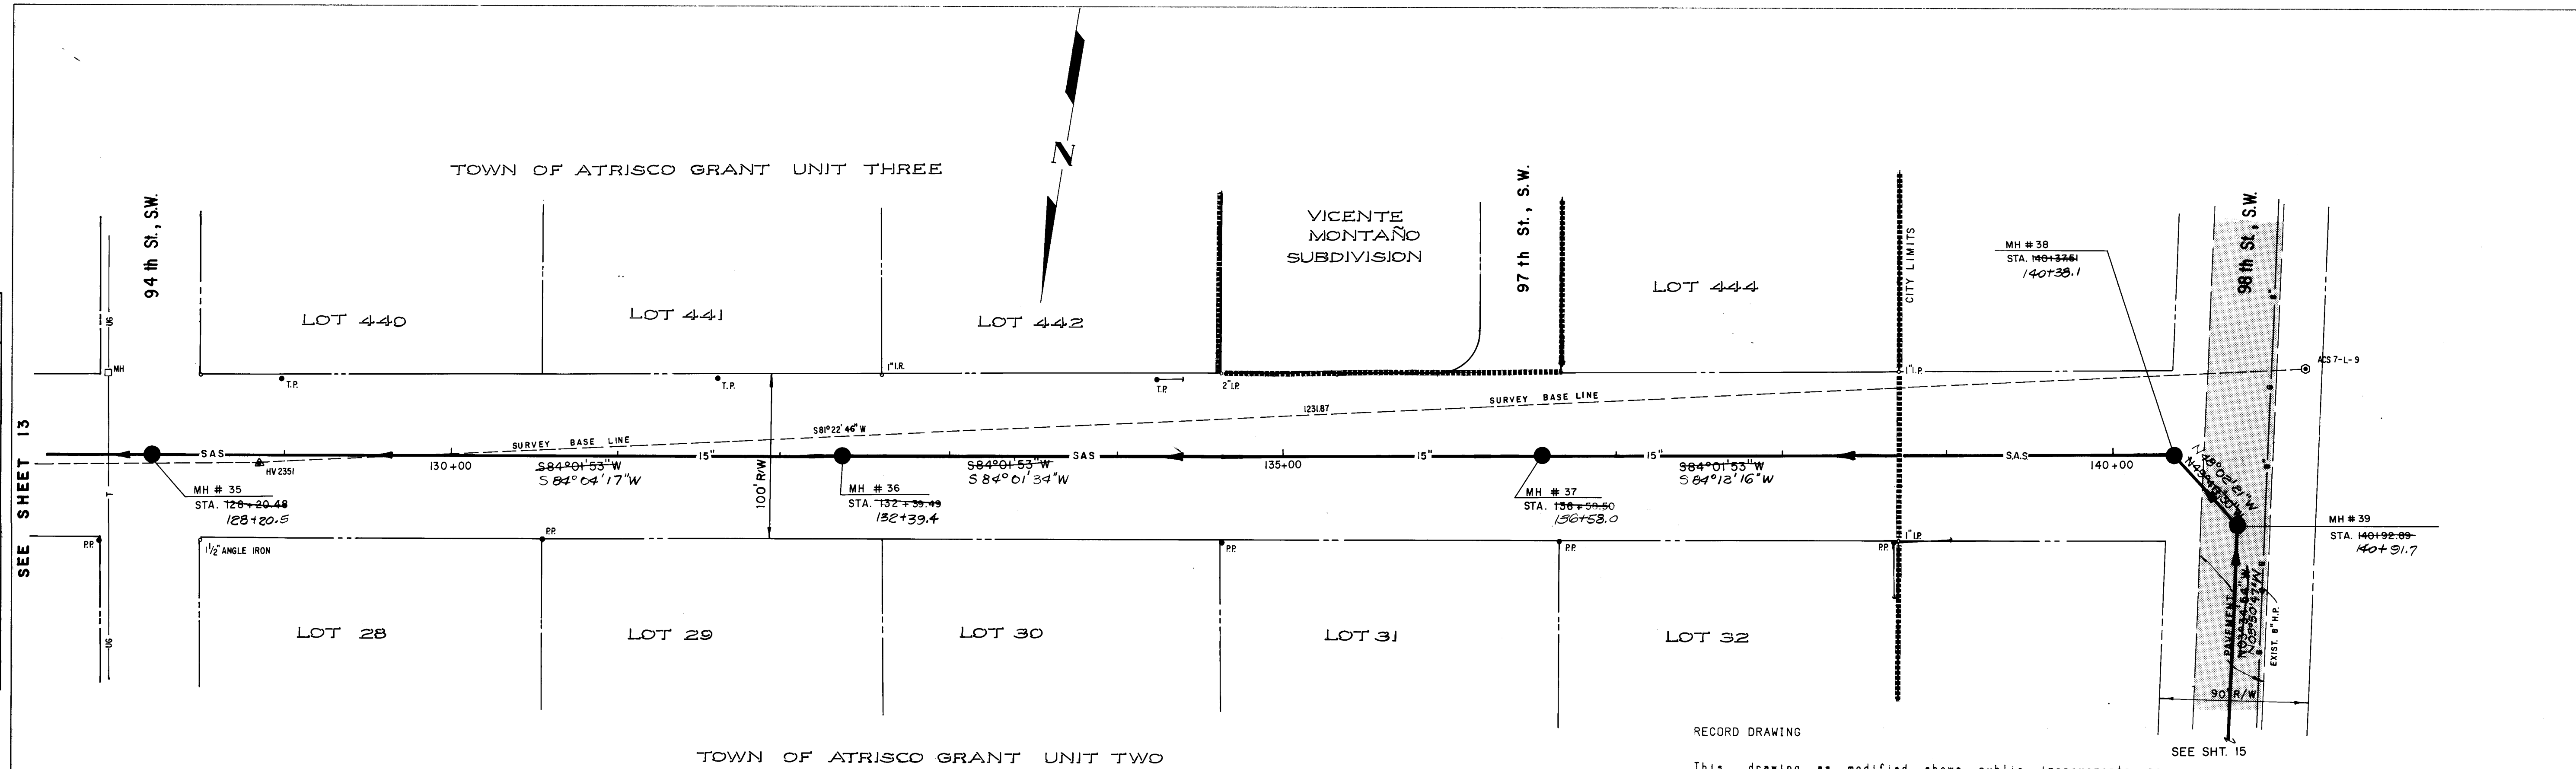


RECORD DRAWING

This drawing as modified shows public improvements as constructed. These modifications have been made using information and measurements obtained by EH&A's field survey crew, the Contractor and City Inspector. The modifications conform to the minimum requirements for record drawing criteria as required by City of Albuquerque per Development Process Manual, Section 10.1.1. The best of my knowledge and belief.

Dennis A. Lorenz
Dennis A. Lorenz P.E. 9647

7-11-88

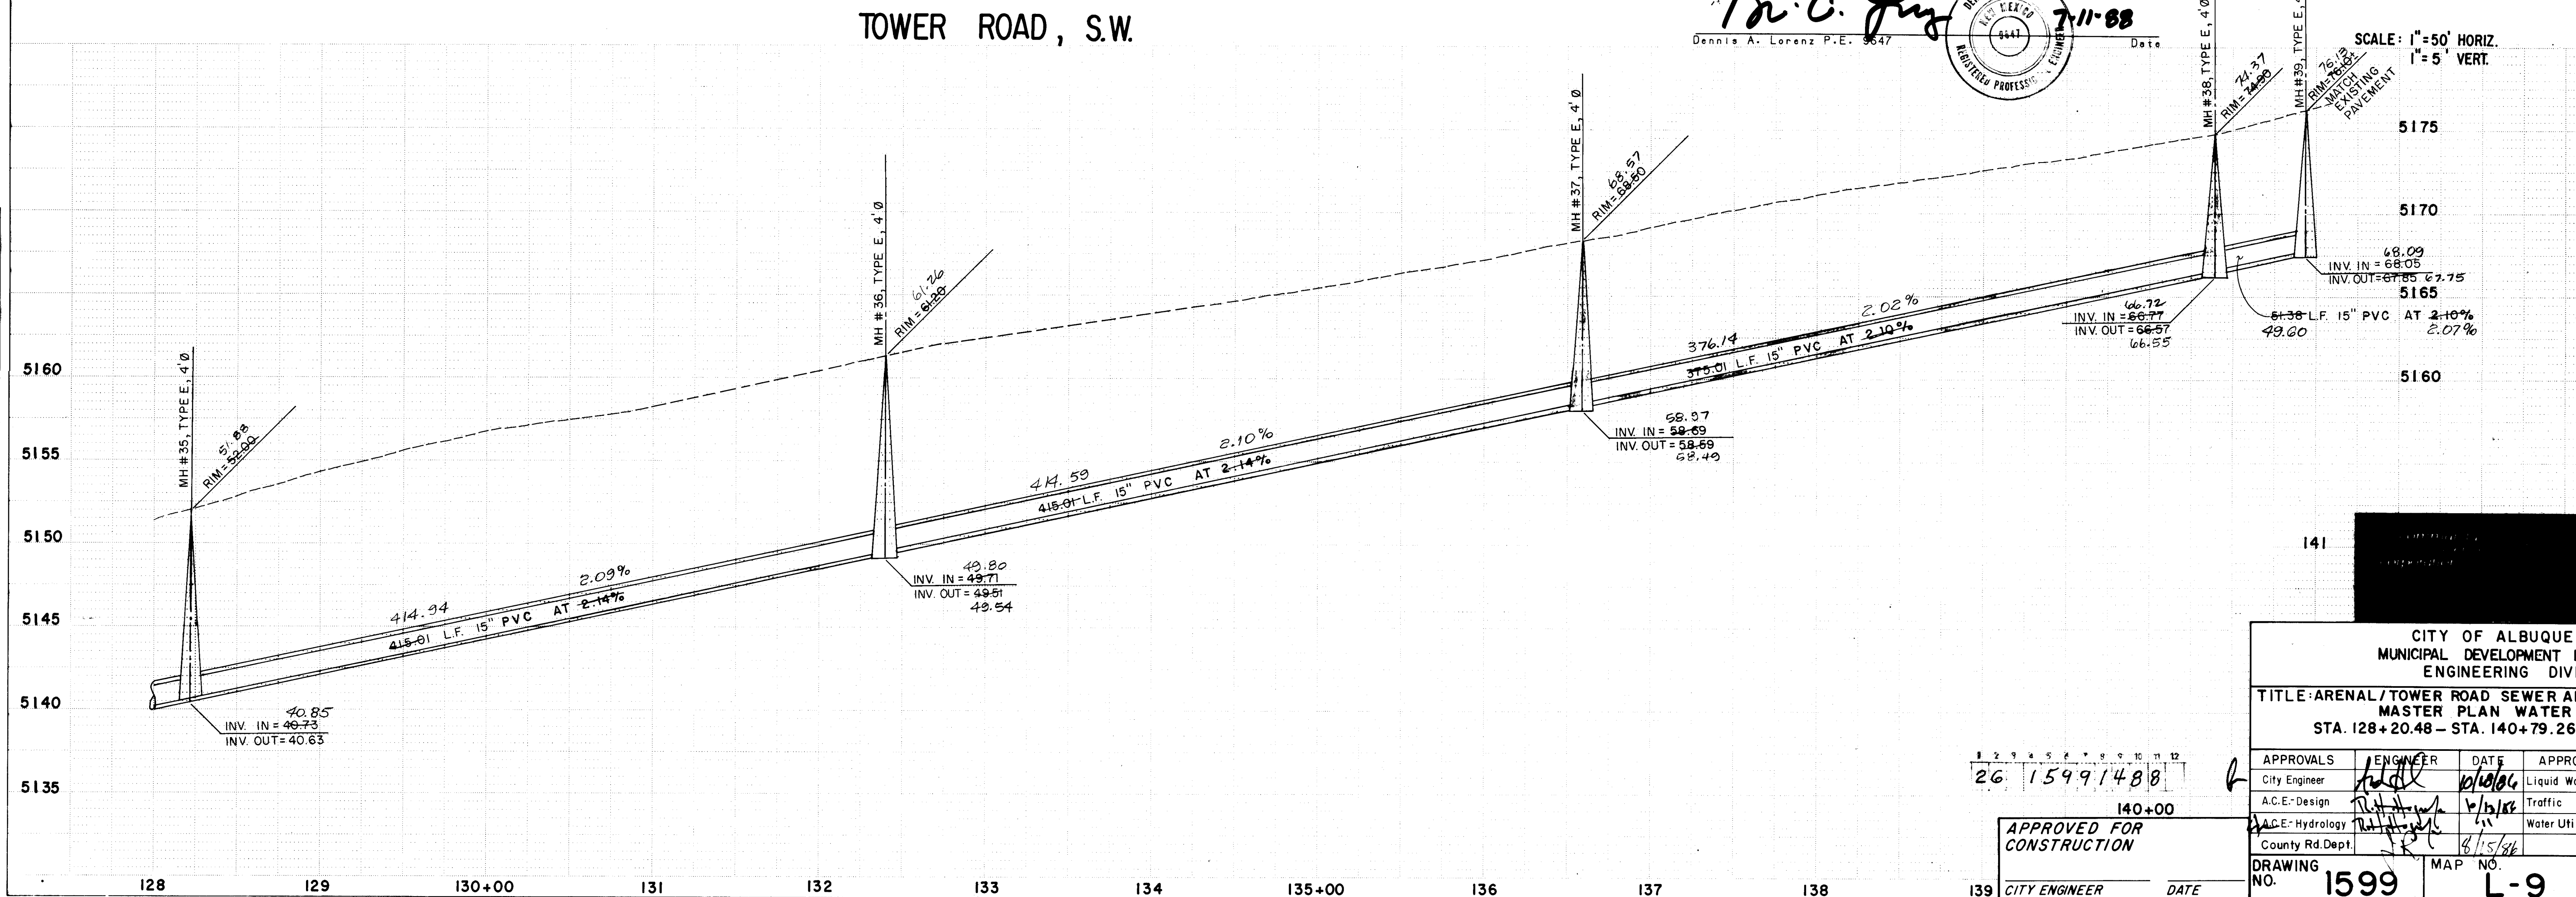

26 15991488


APPROVED FOR CONSTRUCTION

CITY ENGINEER DATE

CITY OF ALBUQUERQUE MUNICIPAL DEVELOPMENT DEPARTMENT ENGINEERING DIVISION					
TITLE: ARENAL/TOWER ROAD SEWER AND SUNRISE TERRACE MASTER PLAN WATER STA. 128+20.48 - STA. 140+79.26 (MH #35 - MH #39)					
APPROVALS	ENGINEER	DATE	APPROVALS	ENGINEER	DATE
City Engineer	<i>[Signature]</i>	8/15/86	Liquid Waste	<i>[Signature]</i>	8/15/86
A.C.E.-Design	<i>[Signature]</i>	8/15/86	Traffic	<i>[Signature]</i>	8/15/86
A.C.E.-Hydrology	<i>[Signature]</i>	8/15/86	Water Utilities	<i>[Signature]</i>	8/15/86
County Rd. Dept.	<i>[Signature]</i>	8/15/86			
DRAWING NO.	1599	MAP NO.	L-9	SHEET	14 OF 21

ENGINEER'S SEAL		SURVEY INFORMATION		BENCH MARKS		AS BUILT INFORMATION	
NO.	DATE	NO.	BY	SEE SHEET	CONTRACTOR	WORK	DATE
				2	CCM	CONTRACTOR	DATE
						INSPECTOR	DATE
						ACCEPTANCE BY	DATE
						VERIFICATION BY	DATE
						DRAWINGS	DATE
						CHECKED BY	DATE
						RECORDED BY	DATE
						NO.	

Michael J. Lopez
6/25/86

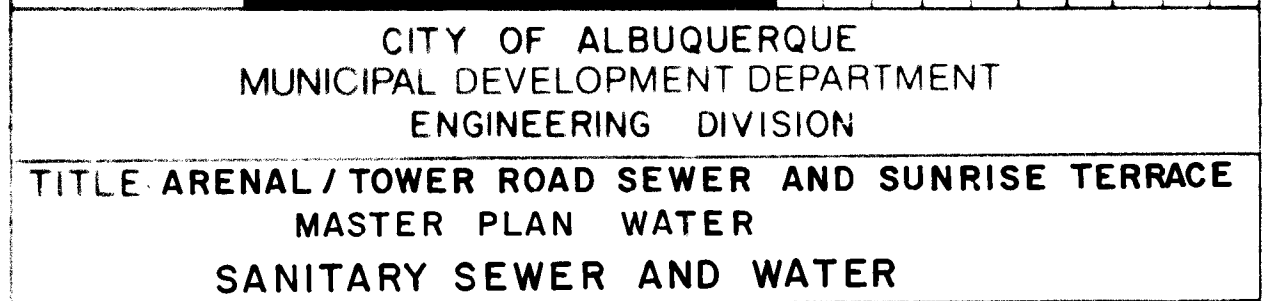

APPROVALS	ENGINEER	DATE	APPROVALS	ENGINEER	DATE
City Engineer	<i>[Signature]</i>	04/26/06	Liquid Waste	<i>[Signature]</i>	8/5/06
ACE Design	<i>[Signature]</i>	10/10/04	Traffc	<i>[Signature]</i>	11/1/06
ACE Hydrology	<i>[Signature]</i>	8/10/04	Water Utilities	<i>[Signature]</i>	8/5/06
County Rd. Dept.	<i>[Signature]</i>				

DRAWING NO

1599

MAP NO


L-8

SHEET

15

OF

21

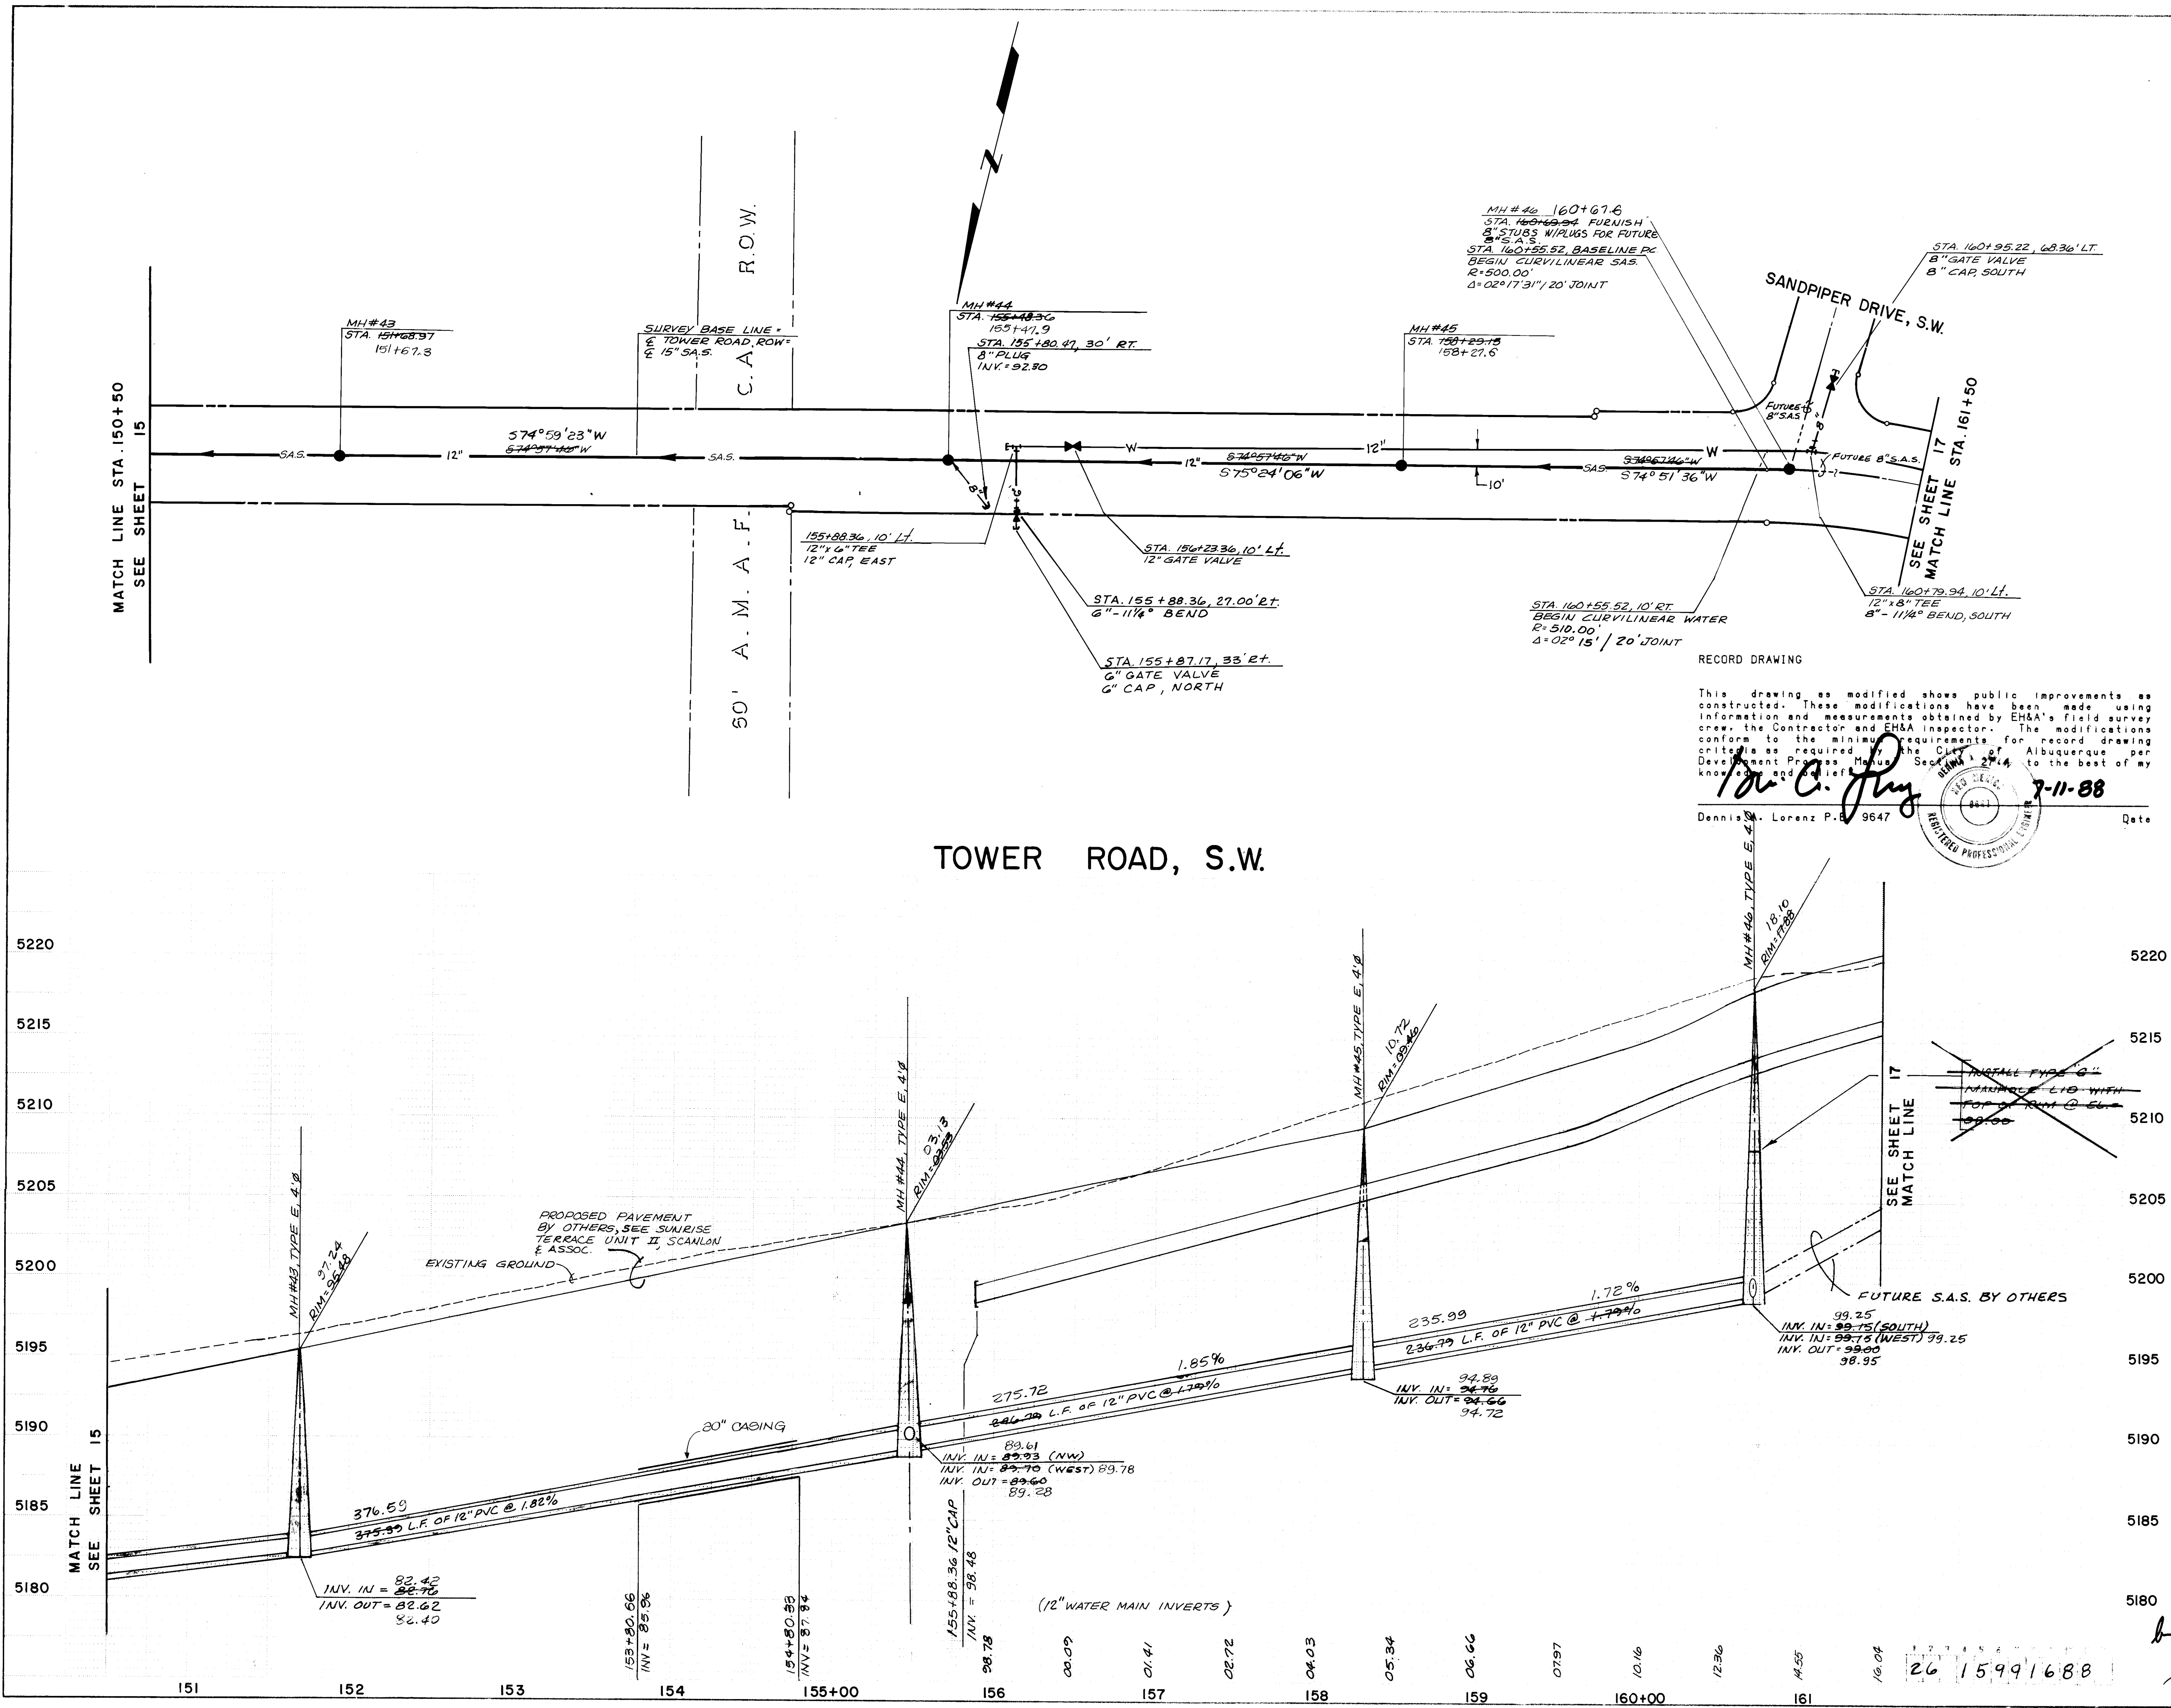

AS BUILT INFORMATION		BENCH MARKS		SURVEY INFORMATION		ENGINEER'S SEAL		M.J.V.		REVISIONS		DESIGN		APPROVALS		DATE	
CONTRACT	CCM	SEE SHEET 2	NO.	BY	DATE	NO.	BY	DATE	NO.	DATE	NO.	DATE	NO.	DATE	NO.	DATE	
WORK BY	EH#4																
INSPECTED BY	EH#4																
ACCURACY BY	EH#4																
VERIFICATION BY	EH#4																
DRAWN BY	EH#4																
CHECKED BY	EH#4																
RECORDED BY	EH#4																
NO.																	



SCALE: 1" = 50' HOR. 1" = 5' VER.

CITY OF ALBUQUERQUE
MUNICIPAL DEVELOPMENT DEPARTMENT
ENGINEERING DIVISION

TITLE ARENAL/TOWER ROAD SEWER AND SUNRISE TERRACE
MASTER PLAN WATER
SANITARY SEWER AND WATER

APPROVALS: ENGINEER DATE: 8/15/86
City Engineer: [Signature] Liquid Waste: [Signature]
A.C.E. Design: [Signature] Traffic: [Signature]
A.C.E. Hydrology: [Signature] Water Utilities: [Signature]
County Rd. Dept: [Signature]

DRAWING NO. 1599 MAP NO. L-8 SHEET 16 OF 21

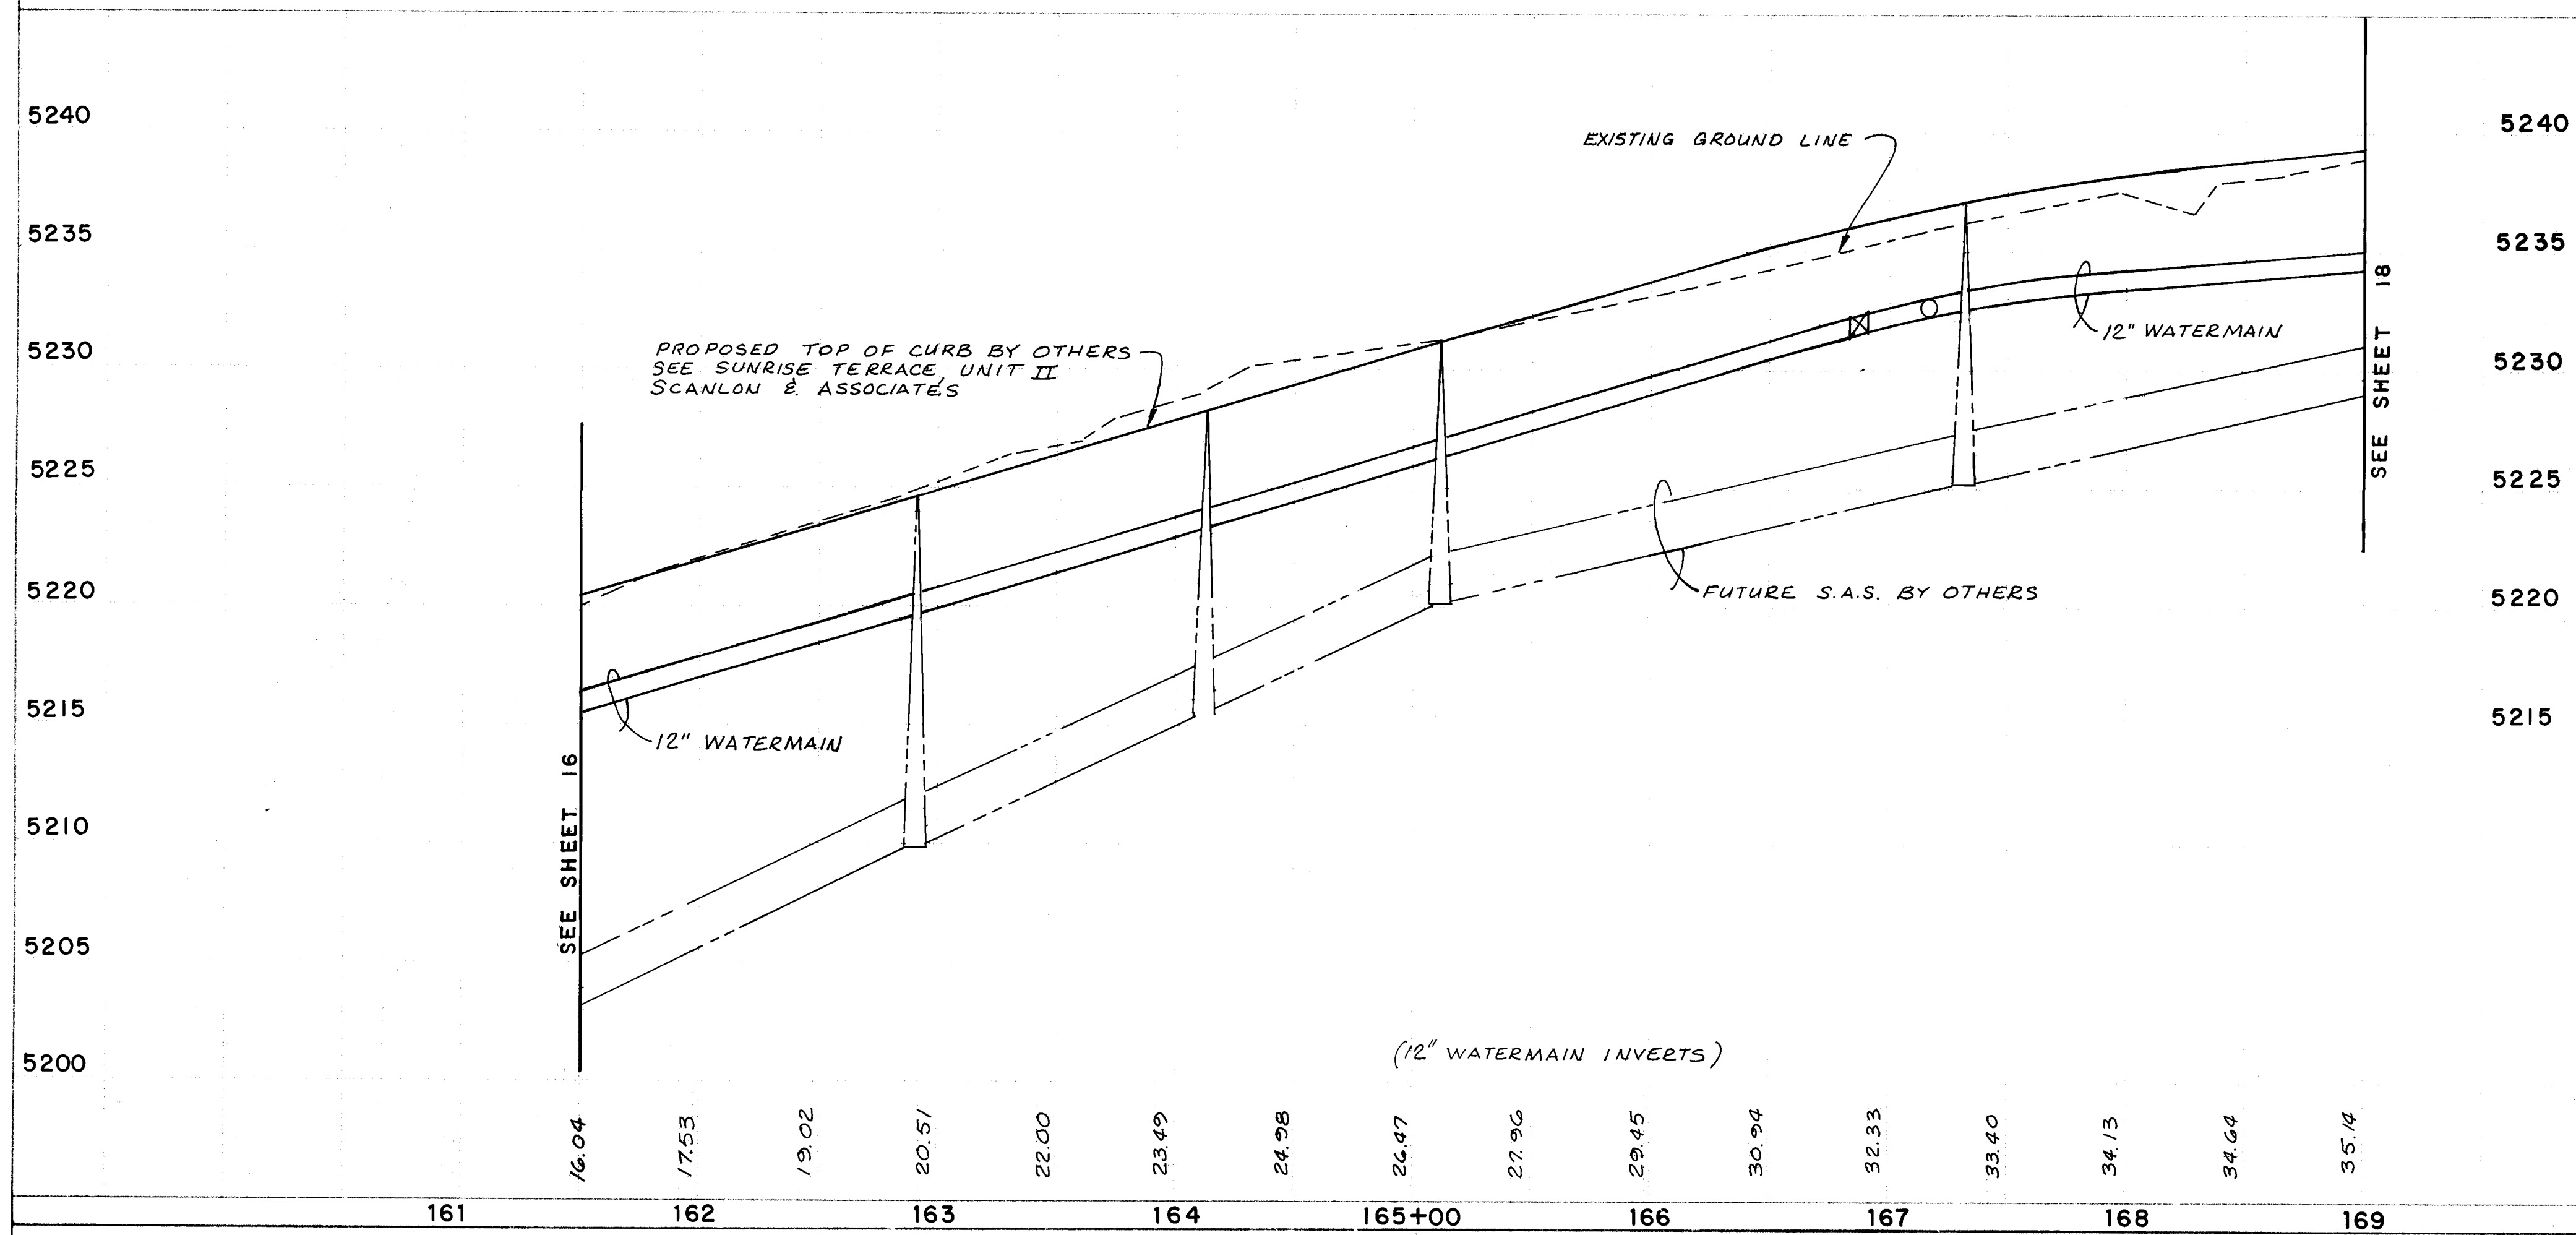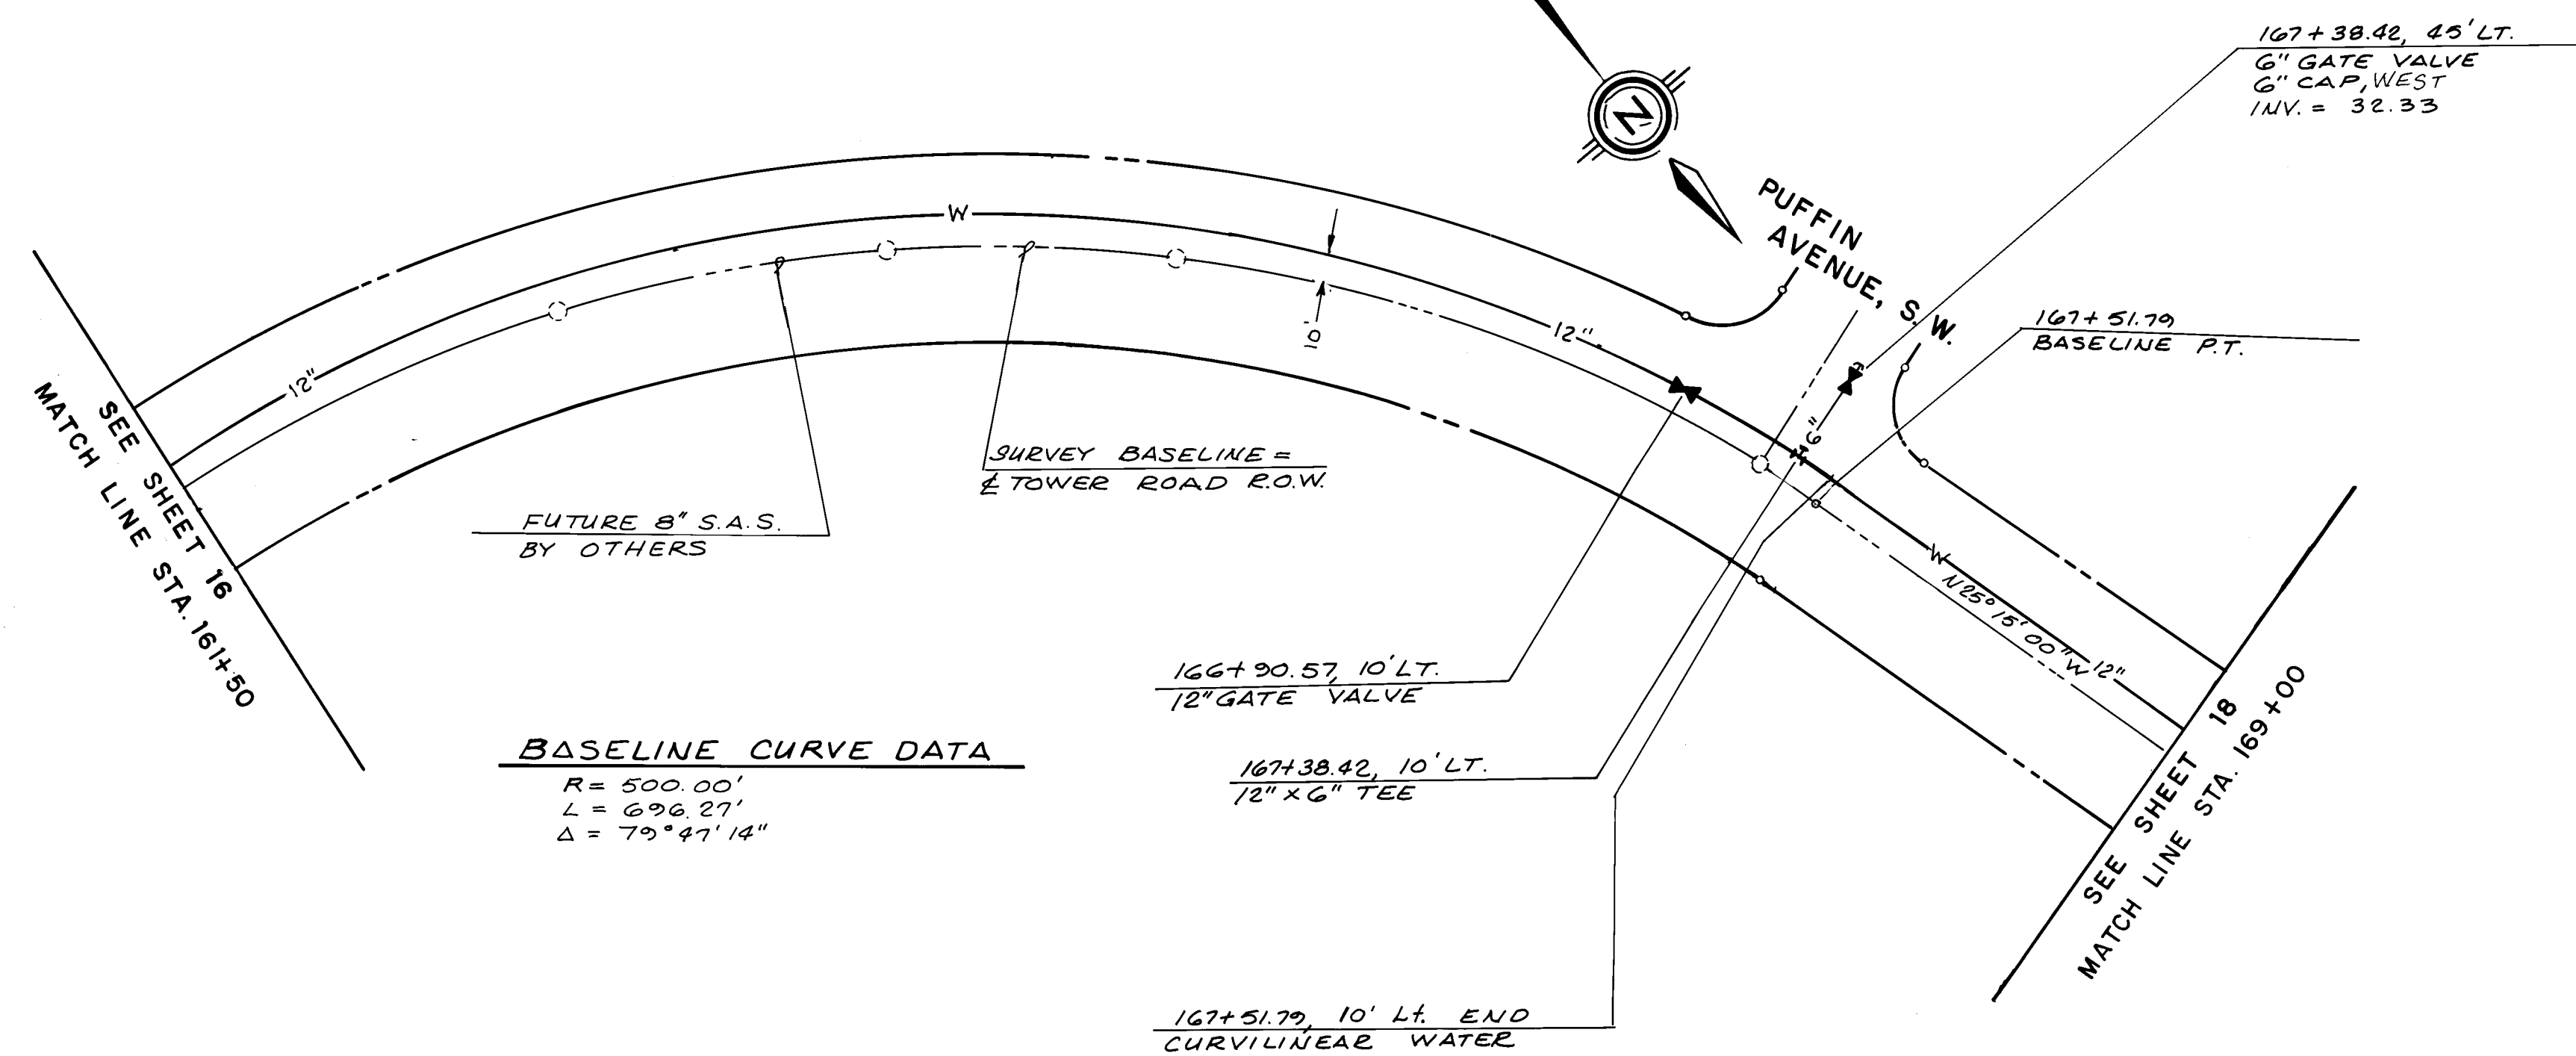

RECORD DRAWING

SCALE : 1" = 50' HOR. 1" = 5' VER.												RECORD DRAWING This drawing as modified shows public improvements as constructed. These modifications have been made by field information and measurements obtained by EHA's field survey crew, the Contractor and City Inspector. The modifications are shown on this drawing and shall be used as the record drawing criteria as required by the City of Albuquerque Engineering Department Project Manual, Section 01-11-00, "The Best of my Knowledge and Belief." <i>Dennis A. Lorenz</i> Dennis A. Lorenz P.E. 9647 Date <u>7-11-88</u>						AS BUILT INFORMATION CITY PLAN INSPECTED BY DATE EHA# DATE EHA# DATE EHA# DATE MICRO-FILM INFORMATION DATE					
						SURVEY INFORMATION FIELD NOTES NO. BY DATE						BENCH MARKS SEE SHEET 2											
						ENGINEER'S SEAL <i>Michael J. Post</i> Michael J. Post C/25/86																	
						MAY						BY											
						12" WATERMAIN LOCATION						REMARKS											
						Δ 7/86						NO. DATE											
						DESIGN						REVISIONS											
						DESIGNED BY M.J.Y.						DATE G-86											
						DRAWN BY W.J.W.						DATE G-86											
						CHECKED BY K.M.W.						DATE G-86											

CITY OF ALBUQUERQUE
MUNICIPAL DEVELOPMENT DEPARTMENT
ENGINEERING DIVISION

TITLE ARENAL/TOWER ROAD SEWER AND SUNRISE TERRACE
MASTER PLAN WATER
12" WATERMAIN

APPROVALS	ENGINEER	DATE	APPROVALS	ENGINEER	DATE
City Engineer	<i>[Signature]</i>	10/8/86	Liquid Waste	<i>[Signature]</i>	8/15/86
A.C.E. Design	<i>[Signature]</i>	10/17/86	Traffic	<i>[Signature]</i>	7/1/86
A.C.E. Hyarology	<i>[Signature]</i>	" "	Water Utilities	<i>[Signature]</i>	8/15/86
County Rd. Dept.	<i>[Signature]</i>	8/15/86			

DRAWING NO

1599

MAP NO


L-8

SHEET


17

OF

20

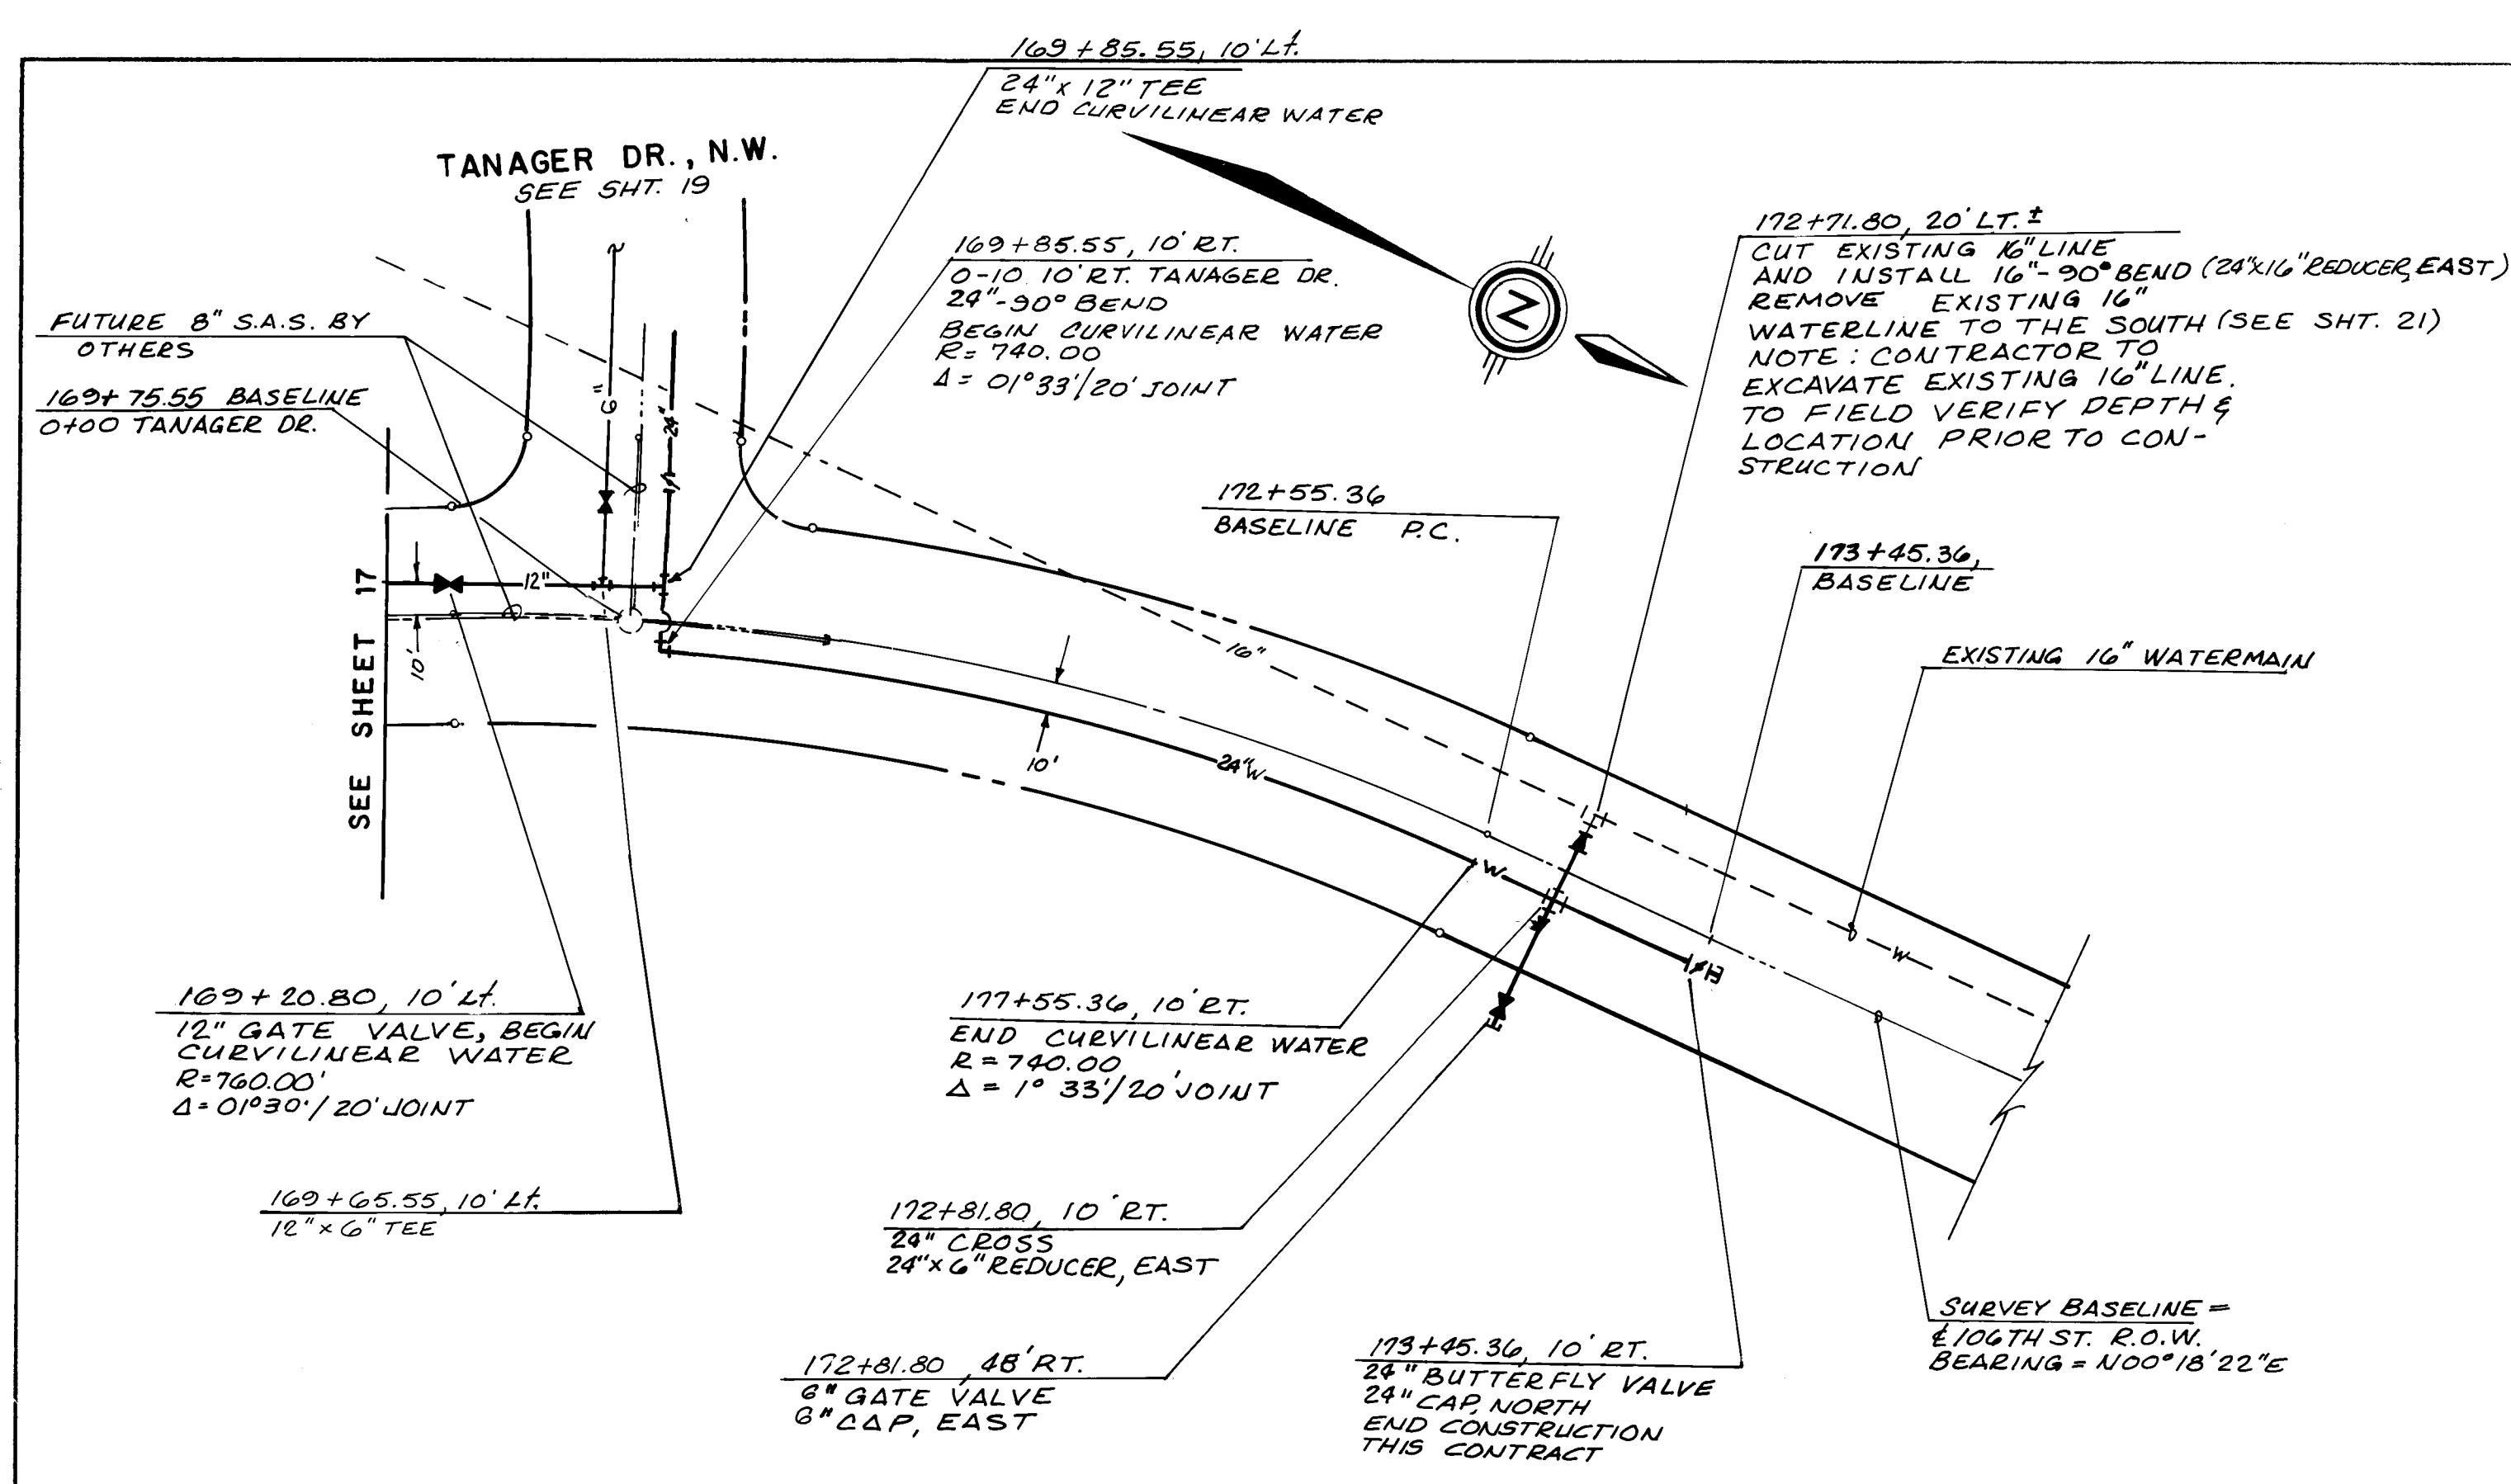


106 th. ST. S.W. WATERMAIN

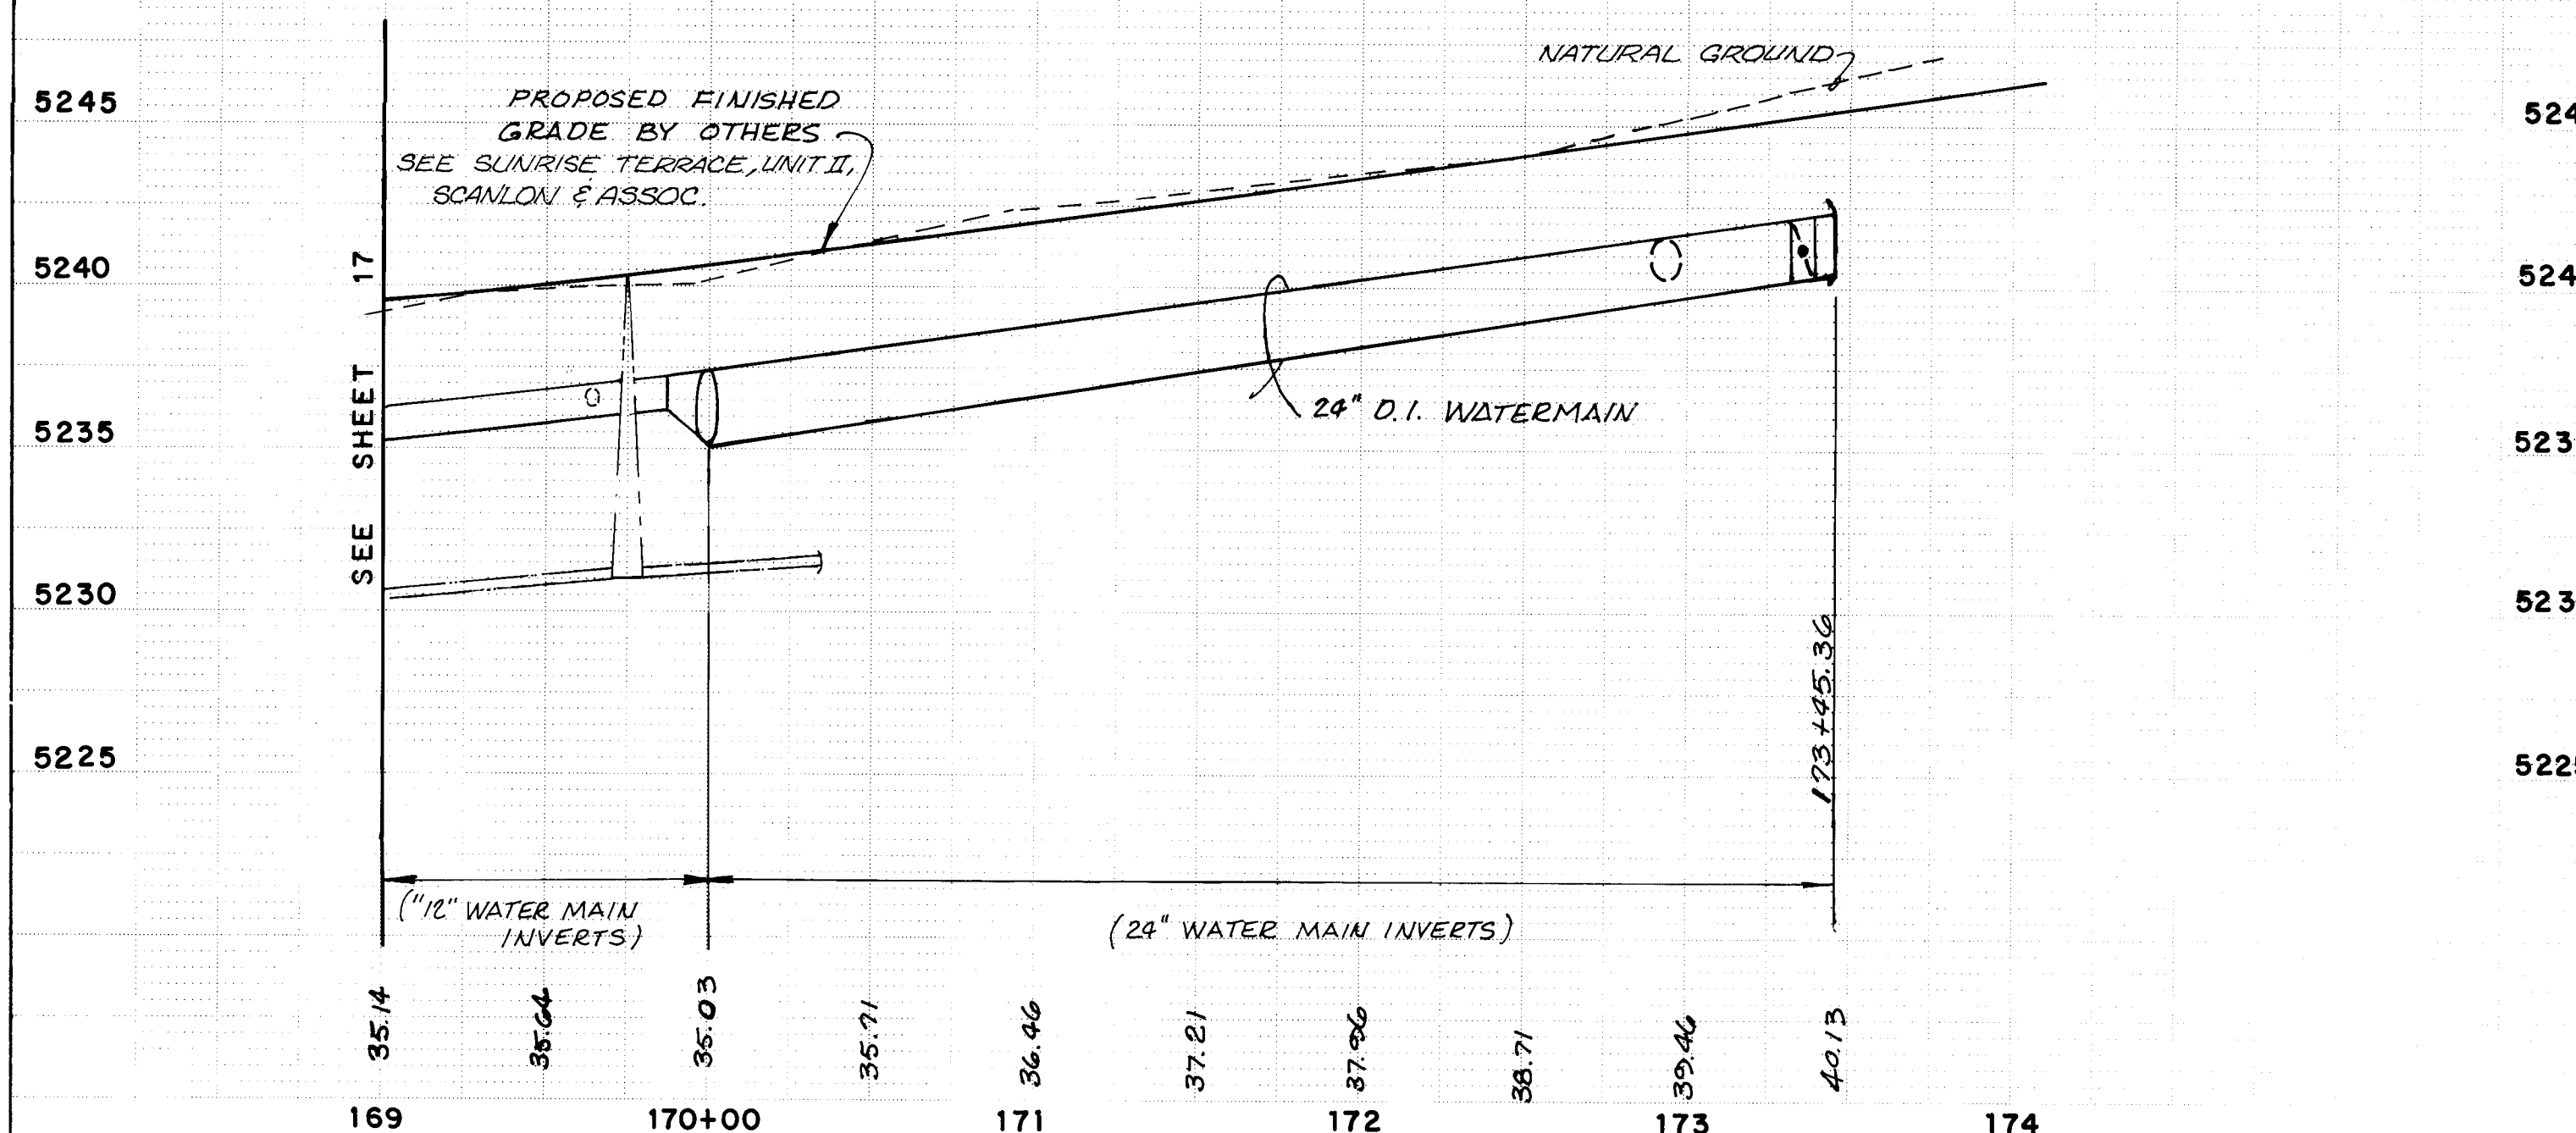

RECORD DRAWING
This drawing as modified shows public improvements as constructed. These modifications have been made using information and measurements obtained by EHA's field survey crew. The modifications are for the minimum requirements to conform to the minimum requirements for the project. The modifications are required by the City of Albuquerque, New Mexico, to the best of my knowledge and belief.
7-11-88
Dennis A. Lorenz P.E. 6847

SCALE:
1" = 50' HOR.
1" = 5' VER.


CITY OF ALBUQUERQUE MUNICIPAL DEVELOPMENT DEPARTMENT ENGINEERING DIVISION					
TITLE: ARENAL/TOWER ROAD SEWER AND SUNRISE TERRACE MASTER PLAN WATER 106th STREET, N.W. - 16" WATERMAIN					
APPROVALS	ENGINEER	DATE	APPROVALS	ENGINEER	DATE
Grty Engineer	<i>[Signature]</i>	8/18/86	Liquid Waste	<i>[Signature]</i>	8/15/86
ACE - Design	<i>[Signature]</i>	8/15/86	Traffic	<i>[Signature]</i>	8/15/86
ACE - Hydrology	<i>[Signature]</i>	8/15/86	Water	<i>[Signature]</i>	8/15/86
County Road Dept.	<i>[Signature]</i>	8/15/86			
DRAWING NO.	1599	MAP NO.	L-8	SHEET	18 OF 21

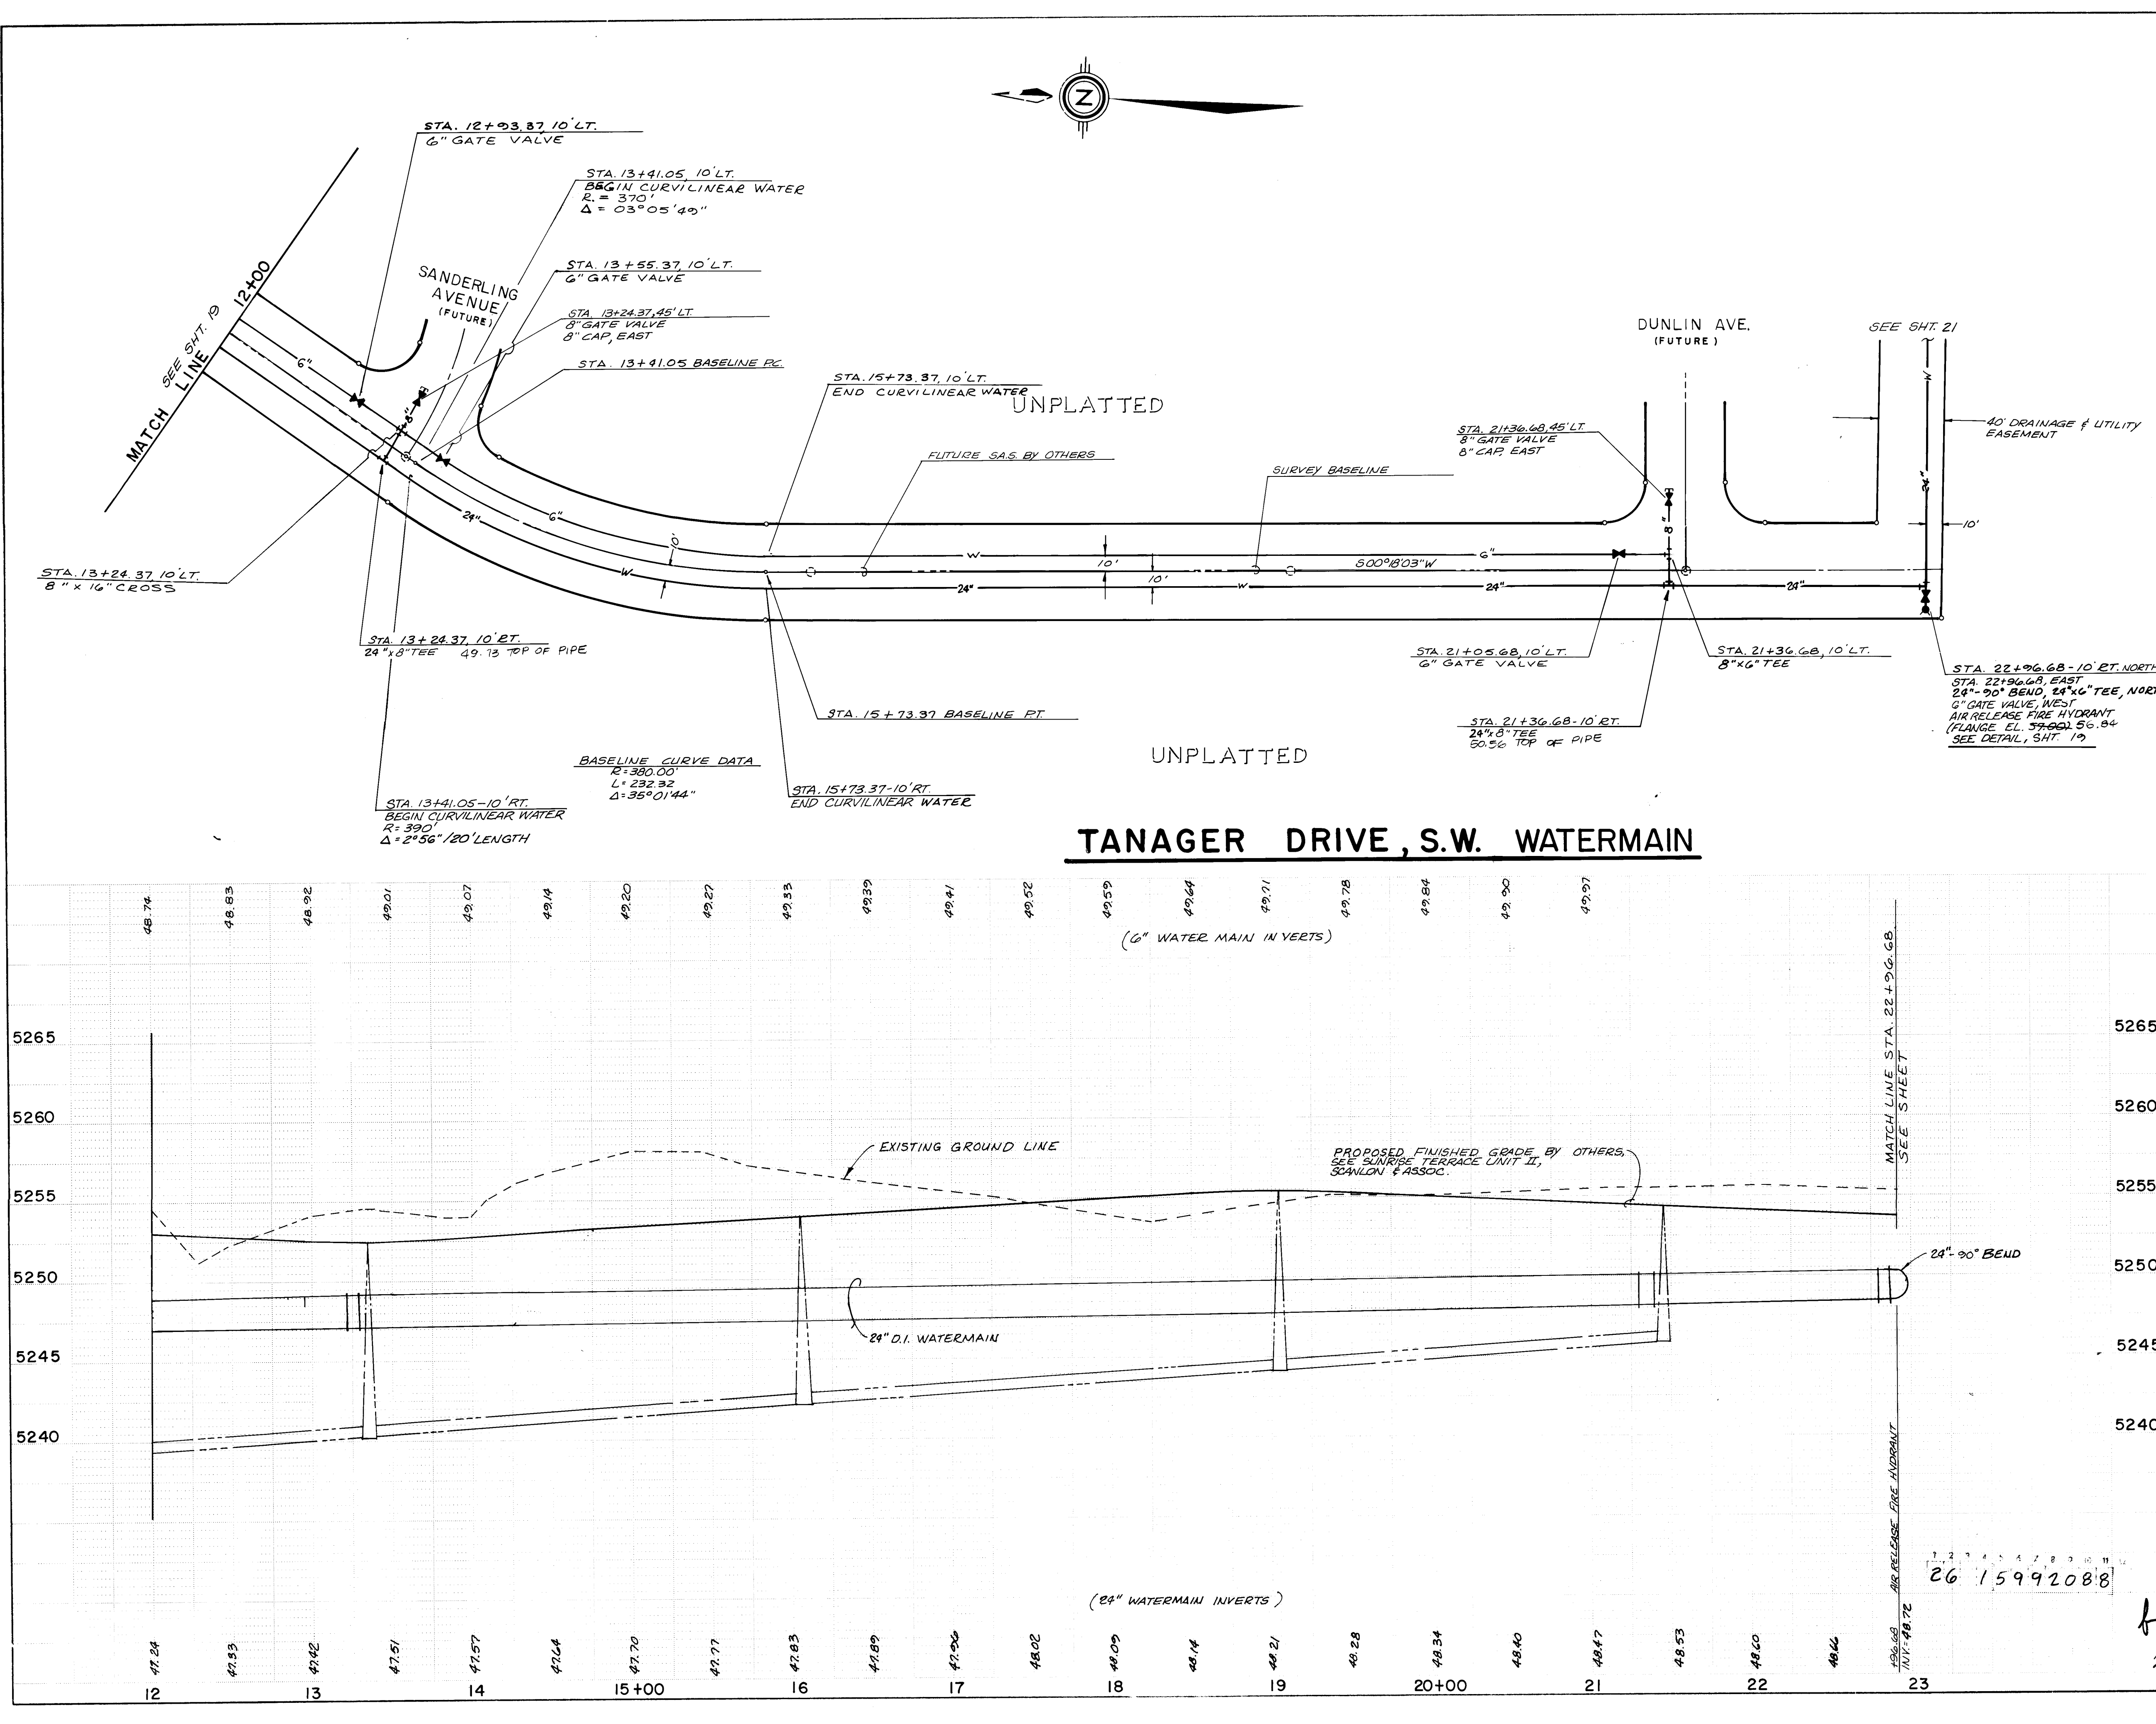

RECORD DRAWING
This drawing as modified shows public improvements as constructed. These modifications have been made using information and measurements obtained by EHA's field survey information and measurements. The modifications conform to the minimum standards for the City of Albuquerque as required by the Manual of Standard Specifications for Public Works Construction, 1985 Edition, to the best of my knowledge and belief.
Dennis A. Lorenz P.E. 947
Date 7-11-88

ENGINEER'S SEAL			SURVEY INFORMATION		BENCH MARKS		AS BUILT INFORMATION	
REVISIONS			NO.	BY	DATE	CONTRACTOR	DATE	
DESIGNED BY M.Y.								
DRAWN BY W.J.W. & C.S.S.								
CHECKED BY M.Y. & K.M.W.								
DATE 6-85								
DATE 6-85								
DATE 6-85								
CITY OF ALBUQUERQUE MUNICIPAL DEVELOPMENT DEPARTMENT ENGINEERING DIVISION								
TITLE: ARENAL/TOWER ROAD SEWER AND SUNRISE TERRACE MASTER PLAN WATER								
TANAGER DRIVE, S.W. - 16" WATERMAIN								
APPROVALS	ENGINEER	DATE	APPROVALS	ENGINEER	DATE			
City Engineer	<i>[Signature]</i>	8/15/86	Liquid Waste	<i>[Signature]</i>	8/15/86			
A.C.E. - Design	<i>[Signature]</i>	8/15/86	Traffic	<i>[Signature]</i>	8/15/86			
A.C.E. - Hydrology	<i>[Signature]</i>	8/15/86	Water	<i>[Signature]</i>	8/15/86			
County Rd. Dept.	<i>[Signature]</i>	8/15/86						
DRAWING NO.	1599	MAP NO.	L-8	SHEET	20	OF 21		

TANAGER DRIVE, S.W.
SEE SHEET 20

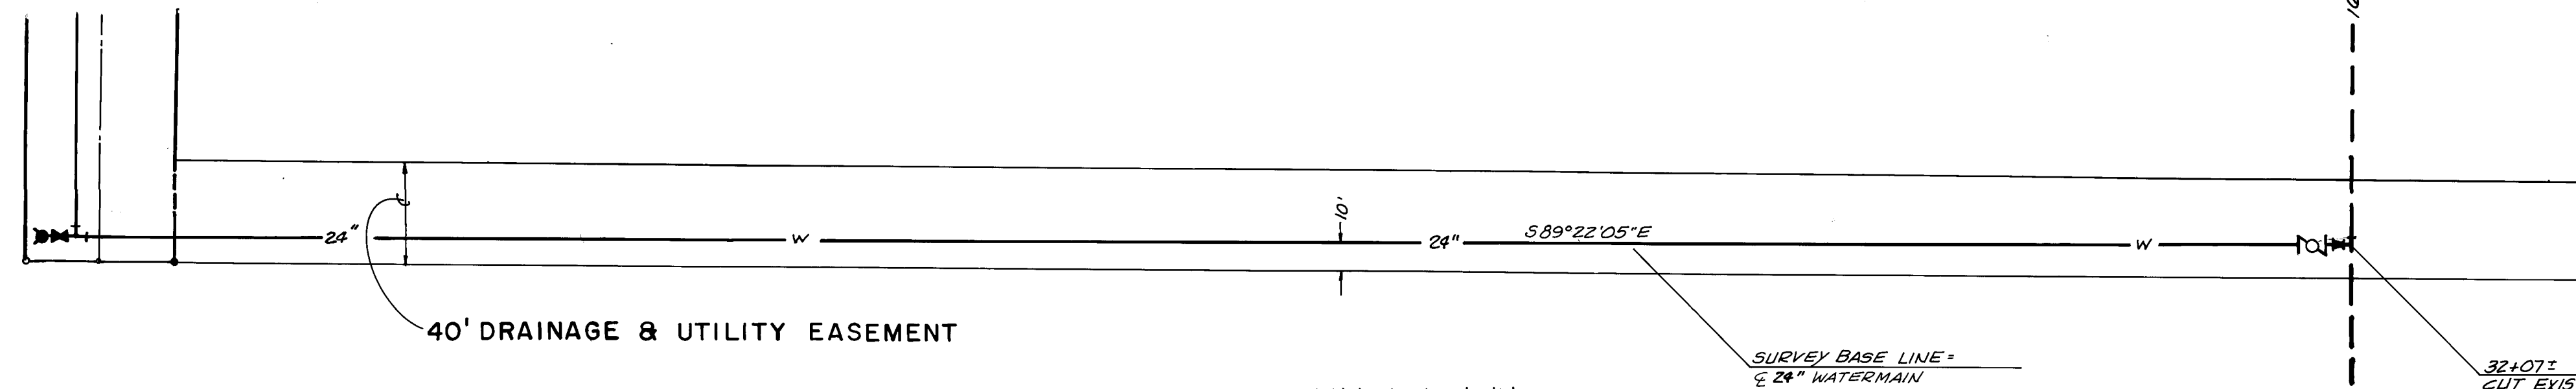


UNPLATTED

SURVEY BASE LINE
 & 24" WATERMAIN

32+01.7
CUT EXISTING 16" LINE AND
INSTALL 16"-90° BEND. (24" X 16" REDUCER, WEST)
REMOVE EXISTING 16"
WATERMAIN TO THE NORTH (SEE SHEET 18)
NOTE: CONTRACTOR TO EXCAVATE
EXISTING WATERMAIN TO
FIELD VERIFY LOCATION AND
DEPTH PRIOR TO CONSTRUCTION.
24" BUTTERFLY VALVE, WEST.

WATERLINE CONNECTION

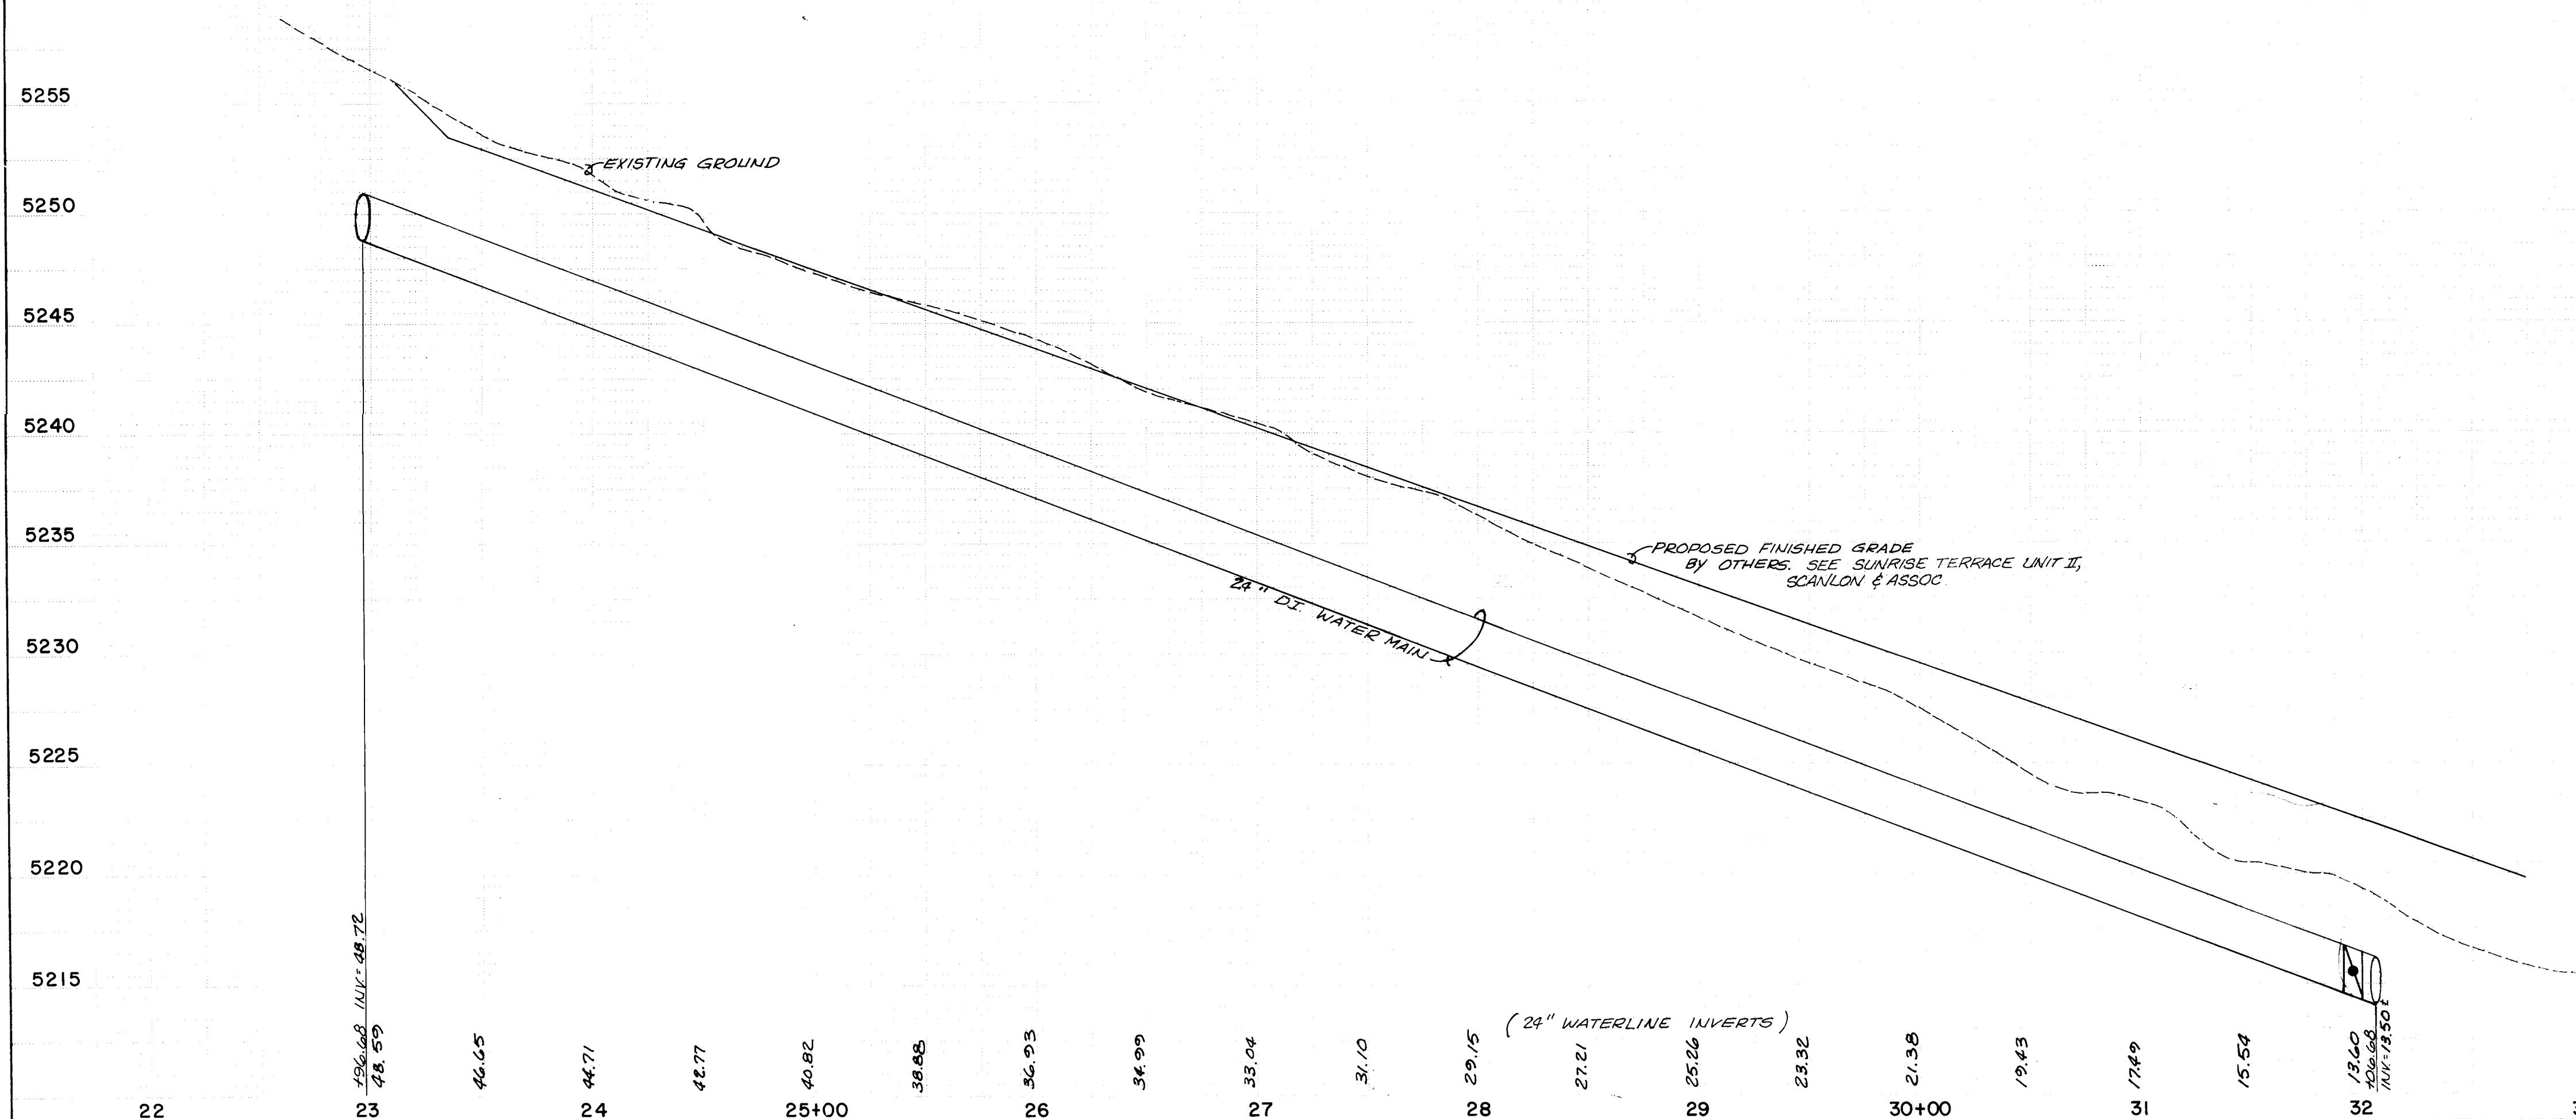

SCALE:
1" = 50' HOR
1" = 5' VER

CITY OF ALBUQUERQUE
MUNICIPAL DEVELOPMENT DEPARTMENT
ENGINEERING DIVISION

TITLE ARENAL/TOWER ROAD SEWER AND SUNRISE TERRACE
MASTER PLAN WATER
16" WATERLINE CONNECTION

APPROVAL'S	DATE	APPROVAL'S	ENGINEER	DATE
City Engineer	<i>[Signature]</i> 8/15/86	Liquid Waste	<i>[Signature]</i>	8/15/86
A.C.E. - Design	<i>[Signature]</i> 10/1/86	Traffic	<i>[Signature]</i> 10/1/86	10/1/86
A.C.E. Hydrology:	<i>[Signature]</i> 8/15/86	Water	<i>[Signature]</i>	8/15/86
County Rd. Dept				

DRAWING NO	1599	MAP NO.	L-8	SHEET	21	OF	21
------------	------	---------	-----	-------	----	----	----

RECORD DRAWING

This drawing as modified shows public improvements as constructed. These modifications have been based on information and measurements obtained by EHA's final survey conducted by the City Engineer and City Inspector. The modifications conform to the requirements of the California Building Code as required by the State of California.

Development Process Manual, Volume 07-4, Albuquerque per knowledge and belief.

JUL 1987

Dennis A. Lorenz

Dennis A. Lorenz P.E. 964

7-11-88

Date

SURVEY INFORMATION

BENCH MARKS
SEE SHEET 2

AS BUILT INFORMATION

NO	BY	DATE
----	----	------

© 2006 The Authors
Journal compilation © 2006 Blackwell Publishing Ltd

WORK
MADE BY
EHD/A DATE '87
SPECTORS

DATE	BY	REMARKS
1971	EH	

	0	1	2	100
0	0	1	4	9	16	25	36	49	64	81	100	121	144	169	196	225	256	289	324	361	400	441	484	529	576	625	676	729	784	841	900	961	1024	1089	1156	1225	1296	1369	1444	1521	1600	1681	1764	1849	1936	2025	2116	2209	2304	2401	2500	2601	2704	2809	2916	3025	3136	3249	3364	3481	3600	3721	3844	3969	4096	4225	4356	4489	4624	4761	4900	5041	5184	5329	5476	5625	5776	5929	6084	6241	6400	6561	6724	6889	7056	7225	7396	7569	7744	7921	8100	8281	8464	8649	8836	9025	9216	9409	9604	9801	10000

© 2006 The Authors
Journal compilation © 2006 Blackwell Publishing Ltd

AWINGS
RECTED BY EHA DATE '88

MICRO-FILM INFORMATION	
ORDERED BY	DATE

Journal of Management Education 36(7) 809-824
