




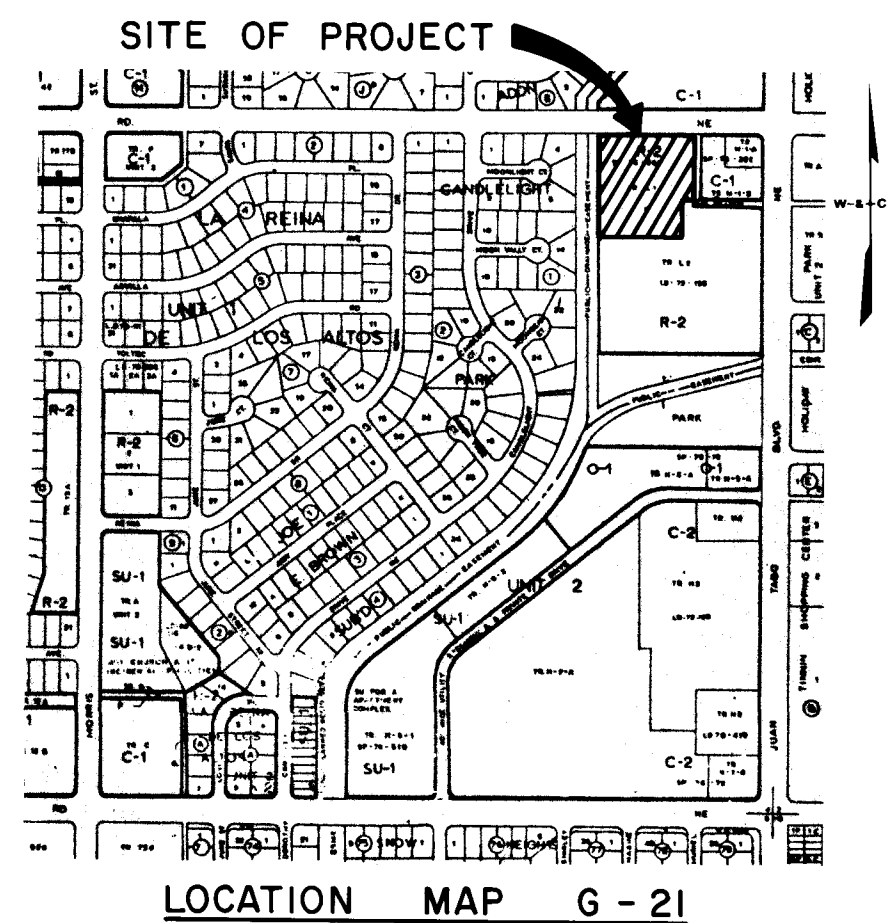

- 212 (R) 8" L.F. Asphalt Curb
- 80 (R) 75 S.Y. Asphalt Pavement
- 264 (C) 805 S.Y. Arterial Asphaltic Conc. Pavement
- 170 (C) 166 L.F. Asphalt Curb
- 18 (C) 16 L.F. Conc. Median Curb & Gutter


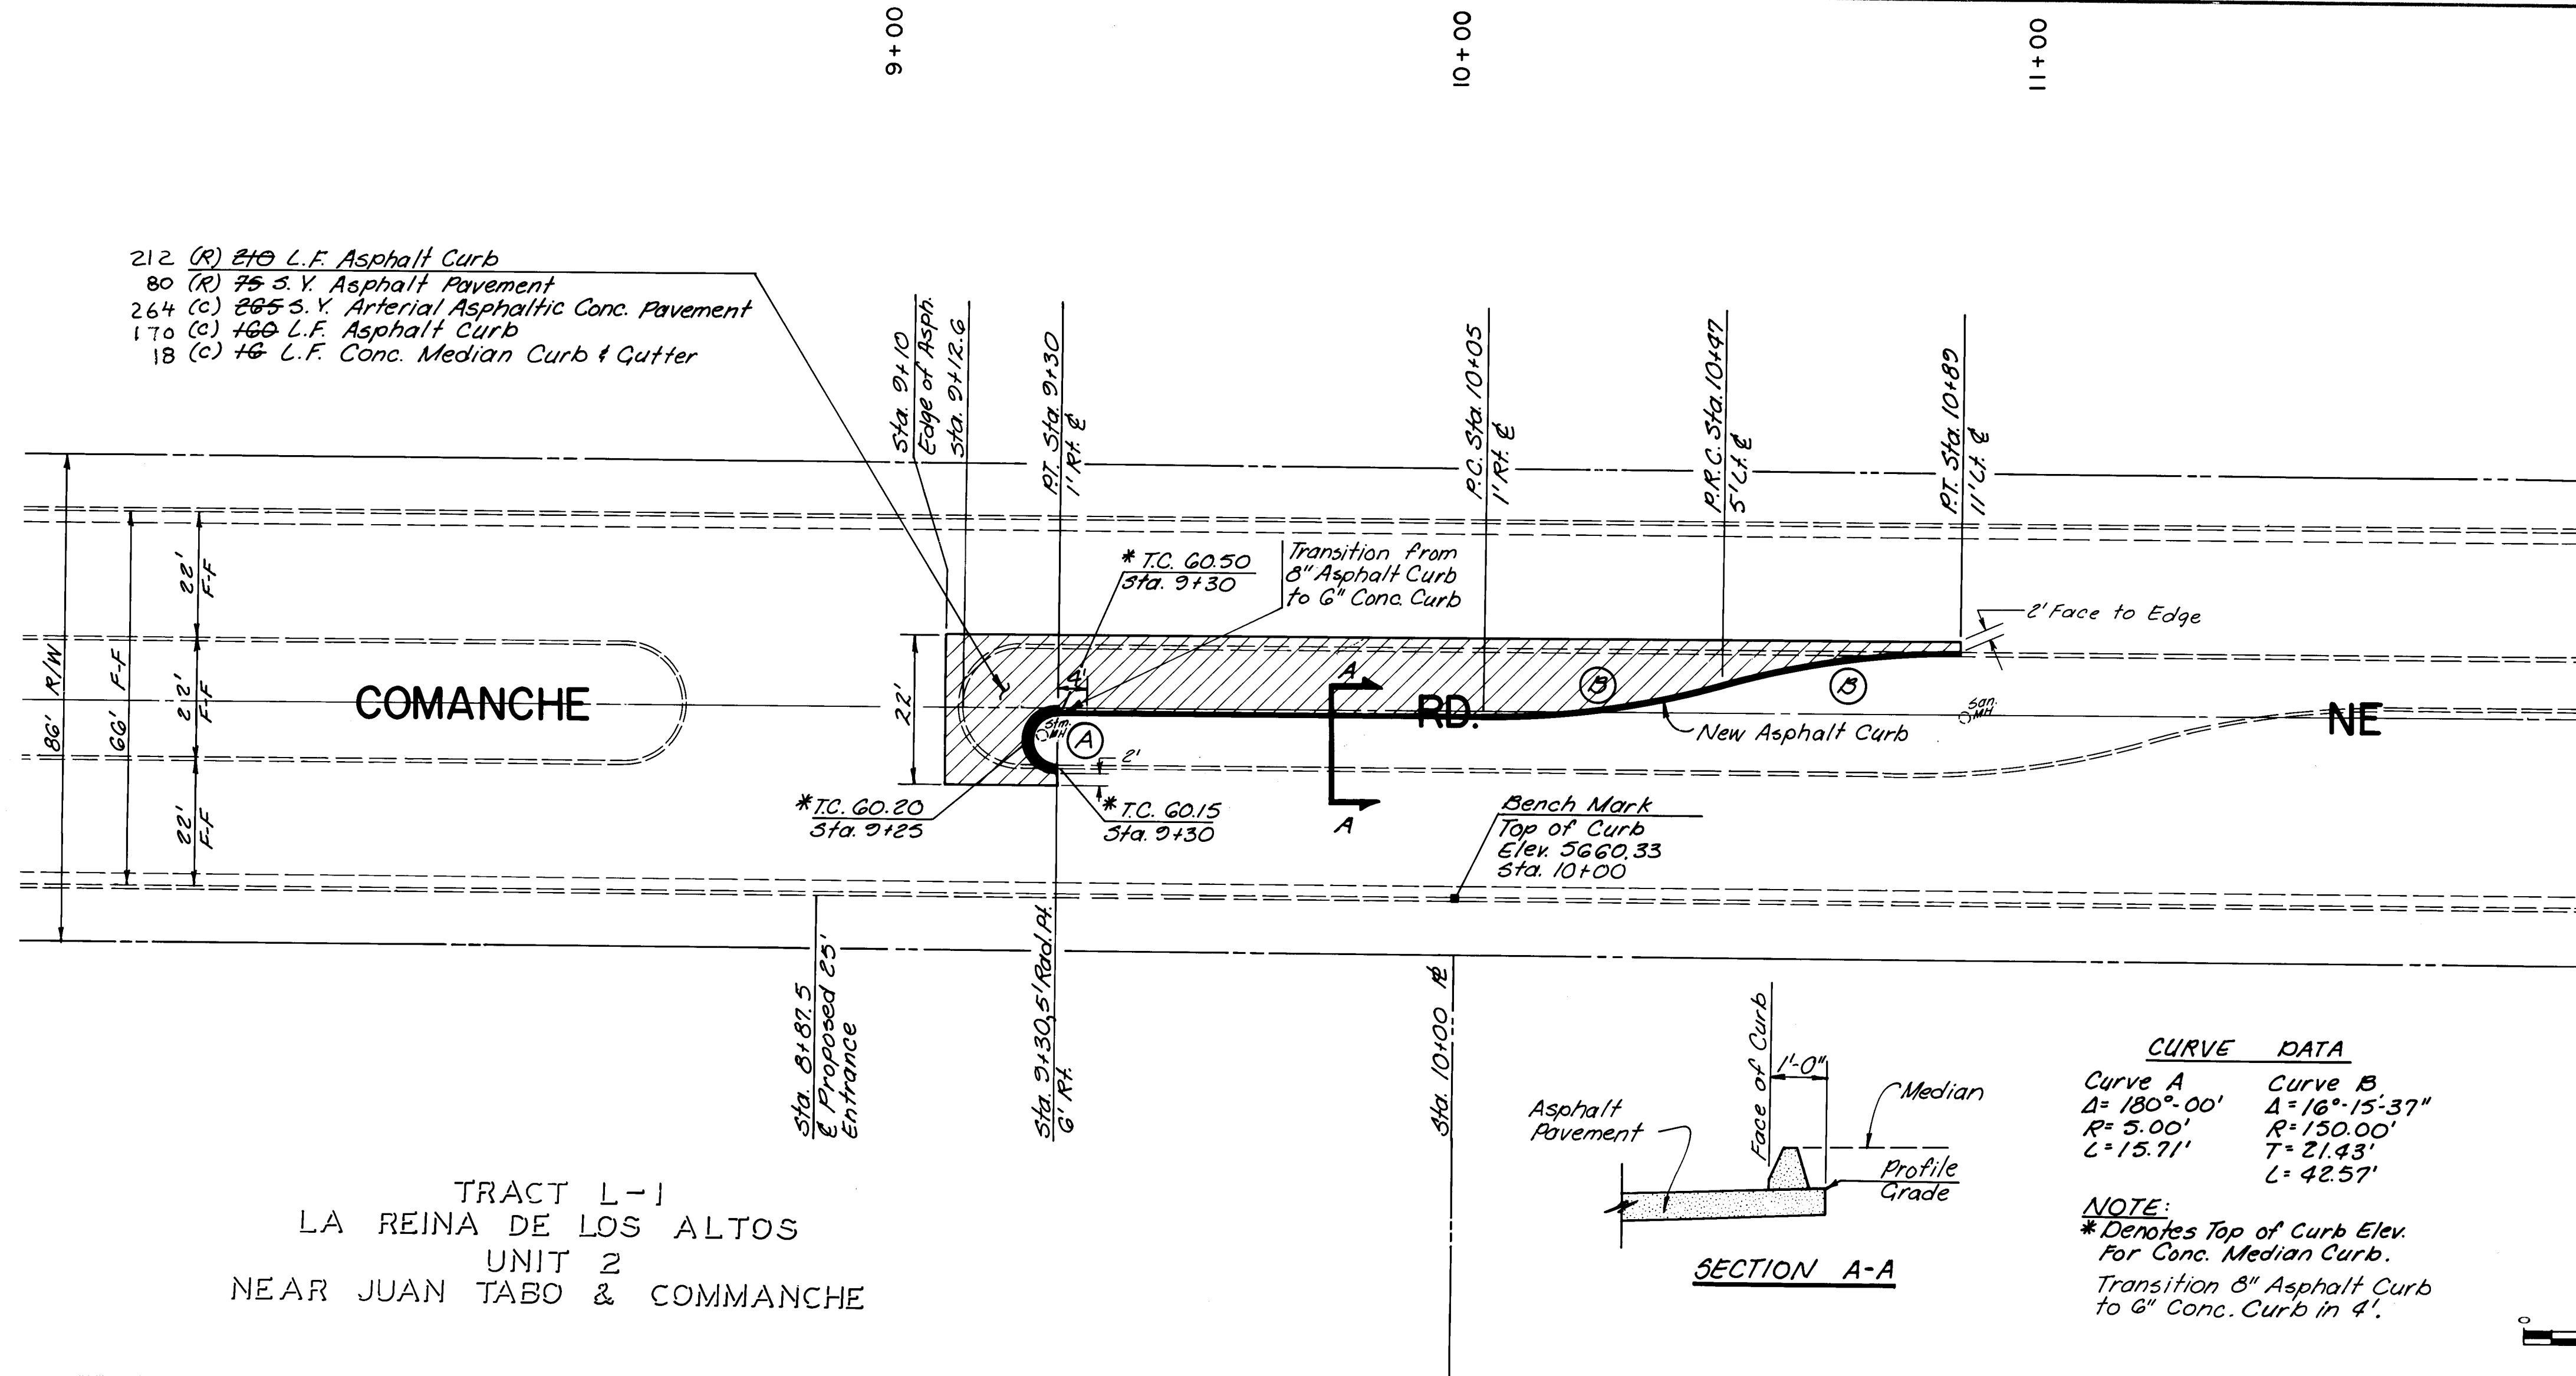


TRACT L-1
LA REINA DE LOS ALTOS
UNIT 2
NEAR JUAN TABO & COMMANCHE

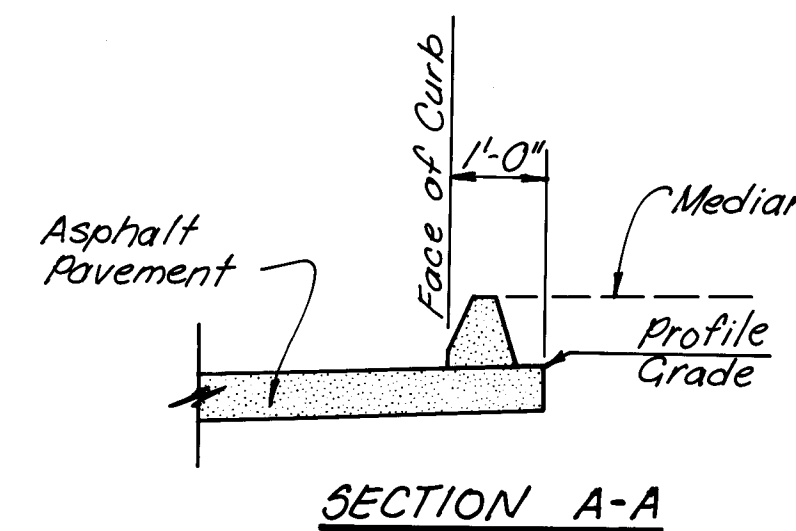

CURVE DATA	
Curve A	Curve B
$\Delta = 180^\circ 00'$	$\Delta = 16^\circ 15' 37''$
$R = 5.00'$	$R = 150.00'$
$L = 15.71'$	$T = 21.43'$
	$L = 42.57'$


NOTE:
* Denotes Top of Curb Elev.
for Conc. Median Curb.
Transition 8" Asphalt Curb
to 6" Conc. Curb in 4'.

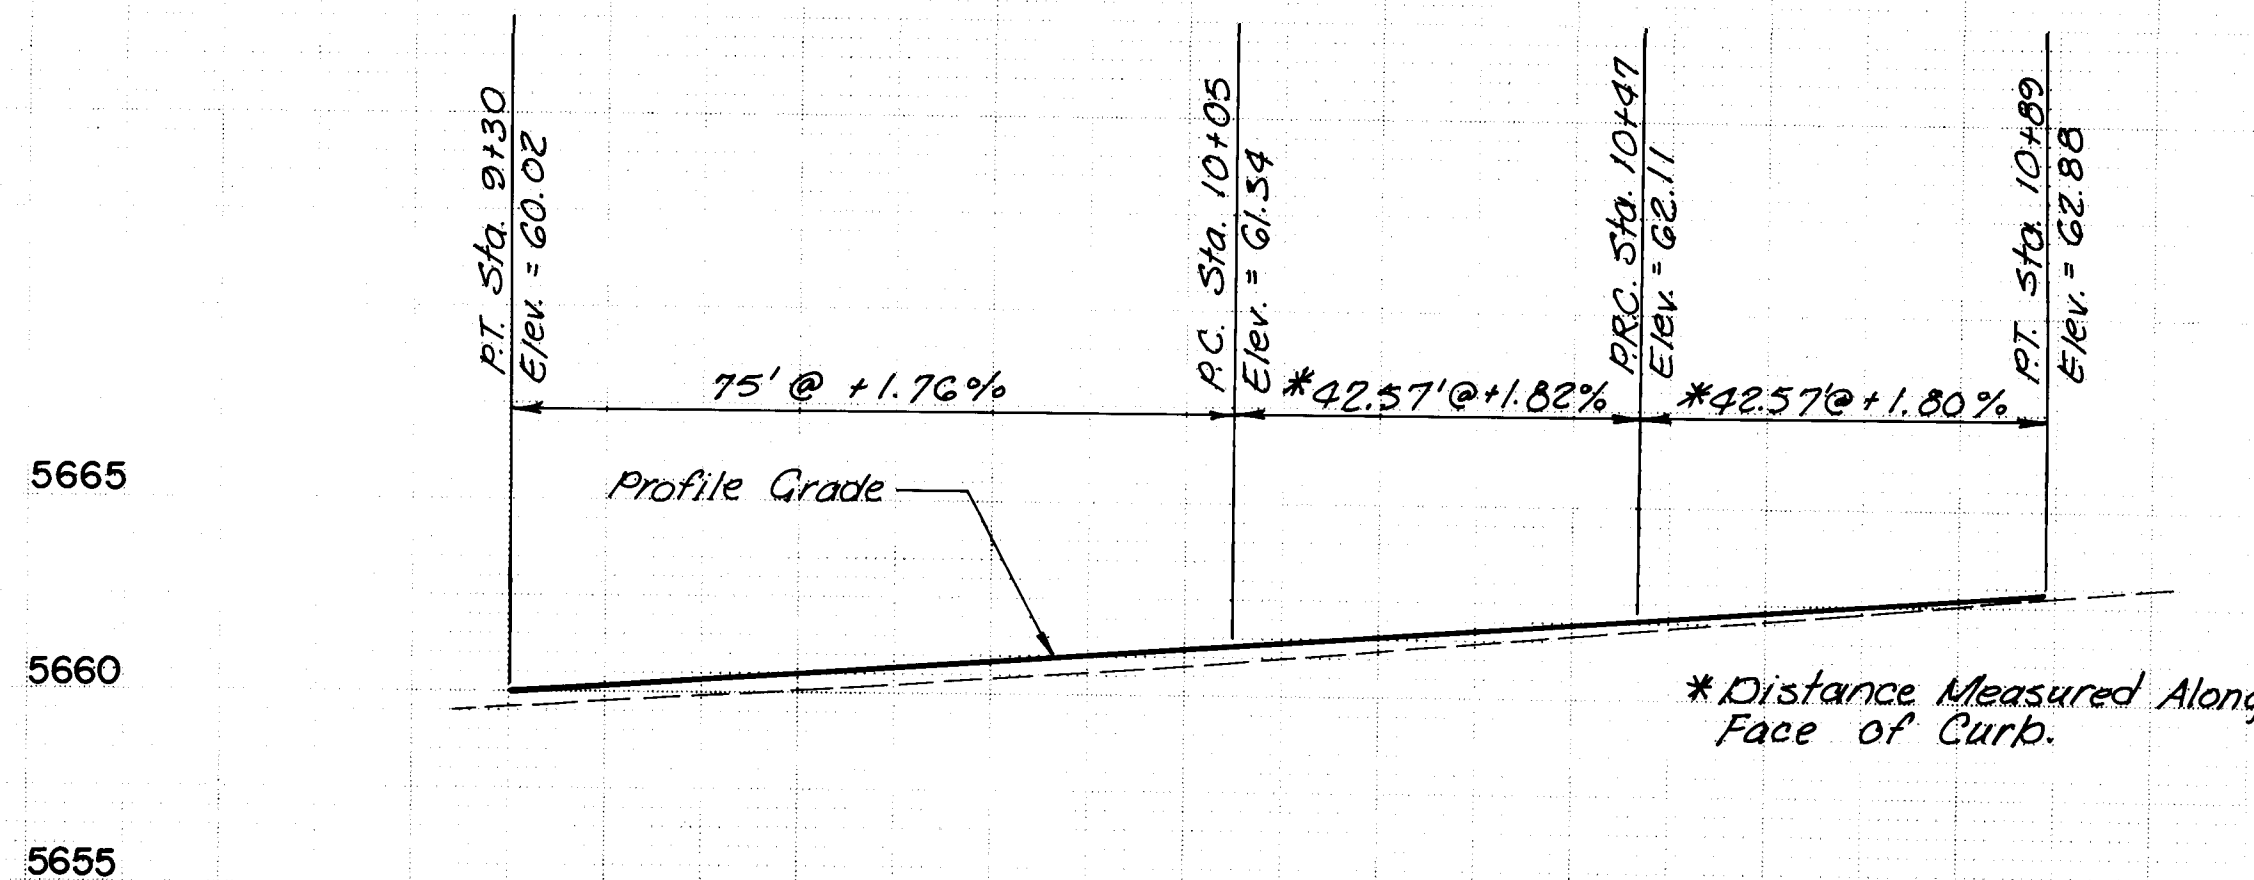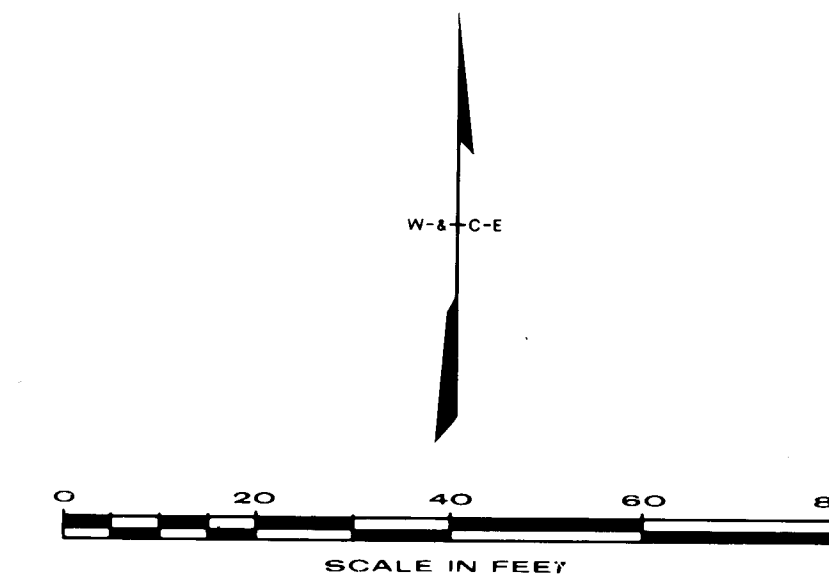

26 1602 0183

APPROVAL OF AS BUILT DRAWINGS
ASST. CITY ENGINEER - FIELD
Handwritten signature
DATE 11/4/83

Handwritten signature
CITY ENGINEER
DATE 3/10/83

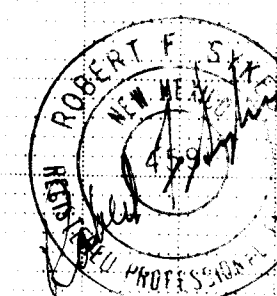

CITY OF ALBUQUERQUE
TRANSPORTATION DEPARTMENT

TURNBAY FOR APARTMENTS NEAR COMANCHE & JUAN TABO

APPROVALS	ENGINEER	DATE	APPROVALS	ENGINEER	DATE
City Engineer	<i>Handwritten signature</i>	3/10/83	Traffic	<i>Handwritten signature</i>	3/10/83
Liquid Waste	<i>Handwritten signature</i>	10/10/83	Water	<i>Handwritten signature</i>	10/10/83
A.C.E. - Design	<i>Handwritten signature</i>	3-10-83			
A.C.E. - Hydrology					

1602

OF 1

BENCH MARKS
City Bench Mark - 17-021 Standard Brass Tablet Stamped
117-021 1978 Located 34' North of Comanche at Embudo Arroyo.
Elev = 5655.54

REFERENCES
MAP NO G-21

NO.	DATE	BY	REVISIONS
1	12/82		DESIGN
2	12/82		REVISIONS
3	12/82		DESIGN
4	12/82		REVISIONS
5	12/82		DESIGN
6	12/82		REVISIONS
7	12/82		DESIGN
8	12/82		REVISIONS
9	12/82		DESIGN
10	12/82		REVISIONS

DESIGNED BY: WILSON & CO. RFS

DRAWN BY: RAG

CHECKED BY:

DATE

DATE

