


DRAINAGE IMPROVEMENTS
IN EASEMENT BETWEEN
TURNER DR. & ORO REAL

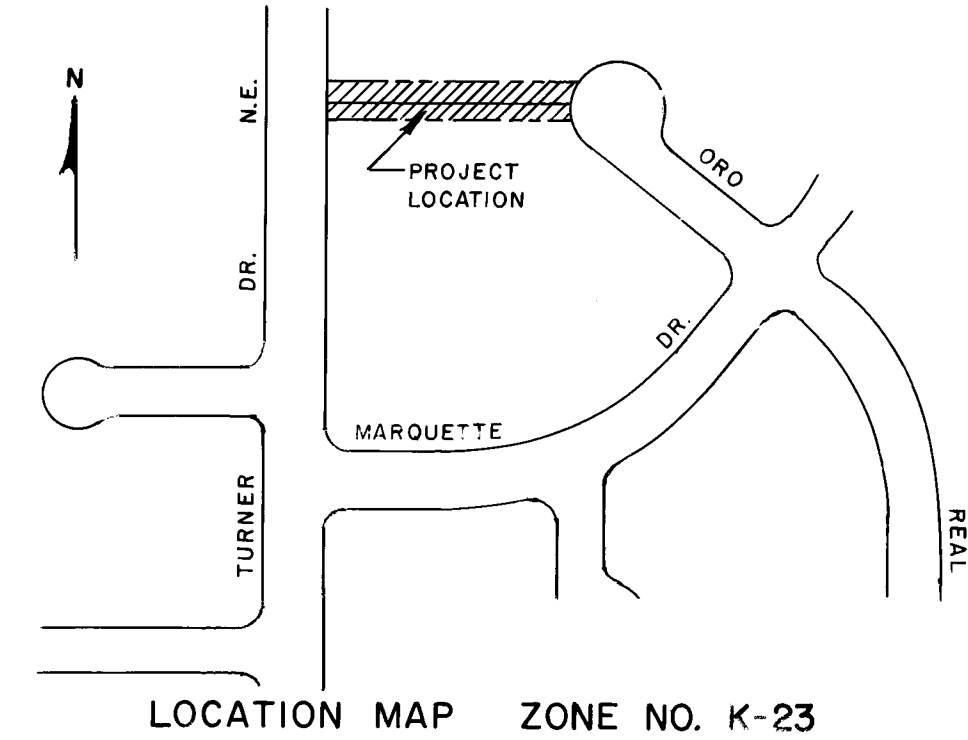

- NOTICE TO CONTRACTORS**
1. All work detailed on these plans to be performed under contract shall, except as otherwise stated or provided for hereon, be constructed in accordance with the New Mexico Standard Specifications for Public Works Construction-1979 Edition (referred to herein as the Standard Specifications) and the Contract Documents for Public Works Contract 64-2.
2. Two (2) working days prior to any excavation, the contractor must contact Line Locating Service, 765-1234, for location of existing utilities.
3. Prior to construction, the contractor shall excavate and verify the horizontal and vertical locations of all obstructions. Should a conflict exist, the contractor shall notify the engineer or surveyor so that the conflict can be resolved with minimum amount of delay.

THE FOLLOWING NOTES ALSO APPLY WHEN CHECKED

- ☐ All utilities and utility service lines shall be installed prior to paving.
- ☐ Backfill compaction shall be according to specified street use.
- ☐ Tack coat requirements shall be determined by the City Engineer.
- ☐ Sidewalks and wheelchair ramps within the curb returns shall be constructed wherever a new curb return is constructed.
- ☐ If curb is depressed for a driveway or a handicap ramp, the driveway or ramp shall be constructed prior to acceptance of the curb and gutter.
- ☐ All storm drainage facilities shall be completed prior to final acceptance.



INDEX	
SHEET	TITLE
1	TITLE SHEET
2	PLAN & PROFILE
3	ENLARGED PLAN-SECTIONS & DETAILS

APPROVAL OF AS BUILT DRAWINGS
ASSISTANT CITY ENGINEER - P.E.
Harold R. Smith
DATE 10/1/84


26.1607.0184

REV.	SHEETS	CITY ENGR.	DATE	USER DEPT.	DATE	USER DEPT.	DATE
APPROVAL OF REVISIONS							

	CITY OF ALBUQUERQUE	APPROVED FOR CONSTRUCTION <i>[Signature]</i> CITY ENGR.
	1607	SHEET OF 1 3

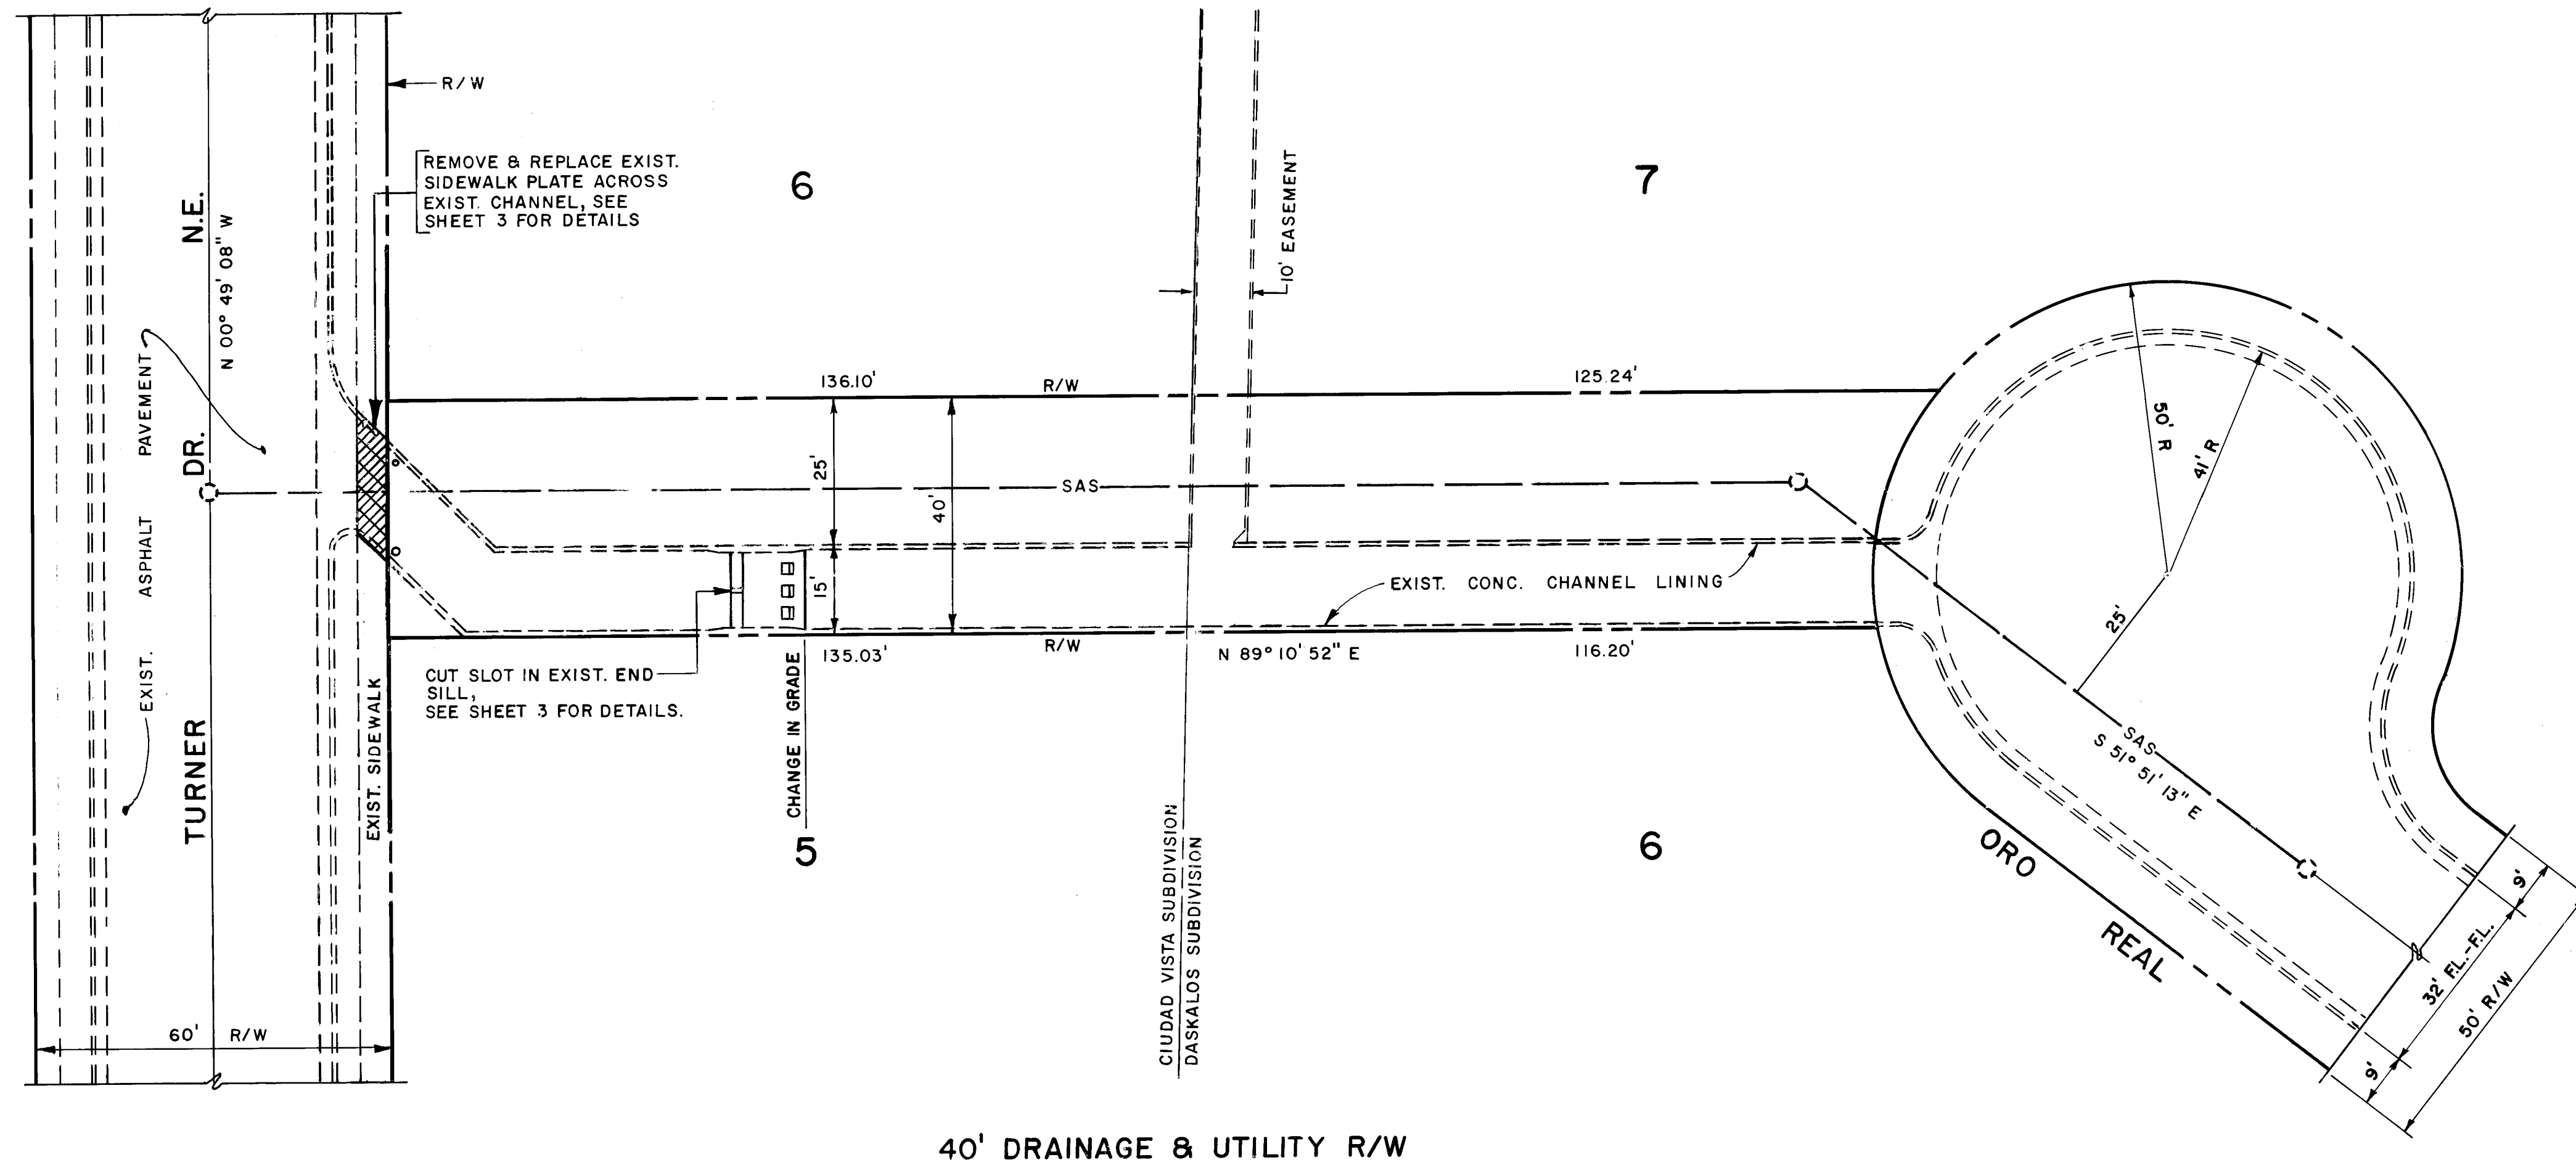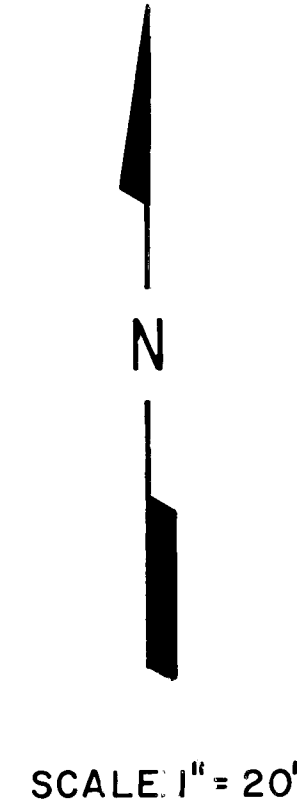

40' DRAINAGE & UTILITY R/W

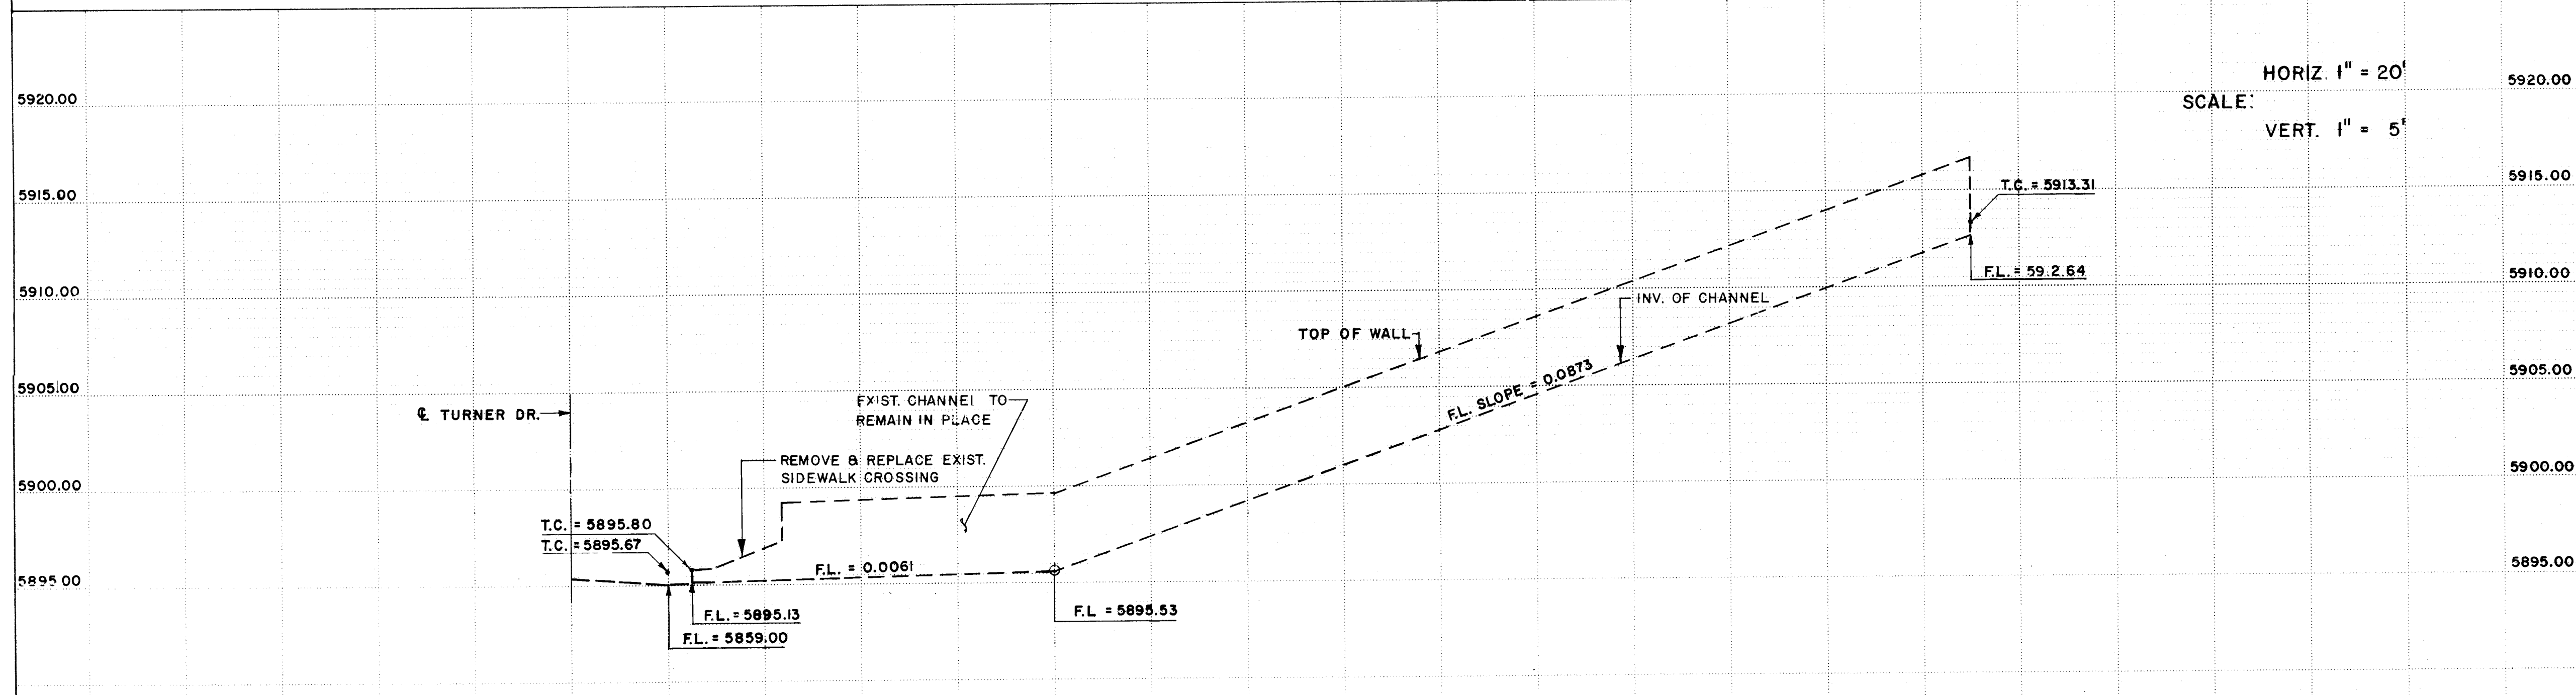

HORIZ. 1" = 20'
SCALE:
VERT. 1" = 5'

21 11607 0284

CITY OF ALBUQUERQUE MUNICIPAL DEVELOPMENT DEPARTMENT ENGINEERING DIVISION					
TITLE: DRAINAGE IMPROVEMENTS IN EASEMENT BETWEEN TURNER DR. & ORO REAL PLAN AND PROFILE					
APPROVALS	ENGINEER	DATE	APPROVALS	ENGINEER	DATE
City Engineer	<i>[Signature]</i>	4/19/84	Liquid Waste	NA	4-20-84
ACE - Design	<i>[Signature]</i>	4/20/84	Traffic	NA	4-20-84
ACE - Hydrology	<i>[Signature]</i>	4-19-84	Water	NA	4-20-84
STREET ENGR	<i>[Signature]</i>	4-19-84			
DRAWING NO.		MAP NO.		SHEET OF	
1607		K-23		2 3	

