


LEGEND


MATERIALS

CONCRETE
ASPHALT PAVEMENT REMOVED

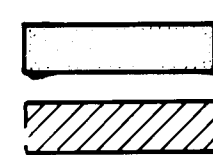

LINES

SUBDIVISION BOUNDARY
PROPERTY LINE (PLAN)
PROPERTY LINE (SECTION)
CENTERLINE
EASEMENT LINE
MATCH LINE
SECTION CUT LINE

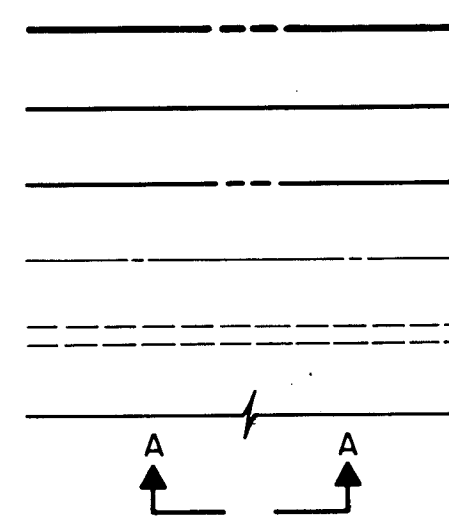


EARTHWORK

CONTOUR LINE
SPOT ELEVATION
PROJECT / PHASE BOUNDARY
SWALE
DIRECTION OF FLOW




MISCELLANEOUS UTILITIES

GAS LINE
UNDERGROUND TELEPHONE
UNDERGROUND ELECTRICAL
STORM DRAIN
STORM DRAIN MANHOLE
STORM DRAIN INLET

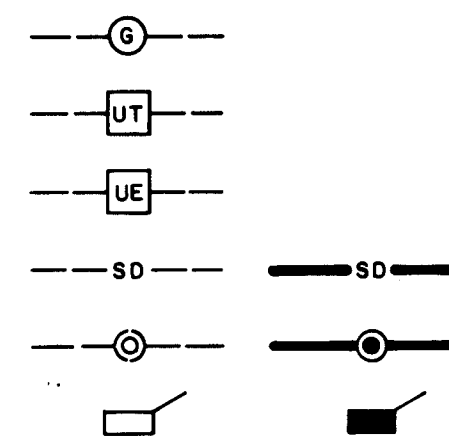


SANITARY SEWER

SANITARY SEWER LINE
SANITARY SEWER MANHOLE
SAS SERVICE CONNECTIONS
SAS CAP OR PLUG
ENCASEMENT

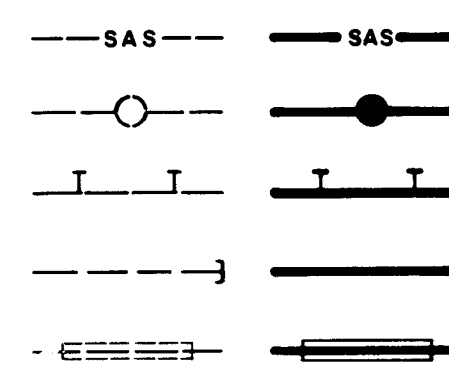


WATER

WATER LINE
WATER CURB STOP BOX
GATE VALVE
FIRE HYDRANT
BUTTERFLY VALVE
REDUCER
WATER PRESSURE ZONE BOUNDARY

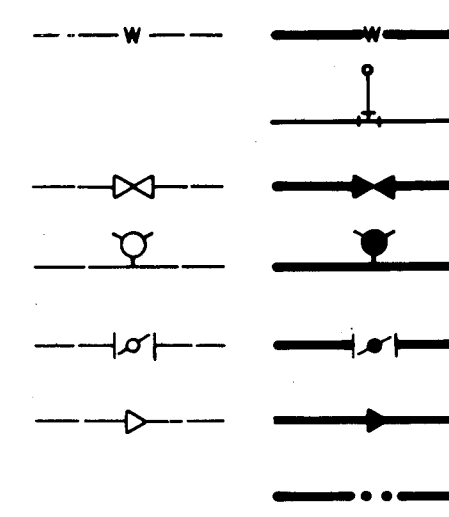


WATER FITTINGS

CAPS AND PLUGS
ELBOW
CROSS
TEE

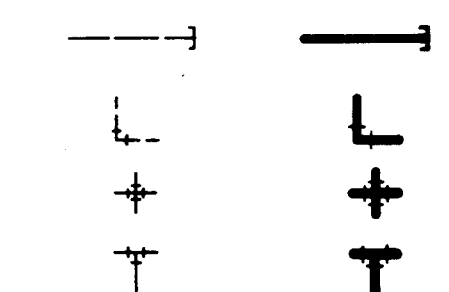

MISCELLANEOUS

CHAINLINK FENCE
FIELD FENCE
COMMON YARD WALL
RETAINING WALL
POWER OR TELEPHONE POLE
TRAFFIC REGULATORY SIGN

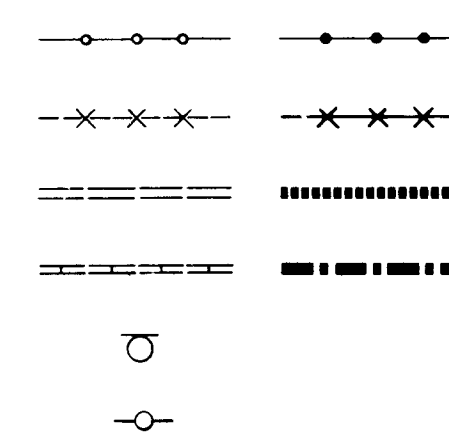

AS BUILT
PLANS FOR THE
MEDIAN

RECONSTRUCTION

OF

SAN PEDRO DRIVE N.E.

CANDELARIA ROAD N.E.

COMANCHE ROAD N.E.

ALBUQUERQUE, NEW MEXICO




FOR THE

CITY OF ALBUQUERQUE, TRANSPORTATION DEPARTMENT

INDEX OF DRAWINGS



SHEET NO.	DESCRIPTION
1	Title Sheet
2	Vicinity Map
3	Details
4	Details
MEDIAN IMPROVEMENTS	
San Pedro Drive N.E.	
5	Sta 10+00 to Sta 22+00
6	Sta 22+00 to Sta 34+00
7	Sta 34+00 to Sta 46+00
Candelaria Road N.E.	
8	Sta 10+00 to Sta 22+00
9	Sta 22+00 to Sta 34+00
10	Sta 34+00 to Sta 46+00
11	Sta 46+00 to Sta 58+00
12	Sta 58+00 to Sta 63+00
Comanche Road N.E.	
13	Sta 10+00 to Sta 22+00
14	Sta 22+00 to Sta 34+00
15	Sta 34+00 to Sta 46+00
16	Sta 46+00 to Sta 58+00
17	Sta 58+00 to Sta 70+00
18	Sta 70+00 to Sta 82+00
19	Sta 82+00 to Sta 94+00
20	Sta 94+00 to Sta 104+74
SANITARY SEWER IMPROVEMENTS	
Comanche Road N.E.	
21	Sta 10+00 to Sta 22+00
22	Sta 22+00 to Sta 23+92
TRAFFIC CONTROL PLAN	
23	Candelaria Road N.E.
24	San Pedro Road N.E.
25-27	Comanche Road N.E.

NOTE: THIS DRAWING INDICATES THE "AS-BUILT" CONDITIONS TO THE BEST OF MY KNOWLEDGE AND BELIEF. THE "AS-BUILT" INFORMATION FOR THIS DRAWING WAS SUPPLIED BY THE CITY OF ALBUQUERQUE.

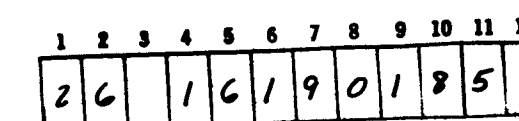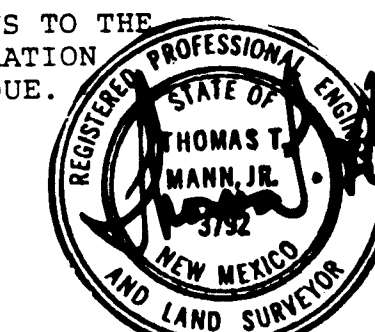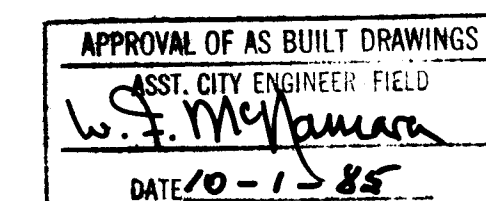


REV.	SHEETS	CITY ENGINEER	DATE	USER DEPARTMENT	DATE	USER DEPARTMENT	DATE

APPROVAL OF REVISIONS

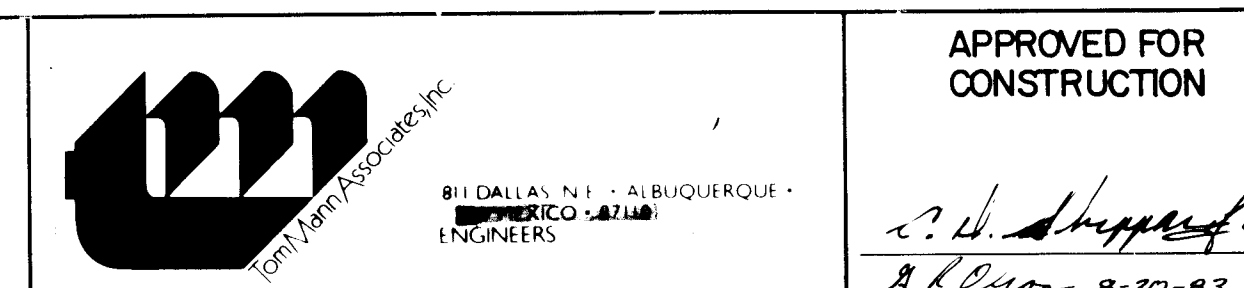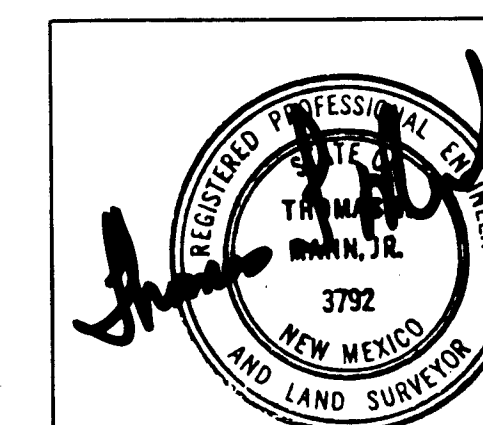

1619

SHEET 1 OF 2

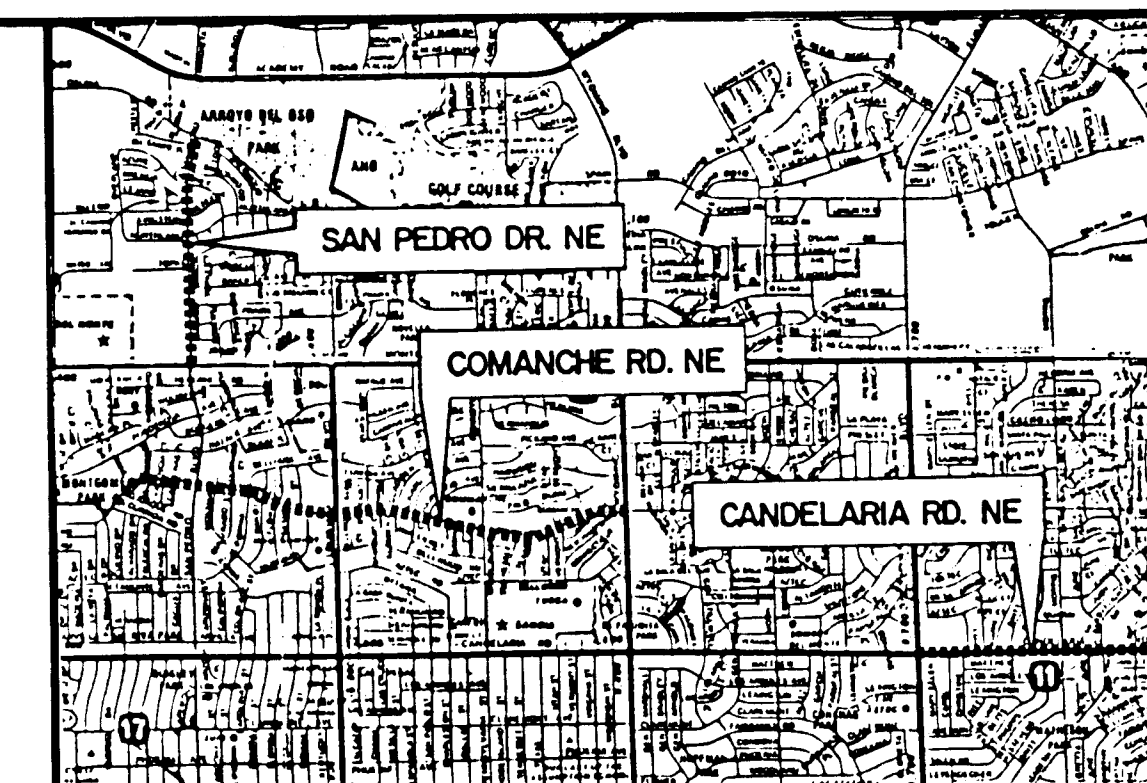

VICINITY MAP SCALE: 1"= 0.7 MI.

GENERAL NOTES:

- All work detailed on these plans to be performed under contract shall, except as otherwise stated or provided for hereon, be constructed in accordance with the New Mexico Standard Specifications for Public Works Construction - 1979 Edition (referred to herein as the Standard Specifications) and the Contract Documents for City-Wide Utilities and Cash Paving No. 31.
 - Two (2) working days prior to any excavation, Contractor must contact line locating service, 765-1234, for location of existing utilities.
 - Prior to construction, the Contractor shall excavate and verify the horizontal and vertical locations of all potential obstructions. Should a conflict exist, the Contractor shall notify the Engineer so that the conflict can be resolved with a minimum amount of delay. Contractor shall maintain access to adjacent properties during construction.
 - All work on this project shall be performed in accordance with applicable Federal, State, and Local laws, rules, and regulations concerning construction safety and health.
 - All finish grades and profiles shown are top of curb grade unless noted otherwise.
 - All gas valve boxes, gas manholes, electric manholes, telephone manholes, and utility poles will be adjusted to grade, or relocated, by others.
 - It will be the Contractor's responsibility to protect and maintain in service all existing utilities.
 - A disposal site for all excess excavation material concrete paving, asphaltic paving, etc., shall be obtained by the Contractor in compliance with applicable environmental regulations and approved by the Field Engineer. All costs incurred in obtaining a disposal site and haul thereto shall be considered incidental to the project and no separate measurement or payment shall be made. See Section 212, Specifications and Contract Documents.
 - The Contractor will be required to confine his work within the construction limits and/or right-of-way to preserve existing vegetation and private property. Overnight parking of construction equipment shall not obstruct driveway openings or designated traffic lanes. Fifty (50) ton roller operation shall not be used in this project where underground utilities are present. The required compaction at these locations shall be effected by means of other types of rolling available.
 - The City of Albuquerque Traffic Engineering Division shall remove all existing traffic signal equipment deemed salvageable by the City. All removal and/or installation of permanent traffic control signs shall be coordinated between the City Traffic Engineering Division and the Contractor so as to minimize disruption of traffic.
 - All power poles located within areas of construction shall be removed and relocated by Public Service Company of New Mexico prior to any construction.
- STREET PAVING IMPROVEMENTS
- ALL SLOPES AS SHOWN ON PROFILES ARE BASED ON SURVEY BASELINE STATIONING (STREET CENTERLINE), UNLESS OTHERWISE NOTED.
 - ALL DIMENSIONS AND RADII OF CURB AND CURB RETURNS ARE SHOWN TO FACE OF CURB.
 - WHERE REMOVAL OF EXISTING CURBS AND GUTTER, SIDEWALK OR PAVEMENT IS REQUIRED, CONTRACTOR SHALL SAWCUT AND/OR REMOVE TO THE NEAREST JOINT. CURB AND GUTTER SHOWN AS EXISTING AND NOT TO BE REMOVED UNDER THIS CONTRACT WHICH IS DAMAGED OR DISPLACED BY THE CONTRACTOR SHALL BE REMOVED AND REPLACED BY THE CONTRACTOR AT THE CONTRACTOR'S EXPENSE.
 - WHEN ABUTTING NEW PAVEMENT TO EXISTING, SAWCUT EXISTING PAVING TO A STRAIGHT LINE AND AT A RIGHT ANGLE, OR AS APPROVED BY THE PROJECT ENGINEER, REMOVE ANY BROKEN OR CRACKED PAVEMENT. NO SEPARATE PAYMENT SHALL BE MADE BUT SHALL BE CONSIDERED INCIDENTAL TO THE PROJECT.
 - ALL OFFSET DIMENSIONS SHOWN ON THESE PLANS ARE GIVEN FROM STREET CENTERLINE.
 - ALL OFFSET DIMENSIONS AT MEDIAN ENDS ARE GIVEN FROM STREET CENTERLINE TO MEDIAN NOSE.
 - ALL LANE STRIPING IS TO BE DONE BY THE CITY OF ALBUQUERQUE AFTER CONSTRUCTION IS COMPLETED.




CITY ENGINEER DATE

CITY OF ALBUQUERQUE
TRANSPORTATION DEPARTMENT


TITLE: MEDIAN RECONSTRUCTION
VICINITY MAP

DRAWING NO.	1619	SHEET	2
-------------	------	-------	---


			REFERENCES		SURVEY INFORMATION		BENCH MARKS	AS BUILT INFORMATION
			MAP NO.			FIELD NOTES		
			EST. NO.	W/O NO.	NO.	BY		
						DATE		
							SAN PEDRO PROJECT BM, STA. M-4A	CONTRACTOR WORKED BY INSPECTORS ACCEPTANCE BY DATE
							CANDELARIA PROJECT BM, GC21, 1975 AC3	DATE

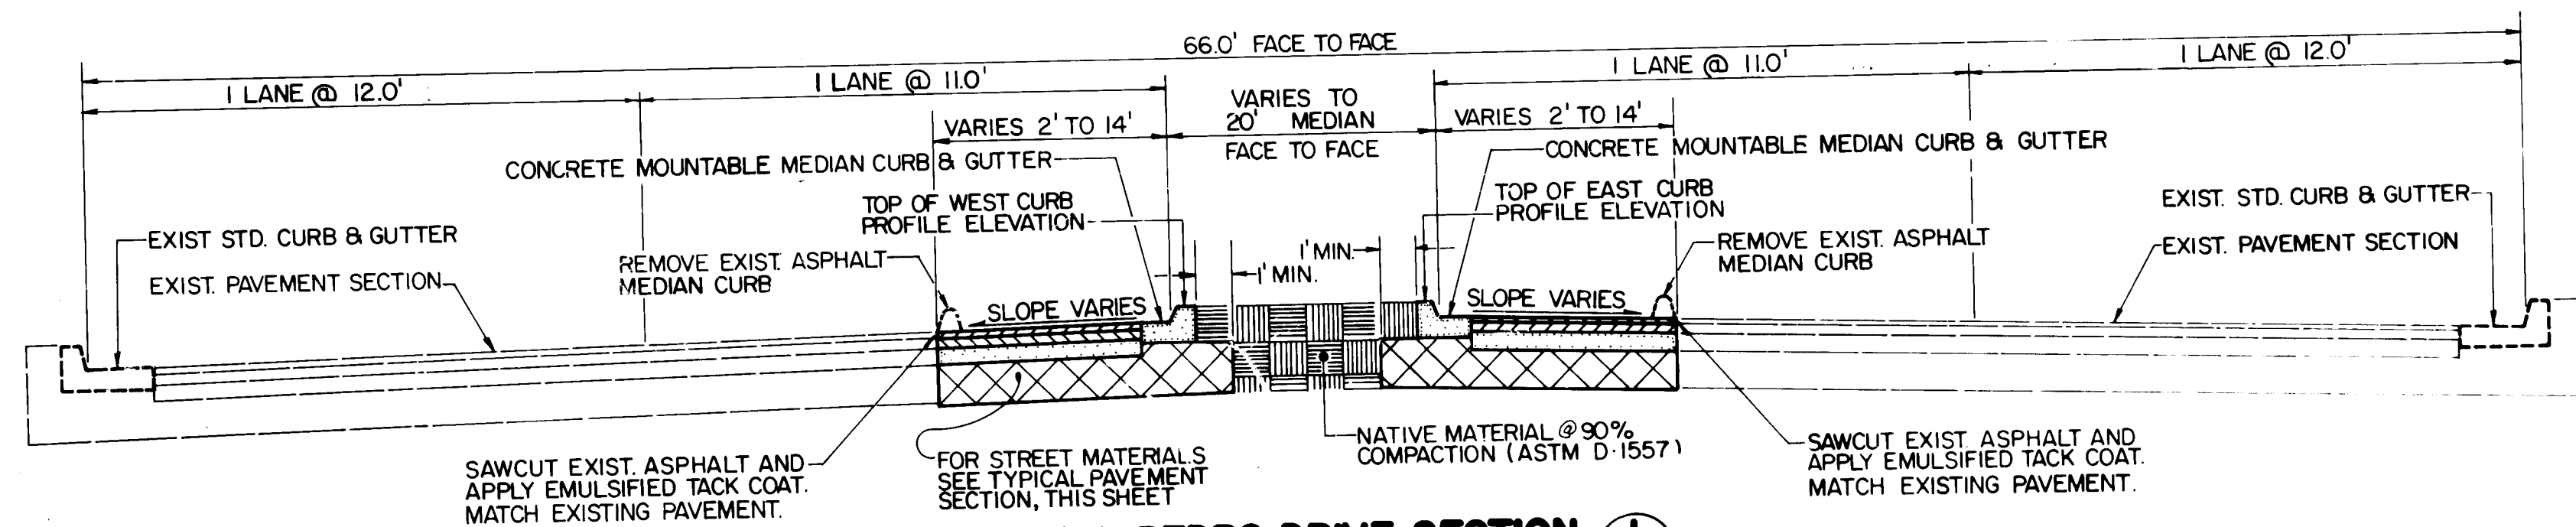


SAN PEDRO DRIVE SECTION 1
NO SCALE

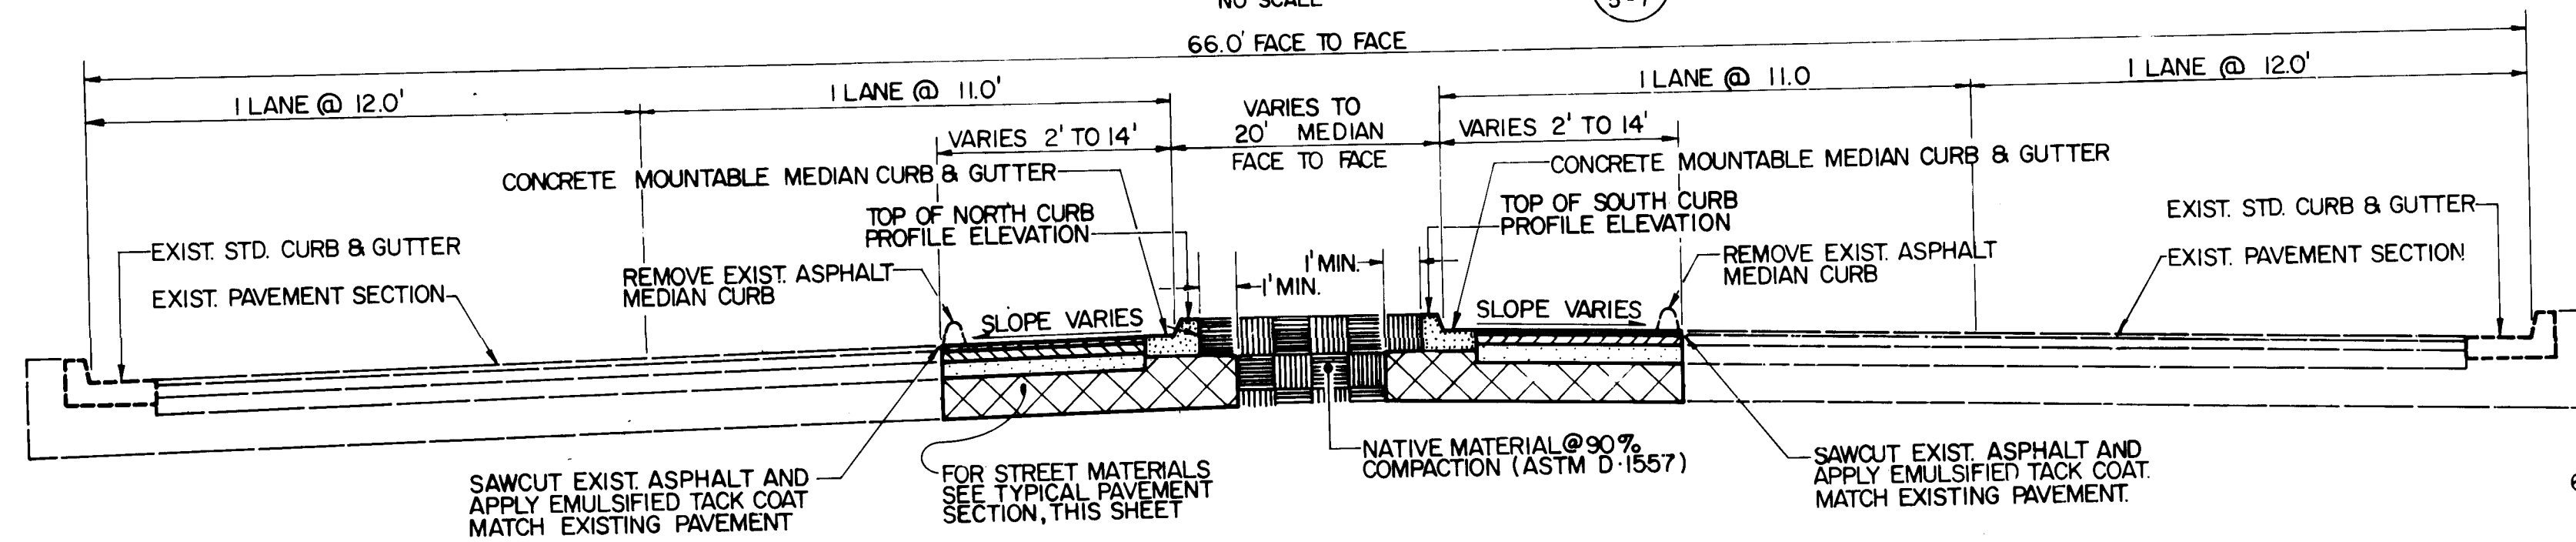


CANDELARIA ROAD SECTION 2
NO SCALE

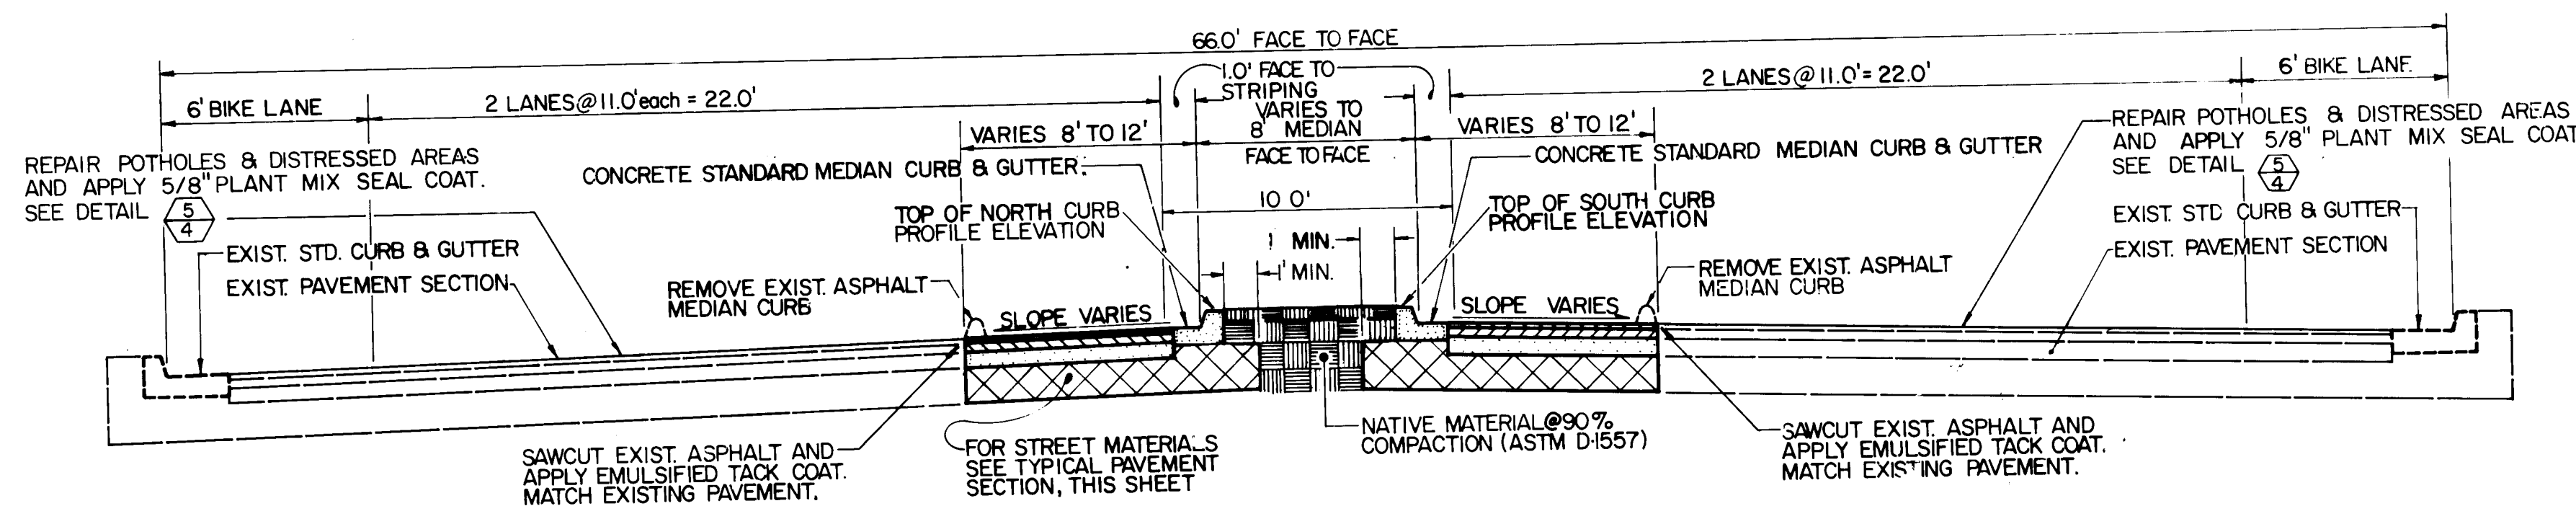


COMANCHE ROAD SECTION 3
NO SCALE

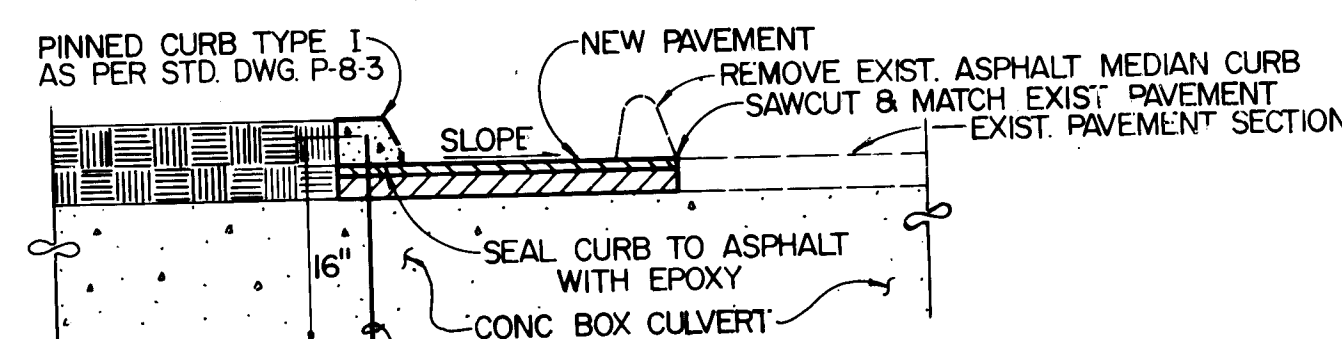


STREET SECTION AT CULVERT 4
SCALE: 1/2" = 1'-0"

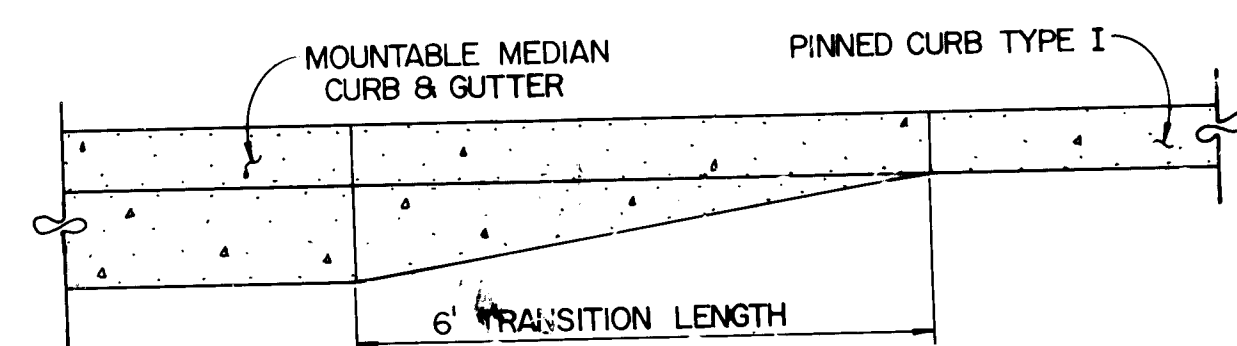



PINNED CURB TRANSITION DETAIL. P
SCALE: 1/2" = 1'-0"

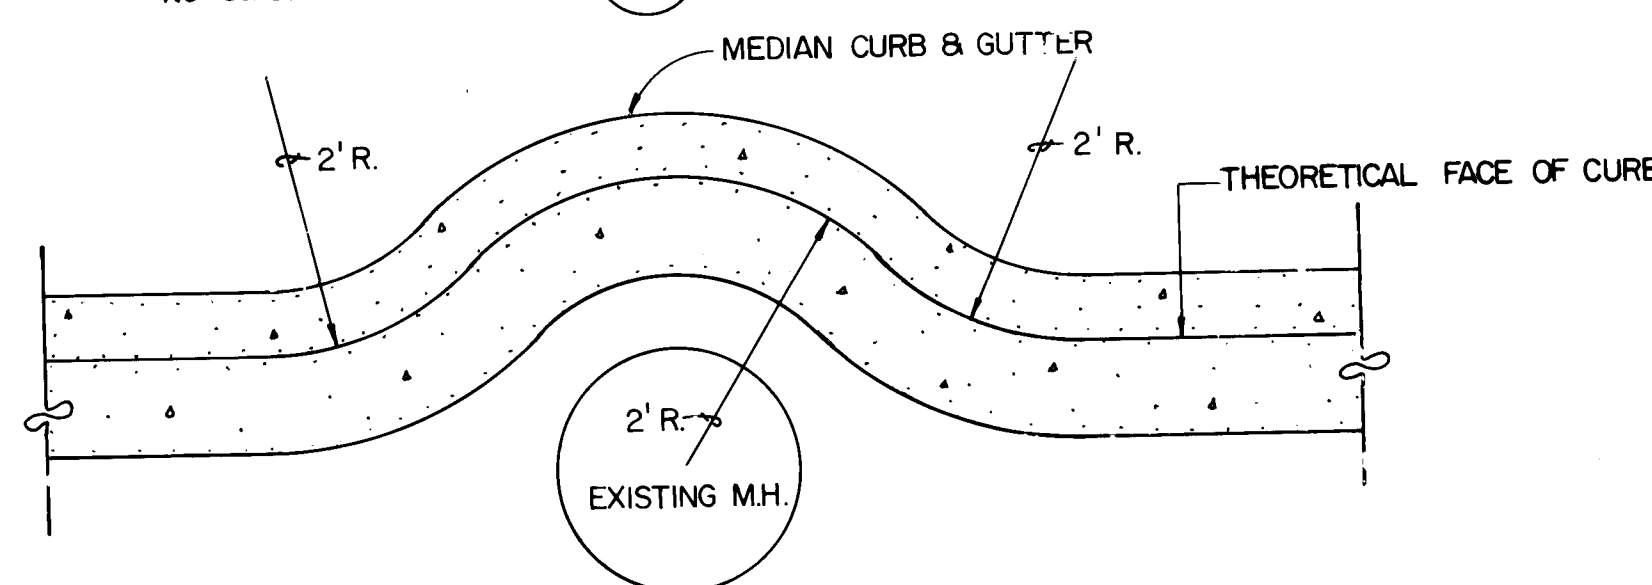


CURB TRANSITION AT MANHOLE Q
SCALE: 1/2" = 1'-0"

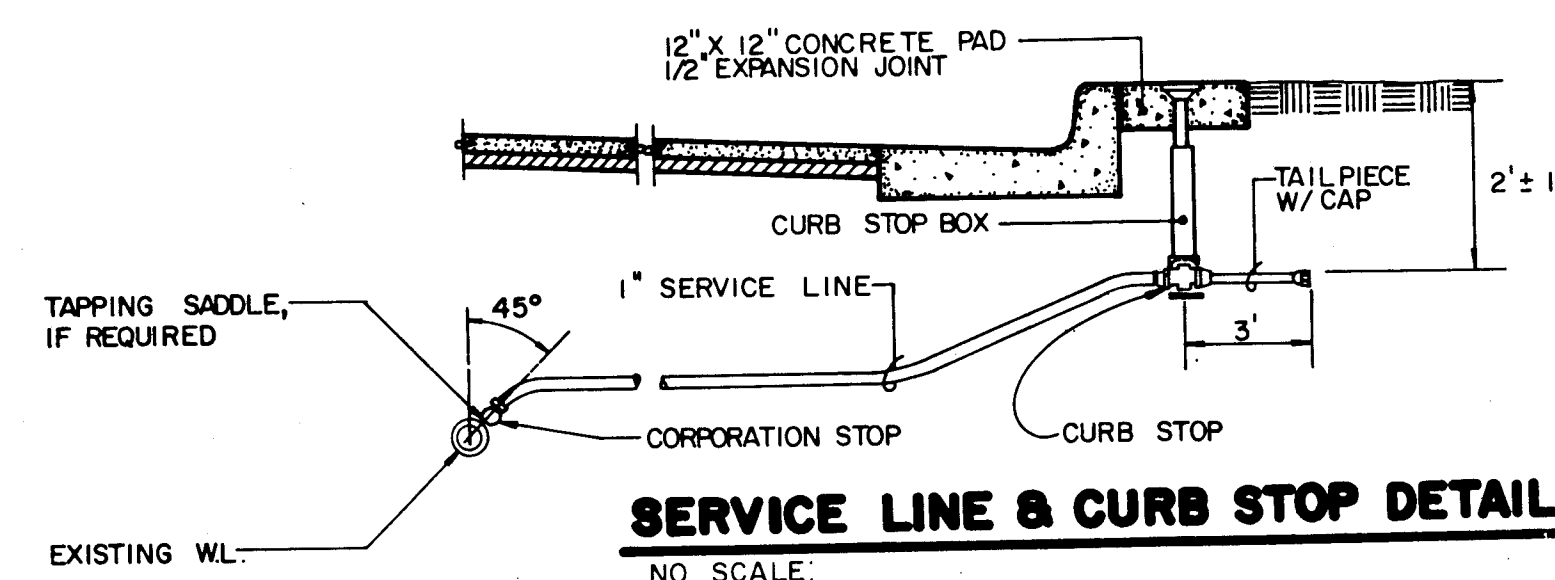


SERVICE LINE & CURB STOP DETAIL L
NO SCALE

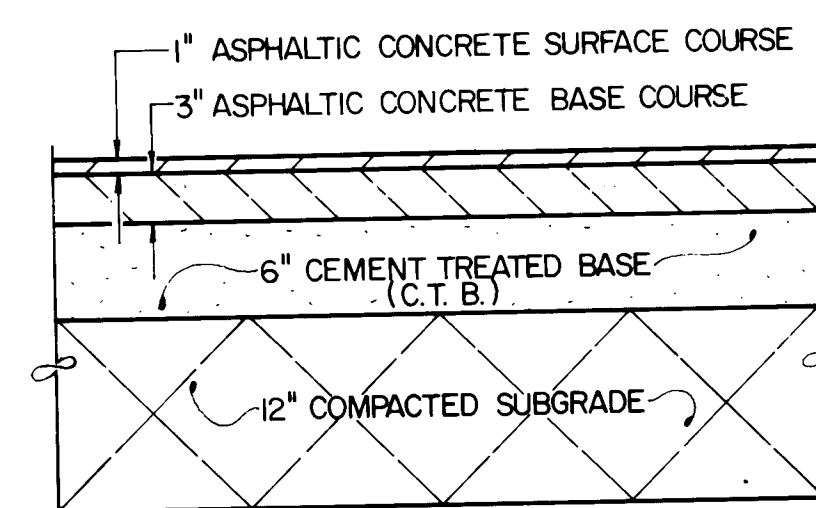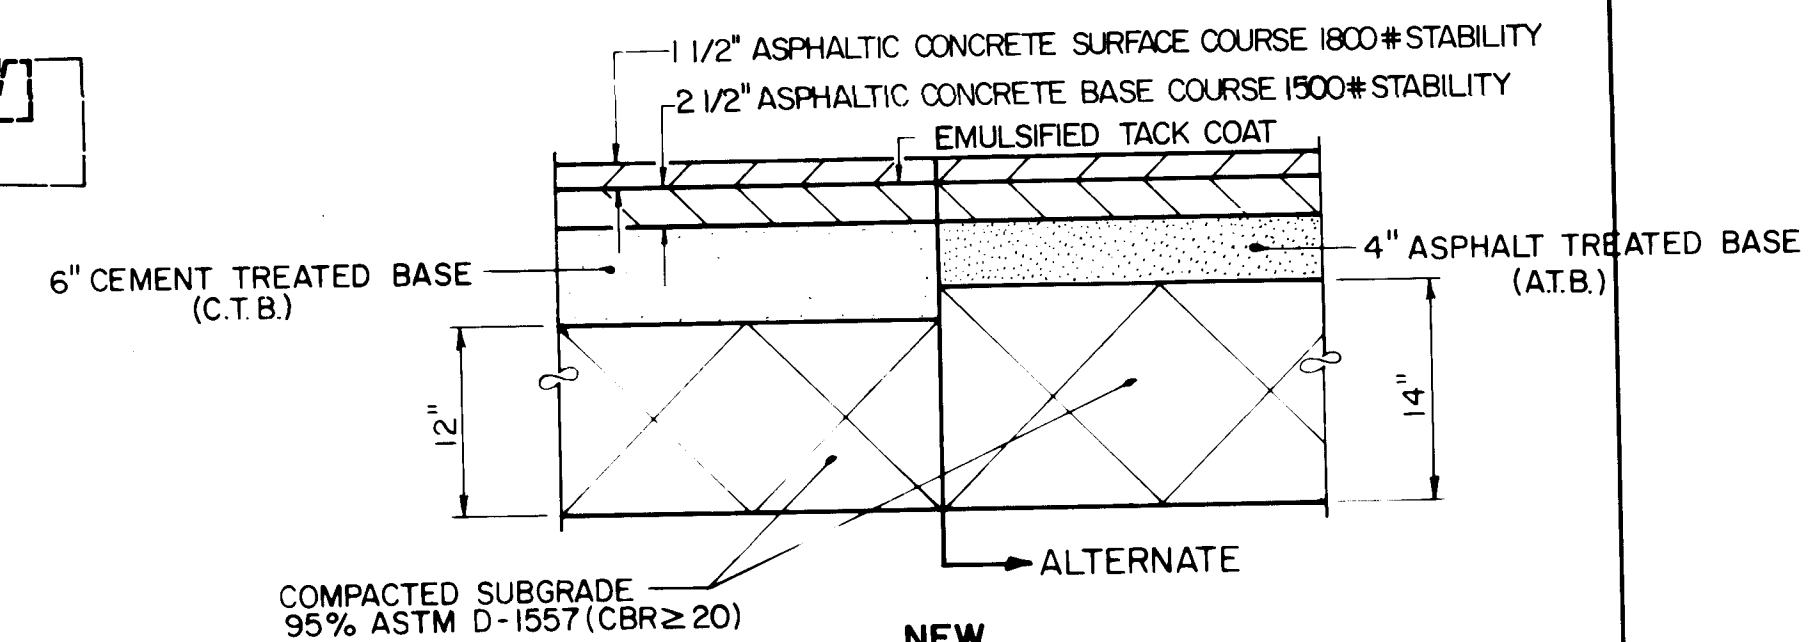

EXISTING TYPICAL PAVEMENT SECTIONS

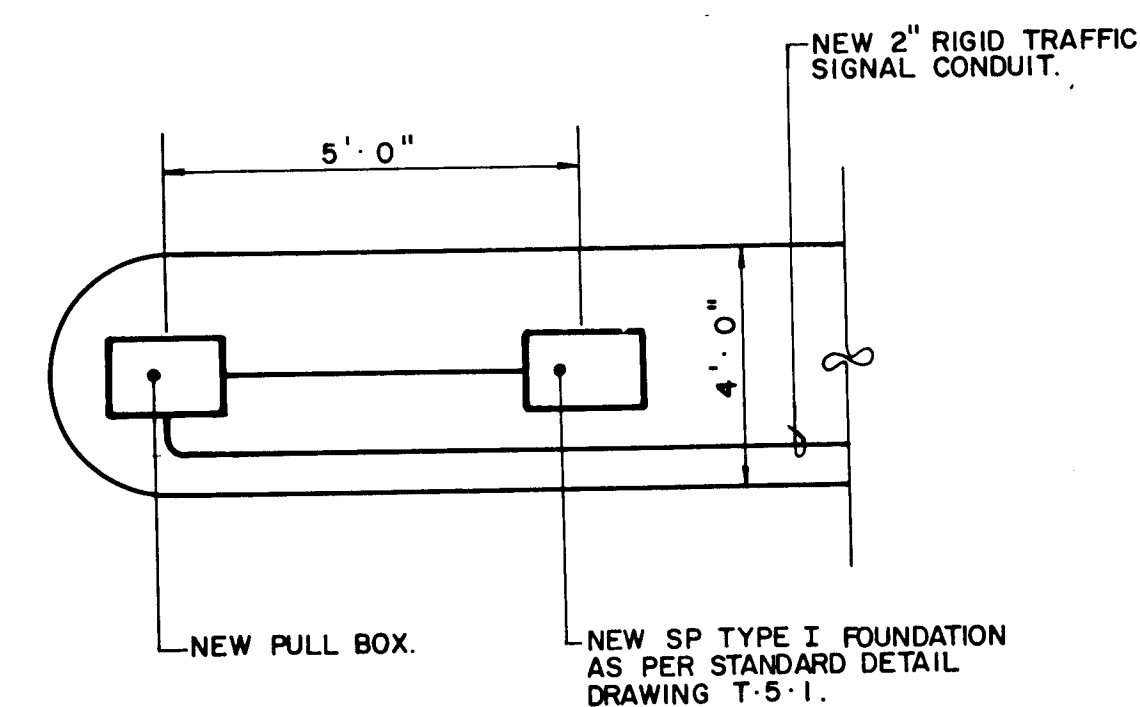

MEDIAN SIGNAL RECONSTRUCTION DETAIL M
NO SCALE

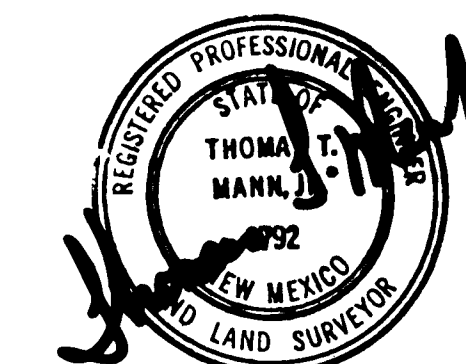

APPROVED FOR
CONSTRUCTION

CITY ENGINEER DATE

1 2 3 4 5 6 7 8 9 10 11 12
2 6 1 6 1 9 0 3 8 5

CITY OF ALBUQUERQUE
TRANSPORTATION DEPARTMENT

TITLE: **MEDIAN RECONSTRUCTION
DETAILS**

APPROVALS	ENGINEER	DATE	APPROVALS	EN
City Engineer			Liquid Waste	
A.C.E. - Design			Traffic	
A.C.E. - Hydrology			Water	

DRAWING NO. **1619** SHEET

AS BUILT INFORMATION	BENCH MARKS	SURVEY INFORMATION	REFERENCES
CONTRACTOR WORK STARTED BY ACCEPTANCE BY FIELD REVISION BY	SAN PEDRO PROJECT B-1, STA. 1+44 CANDELARIA PROJECT B-1, G-021, 1975 ACS	FIELD NOTES BY NO. W.O. NO.	MAP NO. EST. NO.
DATE	DATE	DATE	DATE

KEYED NOTES

1. ADJUST MANHOLE FRAME AND COVER TO GRADE AS PER CITY OF ALB. STD. DWG P-24.
2. ADJUST WATER VALVE BOX AND COVER TO GRADE AS PER CITY OF ALB. STD. DWGS. W-2, W-3, W-26 and P-24.
3. REMOVE AND DISPOSE OF EXISTING ASPHALT AND/OR CONCRETE CURB.
4. REMOVE AND REPLACE EXISTING ASPHALTIC CONCRETE PAVING AT LOCATIONS APPROVED BY FIELD ENGINEER.
5. CONNECT NEW CONCRETE MEDIAN CURB AND GUTTER TO EXISTING CONCRETE CURB AND GUTTER; TOP OF CURB AND FLOWLINE ELEVATIONS SHALL MATCH.
6. TRAFFIC SIGNAL PULL BOXES SHALL BE INSTALLED AT THE STATIONS INDICATED, AS PER CITY OF ALBUQUERQUE STANDARD DRAWING T-4-1.
7. TRAFFIC SIGNAL MANHOLES SHALL BE INSTALLED AT THE STATIONS INDICATED, AS PER CITY OF ALBUQUERQUE STANDARD DRAWING T-13.
8. TRAFFIC SIGNAL COMPUTER INTER-CONNECT CONDUIT (2" RIGID) SHALL BE INSTALLED AT THE LOCATIONS INDICATED.
9. EXISTING TRAFFIC SIGNAL PULLBOXES SHALL BE REMOVED AND RELOCATED TO THE STATIONS INDICATED. COMPUTER INTERCONNECT CONDUIT (2" RIGID) SHALL BE RECONNECTED USING A SWEEP BEND.
10. EXISTING TRAFFIC SIGNAL CONDUIT, ALL EXISTING TRAFFIC SIGNAL EQUIPMENT (EXCEPT PULL BOXES) AND REGULATORY SIGNS THAT NEED TO BE RELOCATED SHALL BE DONE BY THE TRAFFIC ENGINEERING DIVISION WITH 2 DAYS NOTICE.
11. TAP AND INSTALL 1" SERVICE LINE INCLUDING SADDLE AT THE STATIONS INDICATED. REMOVE AND REPLACE EXISTING PAVING IMPROVEMENTS AS NECESSARY.
12. INSTALL CURB STOP AND CURB BOX AT THE STATIONS INDICATED AS PER DETAIL 4.
- 13.

AS BUILT INFORMATION		BENCH MARKS		SURVEY INFORMATION		ENGINEER'S SEAL	
CONTRACTOR	WORK ORDER NO.	AN ACS BRASS TABLET STAMPED STA. 10+00	CEMENTED IN A DRILL HOLE IN THE GUTTER	FIELD NOTES	NO.	DATE	DATE
INSPECTOR	ACCEPTANCE BY	AND FLUSH WITH THE PAVEMENT LOCATED		BY			

CITY OF ALBUQUERQUE
TRANSPORTATION DEPARTMENT

TITLE:
SAN PEDRO DRIVE N.E.
STA. 10+00 TO STA. 22+00



APPROVALS	ENGINEER	DATE	APPROVALS	ENG
City Engineer			Liquid Waste	
A.C.E. - Design			Traffic	
A.C.E. - Hydrology			Water	

DRAWING NO. 1619 MAP NO. F-18 SHEET


1 2 3 4 5 6 7 8 9 10 11 12
26 16190585



"AS-BUILT" NOTE: THIS DRAWING INDICATES THE "AS-BUILT" CONDITIONS TO THE BEST OF MY KNOWLEDGE AND BELIEF. THE "AS-BUILT" INFORMATION FOR THIS DRAWING WAS SUPPLIED BY THE CITY OF ALBUQUERQUE.

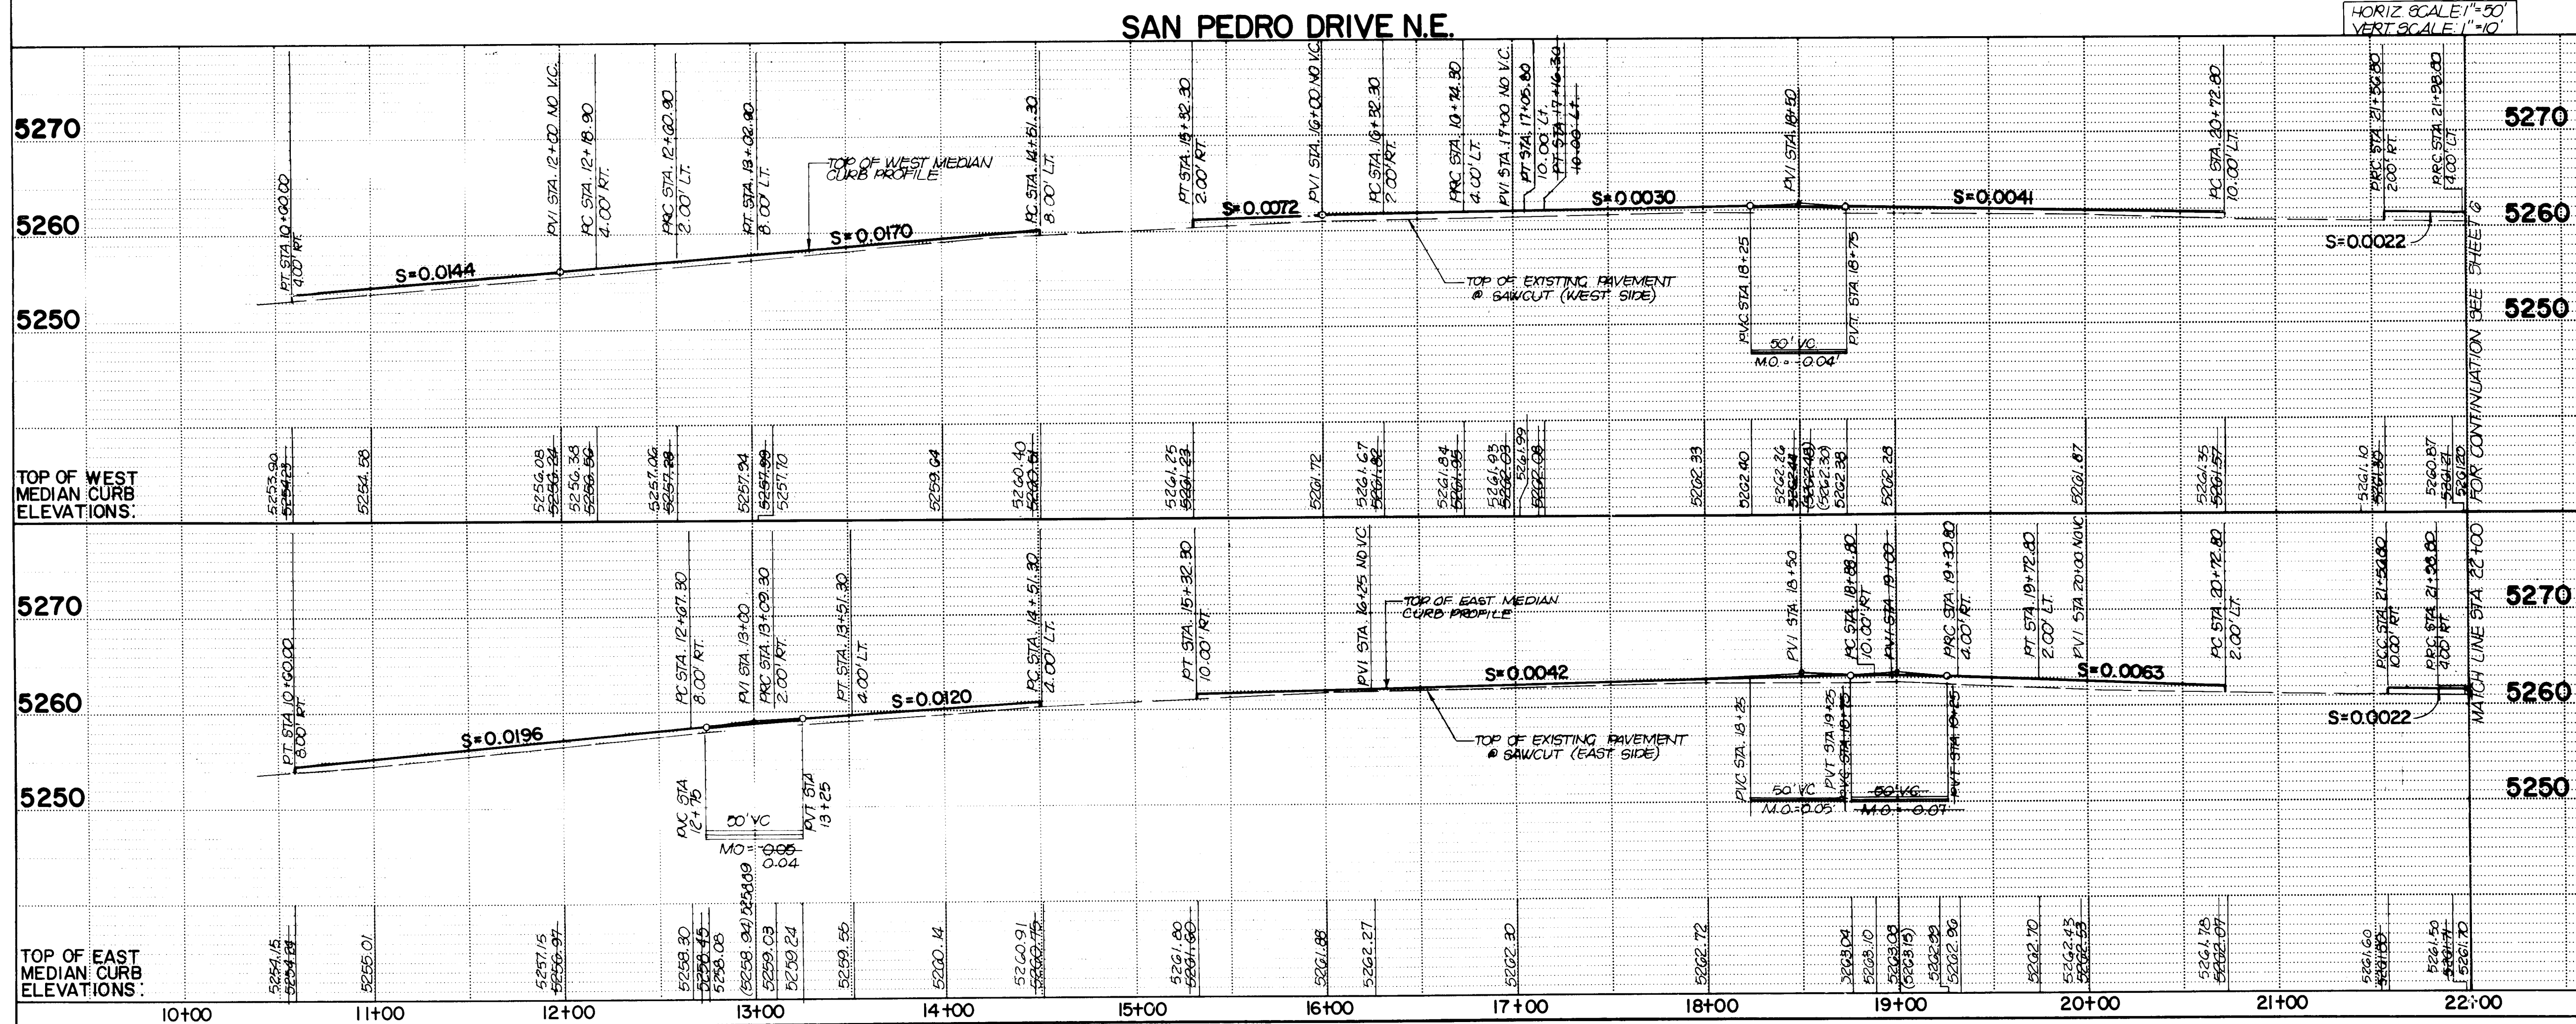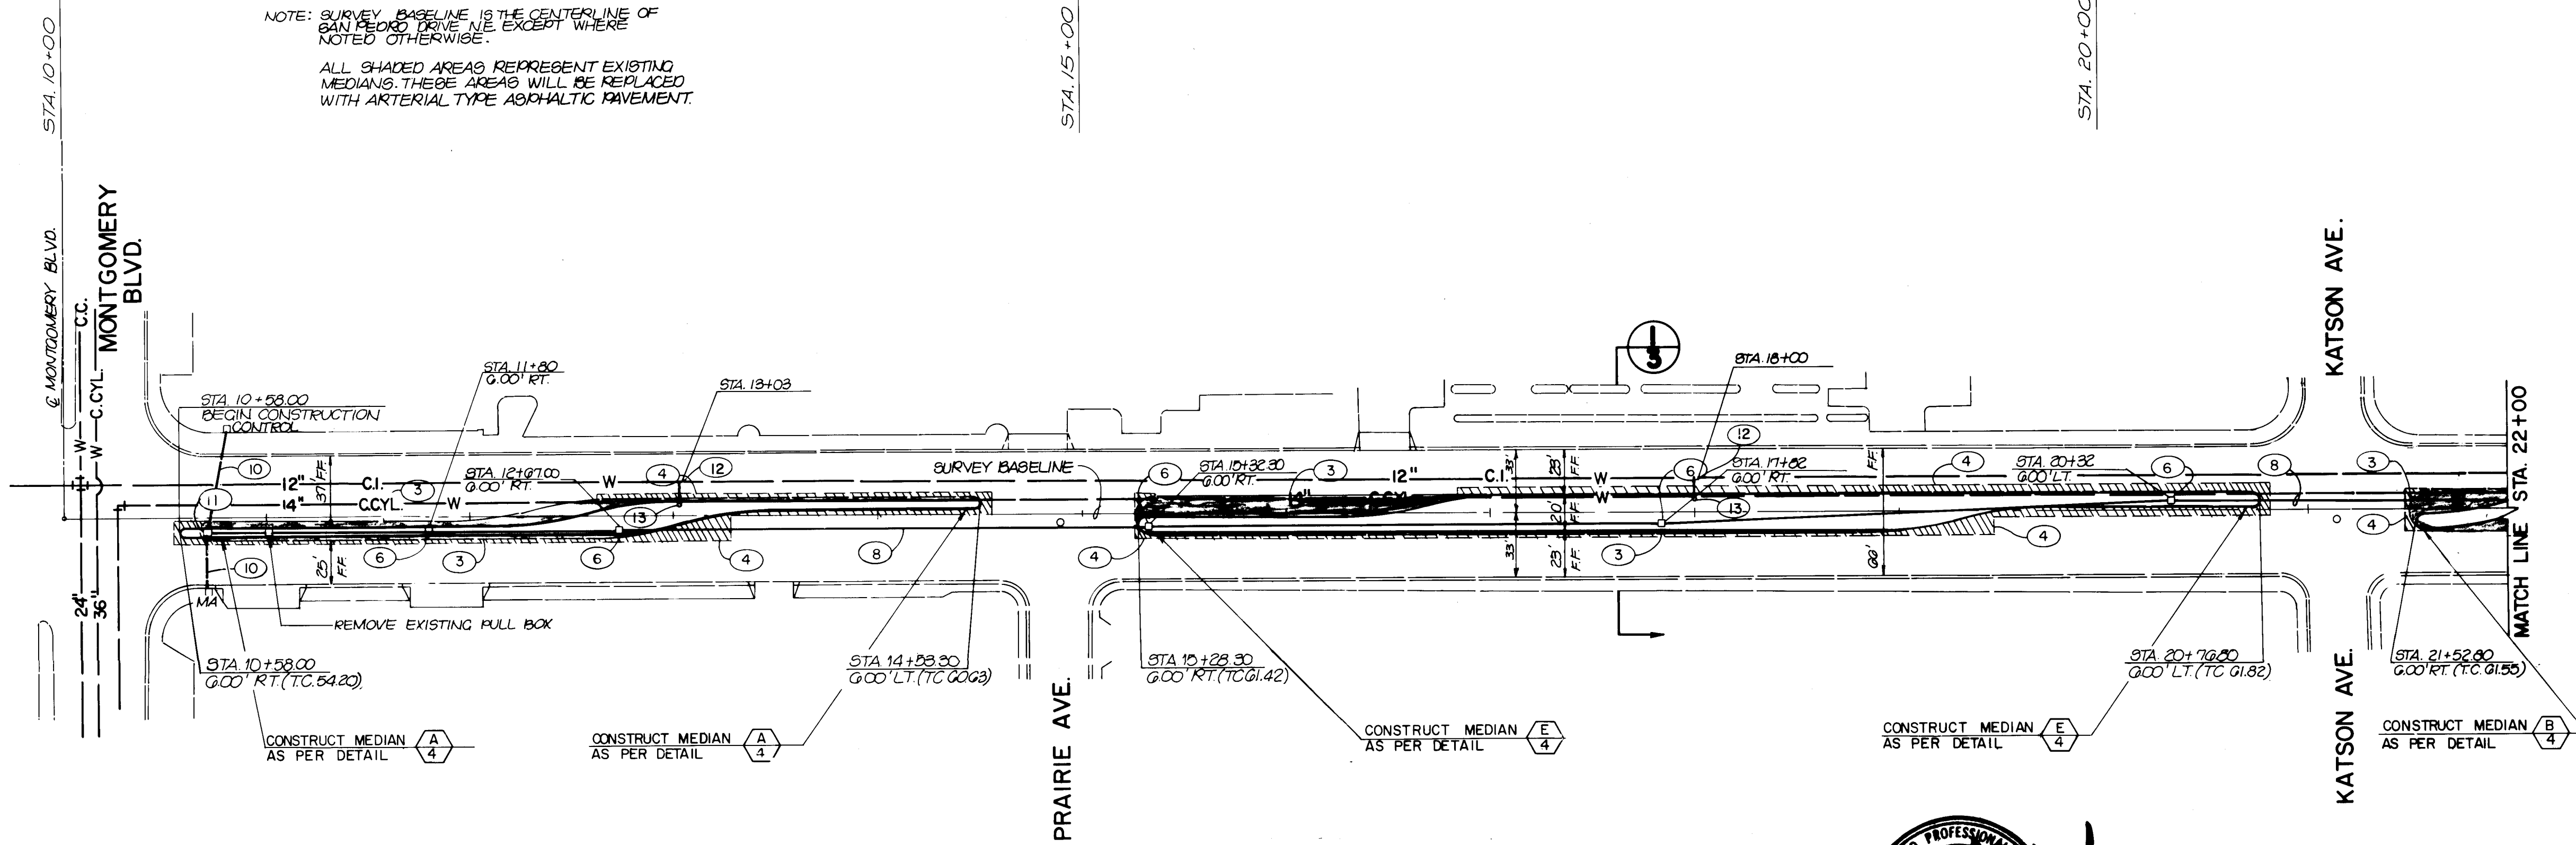

NOTE: SURVEY BASELINE IS THE CENTERLINE OF SAN PEDRO DRIVE N.E. EXCEPT WHERE NOTED OTHERWISE.
ALL SHADED AREAS REPRESENT EXISTING MEDIANS. THESE AREAS WILL BE REPLACED WITH ARTERIAL TYPE ASPHALTIC PAVEMENT.

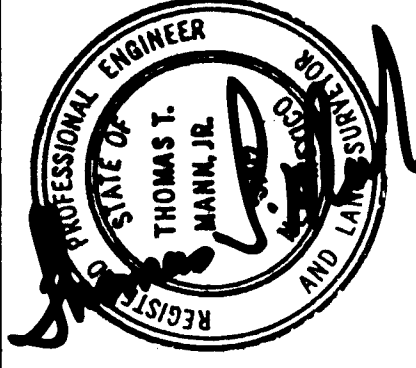[illegible]

"AS-BUILT" NOTE: THIS DRAWING INDICATES THE "AS-BUILT" CONDITIONS TO BEST OF MY KNOWLEDGE AND BELIEF. THE "AS-BUILT" INFORMATION FOR THIS DRAWING WAS SUPPLIED BY THE CITY OF ALBUQUERQUE.

THE
 REGISTERED PROFESSIONAL ENGINEER
 STATE OF TEXAS
 THOMAS T. MANN, JR.
 3792
 LAND SURVEYOR
 11-8

- ① ADJUST MANHOLE FRAME AND COVER TO GRADE AS PER CITY OF ALB. STD. DWG. F-1.
- ② ADJUST WATER VALVE BOX AND COVER TO GRADE AS PER CITY OF ALB. STD. DWGS. W-2, W-3, W-26 and P-24.
- ③ REMOVE AND DISPOSE OF EXISTING ASPHALT AND/OR CONCRETE CURB.
- ④ REMOVE AND REPLACE EXISTING ASPHALTIC CONCRETE PAVING AT LOCATIONS APPROVED BY FIELD ENGINEER.
- ⑤ CONNECT NEW CONCRETE MEDIAN CURB AND GUTTER TO EXISTING CONCRETE CURB AND GUTTER; TOP OF CURB AND FLOWLINE ELEVATIONS SHALL MATCH.
- ⑥ TRAFFIC SIGNAL PULL BOXES SHALL BE INSTALLED AT THE STATIONS INDICATED, AS PER CITY OF ALBUQUERQUE STANDARD DRAWING T- 4-1.
- ⑦ TRAFFIC SIGNAL MANHOLES SHALL BE INSTALLED AT THE STATIONS INDICATED, AS PER CITY OF ALBUQUERQUE STANDARD DRAWING T- 4-1.
- ⑧ TRAFFIC SIGNAL COMPUTER INTERCONNECT CONDUIT (2" RIGID) SHALL BE INSTALLED AT THE LOCATIONS INDICATED.
- ⑨ EXISTING TRAFFIC SIGNAL PULLBOXES SHALL BE REMOVED AND RELOCATED TO THE STATIONS INDICATED. COMPUTER INTERCONNECT CONDUIT (2" RIGID) SHALL BE RECONNECTED USING A SWEEP BEND.
- ⑩ EXISTING TRAFFIC SIGNAL CONDUIT.
- ⑪ ALL EXISTING TRAFFIC SIGNAL EQUIPMENT (EXCEPT PULL BOXES) AND REGULATORY SIGNS THAT NEED TO BE RELOCATED SHALL BE DONE BY THE TRAFFIC ENGINEERING DIVISION WITH 2 DAYS NOTICE.
- ⑫ FIND AND INSTALL 1" SERVICE LINE INCLUDING SADDLE AT THE STATIONS INDICATED. REMOVE AND REPLACE EXISTING PAVING IMPROVEMENTS AS NECESSARY.
- ⑬ INSTALL CURB STOP AND CURB BOX AT THE STATIONS INDICATED AS PER DETAIL (L).

SURVEY INFORMATION			BENCH MARKS		AS BUILT INFORMATION	
NO.	BY	DATE	FIELD NOTES		CONTRACTOR	DATE
			AN 4C-5 BRASS TABLET STAMPED "G-021,"			
			1975 4C5 "1," SET IN 4 CONCRETE CYLINDERS			
			IN THE GROUND. LOCATED 644' WEST OF THE			
			CENTERLINE OF EUBANK BLVD. N.E. AND			
			40' NORTH OF THE CENTERLINE OF CANOE -			
			LARIA ROAD N/E ON THE NOSE OF THE WEST			
			MEDIAN CURB			
			ELEVATION = 5508.42'.			

A circular professional engineer seal for the State of Maryland. The outer ring contains the text "PROFESSIONAL ENGINEER" at the top and "STATE OF MARYLAND" at the bottom. Inside the ring, the name "THOMAS T. MANN, JR." is printed. Below the name, the license number "9607" is visible. A large, stylized signature is written across the center of the seal. To the left of the seal, the words "ENGINEER'S SEAL" are printed vertically.

[illegible]

ERQUE		
ARTMENT		
AD NE		
A 22+00		
PROVALS	ENGINEER	DATE
Waste		
c		
1	SHEET 8	OF 27


CITY OF ALBUQUERQUE
TRANSPORTATION DEPARTMENT

TITLE: CANDELARIA ROAD NE
STA. 10+00 TO STA. 22+00


APPROVALS	ENGINEER	DATE	APPROVALS	ENGINEER	DATE
City Engineer			Liquid Waste		
A C E - Design			Traffic		
A C E - Hydrology			Water		

DRAWING NO.	1619	MAP NO.	G · 21	SHEET	8	OF	27
-------------	------	---------	--------	-------	---	----	----


NOTE: SURVEY BASELINE IS CENTERLINE OF CANDELARIA ROAD NE.
ALL SHADED AREAS REPRESENT EXISTING MEDIANS. THESE AREAS WILL BE REPLACED WITH ARTERIAL TYPE ASPHALTIC PAVEMENT.

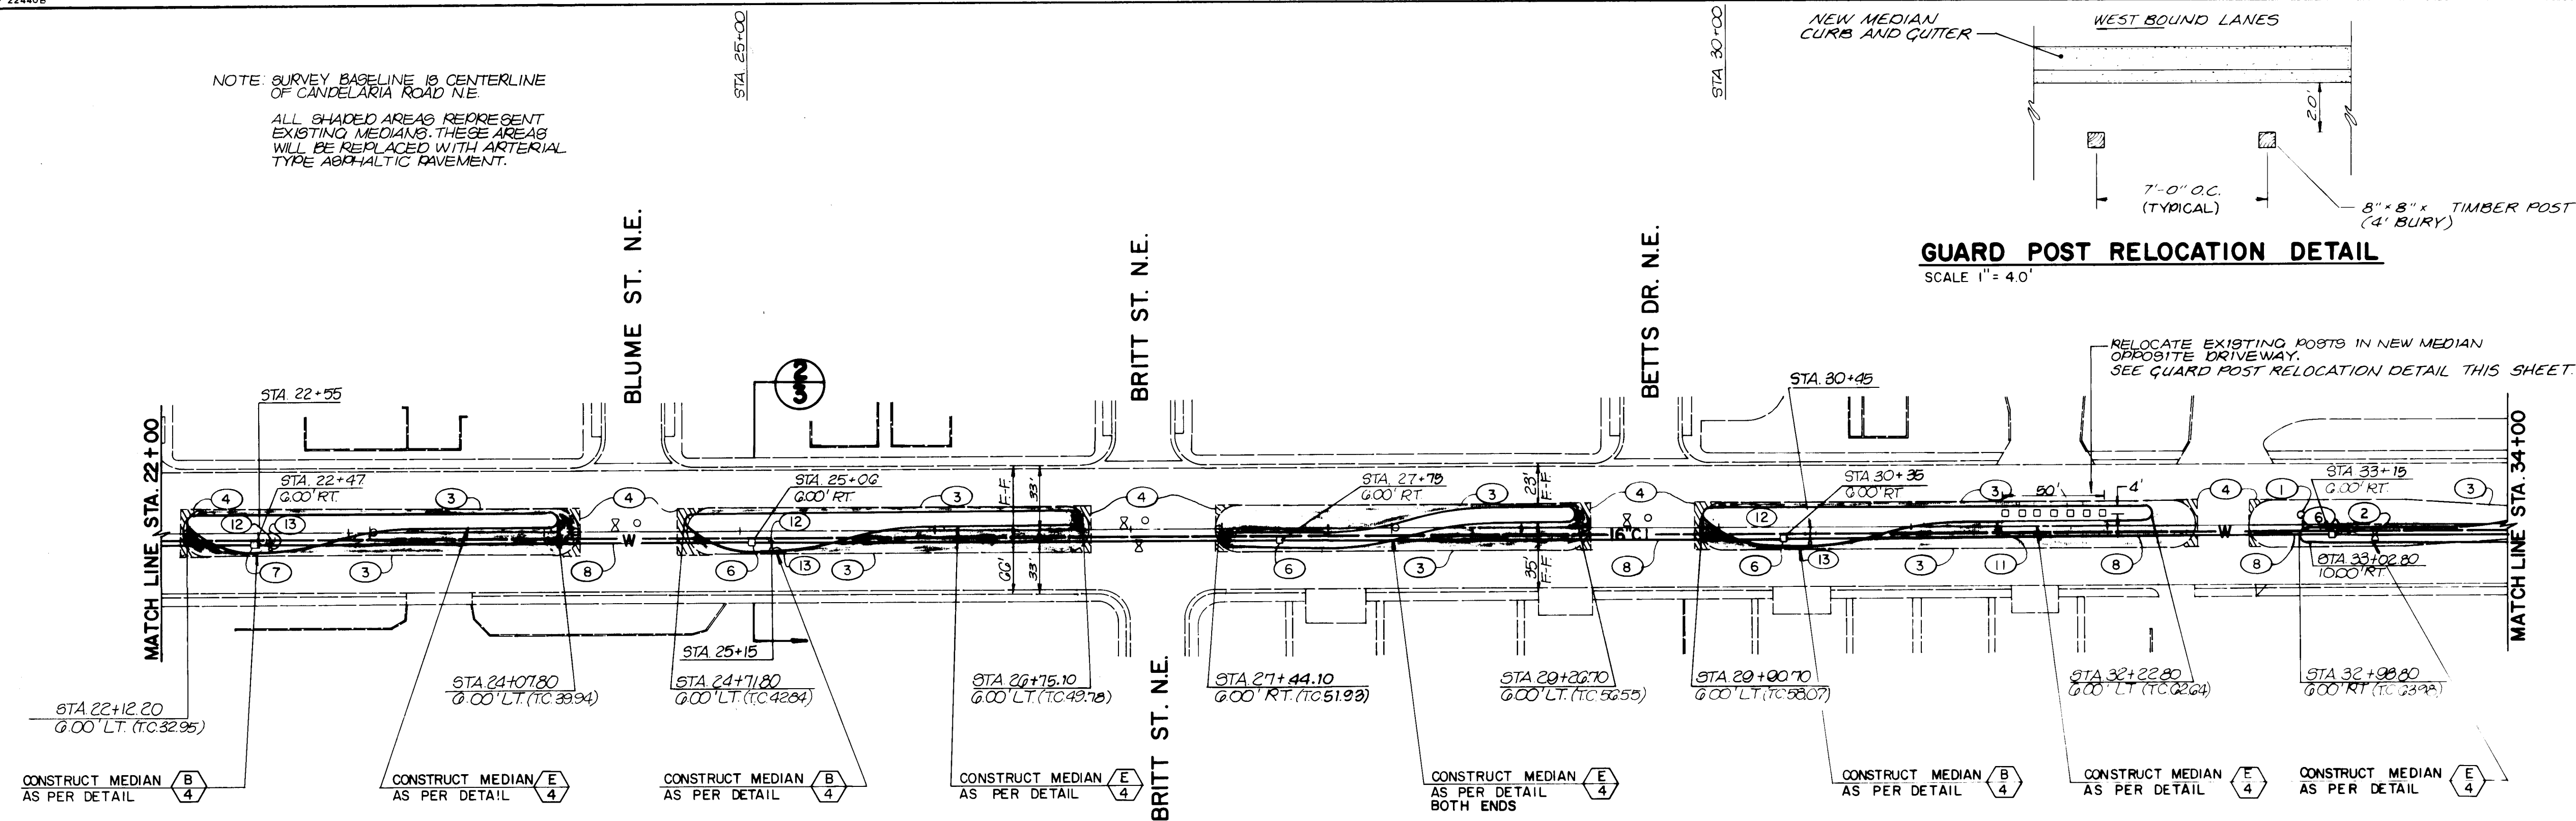

"AS-BUILT" NOTE: THIS DRAWING INDICATES THE "AS-BUILT" CONDITIONS TO THE BEST OF MY KNOWLEDGE AND BELIEF. THE "AS-BUILT" INFORMATION FOR THIS DRAWING WAS SUPPLIED BY THE CITY OF ALBUQUERQUE.

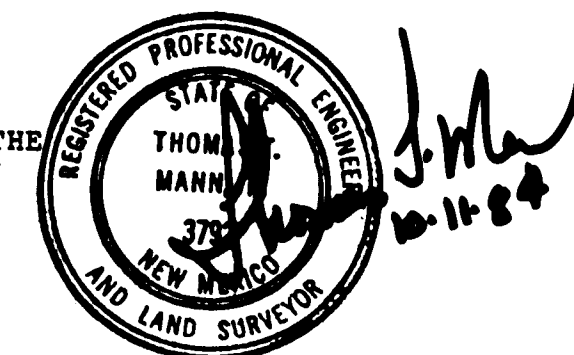

HORIZ. SCALE 1" = 40'
VERT. SCALE 1" = 10'

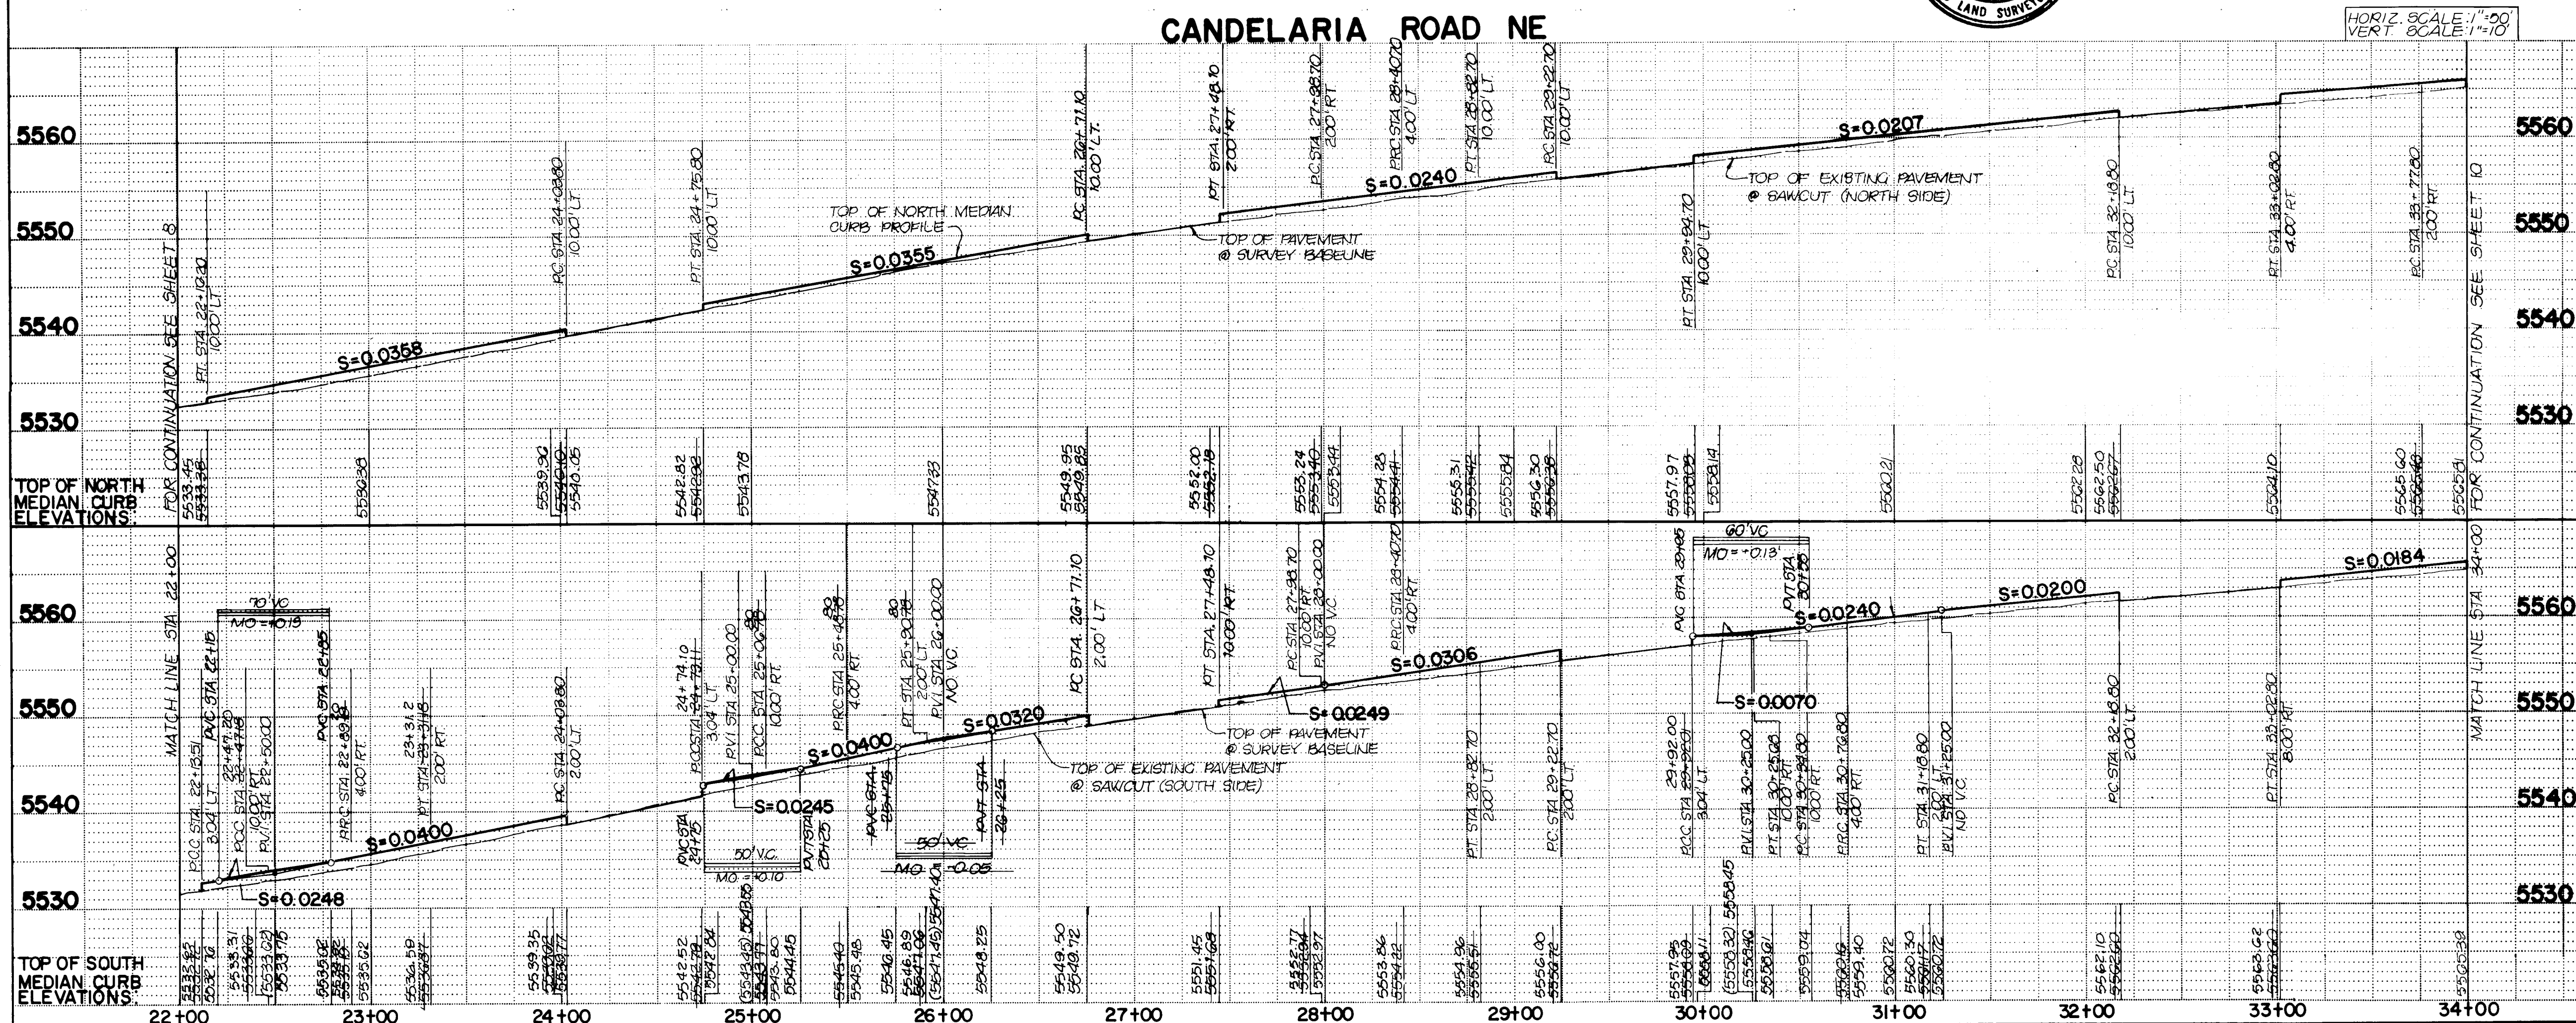

KEYED NOTES

- ADJUST MANHOLE FRAME AND COVER TO GRADE AS PER CITY OF ALB. STD. DWG P-24.
- ADJUST WATER VALVE BOX AND COVER TO GRADE AS PER CITY OF ALB. STD. DWG. W-2, W-3, W-26 and P-24.
- REMOVE AND DISPOSE OF EXISTING ASPHALT AND/OR CONCRETE CURB.
- REMOVE AND REPLACE EXISTING ASPHALTIC CONCRETE PAVING AT LOCATIONS APPROVED BY FIELD ENGINEER.
- CONNECT NEW CONCRETE MEDIAN CURB AND GUTTER TO EXISTING CONCRETE CURB AND GUTTER; TOP OF CURB AND FLOWLINE ELEVATIONS SHALL MATCH.
- TRAFFIC SIGNAL PULL BOXES SHALL BE INSTALLED AT THE STATIONS INDICATED, AS PER CITY OF ALBUQUERQUE STANDARD DRAWING T-4-1.
- TRAFFIC SIGNAL MANHOLES SHALL BE INSTALLED AT THE STATIONS INDICATED, AS PER CITY OF ALBUQUERQUE STANDARD DRAWING T-13.
- TRAFFIC SIGNAL COMPUTER INTERCONNECT CONDUIT (2" RIGID) SHALL BE INSTALLED AT THE LOCATIONS INDICATED.
- EXISTING TRAFFIC SIGNAL PULLBOXES SHALL BE REMOVED AND RELOCATED TO THE STATIONS INDICATED. COMPUTER INTERCONNECT CONDUIT (2" RIGID) SHALL BE RECONNECTED USING A SWEEP BEND.
- EXISTING TRAFFIC SIGNAL CONDUIT. ALL EXISTING TRAFFIC SIGNAL EQUIPMENT (EXCEPT PULL BOXES) AND REGULATORY SIGNS THAT NEED TO BE RELOCATED SHALL BE DONE BY THE TRAFFIC ENGINEERING DIVISION WITH 2 DAYS NOTICE.
- TAP AND INSTALL 1" SERVICE LINE INCLUDING SADDLE AT THE STATIONS INDICATED. REMOVE AND REPLACE EXISTING PAVING IMPROVEMENTS AS NECESSARY.
- INSTALL CURB STOP AND CURB BOX AT THE STATIONS INDICATED AS PER DETAIL L-4.

AS BUILT INFORMATION			BENCH MARKS			SURVEY INFORMATION			ENGINEER'S SEAL		
CONTRACTOR	DATE	NO.	AN ACS BRASS	TABLET STAMPED	G-021	NO.	DATE	BY	NO.	DATE	BY
INSPECTOR'S	DATE		1075 ACS	SET IN A CONCRETE CYLINDER							
FIELD	DATE		IN THE GROUND	LOCATED 64.4' WEST OF THE							
VERIFICATION BY	DATE		CENTERLINE OF EUBANK BLVD N.E. AND 40'								
CORRECTED BY	DATE		NORTH OF THE CENTERLINE OF CANDELARIA								
MICRO-FILM INFORMATION	DATE		ROAD N.E. ON THE NOSE OF THE WEST MEDIAN								
RECORDED BY	DATE		CURB								
NO.			ELEVATION = 5508.42'								

1 2 3 4 5 6 7 8 9 10 11 12
26 16 19 09 8 5

CITY OF ALBUQUERQUE
TRANSPORTATION DEPARTMENT

TITLE: CANDELARIA ROAD NE
STA 22+00 TO STA 34+00


APPROVALS	ENGINEER	DATE	APPROVALS	ENGINEER	DATE
City Engineer			Liquid Waste		
A C E - Design			Traffic		
A C E - Hydrology			Water		

DRAWING NO. 1619 MAP NO. G-21 SHEET 9 OF 27

NOTE: SURVEY BASE LINE IS CENTERLINE OF CANDELARIA ROAD N.E.

ALL SHADED AREAS REPRESENT EXISTING MEDIAN. THESE AREAS WILL BE REPLACED WITH ARTERIAL TYPE ASPHALTIC PAVEMENT.

CONSTRUCT PINNED CURB TYPE I OVER CONCRETE BOX CULVERT. SEE DETAIL 4 AND SECTION 3.

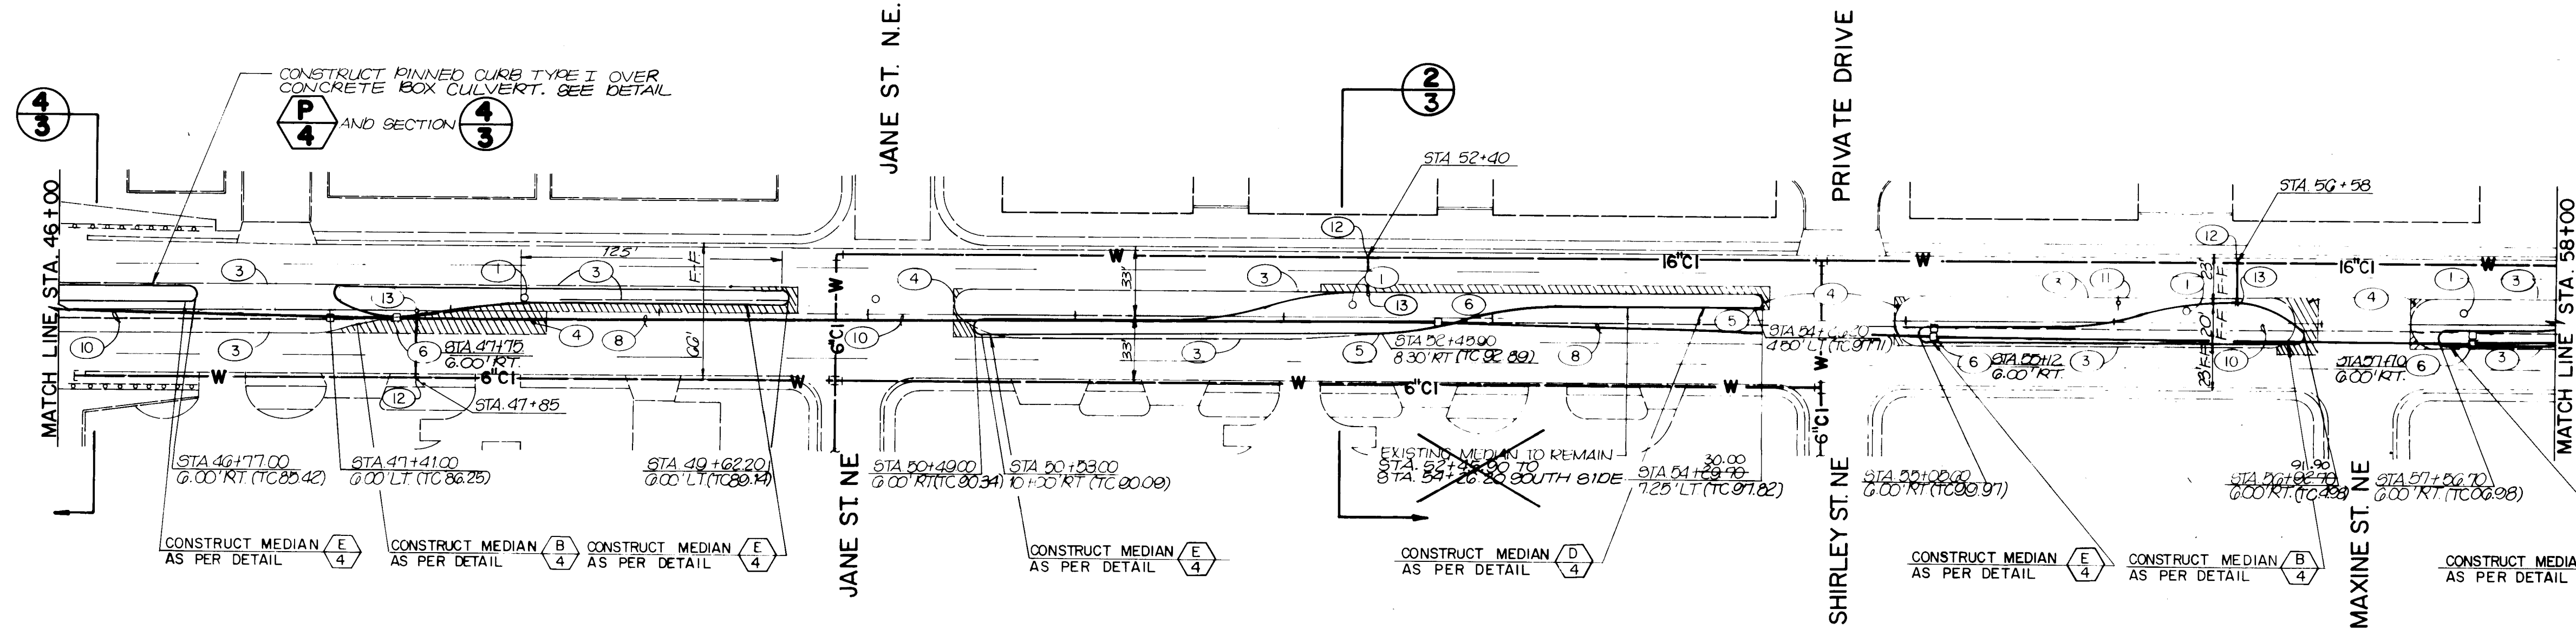

NOTE:


NEW 2" RIGID CONDUIT IS TO BE INSTALLED FROM MORRIS ST. TO JUAN TABO BLVD. EXISTING CONDUIT IS TO BE ABANDONED IN PLACE.

"AS-BUILT"

NOTE: THIS DRAWING INDICATES THE "AS-BUILT" CONDITIONS TO THE BEST OF MY KNOWLEDGE AND BELIEF. THE "AS-BUILT" INFORMATION FOR THIS DRAWING WAS SUPPLIED BY THE CITY OF ALBUQUERQUE.




CANDELARIA ROAD NE

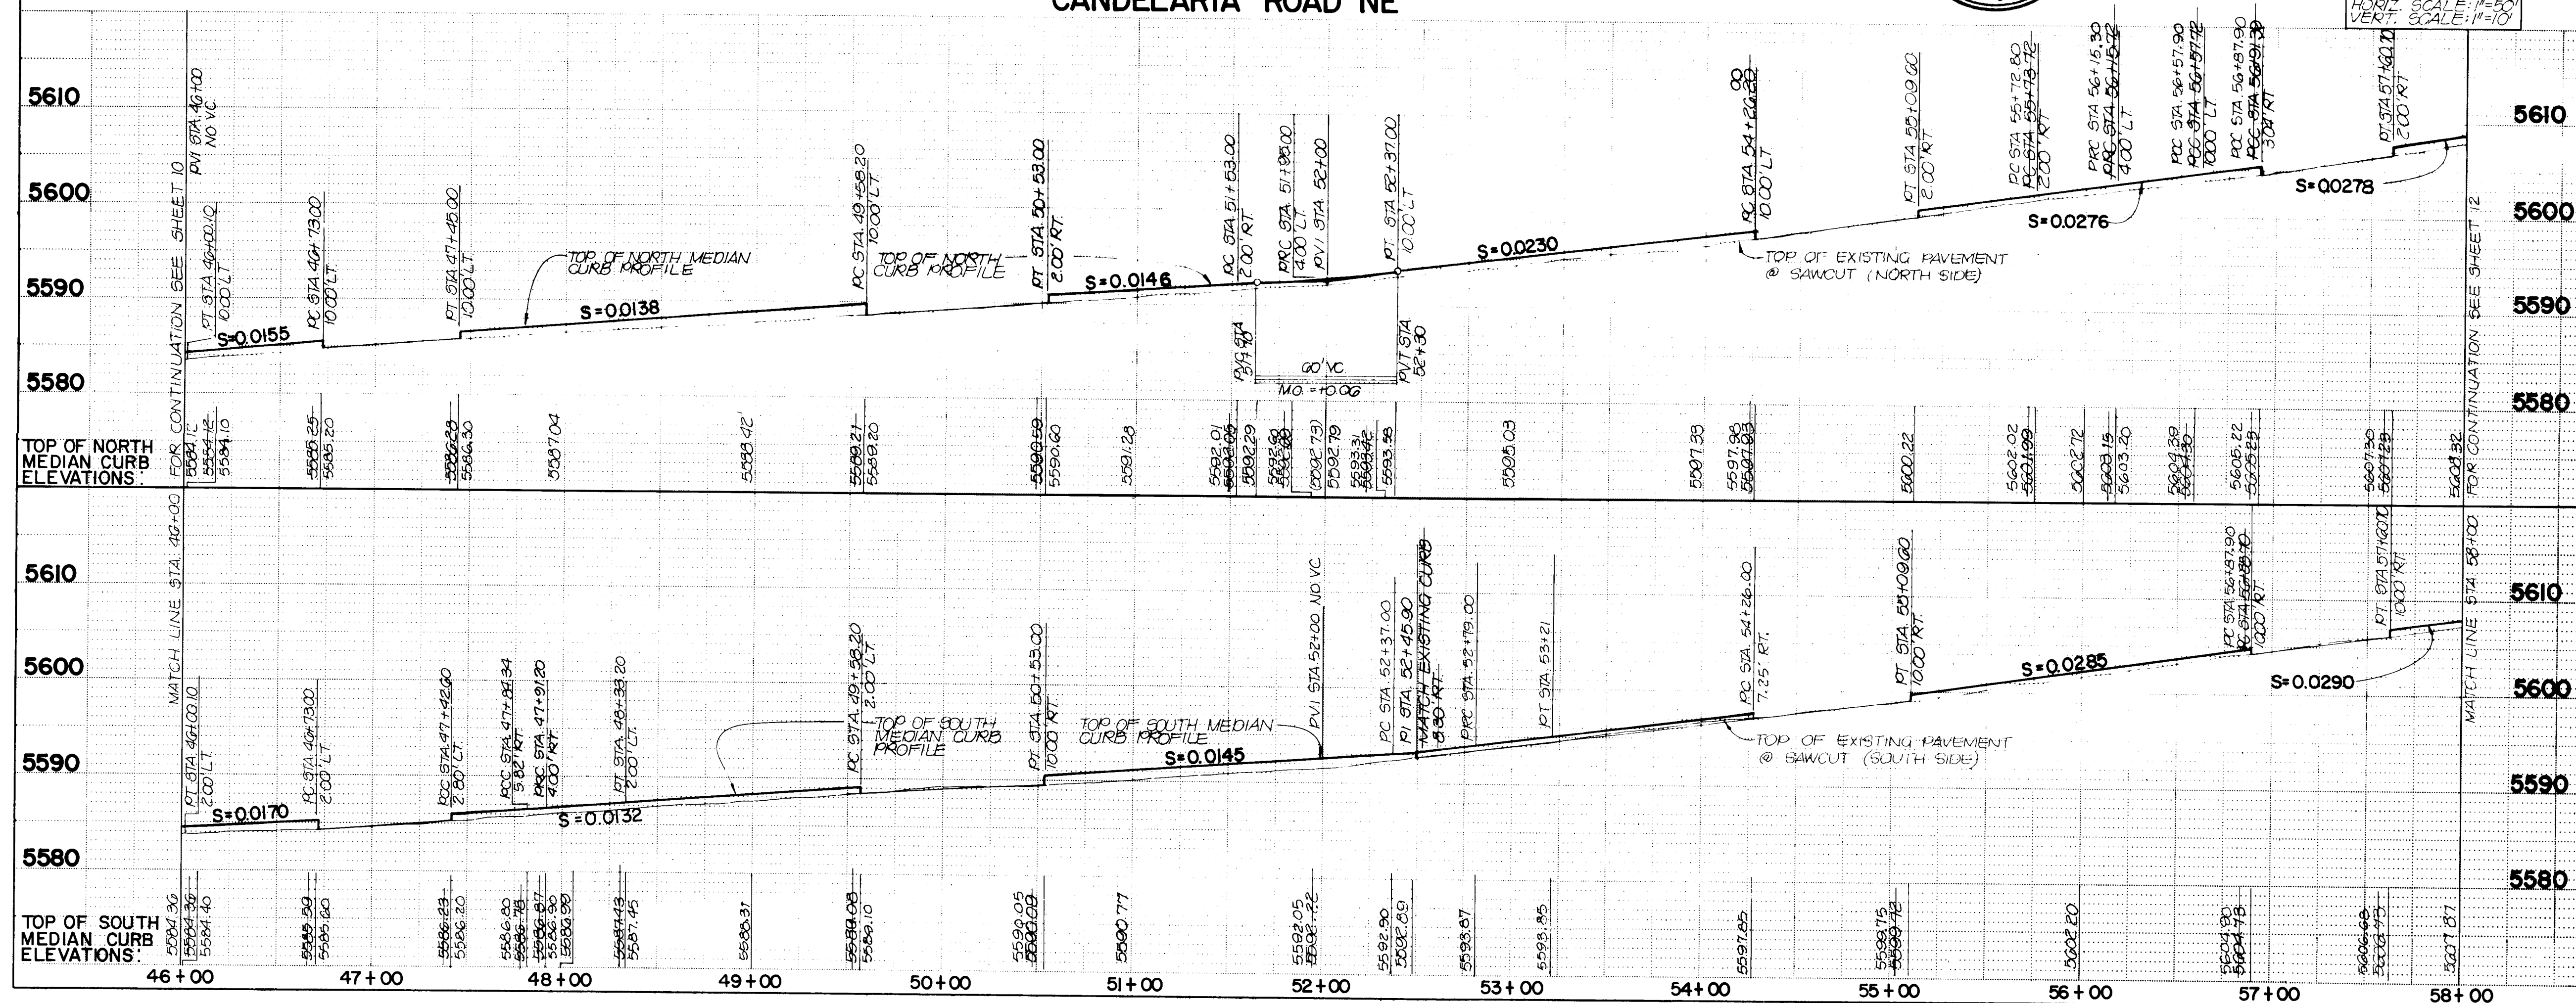

REMARKS

1. ADJUST MANHOLE FRAME AND COVER TO GRADE AS PER CITY OF ALB. STD. DNG P-24.
2. ADJUST WATER VALVE BOX AND COVER TO GRADE AS PER CITY OF ALB. STD. DWGS. W-2, W-3, W-26 and P-24.
3. REMOVE AND DISPOSE OF EXISTING ASPHALT AND/OR CONCRETE CURB.
4. REMOVE AND REPLACE EXISTING ASPHALTIC CONCRETE PAVING AT LOCATIONS APPROVED BY FIELD ENGINEER.
5. CONNECT NEW CONCRETE MEDIAN CURB AND GUTTER TO EXISTING CONCRETE CURB AND GUTTER; TOP OF CURB AND FLOWLINE ELEVATIONS SHALL MATCH.
6. TRAFFIC SIGNAL PULL BOXES SHALL BE INSTALLED AT THE STATIONS INDICATED, AS PER CITY OF ALBUQUERQUE STANDARD DRAWING T-4-1.
7. TRAFFIC SIGNAL MANHOLES SHALL BE INSTALLED AT THE STATIONS INDICATED, AS PER CITY OF ALBUQUERQUE STANDARD DRAWING T-13.
8. TRAFFIC SIGNAL COMPUTER INTERCONNECT CONDUIT (2" RIGID) SHALL BE INSTALLED AT THE LOCATIONS INDICATED.
9. EXISTING TRAFFIC SIGNAL EXISTING TRAFFIC SIGNAL PULLBOXES SHALL BE REMOVED AND RELOCATED TO THE STATIONS INDICATED. COMPUTER INTERCONNECT CONDUIT (2" RIGID) SHALL BE RECONNECTED USING A SWEEP BEND.
10. EXISTING TRAFFIC SIGNAL CONDUIT. ALL EXISTING TRAFFIC SIGNAL EQUIPMENT (EXCEPT PULL BOXES) AND REGULATORY SIGNS THAT NEED TO BE RELOCATED SHALL BE DONE BY THE TRAFFIC ENGINEERING DIVISION WITH 2 DAYS NOTICE.
11. TAP AND INSTALL 1" SERVICE LINE INCLUDING SADDLE AT THE STATIONS INDICATED. REMOVE AND REPLACE EXISTING PAVING IMPROVEMENTS AS NECESSARY.
12. INSTALL CURB STOP AND CURB BOX AT THE STATIONS INDICATED AS PER DETAIL 4.
- 13.

AS BUILT INFORMATION		BENCH MARKS		SURVEY INFORMATION		FIELD NOTES	
CONTRACT NO.	71-AC-3	BEARING	TABLET STAMPED 9-22-1975 ACS	NO.	BY	DATE	DATE
DATE		LOCATED	644' WEST OF THE CENTERLINE OF CANDELARIA ROAD N.E. ON THE NOSE OF THE WEST MEDIAN CURB	NO.	BY	DATE	DATE
DATE		LOCATED	644' WEST OF THE CENTERLINE OF CANDELARIA ROAD N.E. ON THE NOSE OF THE WEST MEDIAN CURB	NO.	BY	DATE	DATE
DATE		LOCATED	644' WEST OF THE CENTERLINE OF CANDELARIA ROAD N.E. ON THE NOSE OF THE WEST MEDIAN CURB	NO.	BY	DATE	DATE
DATE		LOCATED	644' WEST OF THE CENTERLINE OF CANDELARIA ROAD N.E. ON THE NOSE OF THE WEST MEDIAN CURB	NO.	BY	DATE	DATE

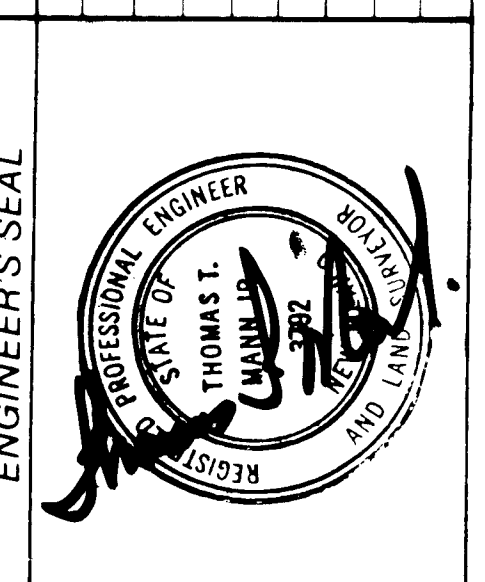

ENGINEER'S SEAL		REMARKS	
NO.	DATE	REMARKS	BY


CITY OF ALBUQUERQUE
TRANSPORTATION DEPARTMENT

TITLE:
CANDELARIA ROAD NE
STA 46+00 TO STA 58+00

APPROVALS	ENGINEER	DATE	APPROVALS	ENGINEER	DATE
City Engineer			Liquid Waste		
A C E - Design			Traffic		
A C E - Hydrology			Water		

DRAWING NO.	1619	MAP NO.	G-21	SHEET	11	OF	27
-------------	------	---------	------	-------	----	----	----


NOTE: SURVEY BASELINE IS THE CENTERLINE OF COMANCHE ROAD N.E.
ALL SHADED AREAS REPRESENT EXISTING MEDIANS. THESE AREAS WILL BE REPLACED WITH ARTERIAL TYPE ASPHALTIC PAVEMENT

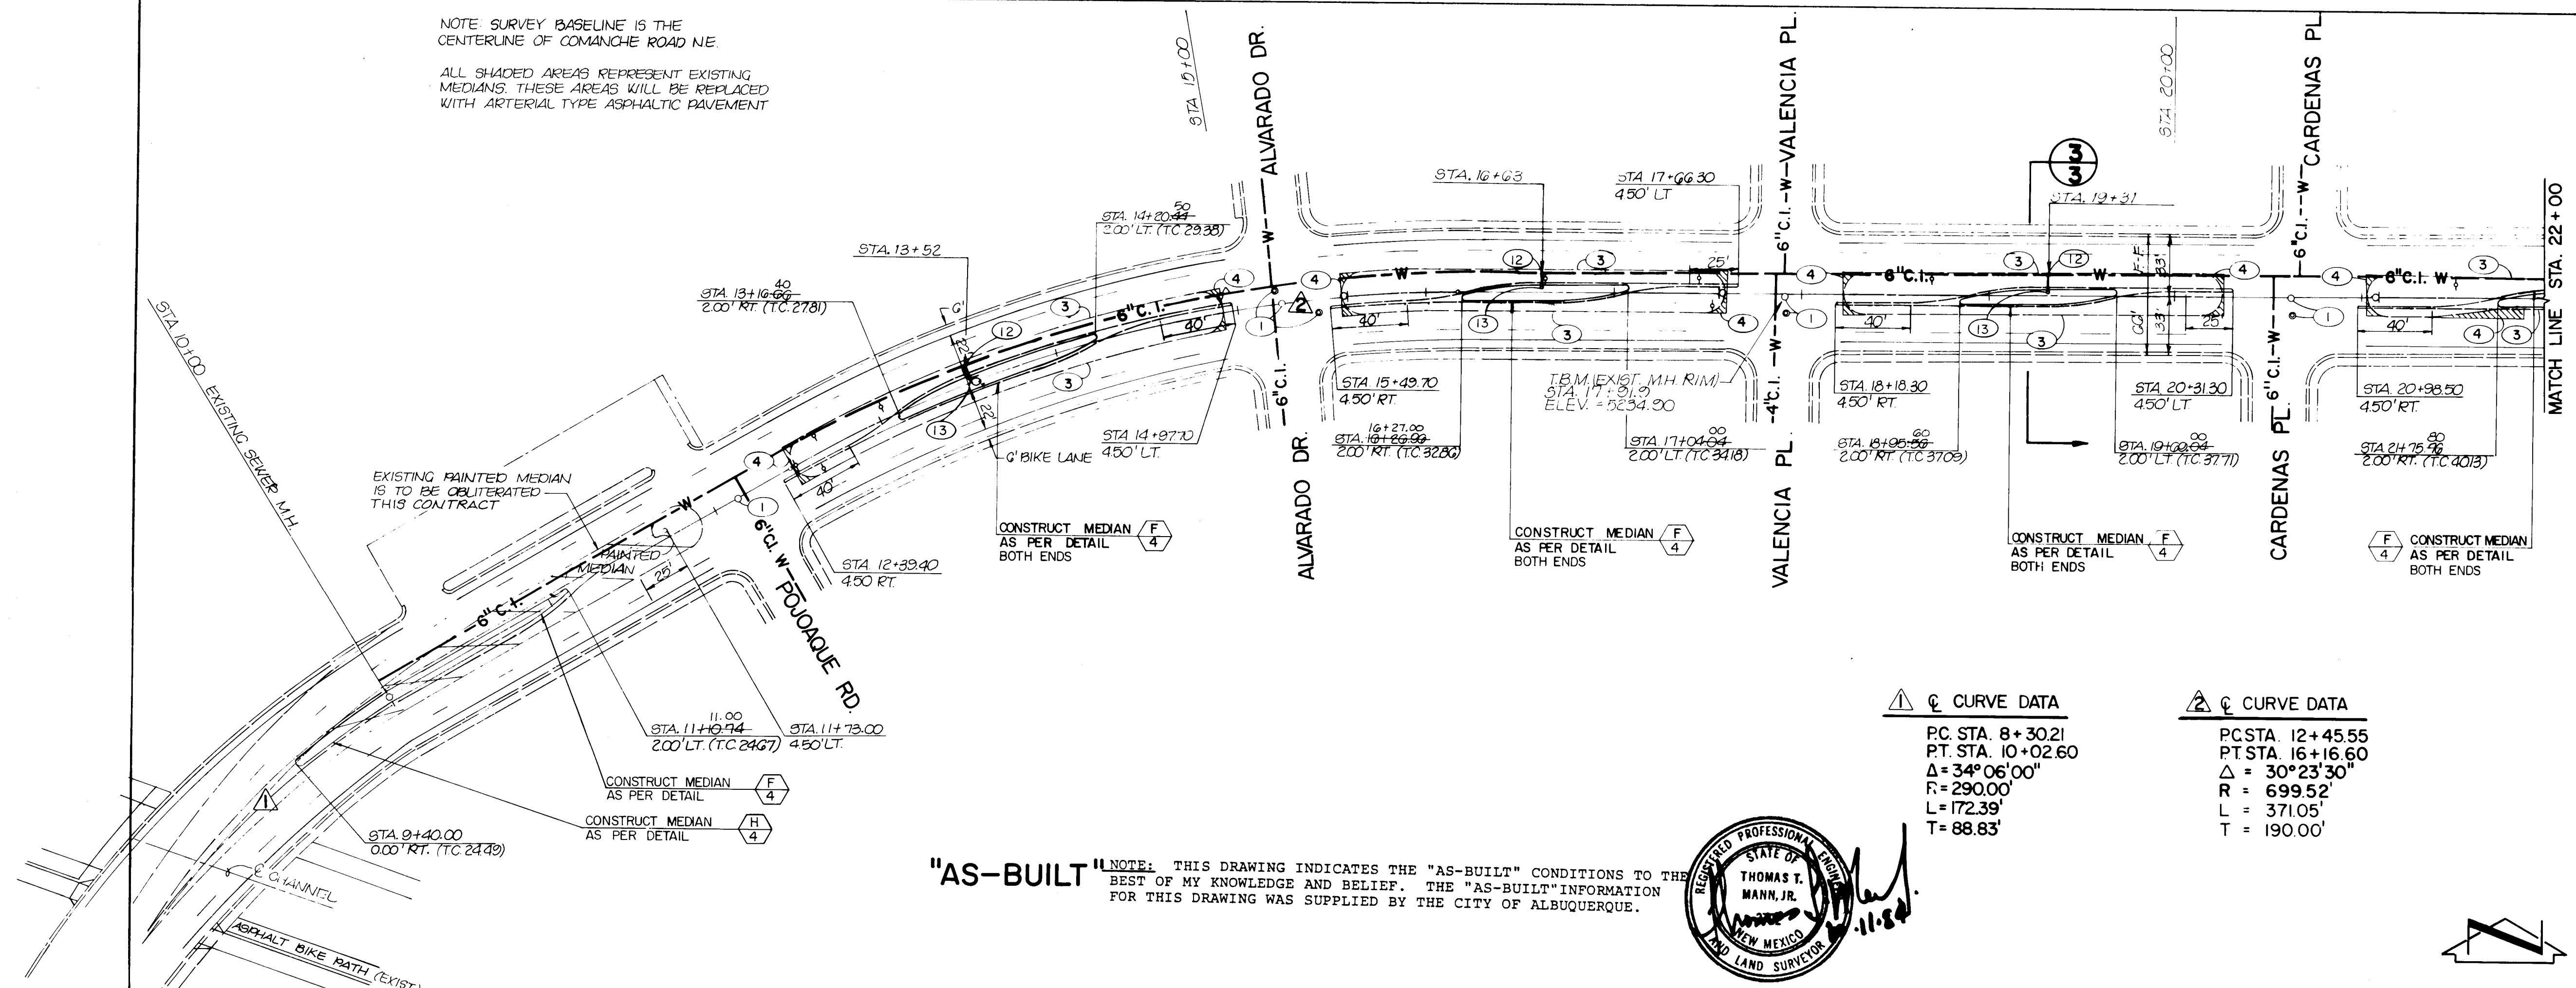

"AS-BUILT" NOTE: THIS DRAWING INDICATES THE "AS-BUILT" CONDITIONS TO THE BEST OF MY KNOWLEDGE AND BELIEF. THE "AS-BUILT" INFORMATION FOR THIS DRAWING WAS SUPPLIED BY THE CITY OF ALBUQUERQUE.



COMANCHE ROAD N.E.

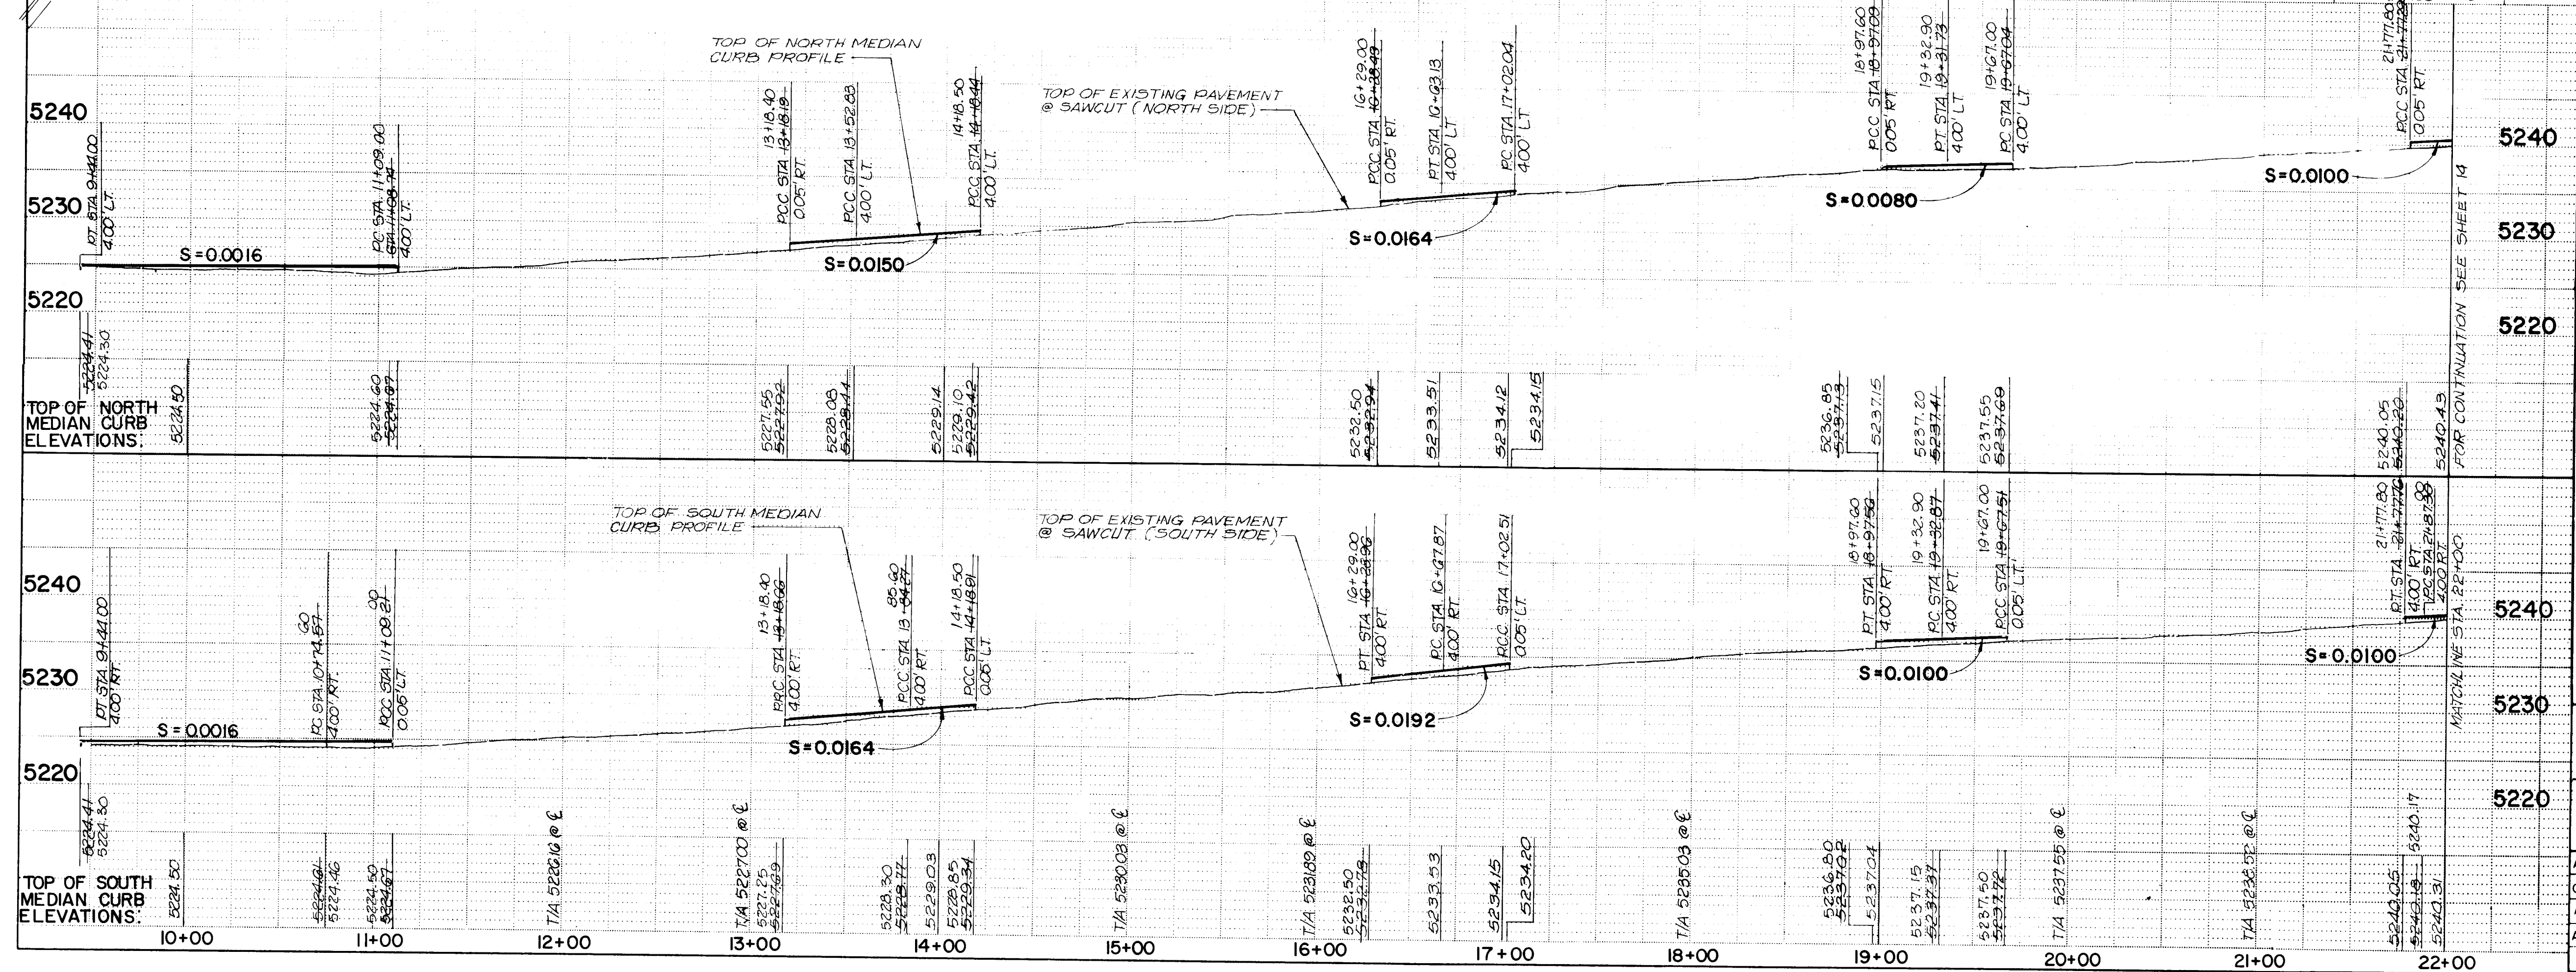

KEYED NOTES

1. ADJUST MANHOLE FRAME AND COVER TO GRADE AS PER CITY OF ALB. STD. DWG P-24.
2. ADJUST WATER VALVE BOX AND COVER TO GRADE AS PER CITY OF ALB. STD. DWGS. W-2, W-3, W-26 and P-24.
3. REMOVE AND DISPOSE OF EXISTING ASPHALT AND/OR CONCRETE CURB.
4. REMOVE AND REPLACE EXISTING ASPHALTIC CONCRETE PAVING AT LOCATIONS APPROVED BY FIELD ENGINEER.
5. CONNECT NEW CONCRETE MEDIAN CURB AND GUTTER TO EXISTING CONCRETE CURB AND GUTTER; TOP OF CURB AND FLOWLINE ELEVATIONS SHALL MATCH.
6. TRAFFIC SIGNAL PULL BOXES SHALL BE INSTALLED AT THE STATIONS INDICATED, AS PER CITY OF ALBUQUERQUE STANDARD DRAWING T-4-1.
7. TRAFFIC SIGNAL MANHOLES SHALL BE INSTALLED AT THE STATIONS INDICATED, AS PER CITY OF ALBUQUERQUE STANDARD DRAWING T-13.
8. TRAFFIC SIGNAL COMPUTER INTERCONNECT CONDUIT (2\" RIGID) SHALL BE INSTALLED AT THE LOCATIONS INDICATED.
9. EXISTING TRAFFIC SIGNAL PULLBOXES SHALL BE REMOVED AND RELOCATED TO THE STATIONS INDICATED. COMPUTER INTERCONNECT CONDUIT (2\" RIGID) SHALL BE RECONNECTED USING A SWEEP BEND.
10. EXISTING TRAFFIC SIGNAL CONDUIT. ALL EXISTING TRAFFIC SIGNAL EQUIPMENT (EXCEPT PULL BOXES) AND REGULATORY SIGNS THAT NEED TO BE RELOCATED SHALL BE DONE BY THE TRAFFIC ENGINEERING DIVISION WITH 2 DAYS NOTICE.
11. TAP AND INSTALL 1\" SERVICE LINE INCLUDING SADDLE AT THE STATIONS INDICATED. REMOVE AND REPLACE EXISTING PAVING IMPROVEMENTS AS NECESSARY.
12. INSTALL CURB STOP AND CURB BOX AT THE STATIONS INDICATED AS PER DETAIL L-4.
- 13.

NOTES

1. IN THE CENTER OF THE ROADWAY (COMANCHE RD.) BETWEEN THE EXISTING MEDIANS A LEVELING SHALL BE PLACED TO MATCH THE EXISTING PAVEMENT FOR THE EAST AND WEST BOUND LANES PRIOR TO APPLYING THE PLANT MIX SEAL COAT. THE LEVELING COURSE SHALL BE A TYPE D ASPHALT DESIGN MIX IN ACCORDANCE WITH SECTION 115. AN EMULSIFIED TACK COAT SHALL BE APPLIED TO THE EDGES AND SURFACE OF THE EXISTING MAT PRIOR TO PLACING THE LEVELING COURSE. THE LEVELING COURSE SHALL BE 1\" THICK AT THE STREET CENTERLINE AND TAPERED TO MATCH THE INSIDE EDGES OF THE EXISTING EAST OR WEST BOUND LANES.


2. PRIOR TO PLACING LEVELING COURSE OR PLANT MIX SEAL COAT THE ROADWAY SURFACE SHALL BE REPAIRED OF POTHoles AND DISTRESSED OR CRACKED AREAS AS PER SECTION 344 OF THE SUPPLEMENTAL TECHNICAL SPECIFICATIONS.

NO.	DATE	REMARKS
1	6/19/13	5

CITY OF ALBUQUERQUE TRANSPORTATION DEPARTMENT					
TITLE: COMANCHE ROAD N.E. STA 10+00 TO STA 22+00					
APPROVALS	ENGINEER	DATE	APPROVALS	ENGINEER	DATE
City Engineer			Liquid Waste		
ACE - Design			Traffic		
ACE - Hydrology			Water		
DRAWING NO.	1619	MAP NO.	G-18	SHEET	13 OF 27

NOTE: SURVEY BASELINE IS THE CENTERLINE OF COMANCHE ROAD N.E.
ALL SHADED AREAS REPRESENT EXISTING MEDIANS. THESE AREAS WILL BE REPLACED WITH ARTERIAL TYPE ASPHALTIC PAVEMENT


Q CURVE DATA
PC STA 25+6755
PT STA 27+9721
Δ = 07°35'40"
R = 1732.68'
L = 229.66'
T = 115.00'

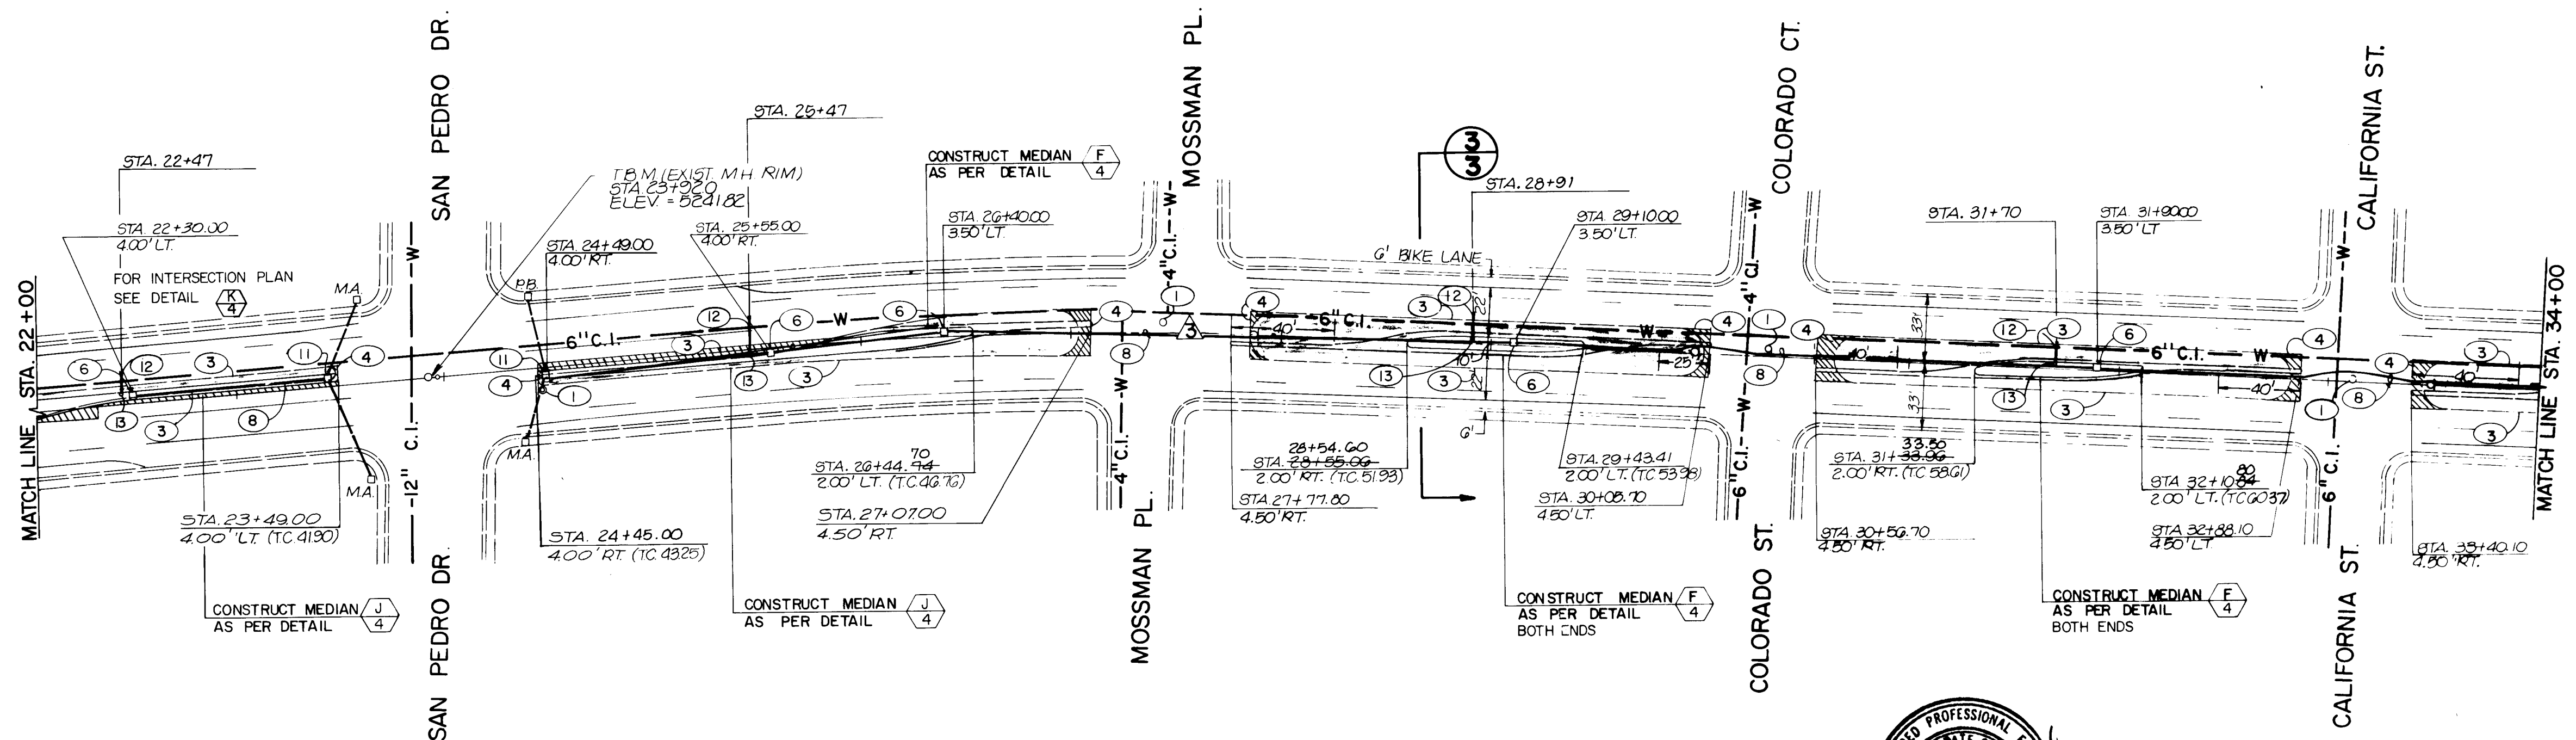

"AS-BUILT" NOTE: THIS DRAWING INDICATES THE "AS-BUILT" CONDITIONS TO THE BEST OF MY KNOWLEDGE AND BELIEF. THE "AS-BUILT" INFORMATION FOR THIS DRAWING WAS SUPPLIED BY THE CITY OF ALBUQUERQUE.



COMANCHE ROAD N.E.

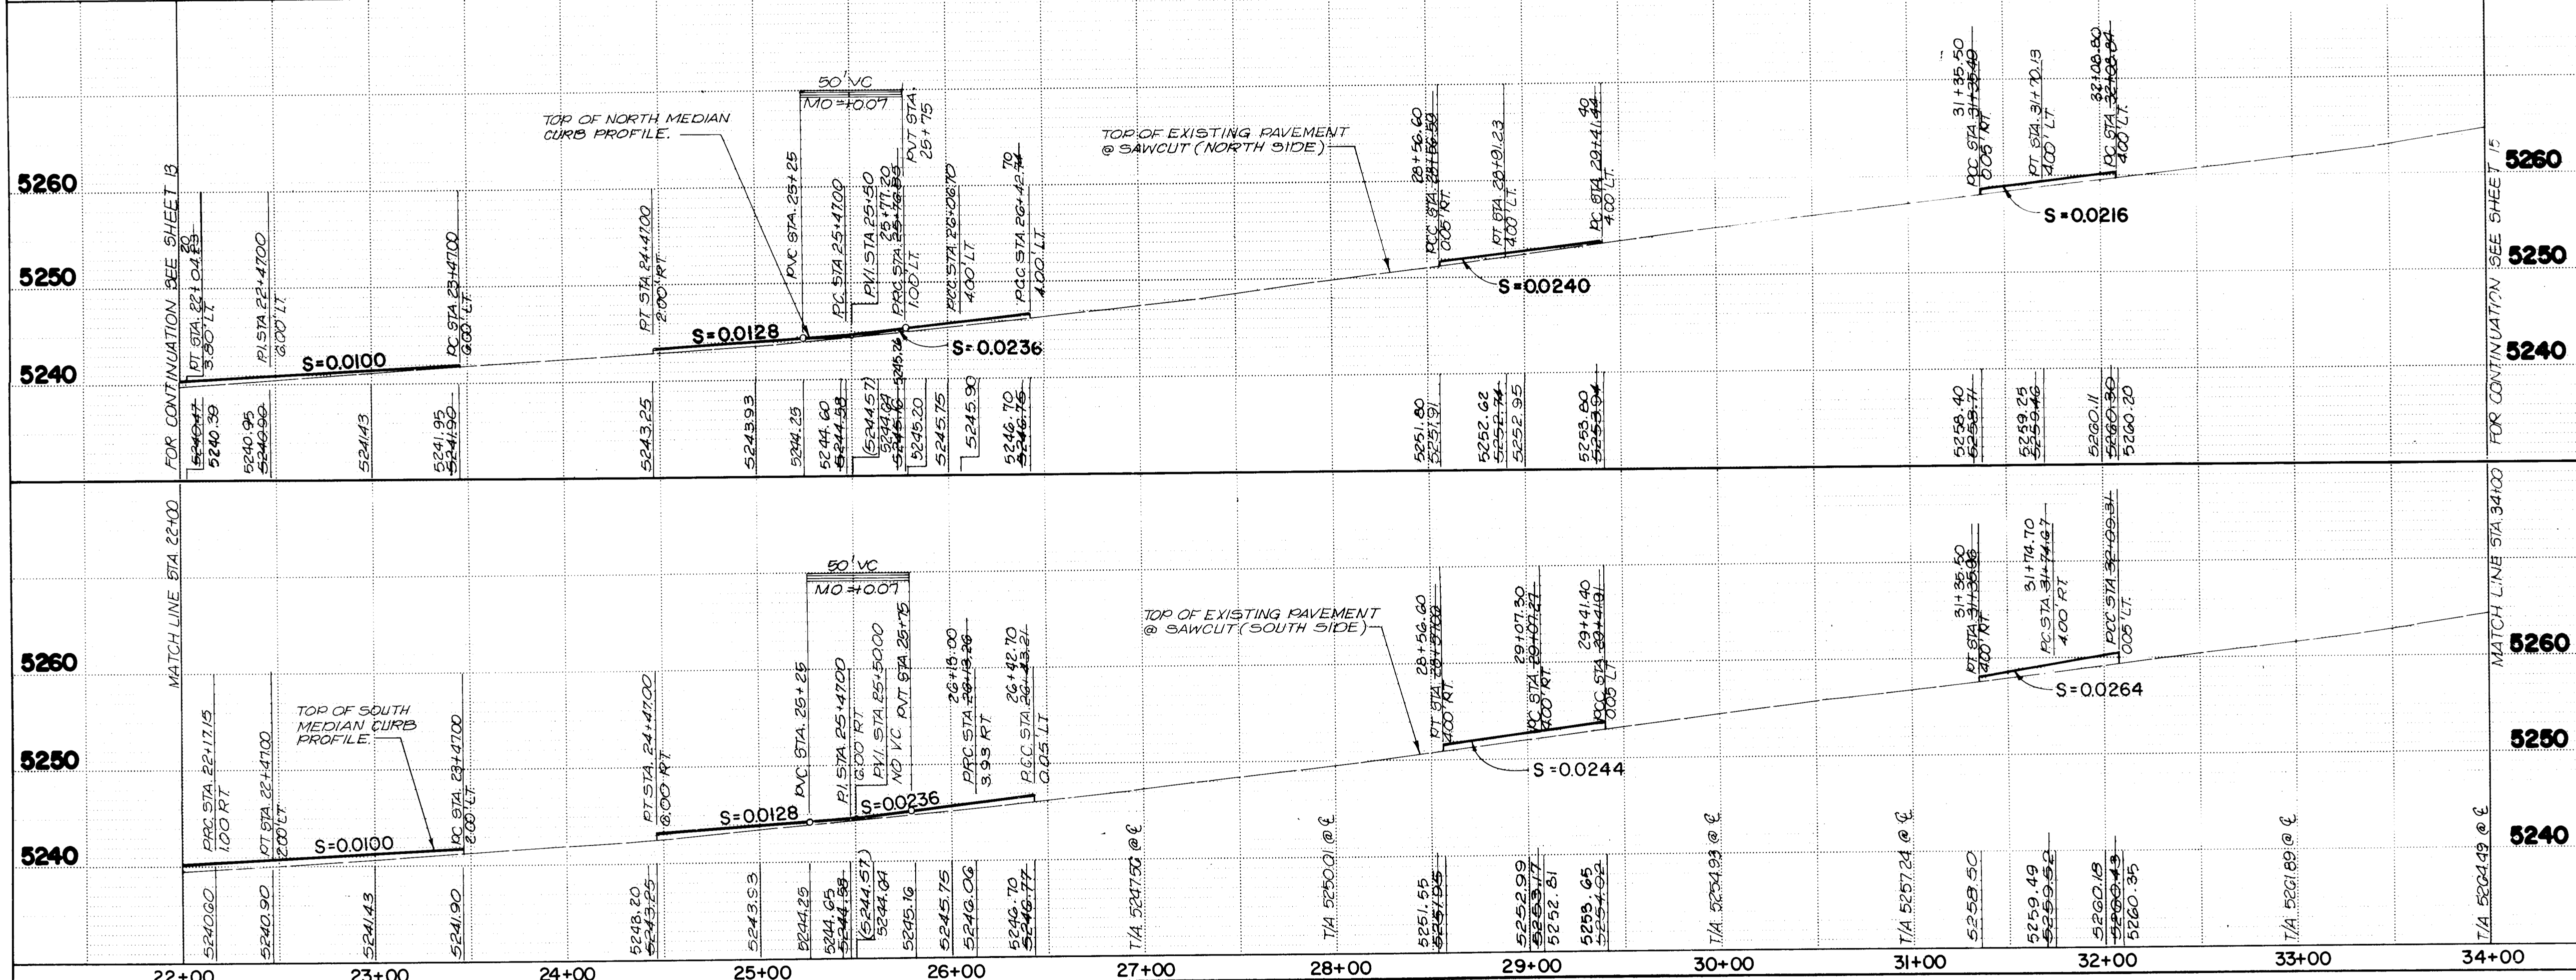

KEYED NOTES

- ADJUST MANHOLE FRAME AND COVER TO GRADE AS PER CITY OF ALB. STD. DWG P-24.
- ADJUST WATER VALVE BOX AND COVER TO GRADE AS PER CITY OF ALB. STD. DWGS. W-2, W-3, W-26 and P-24.
- REMOVE AND DISPOSE OF EXISTING ASPHALT AND/OR CONCRETE CURB.
- REMOVE AND REPLACE EXISTING ASPHALTIC CONCRETE PAVING AT LOCATIONS APPROVED BY FIELD ENGINEER.
- CONNECT NEW CONCRETE MEDIAN CURB AND GUTTER TO EXISTING CONCRETE CURB AND GUTTER; TOP OF CURB AND FLOWLINE ELEVATIONS SHALL MATCH.
- TRAFFIC SIGNAL PULL BOXES SHALL BE INSTALLED AT THE STATIONS INDICATED, AS PER CITY OF ALBUQUERQUE STANDARD DRAWING T-4-1.
- TRAFFIC SIGNAL MANHOLES SHALL BE INSTALLED AT THE STATIONS INDICATED, AS PER CITY OF ALBUQUERQUE STANDARD DRAWING T-13.
- TRAFFIC SIGNAL COMPUTER INTERCONNECT CONDUIT (2" RIGID) SHALL BE INSTALLED AT THE LOCATIONS INDICATED.
- EXISTING TRAFFIC SIGNAL PULLBOXES SHALL BE REMOVED AND RELOCATED TO THE STATIONS INDICATED. COMPUTER INTERCONNECT CONDUIT (2" RIGID) SHALL BE RECONNECTED USING A SHEEP BEND.
- EXISTING TRAFFIC SIGNAL CONDUIT, ALL EXISTING TRAFFIC SIGNAL EQUIPMENT (EXCEPT PULL BOXES) AND REGULATORY SIGNS THAT NEED TO BE RELOCATED SHALL BE DONE BY THE TRAFFIC ENGINEERING DIVISION WITH 2 DAYS NOTICE.
- TAP AND INSTALL 1" SERVICE LINE INCLUDING SADDLE AT THE STATIONS INDICATED. REMOVE AND REPLACE EXISTING PAVING IMPROVEMENTS AS NECESSARY.
- INSTALL CURB STOP AND CURB BOX AT THE STATIONS INDICATED AS PER DETAIL 4.

NOTES:

IN THE CENTER OF THE ROADWAY (COMANCHE RD.) BETWEEN THE EXISTING MEDIANS A LEVELING SHALL BE PLACED TO MATCH THE EXISTING PAVEMENT FOR THE EAST AND WEST BOUND LANES PRIOR TO APPLYING THE PLANT MIX SEAL COAT. THE LEVELING COURSE SHALL BE A TYPE D ASPHALT DESIGN MIX IN ACCORDANCE WITH SECTION 115. AN EMULSIFIED TACK COAT SHALL BE APPLIED TO THE EDGES AND SURFACE OF THE EXISTING MAT PRIOR TO PLACING THE LEVELING COURSE. THE LEVELING COURSE SHALL BE 1" THICK AT THE STREET CENTERLINE AND TAPERED TO MATCH THE INSIDE EDGES OF THE EXISTING EAST OR WEST BOUND LANES.

2. PRIOR TO PLACING LEVELING COURSE OR PLANT MIX SEAL COAT THE ROADWAY SURFACE SHALL BE REPAIRED OF POTHOLES AND DISTRESSED OR CRACKED AREAS AS PER SECTION 344 OF THE SUPPLEMENTAL TECHNICAL SPECIFICATIONS.



AS BUILT INFORMATION		BENCH MARKS		SURVEY INFORMATION		ENGINEER'S SEAL	
CONTRACT NO.	DATE	ALL AC'S BRASS TABLE STAMPED 4-G204 GET	IN TOP OF CONC. POST, FLUSH W/CURB. LOCATED @ THE E.N.E. QUADRANT OF THE INTERSECTION OF COMANCHE ROAD, N.E. AND WOMING BLVD., N.E.	NO.	DATE	NO.	DATE

CITY OF ALBUQUERQUE
TRANSPORTATION DEPARTMENT

TITLE: COMANCHE ROAD N.E.
STA 22+00 TO STA 34+00

APPROVALS	ENGINEER	DATE	APPROVALS	ENGINEER	DATE
City Engineer			Liquid Waste		
ACE - Design			Traffic		
ACE - Hydrology			Water		

DRAWING NO. 1619 MAP NO. G-18 SHEET 14 OF 27

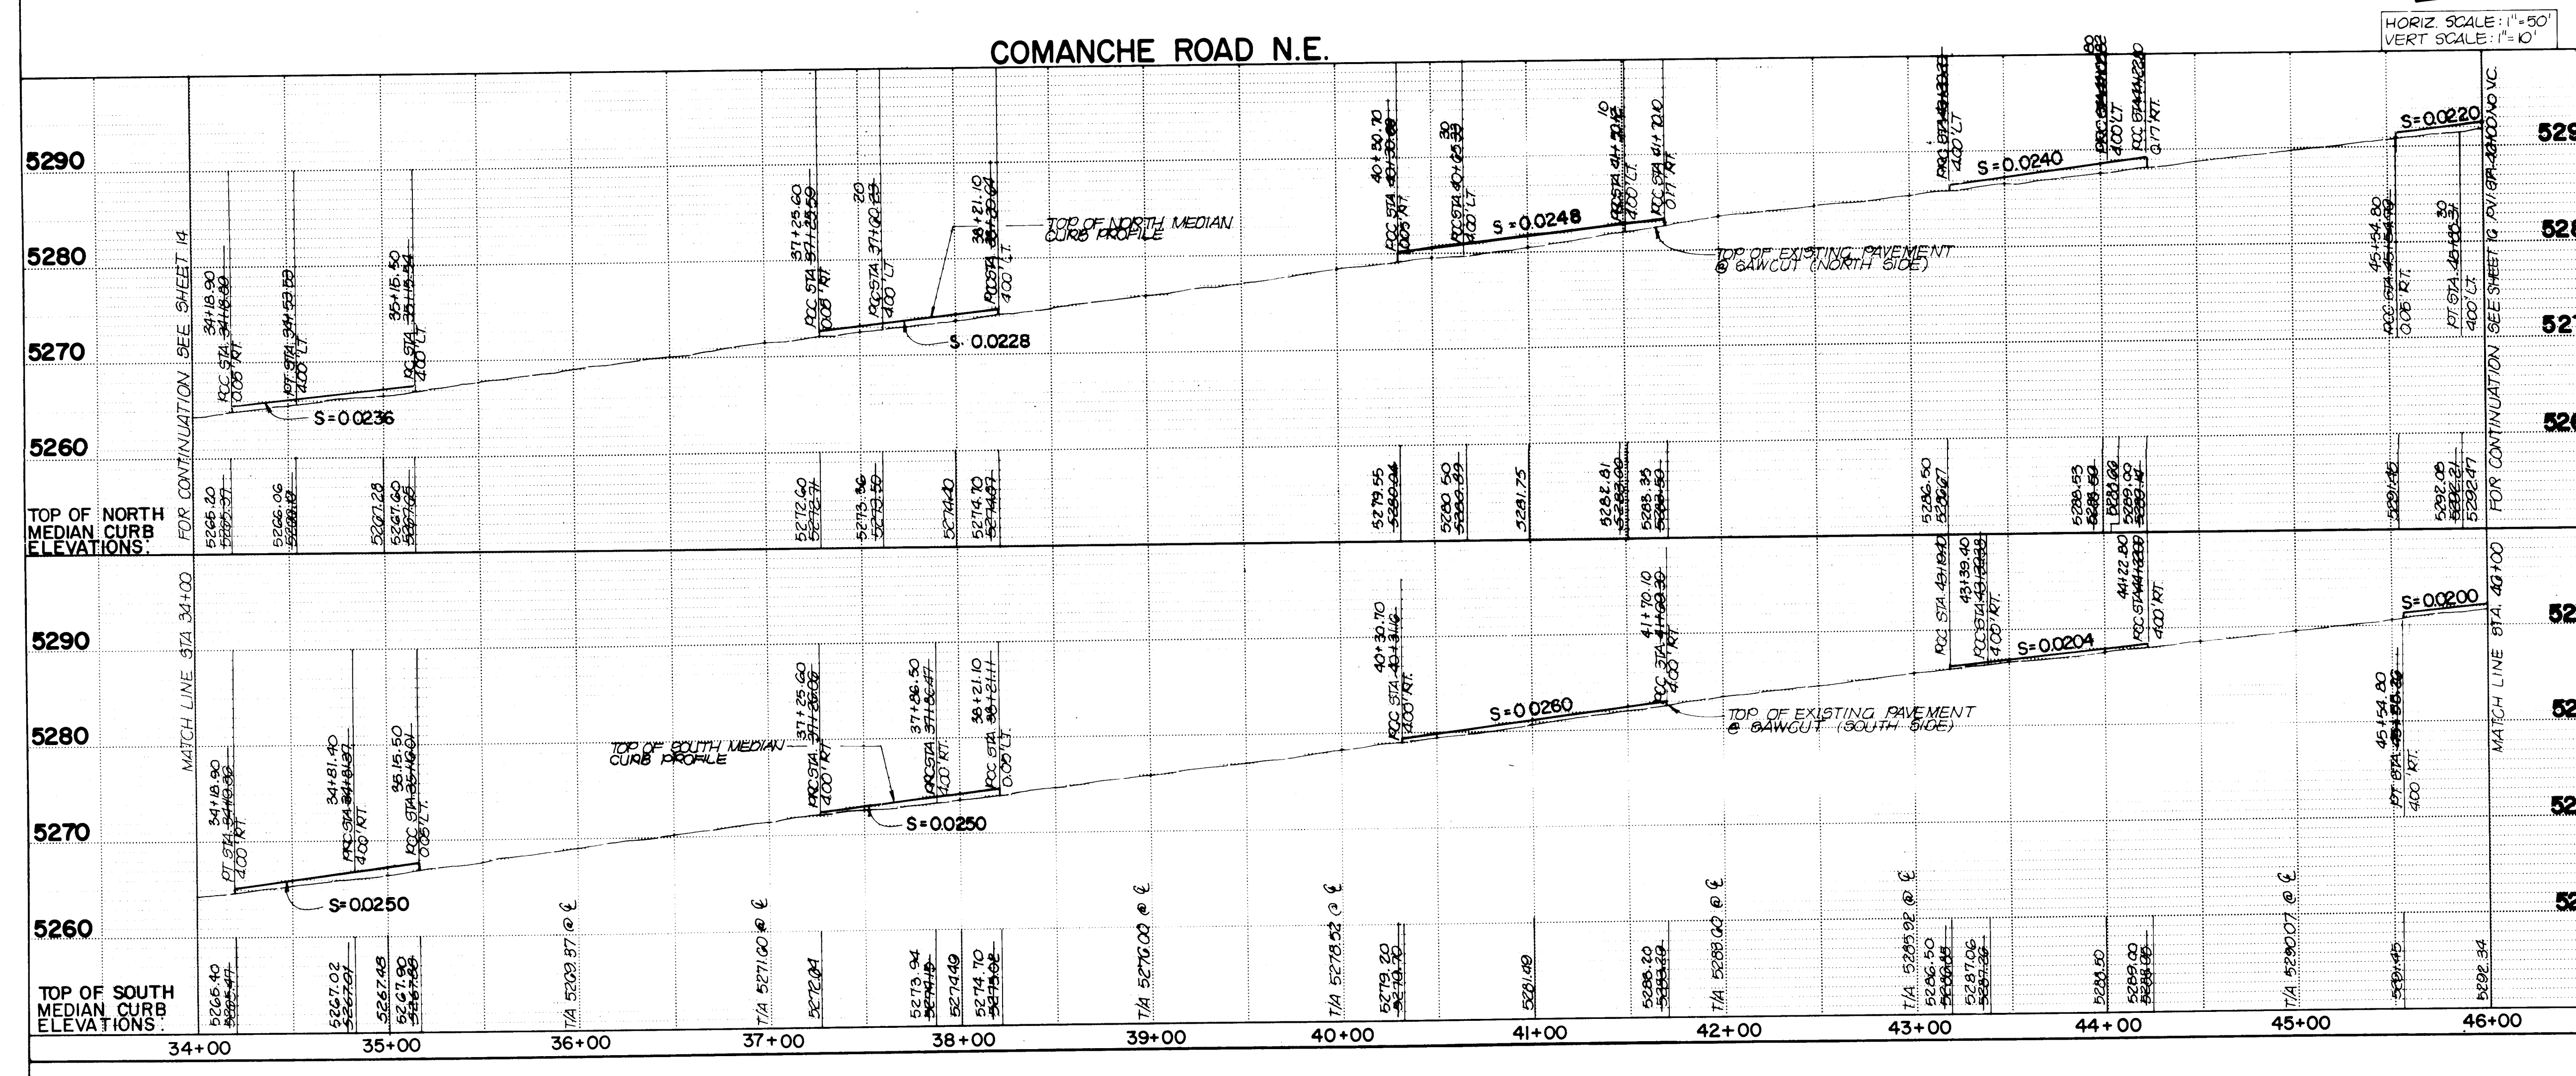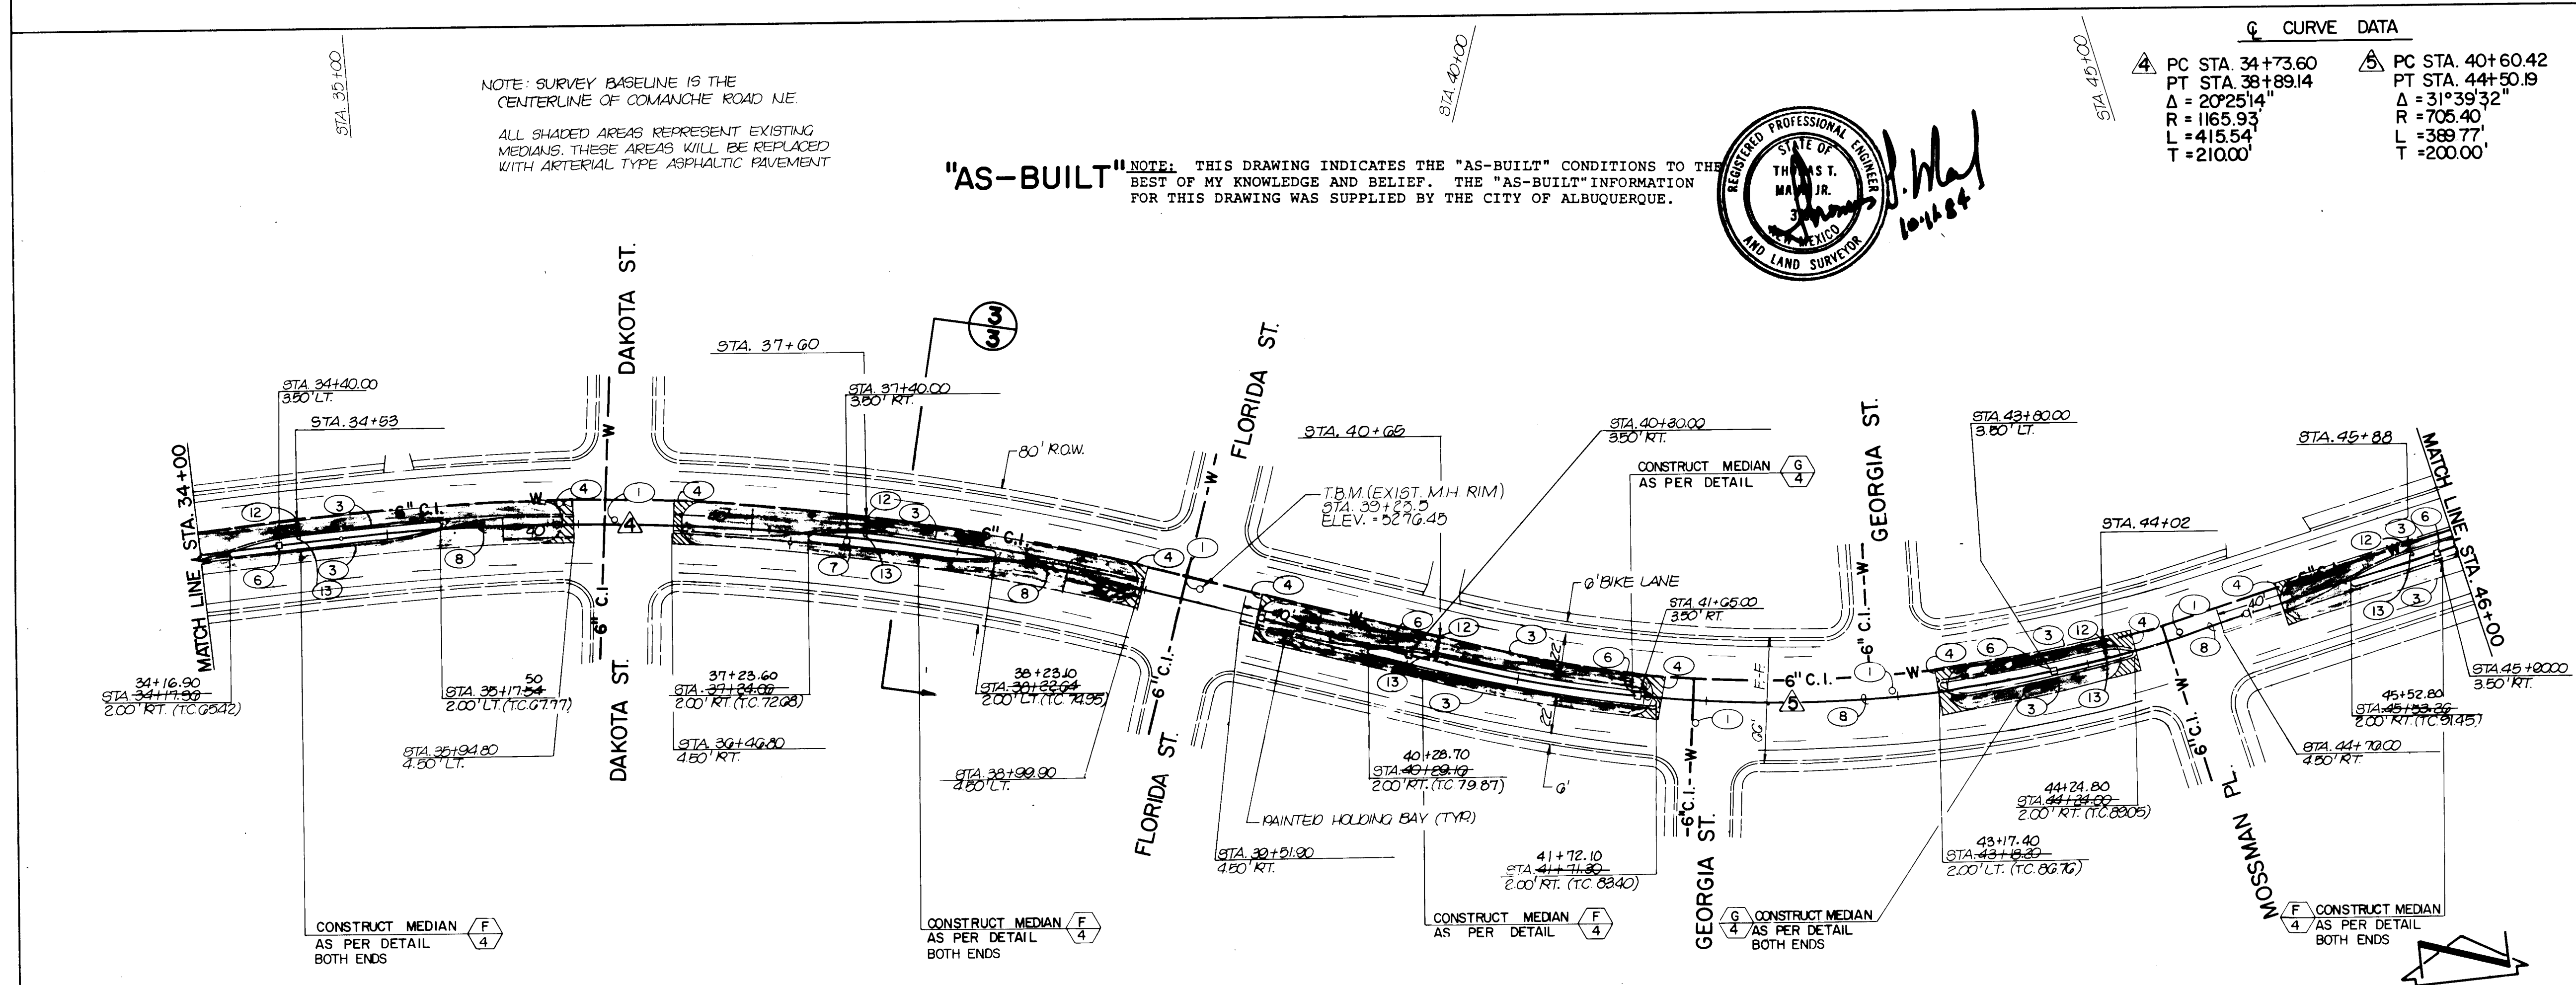


KEYED NOTES			AS BUILT INFORMATION		
1	ADJUST MANHOLE FRAME AND COVER TO GRADE AS PER CITY OF ALB. STD. DWG P-24.	CONTRACTOR	DATE	NO.	DATE
2	ADJUST WATER VALVE BOX AND COVER TO GRADE AS PER CITY OF ALB. STD DWGS. W-2, W-3, W-26 and P-24.	INSPECTOR	DATE	NO.	DATE
3	REMOVE AND DISPOSE OF EXISTING ASPHALT AND/OR CONCRETE CURB.	ACCEPTANCE BY	DATE	NO.	DATE
4	REMOVE AND REPLACE EXISTING ASPHALTIC CONCRETE PAVING AT LOCATIONS APPROVED BY FIELD ENGINEER.	VERIFICATION BY	DATE	NO.	DATE
5	CONNECT NEW CONCRETE MEDIAN CURB AND GUTTER TO EXISTING CONCRETE CURB AND GUTTER; TOP OF CURB AND FLOWLINE ELEVATIONS SHALL MATCH.	COMBINED BY	DATE	NO.	DATE
6	TRAFFIC SIGNAL PULL BOXES SHALL BE INSTALLED AT THE STATIONS INDICATED, AS PER CITY OF ALBUQUERQUE STANDARD DRAWING T-4-1.	RECORDED BY	DATE	NO.	DATE
7	TRAFFIC SIGNAL MANHOLES SHALL BE INSTALLED AT THE STATIONS INDICATED, AS PER CITY OF ALBUQUERQUE STANDARD DRAWING T-13.	NO.	DATE	NO.	DATE
8	TRAFFIC SIGNAL COMPUTER INTERCONNECT CONDUIT (2" RIGID) SHALL BE INSTALLED AT THE LOCATIONS INDICATED.	NO.	DATE	NO.	DATE
9	EXISTING TRAFFIC SIGNAL EQUIPMENT (EXCEPT PULL BOXES) AND REGULATORY SIGNS THAT NEED TO BE RELOCATED SHALL BE DONE BY THE TRAFFIC ENGINEERING DIVISION WITH 2 DAYS NOTICE.	NO.	DATE	NO.	DATE
10	TAP AND INSTALL 1" SERVICE LINE INCLUDING SADDLE AT THE STATIONS INDICATED. REMOVE AND REPLACE EXISTING PAVING IMPROVEMENTS AS NECESSARY.	NO.	DATE	NO.	DATE
11	INSTALL CURB STOP AND CURB BOX AT THE STATIONS INDICATED AS PER DETAIL 4.	NO.	DATE	NO.	DATE
12		NO.	DATE	NO.	DATE
13		NO.	DATE	NO.	DATE

NOTES			ENGINEER'S SEAL		
1. IN THE CENTER OF THE ROADWAY (COMANCHE RD.) BETWEEN THE EXISTING MEDIANS A LEVELING SHALL BE PLACED TO MATCH THE EXISTING PAVEMENT FOR THE EAST AND WEST BOUND LANES PRIOR TO APPLYING THE PLANT MIX SEAL COAT. THE LEVELING COURSE SHALL BE A TYPE D ASPHALT DESIGN MIX IN ACCORDANCE WITH SECTION 115. AN EMULSIFIED TACK COAT SHALL BE APPLIED TO THE EDGES AND SURFACE OF THE EXISTING MAT PRIOR TO PLACING THE LEVELING COURSE. THE LEVELING COURSE SHALL BE 1" THICK AT THE STREET CENTERLINE AND TAPERED TO MATCH THE INSIDE EDGES OF THE EXISTING EAST OR WEST BOUND LANES.			2. PRIOR TO PLACING LEVELING COURSE OR PLANT MIX SEAL COAT THE ROADWAY SURFACE SHALL BE REPAIRED OF POTHOLES AND DISTRESSED OR CRACKED AREAS AS PER SECTION 344 OF THE SUPPLEMENTAL TECHNICAL SPECIFICATIONS.		
CITY OF ALBUQUERQUE TRANSPORTATION DEPARTMENT			COMANCHE ROAD N.E. STA 34+00 TO STA 46+00		
APPROVALS			APPROVALS		
City Engineer	ENGINEER	DATE	Liquid Waste	ENGINEER	DATE
A.C.E. - Design			Traffic		
A.C.E. - Hydrology			Water		
DRAWING NO. 1619			MAP NO. G-18		
SHEET 15			OF 27		

"AS-BUILT" NOTE: THIS DRAWING INDICATES THE "AS-BUILT" CONDITIONS TO THE BEST OF MY KNOWLEDGE AND BELIEF. THE "AS-BUILT" INFORMATION FOR THIS DRAWING WAS SUPPLIED BY THE CITY OF ALBUQUERQUE.

COMANCHE ROAD N.E.

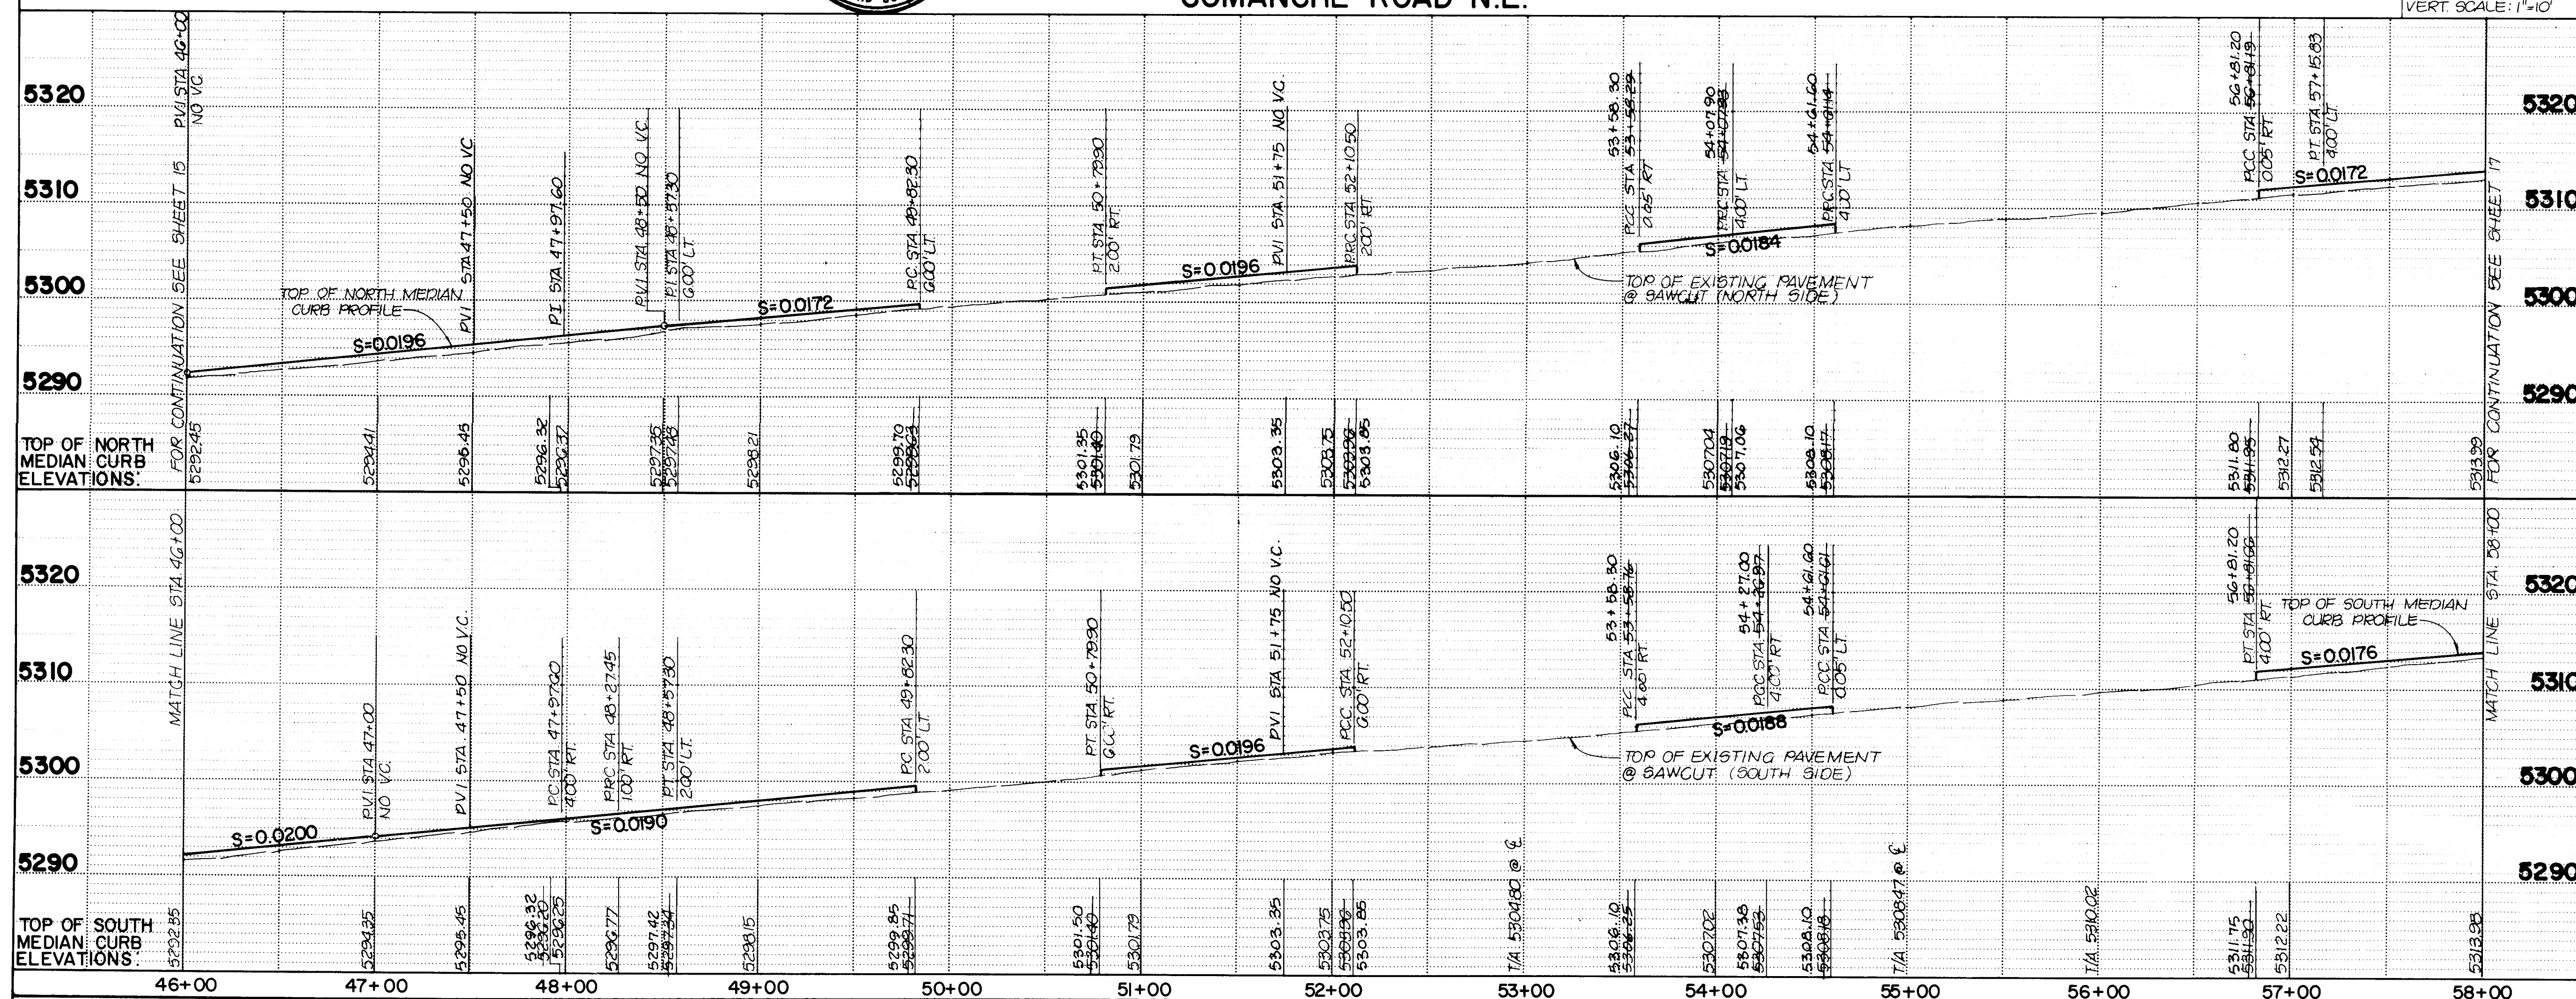

- ① ADJUST MANHOLE FRAME AND COVER TO GRADE AS PER CITY OF ALB. STD. DWG. E-24.
- ② ADJUST WATER VALVE BOX AND COVER TO GRADE AS PER CITY OF ALB. STD. DWGS. W-2, W-3, W-26 and P-24.
- ③ REMOVE AND DISPOSE OF EXISTING ASPHALT AND/OR CONCRETE CURB.
- ④ REMOVE AND REPLACE EXISTING ASPHALTIC CONCRETE PAVING AT LOCATIONS APPROVED BY FIELD ENGINEER.
- ⑤ CONNECT NEW CONCRETE MEDIAN CURB AND GUTTER TO EXISTING CONCRETE CURB AND GUTTER; TOP OF CURB AND FLOWLINE ELEVATIONS SHALL MATCH.
- ⑥ TRAFFIC SIGNAL PULL BOXES SHALL BE INSTALLED AT THE STATIONS INDICATED, AS PER CITY OF ALBUQUERQUE STANDARD DRAWING T-4-1.
- ⑦ TRAFFIC SIGNAL MANHOLES SHALL BE INSTALLED AT THE STATIONS INDICATED, AS PER CITY OF ALBUQUERQUE STANDARD DRAWING T-4-1.
- ⑧ TRAFFIC SIGNAL COMPUTER INTERCONNECT CONDUIT (2" RIGID) SHALL BE INSTALLED AT THE LOCATIONS INDICATED.
- ⑨ EXISTING TRAFFIC SIGNAL PULLBOXES SHALL BE REMOVED AND RELOCATED TO THE STATIONS INDICATED. COMPUTER INTERCONNECT CONDUIT (2" RIGID) SHALL BE RECONNECTED USING A SWEEP BEND.
- ⑩ EXISTING TRAFFIC SIGNAL CONDUIT.
- ⑪ ALL EXISTING TRAFFIC SIGNAL EQUIPMENT (EXCEPT PULL BOXES) AND REGULATORY SIGNS THAT NEED TO BE RELOCATED SHALL BE DONE BY THE TRAFFIC ENGINEERING DIVISION WITH 2 DAYS NOTICE.
- ⑫ REMOVE AND INSTALL 1" SERVICE LINE INCLUDING SADDLE AT THE STATIONS INDICATED. REMOVE AND REPLACE EXISTING PAVING IMPROVEMENTS AS NECESSARY.
- ⑬ INSTALL CURB STOP AND CURB BOX AT THE STATIONS INDICATED AS PER DETAIL 1.

IN THE CENTER OF THE ROADWAY (COMANCHE RD.) BETWEEN THE EXISTING MEDIANS A LEVELING SHALL BE PLACED TO MATCH THE EXISTING PAVEMENT FOR THE EAST AND WEST BOUND LANES PRIOR TO APPLYING THE PLANT MIX SEAL COAT. THE LEVELING COURSE SHALL BE A TYPE D ASPHALT DESIGN MIX IN ACCORDANCE WITH SECTION 115. AN EMULSIFIED TACK COAT SHALL BE APPLIED TO THE EDGES AND SURFACE OF THE EXISTING PAVEMENT PRIOR TO PLACING THE LEVELING COURSE. THE LEVELING COURSE SHALL BE 1" THICK AT THE STREET CENTERLINE AND TAPERED TO MATCH THE INSIDE EDGES OF THE EXISTING EAST OR WEST BOUND LANES.

2 PRIOR TO PLACING LEVELING COURSE OR
PLANT MIX SEAL COAT THE ROADWAY
SURFACE SHALL BE REPAIRED OF
POTHOLES AND DISTRESSED OR CRACKED
AREAS AS PER SECTION 344 OF THE
SUPPLEMENTAL TECHNICAL SPECIFICA-
TIONS.



CITY OF ALBUQUERQUE
TRANSPORTATION DEPARTMENT

TITLE: COMANCHE ROAD NE.
STA46+00 TO STA58+00

APPROVALS	ENGINEER	DATE	APPROVALS	ENGINEER	DATE
City Engineer			Liquid Waste		
A C E - Design			Traffic		
A C E - Hydrology			Water		

DRAWING NO.	1619	MAP NO.	G-18	SHEET	16	OF	27
-------------	------	---------	------	-------	----	----	----

NO.	DATE	REMARKS	BY
B. DALLAS, N.E. - ALBUQUERQUE - NEW MEXICO - 87110 ENGINEERS			

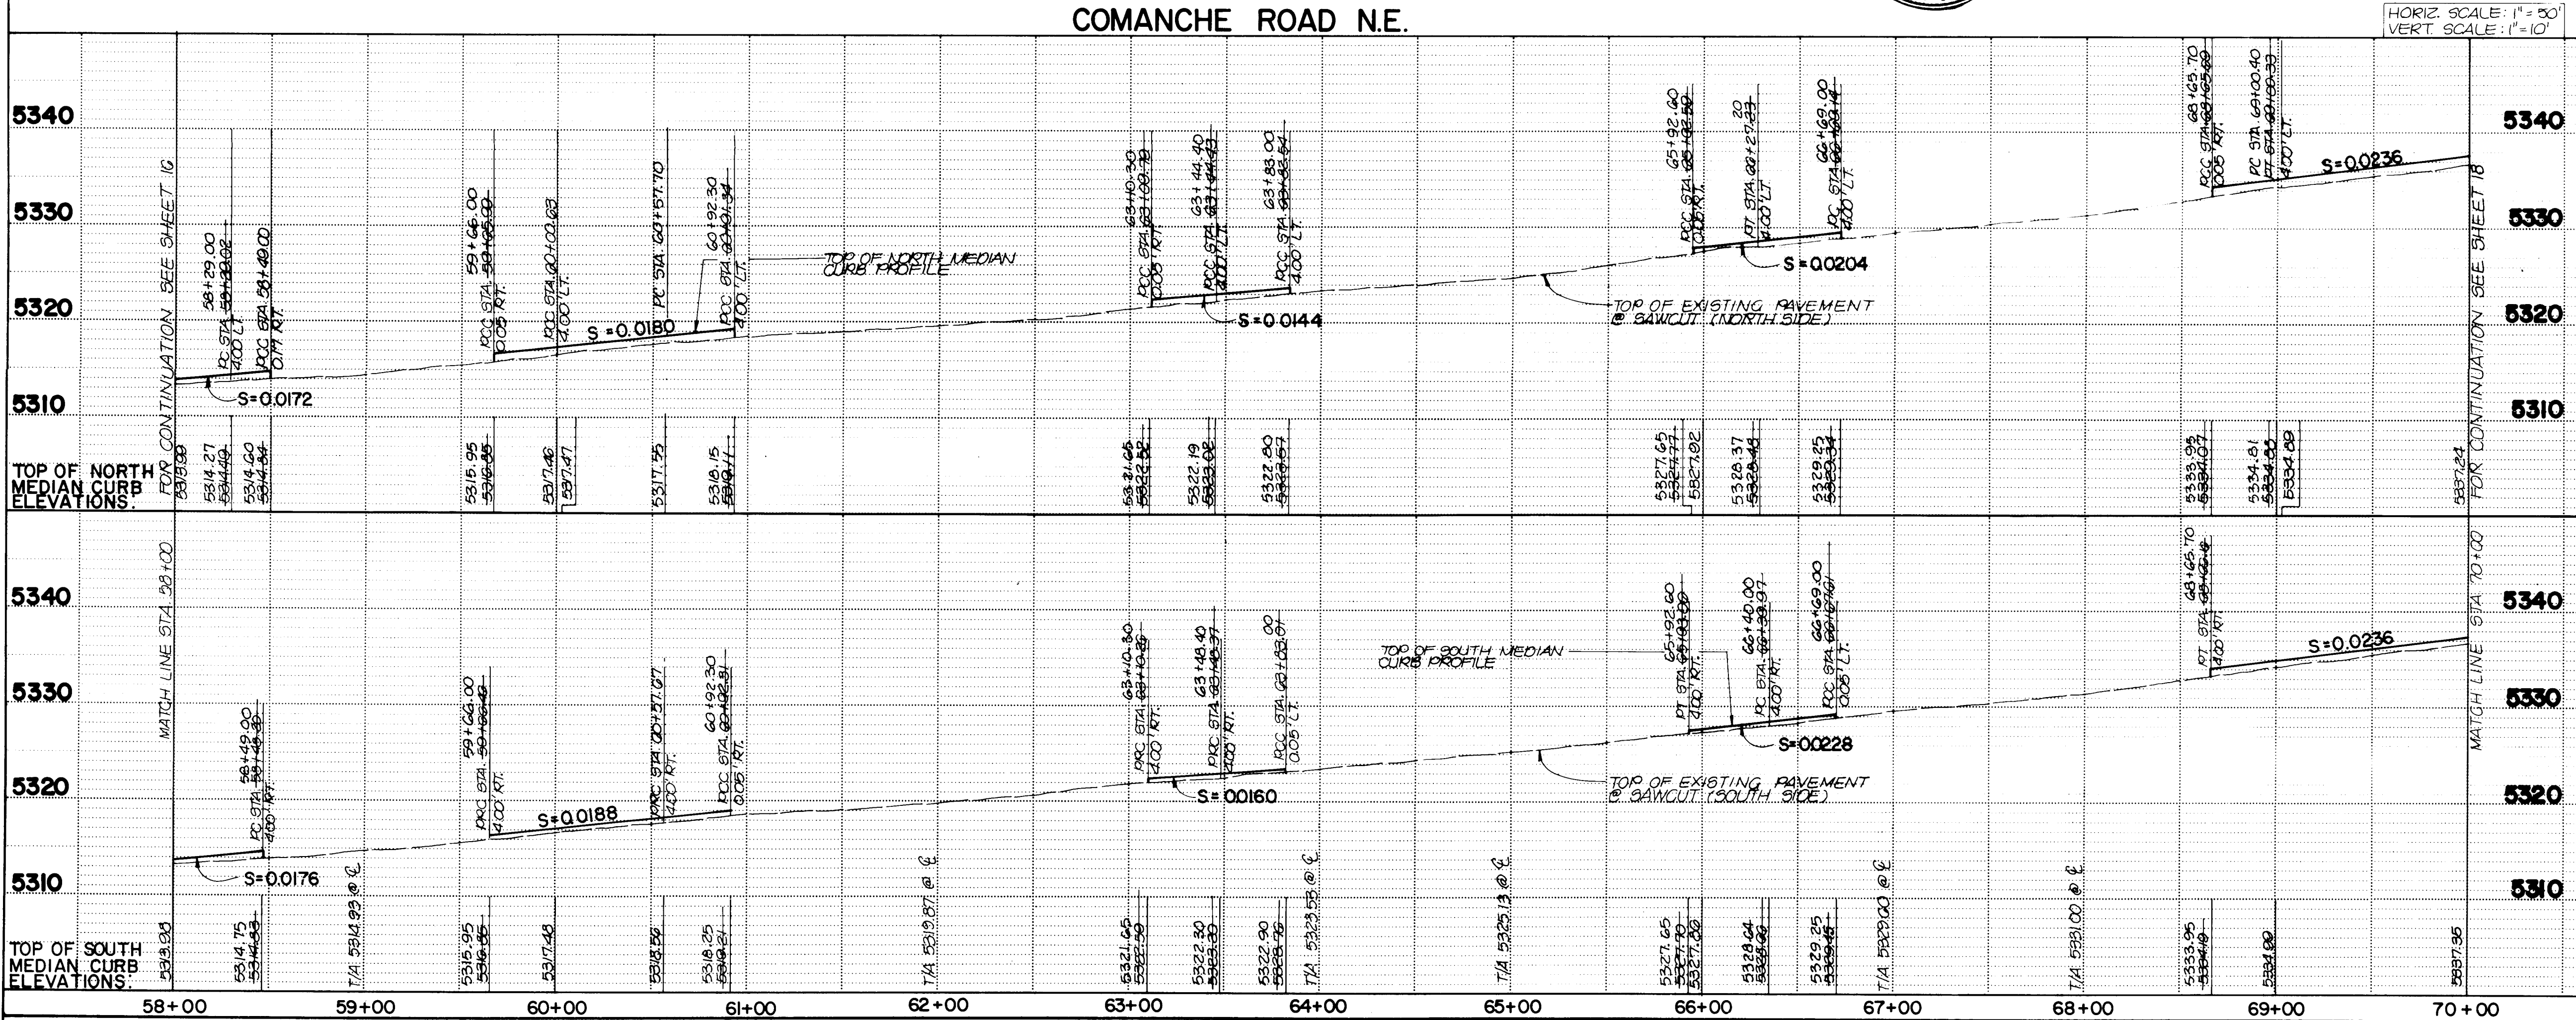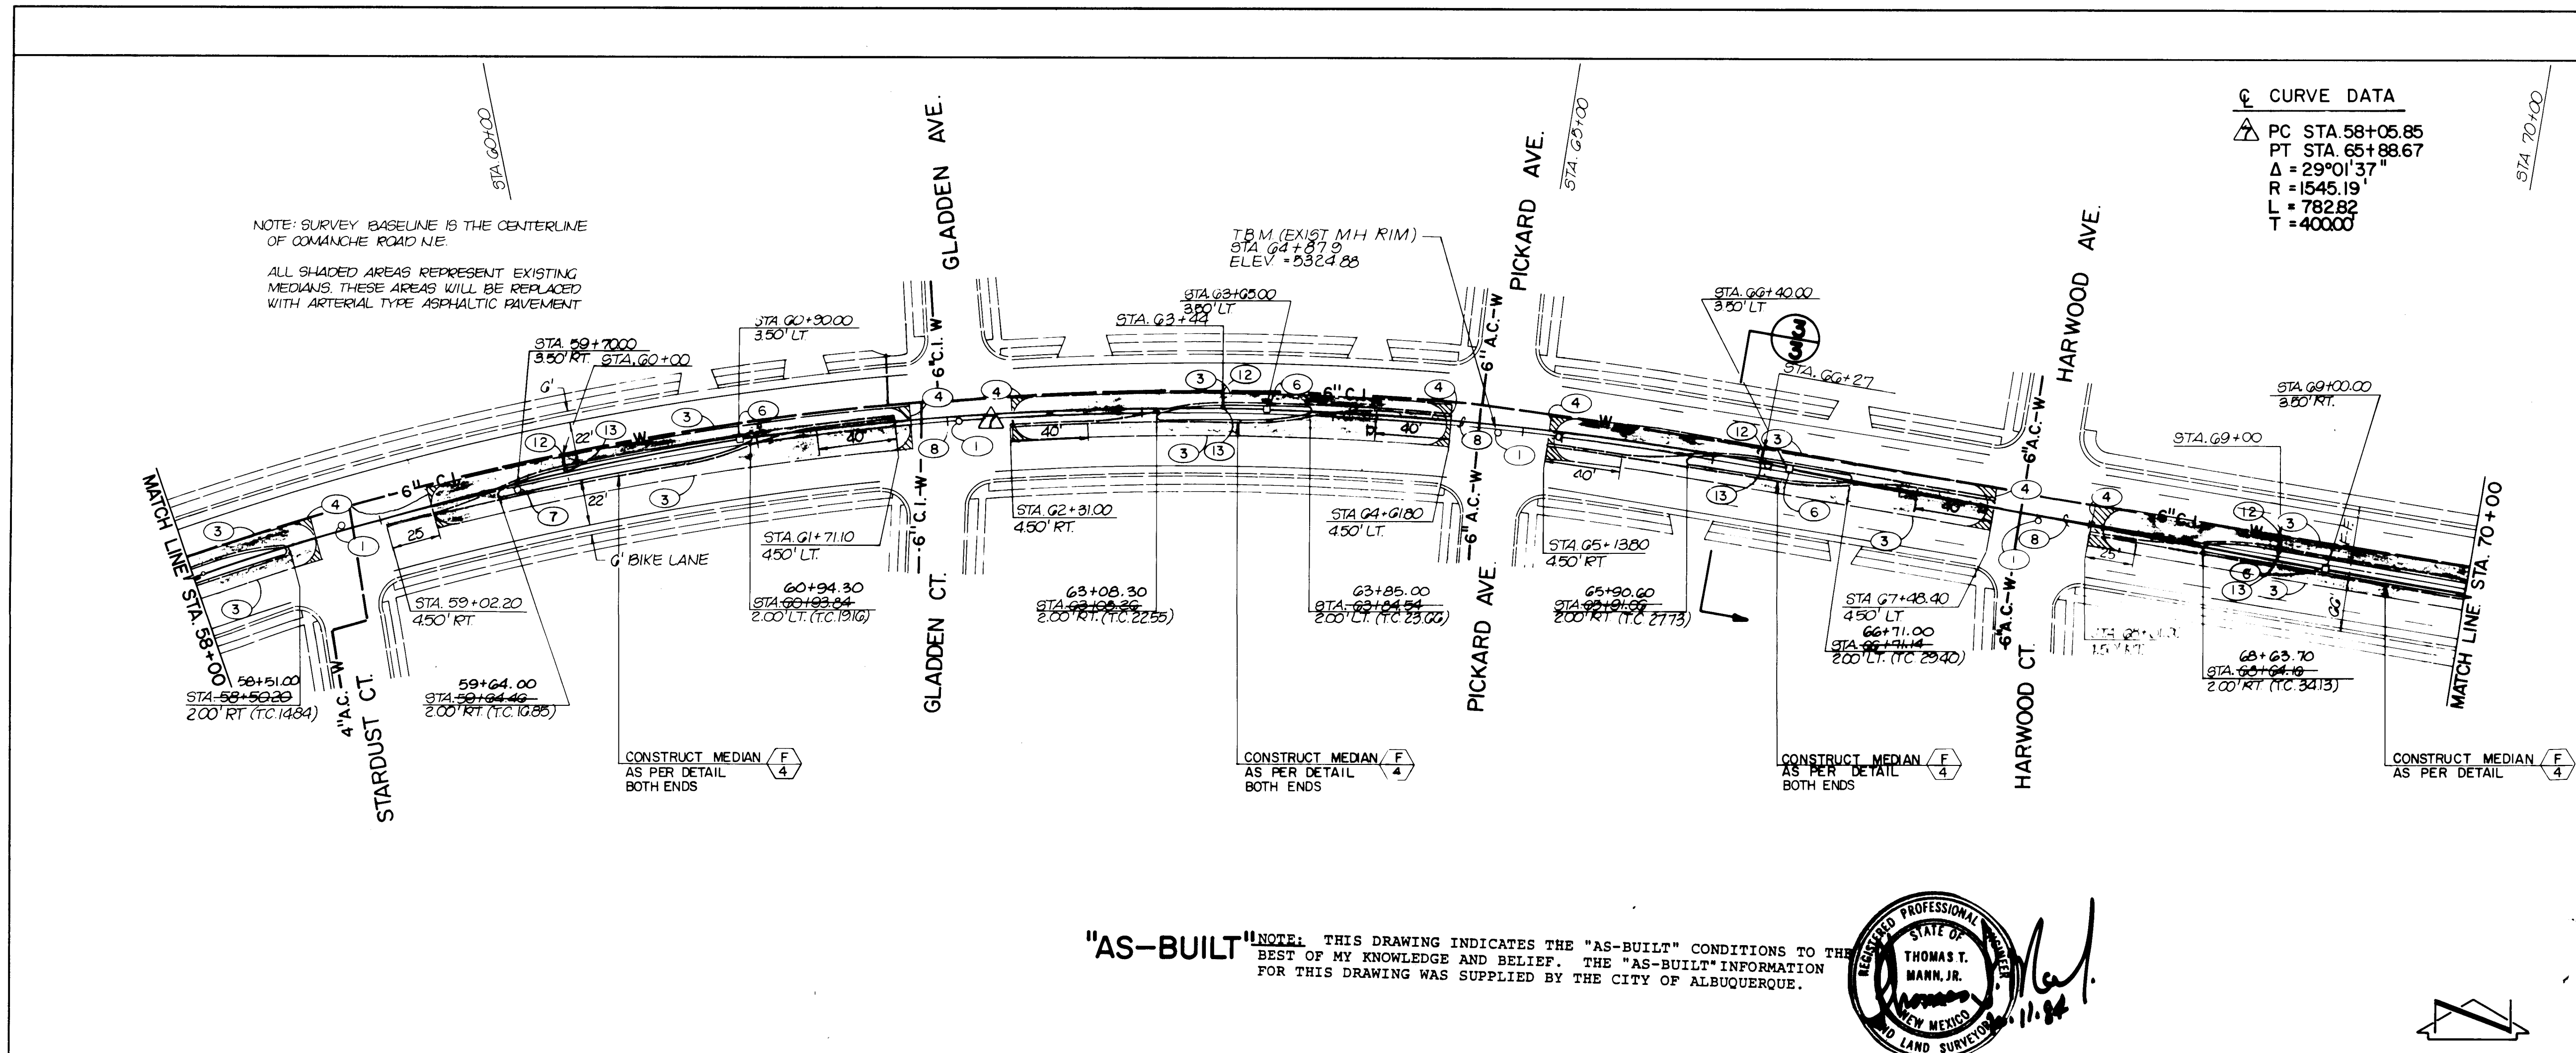

KEYED NOTES

- ADJUST MANHOLE FRAME AND COVER TO GRADE AS PER CITY OF ALB. STD. DWG P-24.
- ADJUST WATER VALVE BOX AND COVER TO GRADE AS PER CITY OF ALB. STD. DWGS. W-2, W-3, W-26 and P-24.
- REMOVE AND DISPOSE OF EXISTING ASPHALT AND/OR CONCRETE CURB.
- REMOVE AND REPLACE EXISTING ASPHALTIC CONCRETE PAVING AT LOCATIONS APPROVED BY FIELD ENGINEER.
- CONNECT NEW CONCRETE MEDIAN CURB AND GUTTER TO EXISTING CONCRETE CURB AND GUTTER; TOP OF CURB AND FLOWLINE ELEVATIONS SHALL MATCH.
- TRAFFIC SIGNAL PULL BOXES SHALL BE INSTALLED AT THE STATIONS INDICATED, AS PER CITY OF ALBUQUERQUE STANDARD DRAWING T-4-1.
- TRAFFIC SIGNAL MANHOLES SHALL BE INSTALLED AT THE STATIONS INDICATED, AS PER CITY OF ALBUQUERQUE STANDARD DRAWING T-13.
- TRAFFIC SIGNAL COMPUTER INTERCONNECT CONDUIT (2" RIGID) SHALL BE INSTALLED AT THE LOCATIONS INDICATED.
- EXISTING TRAFFIC SIGNAL PULLBOXES SHALL BE REMOVED AND RELOCATED TO THE STATIONS INDICATED TO COMPUTER INTERCONNECT CONDUIT (2" RIGID) SHALL BE RECONNECTED USING A SWEEP BEND.
- EXISTING TRAFFIC SIGNAL CONDUIT. ALL EXISTING TRAFFIC SIGNAL EQUIPMENT (EXCEPT PULL BOXES) AND REGULATORY SIGNS THAT NEED TO BE RELOCATED SHALL BE DONE BY THE TRAFFIC ENGINEERING DIVISION WITH 2 DAYS NOTICE.
- TAP AND INSTALL 1" SERVICE LINE INCLUDING SADDLE AT THE STATIONS INDICATED. REMOVE AND REPLACE EXISTING PAVING IMPROVEMENTS AS NECESSARY.
- INSTALL CURB STOP AND CURB BOX AT THE STATIONS INDICATED AS PER DETAIL 4.

NOTES:

- IN THE CENTER OF THE ROADWAY (COMANCHE RD.) BETWEEN THE EXISTING MEDIANS A LEVELING SHALL BE PLACED TO MATCH THE EXISTING PAVEMENT FOR THE EAST AND WEST BOUND LANES PRIOR TO APPLYING THE PLANT MIX SEAL COAT. THE LEVELING COURSE SHALL BE A TYPE D ASPHALT DESIGN MIX IN ACCORDANCE WITH SECTION 115. AN EMULSIFIED TACK COAT SHALL BE APPLIED TO THE EDGES AND SURFACE OF THE EXISTING MAT PRIOR TO PLACING THE LEVELING COURSE. THE LEVELING COURSE SHALL BE 1" THICK AT THE STREET CENTERLINE AND TAPERED TO MATCH THE INSIDE EDGES OF THE EXISTING EAST OR WEST BOUND LANES.
- PRIOR TO PLACING LEVELING COURSE OR PLANT MIX SEAL COAT THE ROADWAY SURFACE SHALL BE REPAIRED OF POTHOLES AND DISTRESSED OR CRACKED AREAS AS PER SECTION 344 OF THE SUPPLEMENTAL TECHNICAL SPECIFICATIONS.

AS BUILT INFORMATION

CONTRACTOR	DATE

BENCH MARKS

CONTRACTOR	DATE

SURVEY INFORMATION

NO.	DATE	BY

ENGINEER'S SEAL

REGISTERED PROFESSIONAL ENGINEER

STATE OF NEW MEXICO

THOMAS T. MANN, JR.

11.8.21

REMARKS

NO.	DATE	BY



CITY OF ALBUQUERQUE
TRANSPORTATION DEPARTMENT

TITLE:
COMANCHE ROAD N.E.
STA 58+00 TO STA 70+00


APPROVALS	ENGINEER	DATE	APPROVALS	ENGINEER	DATE
City Engineer			Liquid Waste		
A.C.E. - Design			Traffic		
A.C.E. - Hydrology			Water		

DRAWING NO. 1619 MAP NO. G-19 SHEET 17 OF 27

MONTGOMERY PARK

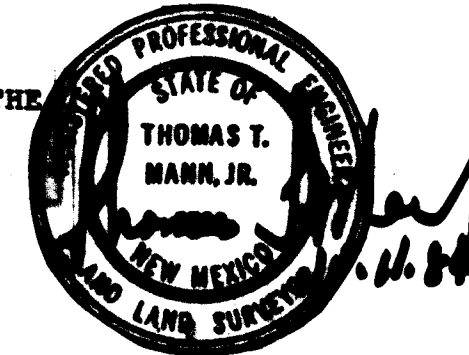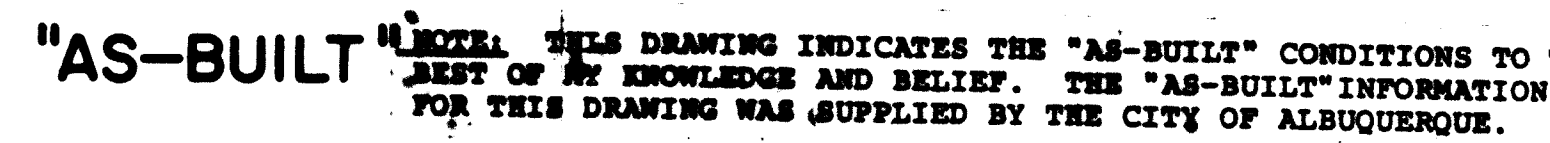

HORIZ SCALE : 1" = 50'
VERT SCALE : 1" = 10'

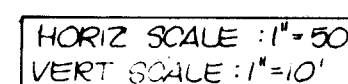

1. NEW 15" SEWER REPLACES EXISTING 12" SEWER. NEW INVERT ELEVATION FOR 15" SEWER SHALL BE 0.25' LOWER THAN THE EXISTING INVERT OF 12" SEWER.
2. EXISTING MANHOLES ARE TO REMAIN. ALL INVERTS WILL BE REQUIR TO REMAIN INVERTS OF NEW 15" SEWER PIPE.
3. CONTRACTOR SHALL BE RESPONSIBLE FOR MAINTAINING SEWER SERVICE TO ALL EXISTING PROPERTIES DURING CONSTRUCTION.
4. ALL STATIONING IS BASED ON SURVEY BASELINE STATIONING, UNLESS OTHERWISE NOTED.
5. SLOPES SHOWN ON THE PROFILES ARE BASED ON TRUE DISTANCES, NOT ON SURVEY BASELINE STATIONING. LENGTHS SHOWN ON PROFILES ARE TRUE DISTANCES.
6. WHERE VERTICAL CLEARANCE BETWEEN EXISTING WATERLINE AND NEW 15" SEWER IS LESS THAN 3'-0" SEWER SHALL BE CONCRETE ENCASED AS PER STD DETAIL 8-10.



SURVEY INFORMATION		BENCH MARKS	AS BUILT INFORMATION
NO.	FIELD NOTES		CONTRACTOR
	BY DATE		WORK DATE FOR SURF POURS
		AN AC9 BRASS TABLET STAMPED 4-GROA SET IN TOP OF CONC. POST, FLUSH W/CURB, LO - CATED @ THE E.N.E. CURB QUADRANT OF THE INTERSECTION OF COMANCHE ROAD, N/E AND WYOMING BLVD., N/E. ELEVATION = 5423.47	ACCEPTANCE BY FIELD INSPECTION BY DRAWINGS CONNECTED BY MICRO-FILM
			RECORDED BY DATE
			N.O.

[illegible][illegible]

TITLE: COMANCHE ROAD N.E.
SANITARY SEWER IMPROVEMENTS
STA. 10+00 TO STA. 22+00

APPROVALS	ENGINEER	DATE	APPROVALS	ENGINEER	DATE
City Engineer			Liquid Waste		
A.C.E - Design			Traffic		
A.C.E -Hydrology			Water		

DRAWING NO.	1619	MAP NO.	G-18	SHEET	21	OF	27
-------------	------	---------	------	-------	----	----	----

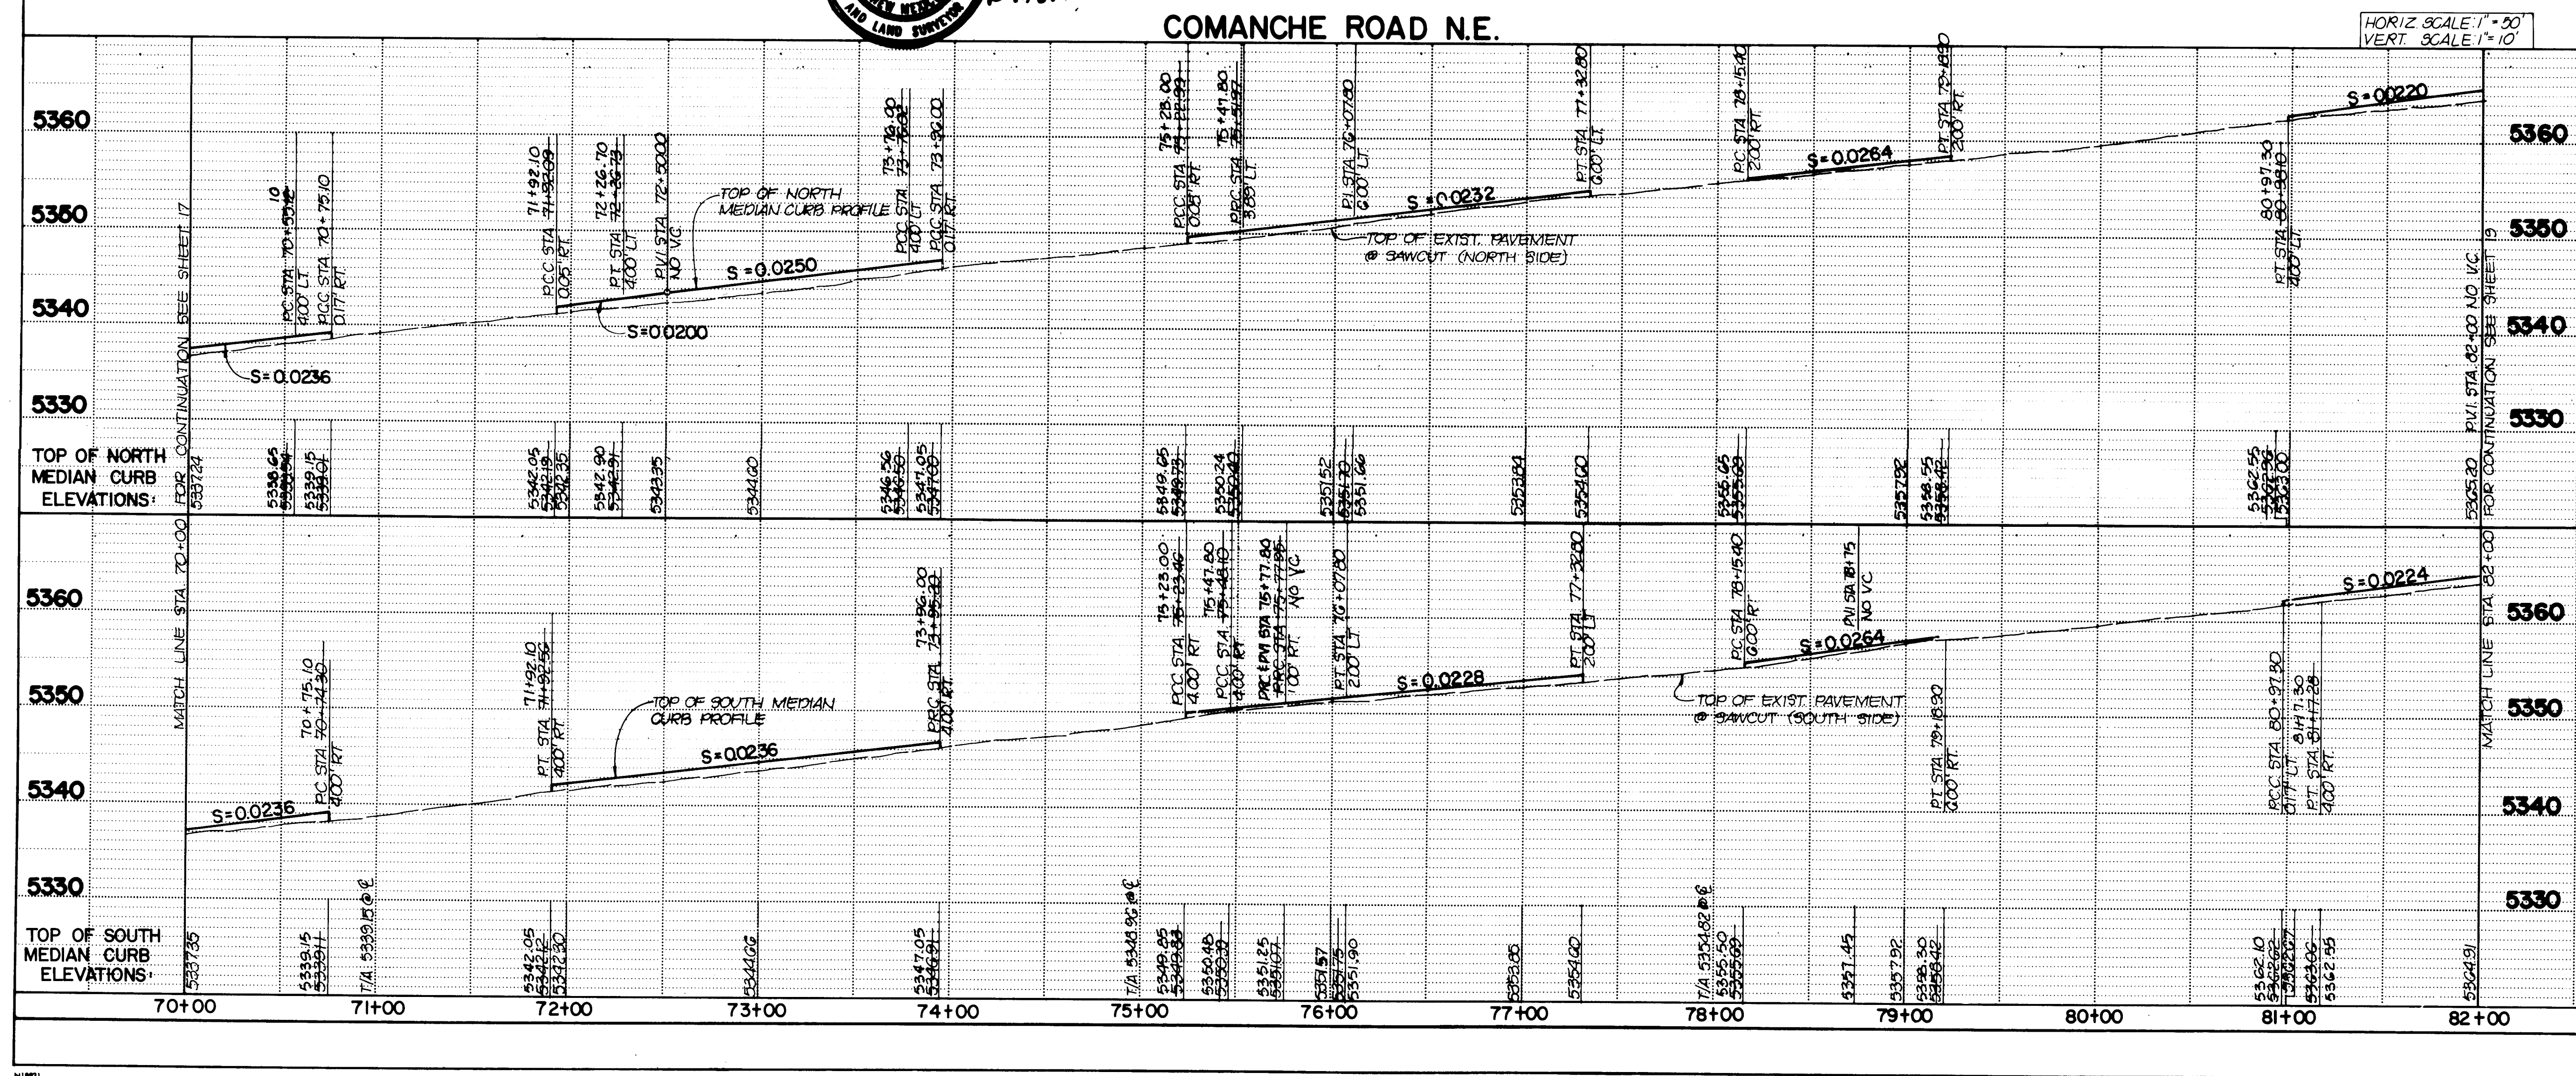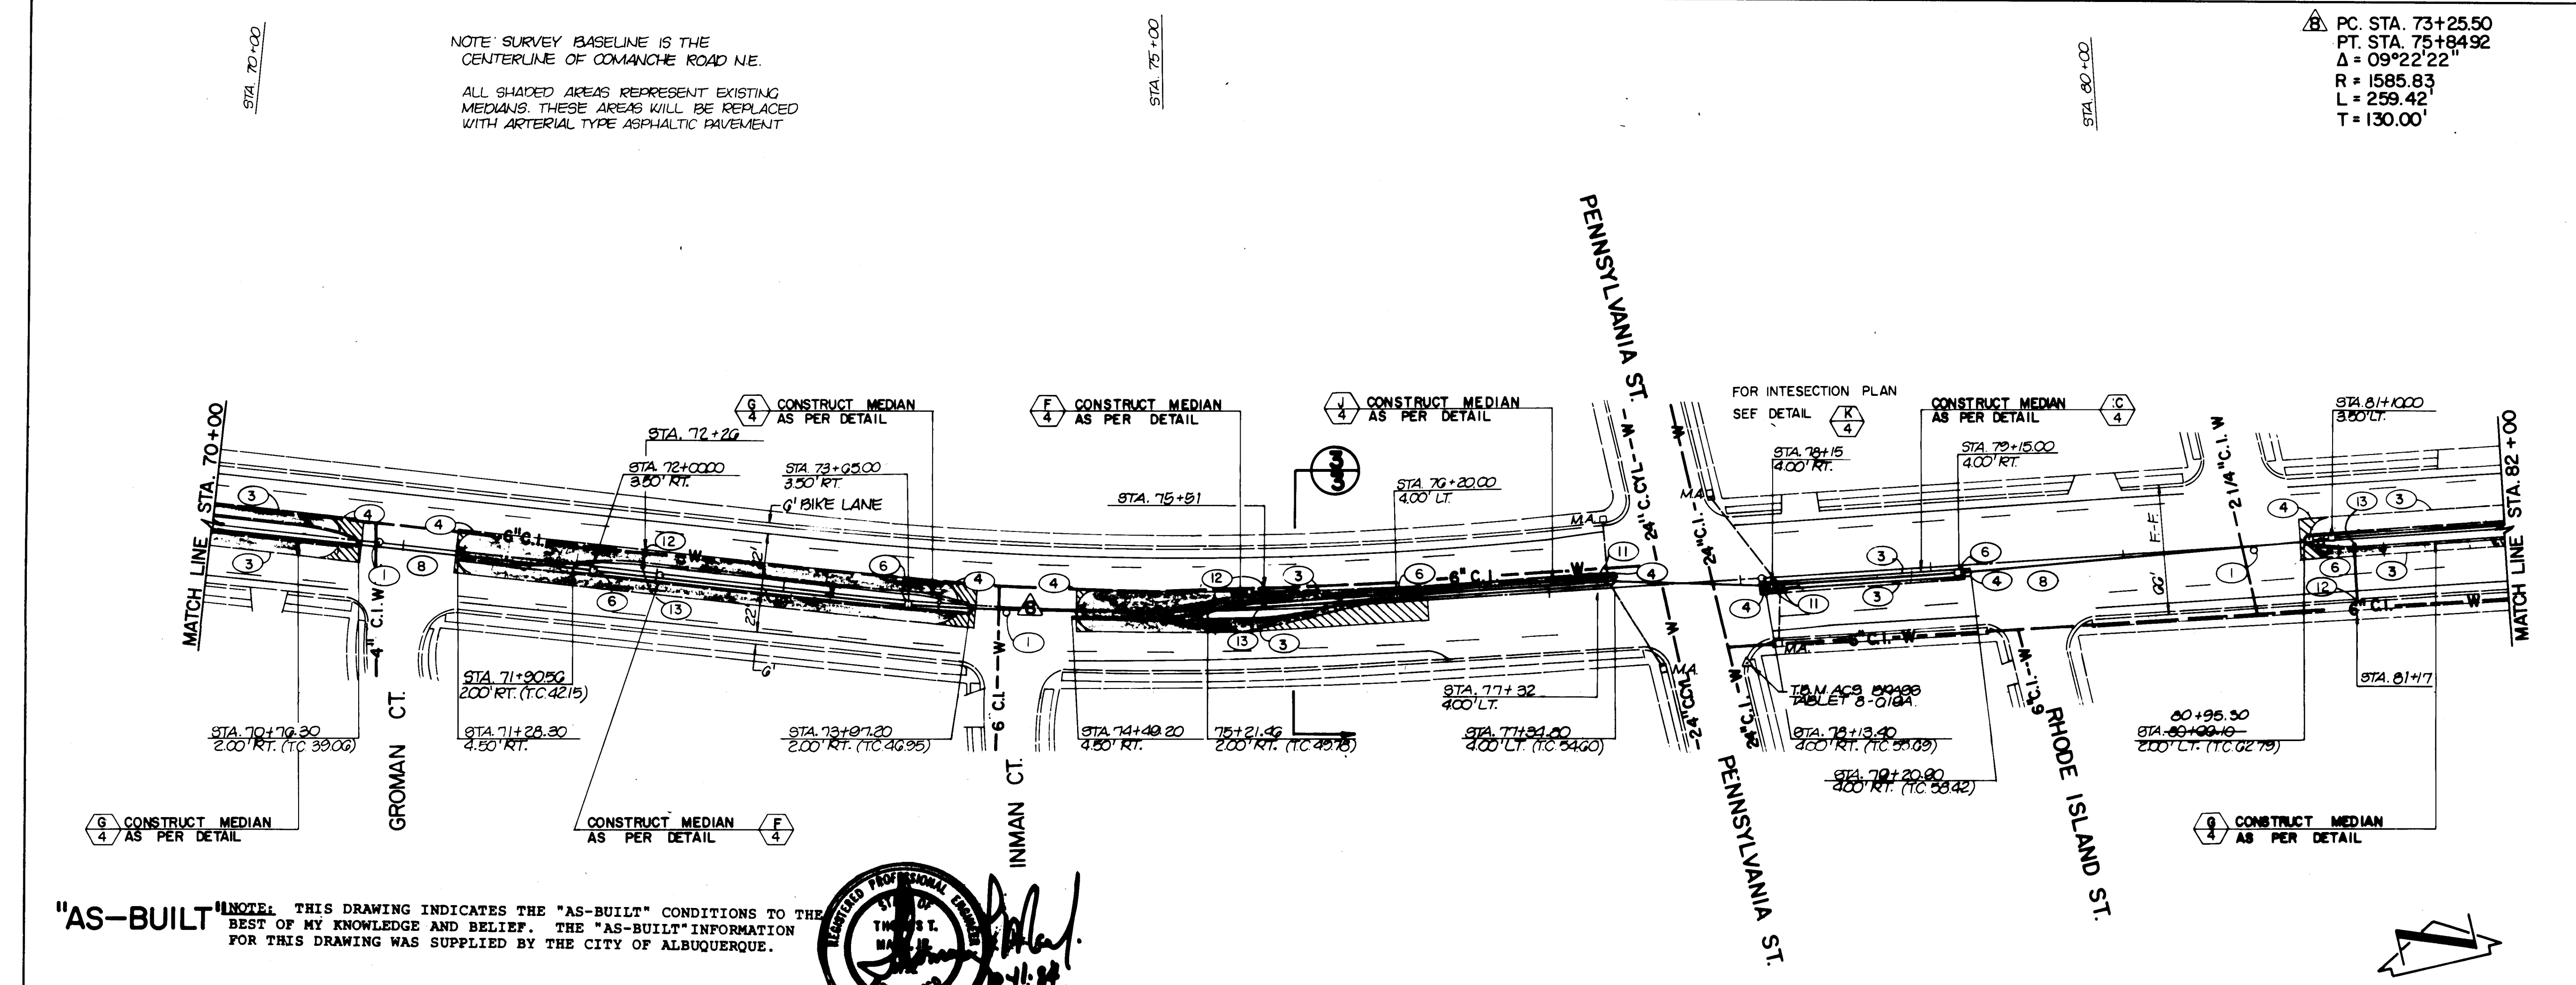

KEYED NOTES		
1	ADJUST MANHOLE FRAME AND COVER TO GRADE AS PER CITY OF ALB. STD. DWG P-24.	
2	ADJUST WATER VALVE BOX AND COVER TO GRADE AS PER CITY OF ALB. STD. DWGS. W-2, W-3, W-26 AND P-24.	
3	REMOVE AND DISPOSE OF EXISTING ASPHALT AND/OR CONCRETE CURB.	
4	REMOVE AND REPLACE EXISTING ASPHALTIC CONCRETE PAVING AT LOCATIONS APPROVED BY FIELD ENGINEER.	
5	CONNECT NEW CONCRETE MEDIAN CURB AND GUTTER TO EXISTING CONCRETE CURB AND GUTTER; TOP OF CURB AND FLOWLINE ELEVATIONS SHALL MATCH.	
6	TRAFFIC SIGNAL PULL BOXES SHALL BE INSTALLED AT THE STATIONS INDICATED, AS PER CITY OF ALBUQUERQUE STANDARD DRAWING T-4-1.	
7	TRAFFIC SIGNAL MANHOLES SHALL BE INSTALLED AT THE STATIONS INDICATED, AS PER CITY OF ALBUQUERQUE STANDARD DRAWING T-13.	
8	TRAFFIC SIGNAL COMPUTER INTERCONNECT CONDUIT (2" RIGID) SHALL BE INSTALLED AT THE LOCATIONS INDICATED.	
9	EXISTING TRAFFIC SIGNAL PULLBOXES SHALL BE REMOVED AND RELOCATED TO THE STATIONS INDICATED. COMPUTER INTERCONNECT CONDUIT (2" RIGID) SHALL BE RECONNECTED USING A SWEEP BEND.	
10	EXISTING TRAFFIC SIGNAL CONDUIT. ALL EXISTING TRAFFIC SIGNAL EQUIPMENT (EXCEPT PULL BOXES) AND REGULATORY SIGNS THAT NEED TO BE RELOCATED SHALL BE DONE BY THE TRAFFIC ENGINEERING DIVISION WITH 2 DAYS NOTICE.	
11	TAP AND INSTALL 1" SERVICE LINE INCLUDING SADDLE AT THE STATIONS INDICATED. REMOVE AND REPLACE EXISTING PAVING IMPROVEMENTS AS NECESSARY.	
12	INSTALL CURB STOP AND CURB BOX AT THE STATIONS INDICATED AS PER DETAIL.	

BENCH MARKS		
AN ACS BRASS	TARGET STAMPED 4-0204	SET IN TOP OF CONC POST FLUSH W/ CURB LOCATION @ THE E-NE QUADRANT OF THE INTERSECTION OF COMANCHE ROAD, NE AND WYOMING BLVD, NE.
DATE		
BY		



SURVEY INFORMATION		
NO.	DATE	BY

ENGINEER'S SEAL		
REGISTERED PROFESSIONAL ENGINEER	STATE OF NEW MEXICO	NO. DATE
REMARKS		
BY		

CITY OF ALBUQUERQUE TRANSPORTATION DEPARTMENT					
TITLE: COMANCHE ROAD N.E. STA 70+00 TO STA 82+00					
APPROVALS	ENGINEER	DATE	APPROVALS	ENGINEER	DATE
City Engineer			Liquid Waste		
A.C.E - Design			Traffic		
A.C.E - Hydrology			Water		

DRAWING NO.	MAP NO.	SHEET	OF
1619	G-19	18	27

ALL SHADED AREAS REPRESENT EXISTING
MEDIAN. THESE AREAS WILL BE REPLACED
WITH ARTERIAL TYPE ASPHALTIC PAVEMENT.

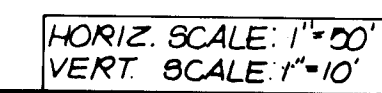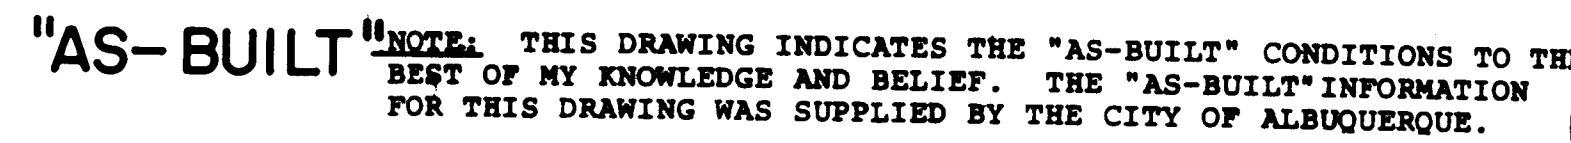

- ① ADJUST MANHOLE FRAME AND COVER TO GRADE AS PER CITY OF ALB. STD. DWG P-24.
- ② ADJUST WATER VALVE BOX AND COVER TO GRADE AS PER CITY OF ALB. STD. DWGS. W-2, W-3, W-26 and P-24.
- ③ REMOVE AND DISPOSE OF EXISTING ASPHALT AND/OR CONCRETE CURB.
- ④ REMOVE AND REPLACE EXISTING ASPHALTIC CONCRETE PAVING AT LOCATIONS APPROVED BY FIELD ENGINEER.
- ⑤ CONNECT NEW CONCRETE MEDIAN CURB AND GUTTER TO EXISTING CONCRETE CURB AND GUTTER; TOP OF CURB AND FLOWLINE ELEVATIONS SHALL MATCH.
- ⑥ TRAFFIC SIGNAL PULL BOXES SHALL BE INSTALLED AT THE STATIONS INDICATED, AS PER CITY OF ALBUQUERQUE STANDARD DRAWING T-4-1.
- ⑦ TRAFFIC SIGNAL MANHOLES SHALL BE INSTALLED AT THE STATIONS INDICATED, AS PER CITY OF ALBUQUERQUE STANDARD DRAWING T-13.
- ⑧ TRAFFIC SIGNAL COMPUTER INTERCONNECT CONDUIT (2" RIGID) SHALL BE INSTALLED AT THE LOCATIONS INDICATED.
- ⑨ EXISTING TRAFFIC SIGNAL PULLBOXES SHALL BE REMOVED AND RELOCATED TO THE STATIONS INDICATED. COMPACTED INTERCONNECT CONDUIT (2" RIGID) SHALL BE RECONNECTED USING A SWEEP BEND.
- ⑩ EXISTING TRAFFIC SIGNAL CONDUIT.
- ⑪ ALL EXISTING TRAFFIC SIGNAL EQUIPMENT (EXCEPT PULL BOXES) AND REGULATORY SIGNS THAT NEED TO BE RELOCATED SHALL BE DONE BY THE TRAFFIC ENGINEERING DIVISION WITH 2 DAYS NOTICE.
- ⑫ TAP AND INSTALL 1" SERVICE LINE INCLUDING SADDLE AT THE STATIONS INDICATED. REMOVE AND REPLACE EXISTING PAVING IMPROVEMENTS AS NECESSARY.
- ⑬ INSTALL CURB STOP AND CURB BOX AT THE STATIONS INDICATED AS PER DETAIL A.

IN THE CENTER OF THE ROADWAY (COMANCHE RD.) BETWEEN THE EXISTING MEDIAN A LEVELING SHALL BE PLACED TO MATCH THE EXISTING PAVEMENT FOR THE EAST AND WEST BOUND LANES PRIOR TO APPLYING THE PLANT MIX SEAL COAT. THE LEVELING COURSE SHALL BE A TYPE D ASPHALT DESIGN MIX IN ACCORDANCE WITH SECTION 115. AN EMULSIFIED TACK COAT SHALL BE APPLIED TO THE EDGES AND SURFACE OF THE EXISTING MAJOR ROAD. IN PLACING THE LEVELING COURSE, THE LEVING SHALL BE 1" THICK AT THE STREET CENTERLINE AND TAPERED TO MATCH THE INSIDE EDGES OF THE EXISTING EAST OR WEST BOUND LANES.

2. PRIOR TO PLACING LEVELING COURSE OR PLANT MIX SEAL COAT THE ROADWAY SURFACE SHALL BE REPAIRED OF POTHoles AND DISTRESSED OR CRACKED AREAS AS PER SECTION 344 OF THE SUPPLEMENTAL TECHNICAL SPECIFICATIONS.


CITY OF ALBUQUERQUE
TRANSPORTATION DEPARTMENT

TITLE: COMANCHE ROAD N.E.
STA.82+00 TO STA.94+00

APPROVALS	ENGINEER	DATE	APPROVALS	ENGINEER	DATE
City Engineer			Liquid Waste		
A.C.E.-Design			Traffic		
A.C.E.-Hydrology			Water		

DRAWING NO.	1619	MAP NO.	G-19	SHEET	19	OF	27
----------------	------	---------	------	-------	----	----	----

STA. 95+00

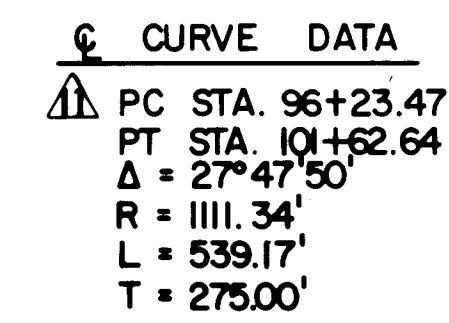


HORIZ. SCALE 1"=50'
VERT. SCALE 1"=10'



NO.	DATE	REMARKS	BY
1	11/11/54	111 DOLLARS IN 1 - AMBROSIO ROSAS - NEW MEXICO - 07114	
2	11/11/54	ENCLOSURE	


APPROVALS	ENGINEER	DATE	APPROVALS	ENGINEER	DATE
City Engineer			Liquid Waste		
A.C.E.-Design			Traffic		
A.C.E.-Hydrology			Water		

DRAWING NO.	1619	MAP NO.	G-19	SHEET	20	OF	27
----------------	------	---------	------	-------	----	----	----

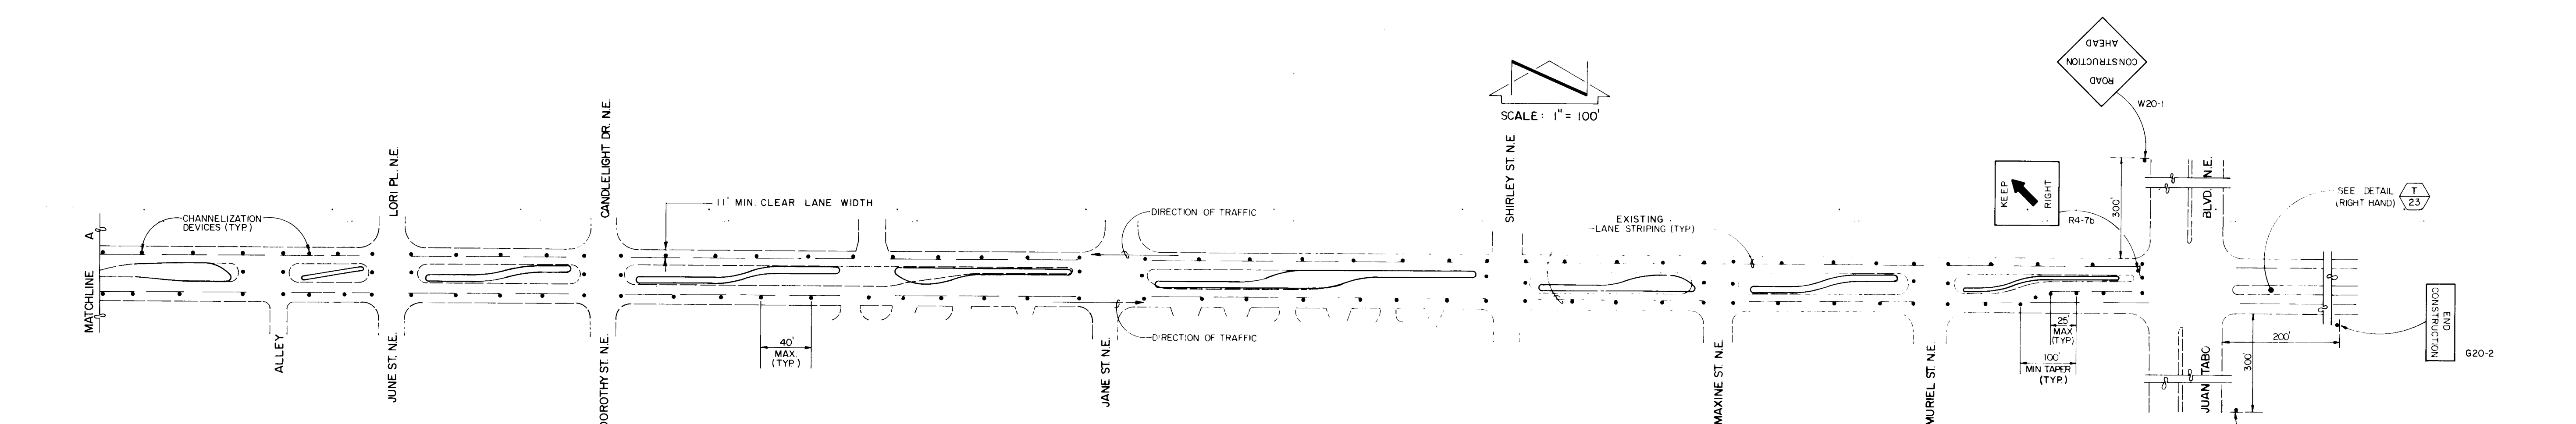

CANDELARIA ROAD N.E.

1. ALL TRAFFIC CONTROL DEVICES SHALL COMPLY WITH CHAPTER VI OF THE 1978 EDITION "NEW MEXICO MANUAL FOR UNIFORM TRAFFIC CONTROL DEVICES."
2. THE CONTRACTOR SHALL PREPARE AND SUBMIT TO THE PROJECT ENGINEER A DETAILED DETOUR PLAN, WHICH MUST BE APPROVED BY THE CITY TRAFFIC ENGINEER 3 WORKING DAYS IN ADVANCE OF ANY REQUIRED LAND CLOSURES OTHER THAN THOSE SHOWN ON THESE PLANS.
3. ALL SIGNS MUST BE INSTALLED BEFORE CONSTRUCTION BEGINS AS DIRECTED BY THE ENGINEER. SIGN HEIGHTS SHALL BE 7 FEET ABOVE THE SIDEWALK LEVEL.
4. ALL DRUMS MAY HAVE SAND OR WATER BALLAST LIMITED TO 100 LBS.
5. ALL SIGN LOCATIONS WILL BE SELECTED IN THE FIELD AND APPROVED BY THE PROJECT ENGINEER. DISTANCES MAY BE ADJUSTED FOR LOCAL CONDITIONS.
6. ALL SIGNS WILL BE INSTALLED IMMEDIATELY AFTER DARK OR DURING POSTS. EXISTING POSTS MAY BE USED AT SOME LOCATIONS, WITH THE APPROVAL OF THE TRAFFIC ENGINEER. PORTABLE SIGN SUPPORTS WILL BE ACCEPTABLE AS AN ALTERNATE FOR A DURATION OF 7 DAYS OR LESS.
7. ALL SIGNS WILL BE MOVED FORWARD AS THE CONSTRUCTION PROGRESSES, AS DETERMINED APPROPRIATE BY THE PROJECT ENGINEER. SIGNS MUST BE COVERED OR REMOVED WHEN NOT IN EFFECT.
8. THE CONTRACTOR SHALL MAINTAIN ACCESS TO BUSINESSES AND RESIDENCES ADJACENT TO THE CONSTRUCTION AREA AT ALL TIMES. CONSTRUCTION EQUIPMENT AND MATERIALS SHALL NOT BE STORED WITHIN THE ROADWAY OR ON THE MEDIAN DURING NON-WORK HOURS.
9. WHEN BARRIERS ARE REQUIRED AFTER DARK, ALL ADVANCE WARNING SIGNS AND ALL BARRICADES SHALL BE EQUIPPED WITH FLASHING WARNING LIGHTS (TYPE A), EXCEPT THAT ALL CHANNELIZING BARRICADES SHALL HAVE STEADY BURNING WARNING LIGHTS (TYPE C).
10. ALL EXISTING REGULATORY SIGNS AND SIGNALS THAT NEED TO BE REMOVED, RELOCATED OR REINSTALLED SHALL BE DONE BY THE CITY OF ALBUQUERQUE TRAFFIC ENGINEERING DIVISION. THE CONTRACTOR SHALL NOTIFY THE TRAFFIC ENGINEERING DIVISIONS 3 WORKING DAYS IN ADVANCE OF ANY REQUIRED WORK.
11. THE CONTRACTOR SHALL PROVIDE AND MAINTAIN A SAFE AND ADEQUATE MEANS OF CHANNELIZING PEDESTRIAN TRAFFIC AROUND ALL WORK AREAS THROUGHOUT THE PERIOD OF CONSTRUCTION. SUCH CHANNELIZATION SHALL BE ARRANGED TO PREVENT PEDESTRIANS FROM HAVING TO ENTER THE ROADWAY IN ORDER TO PASS AROUND THE WORK AREAS.
12. ALL CONSTRUCTION SIGNING SHALL BE BLACK ON A REFLECTORIZED ORANGE FIELD UNLESS OTHERWISE SPECIFIED. ALL CONSTRUCTION BARRICADES AND CHANNELIZATION DEVICES SHALL BE ORANGE ON WHITE, REFLECTORIZED, UNLESS OTHERWISE SPECIFIED.
13. CHANNELIZATION MAY BE ACCOMPLISHED BY USE OF EITHER BARRELS OR TYPE II BARRICADES. THESE MAY NOT BE INTERMIXED ON THE PROJECT.
14. CONSTRUCTION LIMITS SHALL BE ESTABLISHED AT 1/2 MILE FOR MEDIAN RECONSTRUCTION AND 1000 FEET FOR UTILITY WORK.
15. BOTH LANES OF TRAFFIC MUST BE OPEN IN THE PEAK DIRECTION ON CANDELARIA ROAD AND COMANCHE ROAD.
 - 2 LANES EASTBOUND 4-6PM MON-FRI
 - 2 LANES WESTBOUND 7-8:30AM MON-FRI
16. MINIMUM CHANNELIZED CLEAR LANE WIDTH SHALL BE 11 FEET MINIMUM AT ALL TIMES.

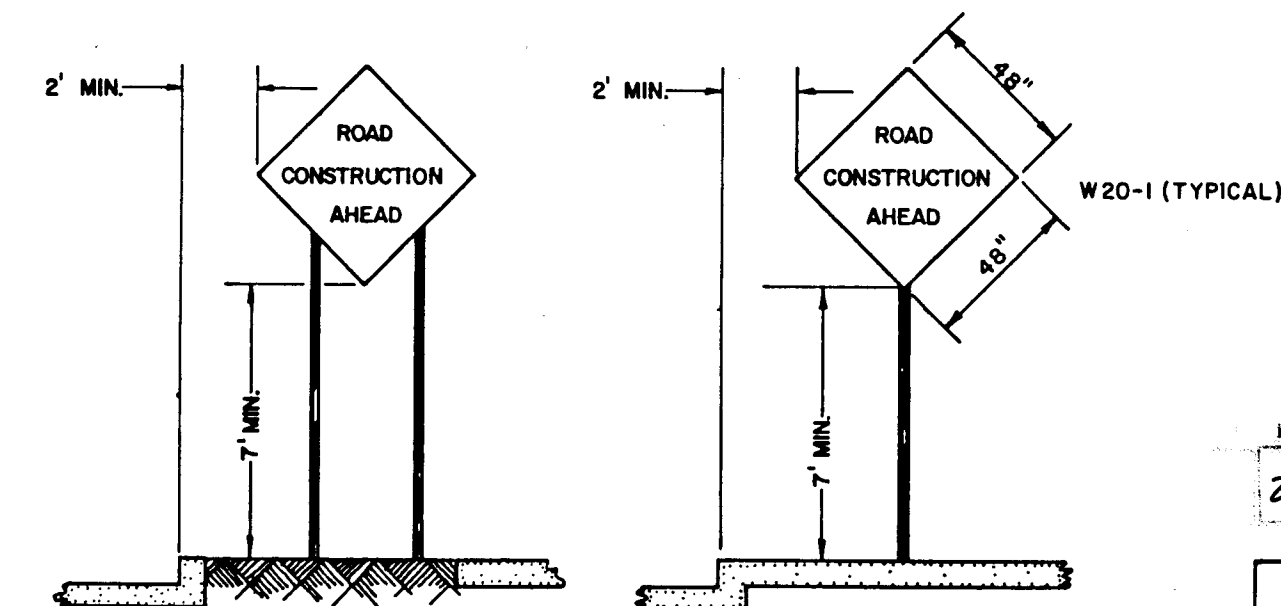

SIGN INSTALLATION DETAIL
NO SCALE

TITLE: CANDELARIA ROAD N.E.
TRAFFIC CONTROL PLAN

DRAWING NO.	1619	SHEET	23	OF	27
-------------	------	-------	----	----	----

MATCHLINE A												
				REFERENCES		SURVEY INFORMATION		BENCH MARKS		AS BUILT INFORMATION		
				MAP NO.			FIELD NOTES					
				EST. NO.	W.O. NO.	NO.	BY	DATE				
NO.	DATE	REMARKS										
										ANJ ACS BK0435 TABLE STAMPED 19-0-21, 1975 ACS # 8ET IN A CONCRETE CYLINDER IN THE GROUND LOCATED 64.21 WEST OF THE CENTERLINE OF EUBANK BLVD N.E. AND 40' NORTH OF THE CENTERLINE OF CANDELARIA ROAD N/E ON THE NOSE OF THE WEST MEDIAN CURB. ELEVATION = 5509.42		CONTRACTOR STARTED BY INSPECTION BY FIELD OFFICE BY VERIFICATION BY DATE MICRO-FILM INFORMATION RECORDED BY NO. DATE
81 DALLAS N.E., ALBUQUERQUE, NEW MEXICO - 81110 ENGINEERS												



CITY ENGINEER DATE

DRAWING NO.	1619	SHEET	24	OF	27
-------------	------	-------	----	----	----

NO.	DATE	REMARKS	BY	REFERENCES			SURVEY INFORMATION		BENCH MARKS	AS BUILT INFORMATION	
				MAP NO.	EST. NO.	W.O. NO.	NO.	BY		DATE	CONTRACTOR
									ANV ACS BRASS TABLET STAMPED 157A M-44"	WORK STAKED BY	
									CEMENTED IN A DRILL HOLE IN THE CUTTER AND FLUSH W/ THE MALEVENT. LOCATED 13.5 FT. WEST AND 0.80 FT. NORTH OF THE NOSE OF THE MOST WESTERLY MEDIAN @ THE INTERSECTION OF MONTGOMERY BLVD. NE. AND SAN PEDRO DRIVE N.E.	INSPECTOR'S FIELD VERIFICATION BY	DATE
										CORRECTED BY	DATE
										MICRO-FILM INFORMATION	
										RECORDED BY	DATE
										NO	
										ELEVATION=5253.305	

INTEGRITY ASSOCIATES, INC.

811 DALLAS N.E. · ALBUQUERQUE · NEW MEXICO · 87110

ENGINEERS

