
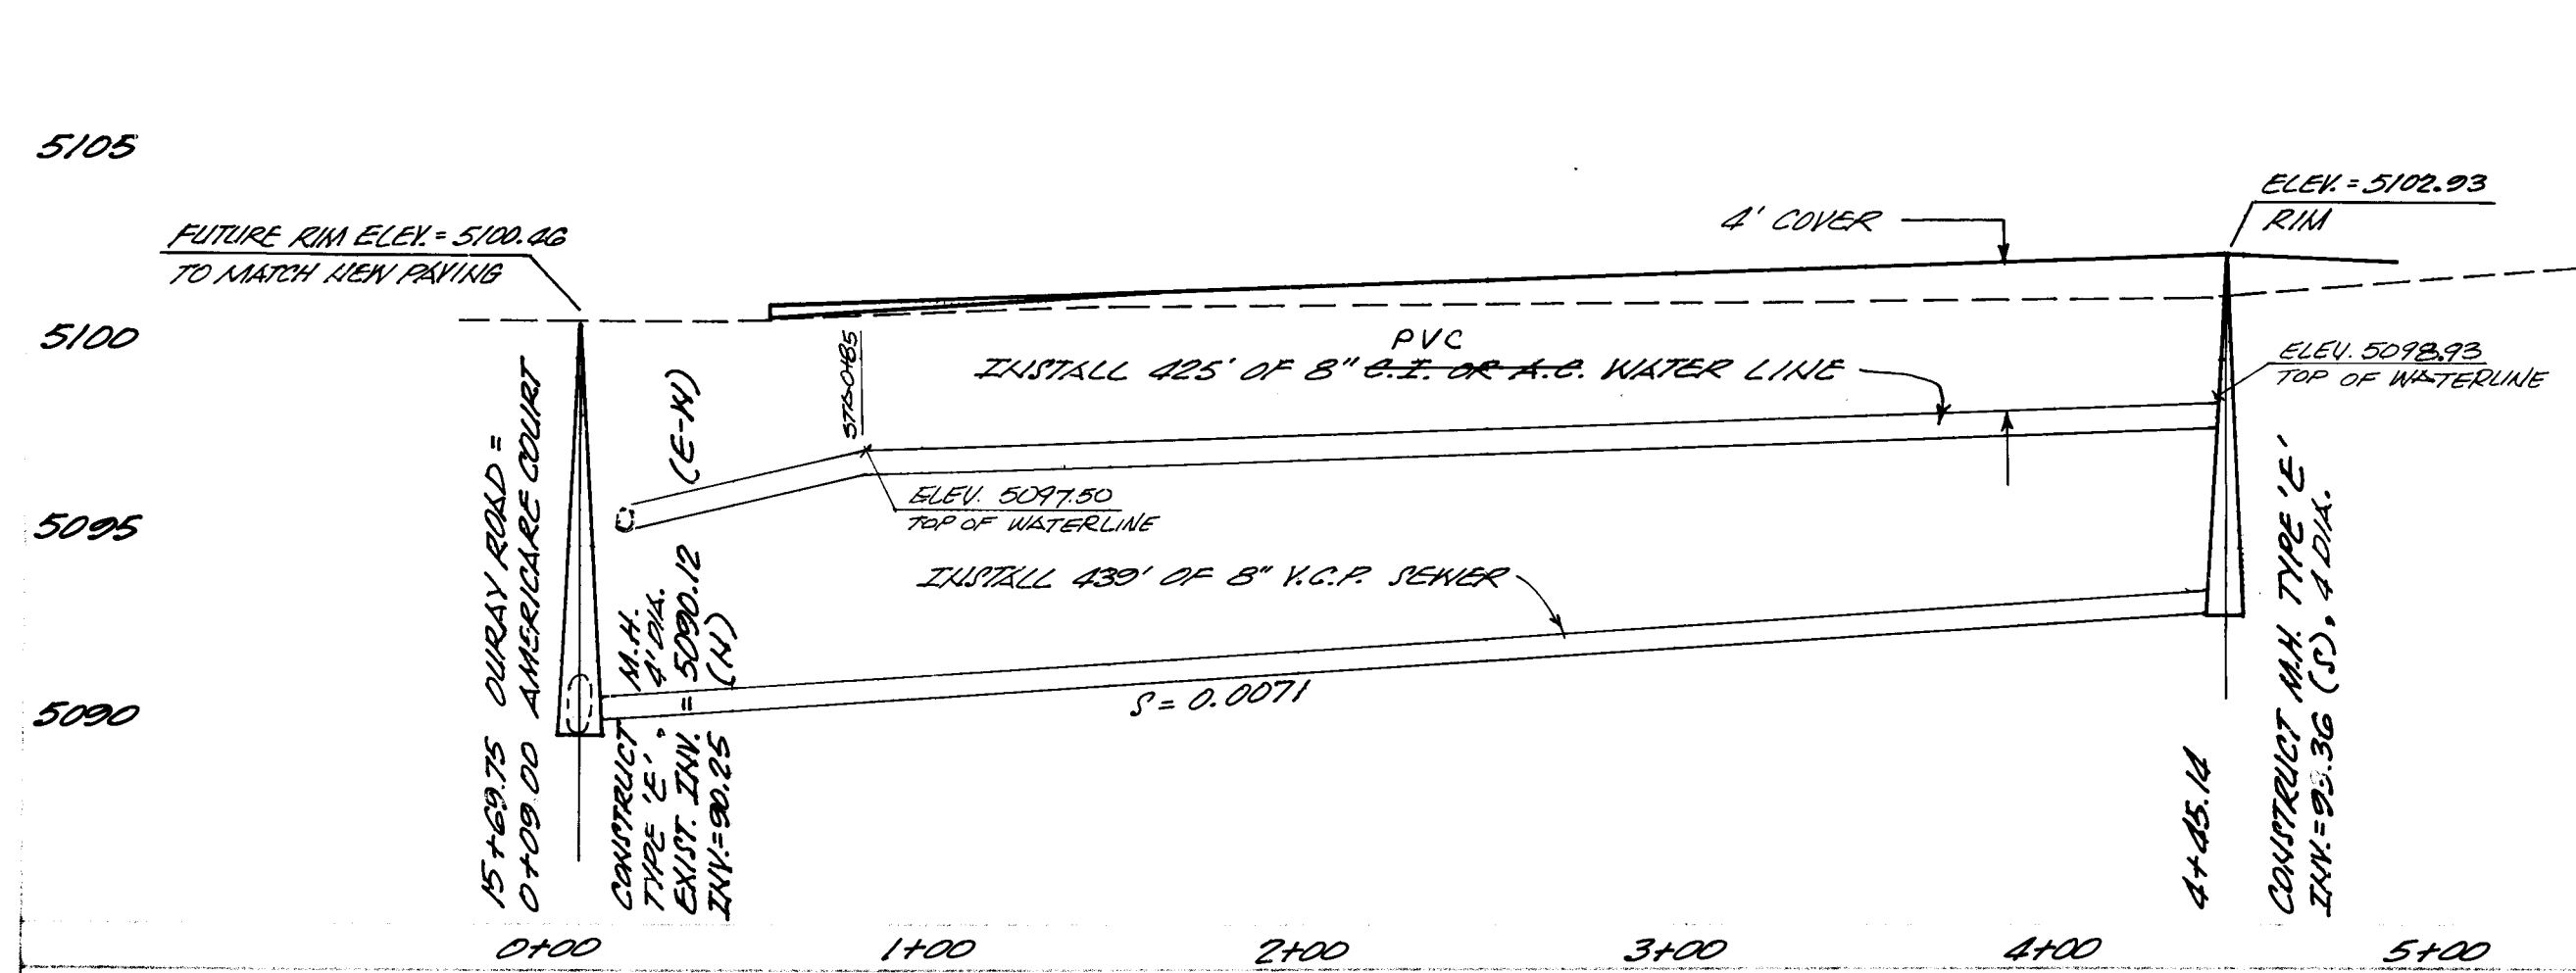
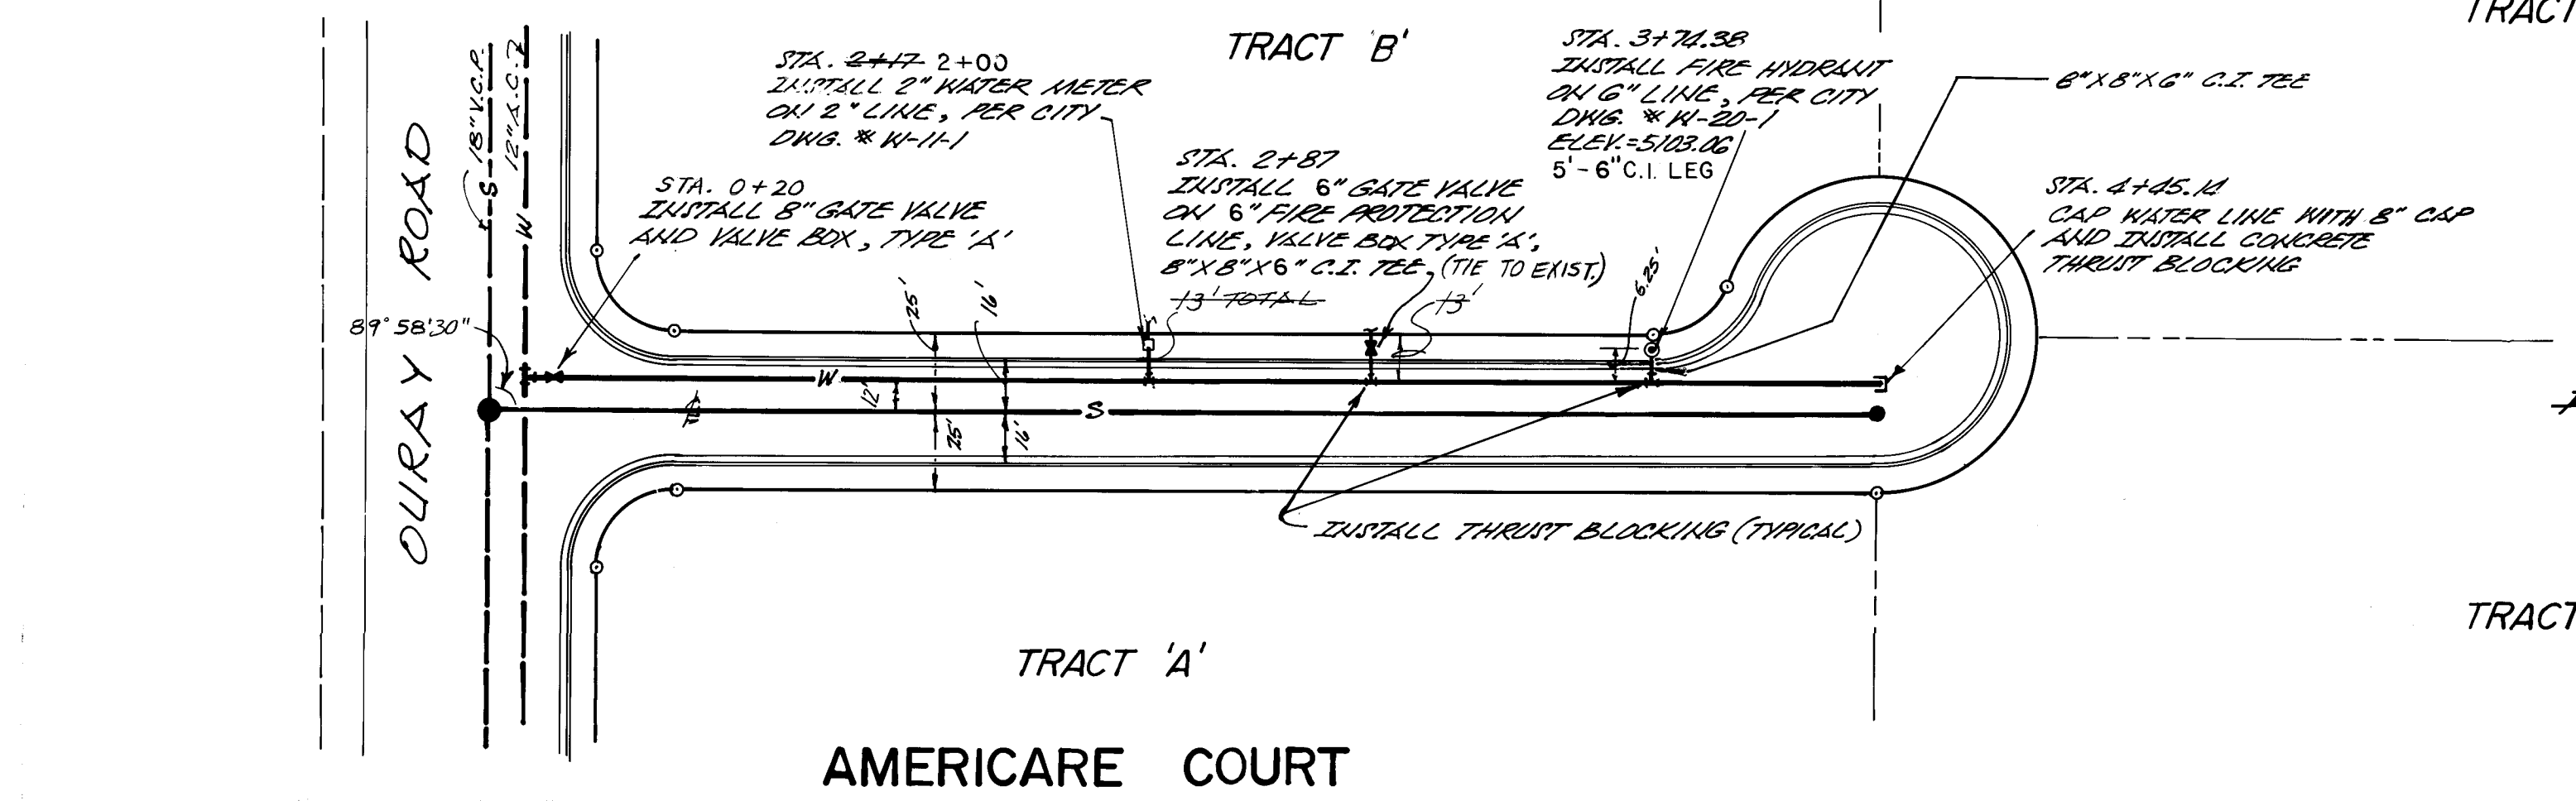
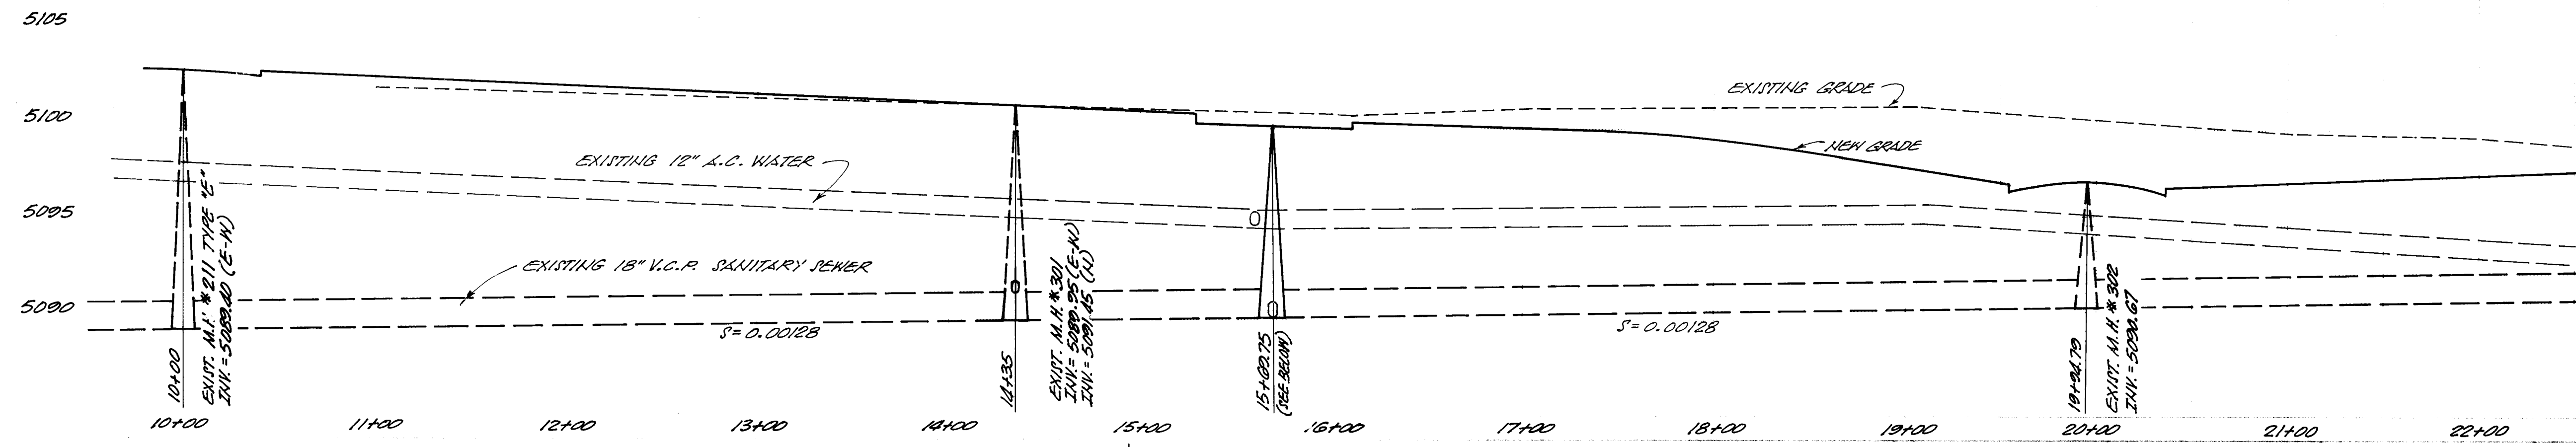


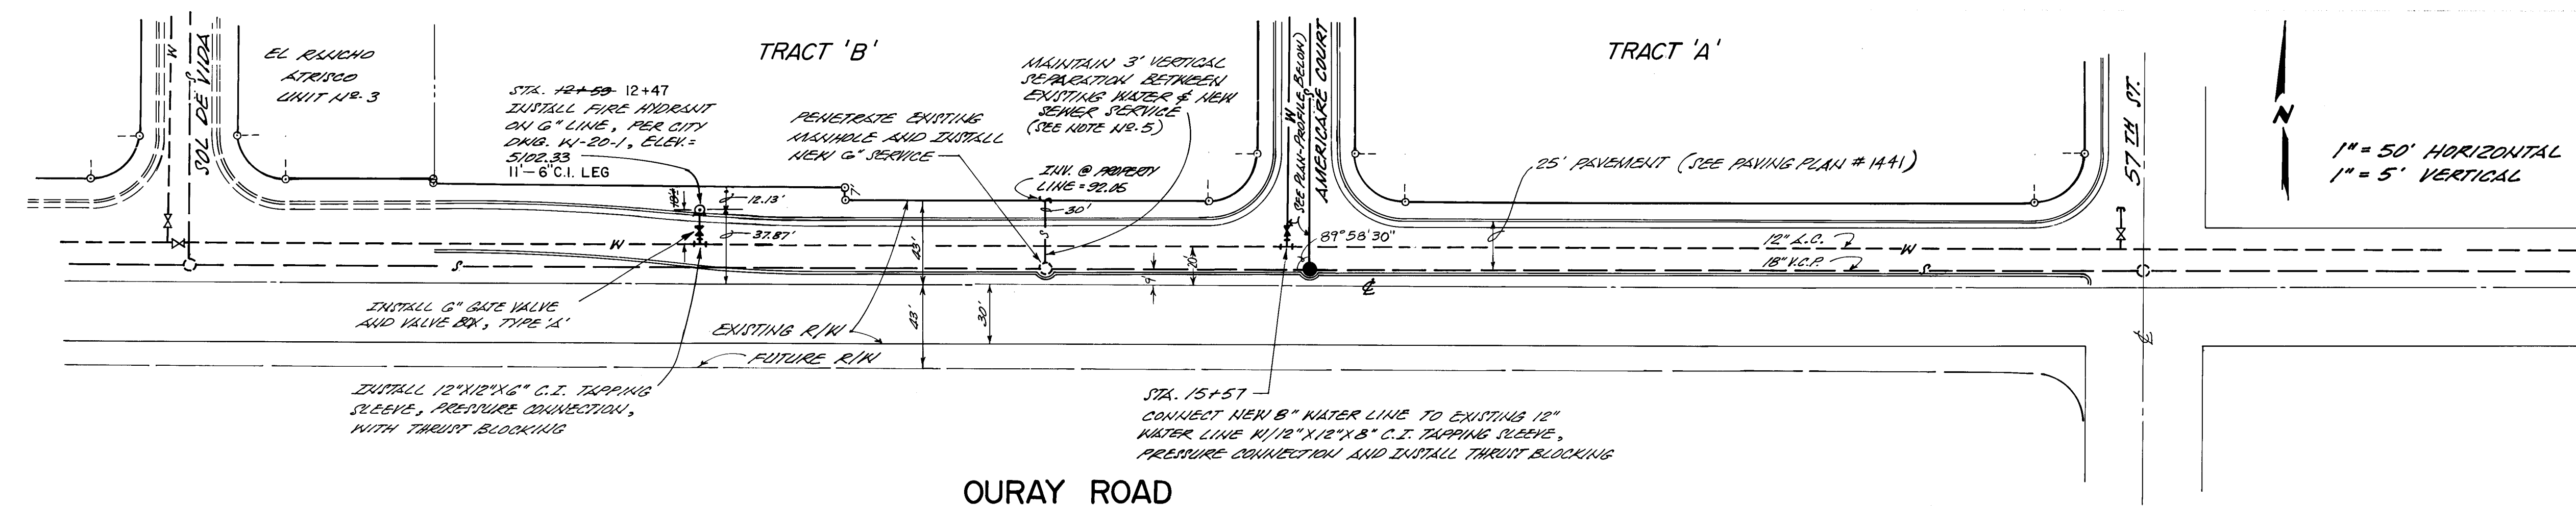

NOTICE TO CONTRACTORS

- 1) New Mexico Standard Specifications for Public Works Construction 1979 Edition will be referred to hereon as the "Standard Specifications."
- 2) All work detailed on these plans to be performed under contract shall, except as otherwise stated or provided for hereon, be constructed in accordance with "Contract Documents for City-Wide Utilities and Cash Paving No. 31 and the Standard Specifications."
- 3) Two working days prior to any excavation, contractor must contact Line Locating Service, 765-1234 for location of existing utilities.
- 4) Prior to construction, the contractor shall excavate and verify the horizontal and vertical locations of all obstructions. Should a conflict exist, the contractor shall notify the engineer or survey so that the conflict can be resolved with minimum of delay.
- 5) When installing the 6" sewer service line at Sta. 14+35, if unable to maintain 3' of vertical separation from existing 12" A.C. water line, sewer line shall be of ductile iron pipe, cast iron pipe, or concrete-encased as shown in City Drawing S-10 for 10' on each side of the water line.

THE FOLLOWING NOTES APPLY WHEN CHECKED:

- ☐ All utilities and utility service lines shall be installed prior to paving.
- ☒ Backfill compaction shall be according to specified street use. *ARTERIAL*
- ☐ Tack coat requirements shall be determined by the City Engineer.
- ☒ Sidewalks and wheelchair ramps within the curb returns shall be constructed wherever a new curb return is constructed.
- ☐ If curb is depressed for a driveway, the driveway shall be constructed prior to acceptance of the curb and gutter.
- ☐ All storm drain facilities shall be completed prior to final acceptance.

LEGEND

EXISTING SEWER MANHOLE	—○—
NEW SEWER MANHOLE	—●—
EXISTING WATER VALVE	—◇—
NEW WATER VALVE W/ VALVE BOX	—◇—
EXISTING WATERLINE	—W—
NEW WATERLINE	—W—
EXISTING SEWERLINE	—S—
NEW SEWERLINE	—S—

WATER ONLY
THIS CONTRACT

26 1621 0183

CITY OF ALBUQUERQUE
MUNICIPAL DEVELOPMENT DEPARTMENT
ENGINEERING DIVISION

TITLE: O'RAY ROAD & AMERICARE COURT
WATER & SEWER PLAN & PROFILE

APPROVALS	ENGINEER	DATE	APPROVALS	ENGINEER	DATE
City Engineer	John Sepanille	1-31-83	City Engineer	John Sepanille	1-31-83
ACE Design	John Sepanille	1-31-83	ACE Design	John Sepanille	1-31-83
ACE Hydrology	John Sepanille	1-31-83	ACE Hydrology	John Sepanille	1-31-83

DRAWING NO. 1621 MAP NO. H-11-Z SHEET 1 OF 1

APPROVED FOR CONSTRUCTION
CITY ENGINEER
DATE 2/23/83
for R.S. Hall