


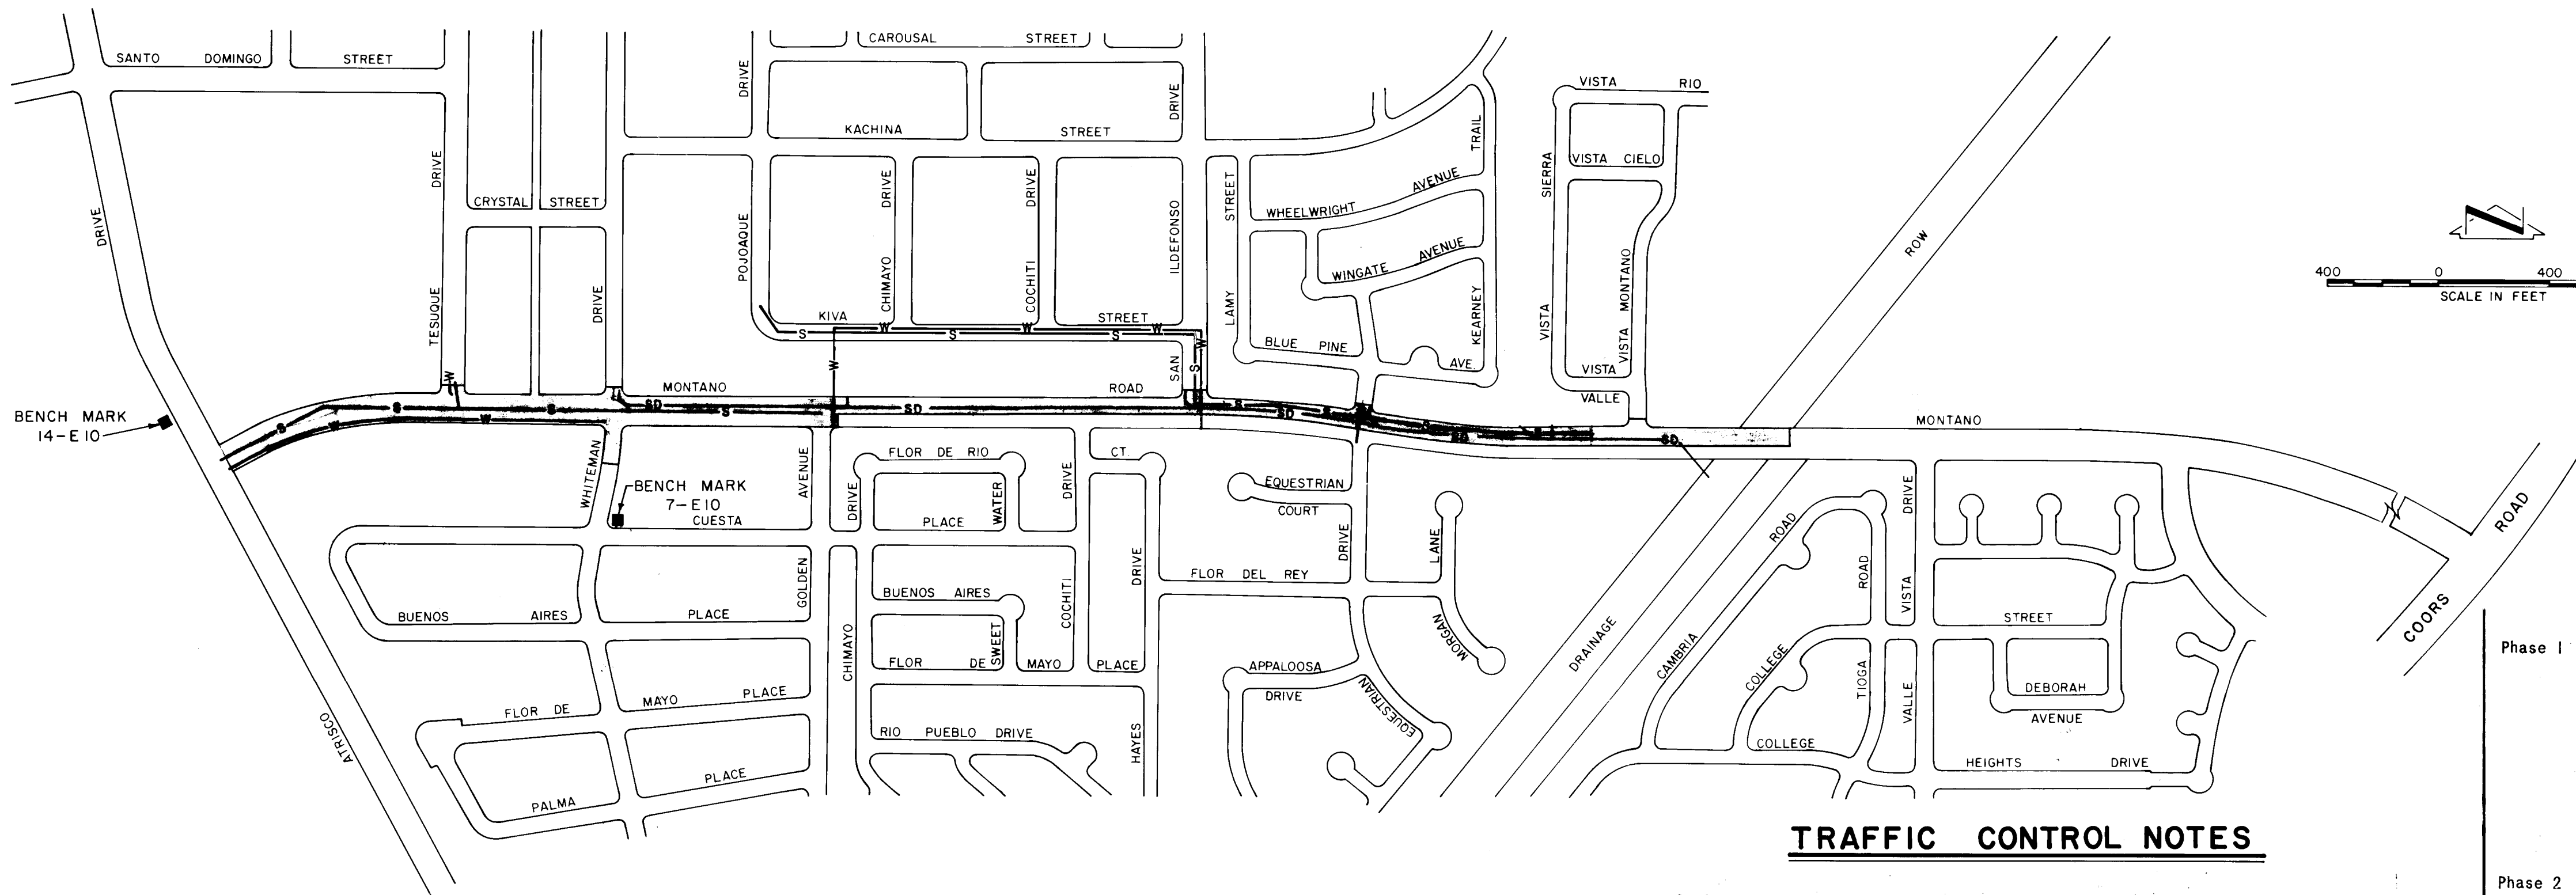

THESE DRAWINGS HAVE BEEN REVISED IN ACCORDANCE WITH INFORMATION FURNISHED BY J. R. HALL CONTRACTING COMPANY, INC. AND SCANLON AND ASSOCIATES, INC. TO REFLECT THE CONSTRUCTION AS ACTUALLY ACCOMPLISHED.

Robert W. Maxwell
ROBERT W. MAXWELL, P.E.
NO. 7089

CONSTRUCTION SEQUENCE (See Sheet 2A)

- Phase 1 Montano may be closed between Valle Vista and Golden as shown in Detour 1 for a maximum of 10 working days in order to create a work area for the crossing of the existing lanes of Montano with the required storm drain lines. The water line crossings at Equestrian Drive, San Ildefonso Drive and at Golden Avenue shall be installed as part of this phase. Access to all business and residents must be maintained at all times. An estimated 4 blue access signs with white, 5 inch lettering will be required during this phase.
- Phase 2 Two way traffic must be maintained on the existing Montano roadway between Valle Vista and Golden at all times during this phase. Montano may be closed between Golden and Unser as shown in Detour 2 during this phase. All sewer lines, water lines, curb, gutter, and pavement shall be installed on Montano between Golden and Valle Vista during this phase of construction. Access must be maintained to all businesses and residences at all times—at no time shall two consecutive cross streets to Montano be closed at the same time between Valle Vista and Golden. An estimated 4 additional access signs will be required during this phase.
- Phase 3 The newly constructed sections of Montano are to be opened to traffic with two way traffic maintained between Unser and Valle Vista. The contractor may use a traffic split, or a single lane closure as required in order to complete work on the intersections of Montano and Valle Vista and Montano and Golden, and any remaining curb, gutter, storm drain line work.
16. Exact location of relocated traffic signal foundations shall be determined by the Traffic Engineering Division.
17. The Contractor shall provide and maintain a safe and adequate means of channelizing pedestrian traffic around all work areas throughout the period of construction. All such channelization shall be arranged to prevent pedestrians from having to enter an open traffic lane in order to pass around the work areas.
18. All construction signing shall be black on a reflectorized orange field unless otherwise specified. All construction barricades and channelization devices shall be orange on white, reflectorized, unless otherwise specified.
19. The contractor shall be responsible for constructing and installing "Impending Construction" signs, subsequent to the award of the contract, and no less than seven days prior to the first day of expected construction work (See Special Provisions, Sec. 3A of the Project Specifications).
20. The contractor shall be responsible for notifying the news media prior to any approved lane closure(s) as indicated on the plans or as directed by the City Traffic Engineer. (See Special Provisions, Sec. 3B, of the Project Specifications).

TRAFFIC CONTROL NOTES

- Contractor must comply with section 19 of the City of Albuquerque's Interim Standard Specifications for Public Works Construction. All work included on traffic control shall be paid for under the Lump Sum Price for "Traffic Control" as provided in the Bid Proposal.
- All traffic control devices, and their placement, shall comply with Chapter VI of the 1978 Edition MANUAL FOR UNIFORM TRAFFIC CONTROL DEVICES.
- The contractor shall prepare and submit to the Project Engineer a detailed traffic control and/or detour plan, which must be approved by the City Traffic Engineer three (3) working days in advance of any required lane closures, if the contractor does not utilize the plan presented herein.
- Prior to the start of construction, the contractor shall submit to the Traffic Engineer a detailed construction sequence indicating when each section of roadway is to be effected by construction.
- The contractor must obtain a barricading permit from the Traffic Engineering office 2 days prior to each phase of construction.
- Contractor shall coordinate his construction activities so that road closures and detour routes will not conflict with other construction related detours in the area — Unser rehab project.
- Whenever Montano traffic is detoured, each M4-9 detour guide sign is to have an attached sign plate reading MONTANO and identifying the detour.
- All signs must be installed before construction begins as directed by the Engineer. Sign heights shall be 7ft. from the bottom of the sign to the sidewalk level.
- All drums may have sand or water ballast limited to 100lbs.
- All sign locations will be selected in the field and approved by the Project Engineer. Distances may be adjusted for local conditions.
- All signs will be ground mounted on single or double posts. Existing posts may be used at some locations, with the approval of the Project Engineer. Portable sign supports will be acceptable as an alternate.
- All signs will be moved forward as the construction progresses, as determined appropriate by the Project Engineer.
- The contractor shall maintain access to businesses and residences adjacent to the construction area at all times, unless such is unavoidable. Maximum Access closing for business shall in no way exceed (2) two hours during business hours. Maximum Access closing to residents shall not exceed (8) eight hours. Construction equipment and materials shall not be stored within the roadway or on the median during non-working hours, except within a barricaded, secured, closed area of the street. Any access closure to be approved by Traffic Engineering.
- When barriers are required after dark, all advance warning signs and all barricades shall be equipped with flashing warning lights (Type A), except that all channelizing barricades shall have steady burning warning lights (Type C).
- All existing regulatory signs and signals that need to be removed, relocated or reinstalled shall be done by the City of Albuquerque Traffic Engineering Division. The contractor shall notify the Traffic Engineering Division (3) three working days in advance of any required work.


SITE MAP

LEGEND

- | | |
|-------------------------------------|--------------------------------|
| EXISTING CURB & GUTTER | NEW PAVING LIMITS |
| NEW STANDARD & MEDIAN CURB & GUTTER | EDGE OF EXISTING DIRT ROAD |
| NEW ASPHALT CURB | NEW TEMPORARY PAVEMENT |
| EXISTING SIDEWALK | NEW PAVEMENT PATCH |
| NEW SIDEWALK | EXISTING GATE VALVE |
| NEW WHEEL CHAIR RAMP | NEW GATE VALVE |
| EXISTING TREE | EXISTING SANITARY SEWER LINE |
| EXISTING SIGN | EXISTING WATER LINE |
| EXISTING POLE | EXISTING GAS LINE |
| EXISTING FENCE | NEW WATER LINE |
| EXISTING BLOCK WALL | NEW SANITARY SEWER LINE |
| PI OR CONTROL POINT | NEW SANITARY SEWER MANHOLE |
| CONSTRUCTION & SURVEY & | EXISTING SPOT ELEVATION |
| R/W LINE | NEW SPOT ELEVATION |
| EXIST. UNDERGROUND ELECTRIC LINES | EXISTING TELEPHONE LINE |
| COLORLED, PATTERNED MEDIAN PAVEMENT | EXISTING CABLE TELEVISION LINE |
| | NEW FIRE HYDRANT |
| | NEW STORM DRAIN |
| | NEW STORM DRAIN MANHOLE |
| | NEW CATCH BASIN |
| | EXISTING BUTTERFLY VALVE |
| | PROPOSED BUTTERFLY VALVE |

PLANS PREPARED UNDER THE DIRECTION OF JENNIS B. BRAND 1374 NOV 20 1985 REGISTERED PROFESSIONAL ENGINEER		CITY OF ALBUQUERQUE MUNICIPAL DEVELOPMENT DEPARTMENT			
TITLE: SPECIAL ASSESSMENT DISTRICT NO. 197 SITE MAP AND LEGEND					
APPROVALS	ENGINEER	DATE	APPROVALS	ENGINEER	DATE
City Engineer	ALL/11/85	11/20/85	Liquid Waste	William J. Babel	11-20-85
A.C.E.-Design			Traffic	W. J. Babel	11-20-85
A.C.E.-Hydrology			Water	William J. Babel	11-20-85
DRAWING NO. 1635		MAP NO. E-10 & E-11		SHEET 2 OF 35	

RECORD DRAWING

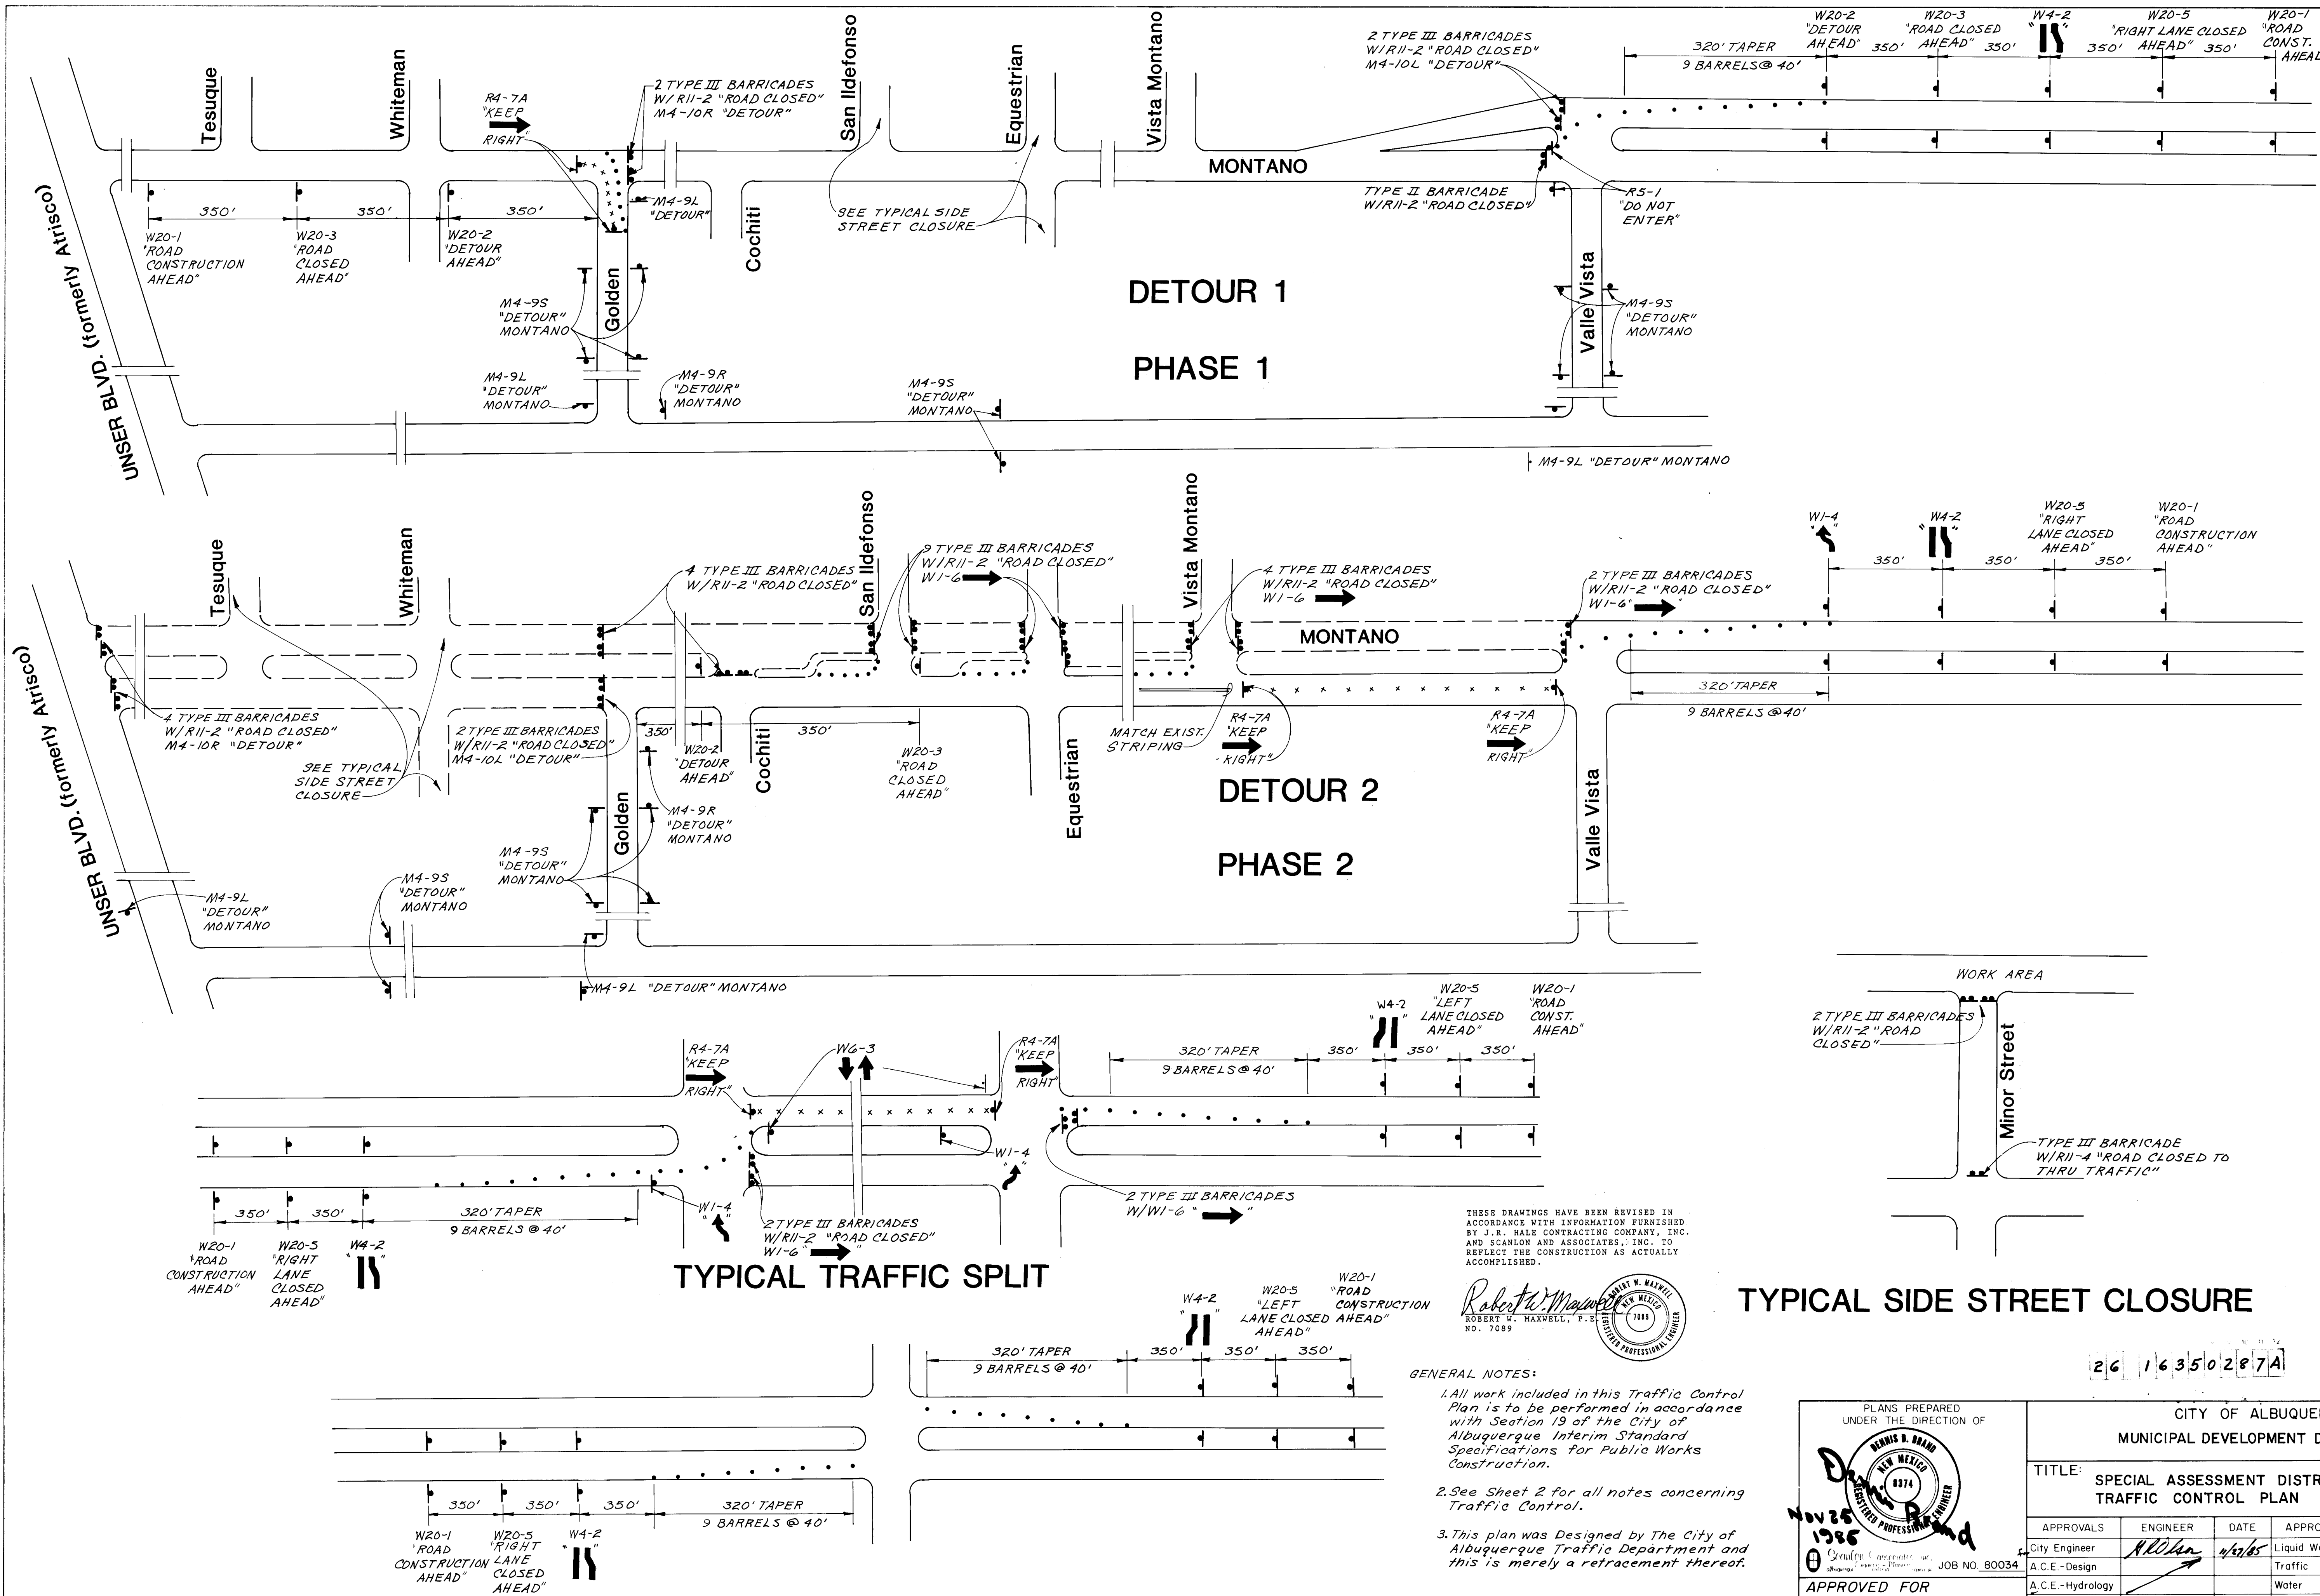

THESE DRAWINGS HAVE BEEN REVISED IN ACCORDANCE WITH INFORMATION FURNISHED BY J.R. HALE CONTRACTING COMPANY, INC. AND SCANLON AND ASSOCIATES, INC. TO REFLECT THE CONSTRUCTION AS ACTUALLY ACCOMPLISHED.

Robert W. Maxwell
 ROBERT W. MAXWELL, P.E.
 NO. 7089

PROFESSIONAL ENGINEER


- GENERAL NOTES:**
1. All work included in this Traffic Control Plan is to be performed in accordance with Section 19 of the City of Albuquerque Interim Standard Specifications for Public Works Construction.
 2. See Sheet 2 for all notes concerning Traffic Control.
 3. This plan was Designed by The City of Albuquerque Traffic Department and this is merely a retracement thereof.

PLANS PREPARED UNDER THE DIRECTION OF 					
CITY OF ALBUQUERQUE MUNICIPAL DEVELOPMENT DEPARTMENT					
TITLE: SPECIAL ASSESSMENT DISTRICT NO. 197 TRAFFIC CONTROL PLAN					
APPROVALS	ENGINEER	DATE	APPROVALS	ENGINEER	DATE
City Engineer	<i>ALDhan</i>	4/27/85	Liquid Waste	<i>R. J. Parker</i>	11-25-85
A.C.E.-Design			Traffic	<i>Allyah NA</i>	11-25-85
A.C.E.-Hydrology			Water		
DRAWING NO. 1635		MAP NO.		SHEET 2A OF 35	

AS BUILT INFORMATION		BENCH MARKS		SURVEY INFORMATION		REFERENCES		REMARKS	
CONTRACTOR	J.R. Hale Co. Inc.	INSPECTOR	Scanlon & Assoc.	DATE	12/86	MAP NO.	EST. NO.	BY	DATE
INSPECTOR'S ACCEPTANCE		DATE		NO.		W.O. NO.		REVISIONS	DESIGN
DATE	12/86	DATE							
VERIFICATION	Scanlon & Assoc.	DATE	12/86						
DATE	12/86	DATE							
RECORDED BY		DATE							
NO.		NO.							


RECORD DRAWING

GENERAL NOTES

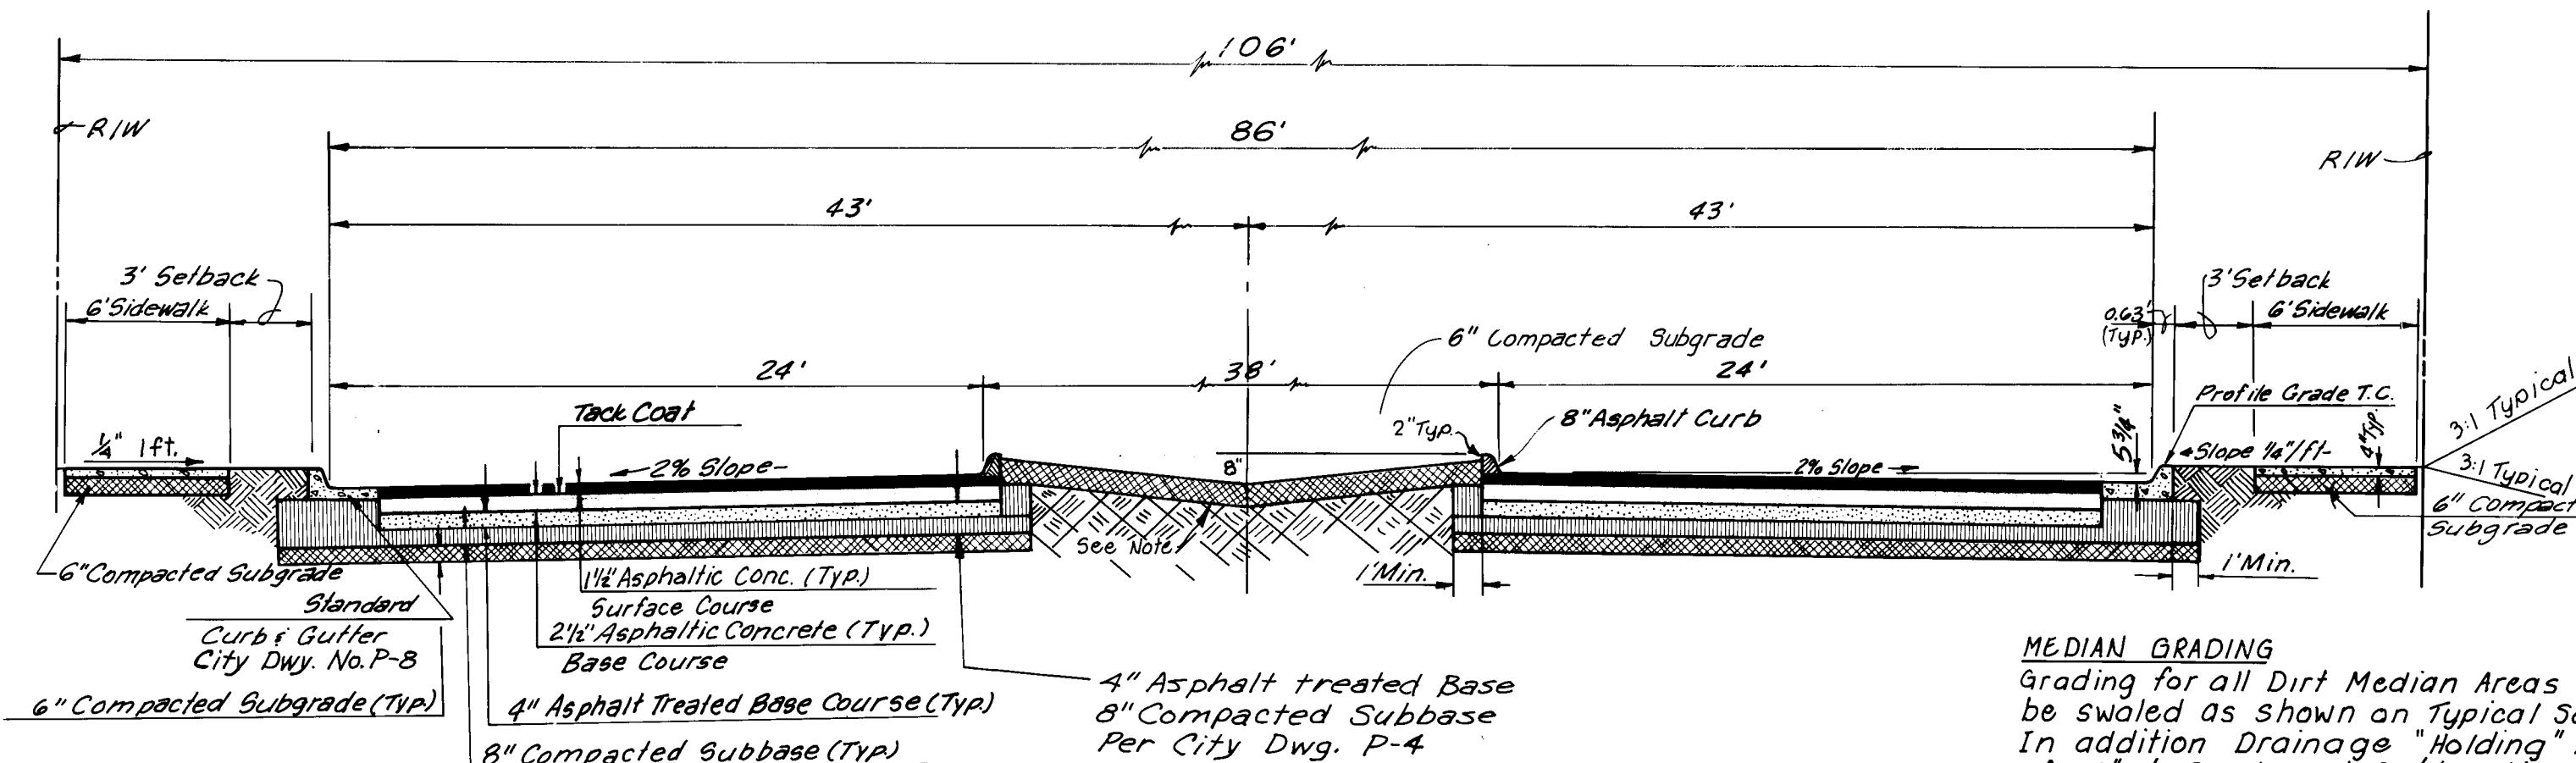


TYPICAL ARTERIAL STREET SECTION (MONTAÑO)

MEDIAN GRADING
Grading for all Dirt Median Areas shall be swaled as shown on Typical Section. In addition Drainage "Holding" Areas of 16" x Depth and 20' Length shall be placed at each low point on the median (Just Prior to Intersections) and at all intermediate points not to exceed 300' spacing.

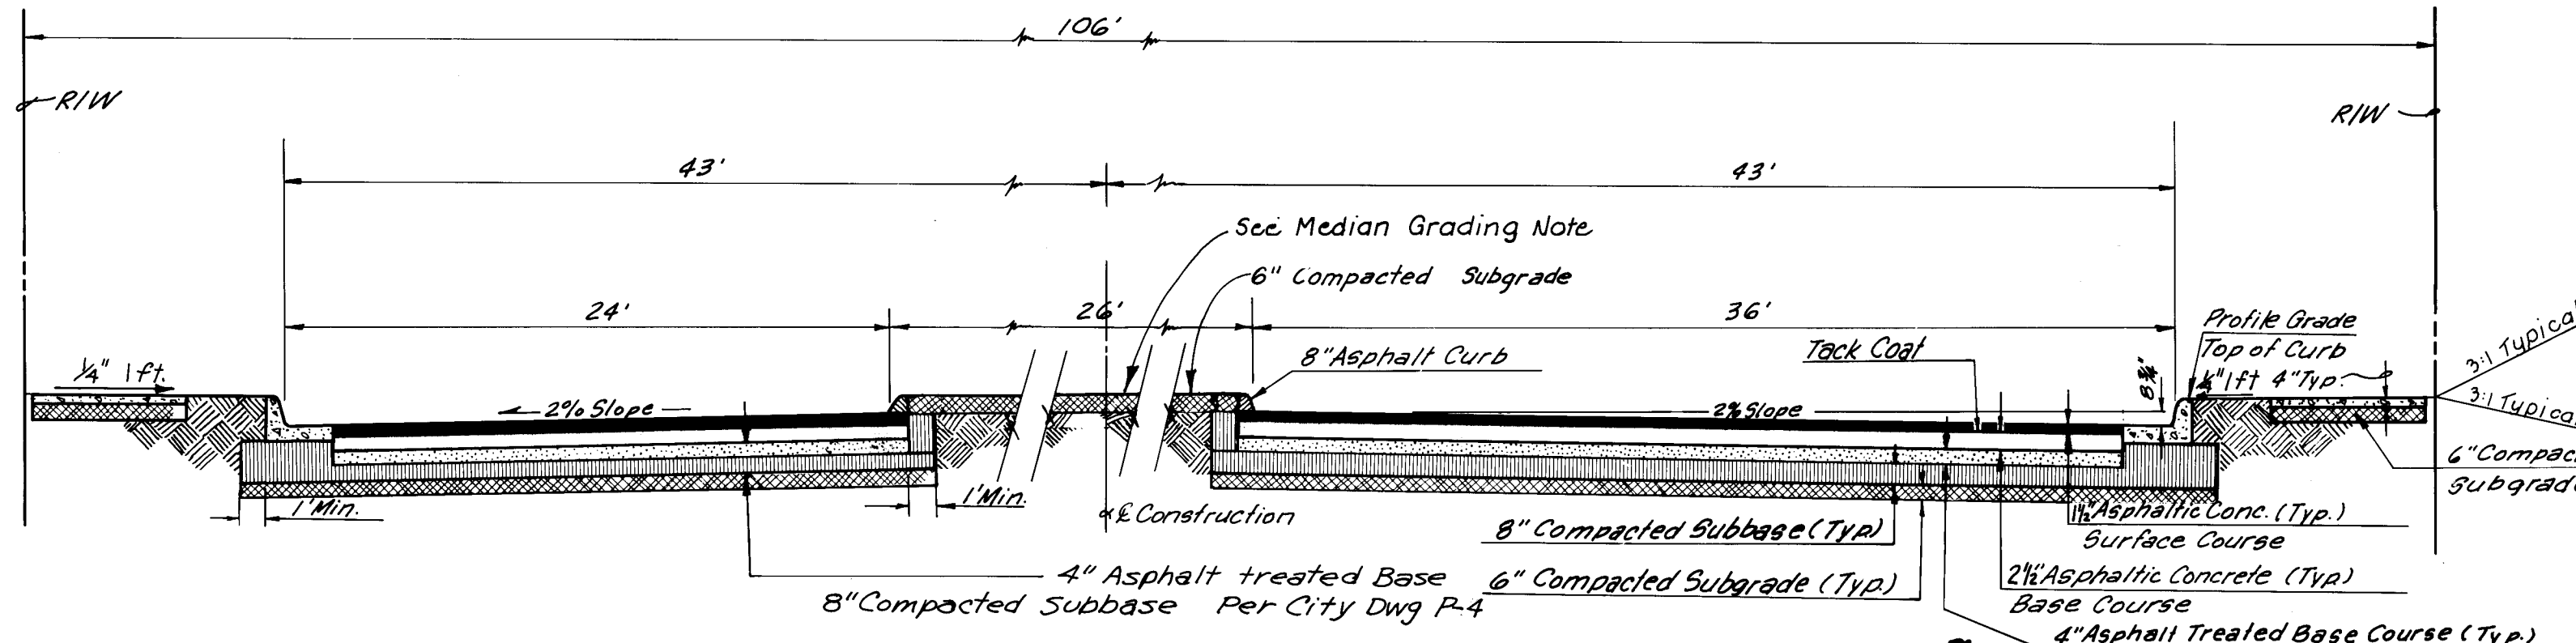

TYPICAL ARTERIAL STREET SECTION WITH HOLDING LANE (MONTANO
NO SCALE

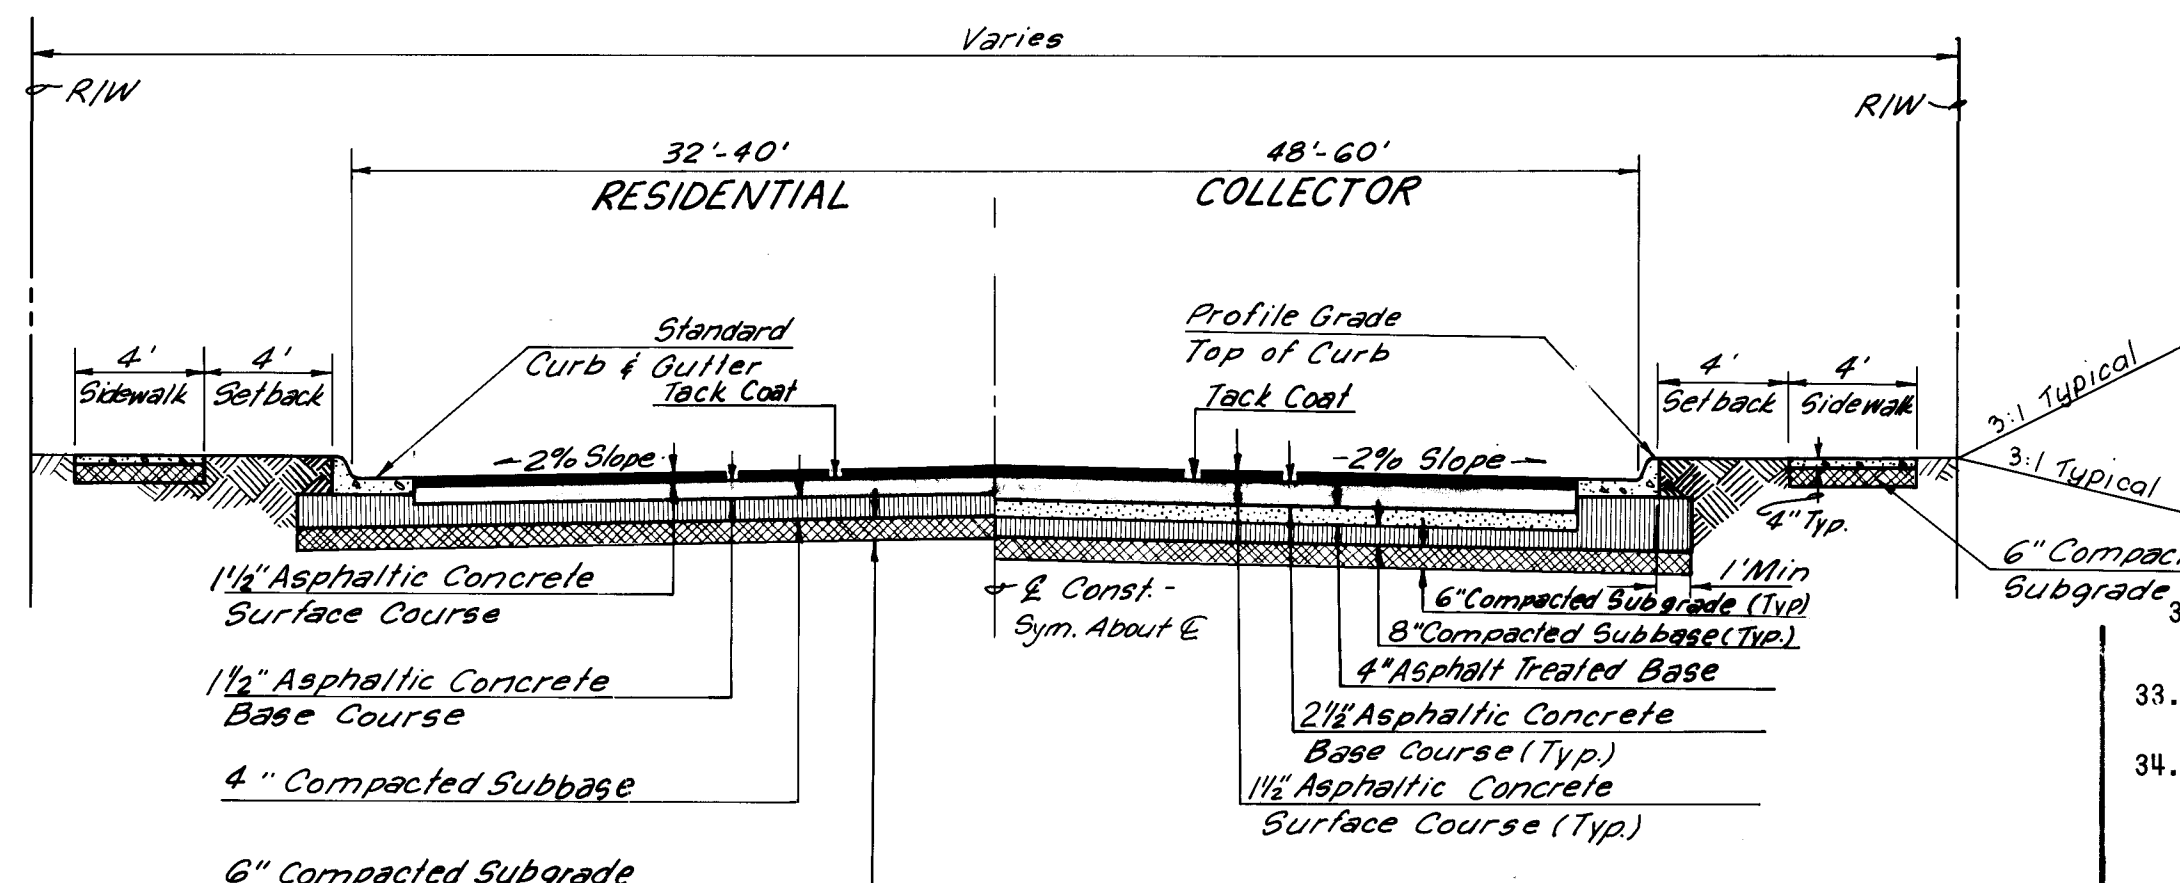

TYPICAL RESIDENTIAL AND COLLECTOR STREET SECTION
NO SCALE

35. Portions of construction of various sidewalks and utility extensions for this project are based on the city's obtaining temporary or permanent easements for construction. If such easements are not obtained, the City Engineer reserves the right to delete the affected improvements from this project. *Do Not Proceed with any Construction on Temporary Easements until Specifically authorized by the City Engineer.*

THESE DRAWINGS HAVE BEEN REVISED IN ACCORDANCE WITH INFORMATION FURNISHED BY J.R. HALE CONTRACTING COMPANY, INC AND SCANLON AND ASSOCIATES, INC. TO REFLECT THE CONSTRUCTION AS ACTUALLY ACCOMPLISHED.

Robert W. Maxwell
ROBERT W. MAXWELL, P.E.
NO. 7089



1. City of Albuquerque Interim Specifications for Public Works Construction 1985 Edition, and any revisions and or additions to the Specifications and Contract Documents, shall govern the construction of this project.
2. The Contractor shall notify all utility companies when working near their systems, Two full working days prior to any excavation, contractor must contact Line Locating Service, 765 123rd, for location of existing utilities.
3. All existing utilities shown here were taken as accurately as possible from record drawings and surface indications. It shall be the Contractor's responsibility to protect, maintain in service, and verify exact locations of all affected utilities during construction of this project.
4. All utilities which are to be abandoned under this contract shall be plugged with concrete at each end of the portion to be abandoned. Payment for this work will be incidental to the work on the adjacent lines.
5. Curb return radii and street widths are to the face of the curb unless otherwise indicated in the plans.
6. Where removal of existing curb and gutter or sidewalk is required, remove to the nearest joint or saw cut.
7. When abutting new paving to existing, saw cut existing paving on a right angle, or as required by the Project Engineer to remove any broken, raveled, or cracked paving and match the new paving grade to the existing. No separate payment shall be made but shall be considered incidental to the project.
8. Curb and gutter shown as existing and not to be removed under this contract which is damaged or displaced by the Contractor or his sub-contractors, shall be replaced by the Contractor at his expense.
9. Existing materials to be removed and paid for on a unit basis shall be measured and the quantities approved by the Engineer before removal.
10. Connection of new sewer lines to existing manholes and plugging of existing lines in manholes shall be incidental to other items of work.
11. New water lines to have a minimum cover of 36" unless otherwise called out in the plans.
12. Remove all valve boxes from abandoned water lines. Payment will be incidental to the paving cost.
13. All abandoned valve and meter box frames and covers shall be returned to the City Water Division warehouse and all storm and sanitary manhole lids and inlet grates, castings, and frames not reused, shall be returned to the Liquid Waste Division warehouse.
14. The maximum allowable quantities for payment for replacement of pavement where water, sanitary sewer, and storm sewer are to be installed under existing pavement will be computed in accordance with the specifications.
15. The Contractor shall expose existing water lines at locations where new sanitary sewer lines cross or parallel such lines within 5 feet in order to adequately establish the proximity of water and sewer lines. The cost of this work shall be incidental to other items of work.
16. Prior to construction, exploratory excavation may be required as directed by the Project Engineer to more specifically locate utility lines. There will be no direct payment for this item of work. Cost will be considered incidental to other items of work.
17. All water meters, water valve boxes, and sewer manholes in the construction area where street grades change are to be adjusted by the Contractor to finished grade under this contract. The Contractor shall be required to set reference points for locating manholes prior to any grading operation. Measurement and payment for this work shall be included in unit price bid for appropriate items.
18. No separate bid item has been established for concrete curb return fillets. Cost to be included in price bid per Square Foot of P.C.C. Valley Gutter.
19. Water Service shall include installation of, Line, Corp. Stop, Curb Stop, Box, Pad, Yoke and Lid.
20. The Contractor will be required to confine his work within the construction limits and/or right-of-way to preserve existing vegetation and private property.
21. Mailboxes within new construction shall be relocated to right-of-way line by the Contractor. The Contractor shall coordinate and obtain approval of relocation of mailboxes with U.S. Postal Service, and Property Owner / Resident. Cost of work shall be considered incidental to other items.
22. Utility relocation schedules shall be confirmed for coordination at the pre-construction conference
23. Utility relocations required by the construction of this project are to be coordinated by the Contractor during construction. No additional compensation will be allowed for delays or inconveniences caused by utility company work crews. The Contractor may be required to reschedule his activities to allow utility crews to perform their required work.
24. No driveways have been shown on the plans. Quantities include eight (8) driveways, which is the approximate number anticipated. Contractor will be responsible for the proper location of driveway sections. Property owners shall be notified that a curb cut permit from City Traffic Engineering is required in order to establish any driveways onto Montano. Any permit issued will be forwarded by Traffic Engineering to the Project Engineer. No driveways will be installed without the written approval of the Traffic Division.
25. The contractor shall maintain access to businesses and residences adjacent to the construction area at all times unless such is unavoidable. Maximum Access closing for business shall in no way exceed two (2) hours during business hours. Maximum Access closing to residents shall not exceed eight (8) hours. Construction equipment and materials shall not be stored within the roadway or on the median during non-working hours, except within a barricaded, secured, closed area of the street. Any access closure to be approved by Traffic Engineering.
- 25A. Stationary Bollards as required for Wheelchair Ramps shall be considered incidental to paving.
26. All valve box rings and covers shall be painted with blue enamel or epoxy paint. color shall be equivalent to "Safety Blue".
27. Sidewalks and Wheelchair ramps within the curb returns shall be constructed wherever a new curb return is constructed. Wheelchair ramps shall be paid for at the unit price for sidewalks.
28. A disposal site for all excess excavation material, asphaltic paving, concrete paving, etc. shall be obtained by contractor, and approved by the Project Engineer in compliance with applicable regulations. All costs incurred in obtaining a disposal site and haul thereto shall be considered incidental to bid item numbers 1, 12, 13, or 14 as appropriate, and no separate payment will be made thereof.
29. Pavement in median, where specified, shall be red, concrete with brick pattern.
30. Fifty ton roller operation shall not be used on this project where underground utilities are present. The required compaction of these locations shall be effected by other types of approved compaction methods.
31. All work on this project shall be performed in accordance with applicable Federal, State and local laws, rules and regulations concerning construction safety and health.
- or areas greater than 2 feet of fill have been estimated from the aerial photography, dated 1981, and no recent field surveys have been performed. The reflect existing conditions, and contractor is advised to perform his own estimate of the work required.

PLANS PREPARED

UNDER THE DIRECTION OF

A circular professional engineer seal for Dennis R. Brand, State of New Mexico, License No. 8374. The seal includes the text "REGISTERED PROFESSIONAL ENGINEER" and "NEW MEXICO".

N-120
1985

SCANLON & ASSOCIATES

CIVIL ENGINEERS

JOB NO. 80034

**APPROVED FOR
CONSTRUCTION**

CITY ENGINEER DATE

CITY OF ALBUQUERQUE

MUNICIPAL DEVELOPMENT DEPARTMENT

TITLE: SPECIAL ASSESSMENT DISTRICT NO. 197
TYPICAL SECTIONS AND GENERAL NOTES

APPROVALS	ENGINEER	DATE	APPROVALS	ENGINEER	DATE
City Engineer	<i>[Signature]</i>	11/27/85	Liquid Waste	<i>[Signature]</i>	11-20-85
A.C.E. - Design	<i>[Signature]</i>		Traffic	<i>[Signature]</i>	11-20-85
A.C.E. - Hydrology	<i>[Signature]</i>		Water	<i>[Signature]</i>	11-20-85

DRAWING NO.

1635


MAP NO.

F-1085-11

SHEET 3 OF 35


RECORD DRAWING

PROFILE	SURVEYED	BY	DATE
	PLOTTED		
	GRADES CHECKED		
	B. M.'s NOTED		
	STRUCTURE NOTATIONS CHECKED		

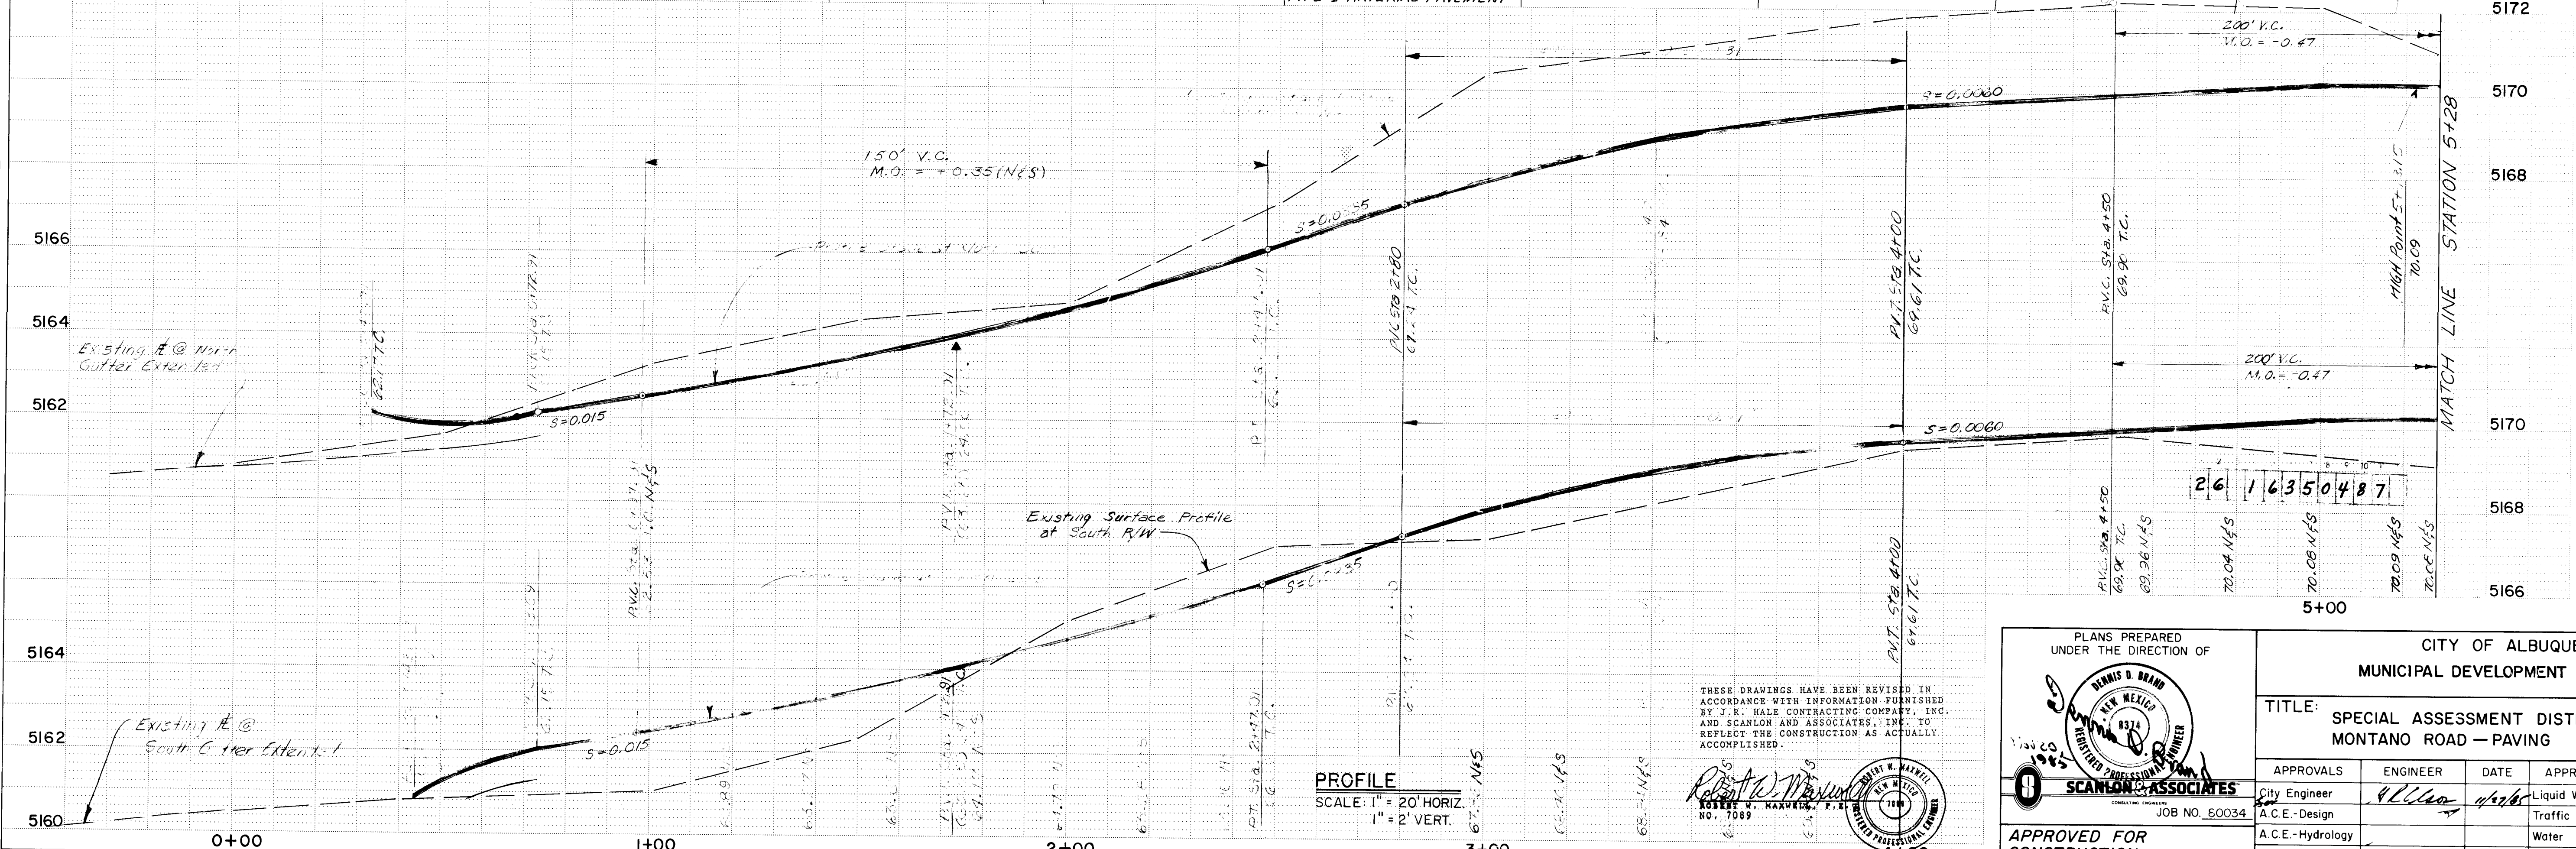[illegible]

PLAN	DATE	BY
SURVEYED		
NOTED		
ALIGNED		
CHECKED		
RT. OF WAY		

PROFILE	DATE	BY
SURVEYED		
NOTED		
GRADES		
CHECKED		
STRUCTURE		
NOTATIONS		

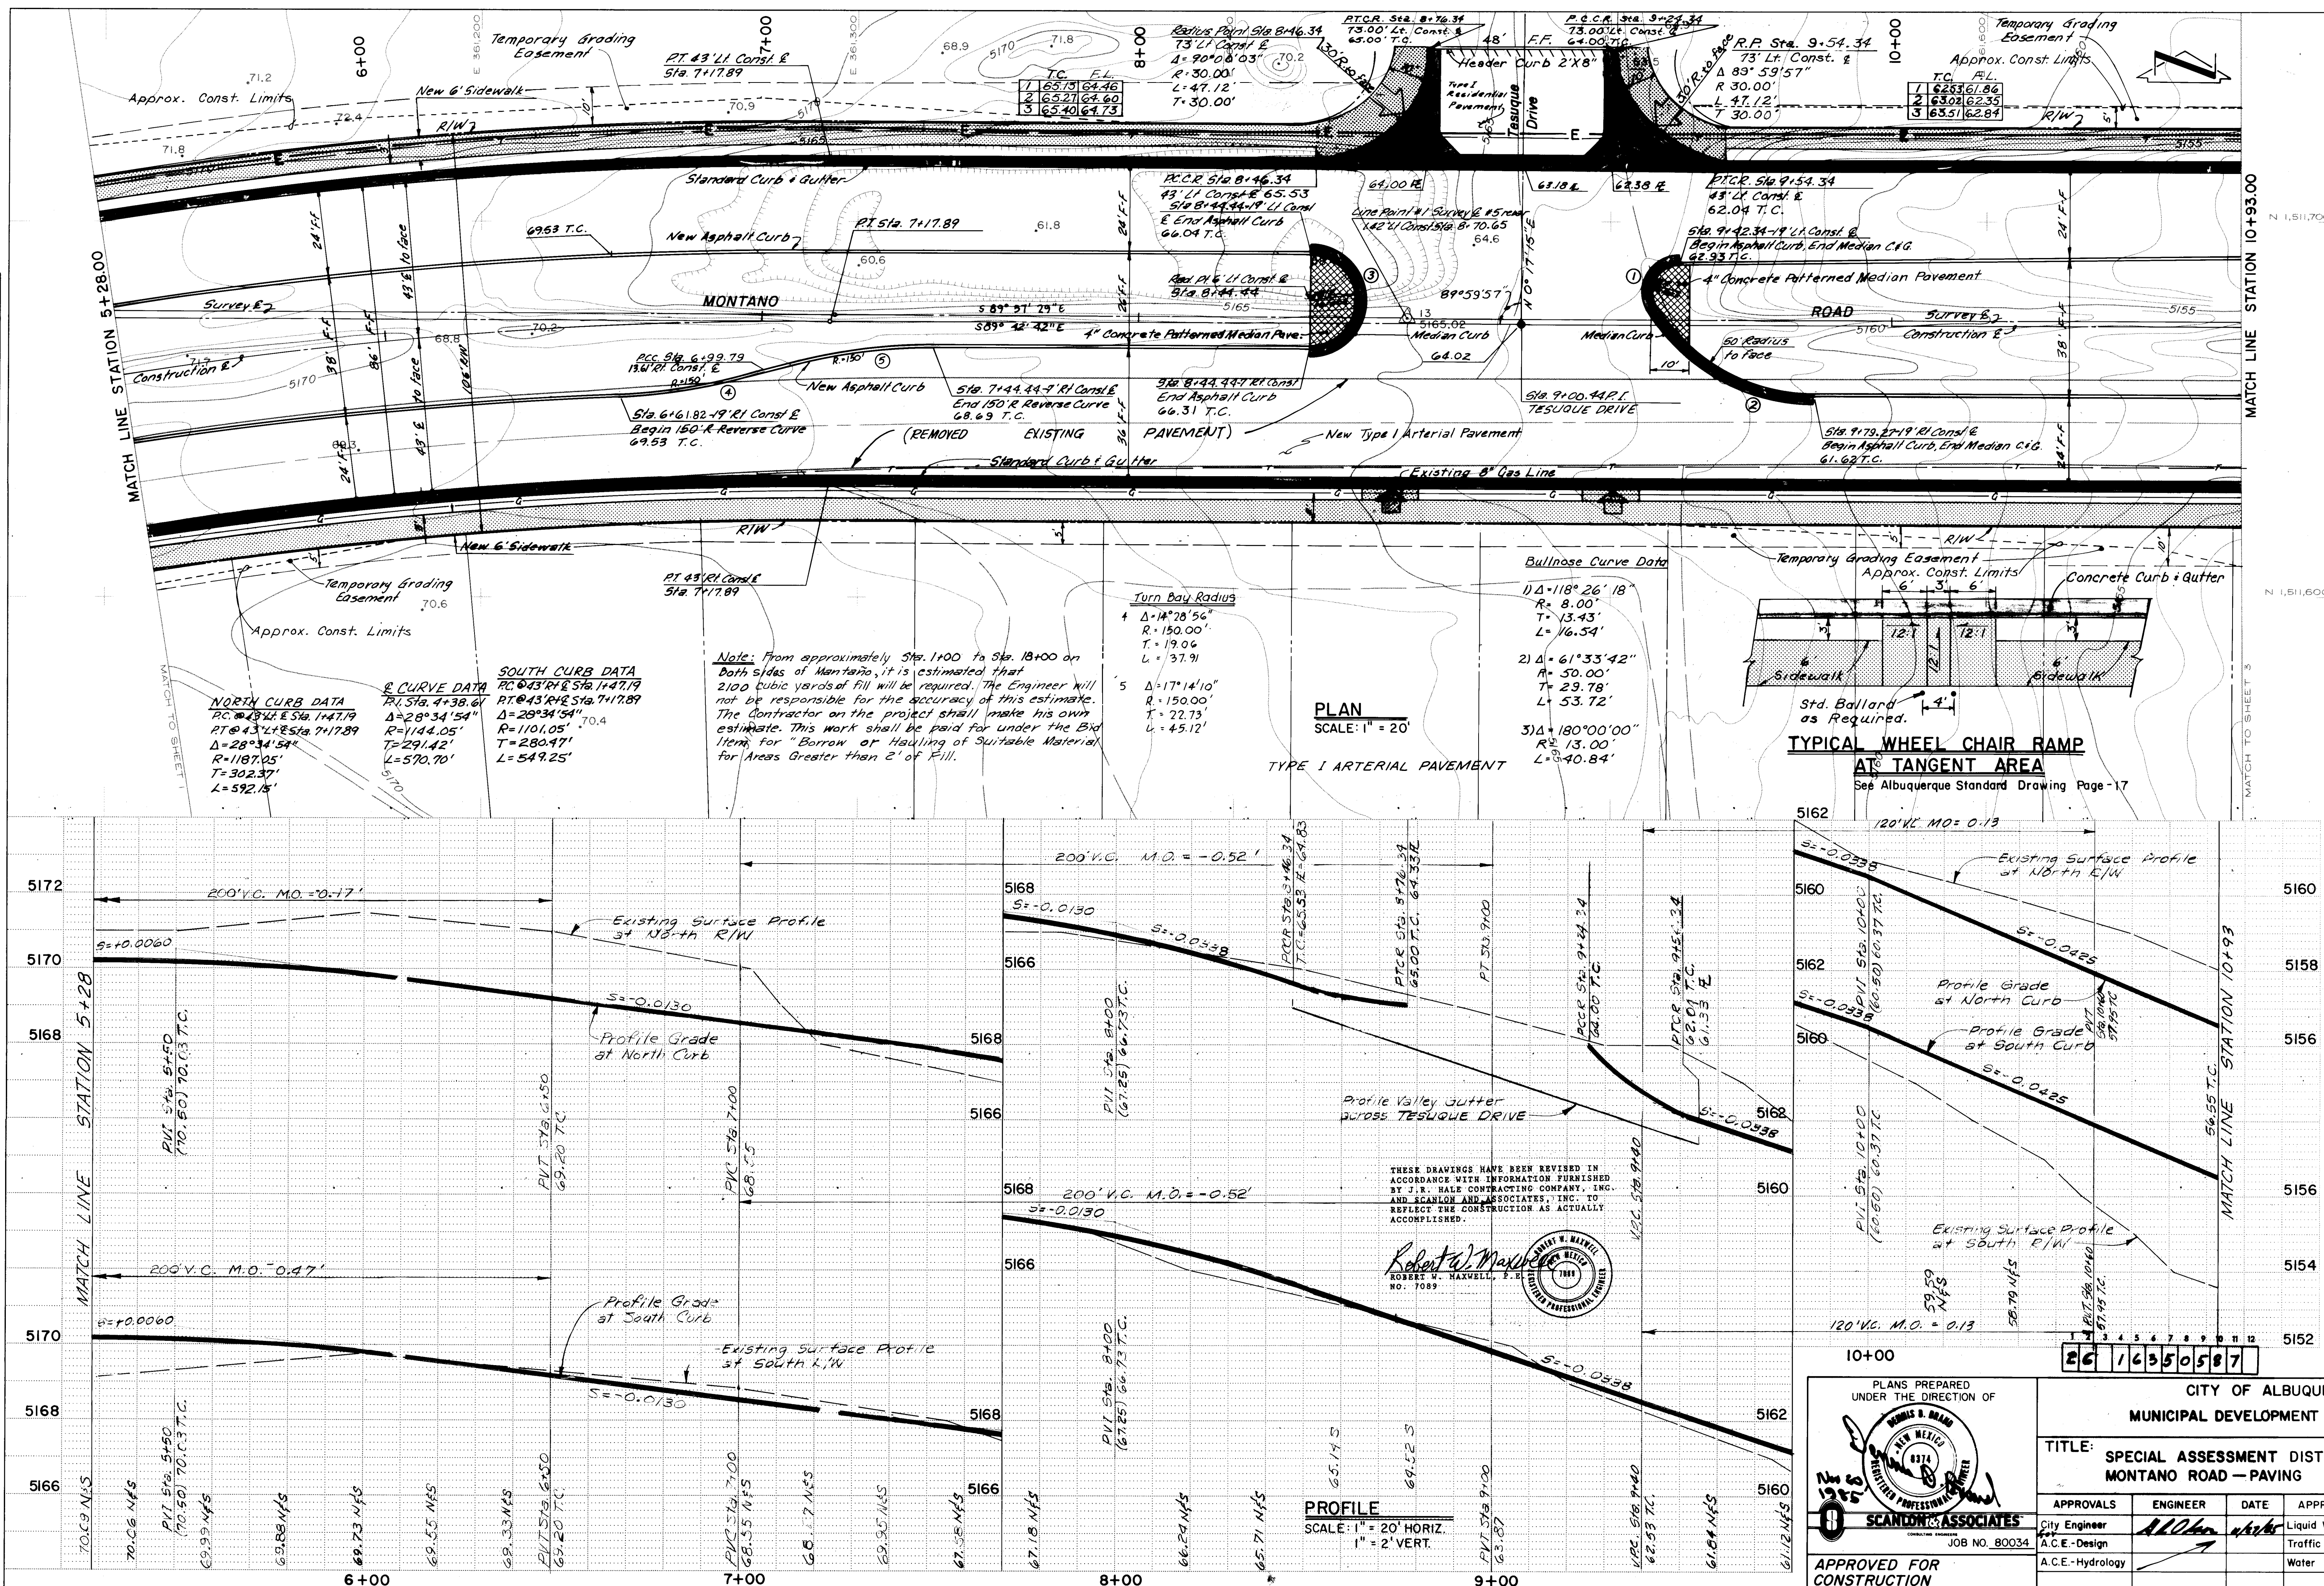


AS BUILT INFORMATION			
CONTRACTOR: J.R. Hale Co. Inc.			
STANDARD: 11-12-86			
DATE: 11-22-86			
DRAWN BY: M.C. L.H.			
CHECKED BY:			
SURVEY INFORMATION			
MAP NO. 6-10	EST. NO.	W.O. NO.	DATE
BENCH MARKS			
BM 14+10.4 40 penny nail in concrete, 180' north of Junction Alameda Road & Montano Road West of Alameda Elev. 5145.930			
MICRO-FILM INFORMATION			
RECORDED BY: NO. DATE			
DESIGNED BY: DATE			
REVISIONS			
NO.	DATE	REMARKS	DESIGN
CITY OF ALBUQUERQUE MUNICIPAL DEVELOPMENT DEPARTMENT			
TITLE: SPECIAL ASSESSMENT DISTRICT NO. 197 MONTANO ROAD - PAVING			
APPROVALS	ENGINEER	DATE	APPROVALS
City Engineer	ALDOVA	11-22-86	Liquid Waste
A.C.E. - Design			Traffic
A.C.E. - Hydrology			Water
DRAWING NO. 1635		MAP NO. E-10	SHEET 5 OF 35

RECORD DRAWING

PLAN	DATE
BY	
NO.	



PROFILE	DATE
BY	
NO.	

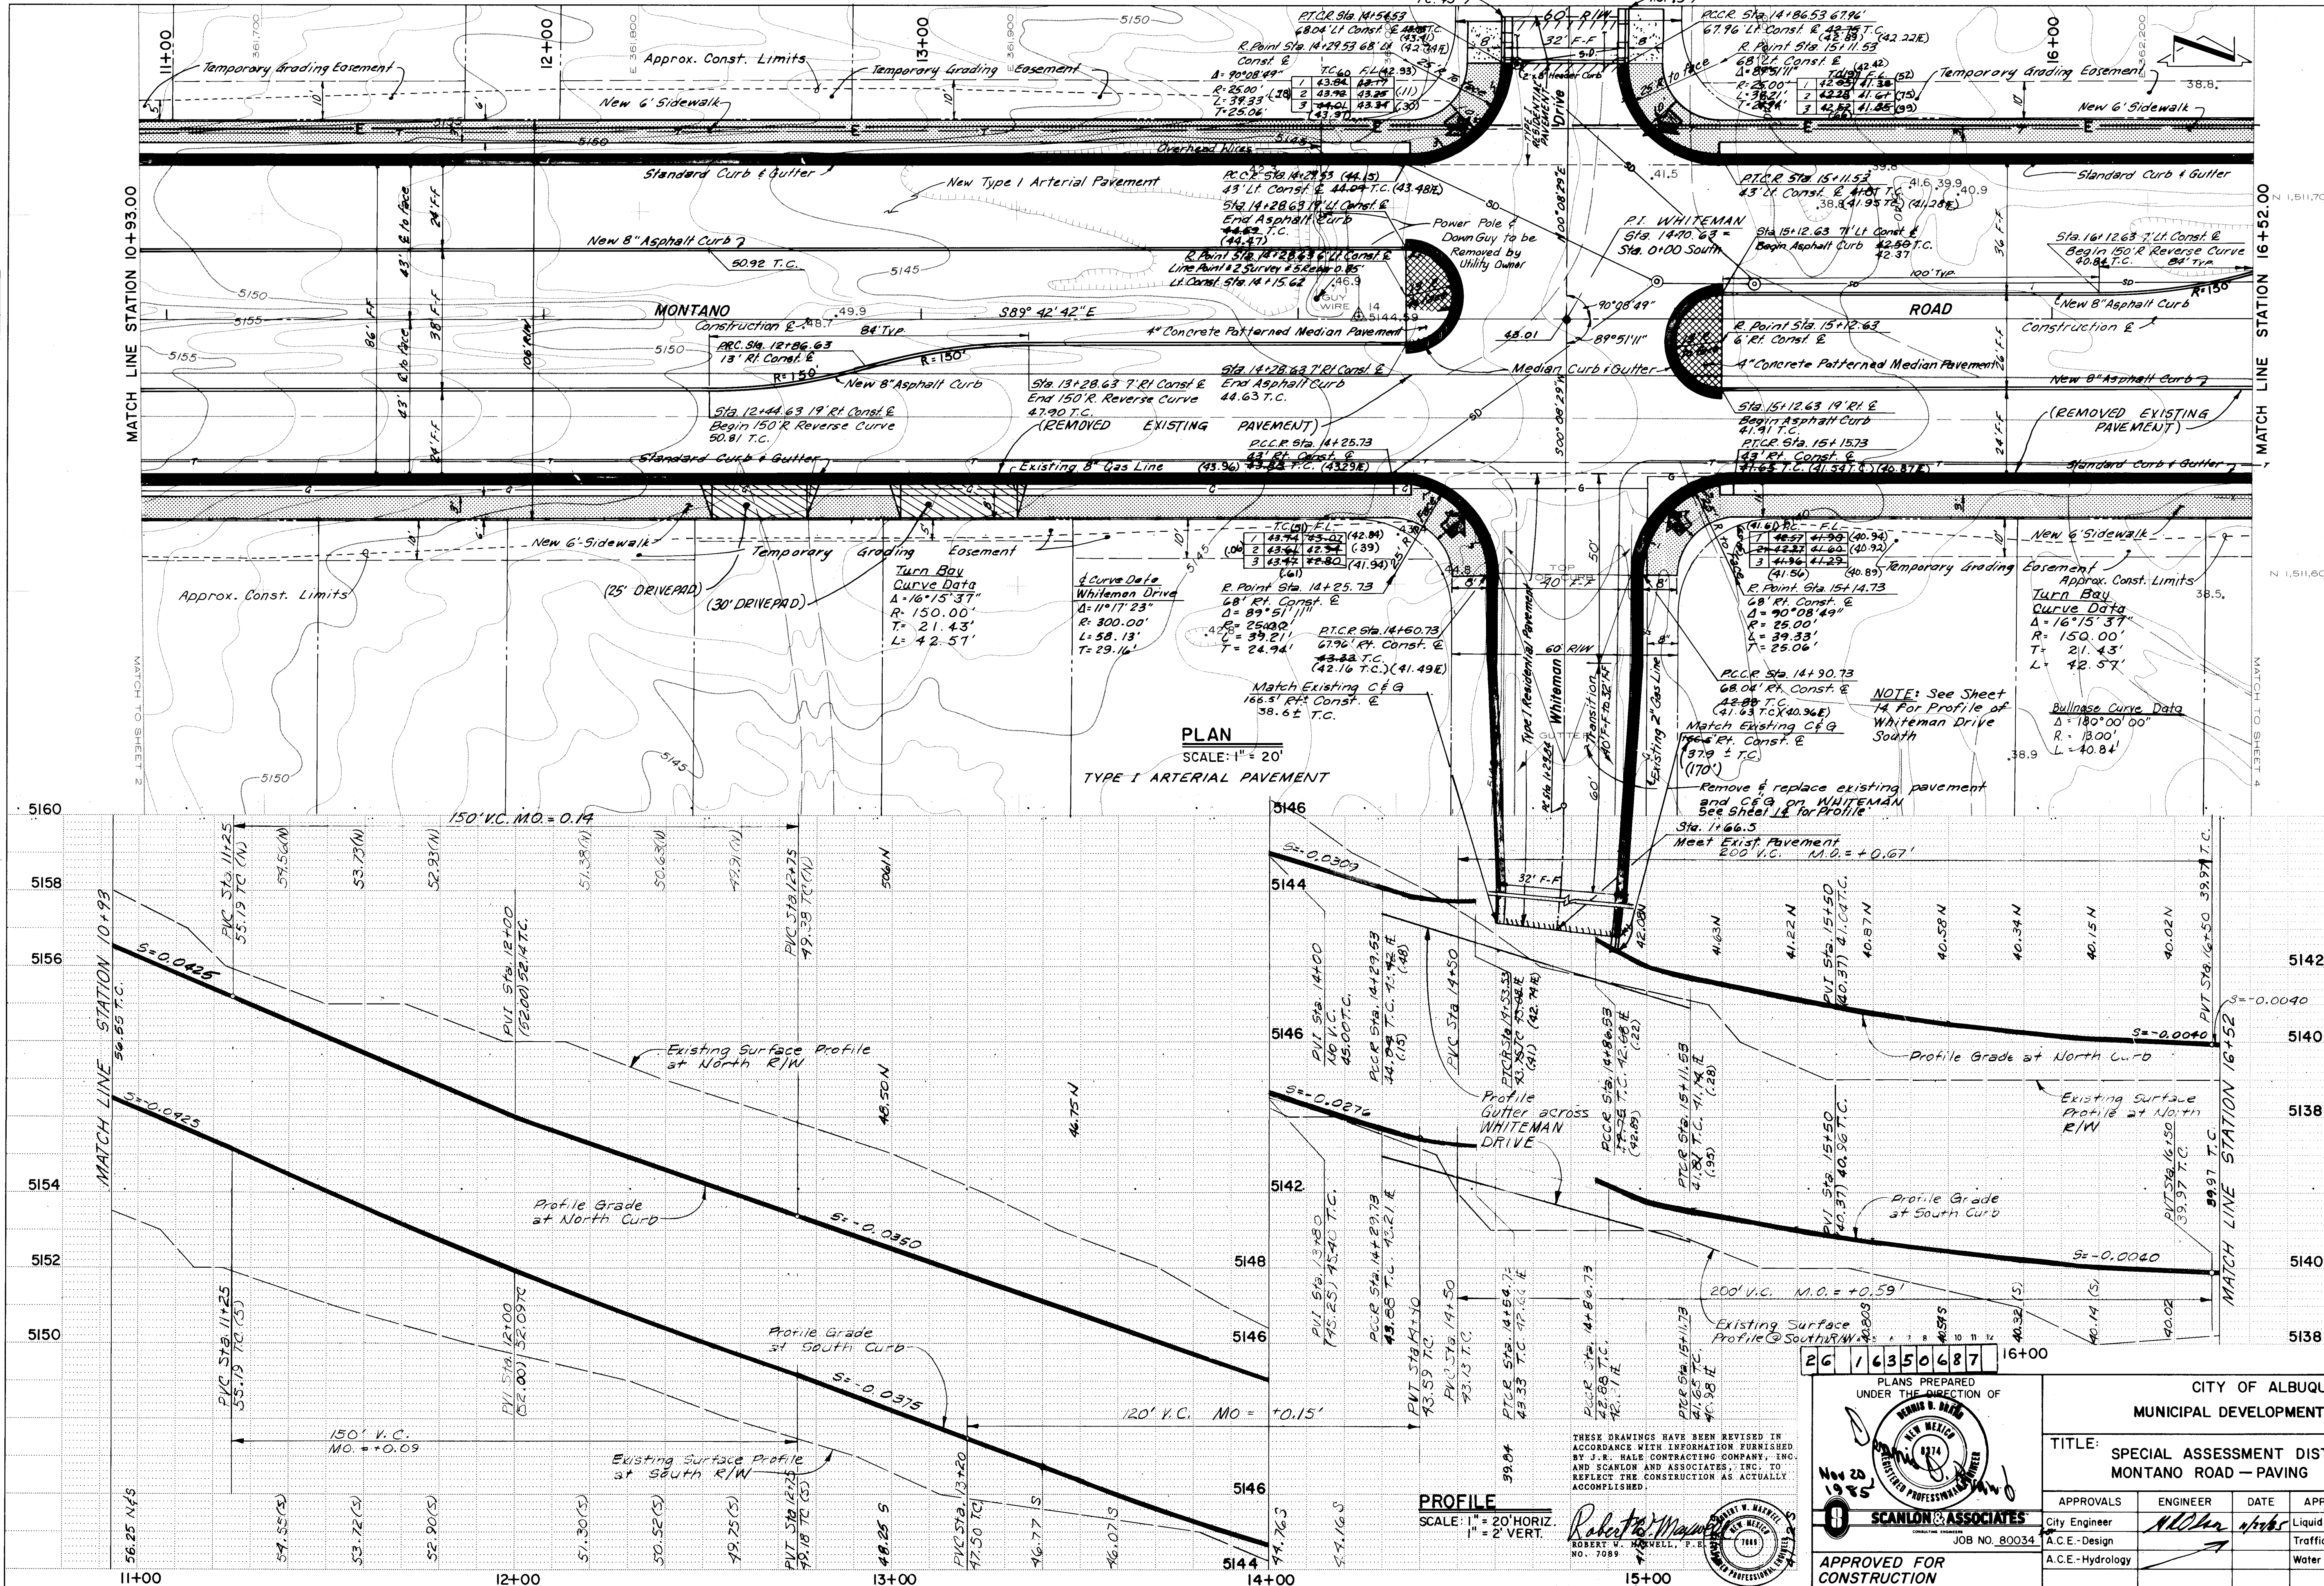

PLANS PREPARED UNDER THE DIRECTION OF		CITY OF ALBUQUERQUE MUNICIPAL DEVELOPMENT DEPARTMENT			
APPROVED FOR CONSTRUCTION		TITLE: SPECIAL ASSESSMENT DISTRICT NO. 197 MONTANO ROAD - PAVING			
APPROVALS	ENGINEER	DATE	APPROVALS	ENGINEER	DATE
City Engineer	MLC	11/20/85	Liquid Waste	NA	11-20-85
A.C.E.-Design			Traffic	NA	11-20-85
A.C.E.-Hydrology			Water	NA	11-20-85
DRAWING NO. 1635		MAP NO. E-10		SHEET 6 OF 35	

AS BUILT INFORMATION		BENCH MARKS		SURVEY INFORMATION		REFERENCES	
CONTRACTOR J.R. Hale Co., Inc.		BM 14-E10-A 40 penny nail in power pole 180'		MAP NO. E-10		14-E10 Corrections for Record Drawings	
INSPECTOR J. Scanlon		North of junction of Montano Road & White Man Drive		EST. NO.			
DATE 11/20/85		Road West of Arisco Road, 5145.93		BY			
FIELD VERIFICATION BY J. Scanlon		BM 14-E10-B 5" top of curb north end N.E.		REVISIONS			
DATE 11/20/85		Return White Man Drive		DESIGN			
MICRO-FILM INFORMATION		Published Elev. 5132.60		DESIGNED BY		DATE	
RECORDED BY		NO.		DRAWN BY M.C. L.H.		DATE	
				CHECKED BY		DATE	


RECORD DRAWING

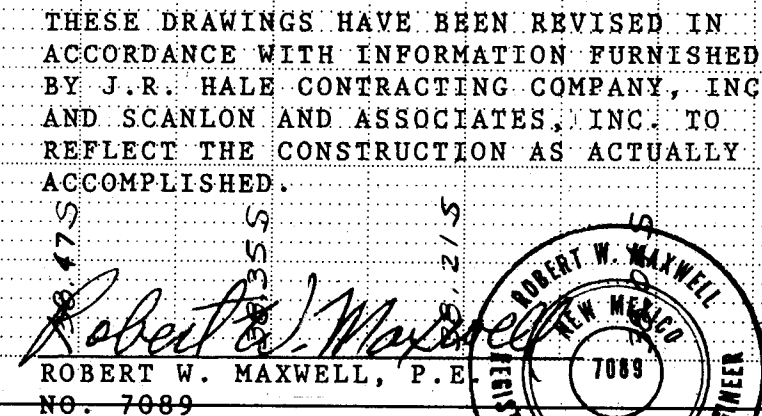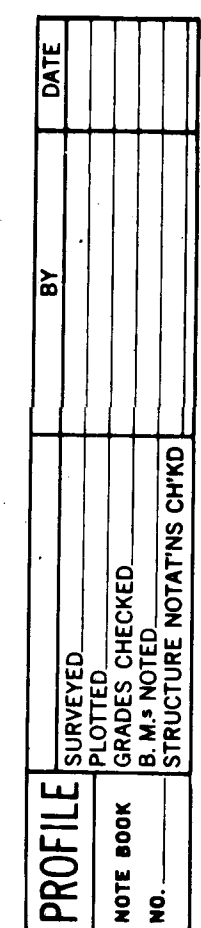

PLANS PREPARED UNDER THE DIRECTION OF  SCANLON & ASSOCIATES CORPORATE ENGINEERS JOB NO. <u>80034</u> APPROVED FOR CONSTRUCTION CITY ENGINEER DATE	CITY OF ALBUQUERQUE MUNICIPAL DEVELOPMENT DEPARTMENT TITLE: SPECIAL ASSESSMENT DISTRICT NO. 197 MONTANO ROAD — PAVING <table border="1" style="width: 100%; border-collapse: collapse;"> <thead> <tr> <th style="width: 25%;">APPROVALS</th> <th style="width: 25%;">ENGINEER</th> <th style="width: 10%;">DATE</th> <th style="width: 25%;">APPROVALS</th> <th style="width: 25%;">ENGINEER</th> <th style="width: 10%;">DATE</th> </tr> </thead> <tbody> <tr> <td>City Engineer</td> <td><i>AKL</i></td> <td><i>11-20-85</i></td> <td>Liquid Waste</td> <td><i>NA</i></td> <td><i>11-20-85</i></td> </tr> <tr> <td>A.C.E. - Design</td> <td><i>/</i></td> <td></td> <td>Traffic</td> <td><i>B.D. Parks</i></td> <td><i>11-20-85</i></td> </tr> <tr> <td>A.C.E. - Hydrology</td> <td><i>/</i></td> <td></td> <td>Water</td> <td><i>NA</i></td> <td><i>11-20-85</i></td> </tr> <tr> <td colspan="2" style="text-align: center;">DRAWING NO.</td> <td style="text-align: center; font-size: 2em;">1635</td> <td colspan="2" style="text-align: center;">MAP NO.</td> <td style="text-align: center;">E-10</td> </tr> <tr> <td colspan="3"></td> <td colspan="3" style="text-align: center;">SHEET 7 OF 35</td> </tr> </tbody> </table>	APPROVALS	ENGINEER	DATE	APPROVALS	ENGINEER	DATE	City Engineer	<i>AKL</i>	<i>11-20-85</i>	Liquid Waste	<i>NA</i>	<i>11-20-85</i>	A.C.E. - Design	<i>/</i>		Traffic	<i>B.D. Parks</i>	<i>11-20-85</i>	A.C.E. - Hydrology	<i>/</i>		Water	<i>NA</i>	<i>11-20-85</i>	DRAWING NO.		1635	MAP NO.		E-10				SHEET 7 OF 35		
APPROVALS	ENGINEER	DATE	APPROVALS	ENGINEER	DATE																																
City Engineer	<i>AKL</i>	<i>11-20-85</i>	Liquid Waste	<i>NA</i>	<i>11-20-85</i>																																
A.C.E. - Design	<i>/</i>		Traffic	<i>B.D. Parks</i>	<i>11-20-85</i>																																
A.C.E. - Hydrology	<i>/</i>		Water	<i>NA</i>	<i>11-20-85</i>																																
DRAWING NO.		1635	MAP NO.		E-10																																
			SHEET 7 OF 35																																		

RECORD DRAWING

PROFILE NOTE BOOK NO. _____	SURVEYED _____	BY _____ DATE _____
	PLOTTED _____	
	GRADES CHECKED _____	
	B. M.'S NOTED _____	
	STRUCTURE NOTATIONS CHKD _____	

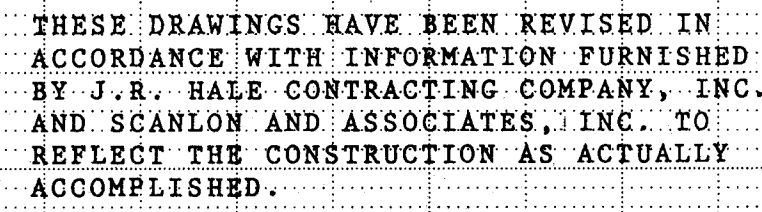

PLANS PREPARED
UNDER THE DIRECTION OF

THOMAS B. DEATON

NEW MEXICO

1271

REGISTERED PROFESSIONAL ENGINEER

Nov 20 1980

8

SPACON ASSOCIATES

CONSULTING ENGINEERS

JOB NO. 80034

APPROVED FOR
CONSTRUCTION

CITY ENGINEER DATE

CITY OF ALBUQUERQUE

MUNICIPAL DEVELOPMENT DEPARTMENT

TITLE: SPECIAL ASSESSMENT DISTRICT NO. 197
MONTANO ROAD — PAVING


APPROVALS	ENGINEER	DATE	APPROVALS	ENGINEER	DATE
City Engineer	<i>AL Deaton</i>	11/27/80	Liquid Waste	<i>NA</i>	11-20-85
A.C.E.—Design			Traffic	<i>S.G. Parks</i>	11-20-85
A.C.E.—Hydrology			Water	<i>NA</i>	11-20-85

DRAWING NO. 1635 MAP NO. E-11 SHEET 8 OF 35

RECORD DRAWING

PLAN	
DATE	BY
NO.	NO.
SURVEYED PLOTTED ALIGNMENT CHECKED RT. OF WAY CHECKED	


PROFILE	
DATE	BY
NO.	NO.
SURVEYED PLOTTED GRADES CHECKED STRUCTURE NOTATIONS CHKD	

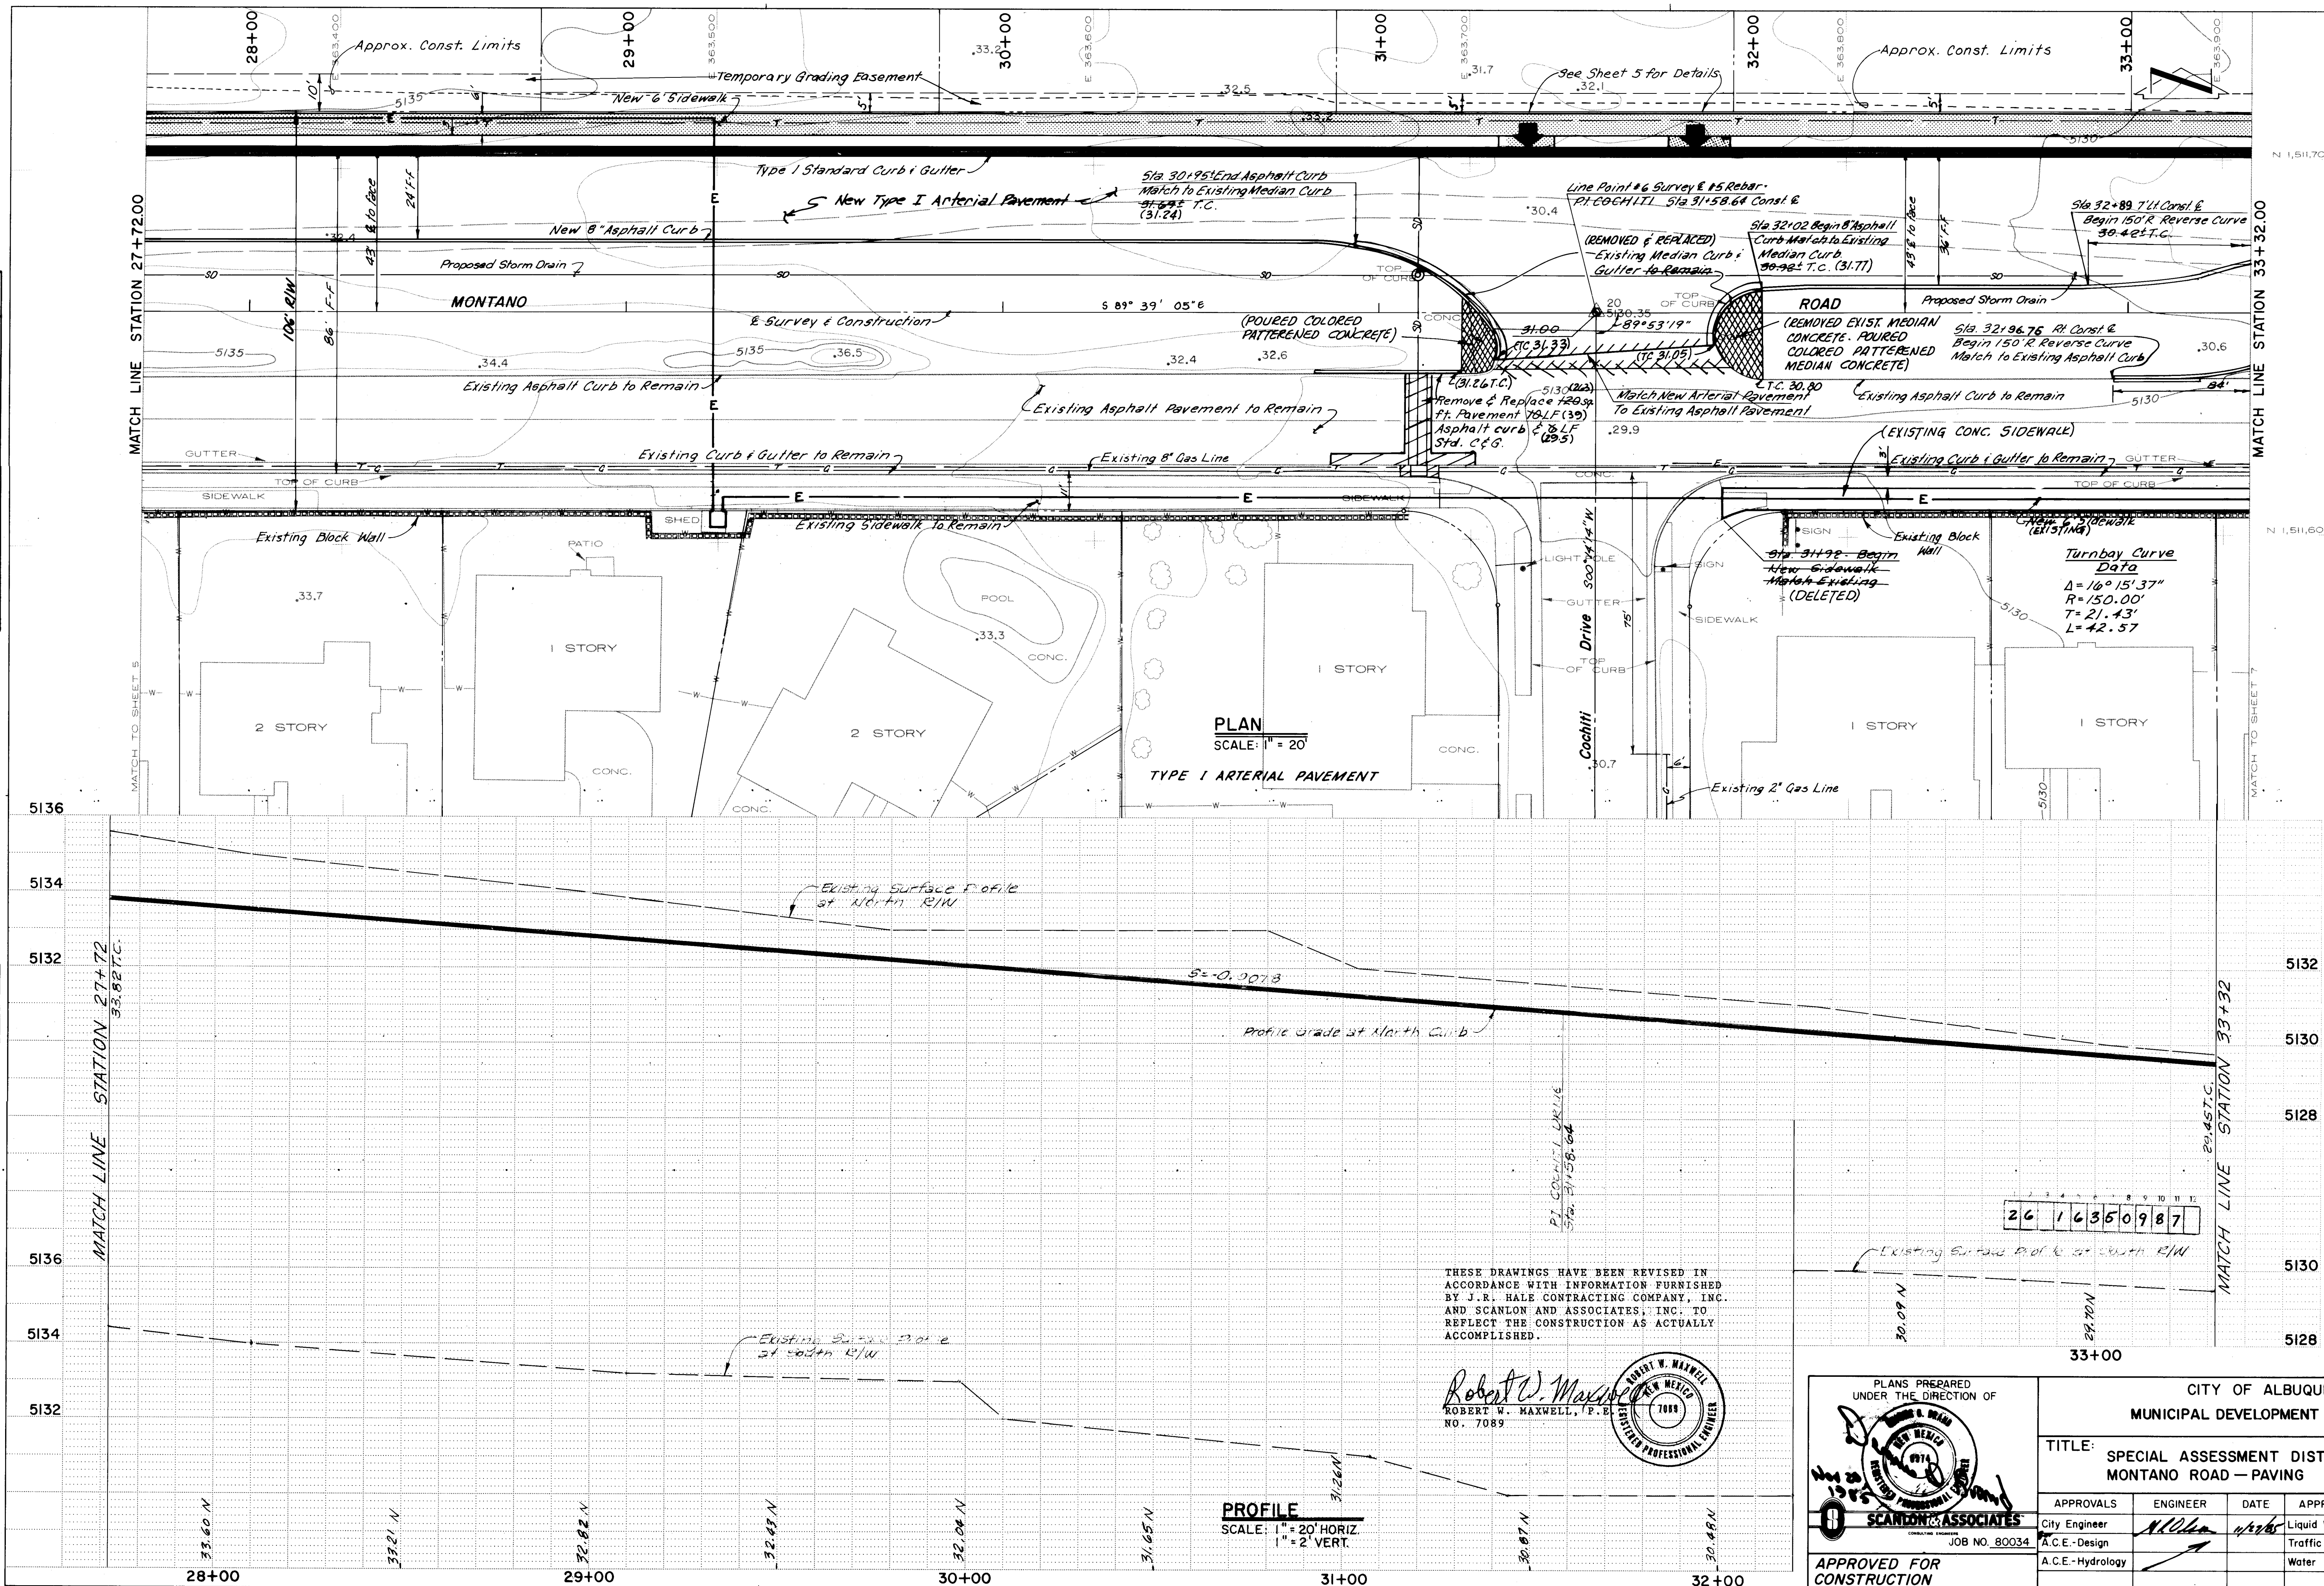

AS BUILT INFORMATION		BENCH MARKS		SURVEY INFORMATION		REFERENCES	
CONTRACTOR J.R. Hale Co. Inc.	DATE 1984	BM 14-110-A 40 penny nail in power pole 180' north of junction Arroyo Road & Montano Road west of Arroyo. Elev. 5145.930	NO.	DATE	MAP NO. E-11	W.O. NO.	BY
INSPECTOR S. Scanlon	DATE 1984	BM No. 7-110-D Top of curb north end N.E. return Whiteman & Cuesia	NO.	DATE	EST. NO.		REMARKS
VERIFICATION BY Scanlon & Assoc. DATE 1984		Published Elev. = 5132.60	NO.	DATE			REVISIONS
			NO.	DATE			DESIGNED BY
			NO.	DATE			DRAWN BY M.C. L.H.
			NO.	DATE			CHECKED BY


PLAN	SURVEYED PLOTTED ALIGNED CHECKED BY	DATE	BY	DATE

PROFILE	SURVEYED PLOTTED GRADES CHECKED BY	DATE	BY	DATE

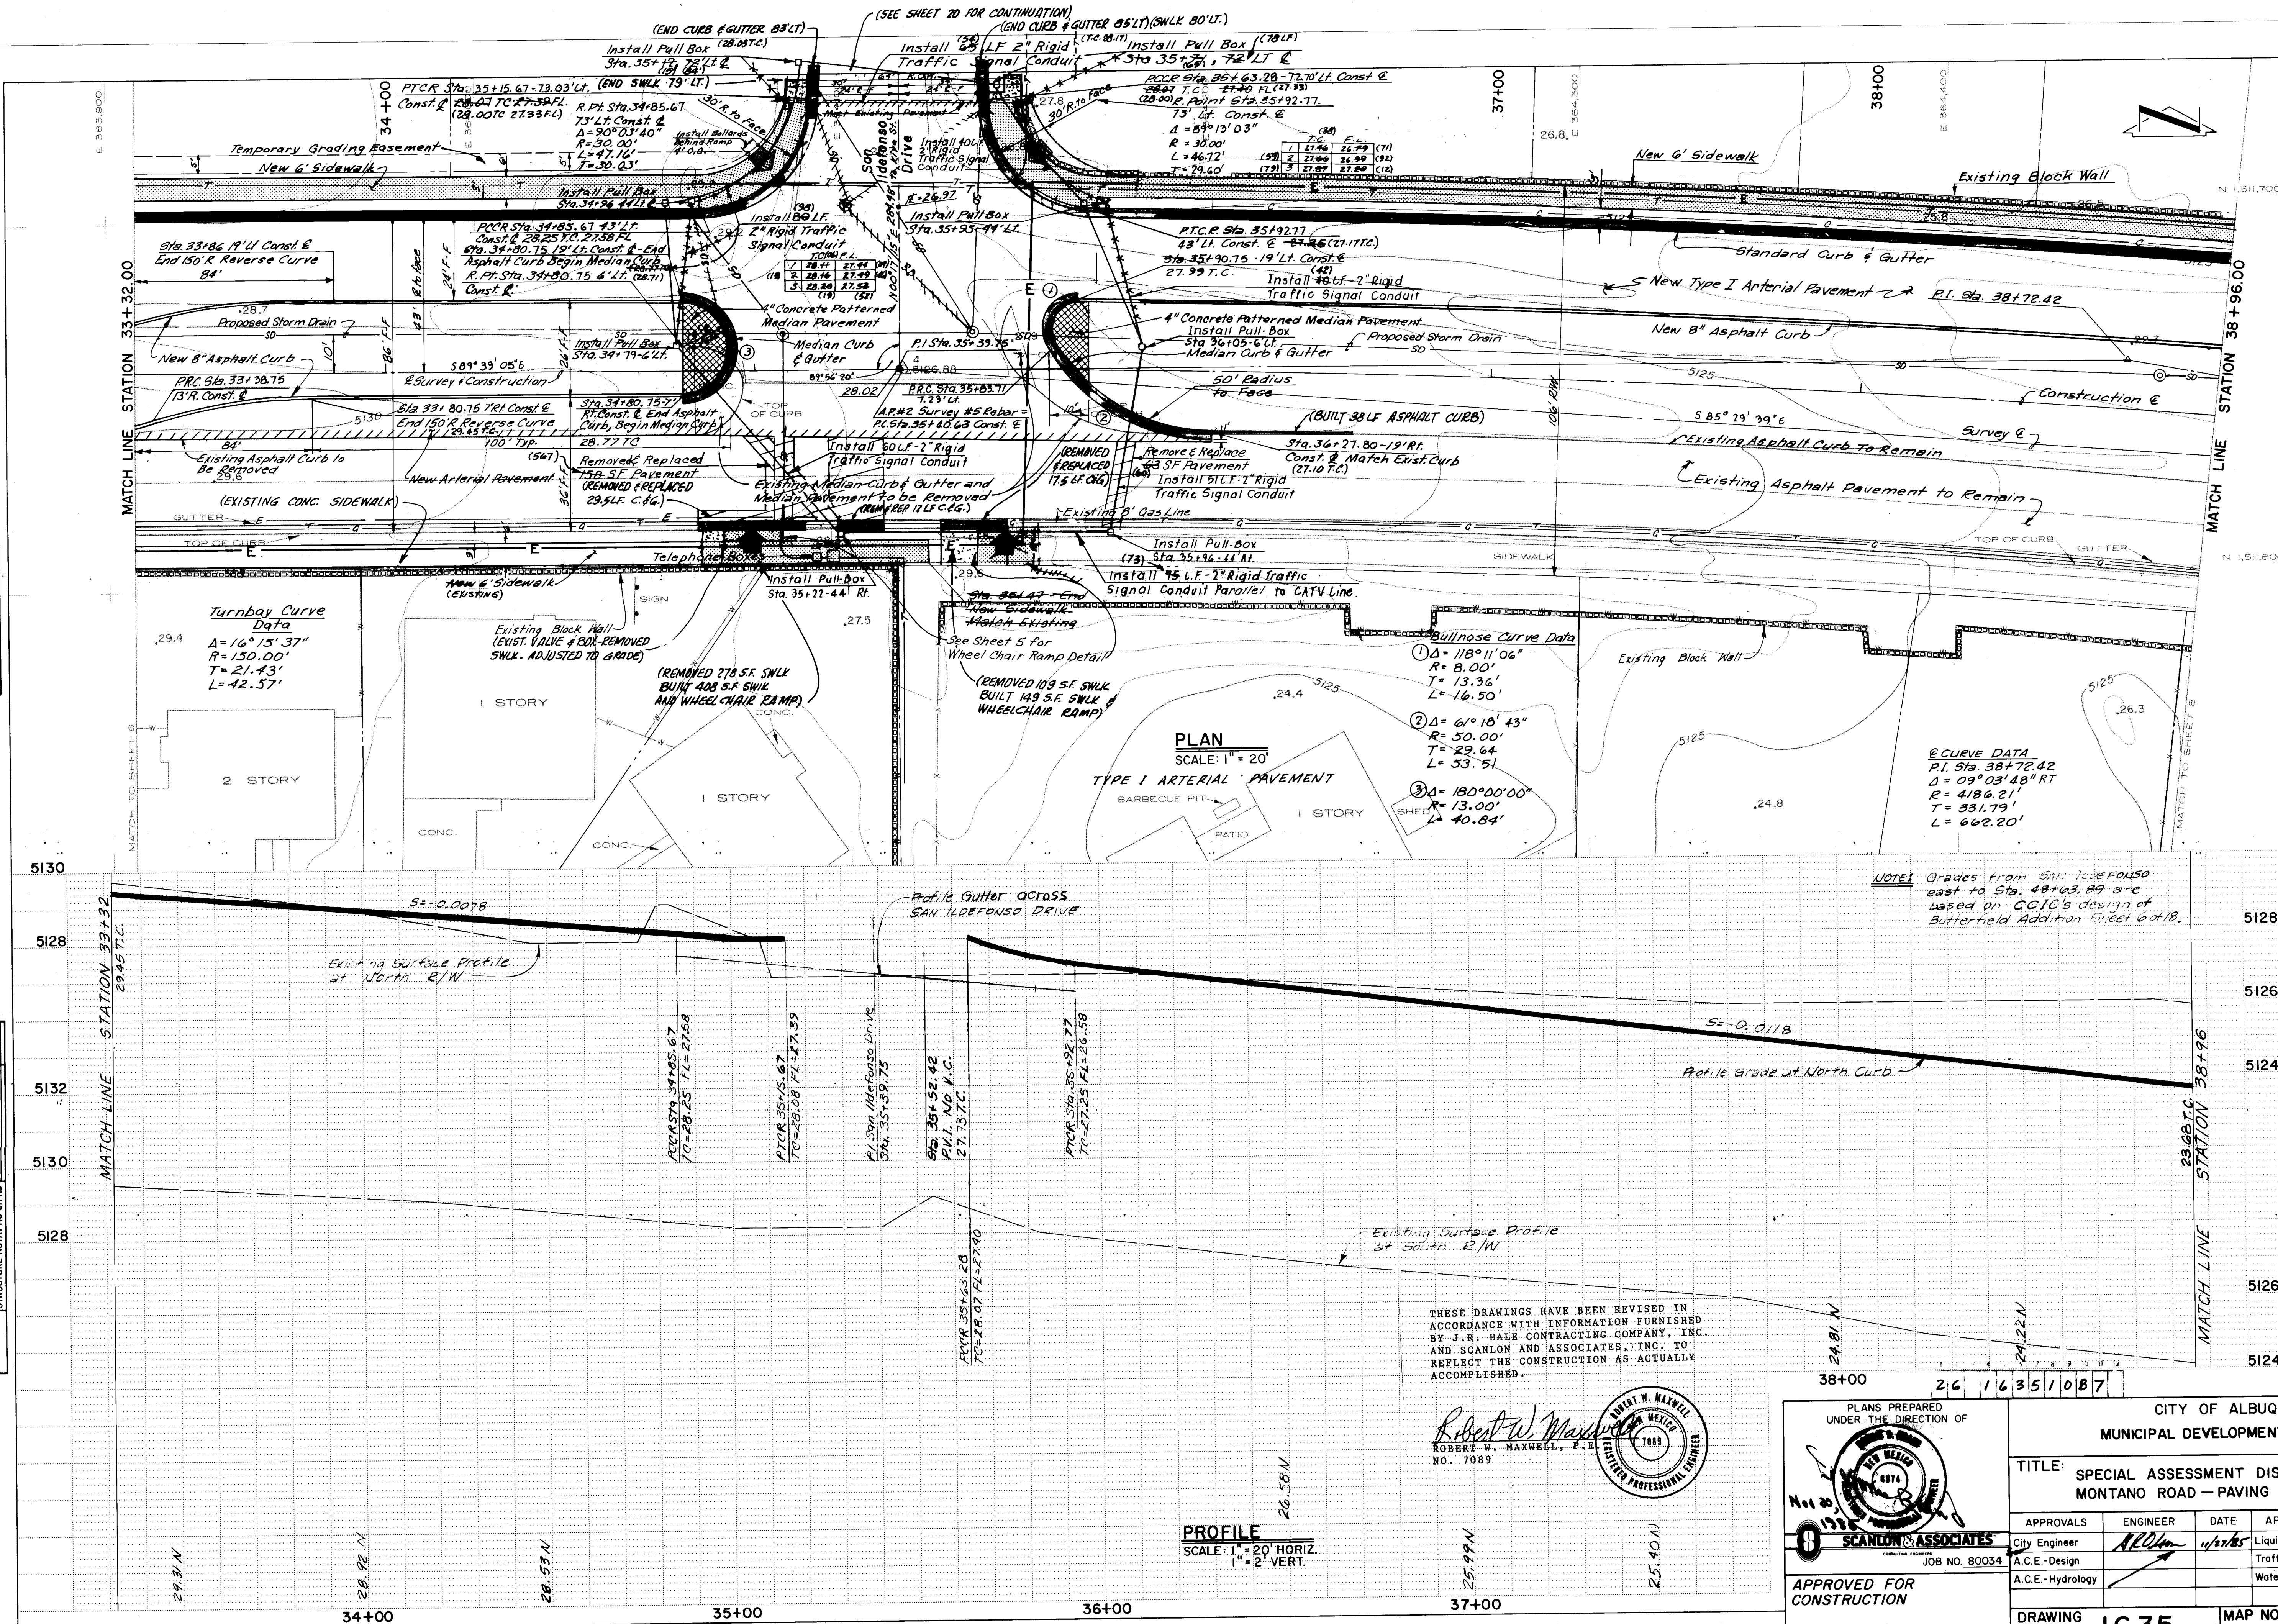

THESE DRAWINGS HAVE BEEN REVISED IN ACCORDANCE WITH INFORMATION FURNISHED BY J.R. HALE CONTRACTING COMPANY, INC. AND SCANLON AND ASSOCIATES, INC. TO REFLECT THE CONSTRUCTION AS ACTUALLY ACCOMPLISHED.

Robert W. Maxwell
ROBERT W. MAXWELL, P.E.
NO. 7089

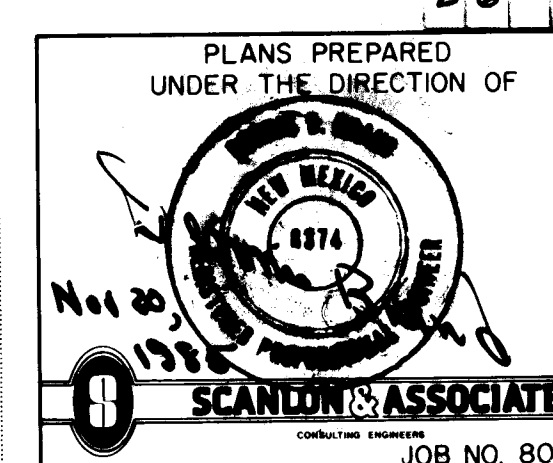


CITY OF ALBUQUERQUE MUNICIPAL DEVELOPMENT DEPARTMENT					
TITLE: SPECIAL ASSESSMENT DISTRICT NO. 197 MONTANO ROAD - PAVING					
APPROVALS	ENGINEER	DATE	APPROVALS	ENGINEER	DATE
City Engineer	ARL	11/27/85	Liquid Waste	N.A. 3/29/85	11-20-85
A.C.E. - Design			Traffic	D.R. Fuchs	11-20-85
A.C.E. - Hydrology			Water	N.A. 3/29/85	11-20-85
DRAWING NO. 1635			MAP NO. E-11		
CITY ENGINEER			SHEET 10 OF 35		

RECORD DRAWING

AS BUILT INFORMATION		BENCH MARKS		SURVEY INFORMATION		REFERENCES		REVISIONS	
CONTRACTOR: J.R. Hale Co., Inc.		BENCH MARK: BM 14-E-10-A 40 penny nail in power pole 180'		FIELD NOTES		MAP NO. E-11		REVISIONS	
WORK: Paving of Montano Road		DATE: 11/27/85		NO.		EST. NO.		REVISIONS	
ACCEPTANCE BY: [Signature]		DATE: 11/27/85		BY		BY		REVISIONS	
DRAWN BY: [Signature]		DATE: 11/27/85		NO.		BY		REVISIONS	
CHECKED BY: [Signature]		DATE: 11/27/85		NO.		BY		REVISIONS	
MICRO-FILM INFORMATION		MICRO-FILM INFORMATION		MICRO-FILM INFORMATION		MICRO-FILM INFORMATION		MICRO-FILM INFORMATION	
RECORDED BY: [Signature]		RECORDED BY: [Signature]		RECORDED BY: [Signature]		RECORDED BY: [Signature]		RECORDED BY: [Signature]	
DATE: 11/27/85		DATE: 11/27/85		DATE: 11/27/85		DATE: 11/27/85		DATE: 11/27/85	


PLAN
SURVEYED BY DATE
NOTE BOOK NO.
ALIGNMENT CHECKED
RT OF WAY CHECKED

PROFILE
SURVEYED BY DATE
NOTE BOOK NO.
GRADES CHECKED
STRUCTURE NOTATIONS CHKD

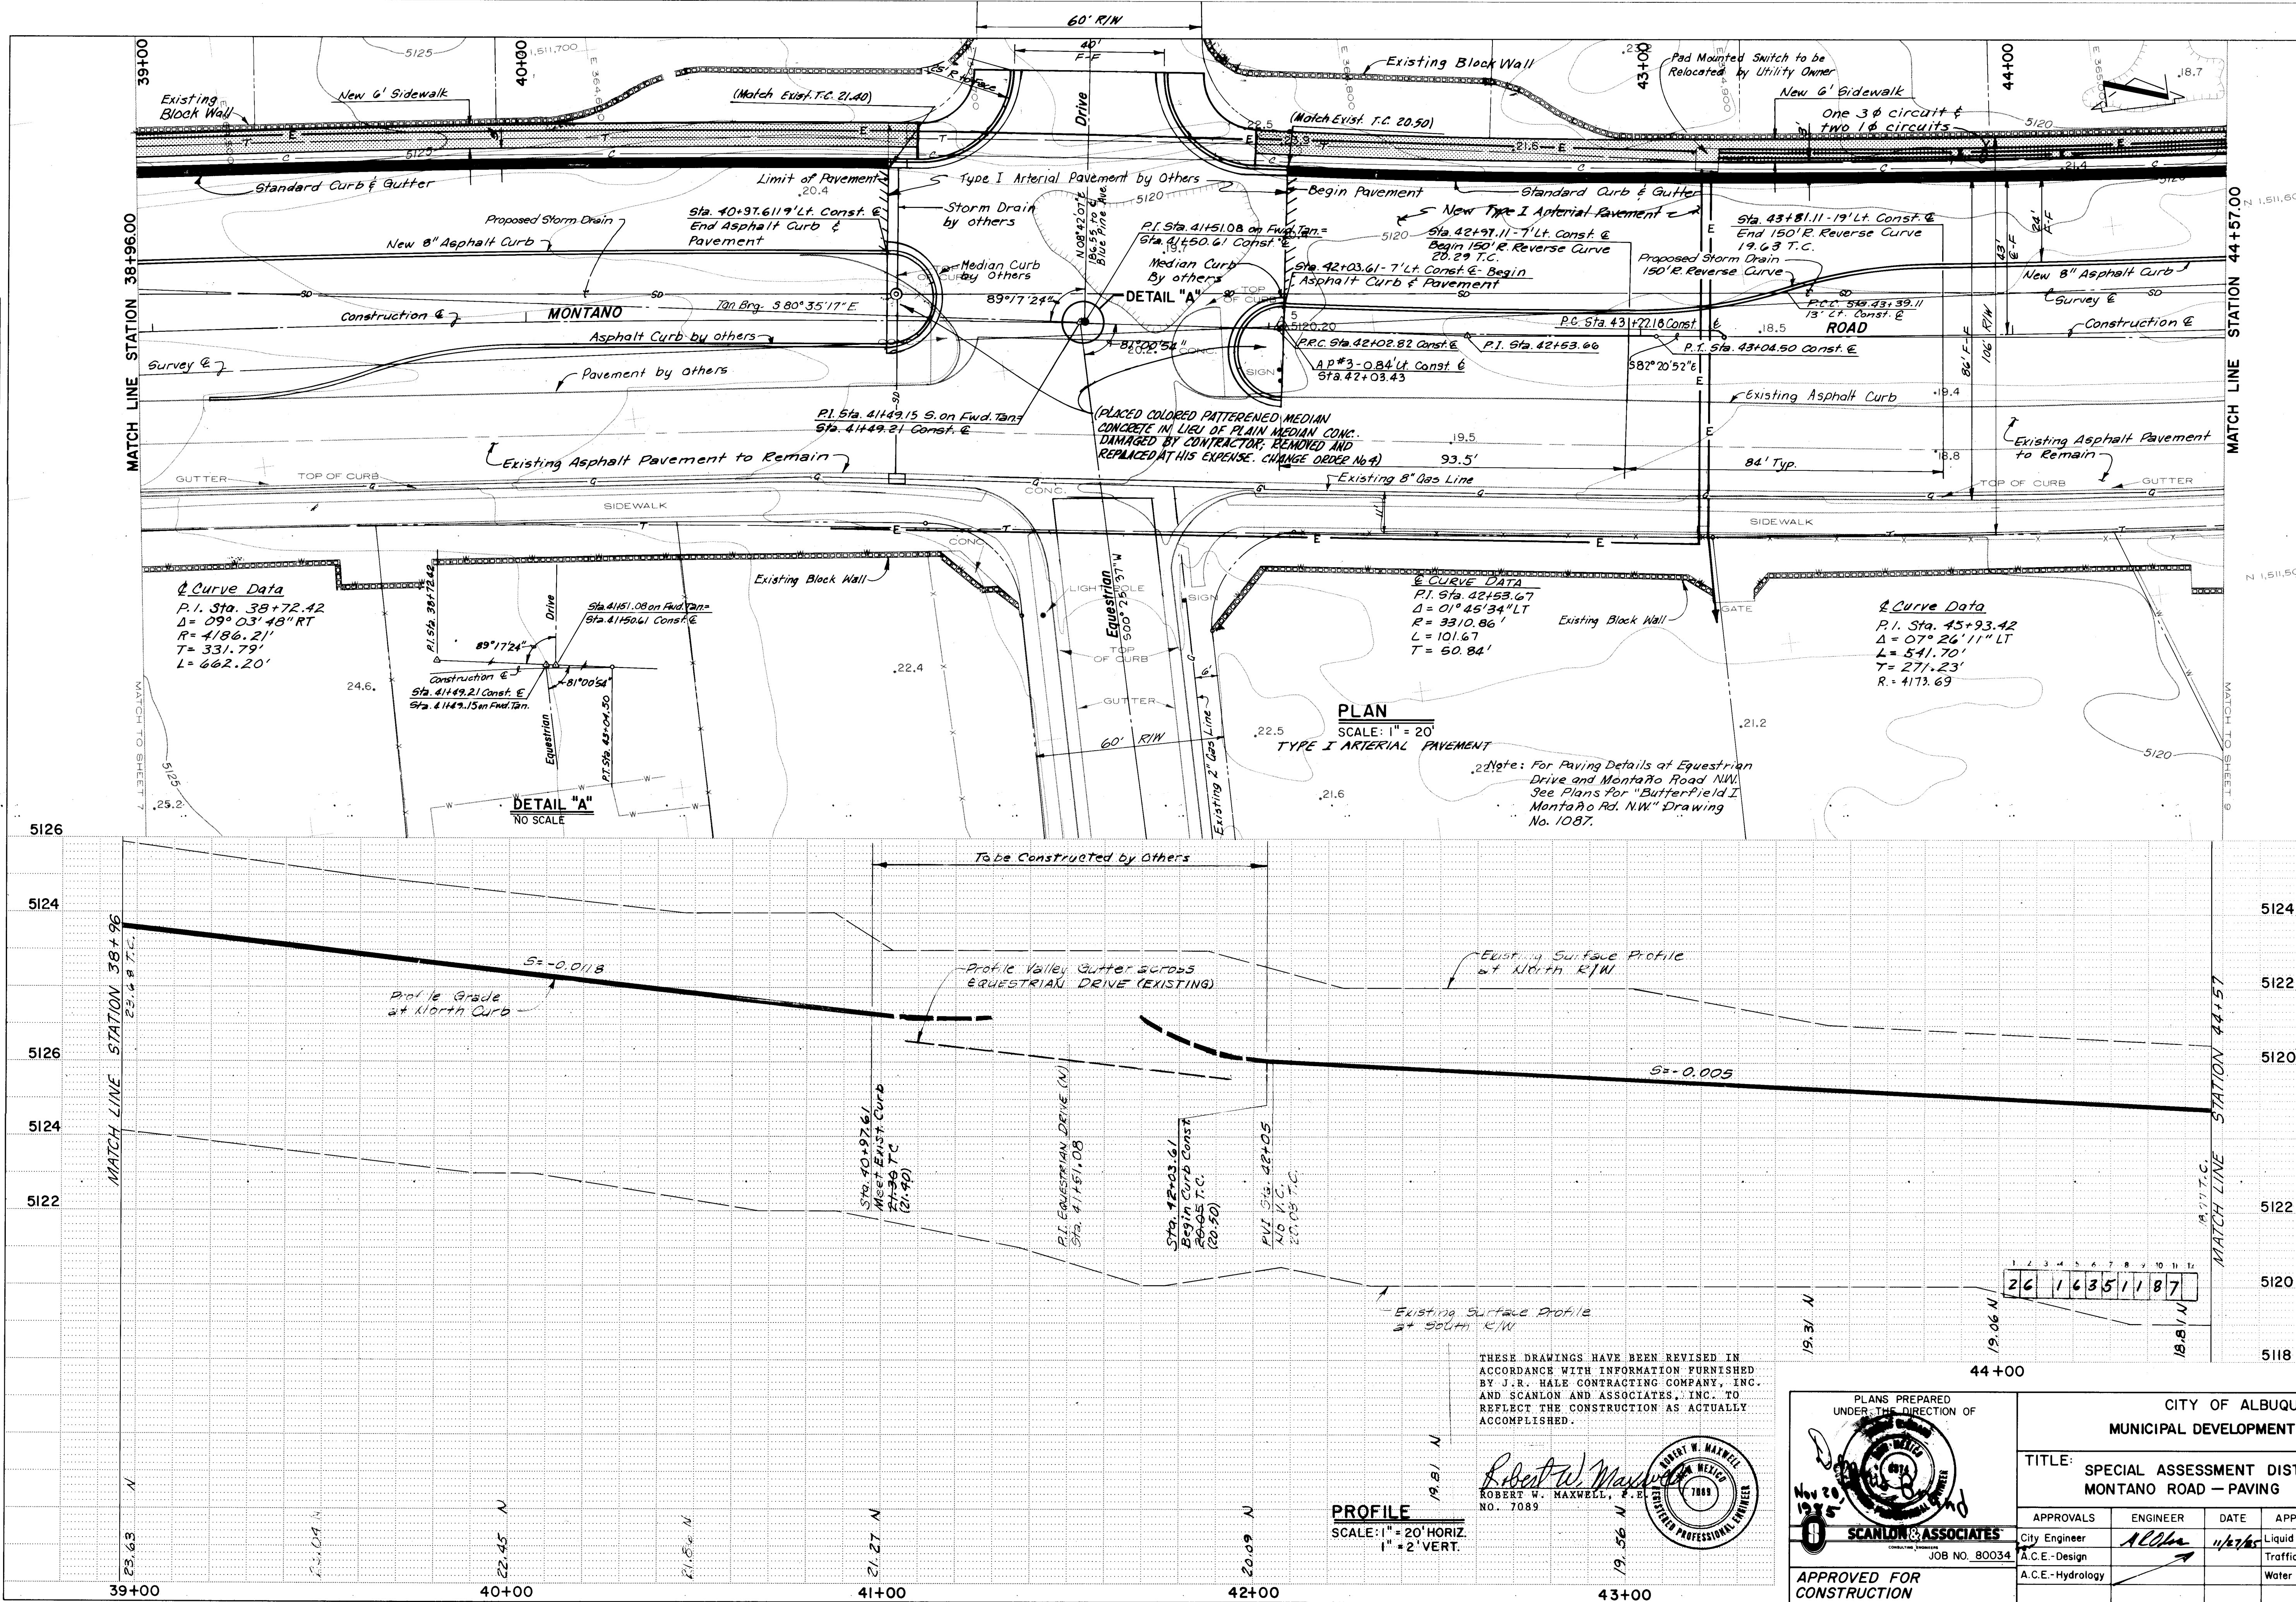

THESE DRAWINGS HAVE BEEN REVISED IN ACCORDANCE WITH INFORMATION FURNISHED BY J.R. HALE CONTRACTING COMPANY, INC. AND SCANLON AND ASSOCIATES, INC. TO REFLECT THE CONSTRUCTION AS ACTUALLY ACCOMPLISHED.


Robert W. Maxwell
ROBERT W. MAXWELL, P.E.
NO. 7089
REGISTERED PROFESSIONAL ENGINEER

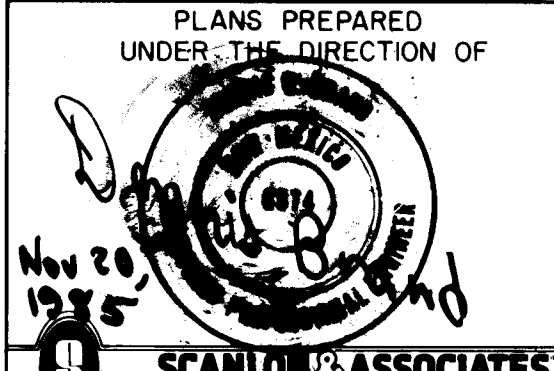


APPROVED FOR CONSTRUCTION
CITY ENGINEER DATE

CITY OF ALBUQUERQUE MUNICIPAL DEVELOPMENT DEPARTMENT					
TITLE: SPECIAL ASSESSMENT DISTRICT NO. 197 MONTANO ROAD - PAVING					
APPROVALS	ENGINEER	DATE	APPROVALS	ENGINEER	DATE
City Engineer	ALD	11/2/85	Liquid Waste	NA	2/2/85
A.C.E. - Design			Traffic	NA	11-20-85
A.C.E. - Hydrology			Water	NA	2/2/85
DRAWING NO. 1635			MAP NO. E-11		
SHEET 11 OF 35			RECORD DRAWING		

PROFILE		BY	DATE
SURVEYED			
PLOTTED			
GRADES CHECKED			
B.M.'s NOTED			
STRUCTURE NOTATIONS CHK'D			
NOTE BOOK			
NO.			

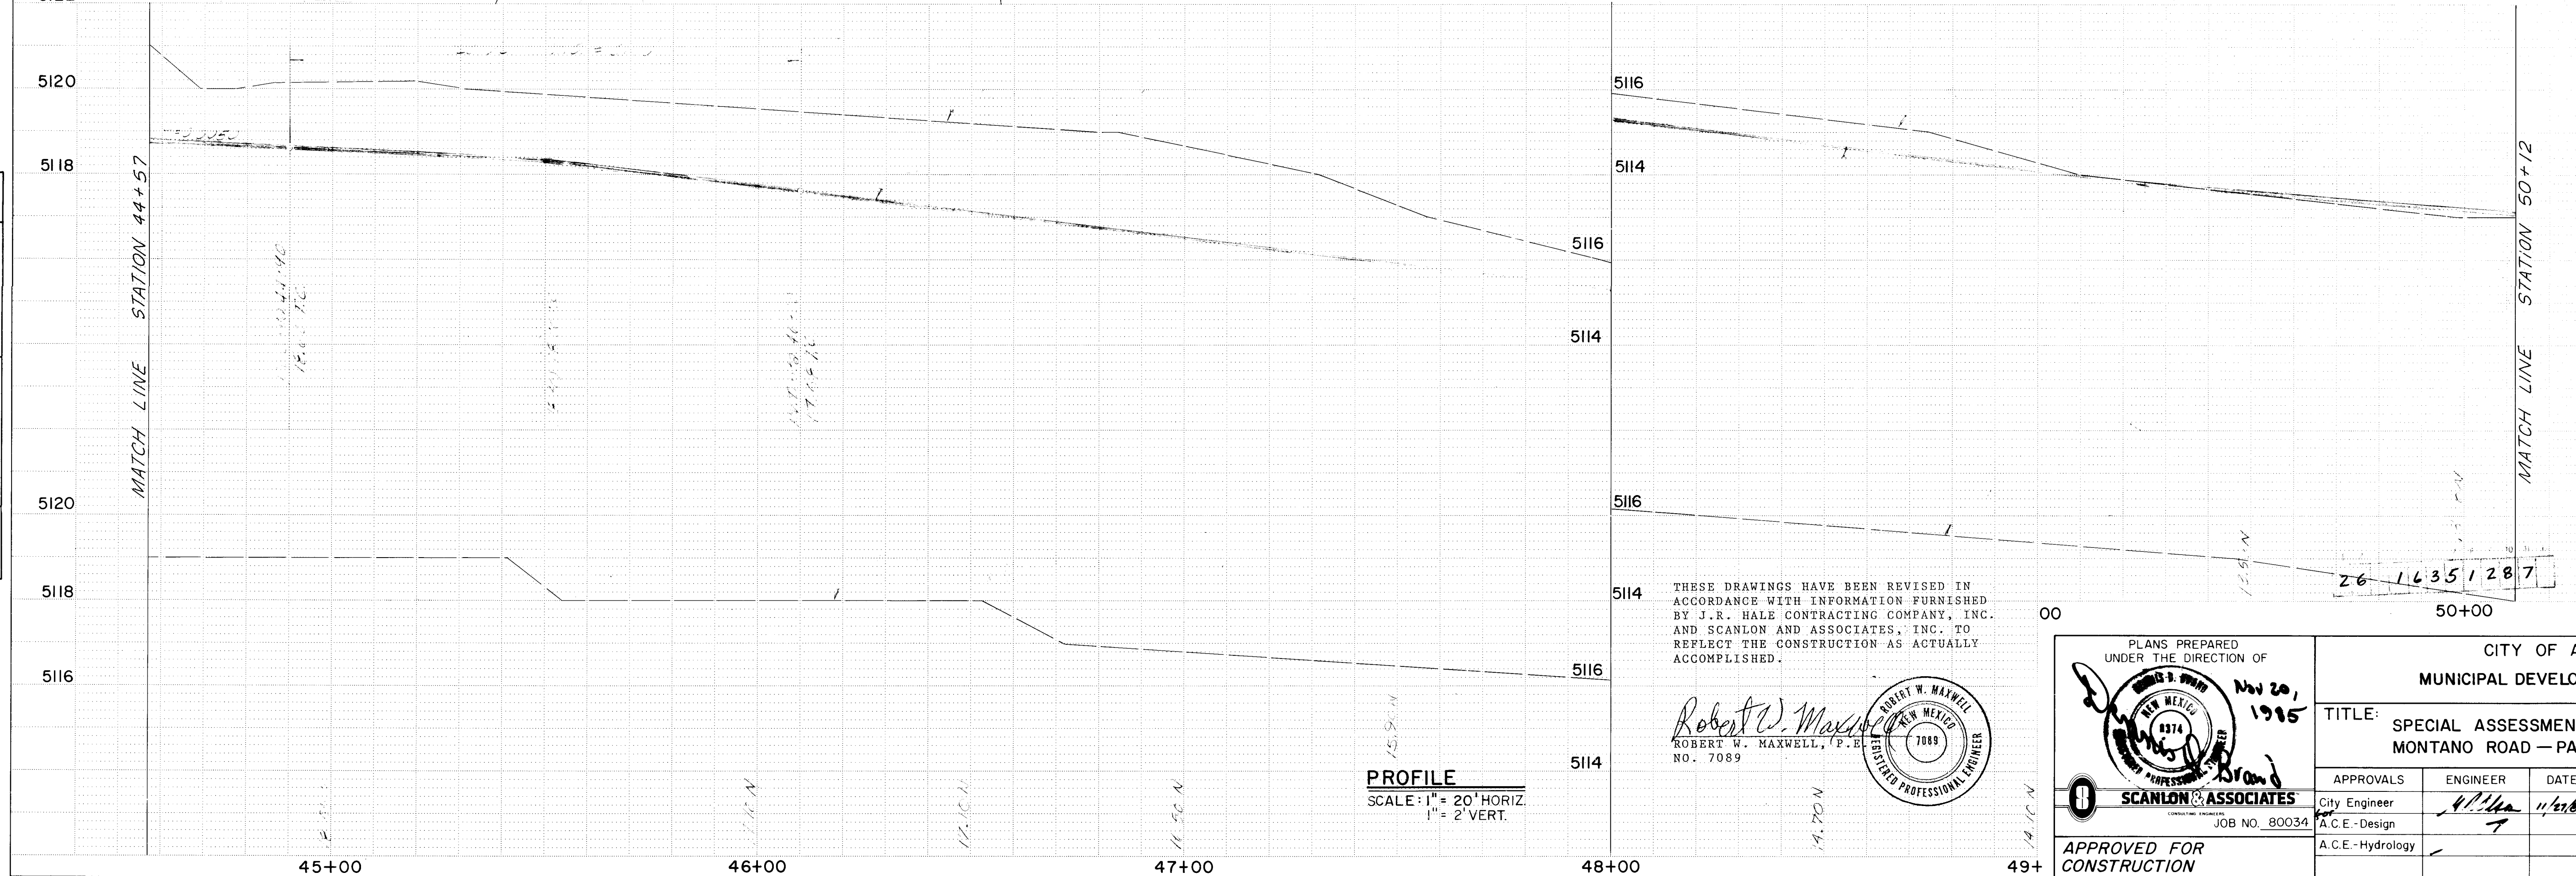[illegible]


PROFILE		BY		DATE	
SURVIVED					
PLOTTED					
GRADES CHECKED					
B. M.'s NOTED					
STRUCTURE NOTATNS CHKD					
NOTE BOOK					
NO.					

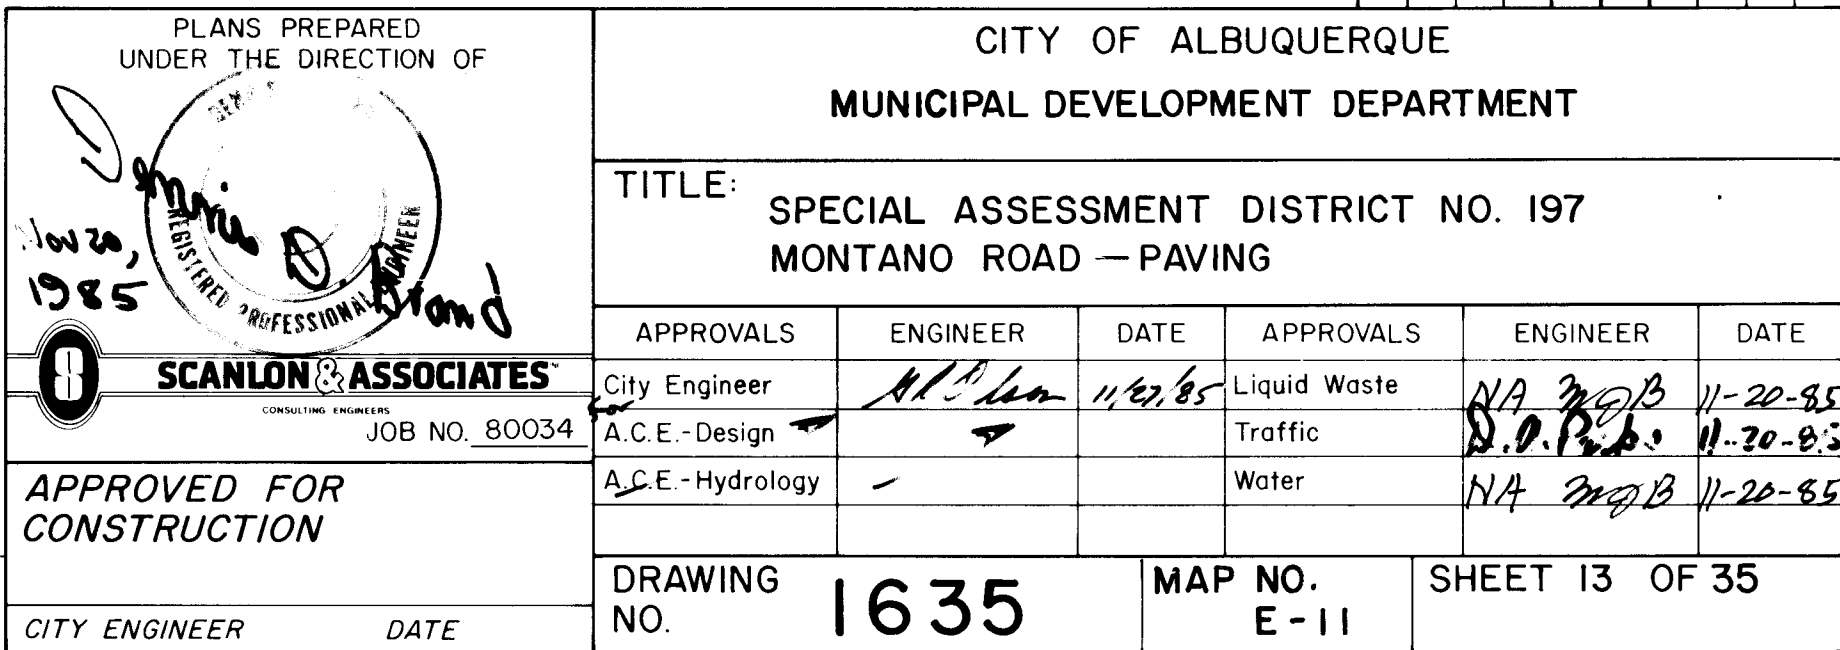[illegible]

RECORD DRAWING

PLAN	DATE	BY
SURVEYED		
ALIGNED		
CHECKED		
RT. OF WAY		
NO.		

PROFILE	DATE	BY
SURVEYED		
GRADES		
CHECKED		
STRUCTURE		
NOTATIONS		
CHKD		
NO.		

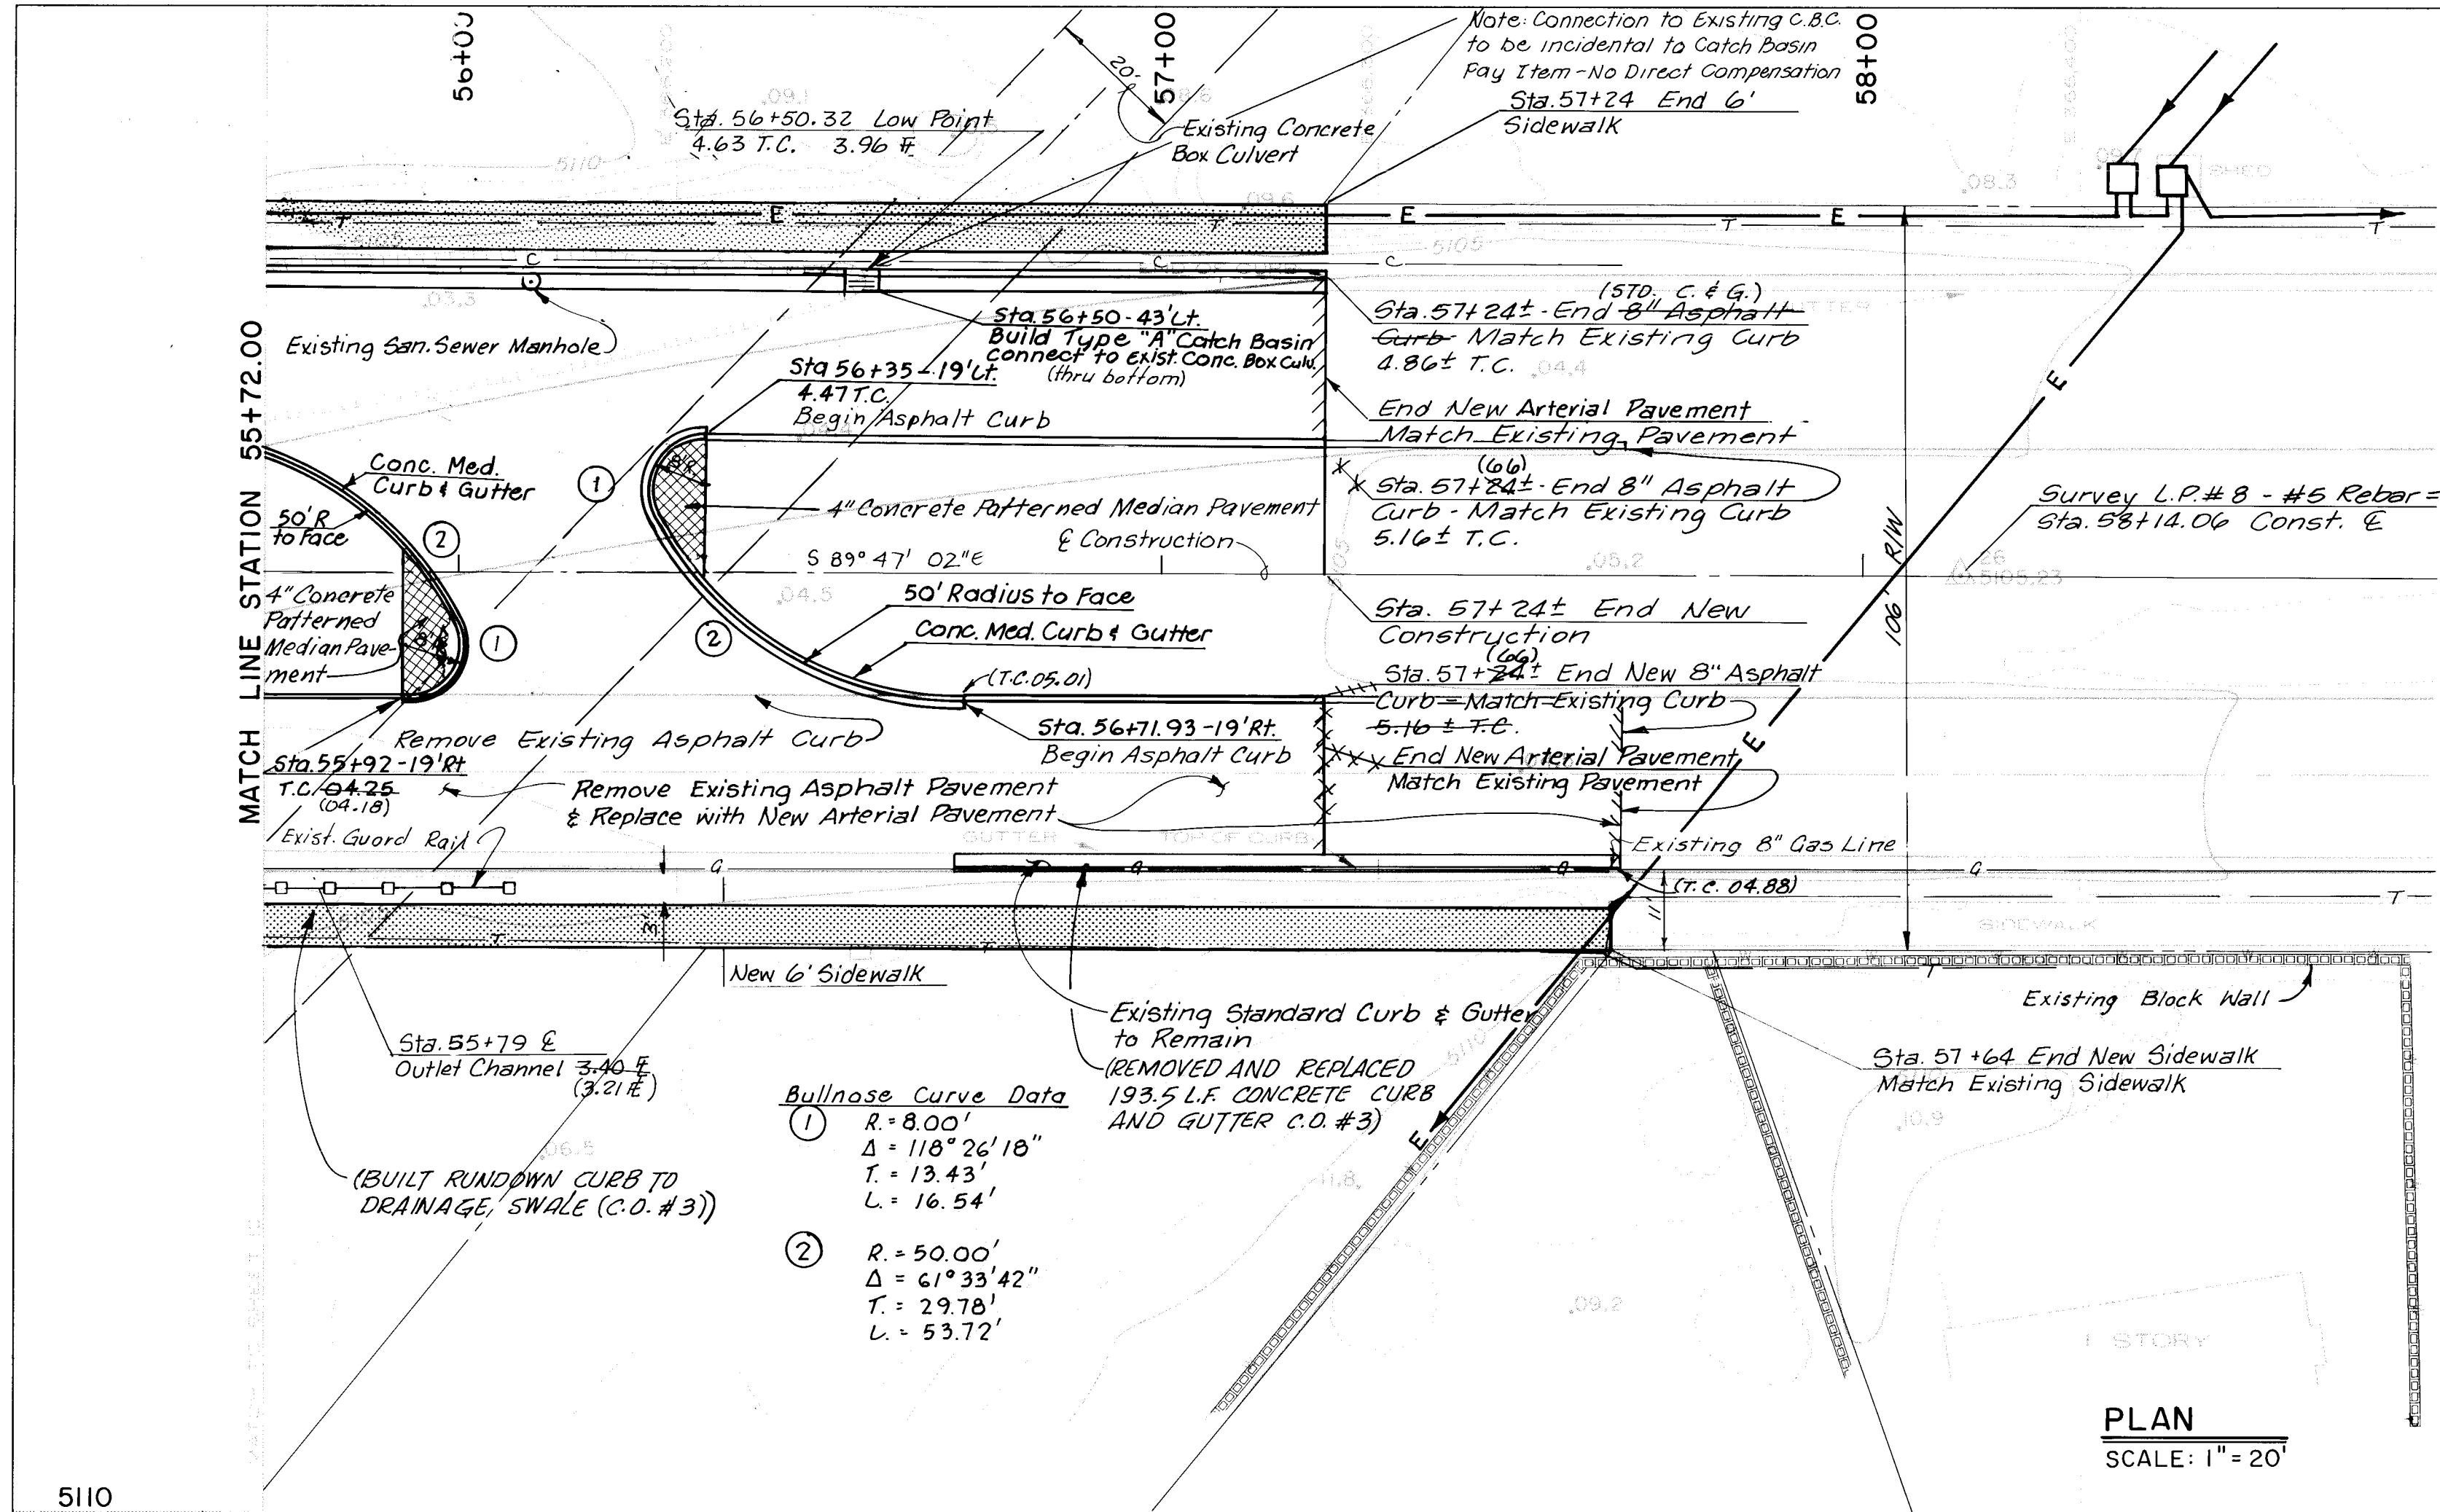

PLAN
SCALE: 1" = 20'



PROFILE
SCALE: 1" = 20' HORIZ.
1" = 2' VERT.

THESE DRAWINGS HAVE BEEN REVISED IN ACCORDANCE WITH INFORMATION FURNISHED BY J.R. HALE CONTRACTING COMPANY, INC. AND SCANLON AND ASSOCIATES, INC. TO REFLECT THE CONSTRUCTION AS ACTUALLY ACCOMPLISHED.


Robert W. Maxwell
ROBERT W. MAXWELL, P.E.
NO. 7089
REGISTERED PROFESSIONAL ENGINEER

PLANS PREPARED UNDER THE DIRECTION OF		CITY OF ALBUQUERQUE MUNICIPAL DEVELOPMENT DEPARTMENT			
APPROVED FOR CONSTRUCTION		TITLE: SPECIAL ASSESSMENT DISTRICT NO. 197 MONTANO ROAD - PAVING			
APPROVALS	ENGINEER	DATE	APPROVALS	ENGINEER	DATE
City Engineer	4/1/85	4/1/85	Liquid Waste	NA 3/2/85	11-20-85
A.C.E.-Design			Traffic	NA 3/2/85	11-20-85
A.C.E.-Hydrology			Water	NA 3/2/85	11-20-85
DRAWING NO. 1635		MAP NO. E-11		SHEET 14 OF 35	
CITY ENGINEER		DATE		RECORD DRAWING	

SURVEY INFORMATION		BENCH MARKS		AS BUILT INFORMATION	
MAP NO. E-11	EST. NO.	NO.	BY	DATE	CONTRACTOR J.R. Hale Co. Inc.
					STATED BY Scanlon & Assoc. DATE 1/86
					INSPECTOR'S FIELD VERIFICATION BY Scanlon & Assoc. DATE 1/86
					CORRECTED BY Scanlon & Assoc. DATE 1/86
REFERENCES		MICRO-FILM INFORMATION		REVISIONS	
MAP NO. E-11	EST. NO.	W.O. NO.	BY	DATE	DESIGNED BY
					DRAWN BY C.H.
					CHECKED BY

PLAN	DATE
SURVEYED	BY
PLOTTED	DATE
ALIGNED	CHECKED
NO.	BY

PROFILE	DATE
SURVEYED	BY
PLOTTED	DATE
GRADES CHECKED	CHECKED
NO.	BY

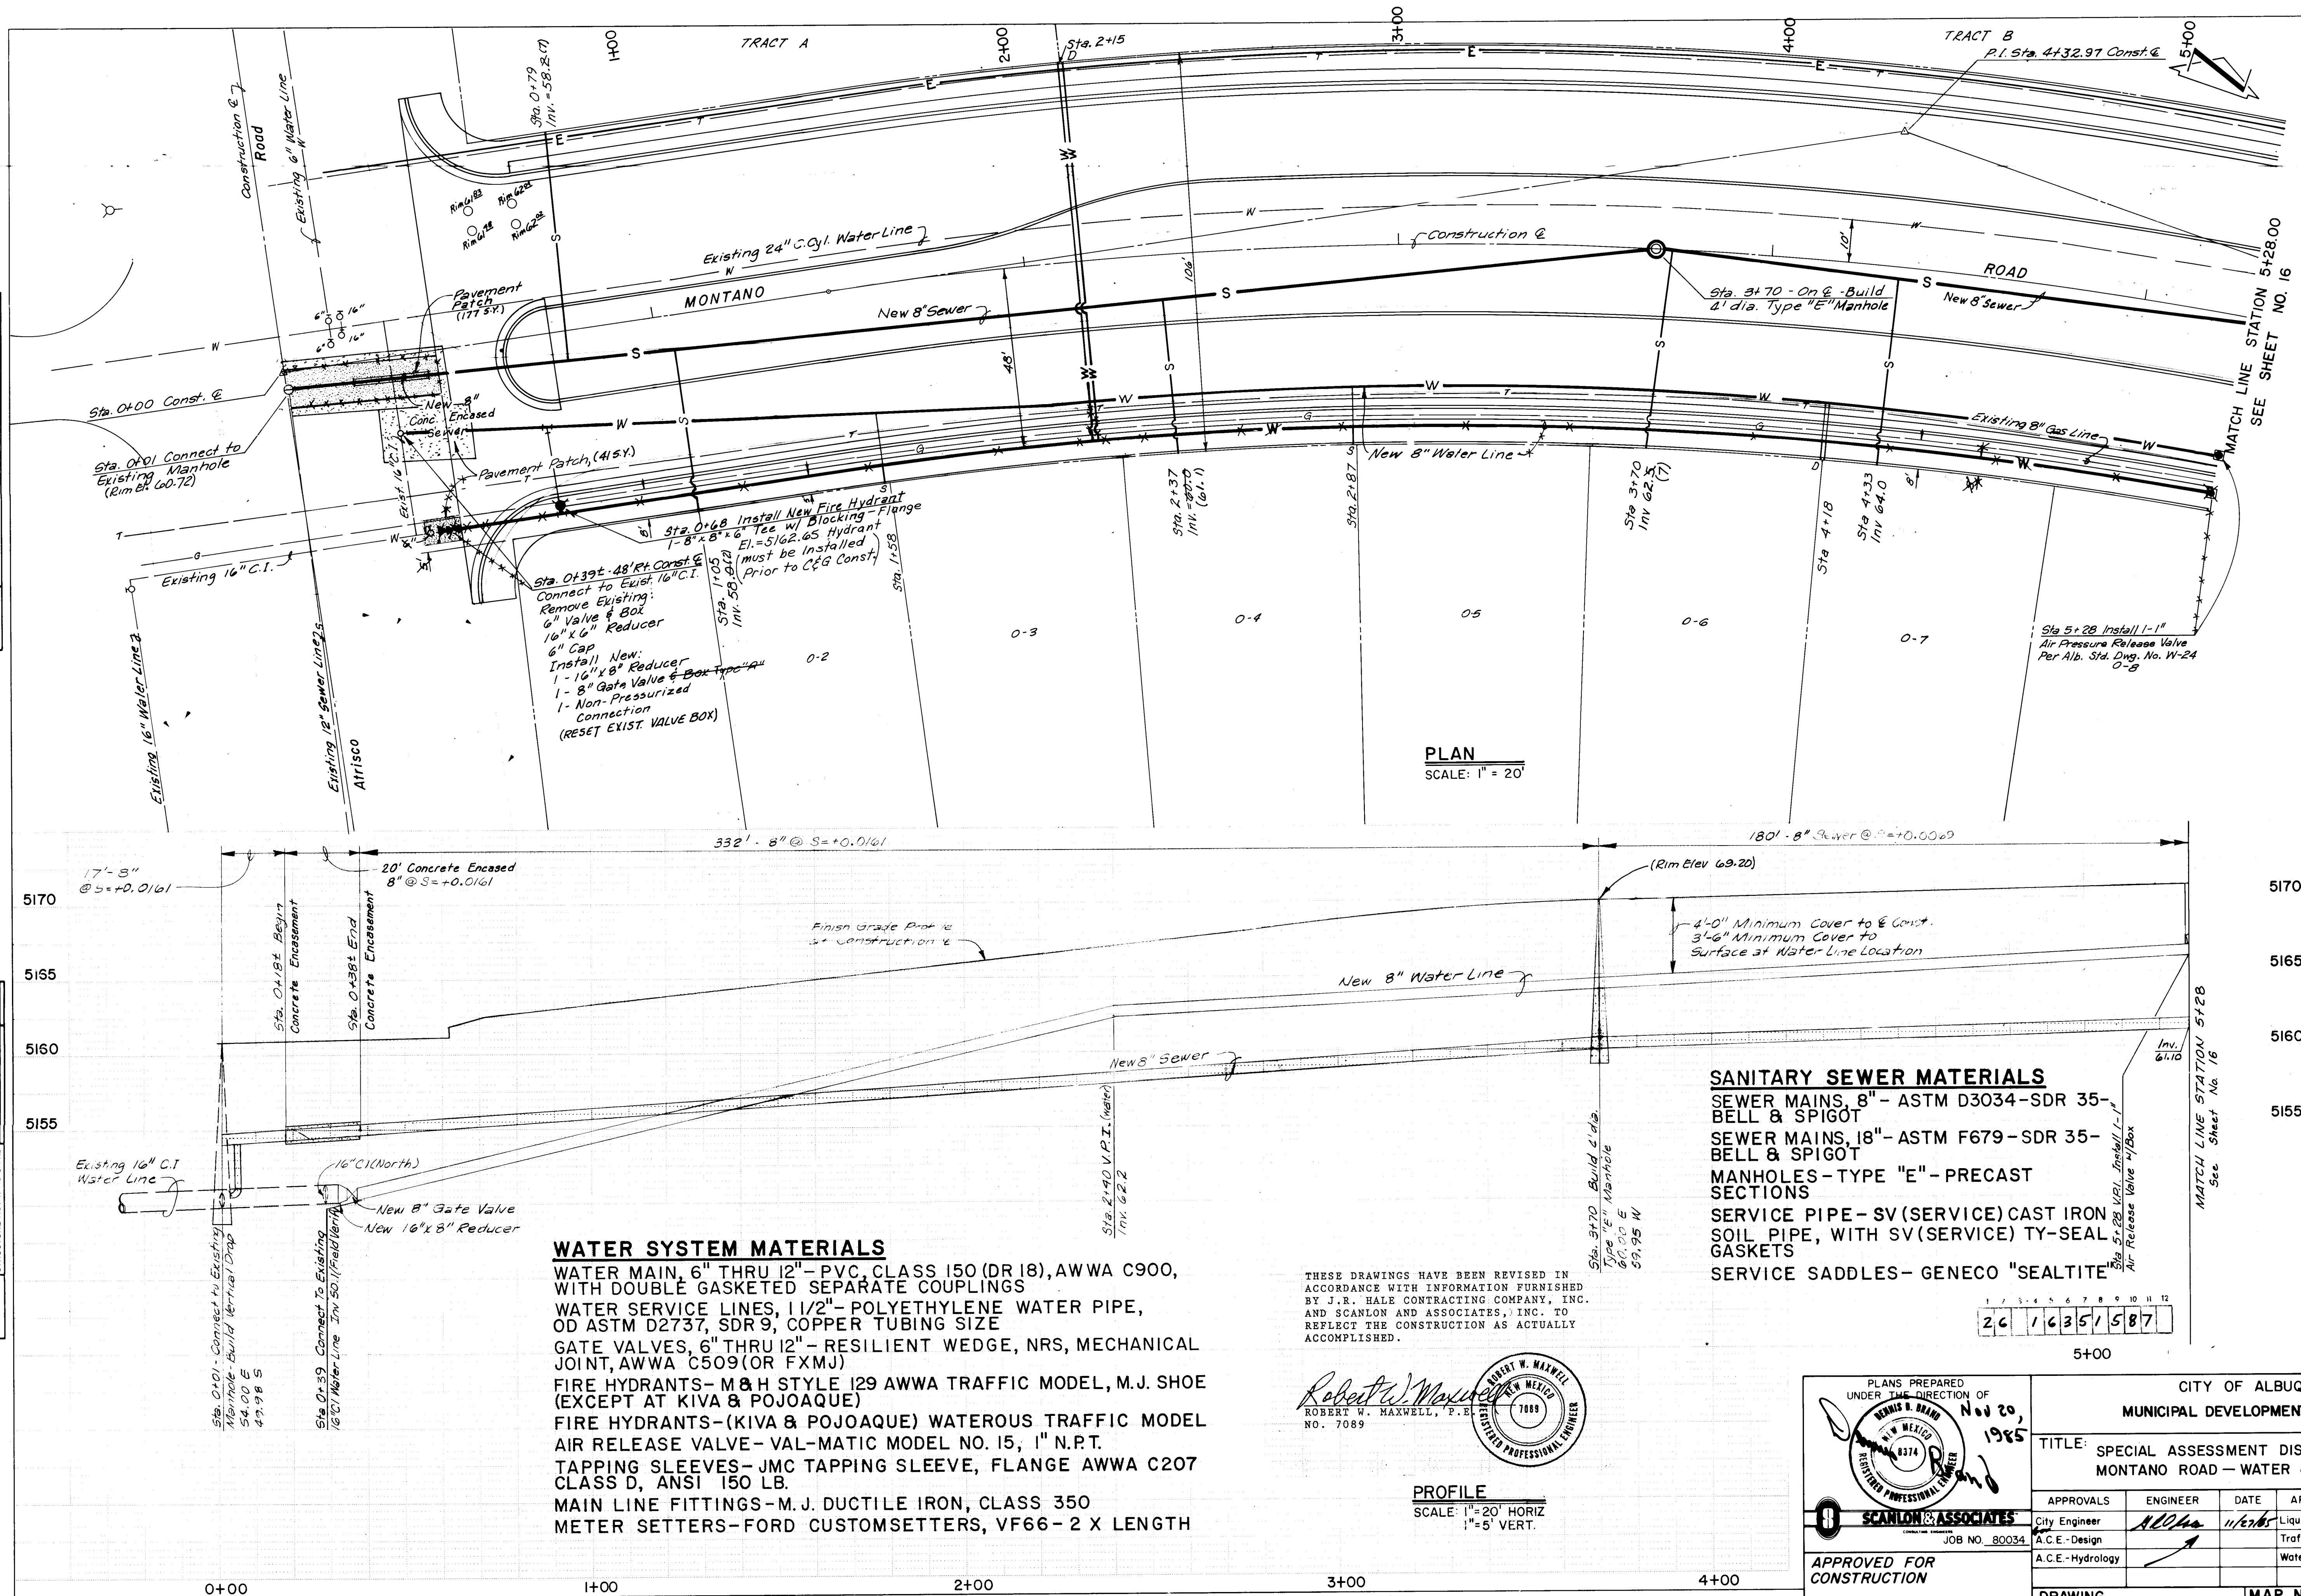

THESE DRAWINGS HAVE BEEN REVISED IN ACCORDANCE WITH INFORMATION FURNISHED BY J. R. HALE CONTRACTING COMPANY, INC. AND SCANLON AND ASSOCIATES, INC. TO REFLECT THE CONSTRUCTION AS ACTUALLY ACCOMPLISHED.

Robert W. Maxwell
ROBERT W. MAXWELL, P.E.
NO. 7089
REGISTERED PROFESSIONAL ENGINEER

PROFILE
SCALE: 1" = 20' HORIZ
1" = 5' VERT.

SANITARY SEWER MATERIALS
SEWER MAINS, 8" - ASTM D3034-SDR 35-
BELL & SPIGOT
SEWER MAINS, 18" - ASTM F679-SDR 35-
BELL & SPIGOT
MANHOLES - TYPE "E" - PRECAST
SECTIONS
SERVICE PIPE - SV (SERVICE) CAST IRON
SOIL PIPE, WITH SV (SERVICE) TY-SEAL
GASKETS
SERVICE SADDLES - GENECO "SEALTITE"


1 2 3 4 5 6 7 8 9 10 11 12
2 6 1 6 3 5 1 5 8 7
5+00

PLANS PREPARED UNDER THE DIRECTION OF					
CITY OF ALBUQUERQUE MUNICIPAL DEVELOPMENT DEPARTMENT					
TITLE: SPECIAL ASSESSMENT DISTRICT NO. 197 MONTANO ROAD - WATER & SEWER					
APPROVALS	ENGINEER	DATE	APPROVALS	ENGINEER	DATE
City Engineer	<i>ADD</i>	11/27/85	Liquid Waste	<i>William Q. Baker</i>	11-20-85
A.C.E.-Design			Traffic	<i>W.A. R.A.P.</i>	11-20-85
A.C.E.-Hydrology			Water	<i>William Q. Baker</i>	11-20-85
DRAWING NO. 1635			MAP NO. E-10		
SHEET 15 OF 35			RECORD DRAWING		

AS BUILT INFORMATION	BENCH MARKS	SURVEY INFORMATION	REFERENCES	REMARKS	REVISIONS	DESIGNED BY	DRAWN BY	CHECKED BY
CONTRACTOR: J.E. Hale Co. Inc. WORKING BY: Scanlon & Assoc. DATE: 1986 INSPECTOR'S ACCEPTANCE BY: DATE: 11/26 VERIFICATION BY: Scanlon & Assoc. DATE: 11/26 DRAWING NO. 1635	B.M. 14.14 - E10 - A 40 Penny Nail in power pole 100' North of Junction Arisco Rd. i Montano Rd. West side of Arisco Rd. Elev. 5145.930	FIELD NOTES NO. BY DATE	MAP NO. E-10 EST. NO. W.O. NO.	NO. DATE	NO. DATE	DATE March '81	DATE	DATE

PLAN	SURVEYED	BY	DATE
NO. 1	PLOTTED		
	ALIGNMENT CHECKED		
	AT 1/2" = 100'		

PROFILE	SURVEYED	BY	DATE
NO. 1	PLOTTED		
	STRUCTURE NOTATIONS OK'D		

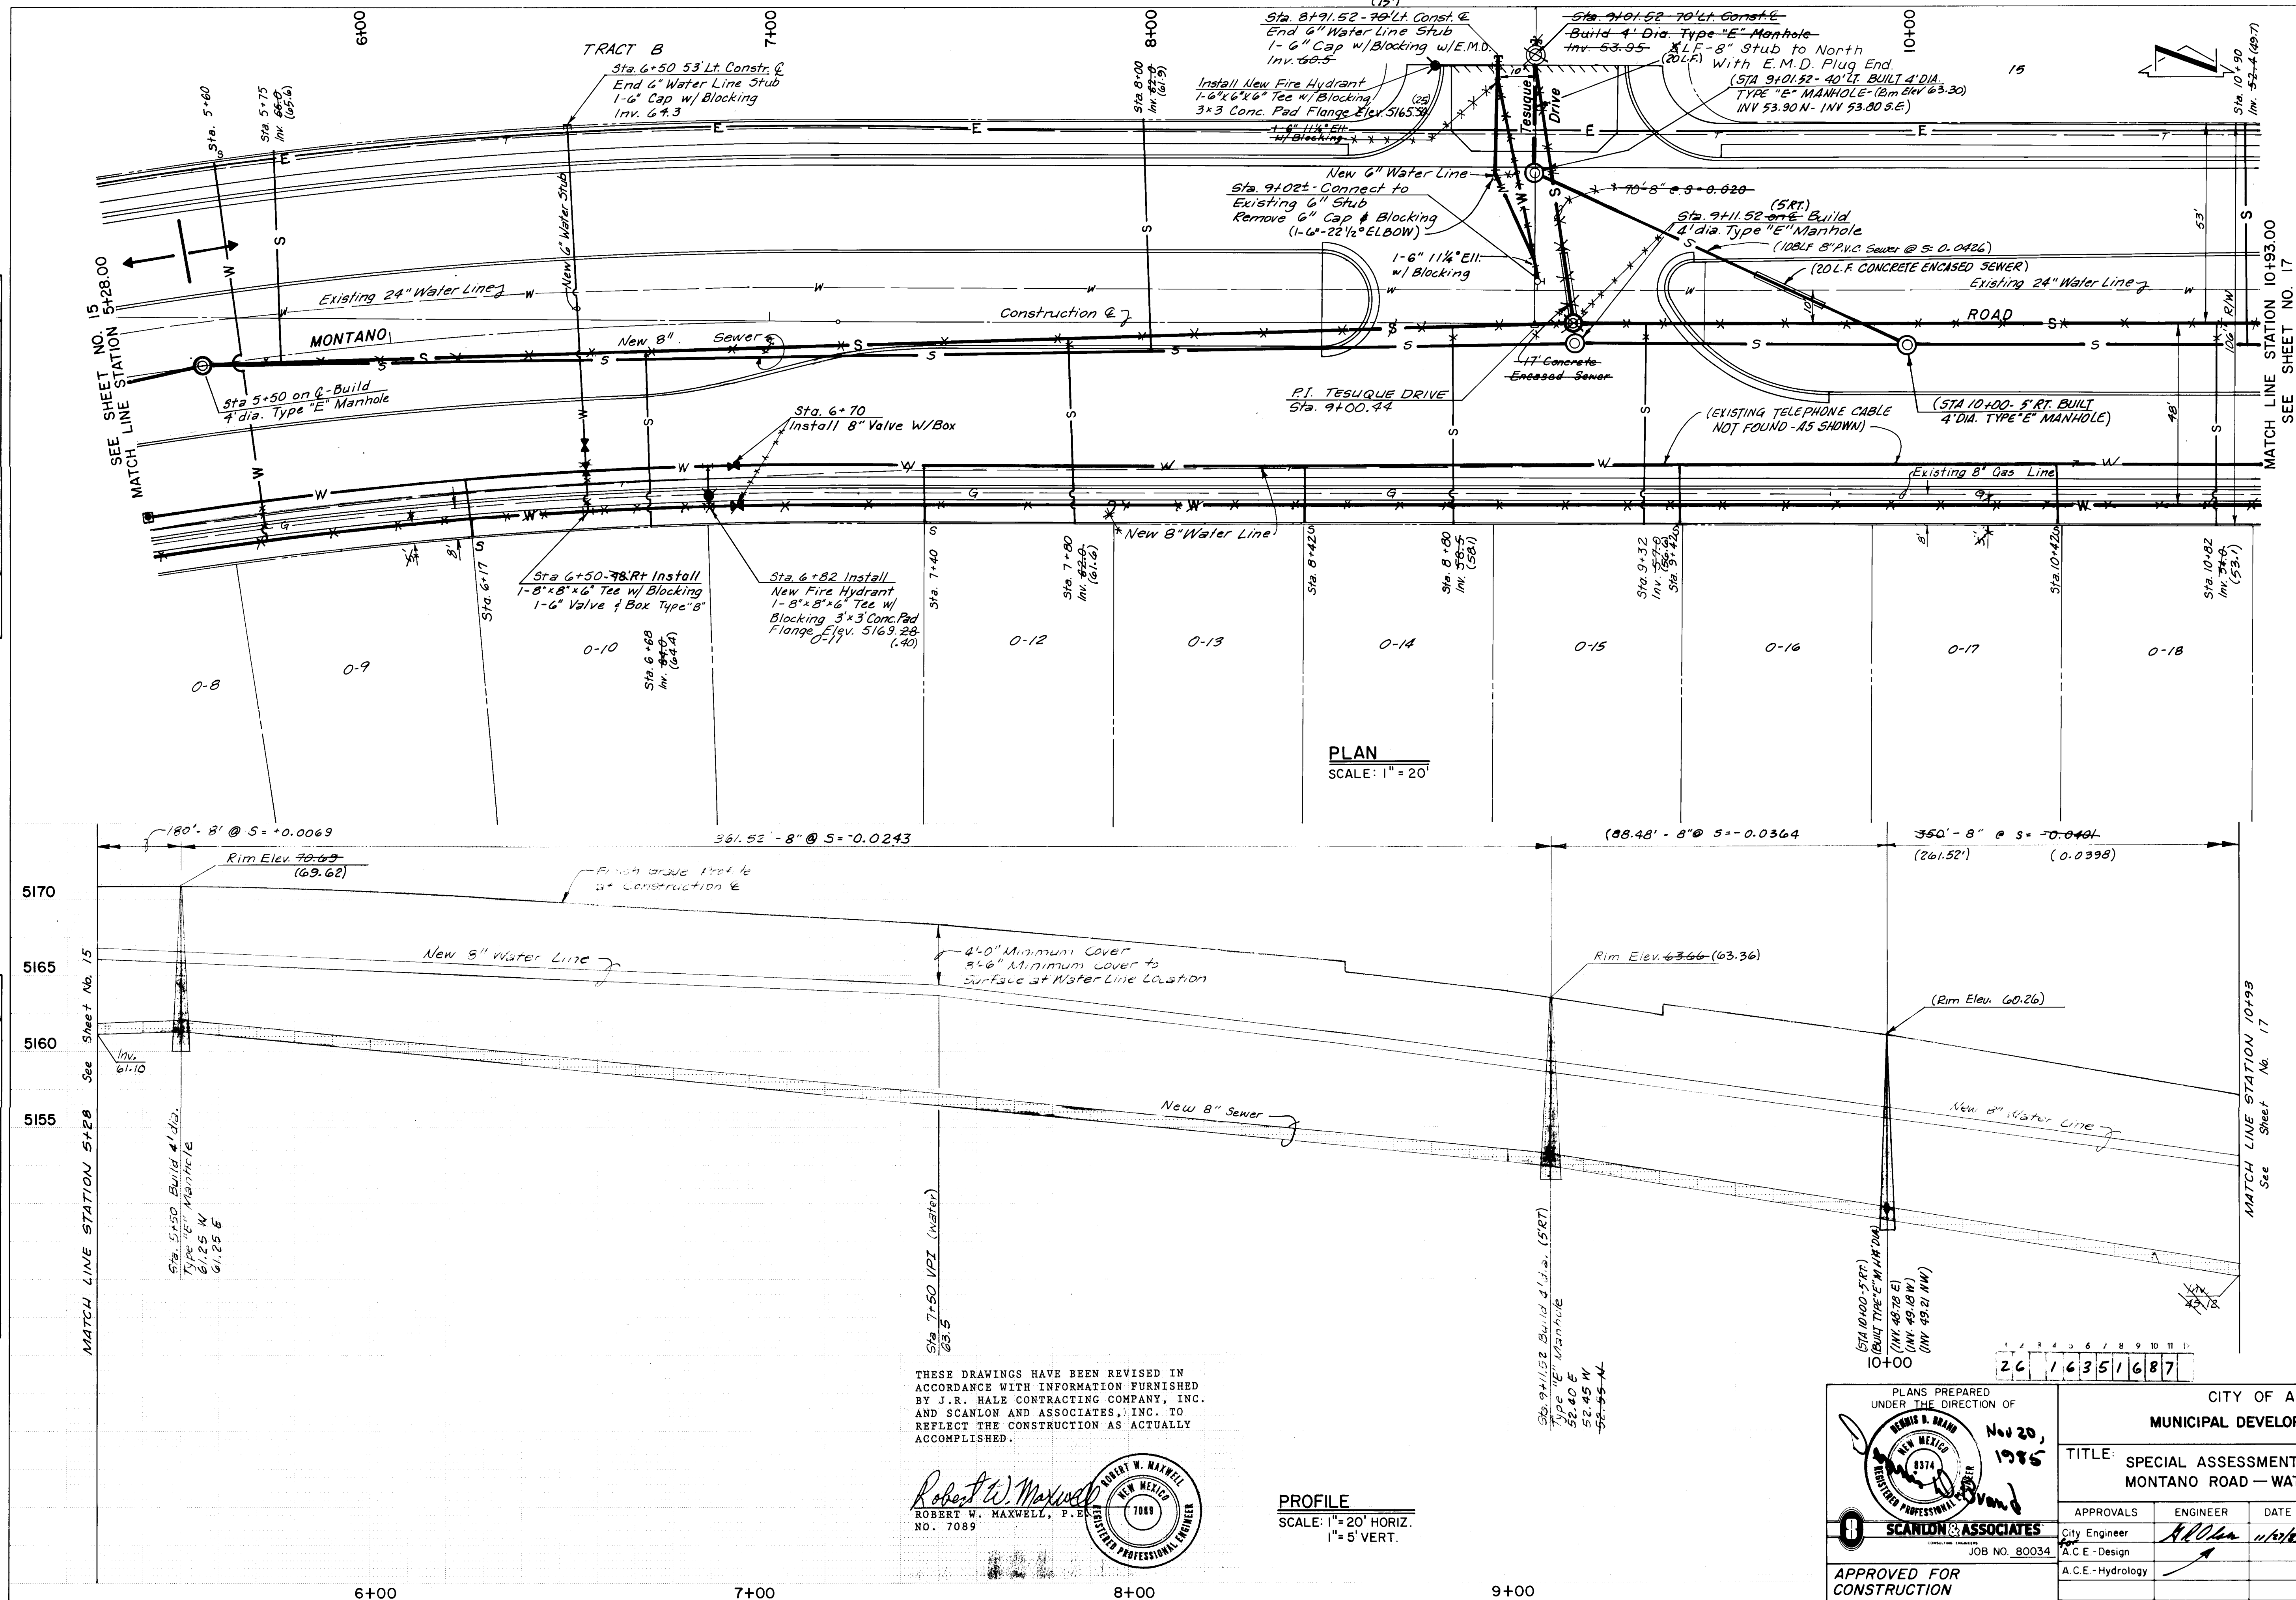

THESE DRAWINGS HAVE BEEN REVISED IN ACCORDANCE WITH INFORMATION FURNISHED BY J.R. HALE CONTRACTING COMPANY, INC. AND SCANLON AND ASSOCIATES, INC. TO REFLECT THE CONSTRUCTION AS ACTUALLY ACCOMPLISHED.

Robert W. Maxwell
ROBERT W. MAXWELL, P.E.
NO. 7089


ROBERT W. MAXWELL
REGISTERED PROFESSIONAL ENGINEER
1000

PROFILE
SCALE: 1" = 20' HORIZ.
1" = 5' VERT.

PLANS PREPARED UNDER THE DIRECTION OF		CITY OF ALBUQUERQUE MUNICIPAL DEVELOPMENT DEPARTMENT	
APPROVED FOR CONSTRUCTION		TITLE: SPECIAL ASSESSMENT DISTRICT NO. 197 MONTANO ROAD - WATER & SEWER	
CITY ENGINEER	DATE	APPROVALS	ENGINEER
		City Engineer	11/1/85
		A.C.E. - Design	11/1/85
		A.C.E. - Hydrology	11/1/85
DRAWING NO. 1635		MAP NO. E-10	
SHEET 16 OF 35		RECORD DRAWING	

PLAN	SURVEYED	BY	DATE
NO.	PLOTTED		
	ALIGNED		
	CHECKED		
	BY		
	DATE		

PROFILE	SURVEYED	BY	DATE
NO.	PLOTTED		
	ALIGNED		
	CHECKED		
	BY		
	DATE		

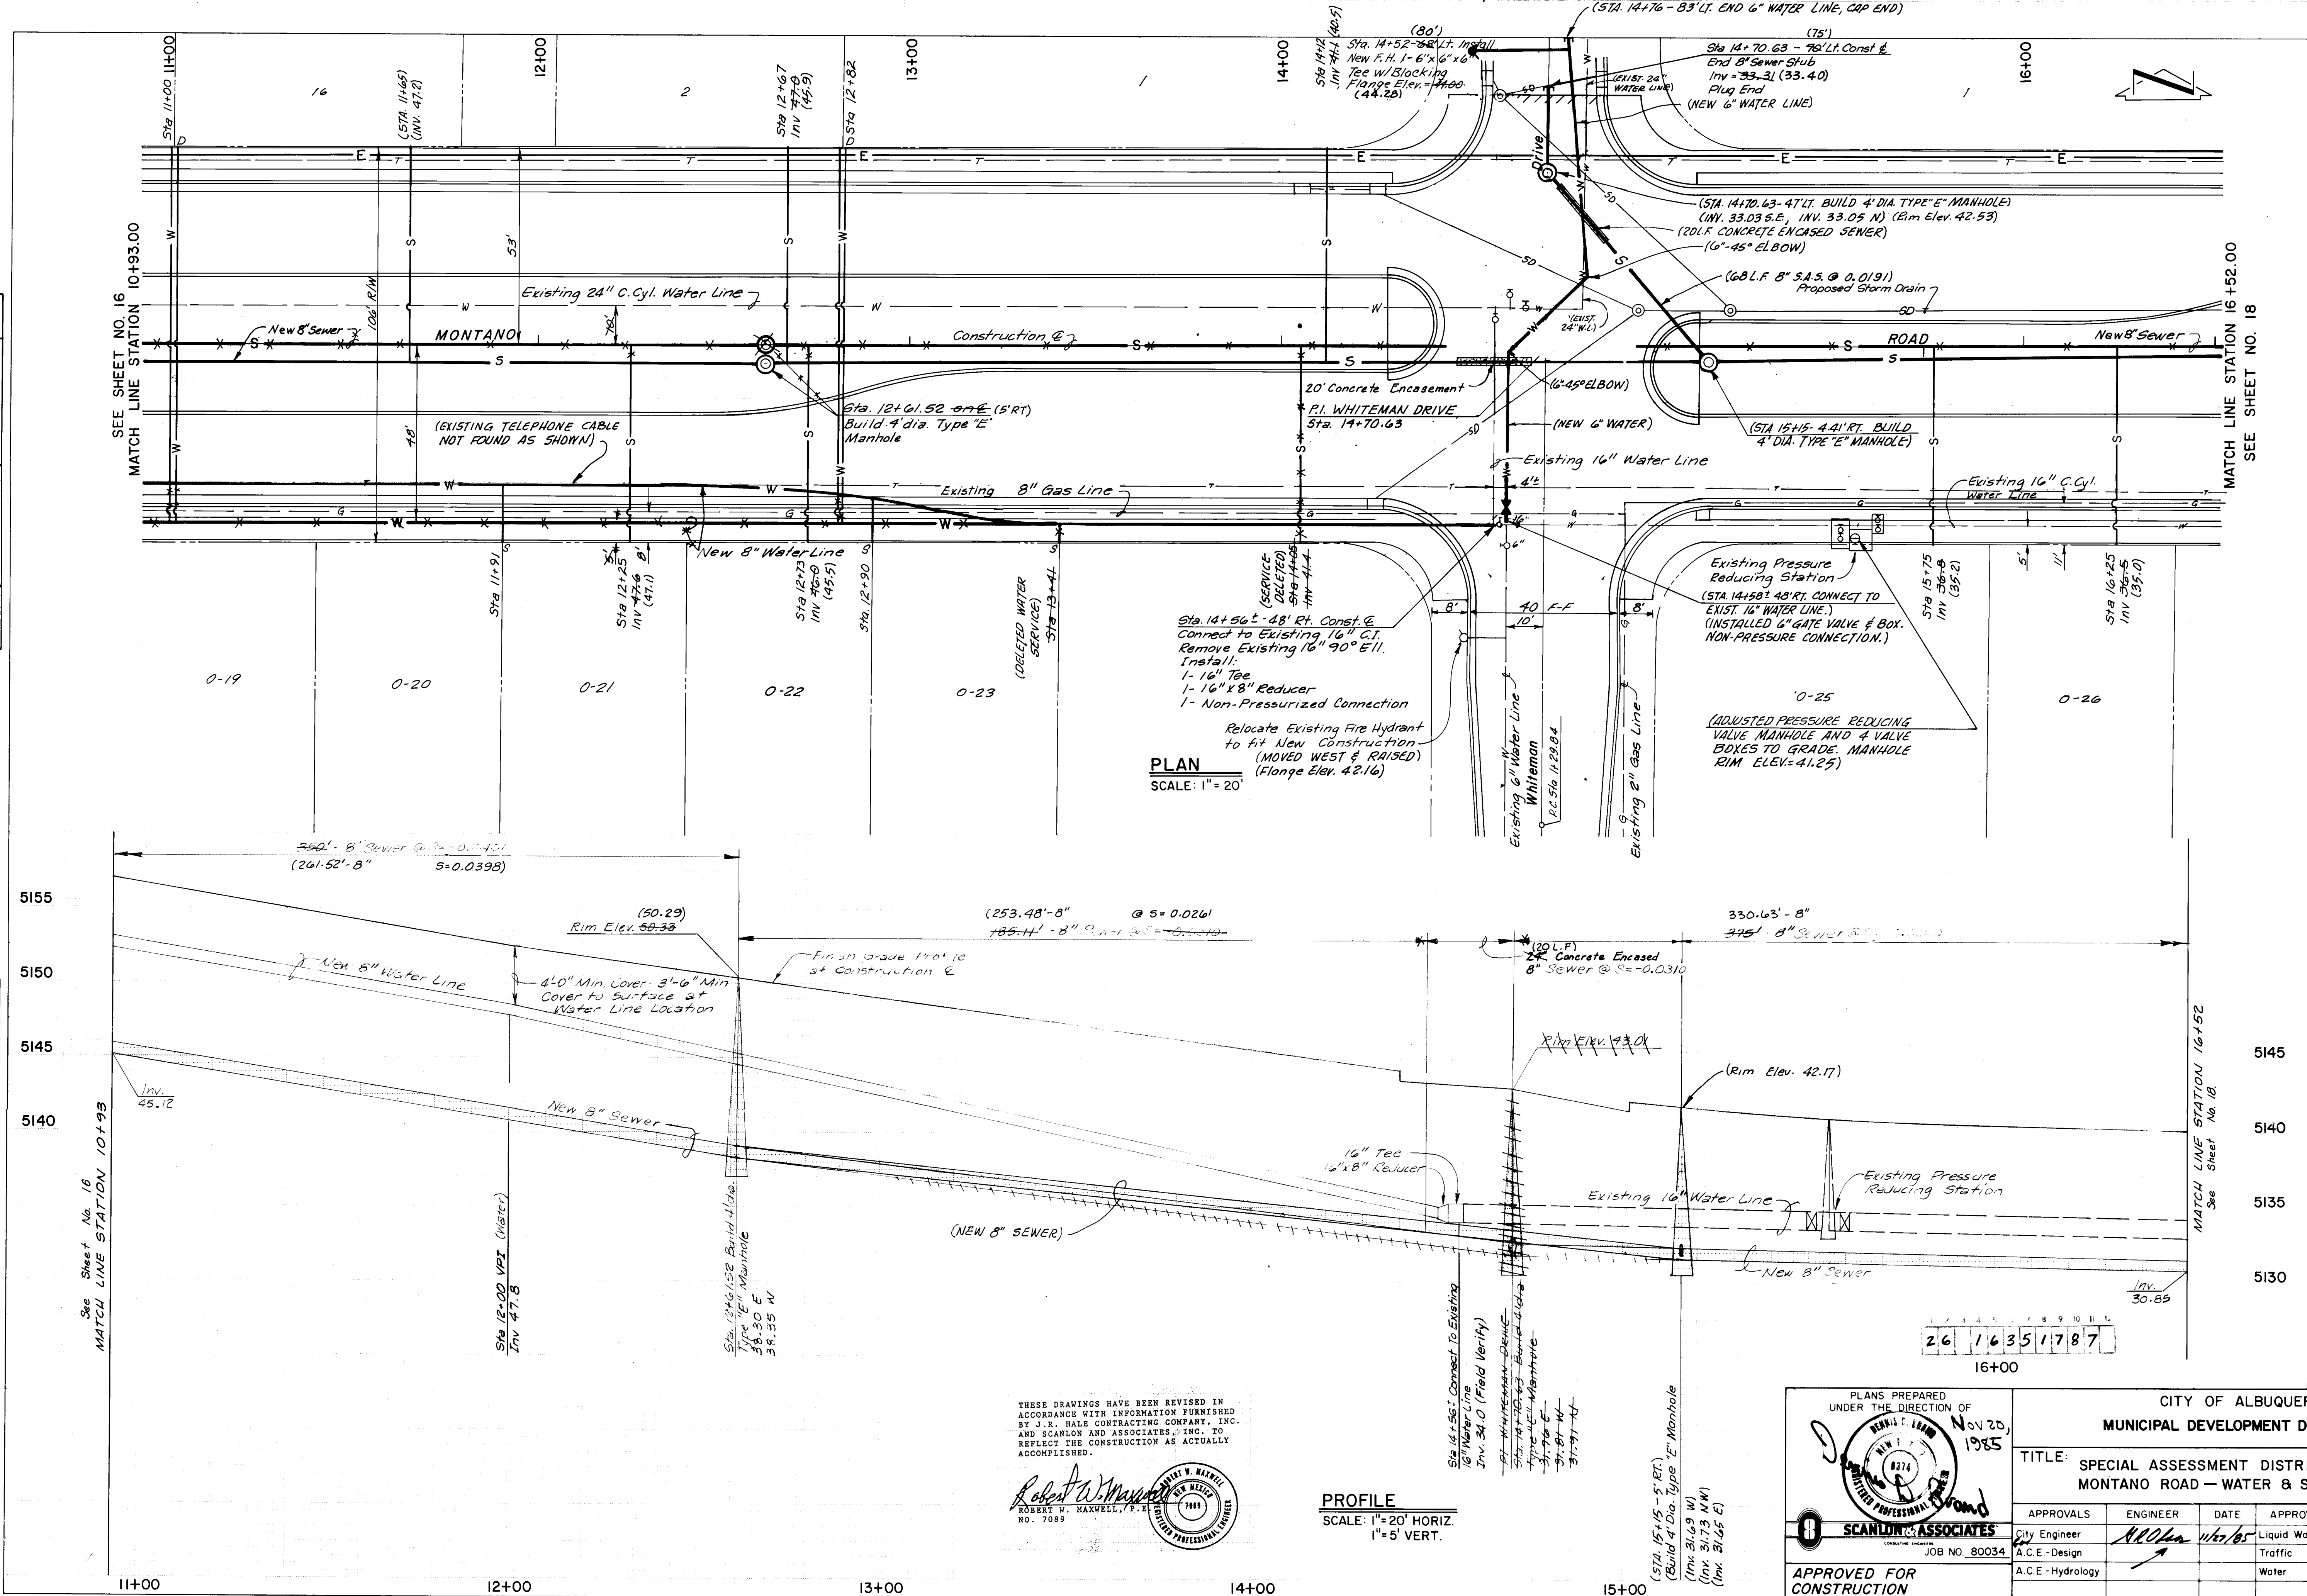

AS BUILT INFORMATION				BENCH MARKS				SURVEY INFORMATION				REFERENCES				REVISIONS				DESIGN			
CONTRACTOR	J.R. Hale Co., Inc.	DATE	1986	BM 14-E10-A	40 penny nail in power pole	180'		MAP NO. E-10	EST. NO.	WO. NO.	BY	NO.	DATE	REMARKS	DESIGN	NO.	DATE	REMARKS	DESIGN	NO.	DATE	REMARKS	DESIGN
STAKE BY	Scanlon & Assoc.	DATE	1986	North of Junction	Atrisco Road & Montano Rd.																		
ACCEPTANCE BY		DATE		West of Atrisco	Line 3145.930																		
VERIFICATION BY	Scanlon & Assoc.	DATE	1986	BM 16-E10-B	Top of curb North end N.E.																		
DRANISSED BY	Scanlon & Assoc.	DATE	1986	Return Whiteman f. Cuesta																			
PUBLISHED	Published	Elev.	5132.60																				
RECORDED BY		DATE																					
NO.																							

THESE DRAWINGS HAVE BEEN REVISED IN ACCORDANCE WITH INFORMATION FURNISHED BY J.R. HALE CONTRACTING COMPANY, INC. AND SCANLON AND ASSOCIATES, INC. TO REFLECT THE CONSTRUCTION AS ACTUALLY ACCOMPLISHED.

Robert W. Maxwell, P.E.
NO. 7089

PROFILE
SCALE: 1" = 20' HORIZ.
1" = 5' VERT.


PLANS PREPARED UNDER THE DIRECTION OF
NOV 20, 1985
SCANLON & ASSOCIATES
JOB NO. 80034
APPROVED FOR CONSTRUCTION
CITY ENGINEER DATE

CITY OF ALBUQUERQUE MUNICIPAL DEVELOPMENT DEPARTMENT					
TITLE: SPECIAL ASSESSMENT DISTRICT NO. 197 MONTANO ROAD - WATER & SEWER					
APPROVALS	ENGINEER	DATE	APPROVALS	ENGINEER	DATE
City Engineer	NOV 20, 1985		Liquid Waste	William P. Bohn	11-20-85
A.C.E. - Design			Traffic	N.A.D.A.P.	11-20-85
A.C.E. - Hydrology			Water	William P. Bohn	11-20-85
DRAWING NO.	1635	MAP NO. E-10	SHEET 17 OF 35		

RECORD DRAWING

PLAN	SURVEYED	DATE
	BY	
NOTE BOOK	ALIGNED CHECKED	
	BY	

PROFILE	SURVEYED	DATE
	BY	
NOTE BOOK	STRUCTURE NOTATIONS CHECKED	
	BY	

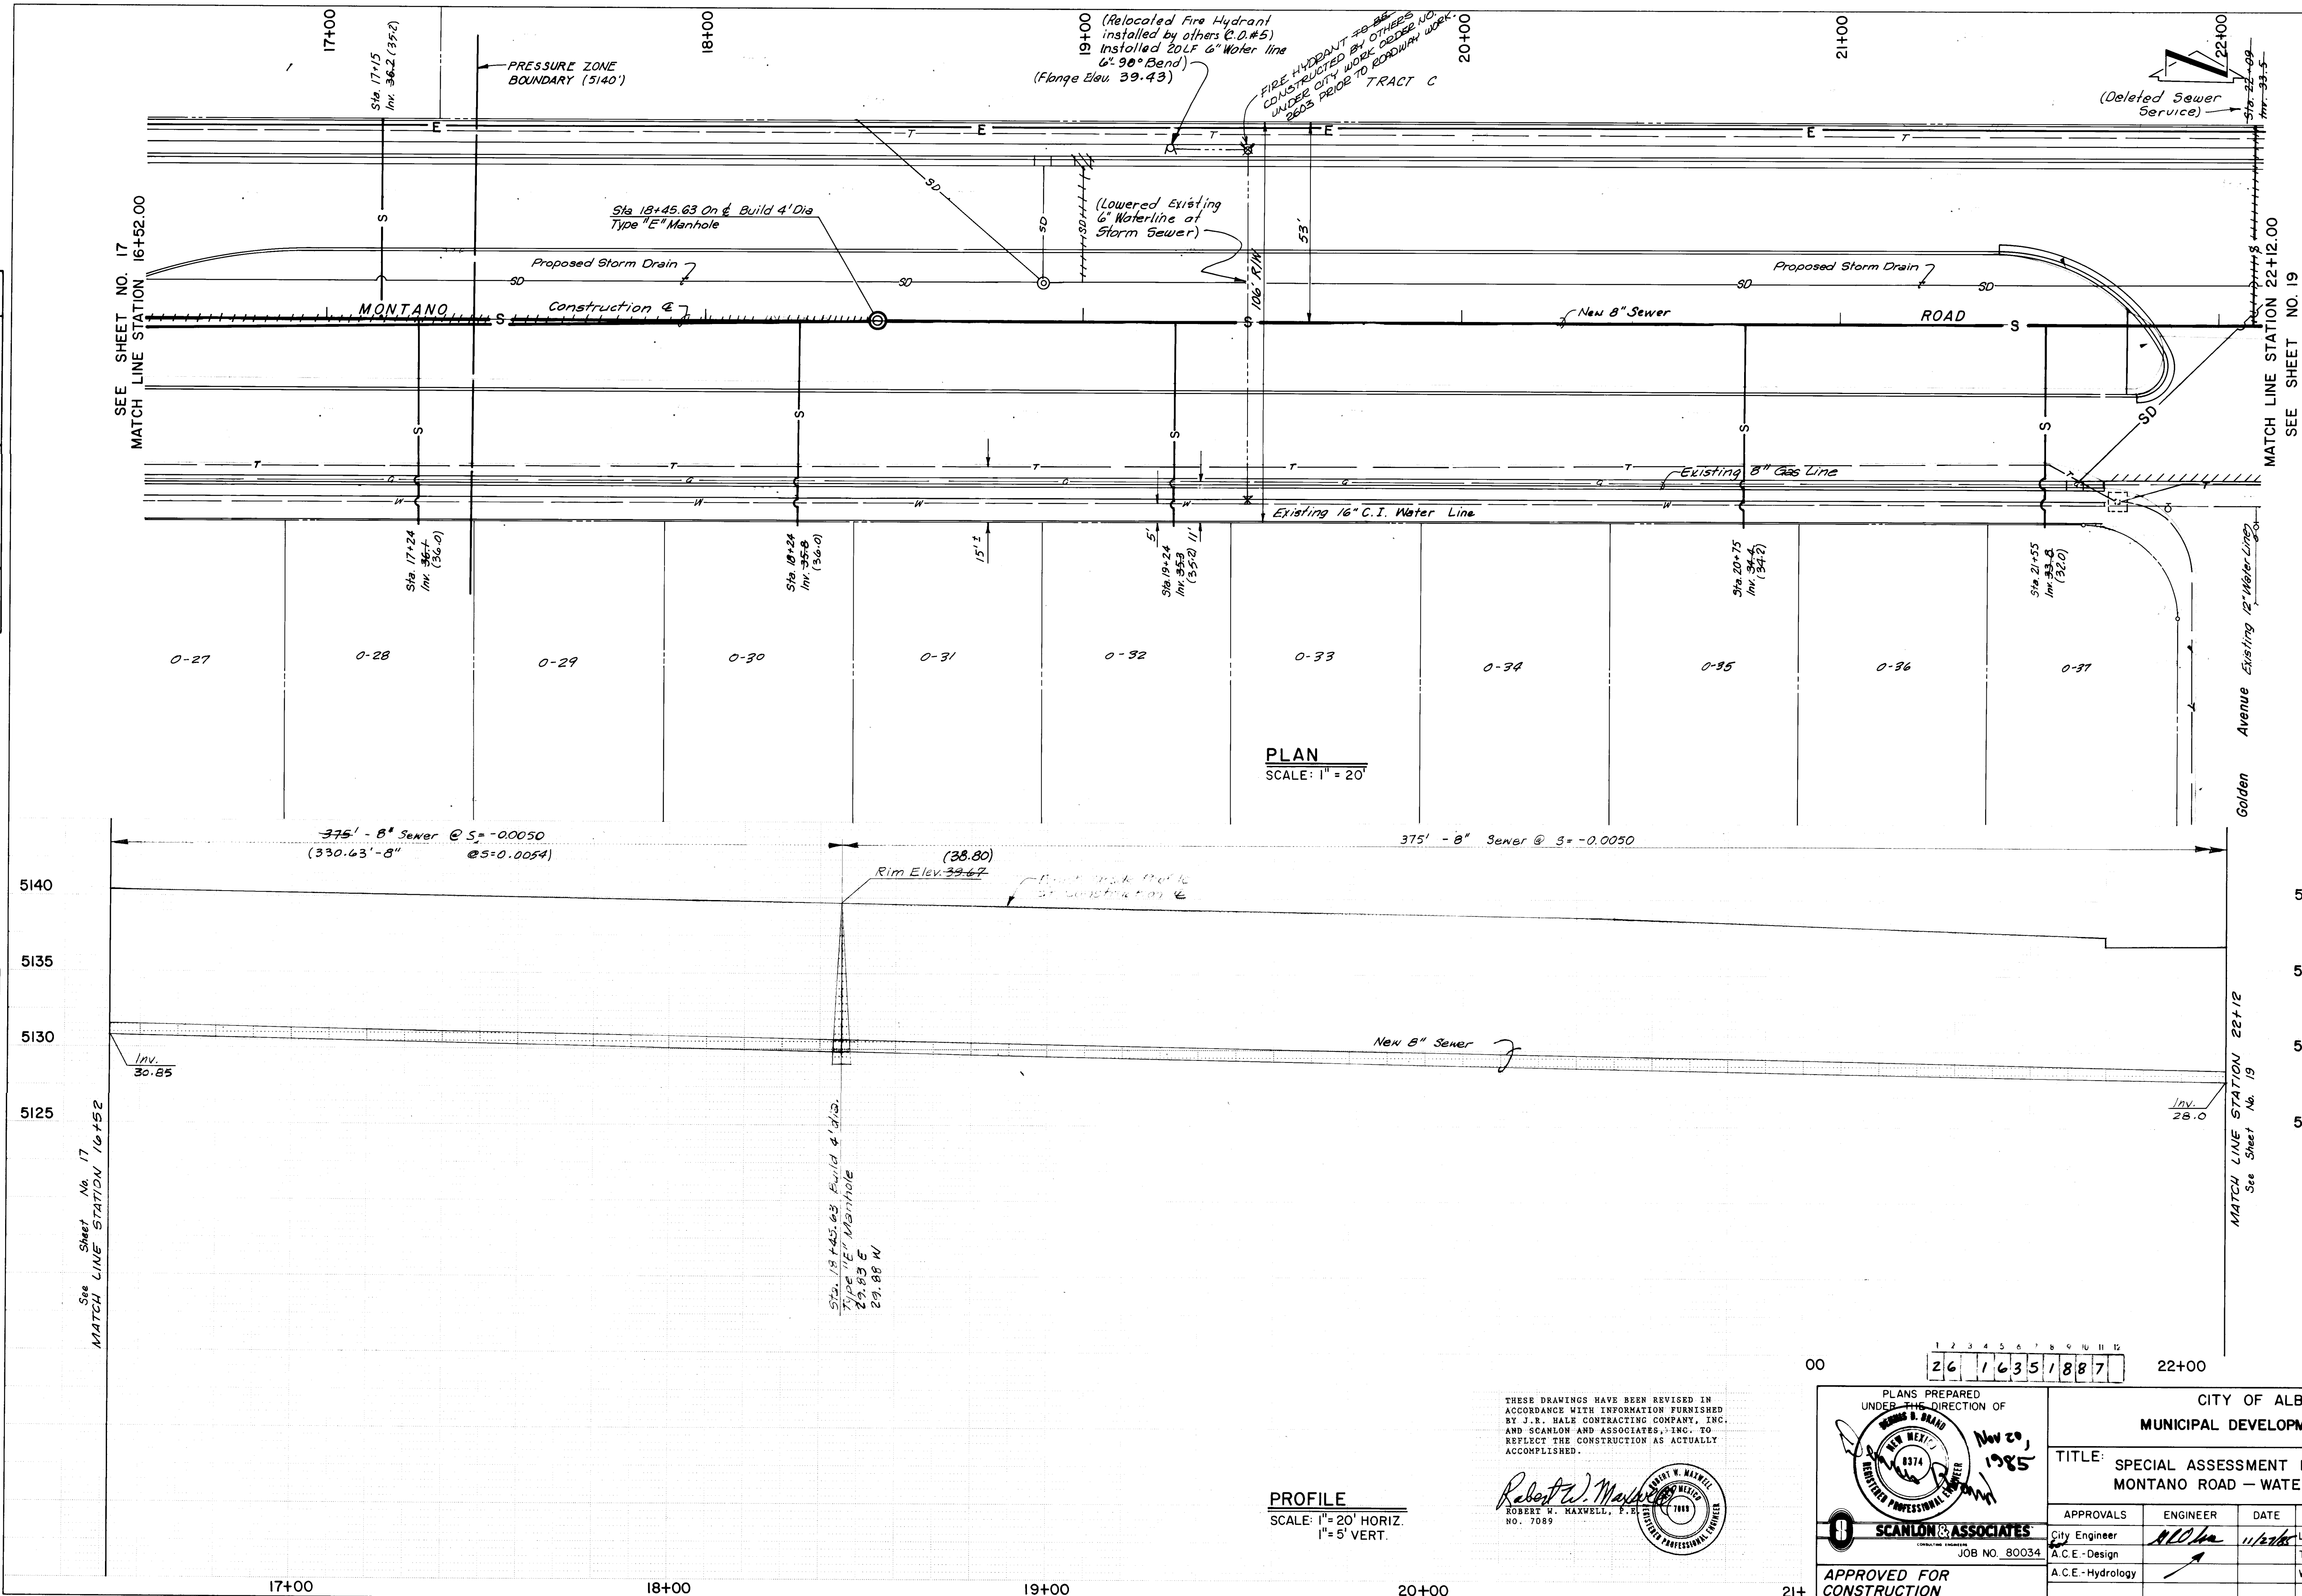

THESE DRAWINGS HAVE BEEN REVISED IN ACCORDANCE WITH INFORMATION FURNISHED BY J.R. HALE CONTRACTING COMPANY, INC. AND SCANLON AND ASSOCIATES, INC. TO REFLECT THE CONSTRUCTION AS ACTUALLY ACCOMPLISHED.

Robert W. Maxwell
ROBERT W. MAXWELL, F.S.
NO. 7089


PLANS PREPARED UNDER THE DIRECTION OF SCANLON & ASSOCIATES NOV 20, 1985 JOB NO. 80034				CITY OF ALBUQUERQUE MUNICIPAL DEVELOPMENT DEPARTMENT TITLE: SPECIAL ASSESSMENT DISTRICT NO. 197 MONTANO ROAD - WATER & SEWER			
APPROVALS	ENGINEER	DATE	APPROVALS	ENGINEER	DATE		
City Engineer	<i>W.D. Ha</i>	11/20/85	Liquid Waste	<i>William D. B. B.</i>	11-20-85		
A.C.E.-Design	<i>A</i>		Traffic	<i>W.D. B. B.</i>	11-20-85		
A.C.E.-Hydrology			Water	<i>William D. B. B.</i>	11-20-85		
DRAWING NO. 1635		MAP NO. E-10		SHEET 18 OF 35			
CITY ENGINEER		DATE					

AS BUILT INFORMATION	BENCH MARKS	SURVEY INFORMATION		REFERENCES		REVISIONS		DESIGN	
		FIELD NOTES	DATE	MAP NO. E-10	EST. NO.	NO. DATE	BY	DATE	
CONTRACTOR J.R. Hale Co., Inc.		BM 14-E-10-A 40 Penny Nail in Power Pole 190' north of junction Arisco Road & Montano Road west of Arisco Elev. 5145.930		11-2-86 Corrections for Record Drawings					
WORK BY Scanlon & Assoc. DATE 10/9/86		BM 16-T-10 "Top of curb north end N.E. Return Whittman & Cuesis							
DRAWN BY Scanlon & Assoc. DATE 10/86		Published Elev = 5132.60							
MICRO-FILM INFORMATION									
RECORDED BY									
DATE									

RECORD DRAWING

PLAN	SURVEYED	BY	DATE
NO.	PLOTTED		
	CHECKED		
	RT. OF WAY CHECKED		

PROFILE	SURVEYED	BY	DATE
NO.	PLOTTED		
	CHECKED		
	STRUCTURE NOTATIONS CHKD		

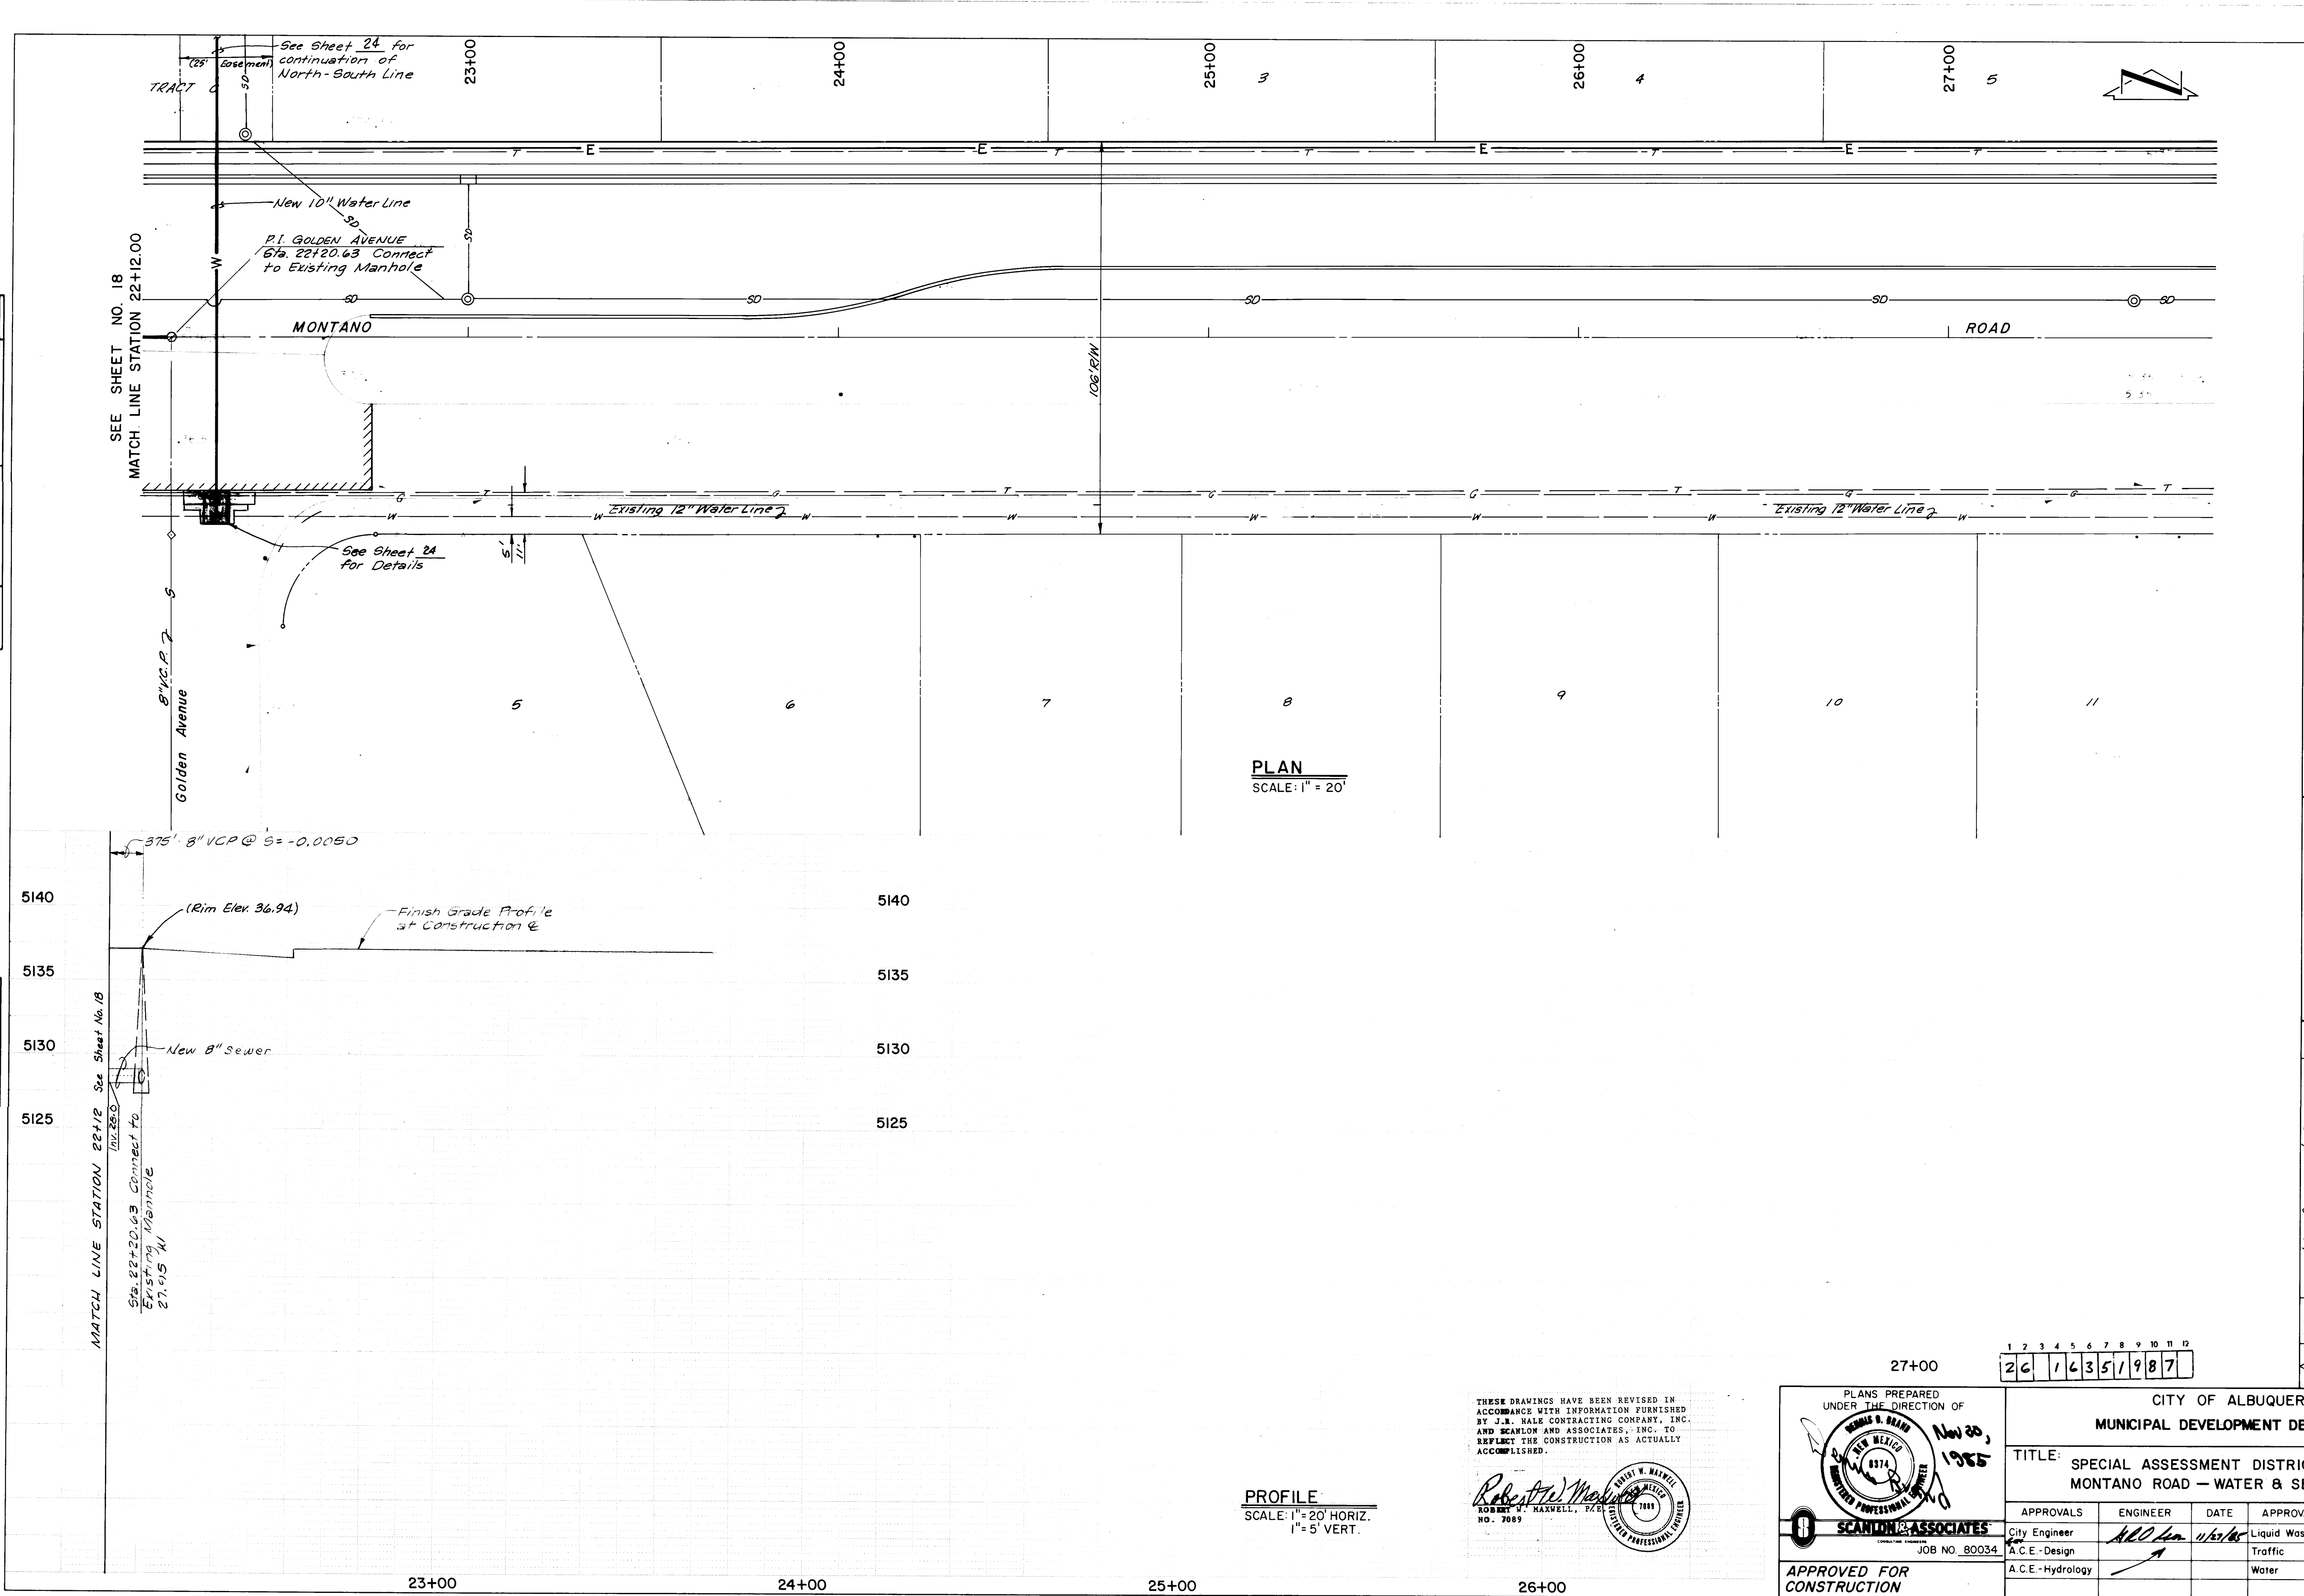

THESE DRAWINGS HAVE BEEN REVISED IN ACCORDANCE WITH INFORMATION FURNISHED BY J.R. HALE CONTRACTING COMPANY, INC. AND SCANLON AND ASSOCIATES, INC. TO REFLECT THE CONSTRUCTION AS ACTUALLY ACCOMPLISHED.

Robert J. Maxwell
ROBERT J. MAXWELL, P.E.
NO. 7089

PLANS PREPARED UNDER THE DIRECTION OF

SCANLON & ASSOCIATES
JOB NO. 80034

APPROVED FOR CONSTRUCTION

CITY ENGINEER DATE

CITY OF ALBUQUERQUE
MUNICIPAL DEVELOPMENT DEPARTMENT

TITLE: SPECIAL ASSESSMENT DISTRICT NO. 197
MONTANO ROAD - WATER & SEWER


APPROVALS	ENGINEER	DATE	APPROVALS	ENGINEER	DATE
City Engineer	<i>ALL</i>	11/17/85	Liquid Waste	<i>William G. Bell</i>	11-20-85
A.C.E. - Design			Traffic	<i>N/A</i>	11-20-85
A.C.E. - Hydrology			Water	<i>William G. Bell</i>	11-20-85

DRAWING NO. 1635 MAP NO. E-11 SHEET 19 OF 35

AS BUILT INFORMATION		BENCH MARKS		SURVEY INFORMATION		REFERENCES	
CONTRACTOR	J.R. Hale Co. Inc.	BM 14-ETD-A	40 penny nail in power pole	MAP NO. E-11	EST. NO.	W.O. NO.	
WORK	Scanlon & Assoc.	180' north of junction Arisco Road / Montano					
INSPECTOR'S		Road west of Arisco. Elev. 5145.930					
ACCEPTANCE		BM No. 7-ETD-B Top of curb north end N.E.					
DATE	10/86	Return Whiteman & Cuestia					
VERIFICATION		Published Elevation = 5132.60					
DATE	10/86						
DESIGNED BY							
DRAWN BY	M.C. L.H.						
CHECKED BY							

RECORD DRAWING

PROFILE		BY	DATE
NOTE BOOK	SURVEYED		
NO.	PLOTTED		
	GRADES CHECKED		
	B. M.'S NOTED		
	STRUCTURE NOTATIONS CHWD		

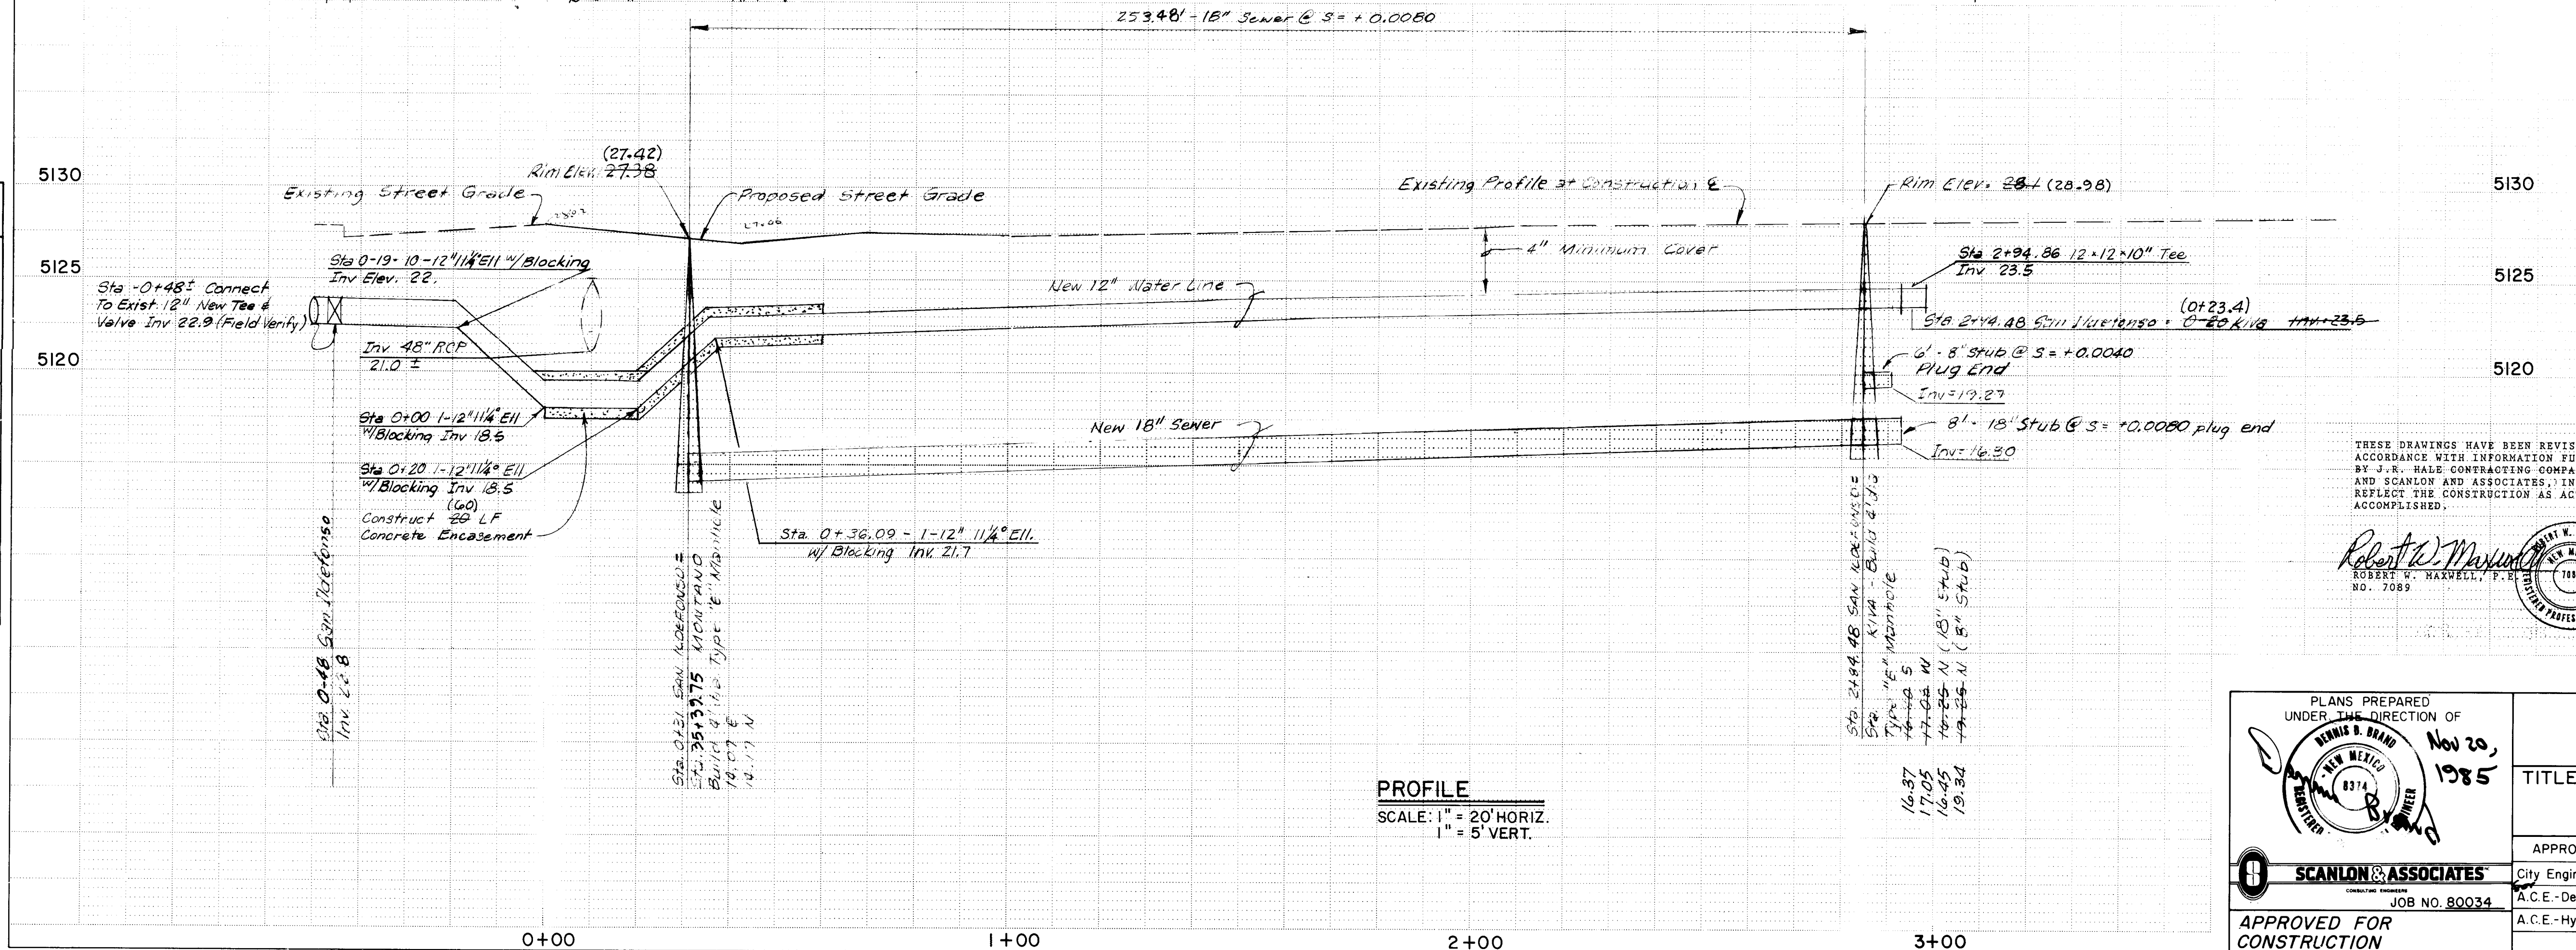

PLANS PREPARED
UNDER THE DIRECTION OF



Nov 20,
1985


CITY OF ALBUQUERQUE MUNICIPAL DEVELOPMENT DEPARTMENT					
TITLE: SPECIAL ASSESSMENT DISTRICT NO. 197 SAN ILDEFONSO DRIVE - WATER & SEWER					
APPROVALS	ENGINEER	DATE	APPROVALS	ENGINEER	DATE
City Engineer	<i>MLC</i>	<i>11/20/85</i>	Liquid Waste	<i>William G. Baker</i>	<i>11-20-85</i>
A.C.E. - Design			Traffic	<i>MLA D.O.P.</i>	<i>11-20-85</i>
A.C.E. - Hydrology			Water	<i>William G. Baker</i>	<i>11-20-85</i>
DRAWING NO.		MAP NO.		SHEET 20 OF 35	
1635		E-11			
CITY ENGINEER		DATE			

THESE DRAWINGS HAVE BEEN REVISED IN ACCORDANCE WITH INFORMATION FURNISHED BY J.R. HALE CONTRACTING COMPANY, INC. AND SCANLON AND ASSOCIATES, INC. TO REFLECT THE CONSTRUCTION AS ACTUALLY ACCOMPLISHED.




RECORD DRAWING

PROFILE		BY	DATE
	SURVEYED		
	PLOTTED		
	GRADES CHECKED		
	B. M.'s NOTED		
	STRUCTURE NOTATIONS CHECKED		
NOTE BOOK			
NO.			

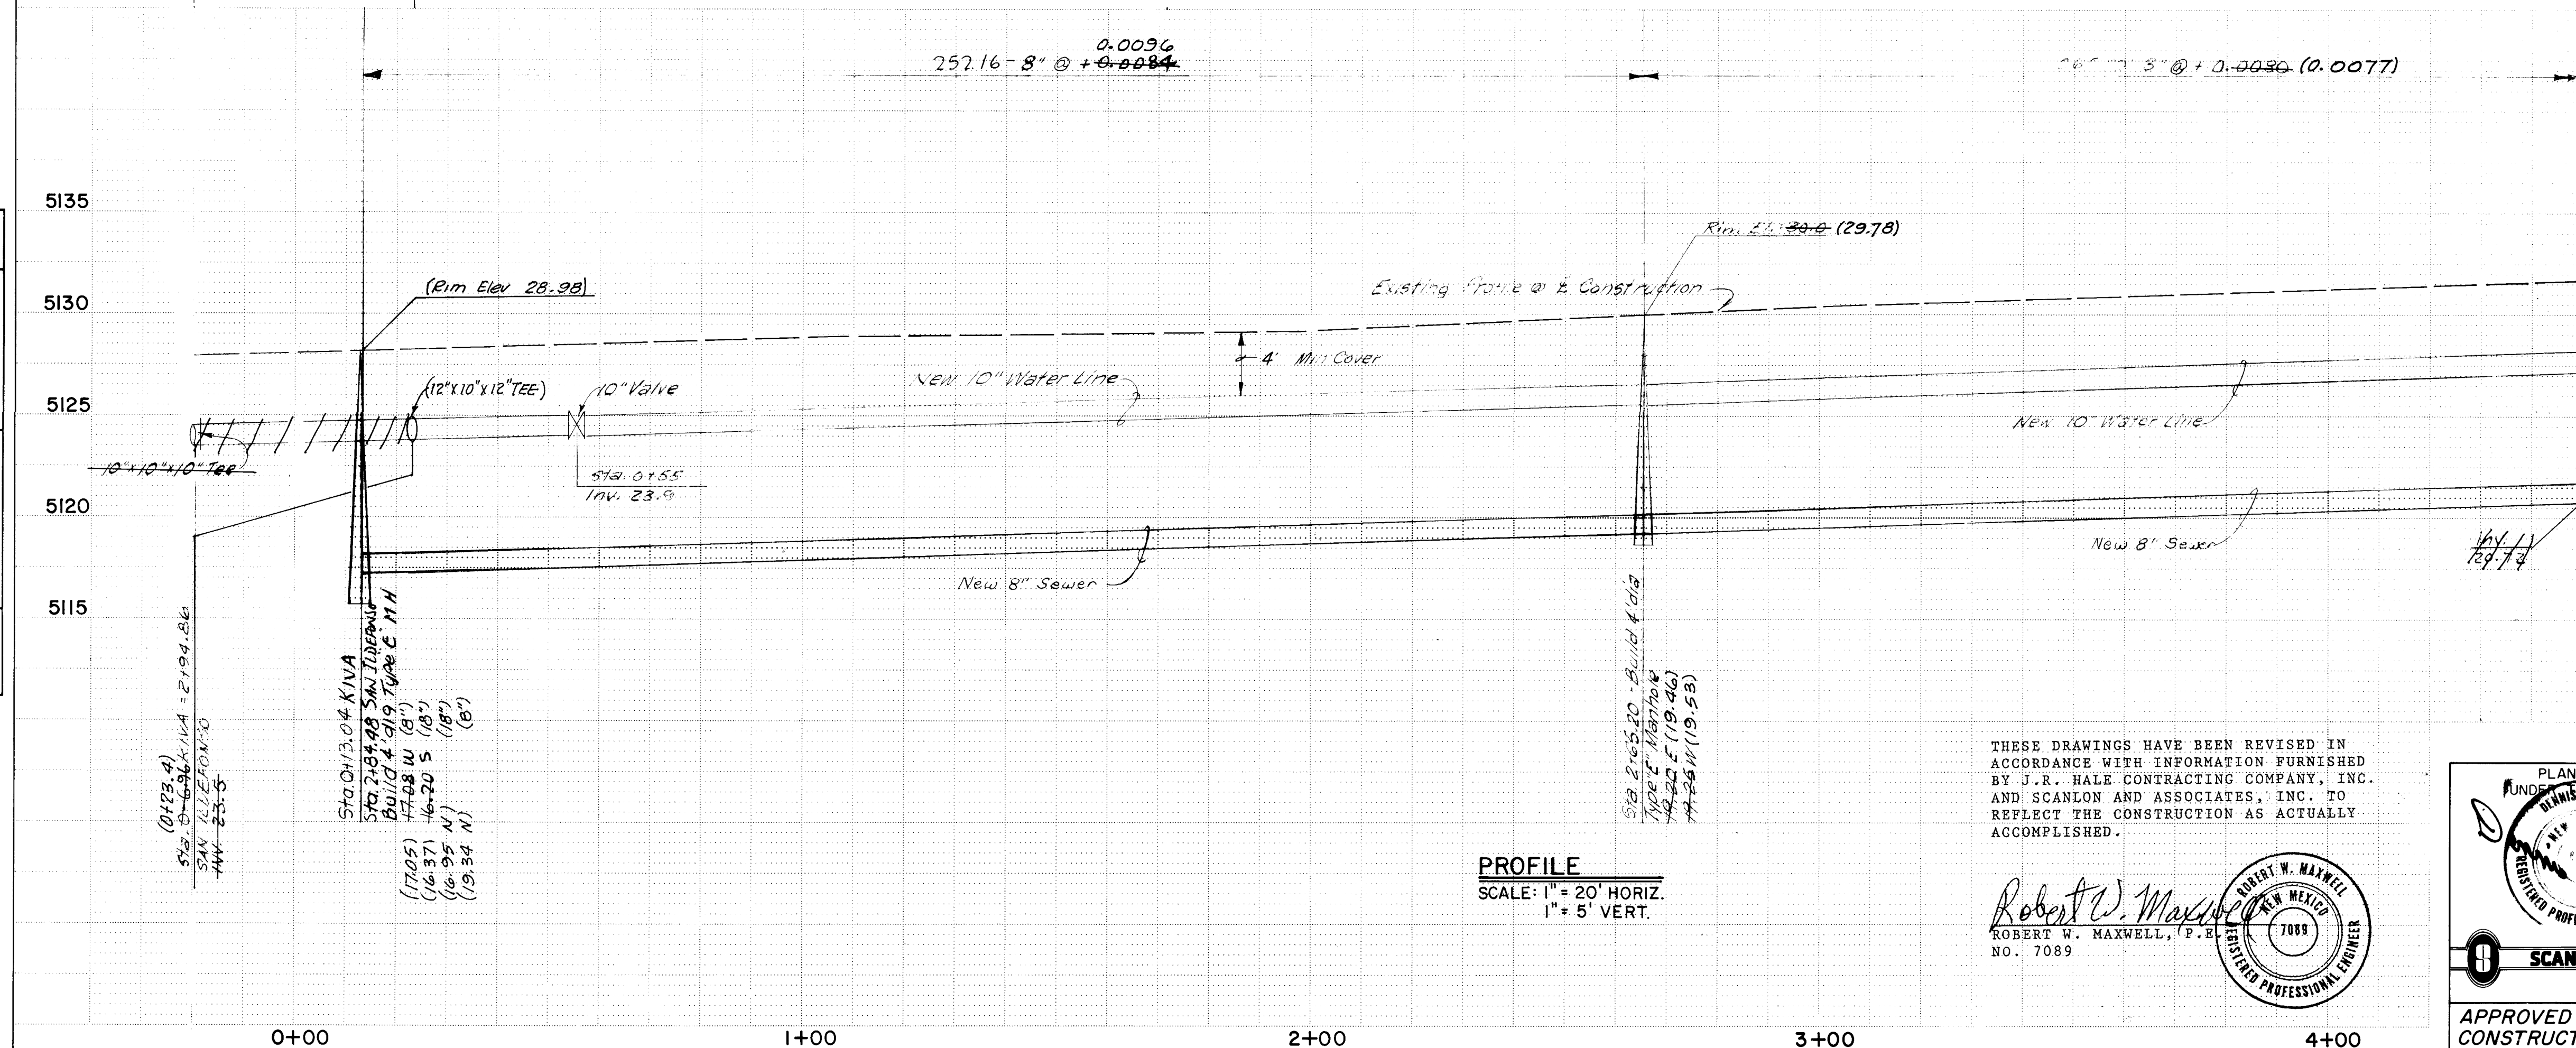

THESE DRAWINGS HAVE BEEN REVISED IN ACCORDANCE WITH INFORMATION FURNISHED BY J.R. HALE CONTRACTING COMPANY, INC. AND SCANLON AND ASSOCIATES, INC. TO REFLECT THE CONSTRUCTION AS ACTUALLY ACCOMPLISHED.

Robert W. Maxwell
ROBERT W. MAXWELL, (P.
NO. 7089

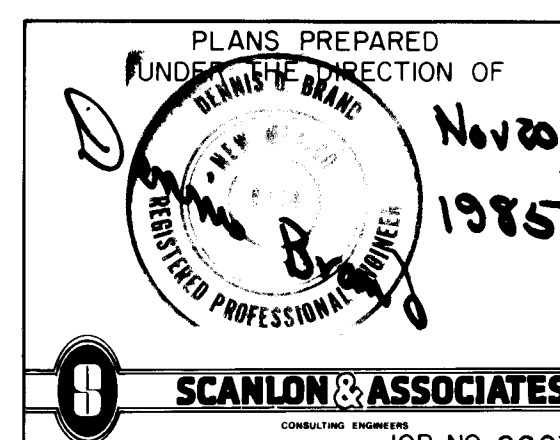

CONSULTING ENGINEERS
JOB NO. 80034


**APPROVED FOR
CONSTRUCTION**

CITY ENGINEER

CITY OF ALBUQUERQUE					
MUNICIPAL DEVELOPMENT DEPARTMENT					
TITLE: SPECIAL ASSESSMENT DISTRICT NO. 197 KIVA STREET — WATER & SEWER					
APPROVALS	ENGINEER	DATE	APPROVALS	ENGINEER	DATE
City Engineer	<i>Handwritten Signature</i>	11/21/02	Liquid Waste	<i>Handwritten Signature</i>	11-20-02
A.C.E. - Design	<i>Handwritten Signature</i>		Traffic	<i>Handwritten Signature</i>	11-20-02
A.C.E. - Hydrology			Water	<i>Handwritten Signature</i>	11-20-02
DRAWING NO. 1635		MAP NO. E-11		SHEET 21 OF 35	

RECORD DRAWING


PROFILE		BY	DATE
SURVEYED			
PLOTTED			
GRADES CHECKED			
B. M.'S NOTED			
STRUCTURE NOTAT'NS CHKD			
NOTE BOOK			
NO.			

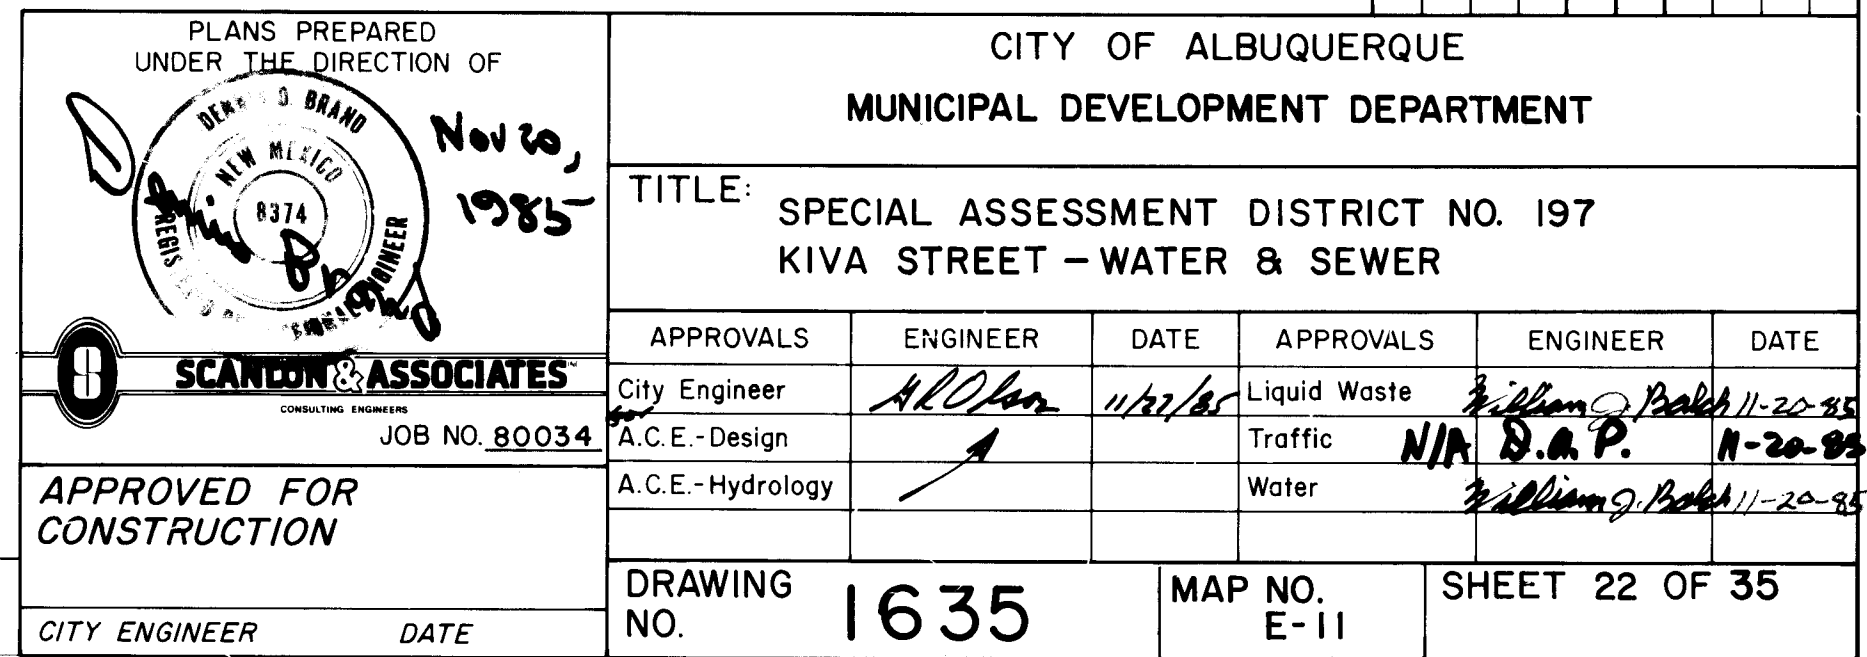[illegible]

RECORD DRAWING

PLAN	SURVEYED	BY	DATE
	PLOTTED		
	CHECKED		
	RT. OF WAY CHECKED		
NO.			

PROFILE	SURVEYED	BY	DATE
	PLOTTED		
	CHECKED		
	STRUCTURE NOTATIONS CHKD		
NO.			

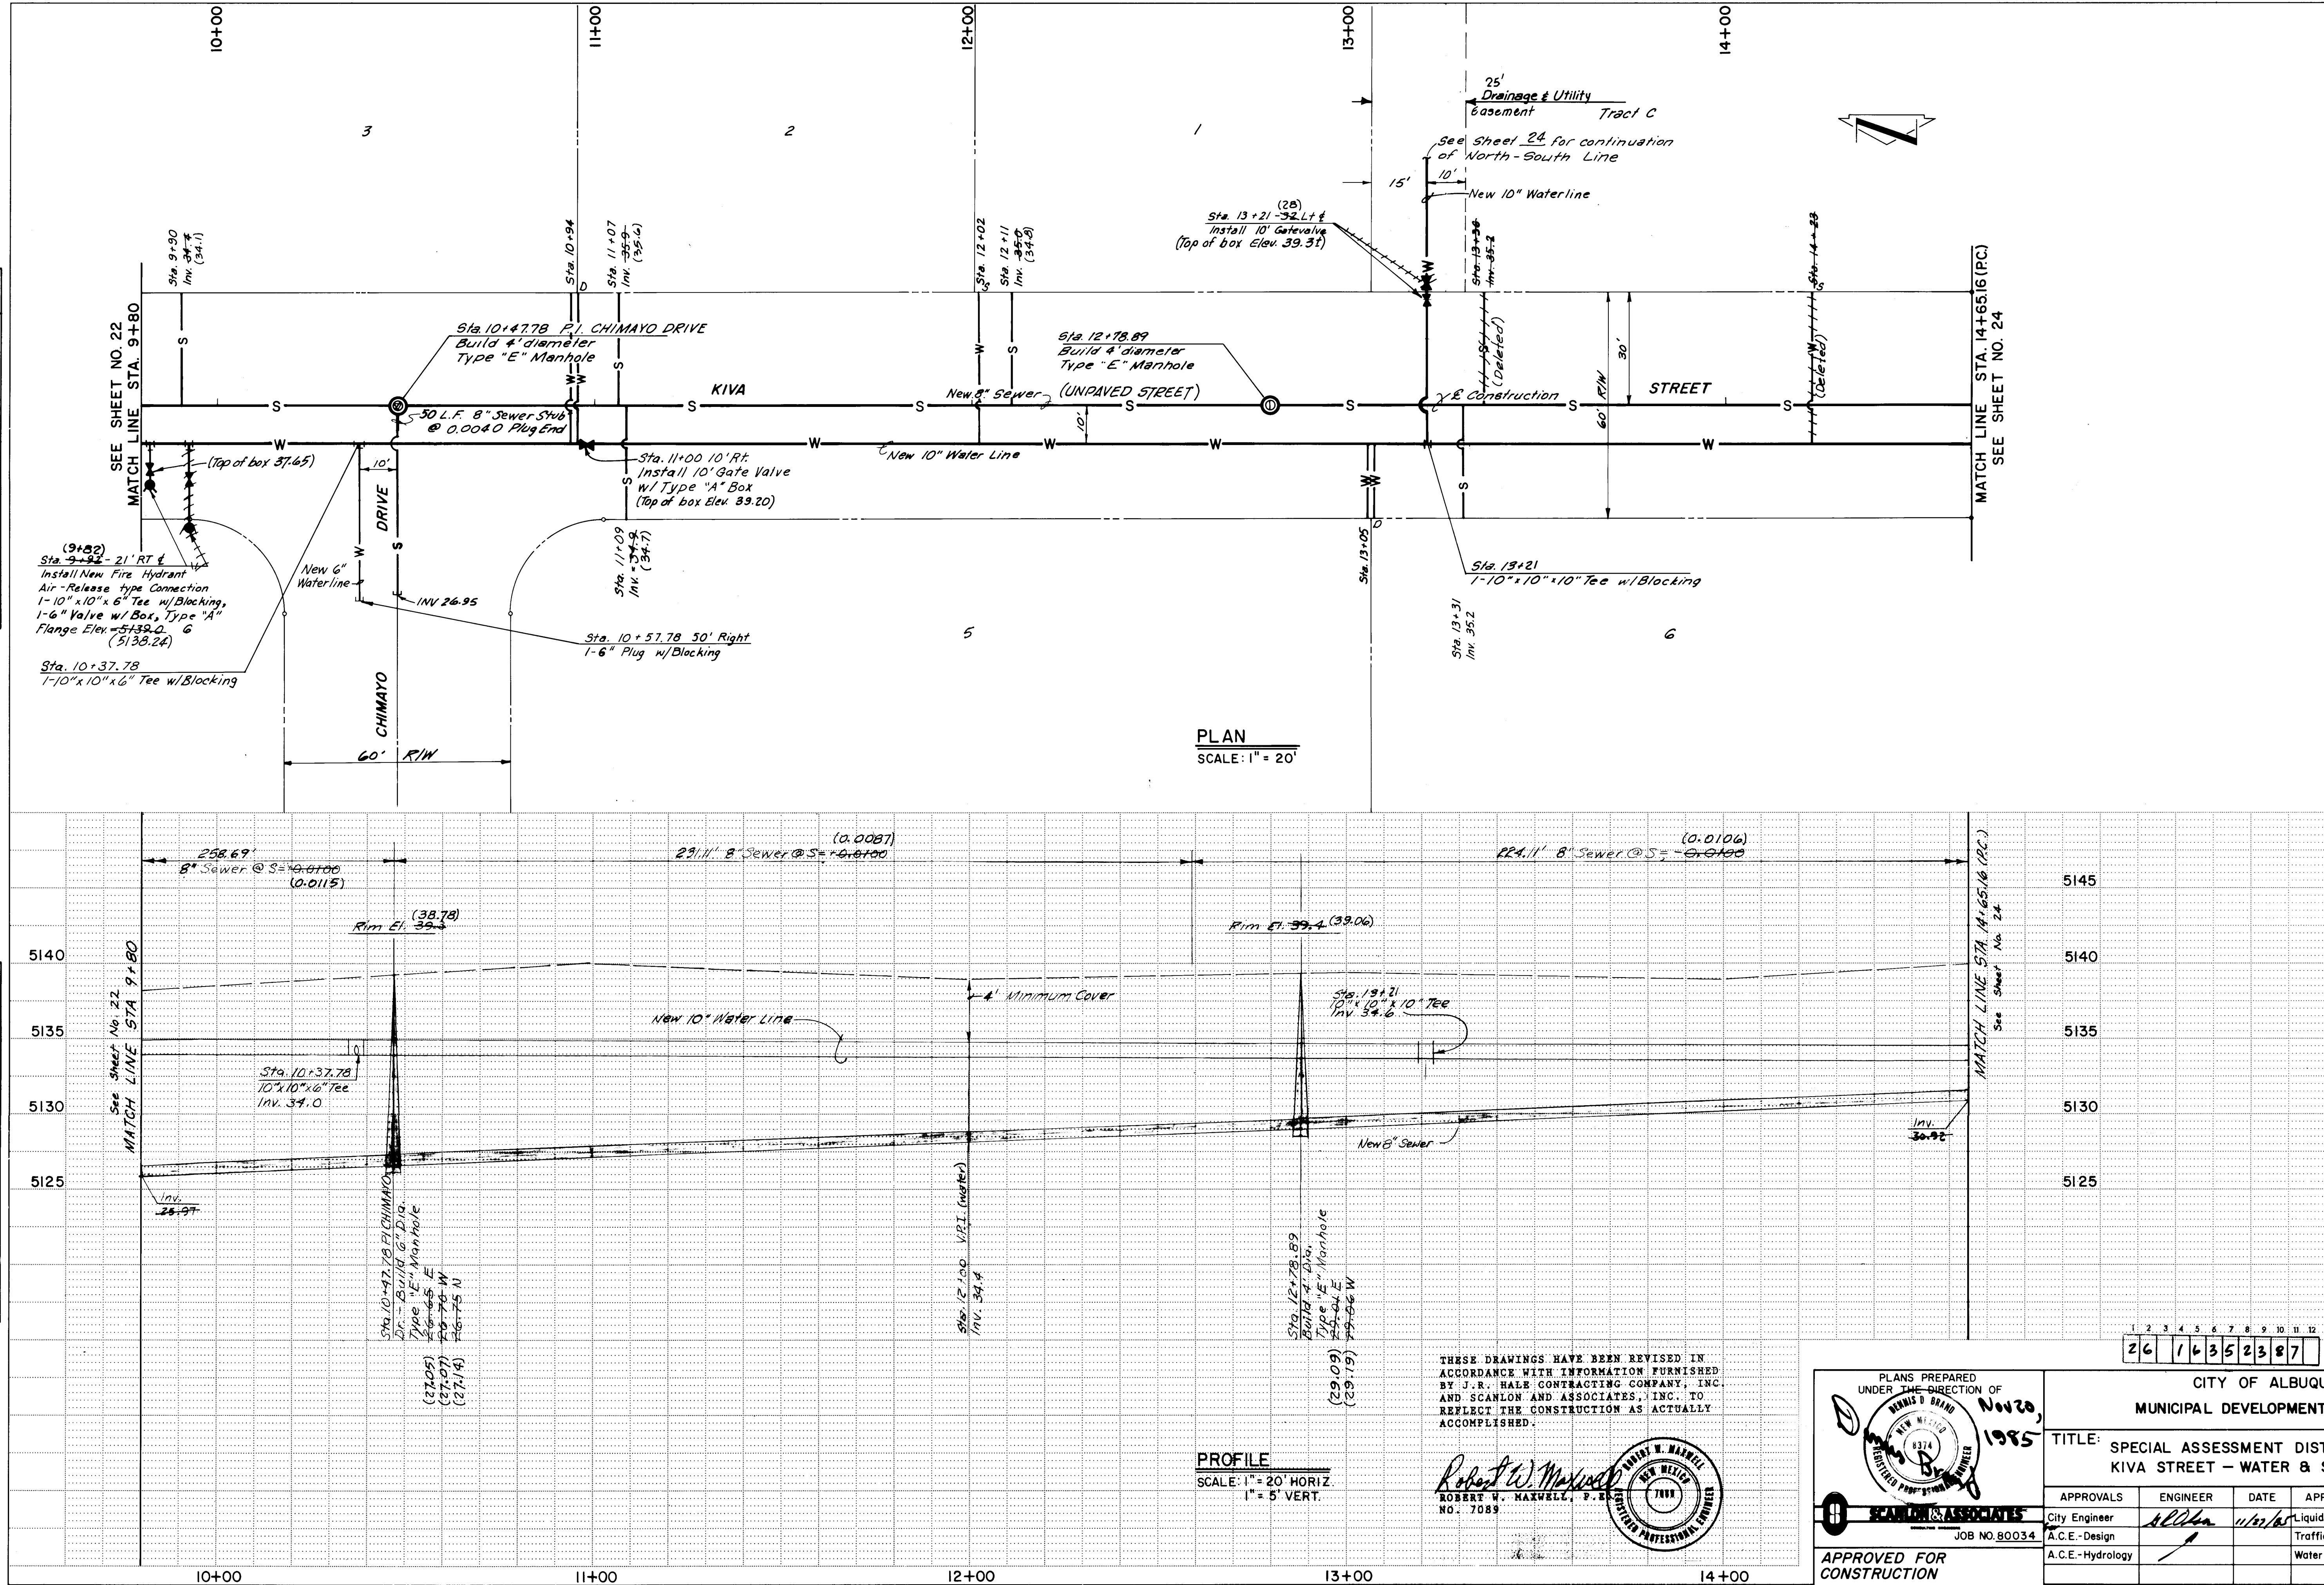



CITY OF ALBUQUERQUE MUNICIPAL DEVELOPMENT DEPARTMENT					
TITLE: SPECIAL ASSESSMENT DISTRICT NO. 197 KIVA STREET - WATER & SEWER					
APPROVALS	ENGINEER	DATE	APPROVALS	ENGINEER	DATE
City Engineer	11/27/85	11/27/85	Liquid Waste	William G. Babel	11-20-85
A.C.E.-Design			Traffic	N.A. D.P.	11-20-85
A.C.E.-Hydrology			Water	William G. Babel	11-20-85
DRAWING NO. 1635		MAP NO. E-11		SHEET 23 OF 35	

AS BUILT INFORMATION		BENCH MARKS		SURVEY INFORMATION		REFERENCES	
CONTRACTOR: J.R. Hale Co. Inc.		BM 14-E10-A 40 Perry Hill in Power Pole 180'		FIELD NOTES		MAP NO. E-11	
WORK: By Scanlon & Associates		North of junction Arroyo Road & Montano Road		BY		EST. NO.	
INSPECTION DATE: 11/28/85		West of Arroyo, Elev. 5145.930		NO.		W.O. NO.	
VERIFICATION BY: Scanlon & Associates		BM No. 7-E10 "C" Top of Curb North end N.E.		DATE		BY	
DATE: 11/28/85		Return Whitman & Cuesca		REVISIONS		REMARKS	
MICRO-FILM INFORMATION		Published Elev. = 5132.60		DESIGN		NO.	
RECORDED BY		DATE		DESIGNED BY		DATE	
NO.		DATE		DRAWN BY M.C.		DATE March '81	
				CHECKED BY		DATE	

RECORD DRAWING

PLAN	DATE	BY
SURVEYED		
NOTED		
PLOTTED		
NOTED		
RT. OF WAY CHECKED		
NO.		

PROFILE	DATE	BY
SURVEYED		
NOTED		
PLOTTED		
NOTED		
STRUCTURE NOTATIONS CHKD		
NO.		

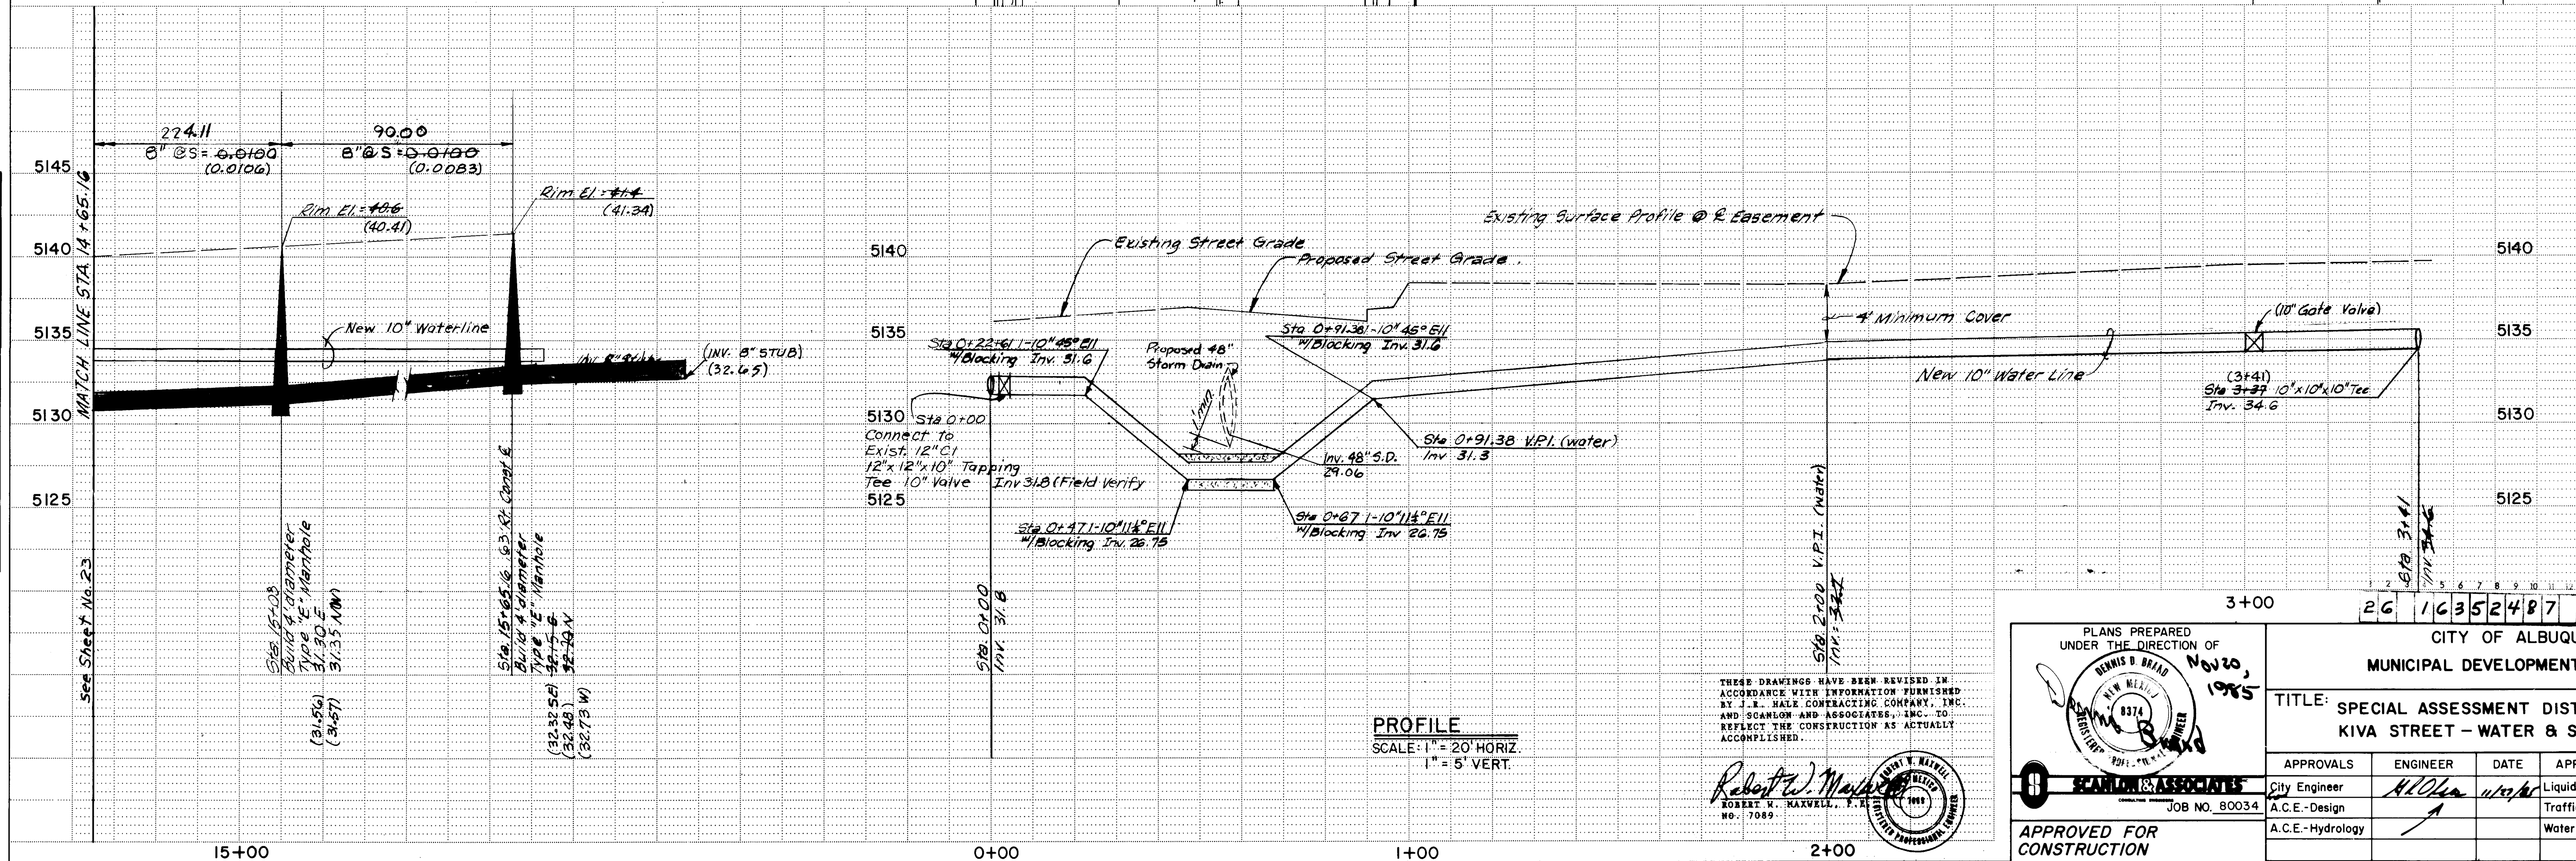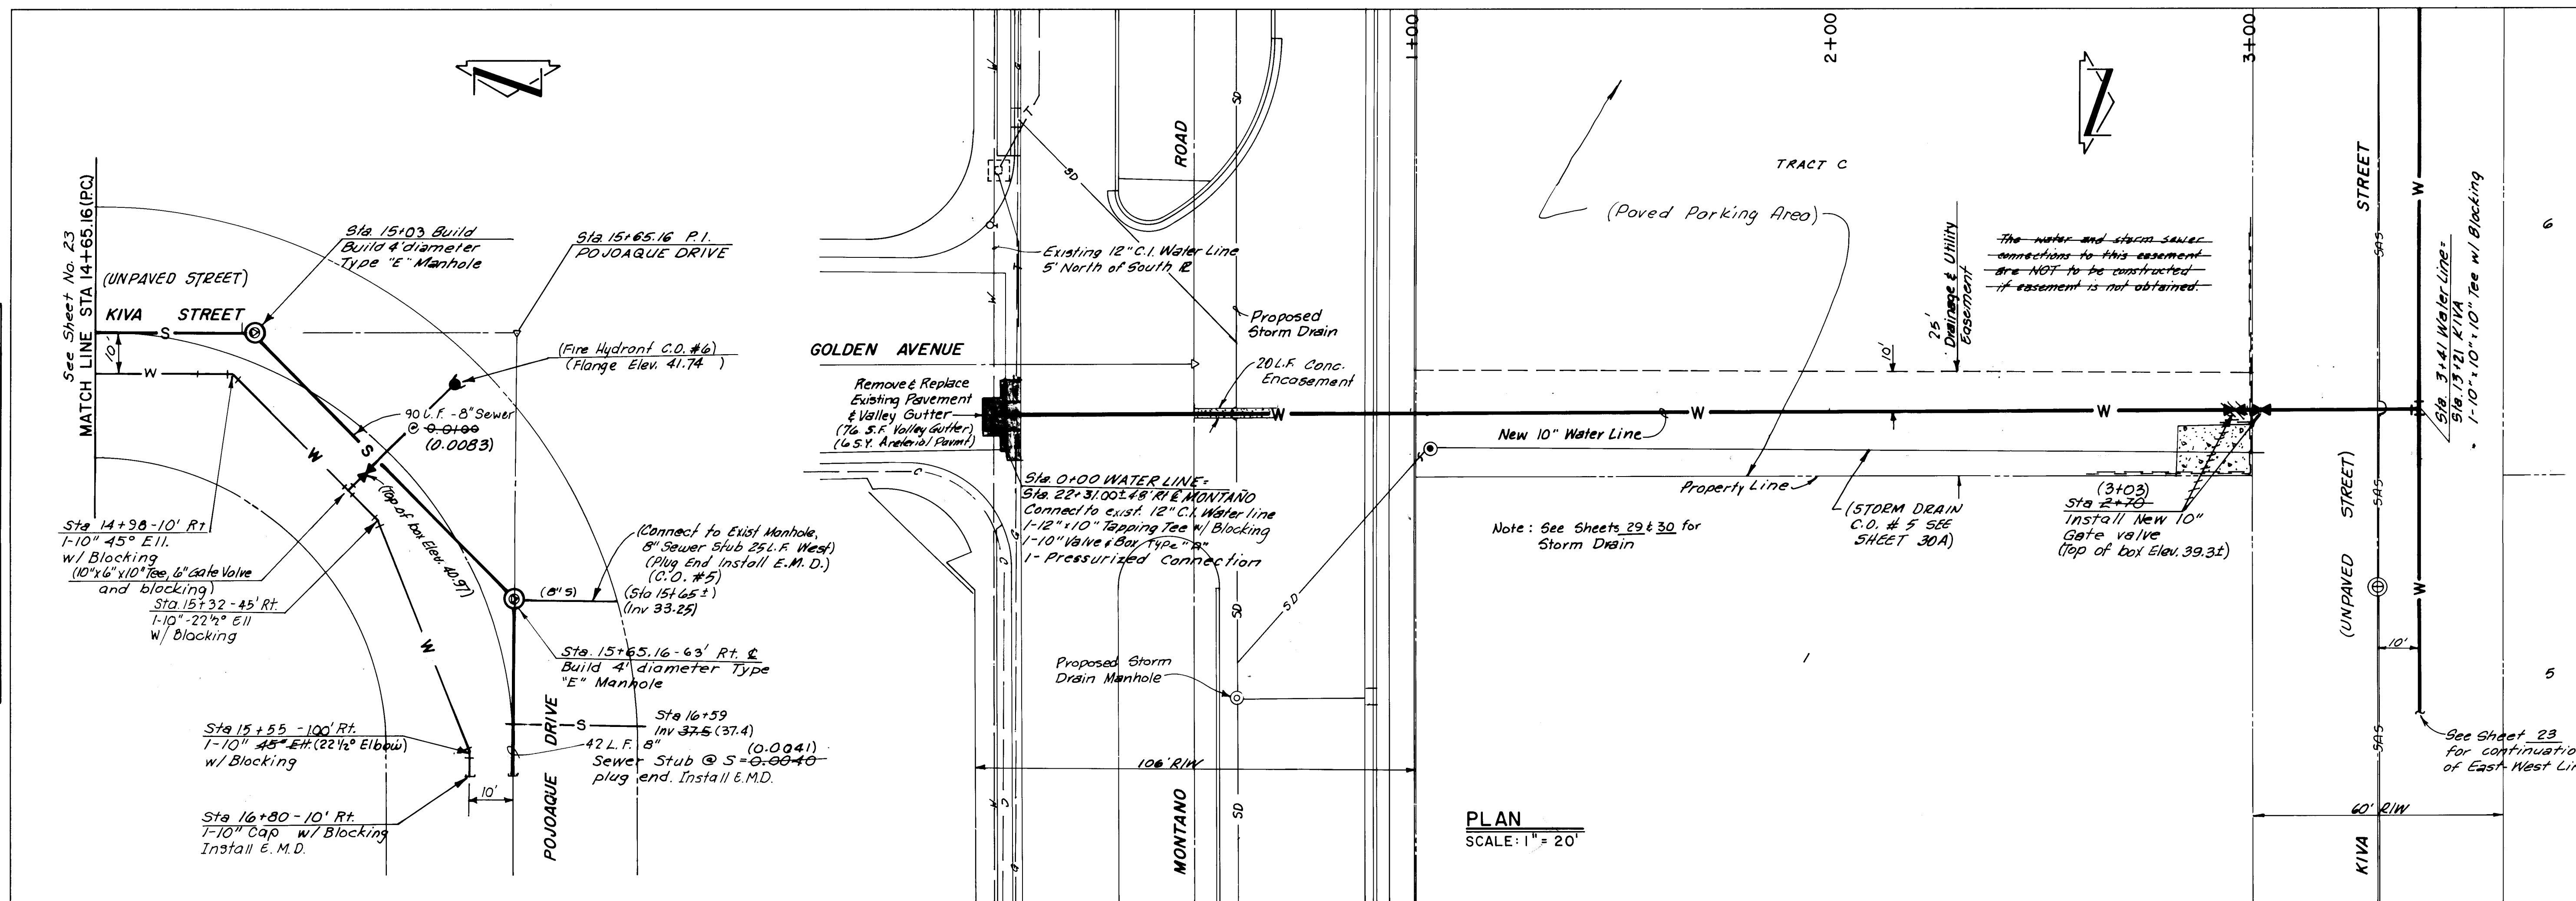

THESE DRAWINGS HAVE BEEN REVISED IN ACCORDANCE WITH INFORMATION FURNISHED BY J.E. HALE CONTRACTING COMPANY, INC. AND SCARLON AND ASSOCIATES, INC. TO REFLECT THE CONSTRUCTION AS ACTUALLY ACCOMPLISHED.


Robert W. Maxwell
ROBERT W. MAXWELL, P.E.
NO. 7089

PLANS PREPARED UNDER THE DIRECTION OF 			CITY OF ALBUQUERQUE MUNICIPAL DEVELOPMENT DEPARTMENT		
TITLE: SPECIAL ASSESSMENT DISTRICT NO. 197 KIVA STREET - WATER & SEWER					
APPROVALS	ENGINEER	DATE	APPROVALS	ENGINEER	DATE
City Engineer	A.D. HALE	11/20/85	Liquid Waste	William G. Bahr	11-20-85
A.C.E.-Design			Traffic	NIA	11-20-85
A.C.E.-Hydrology			Water	William G. Bahr	11-20-85
DRAWING NO. 1635		MAP NO. E-10 & 11		SHEET 24 OF 35	

SURVEY INFORMATION		BENCH MARKS		AS BUILT INFORMATION	
NO.	DATE	NO.	DATE	NO.	DATE
1	11/20/85	1	11/20/85	1	11/20/85
2		2		2	
3		3		3	
4		4		4	
100		100		100	

RECORD DRAWING

PROFILE	BY	DATE
SURVIVED		
PIOTTED		
GRADES CHECKED		
B M'S NOTED		

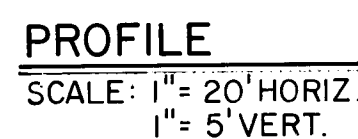



38+0C

PLANS PREPARED UNDER THE DIRECTION OF 		CITY OF ALBUQUERQUE MUNICIPAL DEVELOPMENT DEPARTMENT			
TITLE SPECIAL ASSESSMENT DISTRICT NO. 197 MONTANO ROAD - WATER & SEWER					
APPROVALS City Engineer A.C.E. Design A.C.E. Hydrology		ENGINEER <i>Alfonso</i>	DATE <i>11-20-85</i>	APPROVALS City Engineer Traffic Water	ENGINEER <i>William J. Beckley</i> <i>11-20-85</i> <i>11-20-85</i> <i>11-20-85</i>
DRAWING NO 1635		MAP NO E - 11		SHEET 25 OF 35	
CITY ENGINEER DATE					

RECORD DRAWING

PROFILE	SURVEYED	BY	DATE
	PLOTTED GRADES CHECKED B.M.'S NOTED STRUCTURE NOTATIONS CHECKED		
NOTE BOOK NO.			

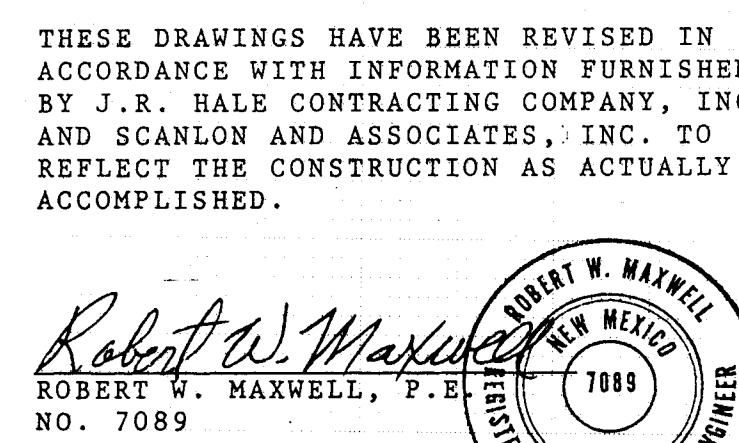


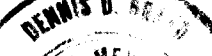PLANS PREPARED UNDER THE DIRECTION OF <i>1982</i>  <i>1982</i>	CITY OF ALBUQUERQUE MUNICIPAL DEVELOPMENT DEPARTMENT																				
0 SCANLON ASSOCIATES PROJ NO. <i>80034</i>	TITLE: SPECIAL ASSESSMENT DISTRICT NO. 197 MONTANO ROAD - WATER & SEWER																				
APPROVED FOR CONSTRUCTION	<table border="1"> <thead> <tr> <th>APPROVALS</th> <th>DATE</th> <th>APPROVALS</th> <th>ENGINEER</th> <th>DATE</th> </tr> </thead> <tbody> <tr> <td>City Engineer</td> <td><i>Alfonso</i></td> <td><i>Wicks</i></td> <td>Liquid Waste</td> <td><i>William G. Baker 11-20-</i></td> </tr> <tr> <td>A.C.E. Design</td> <td></td> <td></td> <td>Water</td> <td><i>NIA S.D.P. 1-20-</i></td> </tr> <tr> <td>A.C.E. Engineer</td> <td><i>Hydro</i></td> <td></td> <td>Traffic</td> <td><i>William G. Baker 11-20-</i></td> </tr> </tbody> </table>	APPROVALS	DATE	APPROVALS	ENGINEER	DATE	City Engineer	<i>Alfonso</i>	<i>Wicks</i>	Liquid Waste	<i>William G. Baker 11-20-</i>	A.C.E. Design			Water	<i>NIA S.D.P. 1-20-</i>	A.C.E. Engineer	<i>Hydro</i>		Traffic	<i>William G. Baker 11-20-</i>
APPROVALS	DATE	APPROVALS	ENGINEER	DATE																	
City Engineer	<i>Alfonso</i>	<i>Wicks</i>	Liquid Waste	<i>William G. Baker 11-20-</i>																	
A.C.E. Design			Water	<i>NIA S.D.P. 1-20-</i>																	
A.C.E. Engineer	<i>Hydro</i>		Traffic	<i>William G. Baker 11-20-</i>																	
CITY ENGINEER DATE	DRAWING NO. 1635 MAP NO. E - 11 SHEET 26 OF 35																				

RECORD DRAWING

PLAN	DATE
DESIGNED BY	
CHECKED BY	
IN CHARGE BY	
DATE	

PROFILE	DATE
DESIGNED BY	
CHECKED BY	
IN CHARGE BY	
DATE	

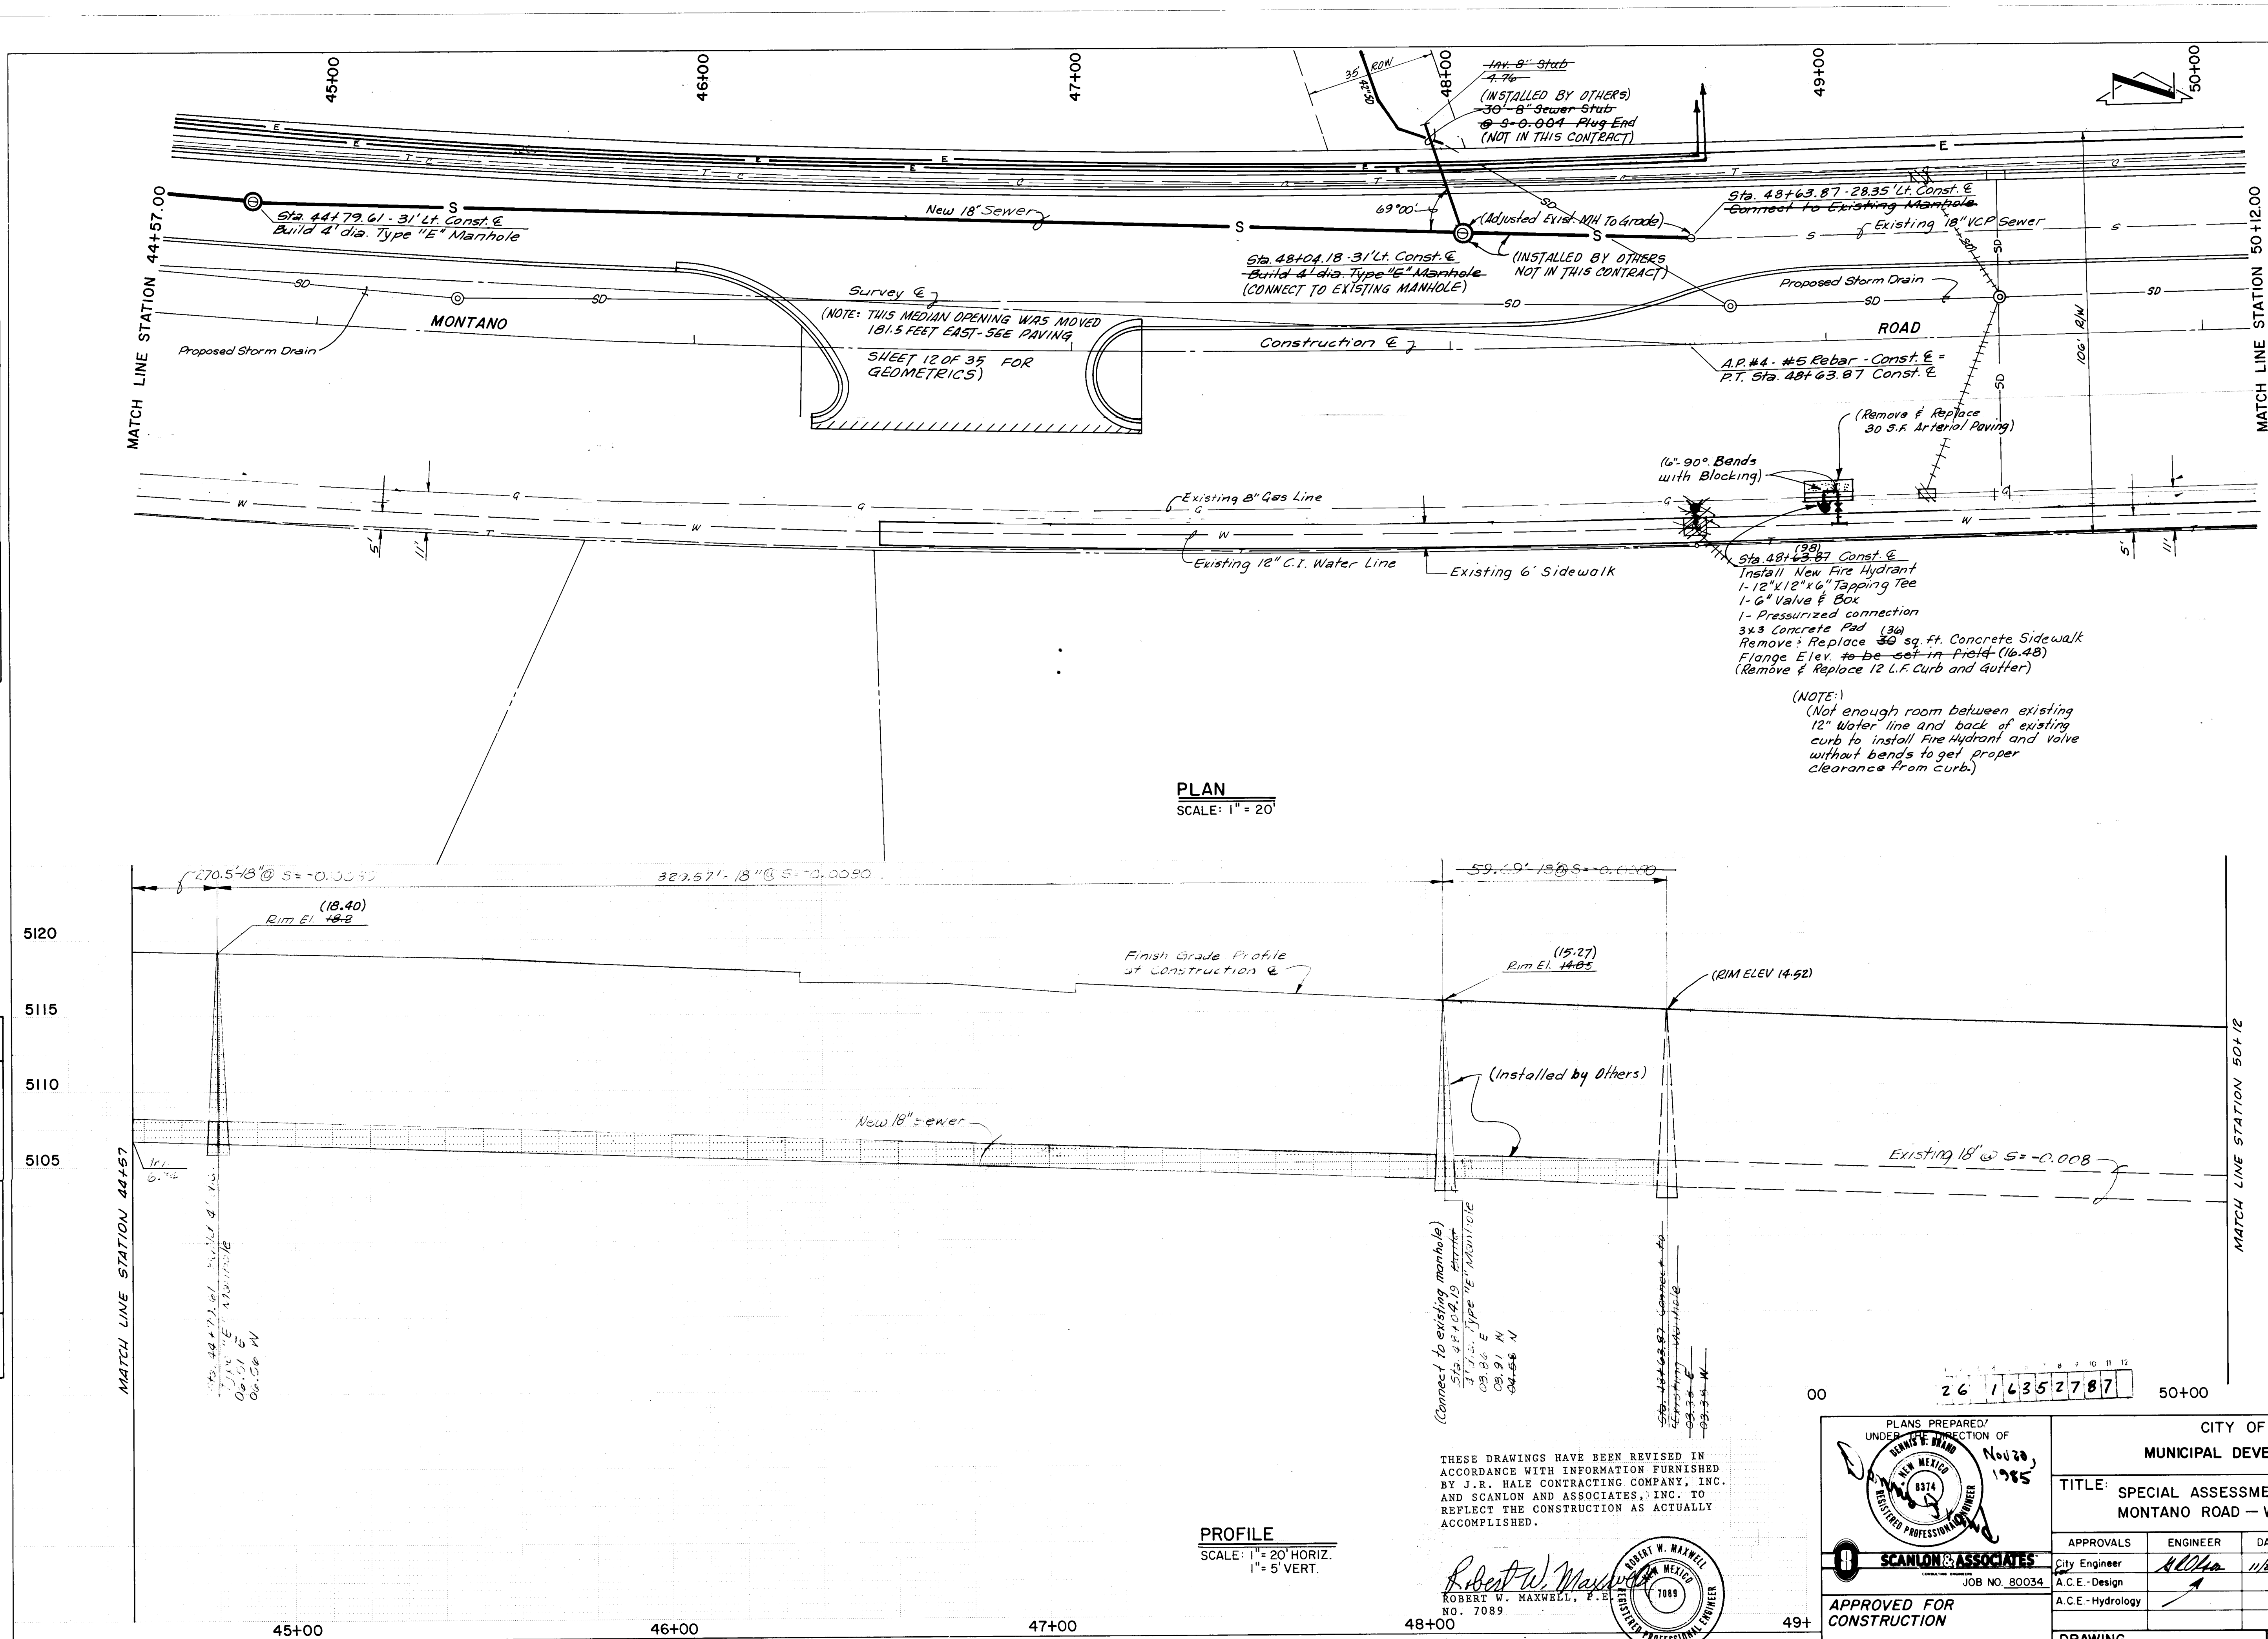


AS BUILT INFORMATION	BENCH MARKS	SURVEY INFORMATION	REFERENCES
CONTRACTOR: J.R. Hale Co. Inc. DRAWN BY: J.R. Hale CHECKED BY: J.R. Hale DATE: 11/20/98	B.M. 1-11 Brass cap 17' Con. east side Canada Viteri Published Elev. 5113.83	FIELD NOTES NO. BY DATE NO. BY DATE	MAP NO. E-11 EST. NO. W.O. NO.
MICRO-FILM INFORMATION		REVISIONS	
NO. BY DATE		NO. DATE	
DESIGNED BY		DATE	
CHECKED BY		DATE	

PLANS PREPARED UNDER SUPERVISION OF		CITY OF ALBUQUERQUE	
[Signature]		MUNICIPAL DEVELOPMENT DEPARTMENT	
TITLE: SPECIAL ASSESSMENT DISTRICT NO. 197		MONTANO ROAD - WATER & SEWER	
APPROVALS	ENGINEER	DATE	APPROVALS
City Engineer	[Signature]	11/20/98	Liquid Waste
A.C.E. - Design	[Signature]		Traffic
A.C.E. - Hydrology	[Signature]		Water
DRAWING NO. 1635	MAP NO. E-11	SHEET 27 OF 35	

RECORD DRAWING

PLAN	DATE	BY
DESIGNED		
CHECKED		
IN CHARGE		
DATE		

PROFILE	DATE	BY
DESIGNED		
CHECKED		
IN CHARGE		
DATE		

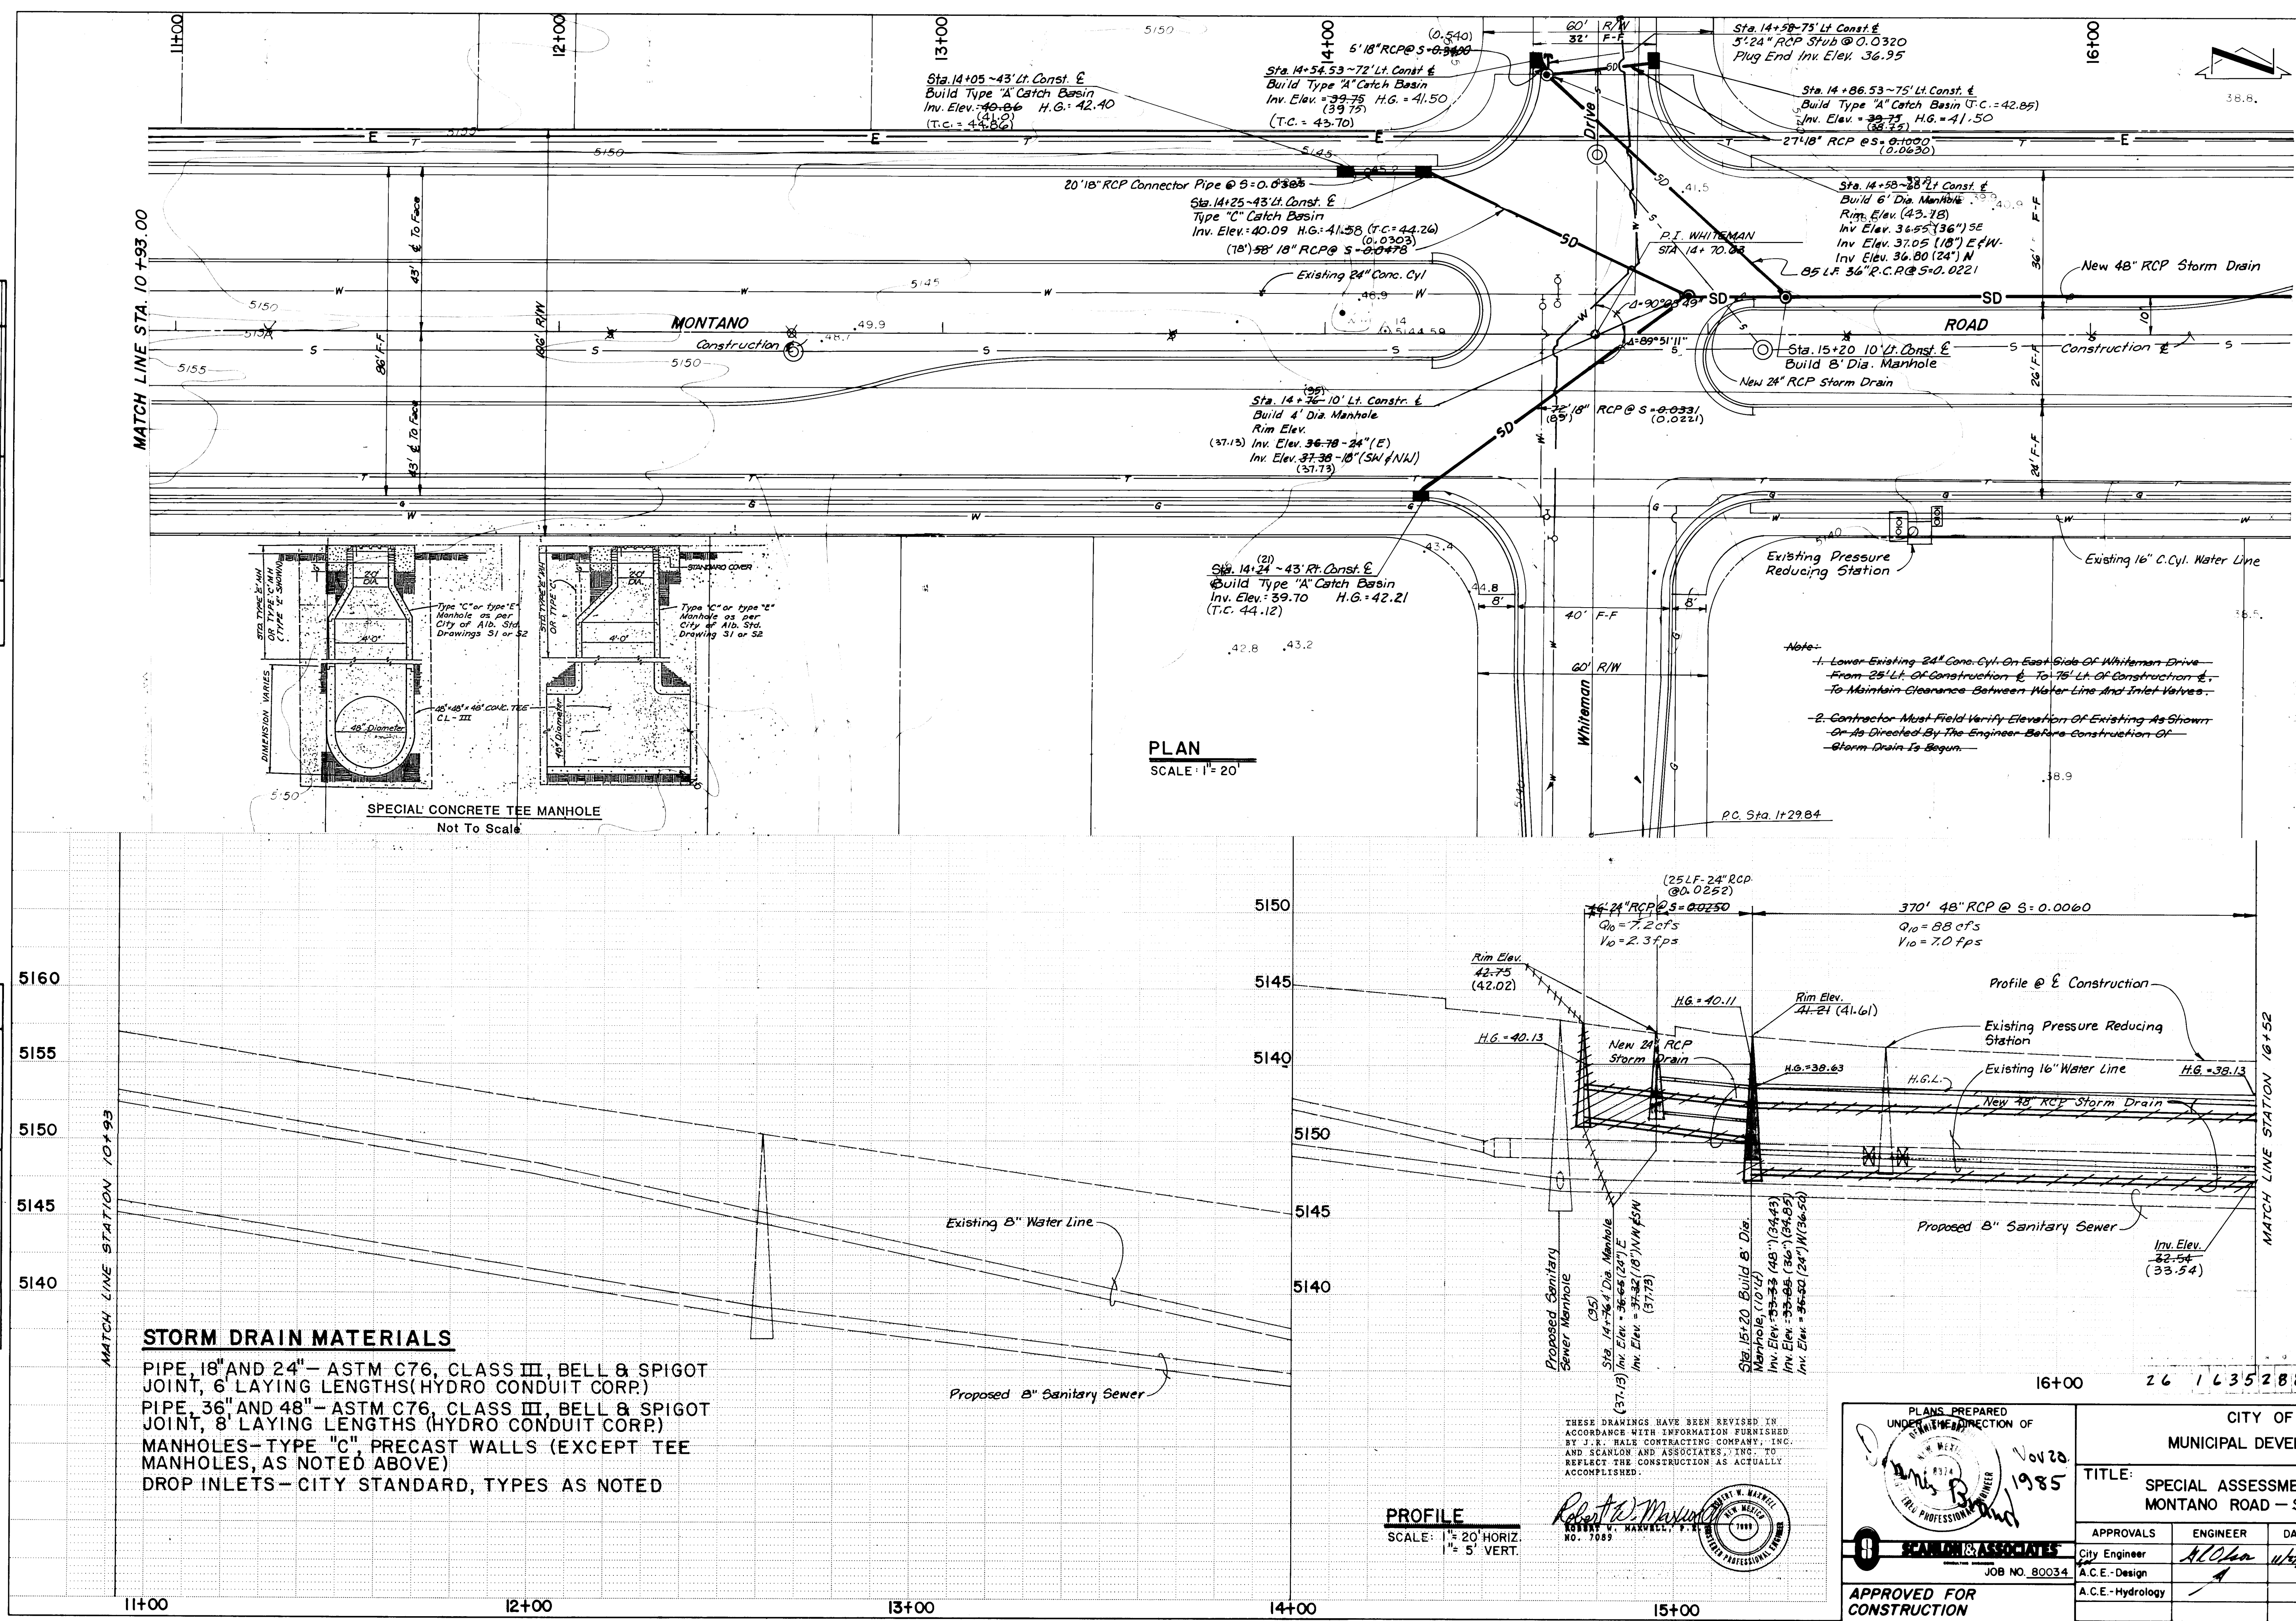


AS BUILT INFORMATION CONTRACTOR: J.E. Hulse Co. Inc. DATE: 11-20-85 BY: J.E. Hulse CHECKED: J.E. Hulse IN CHARGE: J.E. Hulse	
BENCH MARKS B.M. 14 - EIO - A B.M. 15 - EIO - B B.M. 16 - EIO - C B.M. 17 - EIO - D B.M. 18 - EIO - E B.M. 19 - EIO - F B.M. 20 - EIO - G B.M. 21 - EIO - H B.M. 22 - EIO - I B.M. 23 - EIO - J B.M. 24 - EIO - K B.M. 25 - EIO - L B.M. 26 - EIO - M B.M. 27 - EIO - N B.M. 28 - EIO - O B.M. 29 - EIO - P B.M. 30 - EIO - Q B.M. 31 - EIO - R B.M. 32 - EIO - S B.M. 33 - EIO - T B.M. 34 - EIO - U B.M. 35 - EIO - V B.M. 36 - EIO - W B.M. 37 - EIO - X B.M. 38 - EIO - Y B.M. 39 - EIO - Z B.M. 40 - EIO - AA B.M. 41 - EIO - AB B.M. 42 - EIO - AC B.M. 43 - EIO - AD B.M. 44 - EIO - AE B.M. 45 - EIO - AF B.M. 46 - EIO - AG B.M. 47 - EIO - AH B.M. 48 - EIO - AI B.M. 49 - EIO - AJ B.M. 50 - EIO - AK B.M. 51 - EIO - AL B.M. 52 - EIO - AM B.M. 53 - EIO - AN B.M. 54 - EIO - AO B.M. 55 - EIO - AP B.M. 56 - EIO - AQ B.M. 57 - EIO - AR B.M. 58 - EIO - AS B.M. 59 - EIO - AT B.M. 60 - EIO - AU B.M. 61 - EIO - AV B.M. 62 - EIO - AW B.M. 63 - EIO - AX B.M. 64 - EIO - AY B.M. 65 - EIO - AZ B.M. 66 - EIO - BA B.M. 67 - EIO - BB B.M. 68 - EIO - BC B.M. 69 - EIO - BD B.M. 70 - EIO - BE B.M. 71 - EIO - BF B.M. 72 - EIO - BG B.M. 73 - EIO - BH B.M. 74 - EIO - BI B.M. 75 - EIO - BJ B.M. 76 - EIO - BK B.M. 77 - EIO - BL B.M. 78 - EIO - BM B.M. 79 - EIO - BN B.M. 80 - EIO - BO B.M. 81 - EIO - BP B.M. 82 - EIO - BQ B.M. 83 - EIO - BR B.M. 84 - EIO - BS B.M. 85 - EIO - BT B.M. 86 - EIO - BU B.M. 87 - EIO - BV B.M. 88 - EIO - BW B.M. 89 - EIO - BX B.M. 90 - EIO - BY B.M. 91 - EIO - BZ B.M. 92 - EIO - CA B.M. 93 - EIO - CB B.M. 94 - EIO - CC B.M. 95 - EIO - CD B.M. 96 - EIO - CE B.M. 97 - EIO - CF B.M. 98 - EIO - CG B.M. 99 - EIO - CH B.M. 100 - EIO - CI B.M. 101 - EIO - CJ B.M. 102 - EIO - CK B.M. 103 - EIO - CL B.M. 104 - EIO - CM B.M. 105 - EIO - CN B.M. 106 - EIO - CO B.M. 107 - EIO - CP B.M. 108 - EIO - CQ B.M. 109 - EIO - CR B.M. 110 - EIO - CS B.M. 111 - EIO - CT B.M. 112 - EIO - CU B.M. 113 - EIO - CV B.M. 114 - EIO - CW B.M. 115 - EIO - CX B.M. 116 - EIO - CY B.M. 117 - EIO - CZ B.M. 118 - EIO - DA B.M. 119 - EIO - DB B.M. 120 - EIO - DC B.M. 121 - EIO - DD B.M. 122 - EIO - DE B.M. 123 - EIO - DF B.M. 124 - EIO - DG B.M. 125 - EIO - DH B.M. 126 - EIO - DI B.M. 127 - EIO - DJ B.M. 128 - EIO - DK B.M. 129 - EIO - DL B.M. 130 - EIO - DM B.M. 131 - EIO - DN B.M. 132 - EIO - DO B.M. 133 - EIO - DP B.M. 134 - EIO - DQ B.M. 135 - EIO - DR B.M. 136 - EIO - DS B.M. 137 - EIO - DT B.M. 138 - EIO - DU B.M. 139 - EIO - DV B.M. 140 - EIO - DW B.M. 141 - EIO - DX B.M. 142 - EIO - DY B.M. 143 - EIO - DZ B.M. 144 - EIO - EA B.M. 145 - EIO - EB B.M. 146 - EIO - EC B.M. 147 - EIO - ED B.M. 148 - EIO - EE B.M. 149 - EIO - EF B.M. 150 - EIO - EG B.M. 151 - EIO - EH B.M. 152 - EIO - EI B.M. 153 - EIO - EJ B.M. 154 - EIO - EK B.M. 155 - EIO - EL B.M. 156 - EIO - EM B.M. 157 - EIO - EN B.M. 158 - EIO - EO B.M. 159 - EIO - EP B.M. 160 - EIO - EQ B.M. 161 - EIO - ER B.M. 162 - EIO - ES B.M. 163 - EIO - ET B.M. 164 - EIO - EU B.M. 165 - EIO - EV B.M. 166 - EIO - EW B.M. 167 - EIO - EX B.M. 168 - EIO - EY B.M. 169 - EIO - EZ B.M. 170 - EIO - FA B.M. 171 - EIO - FB B.M. 172 - EIO - FC B.M. 173 - EIO - FD B.M. 174 - EIO - FE B.M. 175 - EIO - FF B.M. 176 - EIO - FG B.M. 177 - EIO - FH B.M. 178 - EIO - FI B.M. 179 - EIO - FJ B.M. 180 - EIO - FK B.M. 181 - EIO - FL B.M. 182 - EIO - FM B.M. 183 - EIO - FN B.M. 184 - EIO - FO B.M. 185 - EIO - FP B.M. 186 - EIO - FQ B.M. 187 - EIO - FR B.M. 188 - EIO - FS B.M. 189 - EIO - FT B.M. 190 - EIO - FU B.M. 191 - EIO - FV B.M. 192 - EIO - FW B.M. 193 - EIO - FX B.M. 194 - EIO - FY B.M. 195 - EIO - FZ B.M. 196 - EIO - GA B.M. 197 - EIO - GB B.M. 198 - EIO - GC B.M. 199 - EIO - GD B.M. 200 - EIO - GE B.M. 201 - EIO - GF B.M. 202 - EIO - GG B.M. 203 - EIO - GH B.M. 204 - EIO - GI B.M. 205 - EIO - GJ B.M. 206 - EIO - GK B.M. 207 - EIO - GL B.M. 208 - EIO - GM B.M. 209 - EIO - GN B.M. 210 - EIO - GO B.M. 211 - EIO - GP B.M. 212 - EIO - GQ B.M. 213 - EIO - GR B.M. 214 - EIO - GS B.M. 215 - EIO - GT B.M. 216 - EIO - GU B.M. 217 - EIO - GV B.M. 218 - EIO - GW B.M. 219 - EIO - GX B.M. 220 - EIO - GY B.M. 221 - EIO - GZ B.M. 222 - EIO - HA B.M. 223 - EIO - HB B.M. 224 - EIO - HC B.M. 225 - EIO - HD B.M. 226 - EIO - HE B.M. 227 - EIO - HF B.M. 228 - EIO - HG B.M. 229 - EIO - HH B.M. 230 - EIO - HI B.M. 231 - EIO - HJ B.M. 232 - EIO - HK B.M. 233 - EIO - HL B.M. 234 - EIO - HM B.M. 235 - EIO - HN B.M. 236 - EIO - HO B.M. 237 - EIO - HP B.M. 238 - EIO - HQ B.M. 239 - EIO - HR B.M. 240 - EIO - HS B.M. 241 - EIO - HT B.M. 242 - EIO - HU B.M. 243 - EIO - HV B.M. 244 - EIO - HW B.M. 245 - EIO - HX B.M. 246 - EIO - HY B.M. 247 - EIO - HZ B.M. 248 - EIO - IA B.M. 249 - EIO - IB B.M. 250 - EIO - IC B.M. 251 - EIO - ID B.M. 252 - EIO - IE B.M. 253 - EIO - IF B.M. 254 - EIO - IG B.M. 255 - EIO - IH B.M. 256 - EIO - II B.M. 257 - EIO - IJ B.M. 258 - EIO - IK B.M. 259 - EIO - IL B.M. 260 - EIO - IM B.M. 261 - EIO - IN B.M. 262 - EIO - IO B.M. 263 - EIO - IP B.M. 264 - EIO - IQ B.M. 265 - EIO - IR B.M. 266 - EIO - IS B.M. 267 - EIO - IT B.M. 268 - EIO - IU B.M. 269 - EIO - IV B.M. 270 - EIO - IW B.M. 271 - EIO - IX B.M. 272 - EIO - IY B.M. 273 - EIO - IZ B.M. 274 - EIO - JA B.M. 275 - EIO - JB B.M. 276 - EIO - JC B.M. 277 - EIO - JD B.M. 278 - EIO - JE B.M. 279 - EIO - JF B.M. 280 - EIO - JG B.M. 281 - EIO - JH B.M. 282 - EIO - JI B.M. 283 - EIO - JJ B.M. 284 - EIO - JK B.M. 285 - EIO - JL B.M. 286 - EIO - JM B.M. 287 - EIO - JN B.M. 288 - EIO - JO B.M. 289 - EIO - JP B.M. 290 - EIO - JQ B.M. 291 - EIO - JR B.M. 292 - EIO - JS B.M. 293 - EIO - JT B.M. 294 - EIO - JU B.M. 295 - EIO - JV B.M. 296 - EIO - JW B.M. 297 - EIO - JX B.M. 298 - EIO - JY B.M. 299 - EIO - JZ B.M. 300 - EIO - KA B.M. 301 - EIO - KB B.M. 302 - EIO - KC B.M. 303 - EIO - KD B.M. 304 - EIO - KE B.M. 305 - EIO - KF B.M. 306 - EIO - KG B.M. 307 - EIO - KH B.M. 308 - EIO - KI B.M. 309 - EIO - KJ B.M. 310 - EIO - KK B.M. 311 - EIO - KL B.M. 312 - EIO - KM B.M. 313 - EIO - KN B.M. 314 - EIO - KO B.M. 315 - EIO - KP B.M. 316 - EIO - KQ B.M. 317 - EIO - KR B.M. 318 - EIO - KS B.M. 319 - EIO - KT B.M. 320 - EIO - KU B.M. 321 - EIO - KV B.M. 322 - EIO - KW B.M. 323 - EIO - KX B.M. 324 - EIO - KY B.M. 325 - EIO - KZ B.M. 326 - EIO - LA B.M. 327 - EIO - LB B.M. 328 - EIO - LC B.M. 329 - EIO - LD B.M. 330 - EIO - LE B.M. 331 - EIO - LF B.M. 332 - EIO - LG B.M. 333 - EIO - LH B.M. 334 - EIO - LI B.M. 335 - EIO - LJ B.M. 336 - EIO - LK B.M. 337 - EIO - LL B.M. 338 - EIO - LM B.M. 339 - EIO - LN B.M. 340 - EIO - LO B.M. 341 - EIO - LP B.M. 342 - EIO - LQ B.M. 343 - EIO - LR B.M. 344 - EIO - LS B.M. 345 - EIO - LT B.M. 346 - EIO - LU B.M. 347 - EIO - LV B.M. 348 - EIO - LW B.M. 349 - EIO - LX B.M. 350 - EIO - LY B.M. 351 - EIO - LZ B.M. 352 - EIO - MA B.M. 353 - EIO - MB B.M. 354 - EIO - MC B.M. 355 - EIO - MD B.M. 356 - EIO - ME B.M. 357 - EIO - MF B.M. 358 - EIO - MG B.M. 359 - EIO - MH B.M. 360 - EIO - MI B.M. 361 - EIO - MJ B.M. 362 - EIO - MK B.M. 363 - EIO - ML B.M. 364 - EIO - MM B.M. 365 - EIO - MN B.M. 366 - EIO - MO B.M. 367 - EIO - MP B.M. 368 - EIO - MQ B.M. 369 - EIO - MR B.M. 370 - EIO - MS B.M. 371 - EIO - MT B.M. 372 - EIO - MU B.M. 373 - EIO - MV B.M. 374 - EIO - MW B.M. 375 - EIO - MX B.M. 376 - EIO - MY B.M. 377 - EIO - MZ B.M. 378 - EIO - NA B.M. 379 - EIO - NB B.M. 380 - EIO - NC B.M. 381 - EIO - ND B.M. 382 - EIO - NE B.M. 383 - EIO - NF B.M. 384 - EIO - NG B.M. 385 - EIO - NH B.M. 386 - EIO - NI B.M. 387 - EIO - NJ B.M. 388 - EIO - NK B.M. 389 - EIO - NL B.M. 390 - EIO - NM B.M. 391 - EIO - NO B.M. 392 - EIO - NP B.M. 393 - EIO - NQ B.M. 394 - EIO - NR B.M. 395 - EIO - NS B.M. 396 - EIO - NT B.M. 397 - EIO - NU B.M. 398 - EIO - NV B.M. 399 - EIO - NW B.M. 400 - EIO - NX B.M. 401 - EIO - NY B.M. 402 - EIO - NZ B.M. 403 - EIO - OA B.M. 404 - EIO - OB B.M. 405 - EIO - OC B.M. 406 - EIO - OD B.M. 407 - EIO - OE B.M. 408 - EIO - OF B.M. 409 - EIO - OG B.M. 410 - EIO - OH B.M. 411 - EIO - OI B.M. 412 - EIO - OJ B.M. 413 - EIO - OK B.M. 414 - EIO - OL B.M. 415 - EIO - OM B.M. 416 - EIO - ON B.M. 417 - EIO - OO B.M. 418 - EIO - OP B.M. 419 - EIO - OQ B.M. 420 - EIO - OR B.M. 421 - EIO - OS B.M. 422 - EIO - OT B.M. 423 - EIO - OU B.M. 424 - EIO - OV B.M. 425 - EIO - OW B.M. 426 - EIO - OX B.M. 427 - EIO - OY B.M. 428 - EIO - OZ B.M. 429 - EIO - PA B.M. 430 - EIO - PB B.M. 431 - EIO - PC B.M. 432 - EIO - PD B.M. 433 - EIO - PE B.M. 434 - EIO - PF B.M. 435 - EIO - PG B.M. 436 - EIO - PH B.M. 437 - EIO - PI B.M. 438 - EIO - PJ B.M. 439 - EIO - PK B.M. 440 - EIO - PL B.M. 441 - EIO - PM B.M. 442 - EIO - PN B.M. 443 - EIO - PO B.M. 444 - EIO - PP B.M. 445 - EIO - PQ B.M. 446 - EIO - PR B.M. 447 - EIO - PS B.M. 448 - EIO - PT B.M. 449 - EIO - PU B.M. 450 - EIO - PV B.M. 451 - EIO - PW B.M. 452 - EIO - PX B.M. 453 - EIO - PY B.M. 454 - EIO - PZ B.M. 455 - EIO - QA B.M. 456 - EIO - QB B.M. 457 - EIO - QC B.M. 458 - EIO - QD B.M. 459 - EIO - QE B.M. 460 - EIO - QF B.M. 461 - EIO - QG B.M. 462 - EIO - QH B.M. 463 - EIO - QI B.M. 464 - EIO - QJ B.M. 465 - EIO - QK B.M. 466 - EIO - QL B.M. 467 - EIO - QM B.M. 468 - EIO - QN B.M. 469 - EIO - QO B.M. 470 - EIO - QP B.M. 471 - EIO - QQ B.M. 472 - EIO - QR B.M. 473 - EIO - QS B.M. 474 - EIO - QT B.M. 475 - EIO - QU B.M. 476 - EIO - QV B.M. 477 - EIO - QW B.M. 478 - EIO - QX B.M. 479 - EIO - QY B.M. 480 - EIO - QZ B.M. 481 - EIO - RA B.M. 482 - EIO - RB B.M. 483 - EIO - RC B.M. 484 - EIO - RD B.M. 485 - EIO - RE B.M. 486 - EIO - RF B.M. 487 - EIO - RG B.M. 488 - EIO - RH B.M. 489 - EIO - RI B.M. 490 - EIO - RJ B.M. 491 - EIO - RK B.M. 492 - EIO - RL B.M. 493 - EIO - RM B.M. 494 - EIO - RN B.M. 495 - EIO - RO B.M. 496 - EIO - RP B.M. 497 - EIO - RQ B.M. 498 - EIO - RR B.M. 499 - EIO - RS B.M. 500 - EIO - RT B.M. 501 - EIO - RU B.M. 502 - EIO - RV B.M. 503 - EIO - RW B.M. 504 - EIO - RX B.M. 505 - EIO - RY B.M. 506 - EIO - RZ B.M. 507 - EIO - SA B.M. 508 - EIO - SB B.M. 509 - EIO - SC B.M. 510 - EIO - SD B.M. 511 - EIO - SE B.M. 512 - EIO - SF B.M. 513 - EIO - SG B.M. 514 - EIO - SH B.M. 515 - EIO - SI B.M. 516 - EIO - SJ B.M. 517 - EIO - SK B.M. 518 - EIO - SL B.M. 519 - EIO - SM B.M. 520 - EIO - SN B.M. 521 - EIO - SO B.M. 522 - EIO - SP B.M. 523 - EIO - SQ B.M. 524 - EIO - SR B.M. 525 - EIO - SS B.M. 526 - EIO - ST B.M. 527 - EIO - SU B.M. 528 - EIO - SV B.M. 529 - EIO - SW B.M. 530 - EIO - SX B.M. 531 - EIO - SY B.M. 532 - EIO - SZ B.M. 533 - EIO - TA B.M. 534 - EIO - TB B.M. 535 - EIO - TC B.M. 536 - EIO - TD B.M. 537 - EIO - TE B.M. 538 - EIO - TF B.M. 539 - EIO - TG B.M. 540 - EIO - TH B.M. 541 - EIO - TI B.M. 542 - EIO - TJ B.M. 543 - EIO - TK B.M. 544 - EIO - TL B.M. 545 - EIO - TM B.M. 546 - EIO - TN B.M. 547 - EIO - TO B.M. 548 - EIO - TP B.M. 549 - EIO - TQ B.M. 550 - EIO - TR B.M. 551 - EIO - TS B.M. 552 - EIO - TT B.M. 553 - EIO - TU B.M. 554 - EIO - TV B.M. 555 - EIO - TW B.M. 556 - EIO - TX B.M. 557 - EIO - TY B.M. 558 - EIO - TZ B.M. 559 - EIO - UA B.M. 560 - EIO - UB B.M. 561 - EIO - UC B.M. 562 - EIO - UD B.M. 563 - EIO - UE B.M. 564 - EIO - UF B.M. 565 - EIO - UG B.M. 566 - EIO - UH B.M. 567 - EIO - UI B.M. 568 - EIO - UJ B.M. 569 - EIO - UK B.M. 570 - EIO - UL B.M. 571 - EIO - UM B.M. 572 - EIO - UN B.M. 573 - EIO - UO B.M. 574 - EIO - UP B.M. 575 - EIO - UQ B.M. 576 - EIO - UR B.M. 577 - EIO - US B.M. 578 - EIO - UT B.M. 579 - EIO - UY B.M. 580 - EIO - UZ B.M. 581 - EIO - VA B.M. 582 - EIO - VB B.M. 583 - EIO - VC B.M. 584 - EIO - VD B.M. 585 - EIO - VE B.M. 586 - EIO - VF B.M. 587 - EIO - VG B.M. 588 - EIO - VH B.M. 589 - EIO - VI B.M. 590 - EIO - VJ B.M. 591 - EIO - VK B.M. 592 - EIO - VL B.M. 593 - EIO - VM B.M. 594 - EIO - VN B.M. 595 - EIO - VO B.M. 596 - EIO - VP B.M. 597 - EIO - VQ B.M. 598 - EIO - VR B.M. 599 - EIO - VS B.M. 600 - EIO - VT B.M. 601 - EIO - VU B.M. 602 - EIO - VV B.M. 603 - EIO - VW B.M. 604 - EIO - VX B.M. 605 - EIO - VY B.M. 606 - EIO - VZ B.M. 607 - EIO - WA B.M. 608 - EIO - WB B.M. 609 - EIO - WC B.M. 610 - EIO - WD B.M. 611 - EIO - WE B.M. 612 - EIO - WF B.M. 613 - EIO - WG B.M. 614 - EIO - WH B.M. 615 - EIO - WI B.M. 616 - EIO - WJ B.M. 617 - EIO - WK B.M. 618 - EIO - WL B.M. 619 - EIO - WM B.M. 620 - EIO - WN B.M. 621 - EIO - WO B.M. 622 - EIO - WP B.M. 623 - EIO - WQ B.M. 624 - EIO - WR B.M. 625 - EIO - WS B.M. 626 - EIO - WT B.M. 627 - EIO - WU B.M. 628 - EIO - WV B.M. 629 - EIO - WW B.M. 630 - EIO - WX B.M. 631 - EIO - WY B.M. 632 - EIO - WZ B.M. 633 - EIO - XA B.M. 634 - EIO - XB B.M. 635 - EIO - XC B.M. 636 - EIO - XD B.M. 637 - EIO - XE B.M. 638 - EIO - XF B.M. 639 - EIO - XG B.M. 640 - EIO - XH B.M. 641 - EIO - XI B.M. 642 - EIO - XJ B.M. 643 - EIO - XK B.M. 644 - EIO - XL B.M. 645 - EIO - XM B.M. 646 - EIO - XN B.M. 647 - EIO - XO B.M. 648 - EIO - XP B.M. 649 - EIO - XQ B.M. 650 - EIO - XR B.M. 651 - EIO - XS B.M. 652 - EIO - XT B.M. 653 - EIO - XU B.M. 654 - EIO - XV B.M. 655 - EIO - XW B.M. 656 - EIO - XX B.M. 657 - EIO - XY B.M. 658 - EIO - XZ B.M. 659 - EIO - YA B.M. 660 - EIO - YB B.M. 661 - EIO - YC B.M. 662 - EIO - YD B.M. 663 - EIO - YE B.M. 664 - EIO - YF B.M. 665 - EIO - YG B.M. 666 - EIO - YH B.M. 667 - EIO - YI B.M. 668 - EIO - YJ B.M. 669 - EIO - YK B.M. 670 - EIO - YL B.M. 671 - EIO - YM B.M. 672 - EIO - YN B.M. 673 - EIO - YO B.M. 674 - EIO - YP B.M. 675 - EIO - YQ B.M. 676 - EIO - YR B.M. 677 - EIO - YS B.M. 678 - EIO - YT B.M. 679 - EIO - YU B.M. 680 - EIO - YV B.M. 681 - EIO - YW B.M. 682 - EIO - YX B.M. 683 - EIO - YY B.M. 684 - EIO - YZ B.M. 685 - EIO - ZA B.M. 686 - EIO - ZB B.M. 687 - EIO - ZC B.M. 688 - EIO - ZD B.M. 689 - EIO - ZE B.M. 690 - EIO - ZF B.M. 691 - EIO - ZG B.M. 692 - EIO - ZH B.M. 693 - EIO - ZI B.M. 694 - EIO - ZJ B.M. 695 - EIO - ZK B.M. 696 - EIO - ZL B.M. 697 - EIO - ZM B.M. 698 - EIO - ZN B.M. 699 - EIO - ZO B.M. 700 - EIO - ZP B.M. 701 - EIO - ZQ B.M. 702 - EIO - ZR B.M. 703 - EIO - ZS B.M. 704 - EIO - ZT B.M. 705 - EIO - ZU B.M. 706 - EIO - ZV B.M. 707 - EIO - ZW B.M. 708 - EIO - ZX B.M. 709 - EIO - ZY B.M. 710 - EIO - ZZ	

PLANS PREPARED UNDER THE SUPERVISION OF J. E. Hulse 1985		CITY OF ALBUQUERQUE MUNICIPAL DEVELOPMENT DEPARTMENT TITLE: SPECIAL ASSESSMENT DISTRICT NO. 197 MONTANO ROAD - STORM DRAIN	
APPROVALS CITY ENGINEER A.C.E. - Design A.C.E. - Hydrology	ENGINEER DATE 11/20/85	APPROVALS LIQUID WASTE TRAFFIC WATER	ENGINEER DATE 11/20/85
APPROVED FOR CONSTRUCTION 			

PLAN	DATE	BY
DESIGNED		
CHECKED		
DATE		
BY		


PROFILE	DATE	BY
DESIGNED		
CHECKED		
DATE		
BY		

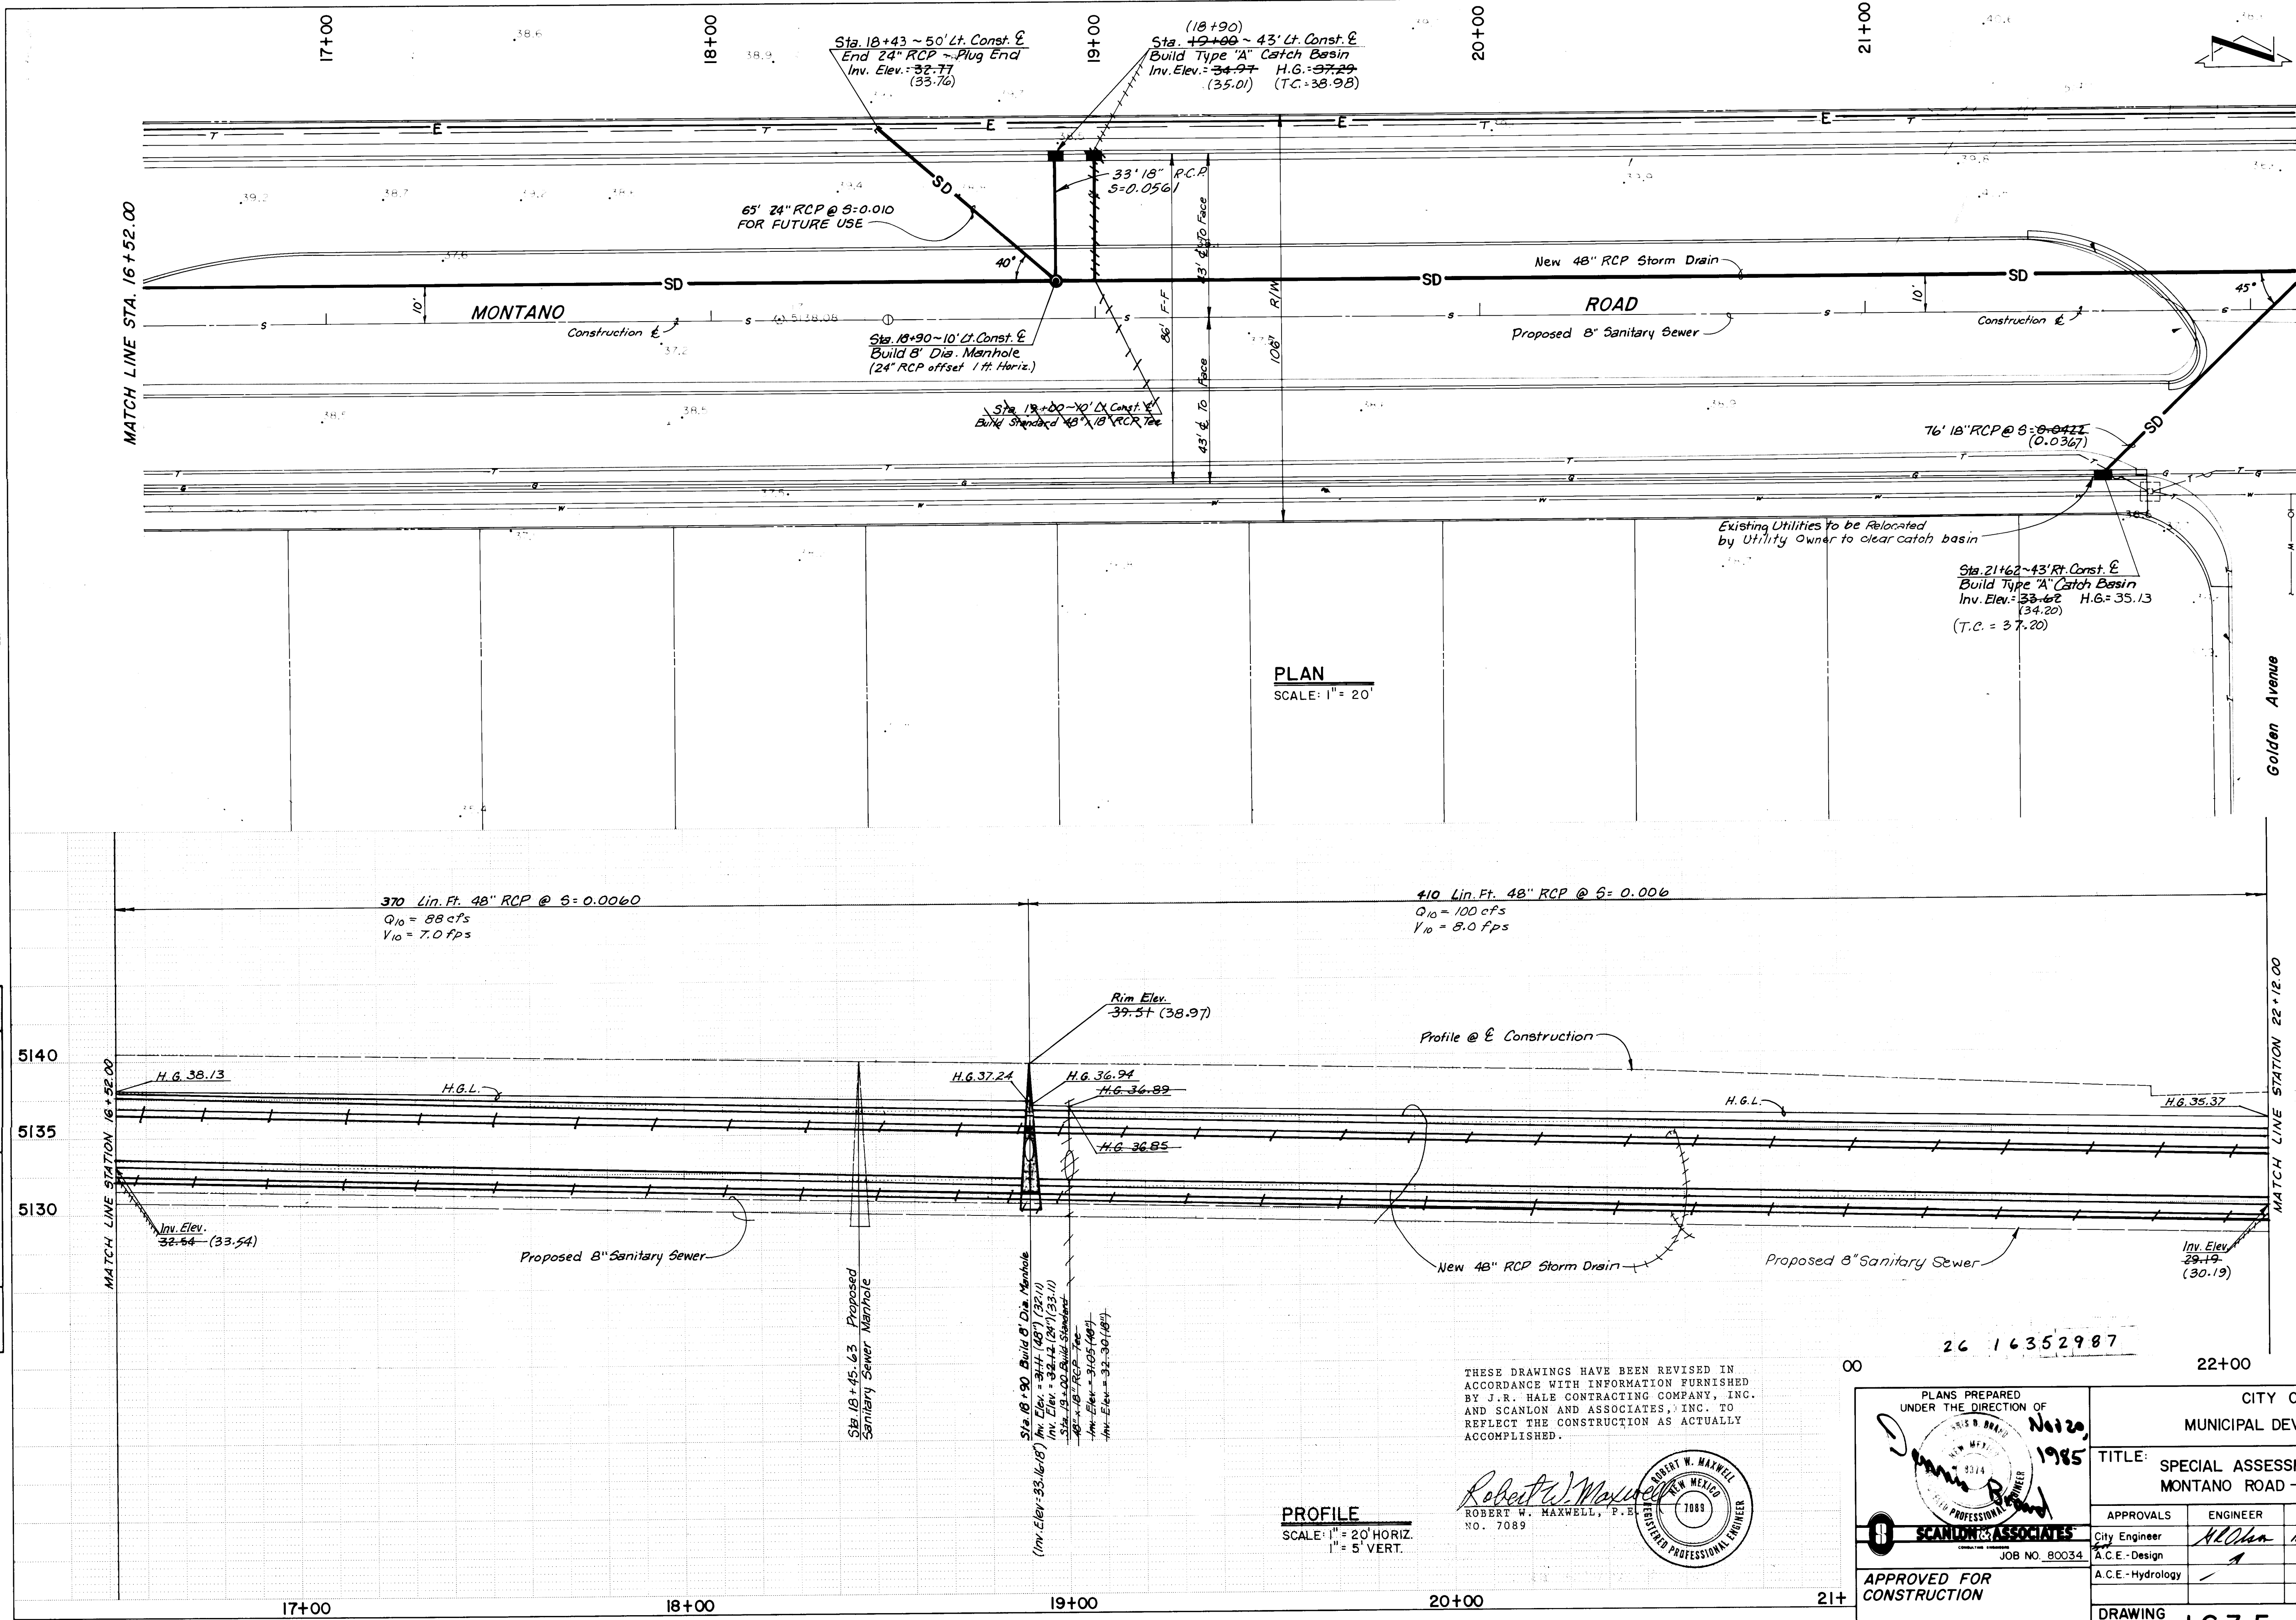

THESE DRAWINGS HAVE BEEN REVISED IN ACCORDANCE WITH INFORMATION FURNISHED BY J. S. HALL CONTRACTING COMPANY, INC. AND SCANLON AND ASSOCIATES, INC. TO REFLECT THE CONSTRUCTION AS ACTUALLY ACCOMPLISHED.

Robert W. Maxwell
ROBERT W. MAXWELL, P.E.
NO. 7089

00

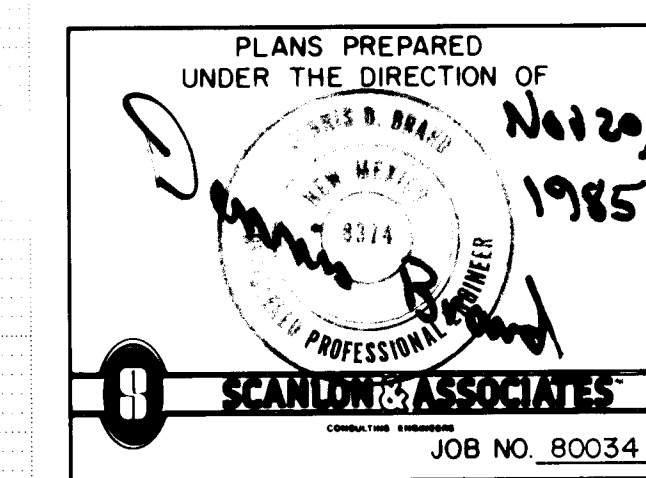

APPROVED FOR CONSTRUCTION
CITY ENGINEER DATE


CITY OF ALBUQUERQUE MUNICIPAL DEVELOPMENT DEPARTMENT			
TITLE: SPECIAL ASSESSMENT DISTRICT NO. 197 MONTANO ROAD - STORM DRAIN			
APPROVALS	ENGINEER	DATE	APPROVALS
City Engineer	<i>Maxwell</i>	11/20/85	Liquid Waste
A.C.E.-Design			Traffic
A.C.E.-Hydrology			Water
DRAWING NO. 1635		MAP NO. E-10	SHEET 29 OF 35

RECORD DRAWING


AS BUILT INFORMATION	BENCH MARKS	SURVEY INFORMATION	REFERENCES	REVISIONS	DESIGN
CONTRACTOR: J.E. Hall Co., Inc. SIGNED BY: Scanlon & Associates, Inc. DATE: 11/20/85 PROJECT: Montano Road - Storm Drain SHEET: 29 OF 35	B.M. 41 - E-10-400 B.M. 42 - E-10-400 B.M. 43 - E-10-400	NO. BY DATE	MAP NO. E-10 EST. NO.	NO. DATE	DESIGNED BY DRAWN BY CHECKED BY

PLAN	DATE	BY	CHKD	DATE
DESIGNED				
PLOTTED				
NOTED				
IN CHARGE				

PROFILE	DATE	BY	CHKD	DATE
DESIGNED				
PLOTTED				
NOTED				
IN CHARGE				

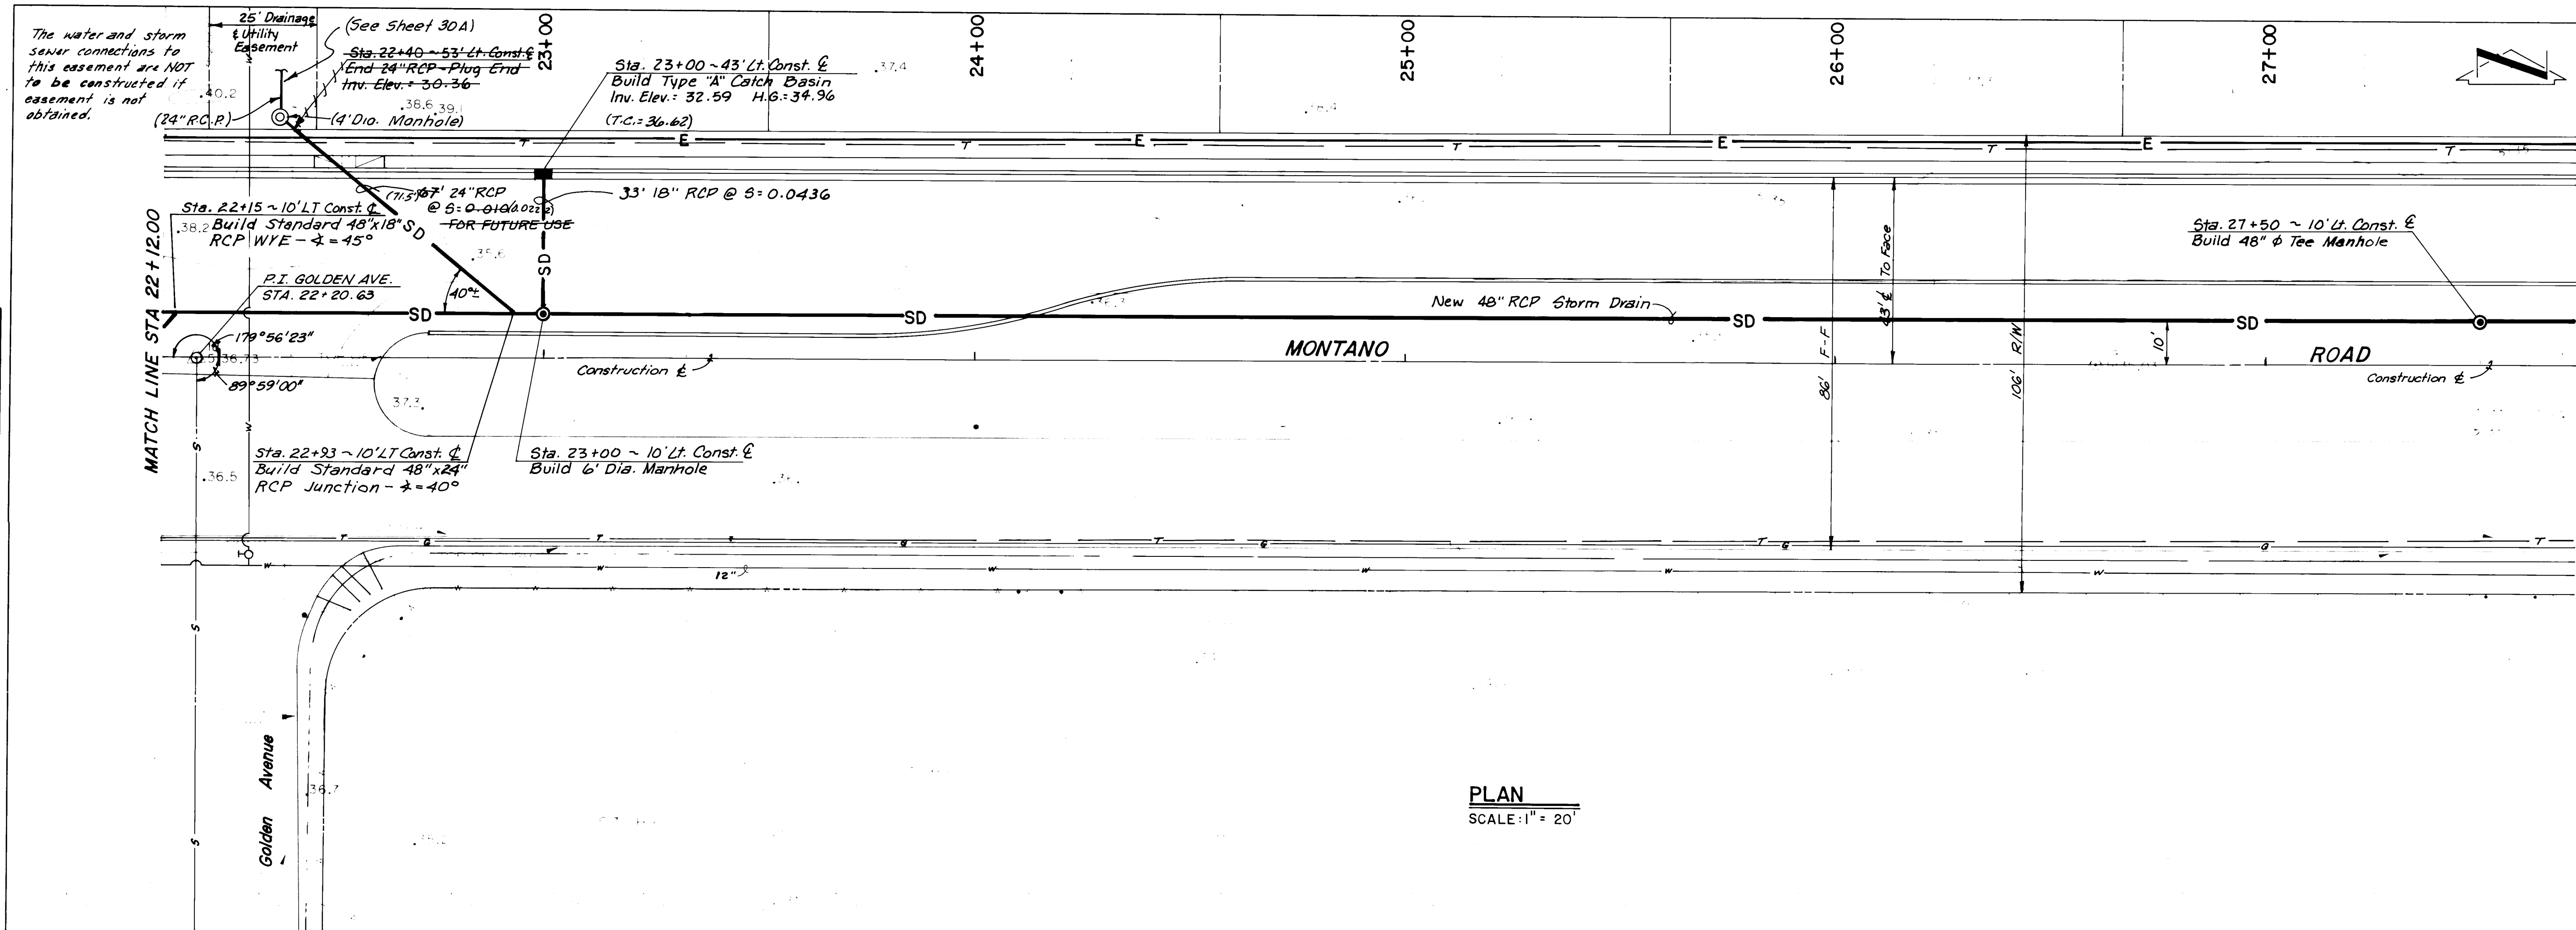

PLAN
SCALE: 1" = 20'

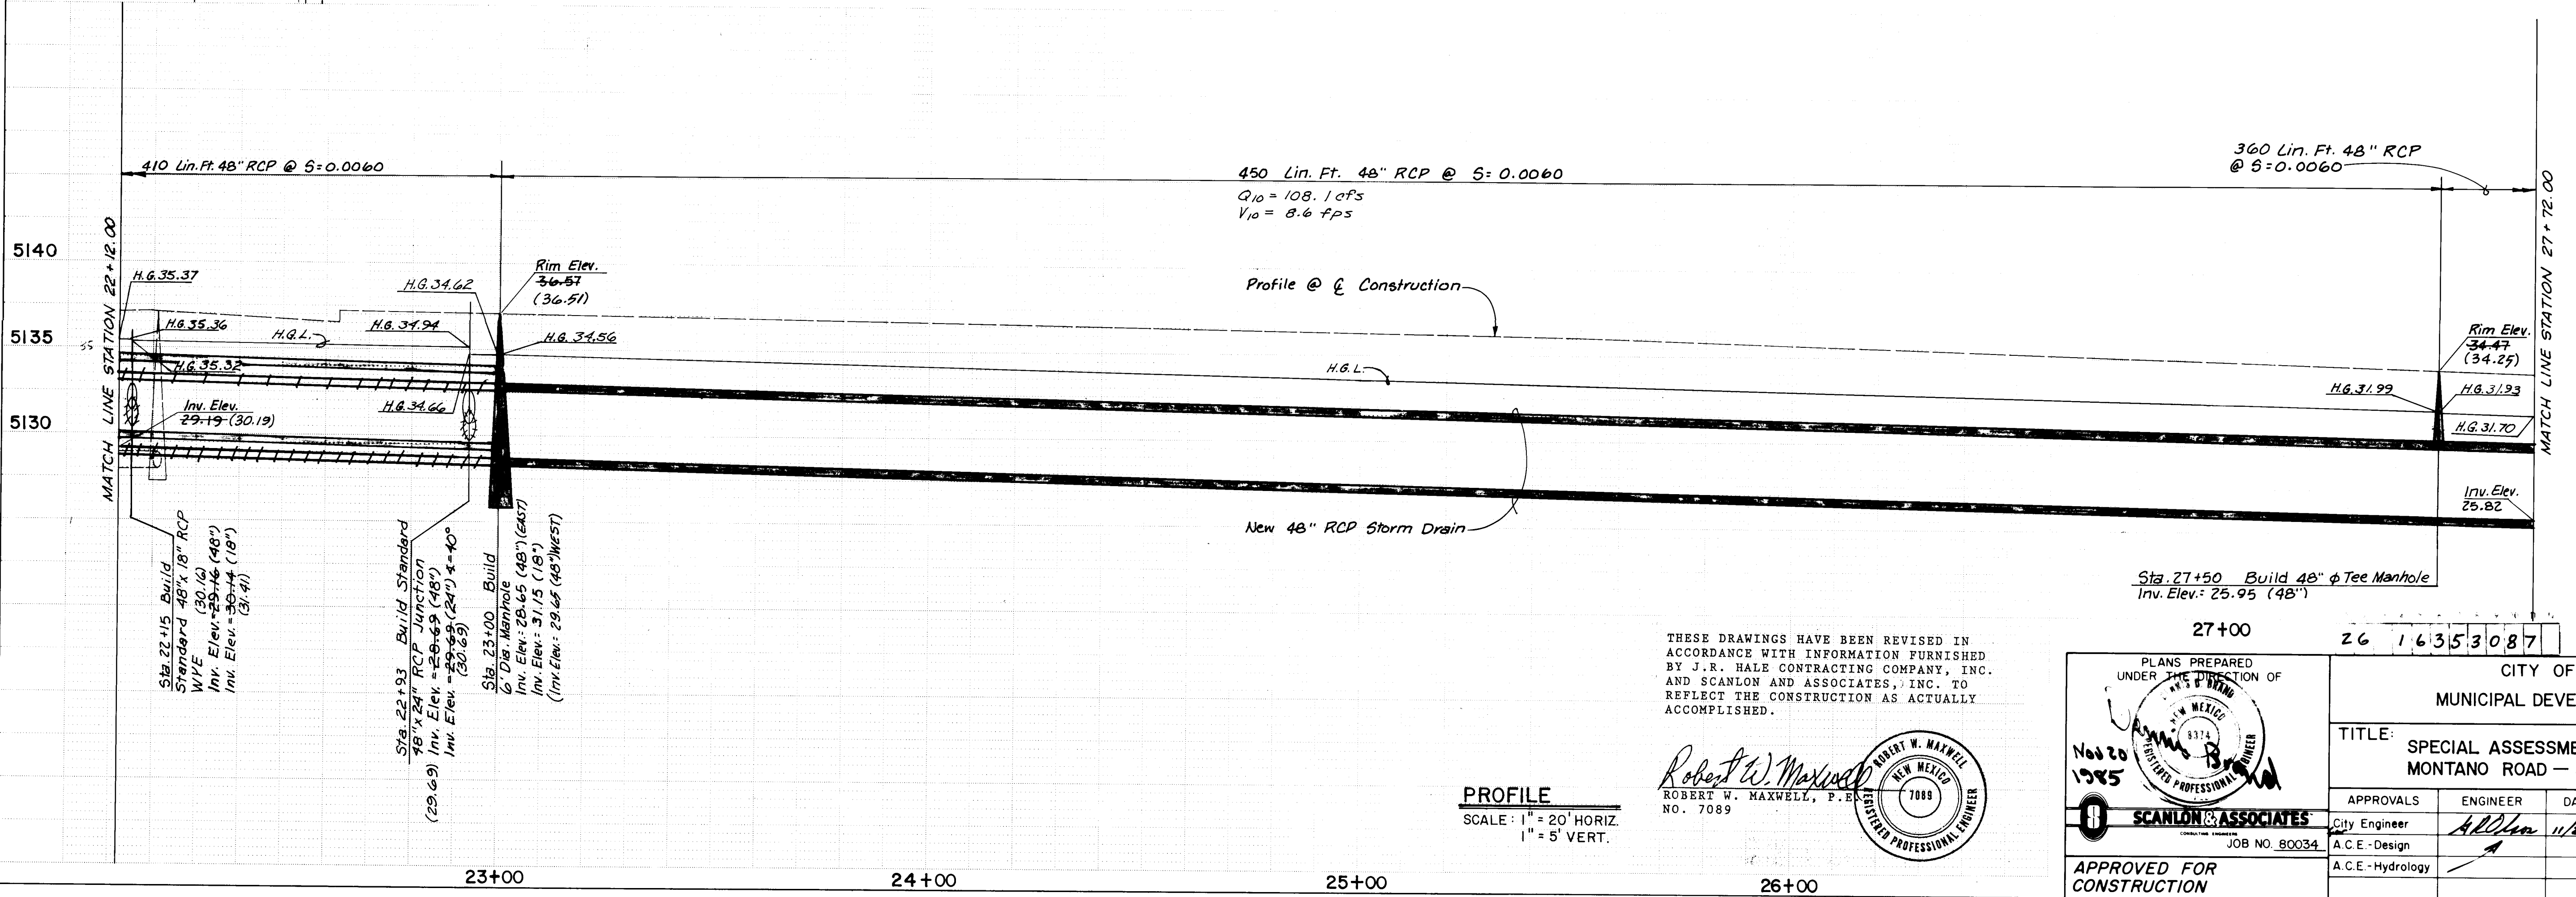

PROFILE
SCALE: 1" = 20' HORIZ.
1" = 5' VERT.

THESE DRAWINGS HAVE BEEN REVISED IN ACCORDANCE WITH INFORMATION FURNISHED BY J. S. BAIS CONTRACTING COMPANY, INC. AND SCANLON AND ASSOCIATES, INC. TO REFLECT THE CONSTRUCTION AS ACTUALLY ACCOMPLISHED.

Robert W. Maxwell
ROBERT W. MAXWELL, P.E.
NO. 7089




PLANS PREPARED UNDER THE SUPERVISION OF		CITY OF ALBUQUERQUE MUNICIPAL DEVELOPMENT DEPARTMENT	
TITLE: SPECIAL ASSESSMENT DISTRICT NO. 197 MONTANO ROAD - STORM DRAIN			
APPROVALS	ENGINEER	DATE	APPROVALS
City Engineer	Allen W. Wether		Engineer
A.C.E. - Design			Engineer
A.C.E. - Hydrology			Engineer
DRAWING NO. 1635		MAP NO. E-11	
CITY ENGINEER		DATE	

RECORD DRAWING

AS BUILT INFORMATION	BENCH MARKS	SURVEY INFORMATION	REFERENCES	REVISIONS
CONTRACTOR: J.P. WILSON & SONS, INC.	B.M. 14 - ETO 440 Perry Hill In Power Ave 180' North	FIELD NOTES	MAP NO. E-11	NO. DATE
WORKING DRAWING NO. 1635	OF Junction Attraction Road of	BY	EST. NO.	BY
REVISIONS	Montano Road West of Attraction	NO.	W.O. NO.	REMARKS
1. Revision to Standard Plans	B.M. 14 - ETO 440 Perry Hill In Power Ave 180' North	DATE		DESIGN
2. Revision to Standard Plans	Return Whittman & Camille Published			DATE
3. Revision to Standard Plans	Revision = 5/22/60			DATE
4. Revision to Standard Plans				DATE
5. Revision to Standard Plans				DATE
PROFILE		BY	DATE
SURVEYED			
PLOTTED			
GRADES CHECKED			
B. M.'S NOTED			
STRUCTURE NOTATIONS CHK'D			

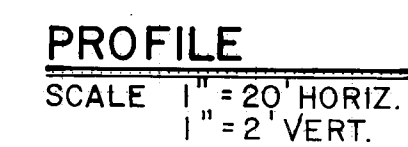


THESE DRAWINGS HAVE BEEN REVISED IN
ACCORDANCE WITH INFORMATION FURNISHED
BY J.R. HALE CONTRACTING COMPANY, INC.
AND SCANLON AND ASSOCIATES, INC. TO
REFLECT THE CONSTRUCTION AS ACTUALLY
ACCOMPLISHED.

Robert W. Maxwell
ROBERT W. MAXWELL, P.E.
NO. 7089

PLANS PREPARED UNDER THE DIRECTION OF  Nov 23 1985		CITY OF ALBUQUERQUE MUNICIPAL DEVELOPMENT DEPARTMENT	
TITLE: SPECIAL ASSESSMENT DISTRICT NO. 197 MONTANO ROAD - STORM DRAIN			
APPROVALS	ENGINEER	DATE	APPROVALS
City Engineer	<i>ARC</i>	<i>11/27/85</i>	Liquid Waste
A.C.E. - Design	<i>A</i>		Traffic
A.C.E. - Hydrology	<i>-</i>		Water
DRAWING NO. 1635		MAP NO. E-11	SHEET 31 OF 35

RECORD DRAWING

PROFILE	BY	DATE
SURVEYED		
PLOTTED		
GRADES CHECKED		
B. M.'S NOTED		

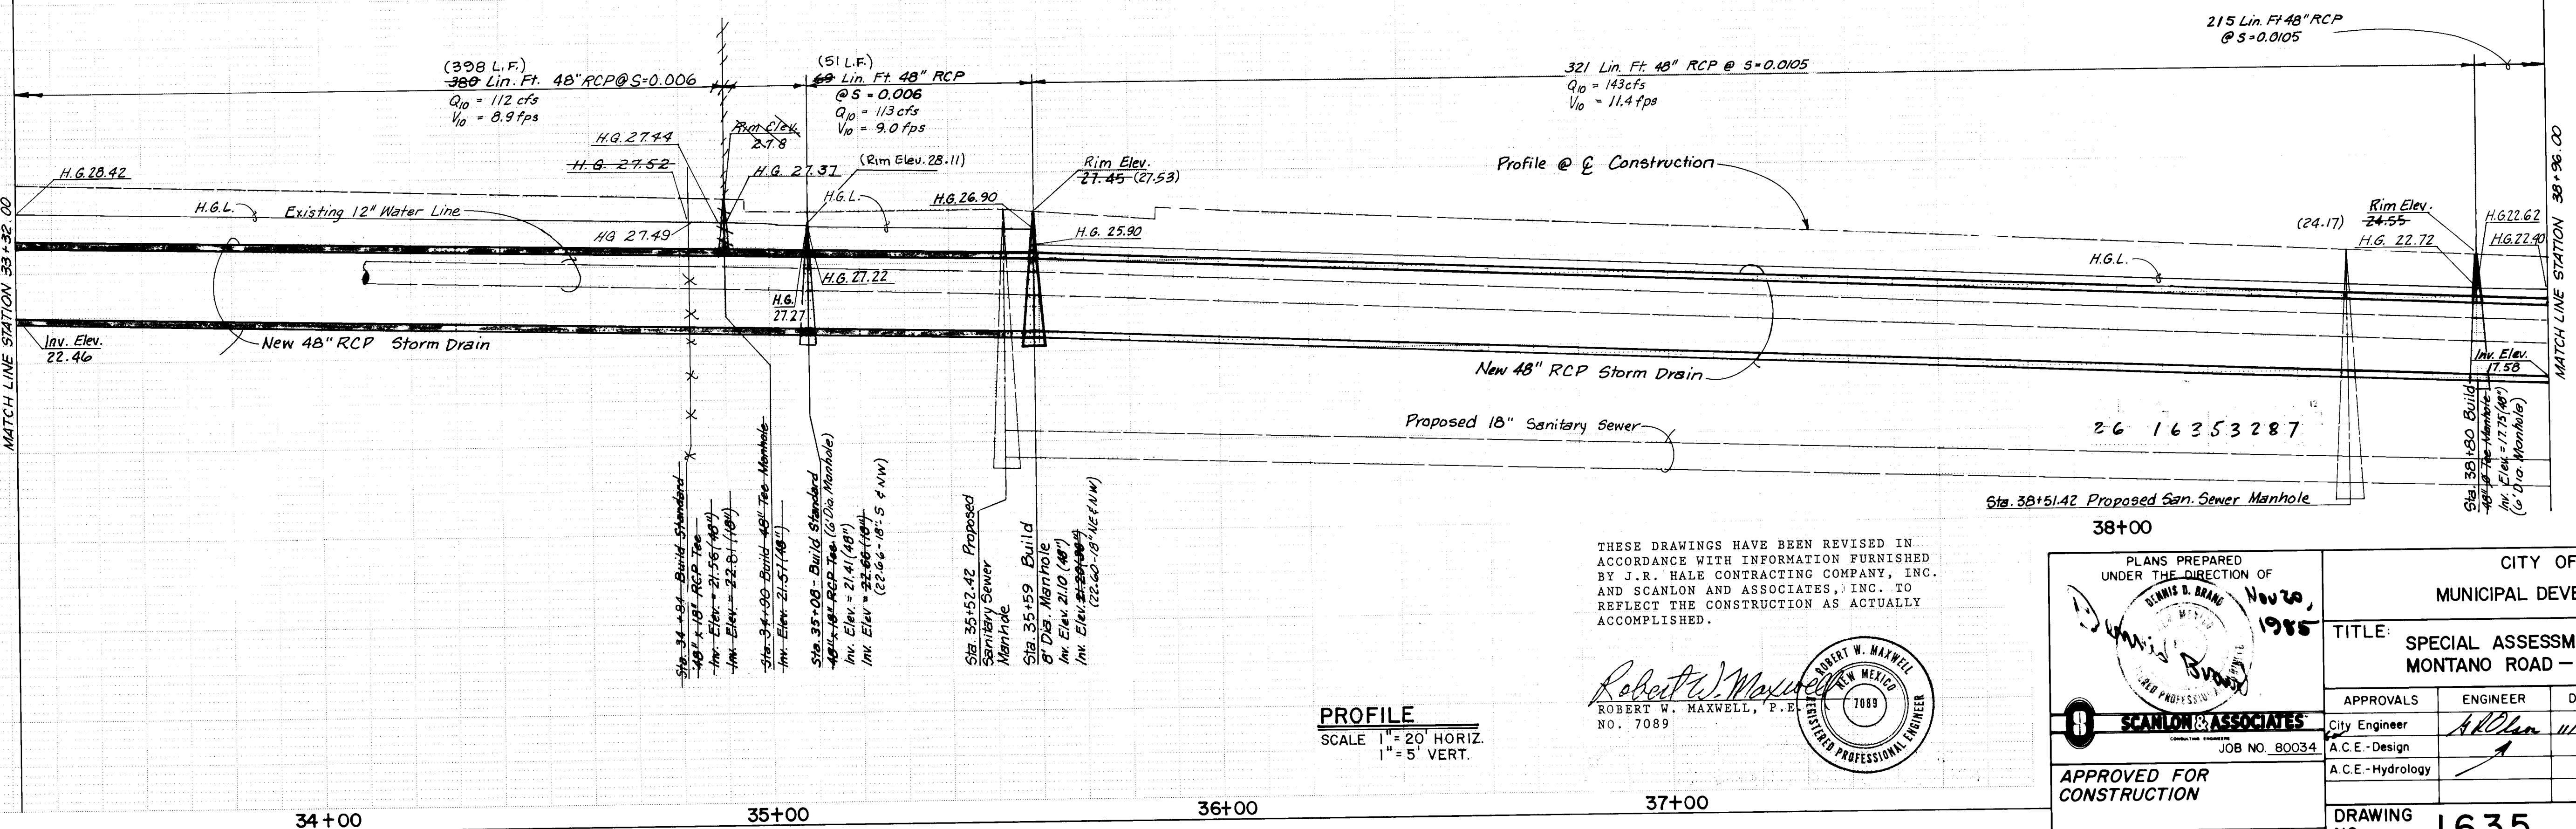


Robert W. Maxwell
ROBERT W. MAXWELL, P.E.
NO. 7089




A circular professional engineer seal for Robert W. Maxwell, New Mexico. The seal features the text "ROBERT W. MAXWELL" at the top, "NEW MEXICO" at the bottom, and "REGISTERED PROFESSIONAL ENGINEER" around the inner circle. The number "7089" is in the center.

PLANS PREPARED UNDER THE DIRECTION OF 		CITY OF ALBUQUERQUE MUNICIPAL DEVELOPMENT DEPARTMENT	
TITLE: SPECIAL ASSESSMENT DISTRICT NO. 197 MONTANO ROAD - STORM DRAIN			
APPROVALS	ENGINEER	DATE	APPROVALS
CITY ENGINEER	<i>A.R. Olson</i>	<i>11/27/85</i>	Liquid Waste <i>B.G. Pender</i> <i>11-20-85</i>
A.C.E. - Design	<i>[Signature]</i>		Traffic <i>B.G. Pender</i> <i>11-20-85</i>
A.C.E. - Hydrology			Water <i>William D. Pender</i> <i>11-20-85</i>
DRAWING NO. 1635		MAP NO. E - 11	SHEET 32 OF 35

PROFILE	SURVEYED	BY	DATE
NOTE BOOK	PLOTTED		
	GRADES CHECKED		
	B. M.'s NOTED		
NO. _____	STRUCTURE NOTATIONS CHK'D		

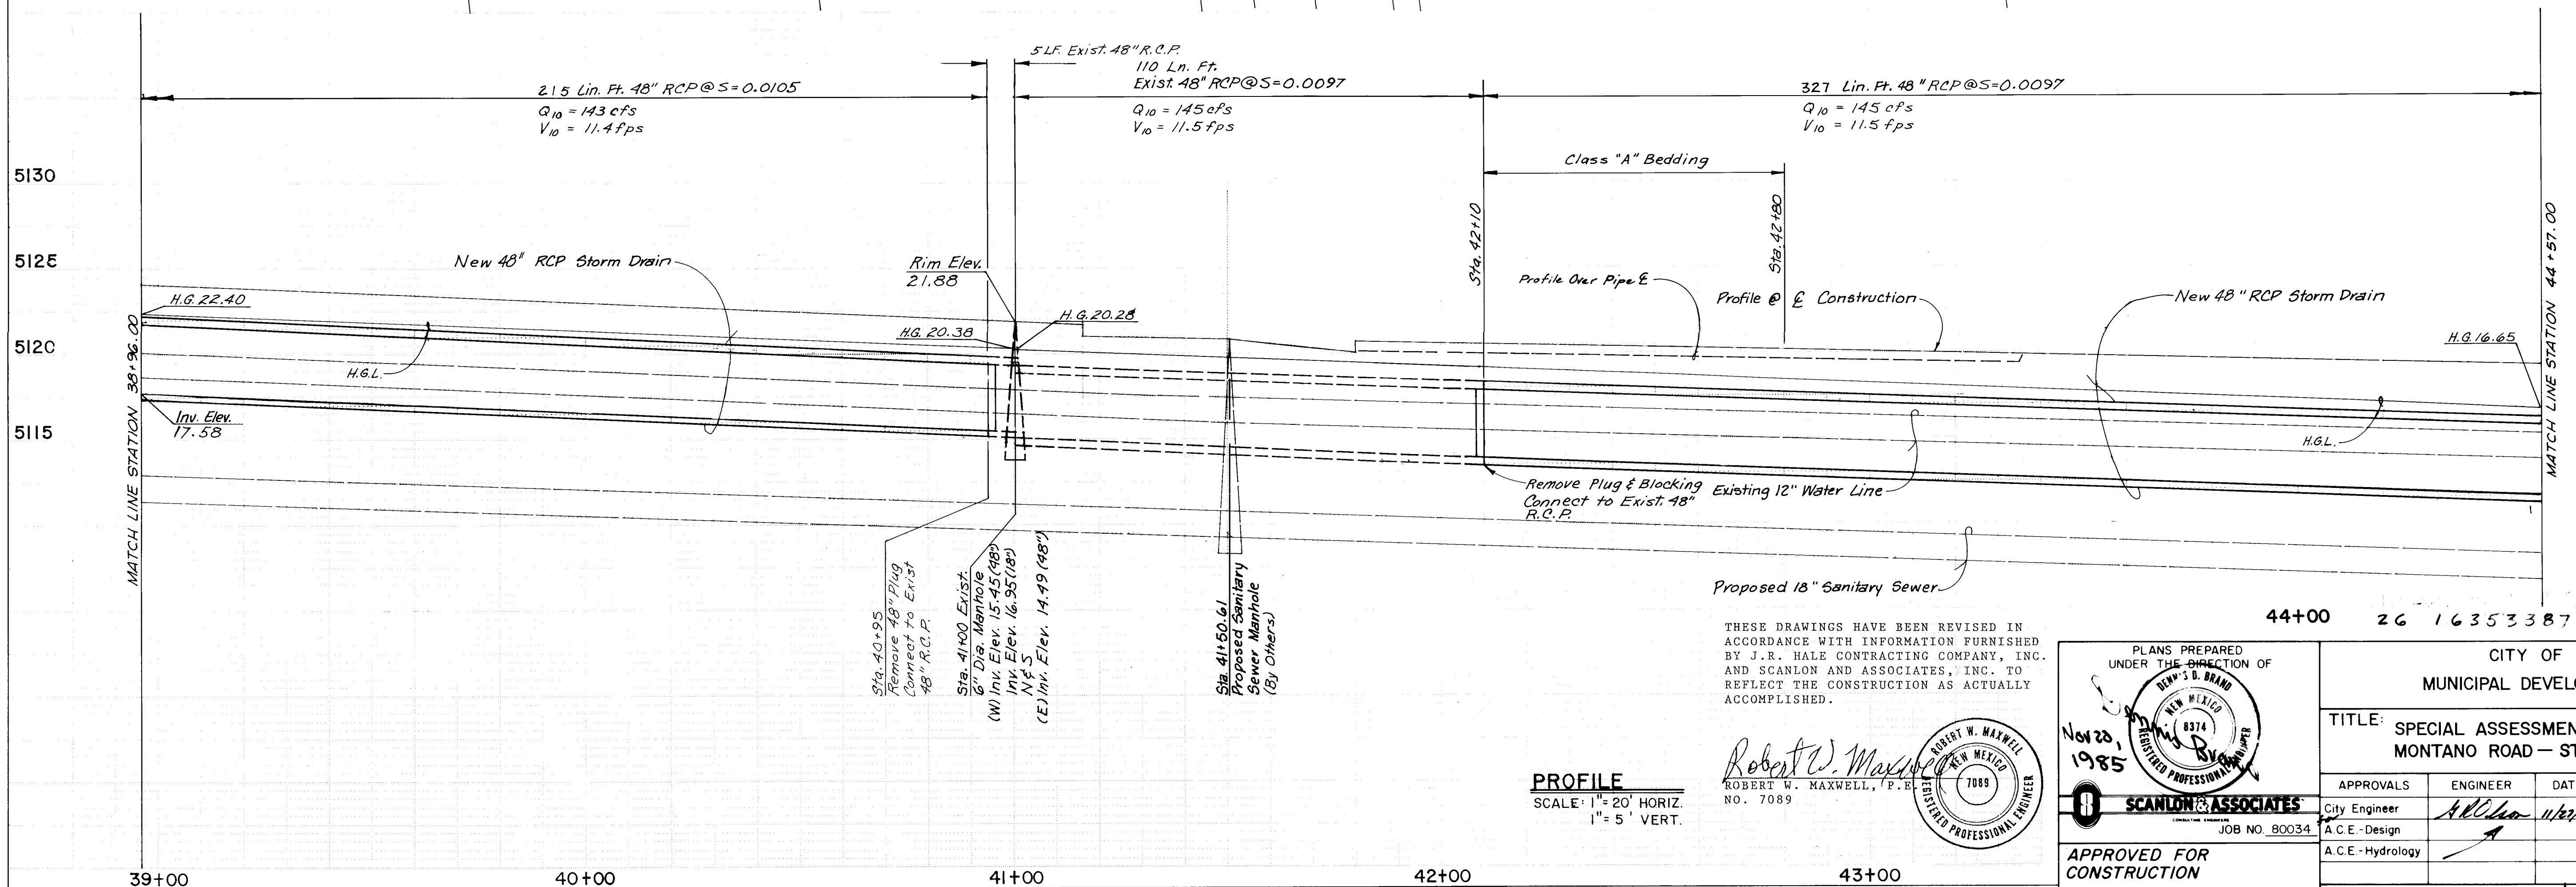

Robert W. Maxwell, P.E.
NO. 7089

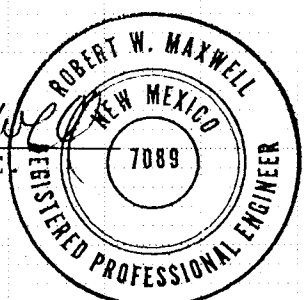


PLANS PREPARED UNDER THE DIRECTION OF  Nov 28, 1985	CITY OF ALBUQUERQUE MUNICIPAL DEVELOPMENT DEPARTMENT			
	TITLE: SPECIAL ASSESSMENT DISTRICT NO. 197 MONTANO ROAD — STORM DRAIN			
	APPROVALS	ENGINEER	DATE	
	APPROVALS	ENGINEER	DATE	
8 SCANTON & ASSOCIATES CIVIL-ENGR. ARCHT. INTERIOR JOB NO. 80034	City Engineer A.C.E. - Design	<i>William J. Bales</i> 11/28/85	Liquid Waste Traffic	<i>William J. Bales</i> 11-20-85 <i>D.A. Parks</i> 11-20-85
	A.C.E. - Hydrology		Water	<i>William J. Bales</i> 11-20-85
APPROVED FOR CONSTRUCTION	DRAWING NO. 1635		MAP NO. E - 11	SHEET 33 OF 35
CITY ENGINEER DATE				

RECORD DRAWING


PLAN	DATE
SURVEYED	BY
ALIGNED	DATE
CHECKED	DATE
RT OF WAY CHECKED	DATE
NO.	

PROFILE	DATE
SURVEYED	BY
GRADES CHECKED	DATE
STRUCTURE NOTATIONS CHKO	DATE
NO.	

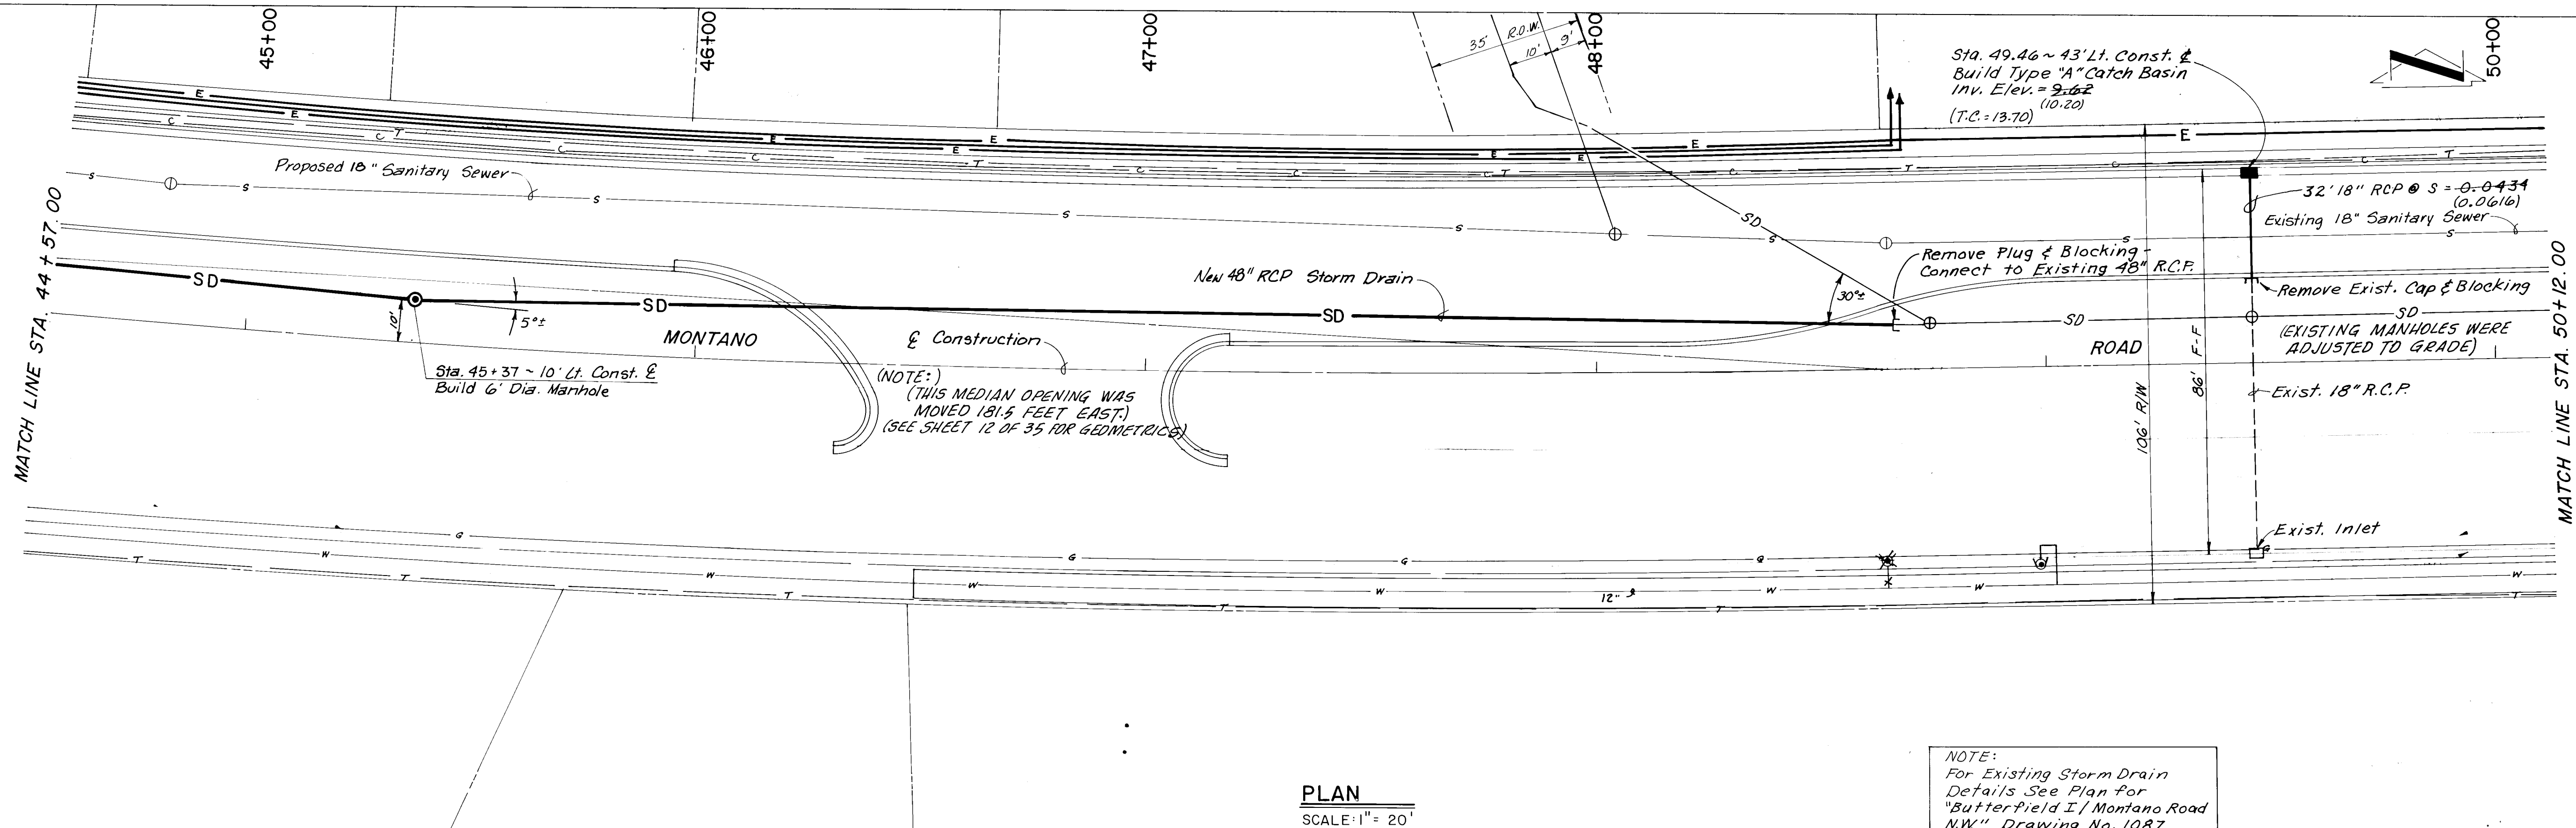

PLAN
SCALE: 1" = 20'


NOTE:
For Existing Storm Drain
Details See Plan for
"Butterfield I / Montano Road
N.W." Drawing No. 1087

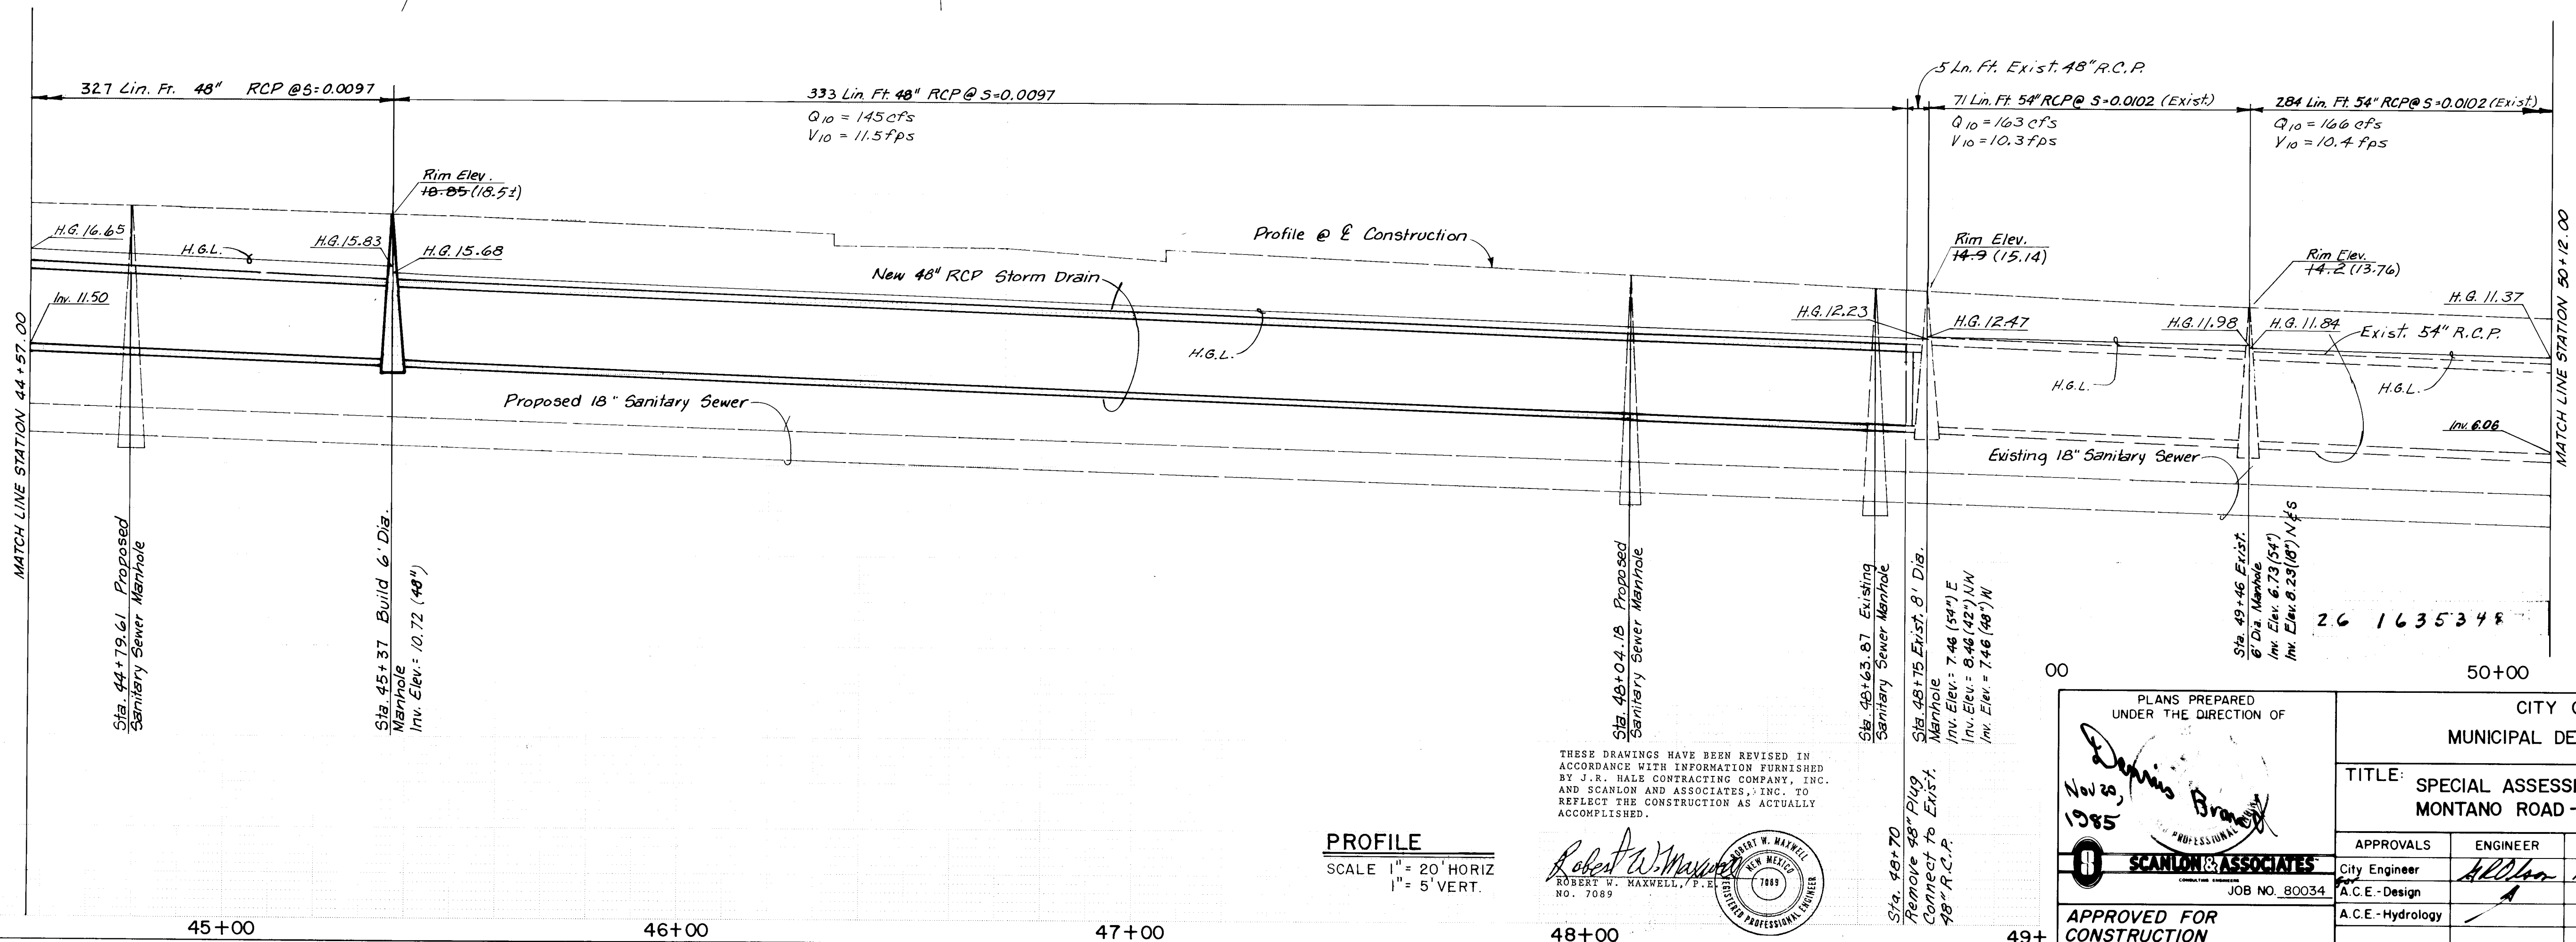

PROFILE
SCALE: 1" = 20' HORIZ
1" = 5' VERT.

THESE DRAWINGS HAVE BEEN REVISED IN
ACCORDANCE WITH INFORMATION FURNISHED
BY J.R. HALE CONTRACTING COMPANY, INC.
AND SCANLON AND ASSOCIATES, INC. TO
REFLECT THE CONSTRUCTION AS ACTUALLY
ACCOMPLISHED.

Robert W. Maxwell
ROBERT W. MAXWELL, P.E.
NO. 7089

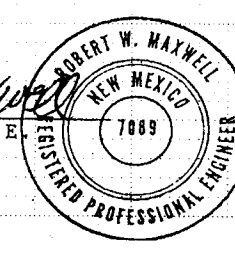


PLANS PREPARED
UNDER THE DIRECTION OF
James Brandy
1985
SCANLON & ASSOCIATES
CONTRACT ENGINEERS
JOB NO. 80034
APPROVED FOR
CONSTRUCTION
CITY ENGINEER DATE

CITY OF ALBUQUERQUE
MUNICIPAL DEVELOPMENT DEPARTMENT
TITLE: SPECIAL ASSESSMENT DISTRICT NO. 197
MONTANO ROAD - STORM DRAIN
APPROVALS
ENGINEER DATE
City Engineer *ALL* 11/21/85
A.C.E. - Design *A*
A.C.E. - Hydrology
LIQUID WASTE
TRAFFIC
WATER
DRAWING NO. 1635
MAP NO. E-11
SHEET 34 OF 35

AS BUILT INFORMATION	BENCH MARKS	SURVEY INFORMATION	REFERENCES	REVISIONS
CONTRACTOR J.R. Hale Co. Inc. WORKED BY Scanlon & Assoc. DATE 1984 INSPECTOR'S ACCEPTANCE BY VERIFICATION BY Scanlon & Assoc. DATE 11/84 DRAWN BY Scanlon & Assoc. DATE 11/84 RECORDED BY NO.	B.M. 1411 Brass Cap In Concrete East Side Canada Vista Published Elevation 5113.93	FIELD NOTES NO. BY DATE	MAP NO. E-11 EST. NO. W.O. NO.	NO. DATE REMARKS DESIGN DESIGNED BY DRAWN BY HOLLIS, SCH CHECKED BY DATE DATE DATE

PLAN	DATE	BY
SURVEYED		
ALIGNED		
CHECKED		
BY		
DATE		

PROFILE	DATE	BY
SURVEYED		
GRADES		
CHECKED		
BY		
DATE		

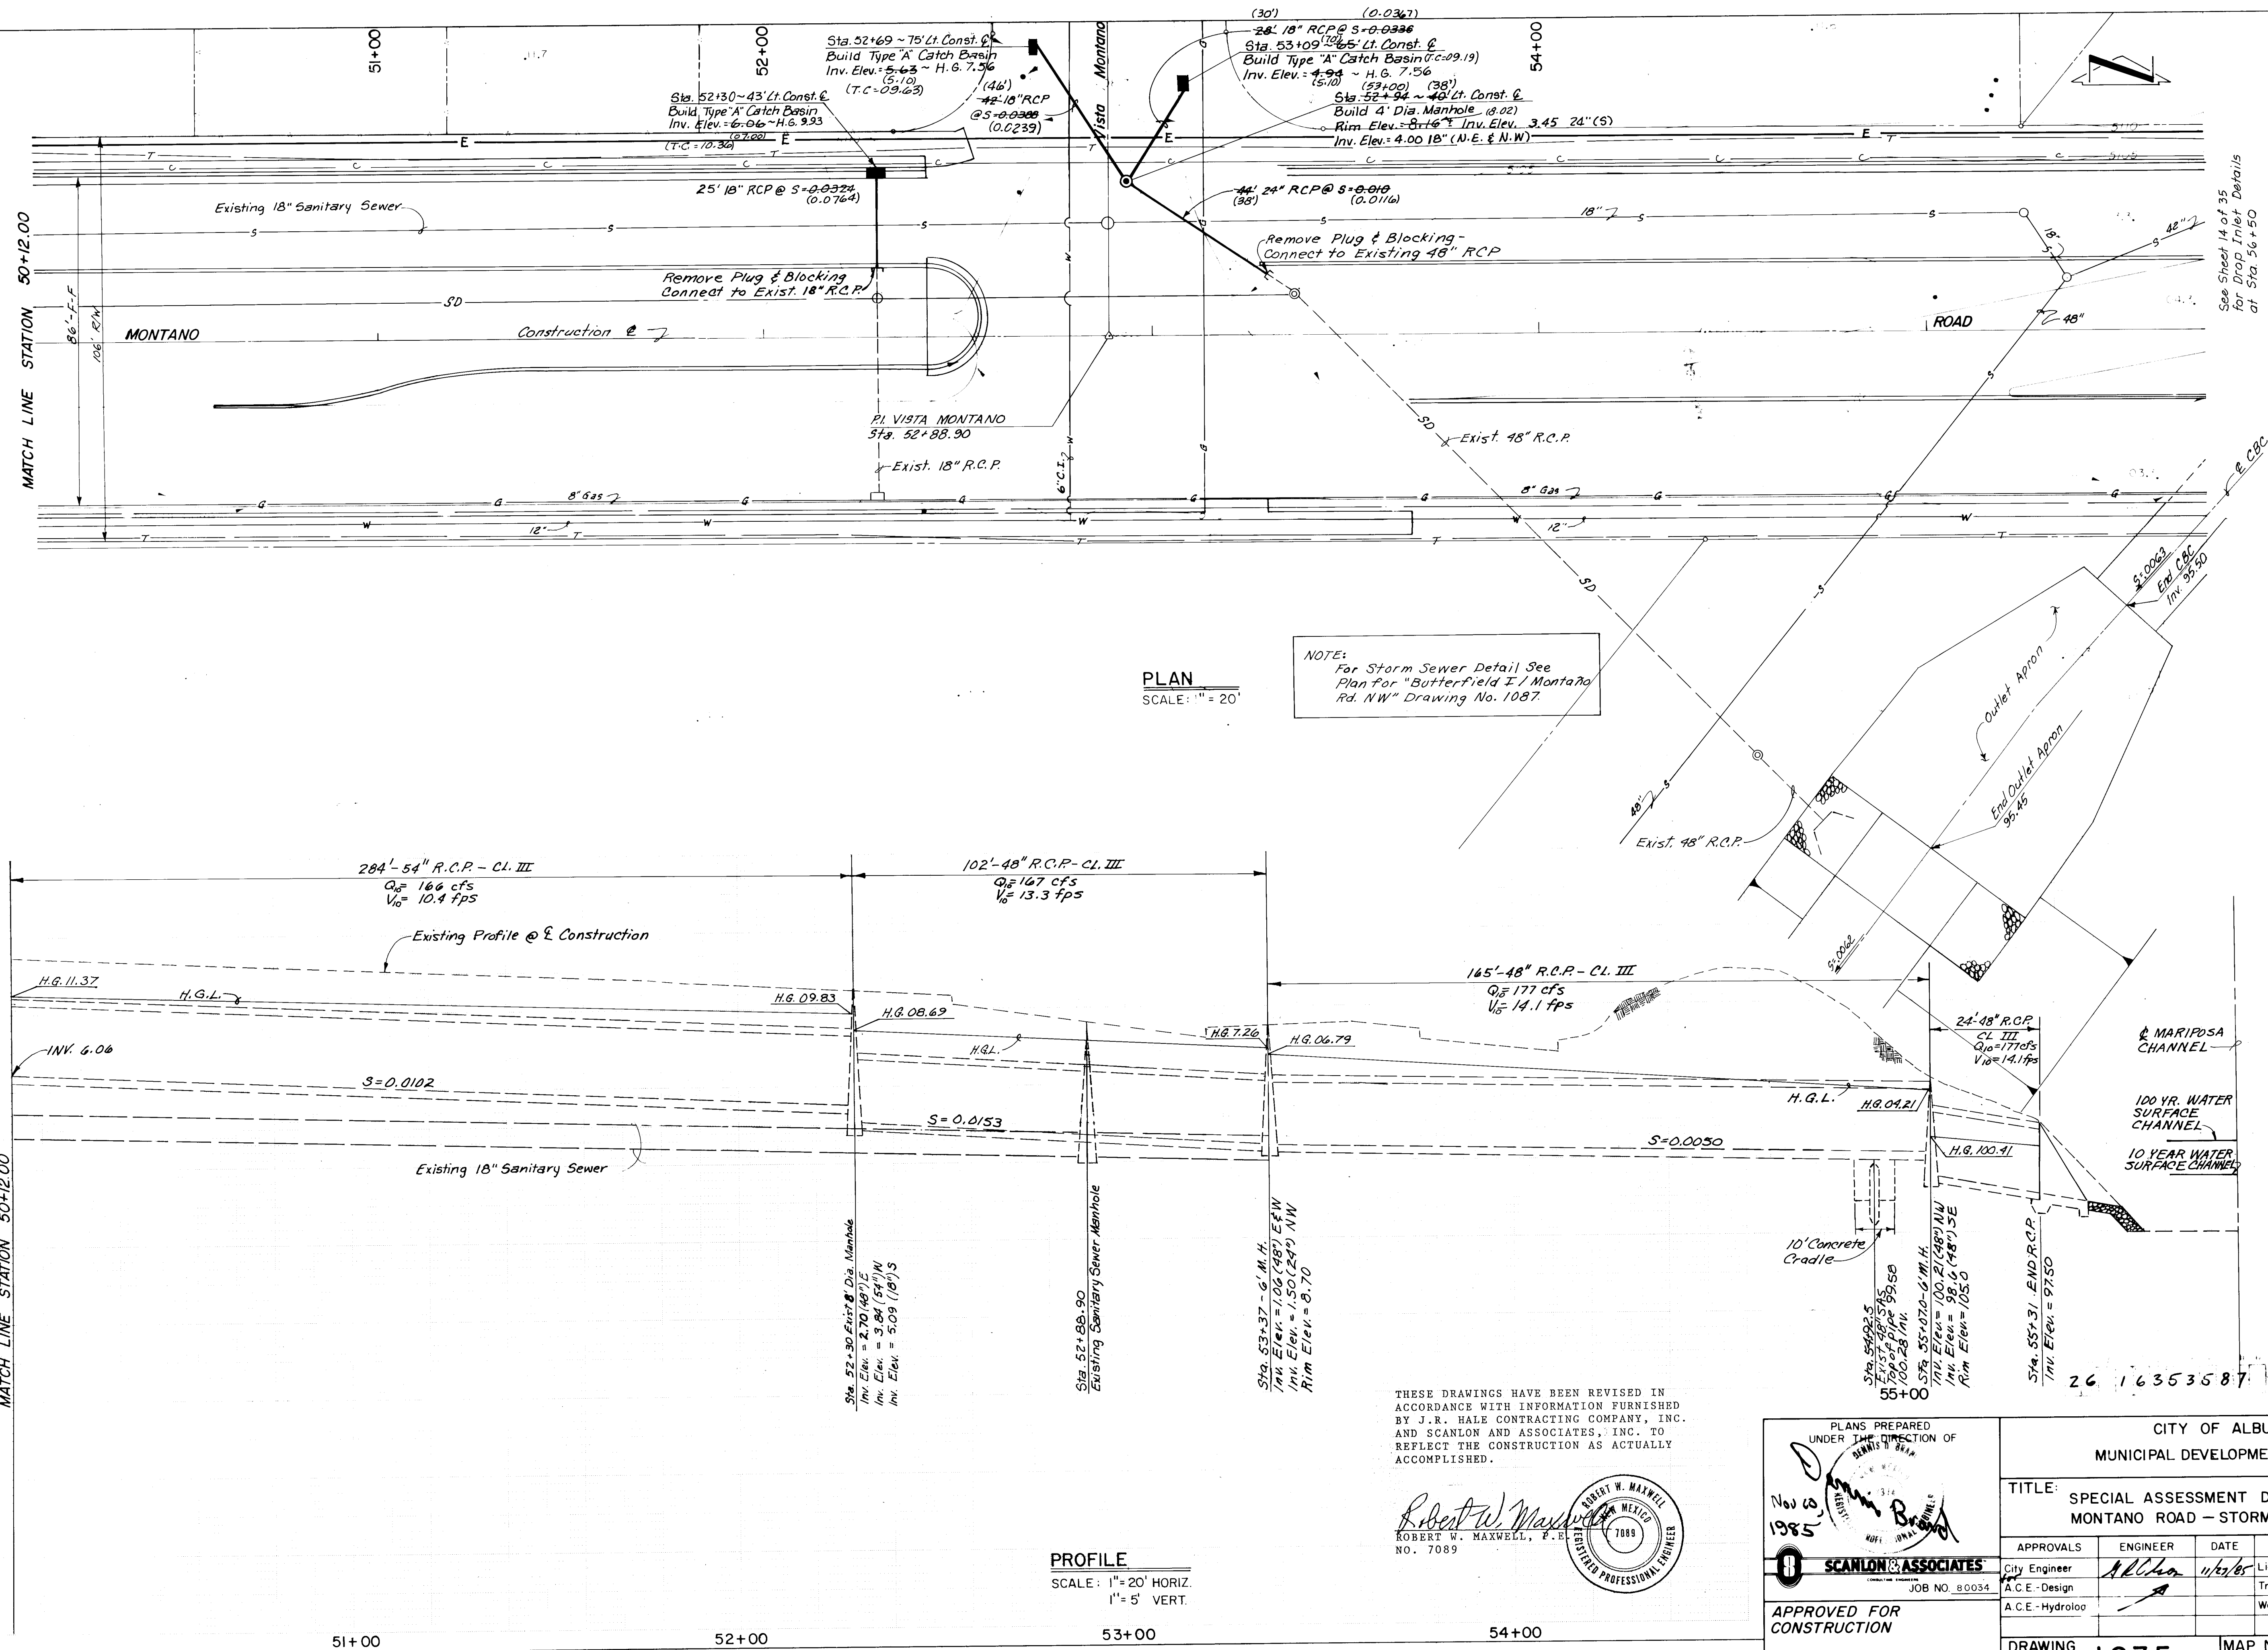

NOTE:
For Storm Sewer Detail See
Plan for "Butterfield I / Montano
Rd. NW" Drawing No. 1087.

THESE DRAWINGS HAVE BEEN REVISED IN
ACCORDANCE WITH INFORMATION FURNISHED
BY J. R. HALE CONTRACTING COMPANY, INC.
AND SCANLON AND ASSOCIATES, INC. TO
REFLECT THE CONSTRUCTION AS ACTUALLY
ACCOMPLISHED.

Robert W. Maxwell
ROBERT W. MAXWELL, P.E.
NO. 7089



PLANS PREPARED UNDER THE DIRECTION OF J. R. HALE CONTRACTING COMPANY, INC.		CITY OF ALBUQUERQUE MUNICIPAL DEVELOPMENT DEPARTMENT	
TITLE: SPECIAL ASSESSMENT DISTRICT NO. 197 MONTANO ROAD - STORM DRAIN		APPROVALS	
APPROVALS	ENGINEER	DATE	APPROVALS
City Engineer	11/17/85	Liquid Waste	William D. Pickett 11-20-85
A.C.E. - Design		Traffic	William D. Pickett 11-20-85
A.C.E. - Hydrology		Water	William D. Pickett 11-20-85
DRAWING NO. 1635		MAP NO. E-11	
CITY ENGINEER		DATE	
APPROVED FOR CONSTRUCTION		SHEET 35 OF 35	

RECORD DRAWING

AS BUILT INFORMATION	BENCH MARKS	SURVEY INFORMATION	REFERENCES	REVISIONS
CONTRACTOR J.R. Hale Co. Inc. WORK STATED BY Scanlon & Associates DATE 11/13/93 CANADA VISTA Published Elev. = 5113.93	BM 1-E11 Br-25 cap in conc. east side Canada Vista Published Elev. = 5113.93	FIELD NOTES NO. BY DATE	MAP NO. E-11 EST. NO.	NO. DATE REMARKS DESIGN
FIELD LOCATION BY Scanlon & Associates DATE 11/13/93 DRAWING BY Scanlon & Associates DATE 11/13/93 RECORDED BY DATE				