


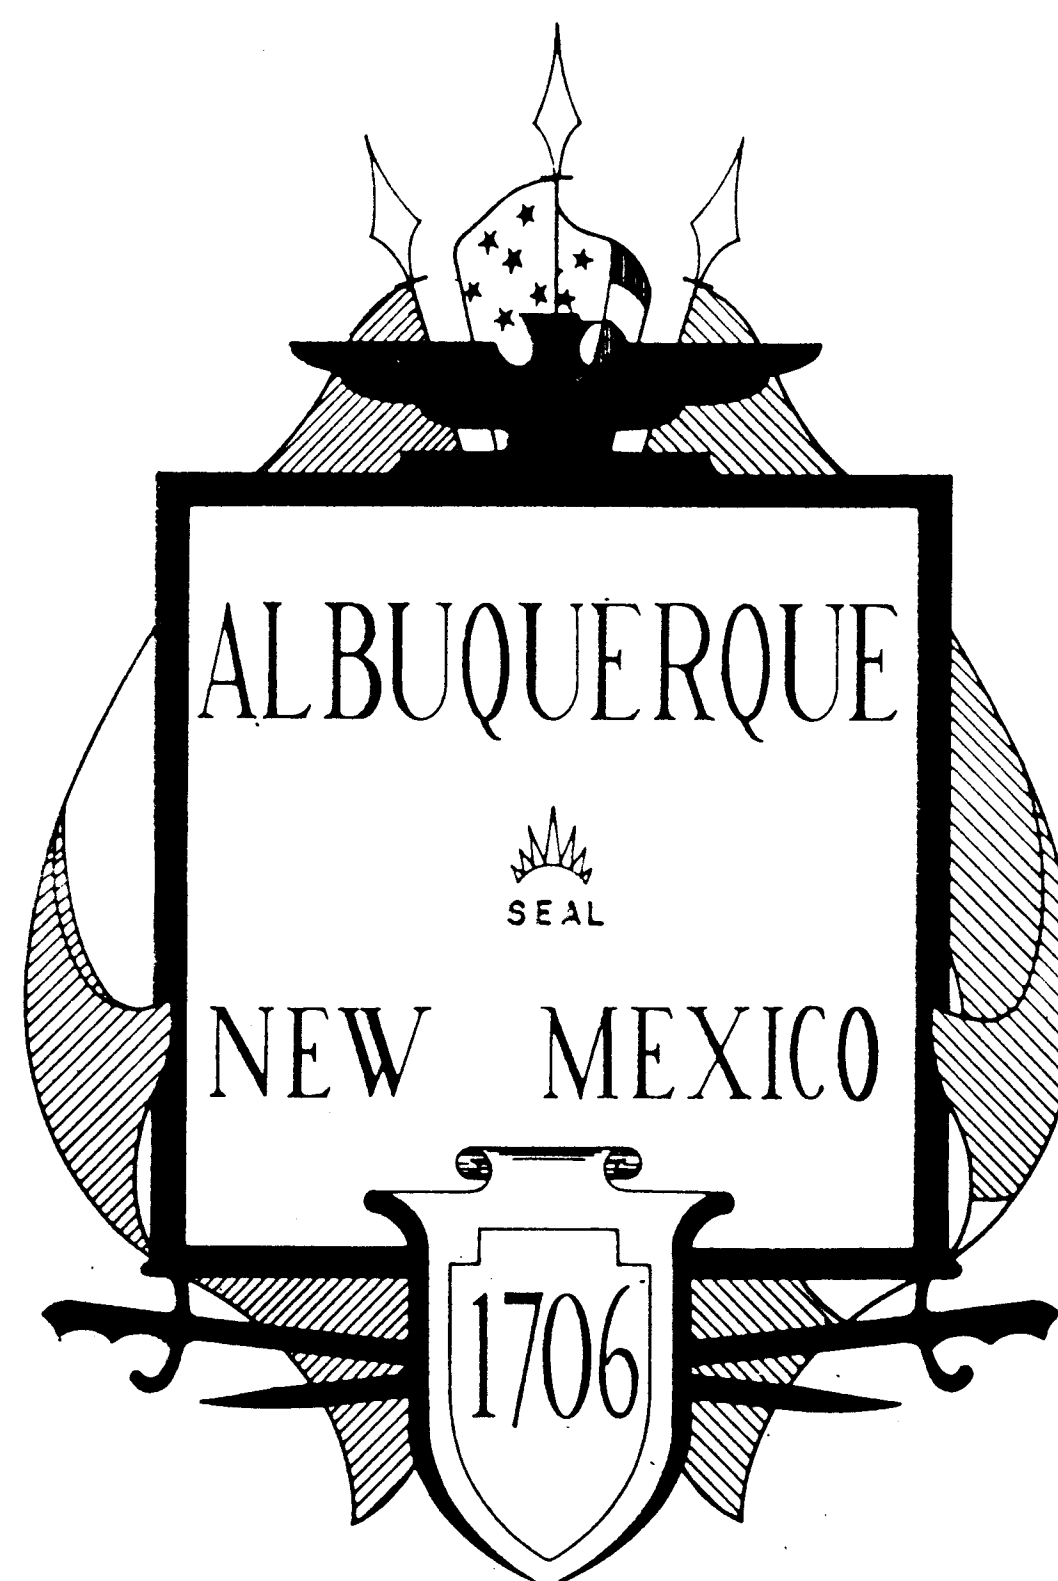

CITY OF ALBUQUERQUE
TRANSPORTATION DEPARTMENT

MAP - M - 4061 (901)

WYOMING BLVD. N.E. WIDENING
ACADEMY RD. TO MONTGOMERY BLVD.
(STAGE ONE TO PERMANENT CONSTRUCTION)

APRIL 1983

CHIEF HIGHWAY ADMINISTRATOR
DATE 3/22/83

APPROVED FOR CONSTRUCTION:
CITY ENGINEER *Blair R. Orr*
DIRECTOR OF TRANSPORTATION *Joseph C. Martinez* 3/14/83


RECORD DRAWING		
DATE: 2-24-84	BY: M.C.	FROM: CITY'S RECORDS

These record drawings have been prepared, on the basis of information compiled and furnished by the city engineers office. The consulting engineer will not be responsible for any errors or omissions which have been incorporated into this document as a result.

1 2 3 4 5 6 7 8 9 10 11 12
26 16370187





MOLZEN - CORBIN & ASSOCIATES
CONSULTING ENGINEERS
ALBUQUERQUE, CARLSBAD - NEW MEXICO

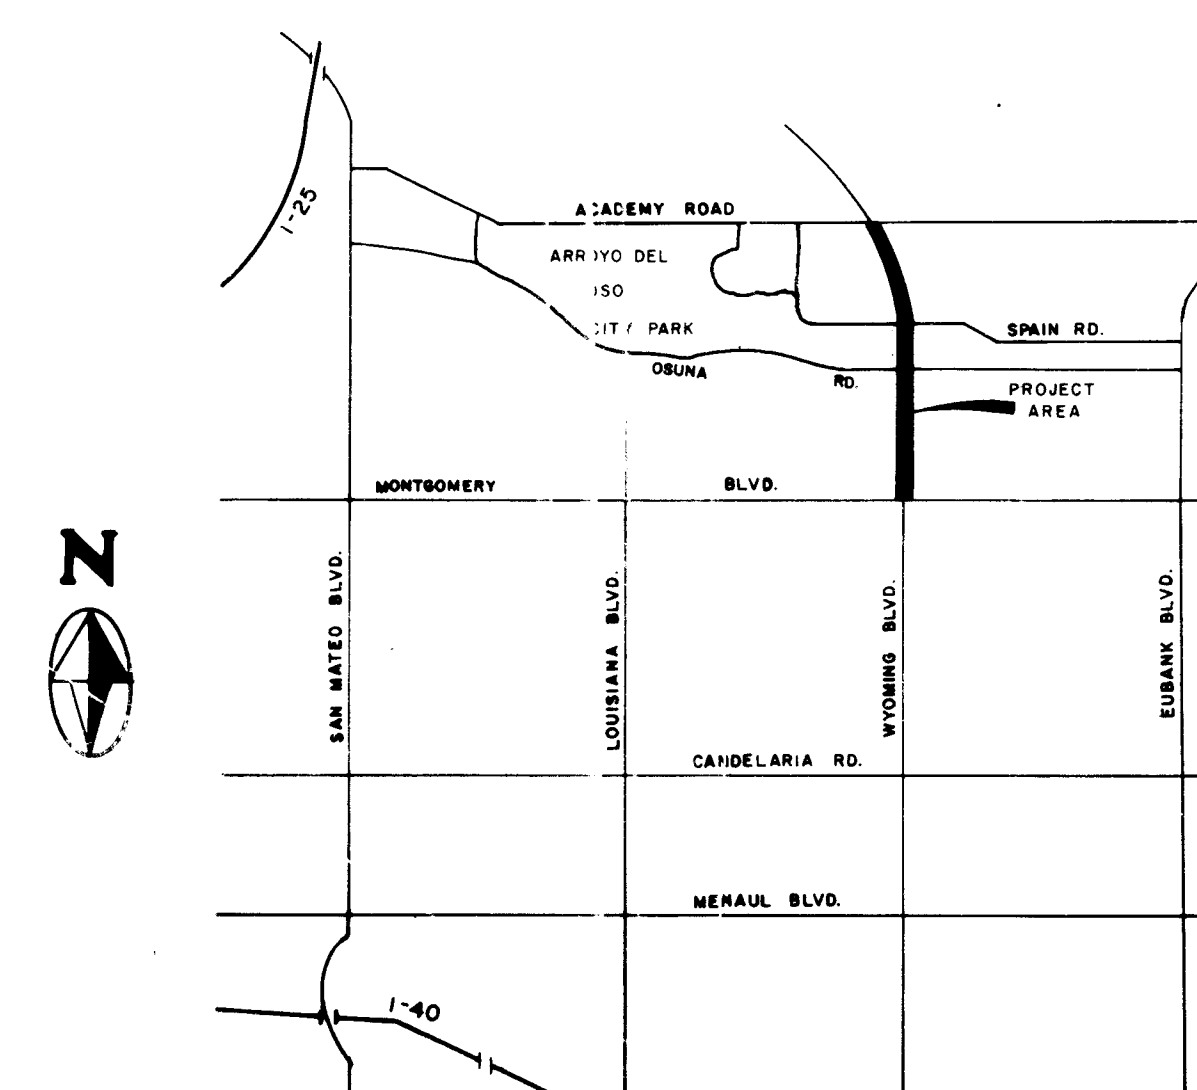

ZONE ATLAS NOS. F-19 & F-20
LOCATION MAP

INDEX TO DRAWINGS	
SHEET NO.	DESCRIPTION
1	TITLE SHEET
2	VICINITY MAP - LEGEND AND GENERAL NOTES
3 & 3A	SUMMARY OF QUANTITIES
4	TRAFFIC CONTROL DETAILS 1 & 2 AND NOTES
5	TRAFFIC CONTROL DETAIL 3
6	TRAFFIC CONTROL DETAILS 4,5,6,7,8 & 9
7	TYPICAL ROADWAY SECTIONS
8	TYPICAL ROADWAY SECTIONS
9	STREET IMPROVEMENTS AND WATER LOCATION MAP
10	STREET IMPROVEMENTS STA 10+00 TO STA 14+50
11	STREET IMPROVEMENTS STA 14+50 TO STA 20+00
12	STREET IMPROVEMENTS STA 20+00 TO STA 25+50
13	STREET IMPROVEMENTS STA 25+50 TO STA 31+00
14	STREET IMPROVEMENTS STA 31+00 TO STA 36+50
15	STREET IMPROVEMENTS STA 36+50 TO STA 42+00
16	STREET IMPROVEMENTS STA 42+00 TO STA 47+50
17	STREET IMPROVEMENTS STA 47+50 TO STA 53+00
18	STREET IMPROVEMENTS STA 53+00 TO STA 58+50
19	STREET IMPROVEMENTS STA 58+50 TO STA 64+00
20	STREET IMPROVEMENTS STA 64+00 TO STA 67+90.06
21	STORM SEWER LOCATION MAP
22	STORM SEWER IMPROVEMENTS STA 36+50 TO STA 42+00
23	STORM SEWER IMPROVEMENTS STA 42+00 TO STA 47+50
24	STORM SEWER IMPROVEMENTS STA 47+50 TO STA 53+00
25	STORM SEWER IMPROVEMENTS STA 53+00 TO STA 58+50
26	STORM SEWER IMPROVEMENTS STA 58+50 TO STA 64+00
27	STORM SEWER IMPROVEMENTS STA 64+00 TO STA 67+90.06
28	STORM SEWER IMPROVEMENTS OSUNA RD STA 1+00 TO STA 3+00
29	STORM SEWER IMPROVEMENTS GUTIERREZ RD AND LAS CAMAS RD
30	SANITARY SEWER LOCATION MAP
31	SANITARY SEWER IMPROVEMENTS STA 53+00 TO STA 58+50
32	SANITARY SEWER IMPROVEMENTS STA 58+50 TO STA 64+00
33	SANITARY SEWER IMPROVEMENTS GUTIERREZ RD AND LAS CAMAS RD
34	MISCELLANEOUS DETAILS
35	MISCELLANEOUS DETAILS
36	RCP SEWER MANHOLE BASES FOR MAINS 36" DIA. & SMALLER
37	RCP SEWER MANHOLE BASES FOR MAINS 42" DIA. & LARGER
38	RCP SPECIAL SECTION DETAILS

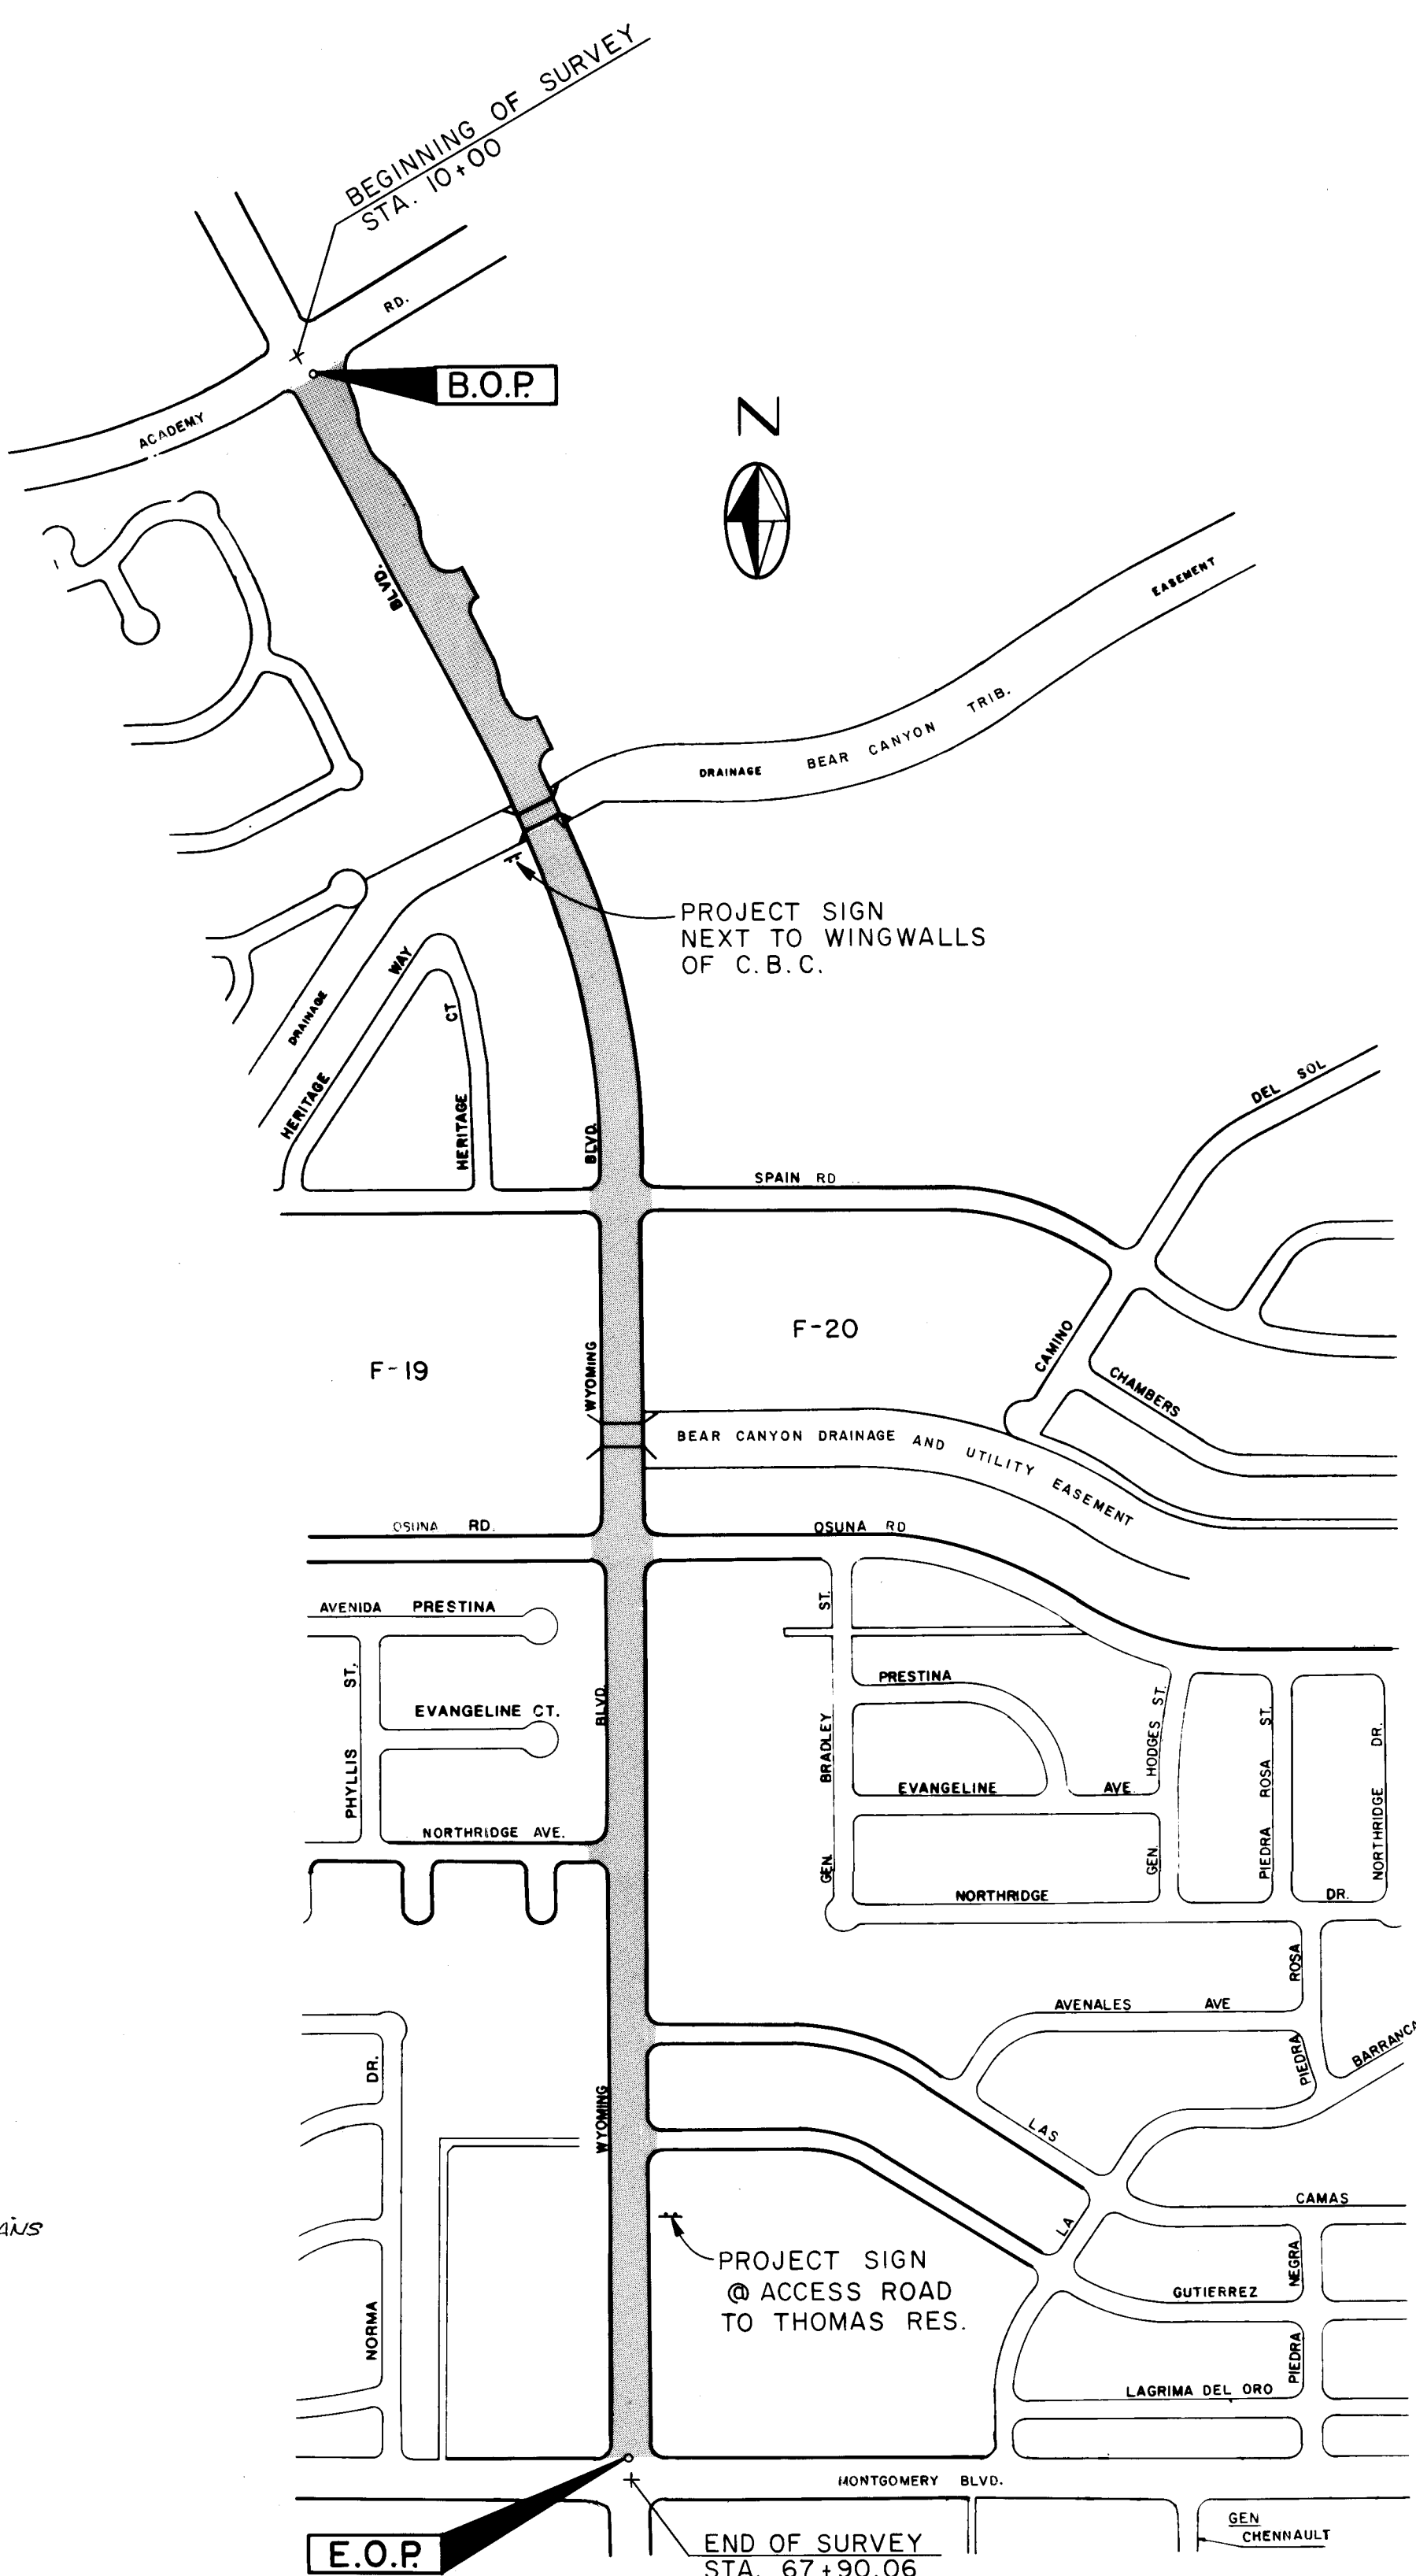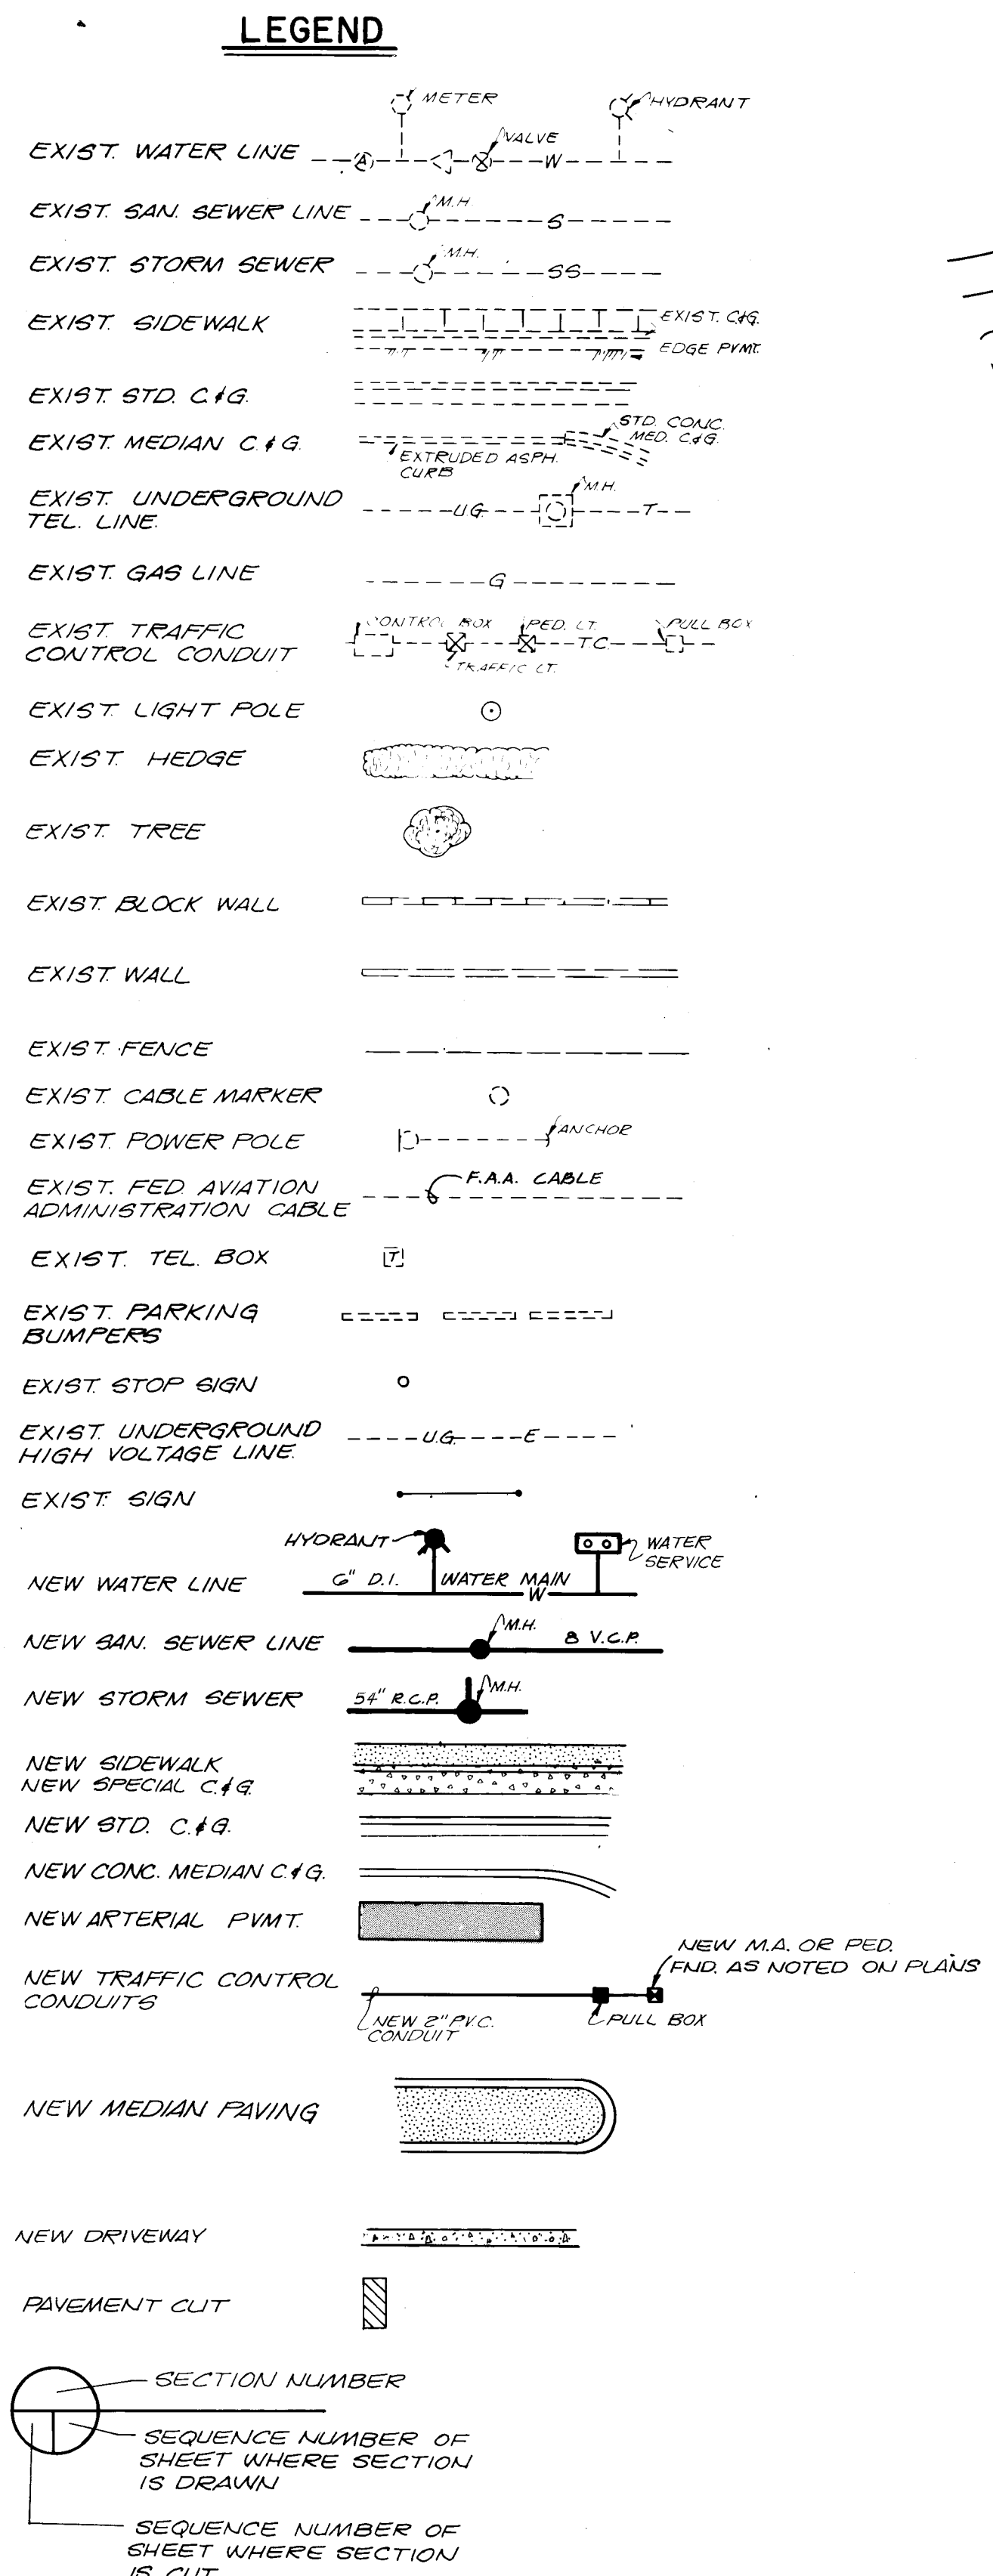

VICINITY MAP

1 2 3 4 5 6 7 8 9 10 11 12
26 16370287


GENERAL NOTES

- ALL CONSTRUCTION SHALL COMPLY WITH THE NEW MEXICO STANDARD SPECIFICATIONS FOR PUBLIC WORKS CONSTRUCTION, 1979 EDITION, EXCEPT AS AMENDED BY THE CONTRACT DOCUMENTS FOR THIS PROJECT.
 - THE CONTRACTOR SHALL NOTIFY THE UTILITY COMPANIES BY CALLING 765-1234, 48 HOURS BEFORE COMMENCING WORK IN THE AREAS NEAR UNDERGROUND UTILITY LINES. CONTRACTOR SHALL NOT INTERFERE WITH UTILITY LINE OPERATION AND SHALL COORDINATE ALL WORK AFFECTING EXISTING UTILITIES WITH THE APPROPRIATE AUTHORITY FOR EACH UTILITY. THE ENGINEER SHALL BE PROMPTLY NOTIFIED OF ANY PROBLEMS OR CONFLICTS ENCOUNTERED.
 - A MOUNTAIN BELL TELEPHONE REPRESENTATIVE MUST BE PRESENT AT ALL TIMES THAT CONSTRUCTION OCCURS OVER, AROUND OR UNDER THE FAA CABLE ON WYOMING BOULEVARD.
 - A DISPOSAL SITE APPROVED BY THE PROJECT ENGINEER, FOR ALL EXCESS EXCAVATION MATERIAL, ASPHALTIC PAVING, CONCRETE PAVING, ETC., SHALL BE OBTAINED BY THE CONTRACTOR IN COMPLIANCE WITH APPLICABLE REGULATIONS. ALL COSTS INCURRED IN OBTAINING A DISPOSAL SITE AND IN HAUL THERETO SHALL BE CONSIDERED INCIDENTAL TO "THE CONTRACT" AND NO SEPARATE PAYMENT WILL BE MADE THEREFOR.
 - THE CONTRACTOR WILL BE REQUIRED TO CONFINE HIS WORK WITHIN THE CONSTRUCTION LIMITS AND/OR RIGHT-OF-WAY TO PRESERVE EXISTING VEGETATION AND PRIVATE PROPERTY.
 - ALL WORK ON THIS PROJECT SHALL BE PERFORMED IN ACCORDANCE WITH APPLICABLE FEDERAL, STATE, AND LOCAL LAWS, RULES, AND REGULATIONS CONCERNING CONSTRUCTION SAFETY AND HEALTH.
 - WHERE REMOVAL OF EXISTING CURBS AND GUTTER, SIDEWALK OR PAVEMENT IS REQUIRED, CONTRACTOR SHALL SAWCUT AND/OR REMOVE TO THE NEAREST JOINT. CURB AND GUTTER SHOWN AS EXISTING AND NOT TO BE REMOVED UNDER THIS CONTRACT, WHICH IS DAMAGED OR DISPLACED BY THE CONTRACTOR, SHALL BE REMOVED AND REPLACED BY THE CONTRACTOR AT THE CONTRACTOR'S EXPENSE.
 - AFTER THE CONTRACTOR HAS REMOVED THE EXISTING EXTRUDED ASPHALT CURBS AND TEMPORARY MEDIAN NOSES, THE PROJECT ENGINEER SHALL DETERMINE THE LINES ALONG WHICH TO CUT THE EXISTING ASPHALT PAVEMENT TO MAKE NEAT CLEAN MATCHLINES WITH THE NEW PAVING WITHOUT UNDUE REMOVAL OF EXISTING SERVICEABLE SURFACING. EXISTING CRACKED, BROKEN OR OTHERWISE DAMAGED SURFACING SHALL BE REMOVED. NO PAYMENT SHALL BE MADE FOR REMOVAL AND REPLACEMENT OF PAVEMENT DAMAGED BY THE CONTRACTOR'S OPERATIONS.
 - ASPHALTIC CONCRETE LEVELING COURSE SHALL BE PLACED IN AREAS DESIGNATED BY THE PROJECT ENGINEER AND SHALL BE MEASURED AND PAID FOR BY THE TON UNDER THE APPROPRIATE ITEM(S) LISTED IN THE BID PROPOSAL.
 - ALL DIMENSIONS AND RADII OF CURB AND CURB RETURNS ARE SHOWN TO FACE OF CURB.
 - THE PROJECT ENGINEER WILL GIVE NOTICE TO PROPERTY OWNERS WHO HAVE STRUCTURES OR LANDSCAPING WITHIN THE STREET RIGHTS-OF-WAY AND IN THE WAY OF THE NEW CONSTRUCTION THAT SUCH FEATURES MUST BE REMOVED BY THE PROPERTY OWNERS IF THEY WISH TO SAVE THEM.

IF SUCH FEATURES ARE STILL PRESENT WHEN THE CONTRACTOR IS READY TO START WORK IN AN AREA, HE MAY PROCEED TO REMOVE THEM AS REQUIRED FOR THE NEW CONSTRUCTION, BUT SHALL TAKE CARE NOT TO CAUSE MORE DAMAGE THAN NECESSARY, AND SHALL IN NO CASE ENTER ONTO PRIVATE PROPERTY WITHOUT PERMISSION.

THE CONTRACTOR WILL NOT BE REQUIRED TO REPAIR OR REPLACE SUCH STRUCTURES, TREES OR PLANTS THAT ARE NOT INDICATED ON THE PLANS TO BE PROTECTED AND SAVED, BUT SHALL LEAVE THE AREA IN A NEAT CONDITION BY CLEANING UP, GRADING, AND RAKING AS DIRECTED BY THE ENGINEER. LANDSCAPING GRAVEL SHALL BE SAVED AND RAKED BACK INTO THE AREAS IT CAME FROM.
 - EXISTING MANHOLE FRAMES AND COVERS ENCOUNTERED WITHIN THE AREAS OF WIDENING SHALL BE ADJUSTED TO GRADE AS PER CITY OF ALBUQUERQUE STD. DWG. P-24 AND CASH PAVING DOCUMENT NO. 31.
 - ALL SEWER SERVICE CONNECTIONS WILL MEET MUNICIPAL STANDARDS FOR CLEARANCES WITH OTHER PIPES AND FOR SLOPES TO SEWER MAINS.
 - SEWER AND WATER LINE CONNECTIONS, INCLUDING SERVICE CONNECTIONS, SHOULD BE DONE BEFORE PAVING AND MEDIAN WORK.
 - EXISTING WATER LINES SHALL BE TAPPED AND SERVICES INSTALLED AT THE STATIONS AND LOCATIONS INDICATED.
 - ALL STATIONING IS BASED ON CONSTRUCTION BASELINE DATA.
 - EXISTING WATER VALVE BOXES ENCOUNTERED WITHIN THE AREAS OF WIDENING SHALL BE ADJUSTED TO GRADE AS PER CITY OF ALBUQUERQUE STD. DWG. W-6, AND CASH PAVING DOCUMENT NO. 31.
 - 3/4" WATER SERVICES TO MEDIANS SHALL BE CONSTRUCTED AS PER CITY OF ALBUQUERQUE STD. DWG. W-10-1 AND CASH PAVING DOCUMENT NO. 31 EXCEPT THAT STREET CONSTRUCTION DETAILS SHOULD REFER TO MEDIAN CONSTRUCTION AND TAILPIECE SHALL EXTEND INTO EARTH MEDIAN.
 - WHERE RELOCATION OF EXISTING 2" WATER SERVICES TO MEDIANS ARE INDICATED, THE SERVICE LINE SHALL BE EXTENDED AS SHOWN ON THE PLANS. THE CONTRACTOR SHALL CONSTRUCT NEW WOODEN METER BOXES, BUT MAY REUSE THE EXISTING METER BOX COVERS AND THE 2" CURB STOPS. NO METERS OR TAILPIECES WILL BE REQUIRED.
 - WHERE REMOVAL AND RELAYING OF EXISTING FIRE HYDRANTS, VALVES, AND FITTINGS ARE CALLED FOR ON THE PLANS, THE CONTRACTOR SHALL ARRANGE TO HAVE THESE ITEMS INSPECTED BY THE WATER RESOURCES DEPT. UPON REMOVAL. IF AN ITEM IS FOUND TO BE UNSUITABLE FOR RELAYING, THE WATER RESOURCES DEPT. WILL FURNISH A NEW OR REBUILT ITEM AND THE CONTRACTOR SHALL INSTALL THE EXCHANGED ITEM.
- TRAFFIC CONTROL**
- THE CONTRACTOR SHALL MAINTAIN ACCESS TO BUSINESSES AND RESIDENCES ADJACENT TO THE CONSTRUCTION AREA EXCEPT DURING ACTUAL PAVING OPERATIONS. CONSTRUCTION EQUIPMENT AND MATERIALS SHALL NOT BE STORED WITHIN THE ROADWAY OR ON THE MEDIAN DURING NON-WORK HOURS.
 - THE CONTRACTOR SHALL COORDINATE ALL WORK RELATING TO THE CITY TRAFFIC SIGNAL SYSTEM WITH THE TRAFFIC ENGINEERING DIVISION.
 - THE CONTRACTOR SHALL PROVIDE AND MAINTAIN A SAFE AND ADEQUATE MEANS OF CHANNELING PEDESTRIAN TRAFFIC AROUND ALL WORK AREAS THROUGHOUT THE PERIOD OF CONSTRUCTION. ALL SUCH CHANNELIZATION SHALL BE ARRANGED TO PREVENT PEDESTRIANS FROM HAVING TO ENTER THE ROADWAY IN ORDER TO PASS AROUND THE WORK AREAS AND SHALL BE PROVIDED AT NO ADDITIONAL COST TO THE OWNER.
 - THE CITY TRAFFIC ENGINEERING DIVISION WILL REMOVE AND REPLACE ALL PERMANENT TRAFFIC CONTROL SIGNS AS REQUIRED. THE CONTRACTOR SHALL GIVE NOTICE 3 DAYS IN ADVANCE WHEN SUCH SIGNS ARE REQUIRED TO BE REMOVED, AND SHALL INSTALL BOX-OUTS AND SLEEVES FOR THE INSTALLATION OF PERMANENT SIGNS WHEN SUCH ARE REQUESTED THROUGH THE PROJECT ENGINEER.
 - PERMANENT PAVEMENT MARKINGS WILL BE CONSTRUCTED BY CITY OF ALBUQUERQUE, TRAFFIC DIVISION.

RECORD DRAWING
DATE: 2-24-84 BY: M-C FROM: CITY OF ALBUQUERQUE
MARK-UP

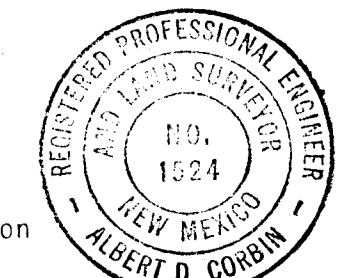

MOLZEN-CORBIN & ASSOCIATES
CONSULTING ENGINEERS
ALBUQUERQUE, CARLSBAD - NEW MEXICO

APPROVED FOR
CONSTRUCTION
CITY ENGINEER DATE

CITY OF ALBUQUERQUE					
TRANSPORTATION DEPARTMENT					
TITLE: WYOMING BLVD N.E. WIDENING VICINITY MAP LEGEND AND GENERAL NOTES					
APPROVALS	ENGINEER	DATE	APPROVALS	ENGINEER	DATE
City Engineer			Liquid Waste		
A.C.E. - Design			Traffic		
A.C.E. - Hydrology			Water		
DRAWING NO. 1637			MAP NO. F 19 & 20		
SHEET 2			OF 38		

SUMMARY OF QUANTITIES

STREET IMPROVEMENTS			
BID ITEM NO.	DESCRIPTION	ESTIMATED QUANTITY	FINAL QUANTITY
238	PORTLAND CEMENT REINF. CONC. FOR HEADWALLS, RETAINING WALLS, AND GENERAL USAGE, IN PLACE, PER CY	2	14,400
301	6" DUCTILE IRON PIPE, COMPLETE IN PLACE, PER LF	40	42
302	REMOVE AND RELAY EXISTING 2-1/4" THRU 14" PIPE, PER LF	20	0
303	REMOVE AND DISPOSE OF 2-1/4" THRU 14" PIPE, PER LF	20	42
306	NON-PRESSURIZED CONNECTION TO EXISTING WATER LINES, PER EACH	4	3
307	INSERTION ONLY (COST OF FITTINGS NOT INCLUDED) OF CI MJ FITTINGS INTO EXISTING WATER MAINS 4" THRU 8", PER LB	450	460
308	REMOVE AND RELAY EXISTING CI FITTINGS 2-1/4" THRU 36", PER LB	250	250
309	CI FITTINGS, MJ, 4" THRU 14", CLASS 250, WITH ALL JOINTING MATERIAL, IN PLACE, PER LB	450	150
310	CI CAPS, 4" OR 6", IN PLACE, PER EACH	1	1
311	6" GATE VALVES, COMPLETE IN PLACE, PER EACH	1	1
312	8" GATE VALVES, COMPLETE IN PLACE, PER EACH	2	2
315	REMOVE AND RETURN EXISTING VALVES, 4"-10", PER EACH	1	1
316	VALVE BOXES, IN PLACE, TYPE A, PER EACH	3	2
317	REMOVE AND RETURN VALVE BOX ONLY, PER EACH	1	1
318	FIRE HYDRANT EXTENSION, 6" OR 12" LENGTH, PER EACH	2	2
319	REMOVE AND RELAY EXISTING FIRE HYDRANT, PER EACH	3	3
320	EXPOSE WATER MAIN TO CLOSE CORP. STOP, BACKFILL, AND COMPACTION, COMPLETE. REMOVE & RETURN METER BOX COVERS, PER EACH	2	2
321	RELOCATE 2" WATER SERVICE TO MEDIAN, COMPLETE IN PLACE, PER EACH (2" CURB STOP AND BOX COVER; CONTRACTOR SHALL FURNISH NEW WOOD BOX)	4	4
322	2" COPPER TUBING, TYPE K, IN PLACE, PER LF	150	142
323	NEW SERVICE LINE, 3/4", SINGLE SERVICE CONNECTION, COMPLETE WITH LABOR AND MATERIALS, AS PER STANDARD DETAILS, PER EACH	5	5
324	BLOCKING FOR WATER PIPE, PORTLAND CEMENT PLAIN CONCRETE, IN PLACE, PER CY	3	2.9
401	GRADING FOR LESS THAN 2' EXCAVATION, PER SY	14,600	14,400
402	MEDIAN GRADING, PER SY	2,600	2,514
403	CUTTING, REMOVAL, AND DISPOSAL OF EXISTING ASPHALTIC CONC. PAVING, WHERE SAWCUTTING IS REQUIRED, PER SY	2,100	2,180
404	CUTTING, REMOVAL, AND DISPOSAL OF EXISTING CONC. PAVING, PER SY	41	28
405	REMOVAL AND DISPOSAL OF EXISTING ASPHALTIC CONC. CURB, PER LF	9,000	8,769
406	REMOVAL AND DISPOSAL OF EXISTING PORTLAND CEMENT CONC. CURB & GUTTER, PER LF	2,760	2,819
407	CUTTING, REMOVAL, AND DISPOSAL OF EXISTING SIDE- WALK AND DRIVEPADS, PER SY	1,370	1,339
409	PROCESS AND COMPACT EXISTING MATERIAL THAT HAS A SOIL BEARING VALUE OF 20 OR MORE, 6" THICK, COMPLETE IN PLACE, PER SY	14,600	14,400
410	CEMENT TREATED BASE COURSE, 6" THICK, CENTRAL PLANT MIXED, COMPLETE IN PLACE, PER SY	14,100	14,400
411	ASPHALTIC CONC. BASE COURSE, 2-1/2" THICK, 1500 LB. STABILITY, MACHINE LAYDOWN, PER SY	15,400	14,400
412	EMULSIFIED ASPHALT TACK COAT, COMPLETE IN PLACE, PER SY	15,400	14,400
414	ASPHALTIC CONC. SURFACE COURSE, 1-1/2" THICK, 1800 LB. STABILITY, MACHINE LAYDOWN, PER SY	15,400	14,400
415	IMPRESSED PATTERN COLORED CONCRETE MEDIAN PAVING, 4" THICK, COMPLETE IN PLACE, PER SF	8,850	12,937
416	PORTLAND CEMENT CONC. SIDEWALK, 4" THICK, COMPLETE IN PLACE, PER SF	9,250	9,418
417	PORTLAND CEMENT CONC. DRIVEPAD, 6" THICK, COMPLETE IN PLACE, PER SF	550	537
418	PORTLAND CEMENT CONC. SPECIAL CURB AND GUTTER, COMPLETE IN PLACE, INCLUDING SUBGRADE PREP., PER LF	1,200	1,158
419	PORTLAND CEMENT CONC. STANDARD CURB & GUTTER, COMPLETE IN PLACE, INCLUDING SUBGRADE PREP., PER LF	370	93
420	PORTLAND CEMENT CONC. MEDIAN CURB & GUTTER, COMPLETE IN PLACE, INCLUDING SUBGRADE PREP., PER LF	9,550	9,555

STREET IMPROVEMENTS (CONT.)			
BID ITEM NO.	DESCRIPTION	ESTIMATED QUANTITY	FINAL QUANTITY
421	ADJUSTING MH FRAMES TO GRADE WITH MASONRY CON- STRUCTION (OVER 2"), PER EACH	5	5
422	REMOVAL AND RECONSTRUCTION OF EXISTING SEWER MH, PER VERTICAL FOOT	20	17
423	ADJUSTING WATER VALVE BOXES TO GRADE, PER EACH	9	17
424	REMOVAL AND DISPOSAL OF EXISTING TRAFFIC SIGNAL FOUNDATION, ANY TYPE, PER CY	6	8.2
425	TRAFFIC SIGNAL FOUNDATION, MAST ARM (MA) BASE, COMPLETE IN PLACE, PER EACH	2	2
426	TRAFFIC SIGNAL FOUNDATION FOR PEDESTAL (SP) TYPE I, COMPLETE IN PLACE, PER EACH	4	4
427	RELOCATE EXISTING TRAFFIC SIGNAL PULLBOX, COMPLETE IN PLACE, PER EACH	8	8
428	TRAFFIC SIGNAL PULLBOX, COMPLETE IN PLACE, PER EACH	16	16
429	TRAFFIC SIGNAL ELECTRICAL CONDUIT, 2" RIGID, COMPLETE IN PLACE, INCLUDING CONNECTIONS TO EXISTING CONDUIT, IF REQUIRED, PER LF	2,650	2,506
430	TRAFFIC SIGNAL ELECTRICAL CONDUIT, 1" PVCP, COMPLETE IN PLACE, INCLUDING CONNECTIONS TO EXISTING CONDUIT, IF REQUIRED, PER LF	650	717
431	TRAFFIC SIGNAL MANHOLE, COMPLETE IN PLACE, AS PER STANDARD DETAIL, PER EACH	2	2
432	MAINTAIN TRAFFIC, COMPLETE AS SHOWN IN TRAFFIC CONTROL PLAN, L.S.	1	1
433	ASPHALTIC CONCRETE LEVELLING COURSE, 1800 LBS. STABILITY, IN PLACE, PER TON	100	47
434	Heat, scarify, and releve existing asphalt surface, per SY	13,500	12,737
435	Asphalt rejuvenating agent, per GAL	1,015	0
436	5/8" plant mix seal, per SY	51,300	50,632
501	Arterial paving removal and replacement, as per standard detail DWG. P-25, without machine laydown, where existing subbase material can be processed and compacted, in place, per SY	150	133

SANITARY SEWER IMPROVEMENTS			
BID ITEM NO.	DESCRIPTION	ESTIMATED QUANTITY	FINAL QUANTITY
103	8" EXTRA STRENGTH VCP, COMPLETE IN PLACE, IN TRENCH, PER LF	150	150
104	10" EXTRA STRENGTH VCP, COMPLETE IN PLACE, IN TRENCH, PER LF	280	280
108	TRENCHING, BACKFILLING, AND COMPACTION FOR 6" TO 15" PIPE, 14'-18' TRENCH DEPTH, PER LF	430	430
117	EXTRA PAY FOR REMOVAL OF 8" AND UNDER SANITARY SEWER LINES, TRENCHING NOT INCLUDED, PER LF	430	310
119	PUMPING SEWAGE BETWEEN MH'S BECAUSE OF SANITARY SEWER LINE REPLACEMENT OR REPAIR, PER HOUR OF PUMP OPERATION	120	40.6
121	CUT AND PATCH TO CONNECT NEW 8" OR 10" SANITARY SEWER LINE INTO EXISTING MANHOLE, INCLUDING RE- WORKING INVERT GROUT FILL AS REQUIRED, PER EACH	3	3
122	CONCRETE ENCASEMENT FOR SANITARY SEWER LINES (STD. DWG. S-10), PER LF	42	42
432	MAINTAIN TRAFFIC, COMPLETE AS SHOWN IN TRAFFIC CONTROL PLAN, L.S.	1	1
501	ARTERIAL PAVING REMOVAL AND REPLACEMENT, AS PER STANDARD DETAIL DWG. P-25, WITHOUT MACHINE LAY- DOWN, WHERE EXISTING SUBBASE MATERIAL CAN BE PROCESSED AND COMPACTED, IN PLACE, PER SY	150	131

WATER IMPROVEMENTS			
BID ITEM NO.	DESCRIPTION	ESTIMATED QUANTITY	FINAL QUANTITY
109	TRENCHING, BACKFILLING, AND COMPACTION FOR 18" TO 36" PIPE, LESS THAN 8' TRENCH DEPTH, PER LF	179	179
112	4' DIA., TYPE "C" OR "D" MH, LESS THAN 6' DEPTH, IN PLACE, PER EACH	1	2
203	24" RCP, CLASS III, COMPLETE IN PLACE, IN TRENCH, PER LF	15	15
204	27" RCP, CLASS III, COMPLETE IN PLACE, IN TRENCH, PER LF	164	164
212	PRECAST CONCRETE PLUG FOR 24" RCP, COMPLETE IN PLACE, PER EACH	1	1
232	TYPE "D" CATCH BASIN, DOUBLE GRATE, COMPLETE IN PLACE, PER EACH	1	1
301	6" DUCTILE IRON PIPE, COMPLETE IN PLACE, PER LF	110	115
304	EXTRA PAY FOR 6' TO 8' TRENCH DEPTH FOR 4" THRU 14" PIPE, PER LF	20	0
305	EXTRA PAY FOR 8' TO 14' TRENCH DEPTH FOR 4" THRU 14" PIPE, PER LF	20	0
306	NON-PRESSURIZED CONNECTION TO EXISTING WATER LINES, PER EACH	3	2
307	INSERTION ONLY (COST OF FITTINGS NOT INCLUDED) OF CI MJ FITTINGS INTO EXISTING WATER MAINS 4" THRU 8", PER LB	600	130
309	CI FITTINGS, MJ, 4" THRU 14", CLASS 250, WITH ALL JOINTING MATERIAL, IN PLACE, PER LB	600	0
313	AIR RELEASE VALVE BOX ONLY, INCLUDING BOX COVER & LID, AND OTHER MATERIALS, AS PER STANDARD DETAILS, COMPLETE IN PLACE, PER EACH	1	1
314	REMOVE AND RELAY EXISTING 2-1/4" THRU 12" GATE VALVES, PER EACH	1	1
316	VALVE BOXES, IN PLACE, TYPE A, PER EACH	1	1
317	REMOVE AND RETURN VALVE BOX ONLY, PER EACH	1	1
324	BLOCKING FOR WATER PIPE, PORTLAND CEMENT PLAIN CONCRETE, IN PLACE, PER CY	1	0.6
406	REMOVAL & DISPOSAL OF EXISTING PORTLAND CEMENT CONC. CURB & GUTTER, PER LF	40	6
407	CUTTING, REMOVAL, & DISPOSAL OF EXISTING SIDE- WALK AND DRIVEPADS, PER SY	30	30
417	PORTLAND CEMENT CONC. DRIVEPAD, 6" THICK, COMPLETE IN PLACE, PER SF	270	244
419	PORTLAND CEMENT CONC. STANDARD CURB & GUTTER, COMPLETE IN PLACE, INCLUDING SUBGRADE PREP., PER LF	40	6
432	MAINTAIN TRAFFIC, COMPLETE AS SHOWN IN TRAFFIC CONTROL PLAN, L.S.	1	1
501	ARTERIAL PAVING REMOVAL AND REPLACEMENT, AS PER STANDARD DETAIL DWG. P-25, WITHOUT MACHINE LAY- DOWN, WHERE EXISTING SUBBASE MATERIAL CAN BE PROCESSED AND COMPACTED, IN PLACE, PER SY	150	133

MOLZEN-CORBIN & ASSOCIATES
CONSULTING ENGINEERS
ALBUQUERQUE, CARLSBAD - NEW MEXICO

APPROVED FOR
CONSTRUCTION


CITY ENGINEER DATE

RECORD DRAWING		
DATE: 8-24-84	BY: M-C	FROM: CIVILS MARK-UPS

These record drawings have been prepared, on the basis of information compiled and furnished by the city engineers office. The consulting engineer will not be responsible for any errors or omissions which have been incorporated into this document as a result.

1 2 3 4 5 6 7 8 9 10 11 12
26 16 37 03 87

CITY OF ALBUQUERQUE					
TRANSPORTATION DEPARTMENT					
TITLE: WYOMING BLVD. N.E. WIDENING					
SUMMARY OF QUANTITIES					
APPROVALS	ENGINEER	DATE	APPROVALS	ENGINEER	DATE
City Engineer			Liquid Waste		
A.C.E.-Design			Traffic		
A.C.E.-Hydrology			Water		
DRAWING NO.	1637	MAP NO. F-19420	SHEET 3	OF 38	

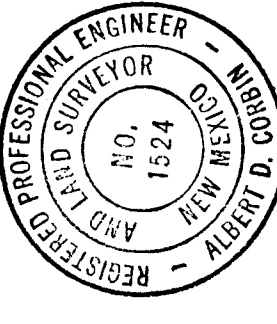AS BUILT INFORMATION		BENCH MARKS		SURVEY INFORMATION		ENGINEER'S SEAL	
CONTRACTOR		WORK BY		FIELD NOTES			
DATE		DATE		BY			
DATE		DATE		NO.			
DATE		DATE		REMARKS			
DATE		DATE		REVISIONS		DESIGNED BY AB DRAWN BY GGA CHECKED BY gfc-g 10-82 DATE 4-82 10-82 DATE 4-82	
DATE		DATE		NO.			
DATE		DATE		DATE			
DATE		DATE		DATE			

RECORD DRAWING

DATE: 11-1-82 BY: M-C FROM: CITY ENGINEER'S OFFICE

These record drawings have been prepared, on the basis of information compiled and furnished by the city engineers office. The consulting engineer will not be responsible for any errors or omissions which have been incorporated into this document as a result.

1	2	3	4	5	6	7	8	9	10	11	12

SCALE: 1" = 400'

NOTE: ALL OF THE SIGNS SHOWN WILL NOT BE IN PLACE FOR THE ENTIRE PROJECT. SIGNS SHALL BE PLACED AND REMOVED AS REQUIRED BY THE PHASES ACTUALLY UNDER CONSTRUCTION.

DETAILS 1 & 2

SEQUENCE OF CONSTRUCTION

THE CONTRACTOR SHALL DIVIDE THE PROJECT INTO WORK AREAS APPROXIMATELY AS SET FORTH BELOW. HE CAN WORK IN MORE THAN ONE AREA AT A TIME. HOWEVER, THE WORK SHALL BE SCHEDULED SUCH THAT WORK AREAS REQUIRING BARRICADING THAT WILL CAUSE SEVERE TRAFFIC RESTRICTION ARE KEPT AT LEAST 1000 FEET APART. A WORK SECTION MAY BE RESTRICTED AT ONE TIME TO TRAFFIC, AND THEN RESTRICTED AGAIN FOR WORK REQUIRED IN THE OUTSIDE LANES.

B.O.P. TO BEAR CANYON TRIBUTARY
BEAR CANYON TRIBUTARY TO SPAIN RD.
SPAIN RD. TO BEAR CANYON
BEAR CANYON TO OSUNA RD.
OSUNA RD. INTX.
OSUNA RD. TO NORTHRIDGE AVE.
NORTHRIDGE AVE. TO LAS CAMAS RD.
LAS CAMAS RD. INTX.
LAS CAMAS RD. TO GUTIERREZ RD.
GUTIERREZ RD. INTX.
GUTIERREZ RD. TO E.O.P. (ALL WORK IN THIS SECTION MUST BE COMPLETED IN 21 DAYS. SEE SECTION 17 OF SPECIAL PROVISIONS.)

THE CONTRACTOR'S CONSTRUCTION SCHEDULE TO BE SUBMITTED IN ACCORDANCE WITH SECTION 2.8 OF THE GENERAL CONDITIONS SHALL BE DETAILED ENOUGH TO INDICATE COMPLIANCE WITH THE ABOVE REQUIREMENTS.

TRAFFIC CONTROL LAYOUTS WILL BE REQUIRED AS FOLLOWS:

1. FOR ALL CONSTRUCTION IN THIS PROJECT.
2. CLOSURE OF THE LAS CAMAS RD. AND GUTIERREZ RD. INTERSECTIONS PERMITTED ONLY WHEN WORKING IN THE INTERSECTIONS NORTHBOUND LANES.
3. FOR MEDIAN & UTILITY CONSTRUCTION WITHIN THE NEW MEDIAN CONSTRUCTION AREAS OF WYOMING BLVD.
4. FOR ALL CONSTRUCTION WHERE TRAFFIC WILL BE CHanneled FROM CURB LANES TO MEDIAN LANES AND BACK.
5. FOR ALL CONSTRUCTION AREAS WHERE COMPLETE CLOSURE OF EITHER NORTHBOUND OR SOUTHBOUND LANES OF WYOMING BLVD. IS REQUIRED.
6. FOR CONSTRUCTION OF SPECIAL CURB & GUTTER WITHIN THE SOUTHBOUND CURB LANE FROM STA. 10+43.28, 81' RT TO STA. 22+00 ±, 46' RT.
7. FOR CONSTRUCTION OF STORM SEWER WITHIN THE NORTHBOUND CURB LANE AT MONTGOMERY BLVD.
8. FOR CONSTRUCTION OF STORM SEWER AT OSUNA RD.
9. WHERE MEDIAN CROSS-OVER IS REQUIRED.

NOTE: IT IS ANTICIPATED SOME ADJUSTMENTS WILL BE REQUIRED TO THE TRAFFIC SIGNING AND BARRICADING SHOWN ON THE DRAWINGS TO MEET ACTUAL FIELD CONDITIONS. THE CONTRACTOR SHALL MAKE SUCH ADJUSTMENTS AT THE DIRECTION OF THE ENGINEER WITHOUT ADDITIONAL COST TO THE OWNER.

TRAFFIC CONTROL NOTES

1. ALL TRAFFIC CONTROL DEVICES SHALL COMPLY WITH CHAPTER VI OF THE LATEST EDITION OF THE NEW MEXICO "MANUAL FOR UNIFORM TRAFFIC CONTROL DEVICES".
2. THE CONTRACTOR SHALL PREPARE AND SUBMIT TO THE PROJECT ENGINEER A DETAILED TRAFFIC CONTROL PLAN WHICH MUST BE APPROVED BY THE CITY TRAFFIC ENGINEER THREE (3) WORKING DAYS IN ADVANCE OF ANY REQUIRED LANE CLOSURES OTHER THAN THOSE SHOWN ON THESE PLANS.
3. ALL SIGNS MUST BE INSTALLED BEFORE CONSTRUCTION BEGINS AS DIRECTED BY THE ENGINEER. SIGN HEIGHTS SHALL BE 7 FEET ABOVE THE SIDEWALK LEVEL, MEASURED FROM BOTTOM OF SIGN, AND SHALL NOT BLOCK SIDEWALK OR FORCE PEDESTRIANS INTO THE STREET.
4. ALL DRUMS MAY HAVE SAND OR WATER BALLAST LIMITED TO 100 LBS.
5. ALL SIGN LOCATIONS WILL BE SELECTED IN THE FIELD AND APPROVED BY THE PROJECT ENGINEER. DISTANCES MAY BE ADJUSTED FOR LOCAL CONDITIONS.
6. ALL SIGNS WILL BE GROUND MOUNTED ON SINGLE OR DOUBLE POSTS. EXISTING POSTS MAY BE USED AT SOME LOCATIONS, WITH THE APPROVAL OF THE PROJECT ENGINEER. PORTABLE SIGN SUPPORTS MAY BE ACCEPTABLE AS AN ALTERNATE.
7. ALL SIGNS WILL BE MOVED FORWARD AS THE CONSTRUCTION PROGRESSES, AS DETERMINED APPROPRIATE BY THE PROJECT ENGINEER.
8. WHEN BARRIERS ARE REQUIRED AFTER DARK, ALL ADVANCE WARNING SIGNS AND ALL BARRICADES SHALL BE EQUIPPED WITH FLASHING WARNING LIGHTS (TYPE A), EXCEPT THAT ALL CHANNELIZING BARRICADES SHALL HAVE STEADY BURNING WARNING LIGHTS (TYPE C).
9. ALL CONSTRUCTION SIGNING SHALL BE BLACK ON A REFLECTORIZED ORANGE FIELD UNLESS OTHERWISE SPECIFIED. ALL CONSTRUCTION BARRICADES AND CHANNELIZATION DEVICES SHALL BE ORANGE ON WHITE, REFLECTORIZED, UNLESS OTHERWISE SPECIFIED.
10. ALL SIGNS WILL BE REMOVED OR COVERED WHEN NOT IN EFFECT.
11. THE TRAFFIC CONTROL PLANS FOR WYOMING ARE BASICALLY SET UP TO PROVIDE 2 LANES OF TRAFFIC SOUTHBOUND AND 1 LANE FOR NORTHBOUND AS A MINIMUM. HOWEVER, THERE WILL BE TIMES WHERE ALL OF THE TRAFFIC WILL BE CONFINED TO ONE SIDE OF THE MEDIAN. DURING THESE TIMES AN ABSOLUTE MINIMUM OF ONE LANE IN EACH DIRECTION MUST BE MAINTAINED. THIS ABSOLUTE MINIMUM IS TO BE KEPT TO AS SHORT A TIME AS POSSIBLE.









BLACK LETTERS ON WHITE REFLECTORIZED BACKGROUND

BLACK LETTERS ON WHITE REFLECTORIZED BACKGROUND

BLACK LETTERS ON WHITE REFLECTORIZED BACKGROUND

NEW MEDIAN CONSTRUCTION
NEW STORM SEWER CONSTRUCTION
NEW SIDEWALK & SPECIAL CURB & GUTTER CONSTRUCTION

* MOUNT ON TYPE III BARRICADES

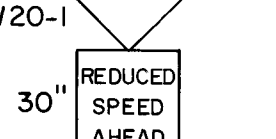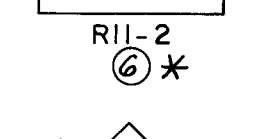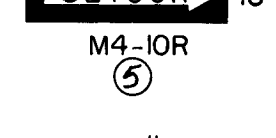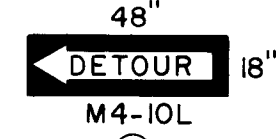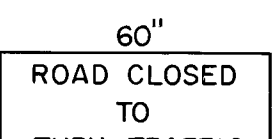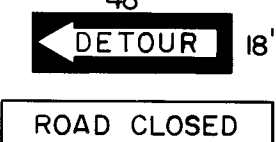
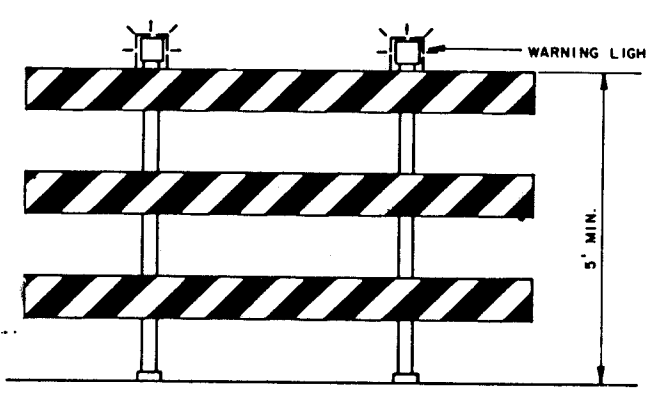
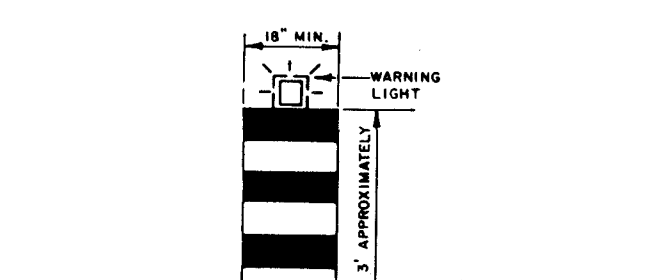


MOLZEN - CORBIN & ASSOCIATES
CONSULTING ENGINEERS
ALBUQUERQUE, CARLSBAD - NEW MEXICO

APPROVED FOR CONSTRUCTION

CITY ENGINEER DATE

CITY OF ALBUQUERQUE					
TRANSPORTATION DEPARTMENT					
TITLE: WYOMING BLVD N.E. WIDENING TRAFFIC CONTROL					
DETAILS 1 & 2 AND NOTES					
APPROVALS	ENGINEER	DATE	APPROVALS	ENGINEER	DATE
City Engineer			Liquid Waste		
A.C.E. - Design			Traffic		
A.C.E. - Hydrology			Water		
DRAWING NO. 1637			MAP NO. SHEET 4 OF 38		

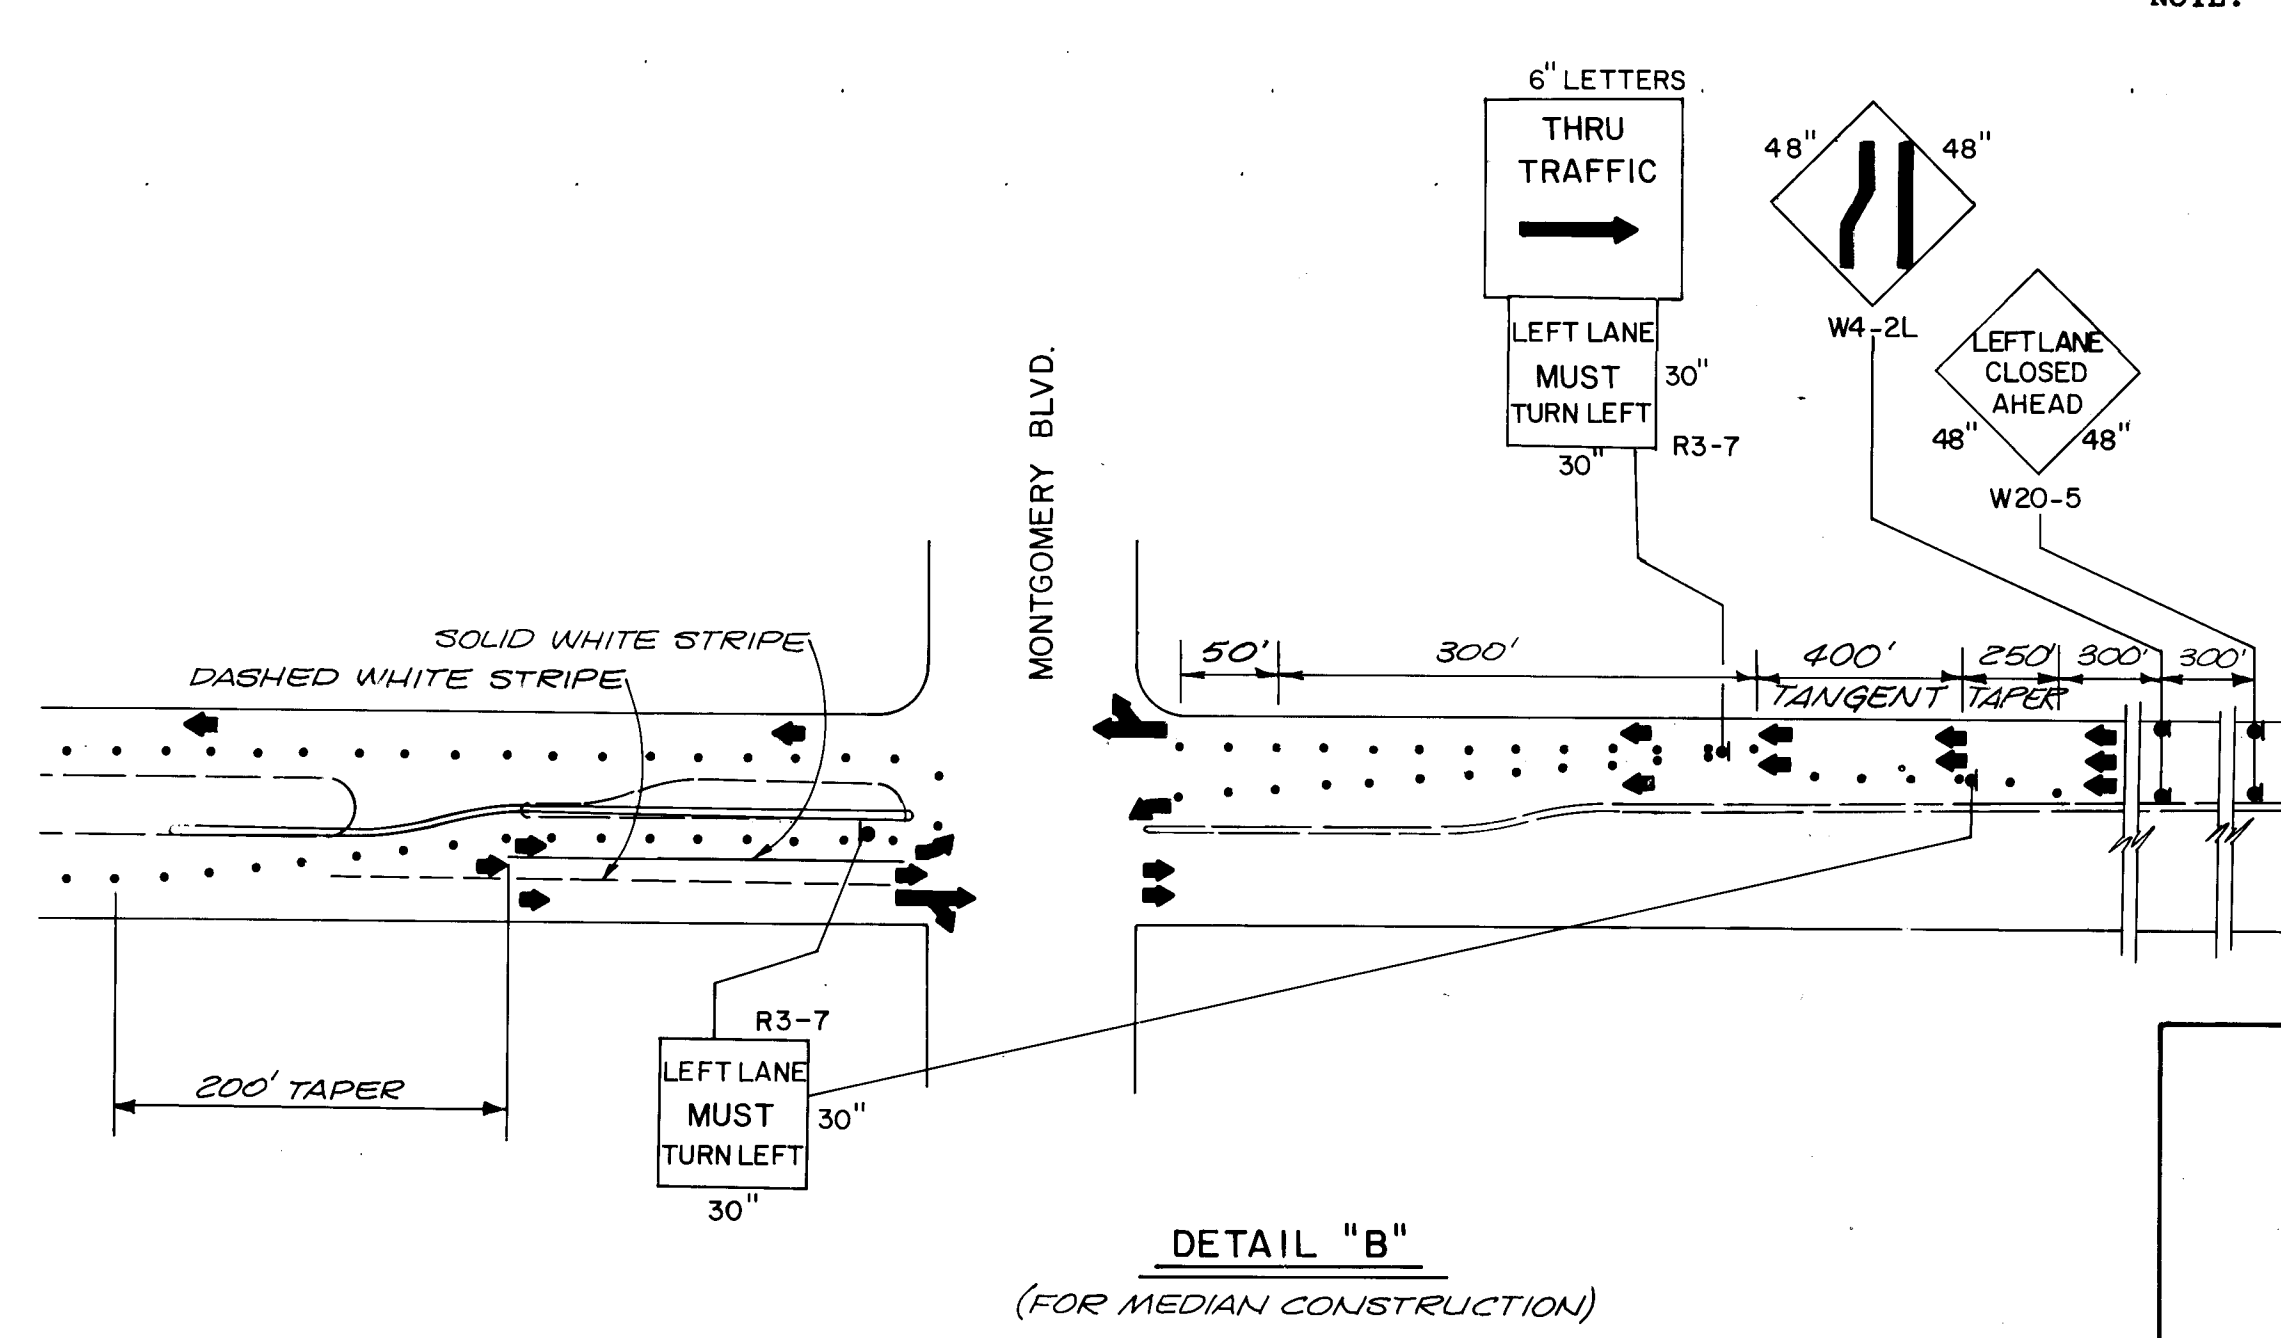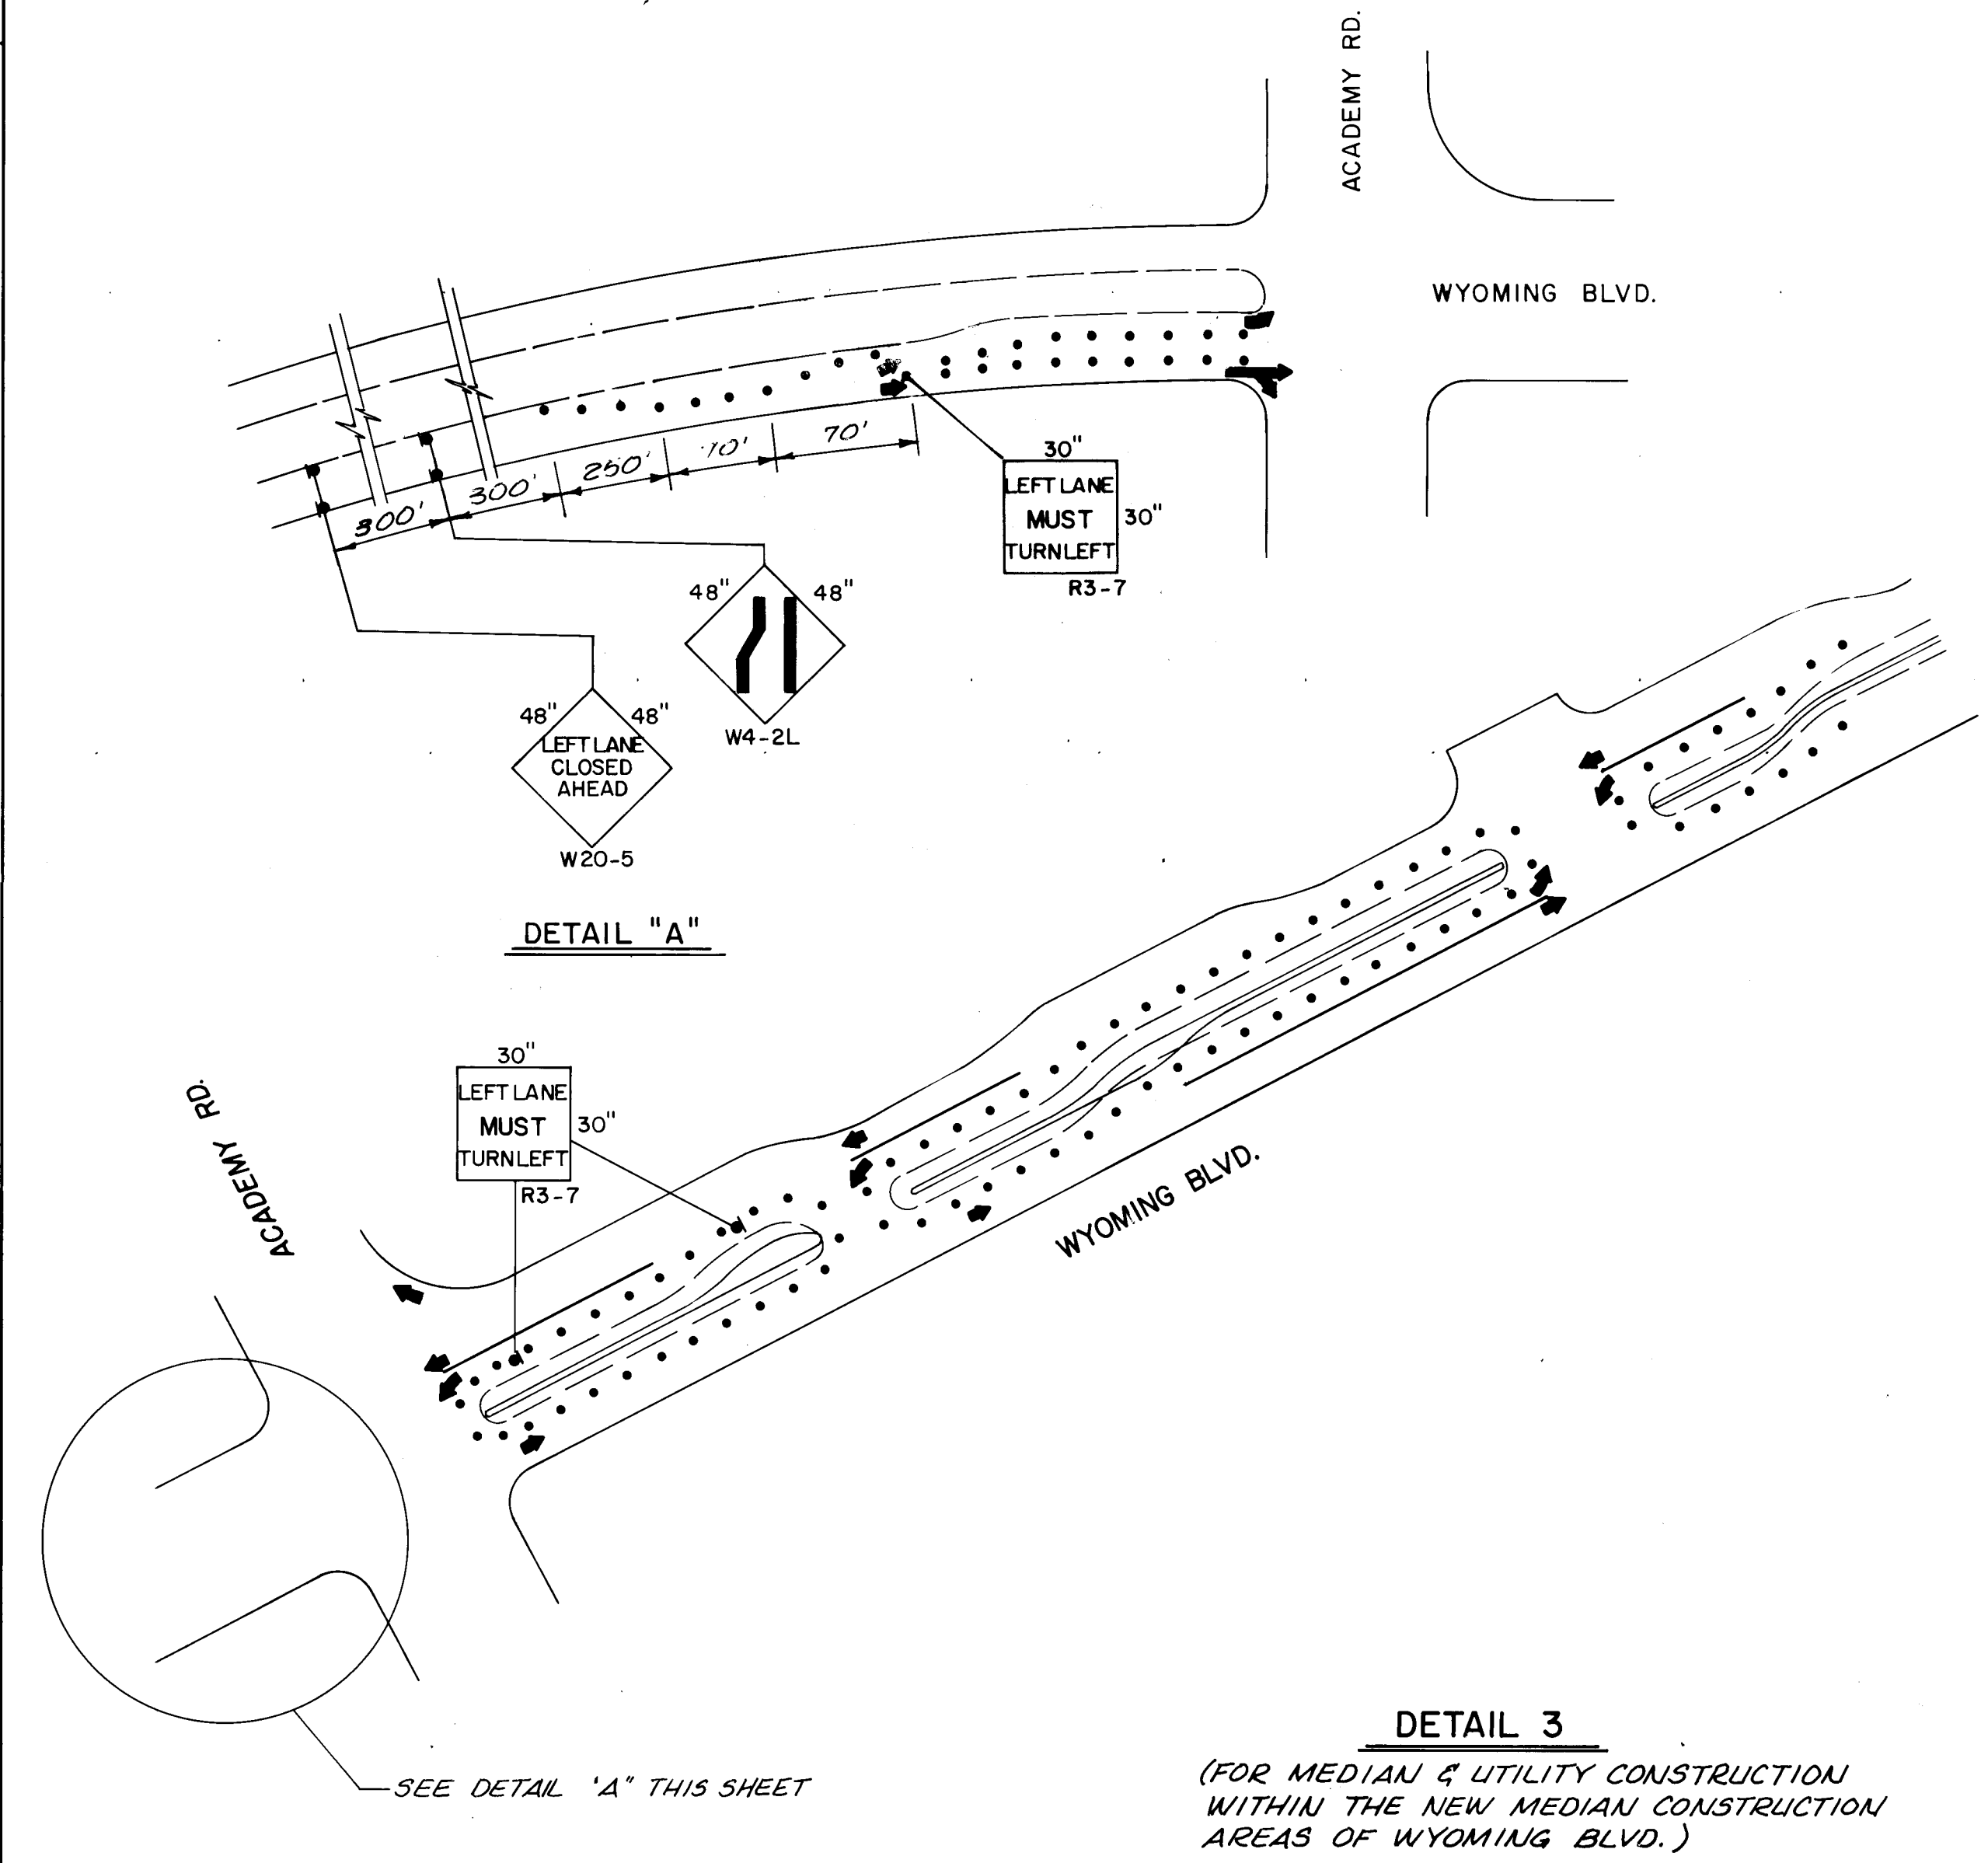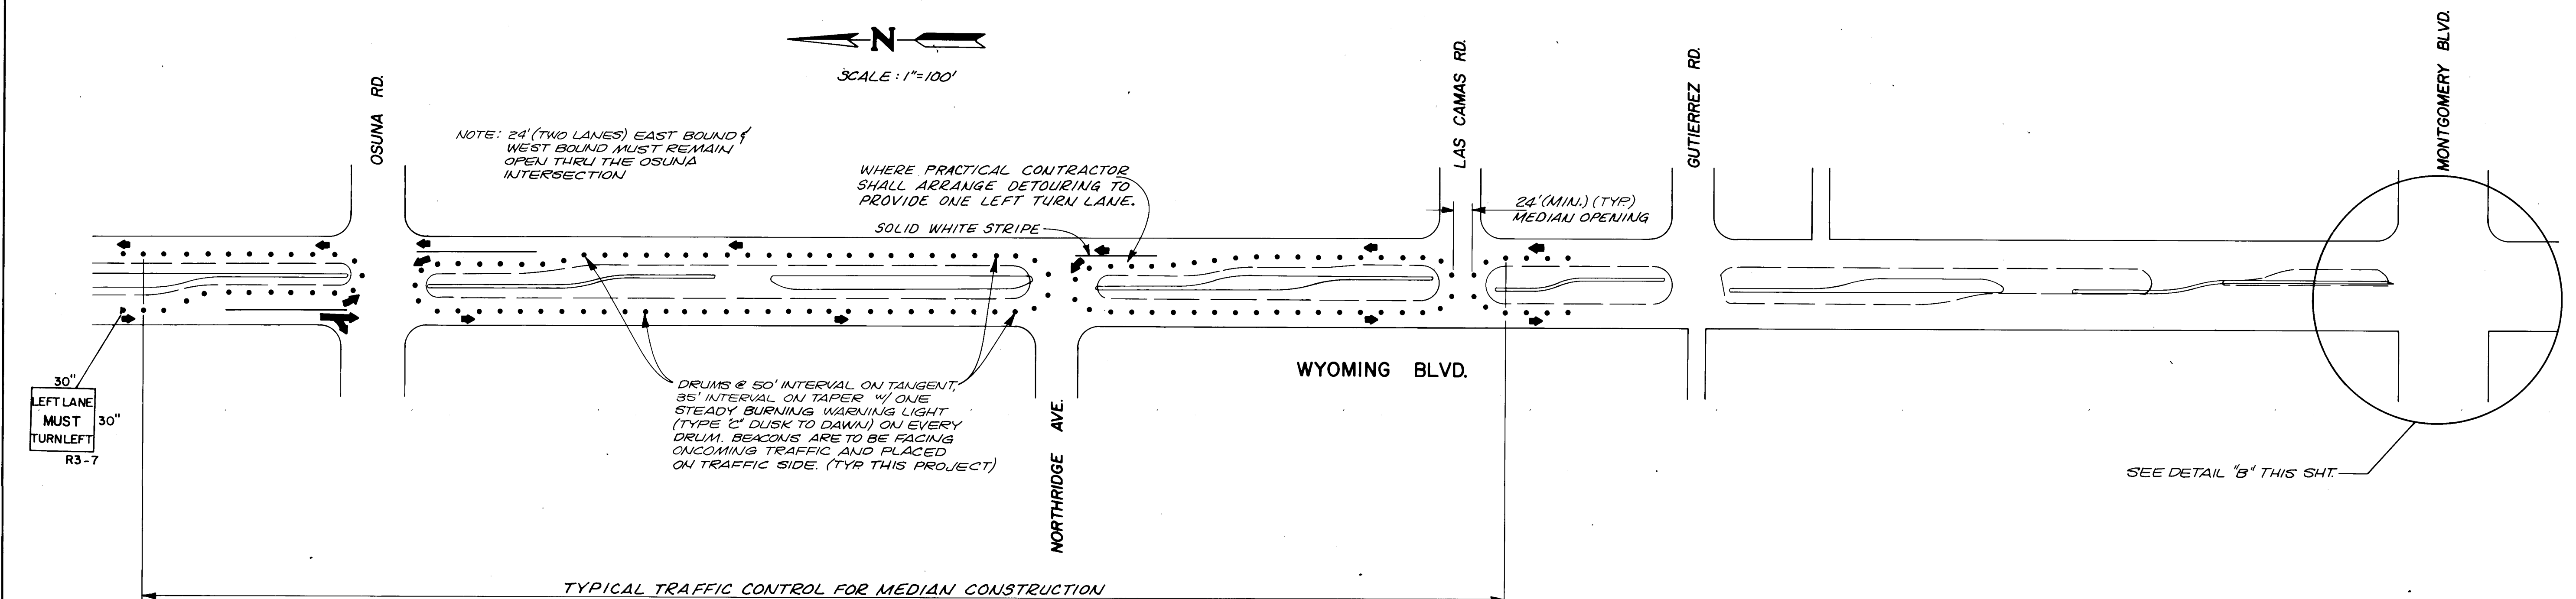

NOTE: IT IS ANTICIPATED SOME ADJUSTMENTS WILL BE REQUIRED TO THE TRAFFIC SIGNING AND BARRICADING SHOWN ON THE DRAWINGS TO MEET ACTUAL FIELD CONDITIONS. THE CONTRACTOR SHALL MAKE SUCH ADJUSTMENTS AT THE DIRECTION OF THE ENGINEER WITHOUT ADDITIONAL COST TO THE OWNER.

NOTE: CONSTRUCTION ON THE FIRST TWO ISLANDS NORTH OF MONTGOMERY SHALL BE LIMITED TO A MAXIMUM OF 3 WEEKS. DURING THIS TIME DETAIL "B" SHALL BE IN EFFECT EXCEPT DURING EVENING RUSH HOURS (4-6:00 PM). WHEN WORK ON THE FIRST TWO ISLANDS ARE COMPLETE AND ALSO DURING THE EVENING RUSH HOUR, WYOMING SOUTH OF MONTGOMERY SHOULD REVERT TO EXISTING SIGNING AND STRIPING. AFTER THE 3 WEEK PERIOD AND DURING RUSH HOUR, WYOMING NORTH OF MONTGOMERY SHOULD REDUCE TO ONE LANE AT GUTIERREZ WHEN NECESSARY.

RECORD DRAWING

DATE: 2-24-84 BY: M-C FROM: CITY'S MARK-UPS

These record drawings have been prepared, on the basis of information compiled and furnished by the city engineers office. The consulting engineer will not be responsible for any errors or omissions which have been incorporated into this document as a result.

1 2 3 4 5 6 7 8 9 10 11 12
26 16370587



APPROVED FOR CONSTRUCTION

CITY ENGINEER DATE

MOLZEN-CORBIN & ASSOCIATES
CONSULTING ENGINEERS
ALBUQUERQUE, CARLSBAD - NEW MEXICO


CITY OF ALBUQUERQUE
TRANSPORTATION DEPARTMENT


TITLE: WYOMING BLVD N.E. WIDENING
TRAFFIC CONTROL
DETAIL 3

APPROVALS	ENGINEER	DATE	APPROVALS	ENGINEER	DATE
City Engineer			Liquid Waste		
ACE-Design			Traffic		
ACE-Hydrology			Water		


DRAWING NO. 1637 **SHEET 5 OF 38**

SURVEY INFORMATION		BENCH MARKS		AS BUILT INFORMATION	
FIELD NOTES	DATE	CONTRACTOR	CONTRACT NO.	CONTRACTOR	CONTRACT NO.
BY	BY	ALBUQ. SURVEY CO.	ALBUQ. SURVEY CO.	CONTRACTOR	CONTRACT NO.
NO.	NO.	5-81	5-81	CONTRACTOR	CONTRACT NO.
REFERENCES	REFERENCES	REFERENCES	REFERENCES	CONTRACTOR	CONTRACT NO.
MAP NO. F-19 8-20	MAP NO. F-19 8-20	MAP NO. F-19 8-20	MAP NO. F-19 8-20	CONTRACTOR	CONTRACT NO.
EST. NO.	EST. NO.	EST. NO.	EST. NO.	CONTRACTOR	CONTRACT NO.
W.O. NO.	W.O. NO.	W.O. NO.	W.O. NO.	CONTRACTOR	CONTRACT NO.
REVISIONS	REVISIONS	REVISIONS	REVISIONS	CONTRACTOR	CONTRACT NO.
NO.	DATE	NO.	DATE	CONTRACTOR	CONTRACT NO.
DESIGNED BY: KB	DATE: 4-82	DESIGNED BY: KB	DATE: 4-82	CONTRACTOR	CONTRACT NO.
DRAWN BY: E.H.	DATE: 4-82	DRAWN BY: E.H.	DATE: 4-82	CONTRACTOR	CONTRACT NO.
CHECKED BY: J.P.	DATE: 5-3-82	CHECKED BY: J.P.	DATE: 5-3-82	CONTRACTOR	CONTRACT NO.

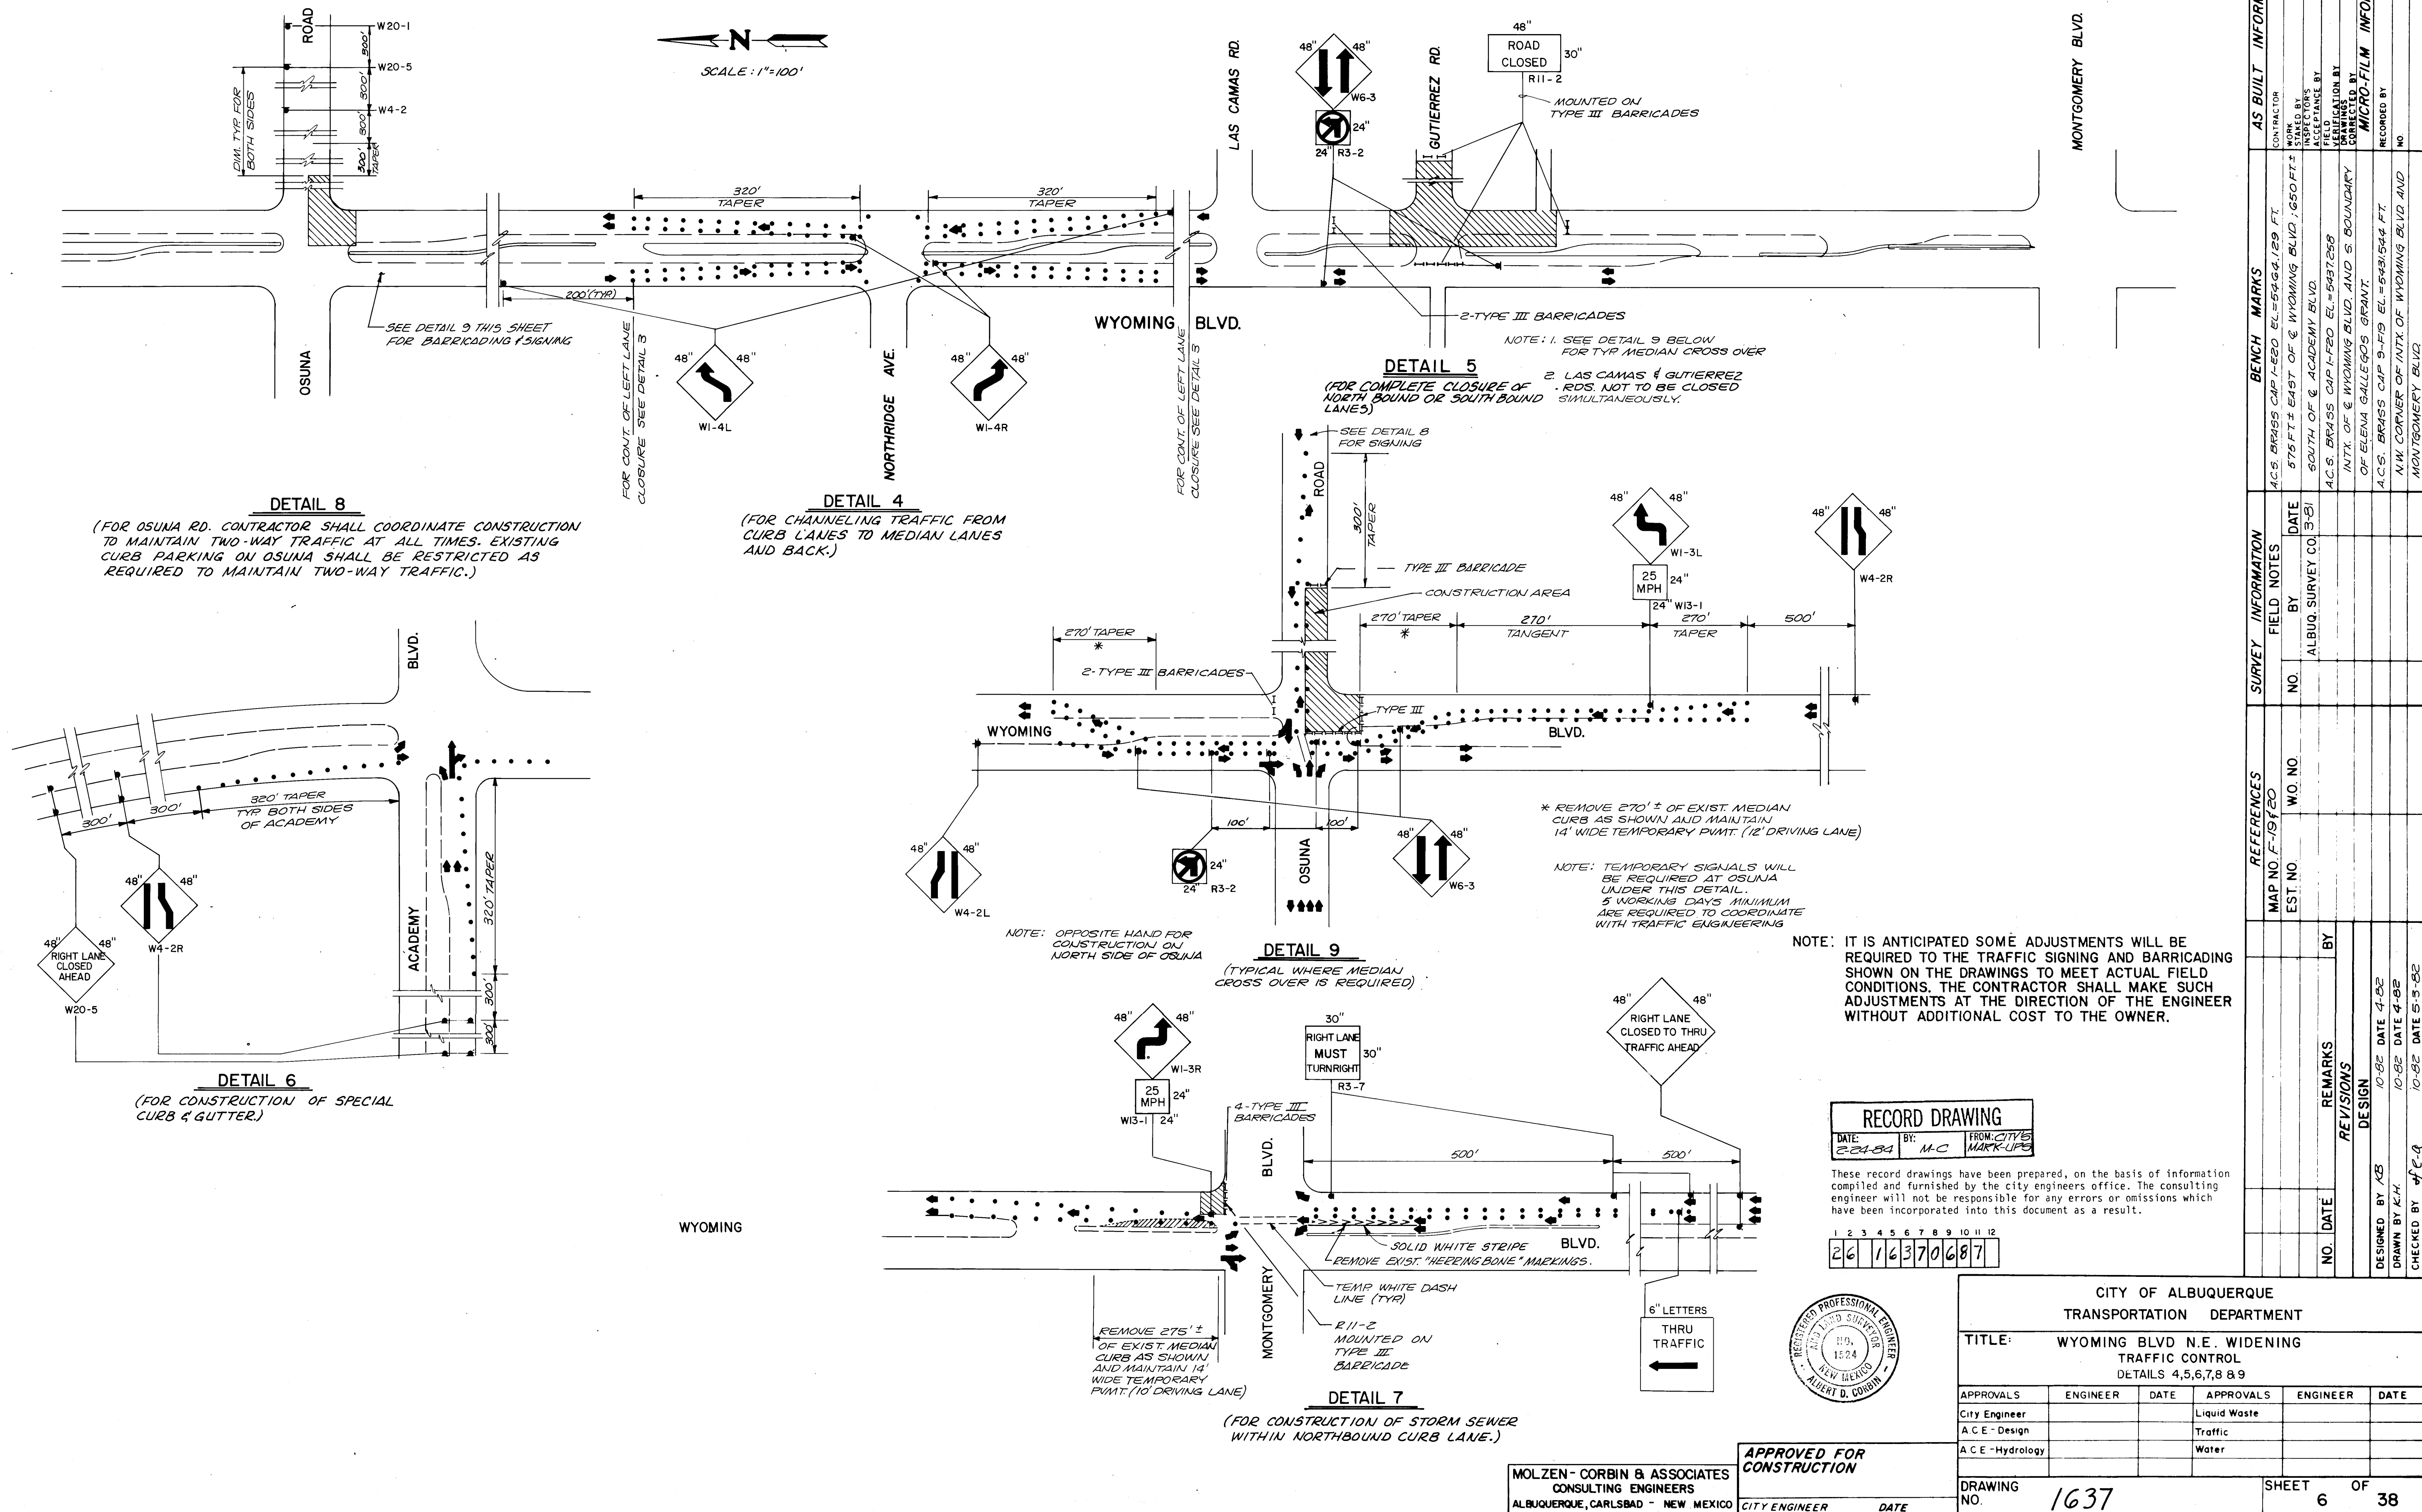


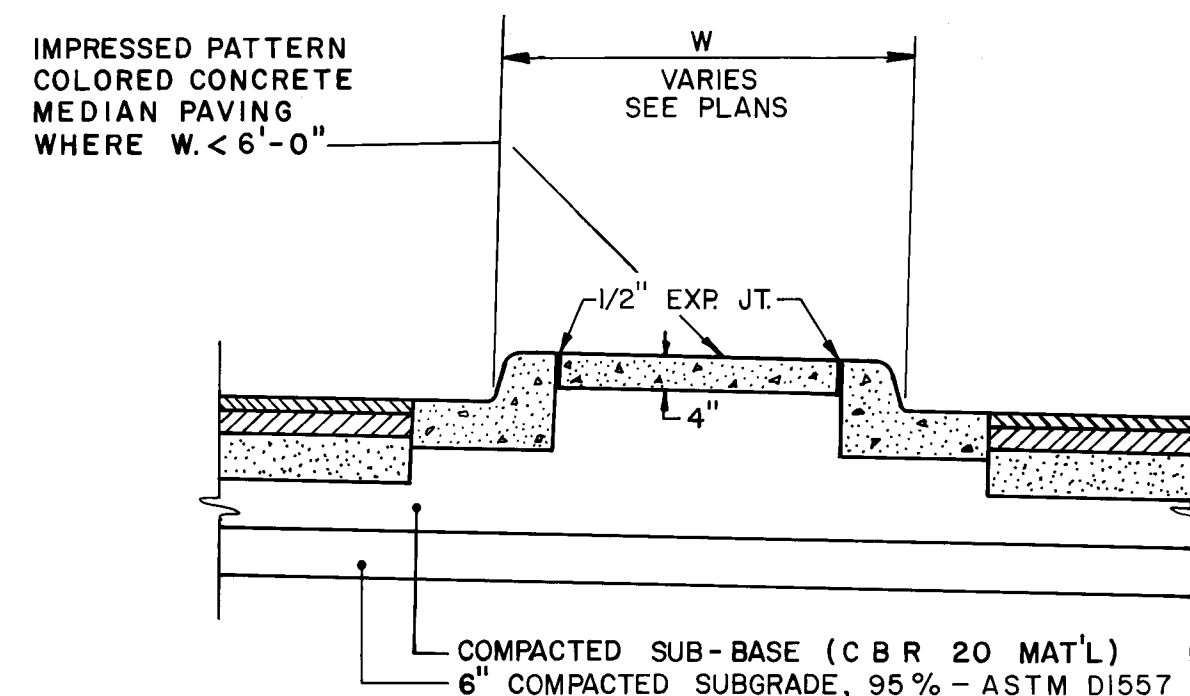

**TYP. MEDIAN SECTION
@ LEFT TURN BAYS**

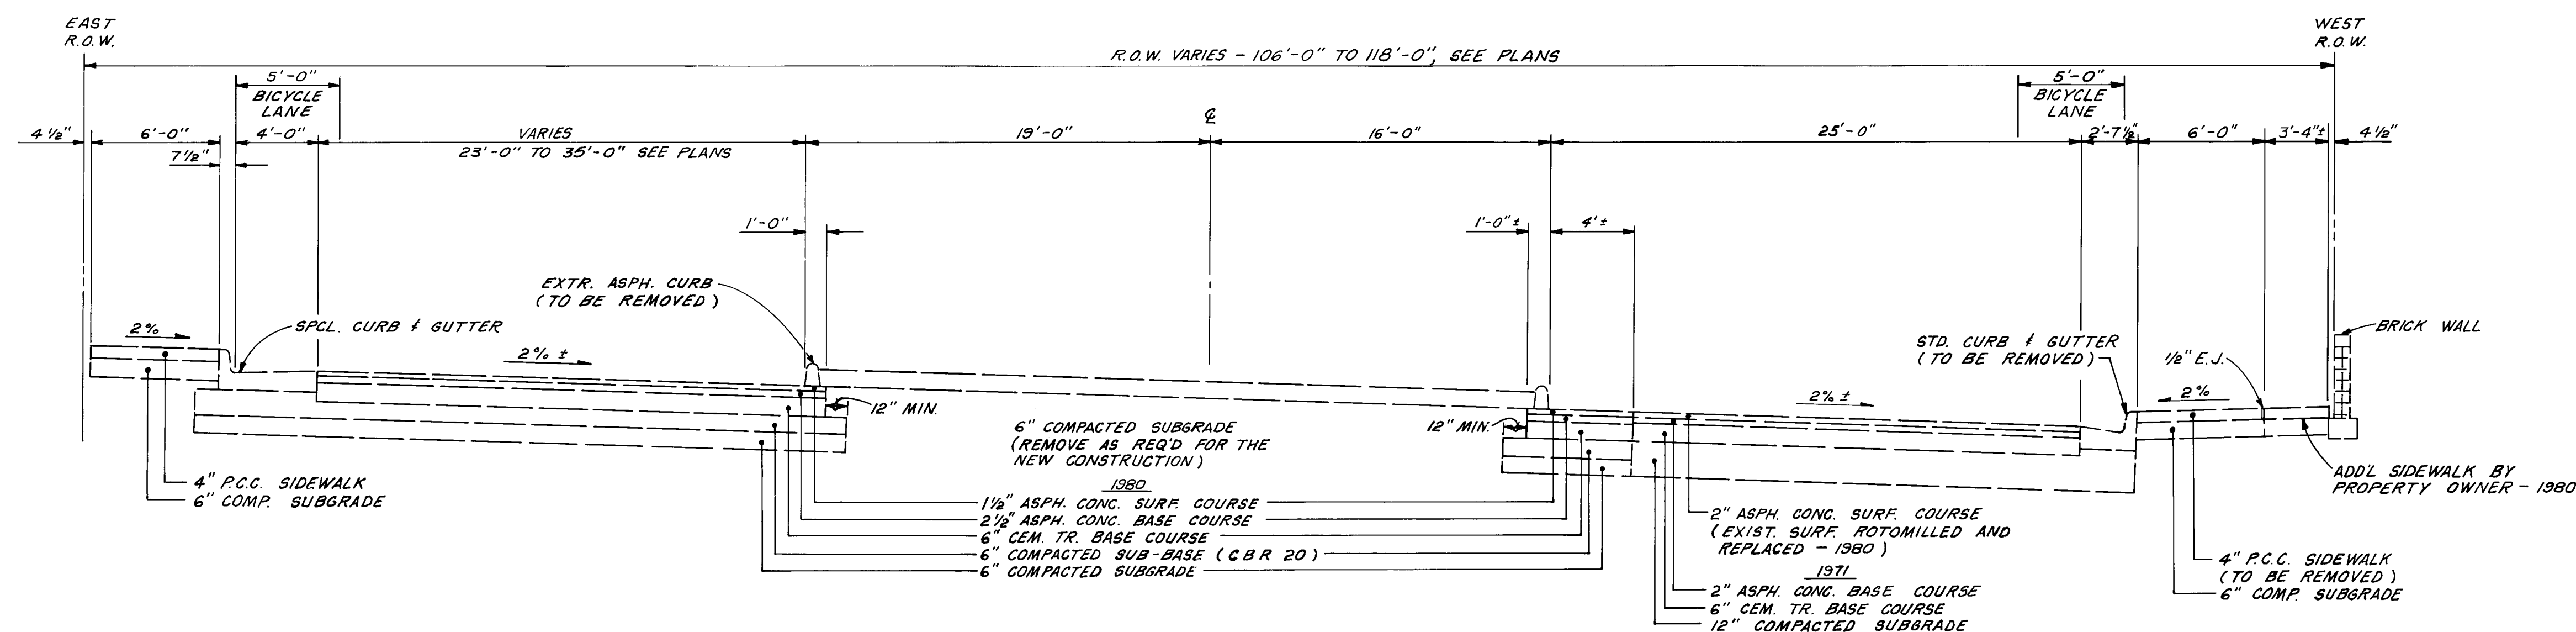

EXISTING CONSTRUCTION
N.T.S.

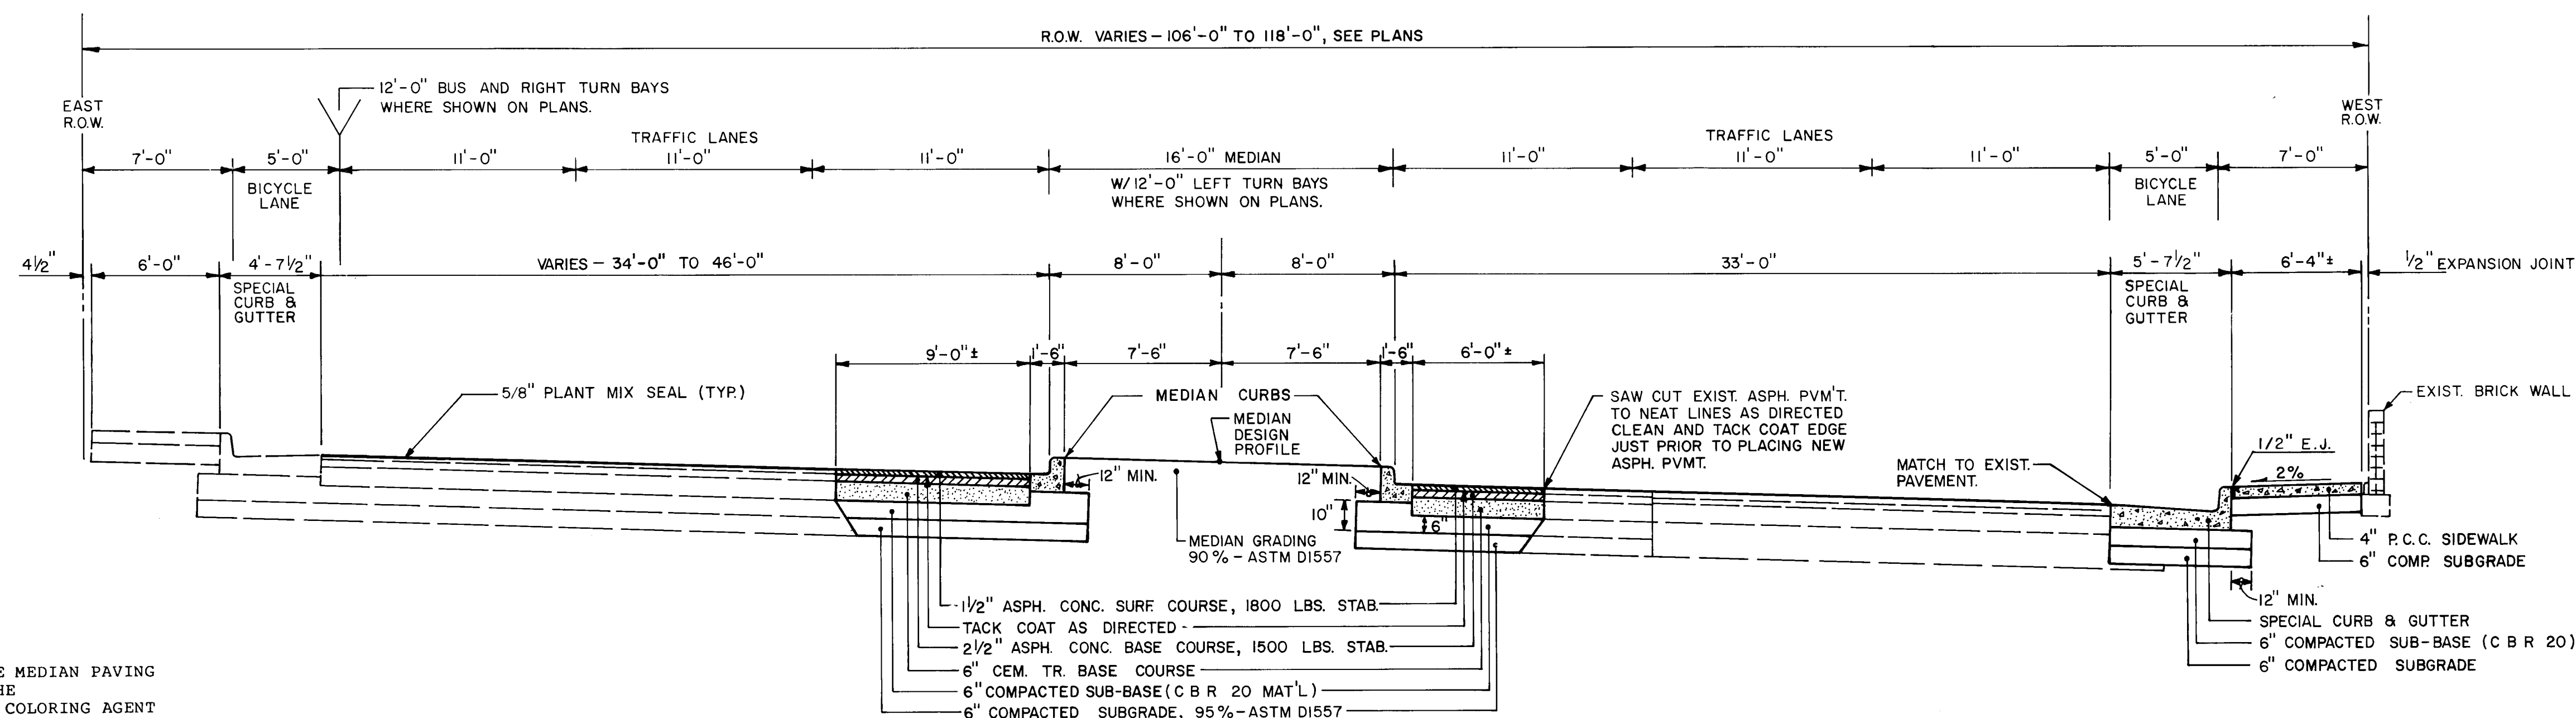


NEW CONSTRUCTION

TYPICAL SECTION STA. 10+00 TO STA. 21+76.14

(ACADEMY RD. TO BEAR CANYON TRIBUTARY)
N.T.S.

NOTE: MATERIALS FOR IMPRESSED PATTERN COLORED CONCRETE MEDIAN PAVING SHALL COMPLY WITH THE REQUIREMENTS OF SECTION 101 OF THE SPECIFICATIONS FOR 1000 PSI CONCRETE, AIR ENTRAINED. COLORING AGENT SHALL BE DAVIS #1117 "File Red" INTEGRALLY ADDED AT A RATE OF 5 LBS PER BAG OF CEMENT, OR APPROVED EQUAL. THE IMPRESSED PATTERN SHALL BE 5" X 8" RUNNING BOND, FLAT FINISH. PLACEMENT, FINISHING, AND CURING SHALL BE PERFORMED IN ACCORDANCE WITH THE MFRG.'S RECOMMENDATIONS.

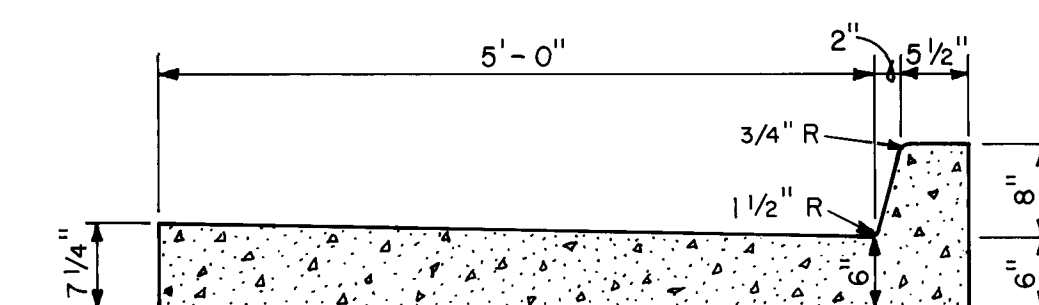

SPECIAL CURB & GUTTER DETAIL

			REFERENCES		SURVEY INFORMATION		BENCH MARKS		AS BUILT INFORMATION	
NO.	DATE	REMARKS	BY	EST. NO.	MAP NO. F-19820	FIELD NOTES		ACCS. BRASS CAP 1-FOO EL=5464.129 FT.	CONTRACTOR	DATE
						NO.	BY			
						ALBUQ. SURVEY CO.	S-GI	575 FT.± EAST OF E WYOMING BLVD.; 650 FT.± SOUTH OF E ACADEMY BLVD.		DATE
								ACCS. BRASS CAP 1-FOO EL=5437.258 FT.		DATE
								INTX. OF E WYOMING BLVD. AND S. BOUNDARY OF ELENA GALLEGOS GRANT.		DATE
REVISIONS										
DESIGN										
DESIGNED BY	K8	10-82	DATE	4-82				ACCS. BRASS CAP 9-F79 EL=5431.544 FT.		DATE
DRAWN BY	STAFF	10-82	DATE	4-82				N.W. CORNER OF INTX. OF WYOMING BLVD. AND		NO

RECORD DRAWING		
DATE: 2-24-84	BY: M-C	FROM: CITY MARK-UP


These record drawings have been prepared, on the basis of information compiled and furnished by the city engineers office. The consulting engineer will not be responsible for any errors or omissions which have been incorporated into this document as a result.

1	2	3	4	5	6	7	8	9	10	11	12
2	6		1	6	3	7	0	7	8	7	

MOLZEN - CORBIN & ASSOCIATES
CONSULTING ENGINEERS
ALBUQUERQUE, CARLSBAD - NEW MEXICO


APPROVED FOR
CONSTRUCTION

CITY OF ALBUQUERQUE TRANSPORTATION DEPARTMENT					
TITLE: WYOMING BLVD. N.E. WIDENING TYPICAL ROADWAY SECTIONS					
APPROVALS	ENGINEER	DATE	APPROVALS	ENGINEER	DATE
City Engineer			Liquid Waste		
A.C.E. - Design			Traffic		
A.C.E. - Hydrology			Water		
DRAWING NO. 1637			SHEET 7 OF 38		

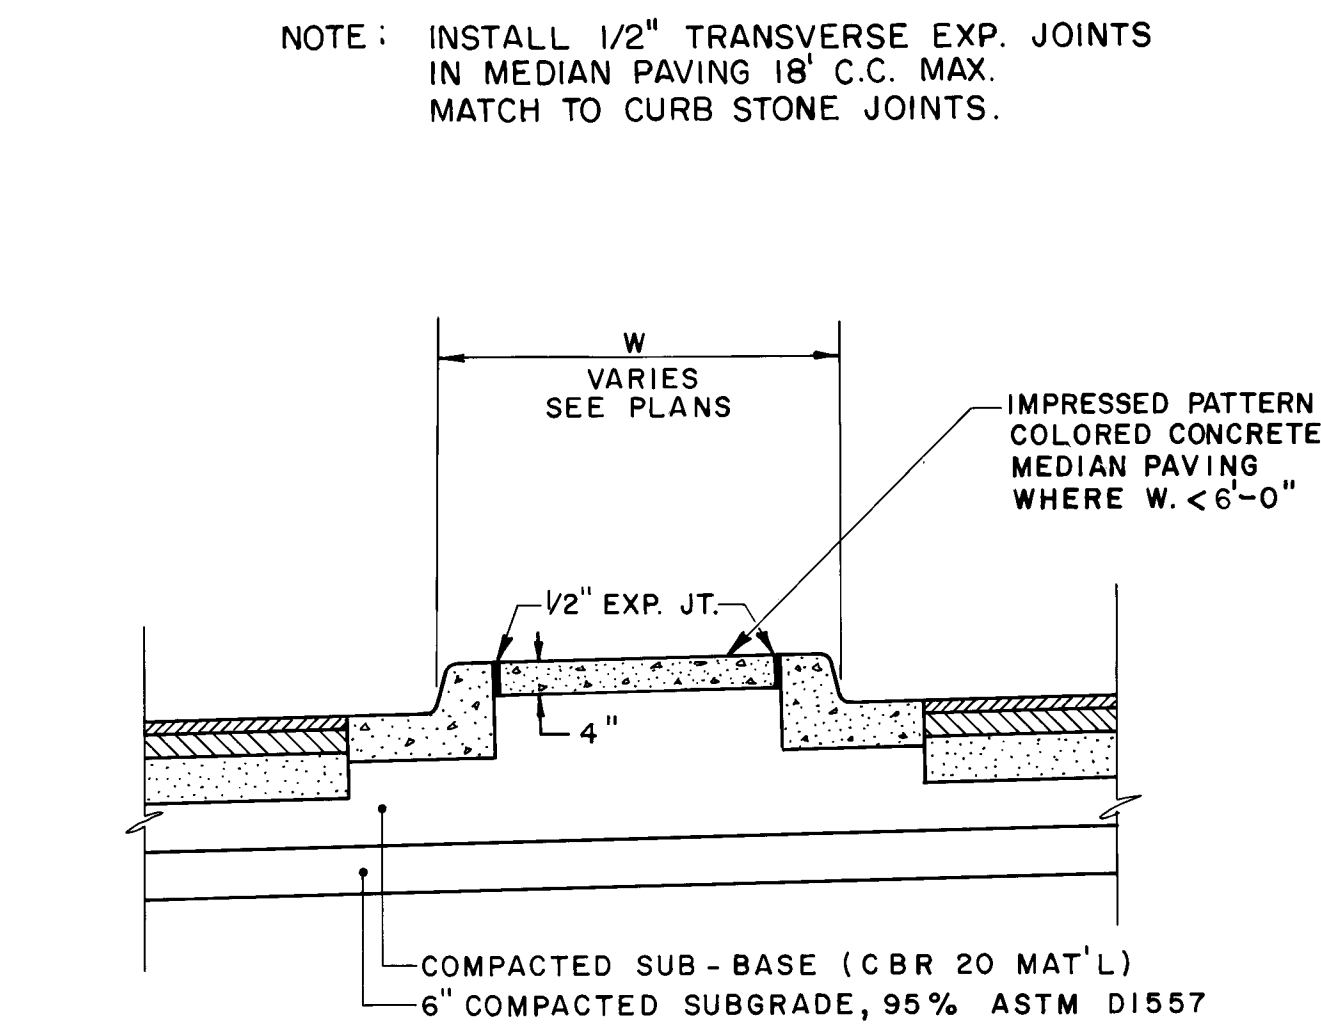

N.T.S.


The contractor shall not allow the rejuvenating agent distributor to stand still on any asphalt surface at any time. Any pavement that is damaged by excessive application of rejuvenating agent shall be removed and replaced as directed by the engineer at the contractor's expense.

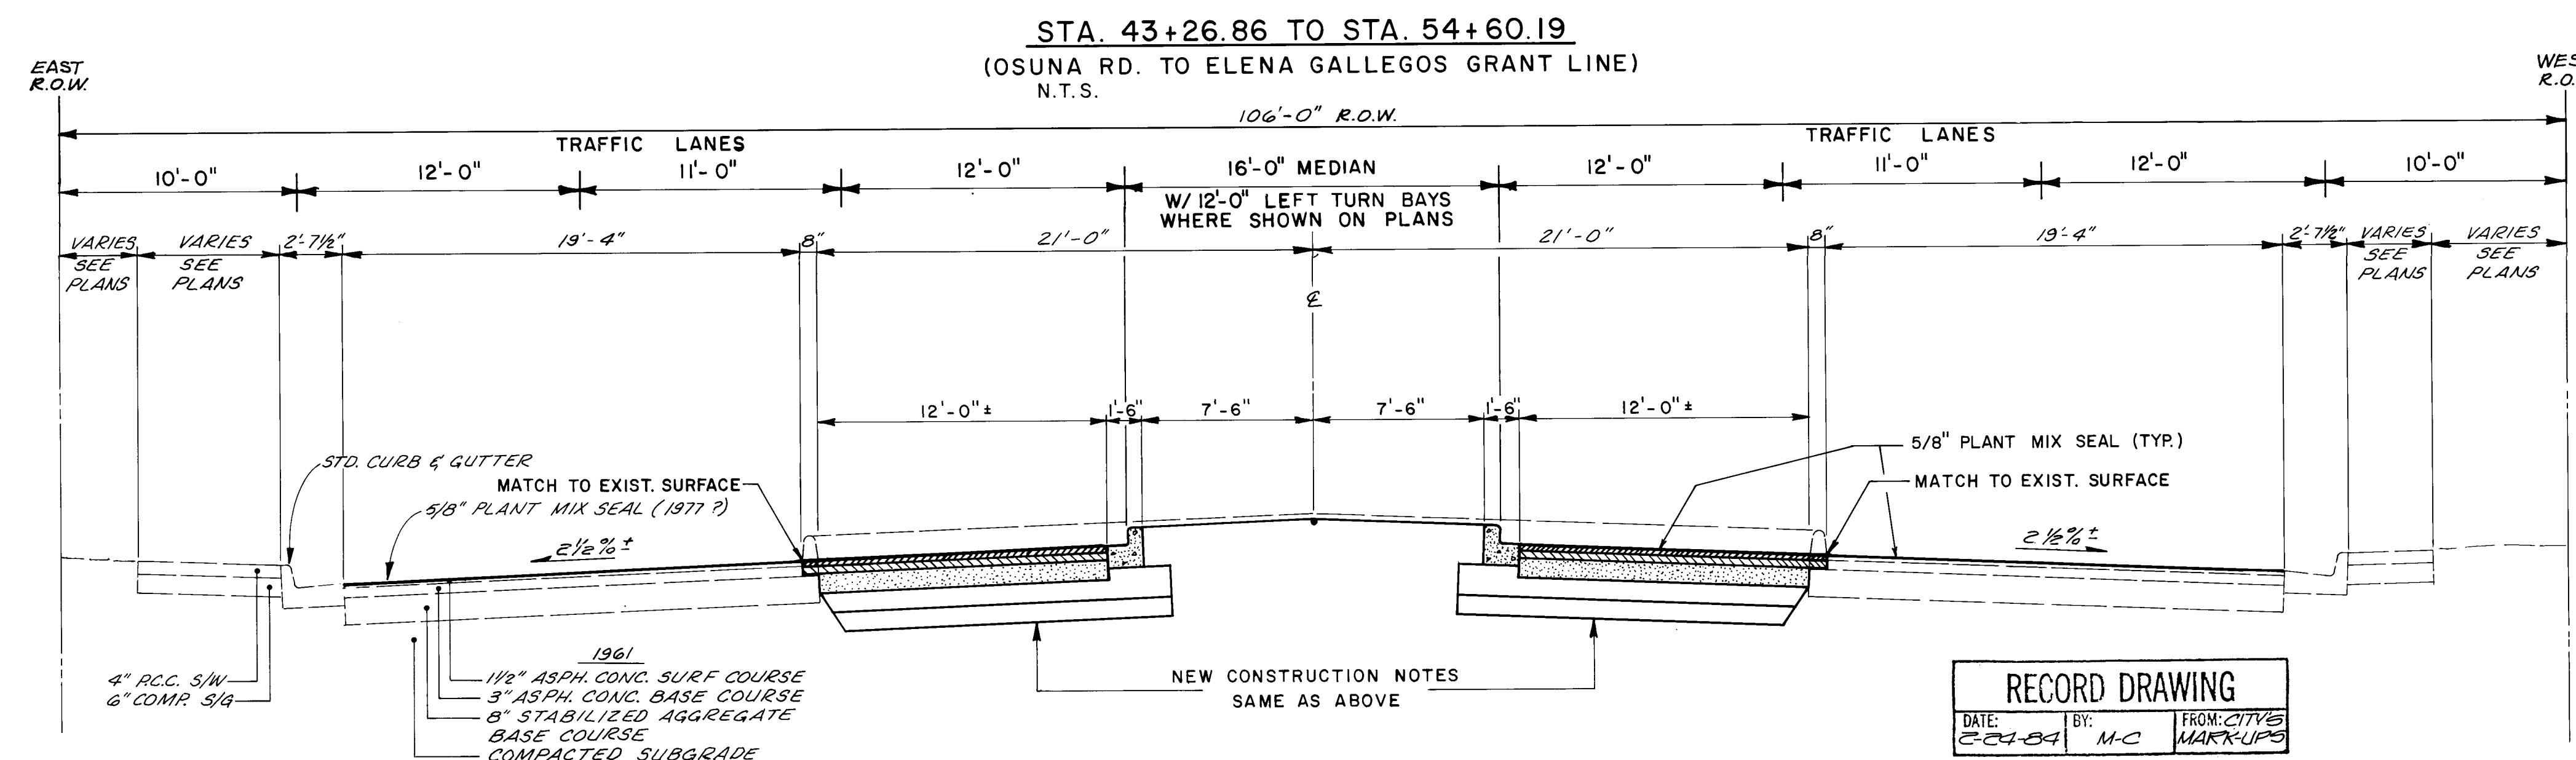

TYPICAL SECTIONS

These record drawings have been prepared, on the basis of information compiled and furnished by the city engineers office. The consulting engineer will not be responsible for any errors or omissions which have been incorporated into this document as a result.



1	2	3	4	5	6	7	8	9	10	11	12
2	6		1	6	3	7	0	8	6	7	

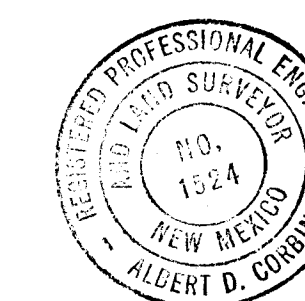

MOLZEN - CORBIN & ASSOCIATES
CONSULTING ENGINEERS
ALBUQUERQUE, CARLSBAD - NEW MEXICO

**APPROVED FOR
CONSTRUCTION**

CITY OF ALBUQUERQUE					
TRANSPORTATION DEPARTMENT					
TITLE: WYOMING BLVD. N.E. WIDENING					
TYPICAL ROADWAY SECTIONS					
APPROVALS	ENGINEER	DATE	APPROVALS	ENGINEER	DATE
City Engineer			Liquid Waste		
A.C.E. - Design			Traffic		
A.C.E. - Hydrology			Water		
DRAWING NO. 1637			SHEET 8 OF 38		

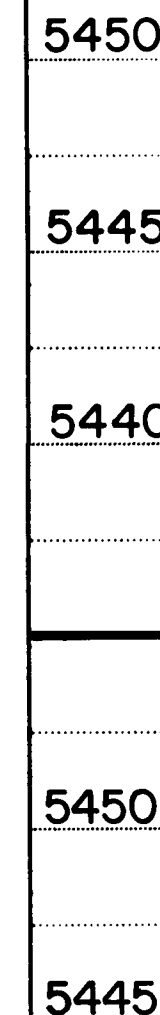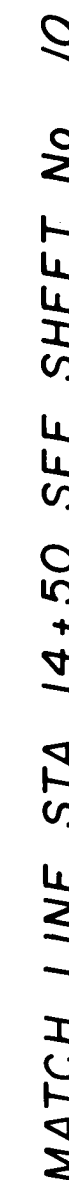

WYOMING BOULEVARD

ACADEMY ESTATES - UNIT I , BLK 4

SCALE : 1" = 20' HORIZ., 1" = 5' VERT

NOTE: A MOUNTAIN BELL TELEPHONE CO.
REPRESENTATIVE MUST BE PRESENT
AT ALL TIMES WHEN CONSTRUCTION
OCCURS OVER, UNDER OR AROUND
THE F.A.A. CABLE IN WYOMING BLVD.

	MOLZEN - CORBIN & ASSOCIATES CONSULTING ENGINEERS
	ALBUQUERQUE, CARLSBAD - NEW MEXICO

**APPROVED FOR
CONSTRUCTION**

CITY ENGINEER DATE

	CITY OF ALBUQUERQUE TRANSPORTATION DEPARTMENT
--	--

TITLE: WYOMING BLVD. N.E. WIDENING
STREET IMPROVEMENTS
STA. 14 + 50 TO STA. 20 + 00

APPROVALS	ENGINEER	DATE	APPROVALS	ENGINEER	DATE
City Engineer			Liquid Waste		
A.C.E.- Design			Traffic		
A.C.E.-Hydrology			Water		

DRAWING NO.	1637
-------------	------


SHEET 11 OF 38

AS BUILT INFORMATION	
CONTRACTOR	
WORK ORDER NO.	
INSTALLED BY	DATE
APPROVED BY	DATE
FIELD	
VERIFICATION BY	DATE
RECORDED BY	DATE
MICRO-FILM INFORMATION	
RECORDED BY	DATE
NO.	

	BENCH	MARKS
ACS. BRASS. CAP 1-E20	EL. = 5464.129 FT.	
	575 FT. ± EAST OF E. WYOMING BLVD. ;	
	650 FT. ± SOUTH OF E. ACADEMY BLVD.	
ACS. BRASS. CAP 1-F20	EL. = 5437.258 FT.	
	INTX. OF E. WYOMING BLVD. AND S.	
	BOUNDARY OF ELENA GALLEGOS GRANT.	
ACS. BRASS. CAP 9-F19	EL. = 5431.544 FT.	
	NW CORNER OF INTX. OF WYOMING BLVD.	
	AND MONTGOMERY BLVD.	

[illegible][illegible][illegible]

28-01
DESIGN

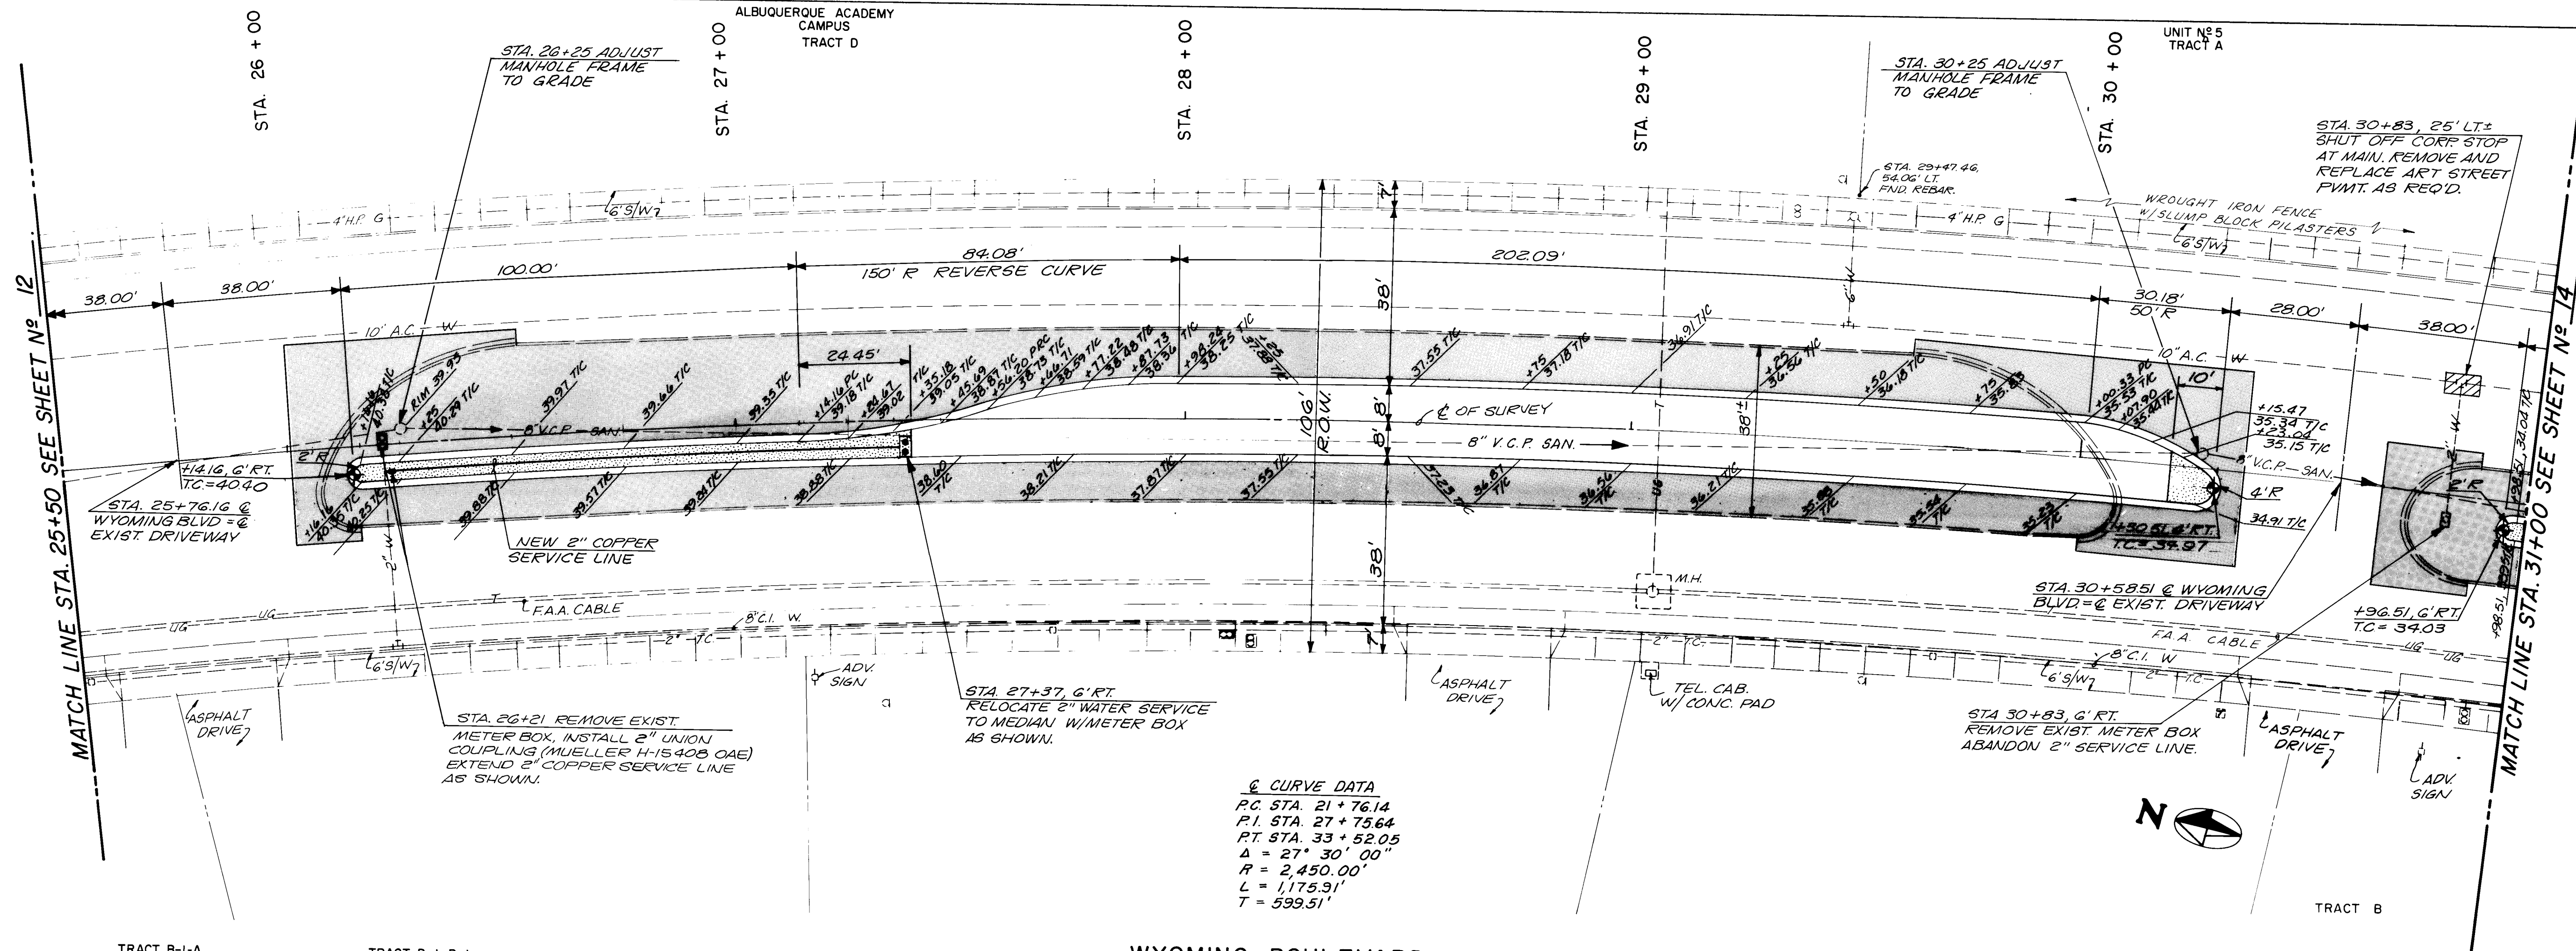


Q CURVE DATA
 P.C. STA. 21 + 76.14
 P.I. STA. 27 + 75.64
 P.T. STA. 33 + 52.05
 L = 271.30' 00"
 R = 2,450.00'
 L = 1,175.31'
 T = 599.51'

WYOMING BOULEVARD

TOP MEDIAN CURB LEFT

TOP MEDIAN CURB RIGHT

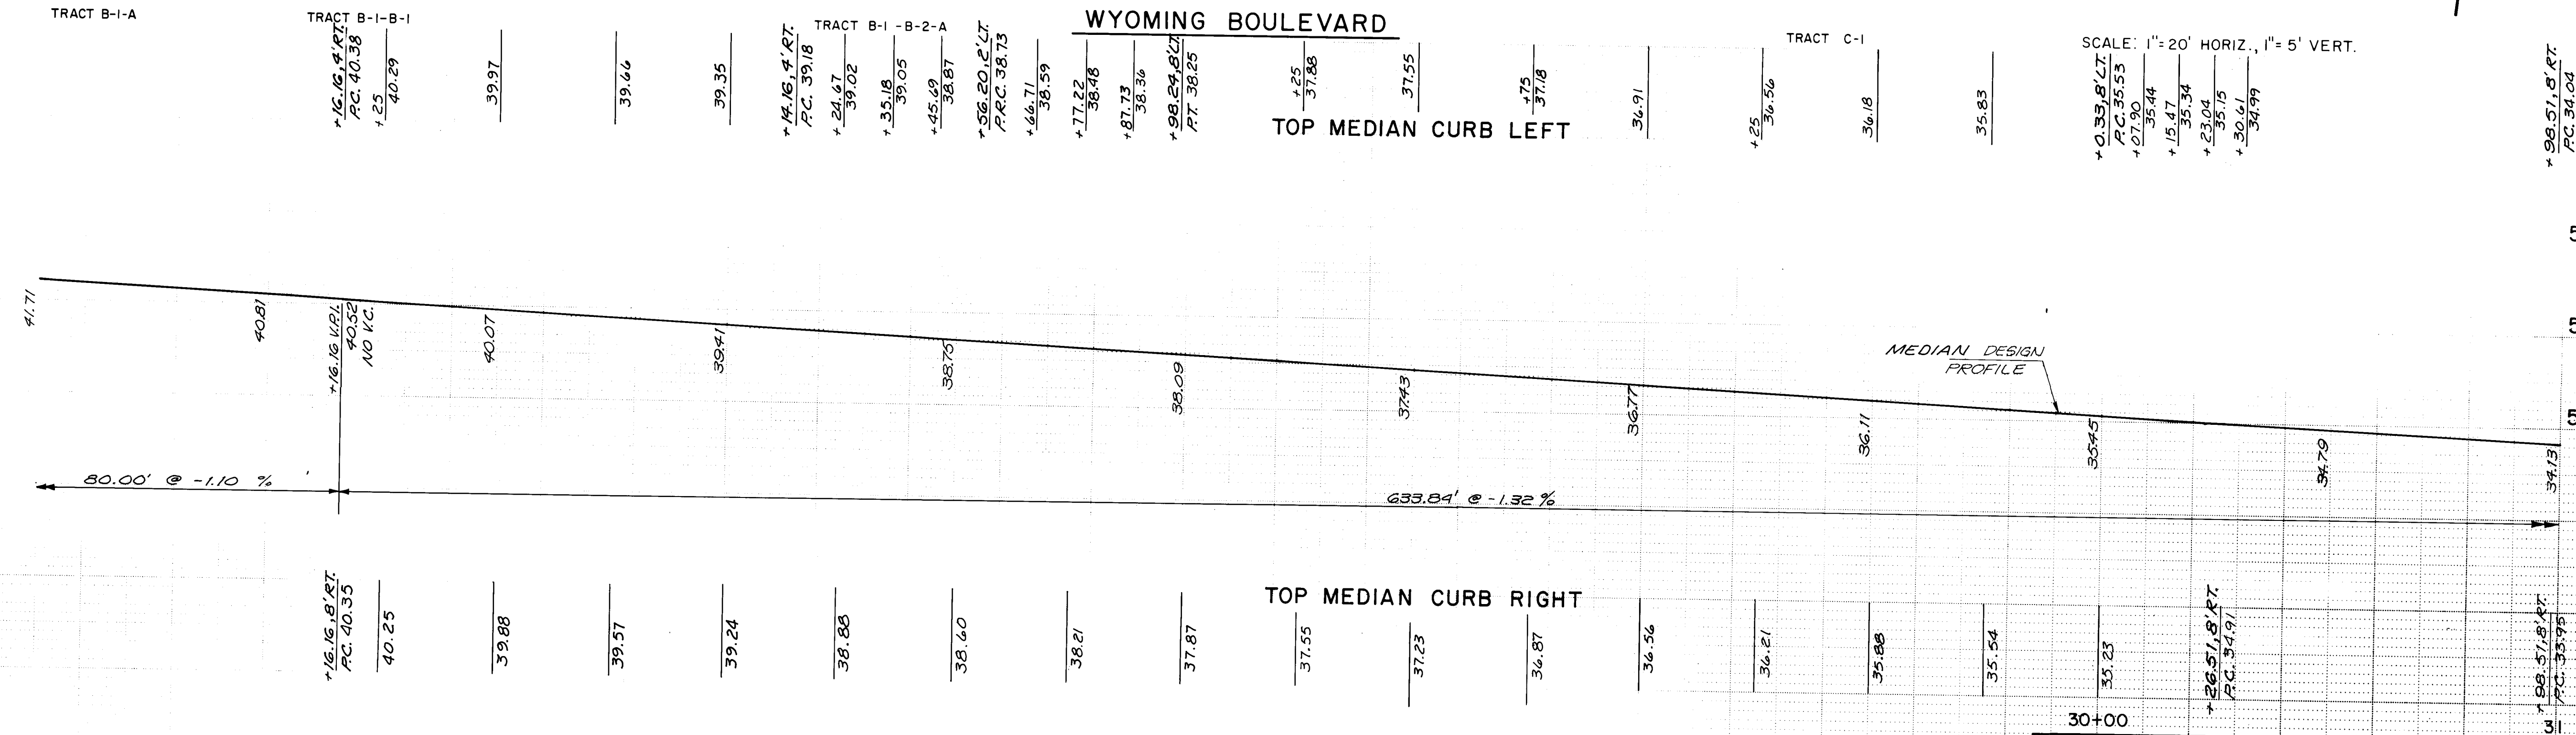


RECORD DRAWING
 DATE: 8-24-81 BY: M.C. FROM: CIVILS MARK-UPS

These record drawings have been prepared, on the basis of information compiled and furnished by the city engineers office. The consulting engineer will not be responsible for any errors or omissions which have been incorporated into this document as a result.

NOTE: A MOUNTAIN BELL TELEPHONE CO. REPRESENTATIVE MUST BE PRESENT AT ALL TIMES WHEN CONSTRUCTION OCCURS OVER, UNDER OR AROUND THE F.A.A. CABLE IN WYOMING BLVD.

1 2 3 4 5 6 7 8 9 10 11 12
 26 16 37 13 87


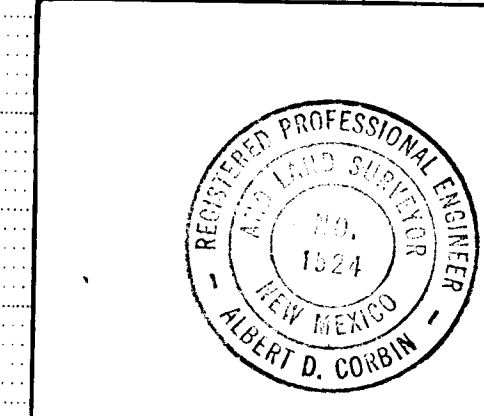


APPROVED FOR CONSTRUCTION

MOLZEN-CORBIN & ASSOCIATES
 CONSULTING ENGINEERS
 ALBUQUERQUE, CARLSBAD - NEW MEXICO

CITY OF ALBUQUERQUE TRANSPORTATION DEPARTMENT				
TITLE: WYOMING BLVD. N.E. WIDENING STREET IMPROVEMENTS STA. 25 + 50 TO STA. 31 + 00				
APPROVALS	ENGINEER	DATE	APPROVALS	ENGINEER
City Engineer			Liquid Waste	
A.C.E. - Design			Traffic	
A.C.E. - Hydrology			Water	
DRAWING NO. 1637			SHEET 13 OF 38	

SURVEY INFORMATION		BENCH MARKS		AS BUILT INFORMATION	
NO.	BY	DATE	FIELD NOTES	NO.	DATE
ALBUQ. SURVEY CO.	13-81				
REFERENCES		MAP NO. F-19 & 20		DATE	
EST. NO.		WO NO.		DATE	
REVISIONS		DESIGN		DATE	
NO.		DATE		DATE	
DESIGNED BY: K.B.		10-82		DATE 4-82	
DRAWN BY: STAFF		10-82		DATE 4-82	
CHECKED BY: P.C.A.		10-82		DATE 5-3-82	
MICRO-FILM INFORMATION		RECORDED BY		NO.	
AC.B. BRASS CAP 1-1/2" DIA. ELEV.=54,641.29 FT.		AC.B. BRASS CAP 1-1/2" DIA. ELEV.=54,641.29 FT.		DATE	
575 FT. ± EAST OF WYOMING BLVD. 1,650 FT. ± SOUTH OF ACADENY BLVD.		AC.B. BRASS CAP 1-1/2" DIA. ELEV.=54,641.29 FT.		DATE	
AC.B. BRASS CAP 1-1/2" DIA. ELEV.=54,641.29 FT.		AC.B. BRASS CAP 1-1/2" DIA. ELEV.=54,641.29 FT.		DATE	
BOUNDARY OF ELEV. GALLEGOS GRANT		AC.B. BRASS CAP 1-1/2" DIA. ELEV.=54,641.29 FT.		DATE	
AC.B. BRASS CAP 1-1/2" DIA. ELEV.=54,641.29 FT.		AC.B. BRASS CAP 1-1/2" DIA. ELEV.=54,641.29 FT.		DATE	
NW CORNER OF INTX. OF WYOMING BLVD		AC.B. BRASS CAP 1-1/2" DIA. ELEV.=54,641.29 FT.		DATE	
AND MONTGOMERY BLVD		AC.B. BRASS CAP 1-1/2" DIA. ELEV.=54,641.29 FT.		DATE	

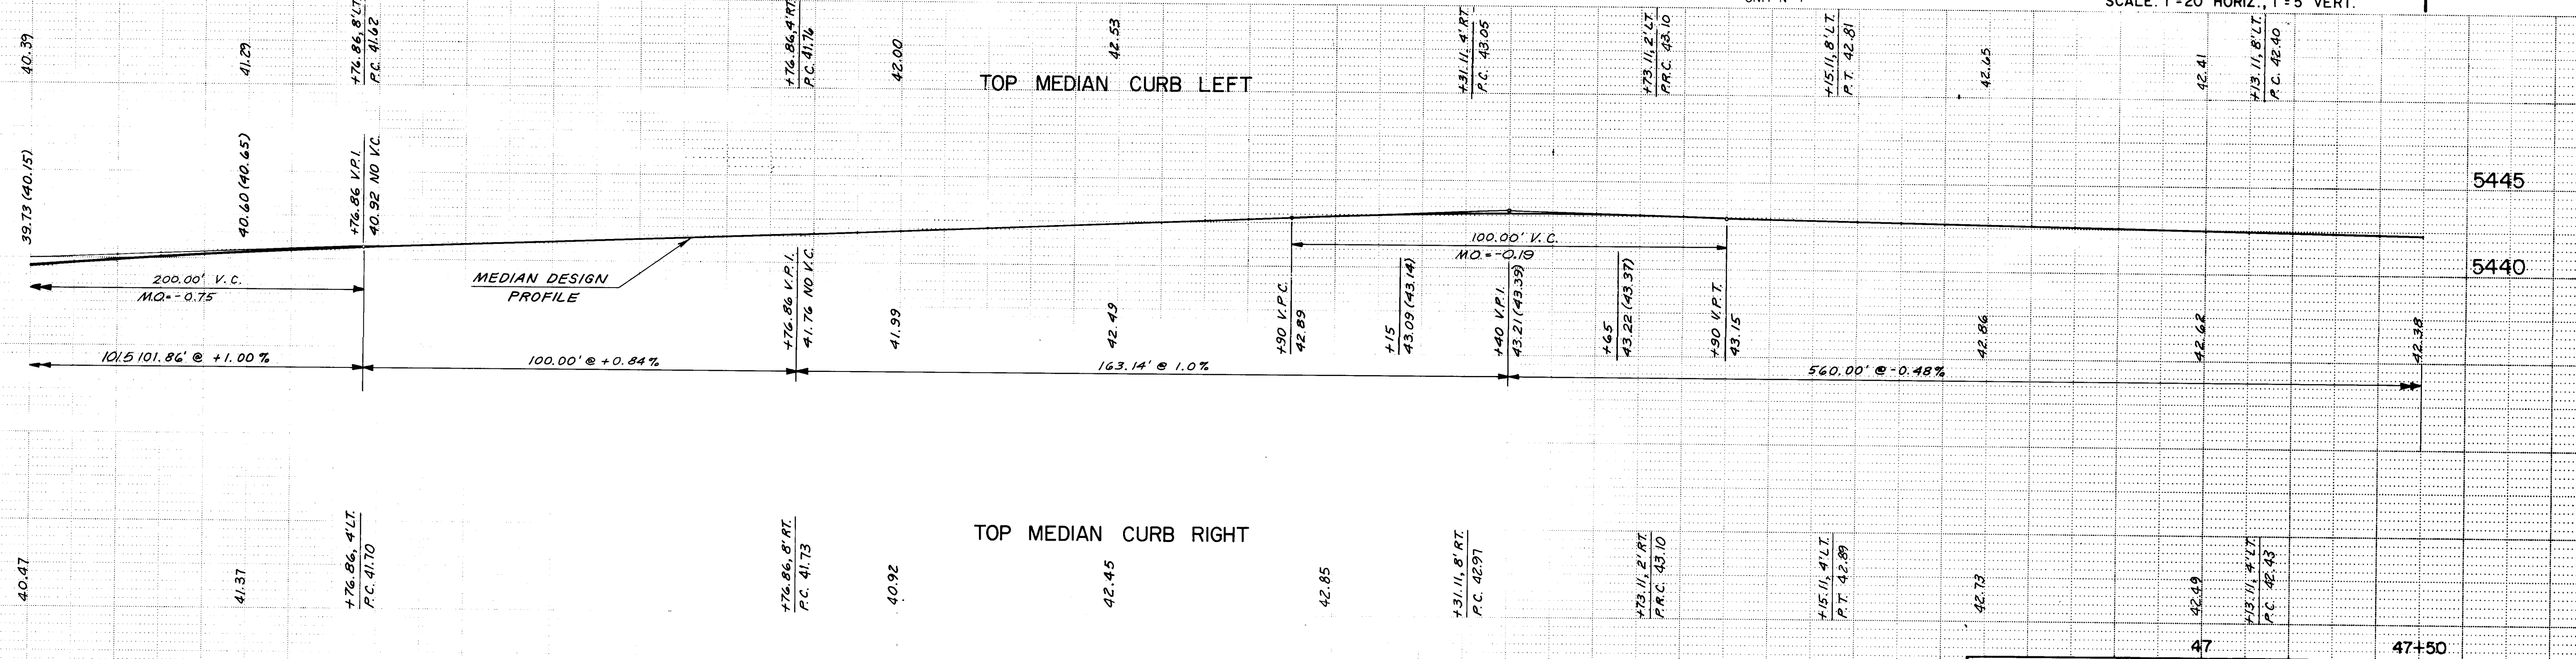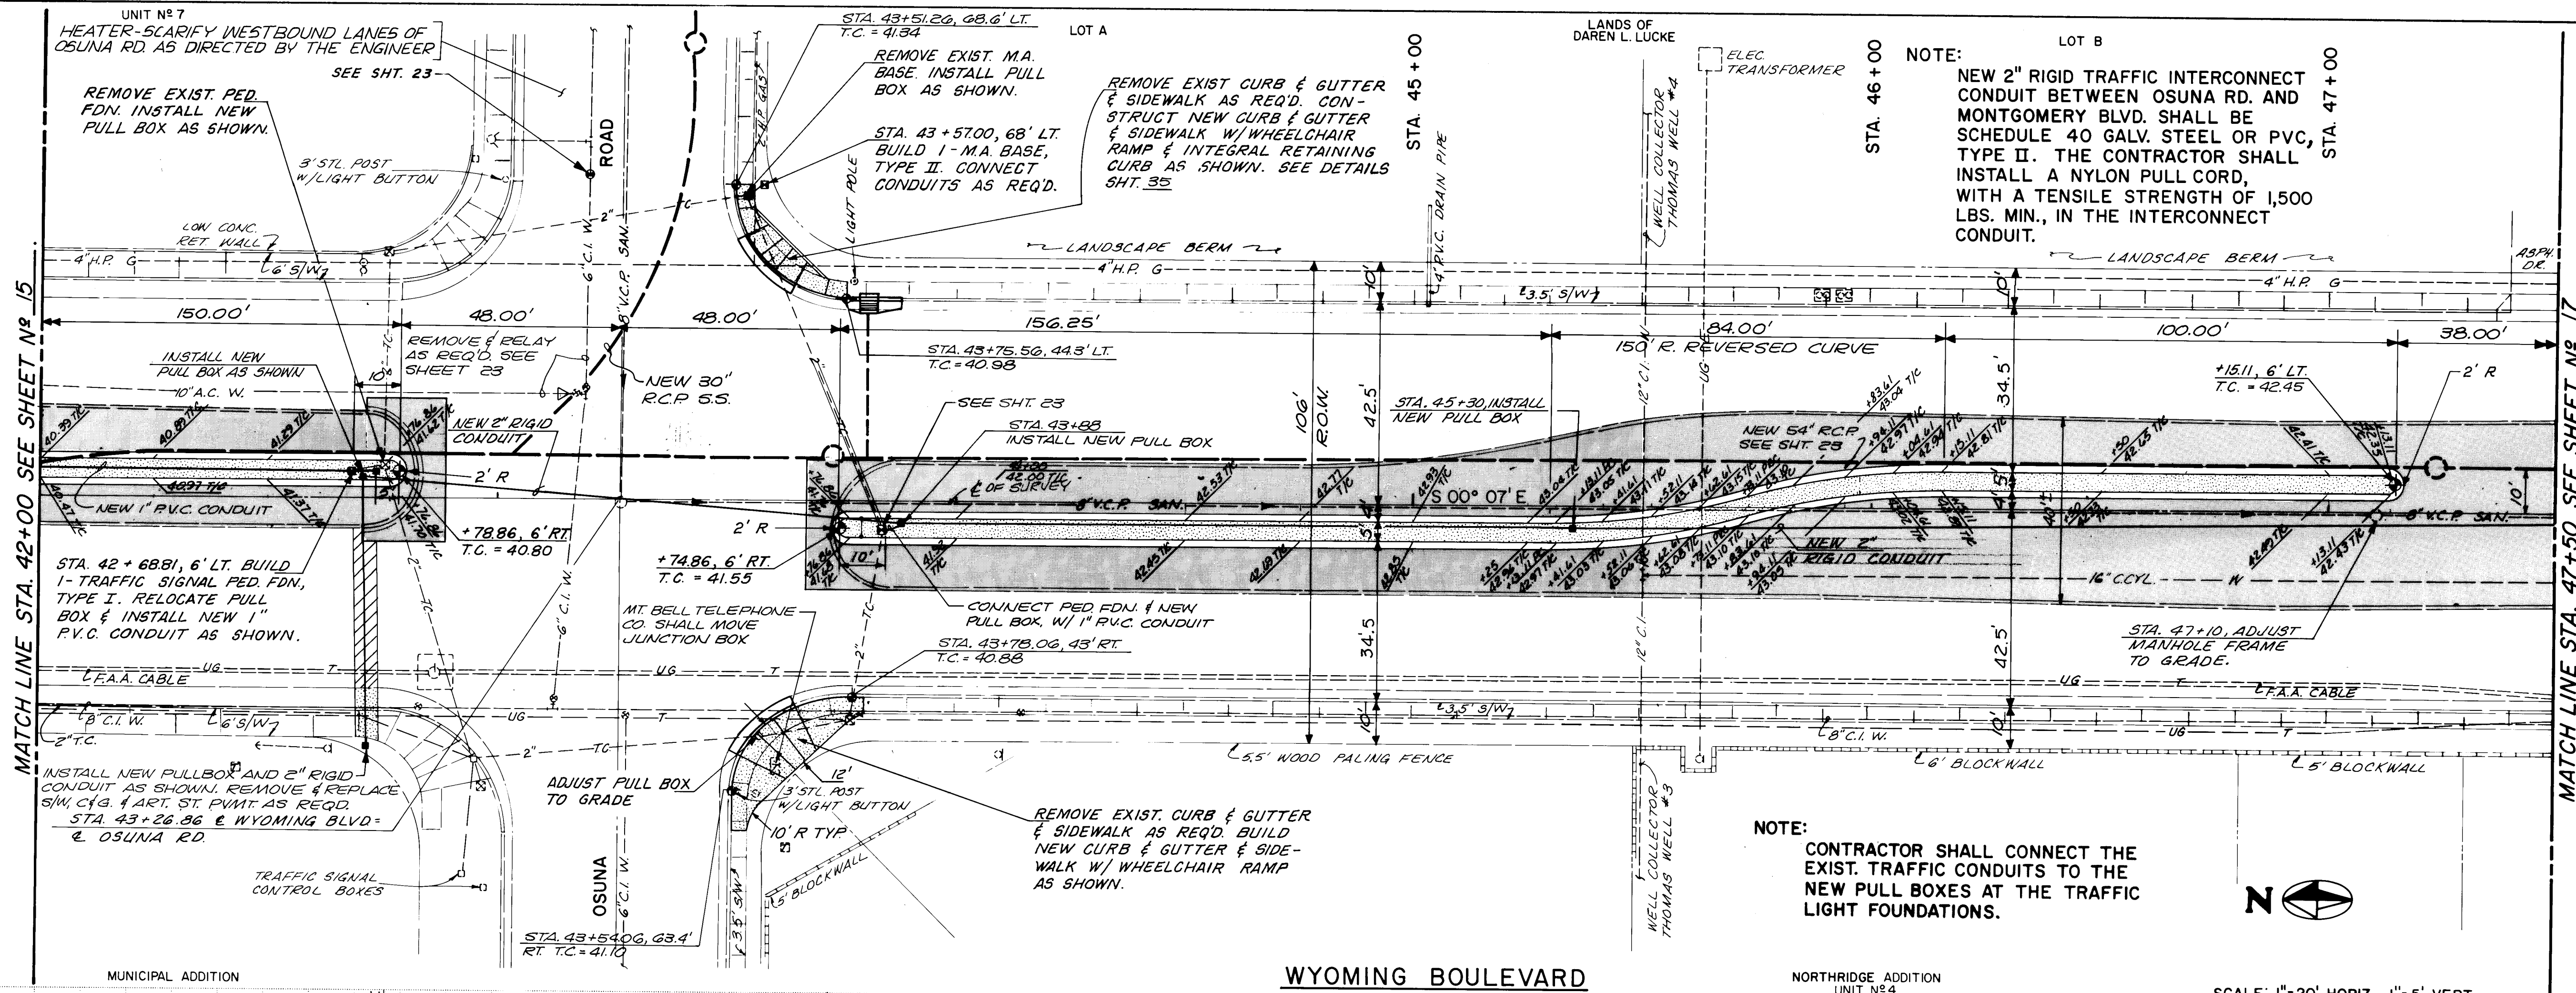

RECORD DRAWING
 DATE: 8-24-84 BY: M.C. FROM: OTV'S MARK-UPS

These record drawings have been prepared, on the basis of information compiled and furnished by the city engineers office. The consulting engineer will not be responsible for any errors or omissions which have been incorporated into this document as a result.

1 2 3 4 5 6 7 8 9 10 11 12
 2 1 6 3 7 1 6 8 7

NOTE: A MOUNTAIN BELL TELEPHONE CO. REPRESENTATIVE MUST BE PRESENT AT ALL TIMES WHEN CONSTRUCTION OCCURS OVER, UNDER OR AROUND THE F.A.A. CABLE IN WYOMING BLVD.




APPROVED FOR CONSTRUCTION



MOLZEN-CORBIN & ASSOCIATES
 CONSULTING ENGINEERS
 ALBUQUERQUE, CARLSBAD - NEW MEXICO

CITY OF ALBUQUERQUE
 TRANSPORTATION DEPARTMENT
 TITLE: WYOMING BLVD. N.E. WIDENING STREET IMPROVEMENTS STA. 42 + 00 TO STA. 47 + 50

APPROVALS	ENGINEER	DATE	APPROVALS	ENGINEER	DATE
City Engineer			Liquid Waste		
A.C.E. - Design			Traffic		
A.C.E. - Hydrology			Water		
DRAWING NO.	1637		SHEET	OF	
			16	38	

REFERENCES			SURVEY INFORMATION			BENCH MARKS			AS BUILT INFORMATION		
MAP NO.	EST. NO.	BY	NO.	DATE	FIELD NOTES	AC.S. BRASS CAP	1-100 ELEV.	5441.90	CONTRACTOR	NO.	DATE
1-19	20			3-91	ALBUQ. SURVEY CO.	575' ± EAST OF E. WYOMING BLVD.	650' ±				
						SOUTH OF E. ACADEMY BLVD.					
						AC.S. BRASS CAP 1-100 ELEV. = 5437.258					
						INTX. OF E. WYOMING BLVD. AND S. BOUND.					
						ARY OF E. ALBUQUERQUE BLVD. GRANT					
						AC.S. BRASS CAP 9-10 ELEV. = 5431.544					
						N.W. CORNER OF INTX. OF WYOMING					
						BLVD. AND MONTGOMERY BLVD.					

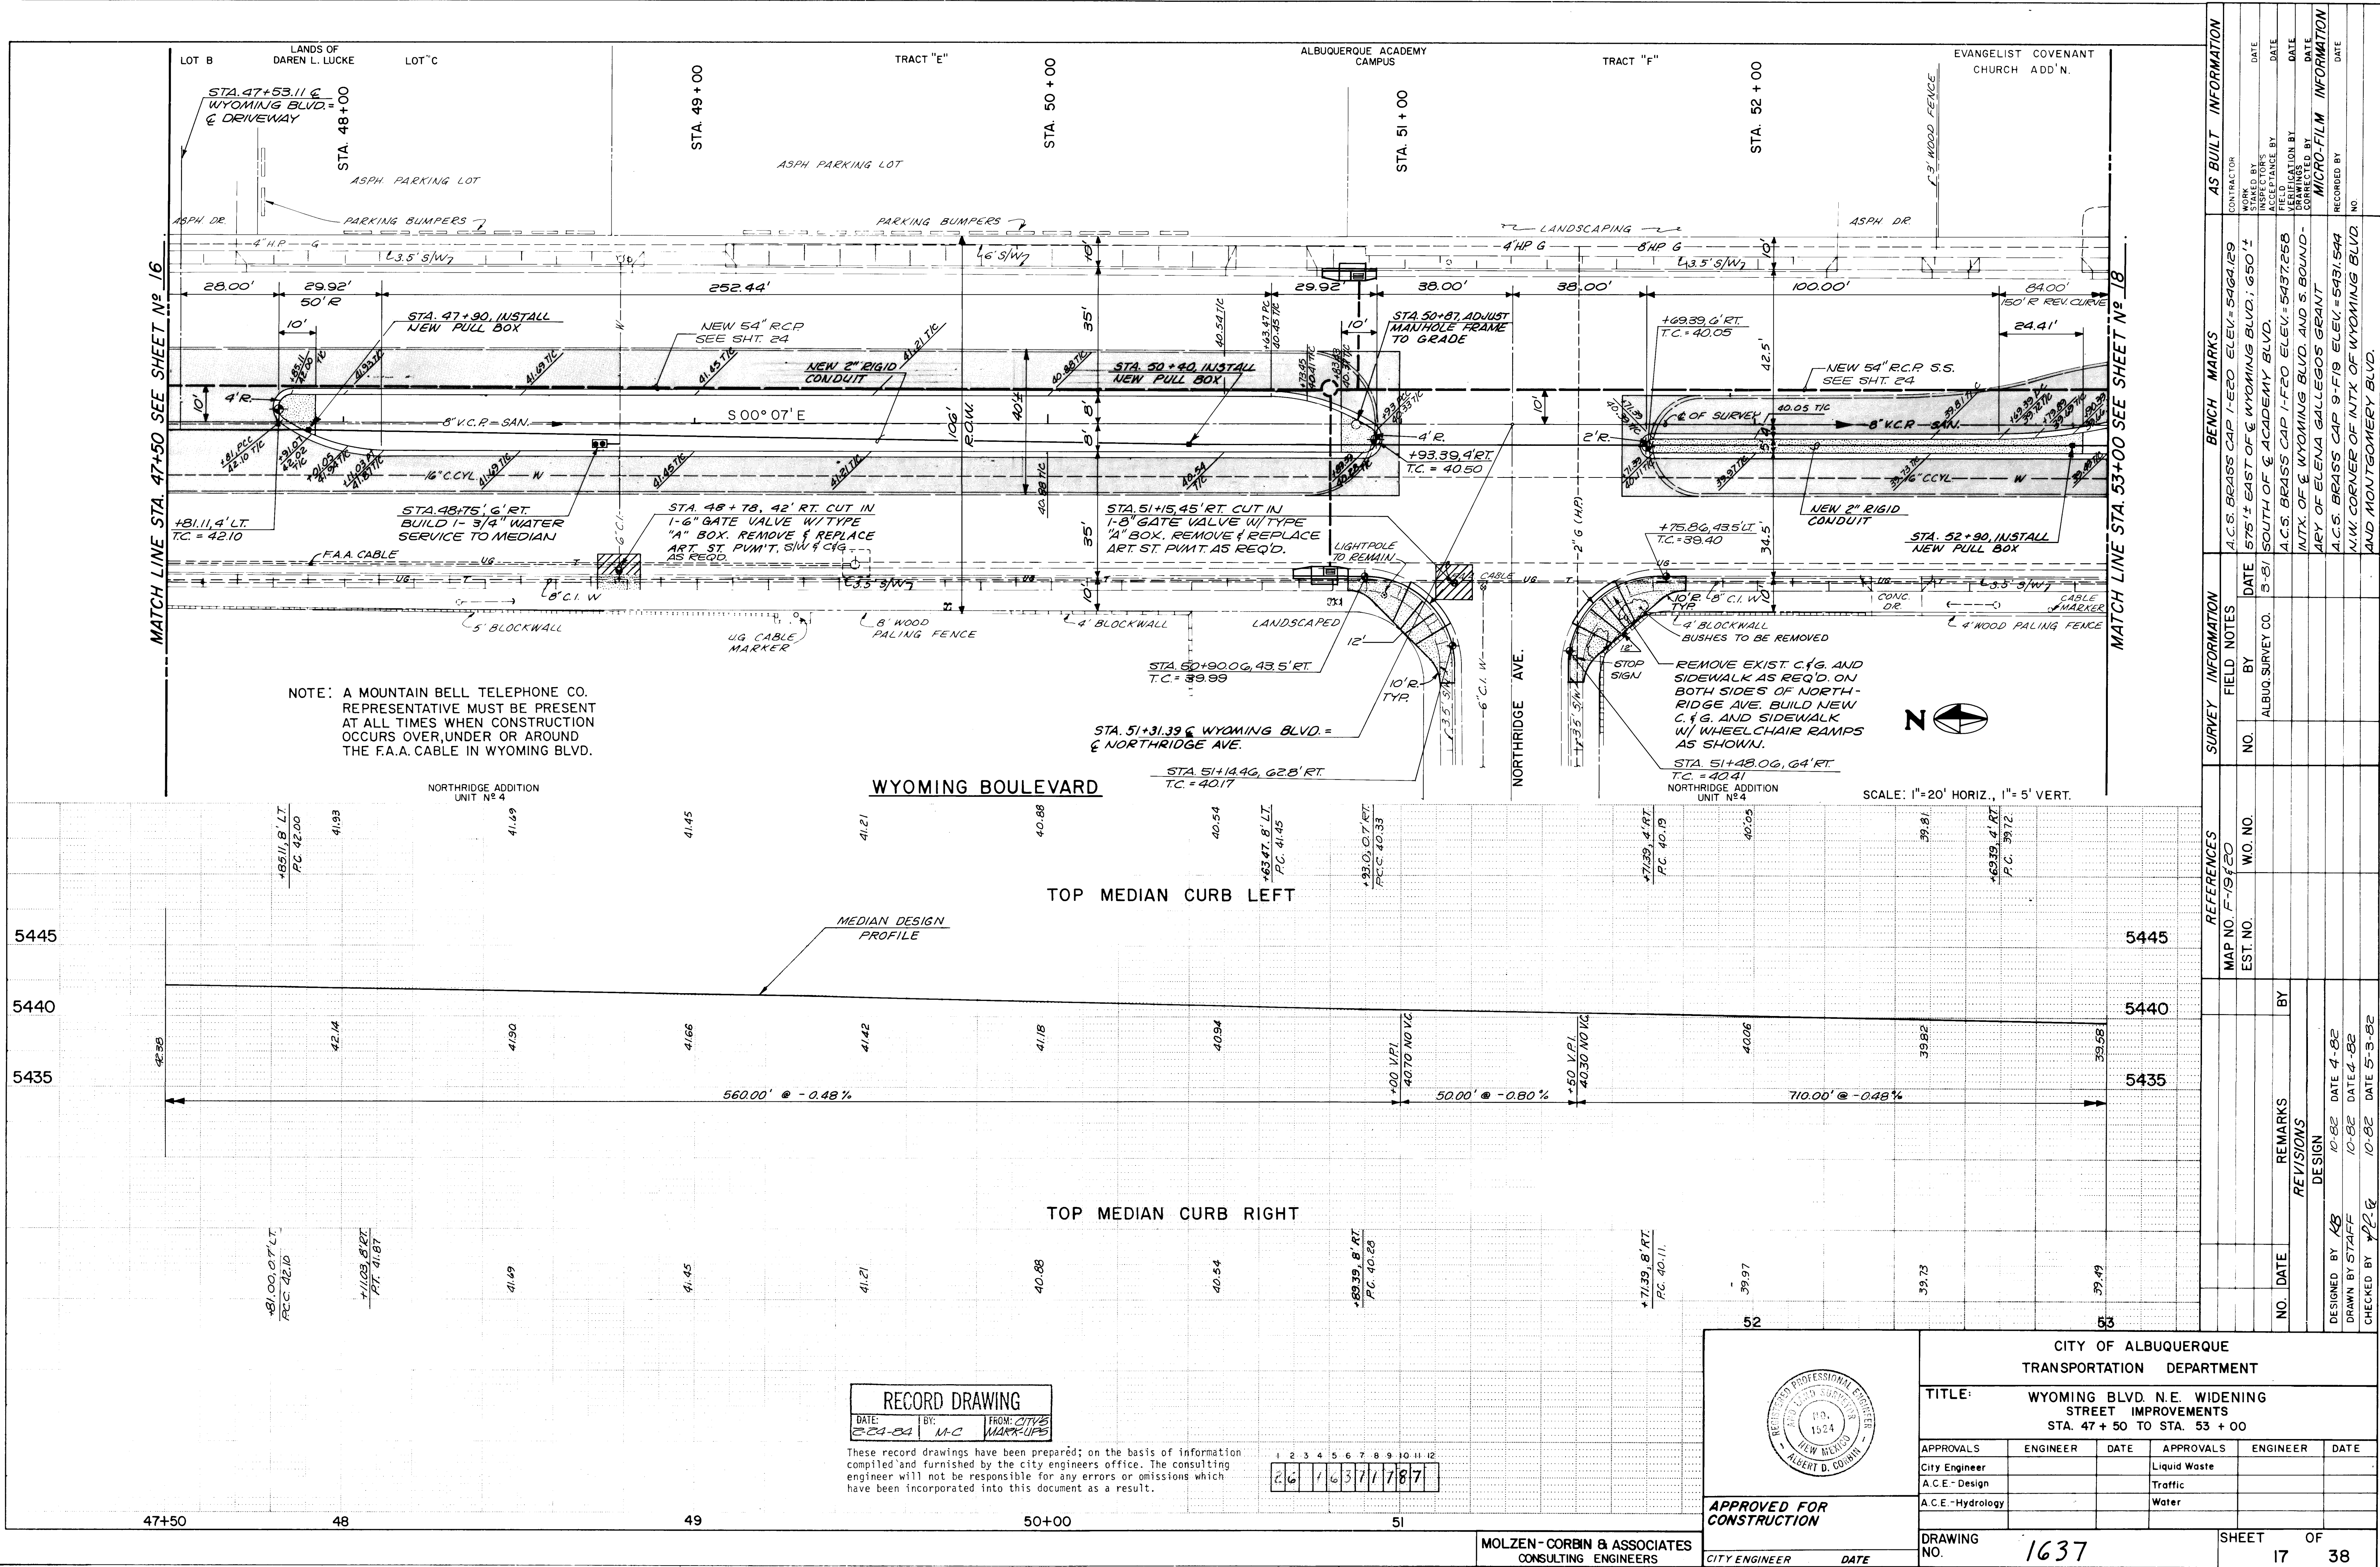

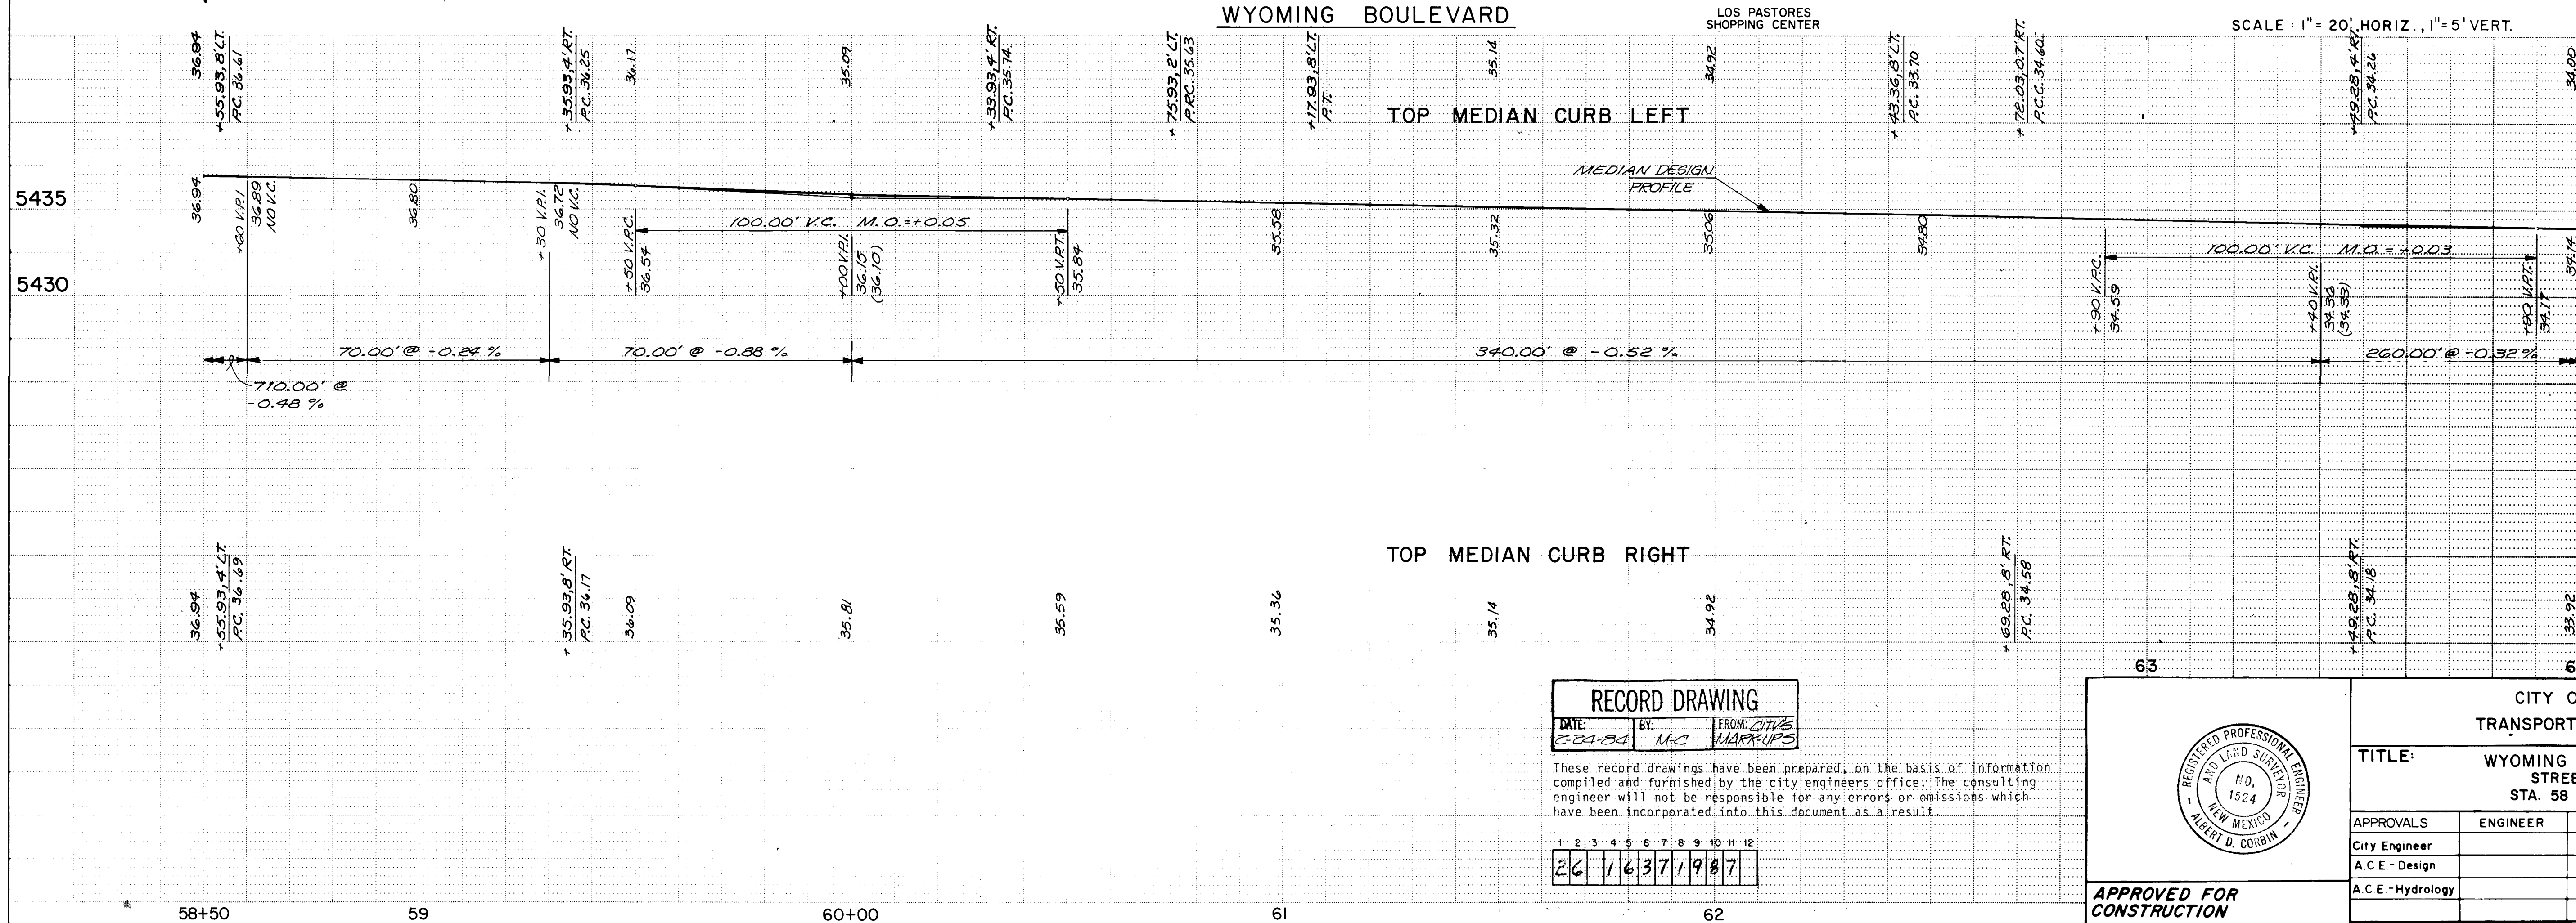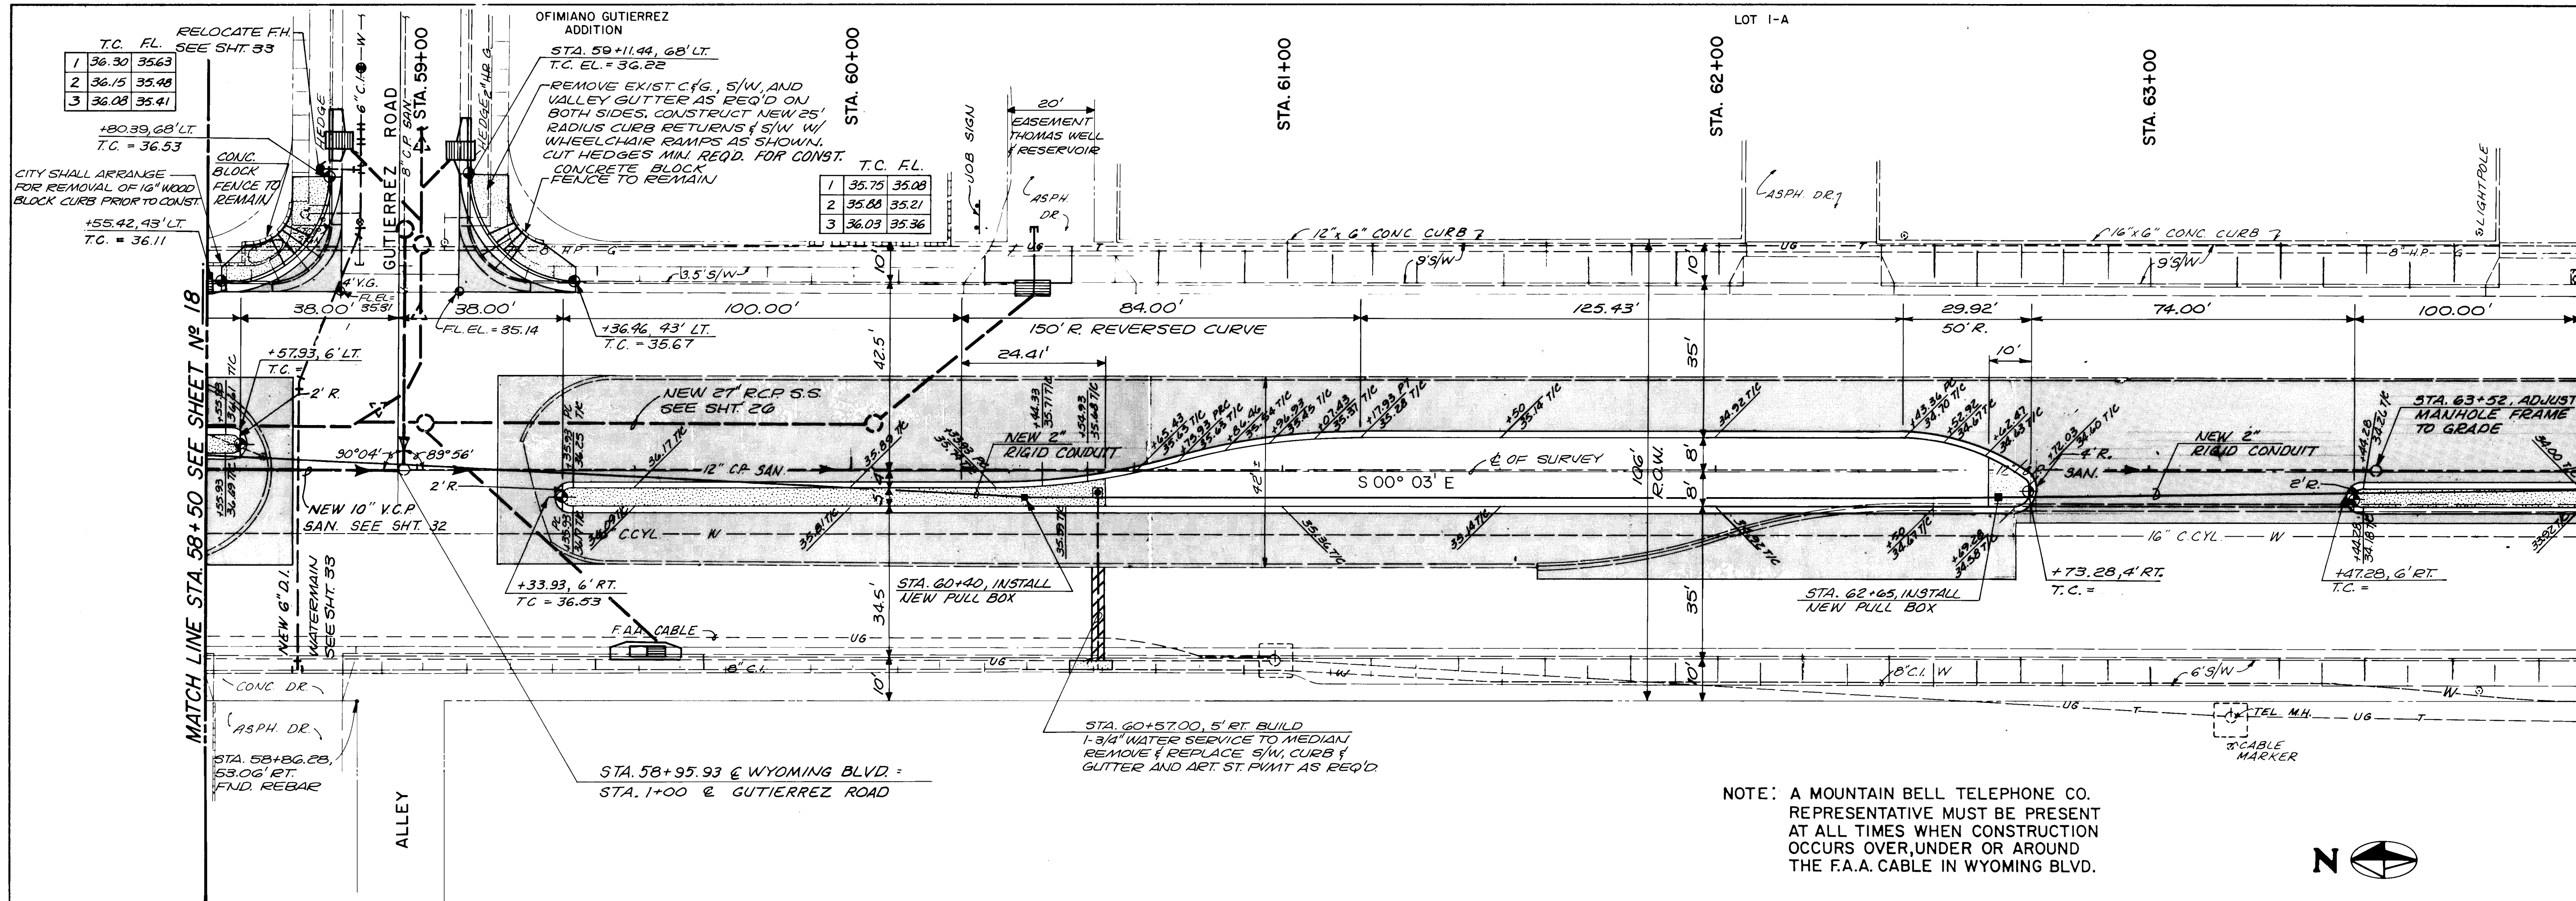

RECORD DRAWING
DATE: 5-24-82 BY: M.C. FROM: CIVIL MARK-UPS
These record drawings have been prepared, on the basis of information compiled and furnished by the city engineers office. The consulting engineer will not be responsible for any errors or omissions which have been incorporated into this document as a result.

1 2 3 4 5 6 7 8 9 10 11 12
26 1637 1987



APPROVED FOR CONSTRUCTION
CITY ENGINEER DATE

MOLZEN - CORBIN & ASSOCIATES
CONSULTING ENGINEERS
ALBUQUERQUE, CARLSBAD - NEW MEXICO


CITY OF ALBUQUERQUE TRANSPORTATION DEPARTMENT					
TITLE: WYOMING BLVD. N.E. WIDENING STREET IMPROVEMENTS STA. 58 + 50 TO STA. 64 + 00					
APPROVALS	ENGINEER	DATE	APPROVALS	ENGINEER	DATE
City Engineer			Liquid Waste		
A.C.E. - Design			Traffic		
A.C.E. - Hydrology			Water		
DRAWING NO. 1637			SHEET 19 OF 38		

MATCH LINE STA. 64+00 SEE SHEET No. 20



MATCH LINE STA. 58+50 SEE SHEET No. 18

NOTE: A MOUNTAIN BELL TELEPHONE CO. REPRESENTATIVE MUST BE PRESENT AT ALL TIMES WHEN CONSTRUCTION OCCURS OVER, UNDER OR AROUND THE F.A.A. CABLE IN WYOMING BLVD.

SURVEY INFORMATION			BENCH MARKS			AS BUILT INFORMATION		
NO.	BY	DATE	NO.	CONTRACTOR	DATE	NO.	CONTRACTOR	DATE
1	ALBUQ. SURVEY CO.	5-81	1	ACS BRASS CAP 1-E20	EL. = 5464.129 FT.	1	WORK	
2			2	575 FT. ± EAST OF & WYOMING BLVD.		2	STAKED BY	
3			3	650 FT. ± SOUTH OF & ACADEMY BLVD.		3	FIELD	
4			4	ACS BRASS CAP 1-F20	EL. = 5437.258 FT.	4	ACCEPTANCE BY	
5			5	INTX. OF & WYOMING BLVD. AND S.		5	DATE	
6			6	BOUNDARY OF ELENA GALLEGOS GRANT		6	DATE	
7			7	ACS BRASS CAP 9-F19	EL. = 5431.544 FT.	7	DATE	
8			8	NW CORNER OF INTX. OF WYOMING BLVD.		8	DATE	
9			9	AND MONTGOMERY BLVD.		9	DATE	

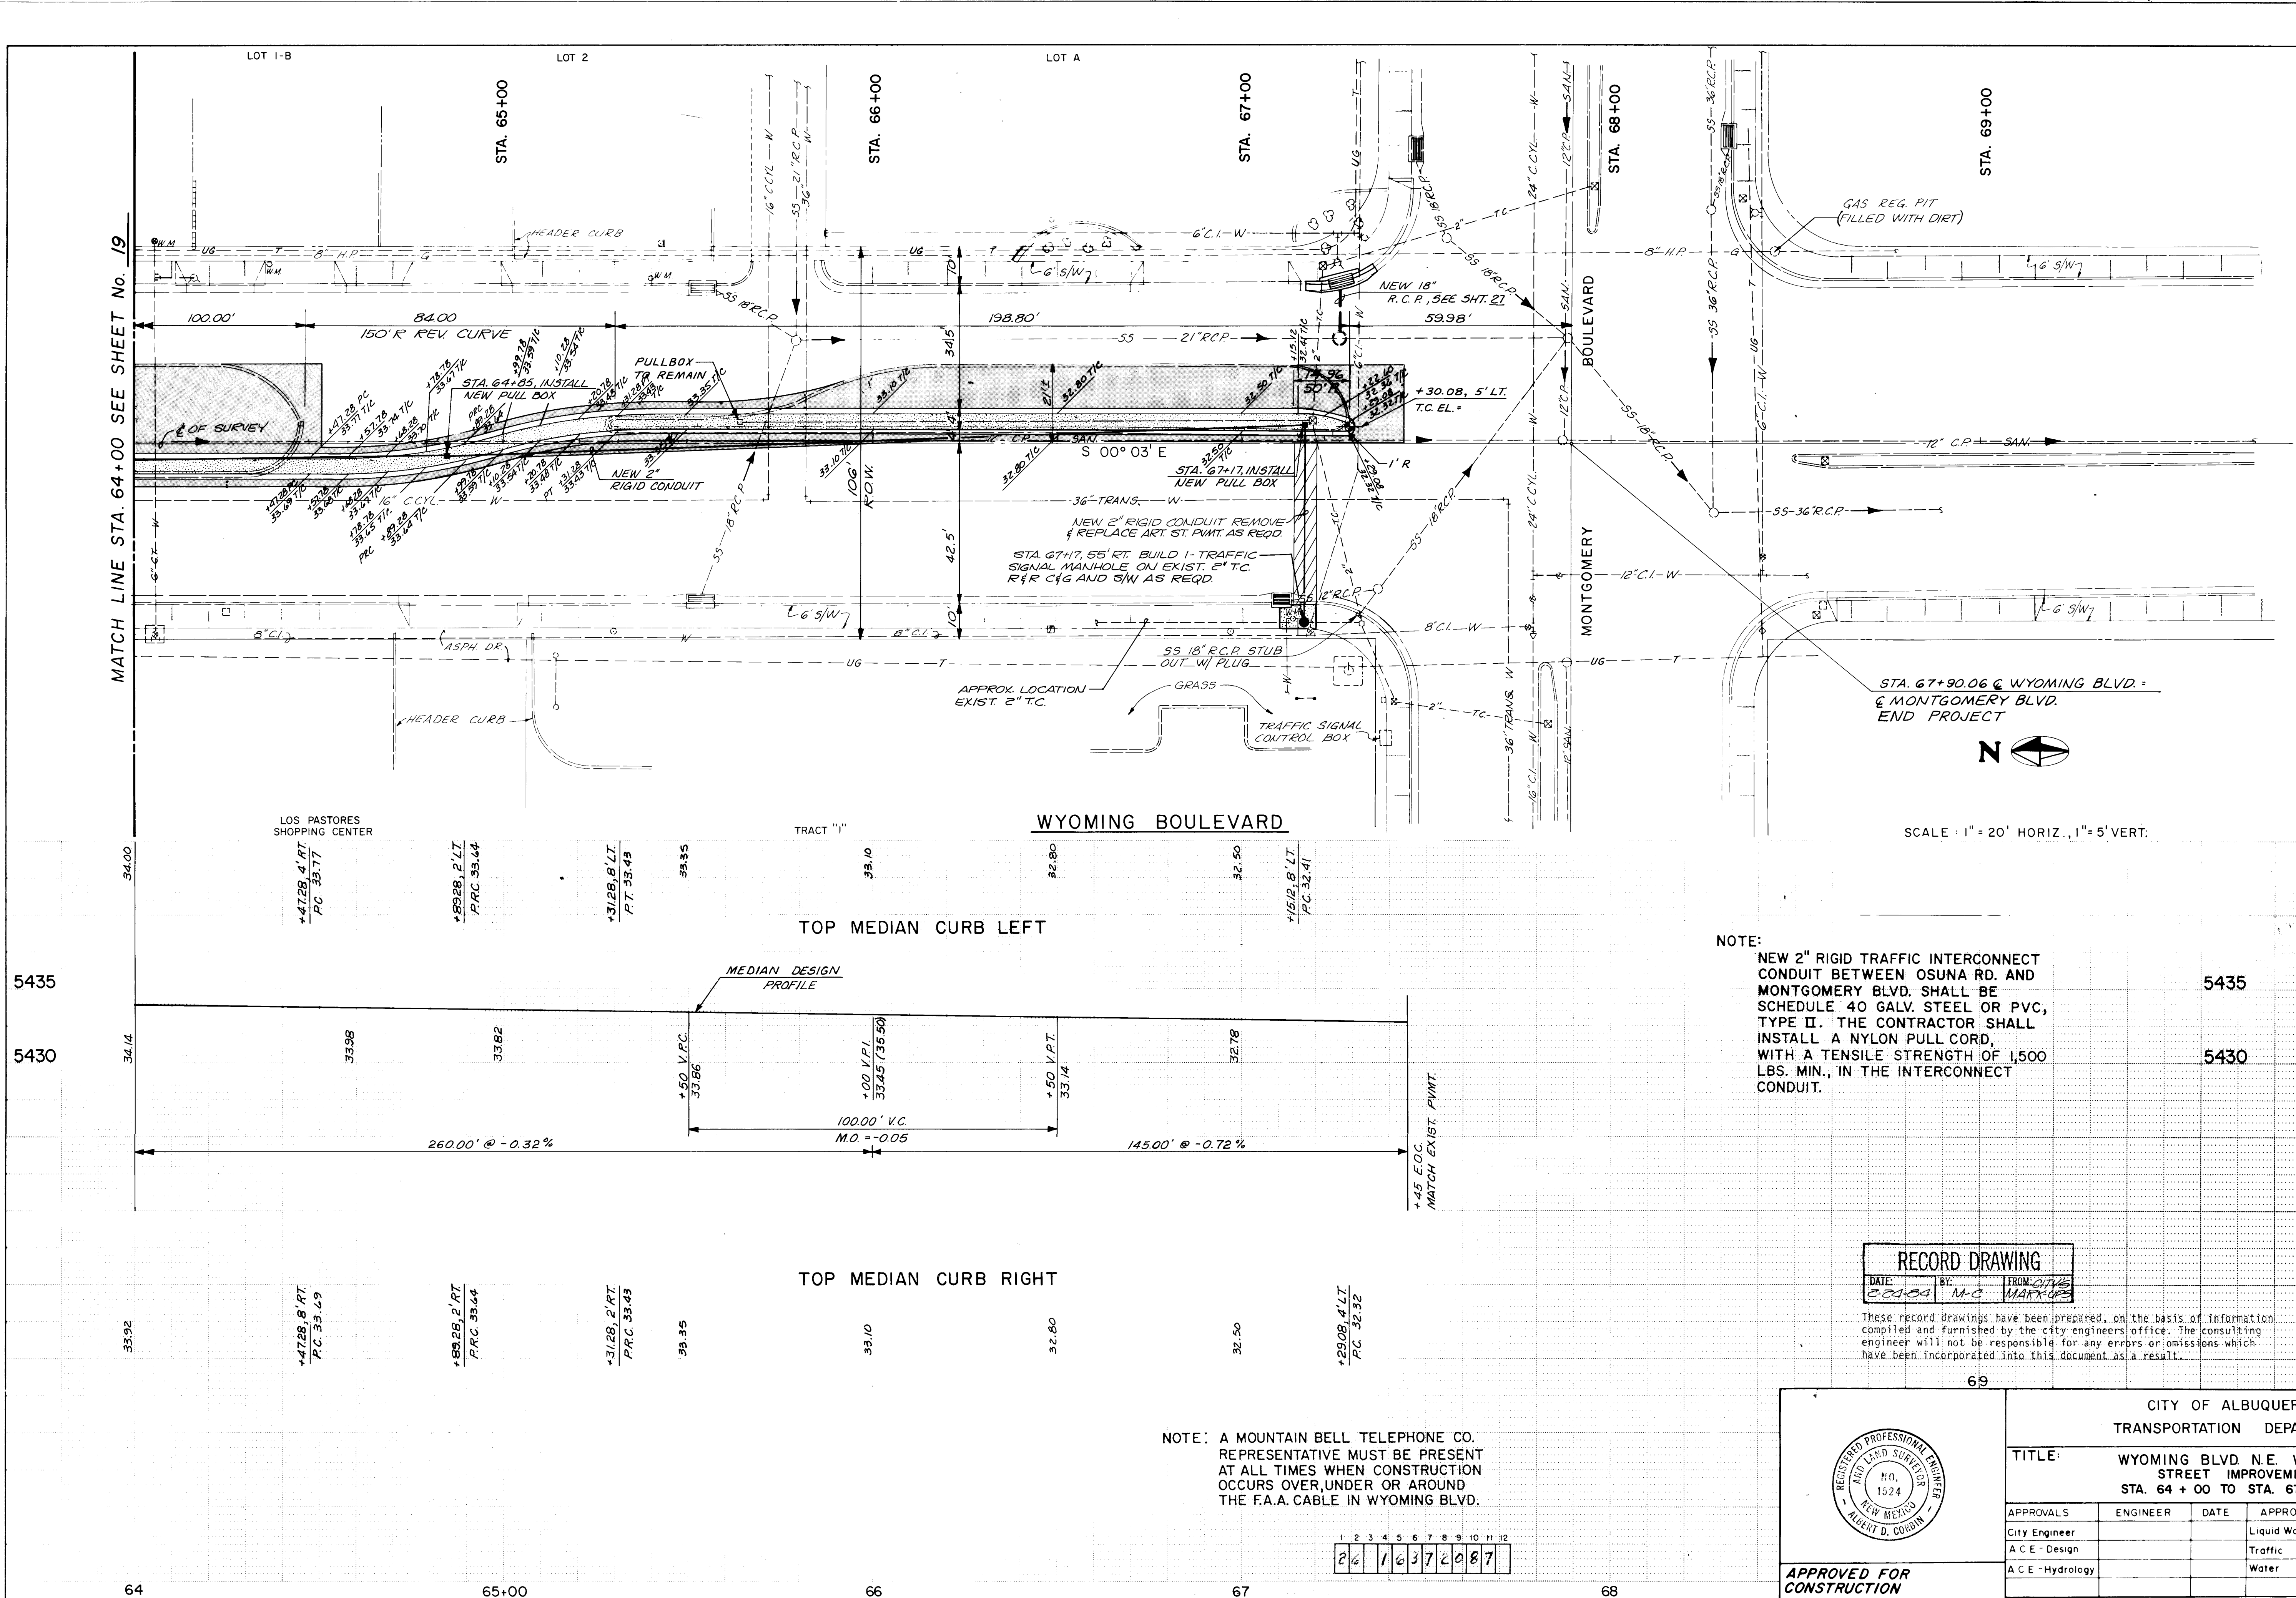


SURVEY INFORMATION		BENCH MARKS		AS BUILT INFORMATION	
NO.	BY	NO.	DATE	CONTRACTOR	DATE
ALBUQ. SURVEY CO.	3-81	ACS BRASS CAP 1-E20 EL. = 5464.129 FT.	575 FT. ± EAST OF E. WYOMING BLVD.;	WORK BY	DATE
		650 FT. ± SOUTH OF E. ACADEMY BLVD.		INSPECTOR'S	DATE
		ACS BRASS CAP 1-E20 EL. = 5437.258 FT.		ACCEPTANCE BY	DATE
		INTX. OF E. WYOMING BLVD. AND SOUTH		FIELD LOCATION BY	DATE
		BOUNDARY OF ELENA GALLEGOS GRANT		DRAWINGS	DATE
		ACS BRASS CAP 9-F19 EL. = 5431.544 FT.		CORRECTIONS	DATE
		NW CORNER OF INTX. OF WYOMING BLVD.		NO	DATE
		AND MONTGOMERY BLVD.			

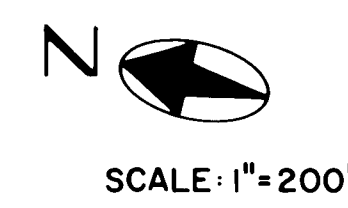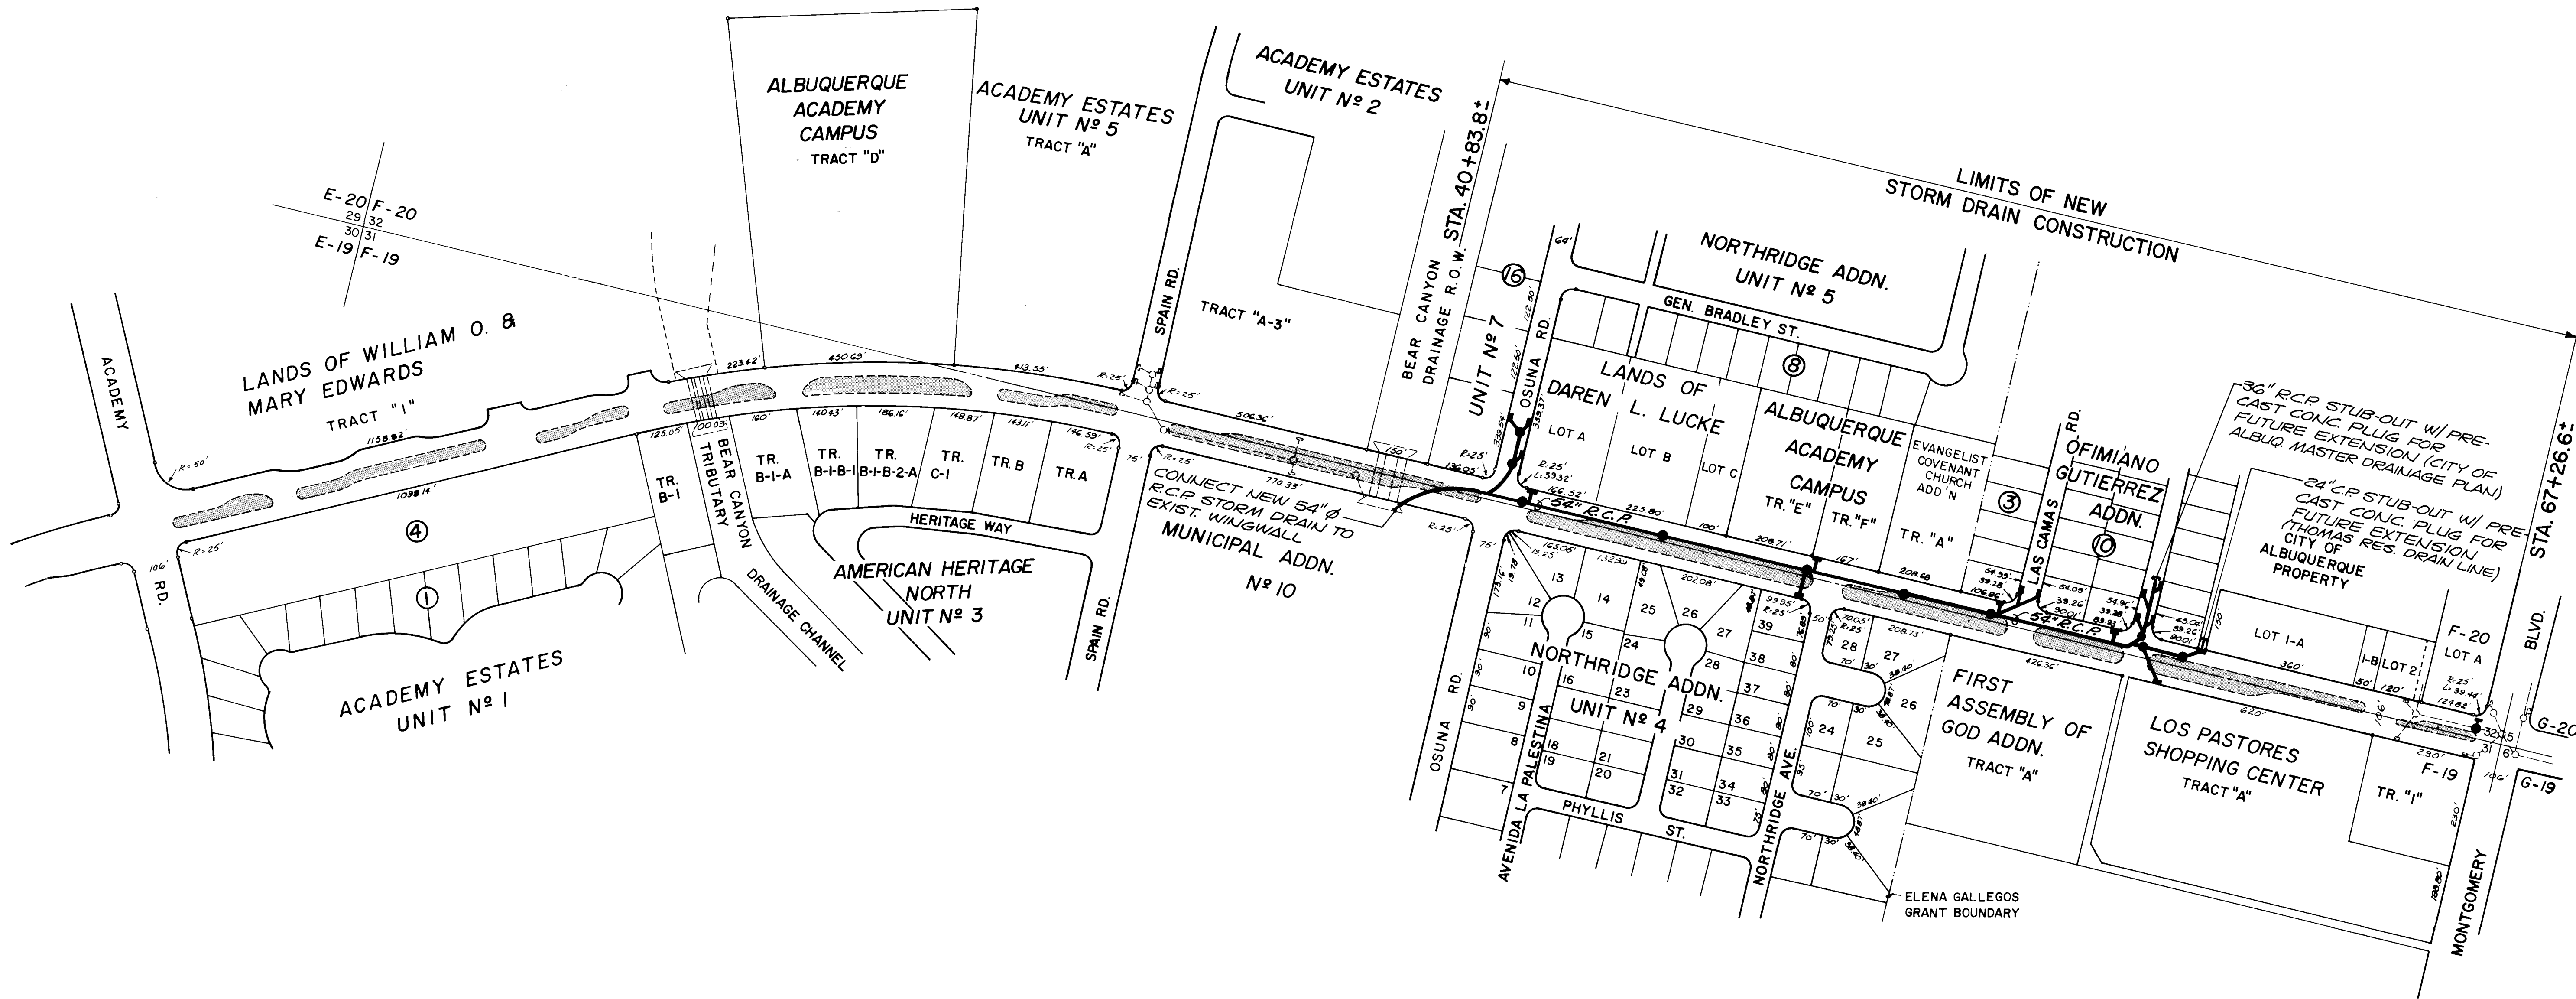

RECORD DRAWING
DATE: 8-24-84 BY: M-C FROM: CIVILS MARKUPS

These record drawings have been prepared, on the basis of information compiled and furnished by the city engineers office. The consulting engineer will not be responsible for any errors or omissions which have been incorporated into this document as a result.

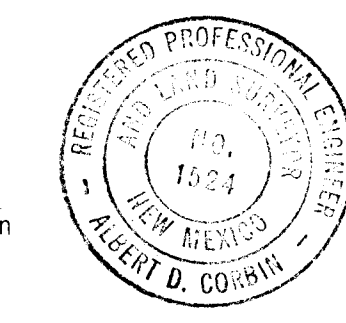


MOLZEN-CORBIN & ASSOCIATES
CONSULTING ENGINEERS
ALBUQUERQUE, CARLSBAD - NEW MEXICO

APPROVED FOR CONSTRUCTION
CITY ENGINEER DATE

CITY OF ALBUQUERQUE TRANSPORTATION DEPARTMENT					
TITLE: WYOMING BLVD. N.E. WIDENING ACADEMY RD. TO MONTGOMERY BLVD. STORM SEWER LOCATION MAP					
APPROVALS	ENGINEER	DATE	APPROVALS	ENGINEER	DATE
City Engineer			Liquid Waste		
A.C.E.-Design			Traffic		
A.C.E.-Hydrology			Water		
DRAWING NO.	1637		SHEET	OF 38	

REFERENCES		SURVEY INFORMATION		BENCH MARKS		AS BUILT INFORMATION	
MAP NO. F-19-1-20	EST. NO.	NO.	BY	FIELD NOTES	DATE	CONTRACTOR	DATE
			ALBUQ. SURVEY CO. S-B			WORK BY	DATE
						INSPECTORS	DATE
						ACCEPTANCE BY	DATE
						VERIFICATION BY	DATE
						DRAWINGS BY	DATE
						SUBMITTED BY	DATE
						MICRO-FILM INFORMATION	
						RECORDED BY	DATE
						NO	

1 2 3 4 5 6 7 8 9 10 11 12
26 16372187

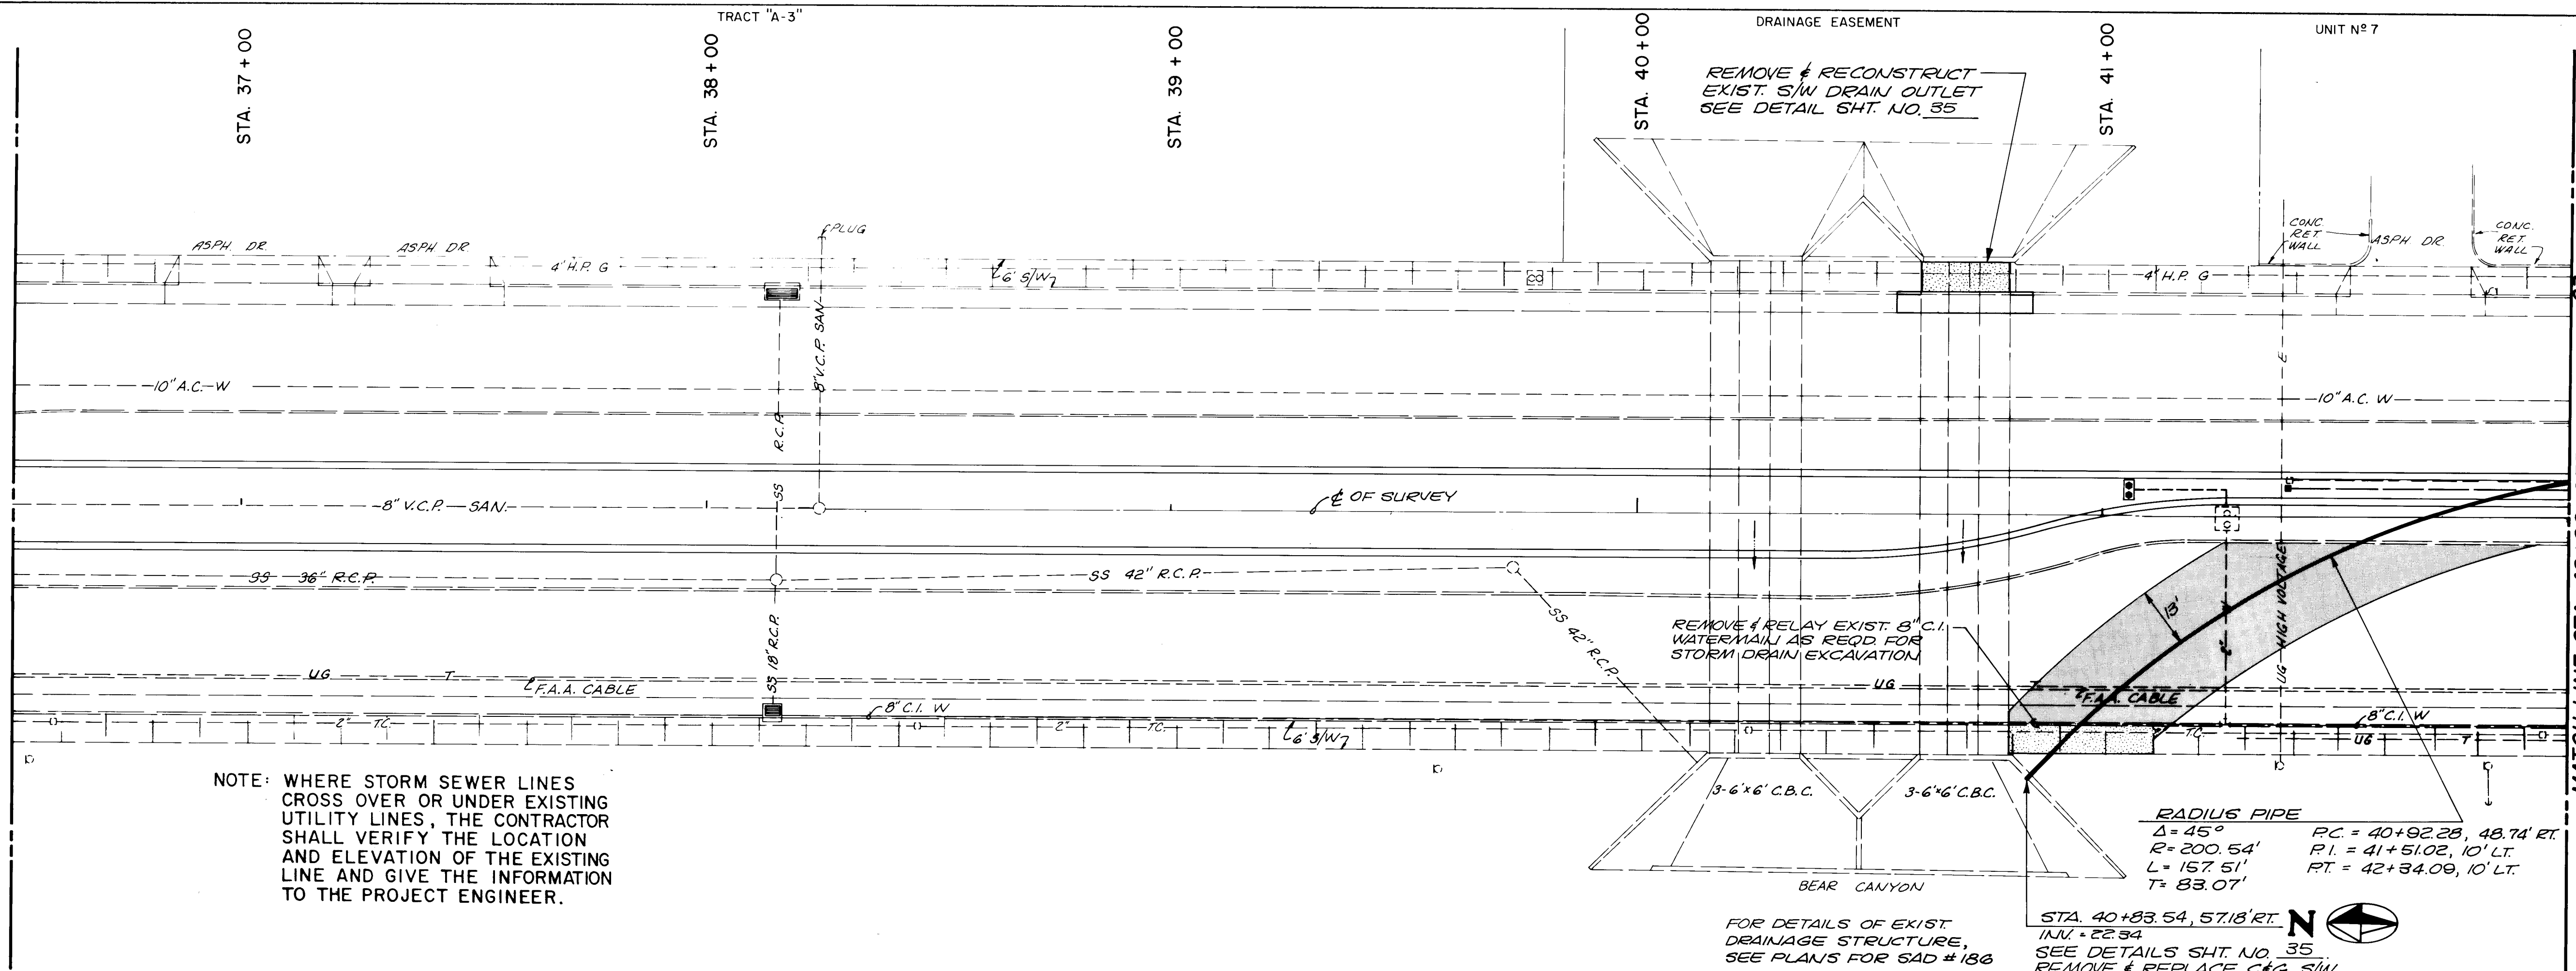

NOTE: WHERE STORM SEWER LINES CROSS OVER OR UNDER EXISTING UTILITY LINES, THE CONTRACTOR SHALL VERIFY THE LOCATION AND ELEVATION OF THE EXISTING LINE AND GIVE THE INFORMATION TO THE PROJECT ENGINEER.

ARROYO DEL OSO
CITY PARK

WYOMING BOULEVARD

MUNICIPAL ADDITION

BEAR CANYON

FOR DETAILS OF EXIST DRAINAGE STRUCTURE, SEE PLANS FOR SAD #186

REMOVE & RECONSTRUCT EXIST. S/W DRAIN OUTLET SEE DETAIL SHT. NO. 35

REMOVE & RELAY EXIST. 8" C.I. WATERMAIN AS REQ'D FOR STORM DRAIN EXCAVATION

REMOVE & REPLACE C&G, S/W & ART. ST. PUNT. AS REQ'D.

RADIUS PIPE
 $\Delta = 45^\circ$
 $R = 200.54'$
 $L = 157.51'$
 $T = 83.07'$
 $P.C. = 40+92.28, 48.74' RT.$
 $P.I. = 41+51.02, 10' LT.$
 $P.T. = 42+84.09, 10' LT.$

SCALE: 1" = 20' HORIZ., 1" = 5' VERT.

54" R.C.P. CL. II
 531.86' @ 0.50 %

APPROX. LOCATION 2" WATER SERVICE DEPTH UNKNOWN

APPROX. LOCATION U.G. HIGH VOLTAGE ELEC. DEPTH UNKNOWN

APPROX. LOCATION FAA CABLE

NOTE: CLASS 'B' BEDDING REQUIRED FOR ALL STORM DRAINS

MATCH LINE STA. 42+00 SEE SHEET No. 23

5440
5435
5430
5425
5420


5440
5435
5430
5425
5420

RECORD DRAWING
 DATE: 10-82 BY: M-C FROM: CITY'S MARK-UPS

These record drawings have been prepared, on the basis of information compiled and furnished by the city engineers office. The consulting engineer will not be responsible for any errors or omissions which have been incorporated into this document as a result.

NOTE: A MOUNTAIN BELL TELEPHONE CO. REPRESENTATIVE MUST BE PRESENT AT ALL TIMES WHEN CONSTRUCTION OCCURS OVER, UNDER OR AROUND THE F.A.A. CABLE IN WYOMING BLVD.

1 2 3 4 5 6 7 8 9 10 11 12
 26 16 57 28 7

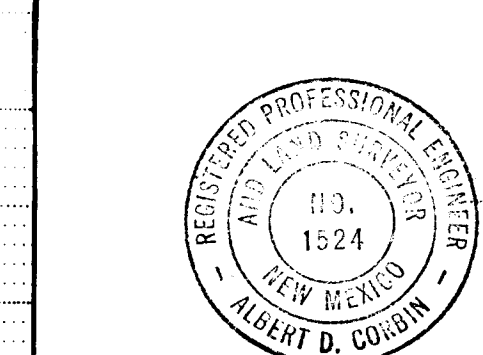

APPROVED FOR CONSTRUCTION

MOLZEN - CORBIN & ASSOCIATES
CONSULTING ENGINEERS
ALBUQUERQUE, CARLSBAD - NEW MEXICO

CITY OF ALBUQUERQUE
TRANSPORTATION DEPARTMENT


TITLE: WYOMING BLVD. N.E. WIDENING
STORM SEWER IMPROVEMENTS
STA. 36 + 50 TO STA. 42 + 00

APPROVALS	ENGINEER	DATE	APPROVALS	ENGINEER	DATE
City Engineer			Liquid Waste		
A.C.E. - Design			Traffic		
A.C.E. - Hydrology			Water		

DRAWING NO. 1637 SHEET 22 OF 38

SURVEY INFORMATION		BENCH MARKS		AS BUILT INFORMATION	
NO.	BY	DATE	FIELD NOTES	CONTRACTOR	NO.
1	ALBUQ. SURVEY CO.	3-81	ACS BRASS CAP 1-E20 EL. = 5444.129 FT.	WORK	1
2			575 FT. ± EAST OF WYOMING BLVD. ;	STATED BY	2
3			650 FT. ± SOUTH OF ACADEMY BLVD.	ACCEPTANCE BY	3
4			ACS BRASS CAP 1-E20 EL. = 5437.258 FT.	FIELD	4
5			INTX. OF WYOMING BLVD. AND S.	DEVELOPMENT BY	5
6			BOUNDARY OF ELENA GALLEGOS GRANT.	CORRECTED BY	6
7			ACS BRASS CAP 9-F19 EL. = 5431.544 FT.	RECORDED BY	7
8			NW CORNER OF INTX. OF WYOMING	NO.	8
9			BLVD. AND MONTGOMERY BLVD.		

NO.	DATE	REVISIONS
DESIGNED BY	10-82	DATE 4-82
DRAWN BY	10-82	DATE 4-82
CHECKED BY	10-82	DATE 5-3-82

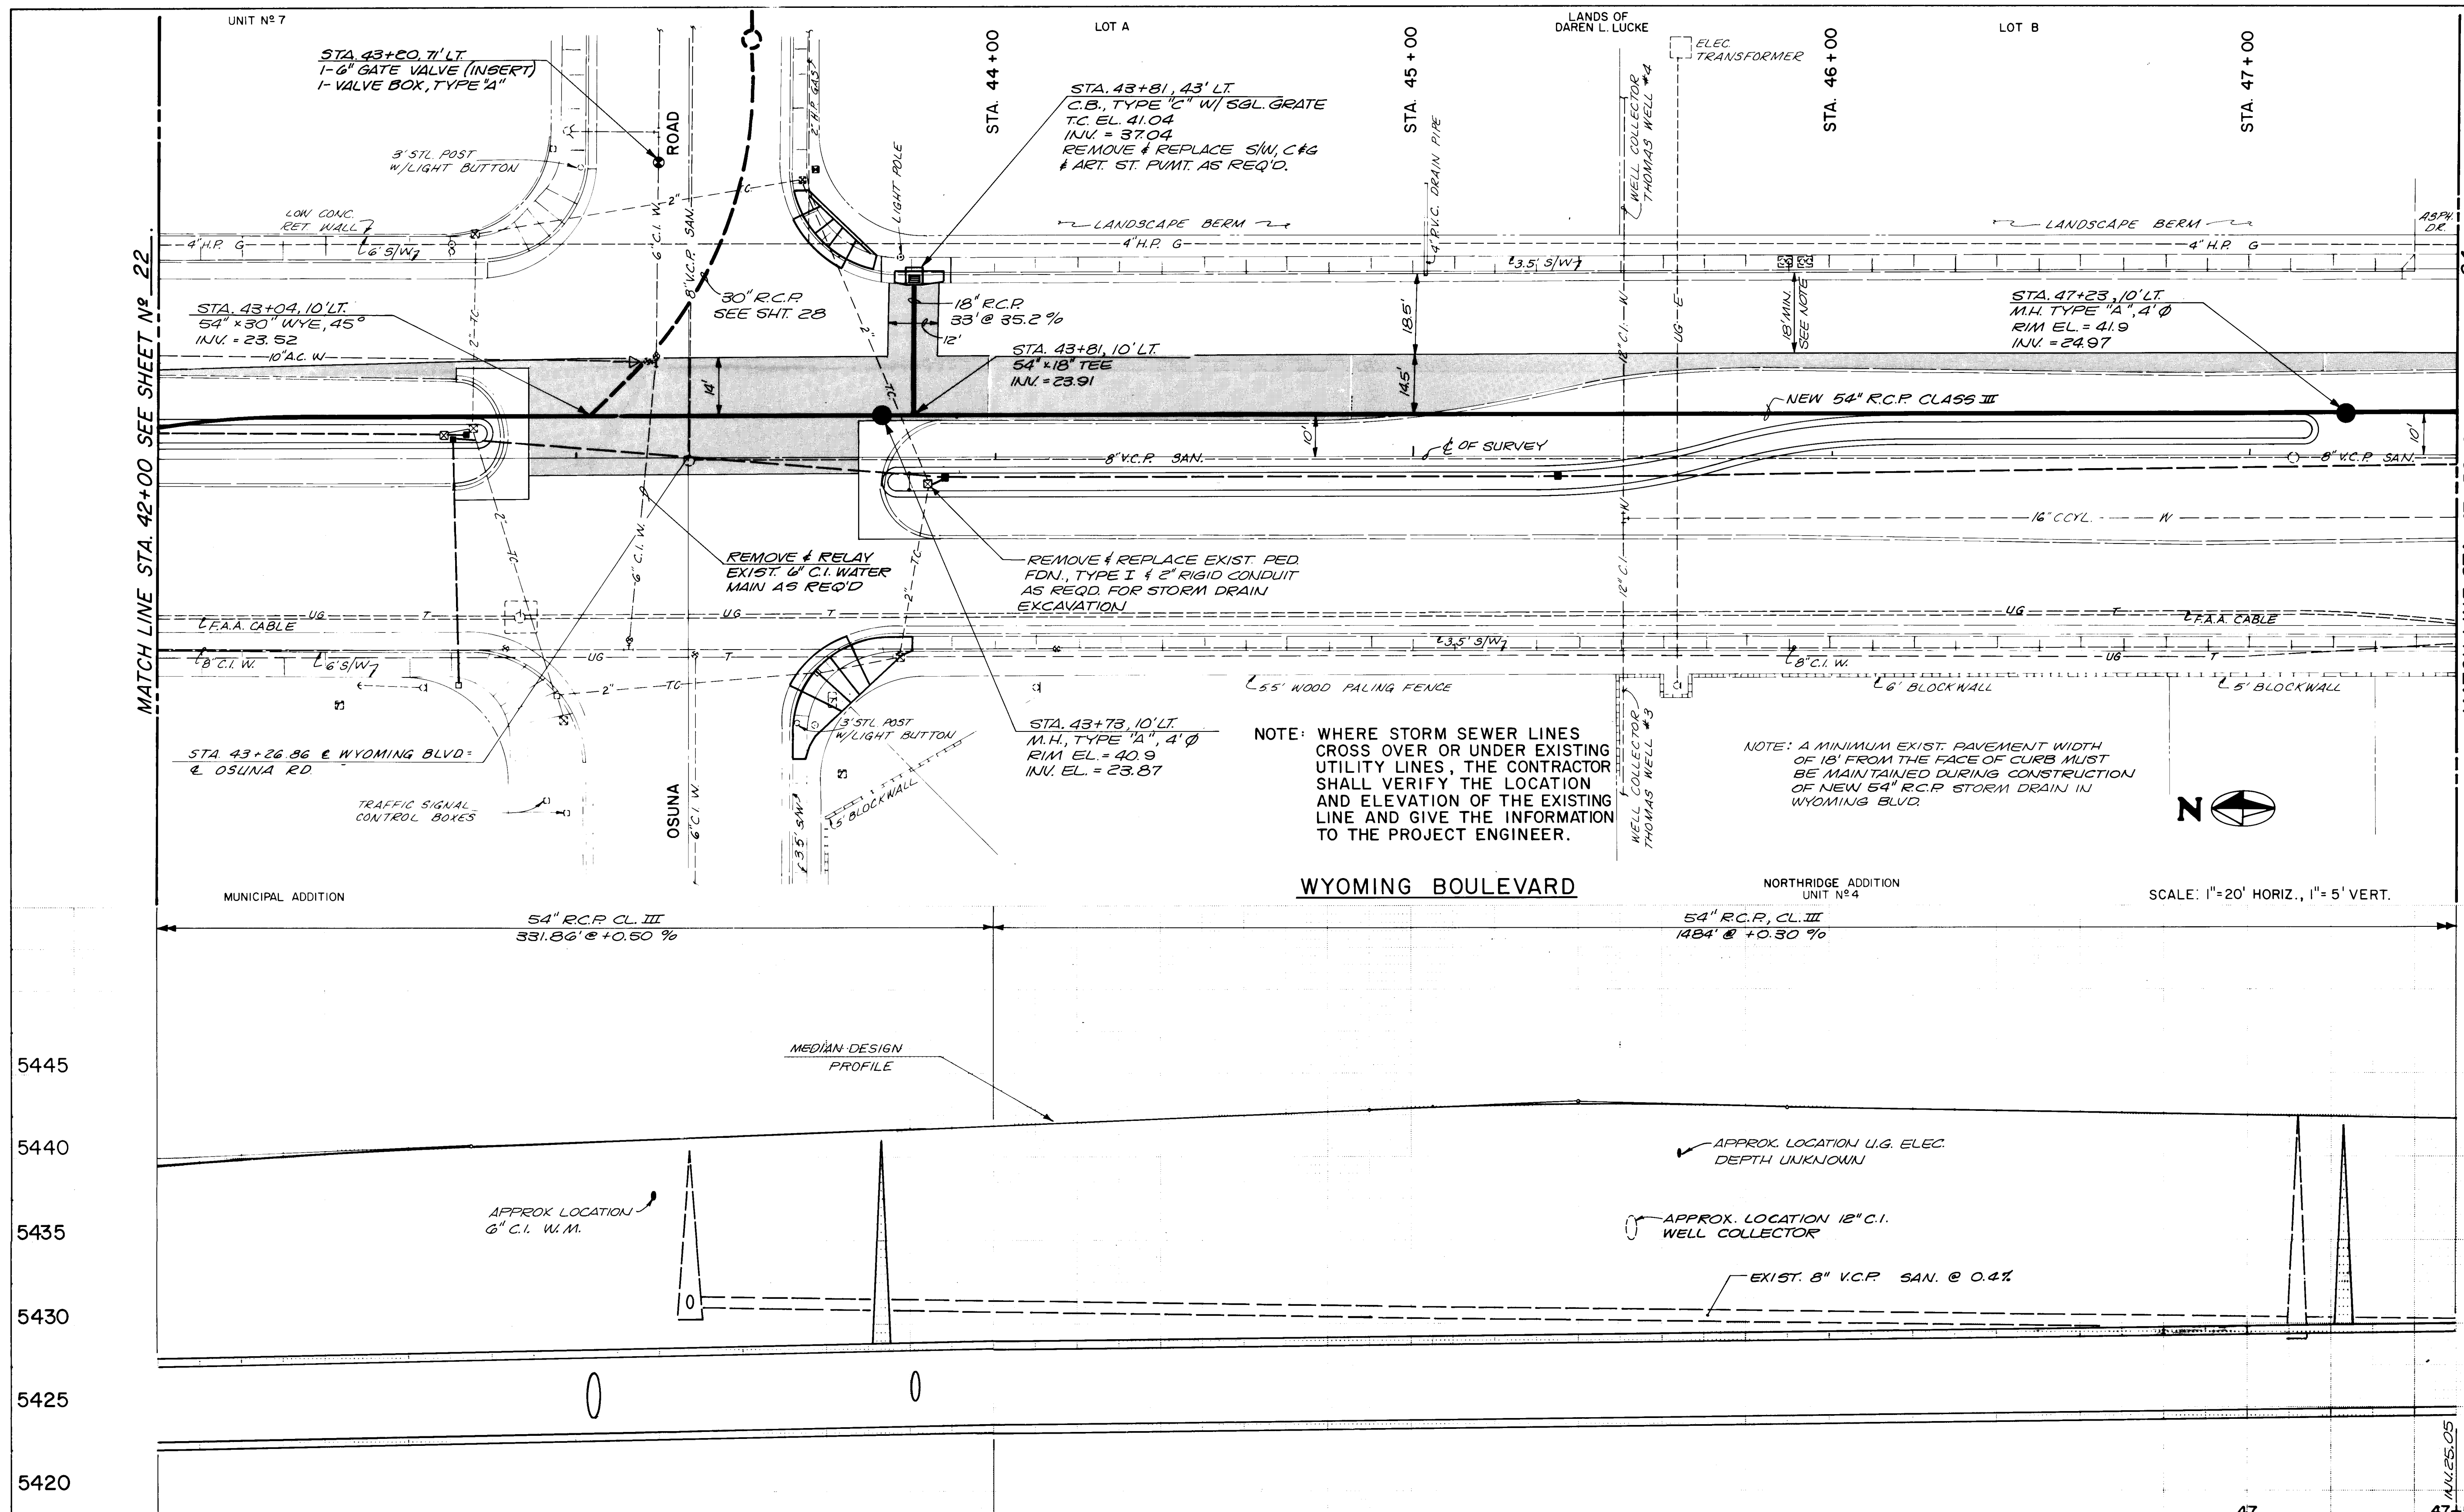

NOTE: WHERE STORM SEWER LINES CROSS OVER OR UNDER EXISTING UTILITY LINES, THE CONTRACTOR SHALL VERIFY THE LOCATION AND ELEVATION OF THE EXISTING LINE AND GIVE THE INFORMATION TO THE PROJECT ENGINEER.

NOTE: A MINIMUM EXIST. PAVEMENT WIDTH
OF 18' FROM THE FACE OF CURB MUST
BE MAINTAINED DURING CONSTRUCTION
OF NEW 54" R.C.P. STORM DRAIN IN
WYOMING BLVD.

SCALE: 1"=20' HORIZ., 1"= 5' VERT

NOTE: A MOUNTAIN BELL TELEPHONE CO. REPRESENTATIVE MUST BE PRESENT AT ALL TIMES WHEN CONSTRUCTION OCCURS OVER, UNDER OR AROUND THE F.A.A. CABLE IN WYOMING BLVD.

1	2	3	4	5	6	7	8	9	10	11	12
26			16	3	7	2	3	8	7		



**APPROVED FOR
CONSTRUCTION**

CITY ENGINEER DATE

CITY OF ALBUQUERQUE
TRANSPORTATION DEPARTMENT

TITLE: WYOMING BLVD. N.E. WIDENING
STORM SEWER IMPROVEMENTS
STA. 42 + 00 TO STA. 47 + 50

APPROVALS	ENGINEER	DATE	APPROVALS	ENGINEER	DATE
City Engineer			Liquid Waste		
A C E - Design			Traffic		
A C E -Hydrology			Water		

DRAWING NO.	1637	SHEET 23 OF 38
-------------	------	----------------



AS BUILT INFORMATION	DATE
CONTRACTOR	DATE
WORK	DATE
STAKED BY	DATE
INSPECTOR'S	DATE
ACCEPTANCE BY	DATE
FIELD	DATE
VERIFICATION BY	DATE
CORRECTED BY	DATE
MICRO-FILM INFORMATION	DATE
RECORDED BY	DATE
IO	DATE

BENCH	MARKS
A.C.S. BR253 CAP 1-F20	EL. = 5464.129 FT.
575 FT. ± EAST OF & ACADEMY BLVD. ;	
650 FT. ± SOUTH OF & ACADEMY BLVD.	
A.C.S. BR255 CAP 1-F20	EL. = 5437.268 FT.
INTX. OF & WYOMING BLVD. AND S.	
BOUNDARY OF ELEVA GALLEDOS GRANT.	
A.C.S. BR253 CAP 9-F19	EL. = 5431.944 FT.
N.W. CORNER OF INTX. OF	

[illegible]

REFERENCES	
MAP NO. F 19 & 20	
EST. NO.	W.O. NO.

[illegible][illegible]

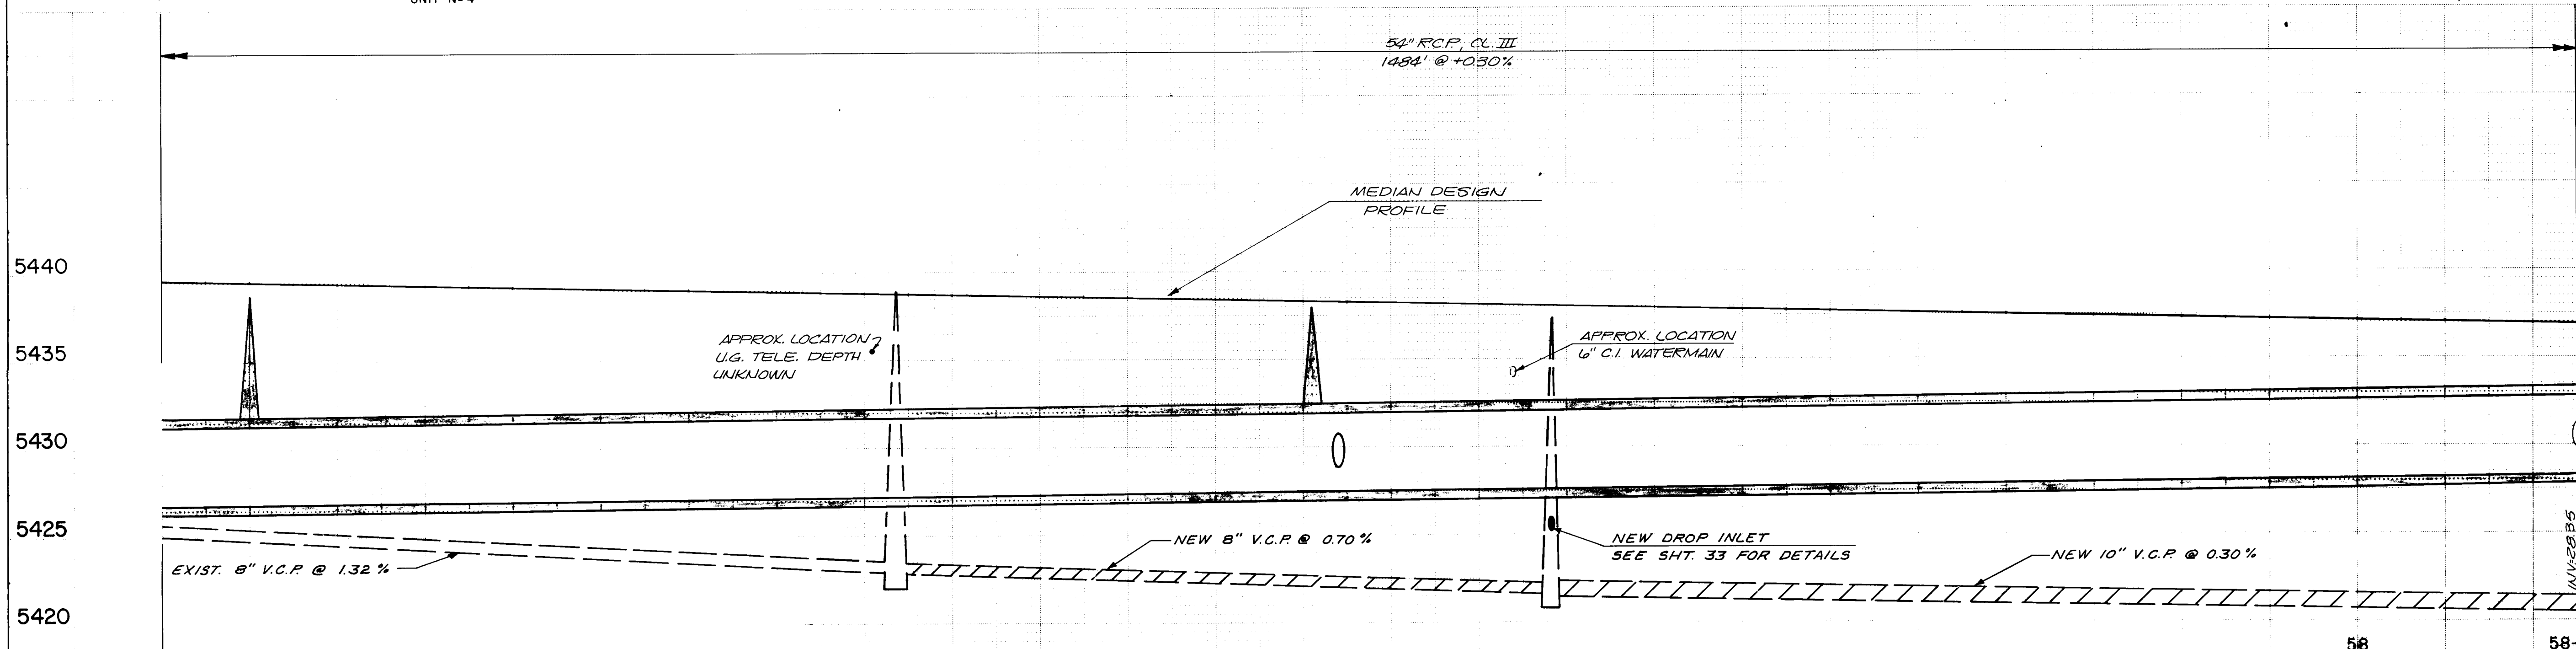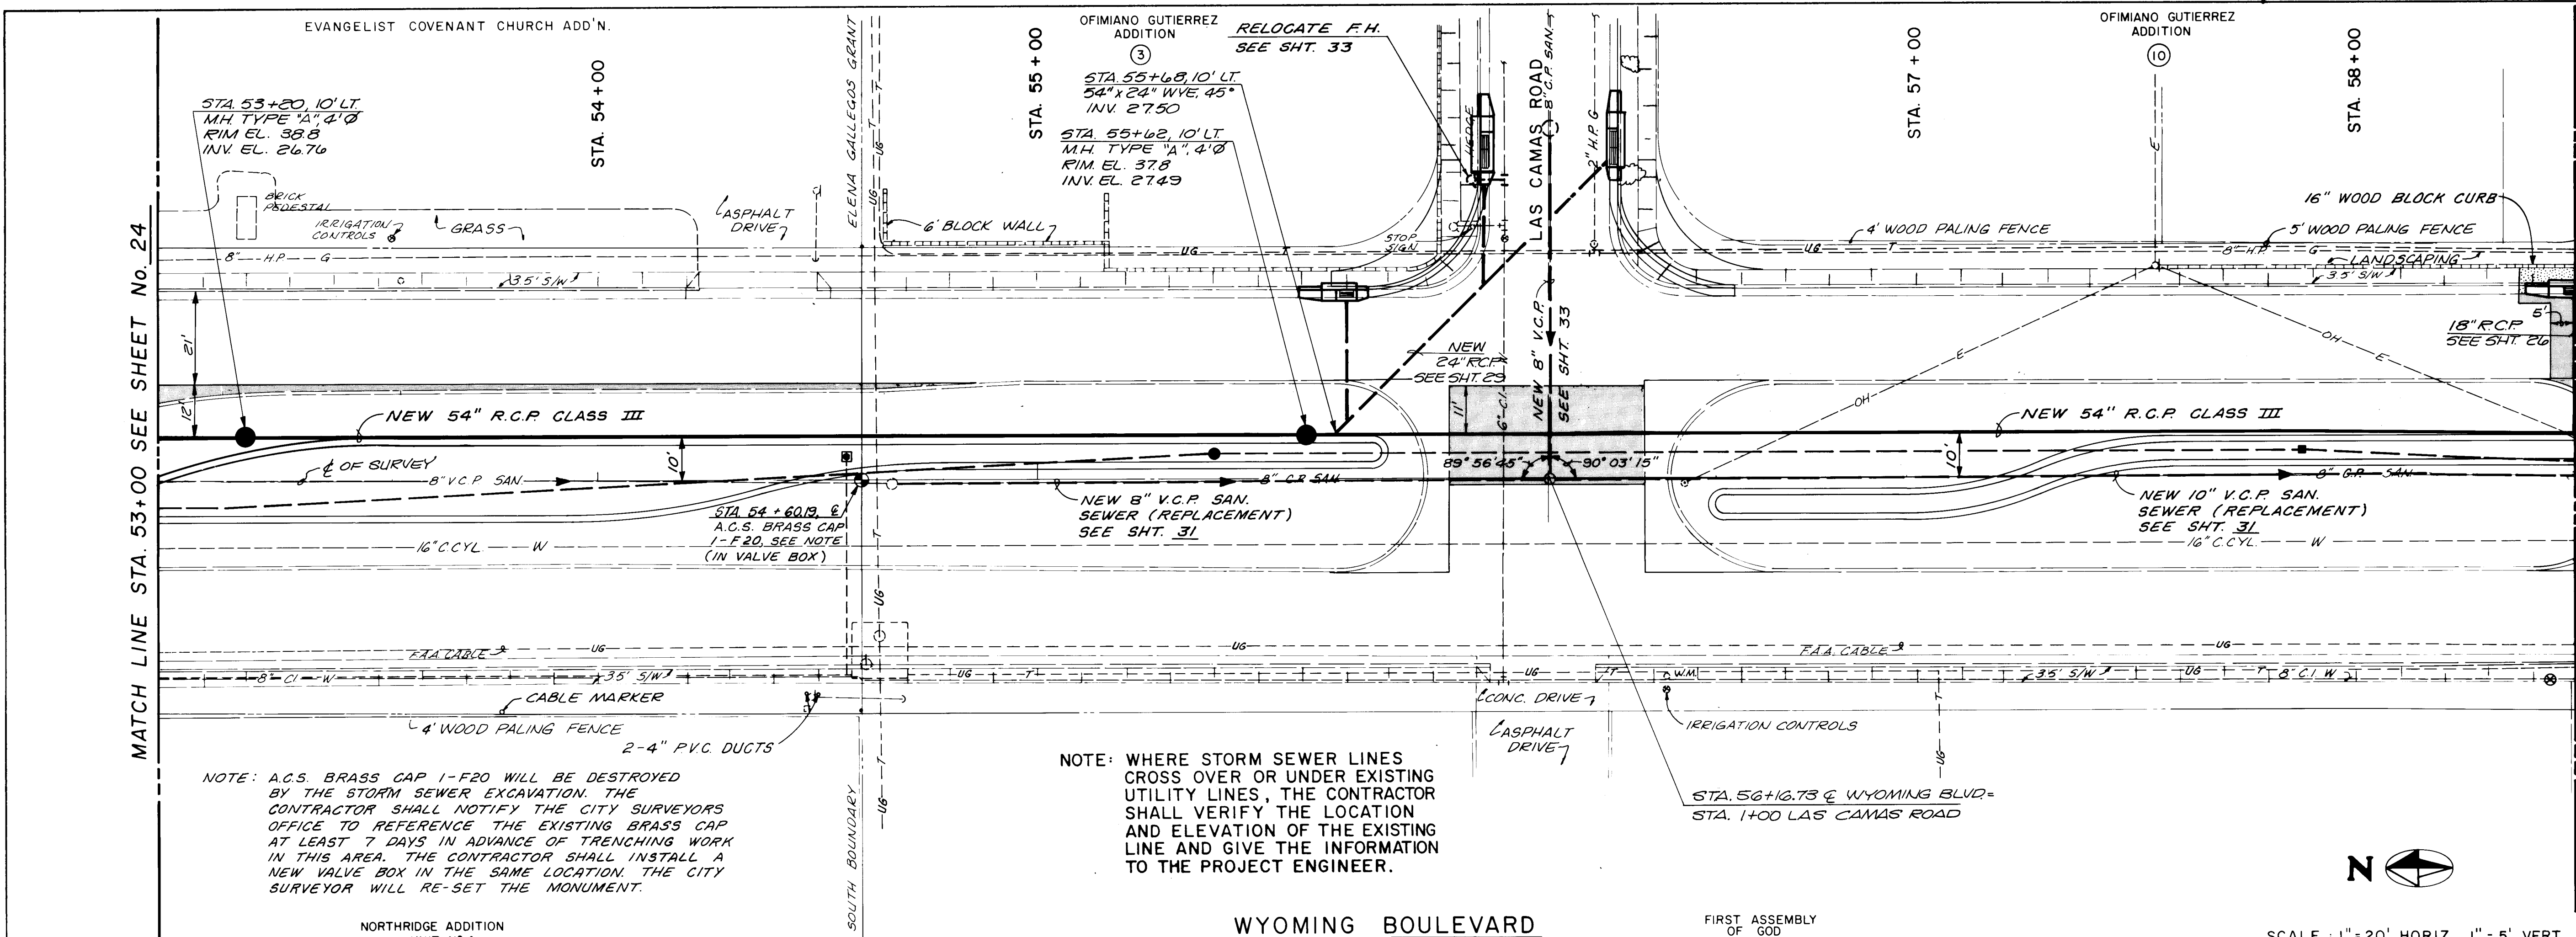

RECORD DRAWING
DATE: 3-21-84 BY: M-C FROM: CITY'S MARKUPS


These record drawings have been prepared, on the basis of information compiled and furnished by the city engineers office. The consulting engineer will not be responsible for any errors or omissions which have been incorporated into this document as a result.


NOTE: A MOUNTAIN BELL TELEPHONE CO. REPRESENTATIVE MUST BE PRESENT AT ALL TIMES WHEN CONSTRUCTION OCCURS OVER, UNDER OR AROUND THE F.A.A. CABLE IN WYOMING BLVD.


CITY OF ALBUQUERQUE TRANSPORTATION DEPARTMENT					
TITLE: WYOMING BLVD. N.E. WIDENING STORM SEWER IMPROVEMENTS STA. 53 + 00 TO STA. 58 + 50					
APPROVALS	ENGINEER	DATE	APPROVALS	ENGINEER	DATE
City Engineer			Liquid Waste		
A.C.E. - Design			Traffic		
A.C.E. - Hydrology			Water		
DRAWING NO. 1637			SHEET 25 OF 38		


APPROVED FOR CONSTRUCTION
CITY ENGINEER DATE

DESIGNED BY: RB 10-82 DATE: 4-82
DRAWN BY: STAFF 10-82 DATE: 4-82
CHECKED BY: JPD 10-82 DATE: 5-3-82

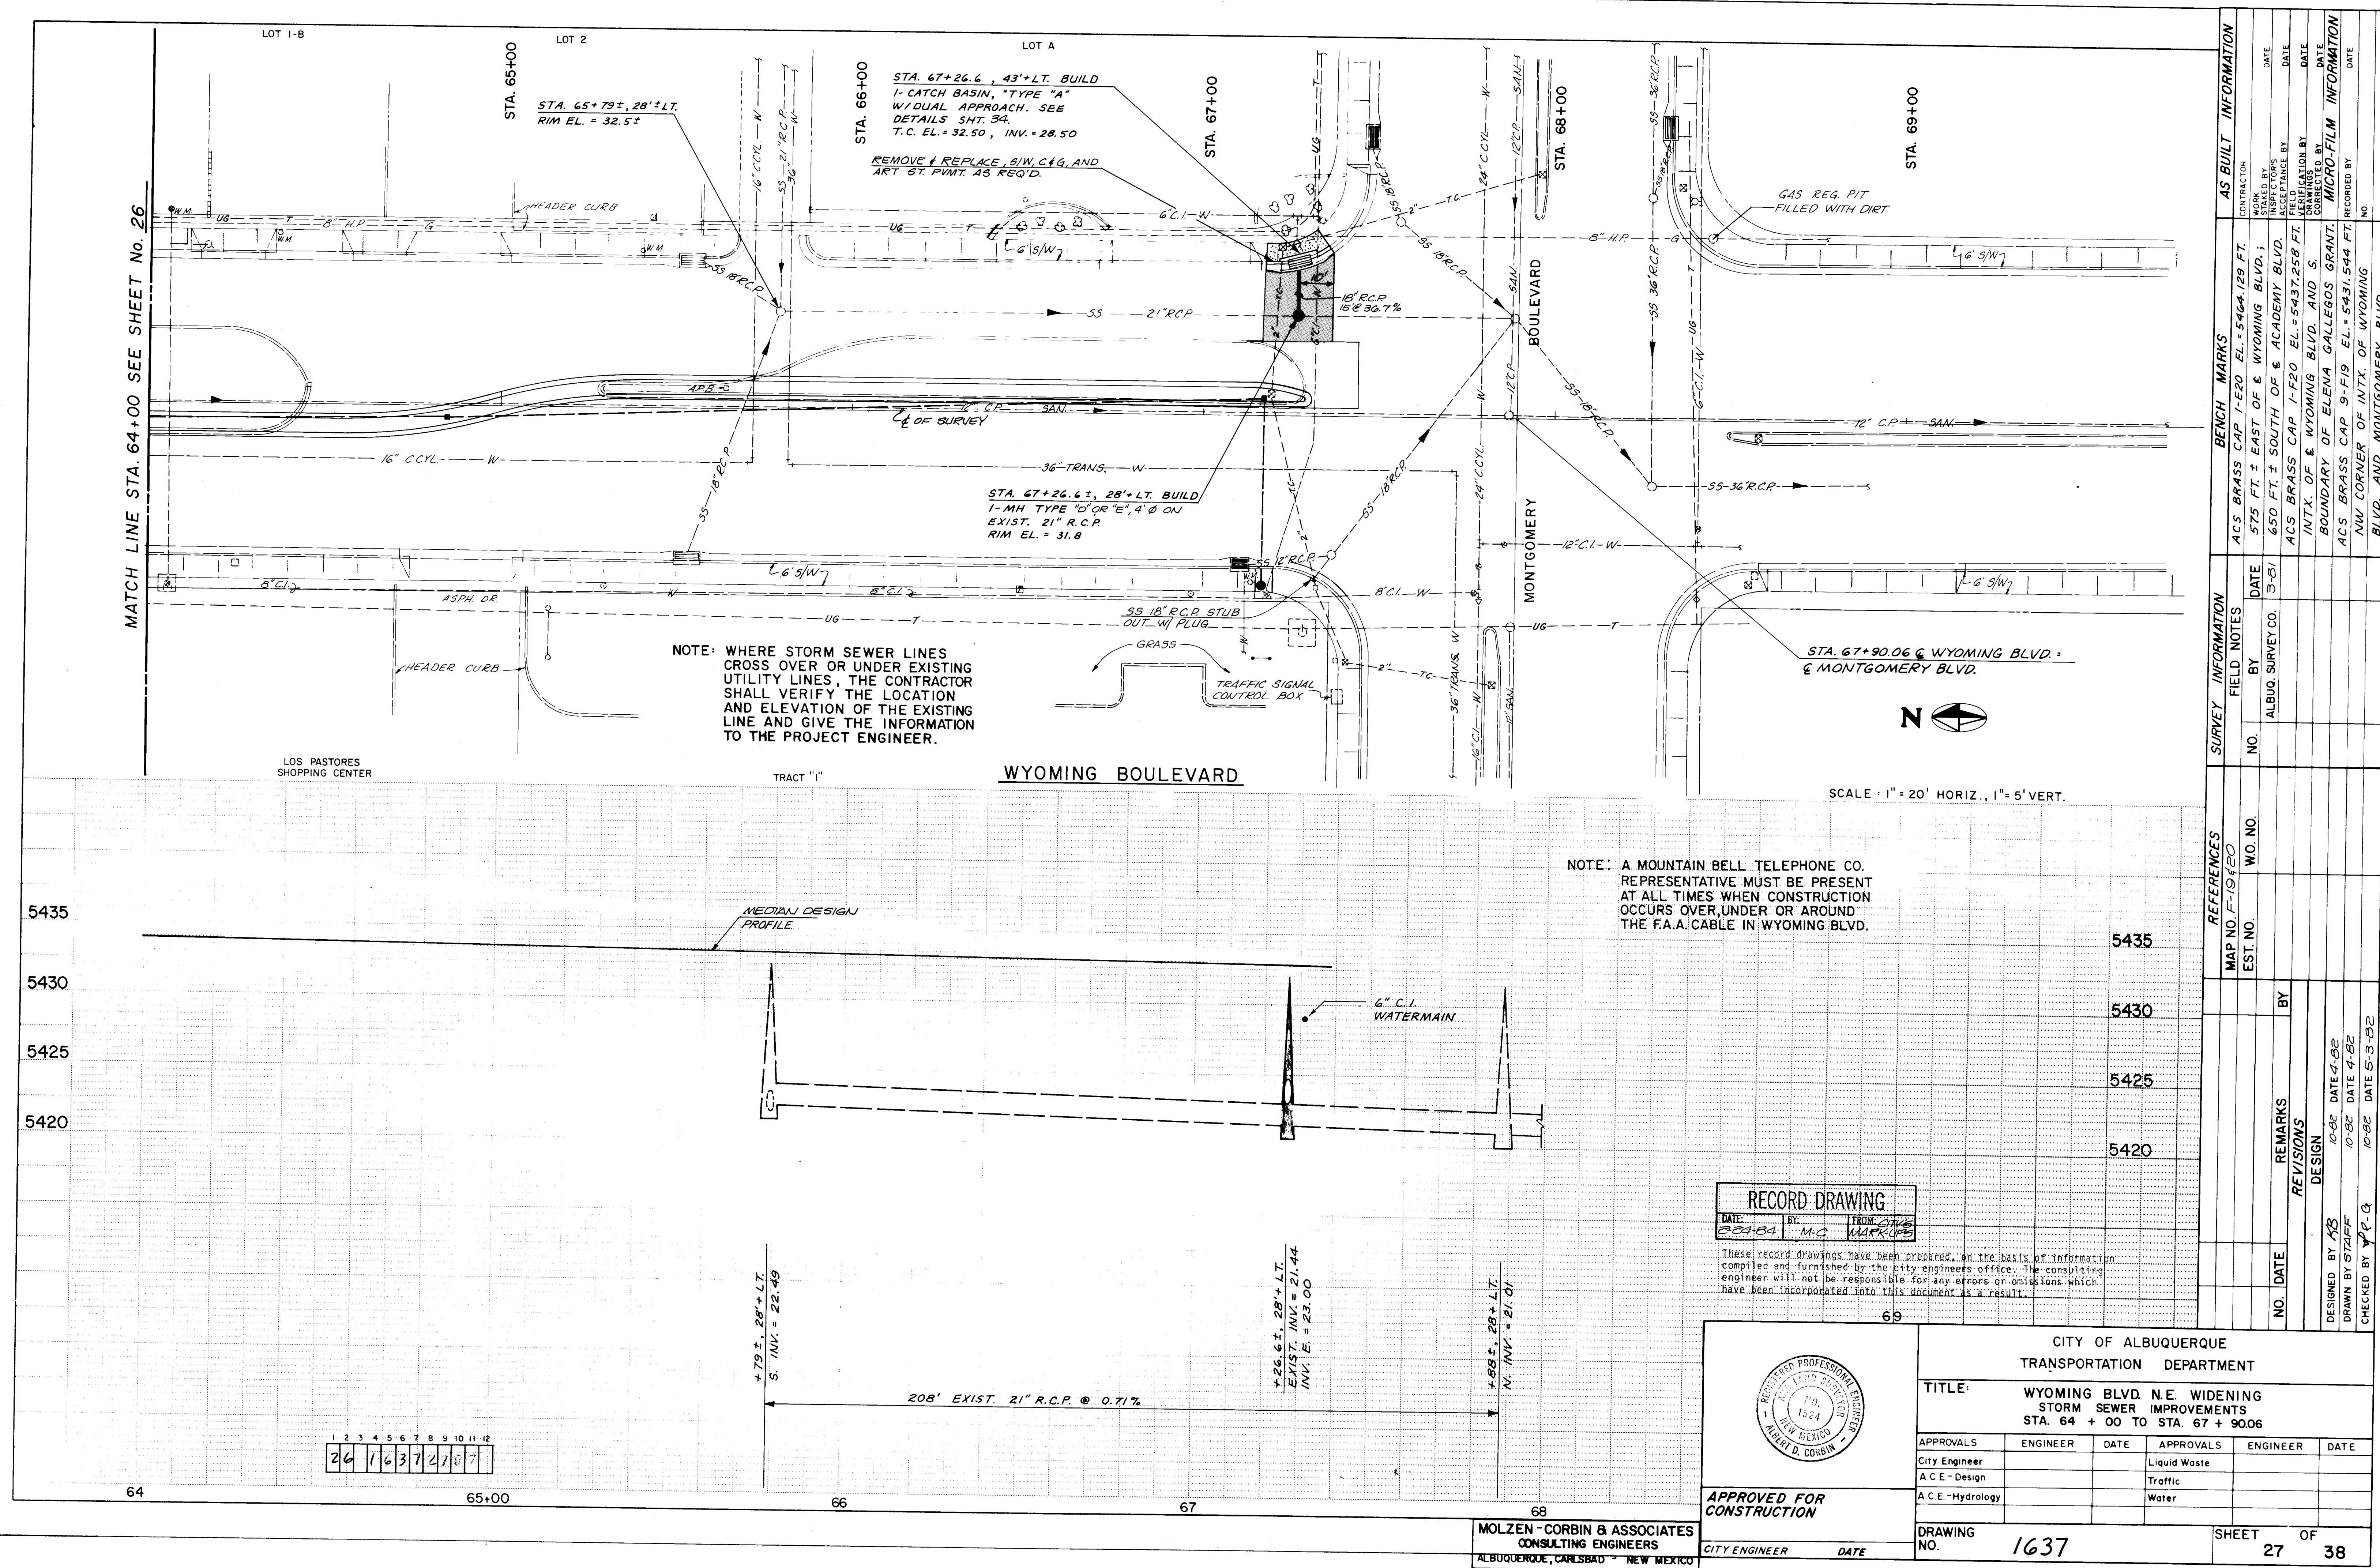


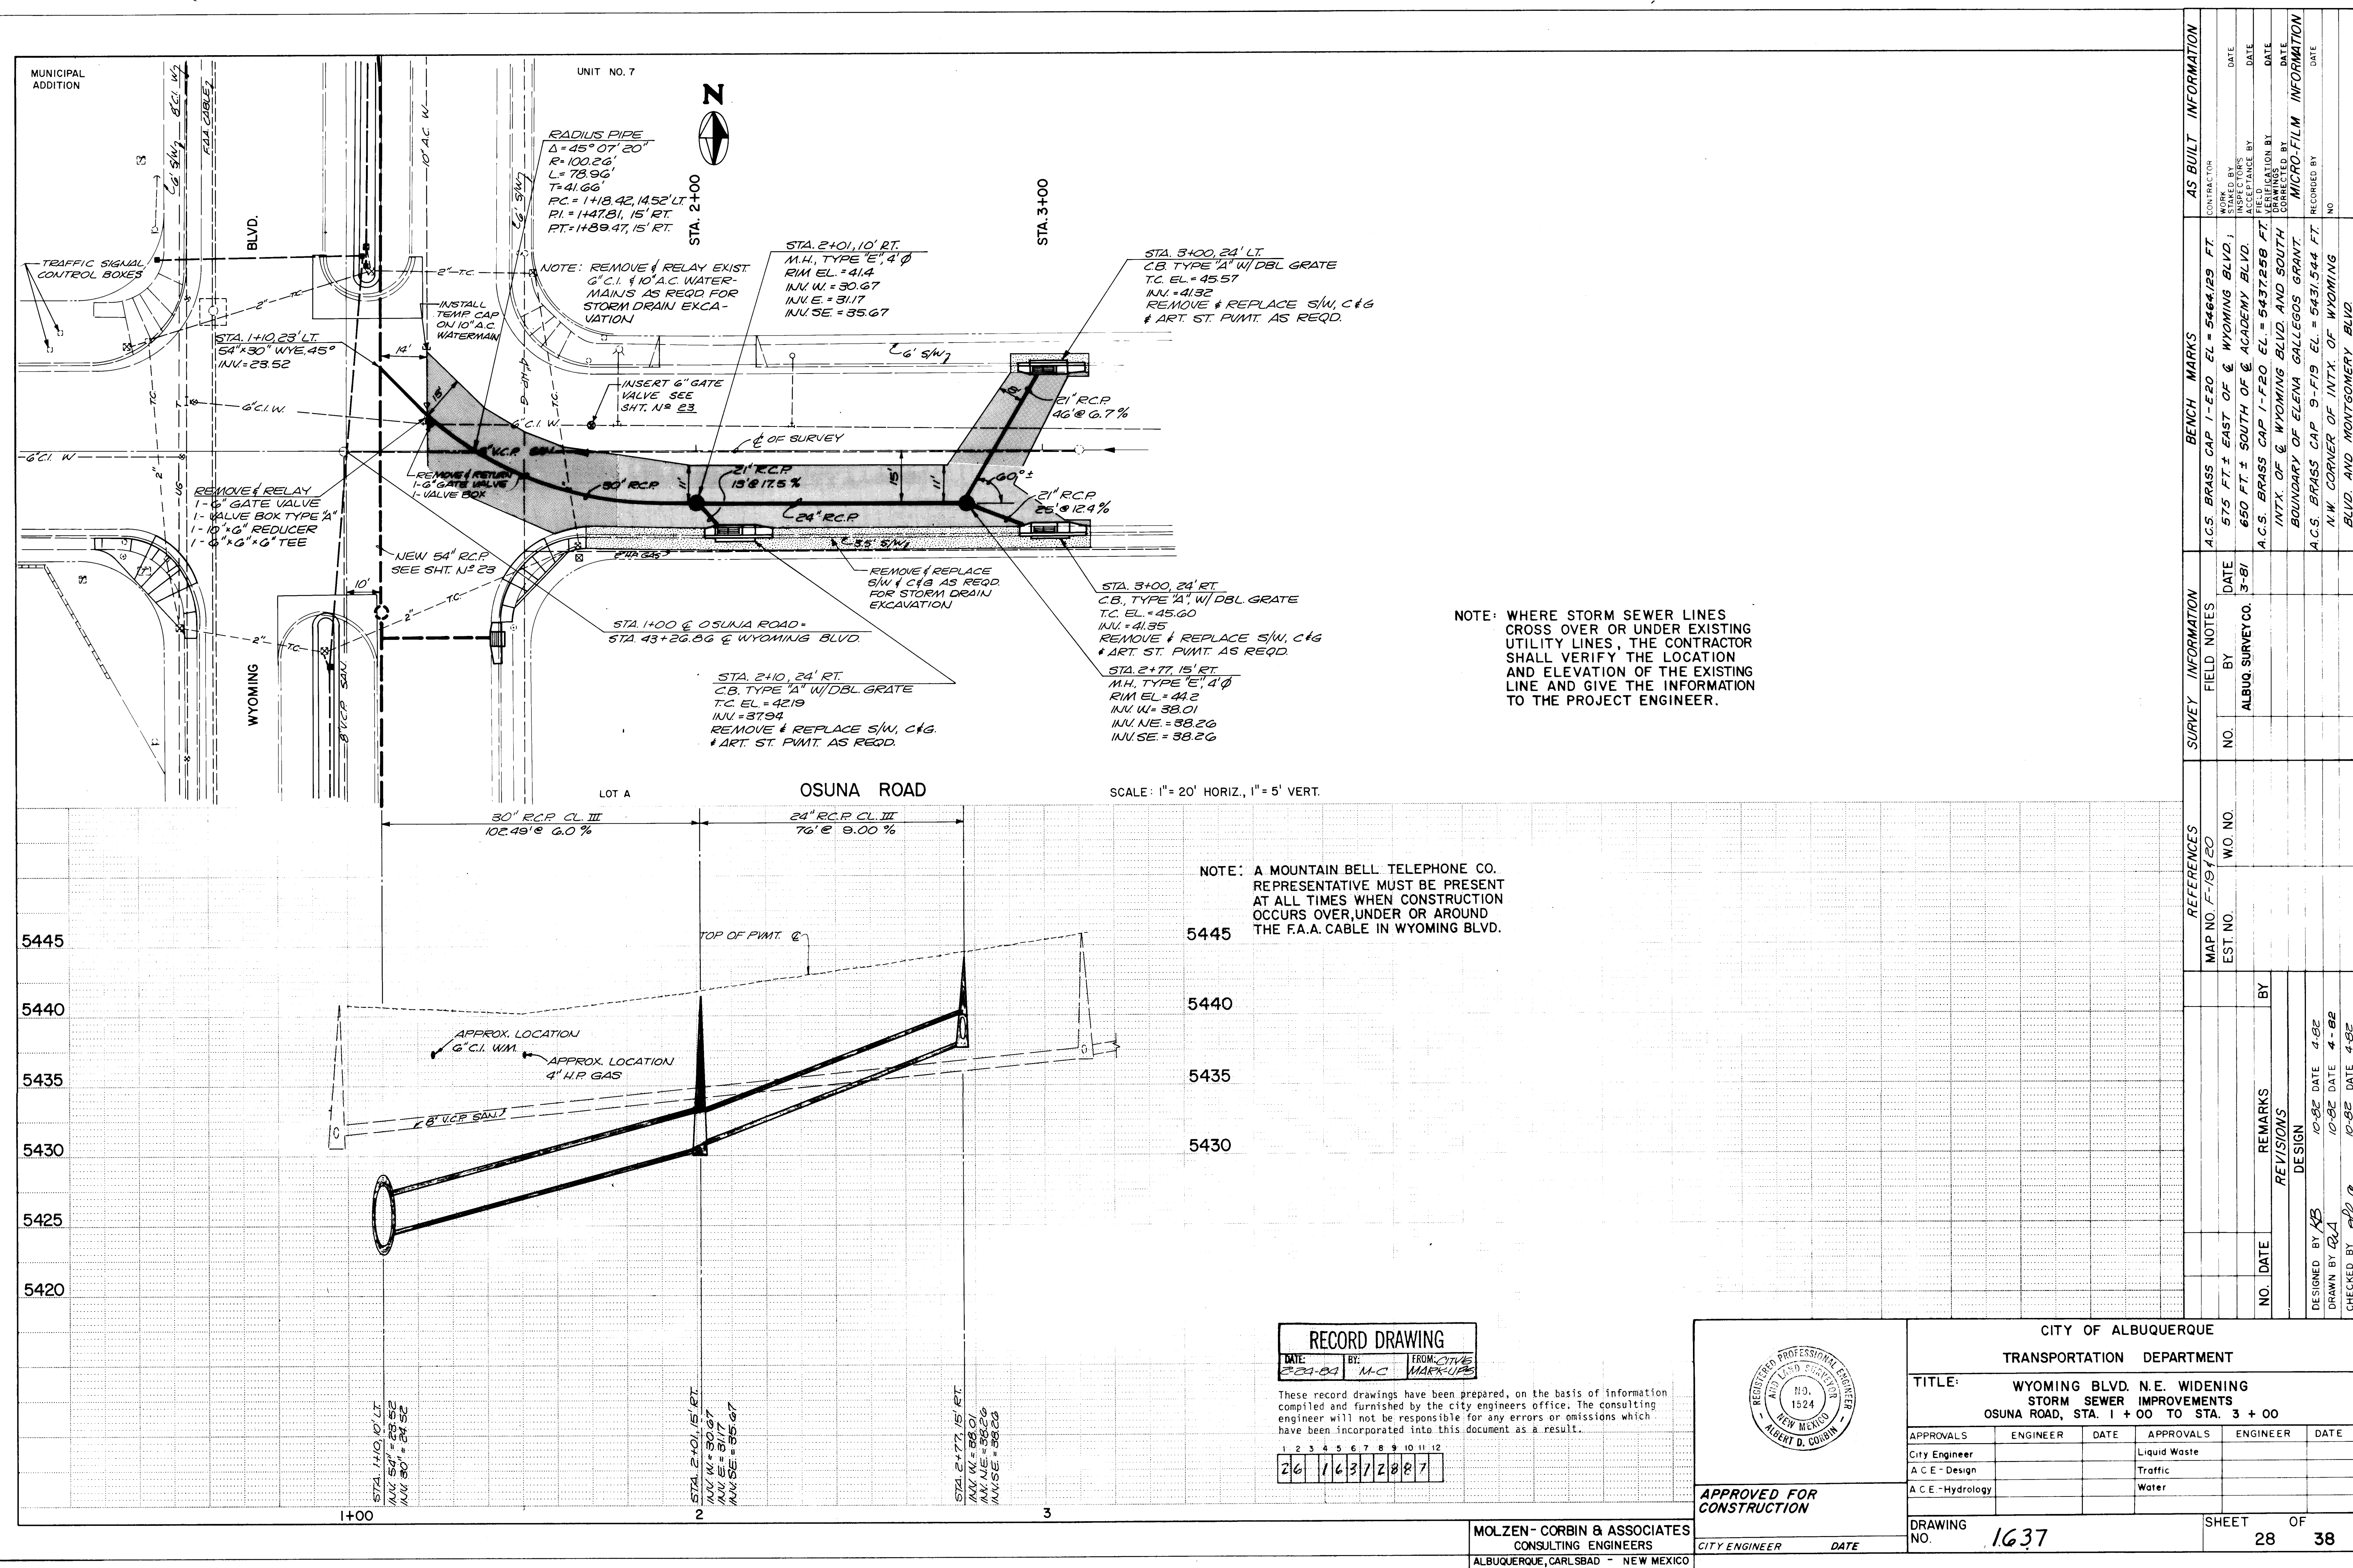

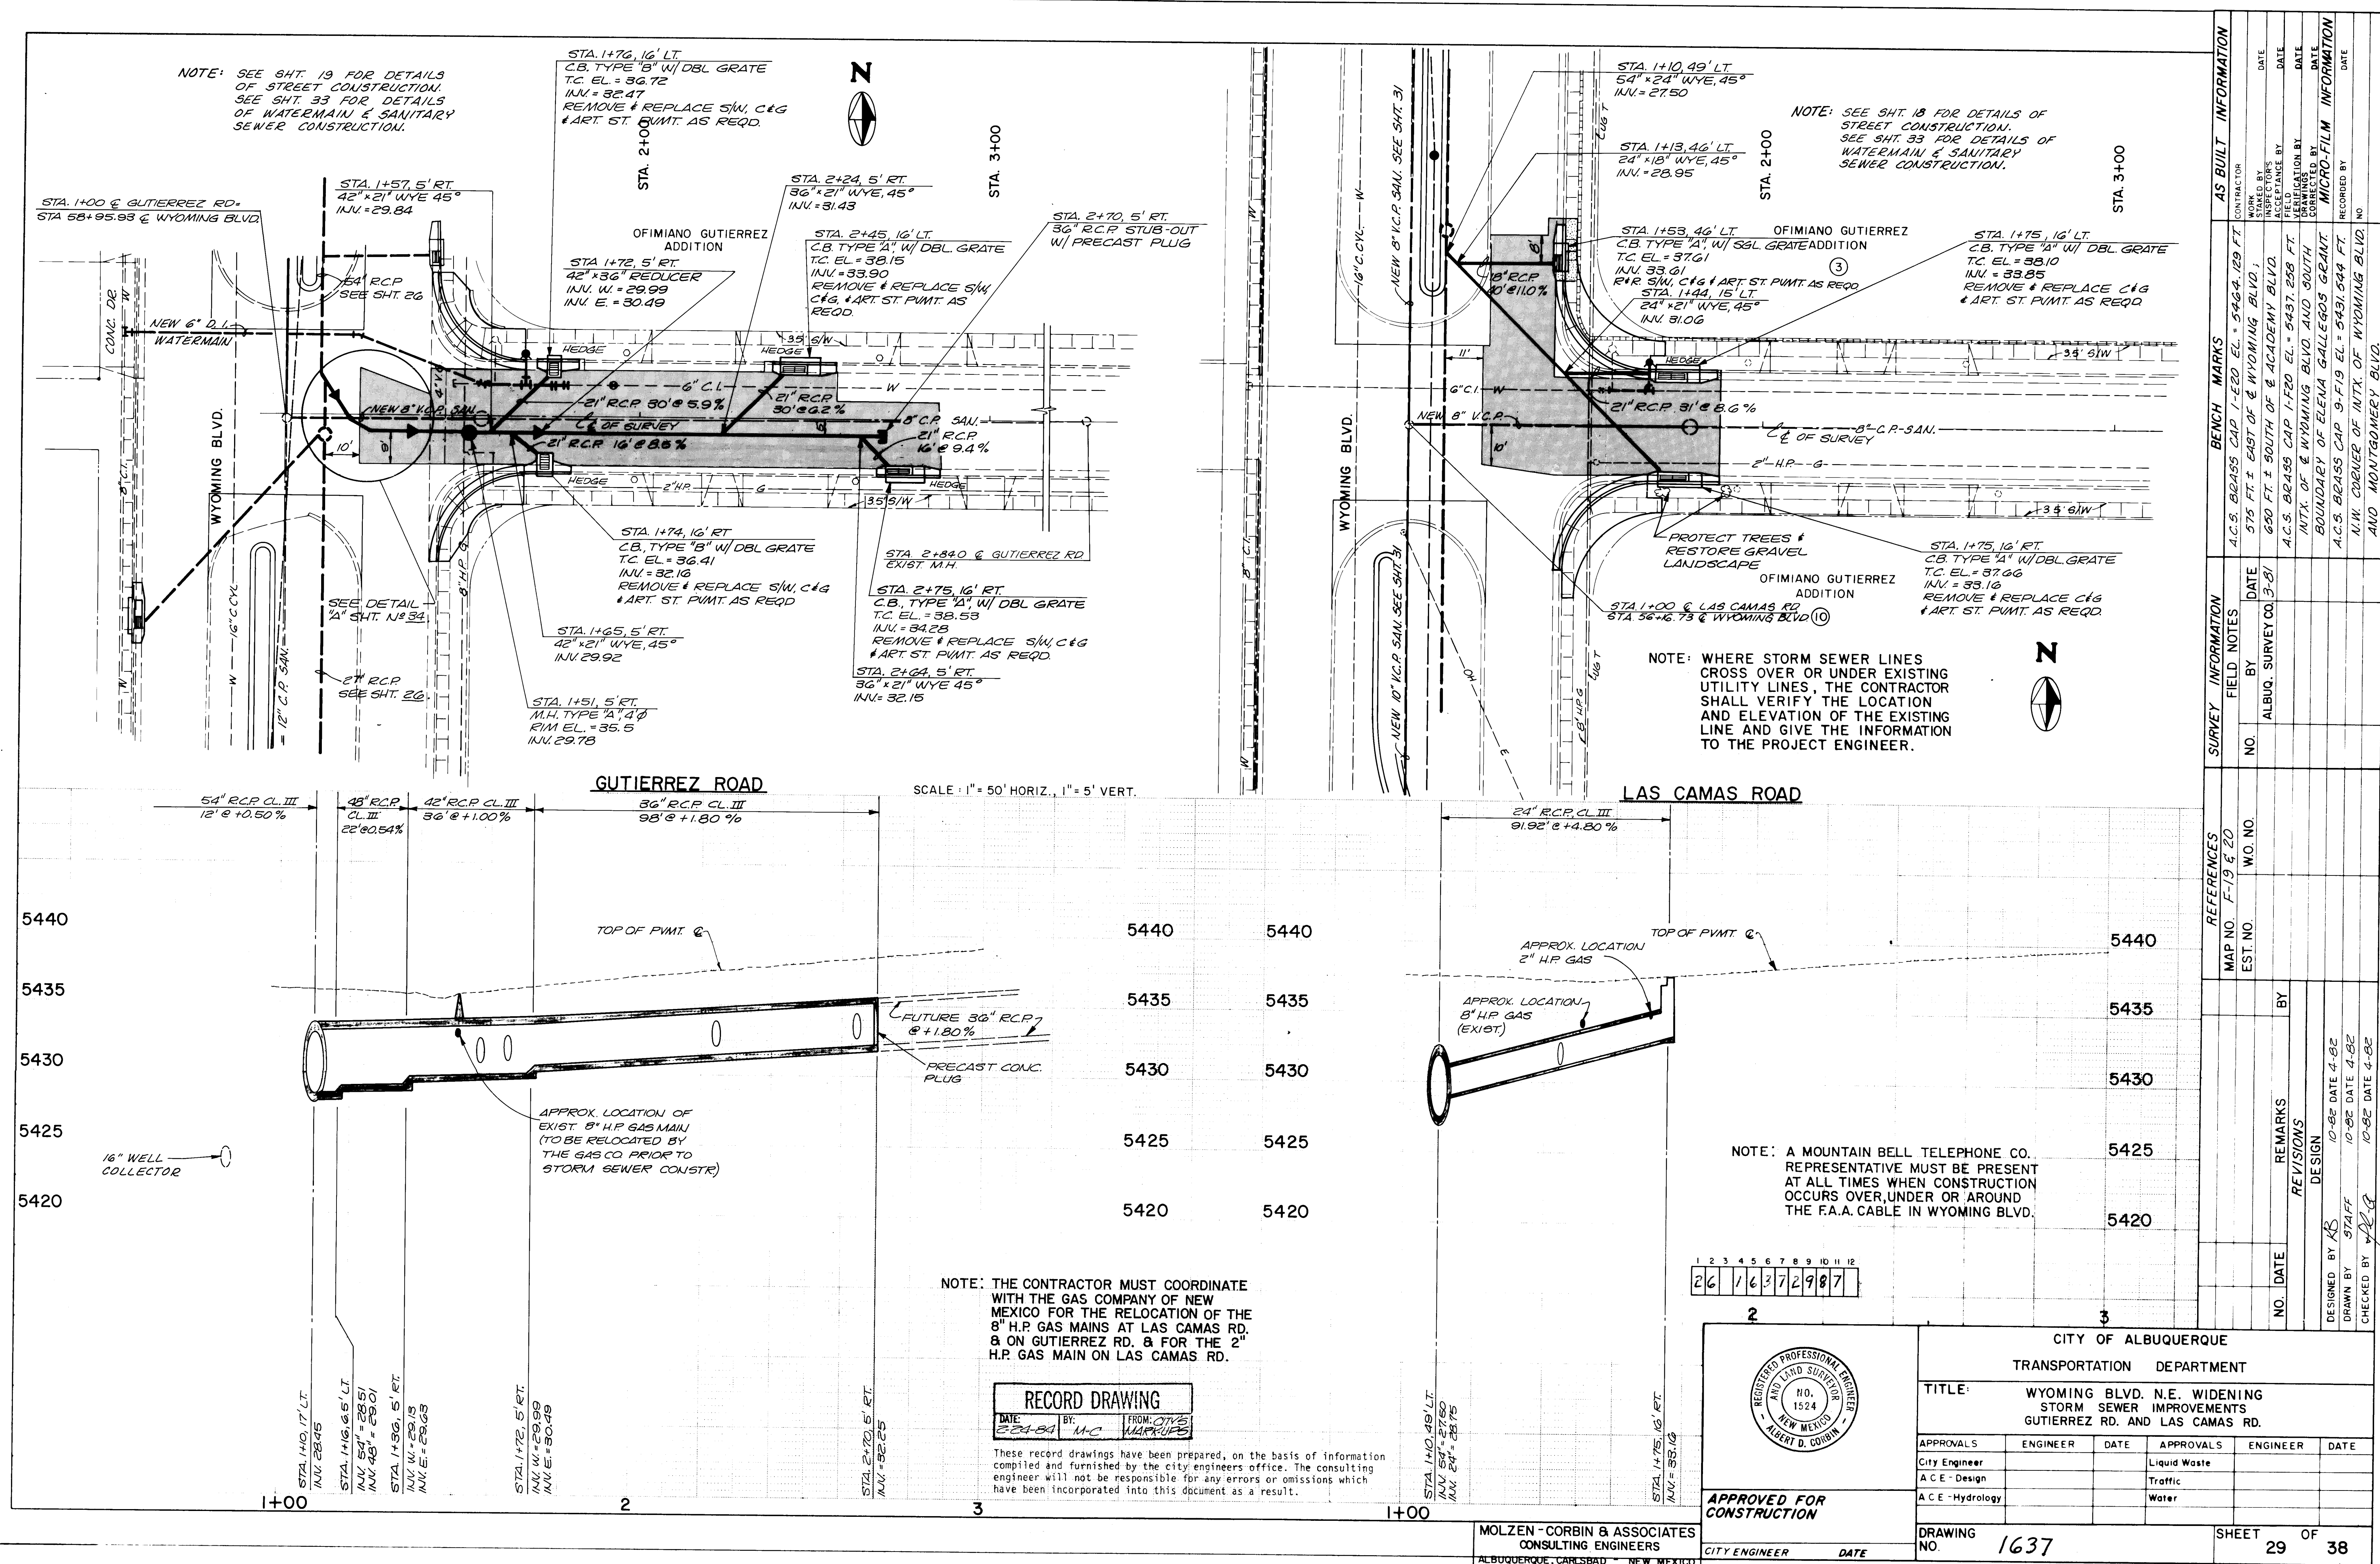

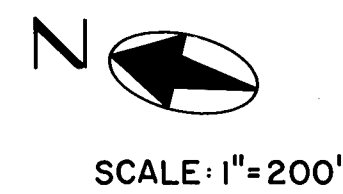




1	2	3	4	5	6	7	8	9	10	11	12
2	6		1	6	3	7	3	0	8	7	

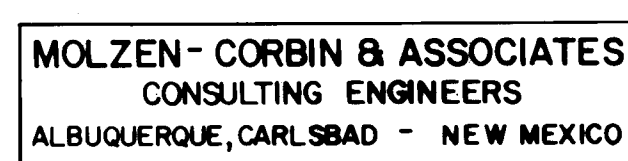

CITY ENGINEER	DATE
---------------	------

CITY OF ALBUQUERQUE				
TRANSPORTATION DEPARTMENT				
TITLE: WYOMING BLVD. N.E. WIDENING ACADEMY RD. TO MONTGOMERY BLVD. SANITARY SEWER LOCATION				
APPROVALS	ENGINEER	DATE	APPROVALS	ENGINEER
City Engineer			Solid Waste	
A.C.E. Design			Traffic	
A.C.E. -Hydrology			Water	
DRAWING NO.	1637		SHEET	OF
			30	38

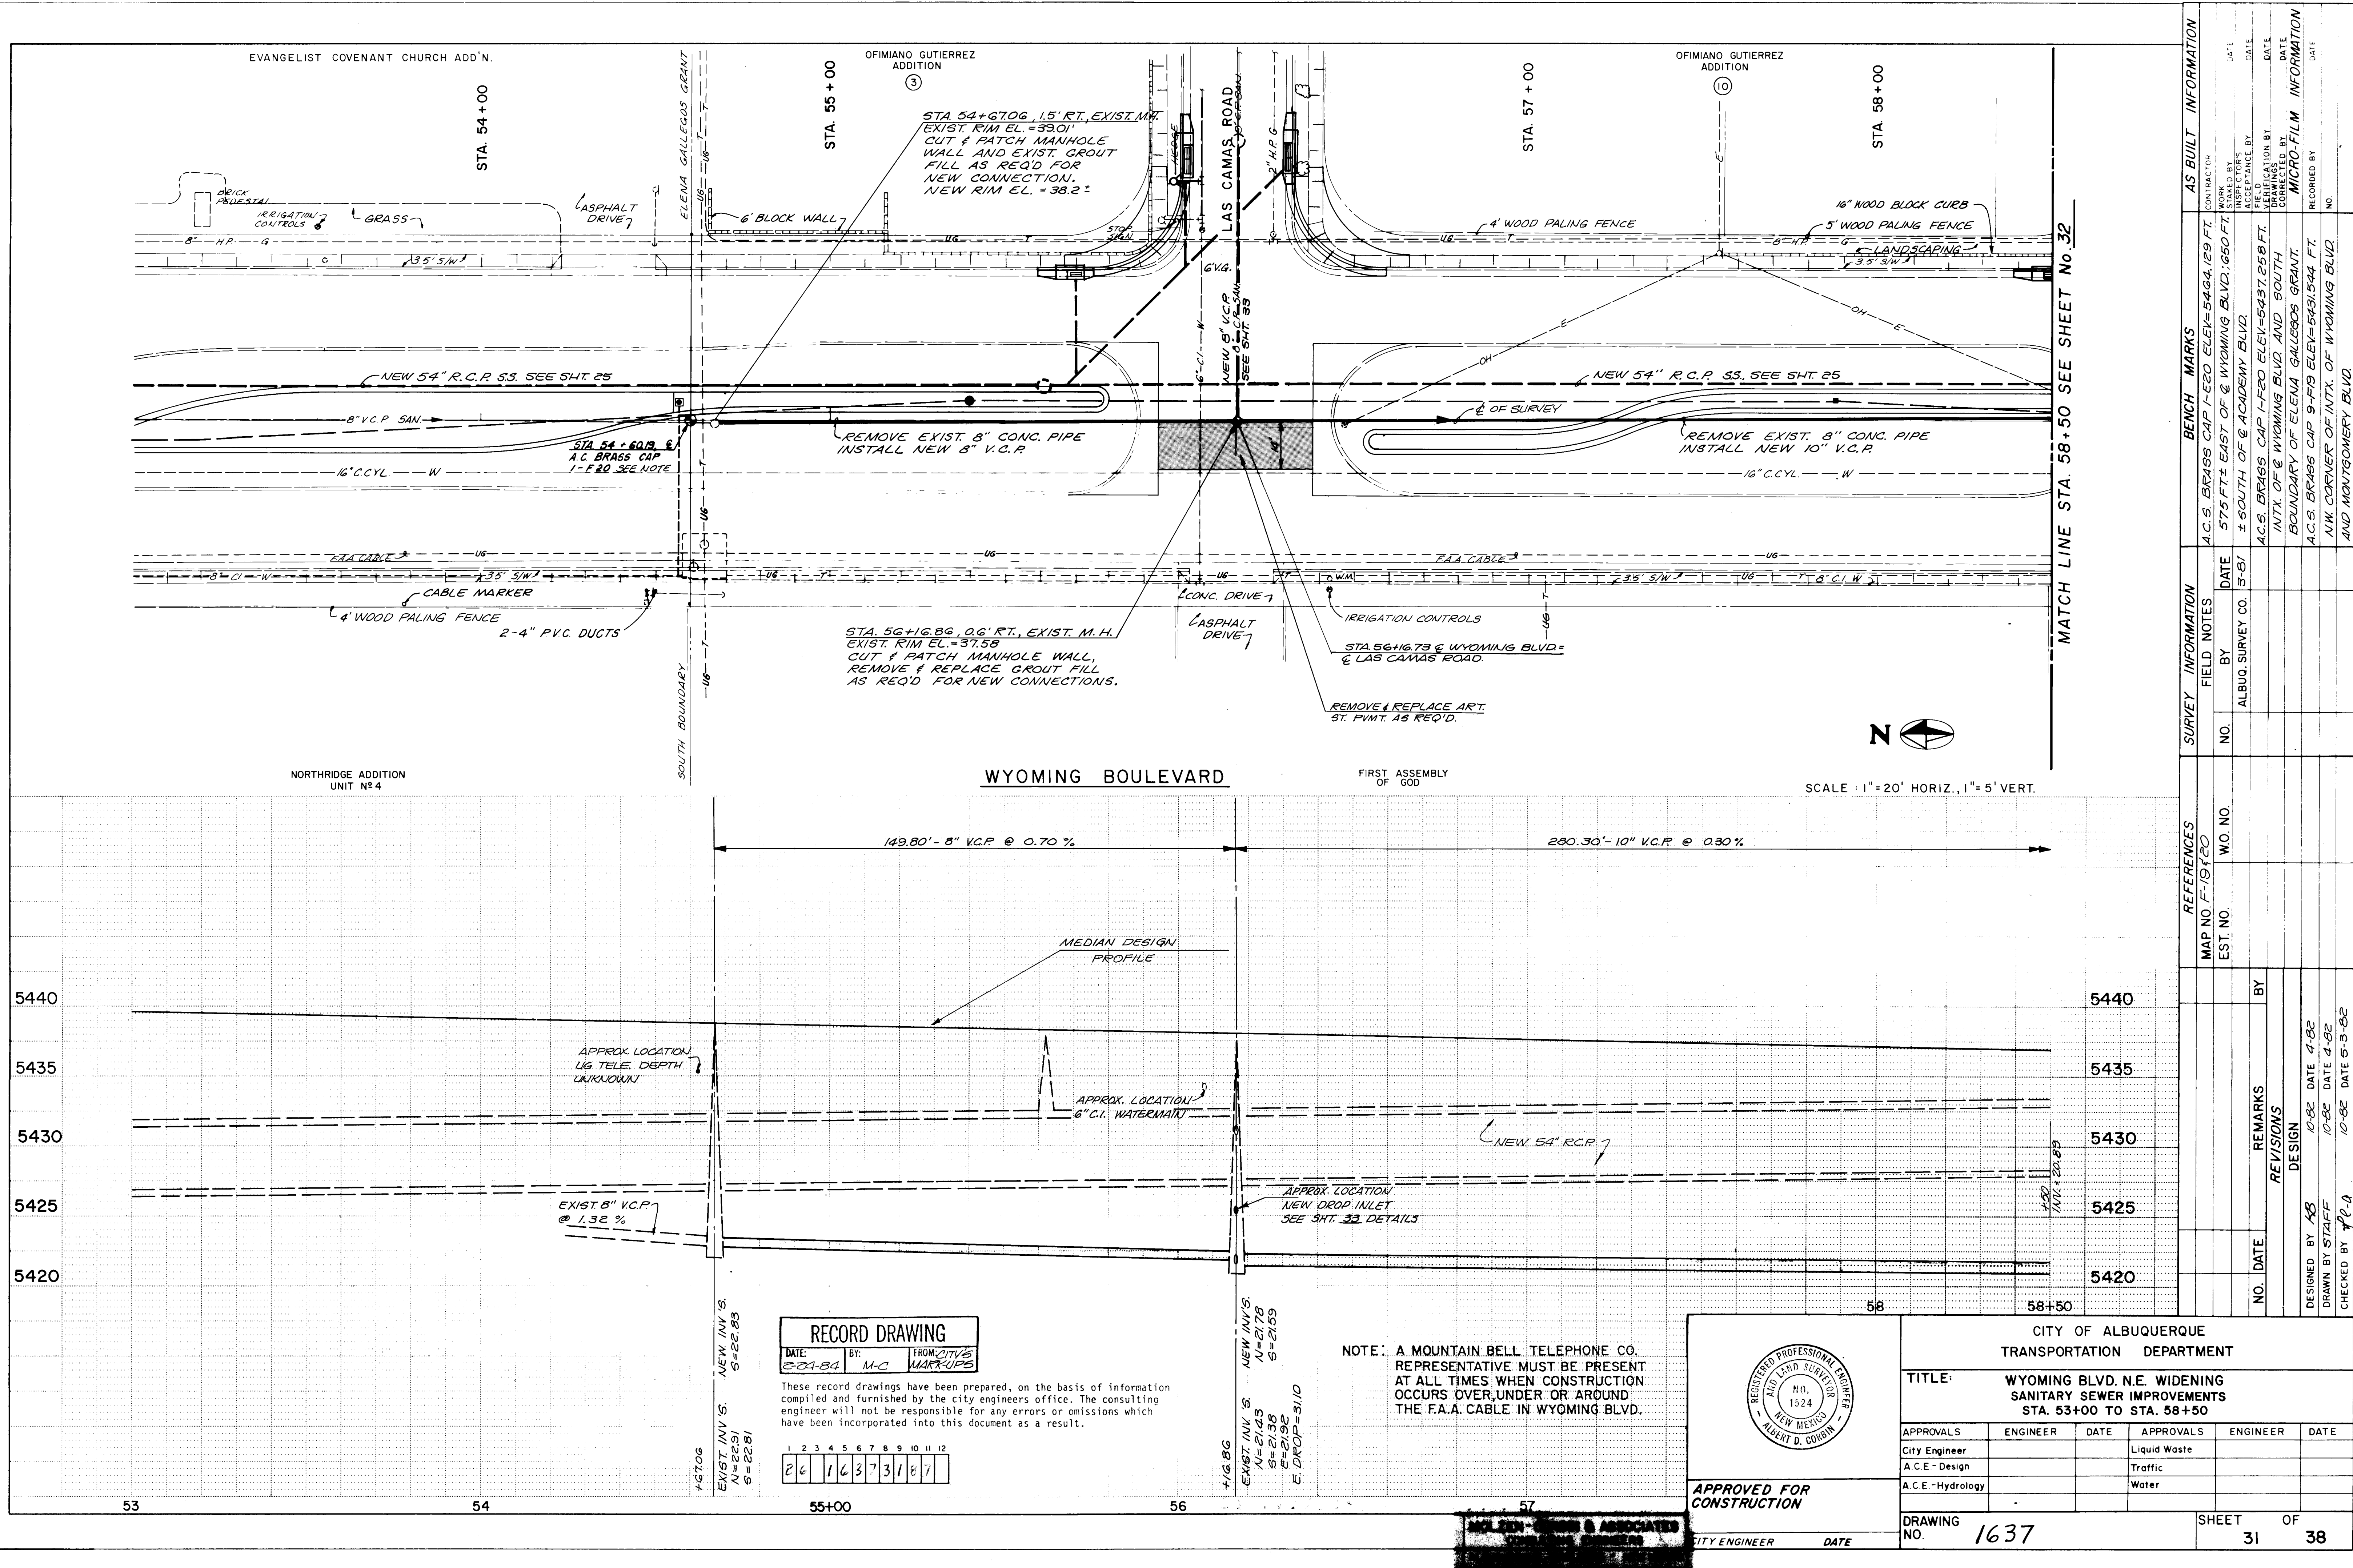

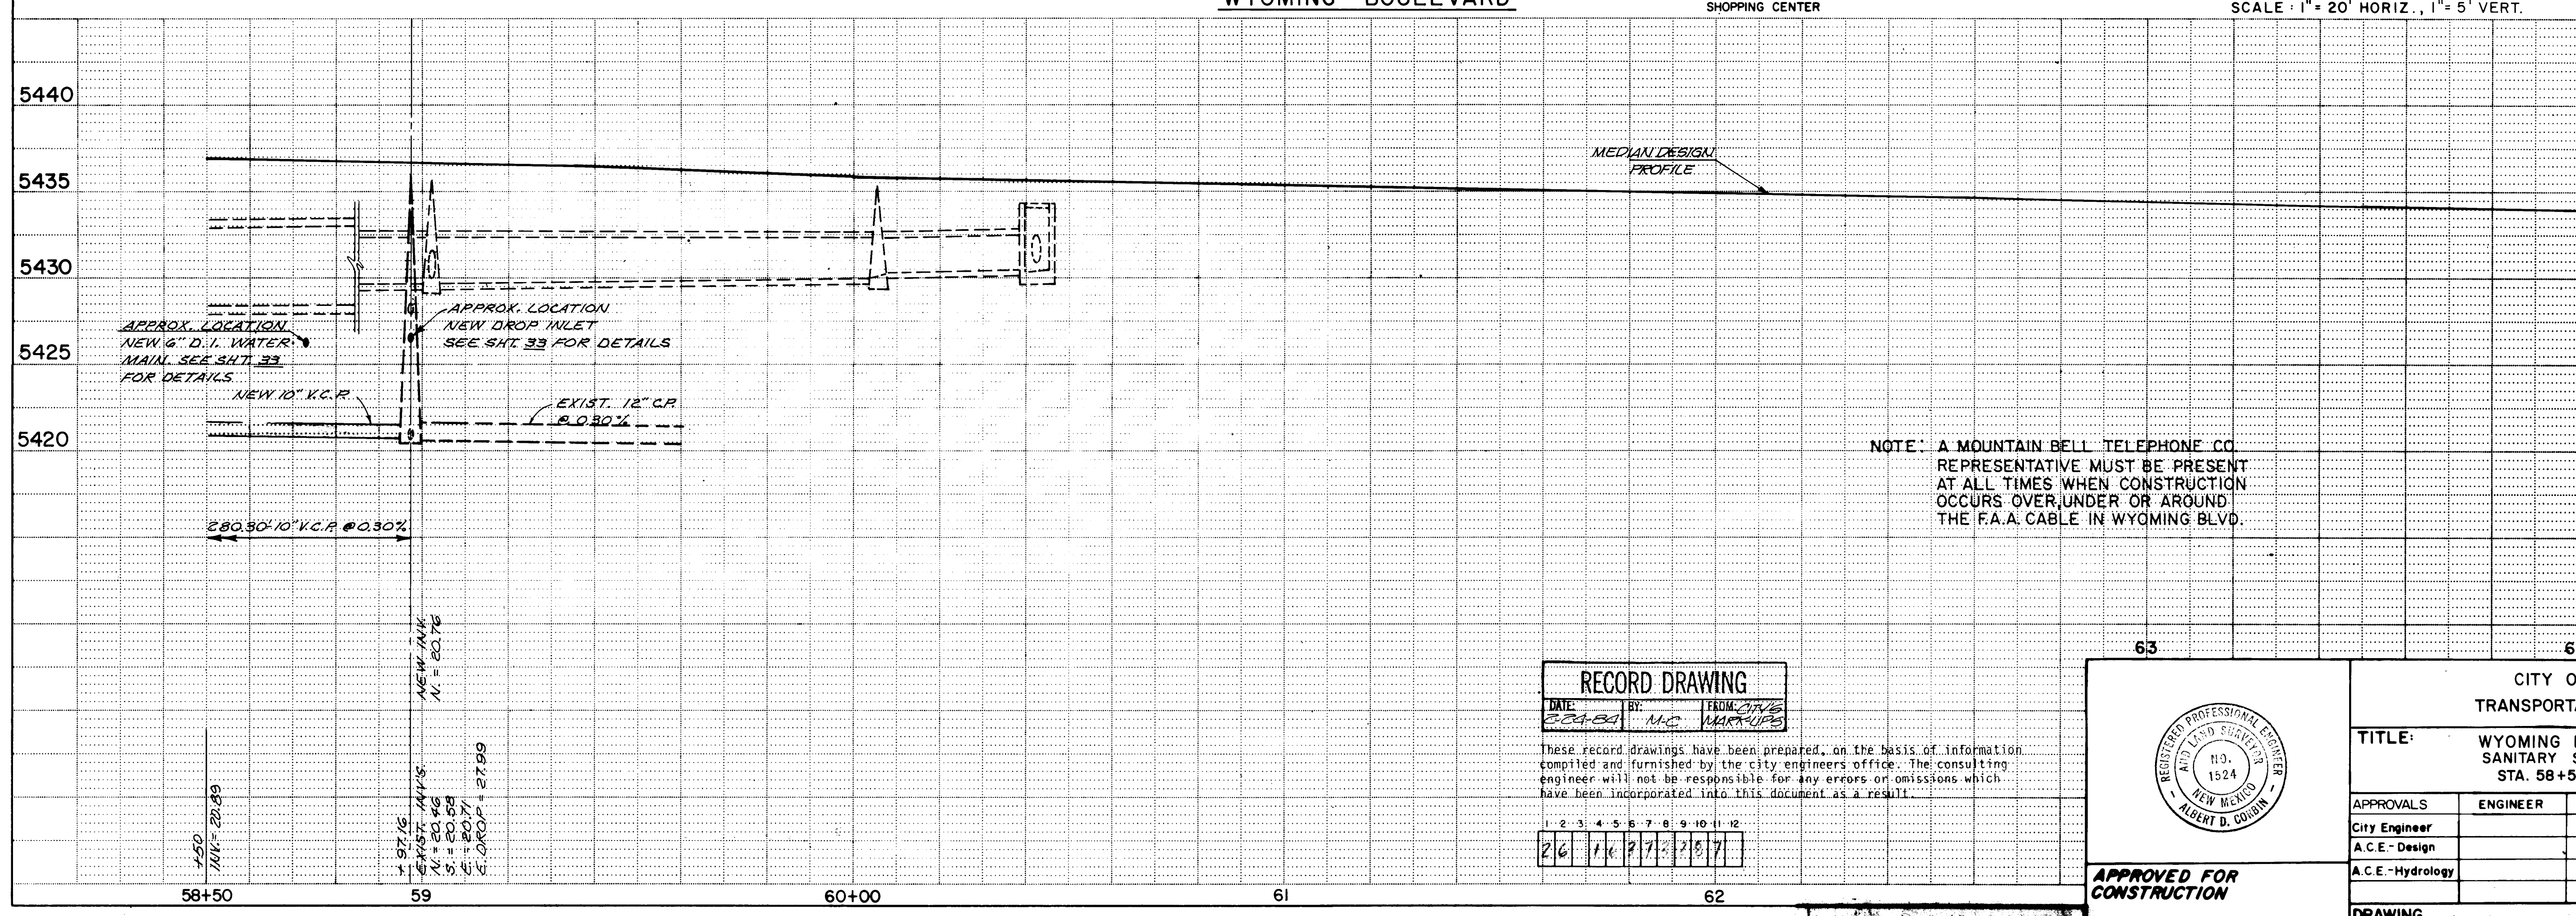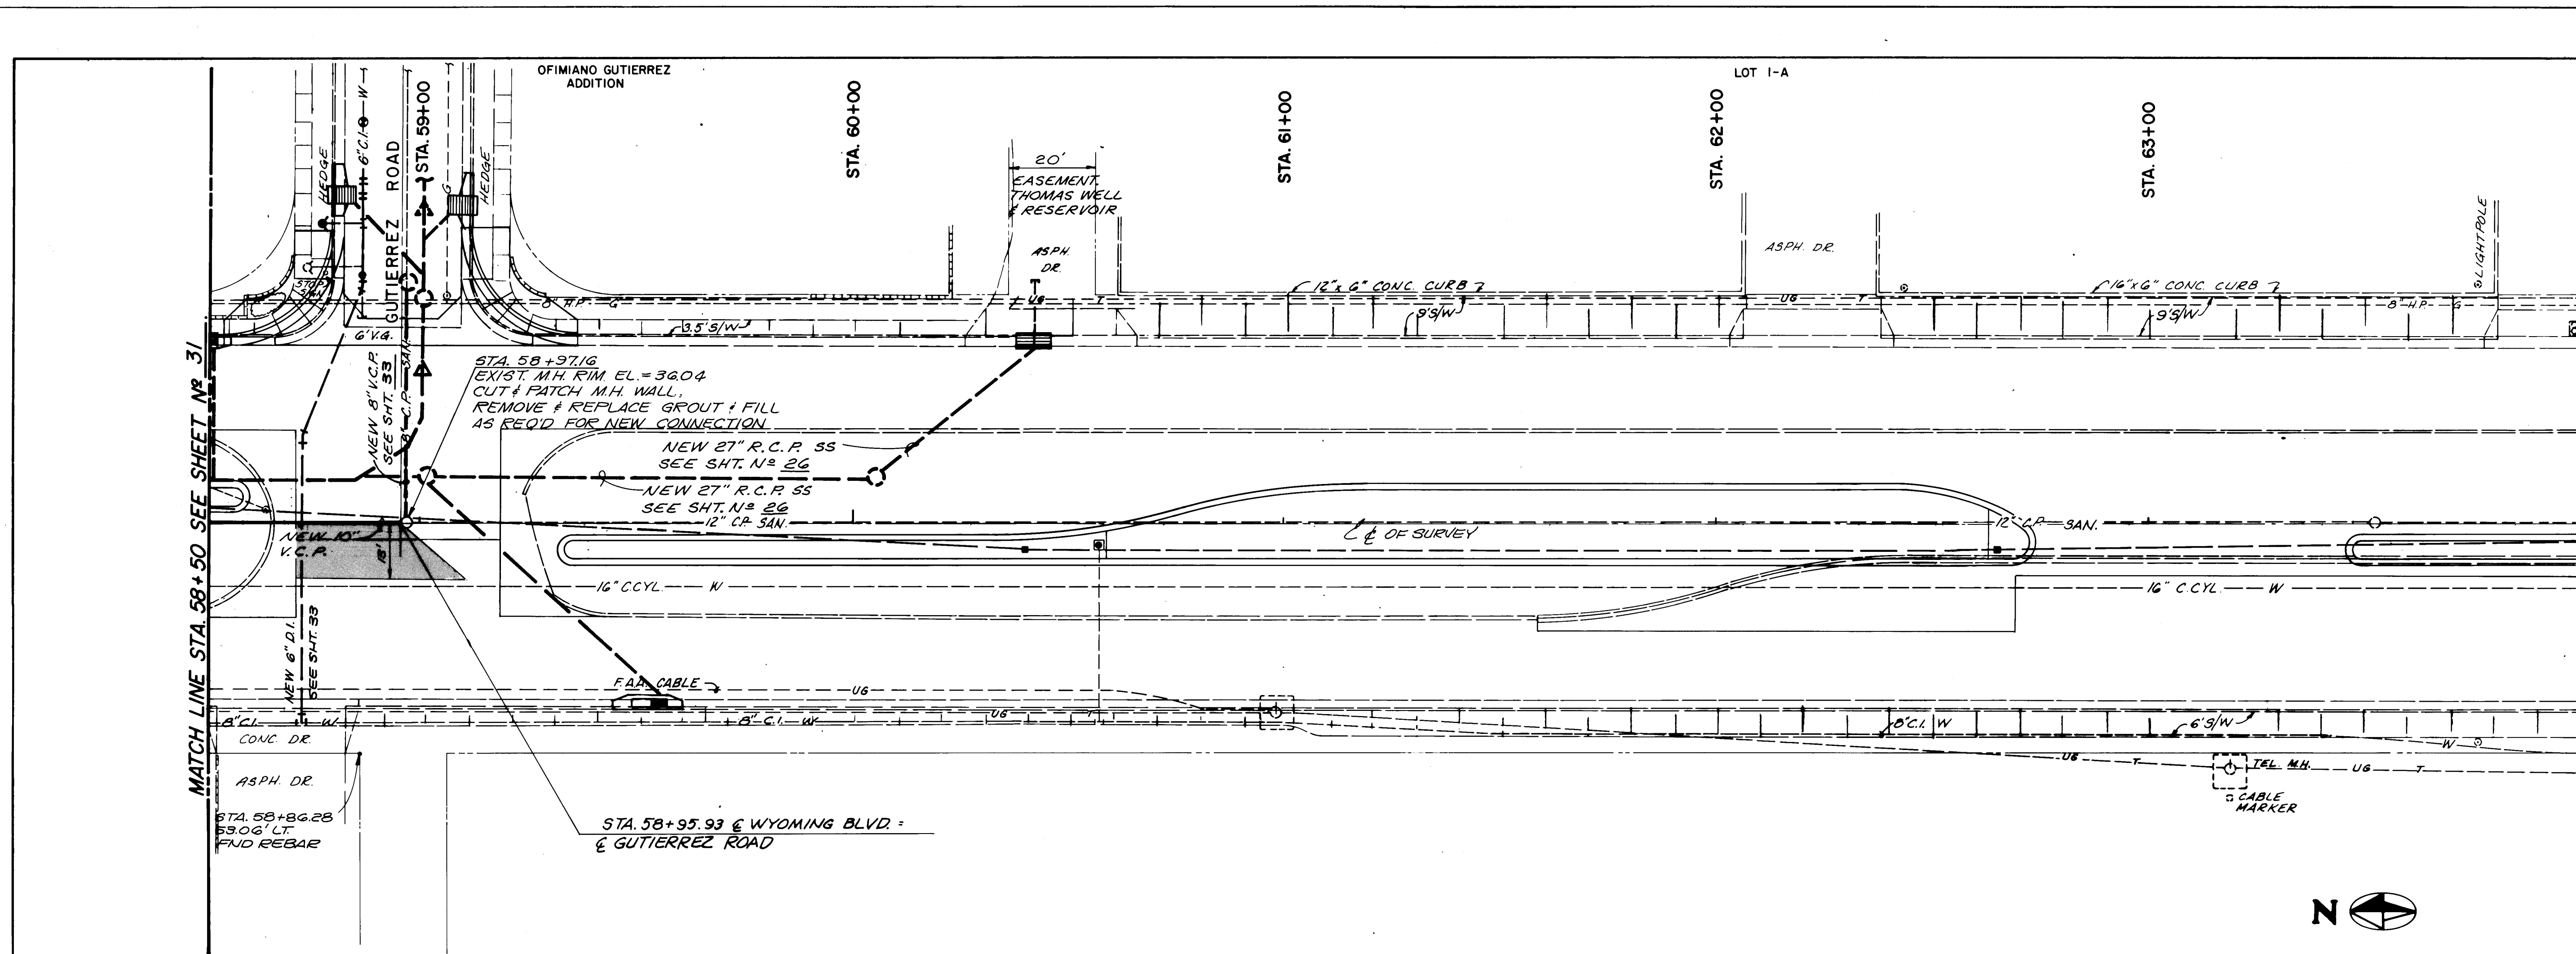


RECORD DRAWING

These record drawings have been prepared, on the basis of information compiled and furnished by the city engineers office. The consulting engineer will not be responsible for any errors or omissions which have been incorporated into this document as a result.

2 3 4 5 6 7 8 9 10 11 12
26 11 27 28 29

MOLLEN - CORBIN & ASSOCIATES
CITY ENGINEER

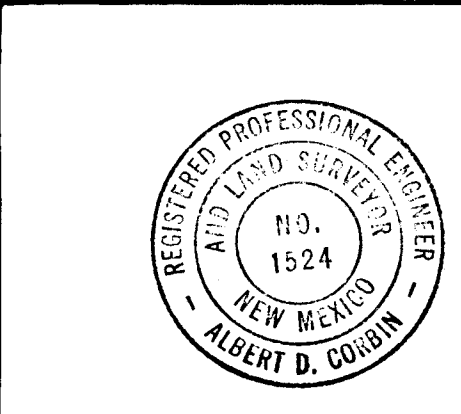




APPROVED FOR CONSTRUCTION

CITY ENGINEER DATE

CITY OF ALBUQUERQUE TRANSPORTATION DEPARTMENT			
TITLE: WYOMING BLVD. N.E. WIDENING SANITARY SEWER IMPROVEMENTS STA. 58+50 TO STA. 64+00			
APPROVALS	ENGINEER	DATE	APPROVALS
City Engineer			Liquid Waste
A.C.E. - Design			Traffic
A.C.E. - Hydrology			Water
DRAWING NO. 1637		SHEET 32 OF 38	


SURVEY INFORMATION		BENCH MARKS		AS BUILT INFORMATION	
NO.	DATE	NO.	DATE	NO.	DATE
1	1-97	1	1-97	1	1-97
2	1-97	2	1-97	2	1-97
3	1-97	3	1-97	3	1-97
100	1-97	100	1-97	100	1-97

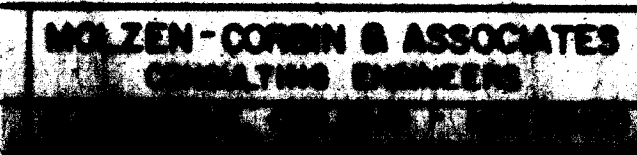

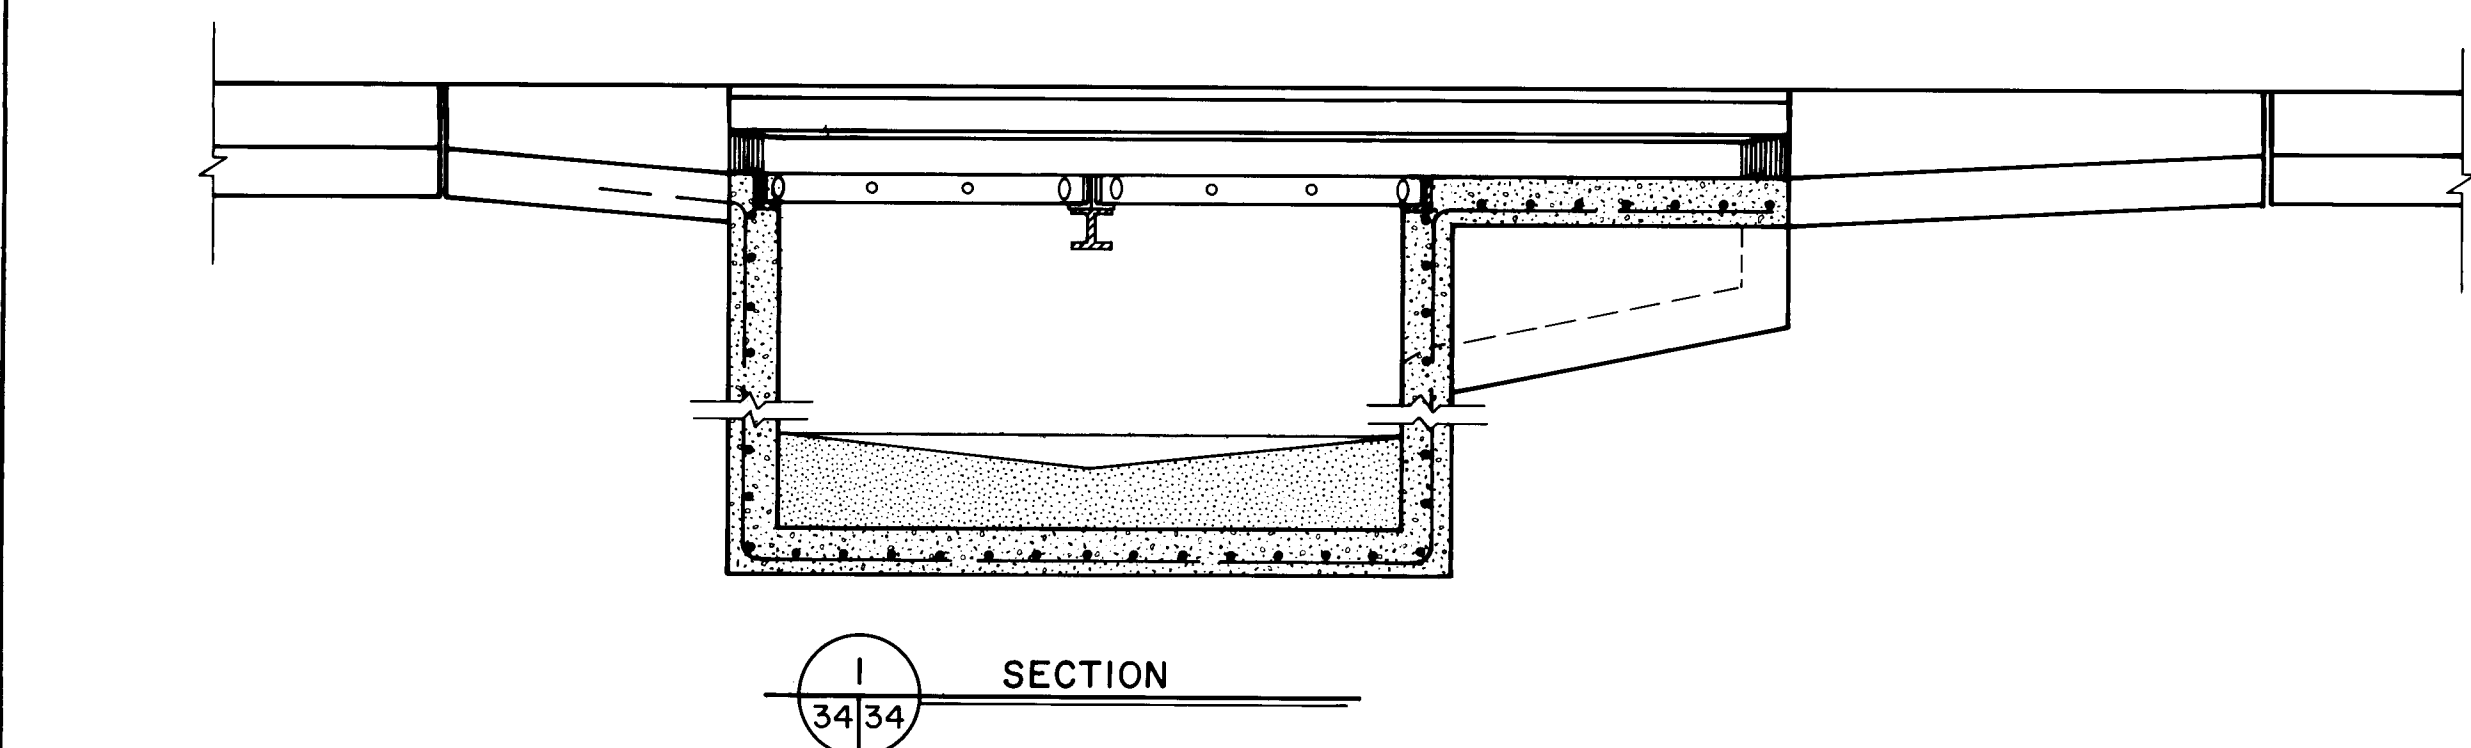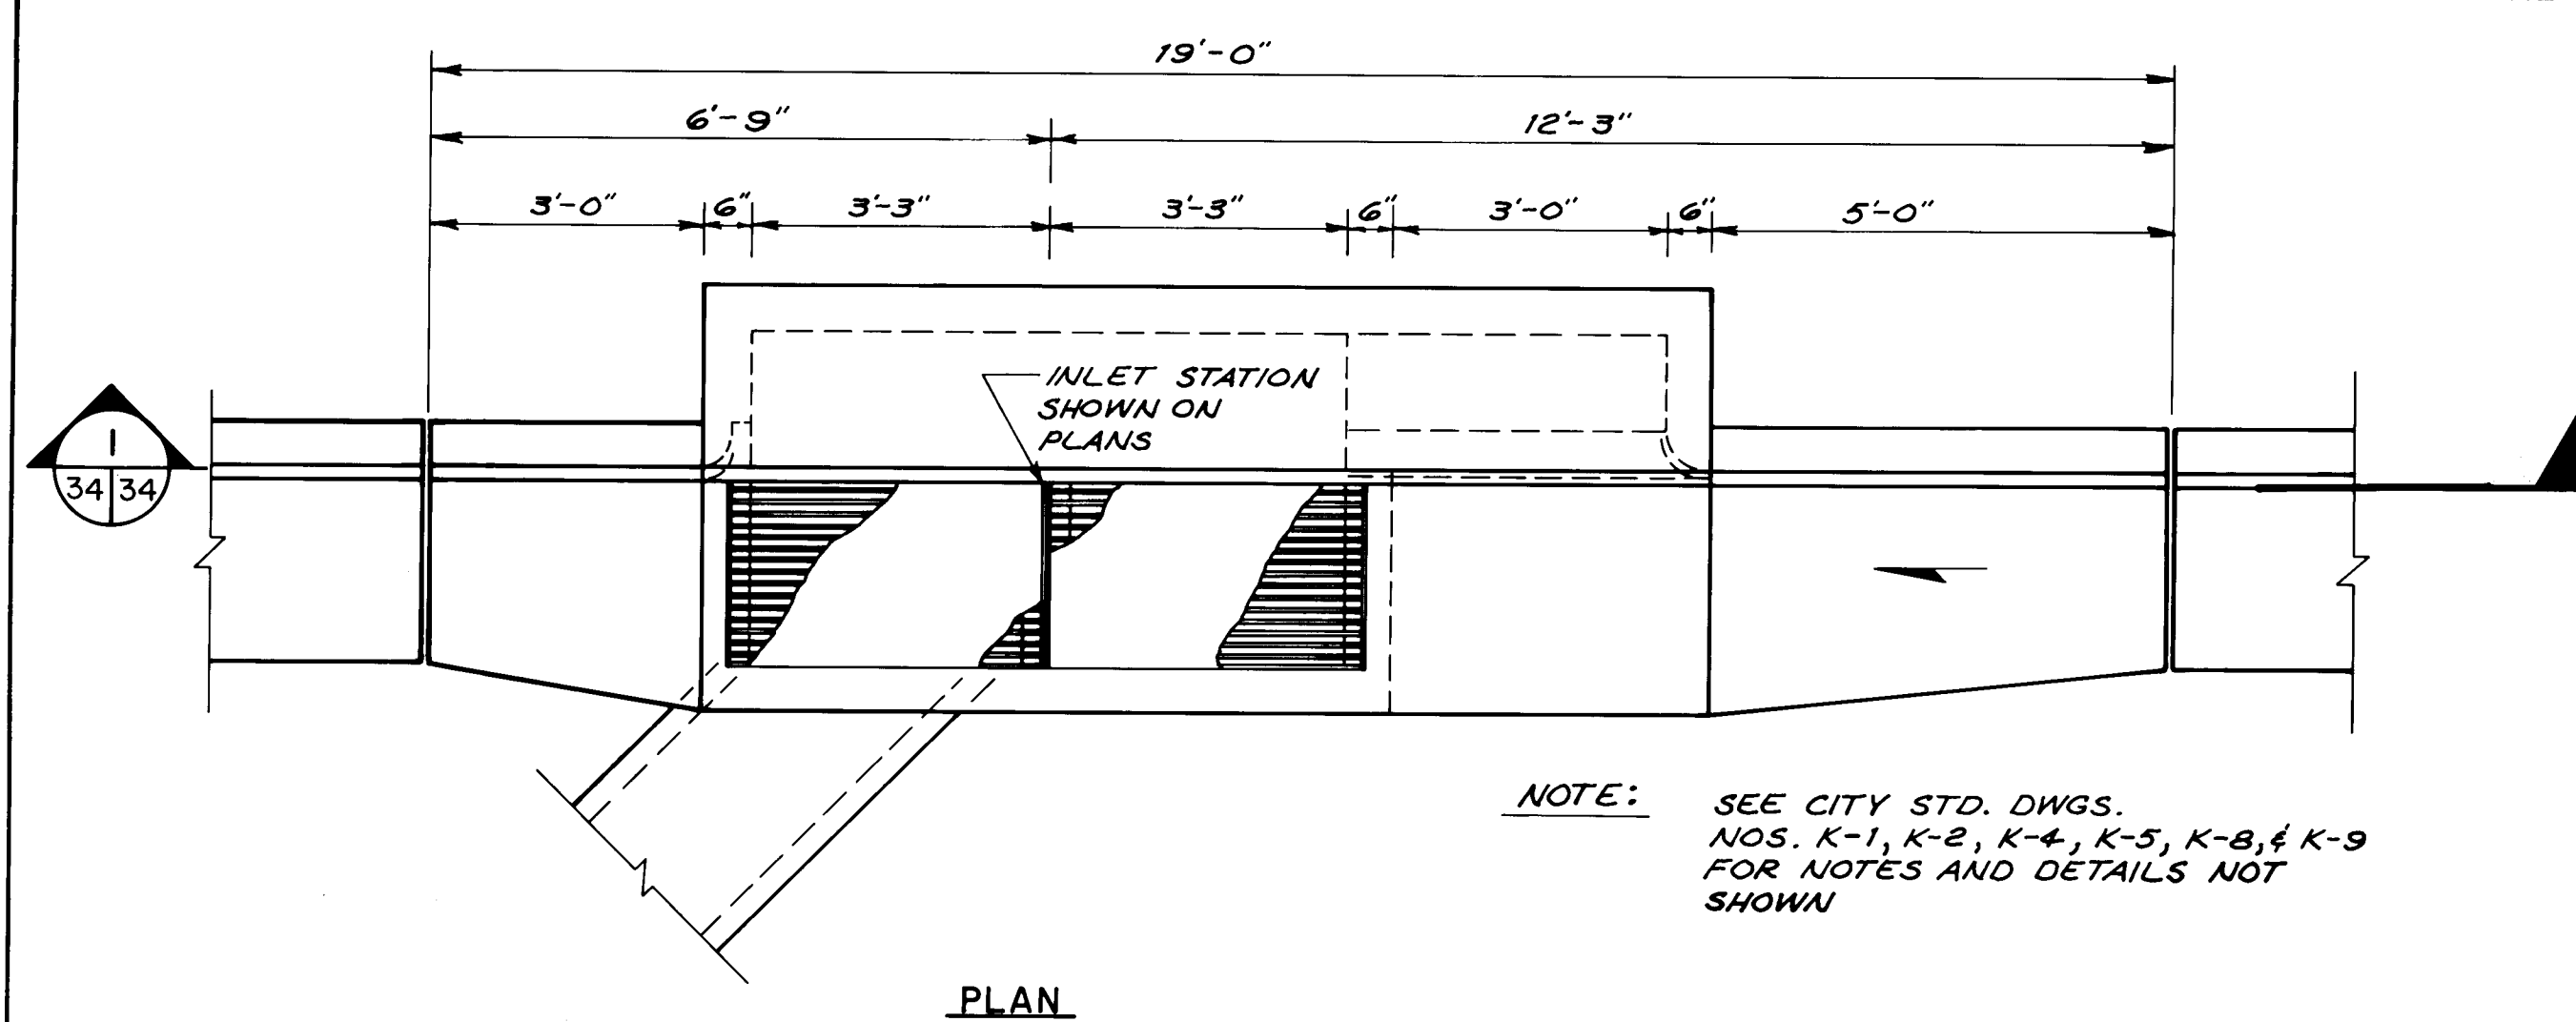


CATCH BASIN, TYPE "A" W/DOUBLE GRATE
NO SCALE

NOTE: MANHOLE ON WYE SECTION
REQ'D IF INLET PIPE $\geq 30"$.
PREFERRED IF M.H. REQ'D
NEAR WYE ANYWAY DUE TO
SPACING REQUIREMENTS. OTHER-
WISE THE PIPE MFG. SHALL
FURNISH NON-STANDARD LENGTH
PIPE SECTIONS AS REQ'D TO MAKE
UP DISTANCE BETWEEN M.H. AND
WYE STATIONS, OR THE M.H. STATION
MAY BE ADJUSTED TO FIT STD.
LENGTH PIPE SECTIONS WITH
THE ENGINEER'S APPROVAL.

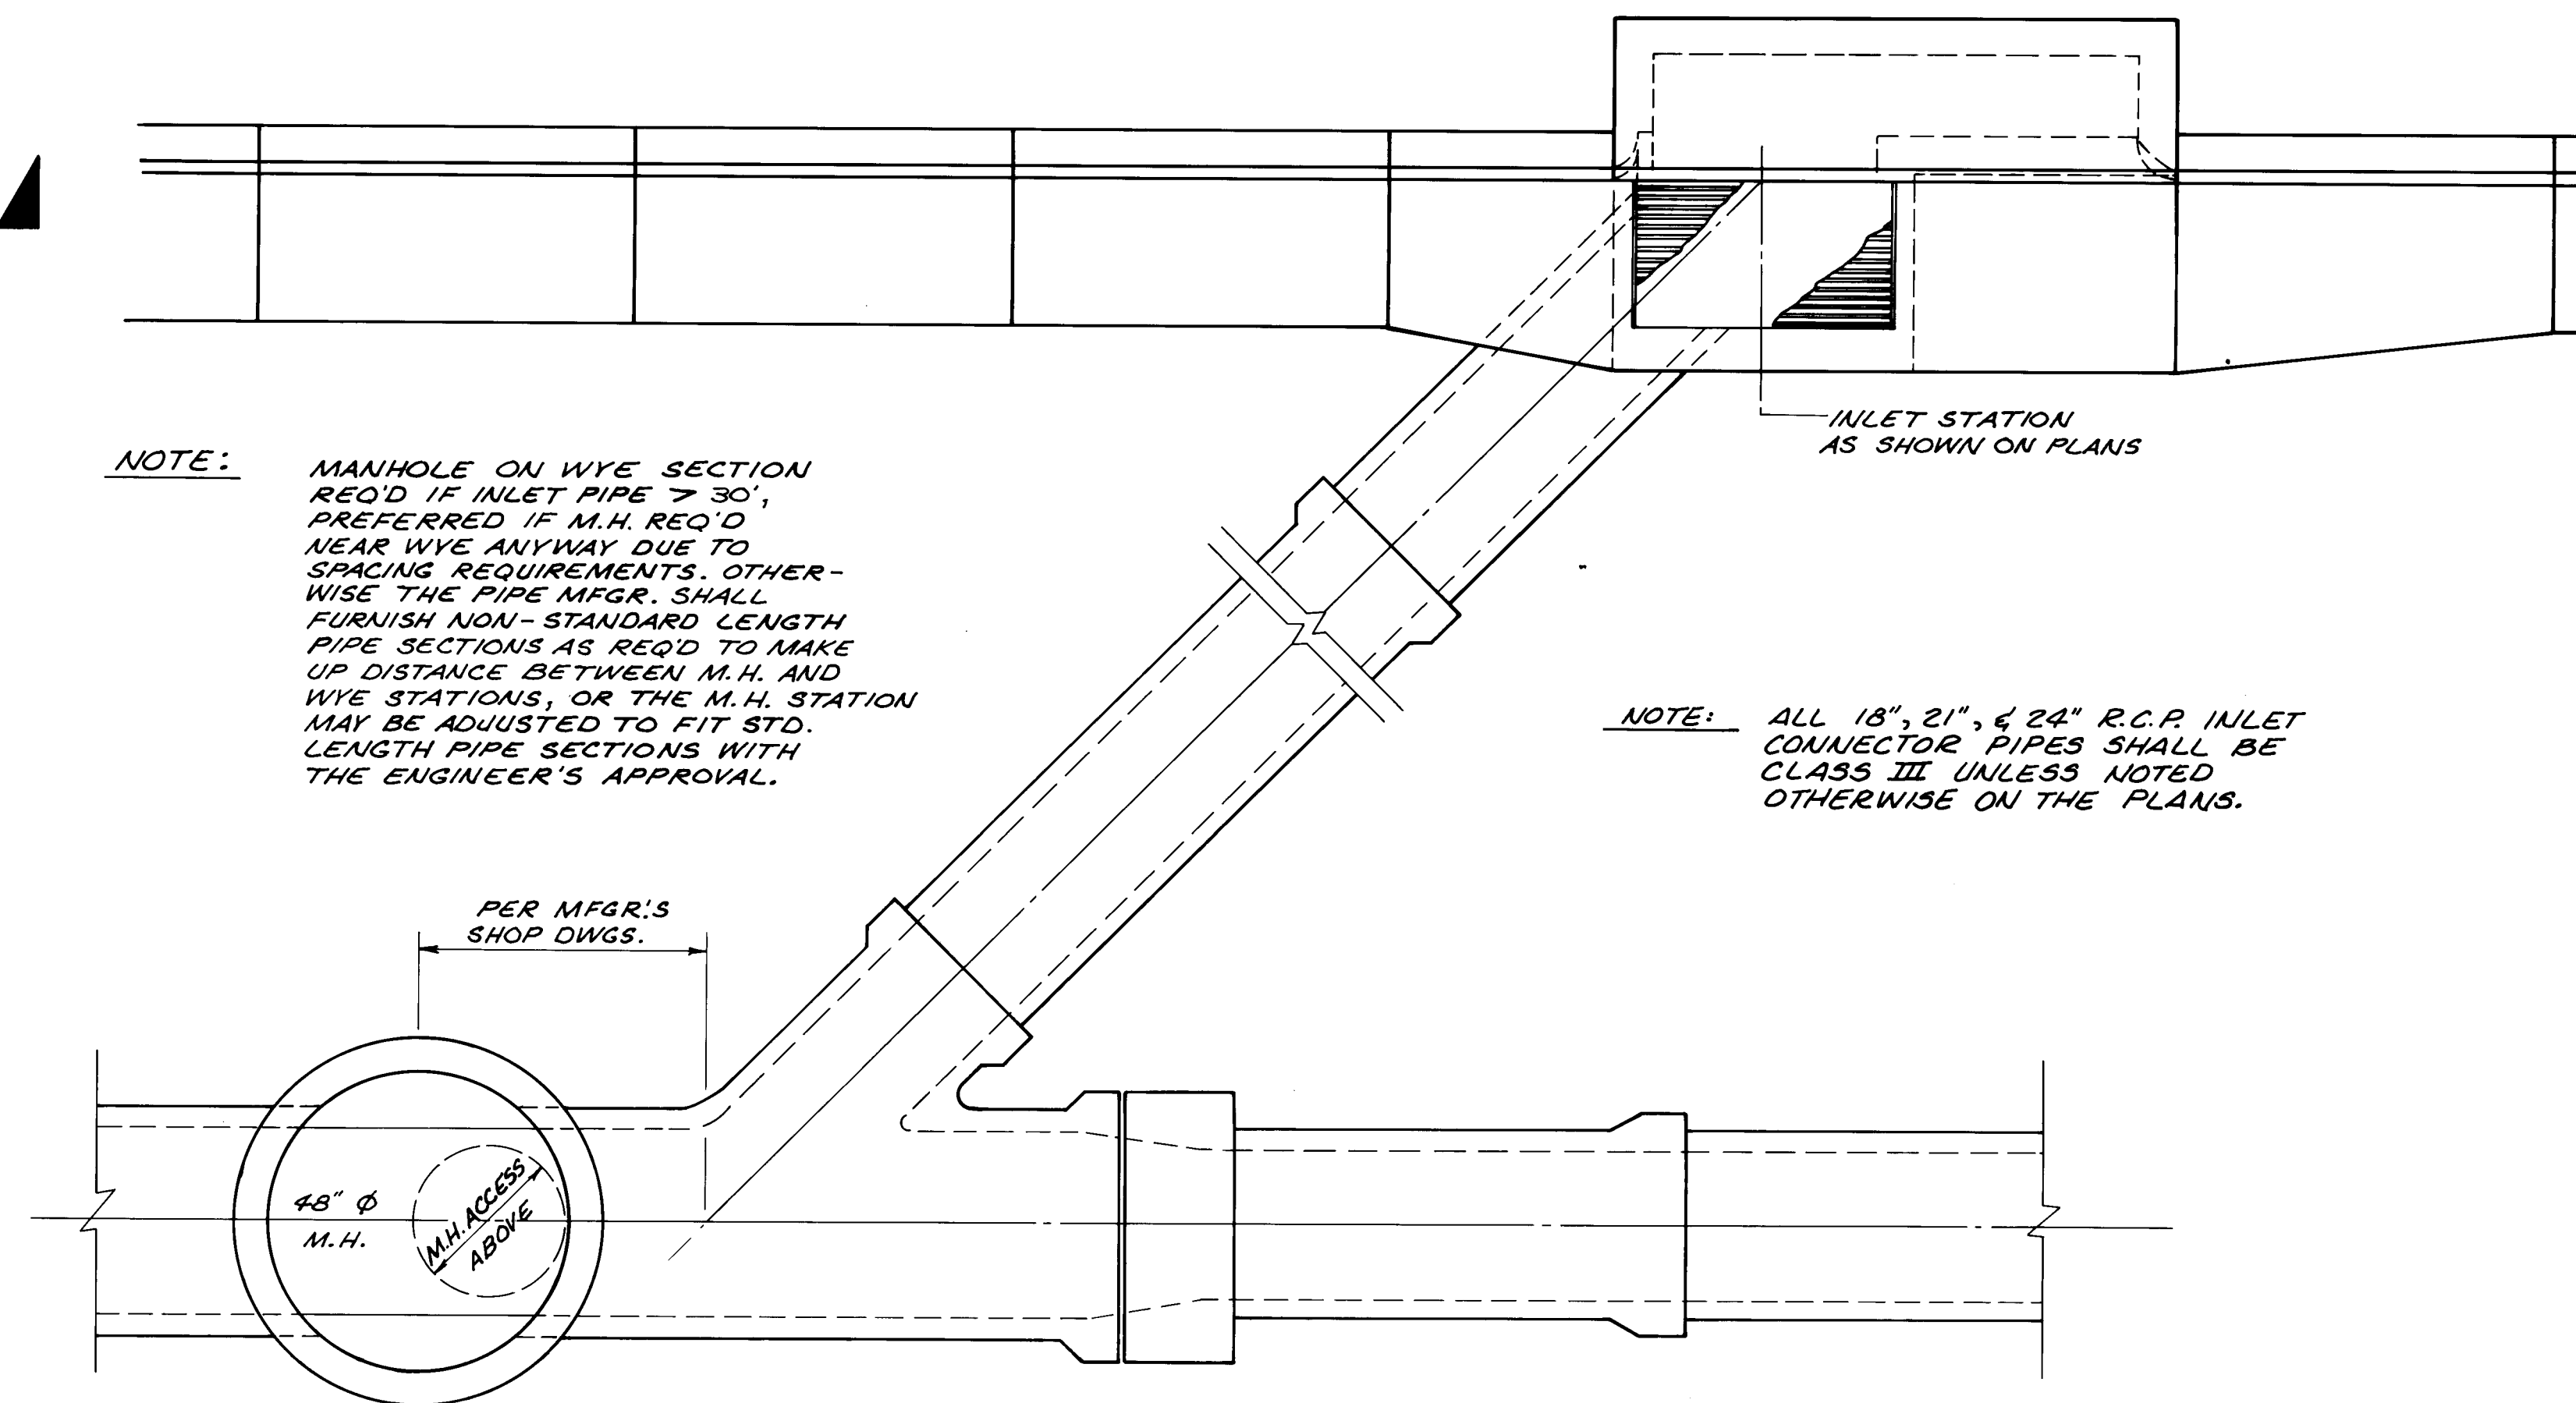



TYPICAL DROP INLET CONNECTION
NO SCALE

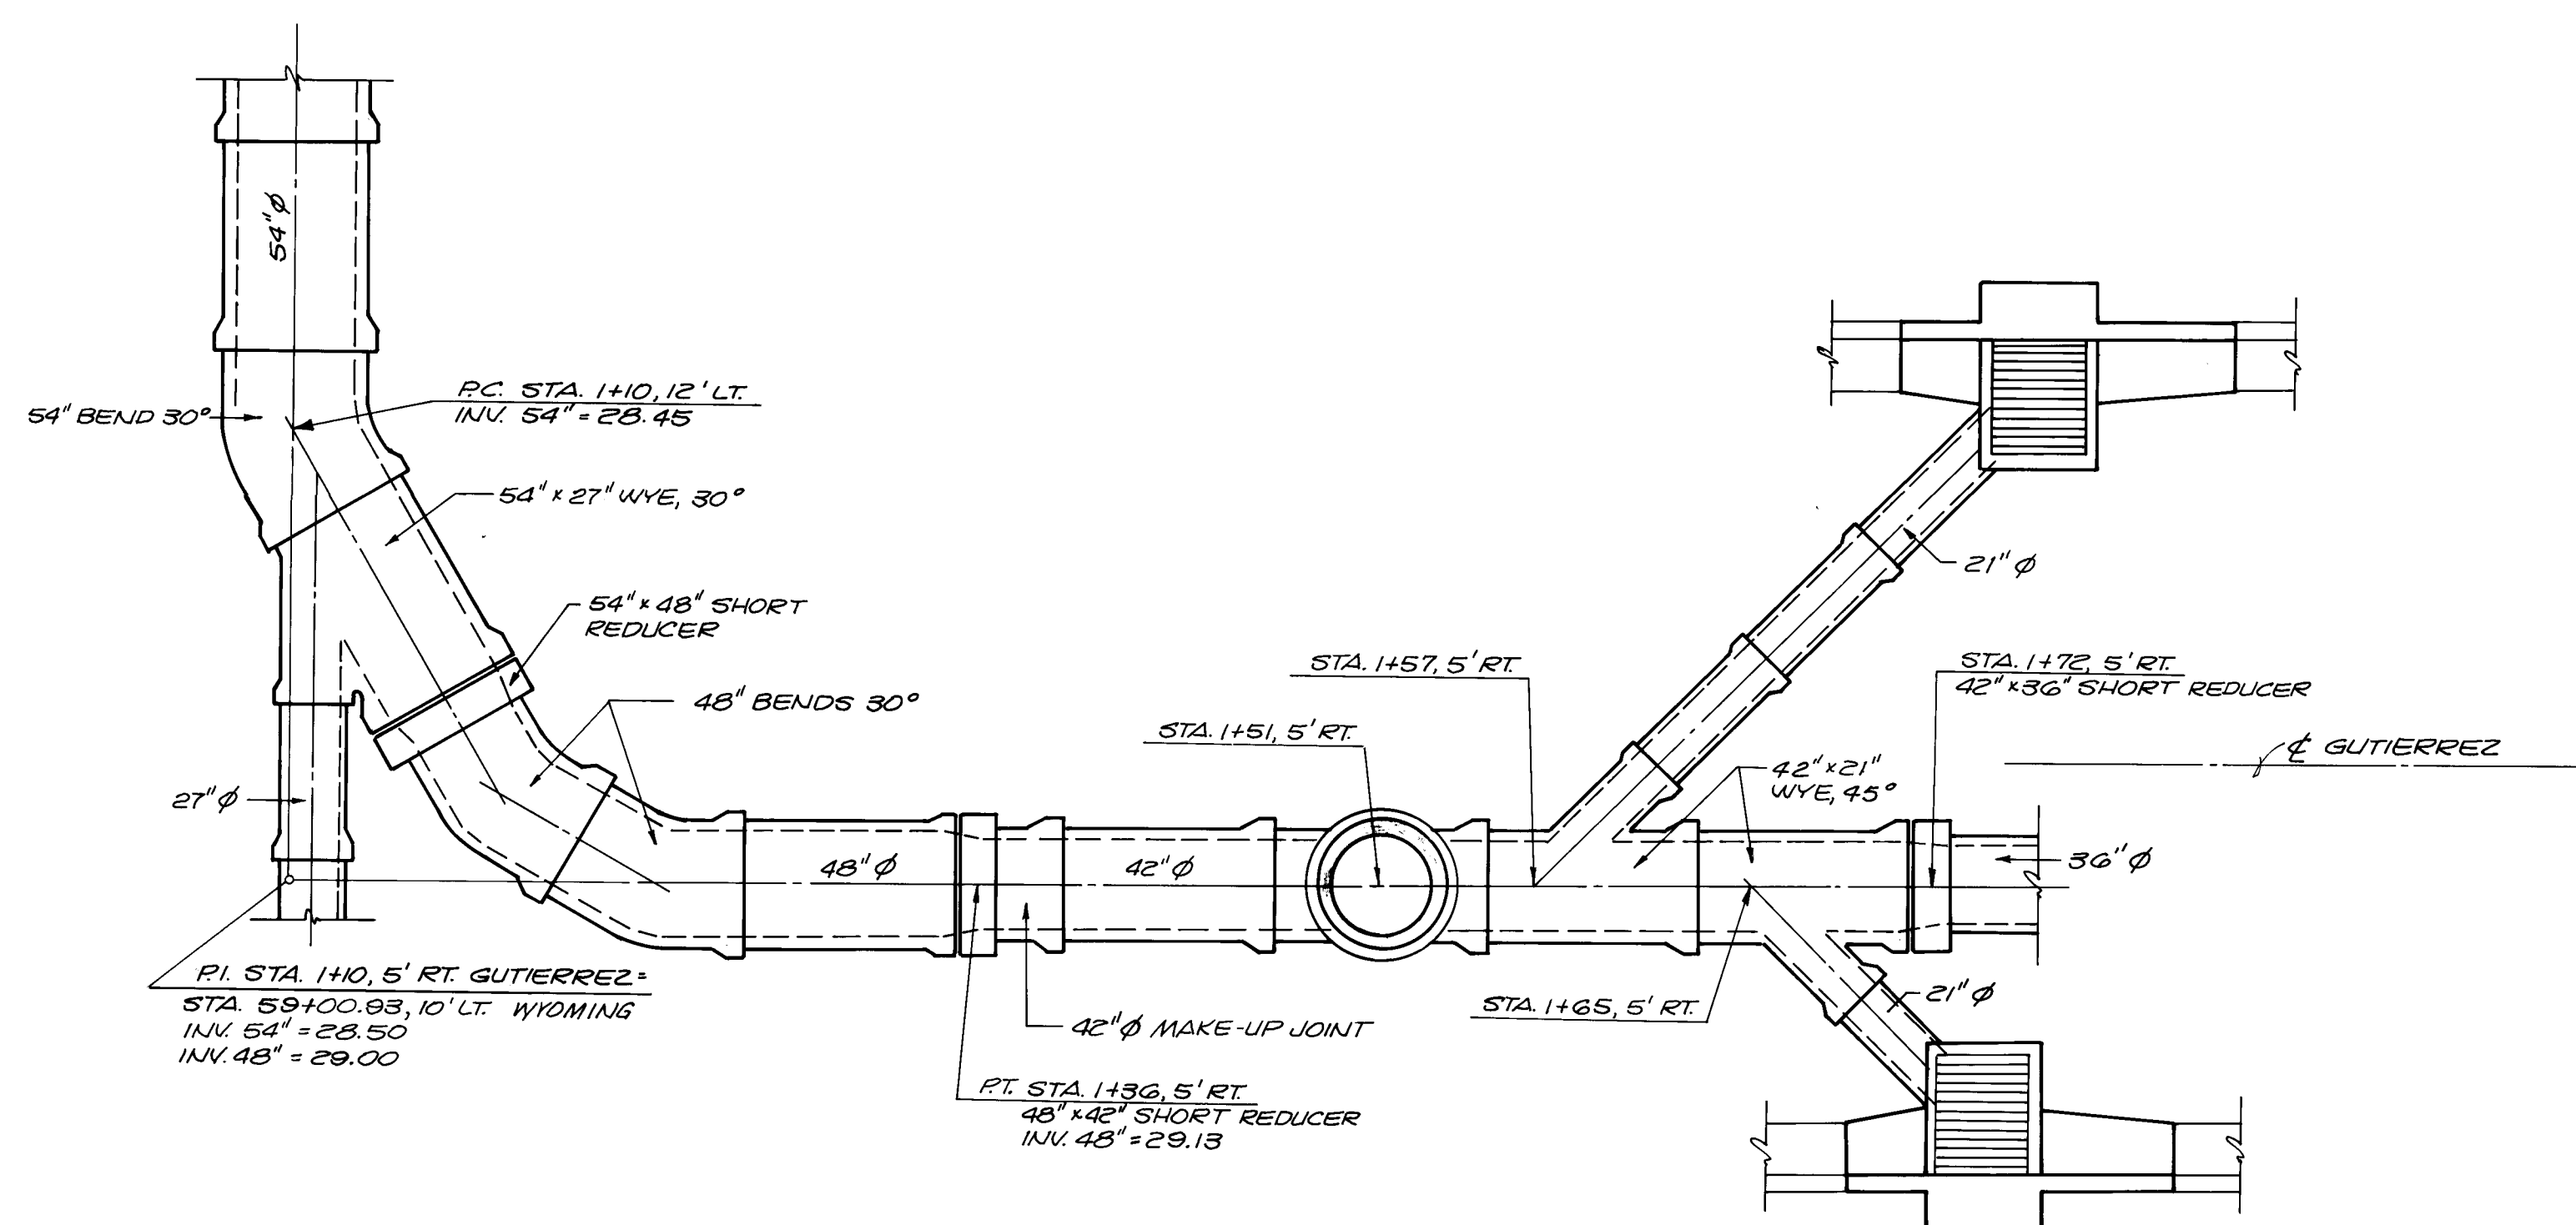

RECORD DRAWING
DATE: 12-21-01 BY: THURGOOD MARSHALL
U.C.

These record drawings have been prepared, on the basis of information
compiled and furnished by the city engineers office. The consulting
engineer will not be responsible for any errors or omissions which
have been incorporated into this document as a result.


1 2 3 4 5 6 7 8 9 10 11 12
26 16 37 34 87

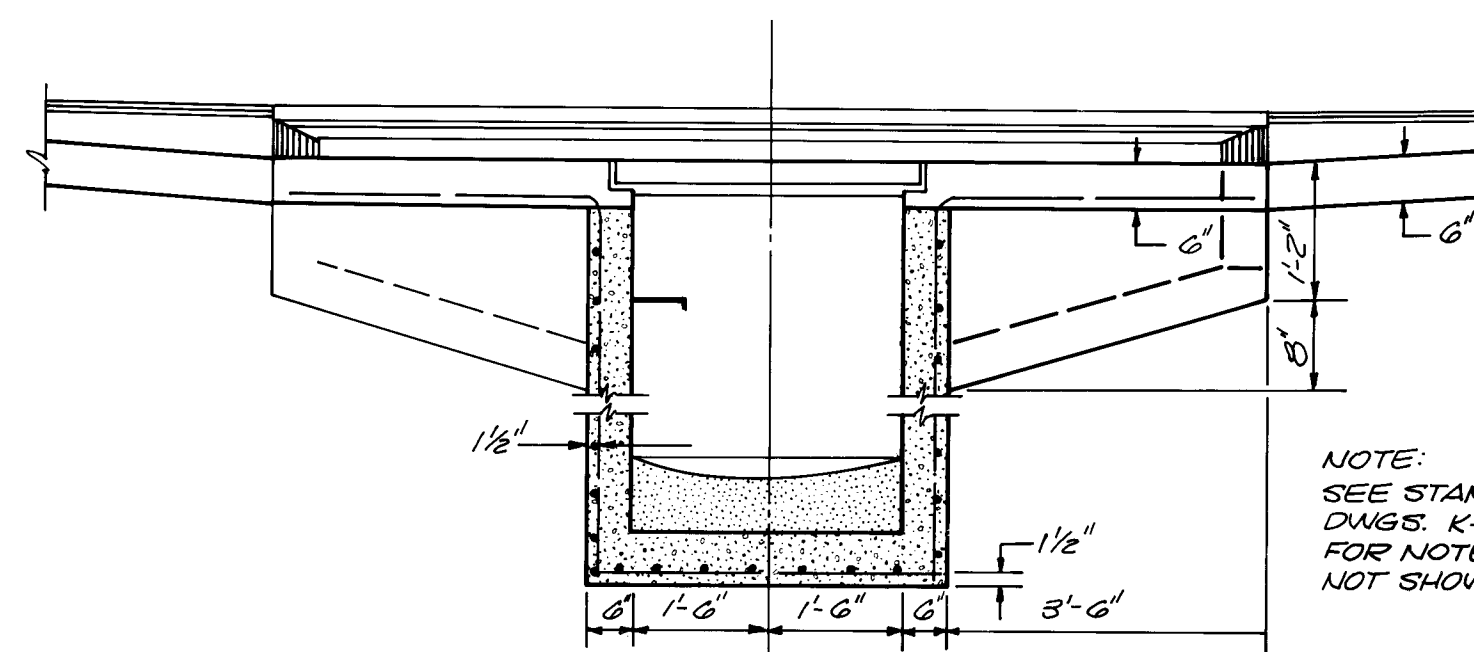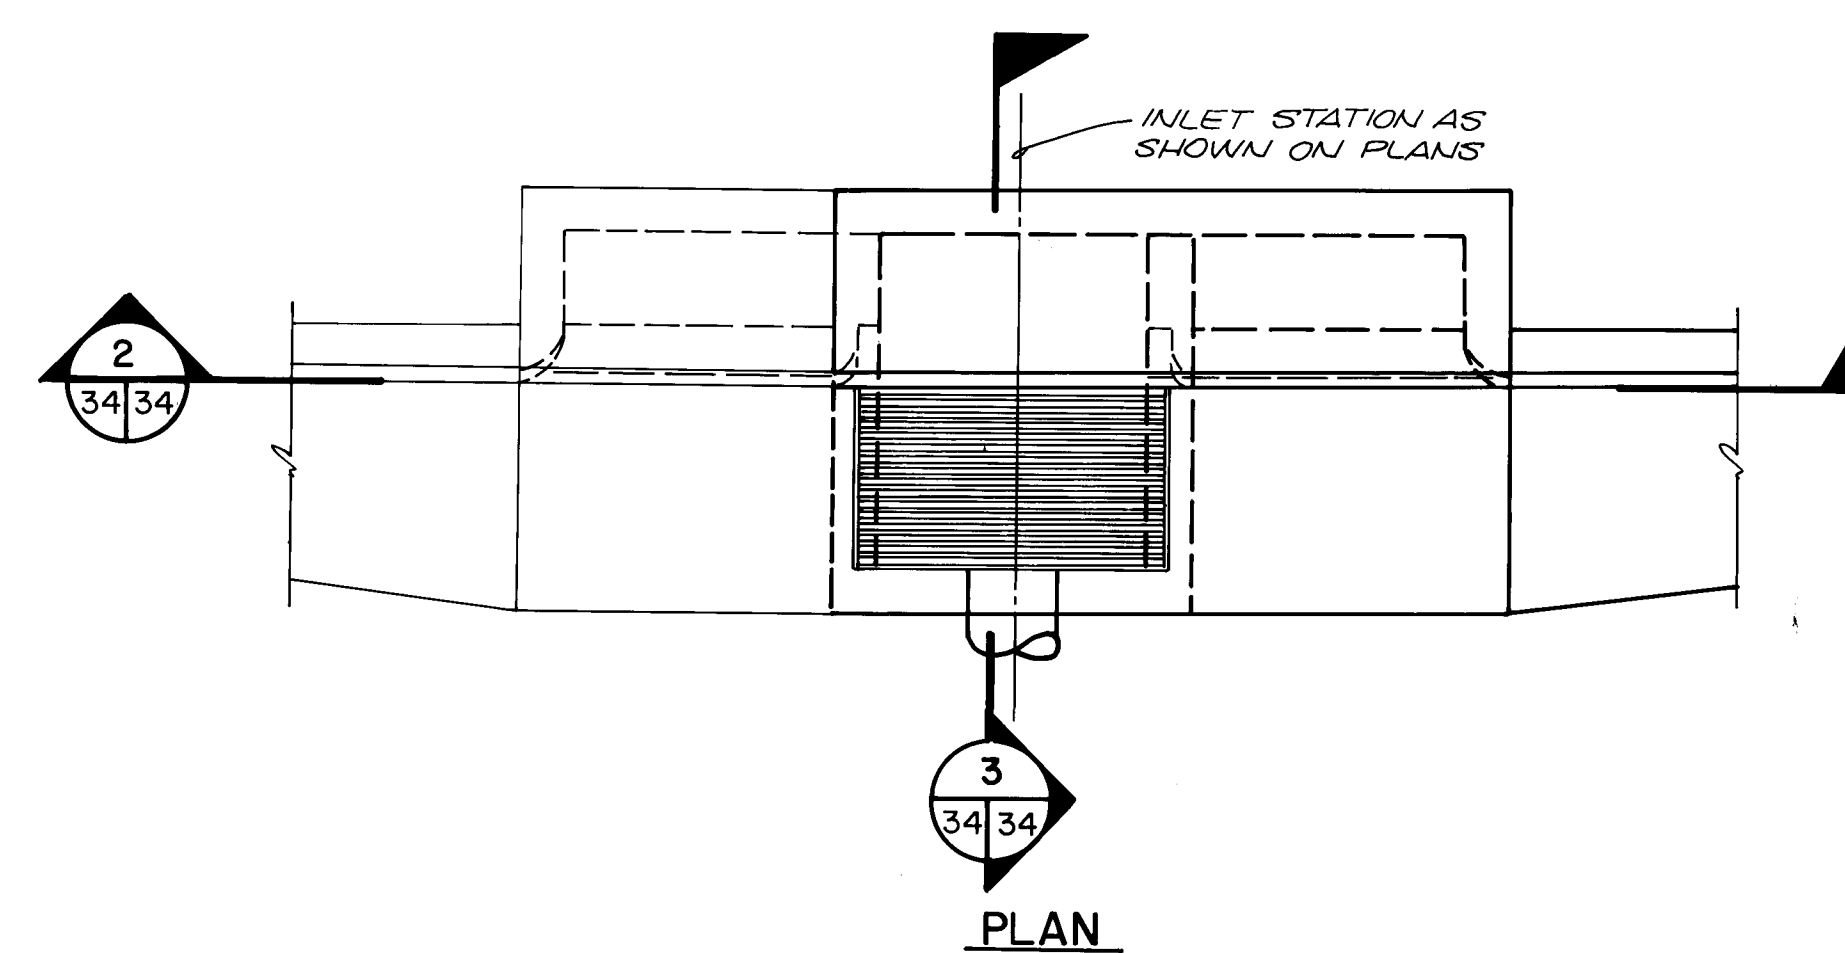


TYPE "A" DROP INLET WITH DUAL APPROACHES
NO SCALE

MOLZEN-CORBIN & ASSOCIATES
CONSULTING ENGINEERS
ALBUQUERQUE, CARLSBAD - NEW MEXICO


AS BUILT INFORMATION		BENCH MARKS		SURVEY INFORMATION		ENGINEER'S SEAL	
CONTRACTOR	DATE	CONTRACTOR	DATE	NO.	BY		DESIGNED BY: 1/2 DRAWN BY: 1/2 CHECKED BY: 1/2
ENGINEER	DATE	ENGINEER	DATE	NO.	BY		
INSPECTOR	DATE	INSPECTOR	DATE	NO.	BY		
APPROVED BY	DATE	APPROVED BY	DATE	NO.	BY		
ACCS BRASS CAP 1-1/2" EL. 5494.19 678 FT. E. EAST OF E. WYOMING BLVD. 650 FT. S. SOUTH OF E. ACADEMY BLVD. ACCS BRASS CAP 1-1/2" EL. 5497.25 WYOMING BLVD. AND SOUTH WYOMING BLVD. AND SOUTH WYOMING BLVD. AND SOUTH WYOMING BLVD. AND SOUTH WYOMING BLVD. AND SOUTH		ACCS BRASS CAP 1-1/2" EL. 5494.19 678 FT. E. EAST OF E. WYOMING BLVD. 650 FT. S. SOUTH OF E. ACADEMY BLVD. ACCS BRASS CAP 1-1/2" EL. 5497.25 WYOMING BLVD. AND SOUTH WYOMING BLVD. AND SOUTH WYOMING BLVD. AND SOUTH WYOMING BLVD. AND SOUTH WYOMING BLVD. AND SOUTH		ACCS BRASS CAP 1-1/2" EL. 5494.19 678 FT. E. EAST OF E. WYOMING BLVD. 650 FT. S. SOUTH OF E. ACADEMY BLVD. ACCS BRASS CAP 1-1/2" EL. 5497.25 WYOMING BLVD. AND SOUTH WYOMING BLVD. AND SOUTH WYOMING BLVD. AND SOUTH WYOMING BLVD. AND SOUTH WYOMING BLVD. AND SOUTH		ACCS BRASS CAP 1-1/2" EL. 5494.19 678 FT. E. EAST OF E. WYOMING BLVD. 650 FT. S. SOUTH OF E. ACADEMY BLVD. ACCS BRASS CAP 1-1/2" EL. 5497.25 WYOMING BLVD. AND SOUTH WYOMING BLVD. AND SOUTH WYOMING BLVD. AND SOUTH WYOMING BLVD. AND SOUTH WYOMING BLVD. AND SOUTH	

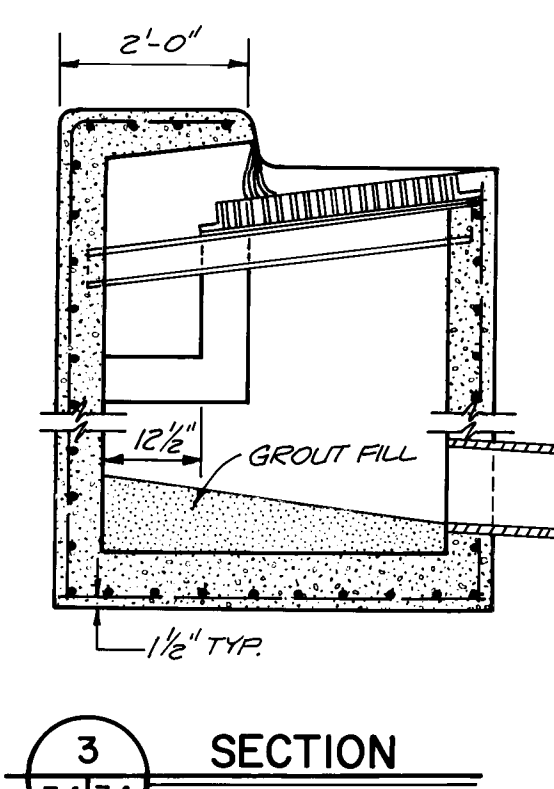


CITY OF ALBUQUERQUE					
TRANSPORTATION DEPARTMENT					
TITLE: WYOMING BLVD. N.E. WIDENING					
MISCELLANEOUS DETAILS					
APPROVALS	ENGINEER	DATE	APPROVALS	ENGINEER	DATE
City Engineer			Liquid Waste		
A.C.E. - Design			Traffic		
A.C.E. - Hydrology			Water		
DRAWING NO. 1637		MAP NO. F-19-120		SHEET 34 OF 38	

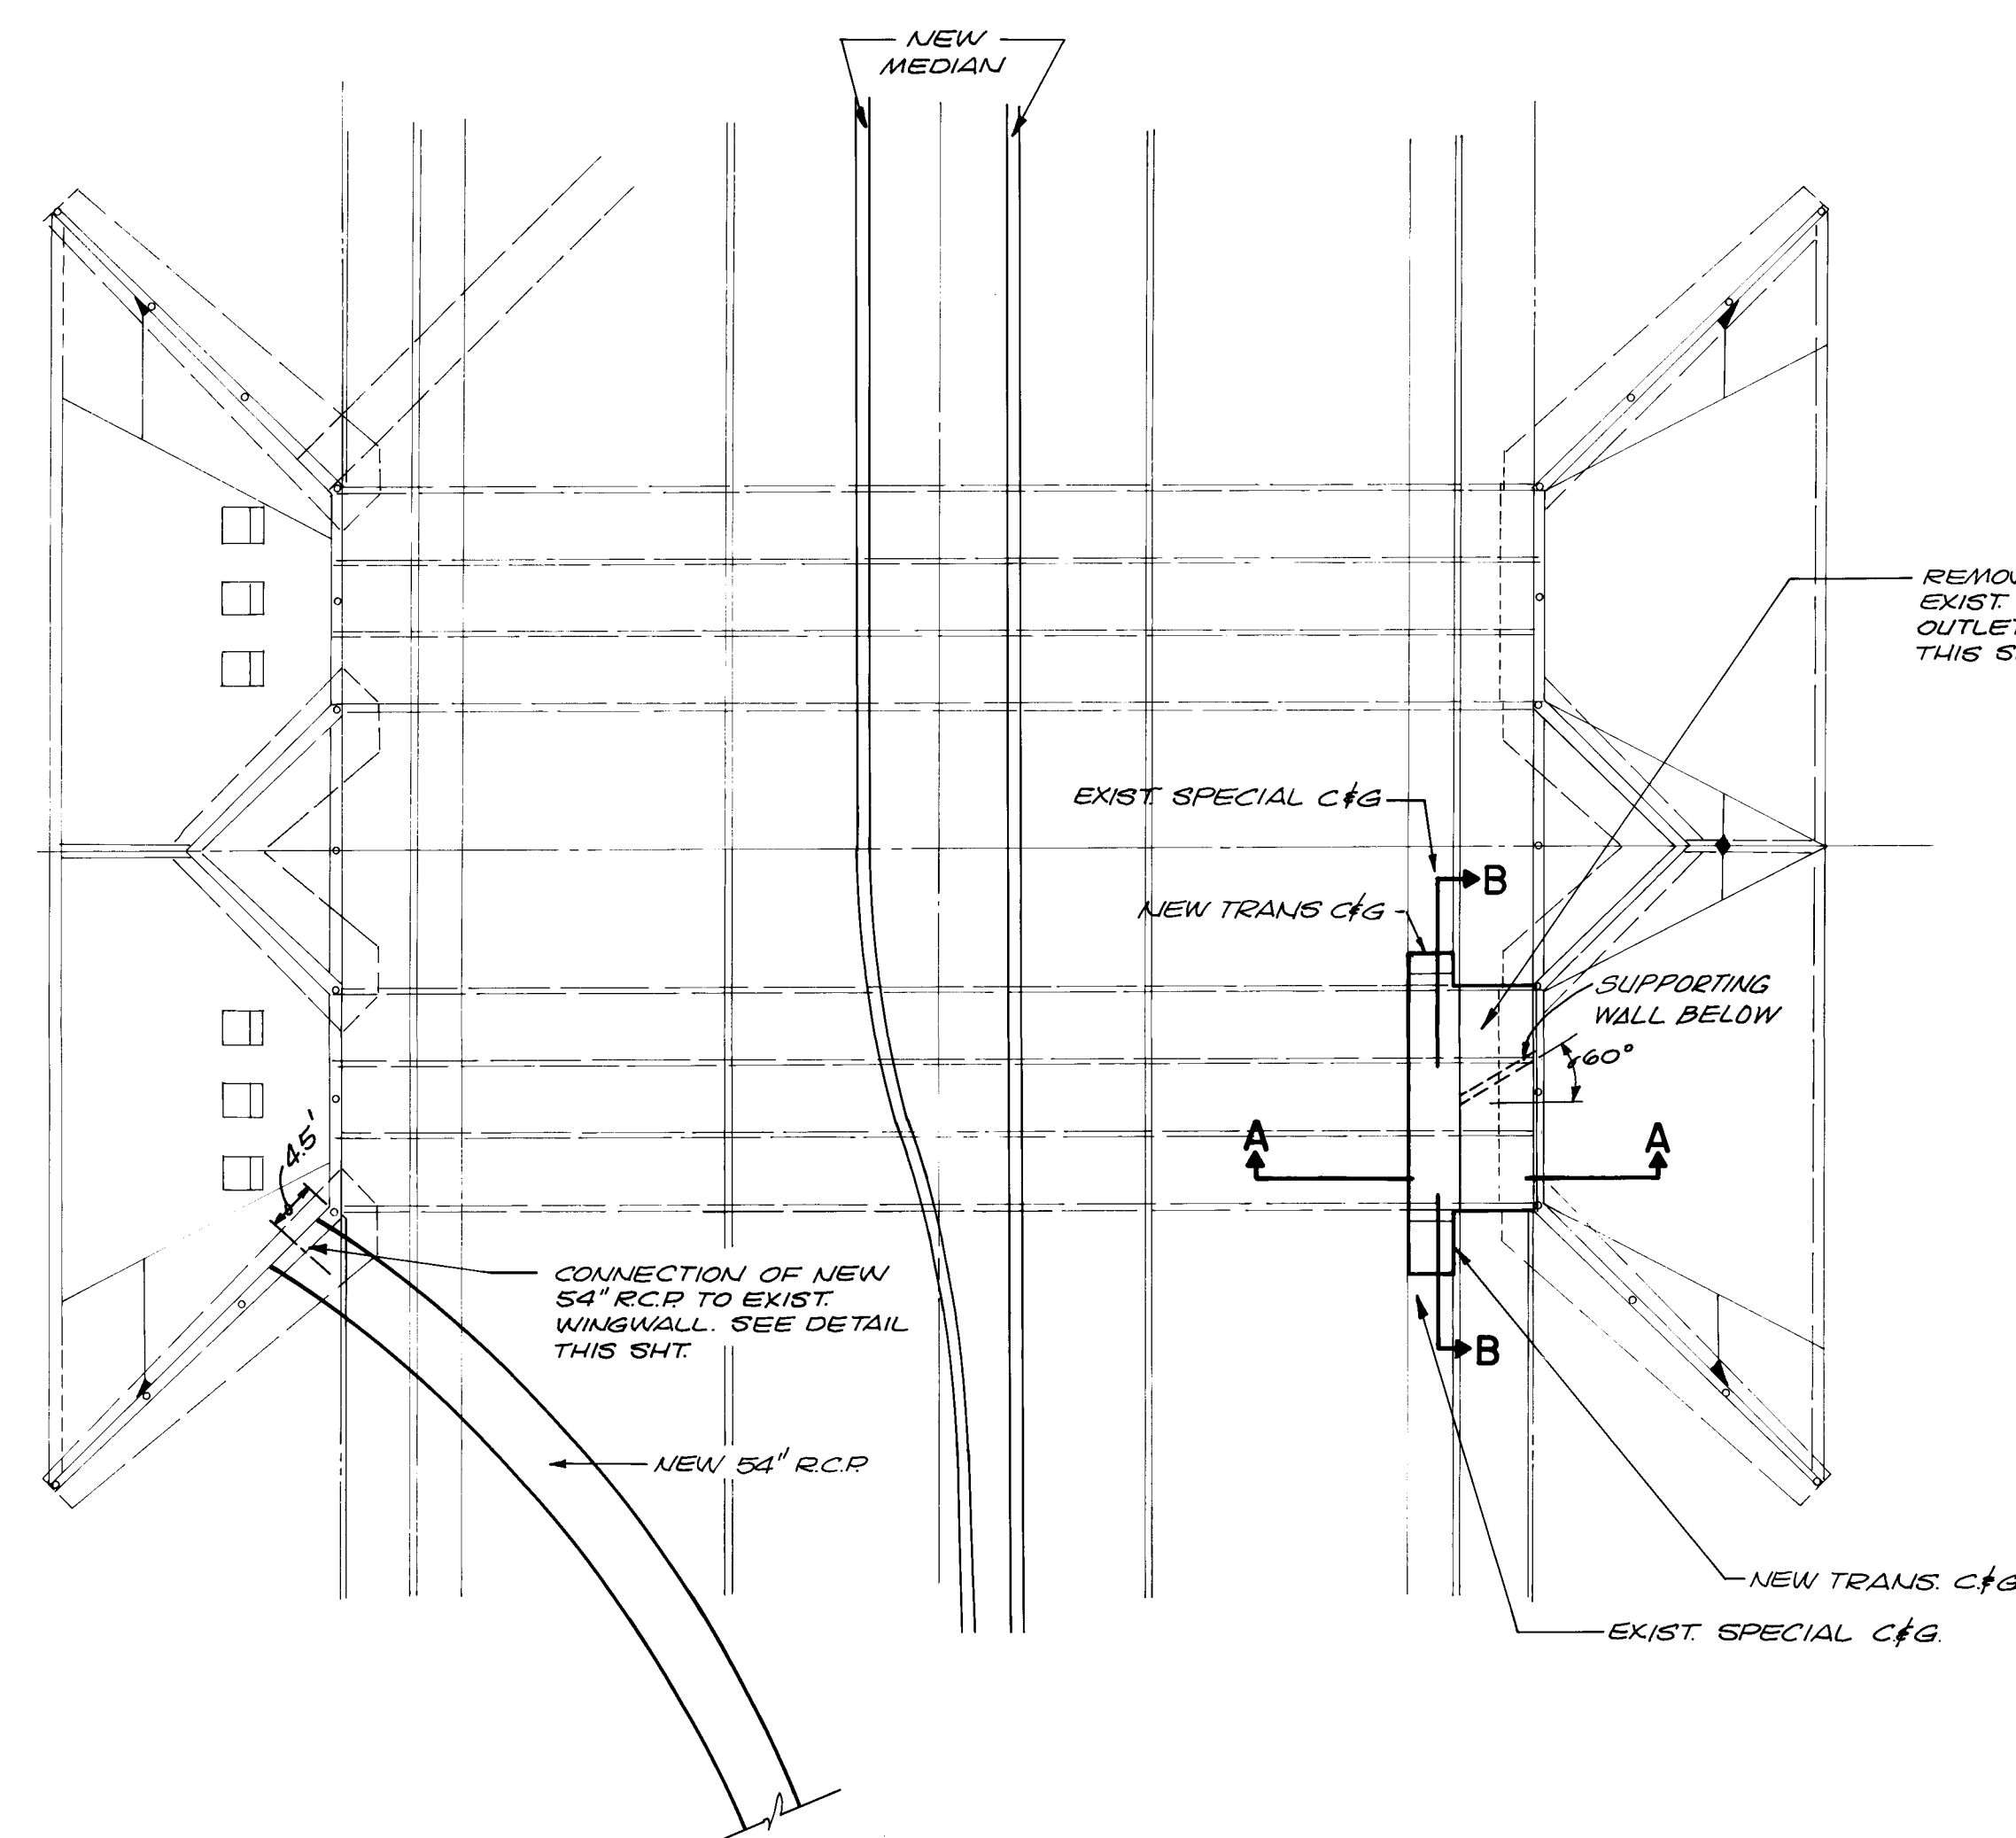

PLAN

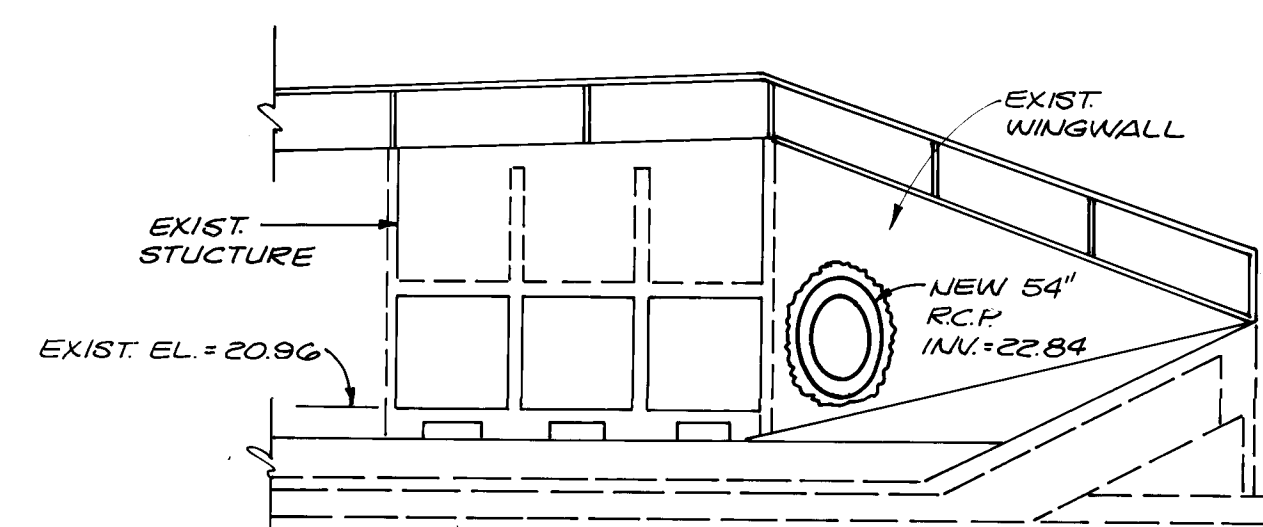


ELEVATION

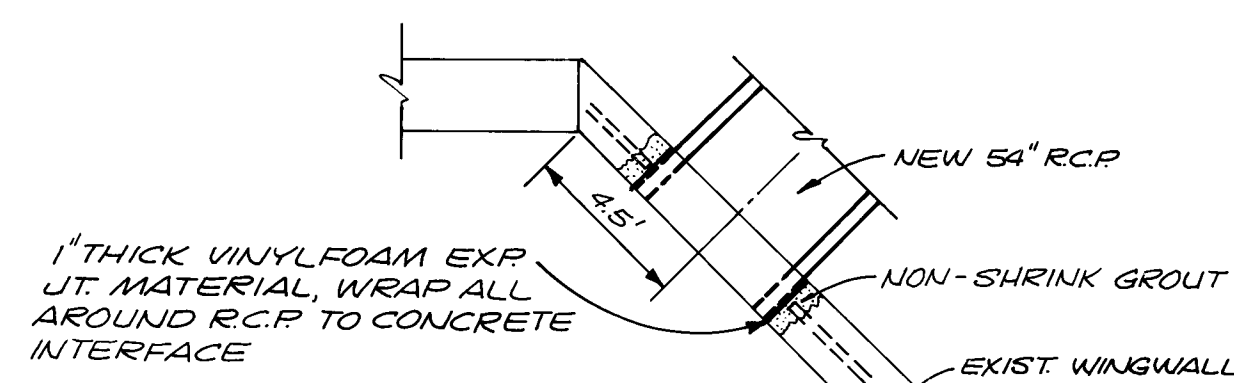

CONNECTION DETAIL


CONNECTION OF NEW 54" R.C.P. TO
EXIST. WINGWALL @ BEAR CANYON

NO SCALE

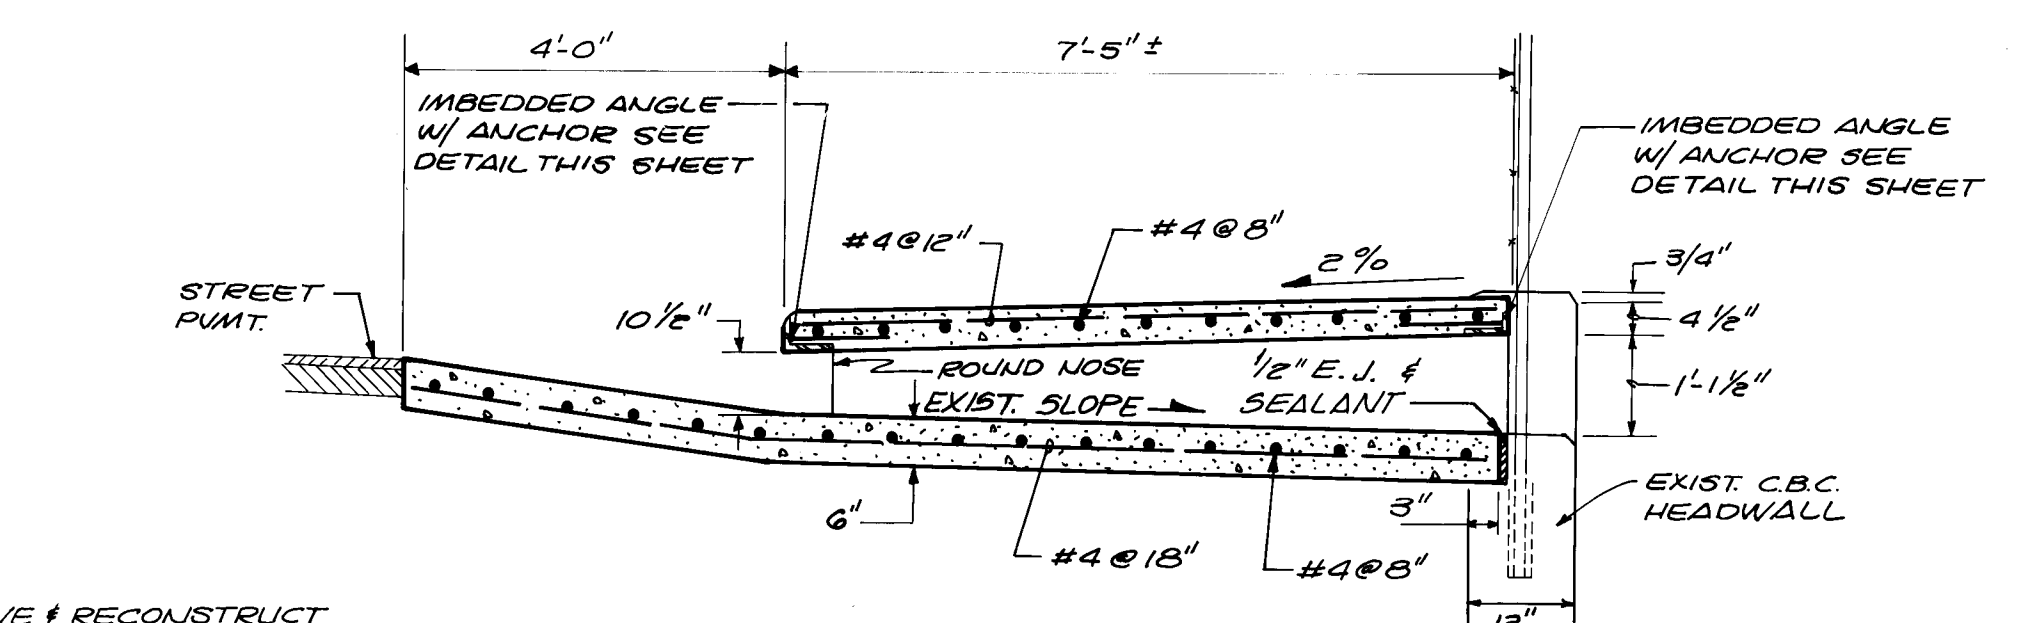


SECTION A-A

NOTE!
CONCRETE SHALL
BE 3000 P.S.I.

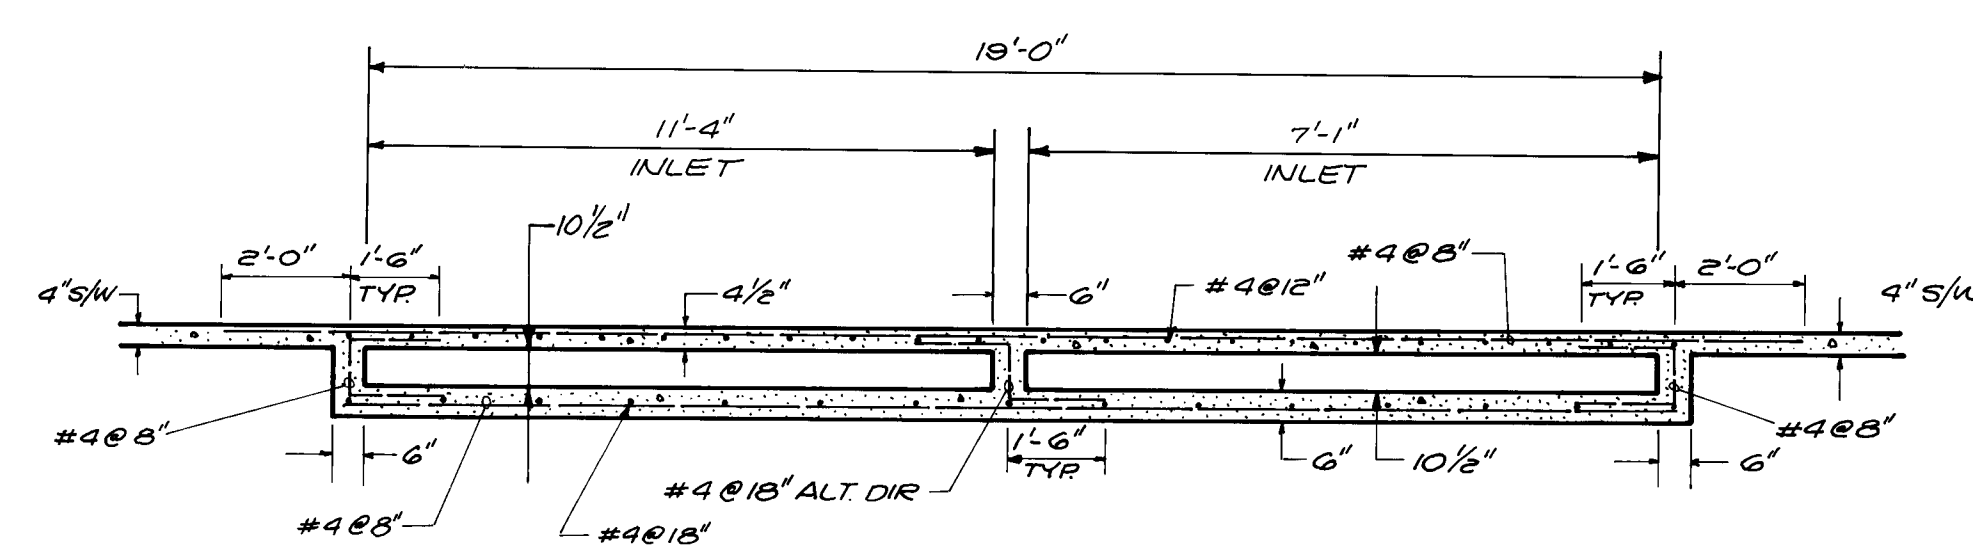



SECTION B-B

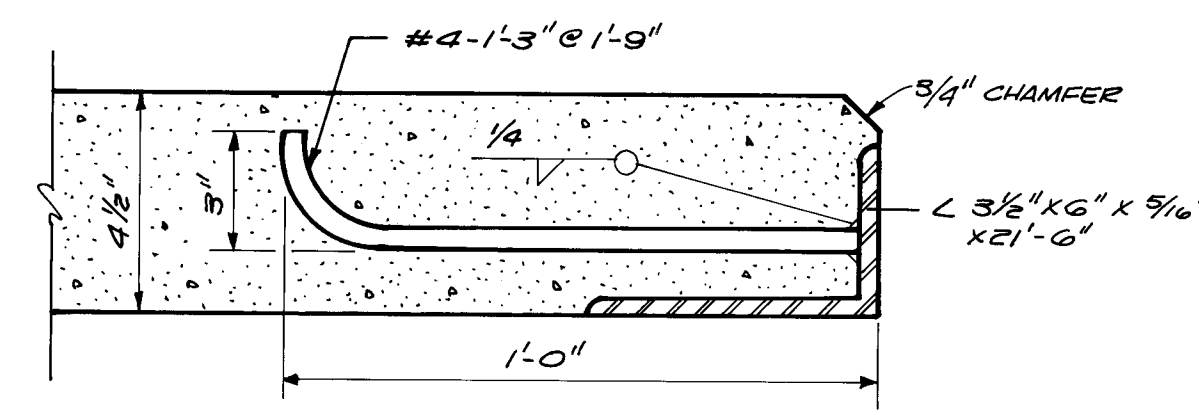

ANGLE W/ ANCHOR DETAIL

SIDEWALK DRAINAGE OUTLET DETAIL

NO SCALE

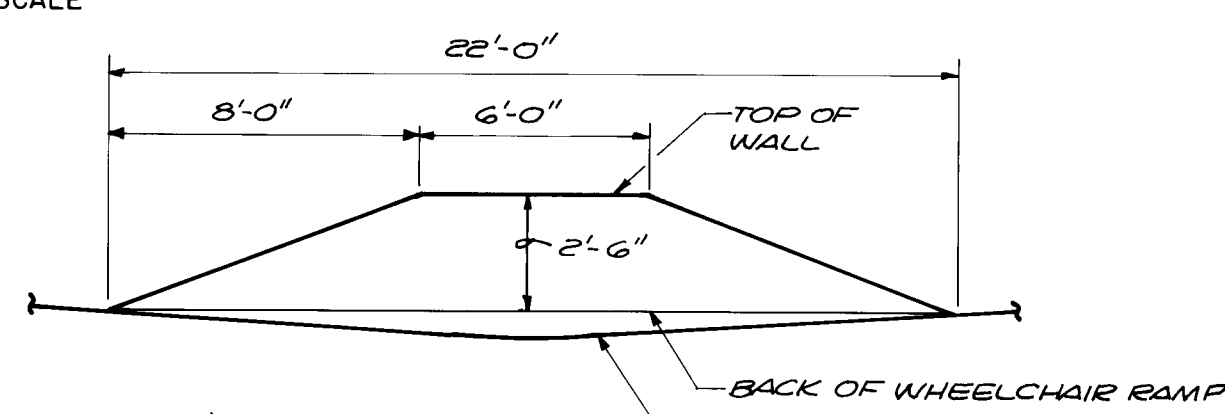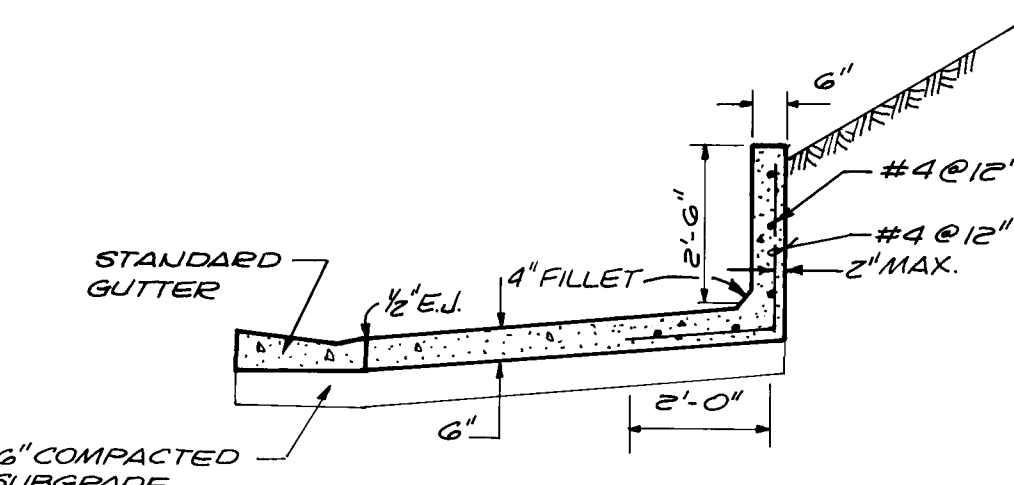ELEVATION


SECTION

INTEGRAL RETAINING WALL
@ STA. 43+58, 45' LT. DETAIL

NO SCALE



PLAN

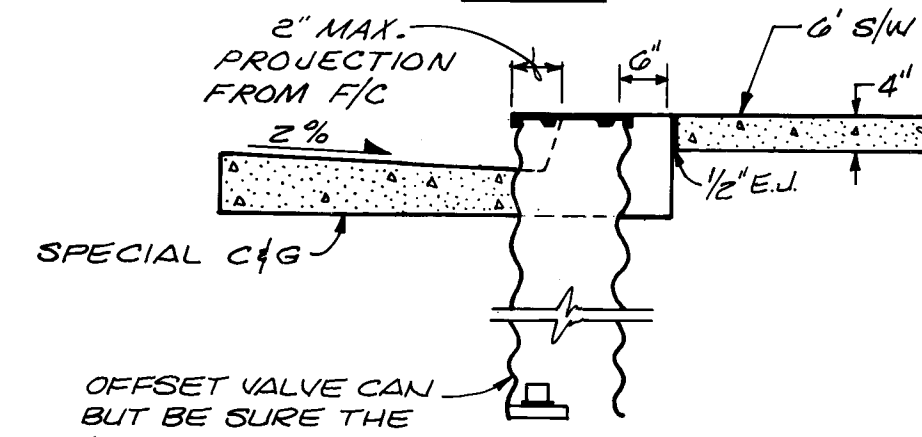

SECTION

VALVE BOX IN CURB
LINE DETAIL

NO SCALE

RECORD DRAWING		
DATE: 2-24-84	BY: M-C	FROM: CIVIL MARK-UPS

These record drawings have been prepared, on the basis of information compiled and furnished by the city engineers office. The consulting engineer will not be responsible for any errors or omissions which have been incorporated into this document as a result.

1	2	3	4	5	6	7	8	9	10	11	12
26			16	37	35	87					

MOLZEN-CORBIN & ASSOCI.
CONSULTING ENGINEERS

ALBUQUERQUE, CARLSBAD - NEW MEXICO

APPROVED FOR
CONSTRUCTION

CITY ENGINEER

CITY ENGINEER

CITY ENGINEER

CITY OF ALBUQUERQUE

TRANSPORTATION DEPARTMENT

TITLE: WYOMING BLVD. N.E. WIDENING

MISCELLANEOUS DETAILS

APPROVALS	ENGINEER	DATE	APPROVALS	ENGINEER	DATE
City Engineer			Liquid Waste		
A.C.E. - Design			Traffic		
A.C.E. -Hydrology			Water		


DRAWING NO. 1637

MAP NO.	
---------	--


SHEET

OF

38

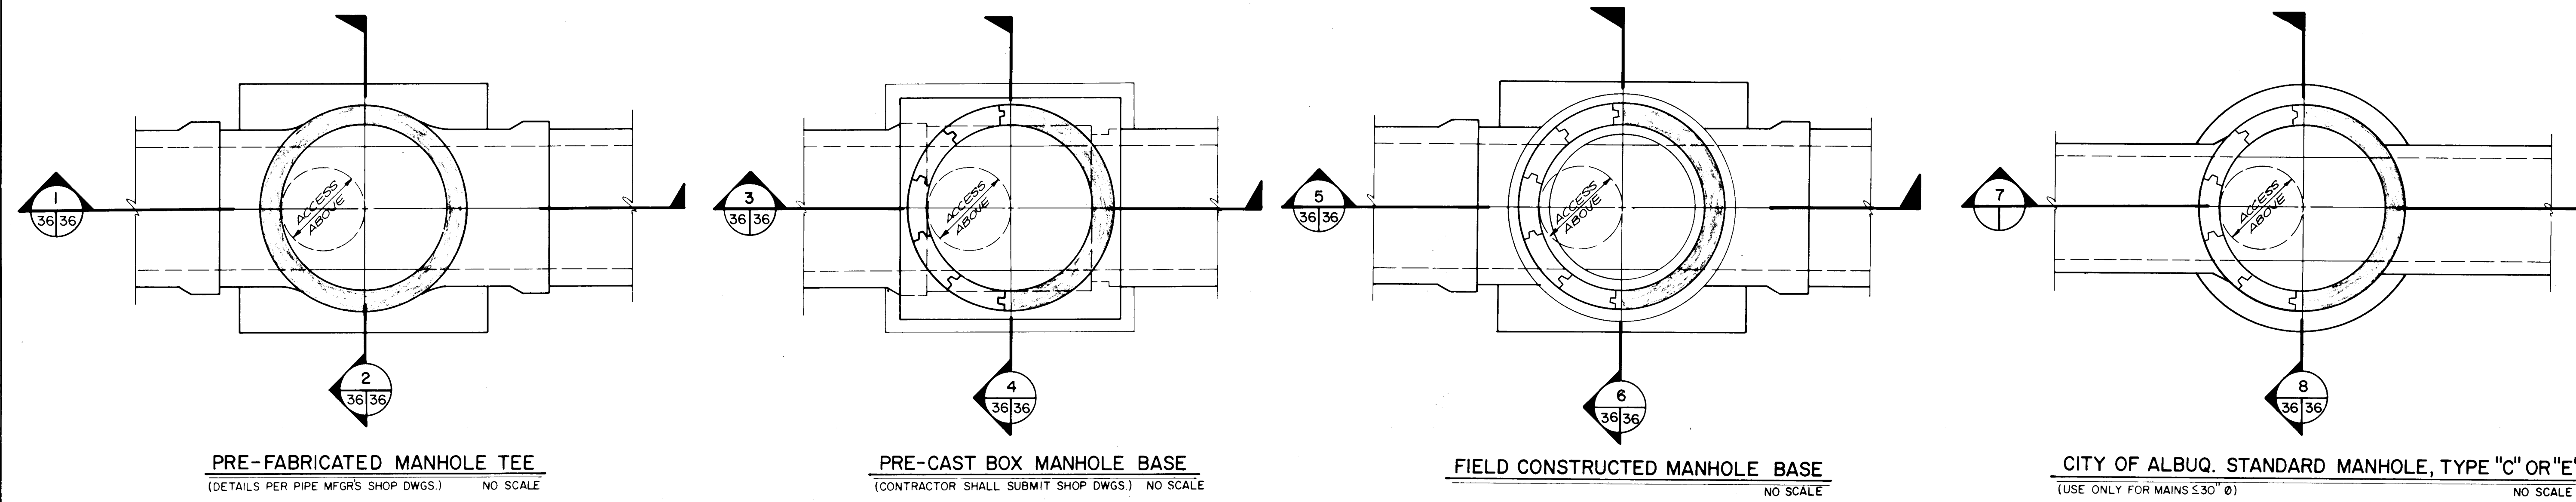

OPTIONAL BASES FOR TYPE "D" MANHOLES

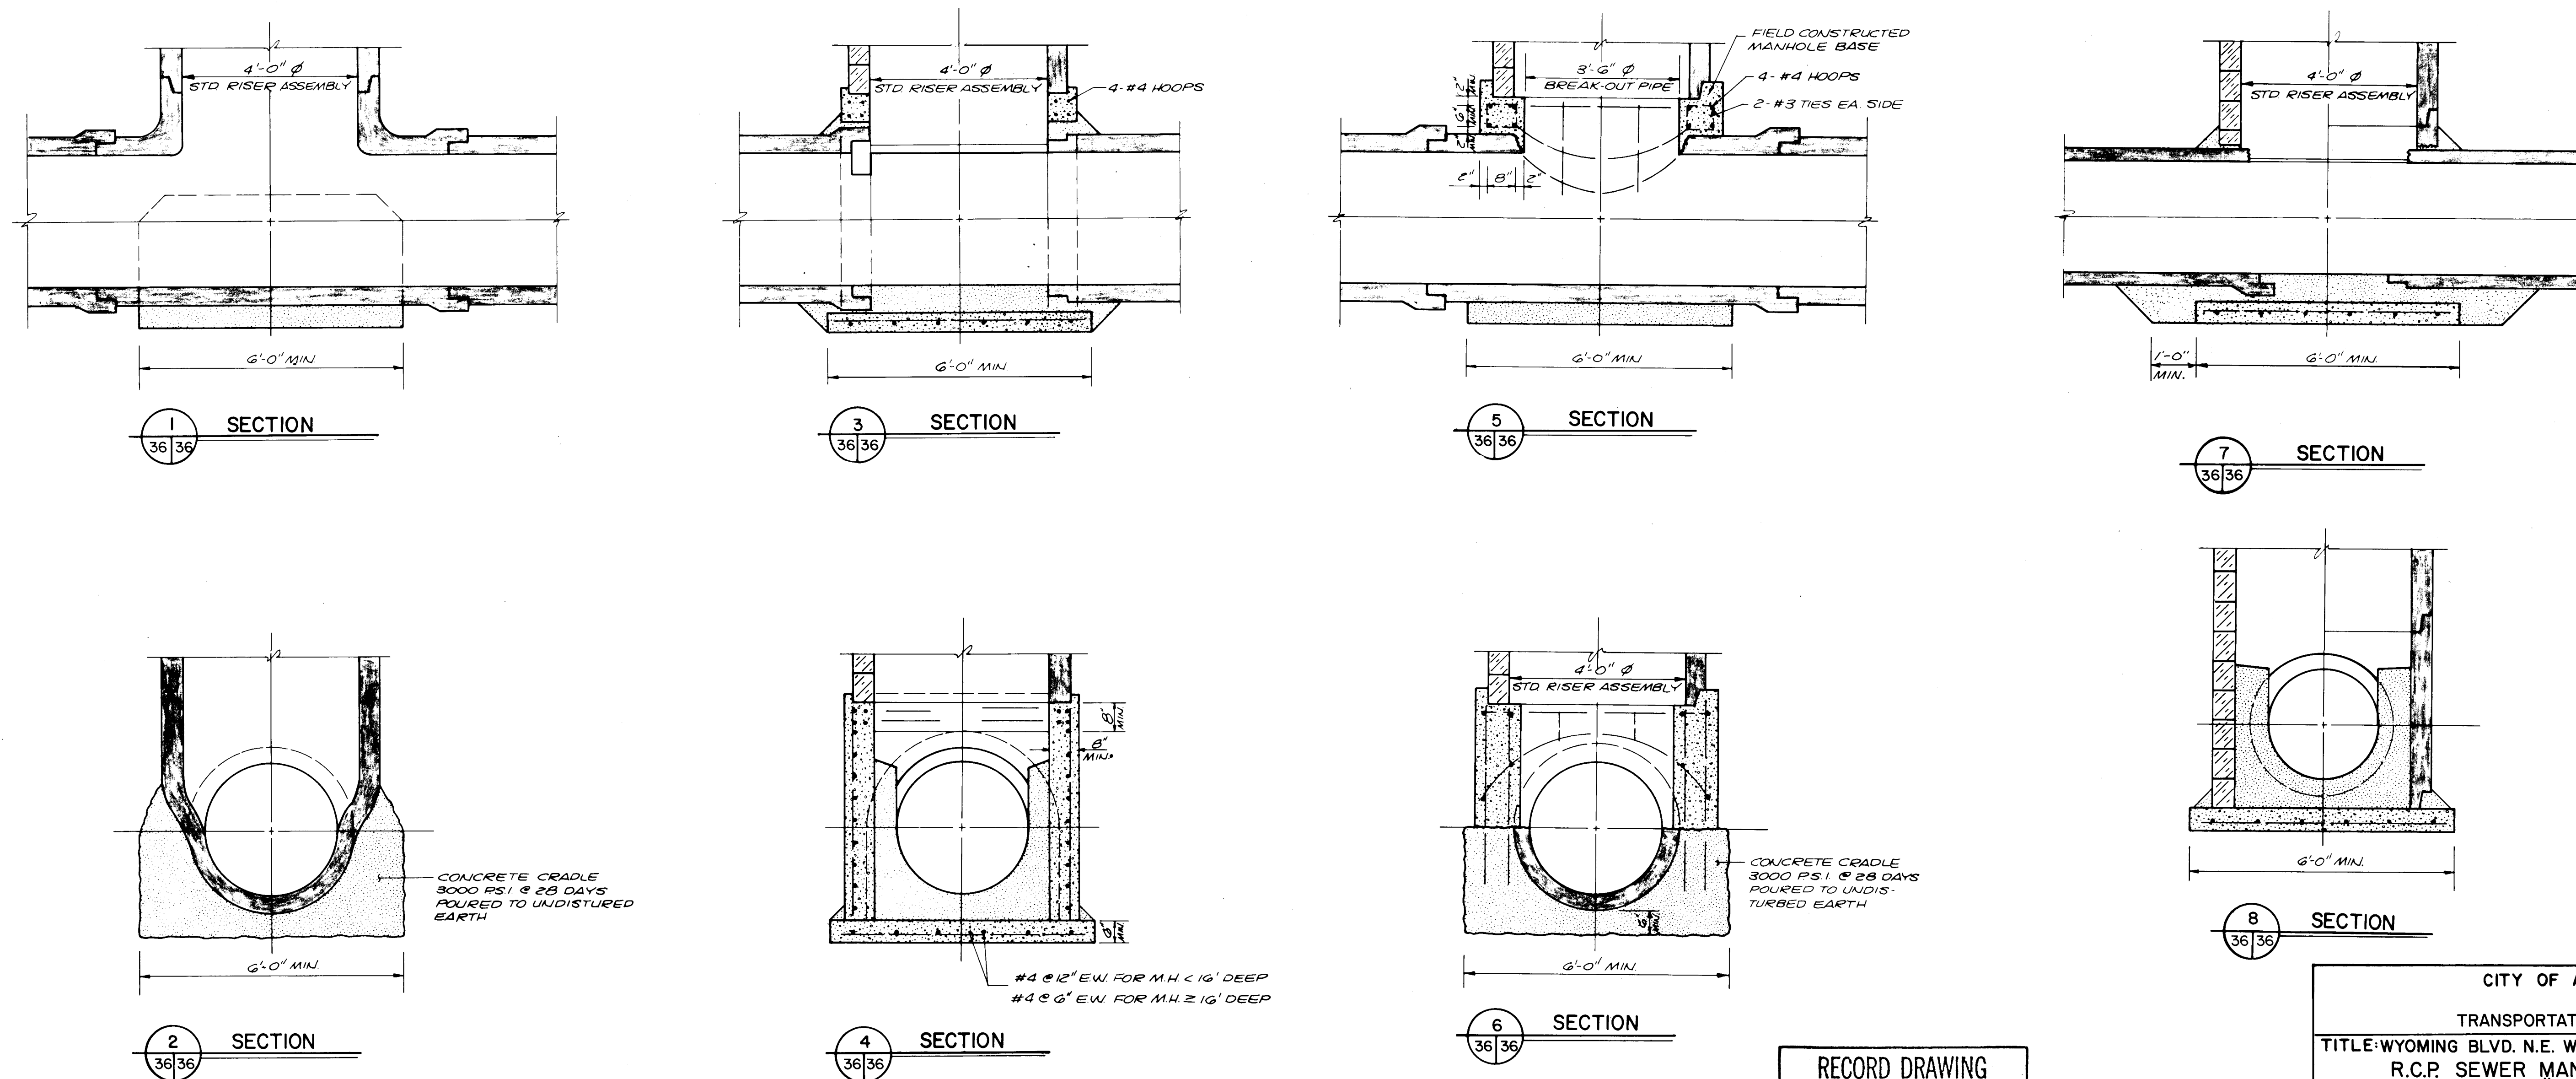

RECORD DRAWING

DATE: 5-23-83 BY: M.C. WARRICK

These record drawings have been prepared, on the basis of information compiled and furnished by the city engineers office. The consulting engineer will not be responsible for any errors or omissions which have been incorporated into this document as a result.


1 2 3 4 5 6 7 8 9 10 11 12
26 26 26 26 26 26 26 26 26 26 26 26

CITY OF ALBUQUERQUE					
TRANSPORTATION DEPARTMENT					
TITLE: WYOMING BLVD. N.E. WIDENING					
R.C.P. SEWER MANHOLE BASES					
FOR MAINS 36" Ø & SMALLER					
APPROVALS	ENGINEER	DATE	APPROVALS	ENGINEER	DATE
City Engineer			Liquid Waste		
A.C.E. - Design			Traffic		
A.C.E. - Hydrology			Water		
DRAWING NO. 1637			MAP NO. F-19120		
SHEET 36			OF 38		


AS BUILT INFORMATION		BENCH MARKS		SURVEY INFORMATION		ENGINEER'S SEAL	
CONTRACTOR	DATE	NO.	DATE	NO.	DATE	NO.	DATE
DESIGNED BY	DATE	ALBUQ. SURVEY CO.	DATE	ALBUQ. SURVEY CO.	DATE	ALBUQ. SURVEY CO.	DATE
CHECKED BY	DATE	ALBUQ. SURVEY CO.	DATE	ALBUQ. SURVEY CO.	DATE	ALBUQ. SURVEY CO.	DATE
RECORDED BY	DATE	ALBUQ. SURVEY CO.	DATE	ALBUQ. SURVEY CO.	DATE	ALBUQ. SURVEY CO.	DATE
RECORDED BY	DATE	ALBUQ. SURVEY CO.	DATE	ALBUQ. SURVEY CO.	DATE	ALBUQ. SURVEY CO.	DATE

A technical diagram of a Tee joint. The top half is labeled "FIELD CONSTRUCTED BASE" and the bottom half is labeled "PRE-FABRICATED TEE". The diagram shows a cross-section of a pipe with a Tee fitting. The Tee fitting is divided into two parts: a "FIELD CONSTRUCTED BASE" on the left and a "PRE-FABRICATED TEE" on the right. The Tee fitting is shown with a "TACKLED EDGE" and a "TACKLED EDGE" label. The diagram also includes a "5" in a circle with "37/37" below it, and a "6" in a circle with "37/37" below it, indicating specific dimensions or specifications.


SECTION

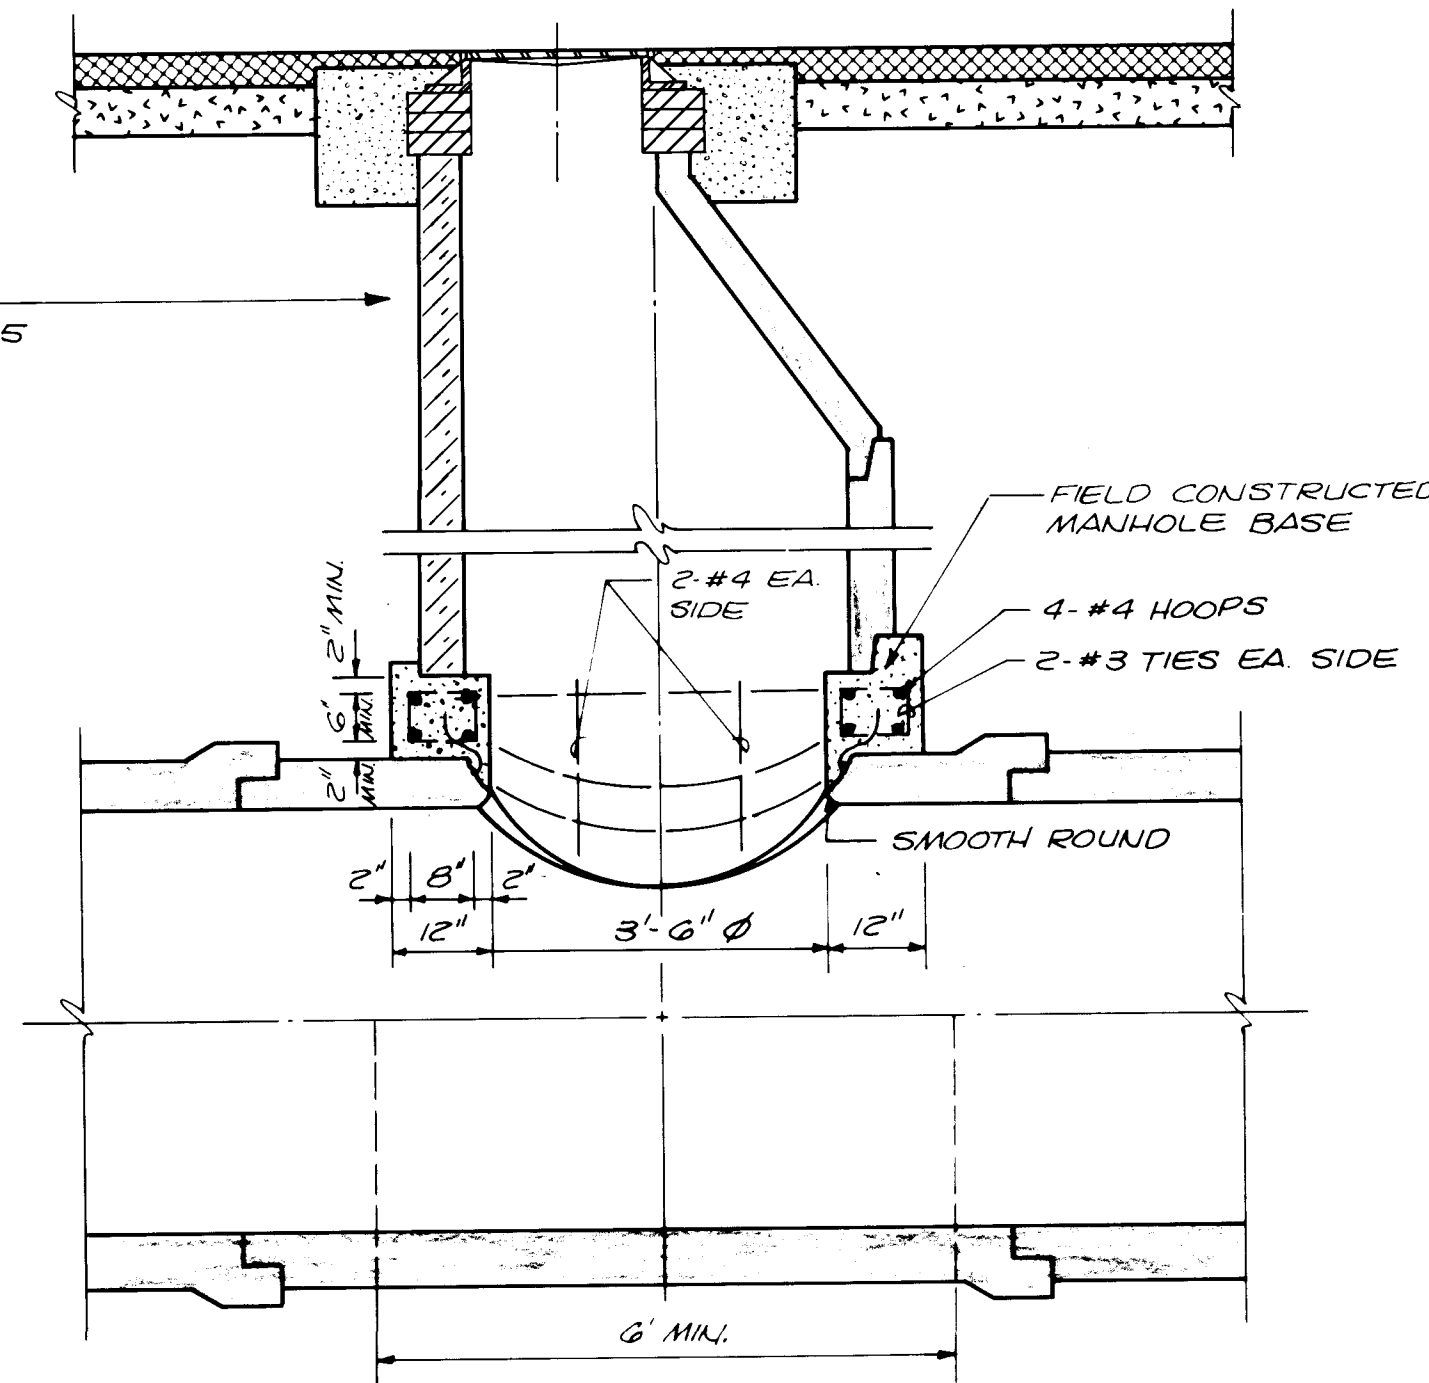

3 SECTION

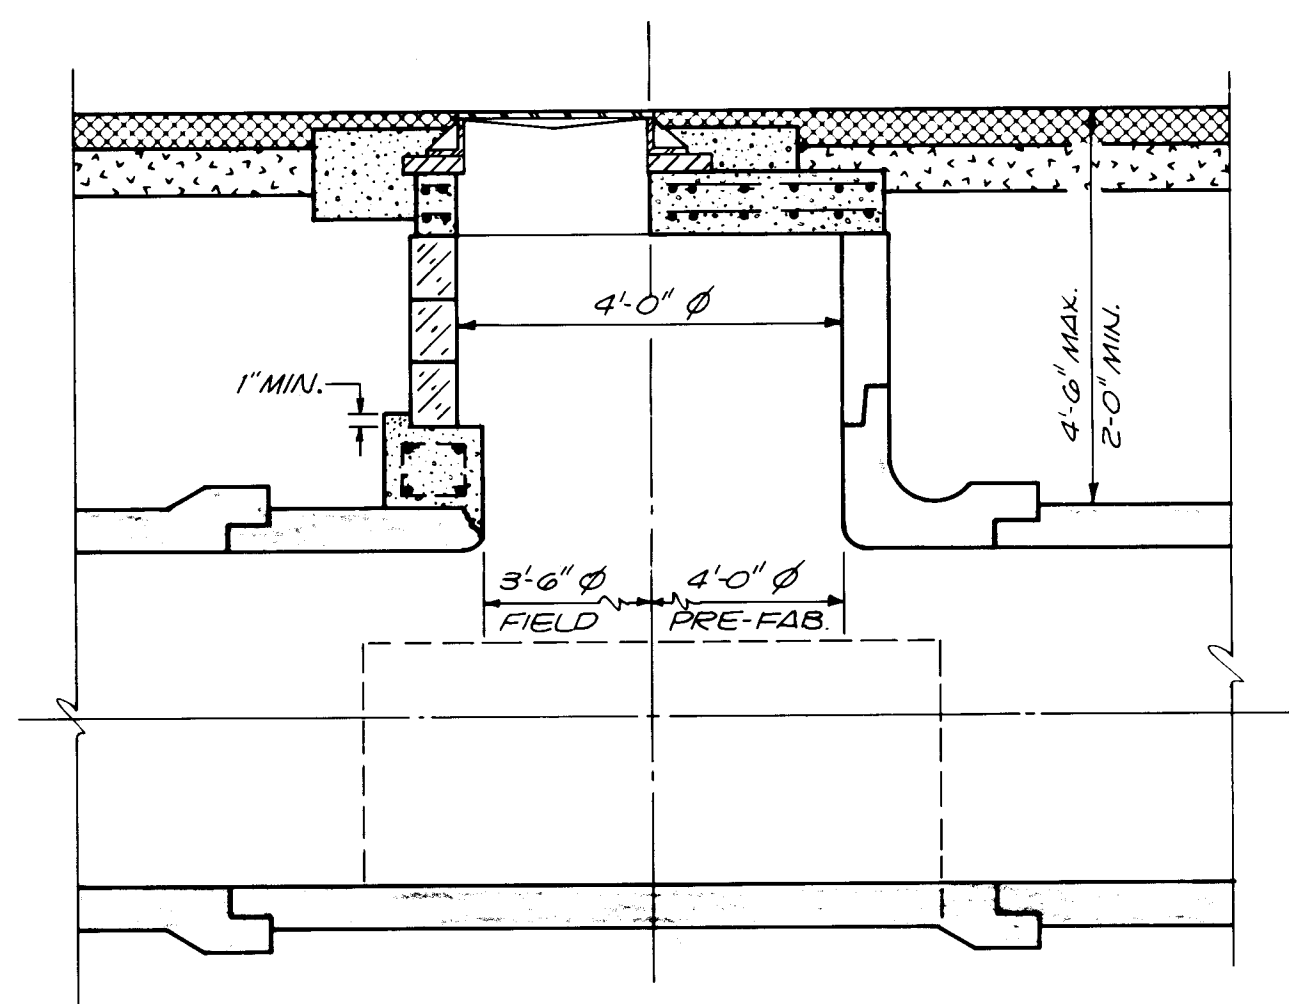


5 SECTION

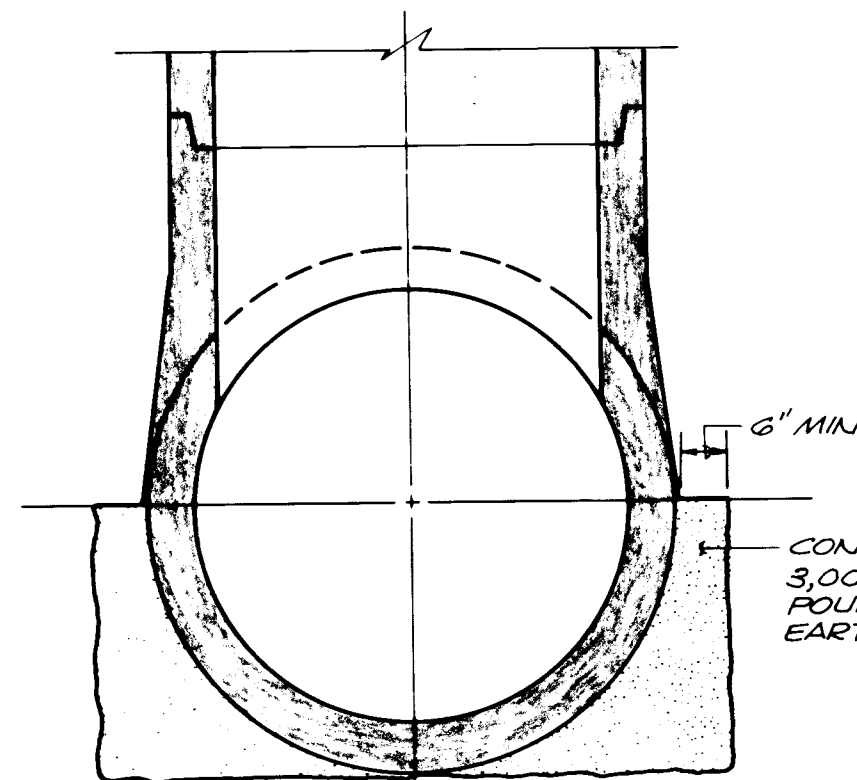

2 SECTION


These record drawings have been prepared; on the basis of information compiled and furnished by the city engineers office. The consulting engineer will not be responsible for any errors or omissions which have been incorporated into this document as a result.

RECORD DRAWING		
DATE: 2-24-84	BY: M-C	FROM: CITY OF MARK-UPS

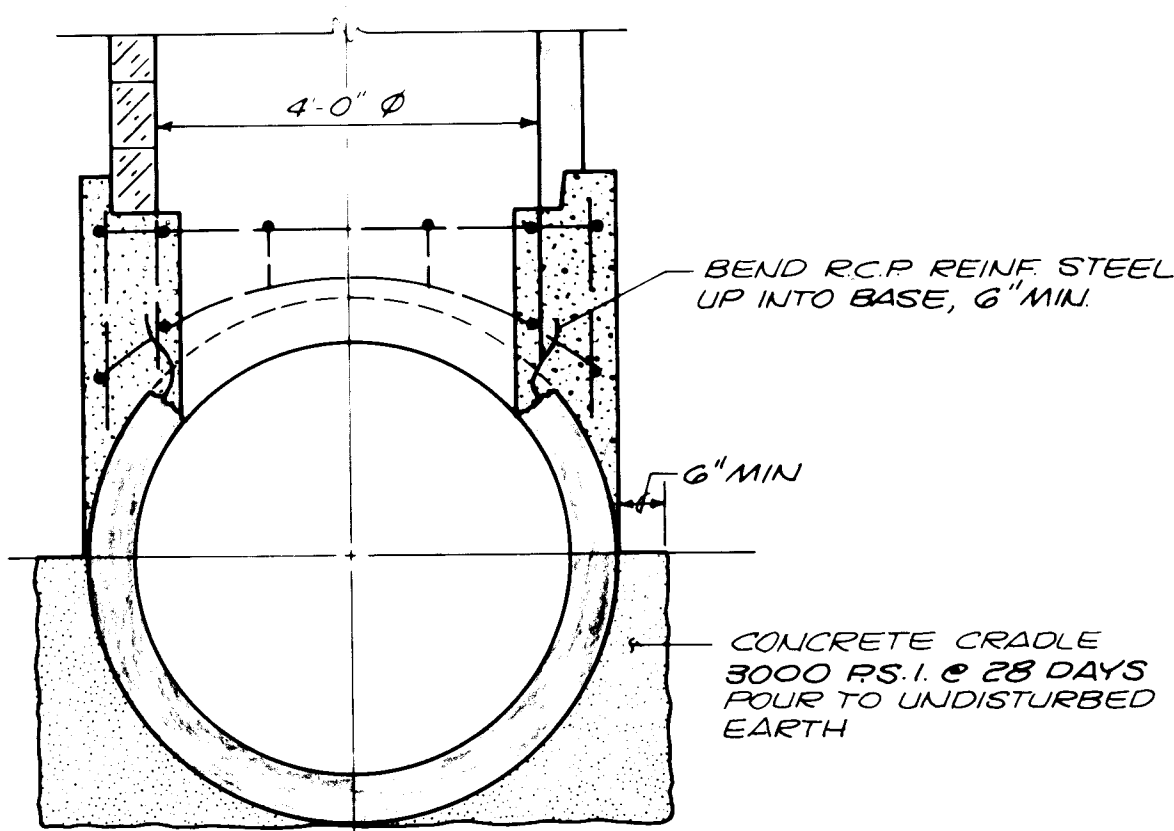

4 SECTION

1	2	3	4	5	6	7	8	9	10	11	12
2	6		1	4	3	7	3	7	8	7	

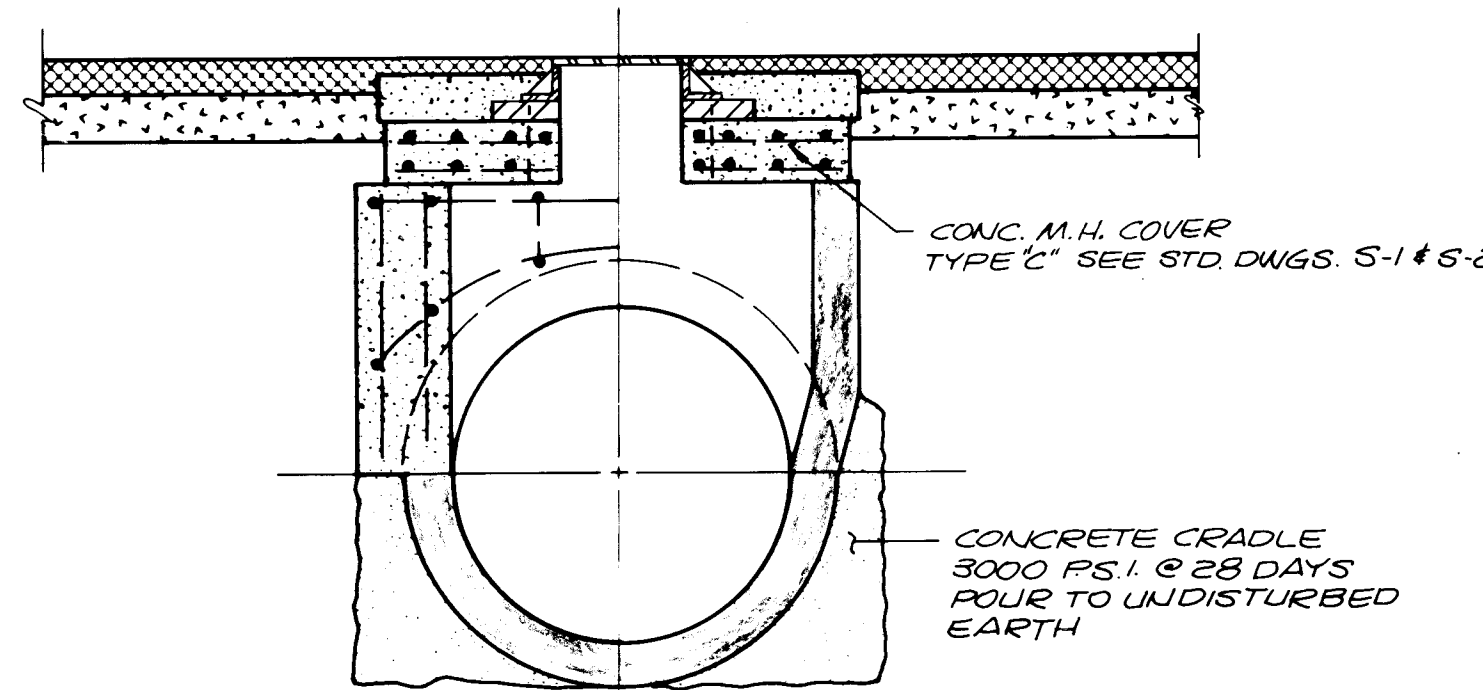

6 SECTION

CITY OF ALBUQUERQUE
TRANSPORTATION DEPARTMENT
TITLE: WYOMING BLVD. N.E. WIDENING R.C.P. SEWER MANHOLE BASES FOR MAINS 42" Ø & LARGER





APPROVALS	ENGINEER	DATE	APPROVALS	ENGINEER	DATE
City Engineer			Liquid Waste		
A.C.E - Design			Traffic		
A.C.E -Hydrology			Water		

DRAWING NO. 1637

MAP NO.	F-1942
---------	--------

SHEET 37 OF 38

ENGINEER'S SEAL				SURVEY INFORMATION		BENCH MARKS		AS BUILT INFORMATION	
				NO.	BY	DATE			
				ALBUQUERQUE SURVEY CO.		5-67			
				REMARKS		DATE	DESIGNED BY	DATE	RECORDED BY
NO. DATE				AFF. DESIGN		MICRO-FILM INFORMATION			
DRAWN BY GA				DATE 12-62		RECORDED BY		NO.	

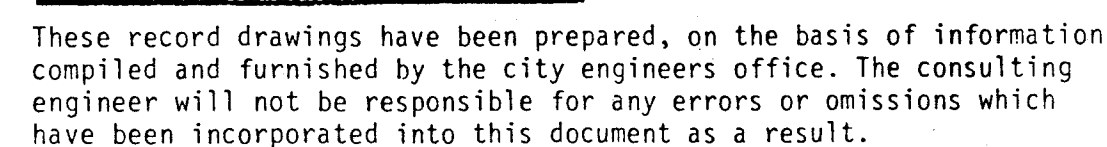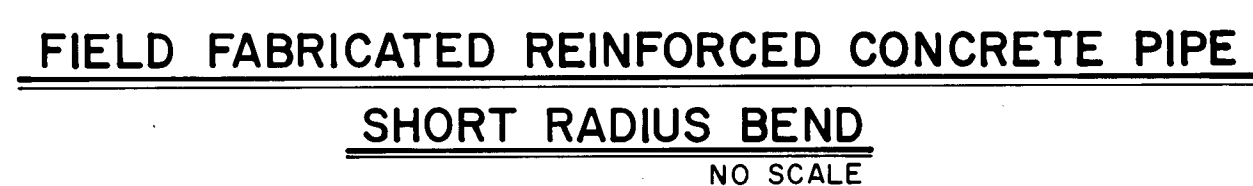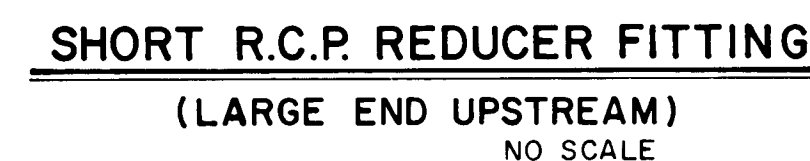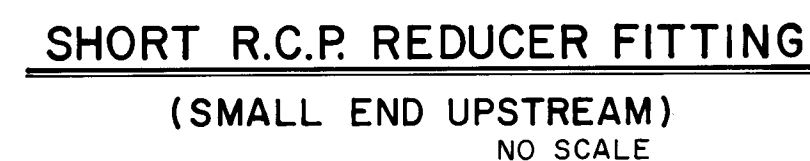

1	2	3	4	5	6	7	8	9	10	11	12
2	6		1	6	3	7	3	8	8	7	

MOLZEN - CORBIN & ASSOCIATES
CONSULTING ENGINEERS
ALBUQUERQUE, CARLSBAD - NEW MEXICO

CITY OF ALBUQUERQUE
TRANSPORTATION DEPARTMENT

TITLE: WYOMING BLVD. N.E. WIDENING

R.C.P. SPECIAL SECTION DETAILS

APPROVALS	ENGINEER	DATE	APPROVALS	ENGINEER	DATE
City Engineer			Liquid Waste		
A C E - Design			Traffic		
A C E -Hydrology			Water		

5		
6	DRAWING NO. 1637	

MAP NO.	F-19 & 20
---------	-----------

SHEET 38 OF 38

SURVEY INFORMATION		BENCH MARKS	AS BUILT INFORMATION
NO.	FIELD NOTES		
	BY ALBUQU SURVEY CO DATE 5-21		CONTRACTOR MOBY STAKED BY INSPECTORS DISTANCE BY FIELD VERIFICATION BY DATE CORRECTED BY DATE MICRO-FILM INFORMATION RECORDED BY DATE NO

Professional Engineer - Building and Land Surveyor
 No. 1324
 State of New York
 Registered Professional Engineer - Building and Land Surveyor
 ALBERT D. WRIGHT

[illegible]

SUMMARY OF QUANTITIES (CONTINUED)

STORM DRAINAGE IMPROVEMENTS			
BID ITEM NO.	DESCRIPTION	ESTIMATED QUANTITY	FINAL QUANTITY
101	4" DI PIPE FOR SERVICES, RISERS, AND DEAD END MH SERVICE STUDS, IN PLACE, INCLUDING TRENCHING, BACKFILL, AND COMPACTION, PER LF	220	47
102	4" CI DOUBLE CLEANOUT FOR SERVICES, RISERS, AND BRONZE SCREW IN COVERS, IN PLACE, INCLUDING TRENCHING, BACKFILL AND COMPACTION, PER EACH	4	0
103	8" EXTRA STRENGTH VCP, COMPLETE IN PLACE, IN TRENCH, PER LF	135	135
105	TRENCHING, BACKFILLING, AND COMPACTION FOR 6" TO 15" PIPE, 6'-8' TRENCH DEPTH, PER LF	55	47
106	TRENCHING, BACKFILLING, AND COMPACTION FOR 6" TO 15" PIPE, 8'-10' TRENCH DEPTH, PER LF	40	49
107	TRENCHING, BACKFILLING, AND COMPACTION FOR 6" TO 15" PIPE, 10'-14' TRENCH DEPTH, PER LF	40	39
109	TRENCHING, BACKFILLING, AND COMPACTION FOR 18" TO 36" PIPE, LESS THAN 8' TRENCH DEPTH, PER LF	390	696
110	TRENCHING, BACKFILLING, AND COMPACTION FOR 18" TO 36" PIPE, 8' TO 14' TRENCH DEPTH, PER LF	197	194.5
111	TRENCHING, BACKFILLING, AND COMPACTION FOR 18" TO 36" PIPE, 14' TO 20' TRENCH DEPTH, PER LF	47	40.5
113	4' DIA. TYPE "C", "D", OR "E" MH, 6' TO 10' DEPTH, IN PLACE, PER EACH	2	3
114	4' DIA. TYPE "C", "D", OR "E" MH, 10' TO 14' DEPTH, IN PLACE, PER EACH	2	1
115	4' DIA. TYPE "A" MH, LESS THAN 6' DEPTH, PER EACH	6	6
116	4' DIA. TYPE "A" MH, IN PLACE, ADDED COST FOR EACH ADDITIONAL FOOT OVER 6' DEPTH, PER FOOT OF DEPTH	45	40.3
117	EXTRA PAY FOR REMOVAL OF 8" AND UNDER SANITARY SEWER LINES, TRENCHING NOT INCLUDED, PER LF	355	255
118	EXTRA PAY FOR CONNECTING NEW 8" SANITARY SEWER LINE TO EXISTING DROP MANHOLE, COMPLETE INCLUDING FITTINGS AND NECESSARY CUTTING AND PATCHING, PER EACH	2	2
119	PUMPING SEWAGE BETWEEN MH'S BECAUSE OF SANITARY SEWER LINE REPLACEMENT OR REPAIR, PER HOUR OF PUMP OPERATION	72	16
120	4" CORE DRILLED TAP ON 8" THRU 15" VCP OR CONC. PIPE, INCLUDING NECESSARY FITTINGS, PER EACH	4	4
201	18" RCP, CLASS III, COMPLETE IN PLACE, IN TRENCH, PER LF	284	355
202	21" RCP, CLASS III, COMPLETE IN PLACE, IN TRENCH, PER LF	207	207
203	24" RCP, CLASS III, COMPLETE IN PLACE, IN TRENCH, PER LF	168	168
205	30" RCP, CLASS III, COMPLETE IN PLACE, IN TRENCH, PER LF	24	24

STORM DRAINAGE IMPROVEMENTS (CONT.)			
BID ITEM NO.	DESCRIPTION	ESTIMATED QUANTITY	FINAL QUANTITY
206	36" RCP, CLASS III, COMPLETE IN PLACE, IN TRENCH, PER LF	98	98
207	42" RCP, CLASS III, COMPLETE IN PLACE, IN TRENCH, PER LF	36	36
208	48" RCP, CLASS III, COMPLETE IN PLACE, IN TRENCH, PER LF	22	22
209	54" RCP, CLASS III, COMPLETE IN PLACE, IN TRENCH, PER LF	1698	1684
210	BEVELED OR RADIUS PIPE, 30" RCP, CLASS III COMPLETE IN PLACE, IN TRENCH, PER LF	79	79
211	BEVELED OR RADIUS PIPE, 54" RCP, CLASS III COMPLETE IN PLACE, IN TRENCH, PER LF	158	158
213	PRECAST CONCRETE PLUG FOR 36" RCP, COMPLETE IN PLACE, PER EACH	1	1
214	BEND IN 48" RCP, ANY DEGREE OF BEND, PER EACH	2	2
215	BEND IN 54" RCP, ANY DEGREE OF BEND, PER EACH	1	1
216	24" X 18" RCP WYE, 45°, CLASS III PER EACH	1	1
217	24" X 21" RCP WYE, 45°, CLASS III PER EACH	1	1
218	36" X 21" RCP WYE, 45°, CLASS III PER EACH	2	2
219	42" X 21" RCP WYE, 45°, CLASS III PER EACH	2	2
220	54" X 24" RCP WYE, 45°, CLASS III PER EACH	1	1
221	54" X 27" RCP WYE, 30°, CLASS III, PER EACH	1	1
222	54" X 30" RCP WYE, 45°, CLASS III PER EACH	1	1
223	54" X 18" RCP TEE, CLASS III PER EACH	3	3
224	42" X 36" RCP REDUCER, PER EACH	1	1
225	48" X 42" RCP REDUCER, PER EACH	1	1
226	54" X 48" RCP REDUCER, PER EACH	1	1
227	TYPE "A" CATCH BASIN, SINGLE GRATE, COMPLETE IN PLACE, PER EACH	5	5
228	TYPE "A" CATCH BASIN, SINGLE GRATE WITH DUAL APPROACH, COMPLETE IN PLACE, PER EACH	1	1
229	TYPE "A" CATCH BASIN, DOUBLE GRATE, COMPLETE IN PLACE, PER EACH	7	7
230	TYPE "B" CATCH BASIN, DOUBLE GRATE, COMPLETE IN PLACE, PER EACH	2	2
231	TYPE "C" CATCH BASIN, SINGLE GRATE, COMPLETE IN PLACE, PER EACH	1	1
233	TRENCHING, BACKFILLING, AND COMPACTION FOR 42" AND OVER PIPE, LESS THAN 8' TRENCH DEPTH, PER LF	58	58
234	TRENCHING, BACKFILLING, AND COMPACTION FOR 42" AND OVER PIPE, 8' TO 14' TRENCH DEPTH, PER LF	684	843
235	TRENCHING, BACKFILLING, AND COMPACTION FOR 42" AND OVER PIPE, 14' TO 20' TRENCH DEPTH, PER LF	1,159	999
236	REMOVE AND REPLACE EXIST. SIDEWALK DRAIN ON WYOMING BLVD. AT BEAR CANYON, COMPLETE AS SHOWN ON DRAWINGS, PER EACH	1	1
237	CONNECT NEW 54" RCP TO EXIST. CBC ON WYOMING BLVD. AT BEAR CANYON, COMPLETE AS SHOWN ON DRAWINGS, PER EACH	1	1

STORM DRAINAGE IMPROVEMENTS (CONT.)			
BID ITEM NO.	DESCRIPTION	ESTIMATED QUANTITY	FINAL QUANTITY
302	REMOVE AND RELAY EXISTING 2-1/4" THRU 14" PIPE, PER LF	200	0
306	NON-PRESSURIZED CONNECTION TO EXISTING WATER LINES, PER EACH	3	0
307	INSERTION ONLY (COST OF FITTINGS NOT INCLUDED) OF CI MJ FITTINGS INTO EXISTING WATER MAINS 4" THRU 8", PER LB	200	45
308	REMOVE AND RELAY EXISTING CI FITTINGS 2-1/4" THRU 36", PER LB	140	0
309	CI FITTINGS, MJ, 4" THRU 14", CLASS 250, WITH ALL JOINTING MATERIAL, IN PLACE, PER LB	700	320
311	6" GATE VALVES, COMPLETE IN PLACE, PER EACH	1	1
314	REMOVE AND RELAY EXISTING 2-1/4" THRU 12" GATE VALVES, PER EACH	1	0
315	REMOVE AND RETURN EXISTING VALVES, 4"-10", PER EACH	1	0
316	VALVE BOXES, IN PLACE, TYPE A, PER EACH	3	1
317	REMOVE AND RETURN VALVE BOX ONLY, PER EACH	2	0
324	BLOCKING FOR WATER PIPE, PORTLAND CEMENT PLAIN CONCRETE, IN PLACE PER CY	5	1.5
401	GRADING FOR LESS THAN 2' EXCAVATION, PER SY	3,100	2870
403	CUTTING, REMOVAL, AND DISPOSAL OF EXISTING ASPHALTIC CONC. PAVING, WHERE SAWCUTTING IS REQUIRED, PER SY	3,100	2870
406	REMOVAL AND DISPOSAL OF EXISTING PORTLAND CEMENT CONC. CURB & GUTTER, PER LF	550	350
407	CUTTING, REMOVAL, AND DISPOSAL OF EXISTING SIDE-WALK AND DRIVEPADS, PER SY	200	200
408	PROCESS AND COMPACT EXISTING MATERIAL THAT HAS A SOIL BEARING VALUE OF 20 OR MORE, 4" THICK, COMPLETE IN PLACE, PER SY	500	502
409	PROCESS AND COMPACT EXISTING MATERIAL THAT HAS A SOIL BEARING VALUE OF 20 OR MORE, 6" THICK, COMPLETE IN PLACE, PER SY	2,600	2,368
410	CEMENT TREATED BASE COURSE, 6" THICK, CENTRAL PLANT MIXED, COMPLETE IN PLACE, PER SY	2,600	2,368
411	ASPHALTIC CONC. BASE COURSE, 2-1/2" THICK, 1500 LB. STABILITY, MACHINE LAYDOWN, PER SY	3,100	2,870
412	EMULSIFIED ASPHALT TACK COAT, COMPLETE IN PLACE, PER SY	3,100	2870
413	ASPHALTIC CONC. SURFACE COURSE, 1-1/2" THICK, 1500 LB. STABILITY, MACHINE LAYDOWN, PER SY	500	502
414	ASPHALTIC CONC. SURFACE COURSE, 1-1/2" THICK, 1800 LB. STABILITY, MACHINE LAYDOWN, PER SY	2,600	2,368
416	PORTLAND CEMENT CONC. SIDEWALK, 4" THICK, COMPLETE IN PLACE, PER SF	1,600	1629
419	PORTLAND CEMENT CONC. STANDARD CURB & GUTTER, COMPLETE IN PLACE, INCLUDING SUBGRADE PREP., PER LF	500	126
424	REMOVAL AND DISPOSAL OF EXISTING TRAFFIC SIGNAL FOUNDATION, ANY TYPE, PER CY	1	1
426	TRAFFIC SIGNAL FOUNDATION FOR PEDESTAL (SP) TYPE I, COMPLETE IN PLACE, PER EACH	1	1
429	TRAFFIC SIGNAL ELECTRICAL CONDUIT, 2" RIGID, COMPLETE IN PLACE, INCLUDING CONNECTIONS TO EXISTING CONDUIT, IF REQUIRED, PER LF	50	50
432	MAINTAIN TRAFFIC, COMPLETE AS SHOWN IN TRAFFIC CONTROL PLAN, L.S.	1	1
501	ARTERIAL PAVING REMOVAL AND REPLACEMENT AS PER STANDARD DETAIL DWG. P-25, WITHOUT MACHINE LAY-DOWN, WHERE EXISTING SUBBASE MATERIAL CAN BE PROCESSED AND COMPACTED, IN PLACE, PER SY	200	178

MOLZEN-CORBIN & ASSOCIATES
CONSULTING ENGINEERS
ALBUQUERQUE, CARLSBAD - NEW MEXICO

APPROVED FOR
CONSTRUCTION

CITY ENGINEER DATE

RECORD DRAWING		
DATE: 2-21-84	BY: M-C	FROM: CITY MARK-UPS

These record drawings have been prepared, on the basis of information compiled and furnished by the city engineers office. The consulting engineer will not be responsible for any errors or omissions which have been incorporated into this document as a result.

1	2	3	4	5	6	7	8	9	10	11	12
C	G	1	6	3	7	0	5	8	7	A	

CITY OF ALBUQUERQUE					
TRANSPORTATION DEPARTMENT					
TITLE: WYOMING BLVD. N.E. WIDENING					
SUMMARY OF QUANTITIES					
APPROVALS	ENGINEER	DATE	APPROVALS	ENGINEER	DATE
City Engineer			Liquid Waste		
A.C.E.-Design			Traffic		
A.C.E.-Hydrology			Water		
DRAWING NO.	1637	MAP NO.	F-19420	SHEET	OF 3A 38

AS BUILT INFORMATION		CONTRACTOR		WORK ORDER BY		INSPECTOR'S		DATE	
BENCH MARKS		ACCEPTANCE BY		DATE		REVISIONS		BY	
SURVEY INFORMATION		FIELD NOTES		DATE		REVISIONS		BY	
ENGINEER'S SEAL		NO.		DATE		REVISIONS		BY	
MICRO-FILM INFORMATION		RECORDED BY		DATE		DESIGN		DATE	

