


CITY OF ALBUQUERQUE, NEW MEXICO

MUNICIPAL DEVELOPMENT DEPARTMENT

SPECIAL ASSESSMENT DISTRICT NO. 214


UNSER BOULEVARD

FROM CENTRAL AVENUE TO LADERA DRIVE N.W.

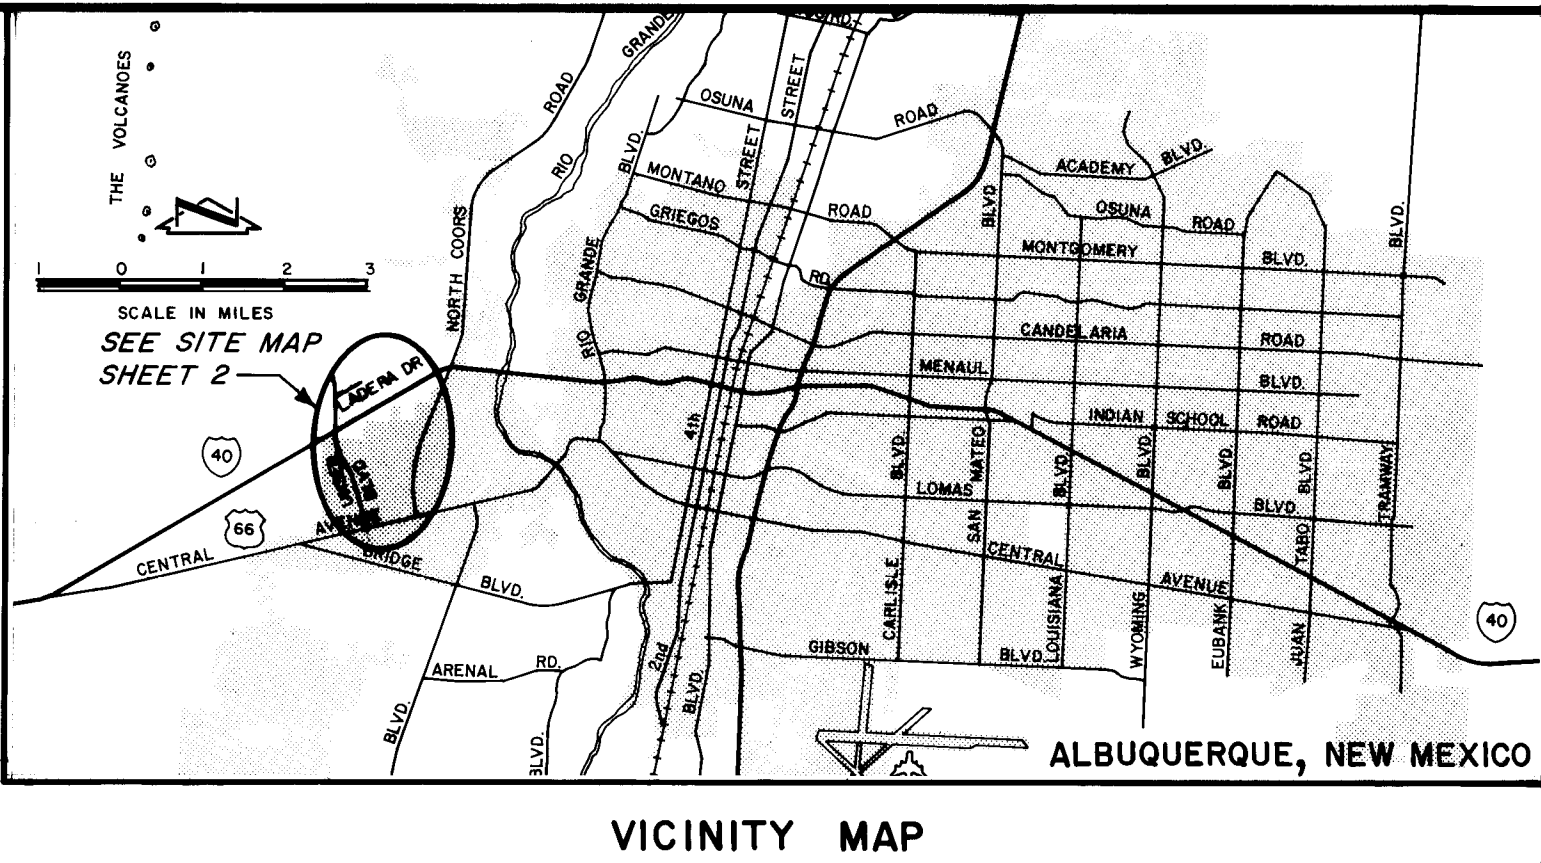


INDEX

SHEET NO.	DESCRIPTION
1	Cover Sheet
2	Legend, Site Map
3	Typical Sections and General Notes
4 - 7	Paving - Sta. 0+00 to Sta. 39+49.35
8	Paving - Sta. 78+50 to Sta. 87+62.21
9 - 12	Water & Sewer - Sta. 0+00 to Sta. 39+49.35
13 - 15	Storm Drain - Sta. 11+50 to Sta. 39+49.35
16	Channel & Temporary Retention Pond
17 - 18	Temporary Retention Pond Details
19	1'x3' Concrete Box Culvert
20	Traffic Control Plan
21	Traffic Control Notes
22	Pullbox Locations & Island Wheel Chair Ramp Details
23	Paving Details - Bluewater/Unser

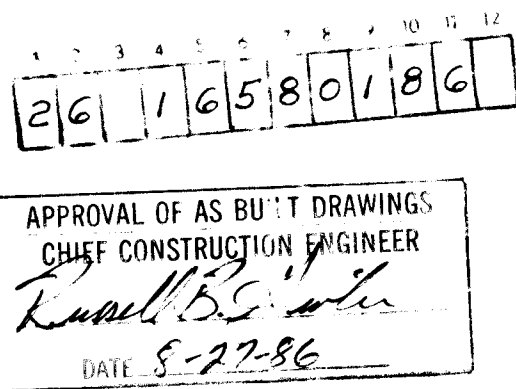

REV	SHEETS	CITY	ENGR.	DATE	USER	DEPT.	DATE	USER	DEPT.	DATE
APPROVAL OF REVISIONS										
PLANS PREPARED UNDER THE DIRECTION OF						SCANLON & ASSOCIATES		APPROVED FOR CONSTRUCTION		
RECORD DRAWING						DRAWING NO. 1658		SHEET 1 OF 23		

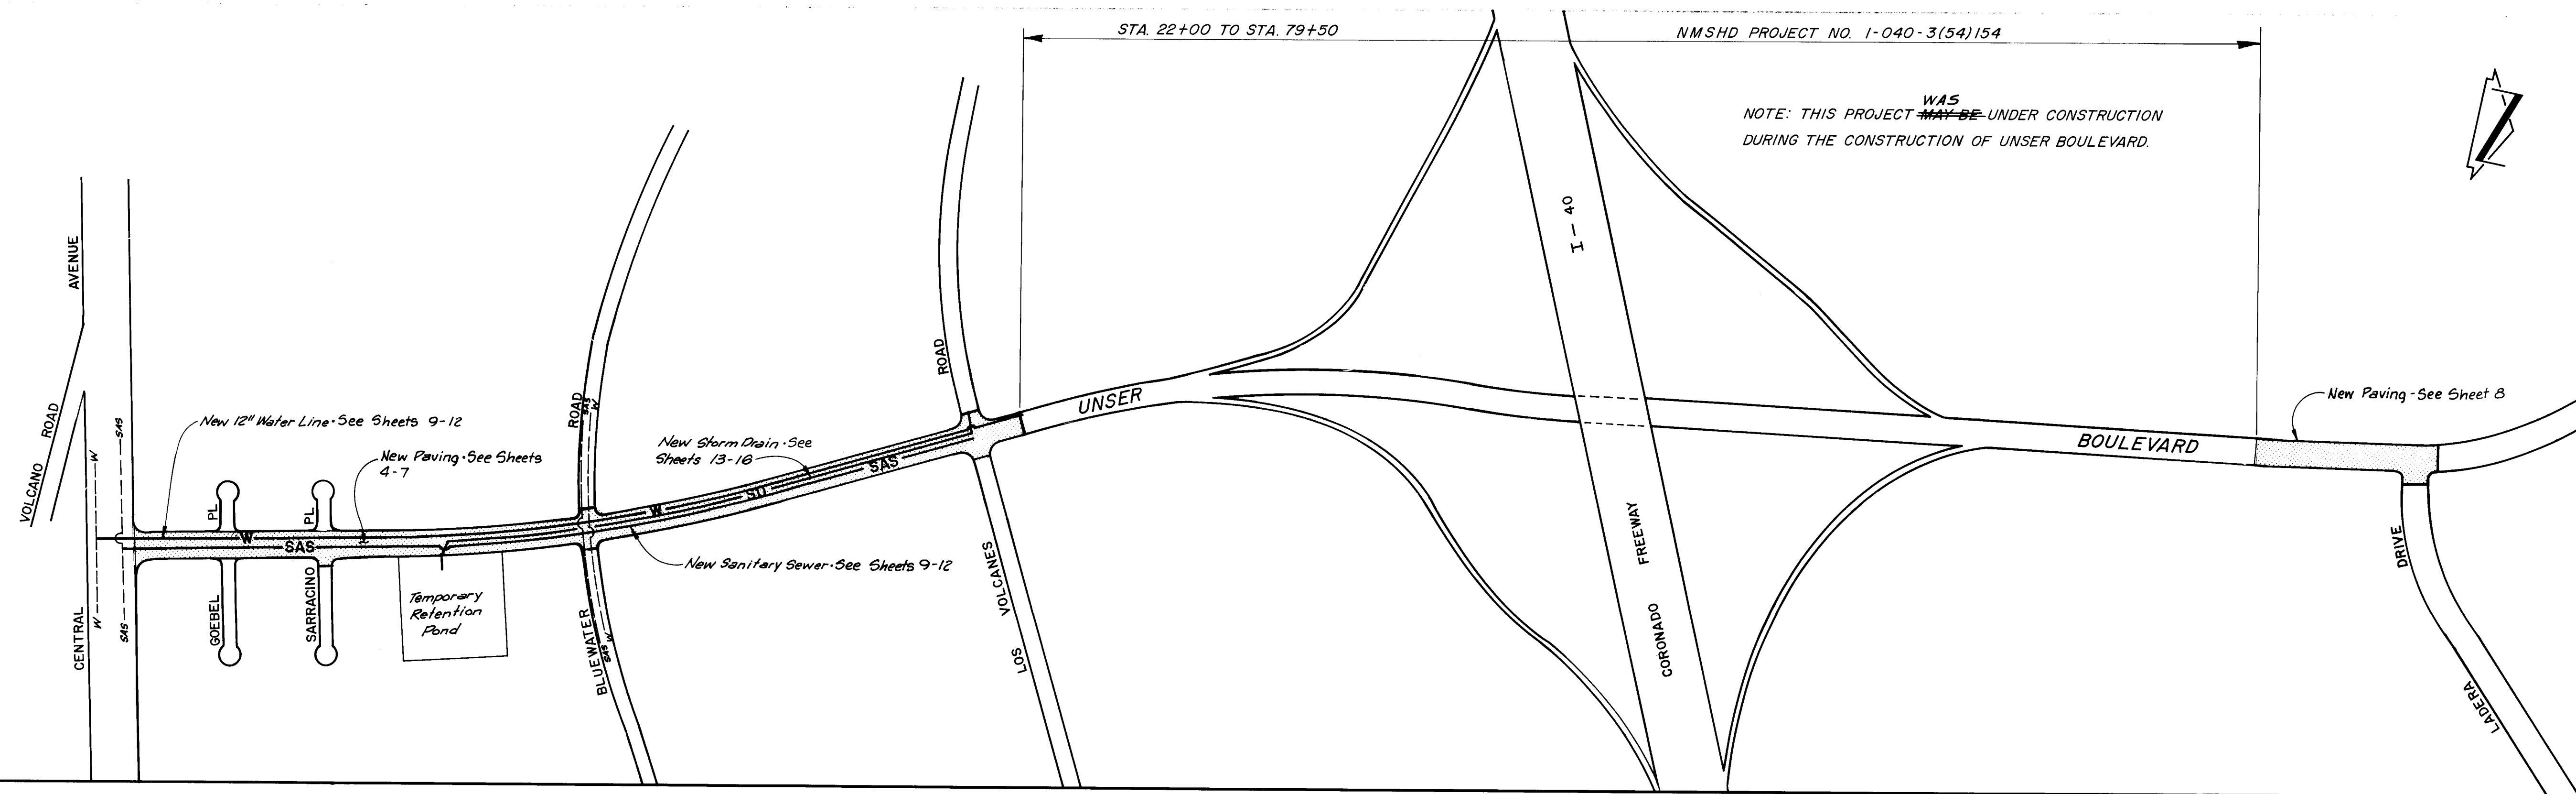



LEGEND

- C — NEW TRAFFIC SIGNAL CONDUIT
- W — NEW SIGNAL FOUNDATION MASTARM (MA) OR PEDESTAL (SP)
- G — EXISTING CURB AND GUTTER
- S — NEW CURB AND GUTTER
- M — NEW ASPHALT MEDIAN CURB
- S — NEW SIDEWALK
- R — NEW WHEEL CHAIR RAMP
- S — SURVEY AND CONSTRUCTION
- R — RIGHT-OF-WAY LINE
- S — EXISTING SIGN
- F — EXISTING FENCE
- L — NEW PAVING LIMITS
- P — CONTROL POINT, P.I.
- Y — EXISTING FIRE HYDRANT
- B — EXISTING TELEPHONE BOX
- V — EXISTING WATER VALVE
- M — EXISTING WATER METER
- P — EXISTING POWER POLE
- S — EXISTING SANITARY SEWER LINE
- G — EXISTING GAS LINE
- W — EXISTING WATER LINE
- P — EXISTING POWER LINE
- C — EXISTING CULVERT
- S — NEW SANITARY SEWER LINE
- W — NEW WATER LINE
- SD — NEW STORM DRAIN LINE
- S — NEW SANITARY SEWER MANHOLE
- S — NEW STORM DRAIN MANHOLE
- S — EXISTING WATER LINE MANHOLE
- S — EXISTING STORM DRAIN MANHOLE
- S — EXISTING SANITARY SEWER LINE MANHOLE
- S — NEW DROP INLET
- S — NEW SPOT ELEVATION
- S — NEW DRIVEPAD

SITE MAP

SCALE: 1" = 400'

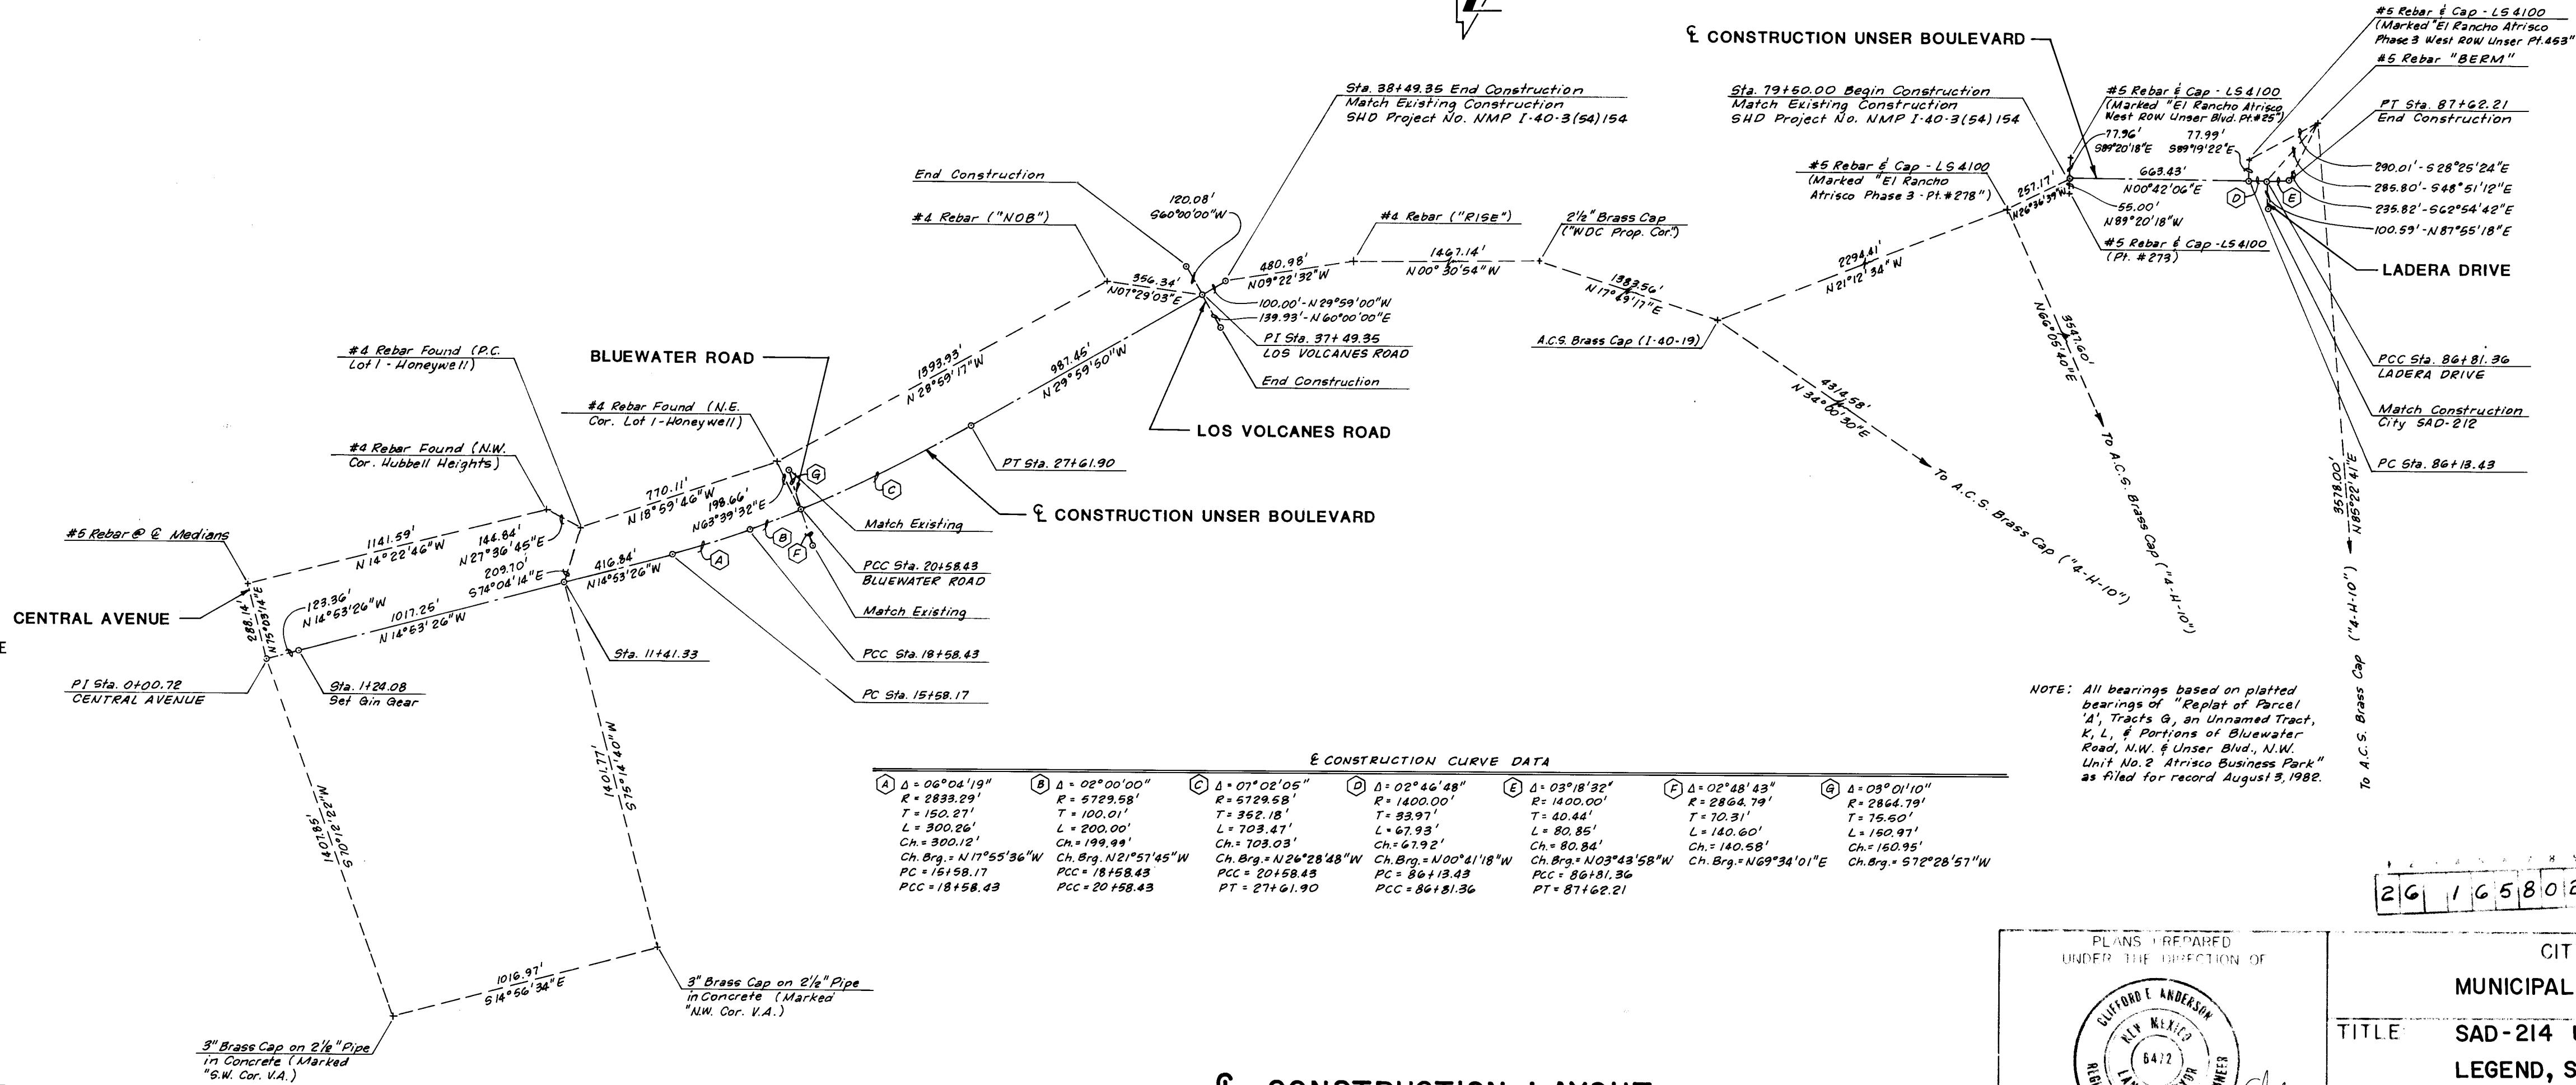

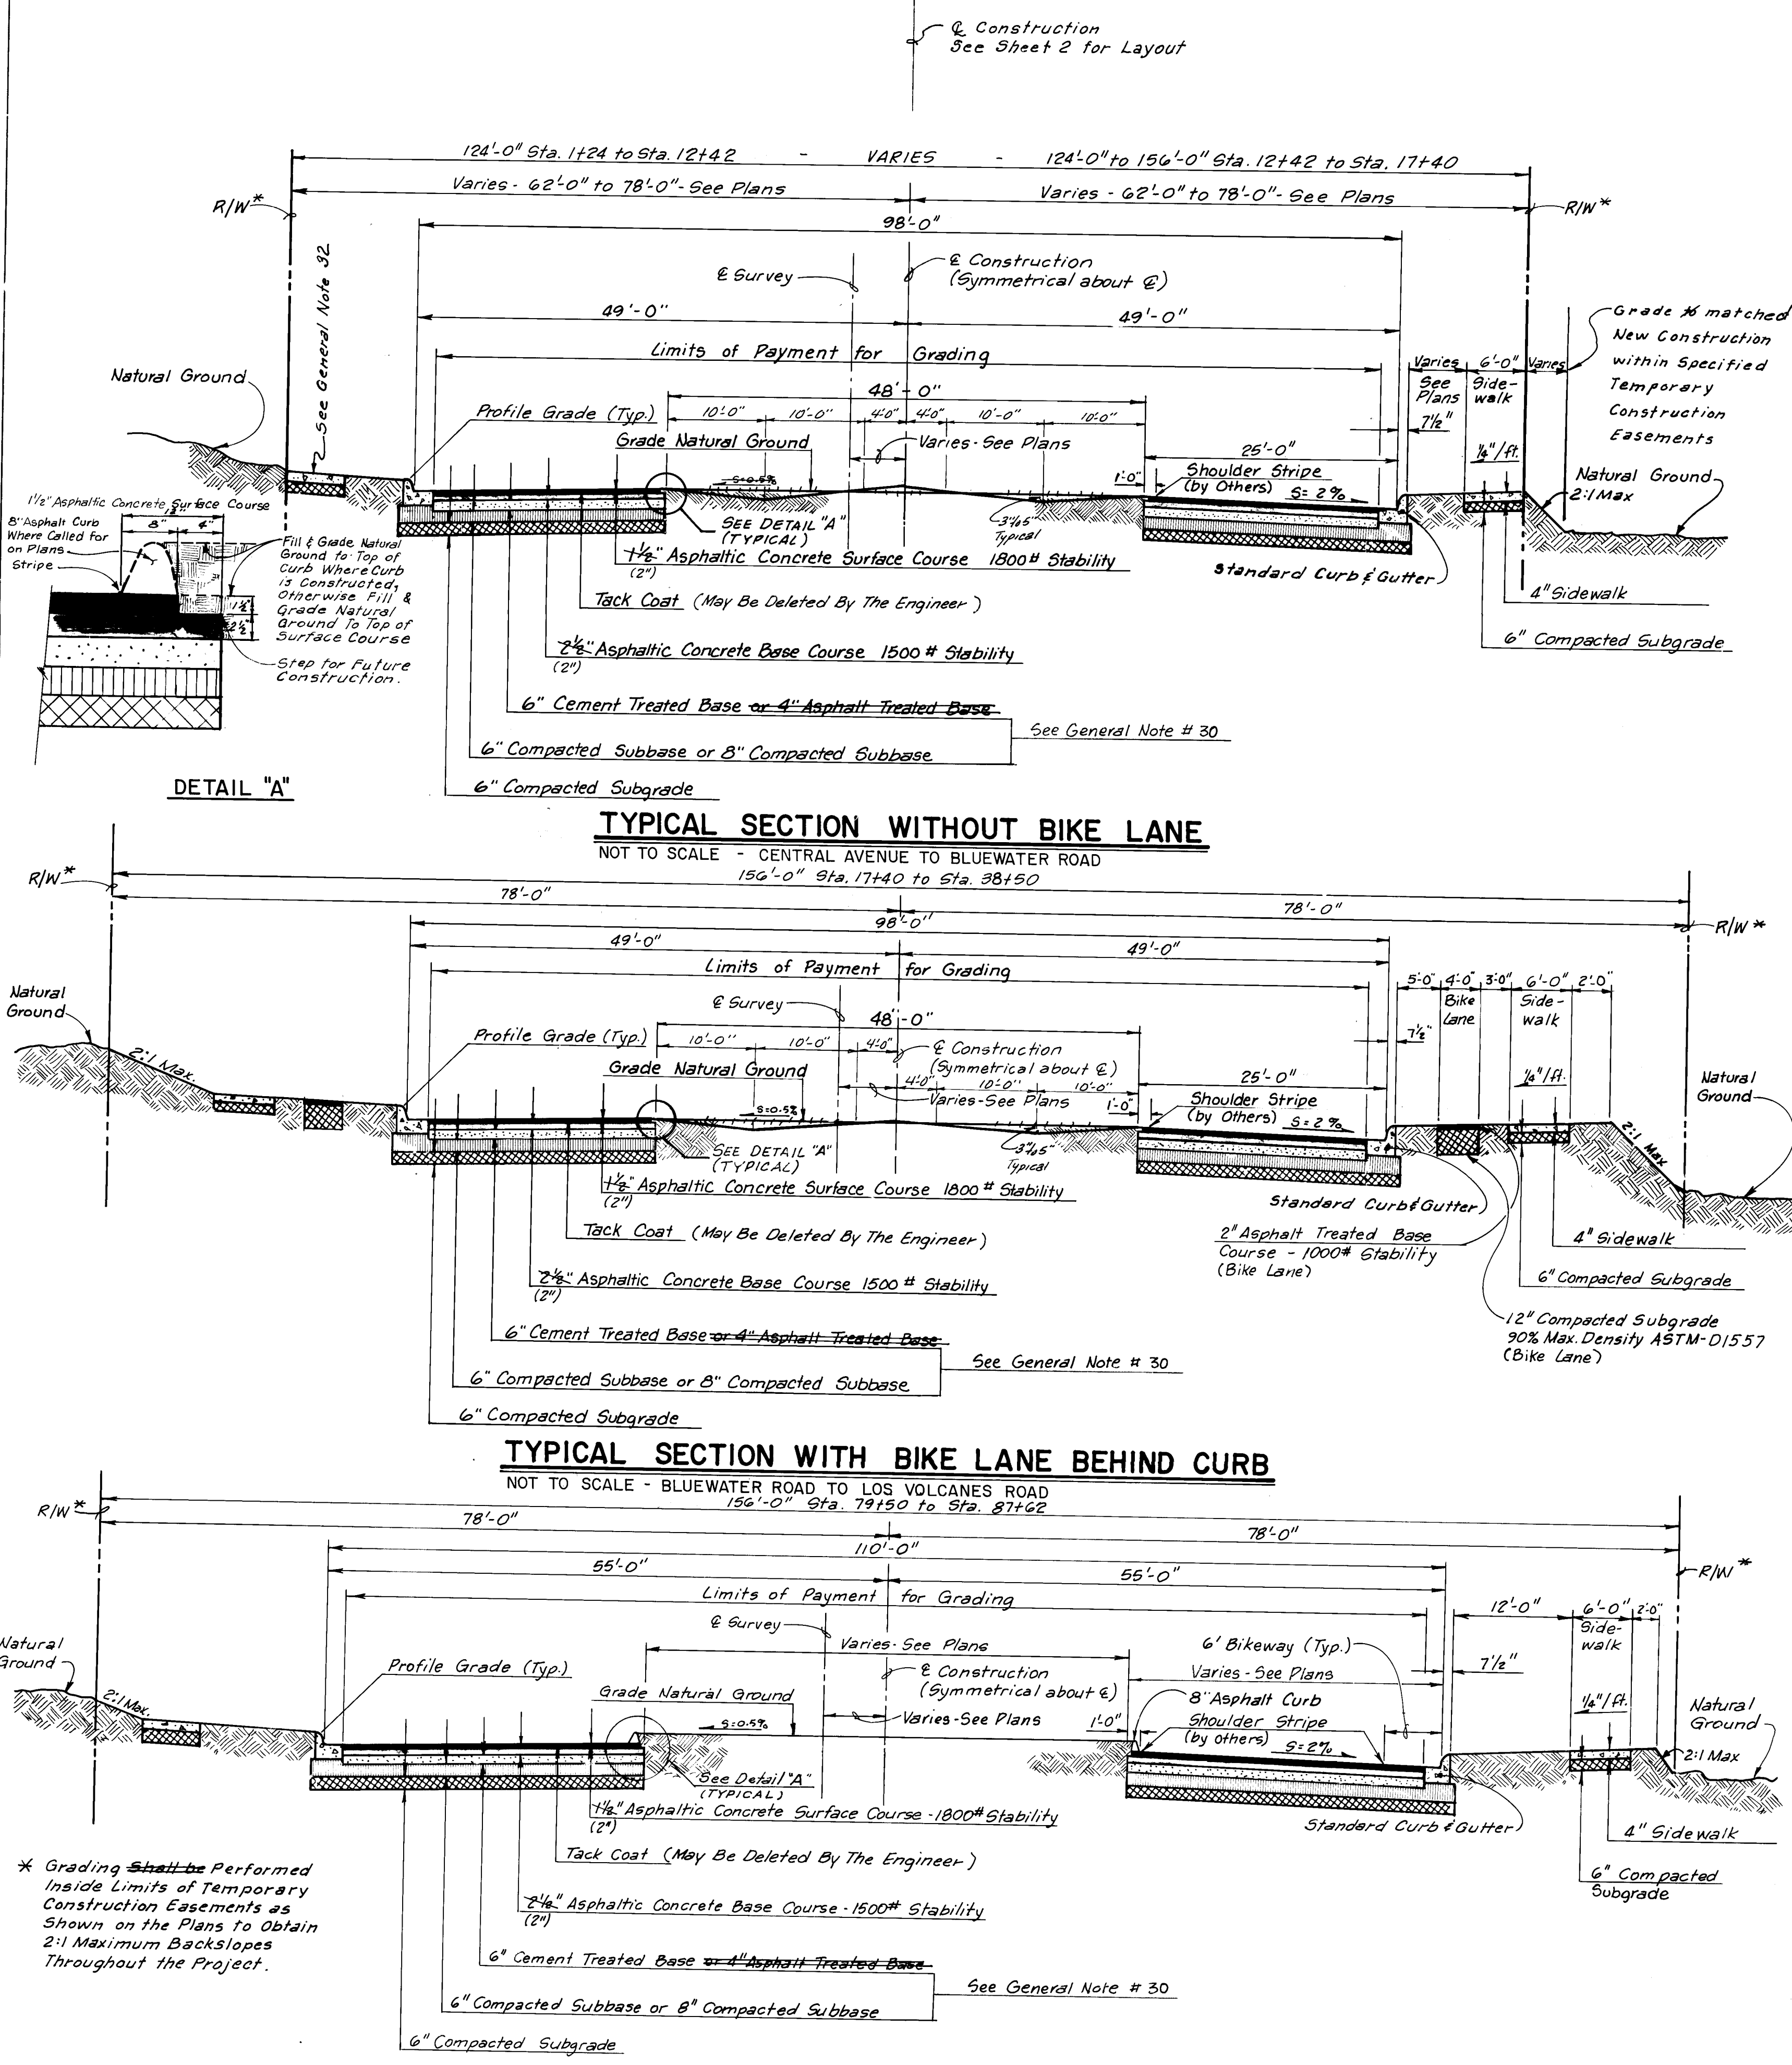

GENERAL NOTES


- 1. New Mexico Standard Specifications for Public Works Construction 1979 Edition, and any revisions and additions in the Supplemental Specifications in the Contract Documents, shall govern the construction of this project.
- 2. The Contractor shall notify all utility companies when working near their systems. Two days prior to any excavation, Contractor must contact Line Locating Service, 765-1234, for location of existing utilities.
- 3. Prior to construction, the Contractor shall excavate and verify the horizontal and vertical locations of all obstructions. Should a conflict exist, the Contractor shall notify the Engineer so that the conflict can be resolved with minimum amount of delay.
- 4. All existing utilities shown here were taken as accurately as possible from record drawings and surface indications. It shall be the Contractor's responsibility to protect, maintain in service, and verify exact locations of all affected utilities during construction of this project.
- 5. All utilities which are to be abandoned under this contract shall be plugged with concrete at each end of the portion to be abandoned. The cost of this work shall be considered incidental to other items of work.
- 6. Curb return radii and street widths are to the face of the curb unless otherwise indicated in the plans.
- 7. Where removal of existing curb and gutter or sidewalk is required, removal shall be to the nearest joint or saw cut.
- 8. When matching new paving to existing pavement, the Contractor shall saw cut the existing paving on a right angle, or as directed by the Engineer to remove any broken, raveled, or cracked paving. The cost of this work shall be considered incidental to other items of work.
- 9. Curb and gutter shown as existing and not to be removed under this contract which is damaged or displaced by the Contractor or his sub-contractors, shall be replaced by the Contractor at his expense.
- 10. Existing materials to be removed and paid for on a unit basis shall be measured and the quantities approved by the Engineer before removal.
- 11. Connection of new sewer lines to existing manholes and plugging of existing lines in manholes shall be incidental to other items of work.
- 12. New water lines shall have a minimum cover of 36" unless otherwise called out in the plans.
- 13. The Contractor shall remove all valve boxes from abandoned water lines and return them to the City Yards. The cost of this work shall be considered incidental to other items of work.
- 14. All abandoned valves and meter box frames and covers shall be returned to the City Water Division warehouse and all storm and sanitary manhole lids and inlet grates, castings, and frames not reused, shall be returned to the Liquid Waste Division warehouse.
- 15. The maximum allowable quantities for payment for replacement of pavement where water, sanitary sewer, and storm sewer are to be installed under existing pavement shall be computed in accordance with section 550.05 of the Supplemental Technical Specifications and Standard Details.
- 16. The Contractor shall expose existing water lines at locations where new sanitary sewer lines cross or parallel such lines in order to adequately establish the proximity of water and sewer lines. The cost of this work shall be incidental to other items of work.
- 17. All water meters, water valve boxes, and sewer manholes in the construction area where street grades change are to be adjusted by the Contractor to finished grade under this contract. The Contractor shall be required to set reference points for locating manholes prior to any grading operation. Measurement and payment for this work shall be included in unit price bid for appropriate items.
- 18. Concrete curb return fillets including curb shall be measured and paid for by the square foot at the unit price bid for concrete valley gutter.
- 19. The Contractor will be responsible to replace at his expense any and all property corners destroyed in the process of construction. All property corners must be set by a Registered Land Surveyor. Records of any such surveys shall be given to the Engineer.
- 20. The Contractor will be required to confine his work within the construction limits and/or right-of-way to preserve existing vegetation and private property.
- 21. Mailboxes within new construction shall be relocated to right-of-way line by the Contractor. The Contractor shall coordinate relocation of mailboxes with property owner or resident. The cost of this work shall be considered incidental to other items of work.
- 22. Utility relocations and new utility installation schedules shall be coordinated at the pre-construction conference.
- 23. Utility relocations and new utility installations required by the construction of this project are to be coordinated by the Contractor during construction. No additional compensation will be allowed for delays or inconveniences caused by utility company work crews. The Contractor may be required to reschedule his activities to allow utility crews to perform their required work.
- 24. Contractor will be responsible for the proper location of driveway sections. Property owners shall be notified that a curb cut permit from City Traffic Engineering is required in order to establish any driveways onto Unser Blvd. Any permit issues will be forwarded by Traffic Engineering to the Engineer. No driveways will be installed without the written approval of the Traffic Division. Approved driveways shall be shown on the "As Constructed" drawings.
- 25. Access to local business and residences shall be kept open at all times. Temporary access closures, if required, must be scheduled at least twenty four (24) hours in advance with property owners and approved by the Engineer.
- 26. A disposal site for all excess excavation material, asphaltic paving, concrete paving, etc. shall be obtained by the Contractor in compliance with applicable regulations and approval of the Engineer. All cost incurred in obtaining a disposal site and haul thereto shall be considered incidental. Suitable material may be disposed of as stipulated in Section 212 of the Supplemental Technical Specifications.
- 27. Fifty ton roller operation shall not be used on this project where underground utilities are present. The required compaction of these locations shall be effected by other types of approved compaction methods.
- 28. All work on this project shall be performed in accordance with applicable Federal, State, and local laws, rules, and regulations concerning construction safety and health.
- 29. All storm drainage facilities shall be completed prior to final acceptance.
- 30. The Contractor has the option of using either 6" Cement Treated Base with 6" Compacted Subbase or 4" Asphalt Treated Base with 8" Compacted Subbase.
- 31. Electronic marker disks shall be installed in all new sewer and water lines and in all existing lines to be replaced in accordance with Section 131 of the Supplemental Technical Specifications.
- 32. Sidewalk from Station 1+00 to Station 1+502 Lt. shall be constructed 3' inside right-of-way line to prevent relocation of existing fence. Back slopes shall match existing ground at fence line. Sidewalk Right Side Location Shown on Existing Survey.

RECORD DRAWING

PLANS PREPARED UNDER THE DIRECTION OF			CITY OF ALBUQUERQUE		
MUNICIPAL DEVELOPMENT DEPARTMENT			TITLE: SAD-214 UNSER BOULEVARD		
TYPICAL SECTIONS AND GENERAL NOTES			APPROVALS		
ENGINEER	DATE	APPROVALS	ENGINEER	DATE	
City Engineer	1/4/84	Liquid Waste	James J. Smith	1/4/84	
A.C.E.-Design	1/4/84	Traffic	James J. Smith	1/4/84	
A.C.E.-Hydrology	1/4/84	Water	James J. Smith	1/4/84	
DESIGNED BY A.D. DRAWN BY L.H. CHECKED BY C.A.			DATE 1/4/84		
APPROVED FOR CONSTRUCTION			DRAWING NO. 1658		
LITY ENGINEER			SHEET 3 OF 23		

PLAN	DATE	BY
SURVEYED		
ALIGNED		
CHECKED		
RT. OF WAY		
NO.		

PROFILE	DATE	BY
SURVEYED		
PLOTTED		
CHECKED		
STRUCTURE		
NOTATIONS		
NO.		


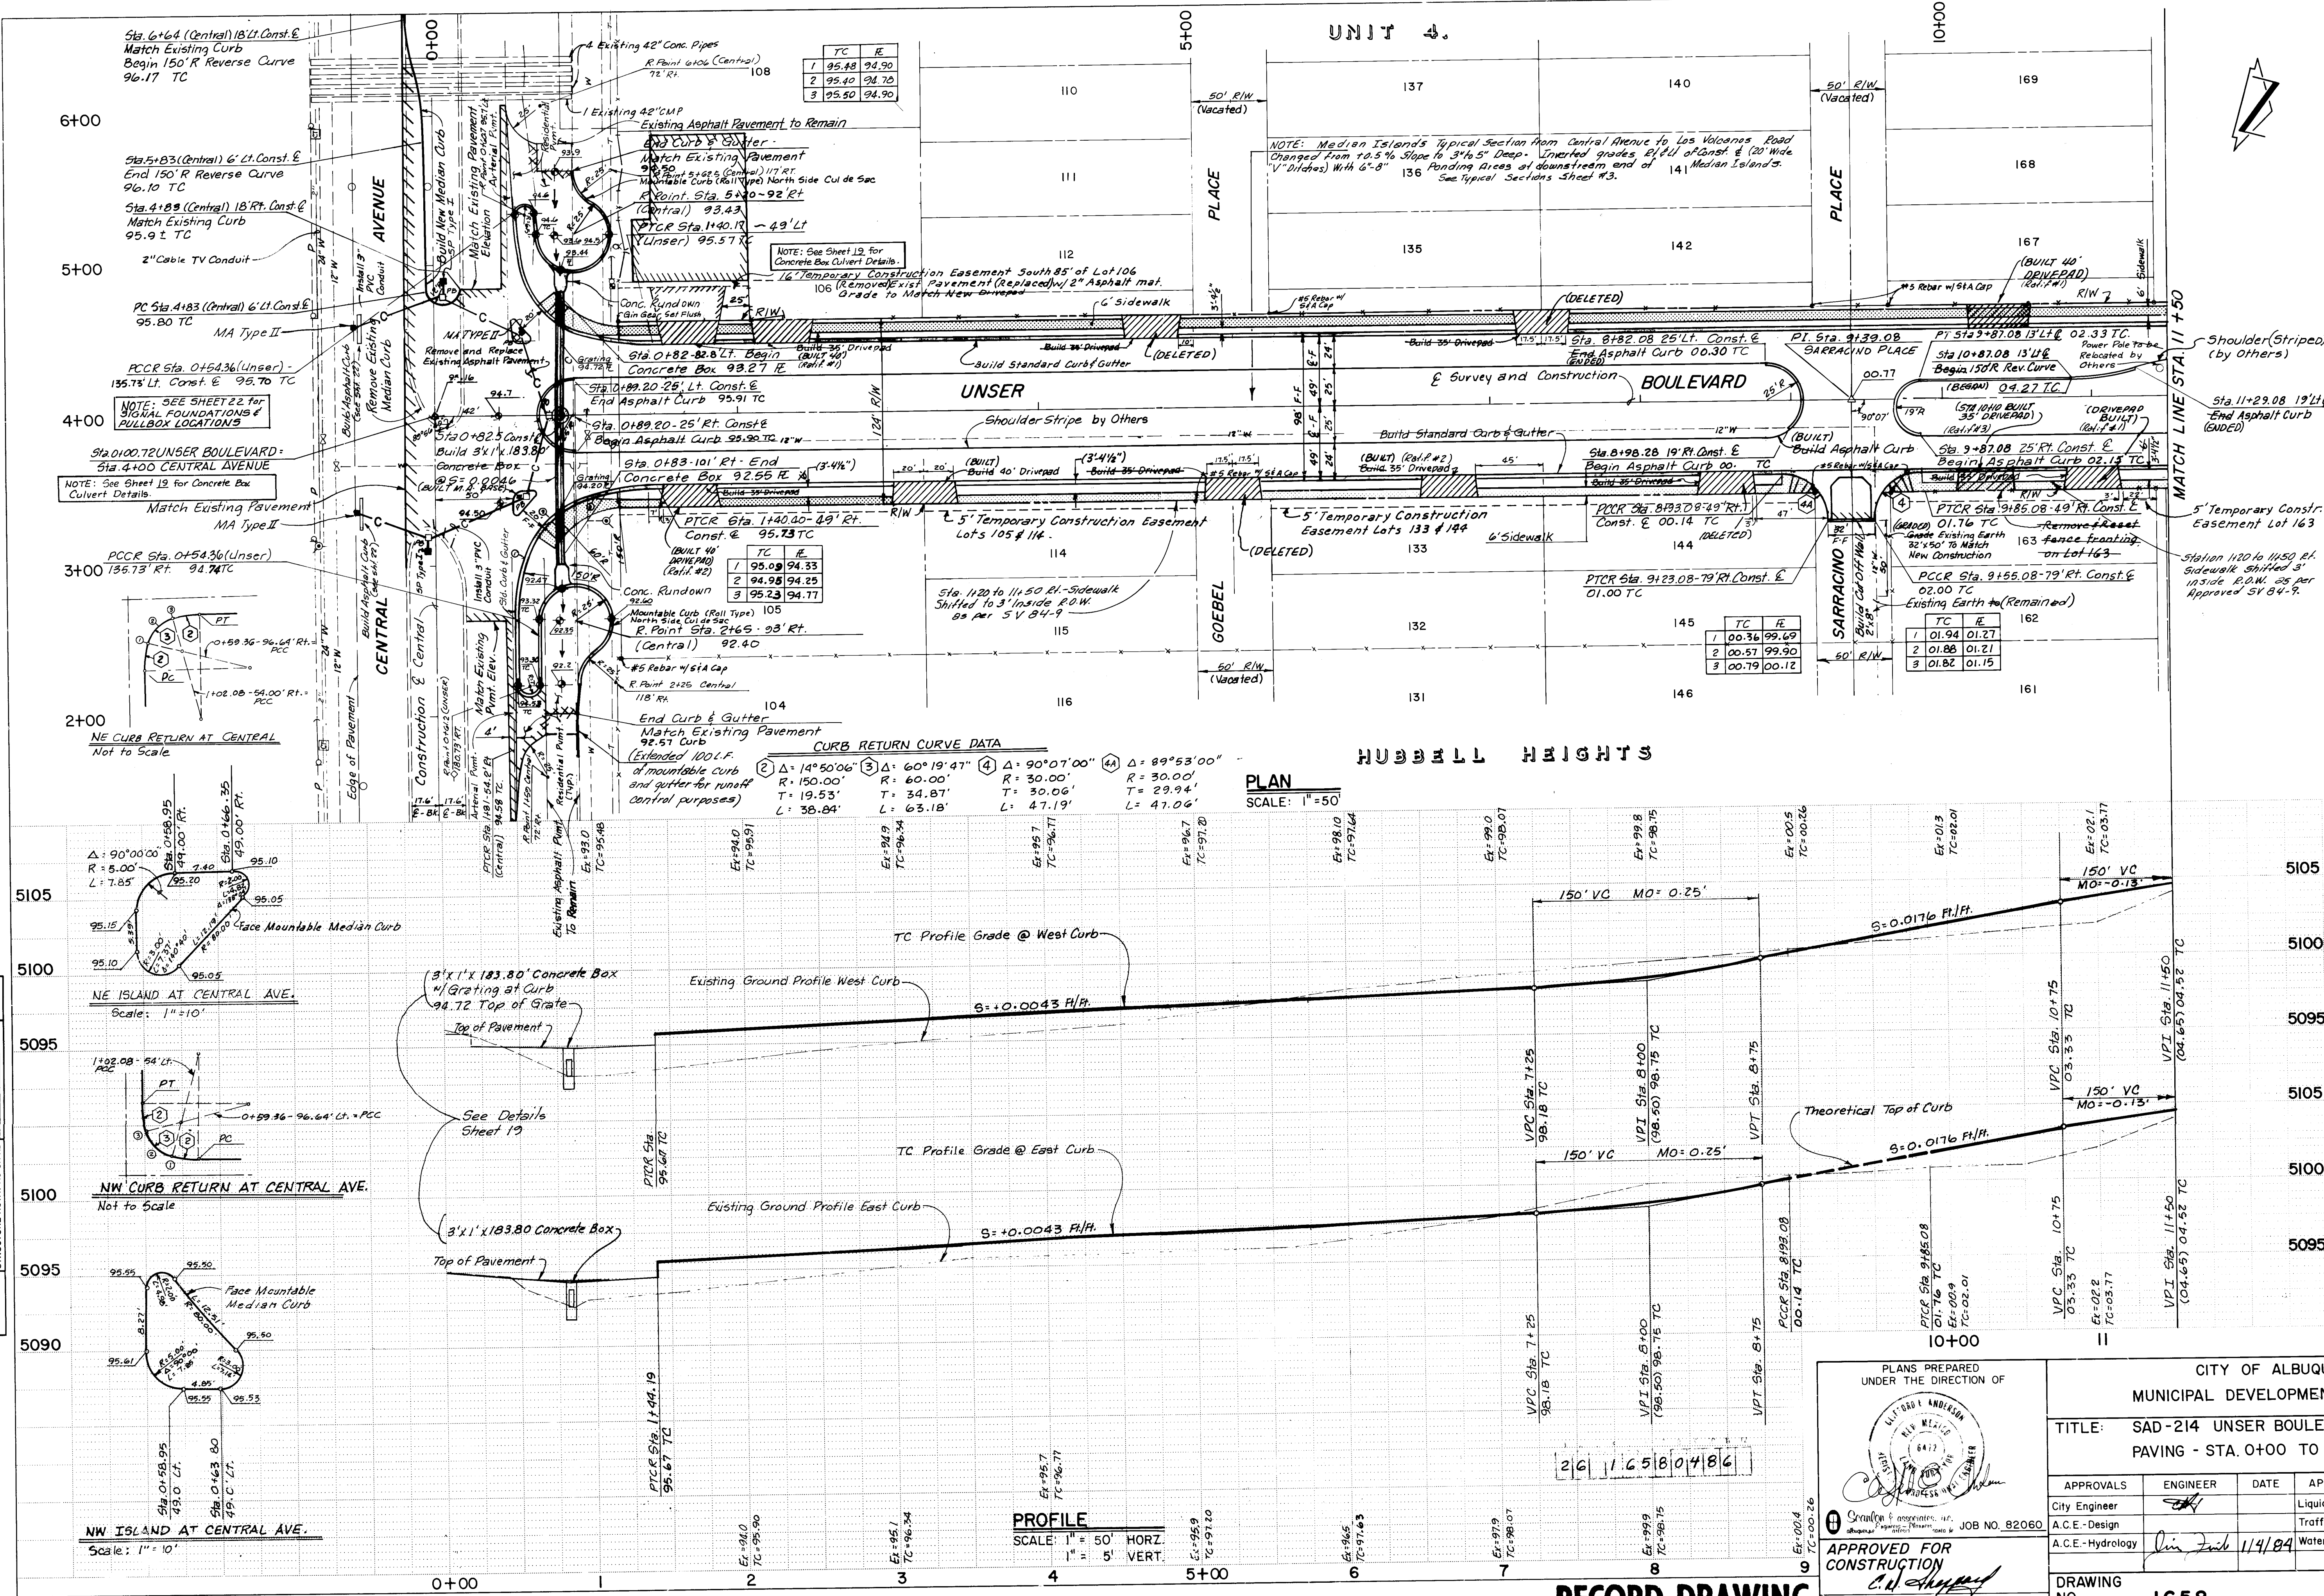


RECORD DRAWING

PLANS PREPARED UNDER THE DIRECTION OF		CITY OF ALBUQUERQUE MUNICIPAL DEVELOPMENT DEPARTMENT	
TITLE: SAD-214 UNSER BOULEVARD PAVING - STA. 0+00 TO STA. 11+50		APPROVALS	
APPROVALS	ENGINEER	DATE	APPROVALS
City Engineer	1/4/84	1/4/84	1/4/84
A.C.E. - Design	1/4/84	1/4/84	1/4/84
A.C.E. - Hydrology	1/4/84	1/4/84	1/4/84
DRAWING NO.	1658	SHEET	4 OF 23

PLAN	DATE	BY
SURVEYED		
NOTED		
PLOTTED		
CHECKED		
BY		
DATE		

PROFILE	DATE	BY
SURVEYED		
NOTED		
PLOTTED		
CHECKED		
BY		
DATE		

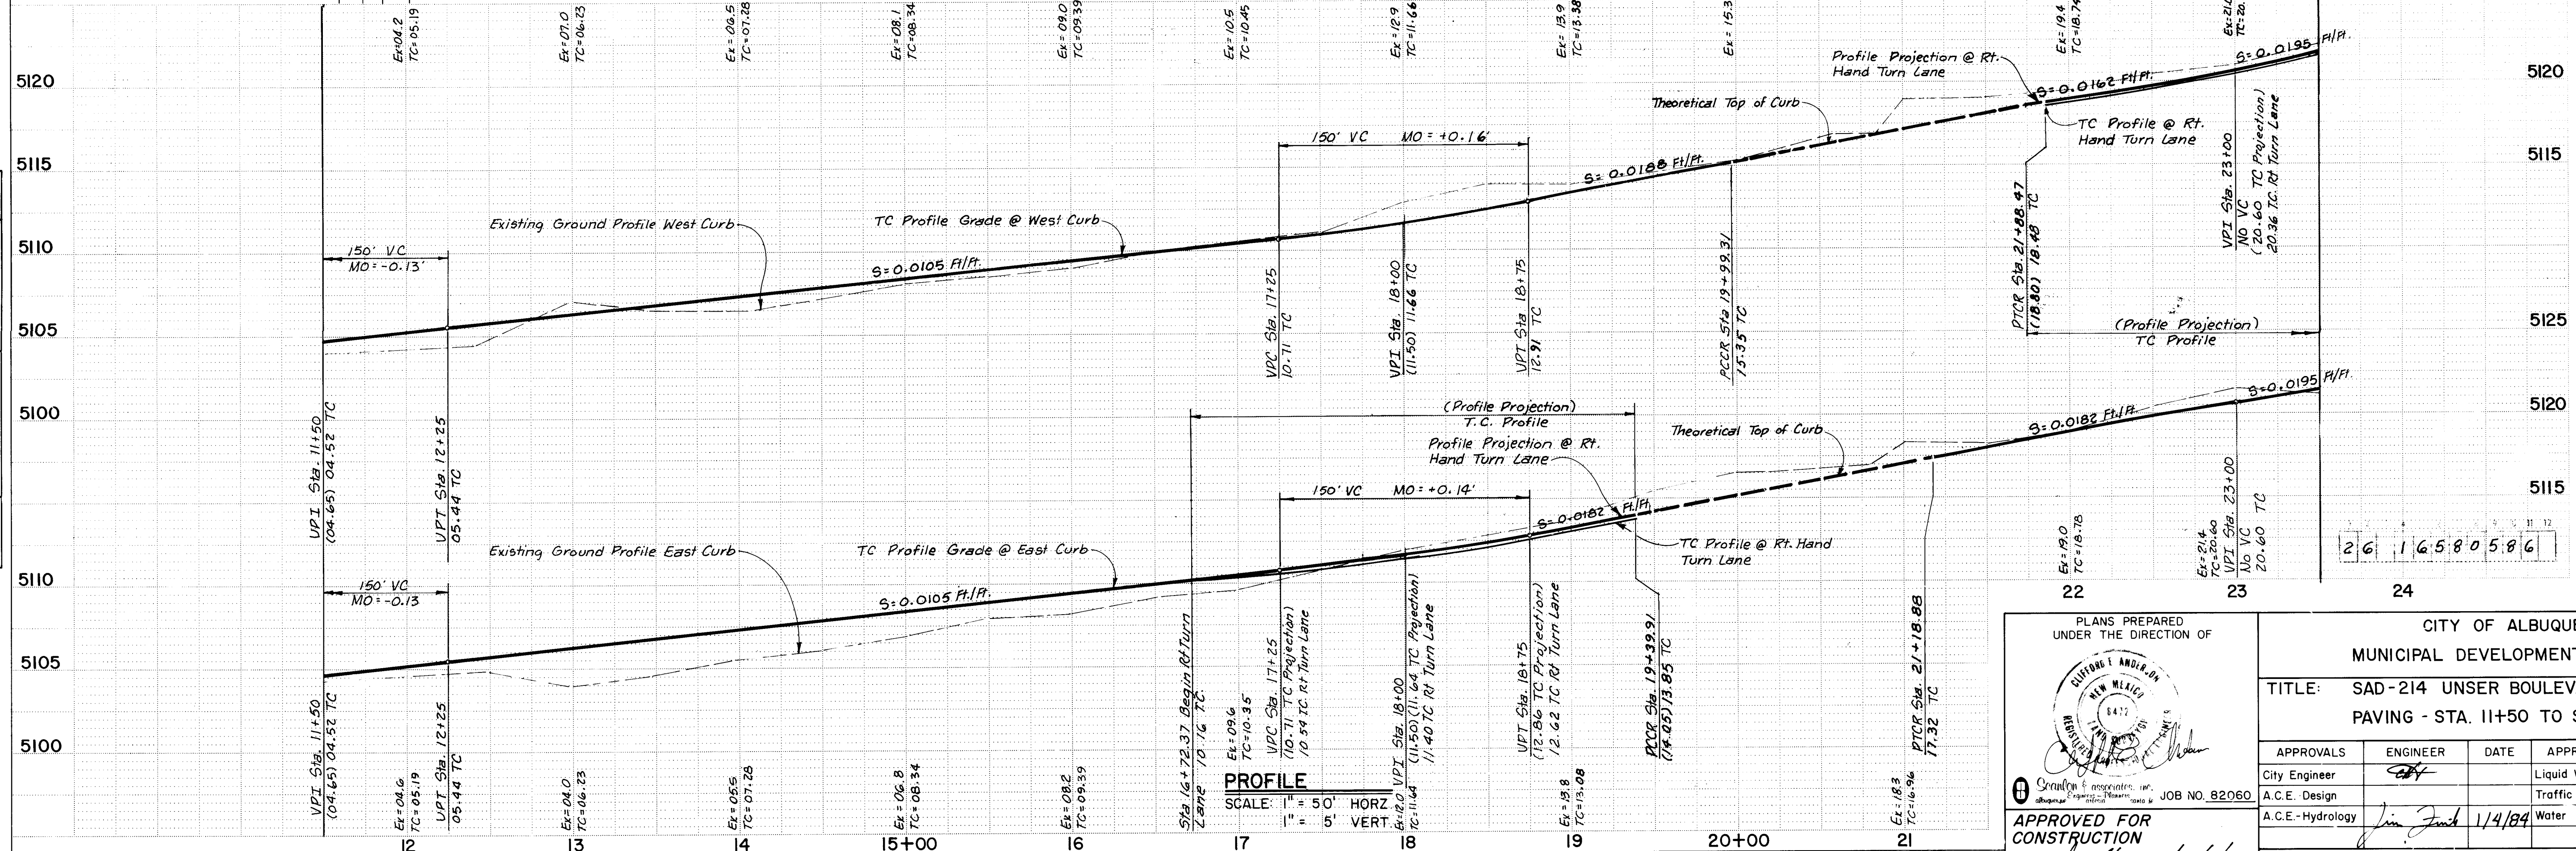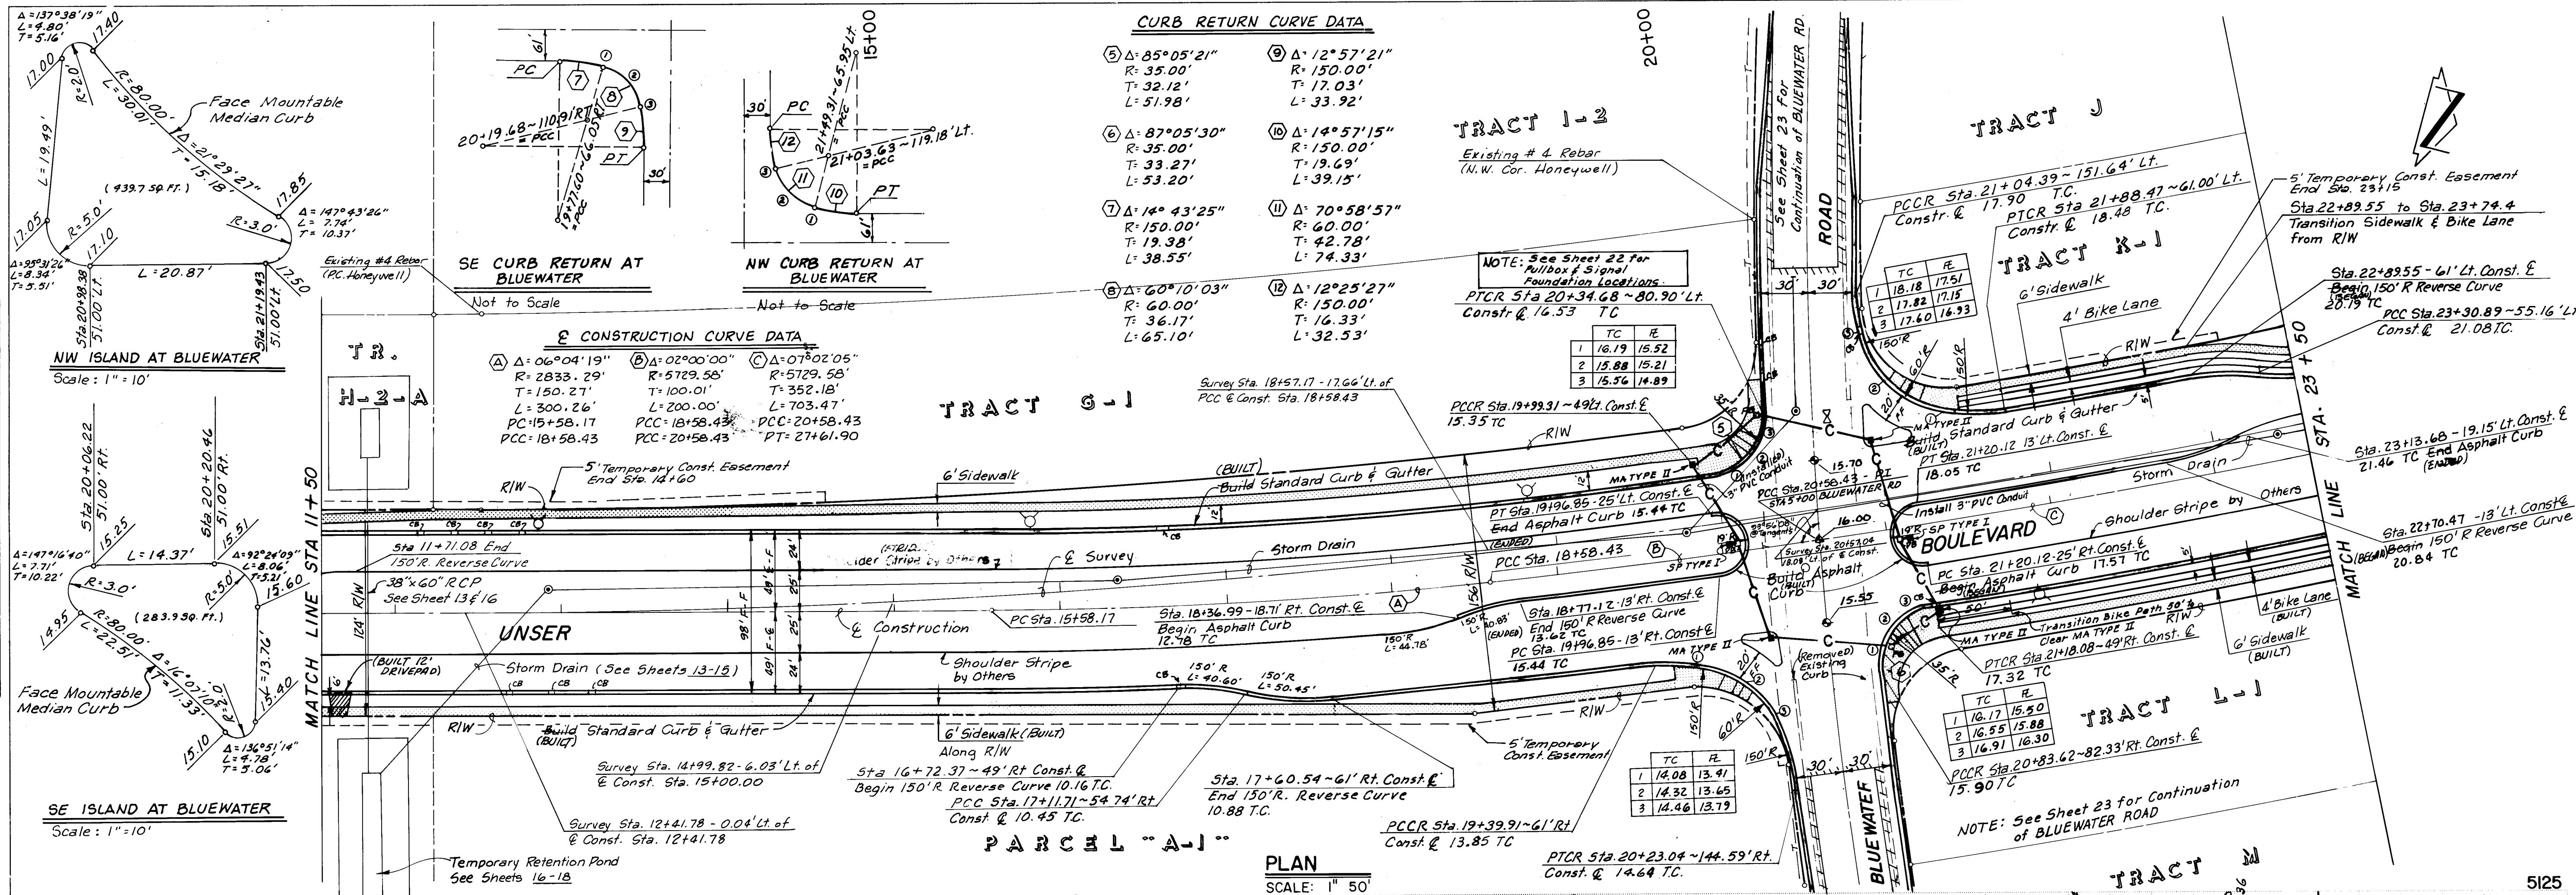



RECORD DRAWING

PLANS PREPARED UNDER THE DIRECTION OF			CITY OF ALBUQUERQUE MUNICIPAL DEVELOPMENT DEPARTMENT		
TITLE: SAD-214 UNSER BOULEVARD PAVING - STA. 11+50 TO STA. 23+50					
APPROVALS	ENGINEER	DATE	APPROVALS	ENGINEER	DATE
City Engineer	<i>[Signature]</i>		Liquid Waste	<i>[Signature]</i>	1/4/84
A.C.E. Design			Traffic	<i>[Signature]</i>	1/4/84
A.C.E. Hydrology	<i>[Signature]</i>	1/4/84	Water	<i>[Signature]</i>	1/4/84
APPROVED FOR CONSTRUCTION <i>[Signature]</i> 1/4/84 CITY ENGINEER DATE			DRAWING NO. 1658		
SHEET 5 OF 23					

AS BUILT INFORMATION	BENCH MARKS	SURVEY INFORMATION	REFERENCES
CONTRACTOR: Bruce Const. Co., Inc.	TBM - Gin Gear on North side of Power Pole	FIELD NOTES	MAP NO. K-10
INSPECTED BY: [Signature]	142' Left - Sta. 11+42 - Elev. = 5104.139	DATE	EST. NO.
DATE: 1/4/84		NO.	
MICRO-FILM INFORMATION			
DATE: 1/4/84			
RECORDED BY: [Signature]			
DATE: 1/4/84			

PLAN	DATE	BY
SURVEYED		
NOTED		
ALIGNED		
CHECKED		
RT. OF WAY		
NO.		

PROFILE	DATE	BY
SURVEYED		
GRADES		
CHECKED		
STRUCTURE		
NOTATIONS		
NO.		

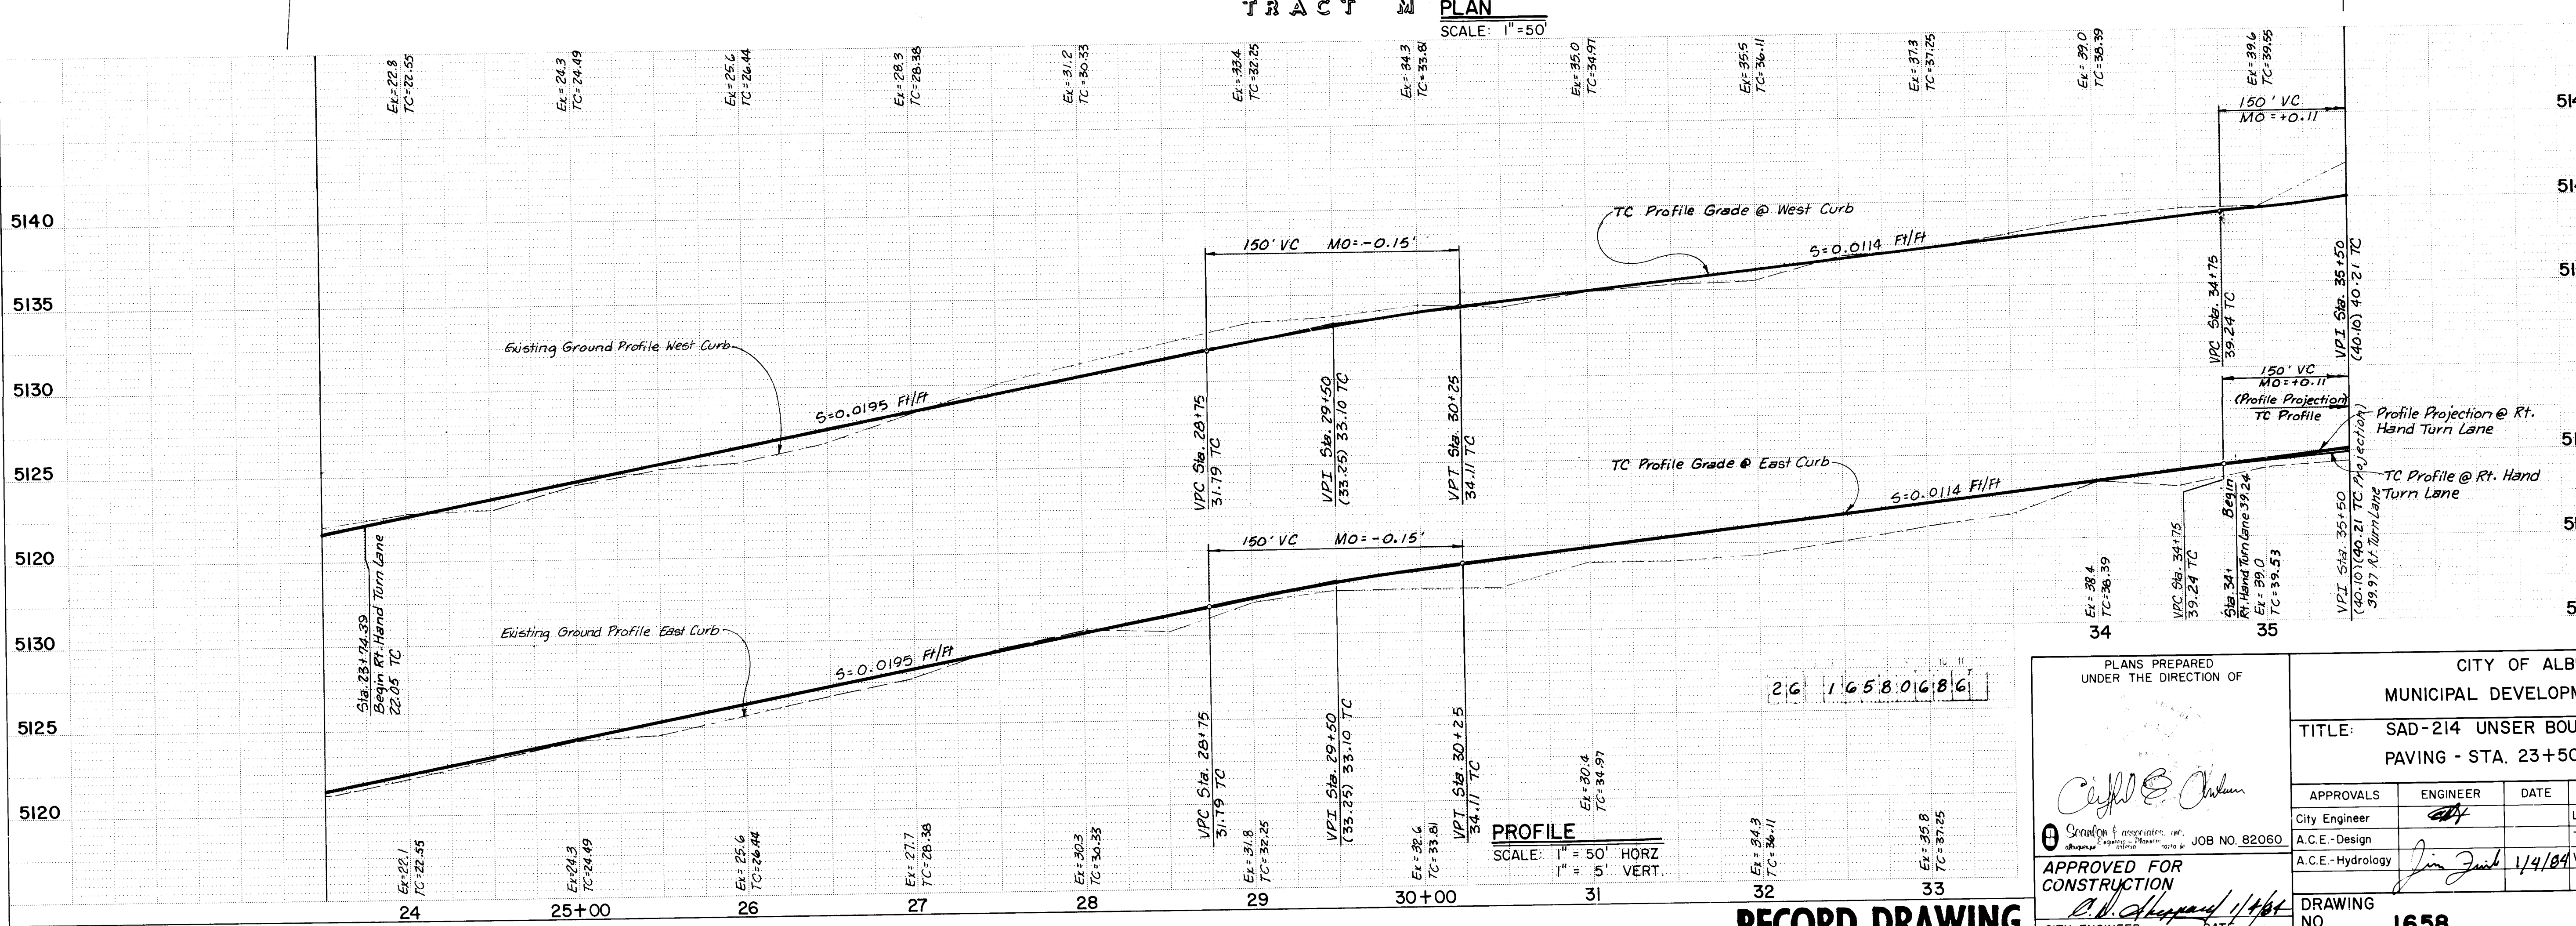
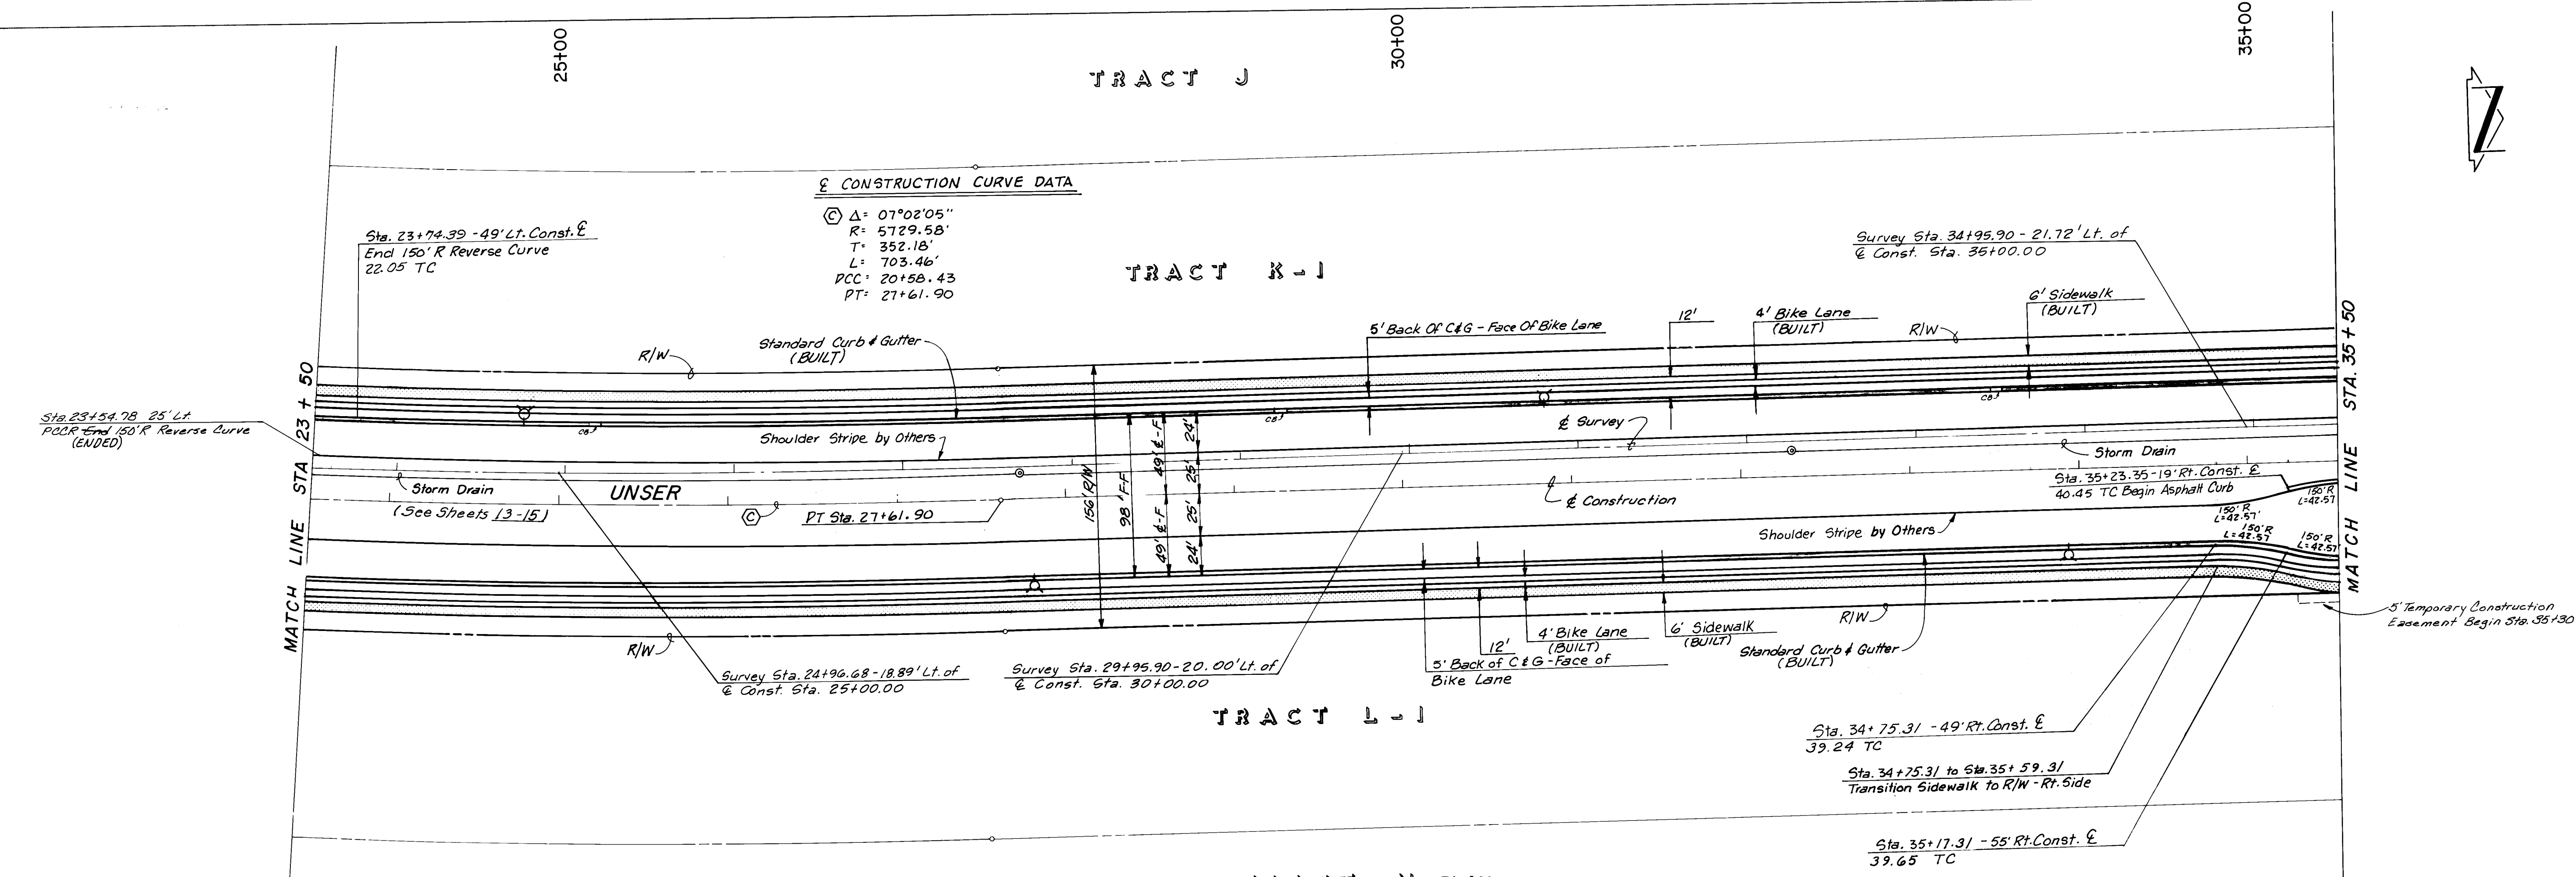


RECORD DRAWING


PLANS PREPARED UNDER THE DIRECTION OF		CITY OF ALBUQUERQUE MUNICIPAL DEVELOPMENT DEPARTMENT			
APPROVED FOR CONSTRUCTION		TITLE: SAD-214 UNSER BOULEVARD PAVING - STA. 23+50 TO STA. 35+50			
APPROVALS	ENGINEER	DATE	APPROVALS	ENGINEER	DATE
City Engineer	<i>[Signature]</i>		Liquid Waste	NA James J.	1/4/84
A.C.E. - Design			Traffic	NA James J.	1/4/84
A.C.E. - Hydrology			Water	NA James J.	1/4/84
DRAWING NO. 1658			SHEET 6 OF 23		

REFERENCES	SURVEY INFORMATION	BENCH MARKS	AS BUILT INFORMATION
MAP NO. K-10	FIELD NOTES	I-40-19 NMHC Brass Cap 1.4 miles SW of the intersection of I-40 and Coors Road in the Median of I-40 - Elev = 5151.197	CONTRACTOR Broce Const. Co. Inc.
EST. NO.	NO.		WORK STATIONED by Scanlon & Assoc. DATE 1/84
			ACCEPTED BY DATE 1/84
			FIELD CAT. ON by Scanlon & Assoc. DATE 1/84
			DRAWINGS BY Scanlon & Assoc. DATE 1/84
			CORRECTED BY Scanlon & Assoc. DATE 1/84
			RECORDED BY DATE
			NO



PROFILE NOTE BOOK NO. _____	SURVEYED _____	BY _____ DATE _____
	PLOTTED _____	
	GRADES CHECKED _____	
	B. M.'S NOTED _____	
	STRUCTURE NOTATIONS CHWD _____	

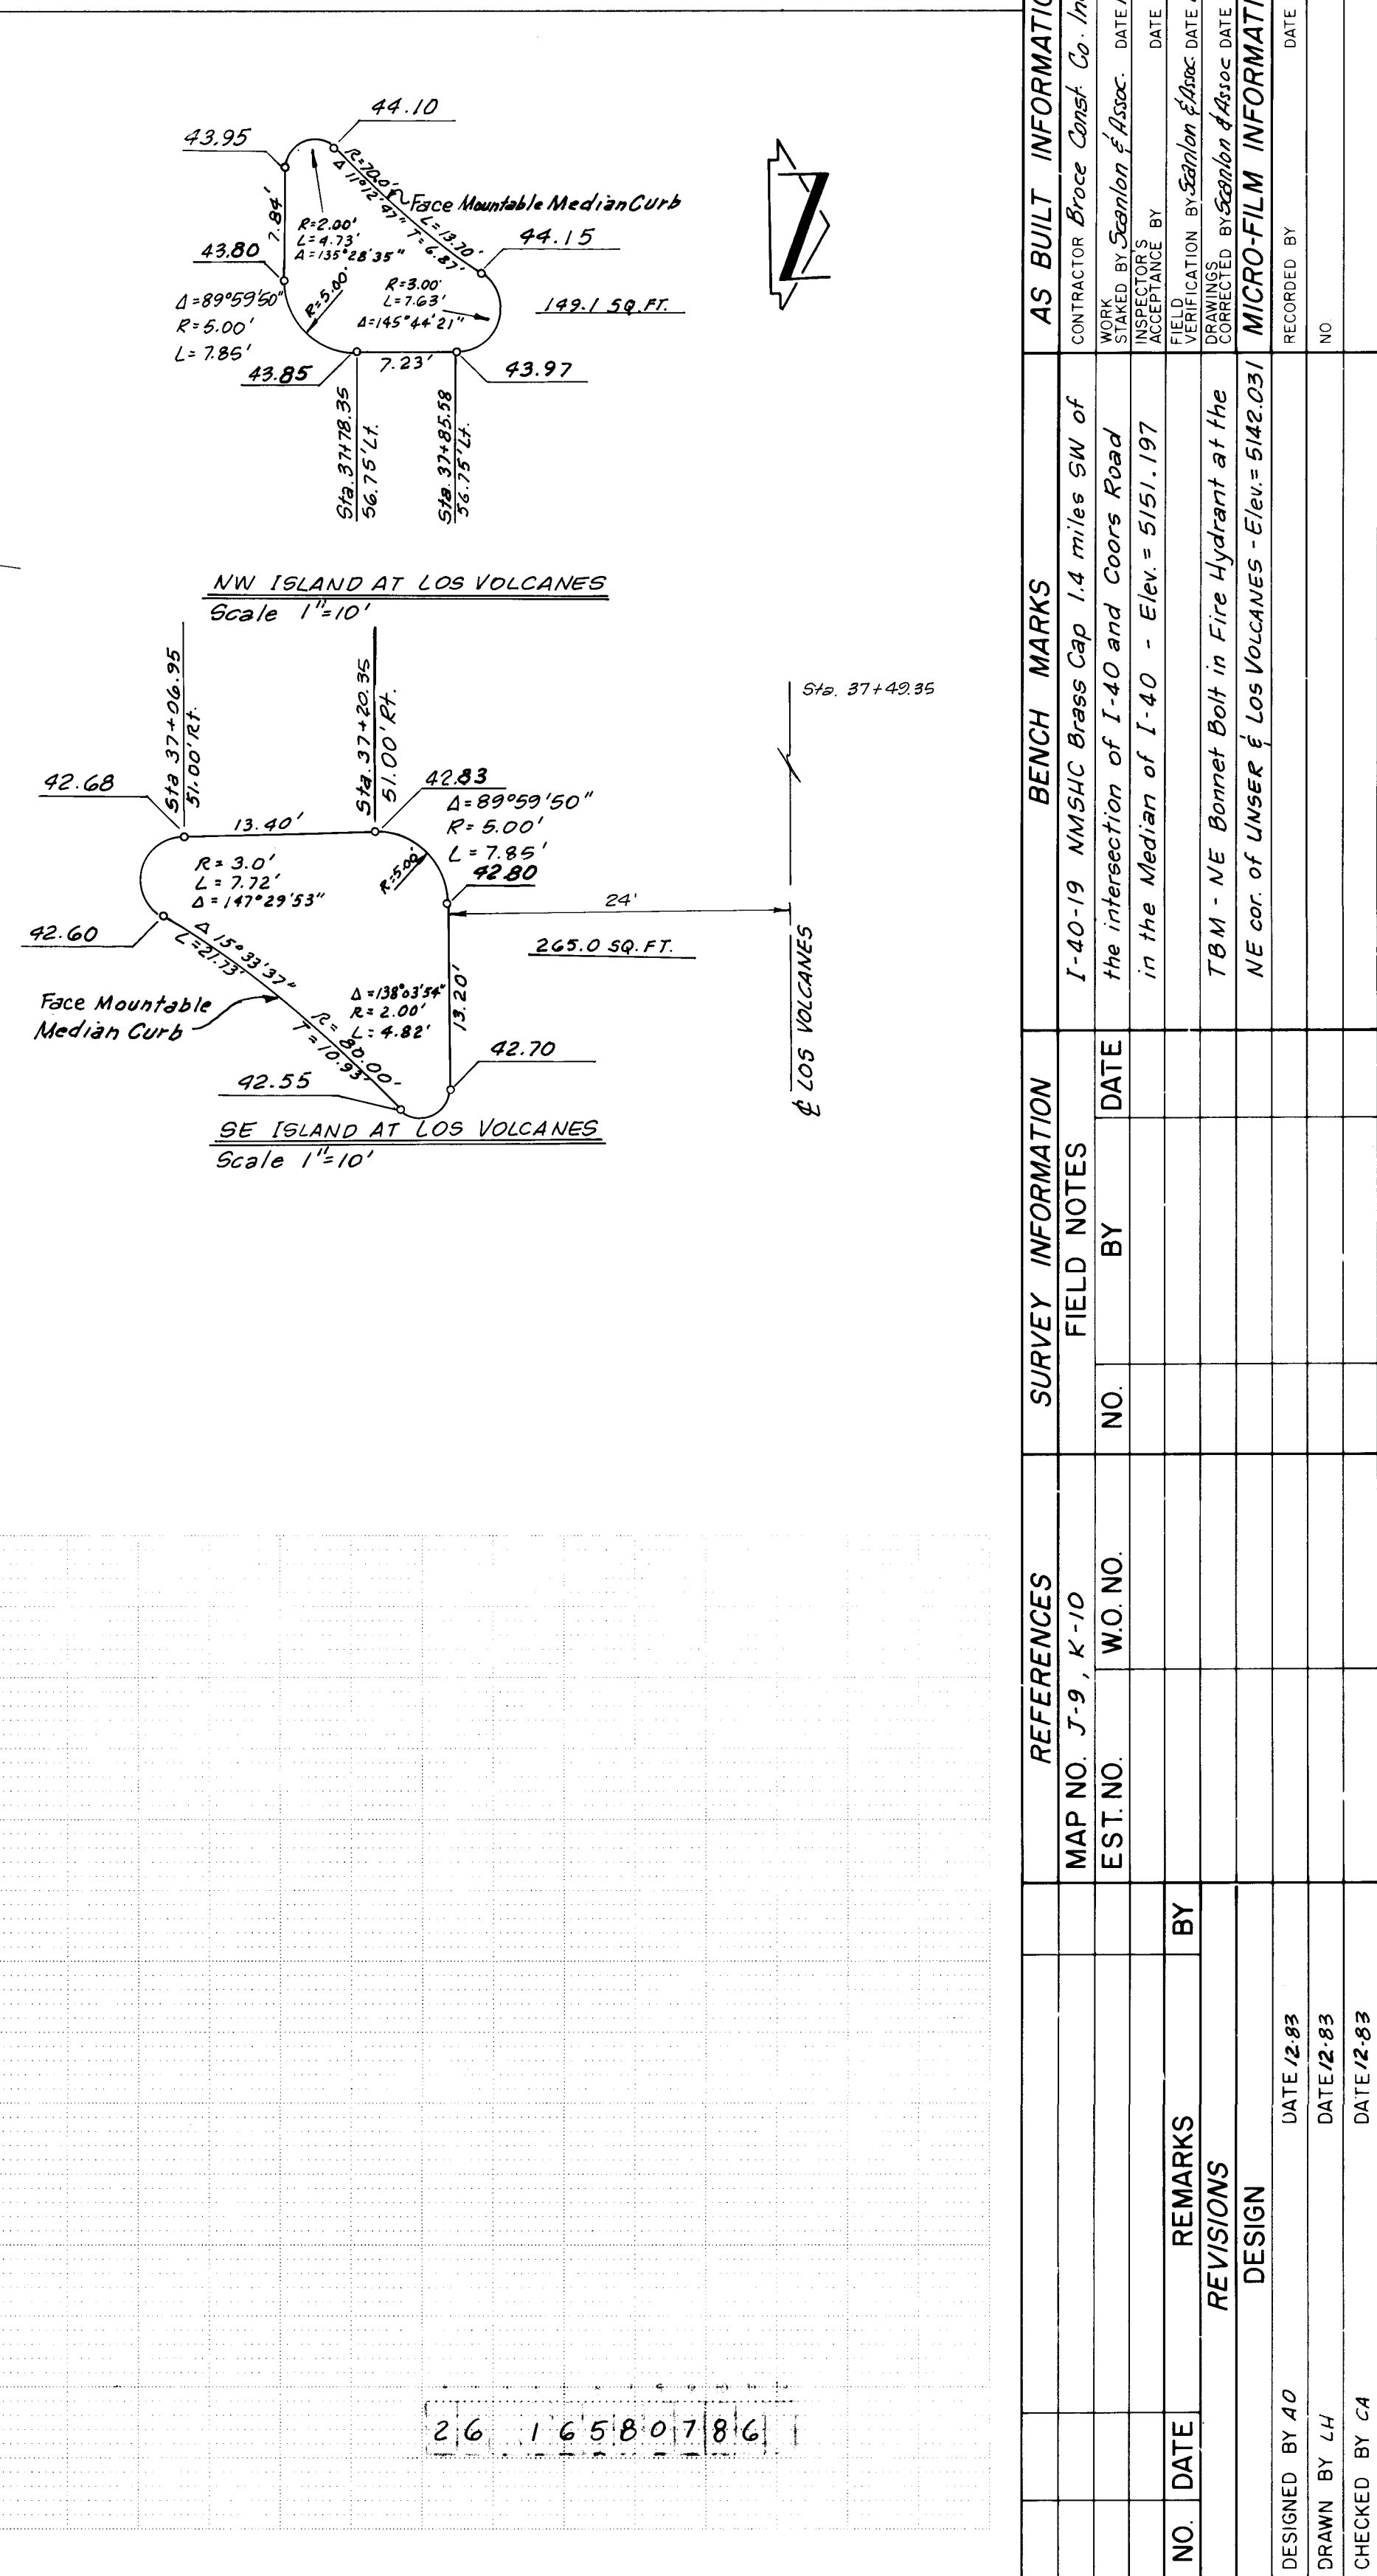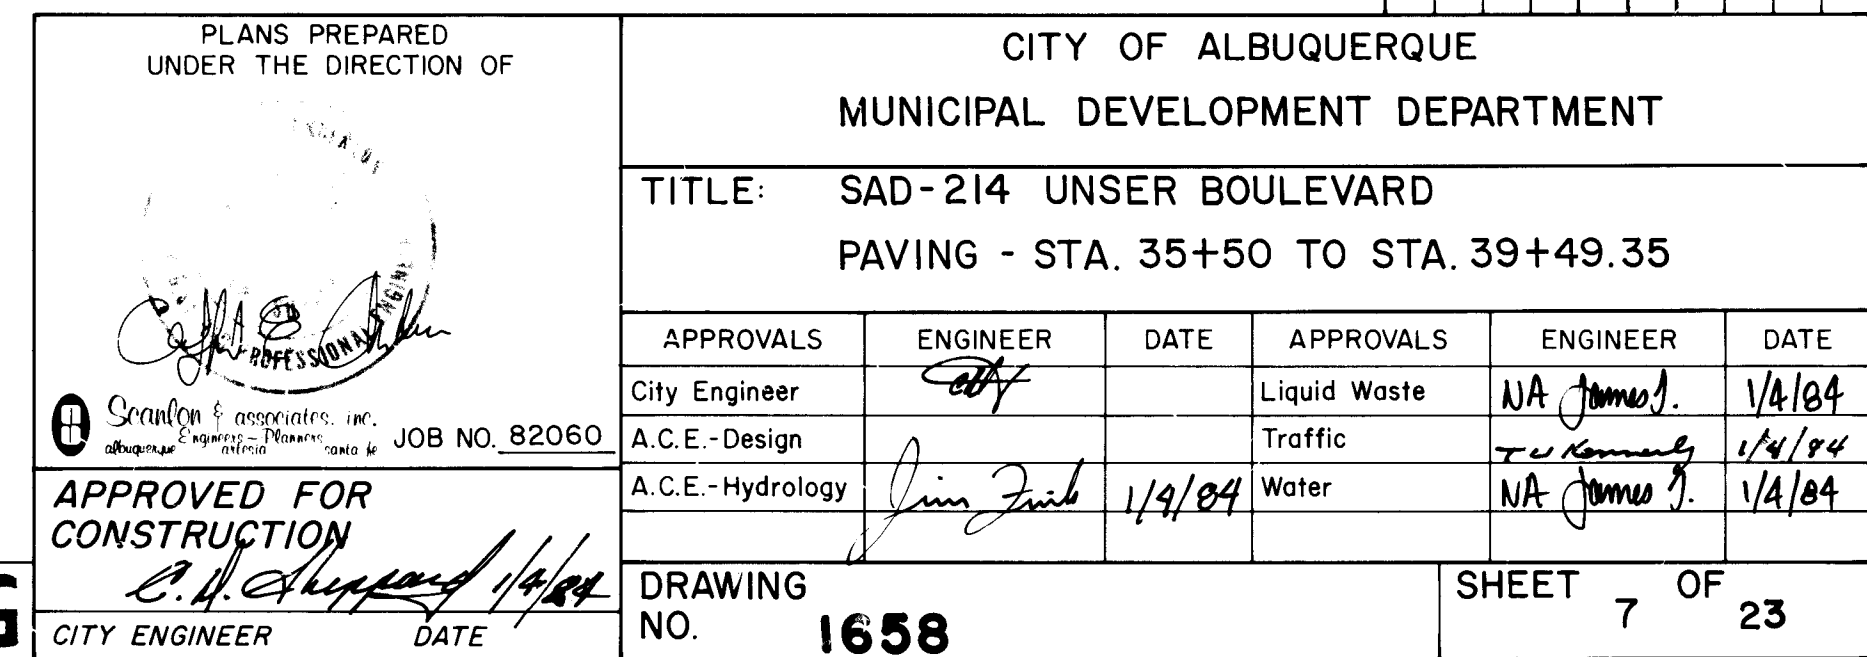


PROFILE		BY	DATE
NOTE BOOK NO.	SURVEYED		
	PLOTTED		
	GRADES CHECKED		
	B. M.'S NOTED		
	STRUCTURE NOTATIONS CH'KD		

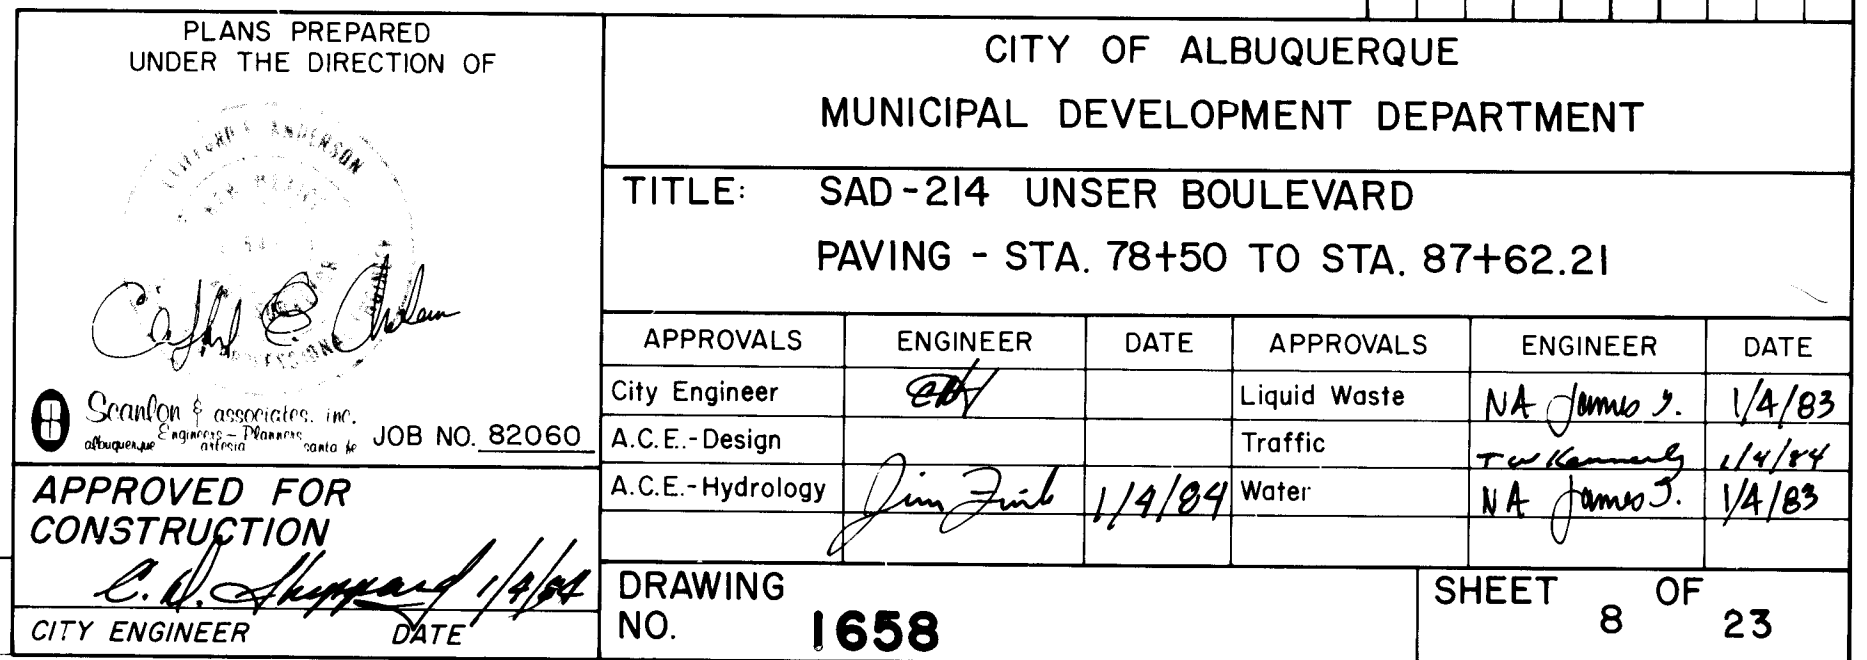




REFERENCES				SURVEY INFORMATION			BENCH MARKS		AS BUILT INFORMATION		
MAP NO. J-9		EST. NO.		W.O. NO.		NO.		BY		DATE	
NO.		DATE		REMARKS		BY					
REVISIONS											
DESIGN											
DESIGNED BY 40		DATE 12-83									
DRAWN BY L4		DATE 12-83									
CHECKED BY CA		DATE 12-83									
CONTRACTOR Grace Const. Co. Inc											
WORKS BY Sanborn & Assoc.											
INSPECTOR BY											
ACCEPTANCE BY											
FIELD VERIFICATION BY Sanborn & Assoc. DATE 1984											
DRAWINGS CORRECTED BY Sanborn & Assoc. DATE 1984											
MICRO-FILM INFORMATION											
RECORDED BY											
DATE											
NO.											

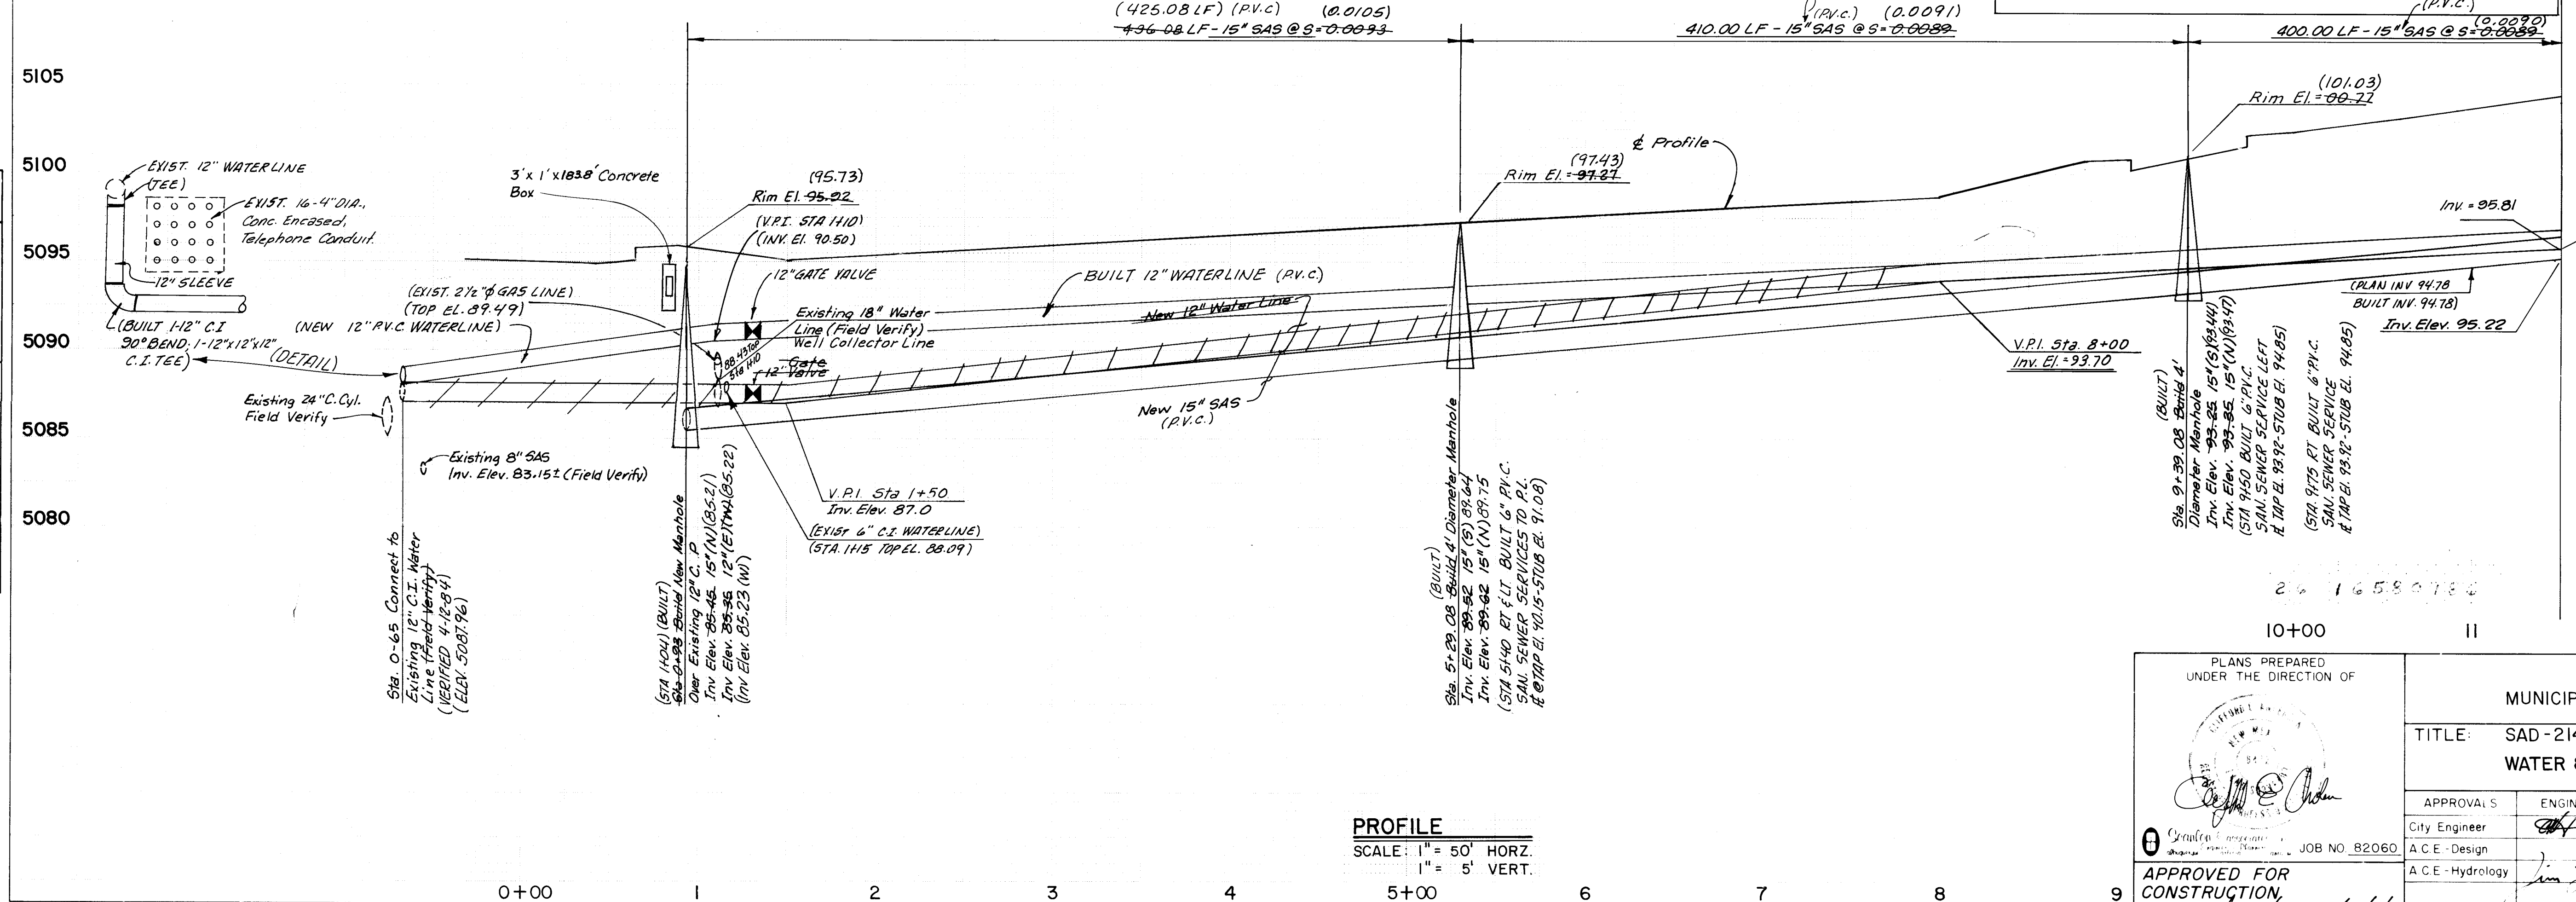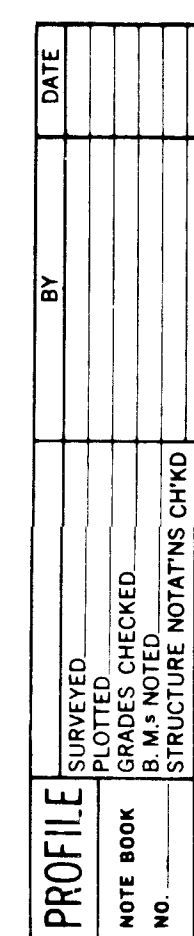

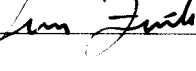PLANS PREPARED UNDER THE DIRECTION OF 		CITY OF ALBUQUERQUE MUNICIPAL DEVELOPMENT DEPARTMENT			
TITLE: SAD-214 UNSER BOULEVARD WATER & SEWER - STA. 0+00 TO STA. 11+50					
APPROVALS City Engineer A.C.E. - Design A.C.E. - Hydrology		ENGINEER   		DATE 1/4/84	
APPROVALS Liquid Waste Traffic Water		ENGINEER NA James J. NA xxxx NA James J.		DATE 1/4/84 1/4/84 1/4/84	
APPROVED FOR CONSTRUCTION. 		DRAWING NO.		SHEET 9 OF 23	
CITY ENGINEER DATE		1658			

PLAN	DATE	BY
SURVEYED		
NOTED		
PLANNED		
DESIGNED		
DRAWN		
CHECKED		
BY		

PROFILE	DATE	BY
SURVEYED		
NOTED		
PLANNED		
DESIGNED		
DRAWN		
CHECKED		
BY		

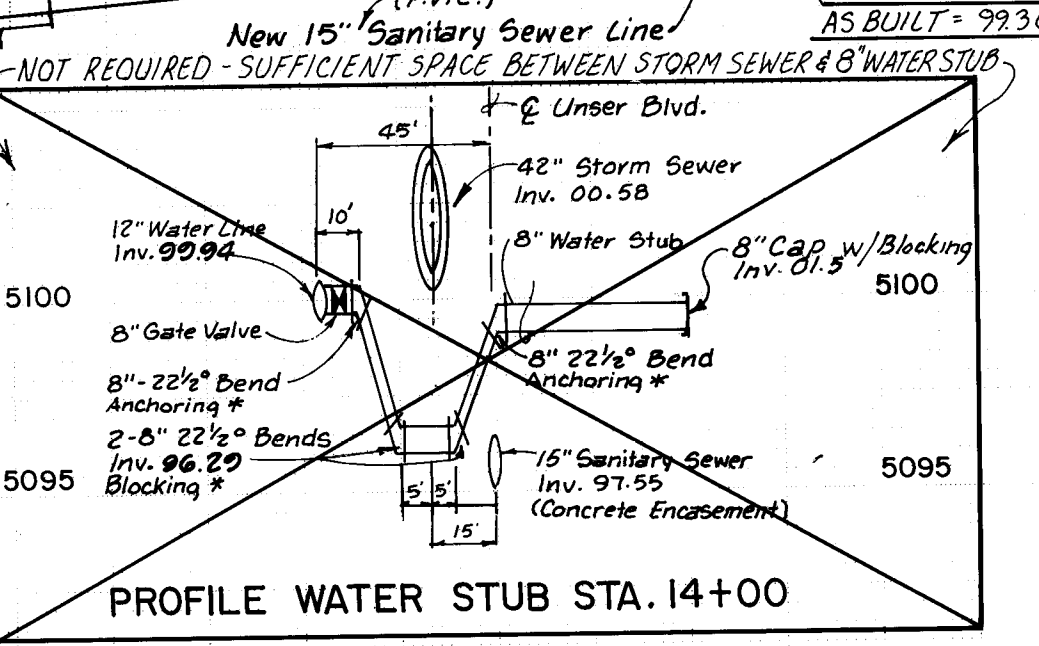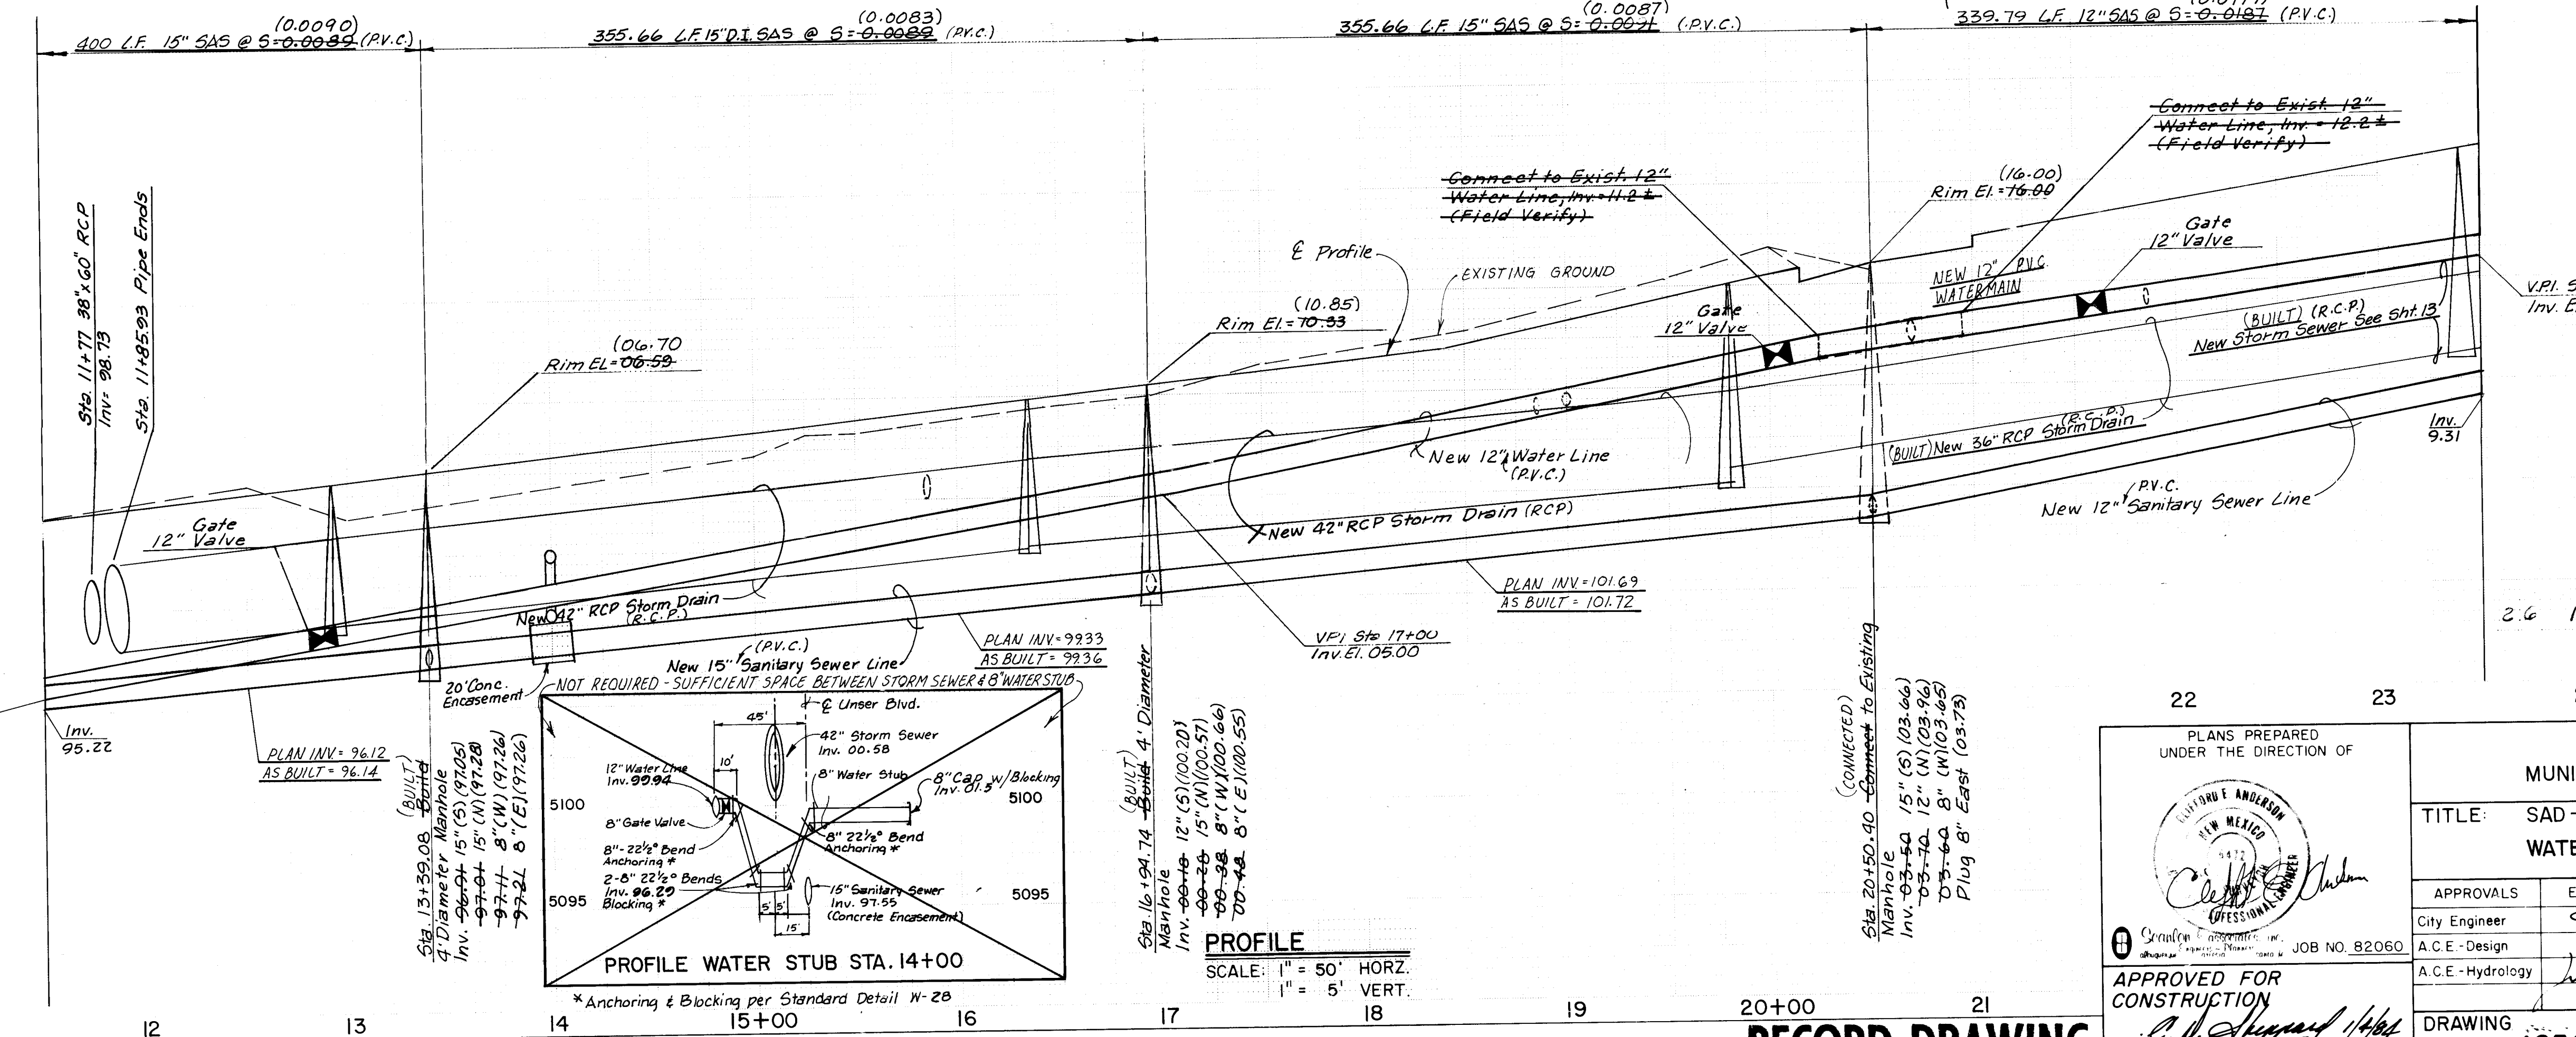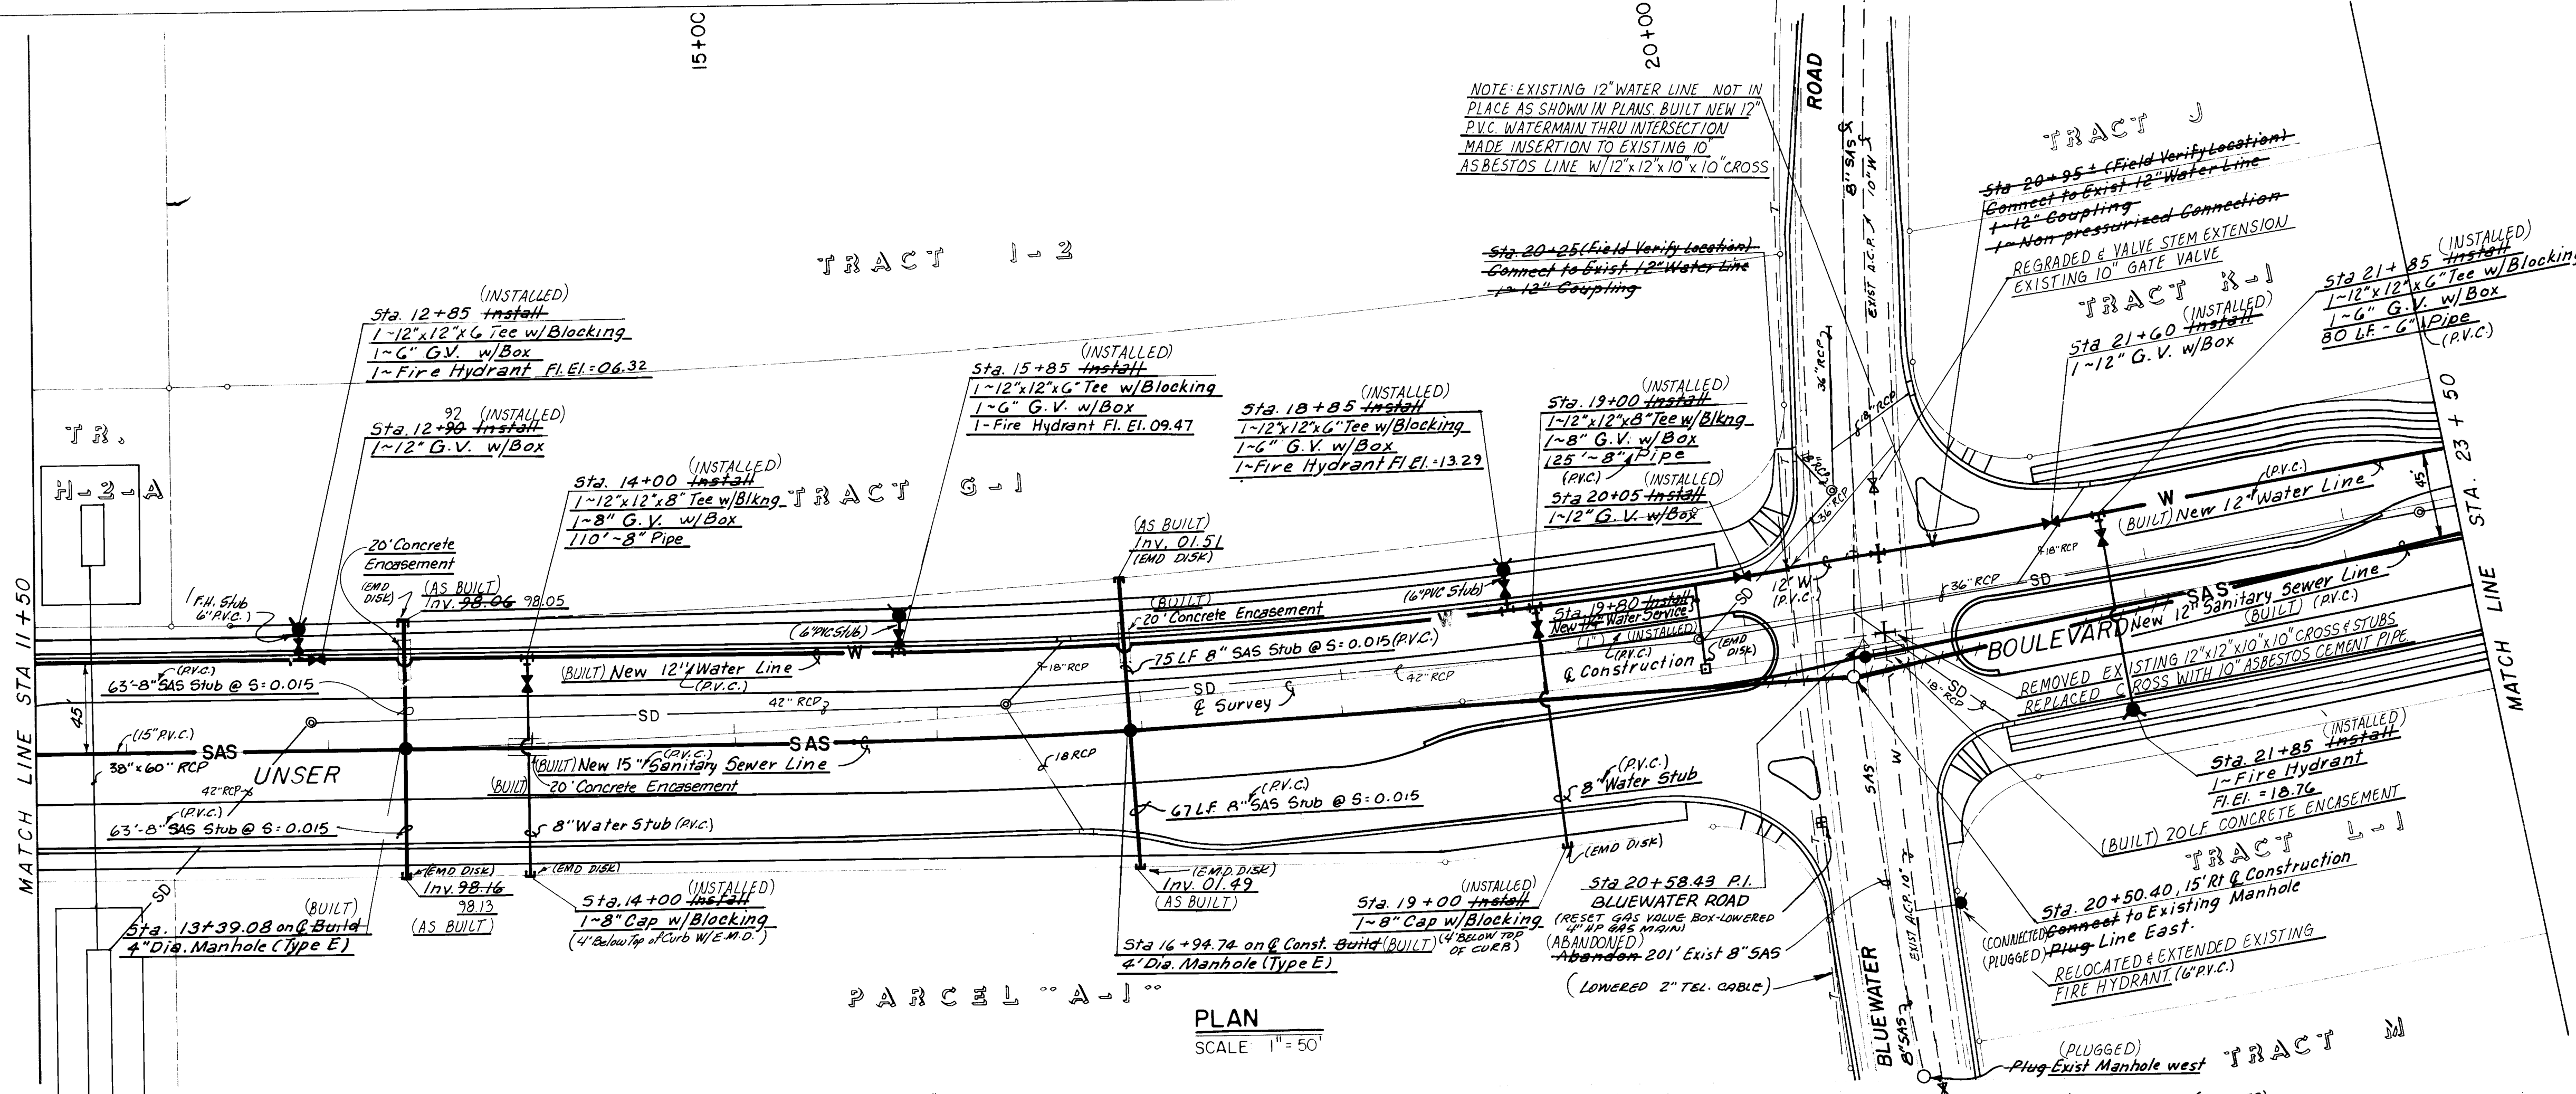

PROFILE
SCALE: 1" = 50' HORIZ.
1" = 5' VERT.


RECORD DRAWING

PLANS PREPARED UNDER THE DIRECTION OF			CITY OF ALBUQUERQUE MUNICIPAL DEVELOPMENT DEPARTMENT		
TITLE: SAD-214 UNSER BOULEVARD WATER & SEWER - STA. 11+50 TO STA. 23+50					
APPROVALS	ENGINEER	DATE	APPROVALS	ENGINEER	DATE
City Engineer	<i>[Signature]</i>		Liquid Waste	<i>[Signature]</i>	1/4/84
A.C.E.-Design	<i>[Signature]</i>	1/4/84	Traffic	<i>[Signature]</i>	1/4/84
A.C.E.-Hydrology	<i>[Signature]</i>	1/4/84	Water	<i>[Signature]</i>	1/4/84
DRAWING NO.	1658		SHEET	10 OF 23	

AS BUILT INFORMATION	BENCH MARKS	SURVEY INFORMATION	REFERENCES
CONTRACTOR: Broce Const. Co. Inc. WORK: By Sanborn & Assoc. DATE: 1984 INSPECTOR: [Signature] DATE: [Blank] ACCEPTANCE: [Blank] DATE: [Blank] DRAWING: [Blank] DATE: [Blank] MICRO-FILM INFORMATION: [Blank]	TBM - 6 in. Gear on North side of Power Pole 12' Left - Sta. 11+42 - Elev. = 5104.139 I-40 - 10' NMSHC Bases Cap 1.4 miles S.W. of the intersection of I-40 and COORS ROAD in the median of I-40 Elev. = 5151.97	FIELD NOTES NO. [Blank] BY [Blank] DATE [Blank]	MAP NO. K-10 EST. NO. [Blank] W.O. NO. [Blank] NO. [Blank] BY [Blank] DATE [Blank] REVISIONS DESIGN DATE 12-83 DRAWN BY DM DATE 12-83 CHECKED BY CA DATE 12-83

PLAN	DATE	BY
SURVEYED		
NOTED		
ALIGNED		
CHECKED		
RT. OF WAY		
NO.		

PROFILE	DATE	BY
SURVEYED		
NOTED		
GRADES		
CHECKED		
STRUCTURE		
NOTATIONS		
CHNG		
NO.		

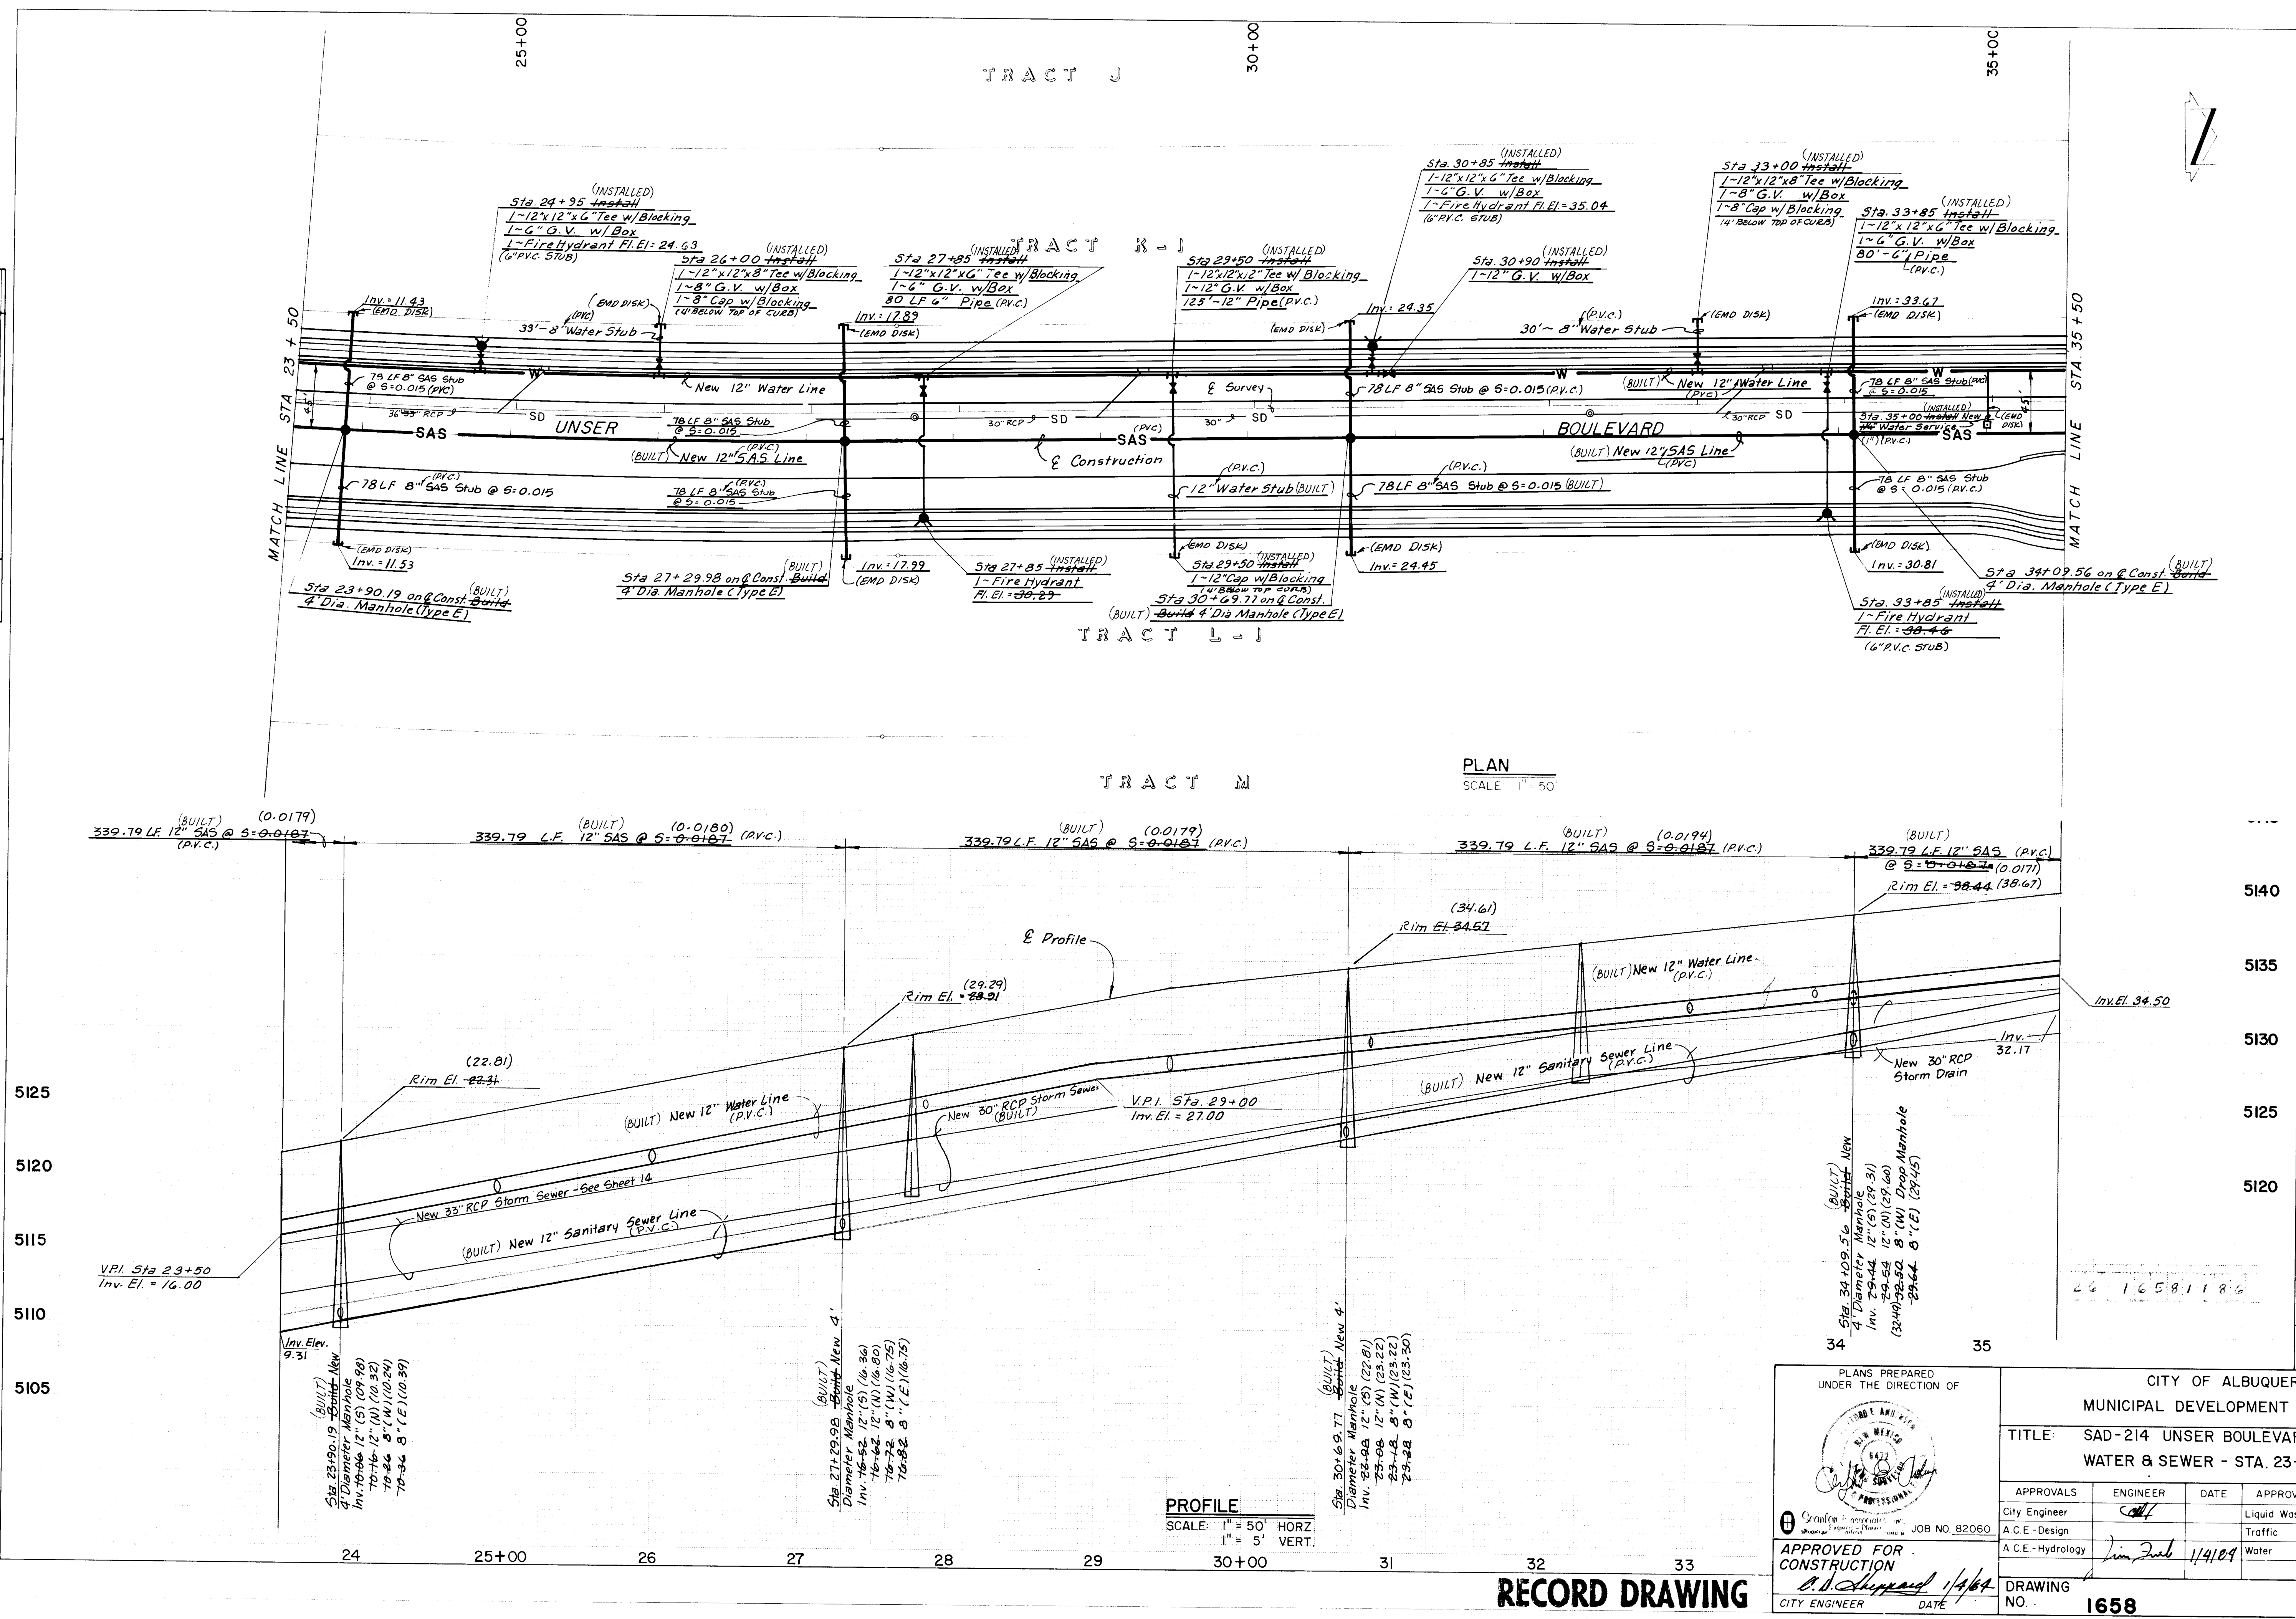


PLANS PREPARED UNDER THE DIRECTION OF		CITY OF ALBUQUERQUE MUNICIPAL DEVELOPMENT DEPARTMENT	
		TITLE: SAD-214 UNSER BOULEVARD WATER & SEWER - STA. 23+50 TO STA. 35+50	
APPROVALS	ENGINEER	DATE	APPROVALS
City Engineer	<i>[Signature]</i>		Liquid Waste
A.C.E. - Design			Traffic
A.C.E. - Hydrology	<i>[Signature]</i>	1/4/84	Water
APPROVED FOR CONSTRUCTION		DESIGNED BY AO	
<i>[Signature]</i> 1/4/84		DRAWN BY DW	
CITY ENGINEER		CHECKED BY CA	
DATE		DATE 12-83	
		DATE 12-83	
		DATE 12-83	
DRAWING NO. 1658		SHEET 11 OF 23	

AS BUILT INFORMATION		BENCH MARKS		SURVEY INFORMATION		REFERENCES	
CONTRACTOR	Broce Const. Co. Inc.	1-40-19	NMSHC Brass Cap 1.4 miles SW of the intersection of I-40 and Coors Road in the Median of I-40 - Elev = 5151.197	FIELD NOTES	NO	MAP NO. K-10	EST. NO.
WORK	STABED BY: Seablan f. Assoc. DATE 1984	DATE		DATE		NO	
ACCEPTANCE BY		DATE		BY		WO NO.	
FIELD LAYOUT	By: Seablan f. Assoc. DATE 1984	DATE		REMARKS			
DRAWING	By: Seablan f. Assoc. DATE 1984	DATE		REVISIONS			
CORRECTED BY	Seablan f. Assoc. DATE 1984	DATE		DESIGN			
NO		NO		DESIGNED BY	AO		
				DRAWN BY	DW		
				CHECKED BY	CA		

PLAN	DATE	BY
SURVEYED		
PLOTTED		
CHECKED		
NOTE BOOK		
NO.		

PROFILE	DATE	BY
SURVEYED		
PLOTTED		
CHECKED		
NOTE BOOK		
NO.		

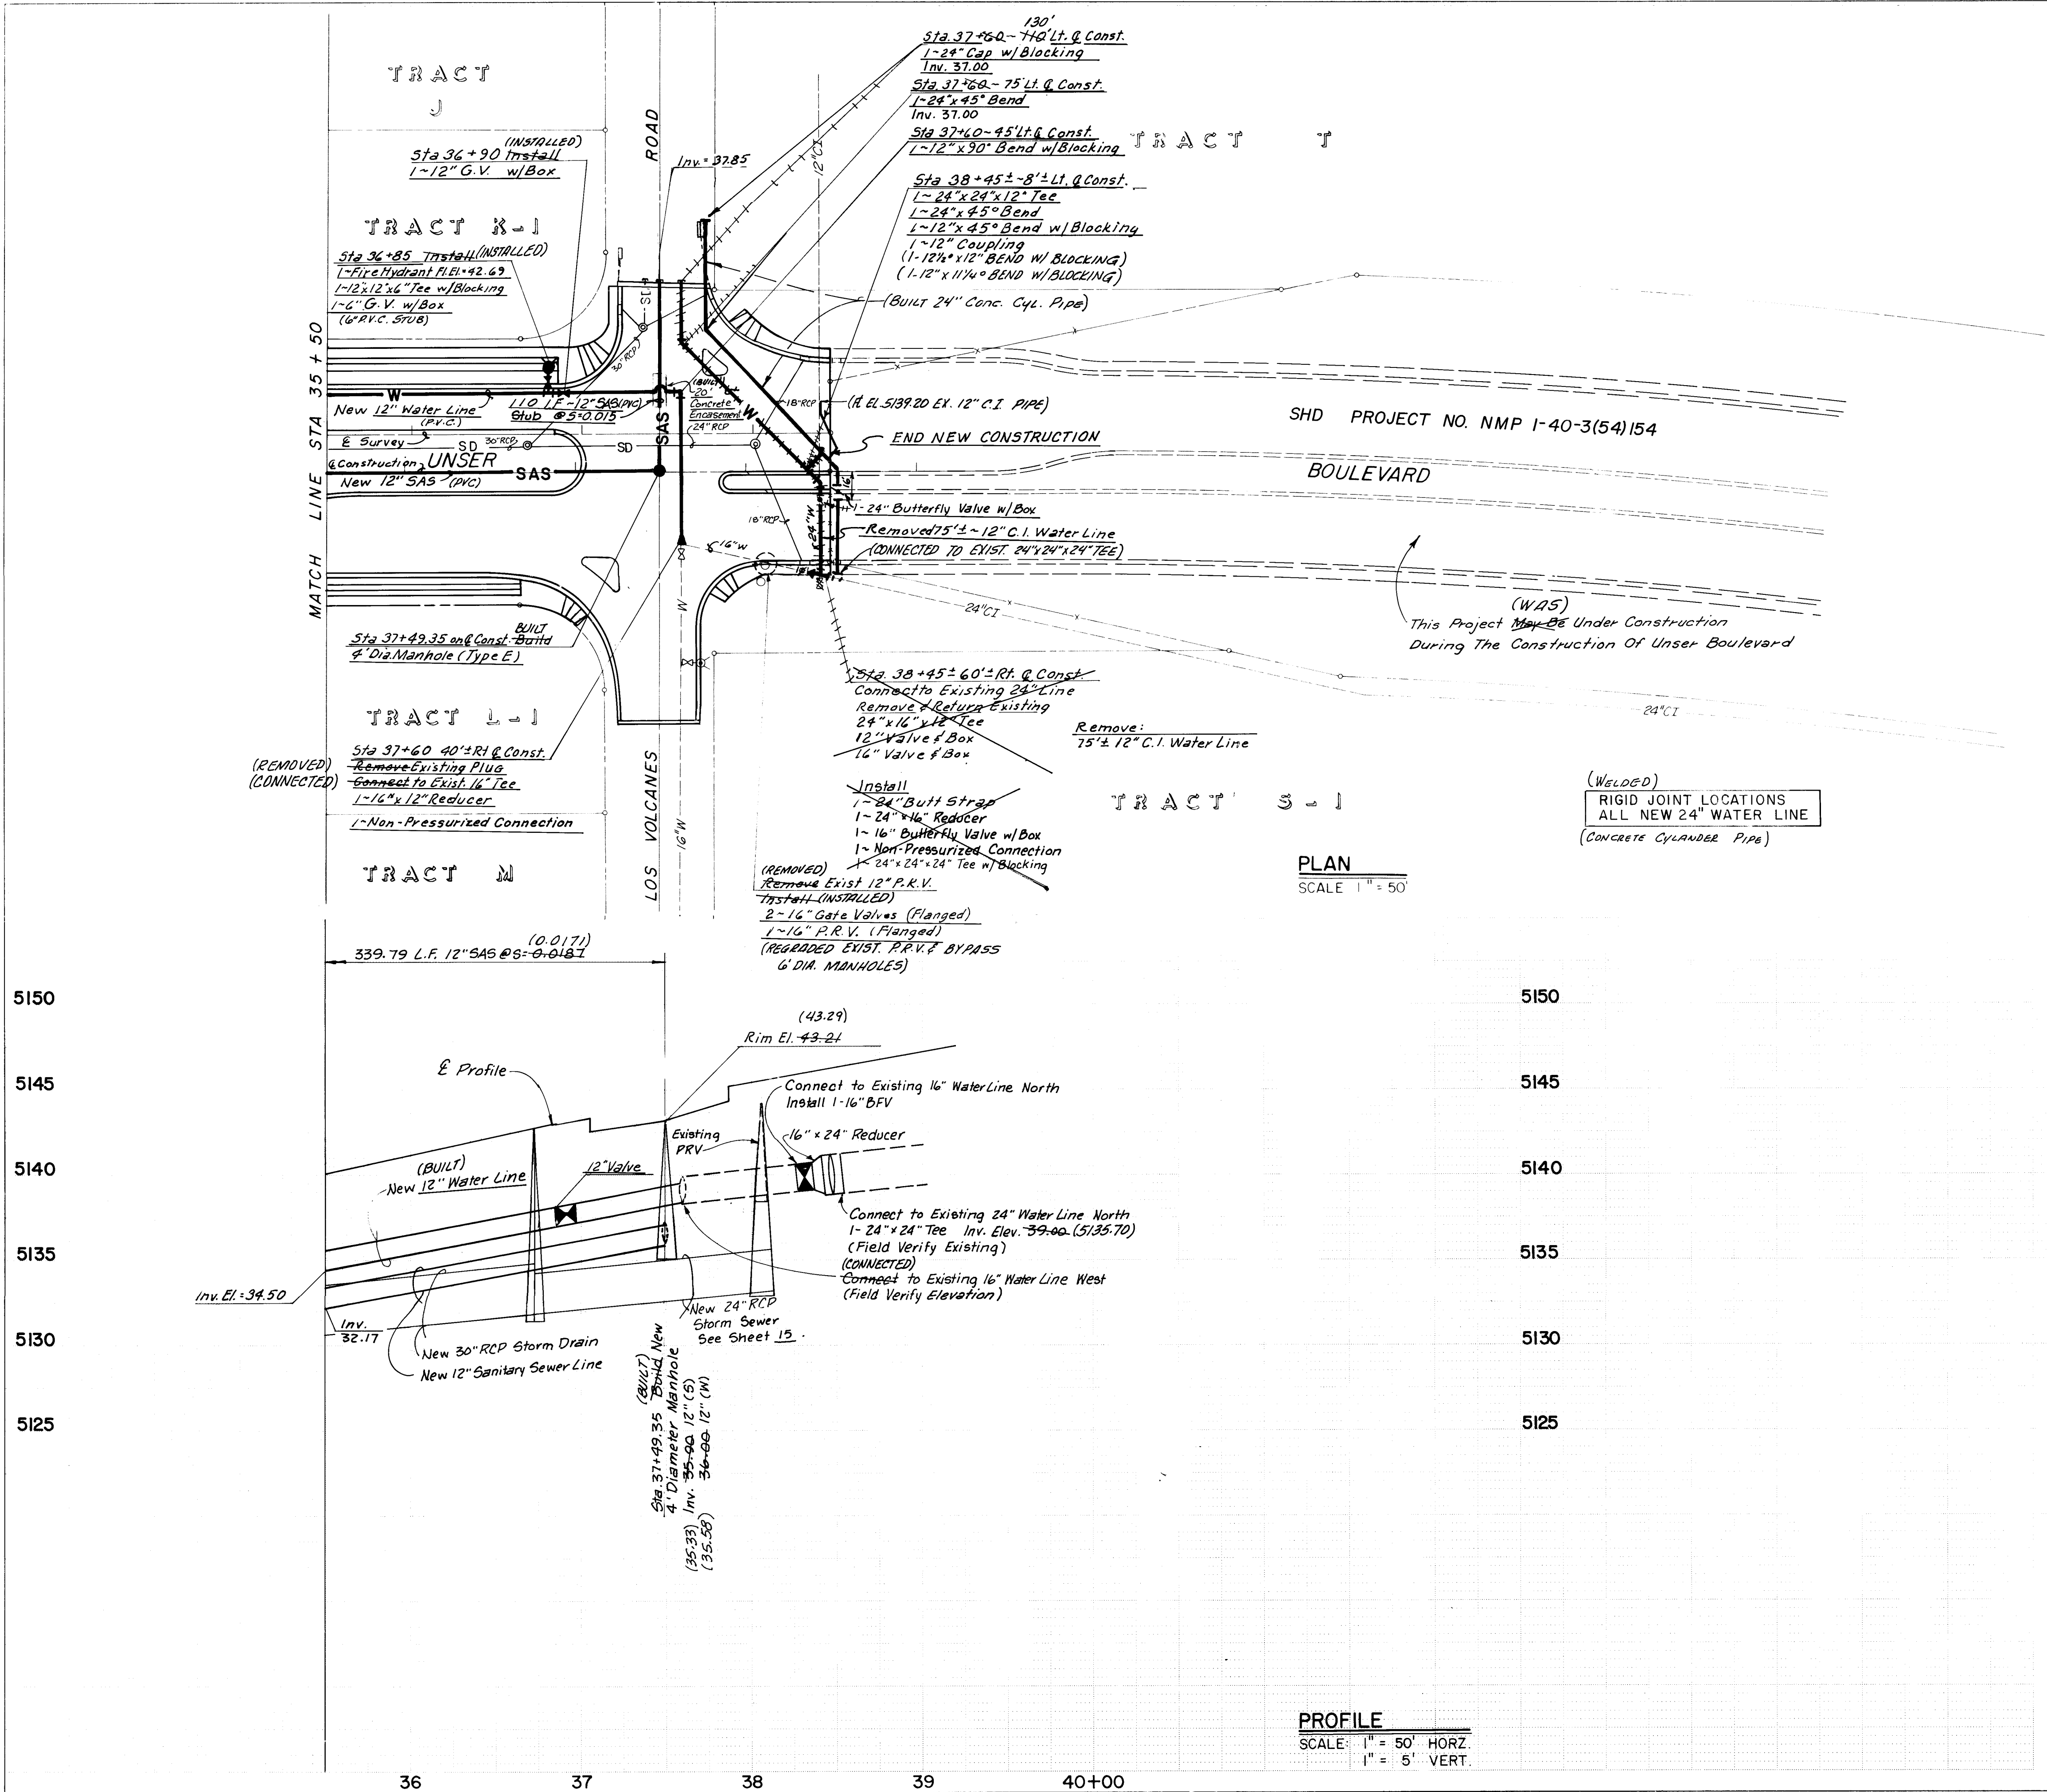


PLANS PREPARED UNDER THE DIRECTION OF			CITY OF ALBUQUERQUE MUNICIPAL DEVELOPMENT DEPARTMENT		
TITLE: SAD-214 USNER BOULEVARD WATER & SEWER - STA. 35+50 TO STA. 39+49.35					
APPROVALS	ENGINEER	DATE	APPROVALS	ENGINEER	DATE
City Engineer	<i>[Signature]</i>		Liquid Waste	<i>[Signature]</i>	1/1/84
A.C.E.-Design	<i>[Signature]</i>		Traffic	<i>[Signature]</i>	1/1/84
A.C.E.-Hydrology	<i>[Signature]</i>	1/1/84	Water	<i>[Signature]</i>	1/1/84
APPROVED FOR CONSTRUCTION <i>[Signature]</i> CITY ENGINEER			DESIGNED BY: A.C. DRAWN BY: D.W. CHECKED BY: C.A.		
DRAWING NO. 1658			SHEET 12 OF 23		

AS BUILT INFORMATION	BENCH MARKS	SURVEY INFORMATION	REFERENCES	REVISIONS	REMARKS	BY	DATE
CONTRACTOR: Bruce Const. Co., Inc. WORK: STAKED BY: Scanlon & Assoc. DATE: 1984 ACCEPTANCE: BY: DATE: 1984 FIELD LAYOUT: BY: Scanlon & Assoc. DATE: 1984 DRAWING: BY: Scanlon & Assoc. DATE: 1984 MICRO-FILM INFORMATION: RECORDED BY: DATE: NO.	I-40-19 NW 1/4 Sec 14 miles SW of the intersection of I-40 and Coors Road in the Median of I-40 - Elev = 5151.197 TBM - NE Corner Bolt in Fire Hydrant at the NE cor. of UNSER & Los Volcanes - Elev = 5142.031	MAP NO. J-9, K-10 EST. NO. W.O. NO. DATE BY NO.					

PLAN	DATE	BY
SURVEYED		
ALIGNED		
CHECKED		
NO.		

PROFILE	DATE	BY
SURVEYED		
GRADES CHECKED		
NO.		

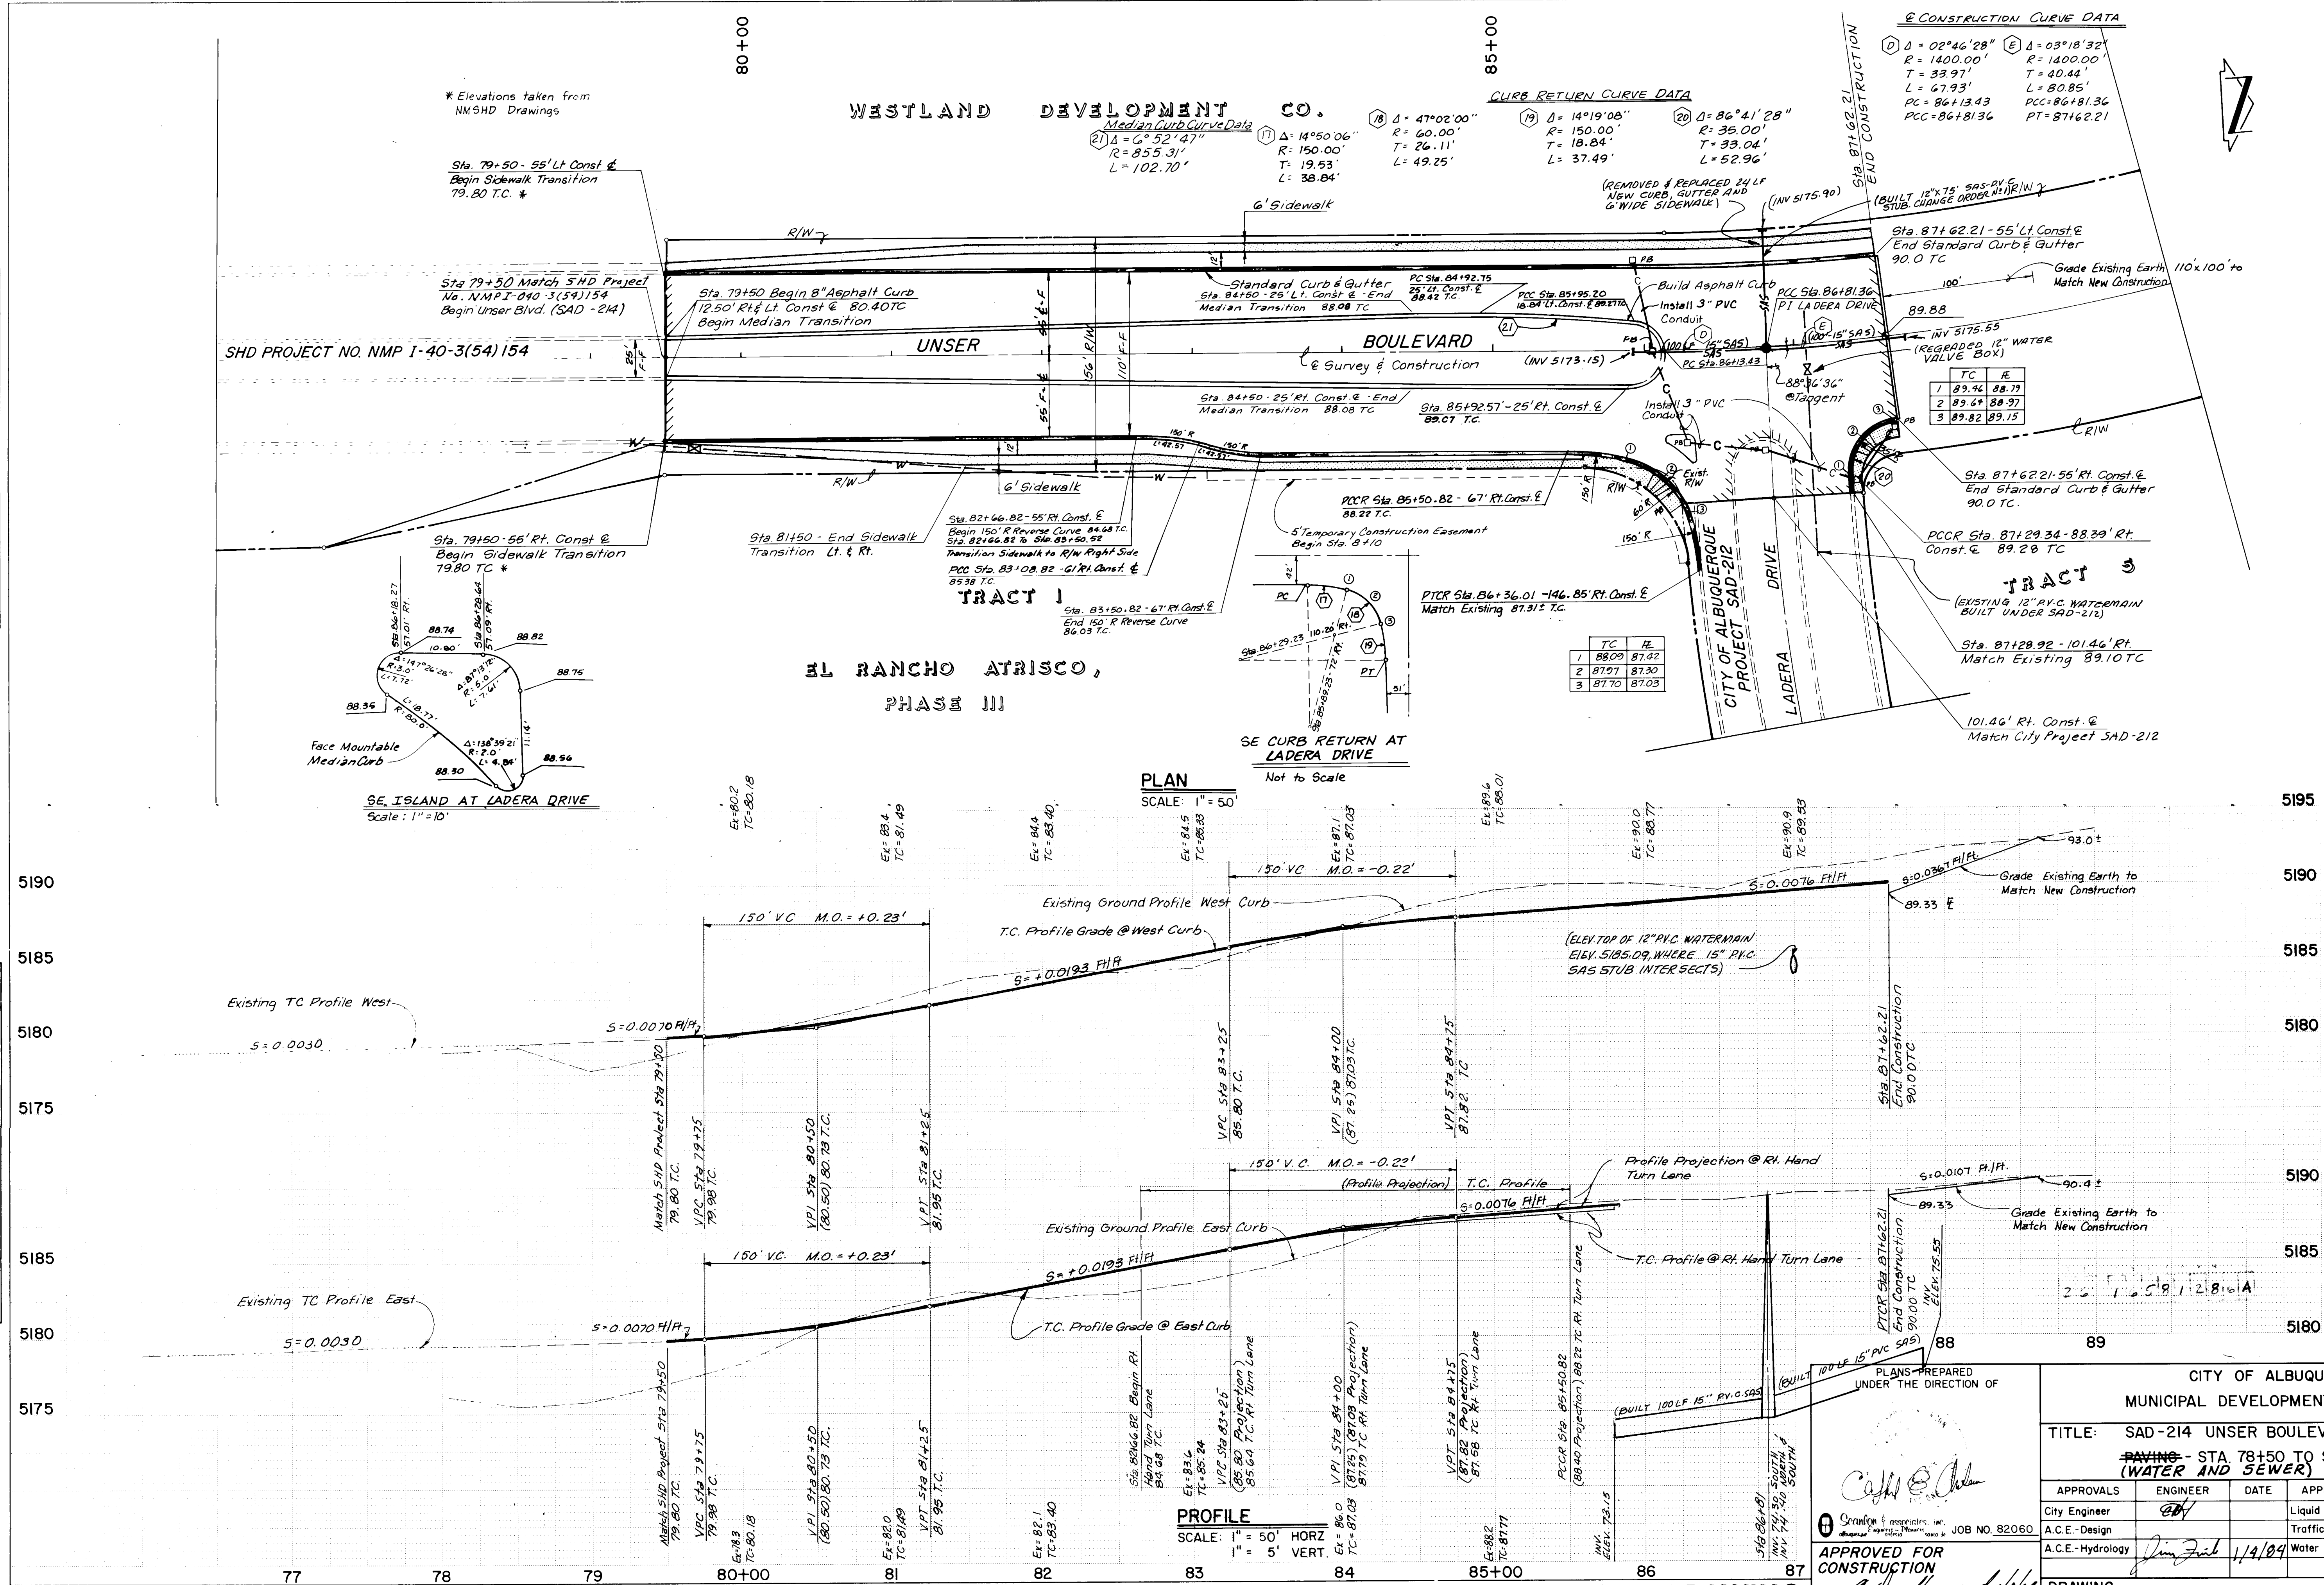


AS BUILT INFORMATION			BENCH MARKS			SURVEY INFORMATION			REFERENCES			REVISIONS		
CONTRACTOR	BRASS CONST. CO. INC.	DATE	1-40-19	1-40-19	1-40-19	MAP NO.	J-9	EST. NO.	W.O. NO.	BY	NO.	DATE	REMARKS	DESIGNED BY
WORK	STANDARD & ASSOC.	DATE	1-40-19	1-40-19	1-40-19									1/4/83
FIELD	BY SCOTT & ASSOC.	DATE	1-40-19	1-40-19	1-40-19									1/4/83
DRAWINGS	BY SCOTT & ASSOC.	DATE	1-40-19	1-40-19	1-40-19									1/4/83
CHECKED	BY SCOTT & ASSOC.	DATE	1-40-19	1-40-19	1-40-19									1/4/83
RECORDED	BY	DATE												1/4/83
NO.														1/4/83

RECORD DRAWING

CITY OF ALBUQUERQUE MUNICIPAL DEVELOPMENT DEPARTMENT			
TITLE: SAD-214 UNSER BOULEVARD PAYING - STA. 78+50 TO STA. 87+62.21 (WATER AND SEWER)			
APPROVALS	ENGINEER	DATE	APPROVALS
City Engineer	1/4/83		Liquid Waste
A.C.E.-Design	1/4/83		Traffic
A.C.E.-Hydrology	1/4/83		Water
DRAWING NO. 1658		SHEET 12A OF 23	

PROFILE		BY	DATE
SURVEYED			
PLOTTED			
GRADES CHECKED			
B. M.'S NOTED			
STRUCTURE NOTATIONS CHKD			
NO.			

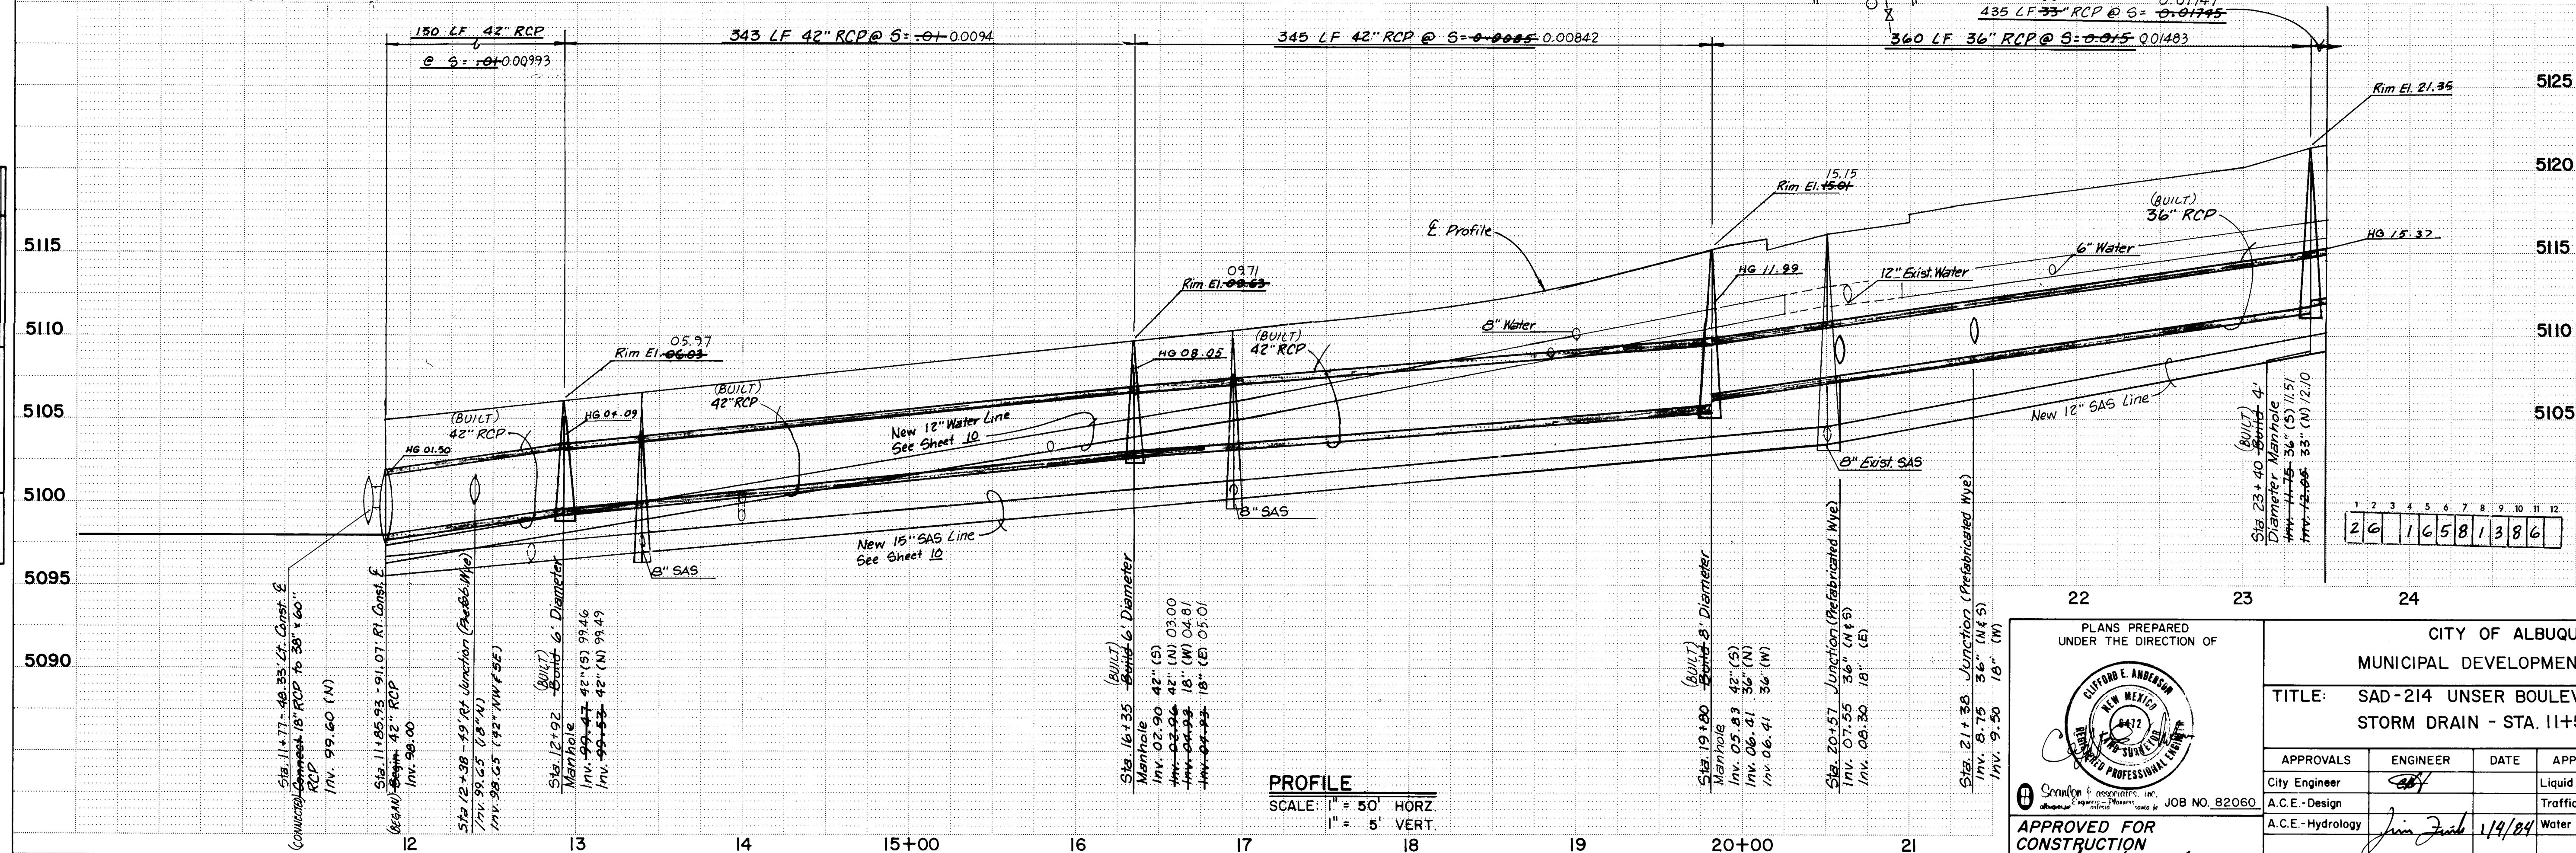

NOTE: WHERE STORM SEWERS CROSS OVER WATER AND SANITARY SEWER LINES WITH LESS THAN ONE (1) FOOT OF CLEARANCE, A MINIMUM OF 6 INCHES OF ELASTOMERIC MATERIAL MUST BE PLACED BETWEEN PIPES. THE MATERIAL MUST COMPLETELY COVER THE LOWER PIPE. ABSOLUTE MINIMUM CLEARANCE BETWEEN TWO PIPES CROSSING WILL BE 6 INCHES.


PLAN **PIPE**
WILL

SCALE: 1" = 50'

RECORD DRAWING

PLANS PREPARED UNDER THE DIRECTION OF  Seal of the State of New Mexico Professional Engineer Clifford E. Anderson No. 8432 Civil Engineering	CITY OF ALBUQUERQUE MUNICIPAL DEVELOPMENT DEPARTMENT TITLE: SAD-214 UNSER BOULEVARD STORM DRAIN - STA. 11+50 TO STA. 23+50																								
APPROVED FOR CONSTRUCTION <i>a. d. Anderson</i> 1/14/84 CITY ENGINEER DATE	<table border="1" style="width: 100%; border-collapse: collapse;"> <thead> <tr> <th style="width: 33%;">APPROVALS</th> <th style="width: 33%;">ENGINEER</th> <th style="width: 33%;">DATE</th> </tr> </thead> <tbody> <tr> <td>City Engineer</td> <td><i>SBH</i></td> <td></td> </tr> <tr> <td>A.C.E. - Design</td> <td></td> <td></td> </tr> <tr> <td>A.C.E. - Hydrology</td> <td><i>Jim Zurek</i></td> <td>1/14/84</td> </tr> </tbody> </table> <table border="1" style="width: 100%; border-collapse: collapse;"> <thead> <tr> <th style="width: 33%;">APPROVALS</th> <th style="width: 33%;">ENGINEER</th> <th style="width: 33%;">DATE</th> </tr> </thead> <tbody> <tr> <td>Liquid Waste</td> <td><i>NA James J.</i></td> <td>1/14/84</td> </tr> <tr> <td>Traffic</td> <td><i>NA</i></td> <td>1/14/84</td> </tr> <tr> <td>Water</td> <td><i>NA James J.</i></td> <td>1/14/84</td> </tr> </tbody> </table>	APPROVALS	ENGINEER	DATE	City Engineer	<i>SBH</i>		A.C.E. - Design			A.C.E. - Hydrology	<i>Jim Zurek</i>	1/14/84	APPROVALS	ENGINEER	DATE	Liquid Waste	<i>NA James J.</i>	1/14/84	Traffic	<i>NA</i>	1/14/84	Water	<i>NA James J.</i>	1/14/84
APPROVALS	ENGINEER	DATE																							
City Engineer	<i>SBH</i>																								
A.C.E. - Design																									
A.C.E. - Hydrology	<i>Jim Zurek</i>	1/14/84																							
APPROVALS	ENGINEER	DATE																							
Liquid Waste	<i>NA James J.</i>	1/14/84																							
Traffic	<i>NA</i>	1/14/84																							
Water	<i>NA James J.</i>	1/14/84																							
DRAWING NO. 1658 SHEET 13 OF 23																									




PROFILE		BY	DATE
SURVEYED			
PLOTTED			
GRADES CHECKED			
B. M.'S NOTED			
STRUCTURE NOTATIONS CHKD			

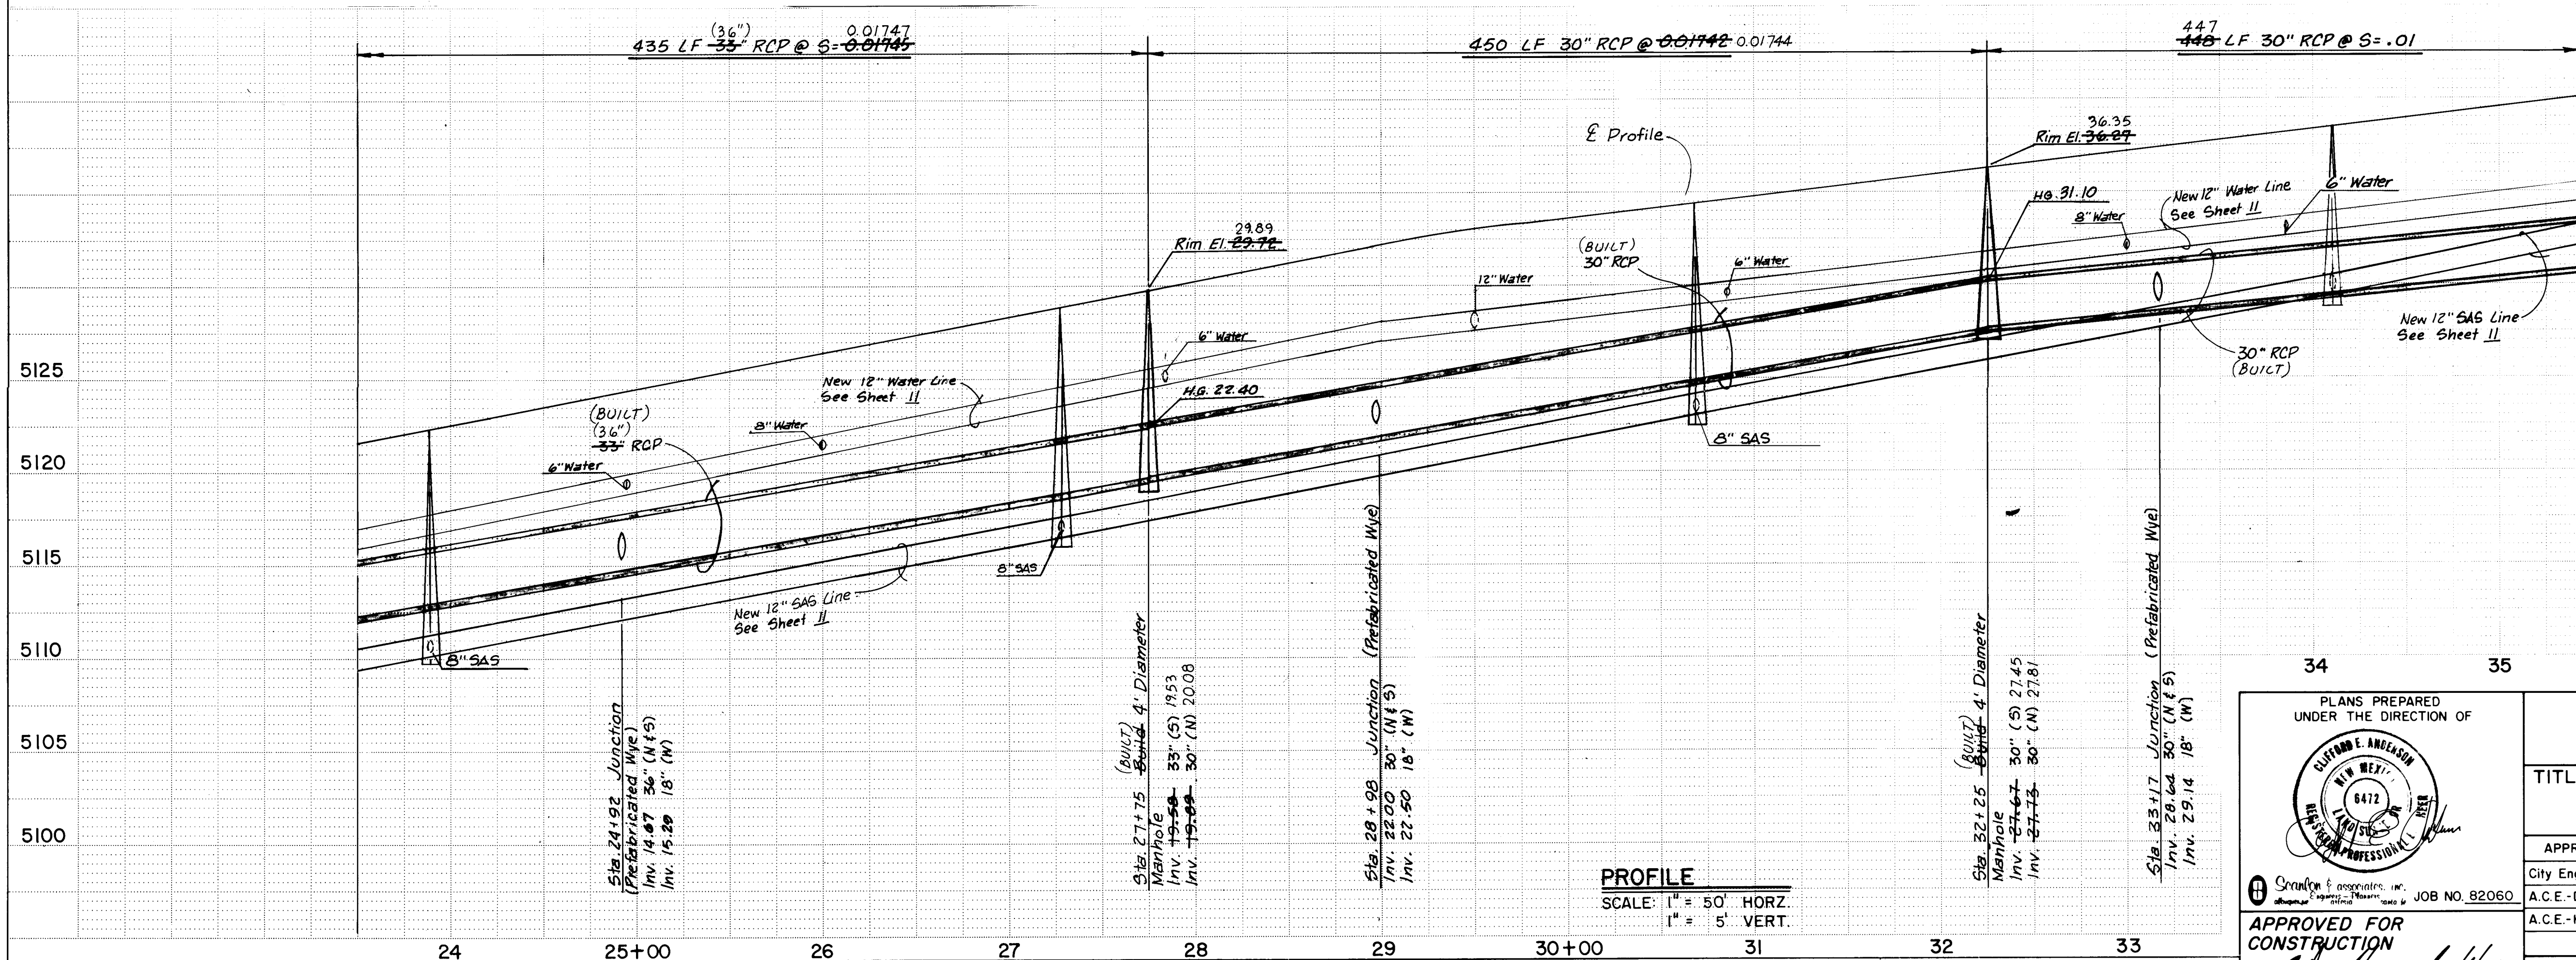

RECORD DRAWING


PLANS PREPARED UNDER THE DIRECTION OF		CITY OF ALBUQUERQUE MUNICIPAL DEVELOPMENT DEPARTMENT																									
		TITLE: SAD-214 UNSER BOULEVARD STORM DRAIN - STA. 23+50 TO STA. 35+50																									
APPROVED FOR CONSTRUCTION <i>C.E. Shapard</i> 1/4/84	CITY ENGINEER DATE	<table border="1" style="width: 100%; border-collapse: collapse;"> <tr> <th style="width: 33%;">APPROVALS</th> <th style="width: 33%;">ENGINEER</th> <th style="width: 33%;">DATE</th> </tr> <tr> <td style="padding: 5px;">City Engineer</td> <td style="padding: 5px;"><i>SPV</i></td> <td style="padding: 5px;"></td> </tr> <tr> <td style="padding: 5px;">A.C.E.-Design</td> <td style="padding: 5px;"></td> <td style="padding: 5px;"></td> </tr> <tr> <td style="padding: 5px;">A.C.E.-Hydrology</td> <td style="padding: 5px;"><i>John Smith</i></td> <td style="padding: 5px;">1/4/84</td> </tr> </table>	APPROVALS	ENGINEER	DATE	City Engineer	<i>SPV</i>		A.C.E.-Design			A.C.E.-Hydrology	<i>John Smith</i>	1/4/84	<table border="1" style="width: 100%; border-collapse: collapse;"> <tr> <th style="width: 33%;">APPROVALS</th> <th style="width: 33%;">ENGINEER</th> <th style="width: 33%;">DATE</th> </tr> <tr> <td style="padding: 5px;">Liquid Waste</td> <td style="padding: 5px;">NA <i>James J.</i></td> <td style="padding: 5px;">1/4/84</td> </tr> <tr> <td style="padding: 5px;">Traffic</td> <td style="padding: 5px;">NA <i>James J.</i></td> <td style="padding: 5px;">1/4/84</td> </tr> <tr> <td style="padding: 5px;">Water</td> <td style="padding: 5px;">NA <i>James J.</i></td> <td style="padding: 5px;">1/4/84</td> </tr> </table>	APPROVALS	ENGINEER	DATE	Liquid Waste	NA <i>James J.</i>	1/4/84	Traffic	NA <i>James J.</i>	1/4/84	Water	NA <i>James J.</i>	1/4/84
APPROVALS	ENGINEER	DATE																									
City Engineer	<i>SPV</i>																										
A.C.E.-Design																											
A.C.E.-Hydrology	<i>John Smith</i>	1/4/84																									
APPROVALS	ENGINEER	DATE																									
Liquid Waste	NA <i>James J.</i>	1/4/84																									
Traffic	NA <i>James J.</i>	1/4/84																									
Water	NA <i>James J.</i>	1/4/84																									
DRAWING NO. 1658		SHEET 14 OF 23																									


PROFILE NOTE BOOK NO. _____	SURVIVED	BY	DATE
	PLOTTED		
	GRADES CHECKED		
	B. M.'S NOTED		
	STRUCTURE NOTATIONS CHECKED		

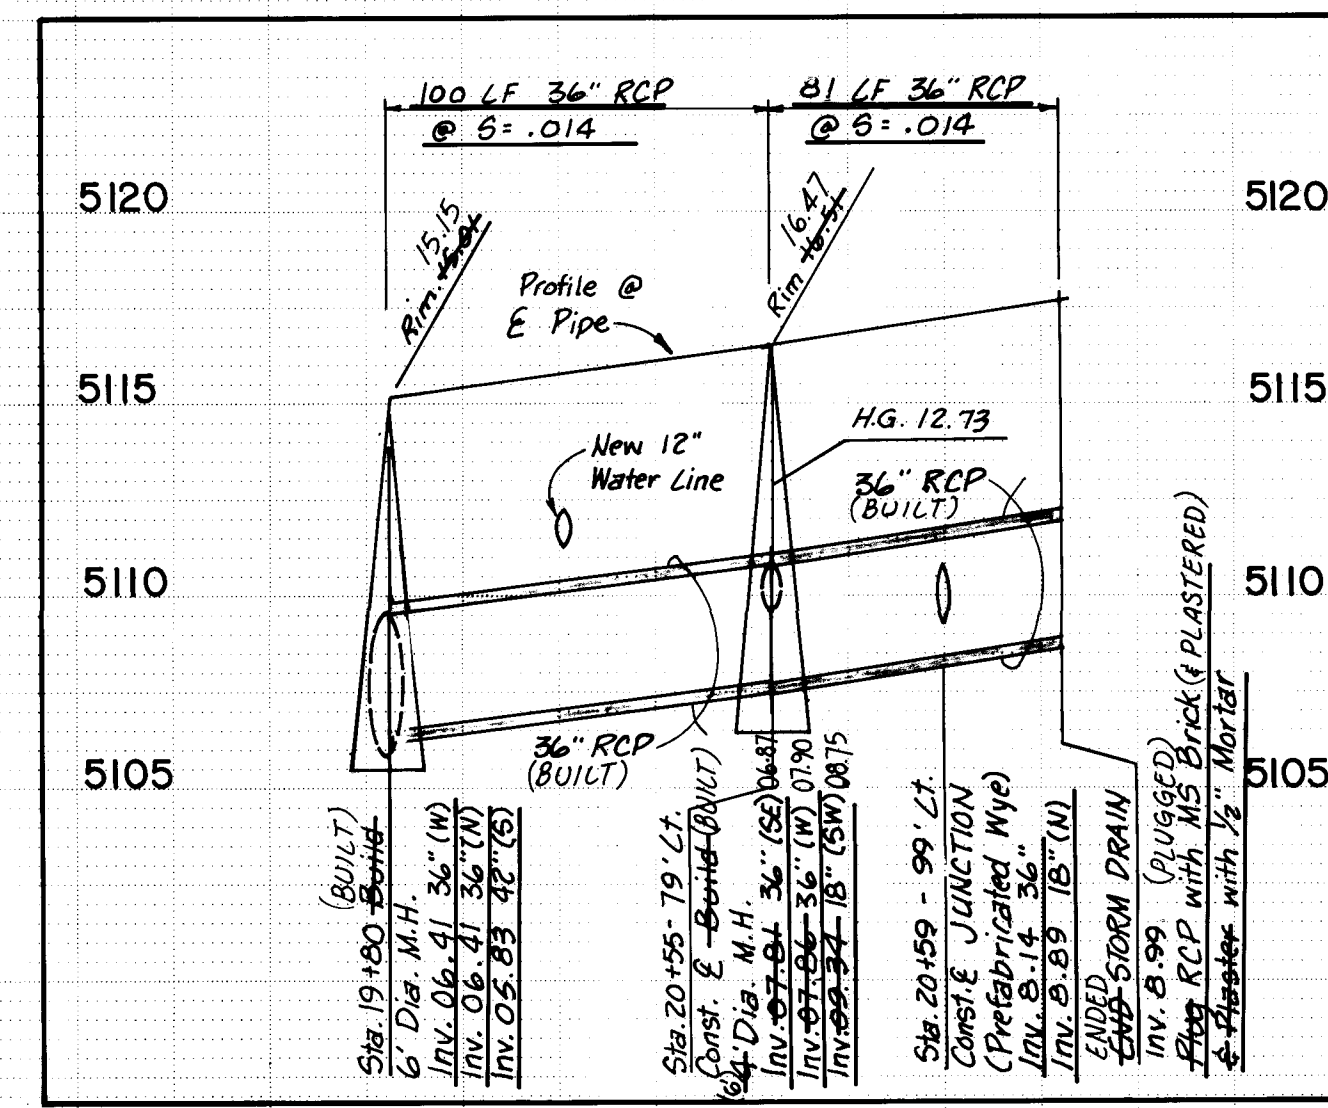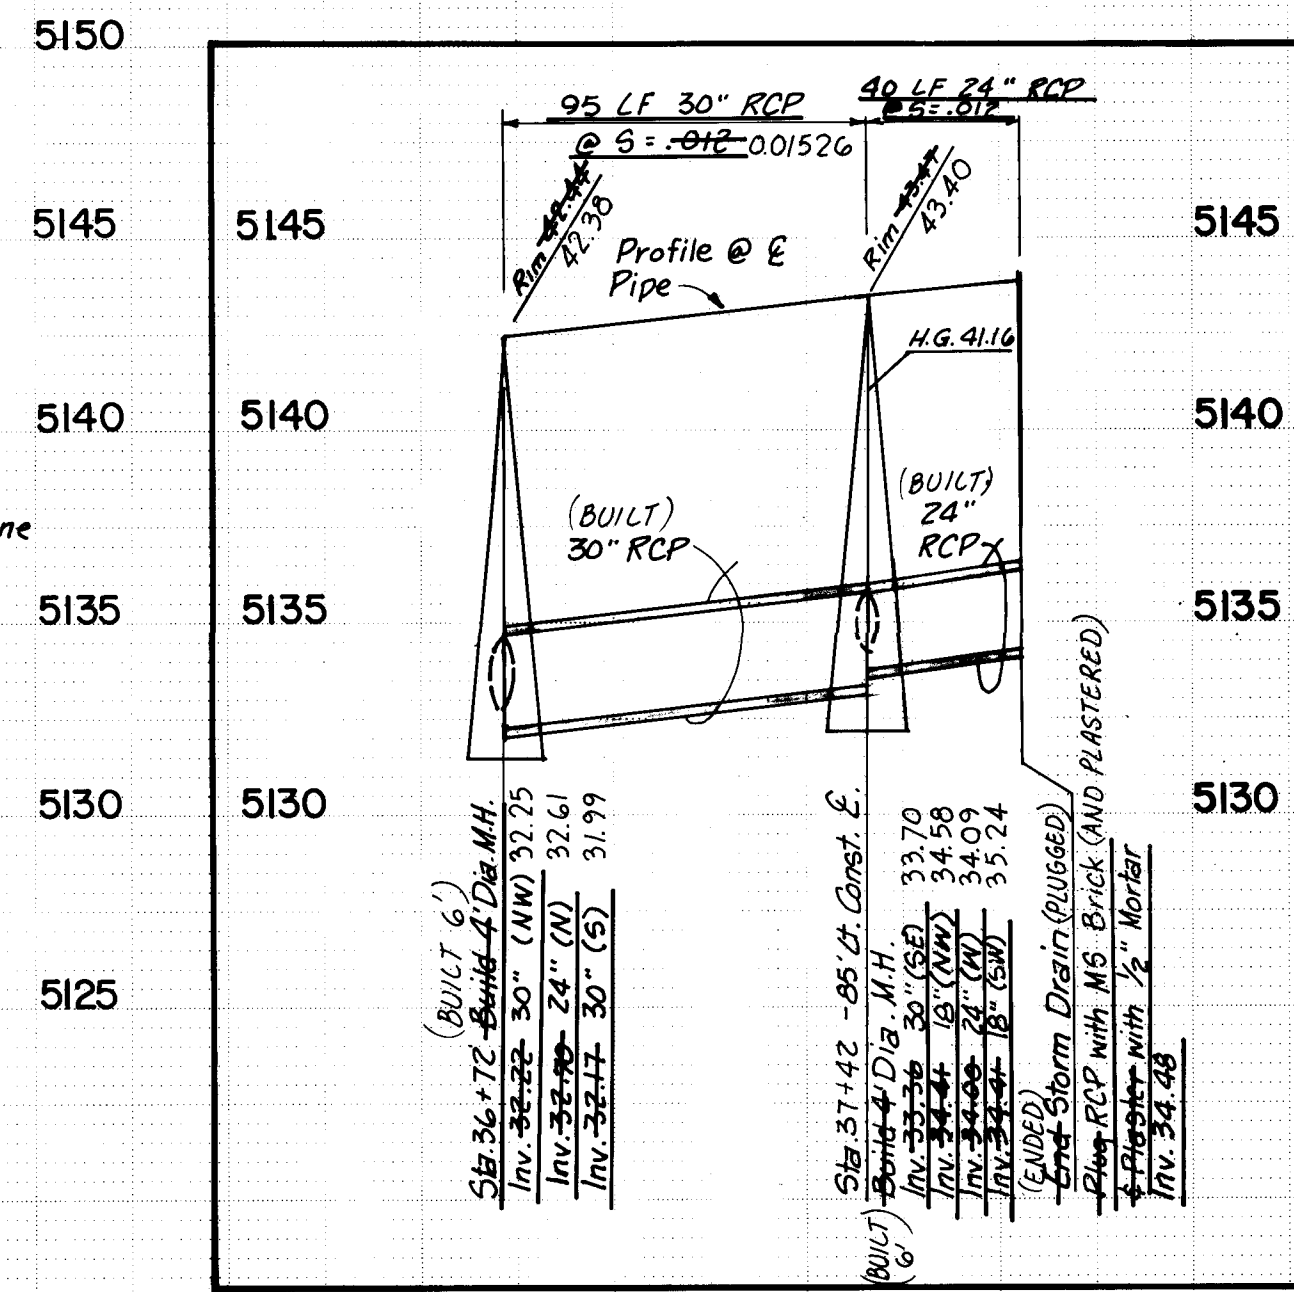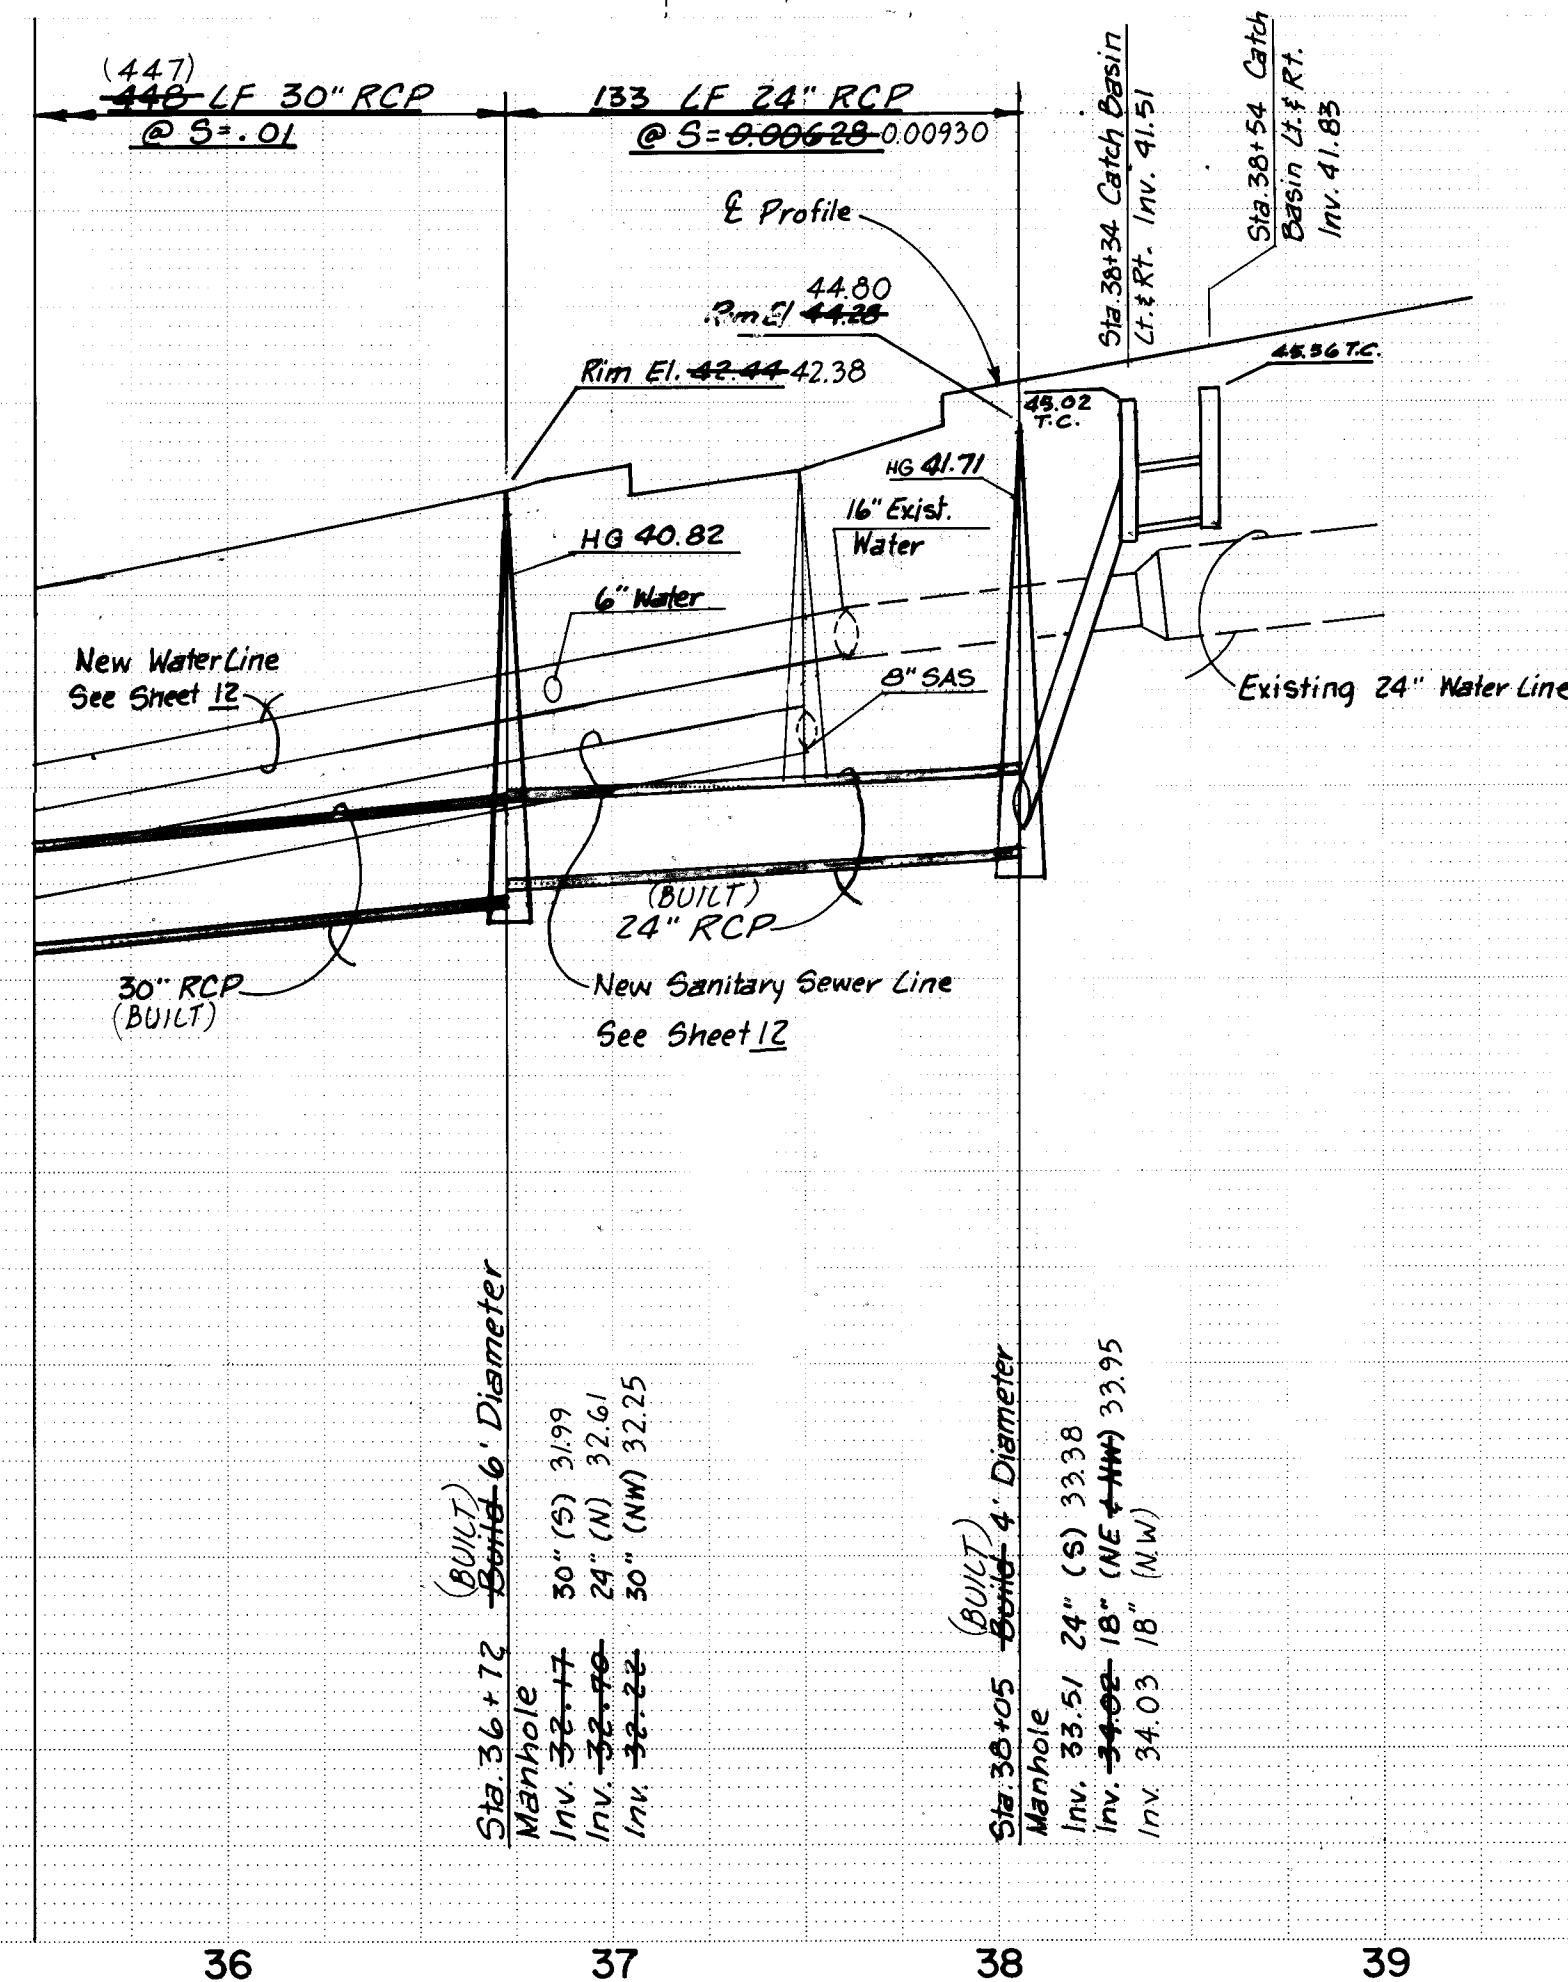[illegible]


RECORD DRAWING

PROFILE		BY	DATE
SURVEYED			
PLOTTED			
GRADES CHECKED			
B. M.'S NOTED			
STRUCTURE NOTATIONS CHK'D			
NOTE BOOK			
NO.			

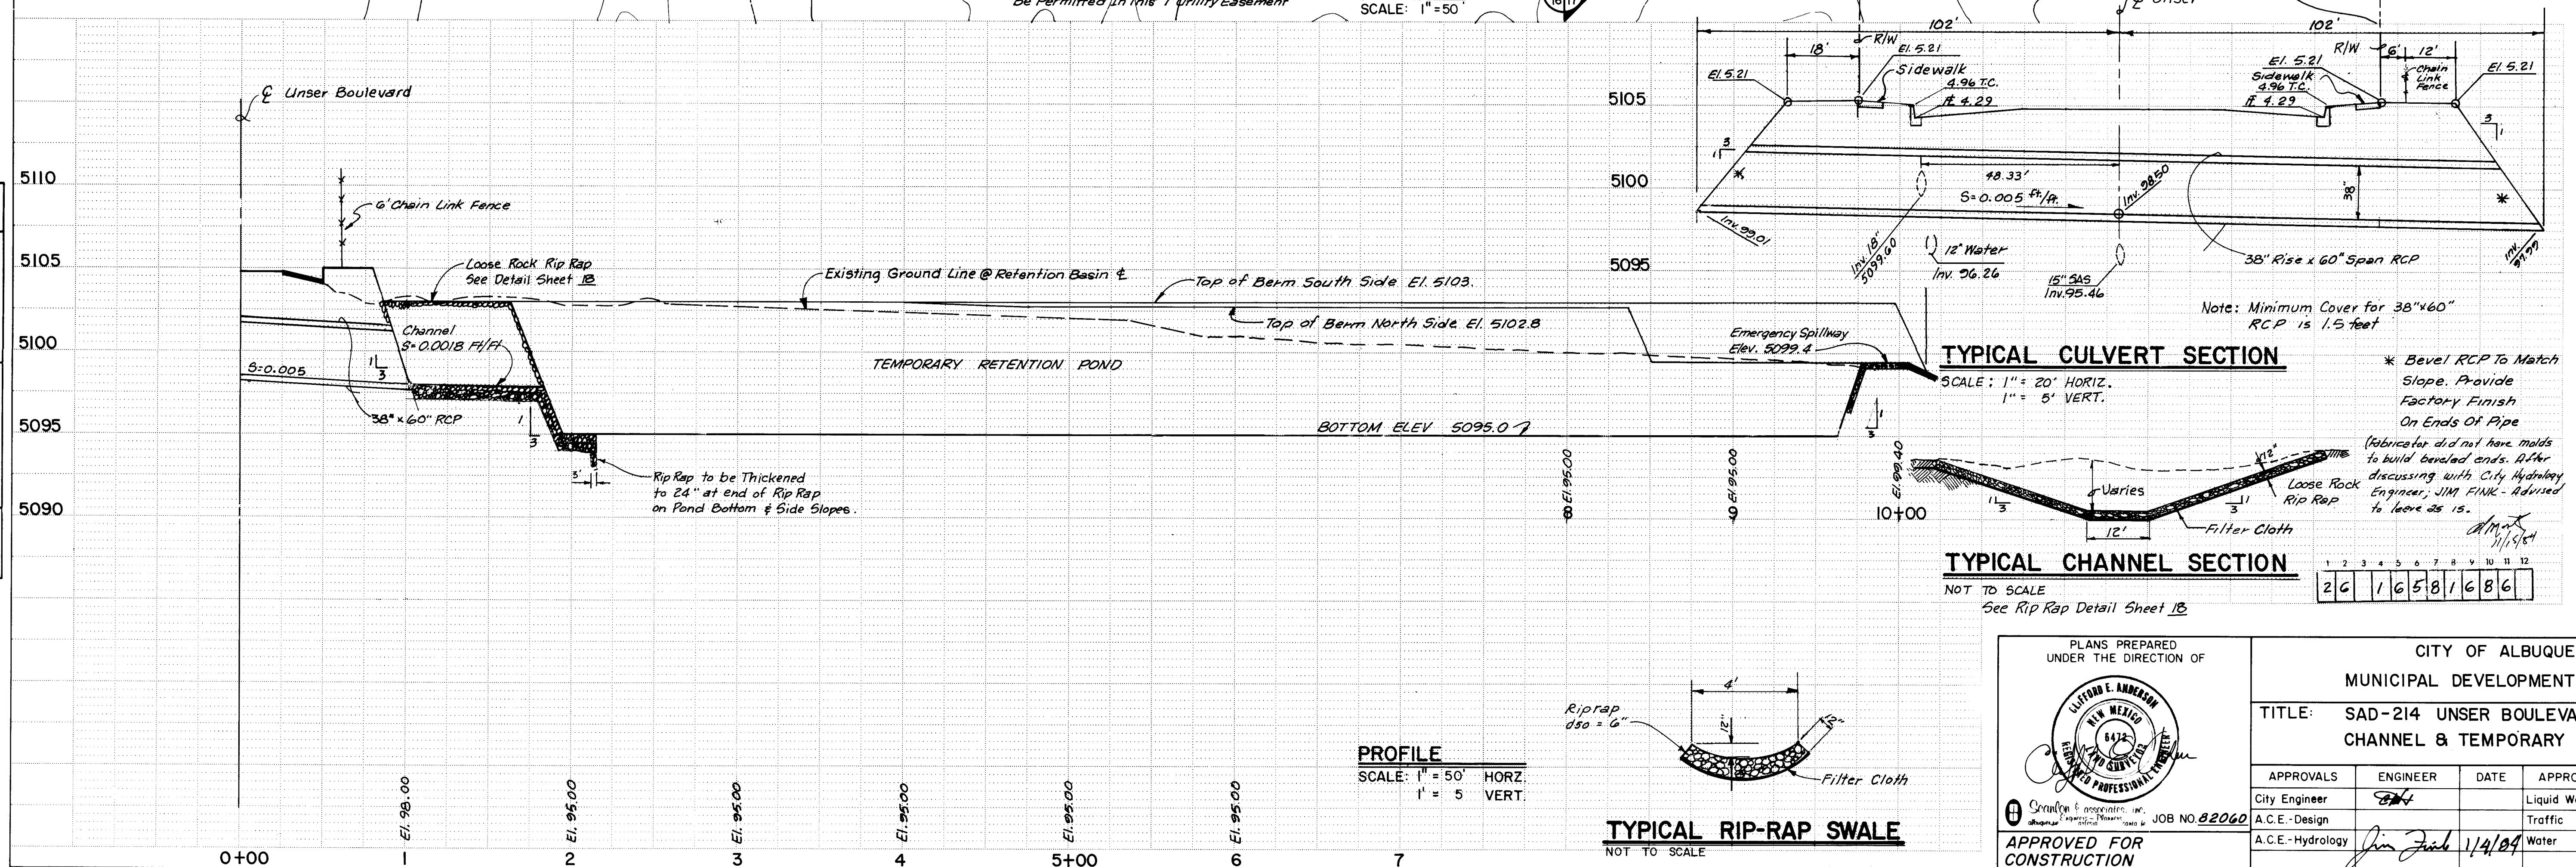[illegible]

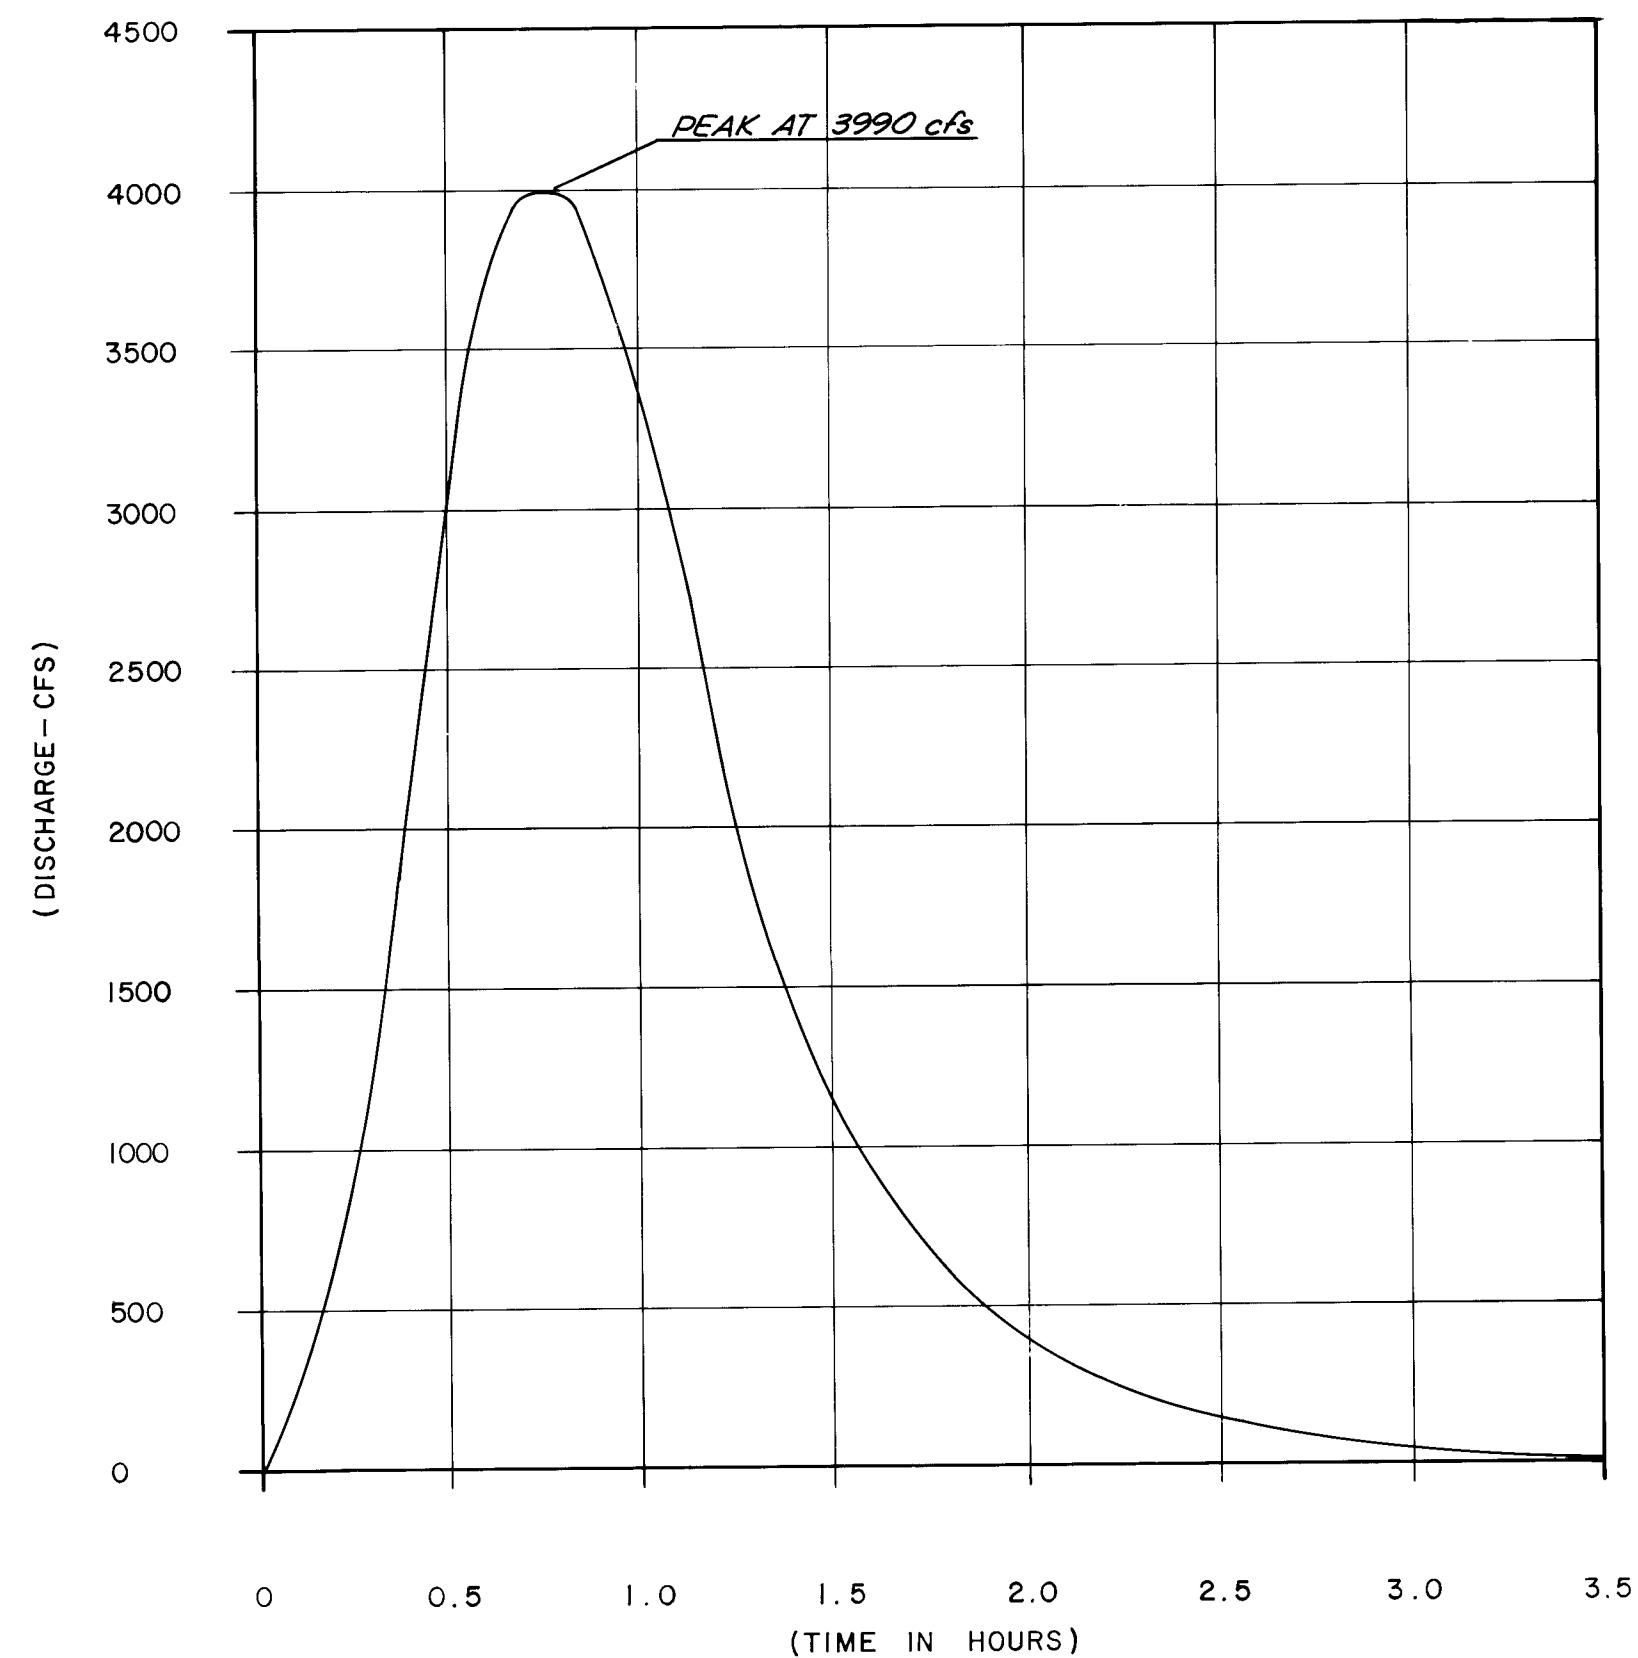


PMF HYDROGRAPH 6 HOUR THUNDERSTORM

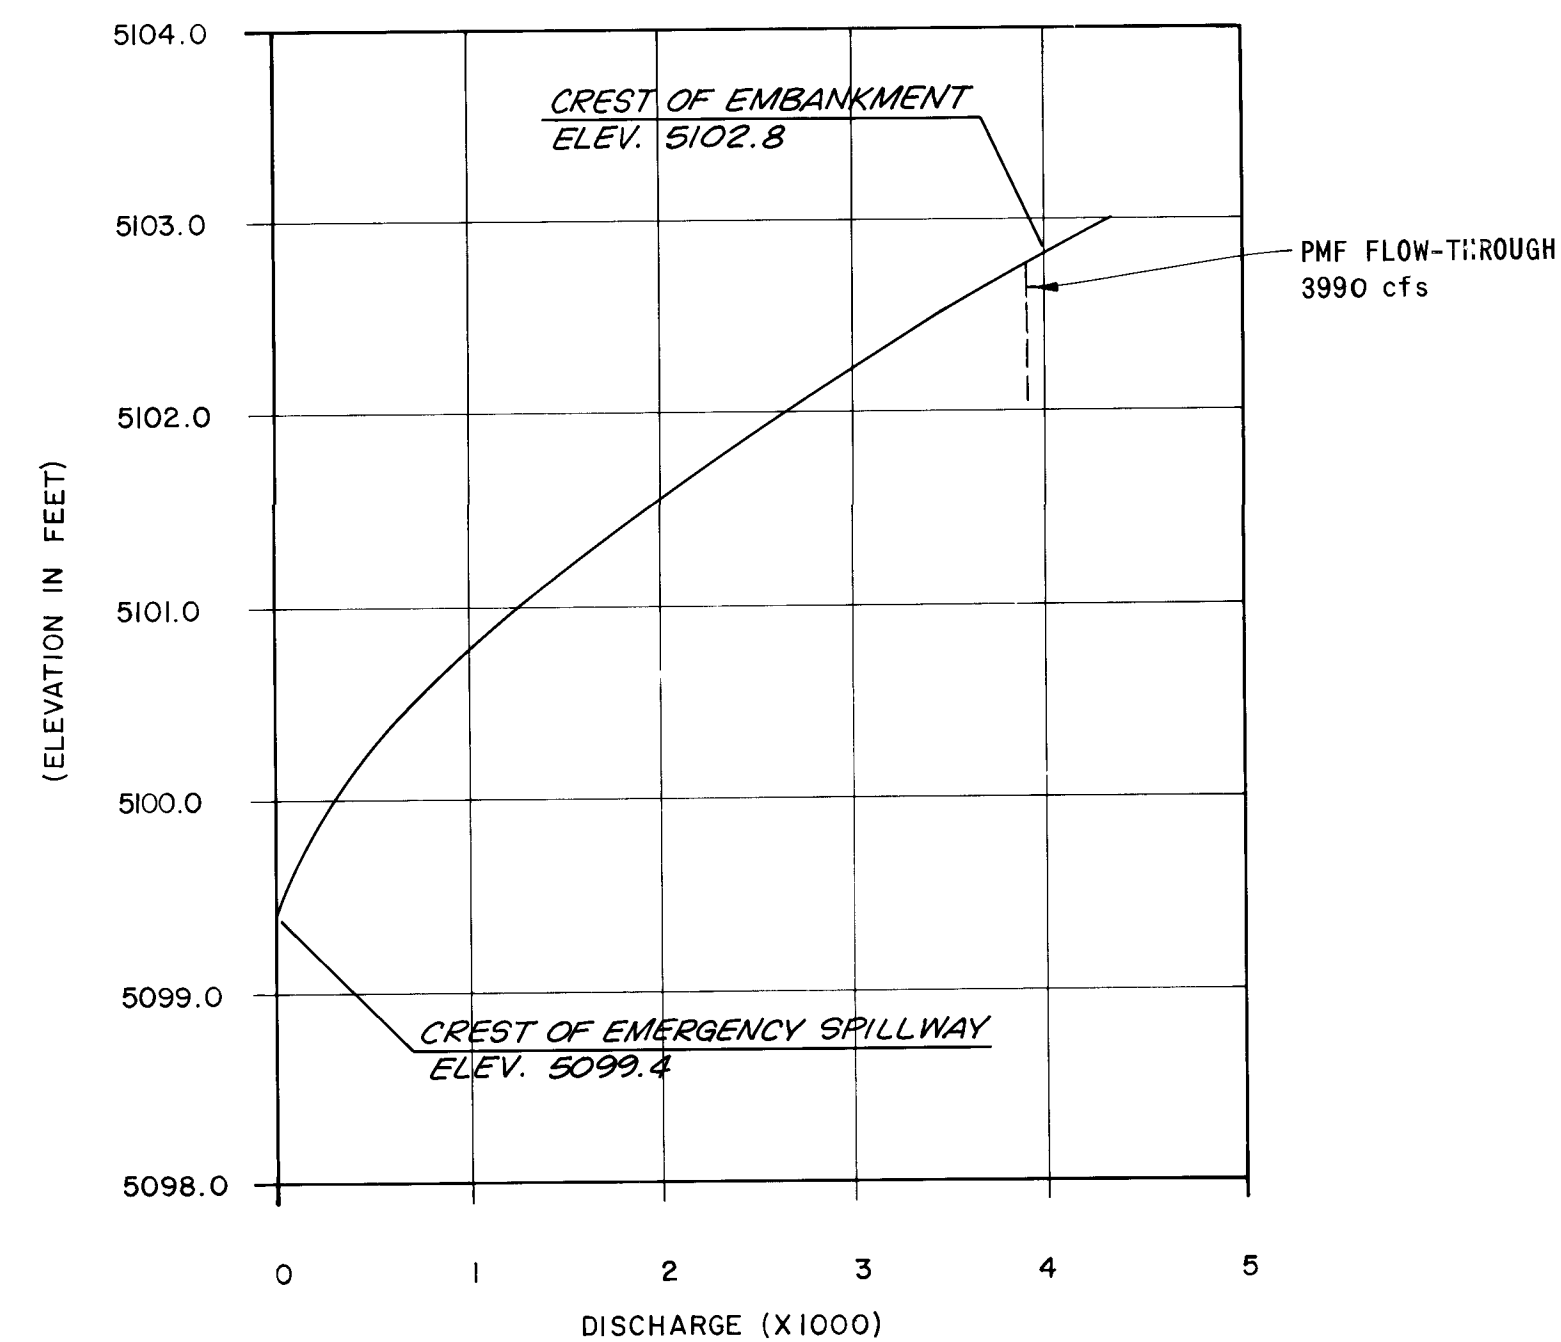

EMERGENCY SPILLWAY DISCHARGE CURVE


TEMPORARY RETENTION POND STORAGE DATA		
ELEVATION (FT)	AREA (ACRES)	ACCUM.STORAGE (ACRE - FEET)
5095.0	1.883	1.946
5096.0	2.010	4.0202
5097.0	2.139	6.224
5098.0	2.269	8.559
5099.0	2.401	9.528
5099.4 ELEV. OF EMERGENCY SPILLWAY	2.445	

NOTE: 100 YEAR - 24 HOUR DESIGN STORM
REQUIRES 9.18 ACRE- FEET STORAGE

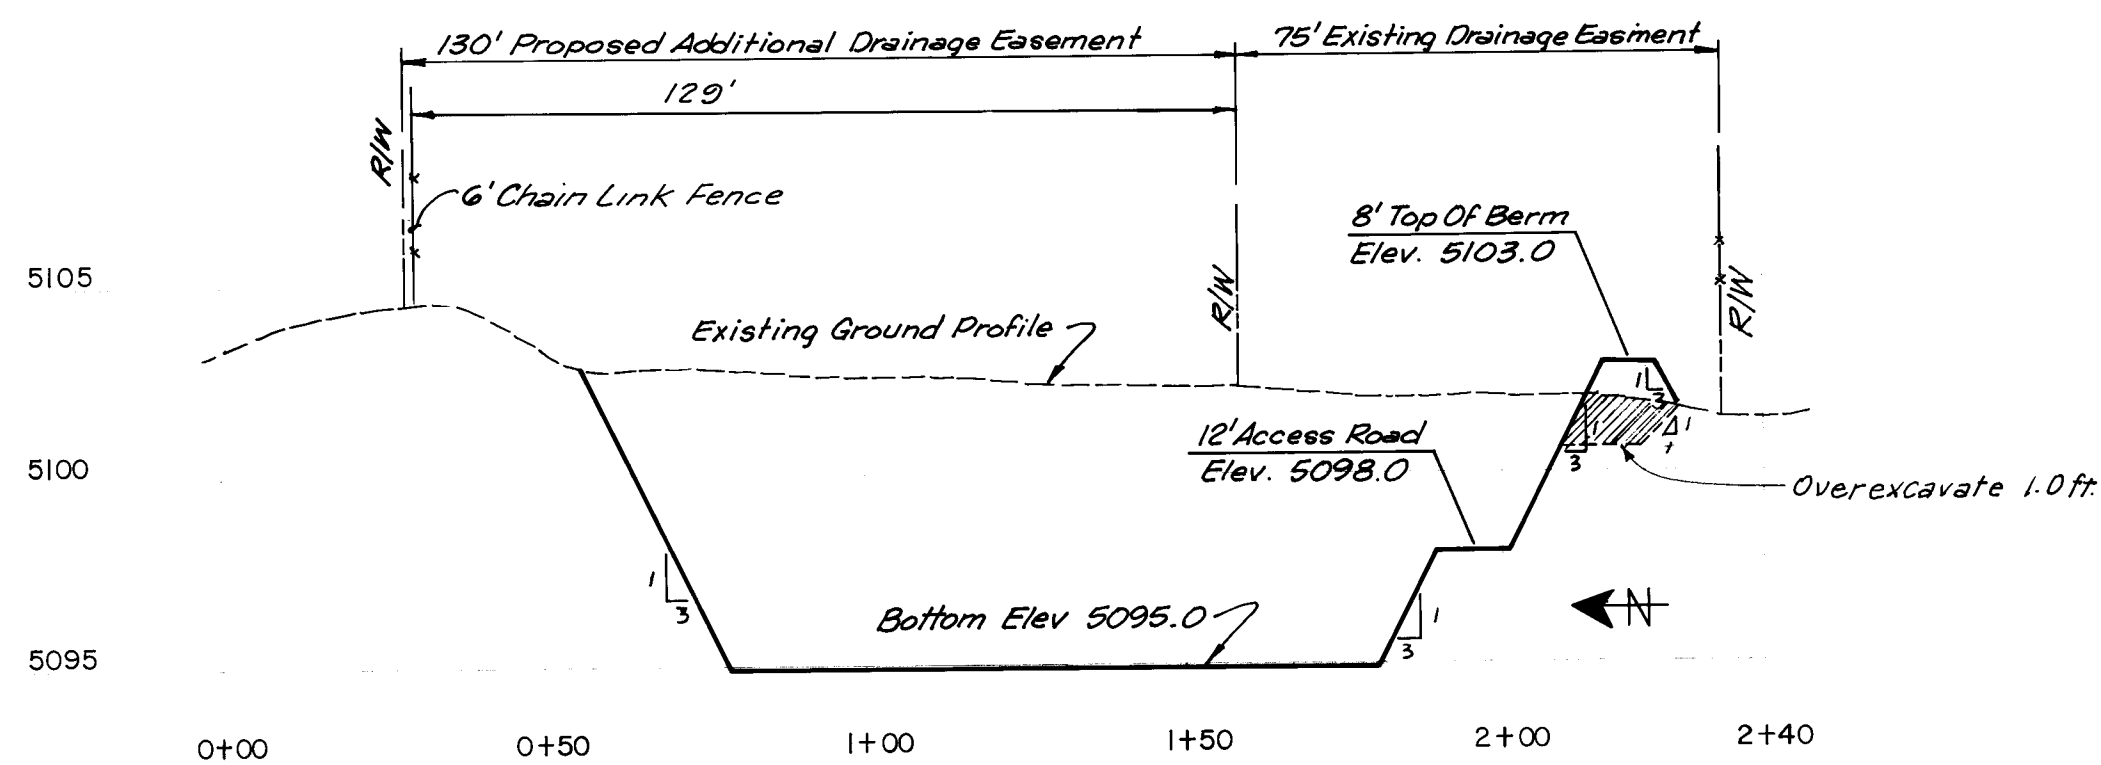

SECTION A-A
SCALE: 1" = 30' HORIZ.
1" = 5' VERT.

NOTE:
Compact Earth Berms to 95%
Maximum Density ASTM - D 1557










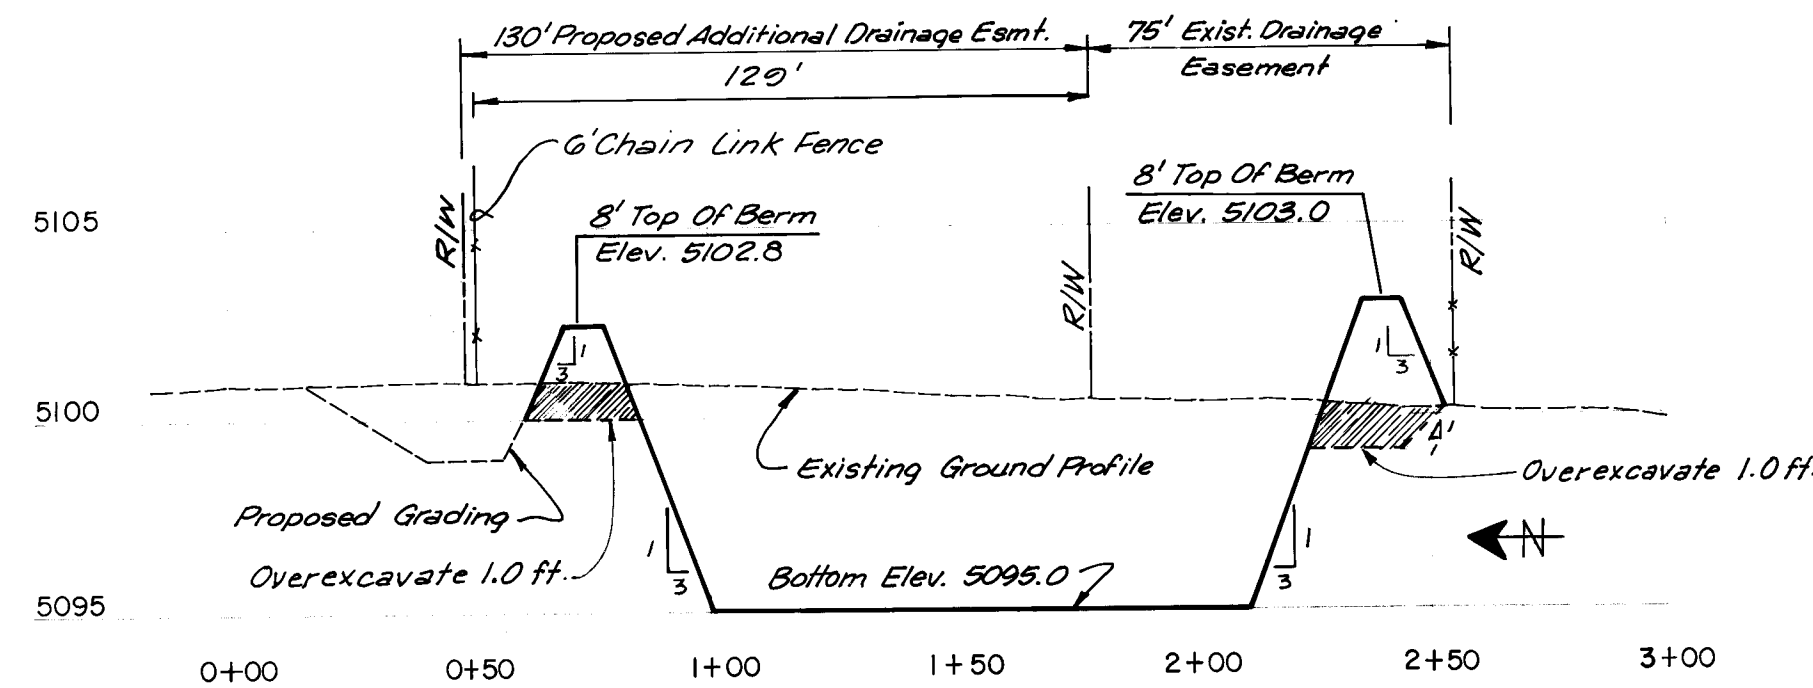



SECTION C-C
SCALE: 1" = 40' HORIZ.
1" = 5' VERT.

26 16581786

RECORD DRAWING

PLANS PREPARED UNDER THE DIRECTION OF		CITY OF ALBUQUERQUE MUNICIPAL DEVELOPMENT DEPARTMENT			
TITLE: SAD-214 UNSER BOULEVARD TEMPORARY RETENTION POND DETAILS					
APPROVALS	ENGINEER	DATE	APPROVALS	ENGINEER	DATE
City Engineer	<i>[Signature]</i>		Liquid Waste	NA <i>[Signature]</i>	1/4/04
A.C.E. - Design			Traffic	NA <i>[Signature]</i>	1/4/04
A.C.E. - Hydrology	<i>[Signature]</i>	1/4/04	Water	NA <i>[Signature]</i>	1/4/04
APPROVED FOR CONSTRUCTION <i>[Signature]</i> CITY ENGINEER		DATE 1/4/04			
DRAWING NO. 1658		SHEET 17 OF 23			

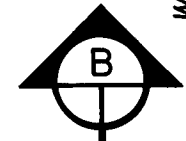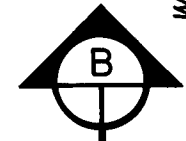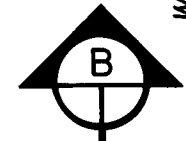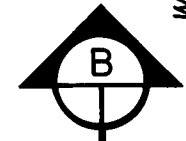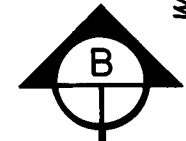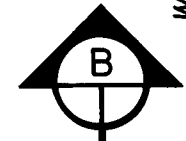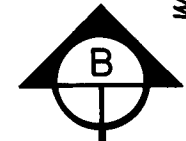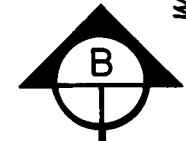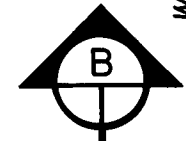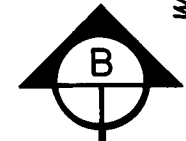


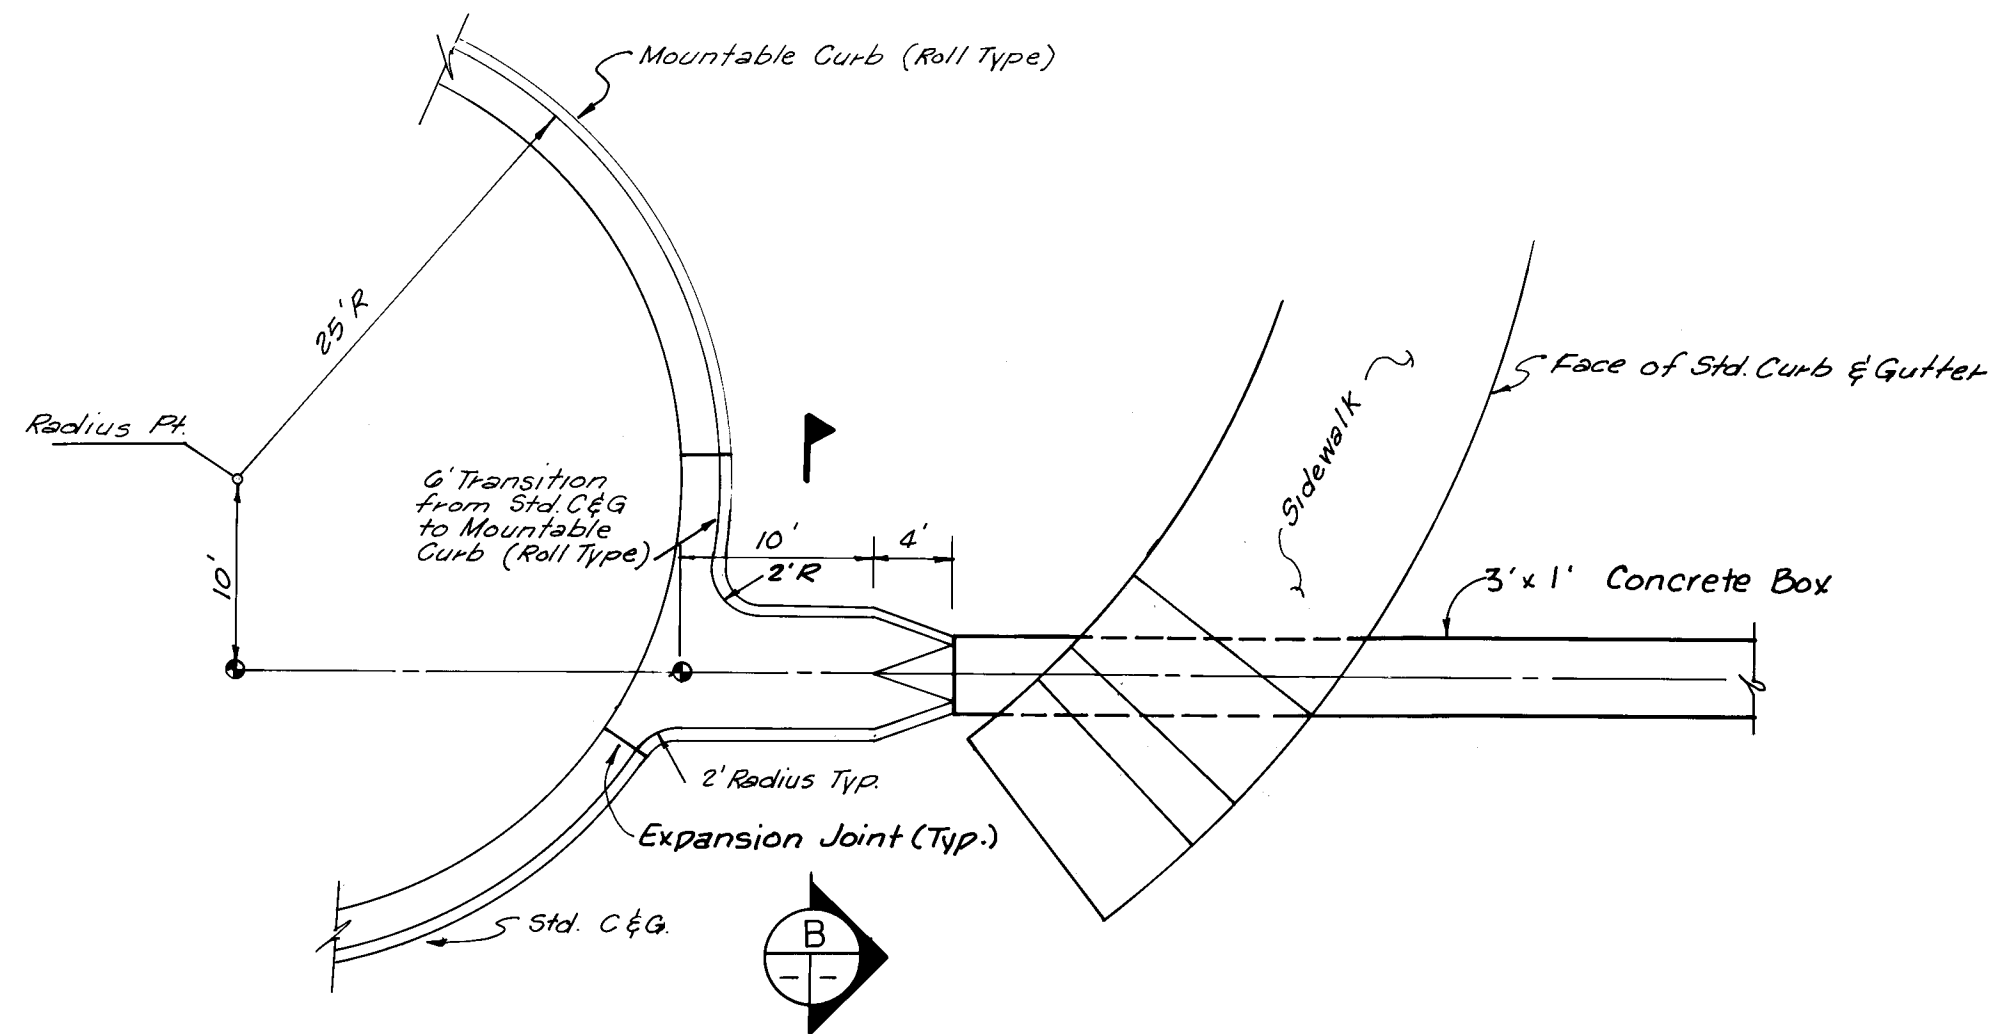

TYPICAL CONCRETE RUNDOWN

SCALE: 1" = 10'


** Rundown Shown for Central/Unser West side. East side is opposite hand.

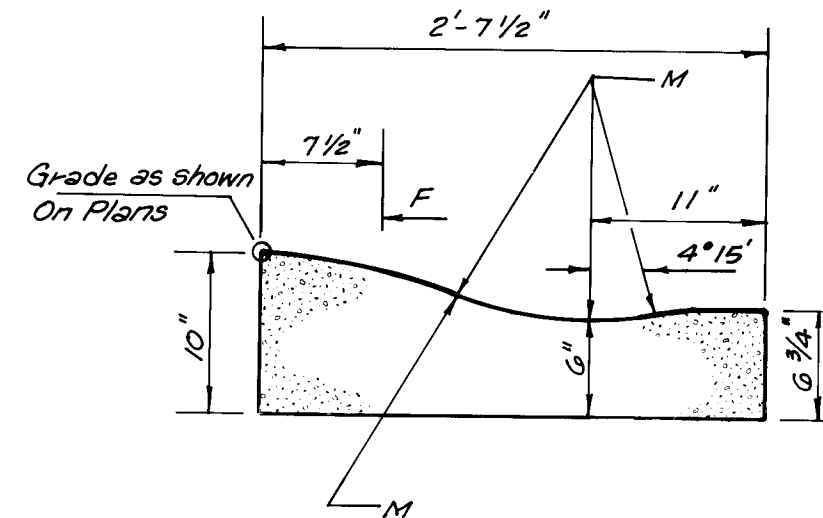

MOUNTABLE CURB


ROLL TYPE

(See City Standard Detail Drawing P-8-3)

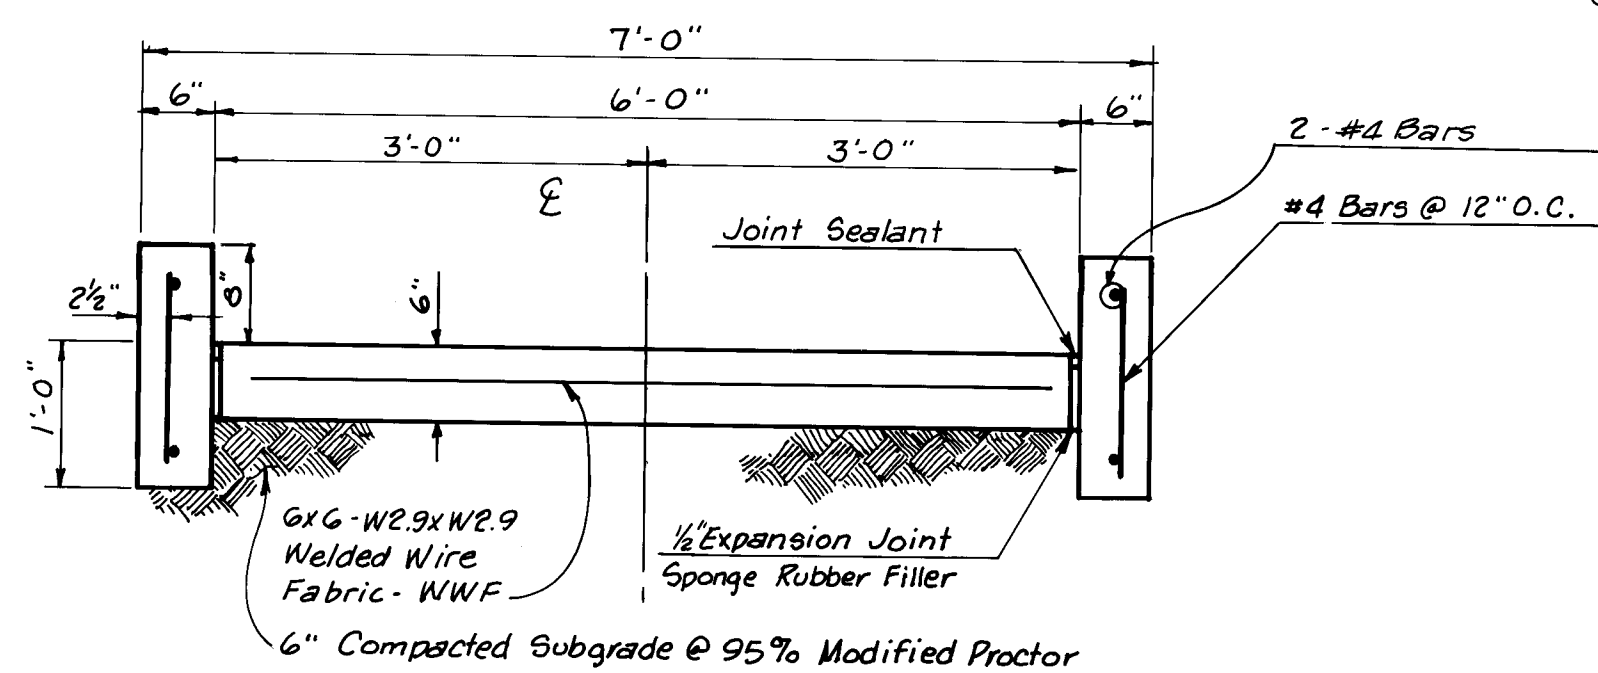

SECTION B-B


SCALE: 3/4" = 1'-0"

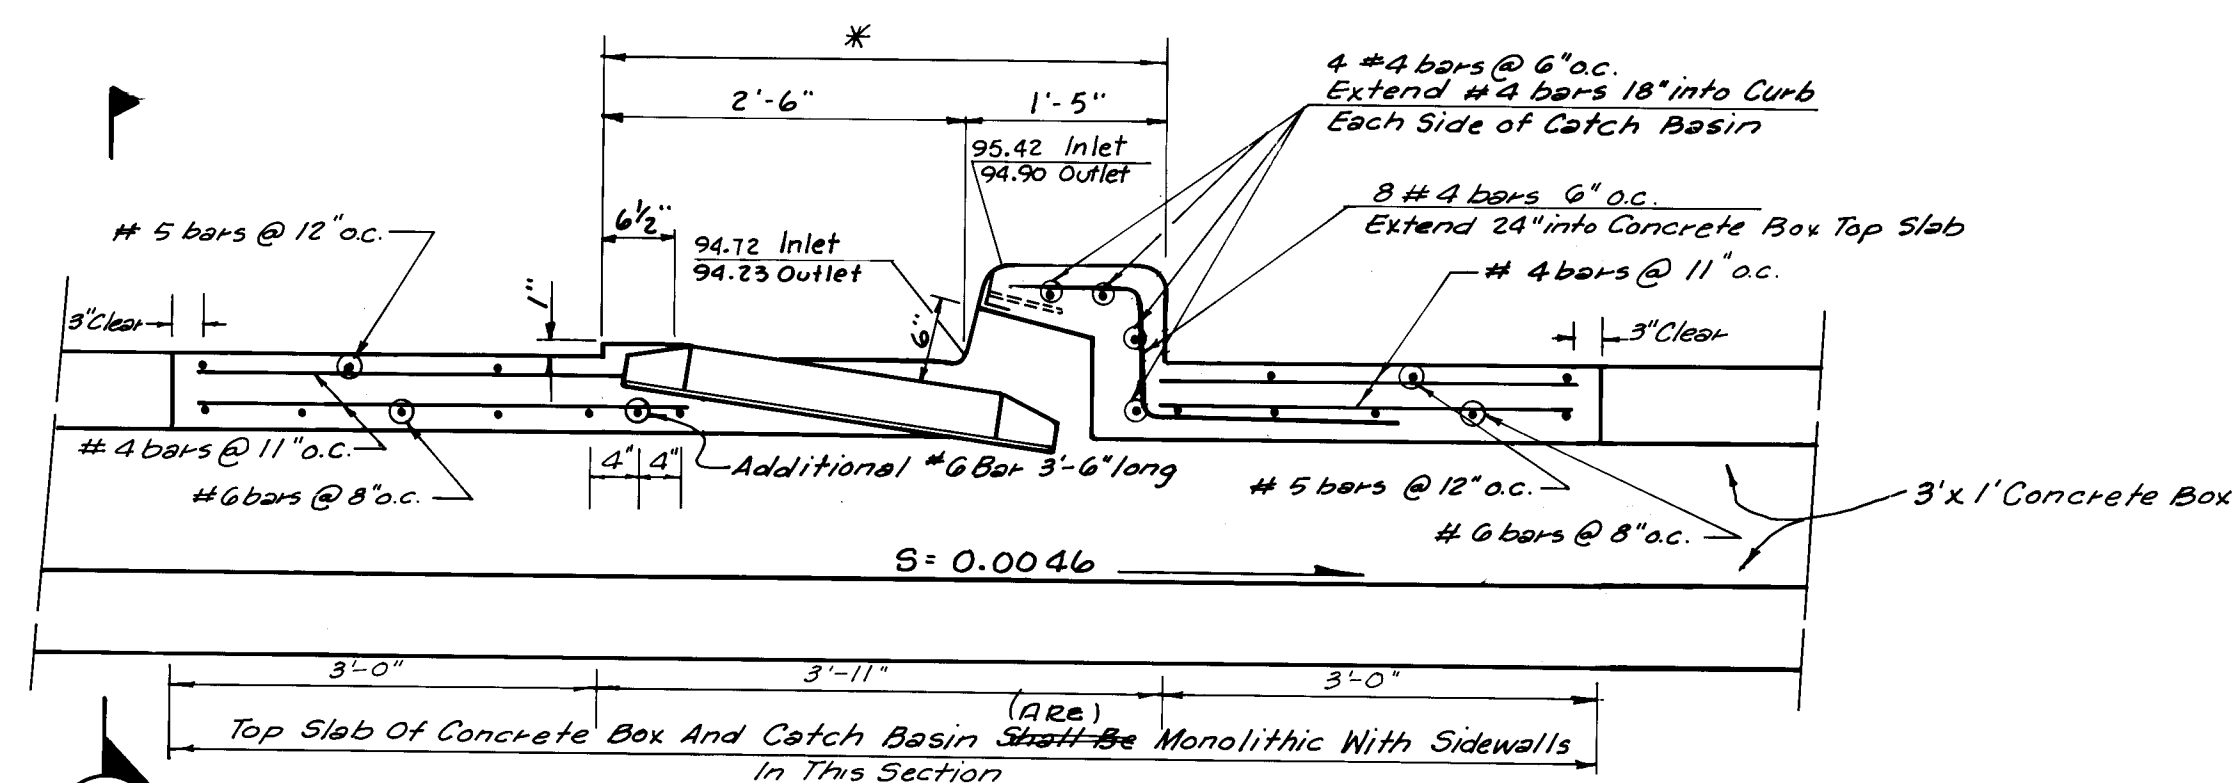

CATCH BASIN & GRATING DETAIL

SCALE: 3/4" = 1'-0"


* Top of inlet dimensions and details including frame, grate and gutter transition shall conform to City Standard Detail Drawings K-4-2, K-7-1, and K-8-1. (CONFORMED)

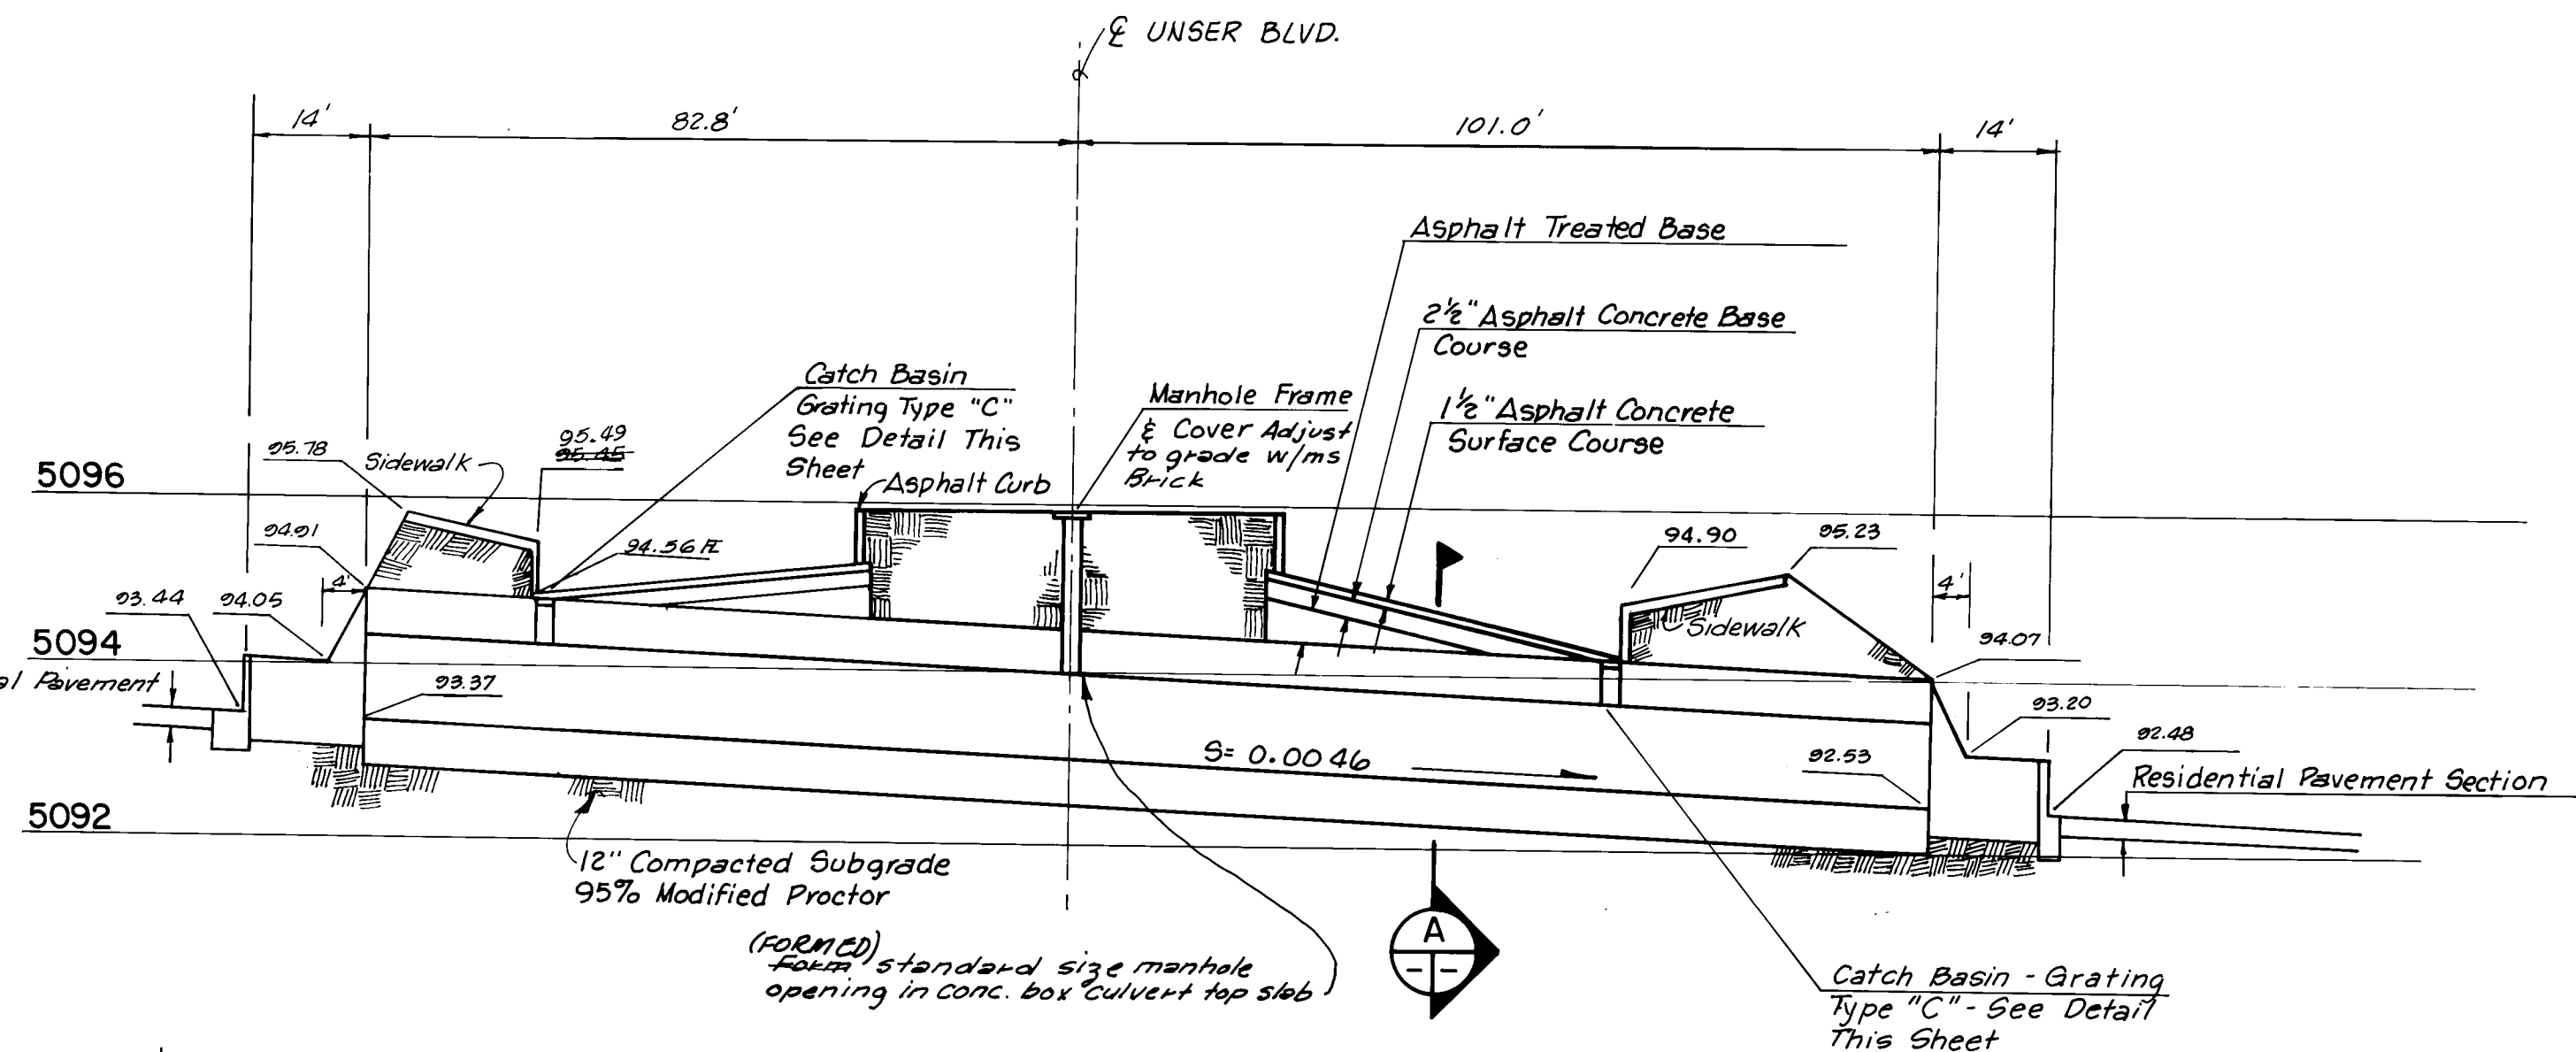

ROADWAY SECTION AT CONCRETE BOX


SCALE: 1" = 20' HORIZONTAL

1" = 2' VERTICAL

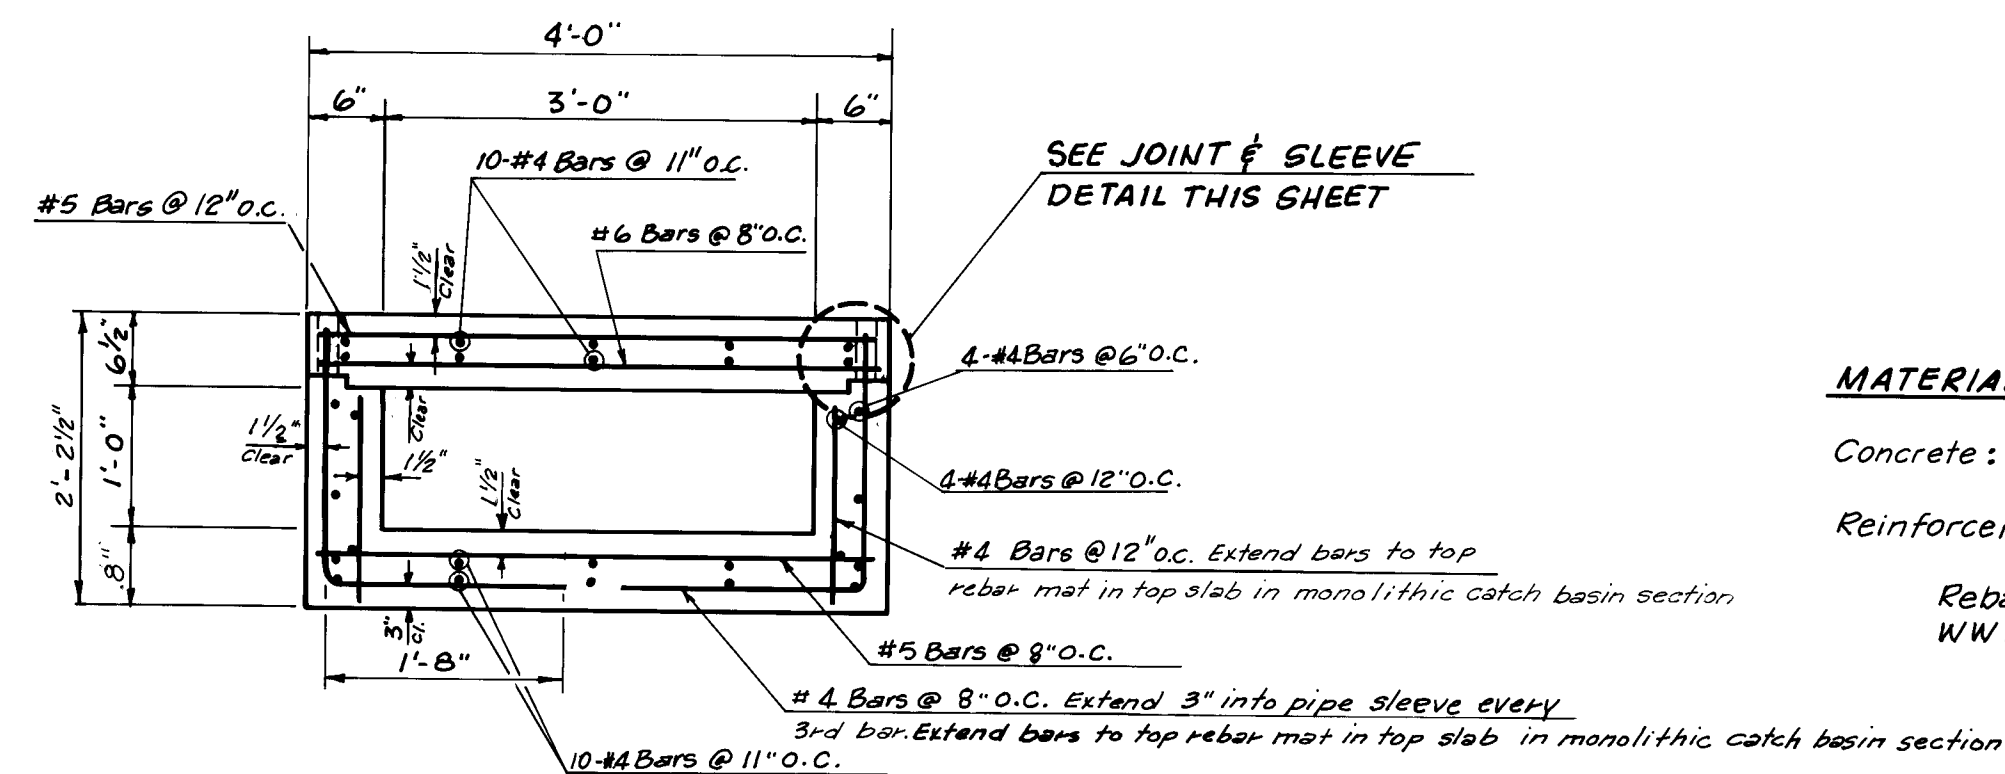

SECTION A-A

SCALE: 3/4" = 1'-0"

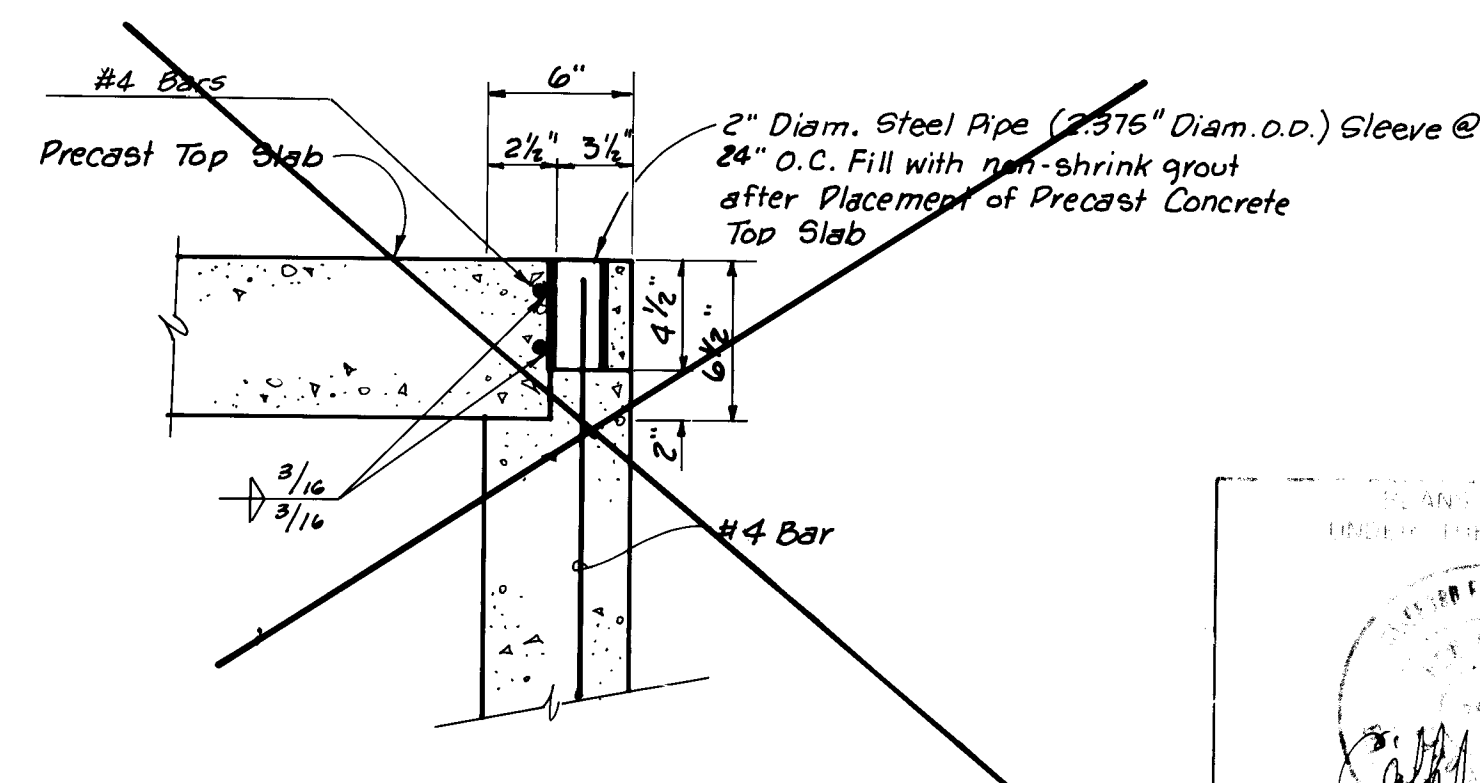


CONCRETE BOX - JOINT & SLEEVE DETAIL

SCALE: 1-1/2" = 1'-0"

(This detail does not apply to monolithic catch basin section.)



(NOTE: RATHER THAN PRECAST CONCRETE TOP SLAB, CONTRACTOR ELECTED TO POUR TOP SLAB CONCRETE IN PLACE BY FILLING INSIDE OF 1'x3' C.B.C. WITH SAND & PLASTIC COVER & PLACING CONCRETE DIRECTLY ON SAND; THEN REMOVED SAND WHEN CONCRETE HAD GAINED SUFFICIENT STRENGTH. TOP SLAB CONCRETE BOUNDED TO EXPOSED WALL REBAR & DOWELS)

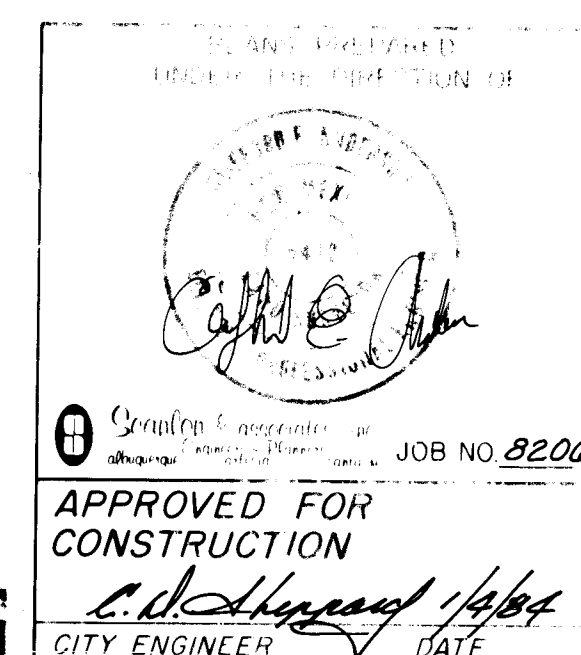

CITY OF ALBUQUERQUE					
MUNICIPAL DEVELOPMENT DEPARTMENT					
TITLE: SAD-214 UNSER BOULEVARD					
1'x3' CONCRETE BOX CULVERT					
APPROVALS	ENGINEER	DATE	APPROVALS	ENGINEER	DATE
City Engineer			Liquid Waste	NA	1/4/84
A.C.E. - Design			Traffic	NA	1/4/84
A.C.E. - Hydrology			Water	NA	1/4/84
DRAWING NO.	1658				

RECORD DRAWING

AS BUILT INFORMATION					
BY: Scanlon & Assoc. 1984					
DATE: 1/4/84					
SHEET 19 OF 23					

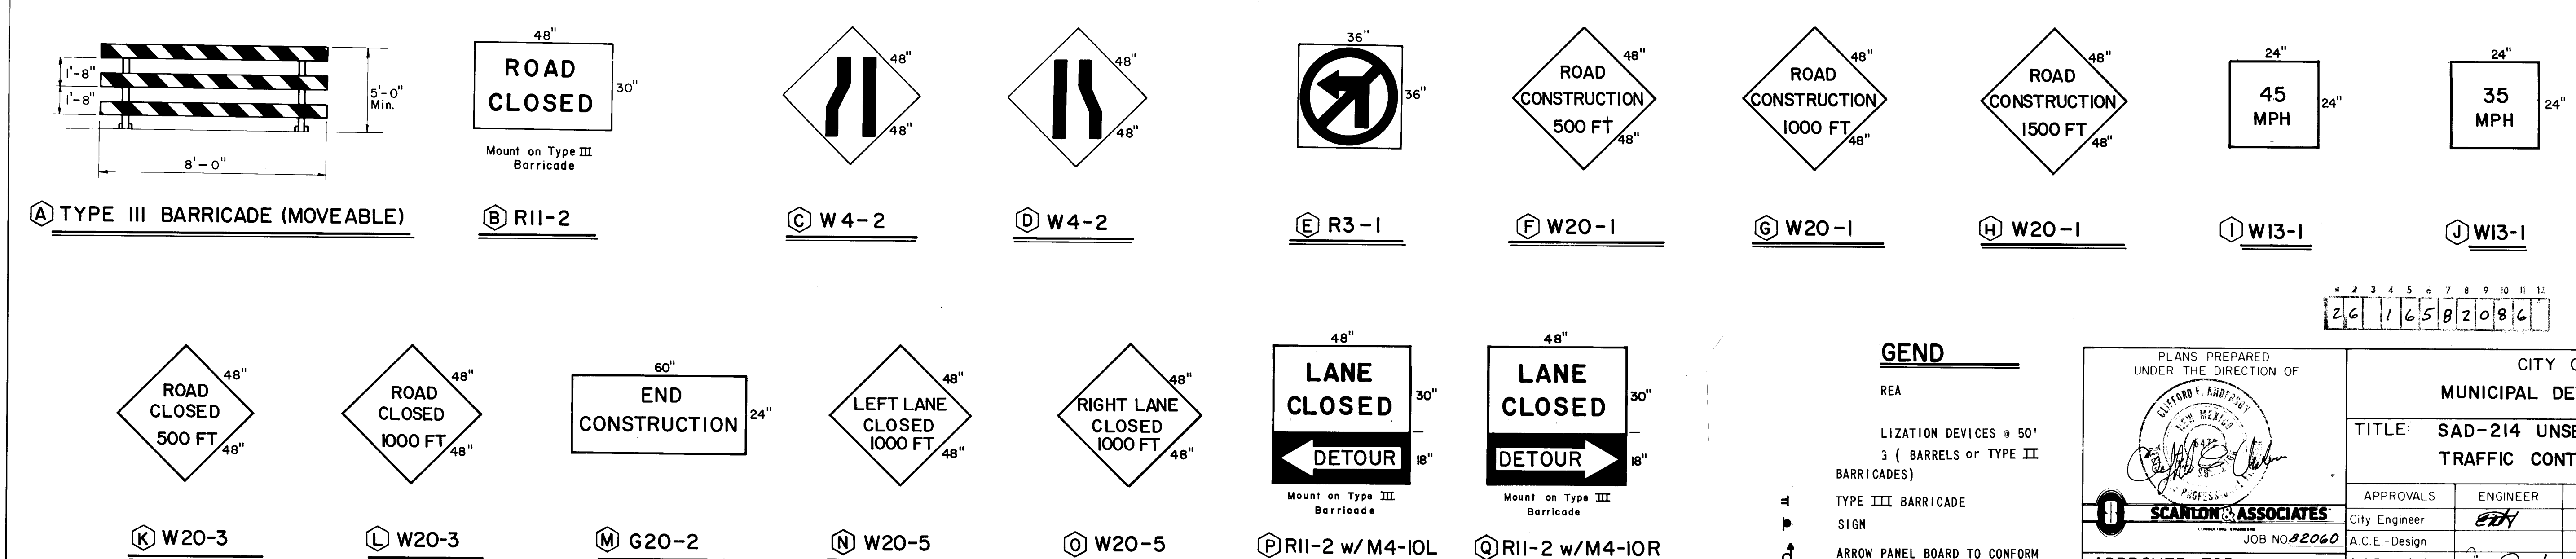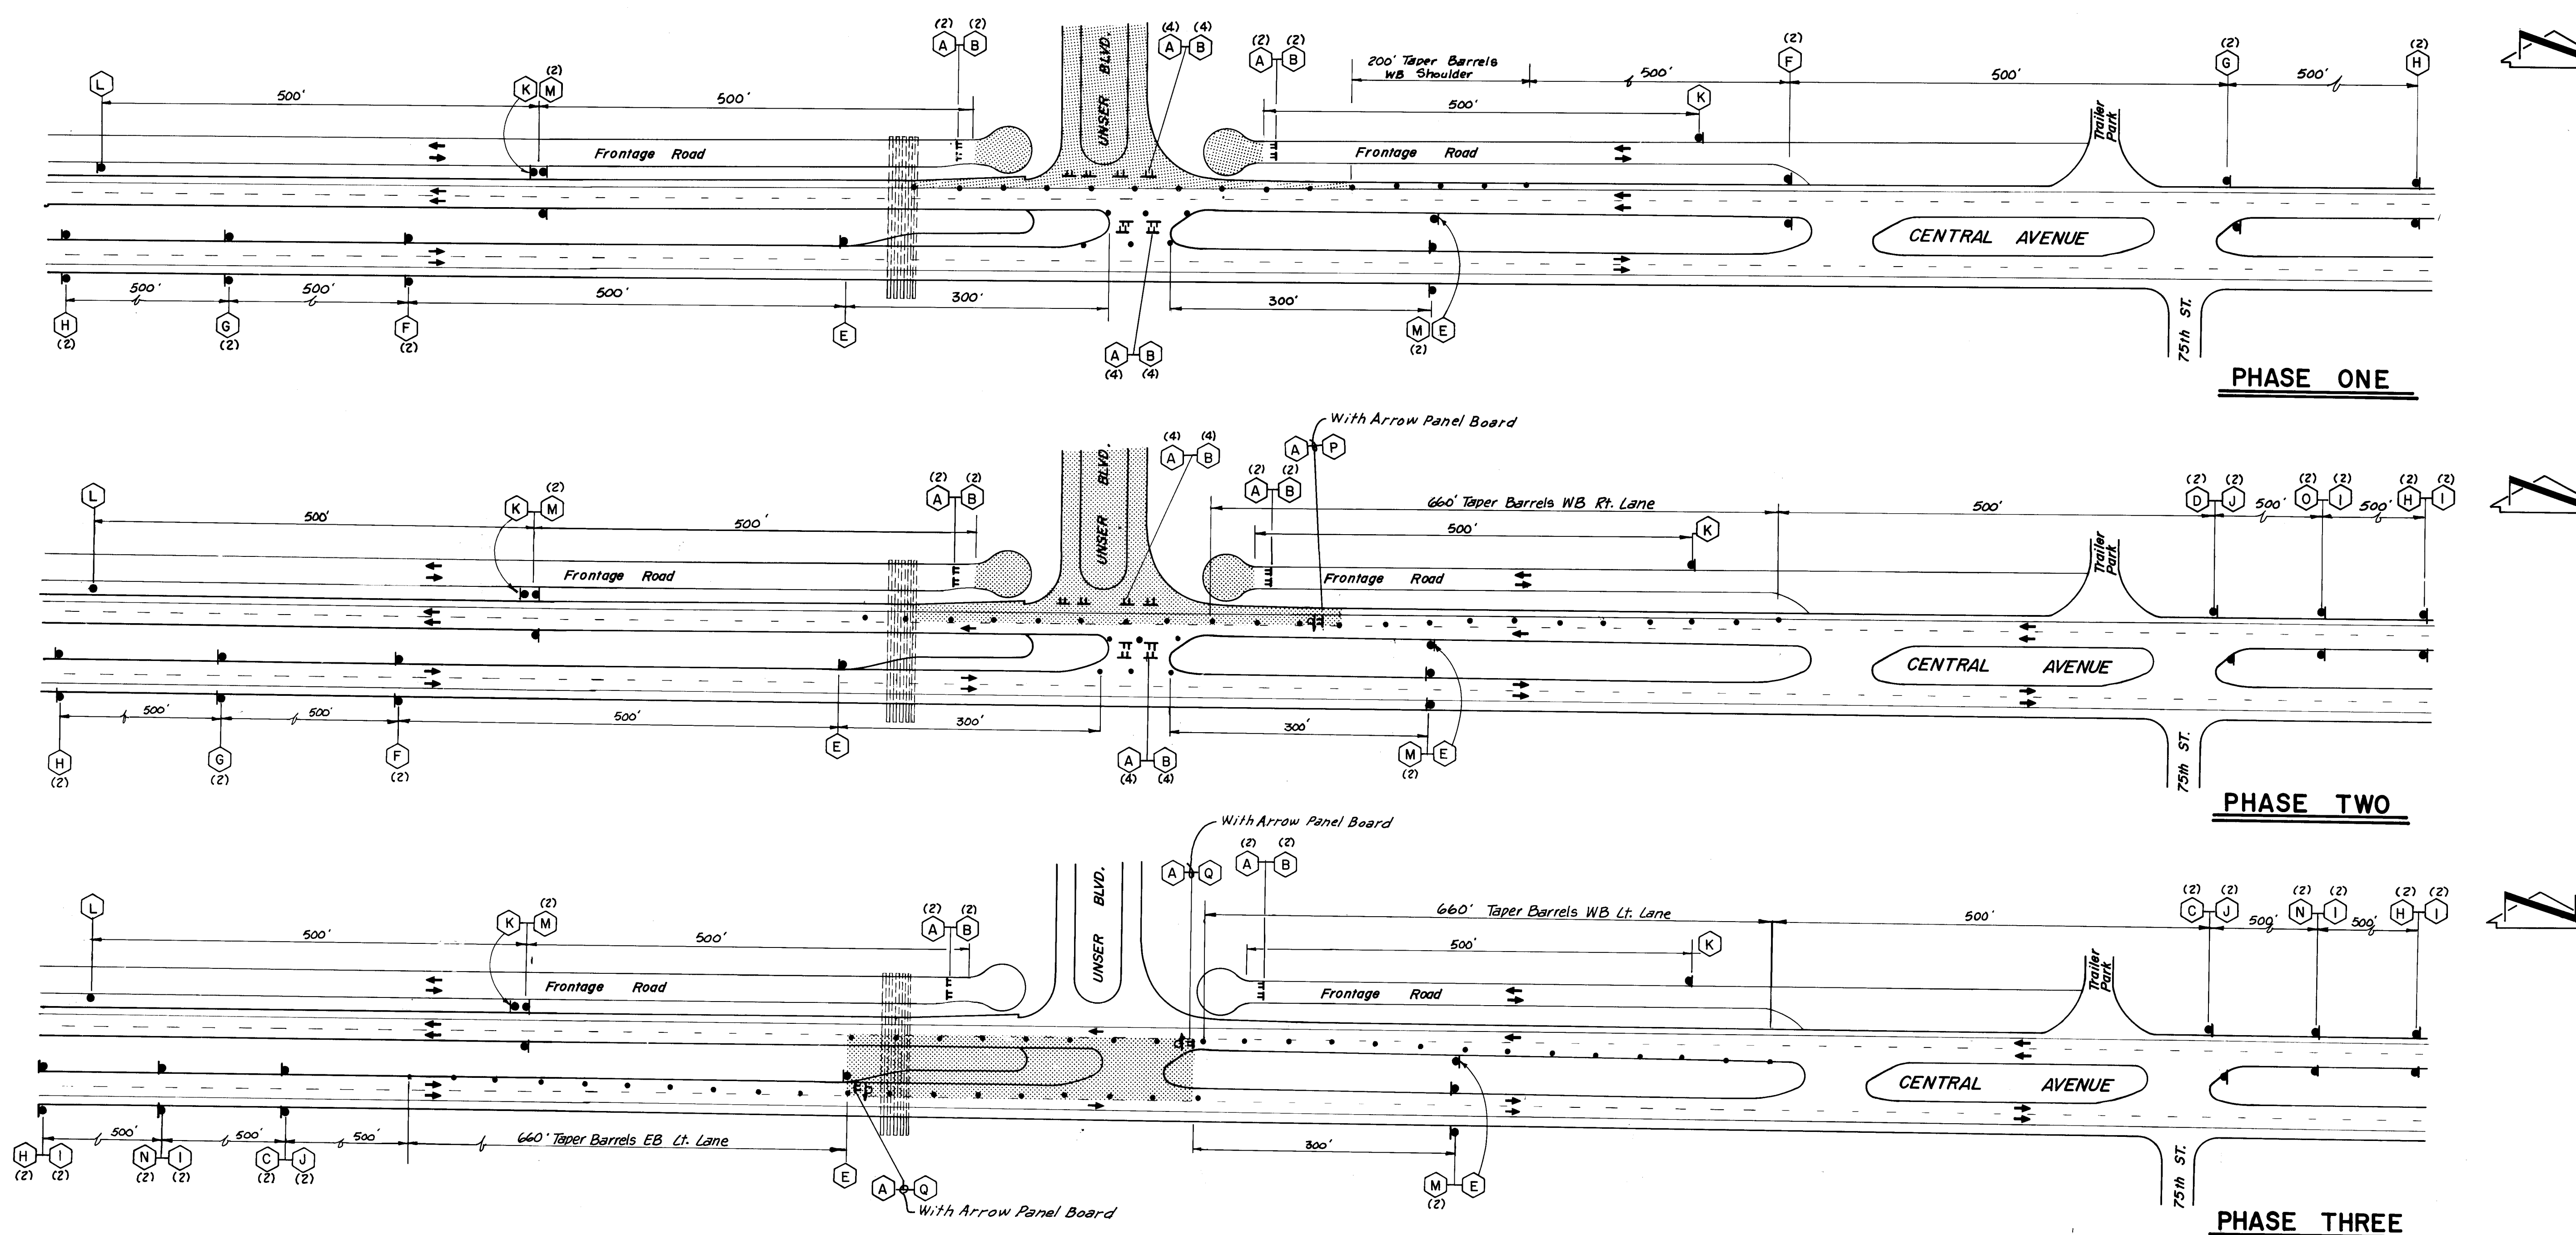

SIGN FACE DETAILS

RECORD DRAWING

AS BUILT INFORMATION CONTRACTOR: <i>Boice Const. Co., Inc.</i> WORK: <i>Scanlon & Assoc.</i> DATE: <i>1984</i> ACCEPTANCE BY: <i>[Signature]</i> DATE: <i>1984</i>		BENCH MARKS NO. <i>1</i> DATE <i>1984</i> NO. <i>2</i> DATE <i>1984</i> NO. <i>3</i> DATE <i>1984</i> NO. <i>4</i> DATE <i>1984</i> NO. <i>5</i> DATE <i>1984</i> NO. <i>6</i> DATE <i>1984</i> NO. <i>7</i> DATE <i>1984</i> NO. <i>8</i> DATE <i>1984</i> NO. <i>9</i> DATE <i>1984</i> NO. <i>10</i> DATE <i>1984</i> NO. <i>11</i> DATE <i>1984</i> NO. <i>12</i> DATE <i>1984</i>	
SURVEY INFORMATION FIELD NOTES BY: <i>[Signature]</i> NO. <i>1</i> DATE <i>1984</i> NO. <i>2</i> DATE <i>1984</i> NO. <i>3</i> DATE <i>1984</i> NO. <i>4</i> DATE <i>1984</i> NO. <i>5</i> DATE <i>1984</i> NO. <i>6</i> DATE <i>1984</i> NO. <i>7</i> DATE <i>1984</i> NO. <i>8</i> DATE <i>1984</i> NO. <i>9</i> DATE <i>1984</i> NO. <i>10</i> DATE <i>1984</i> NO. <i>11</i> DATE <i>1984</i> NO. <i>12</i> DATE <i>1984</i>		REFERENCES MAP NO. <i>1</i> EST NO. <i>1</i> W/O NO. <i>1</i> NO. <i>1</i> DATE <i>1984</i> NO. <i>2</i> DATE <i>1984</i> NO. <i>3</i> DATE <i>1984</i> NO. <i>4</i> DATE <i>1984</i> NO. <i>5</i> DATE <i>1984</i> NO. <i>6</i> DATE <i>1984</i> NO. <i>7</i> DATE <i>1984</i> NO. <i>8</i> DATE <i>1984</i> NO. <i>9</i> DATE <i>1984</i> NO. <i>10</i> DATE <i>1984</i> NO. <i>11</i> DATE <i>1984</i> NO. <i>12</i> DATE <i>1984</i>	
REVISIONS NO. <i>1</i> DATE <i>1984</i> BY <i>[Signature]</i> NO. <i>2</i> DATE <i>1984</i> BY <i>[Signature]</i> NO. <i>3</i> DATE <i>1984</i> BY <i>[Signature]</i> NO. <i>4</i> DATE <i>1984</i> BY <i>[Signature]</i> NO. <i>5</i> DATE <i>1984</i> BY <i>[Signature]</i> NO. <i>6</i> DATE <i>1984</i> BY <i>[Signature]</i> NO. <i>7</i> DATE <i>1984</i> BY <i>[Signature]</i> NO. <i>8</i> DATE <i>1984</i> BY <i>[Signature]</i> NO. <i>9</i> DATE <i>1984</i> BY <i>[Signature]</i> NO. <i>10</i> DATE <i>1984</i> BY <i>[Signature]</i> NO. <i>11</i> DATE <i>1984</i> BY <i>[Signature]</i> NO. <i>12</i> DATE <i>1984</i> BY <i>[Signature]</i>		DESIGN DESIGNED BY: <i>CWT</i> DATE <i>12-83</i> DRAWN BY: <i>SGH</i> DATE <i>12-83</i> CHECKED BY: <i>CWT</i> DATE <i>12-83</i>	
CITY OF ALBUQUERQUE MUNICIPAL DEVELOPMENT DEPARTMENT TITLE: SAD-214 UNSER BOULEVARD TRAFFIC CONTROL PLAN APPROVALS: <i>[Signature]</i> ENGINEER: <i>[Signature]</i> DATE: <i>1/4/84</i> A.C.E.-Design: <i>[Signature]</i> DATE: <i>1/4/84</i> A.C.E.-Hydrology: <i>[Signature]</i> DATE: <i>1/4/84</i> DRAWING NO. 1658 SHEET 20 OF 23			

GENERAL NOTES FOR TRAFFIC CONTROL

1. All traffic control devices shall comply with chapter VI of the 1978 edition "Manual for Uniform Traffic Control Devices".
2. The contractor shall prepare and submit to the Project Engineer a detailed detour plan, which is subject to the approval of the City Traffic Engineer, 3 working days in advance of any required lane closures other than those shown on these plans.
3. All signs must be installed before construction begins as directed by the Engineer. The bottom of construction warning signs shall be 7-feet above the sidewalk level.
4. All signs, barricades and/or barrels will be reflectorized. All barrels may have sand or water ballast limited to 100 lbs.
5. All sign locations will be selected in the field and approved by the Project Engineer. Distances may be adjusted for local conditions.
6. All signs will be ground mounted on single or double posts. Existing posts may be used at some locations, with the approval of the Project Engineer. Portable sign supports will be acceptable as an alternate for signs which are in place less than 1 week.
7. All signs will be moved forward as the construction progresses.
8. The contractor shall maintain access to businesses and residences adjacent to the construction area.
9. When barriers are required after dark, all advance warning signs and all barricades shall be equipped with flashing warning lights (type A), except that all channelizing barricades shall have steady burning warning lights (type C).
10. All existing regulatory signs that need to be removed, relocated or reinstalled shall be done by the City of Albuquerque Traffic Engineering Division. The contractor shall notify the Traffic Engineering Division 3 working days in advance of any required work.
11. The contractor shall provide and maintain a safe and adequate means of channeling pedestrian traffic around all work areas throughout the period of construction. All such channelization shall be arranged to prevent pedestrians from having to enter the roadway in order to pass around the work areas.
12. All construction signing shall be black on a reflectorized orange field unless otherwise specified. All construction barricades and channelization devices shall be orange on white, reflectorized, unless otherwise specified.
13. All advance warning signs not directly applicable shall be removed, covered, or turned away from oncoming traffic.
14. A minimum width of 11 feet shall be provided for traffic in one direction.
15. All advance warning signs shall be 48" x 48" minimum.
16. The contractor shall be required to keep the public informed, through the local news media, of construction operations involving street or lane closures.
17. Equipment and materials are not to be stored within the street right-of-way during non-working hours.
18. Excavations must be placed or patched prior to opening to traffic.

SEQUENCE OF CONSTRUCTION

1. Exploratory trenching to locate existing utilities in the intersection of Unser Boulevard and Central Avenue shall be completed prior to beginning any lane closures on Central Avenue.
2. PHASE ONE: Construct Unser Boulevard north of Central Avenue. Median opening on Central Avenue and Frontage Road may be closed to traffic at this time. Construction shall be limited to the north edge of the Central Avenue westbound paved shoulder. Contractor shall maintain two lanes for eastbound and two lanes for westbound Central Avenue traffic at all times.
3. PHASE TWO: As the work progresses, the Contractor may continue his operations southward by closing the right hand westbound lane on Central Avenue. The Contractor shall maintain two lanes for eastbound and one lane for westbound Central Avenue traffic at all times.
4. PHASE THREE: When the paving is completed in the right hand westbound lane on Central Avenue, the Contractor may close the left hand westbound and left hand eastbound lanes on Central Avenue to complete the intersection paving and median construction. The Contractor shall maintain one lane for eastbound and one lane for westbound Central Avenue traffic at all times.
5. PHASE FOUR: The Contractor may complete the installation of the 12" waterline by closing the right hand eastbound lane on Central Avenue when the intersection paving and median construction is completed. The closure of the right hand eastbound lane on Central Avenue shall be accomplished by traffic control similar to that shown on the plans for the Phase Two westbound right hand lane closure.

NEW MEXICO STATE HIGHWAY DEPARTMENT PERMIT REQUIREMENTS*

1. Contractor shall comply with the provisions of NMSHD Permit No. 311602 including the following special provisions:
 - A. All work performed on State Right-of-Way shall meet the Standard Specifications for Road and Bridge Construction (Edition of 1976).
 - B. Traffic Control shall be in accordance with Manual on Uniform Traffic Control Devices for Streets and Highways as shown on plan sheet 20 and will be supplemented with arrow panel boards on lane closures.
 - C. All materials used within the State Right-of-Way shall be tested by a private testing laboratory and copies of the test reports submitted to the District Highway Engineer.
 - D. The State Right-of-Way must be restored to its original condition or better.
 - E. NMSHD District Office will make a final inspection after the project has been completed.

* APPLIES TO CONSTRUCTION ON CENTRAL AVENUE ONLY.

RECORD DRAWING

MUNICIPAL DEVELOPMENT DEPARTMENT
SAD-214 UNSER BOULEVARD
TRAFFIC CONTROL NOTES


1658

Boice Const. Co., Inc.
Scanlon & Assoc.
1984

Scanlon & Assoc.
1984


NA Jones 1/4/84
TW Kennedy 1/4/84
NA Jones 1/4/84

21 23

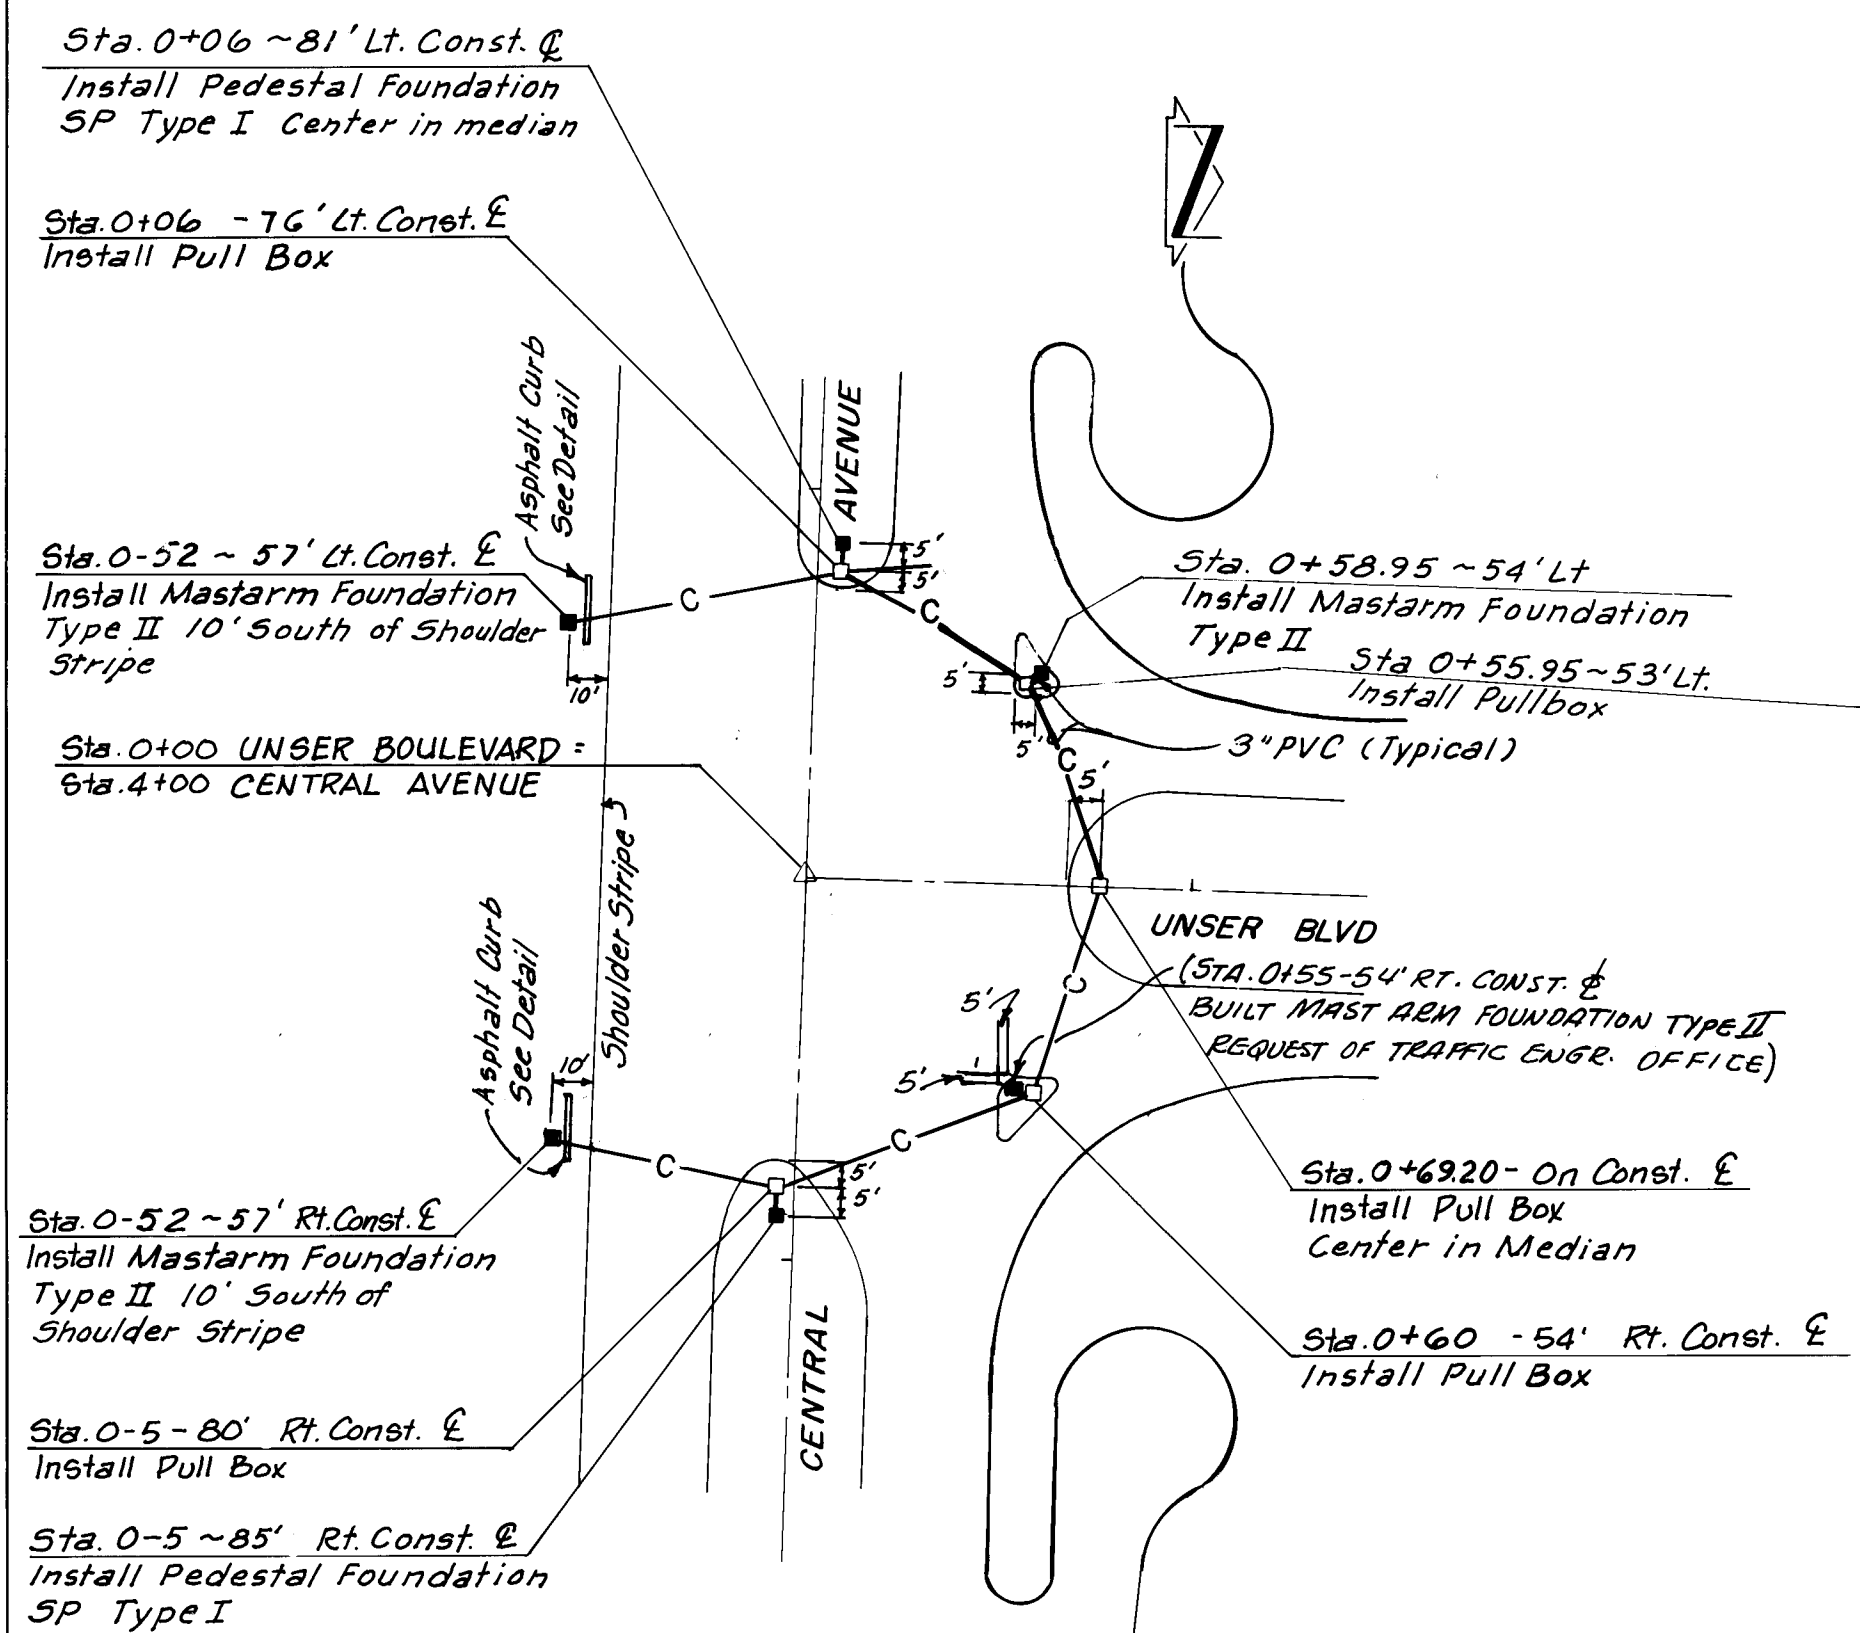


**SIGNAL & PULLBOX LOCATIONS
UNSER AT CENTRAL**

SCALE: 1" = 50'

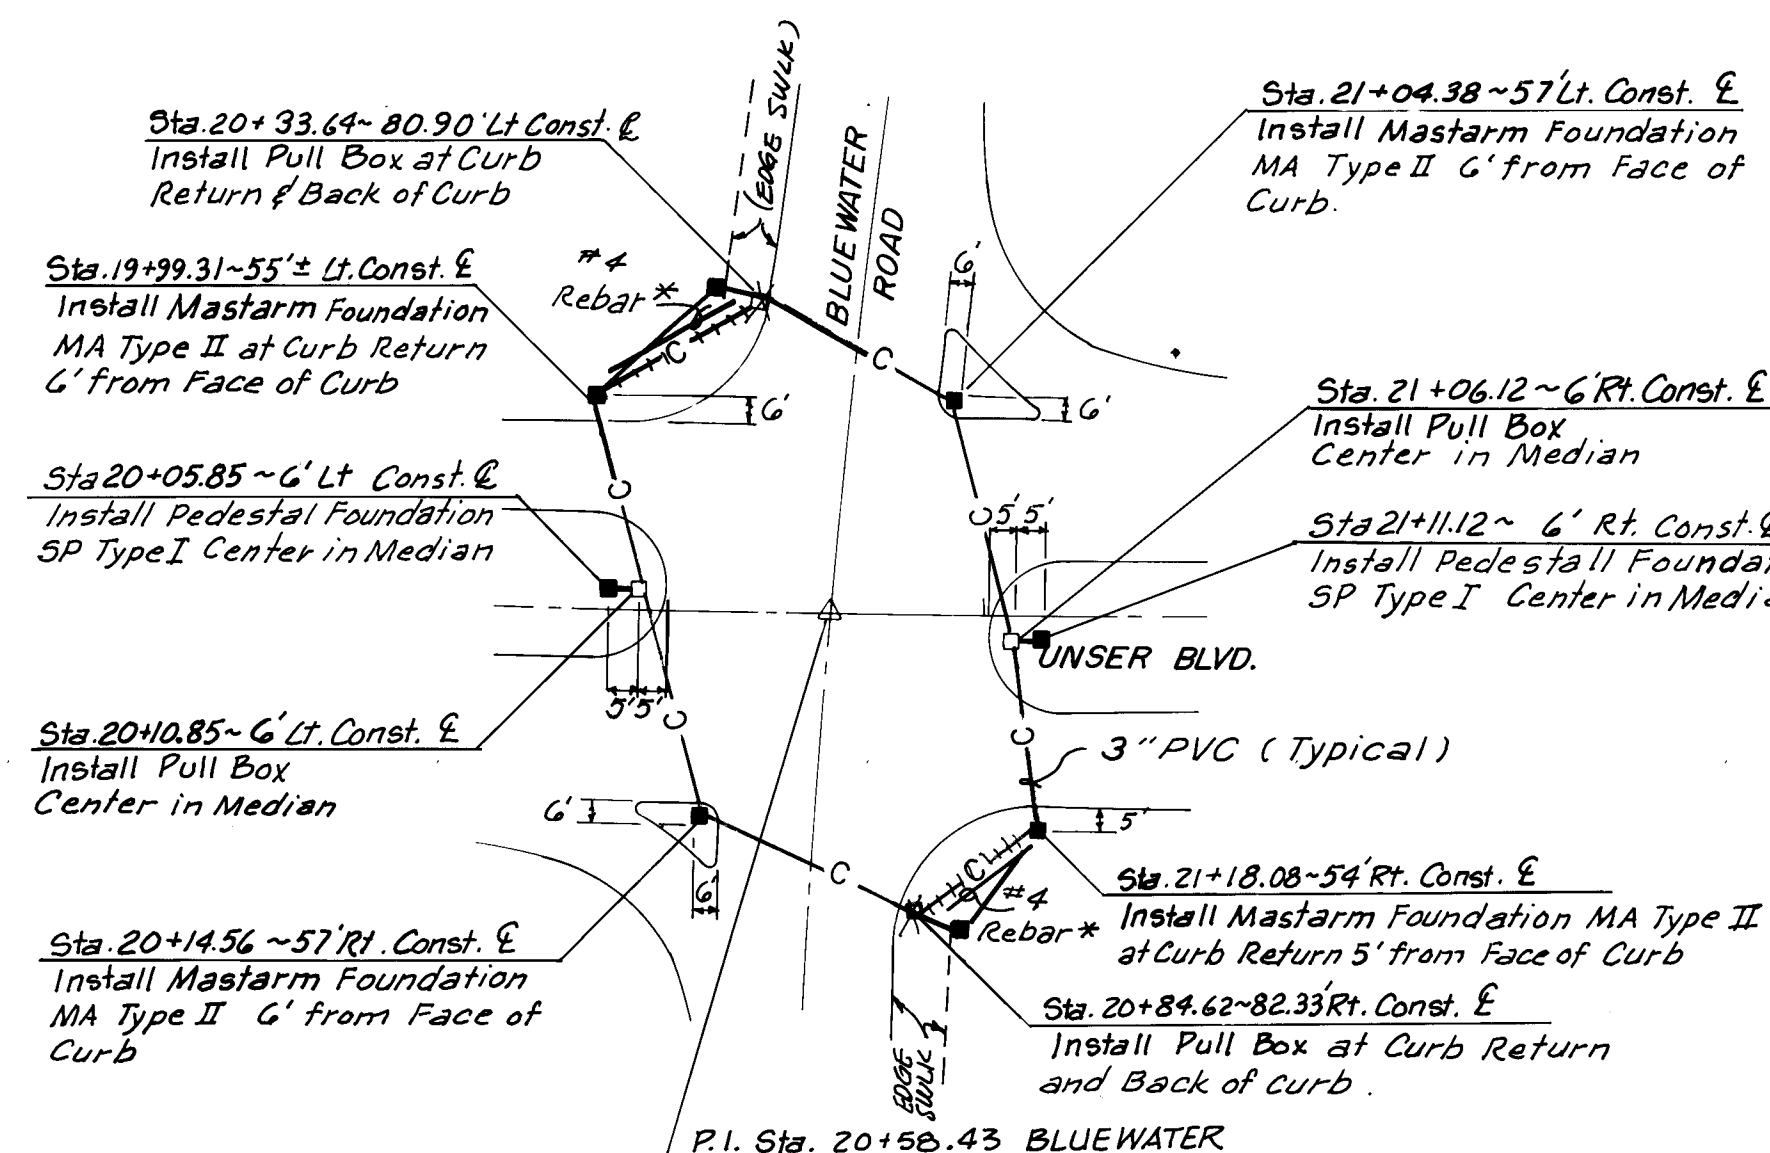


**SIGNAL & PULLBOX LOCATIONS
UNSER AT BLUEWATER**

SCALE: 1" = 50'

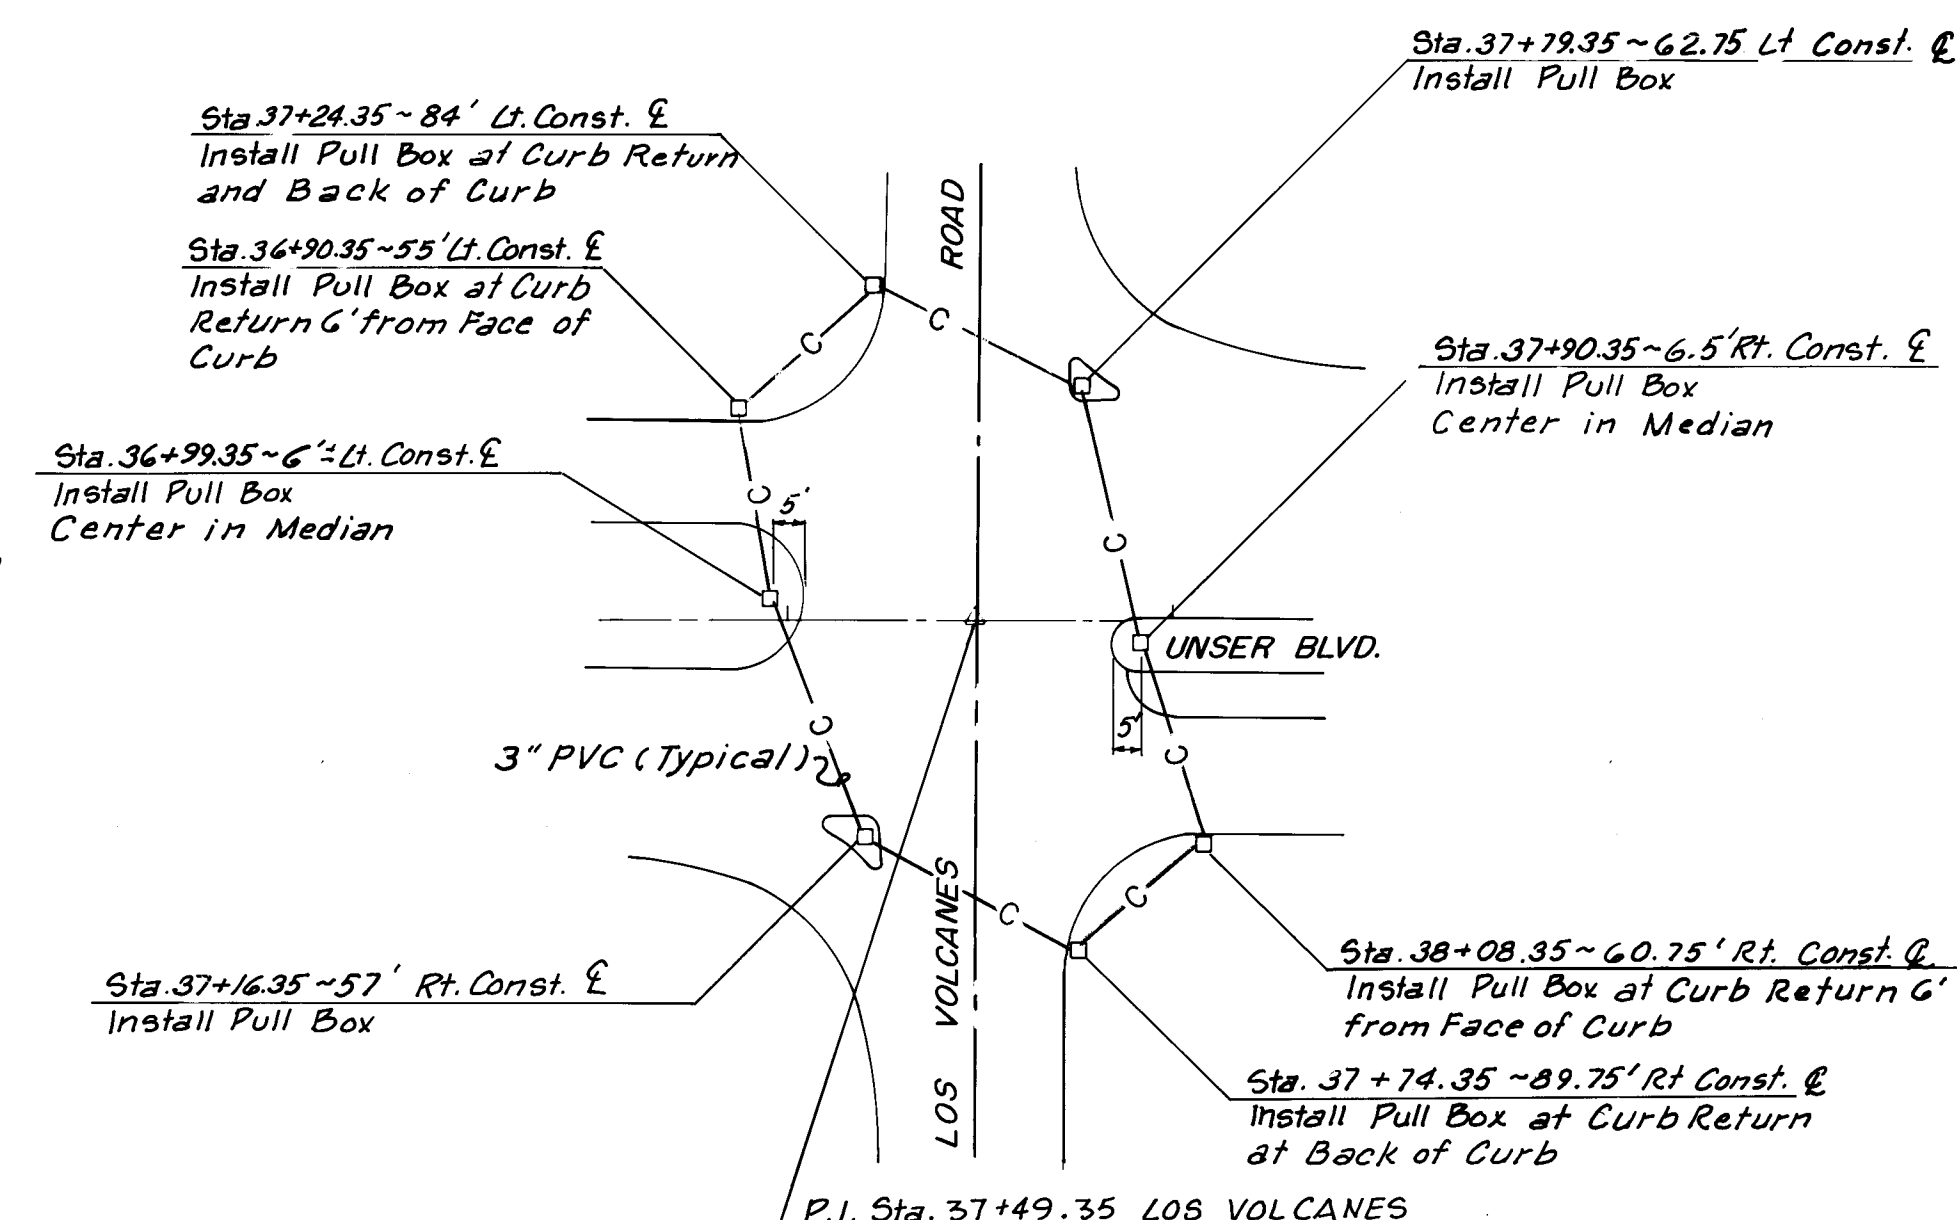


**PULLBOX LOCATIONS
UNSER AT LOS VOLCANES**

SCALE: 1" = 50'

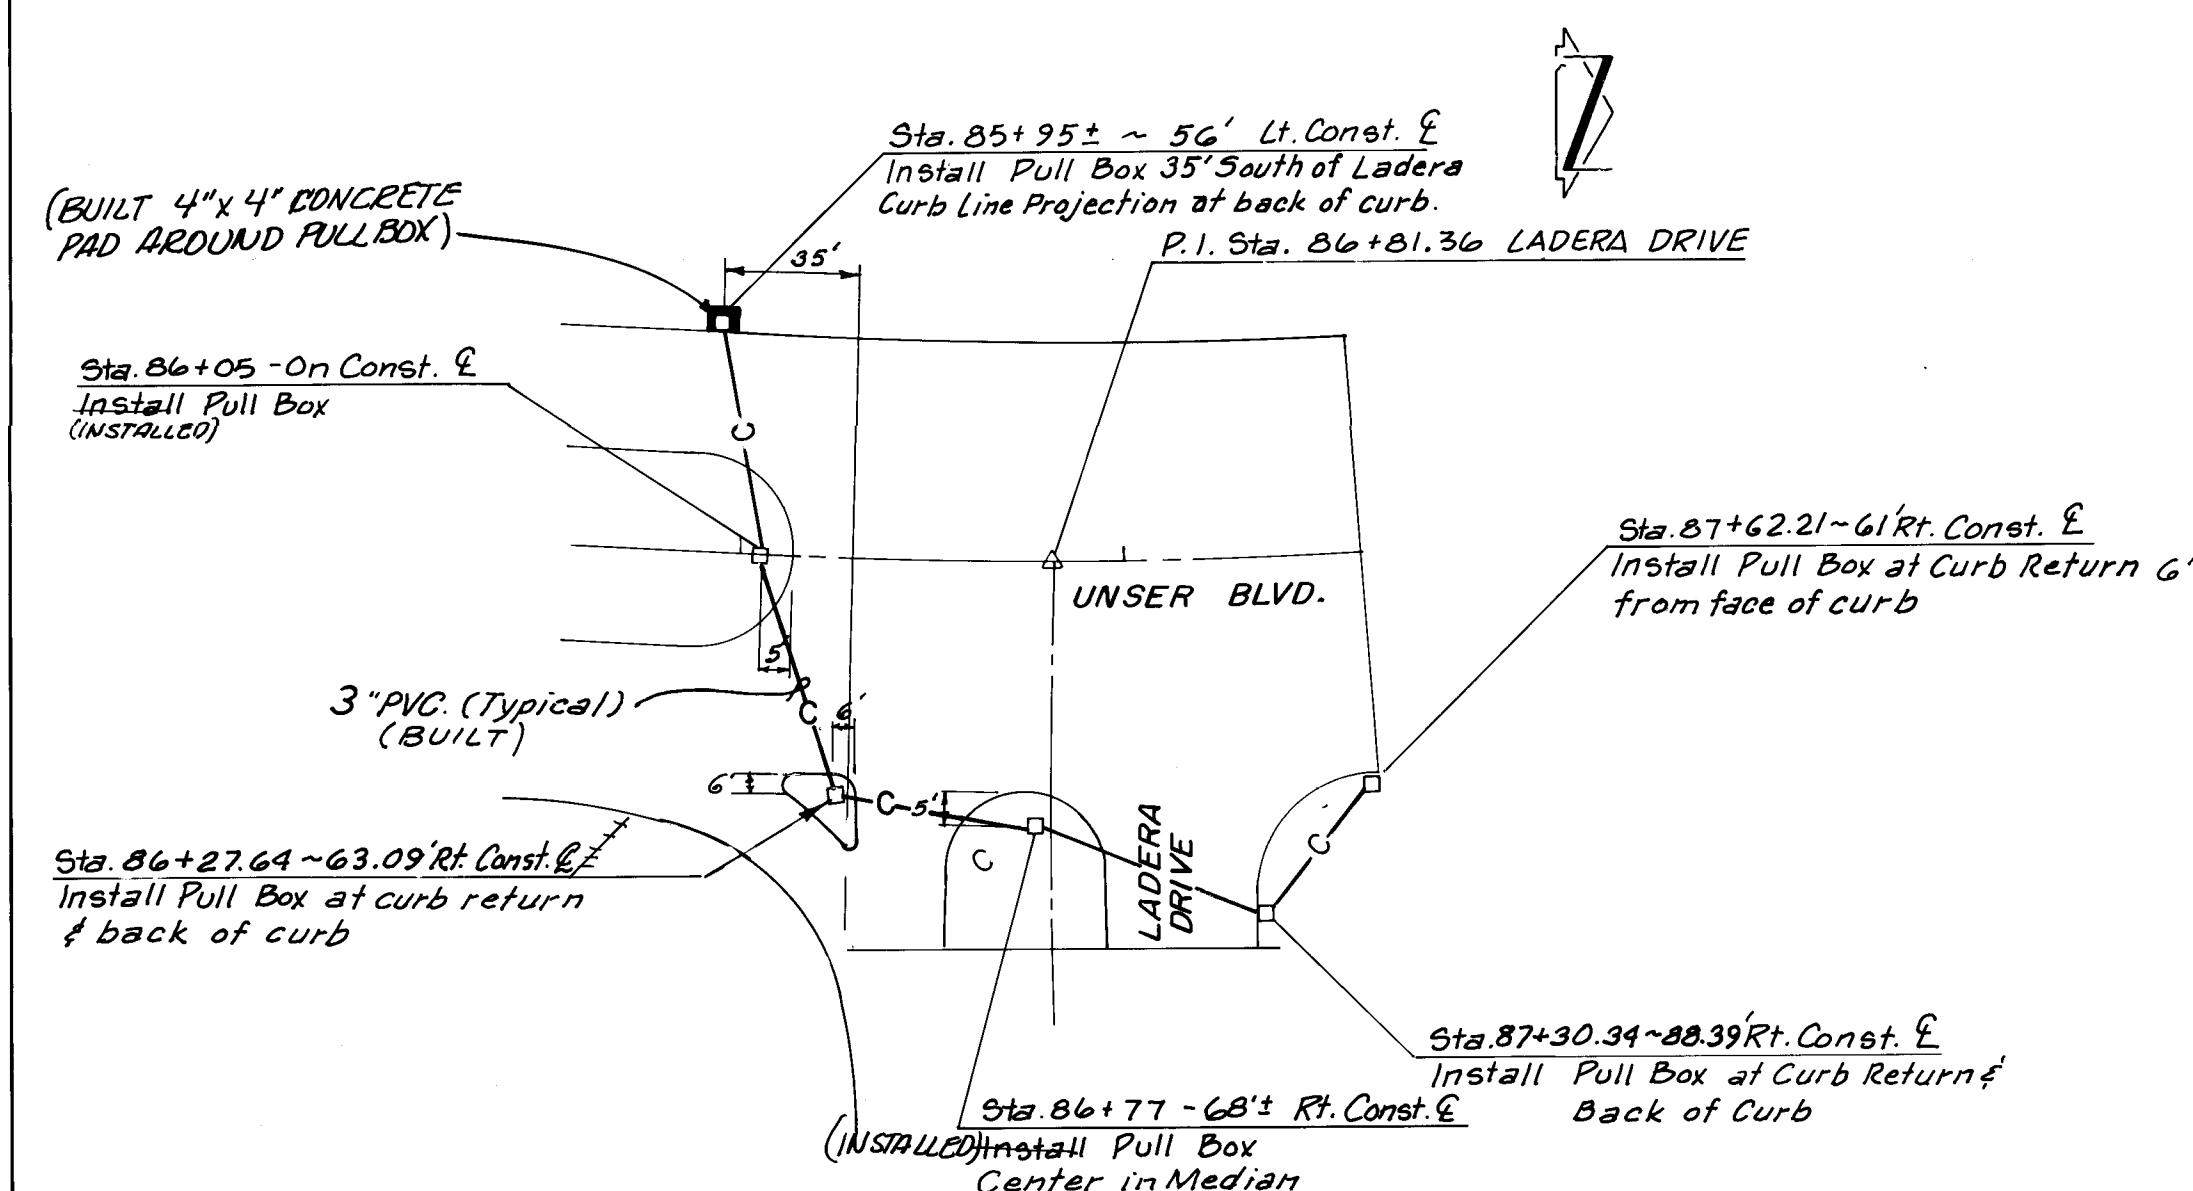

**PULLBOX LOCATIONS
UNSER AT LADERA DRIVE**

SCALE: 1" = 50'

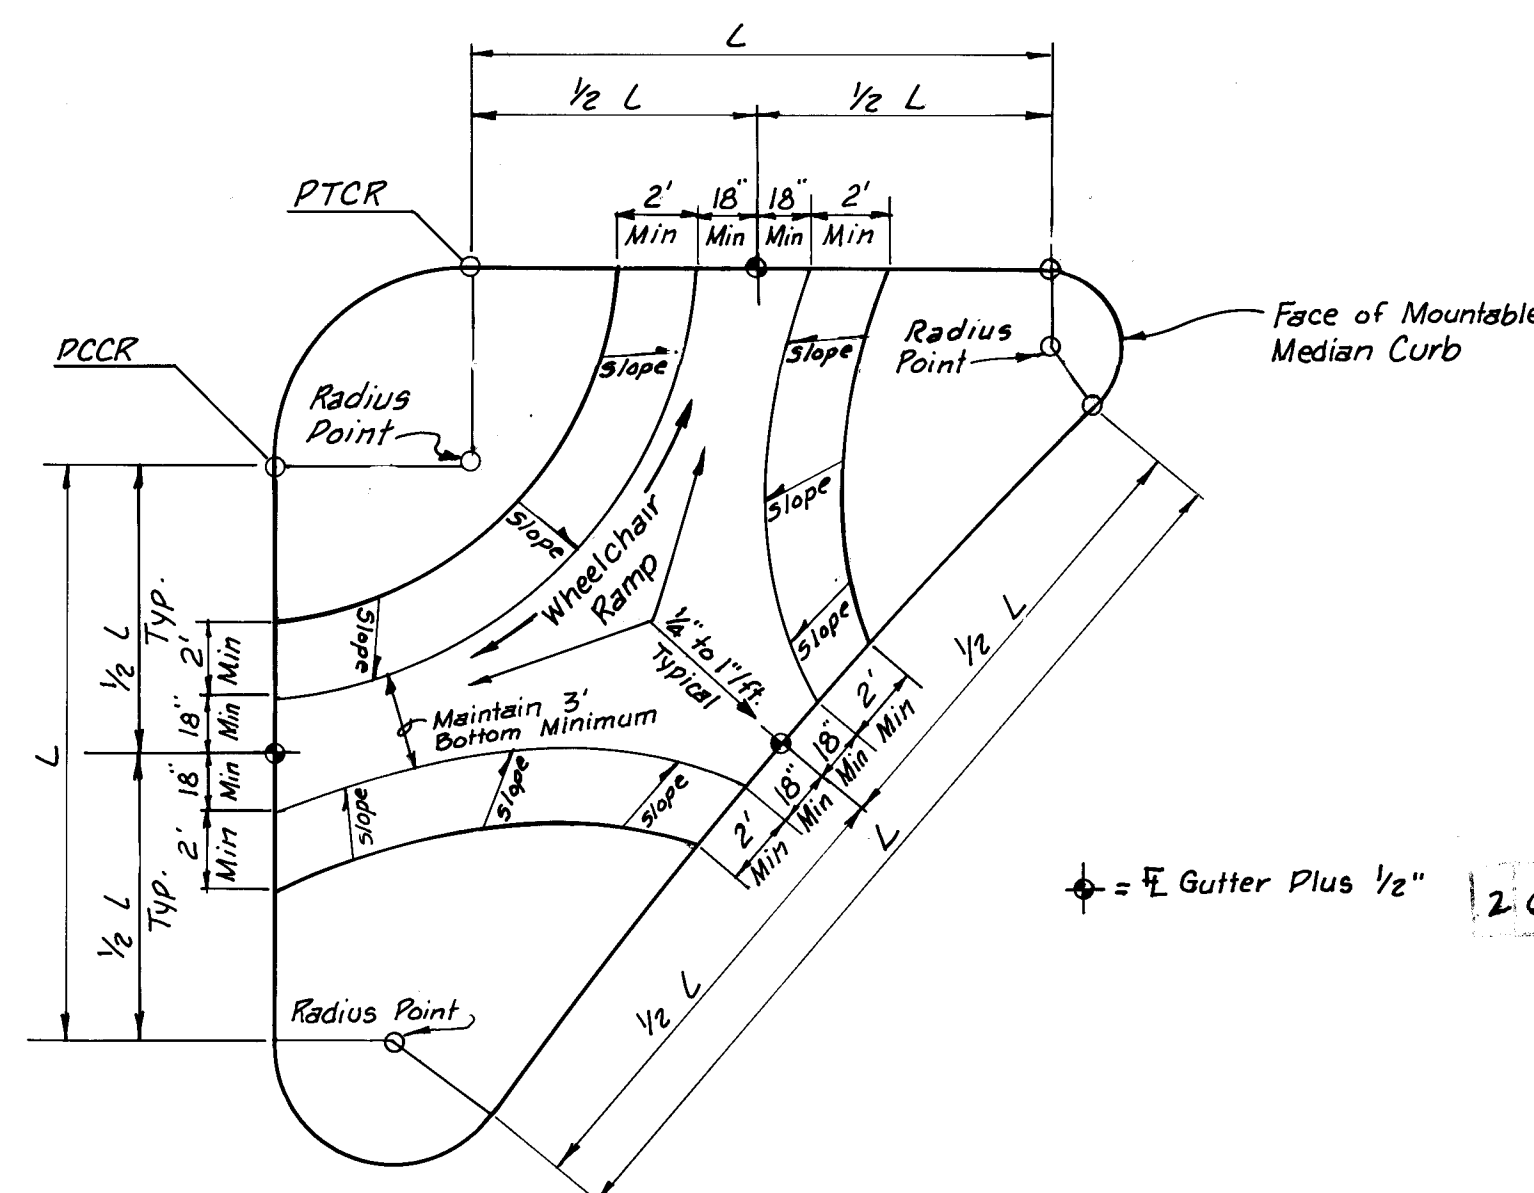


TYPICAL ISLAND WHEELCHAIR RAMP DETAIL

NO SCALE

NOTE: Island Wheelchair Ramp Details shall conform to City Standard Drawing P-17. Islands to be surfaced with 4" Concrete Pavement.

NOTES:

- Contractor shall verify exact locations of pull boxes, pedestal foundations, and mastarm foundations in the field with Traffic Engineering Department.
- Pedestal Foundations SP Type I shall conform to City Standard Detail Drawing T-5. Mastarm Foundations MA Type II shall conform to City Standard Detail Drawing T-6. Pull Boxes shall conform to City Standard Detail Drawing T-4.
- Mastarm foundations and pull box locations in traffic islands shall be coordinated with wheel chair ramp construction to provide adequate wheel chair ramps and mastarm clearances to face of curb.

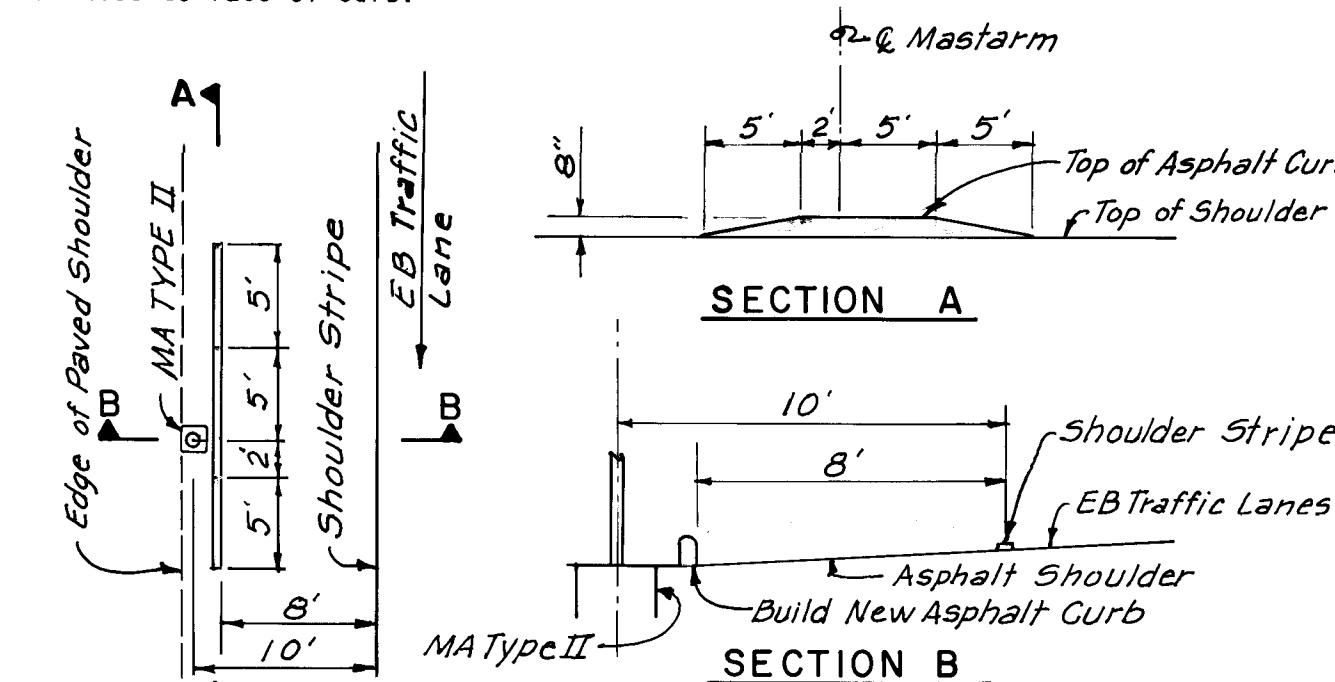


ASPHALT CURB AT CENTRAL SOUTH SIDE

CITY OF ALBUQUERQUE MUNICIPAL DEVELOPMENT DEPARTMENT					
TITLE: SAD-214 UNSER BOULEVARD PULLBOX LOCATIONS & ISLAND WHEELCHAIR RAMP DETAILS					
APPROVALS	ENGINEER	DATE	APPROVALS	ENGINEER	DATE
City Engineer	NA James	1/4/04	Liquid Waste	NA James	1/4/04
A.C.E.-Design	NA James	1/4/04	Traffic	NA James	1/4/04
A.C.E.-Hydrology	NA James	1/4/04	Water	NA James	1/4/04
DRAWING NO. 1658			SHEET 22 OF 23		

RECORD DRAWING

PROFILE	SURVIVED	BY	DATE
	PLOTTED		
	GRADES CHECKED		
	B. M.'S NOTED		
	STRUCTURE NOTATIONS CHK'D		
NOTE BOOK			
NO.			

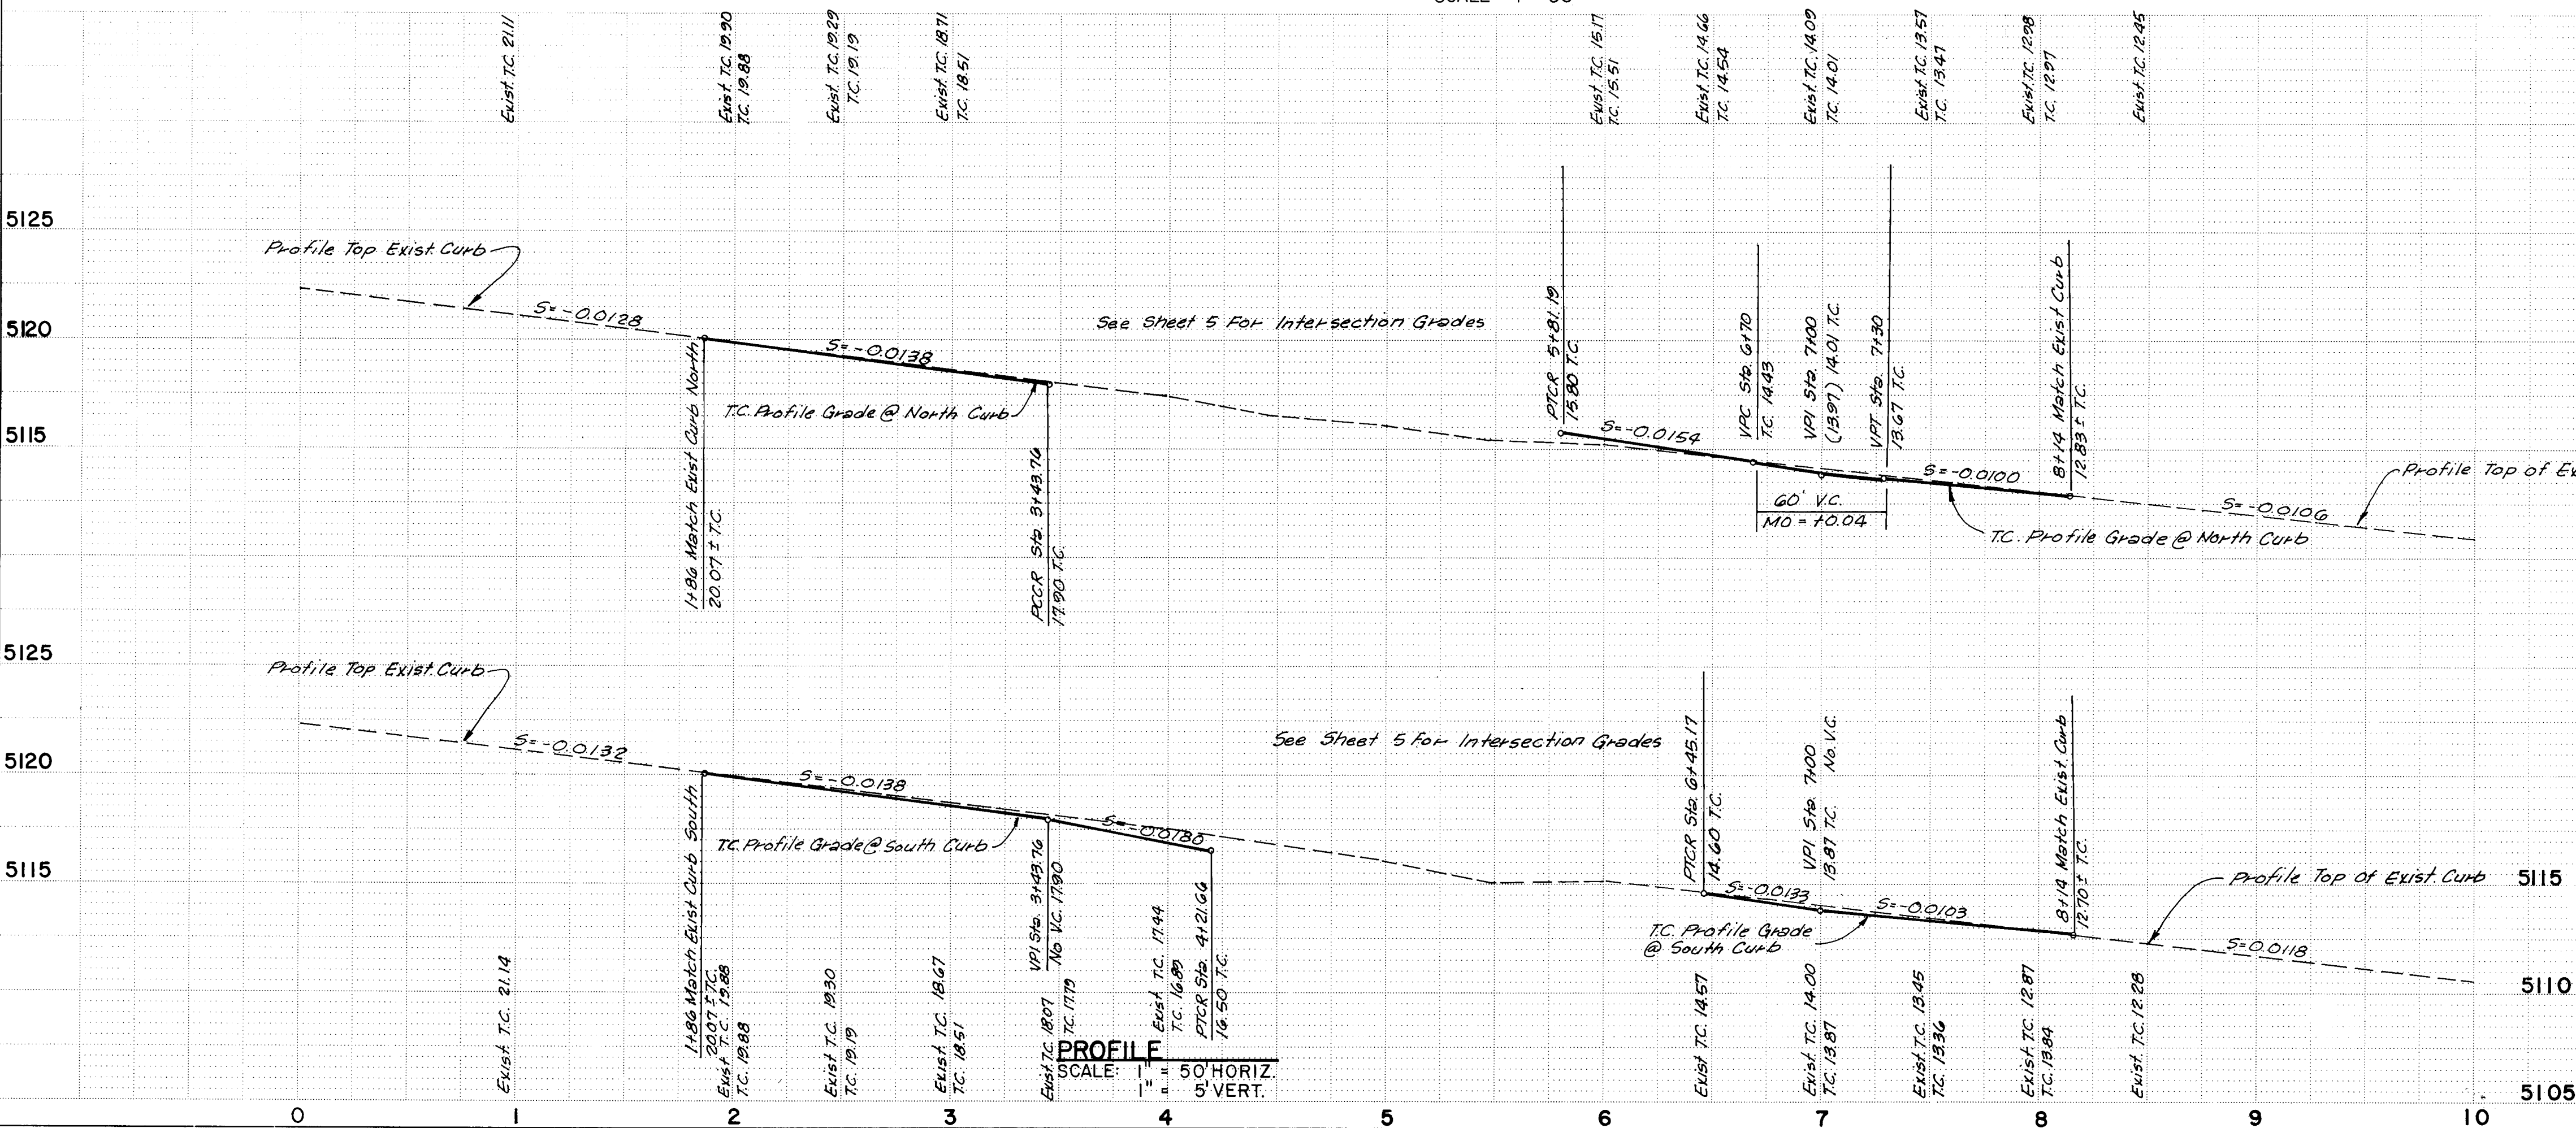

1. STATIONING SHOWN ON THIS SHEET IS REFERENCED TO BLUEWATER CONSTRUCTION.
2. SEE SHEET 5 FOR CURB RETURN CURVE DATA, ISLANDS CURVE DATA, AND PULL BOX AND CONDUIT PLACEMENT. SEE SHEET 10 FOR WATER AND SEWER PLAN AND PROFILE AND SEE SHEET 13 FOR STORM DRAIN PLAN AND PROFILE.
3. SAW CUT OR BLADE CUT EXISTING ASPHALT PAVEMENT 2' FROM LIP OF GUTTER WHERE INDICATED

RECORD DRAWING

PLANS PREPARED UNDER THE DIRECTION OF <i>Charles W. Troschke, Inc.</i>	CITY OF ALBUQUERQUE MUNICIPAL DEVELOPMENT DEPARTMENT TITLE: PAVING DETAILS - BLUEWATER / USNR <table border="1" style="width: 100%; border-collapse: collapse;"> <tr> <th style="width: 25%;">APPROVALS</th> <th style="width: 25%;">ENGINEER</th> <th style="width: 25%;">DATE</th> <th style="width: 25%;">APPROVALS</th> <th style="width: 25%;">ENGINEER</th> <th style="width: 25%;">DATE</th> </tr> <tr> <td>City Engineer</td> <td><i>[Signature]</i></td> <td></td> <td>Liquid Waste</td> <td><i>NA James J.</i></td> <td><i>1/4/84</i></td> </tr> <tr> <td>A.C.E. - Design</td> <td></td> <td></td> <td>Traffic</td> <td><i>T.E. Kennedy</i></td> <td><i>1/4/84</i></td> </tr> <tr> <td>A.C.E. - Hydrology</td> <td><i>Jim Zisch</i></td> <td><i>1/4/84</i></td> <td>Water</td> <td><i>NA James J.</i></td> <td><i>1/4/84</i></td> </tr> </table>	APPROVALS	ENGINEER	DATE	APPROVALS	ENGINEER	DATE	City Engineer	<i>[Signature]</i>		Liquid Waste	<i>NA James J.</i>	<i>1/4/84</i>	A.C.E. - Design			Traffic	<i>T.E. Kennedy</i>	<i>1/4/84</i>	A.C.E. - Hydrology	<i>Jim Zisch</i>	<i>1/4/84</i>	Water	<i>NA James J.</i>	<i>1/4/84</i>
APPROVALS	ENGINEER	DATE	APPROVALS	ENGINEER	DATE																				
City Engineer	<i>[Signature]</i>		Liquid Waste	<i>NA James J.</i>	<i>1/4/84</i>																				
A.C.E. - Design			Traffic	<i>T.E. Kennedy</i>	<i>1/4/84</i>																				
A.C.E. - Hydrology	<i>Jim Zisch</i>	<i>1/4/84</i>	Water	<i>NA James J.</i>	<i>1/4/84</i>																				