

PROJECT DATA:

LAND DESCRIPTION ARROYO DEL OSO

Tract: _____
 Lot(s): _____
 Block: _____
 Addition: MUNICIPAL ADDITION NO. 10
 Zoned: _____ Map Reference: P-182
STRUCTURAL DESIGN CRITERIA
 Roof Live Load: 20 PSF
 Floor Live Loads:
 Basement: _____
 First: 10 PSF LUNCH/LOBBY/REPAIR/STOR.
 (LOFT) 100 PSF
 Mezzanine: _____
 Second: _____
 Third: _____
 Wind Load: 25 PSF
 Seismic Zone: 2
 Fire Zone: _____
 Type of Construction: III
 Occupancy: B-1 & B-2
 Stress Values:
 Lumber: 1200 F
 Steel: 2400 PSI
 Soil Bearing Capacity: 2200 PSF

CONCRETE STRENGTHS, 28 DAY TEST

Block Fill: _____
 Floor Slabs, Bond Beams: 3000 PSI
 Footings, Walls: 3000 PSI
 Exterior Walks, Slabs, Etc.: 2200 PSI AIR ENTRAINED

FLOOR AREAS SQ. FT. ALLOWABLE

Basement: _____
 First: 1000 (2500) _____
 Mezzanine: 560 (2500) _____
 Second: _____
 Third: _____
 Total Area: 10,000 (25,000) _____
 Occupant Load: _____
 Parking Required: _____
 Parking Provided: _____

REFUSE CONTAINERS



GENERAL NOTES

- Affected Contractors to verify exact location of all utilities.
- General Contractor to be responsible for compliance with requirements of city of Albuquerque Dept. of Environmental Health, Air Management Division, regarding control of dust from excavation and grading operations. Contractor to obtain topsoil removal permit.

EXISTING
 2" DEEP TANK

NOTE: CONTR. TO VERIFY & LOCATE ALL
 UNDERGROUND UTILITIES PRIOR
 TO EXCAVATION.

ARROYO DEL OSO
SITE PLAN
 SCALE: 1" = 20'-0"

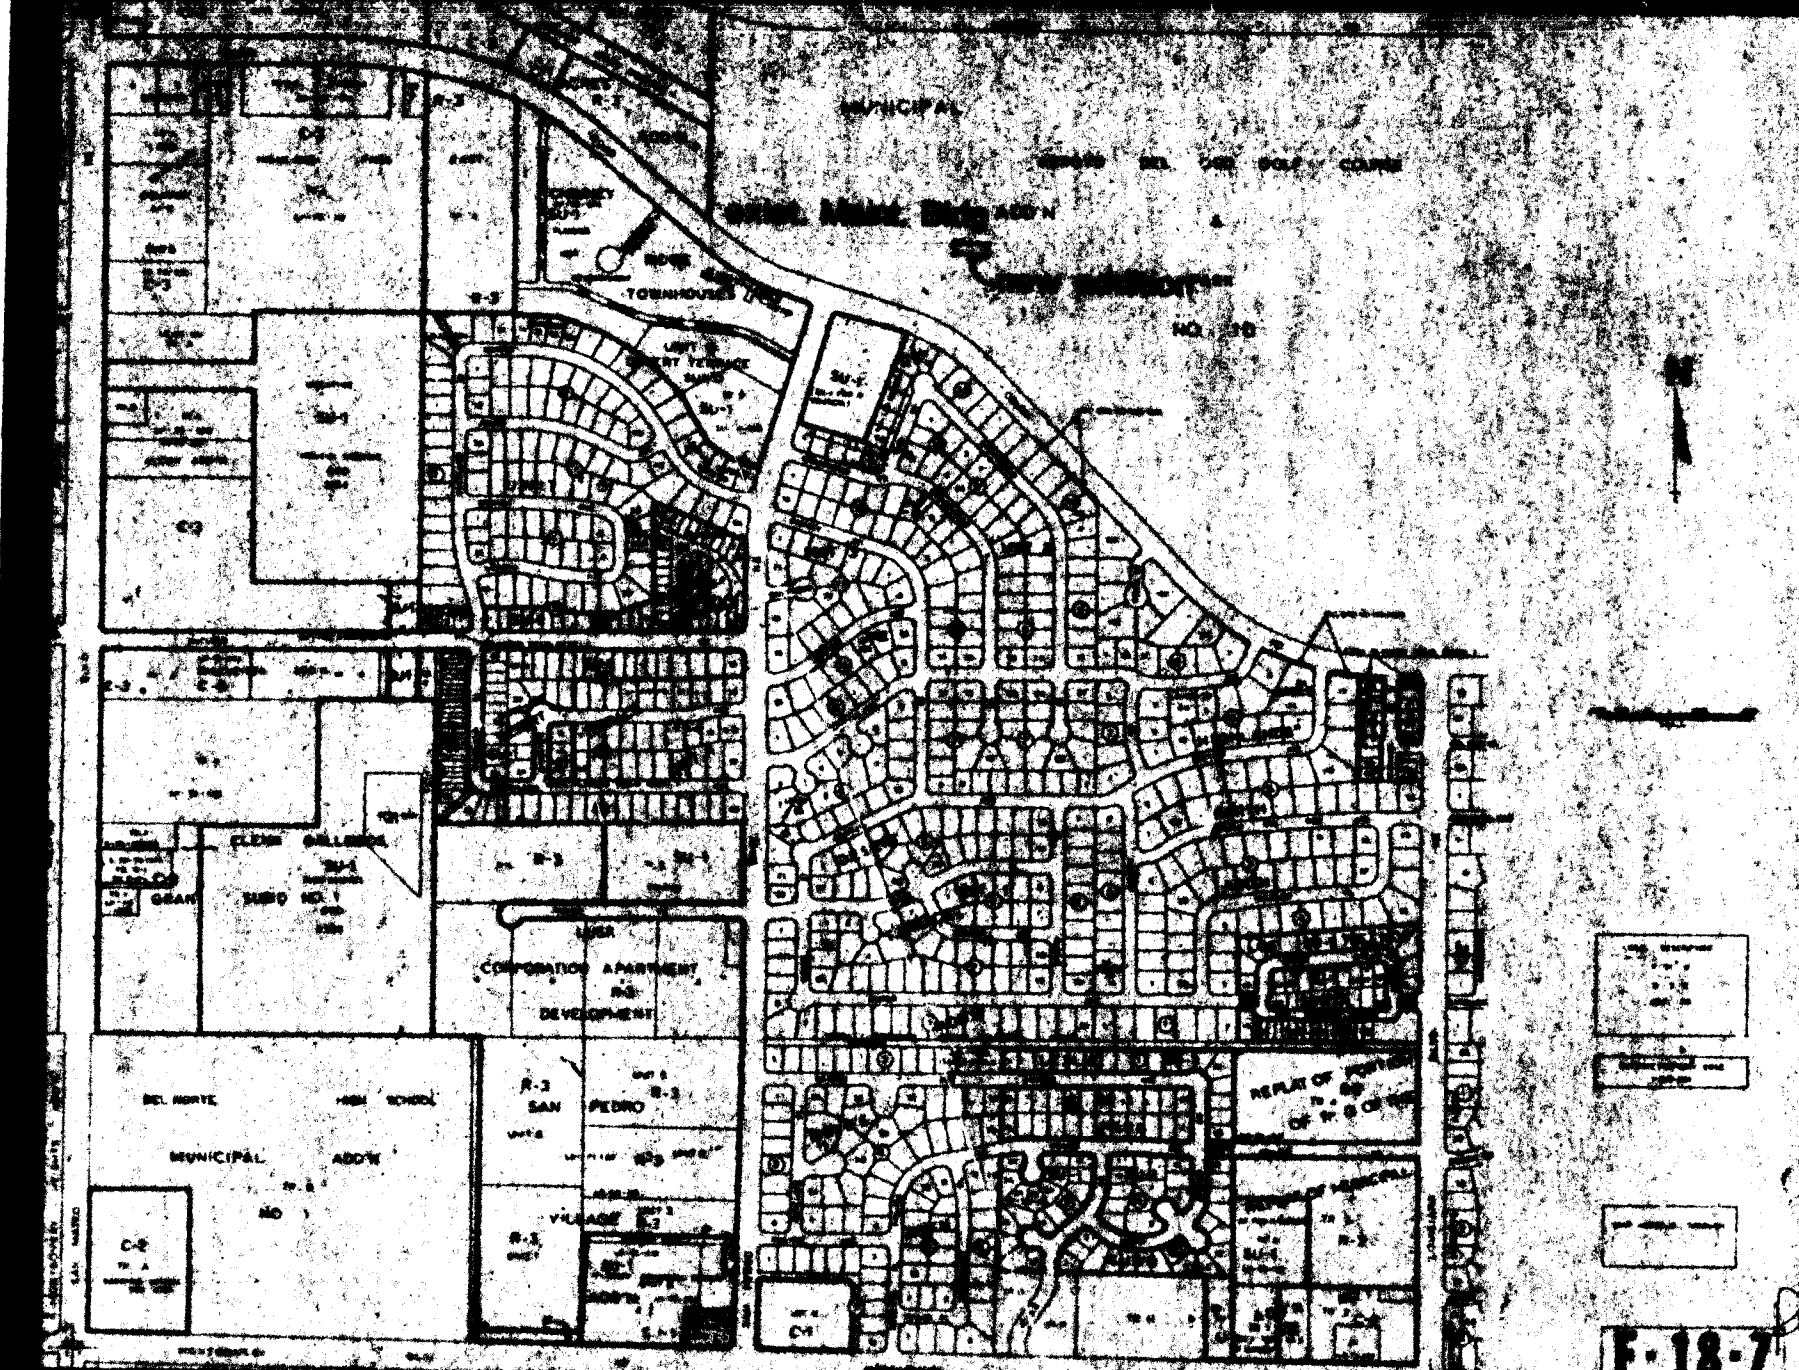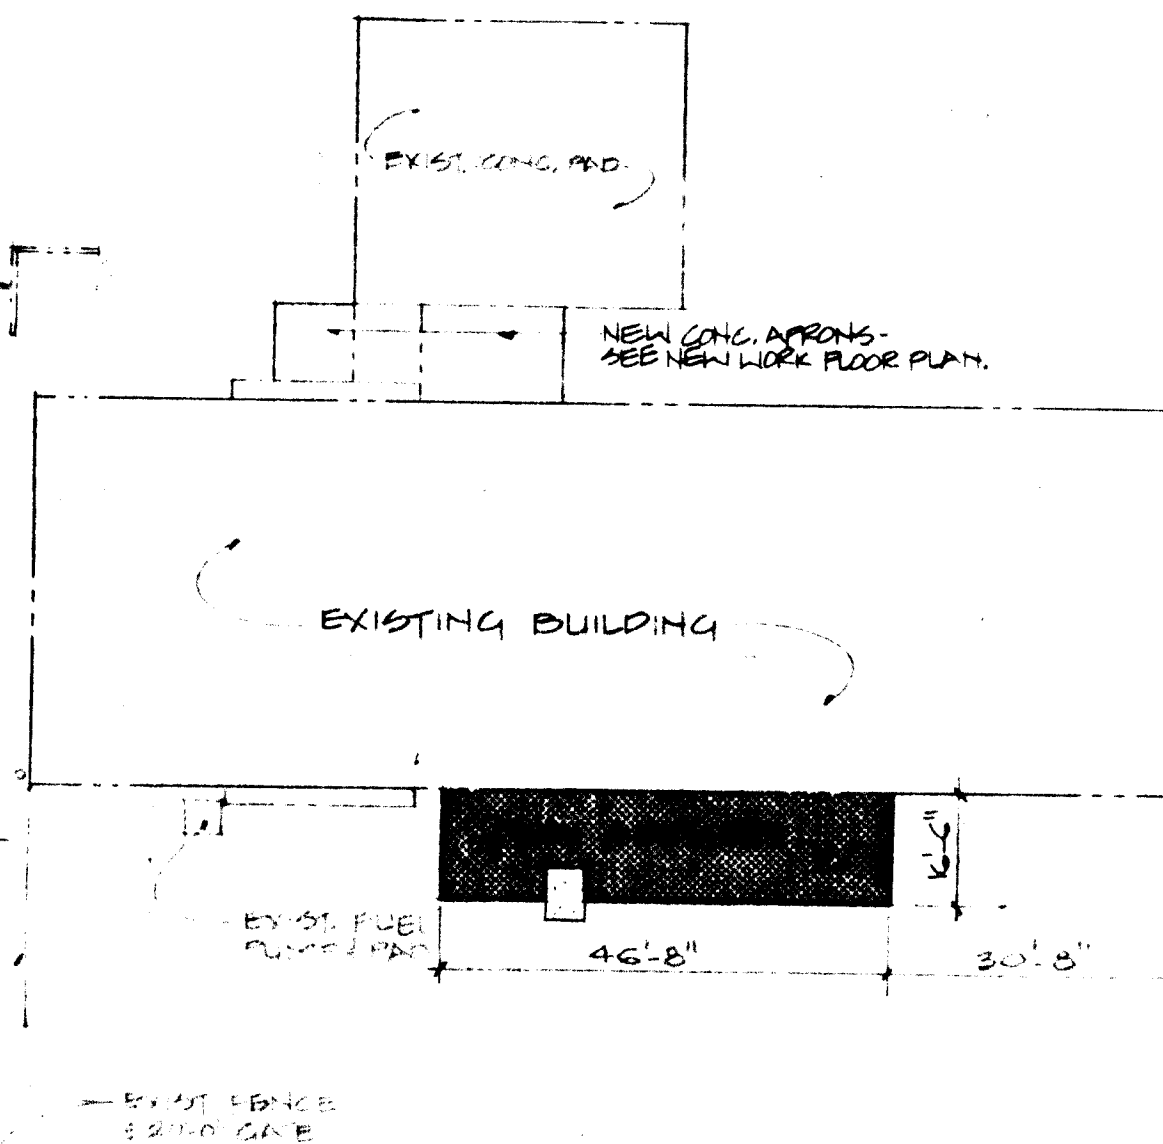

LOCATION PLAN

INDEX TO DRAWINGS

ARROYO DEL OSO	SPORTS STADIUM
1 SITE PLAN, PROJECT DATA, ENERGY CALCULATIONS	17 SITE PLAN, PROJECT DATA, ENERGY CALCULATIONS
2 DRAINAGE INFORMATION AND DETAILS	18 DRAINAGE INFORMATION AND DETAILS
3 DEMOLITION AND REMOVAL PLAN AND NOTES	19 DEMOLITION AND REMOVAL, FLOOR PLAN, SCHEDULES
4 FLOOR PLAN, FOUNDATION & FRAMING, SCHEDULES	20 ELEVATIONS AND SECTIONS
5 ELEVATIONS AND SECTIONS	21 UTILITY SITE PLAN, HVAC AND PLUMBING
6 DETAILS	22 ELECTRICAL LIGHTING AND POWER
7 UTILITY SITE PLAN, HVAC AND PLUMBING	
8 ELECTRICAL LIGHTING AND POWER	
LOS ALTOS	PUERTO DEL SOL
9 SITE PLAN, PROJECT DATA, ENERGY CALCULATIONS	23 SITE PLAN, PROJECT DATA, ENERGY CALCULATIONS
10 DRAINAGE INFORMATION AND CALCULATIONS	24 DRAINAGE INFORMATION AND DETAILS
11 DEMOLITION AND REMOVAL PLAN AND NOTES	25 DEMOLITION AND REMOVAL, FLOOR PLANS, SCHEDULES
12 FLOOR PLANS, FOUNDATION & FRAMING, SCHEDULES	26 ELEVATIONS AND SECTIONS
13 ELEVATIONS, SECTIONS	27 DETAILS
14 DETAILS	28 UTILITY SITE PLAN, HVAC, PLUMBING
15 UTILITY SITE PLAN, HVAC AND PLUMBING	29 ELECTRICAL LIGHTING AND POWER
16 ELECTRICAL LIGHTING AND POWER	

MAINTENANCE AND STORAGE FACILITIES PARKS AND RECREATION DEPARTMENT CITY OF ALBUQUERQUE

ARROYO DEL OSO GOLF COURSE

UBC CHAPTER 53 REQUIREMENTS

PROJECT: ARROYO DEL OSO GOLF COURSE ADDITION BLDG. TYPE B-1 Page 1 of 1

	Summer	Winter	Degree Days	Latitude
Inside	78°F	70°F	3911	35°
Outside	91°F	17°F	"U", Roof, Max. = 0.09	By: JOH
Difference	19°F	53°F	"U", Wall, Max. = 0.02	Date: 10/1/02
			OTTV, Max. = 0.2	

WALL TYPE "A": TO ea = 4.4	WALL TYPE "B": TO ea = 4.4	ROOF TYPE "A": TO ea = 1.2	ROOF TYPE "B": TO ea = 1.2
OSA STEEL PANEL INSUL ISA	OSA STEEL PANEL INSUL ISA	OSA STEEL PANEL INSUL ISA	OSA STEEL PANEL INSUL ISA
0.17	0.17	0.17	0.17
0.0	0.0	0.0	0.0
11.0	11.0	11.0	11.0
0.68	0.68	0.68	0.68
Total "R" Value	11.85	Total "R" Value	11.85
Total "U" Value	0.084	Total "U" Value	0.084
Aver. "U" Value	0.084	Aver. "U" Value	0.084


WALL TYPE "A": TO ea = 4.4	WALL TYPE "B": TO ea = 4.4	ROOF TYPE "A": TO ea = 1.2	ROOF TYPE "B": TO ea = 1.2
WALL TYPE "A" = 295 #	WALL TYPE "B" = 1125	ROOF TYPE "A" = 1400 #	ROOF TYPE "B" = 1400 #
GLAZING AREA "A" = 48	GLAZING AREA "B" = 48	SKYLIGHT AREA =	SKYLIGHT AREA =
DOOR AREA "A" = 145	DOOR AREA "B" = 145	ROOF VENT AREA =	ROOF VENT AREA =
DOOR AREA "B" = 100	DOOR AREA "C" = 100	OTHER (ROOF "B") = 136	OTHER (ROOF "B") = 136
DOOR AREA "C" =	DOOR AREA "D" =	OTHER =	OTHER =
GROSS WALL AREA = 2513 #	GROSS WALL AREA = 2513 #	GROSS ROOF AREA = 2422 #	GROSS ROOF AREA = 2422 #

WALLS	ROOF
U ₀ = 0.95(0.084) + 1125(0.056) + 48(0.58) + 145(0.54) + 100(0.52) = 2313	U ₀ = 1086(0.084) + 736(0.049) = 2422
U ₀ = 0.13 < 0.32 : OK	U ₀ = 0.07 < 0.09 : OK

HEATING	COOLING
U ₀ = 0.95(0.084) + 1125(0.056) + 48(0.58) + 145(0.54) + 100(0.52) = 2313	U ₀ = 1086(0.084) + 736(0.049) = 2422
U ₀ = 0.13 < 0.32 : OK	U ₀ = 0.07 < 0.09 : OK

WALLS	ROOF
U ₀ = 0.95(0.084) + 1125(0.056) + 48(0.58) + 145(0.54) + 100(0.52) = 2313	U ₀ = 1086(0.084) + 736(0.049) = 2422
U ₀ = 0.13 < 0.32 : OK	U ₀ = 0.07 < 0.09 : OK


WALLS	ROOF
U ₀ = 0.95(0.084) + 1125(0.056) + 48(0.58) + 145(0.54) + 100(0.52) = 2313	U ₀ = 1086(0.084) + 736(0.049) = 2422
U ₀ = 0.13 < 0.32 : OK	U ₀ = 0.07 < 0.09 : OK

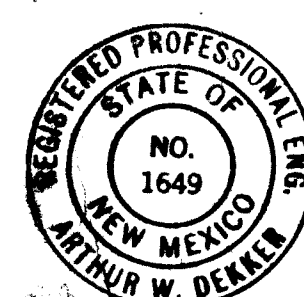

dekker & associates
 architects & engineers & planners
 2401 San Mateo NE, Suite P-15 Albuquerque, New Mexico 87111
 Phone: 505-241-3639

ARROYO DEL OSO GOLF COURSE 7001 osuna rd n e
 albuquerque n.m.


Job no. 0208
 drn by JOH
 ckd by ALP
 issued 2-1-00
 hold date revision

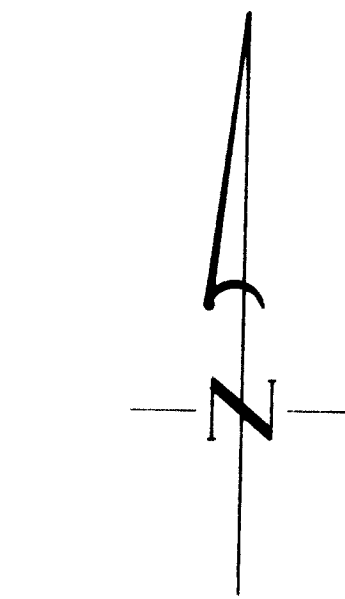

SCALE 1"=10'-0"

NOTES:
ELEVATIONS ARE BASED ON BENCH MARK NO. 2F-1R, A BRASS CAP SET IN CONCRETE INSIDE THE CENTER MEDIAN ON HIGHWAY ROAD NE, NORTH OF THE ARROYO DEL ORO GOLF COURSE, OPPOSITE FIRST HOME NO. 15. ELEVATION = 5134.96 (MAY 1929)
SET TB14, TOP OF CONCRETE FOOTING AT NW CORNER OF BLDG. (WEST SIDE OF BLDG.) ELEVATION = 5288.37
20' GRID ORIGINATING AT NW CORNER OF BLDG. BASE WAS 50' NORTH OF BLDG.
1' ELEV. CONTOUR INTERVALS
DRAINAGE PLAN IS BASED ON FIELD SURVEY DATA AND AERIAL PHOTOGRAPHY.

This drawing is the property of Dekker & Associates, Inc. and is not to be reproduced or used in any way without the written consent of Dekker & Associates, Inc. All rights reserved.

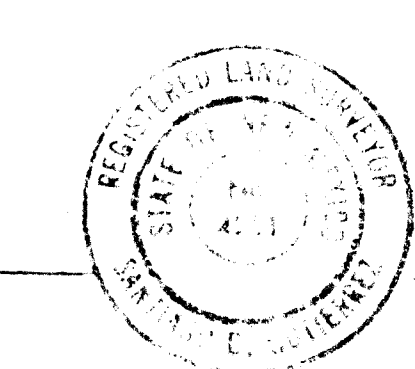

SY 180-1661-2
112 EXISTING ELEVATION
0882 NEW ELEVATION
ELEV. 5288.37

26 1061 0283

DRAINAGE PLAN		
NO.	DESCRIPTION	REMARKS
1	EXISTING	
2	NEW	
3	NEW	
4	NEW	
5	NEW	
6	NEW	
7	NEW	
8	NEW	
9	NEW	
10	NEW	
11	NEW	
12	NEW	

NOTE: DRAINAGE PLAN IS BASED ON FIELD SURVEY DATA AND AERIAL PHOTOGRAPHY. ALL ELEVATIONS ARE IN FEET ABOVE SEA LEVEL. THE DRAINAGE PLAN IS NOT TO BE USED FOR ANY OTHER PURPOSES WITHOUT THE WRITTEN CONSENT OF DEKKER & ASSOCIATES, INC.




1661

dekker & associates
architects & engineers & planners
2403 San Mateo, NE suite P15 Albuquerque, New Mexico 87110 505.884.3689


job no. 0208
drn by JCH
ckd by
issued 2-3-08
no date revision

12-20-08

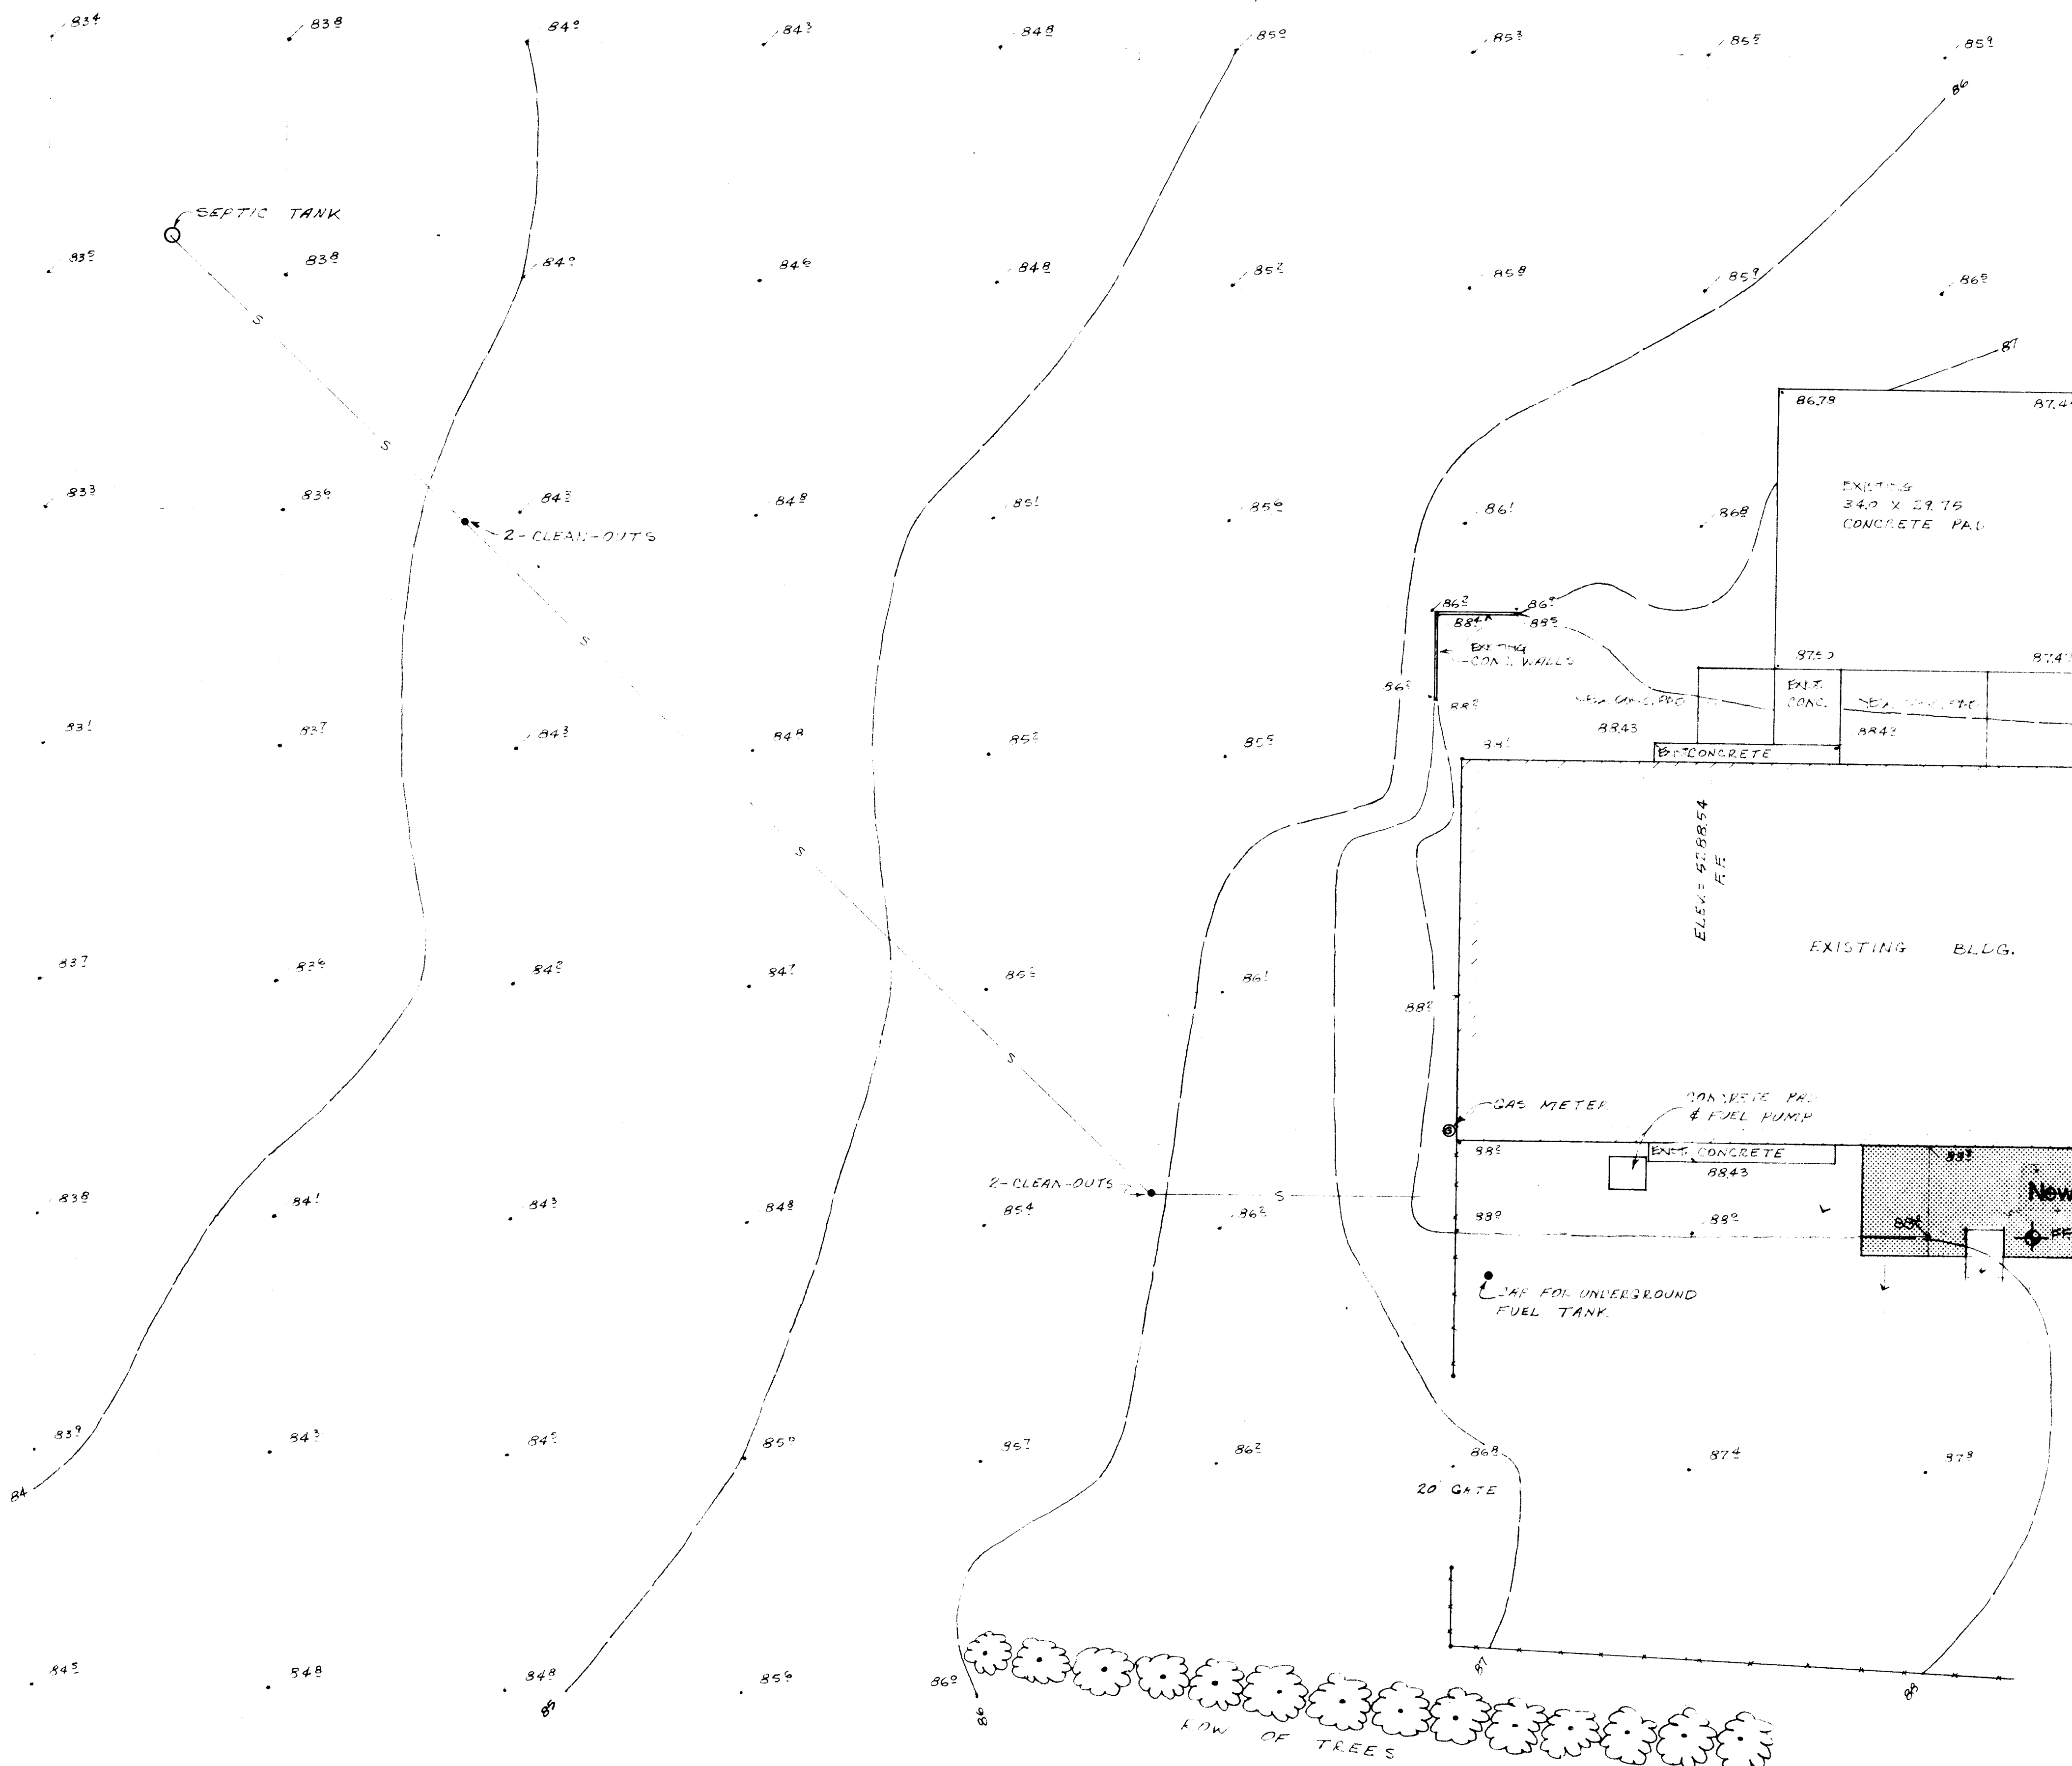


1/2 SITE DRAINAGE PLAN
1"=10'-0"




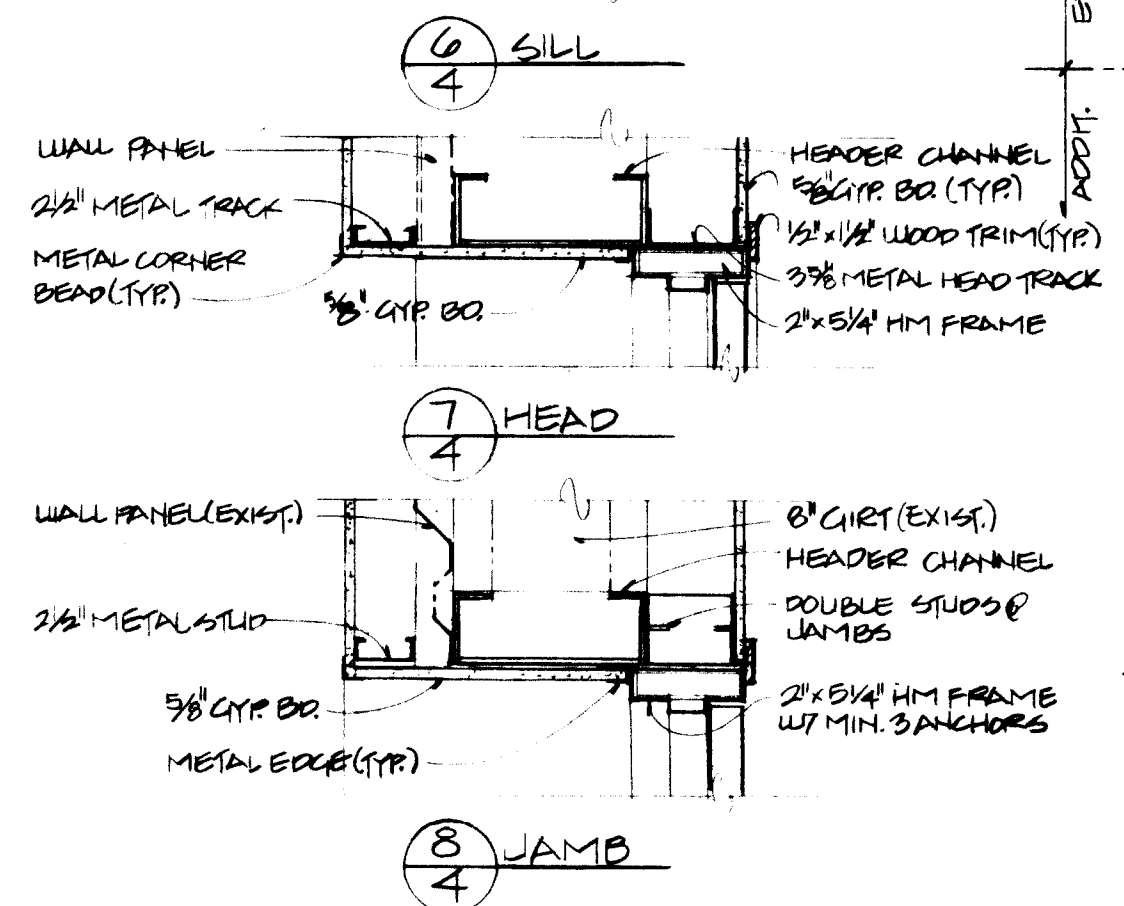

DOOR SCHEDULE													
MARK	SIZE	H	W	MATERIALS		FRAME DETAILS			HARDWARE				REMARKS
				WOOD	METAL	HEAD	JAMB	SILL	BUTTS 1/2 PR	LOCKSET	STOP	HOLDER	
1, 16 20A	3'-0" x 6'-8"	3 1/4"	A	—	HM	9	0	11	F-79 1 FBS 7/8 4 1/2" x 4 1/2"	W-815	—	544H 43	DOOR #1 ONLY (WEATHERSTRIP) SEE SPEC.
2, 3	3'-0" x 6'-8"	3 1/4"	B	SC	—	12	13	—	PR 2060 1 FBS 7/8 4 1/2" x 4 1/2"	W-815	W-812	—	1 HR LABELED DOOR & FRAME
B	2'-8" x 6'-8"	1 3/4"	B	SC	—	12	13	14	PR 2060 1 FBS 7/8 4 1/2" x 4 1/2"	W-815	W-812	—	1 HR LABELED DOOR & FRAME
4, 5	2'-8" x 6'-8"	1 3/8"	B	HC	—	12	13	—	F-79 3 1/2" x 3 1/2"	W-815	W-812	—	
6, 8	2'-8" x 6'-8"	1 3/8"	B	HC	—	7	8	—	F-79 3 1/2" x 3 1/2"	W-815	W-812	—	DOOR #2 SIM. - SEE DETAIL (6) FOR WALL CONST.
1	3'-0" x 6'-8"	1 3/8"	B	HC	—	7	8	—	F-79 3 1/2" x 3 1/2"	W-815	—	544C A	
9 8	2'-8" x 6'-8" 2'-8" x 6'-8"	1 3/4" 3/4"	B SC	SC	—	12	13	14	PR 2060 1 FBS 7/8 4 1/2" x 4 1/2"	W-815	W-812	—	1 HR LABELED DOOR & FRAME
10 20B	2'-8" x 6'-8" 2'-8" x 6'-8"	1 3/4" 3/4"	B SC	SC	—	12	13	—	PR 2060 1 FBS 7/8 4 1/2" x 4 1/2"	W-815	W-812 ON DOOR	—	1 HR LABELED DOOR & FRAME
11	2'-8" x 6'-8"	1 3/4"	B	SC	—	12	13	—	PR 2060 1 FBS 7/8 4 1/2" x 4 1/2"	W-815	W-812	—	1 HR LABELED DOOR & FRAME
12	2'-8" x 6'-8"	3"	D	SC	—	12	13	—	F-79 4 1/2" x 4 1/2"	W-815	W-812	—	DOOR WITH 26" W. 12" H. LOUVER
14, 15	0'-0" x 3'-6"	—	RU	—	STEEL	4	5	6	—	STANDARD W/ DOOR	—	—	
17	PR 4'-0" x 8'-0"	1 3/4"	C	—	HM	12	13	—	2 PR PER L FBS 1 1/8 4 1/2" x 4 1/2"	W-815	W-812	—	1 HR LABELED DOOR & FRAME
19, 20C	3'-0" x 6'-8"	1 3/4"	A	—	HM	7	8	—	PR 2060 1 FBS 7/8 4 1/2" x 4 1/2"	W-815	W-812	—	1 HR LABELED DOOR & FRAME

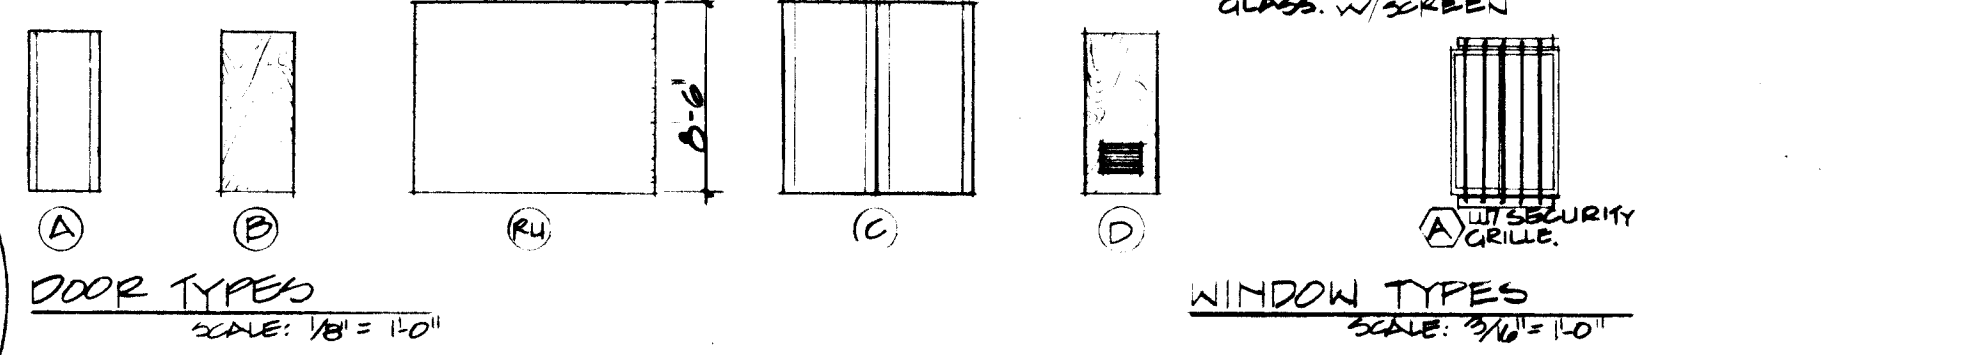

FINISH SCHEDULE																	
W N E S WALL & BASE FINISH ORIENTATION	FLOOR	BASE	WALLS				CEILING				REMARKS						
	SEALER OR EXPOSED CONC.	VINYL MASTIC TILE	A VINYL	A TIGHT MEMORY	NONE	GYP BO. TAPE ED ONLY	METAL PANELS & EXPOSED STRUCT.	GYP BO. TEXTURED PAINT	METAL PANELS			EXPOSED STRUCT.	9" X 12" GYP BO. TAPE ED ONLY	9" X 12" GYP BO. TAPE ED ONLY	9" X 12" GYP BO. TAPE ED ONLY	TEXTURE PAINTED	HEIGHT
ROOM OR AREA																	
EQUIP. STORAGE	○					●	○					○					9'-0" to 16'-0"
POST. STORAGE	●			●		●	○						●				8'-0"
PARTS	○					●	○					○					9'-0" to 12'-0"±
REPAIR & MAINT.	○					●	○					○					9'-0" to 16'-0"±
IRREG. REPAIR						●	○					○					9'-0" to 12'-0"±
LUNCH		●	●					●	○					●			8'-0"
MECHANICAL	○					●	○					●					8'-0"
SHOWER		●	●					●	○					●			8'-0"
MEN		●	●					●	○					●			8'-0"
WOMEN		●	●					●	○					●			8'-0"
CONFERENCE		●	●					●	○					●			8'-0"
OFFICE #1		●	●					●	○			●	●				11'-0" to 14'-0"±
HALL								●	○					●			11'-0" to 14'-0"±
SECRETARY												●	●				11'-0" to 14'-0"±
OFFICE #2												●	●				11'-0" to 14'-0"±
OFFICE #3		●	●									●	●				11'-0" to 14'-0"±
SYMBOLS:																	
● NEW CONSTRUCTION																	
○ EXISTING CONST.																	
● NEW & EXIST. CONST. - SEE FLOOR PLANS																	



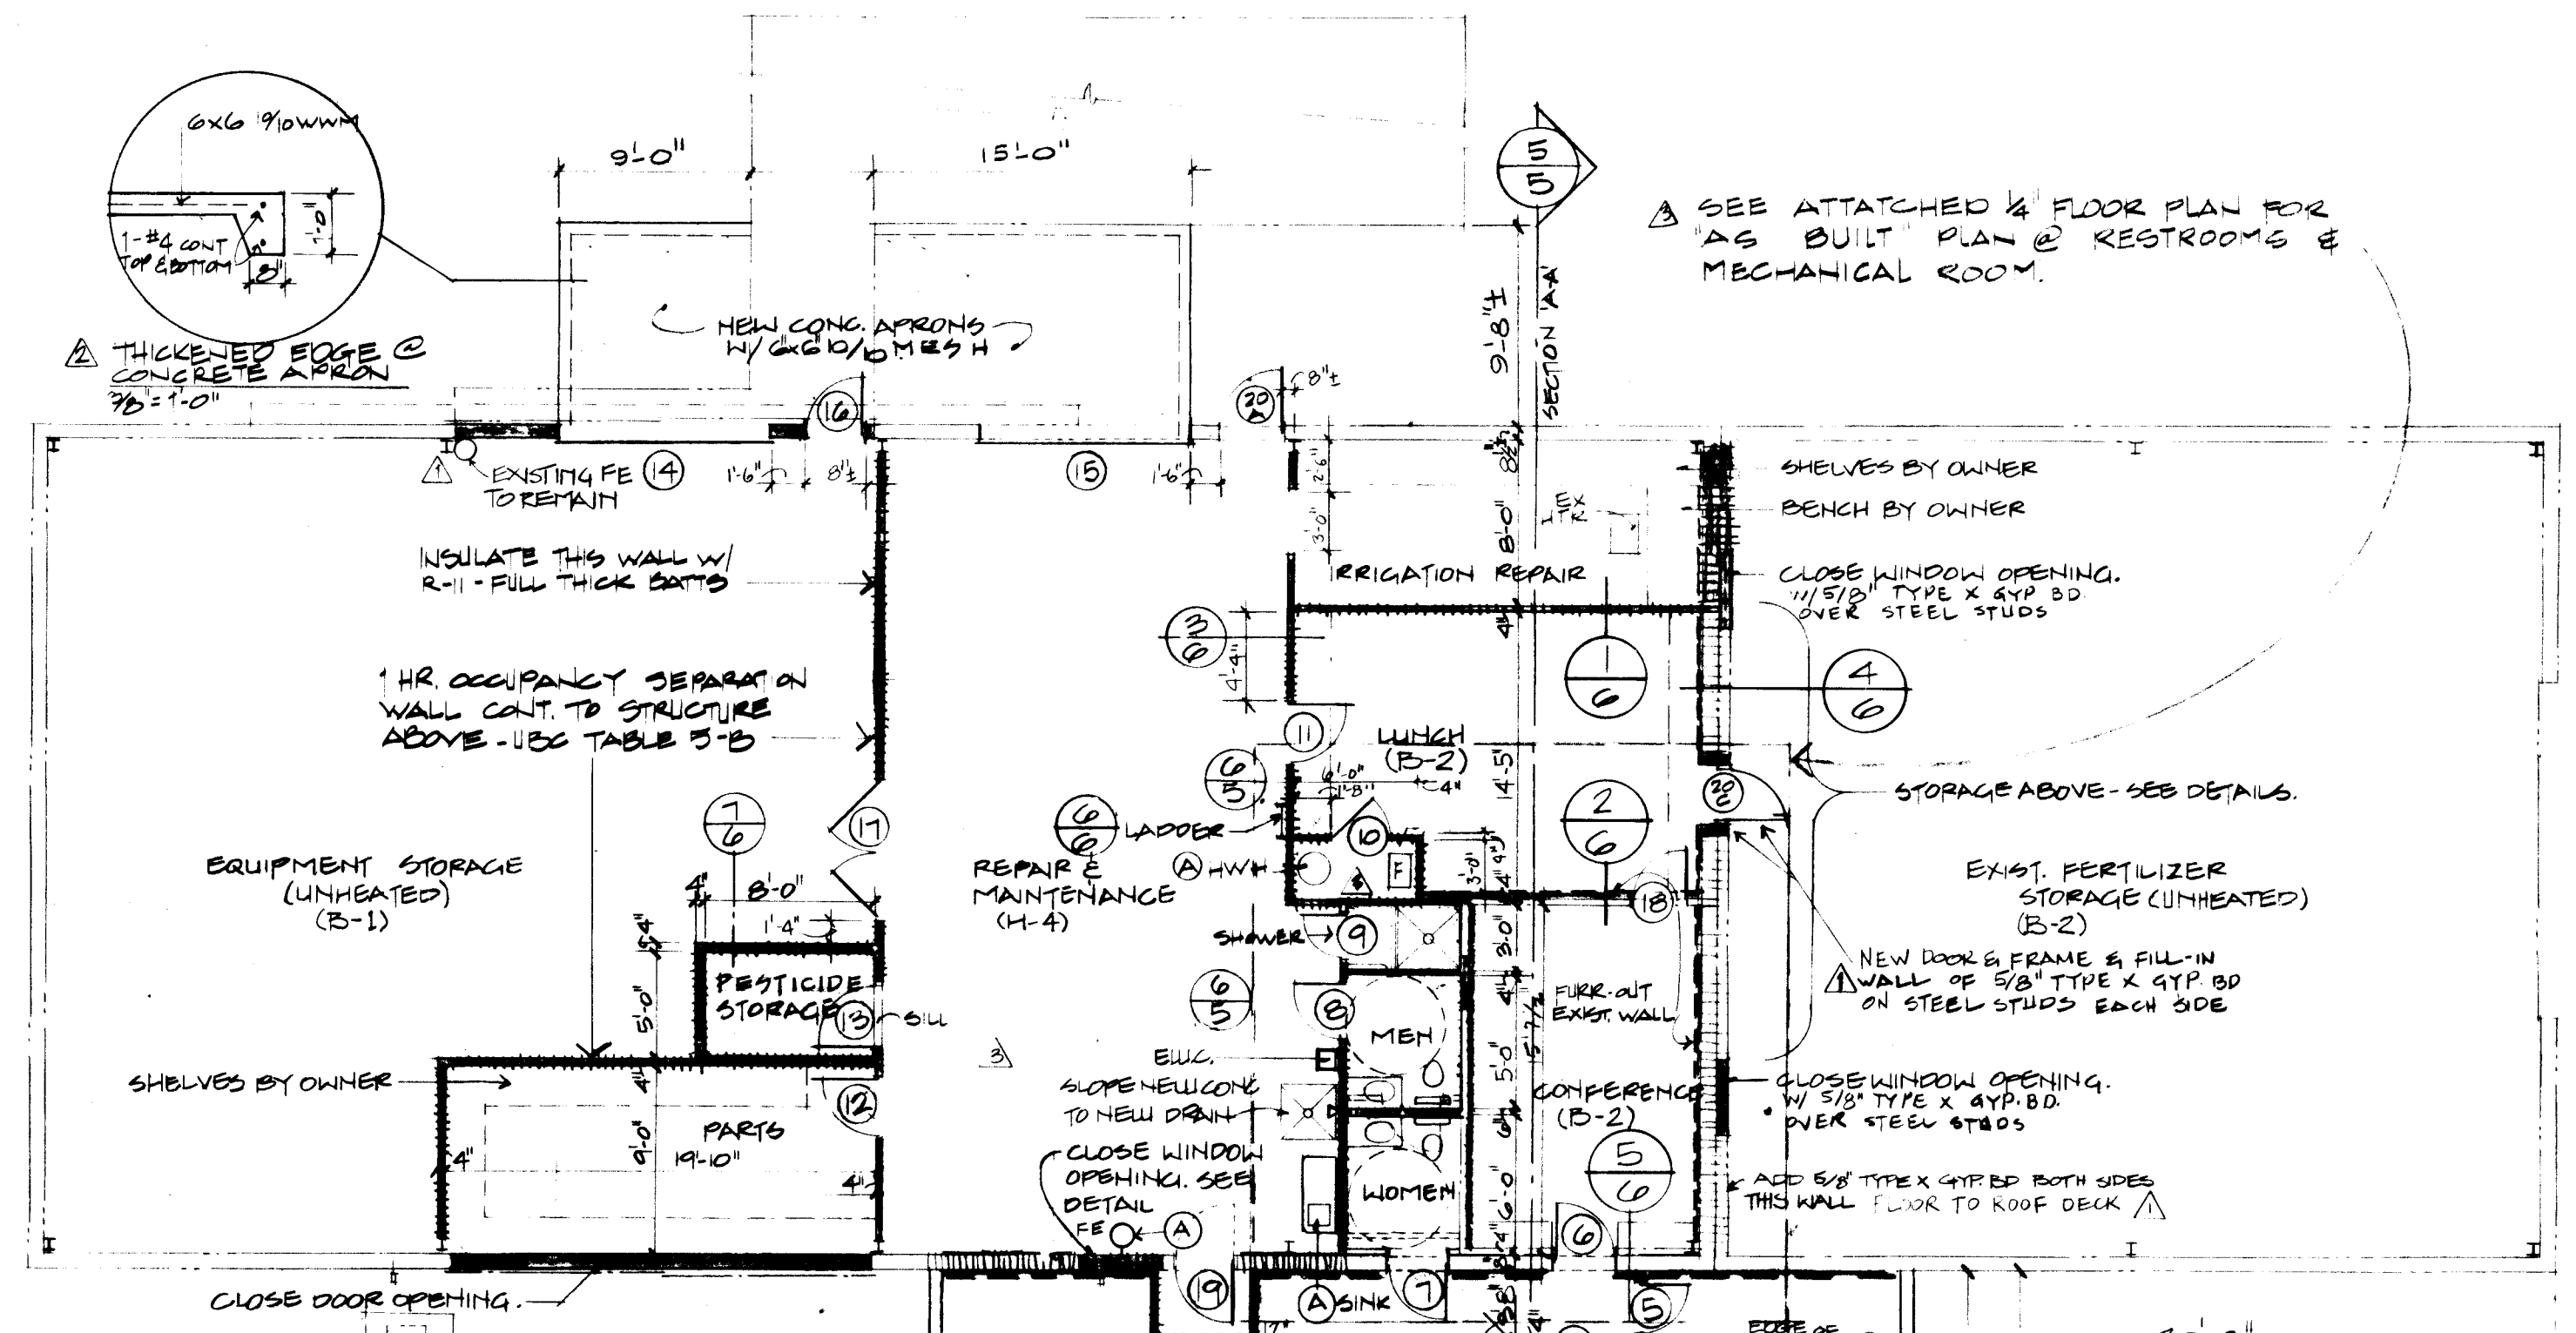


SYMBOLS:



- ===== STRUCTURAL STEEL STUD BEARING PARTITION-20 GA @ 24" OC
- ===== 20 GA STEEL STUD NON-BEARING PARTITION, OR FILL-IN 24" OC
- ===== 20 GA STUD STUD PART. W/ 7/8" TYPE X FIRE CODE GYPSO BOTH SIDES,
- ===== EXIST. WALLS W/ NEW 1/2" TYPE X BOTH SIDES, 1 HR.
- (A) RELOCATED ITEM.
- ===== EXIST. TO REMAIN
- ===== 2 1/2" STEEL STUD FIBER OR EXIST. WALL WITH 7/8" TYPE X GYPSO
- ===== 2 1/2" STUDS TO FURROW WALL W/ 7/8" GYPSO - USE 2" SOUND BATT.







LASON 1-505-344-9404
BEST COPY AVAILABLE

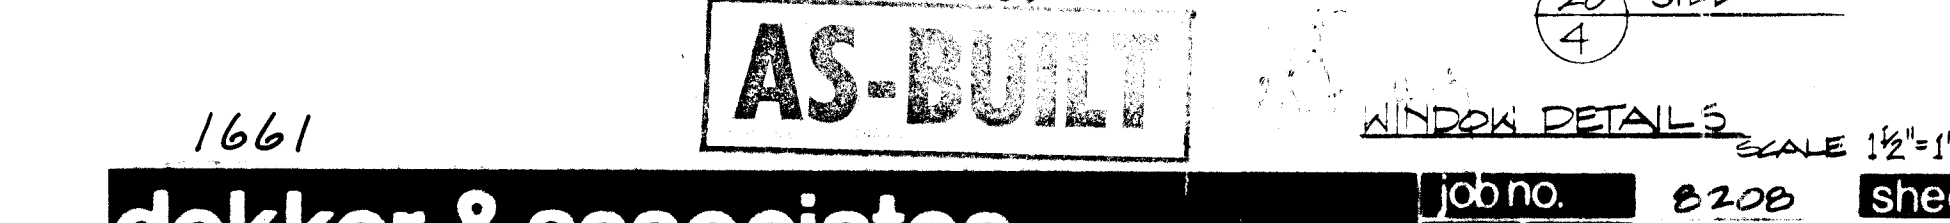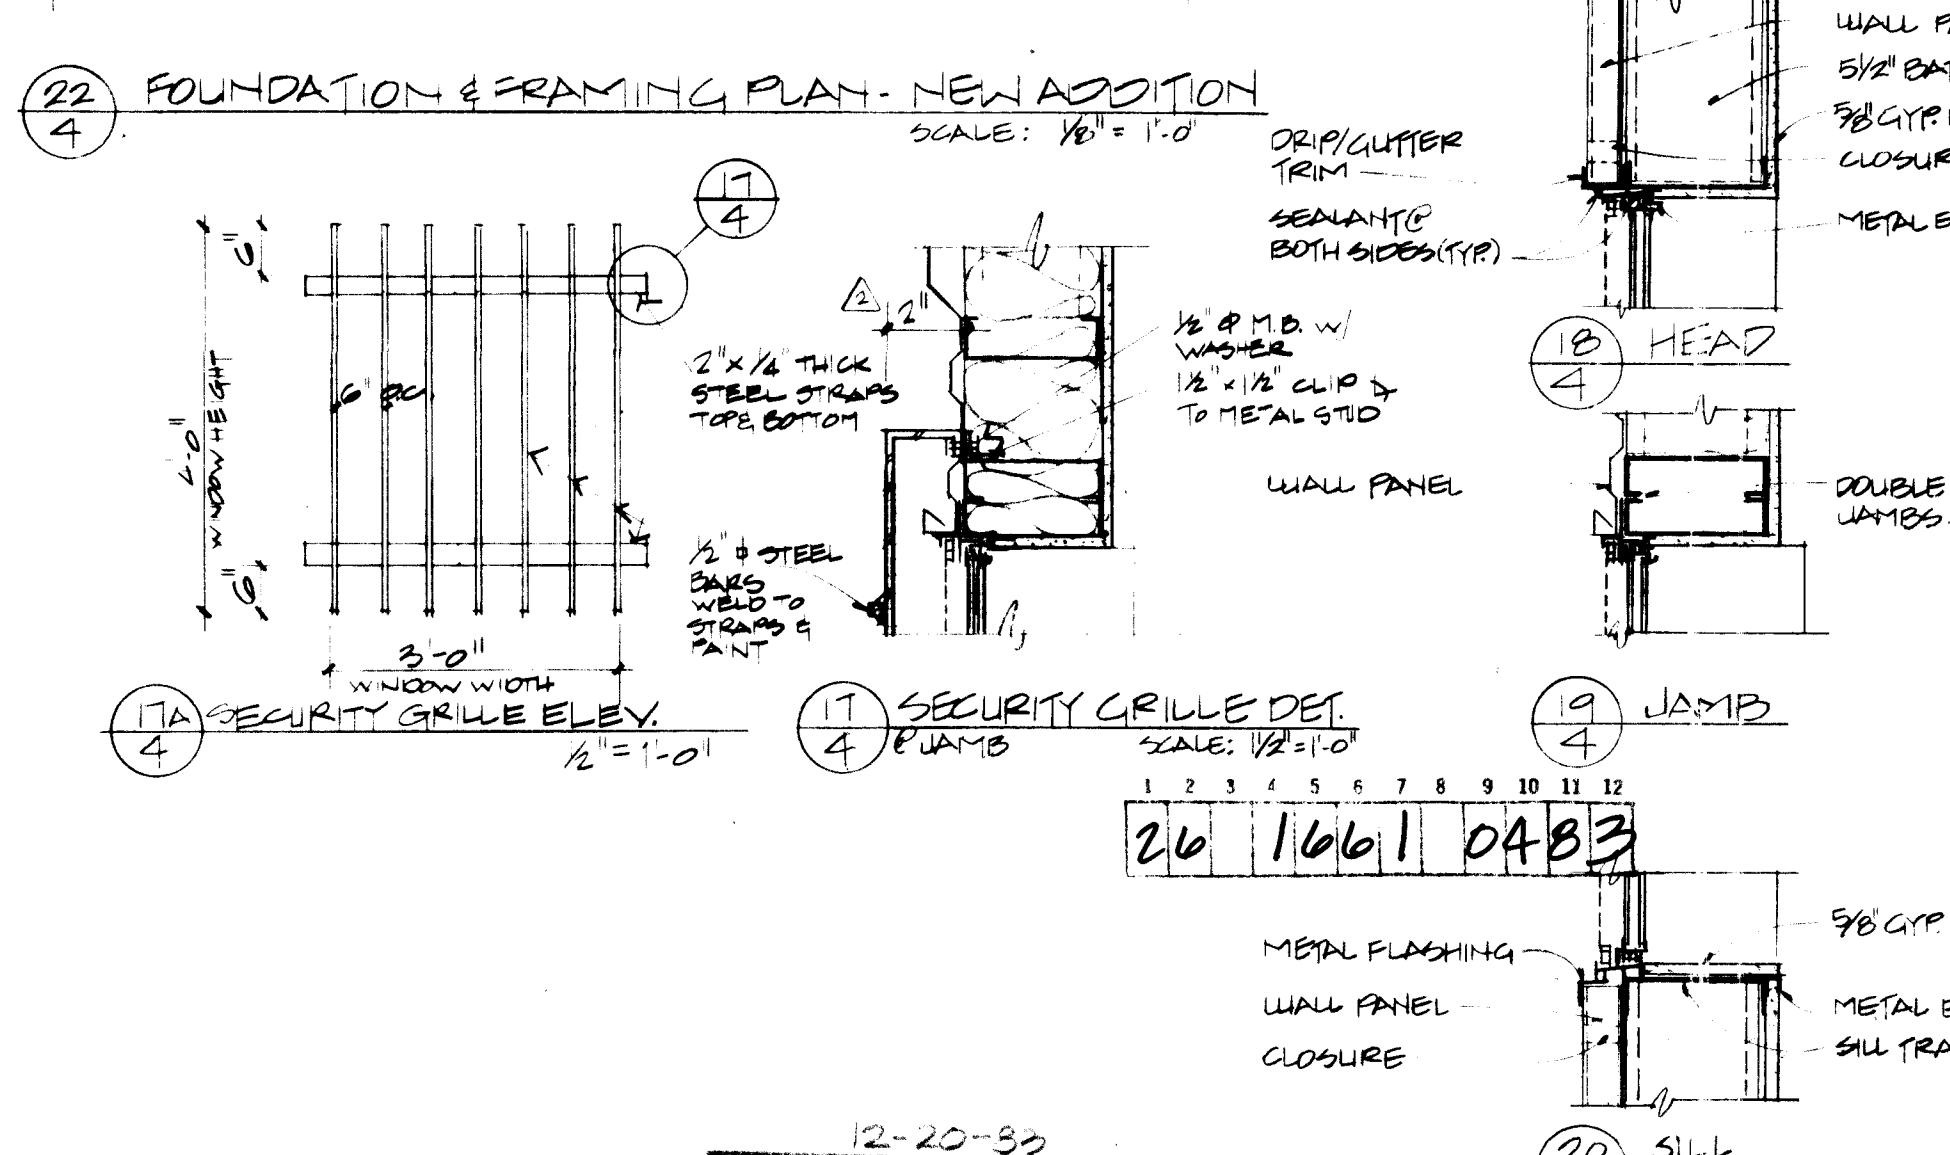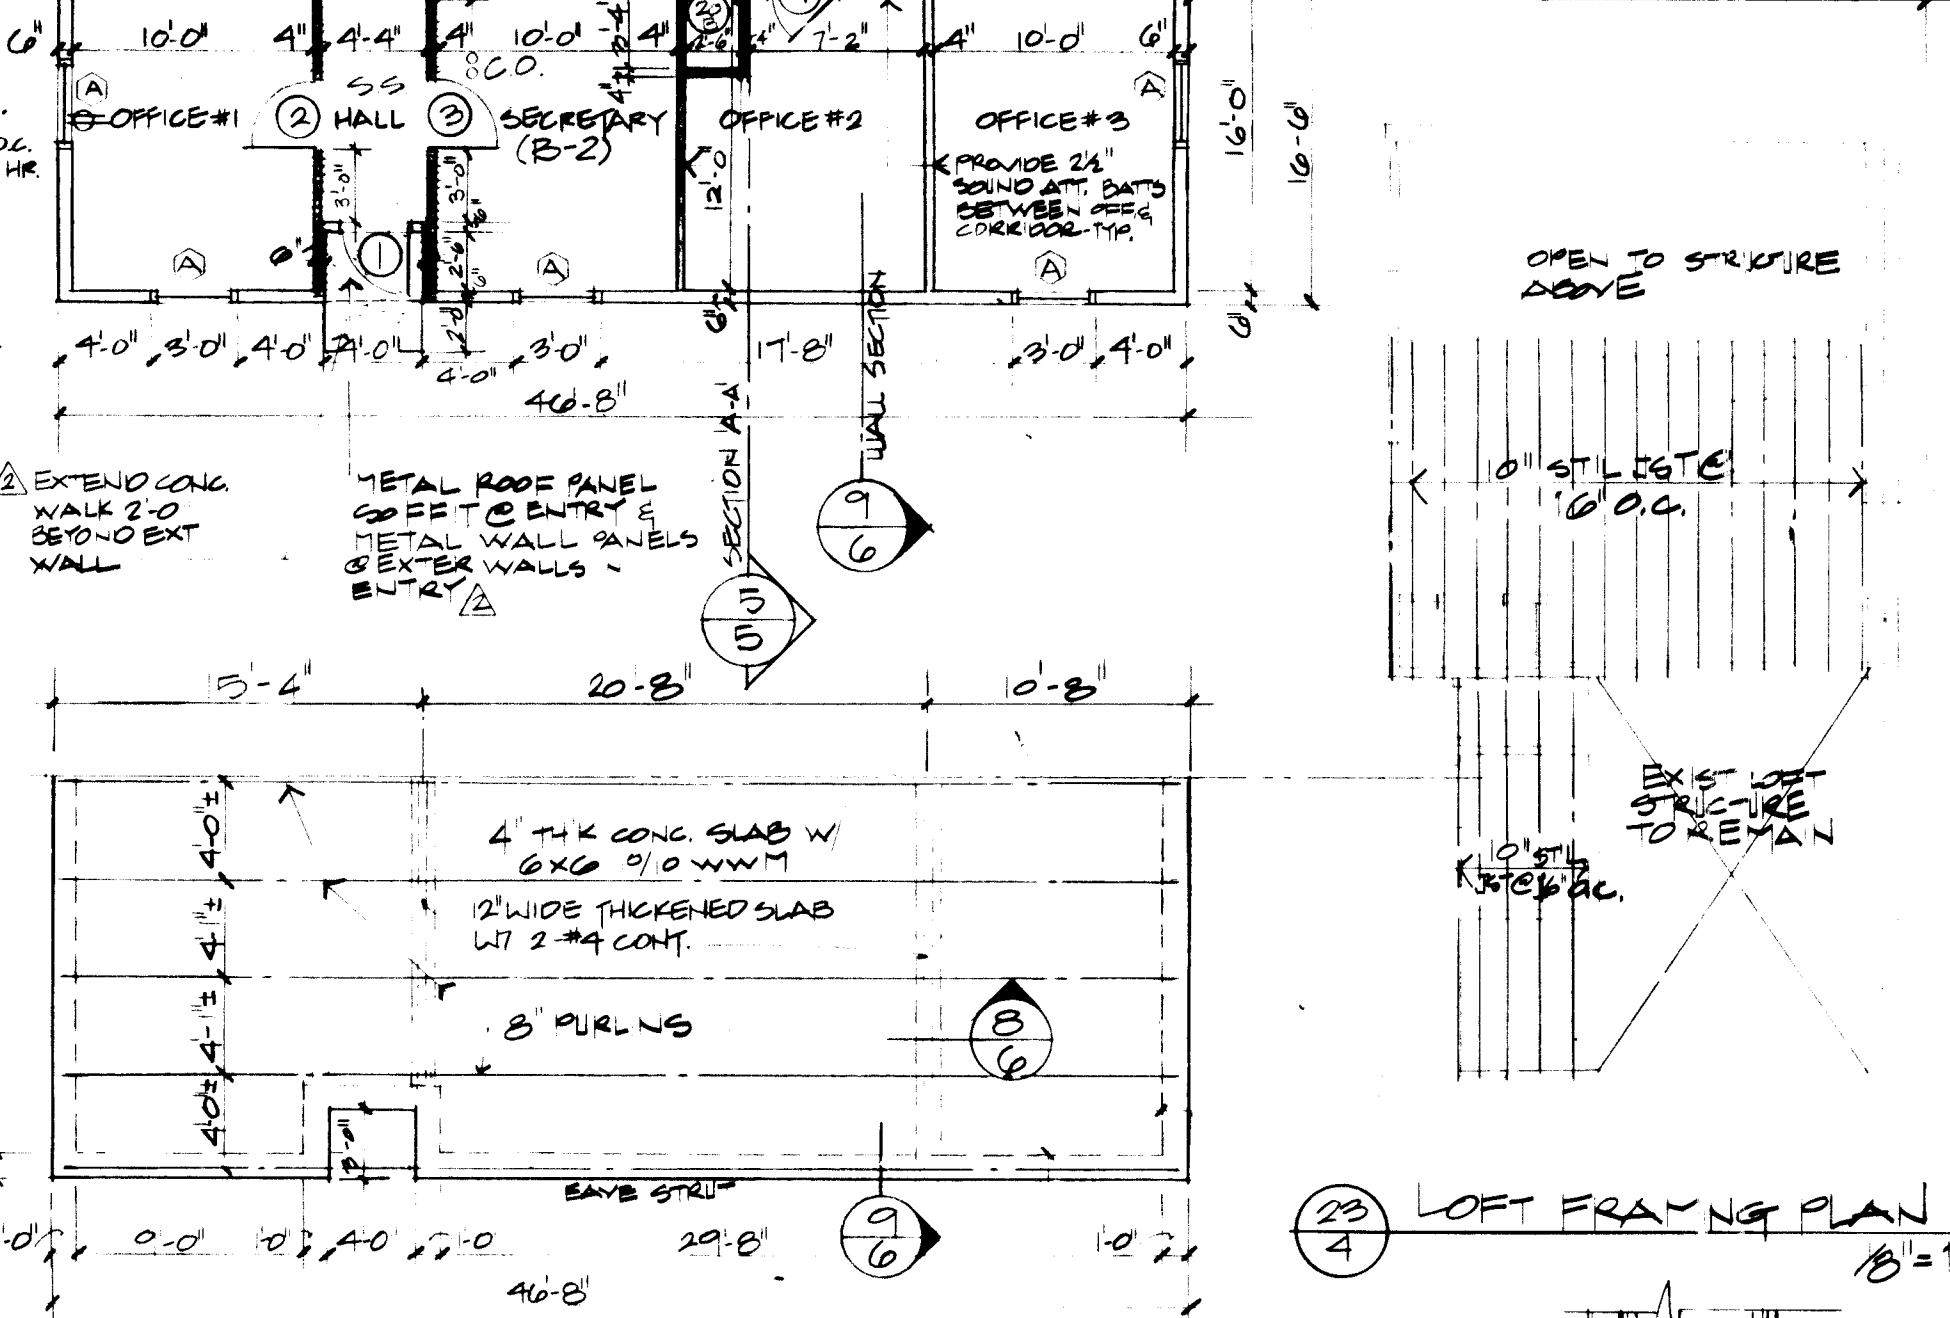

dekker & associates
architects & engineers & planners
 2403 San Mateo NE suite P15 Albuquerque New Mexico 87110 505 884 3689
ARROYO DEL OSO GOLF COURSE 7001 osuna rd n e
albuquerque n m

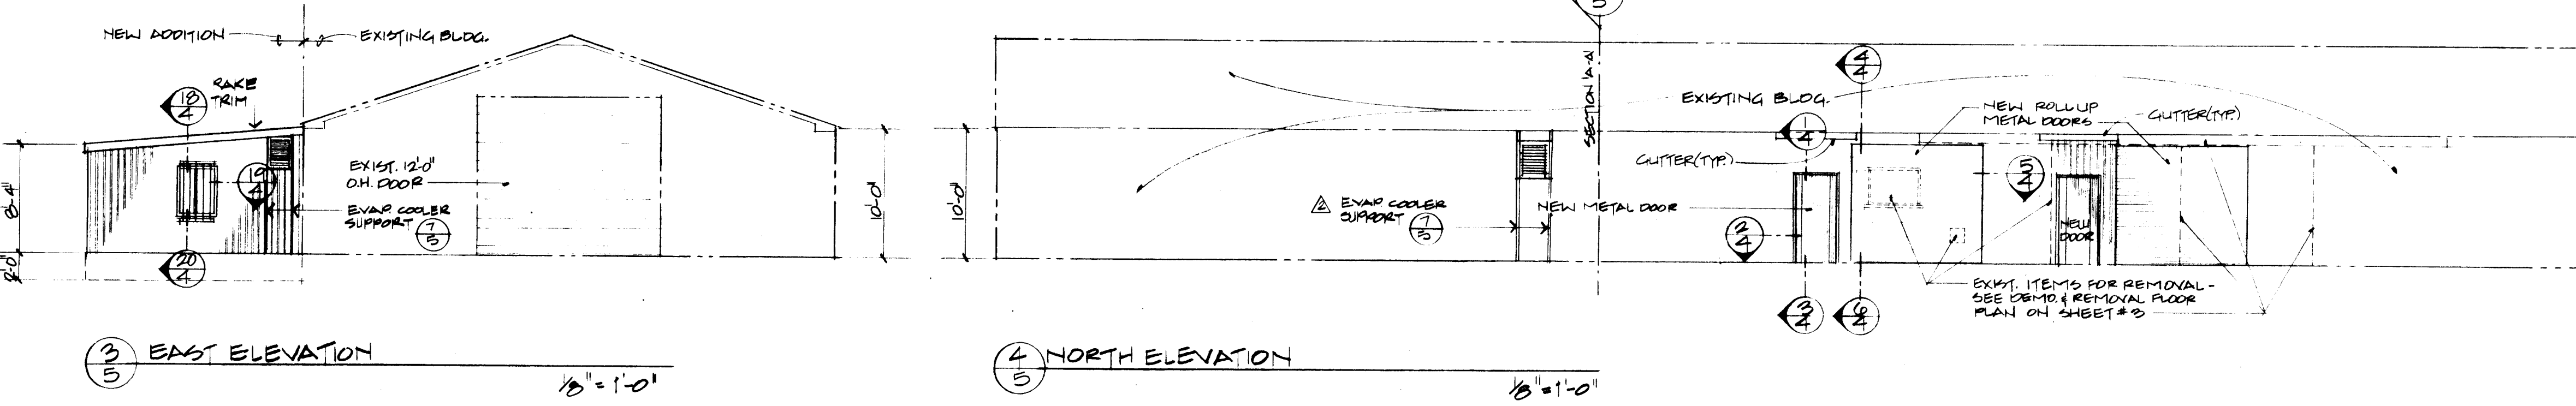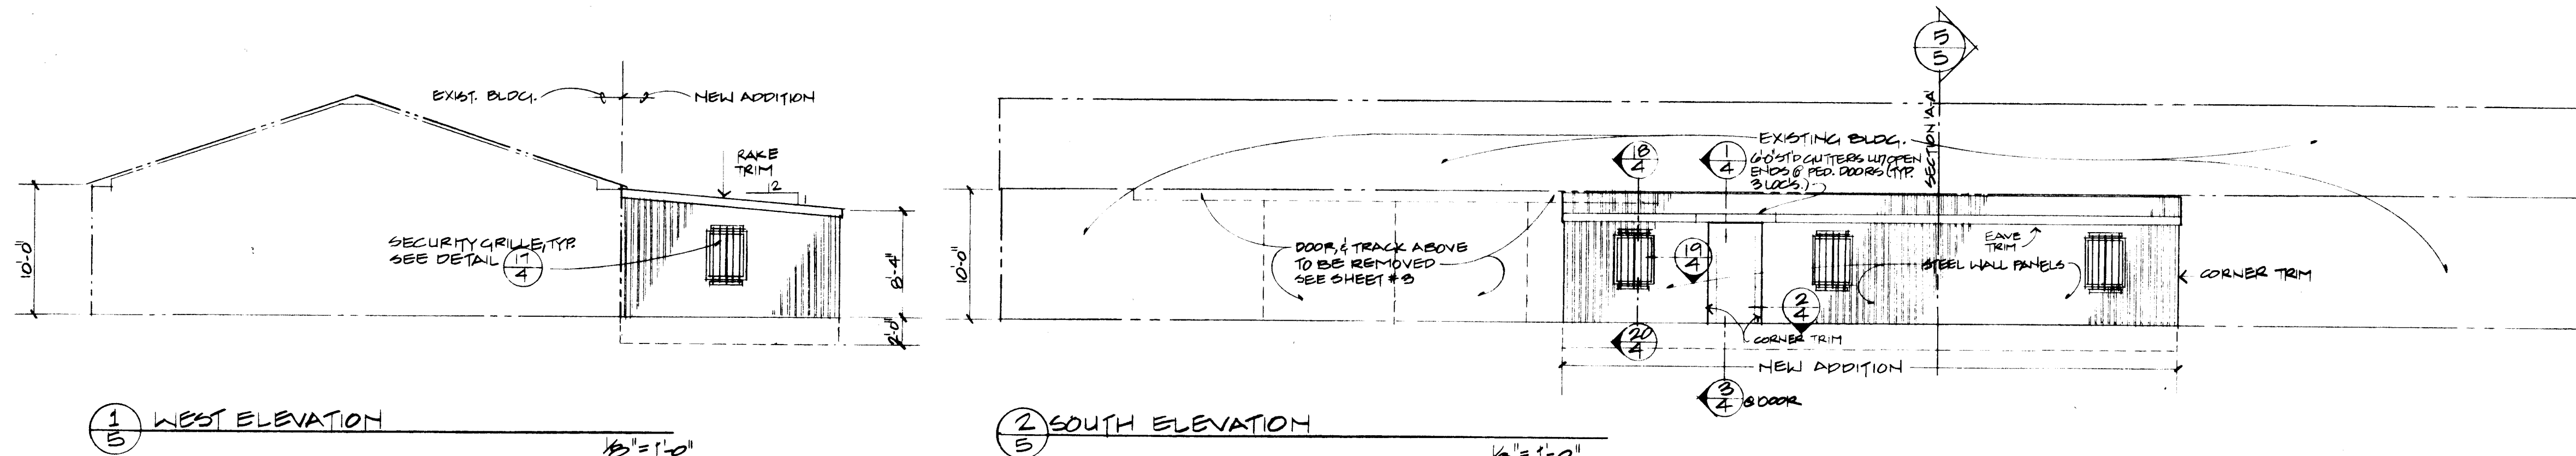

LASON 1-505-344-9404
BEST COPY AVAILABLE

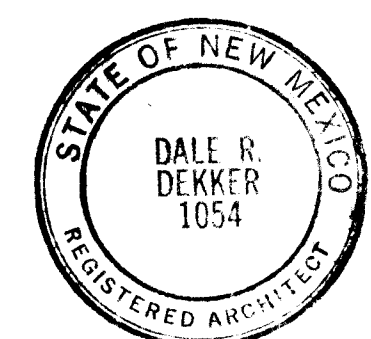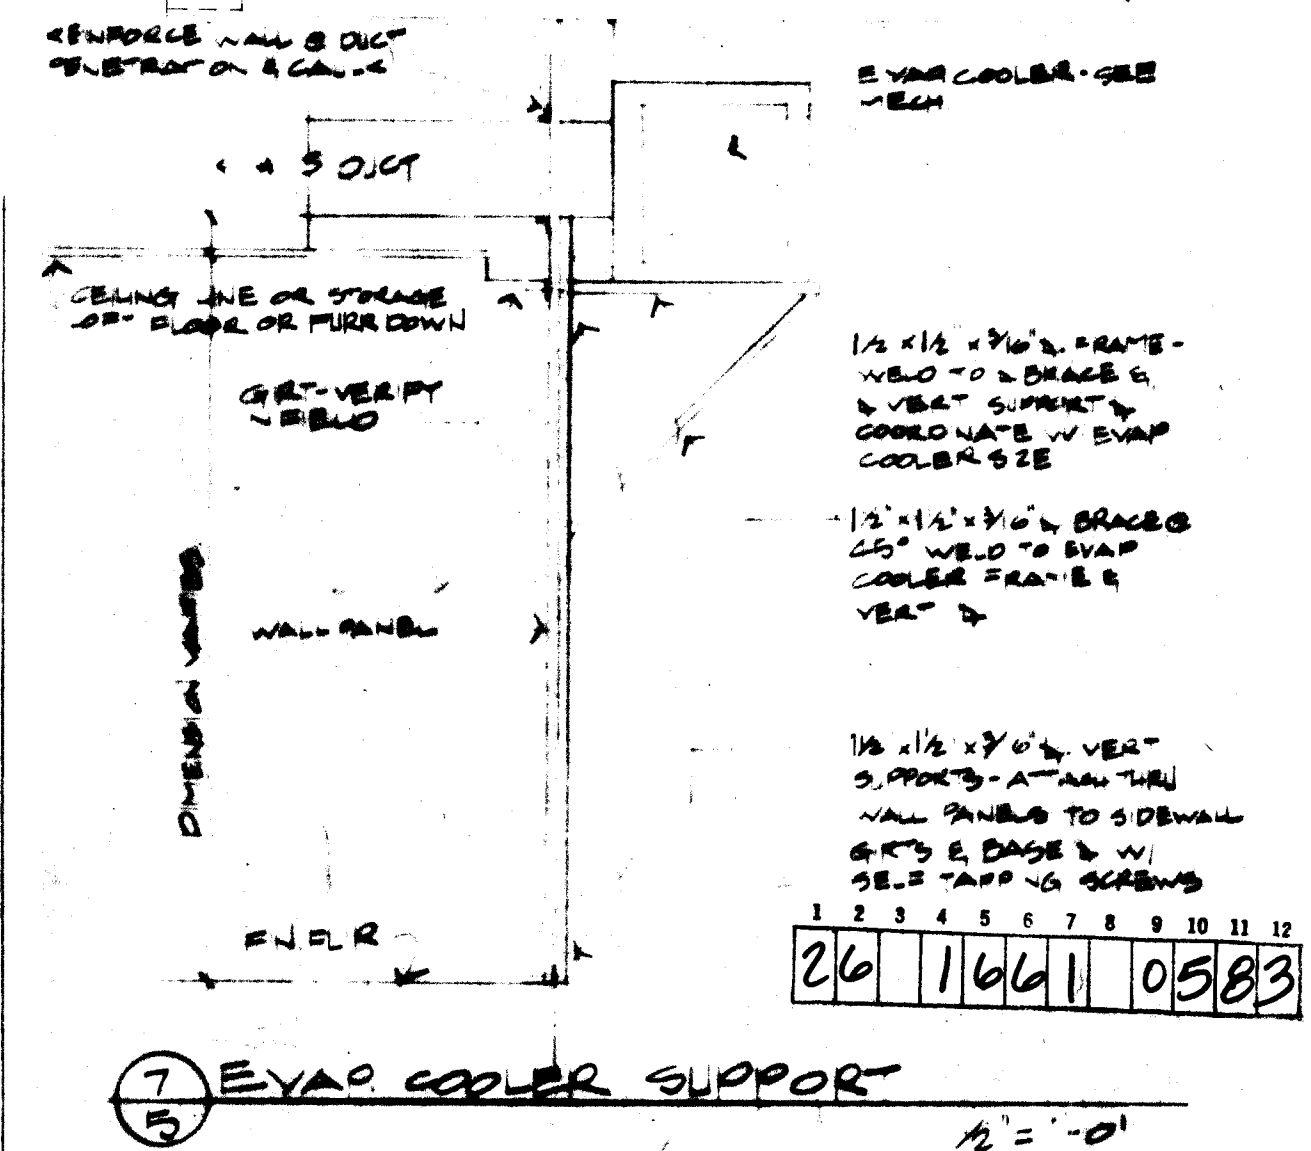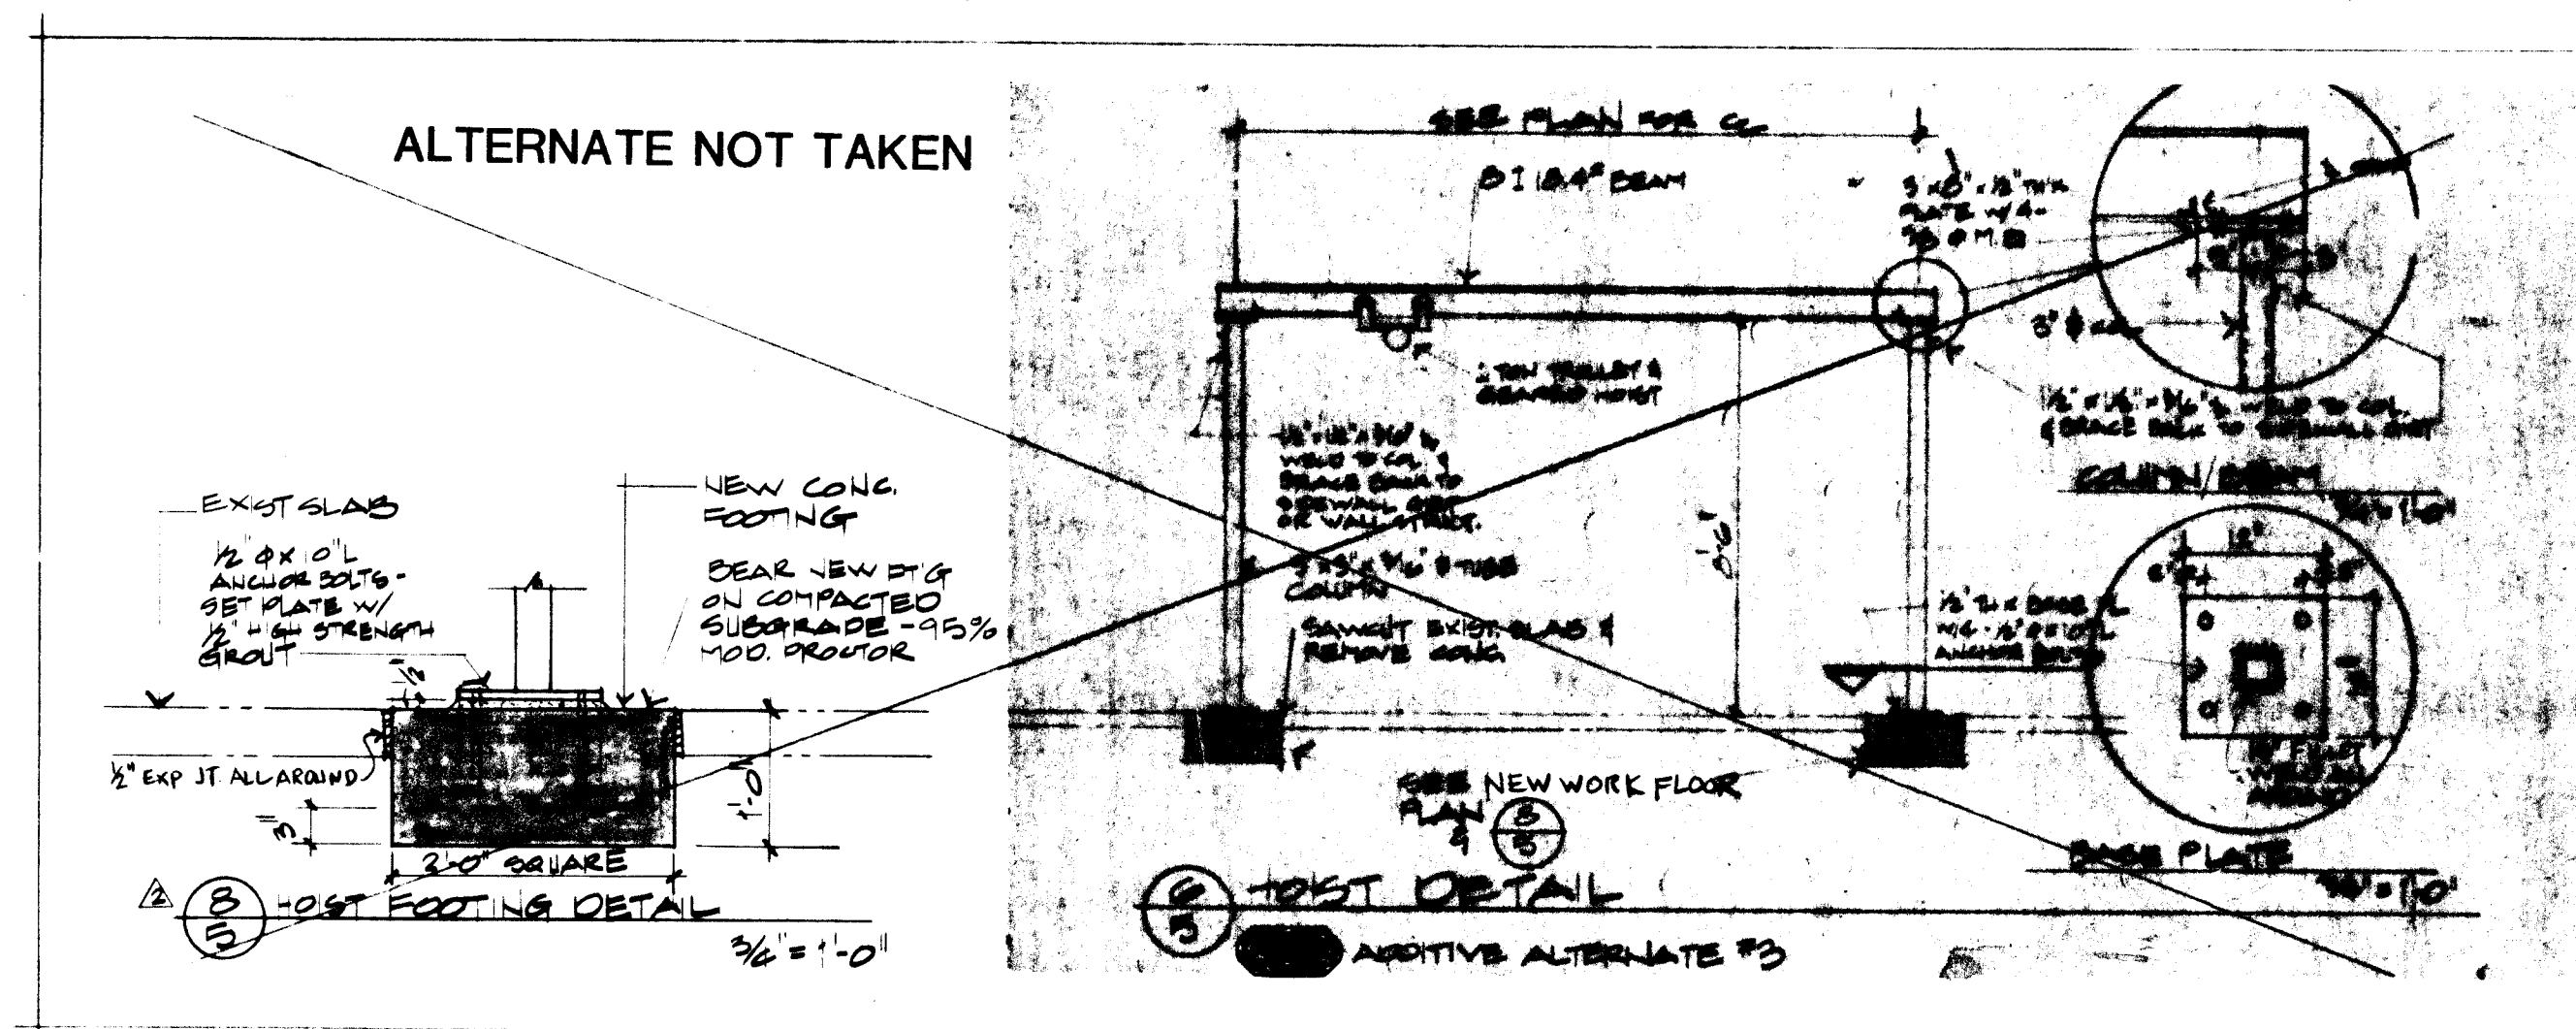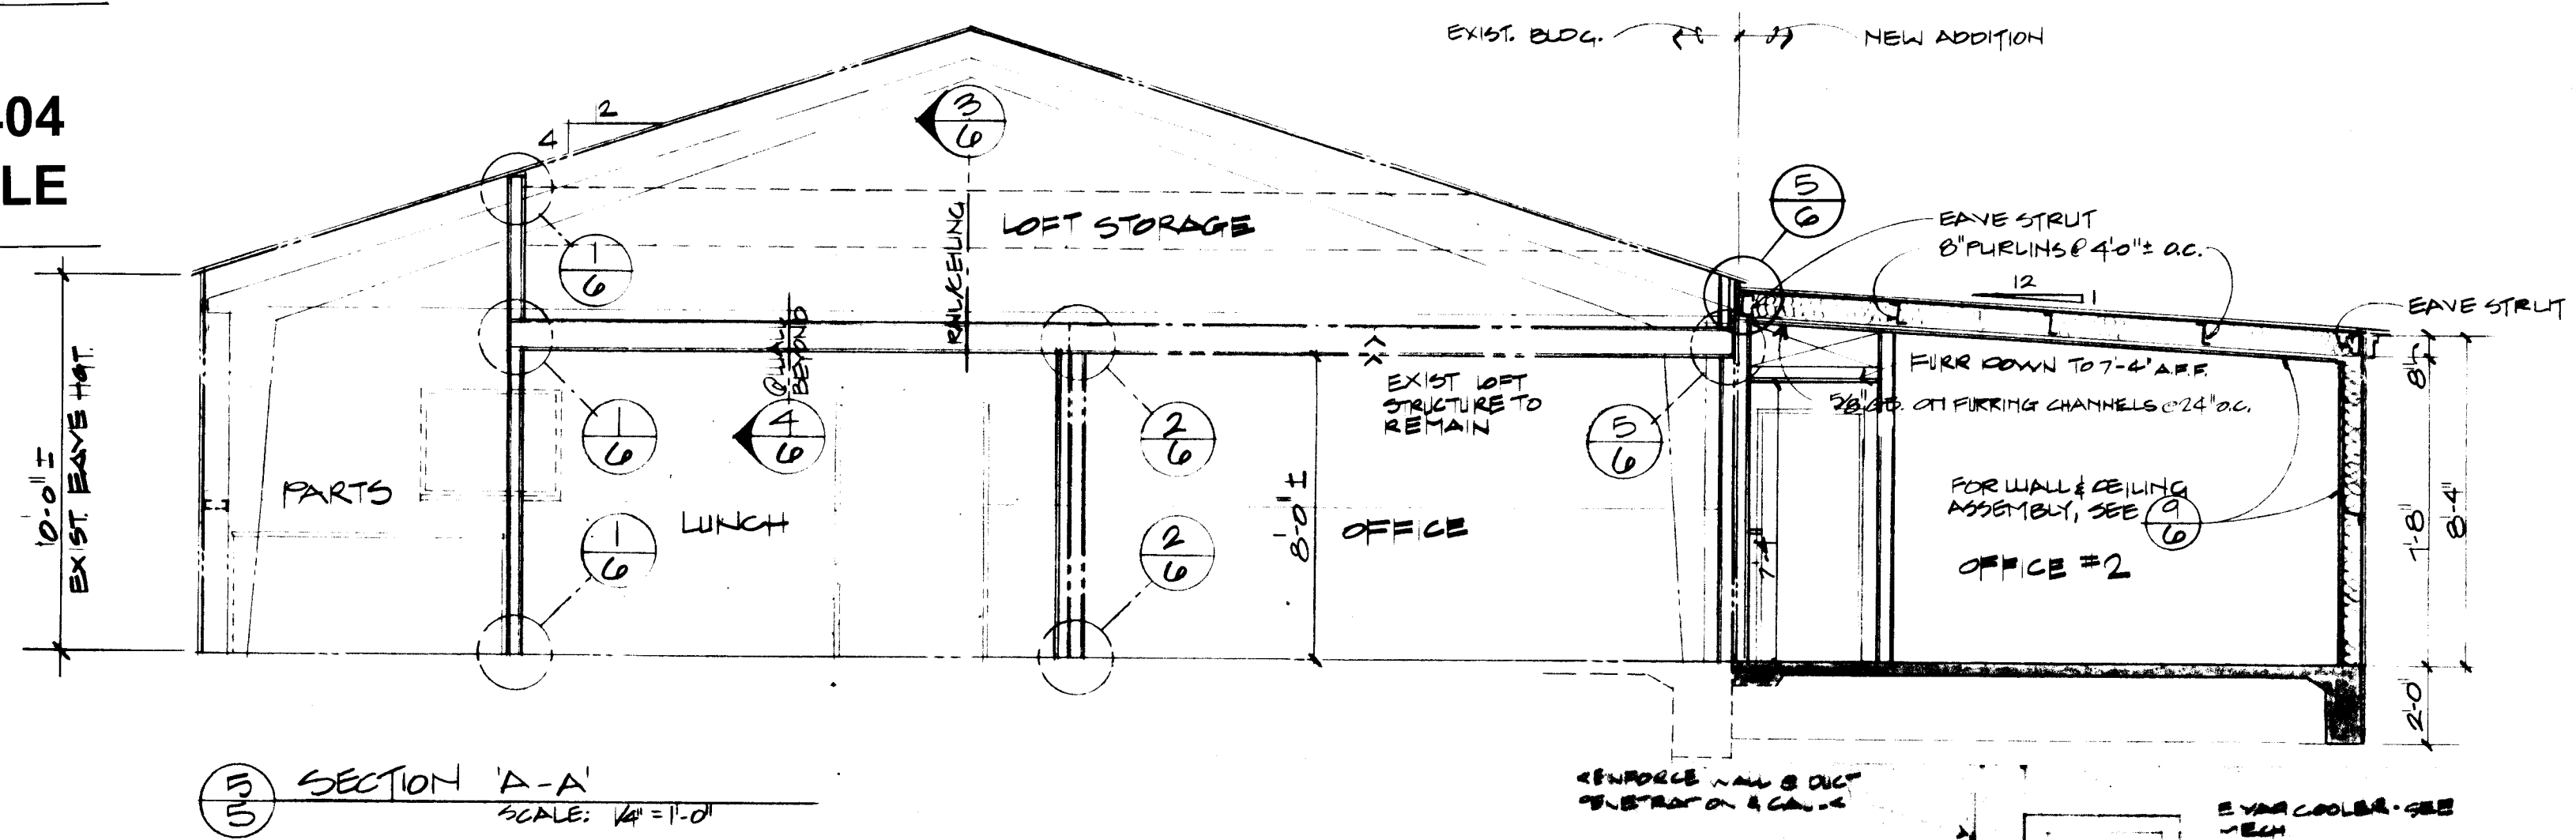

1661 12-20-93


dekker & associates
architects & engineers & planners

1300 no. 8100 sheet
dwn by 104H, DRD
chkd by AUD, DRD
issued 2-1-83
no date revision


APPROVED DEL. 000 GOLF COURSE 7001 0000 1011 0

AS-BUILT

5

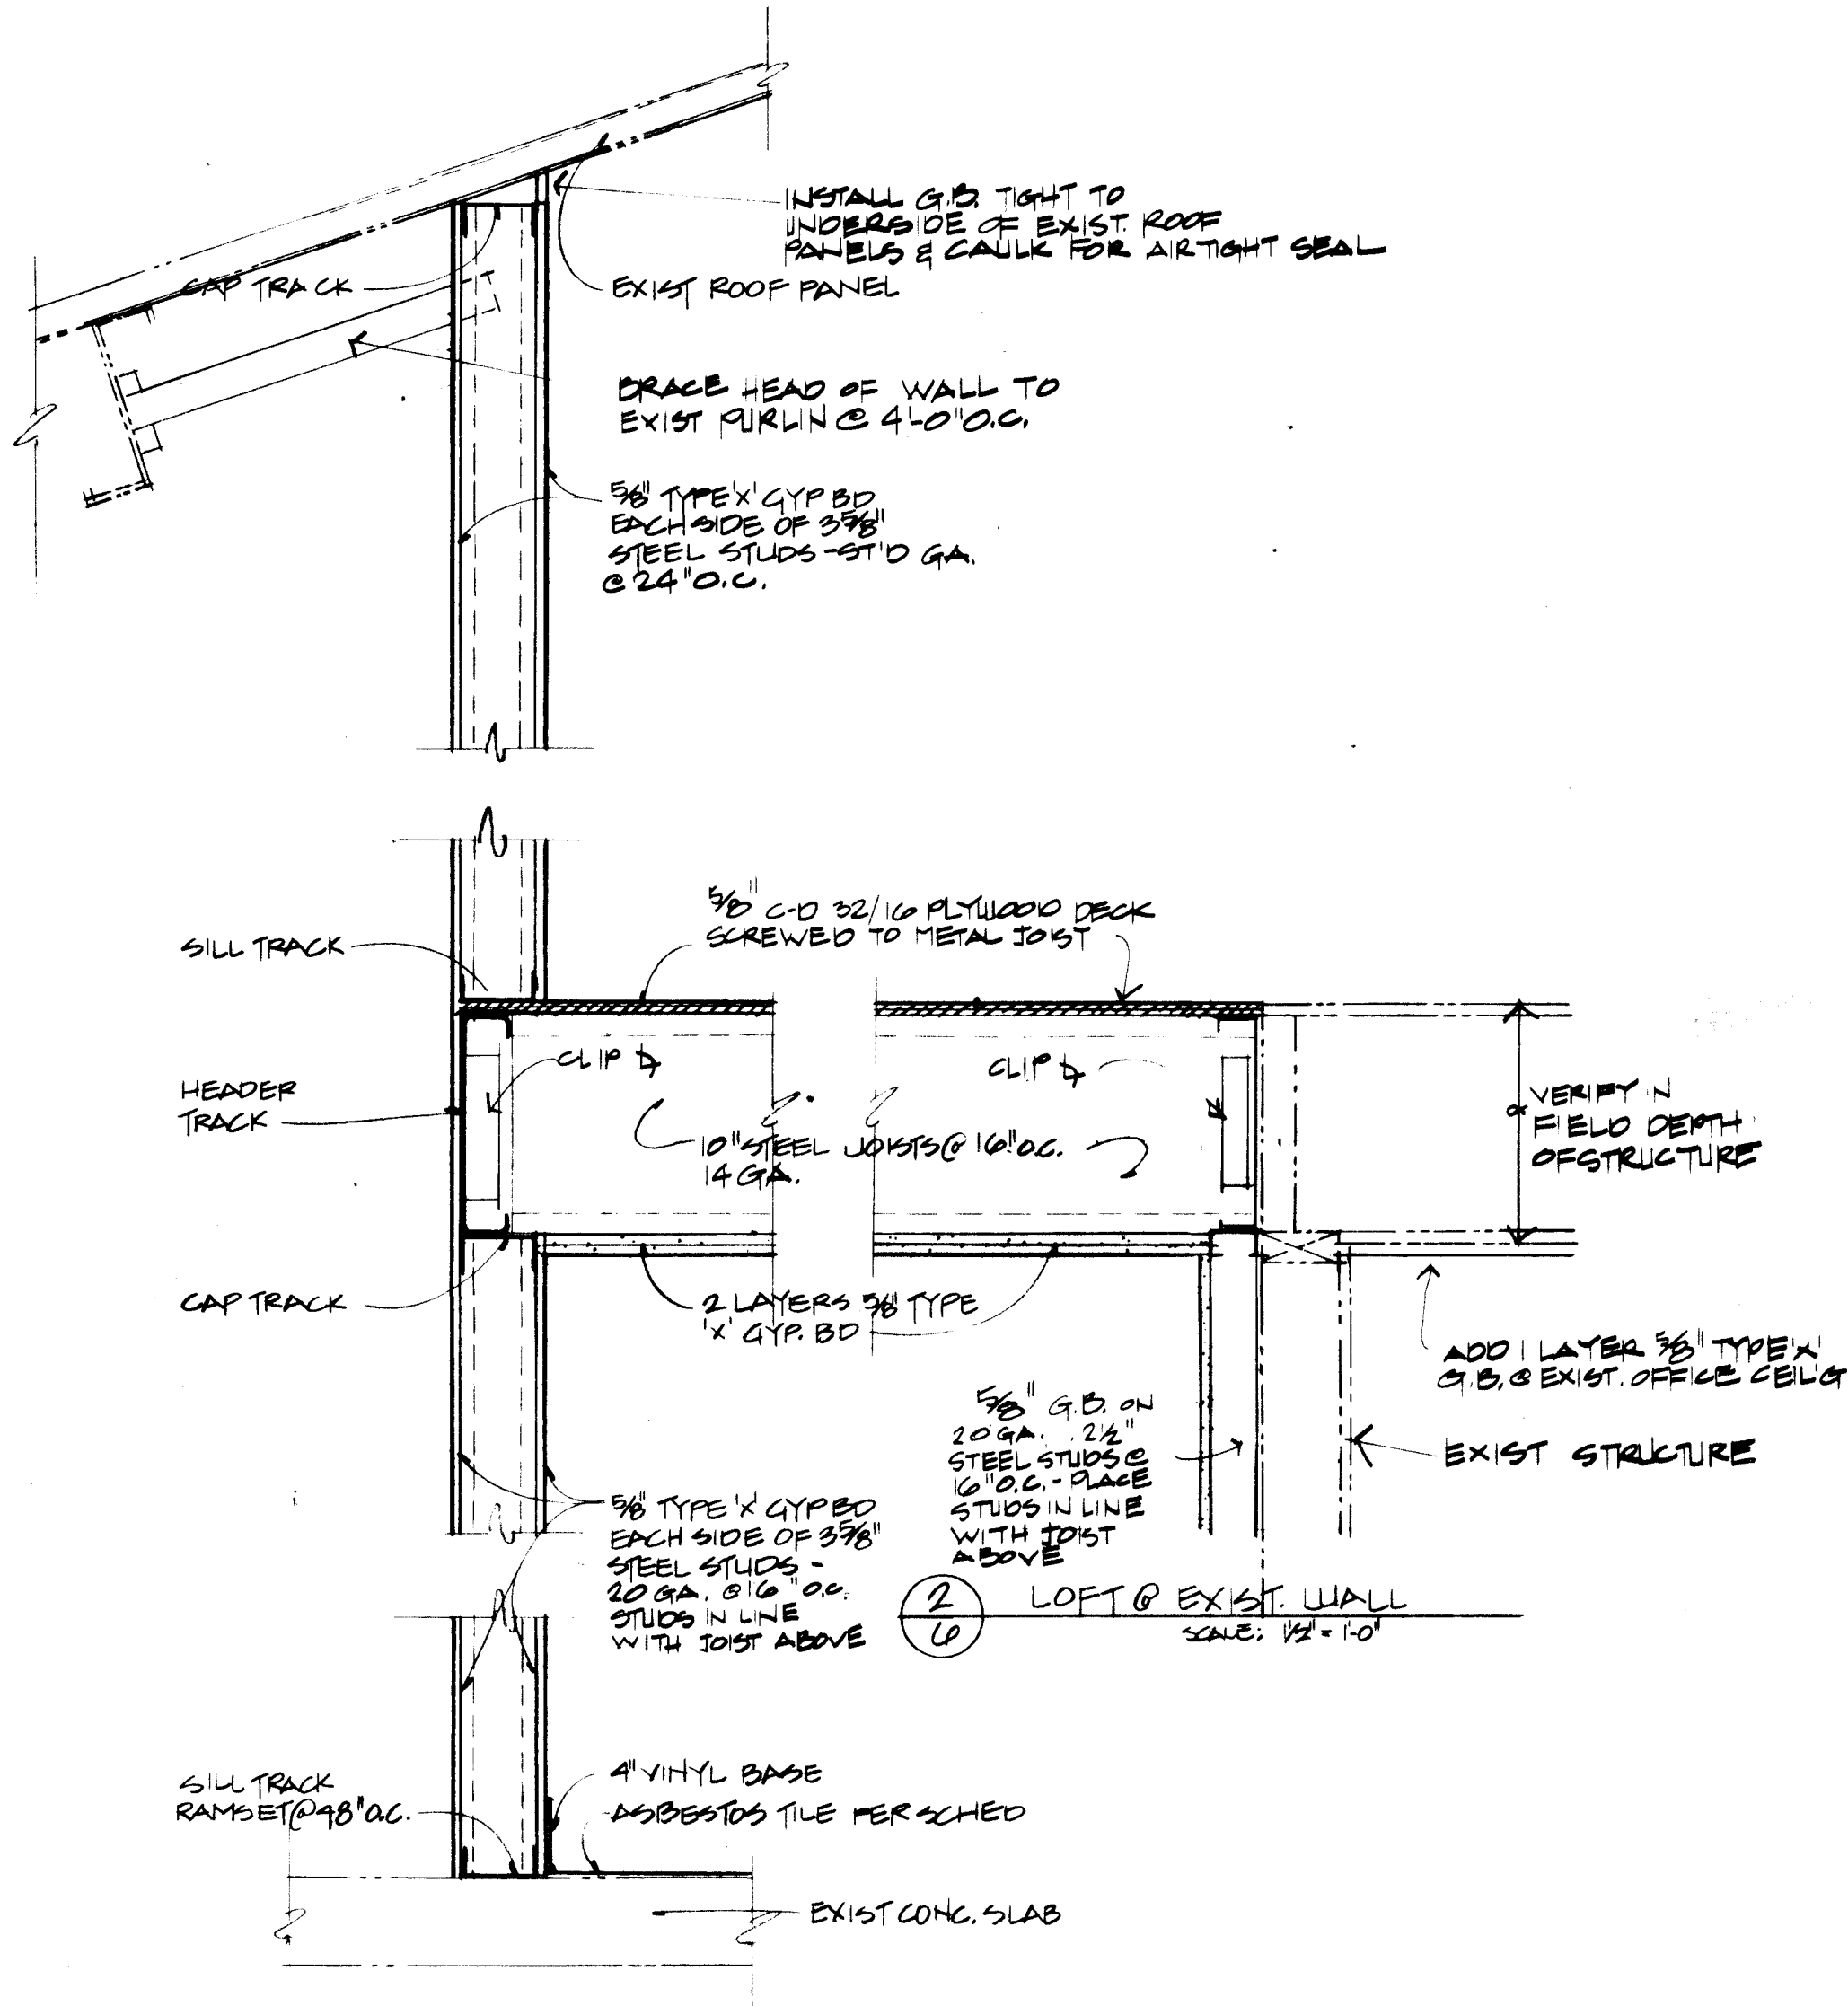


6 WALL/FLOOR/LOFT/ROOF
SCALE: 1/2" = 1'-0"

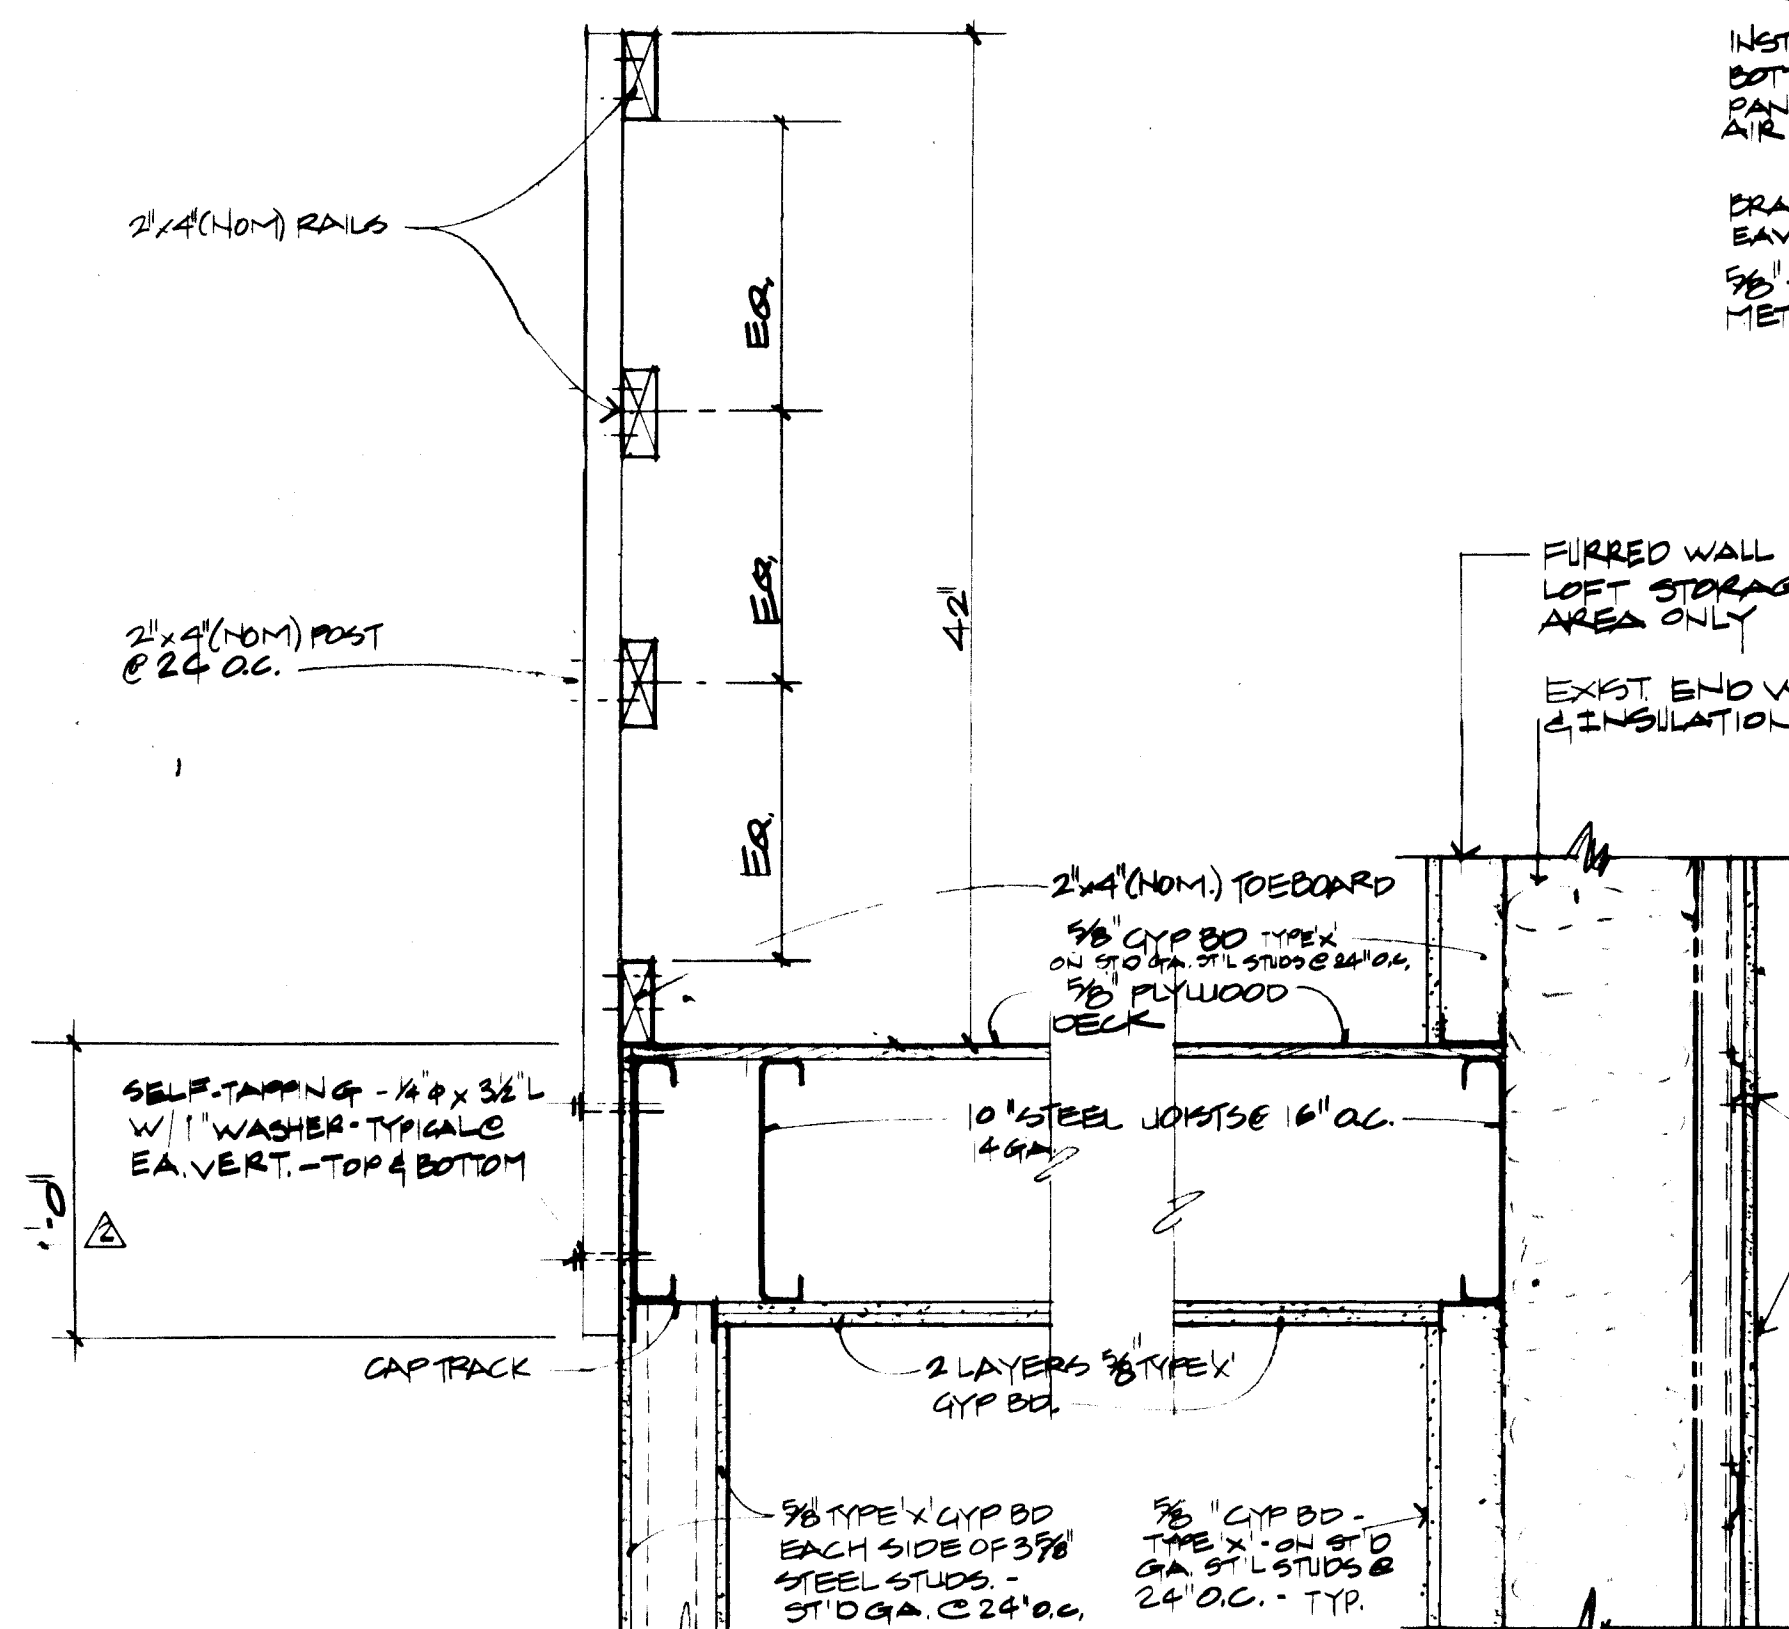


3 RAIL/LOFT DET.
SCALE: 1/2" = 1'-0"


4 LOFT @ EXIST. WALL
SCALE: 1/2" = 1'-0"

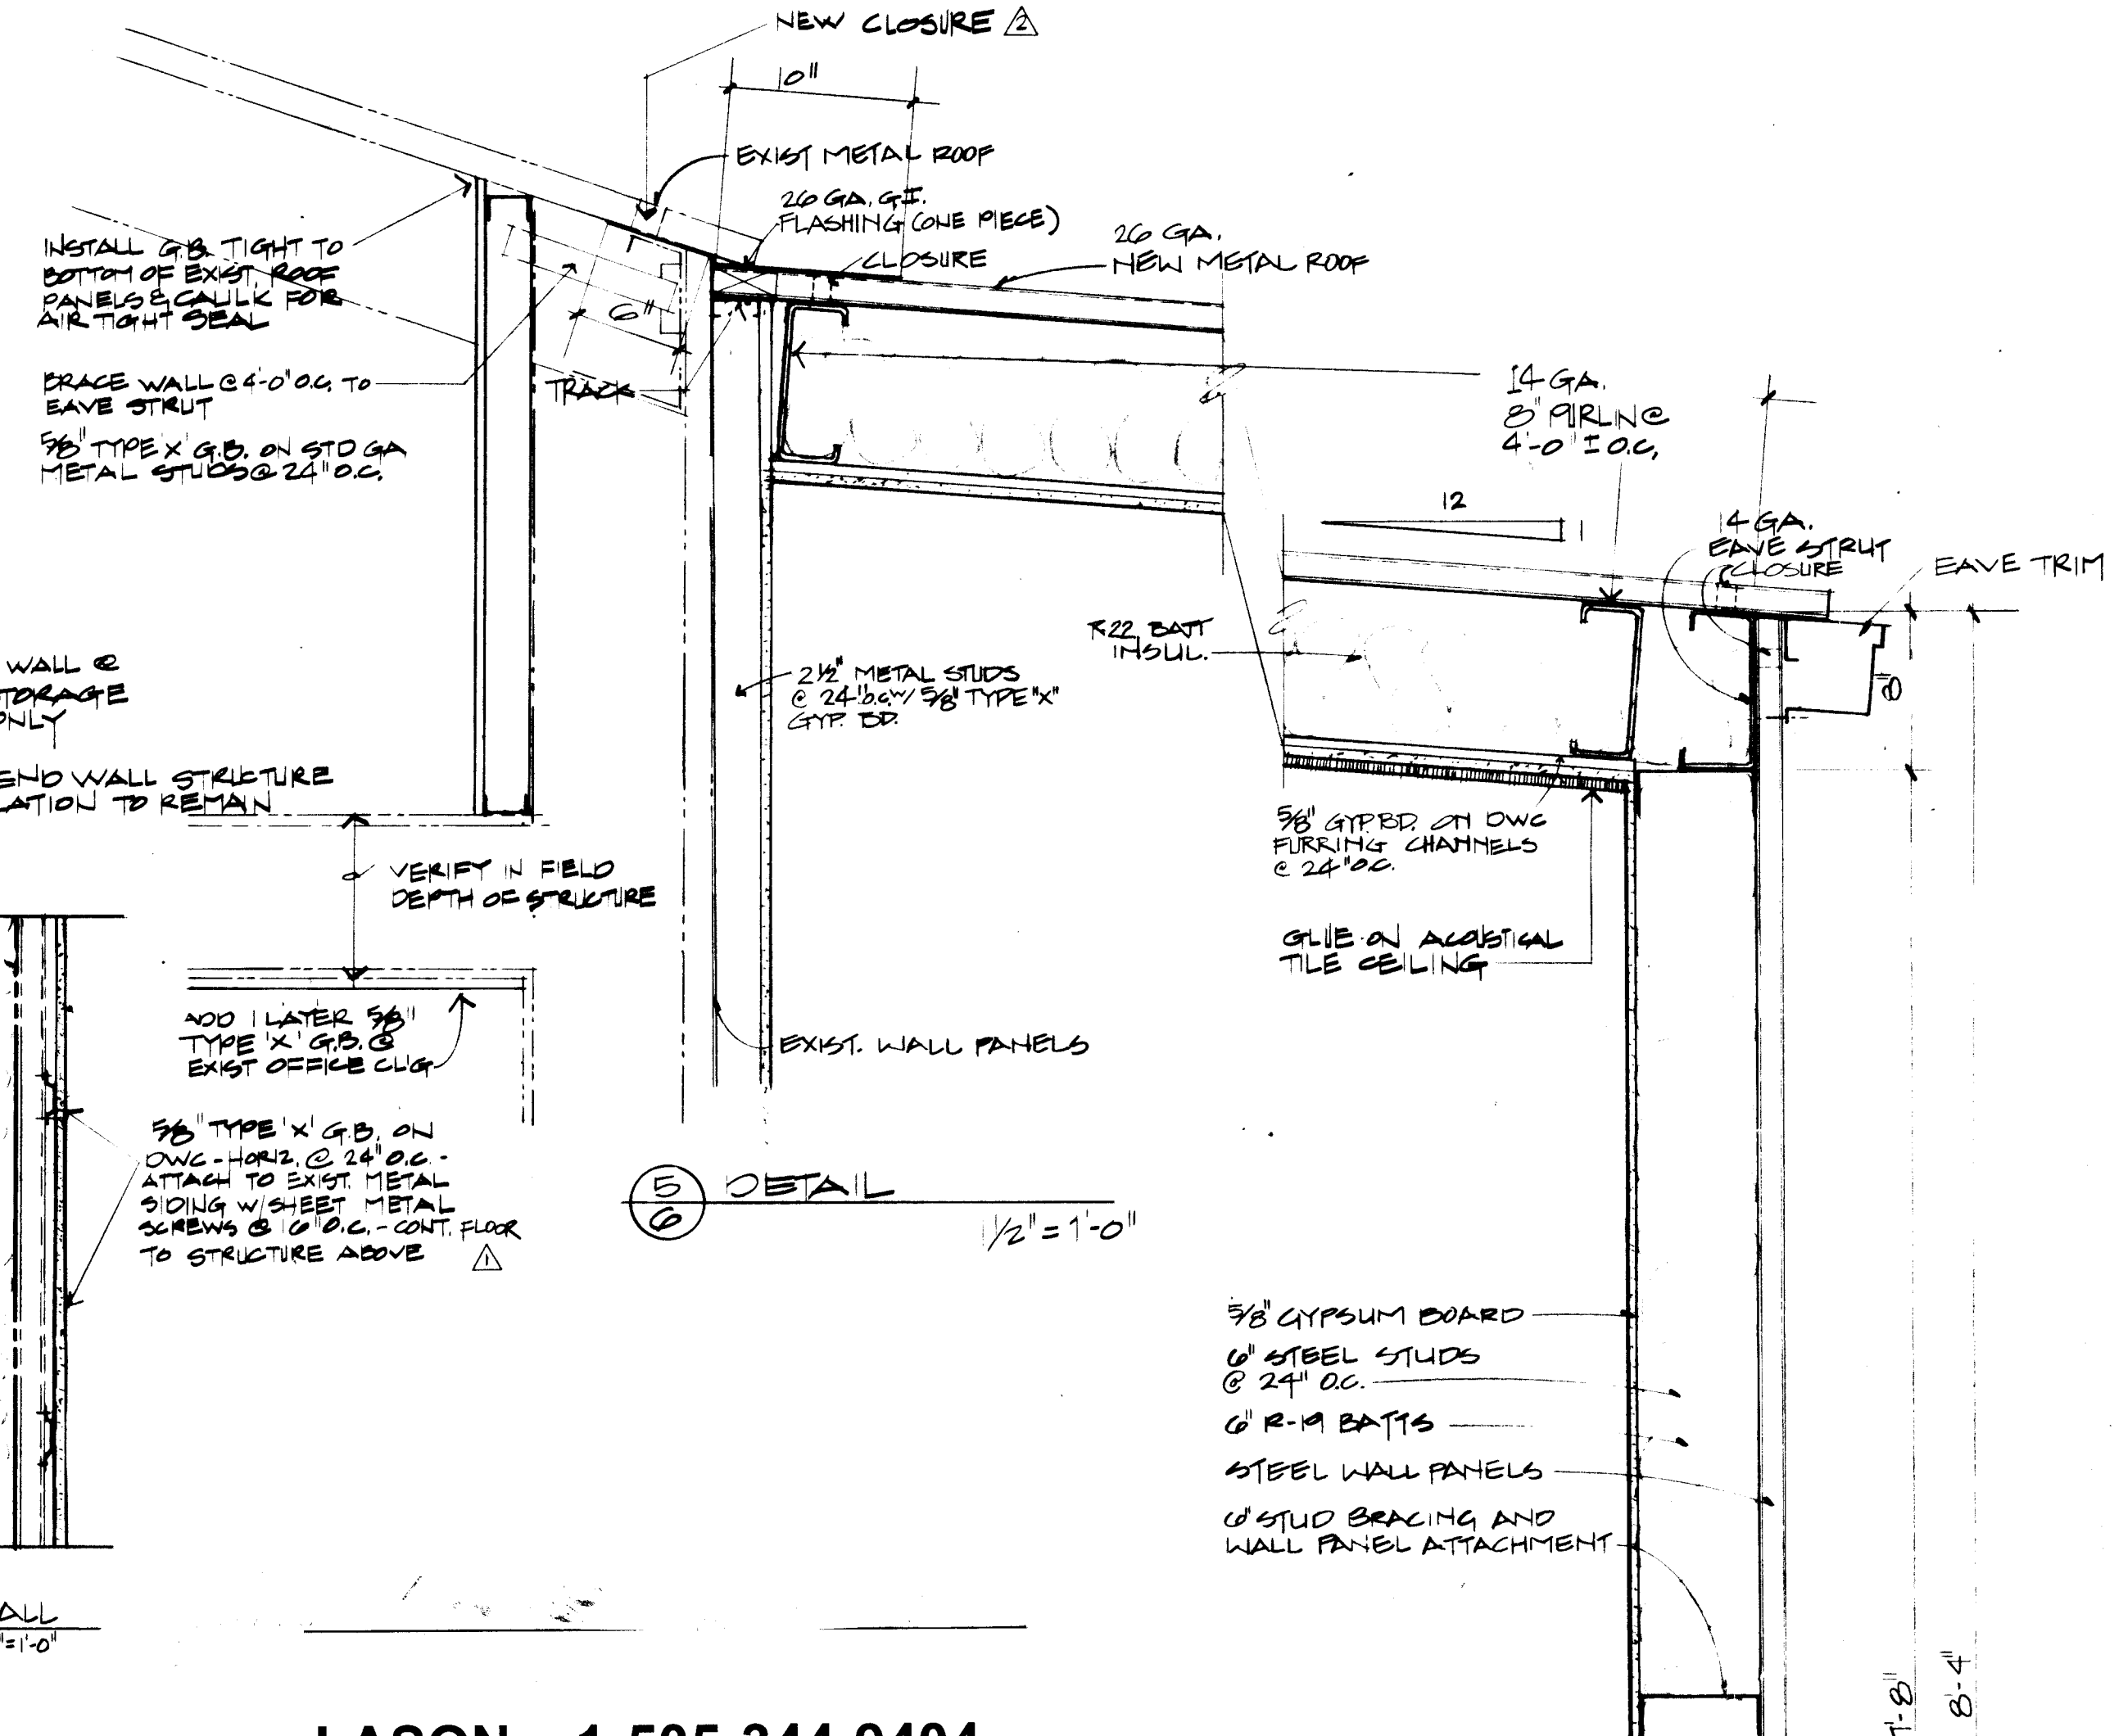


5 DETAIL
SCALE: 1/2" = 1'-0"

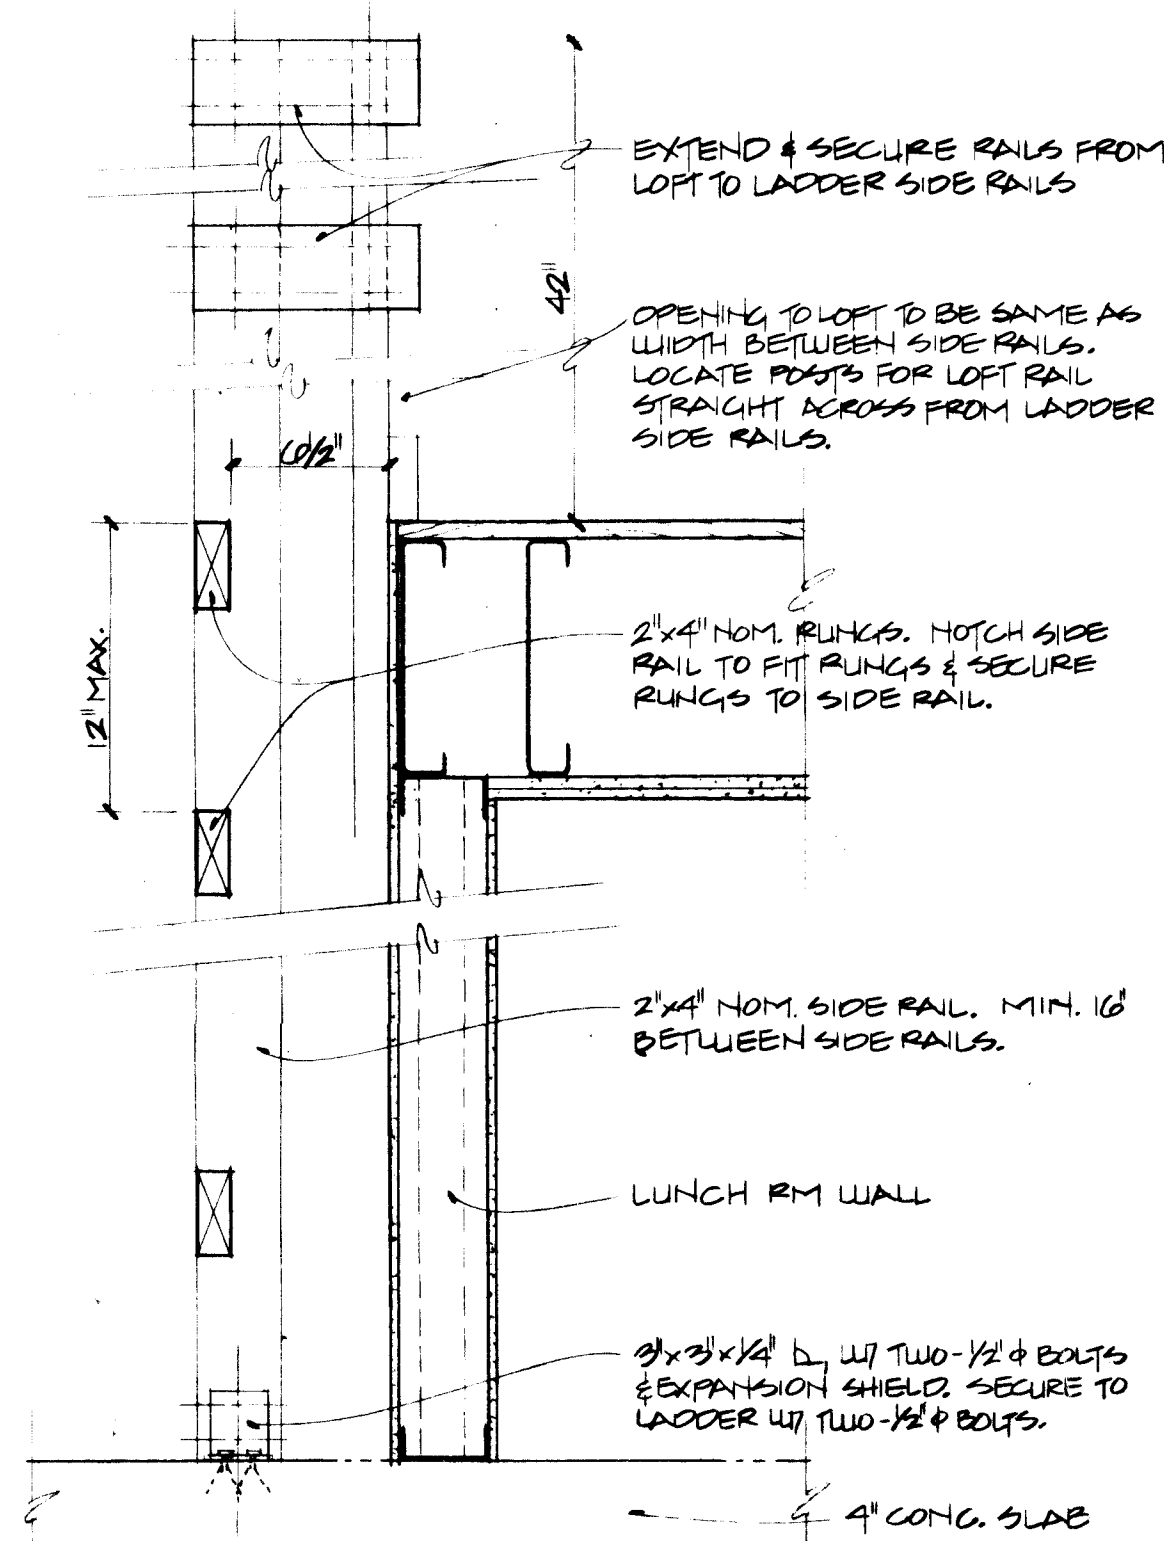


6 LADDER DETAIL
SCALE: 1/2" = 1'-0"

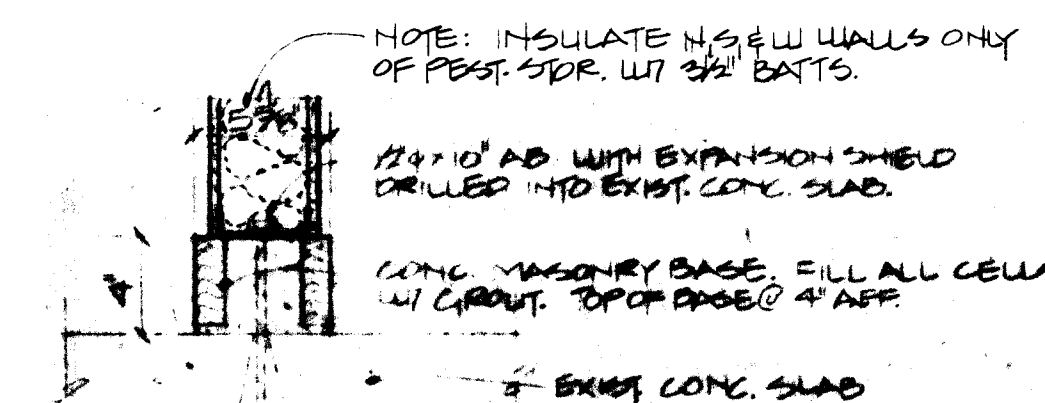

7 BASE OF POST/STOR.
SCALE: 1/2" = 1'-0"


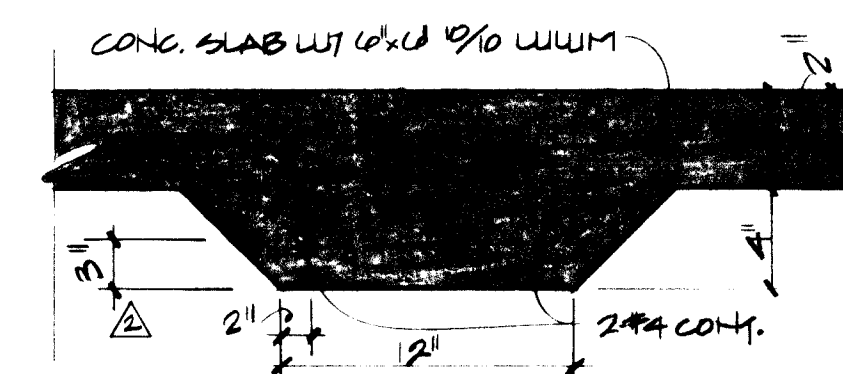


8 THICKENED SLAB DETAIL
SCALE: 1/2" = 1'-0"

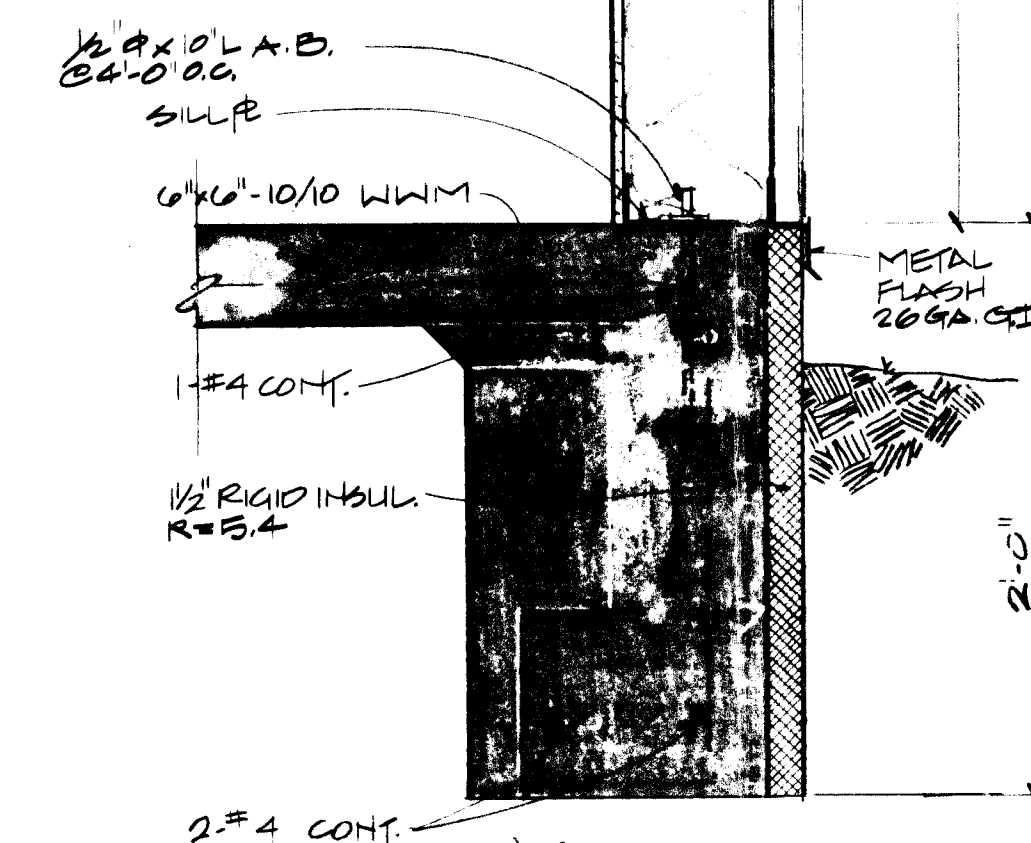

9 WALL SECTION
SCALE: 1/2" = 1'-0"

LASON 1-505-344-9404
BEST COPY AVAILABLE

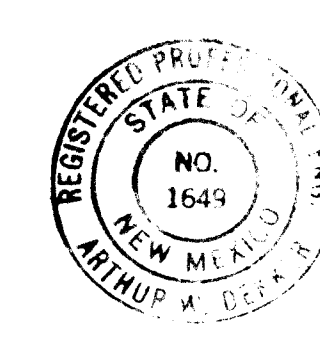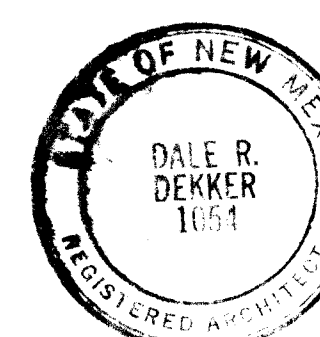

1661
dekker & associates
architects & engineers & planners
2411 San Mateo N.E. Suite P-15 Albuquerque, New Mexico 87111 505 884-3689
ARROYO DEL OSO GOLF COURSE 7001 Camino rd n e
albuquerque n m

job no. 8208 sheet
drn by JCH,BH
ckd by ALD
issued 2-1-83
no date revision
11013 PLAN CHECK
AS-BUILT
20 29

MECHANICAL CONTRACTOR NOTE:
These Drawings reflect information on utilities gathered by site inspection, discussions with local utilities engineering officials, and previous construction drawings, provided to the Architect. It is possible that the exact location of lines in the immediate vicinity of the proposed building may be slightly different from the location shown on this Drawing. If additional lines are encountered, they shall be exposed and identified by this Contractor. Where additional lines and/or differing locations are encountered, this Contractor shall request that the Architect make a ruling as to any necessary change of materials, re-routing, abandoning or relocating of such lines. All lines encountered that interfere with construction shall be relocated to clear construction (if active) and shall be removed if inactive by this Contractor under this contract. All bidders are cautioned to investigate site conditions before submitting their bids. All existing piping shall have minimum earth coverage and depths shall be adjusted as required to provide minimum coverage due to new grades or construction. Contractor shall pay for any and all costs of permits, line extensions, meter installation, etc., as required by local governing utilities engineering officials.

GENERAL MECHANICAL UTILITIES NOTES:
This Contractor shall be responsible for the complete installation of all work related to mechanical utilities including: trenching; backfill; supports; cleanout pads; service stops and boxes; service lines; testing; cleaning; and any work not accepted by the Architect or Mechanical Engineer due to improper workmanship or lack of proper coordination shall be removed and correctly installed at the Mechanical Contractor's expense, as directed.


MINIMUM DEPTHS BELOW GRADE (COVER): WATER -- 42" SEWER -- 30"
Refer to Architectural Plans for finish and existing grades.

This Contractor shall coordinate cutoff of existing utilities for new connections with local utilities engineering officials and shall conform to their requirements.


Utilities connection points are approximate only. Each bidder shall satisfy himself as to existing site conditions before submitting his bid. No allowance shall be made after the contract is awarded to compensate for lack of pre-bid inspection of the site by the successful bidder. Verify exact size, location and depth of existing sewer before setting any new inverts. Verify exact size, location and pressure of existing water mains.

Contractor shall connect new service lines as approved and directed by local governing utilities engineering officials and conform to their requirements.

LASON 1-505-344-9404
BEST COPY AVAILABLE

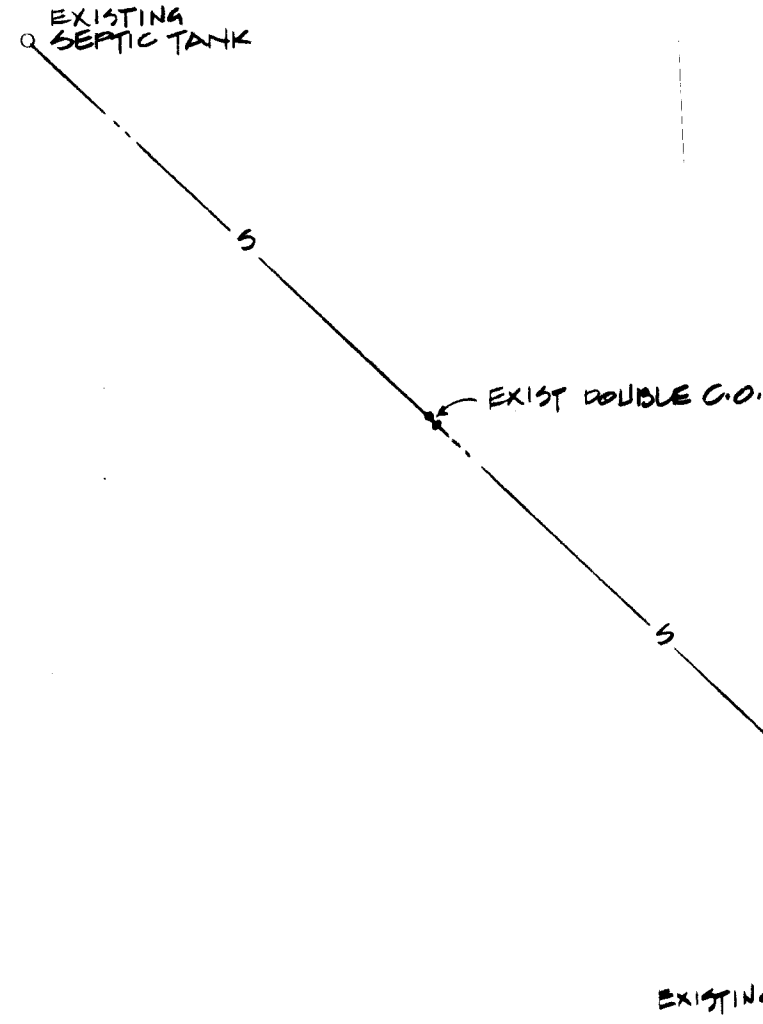


1 UTILITY SITE PLAN
SCALE: 1" = 20'-0"

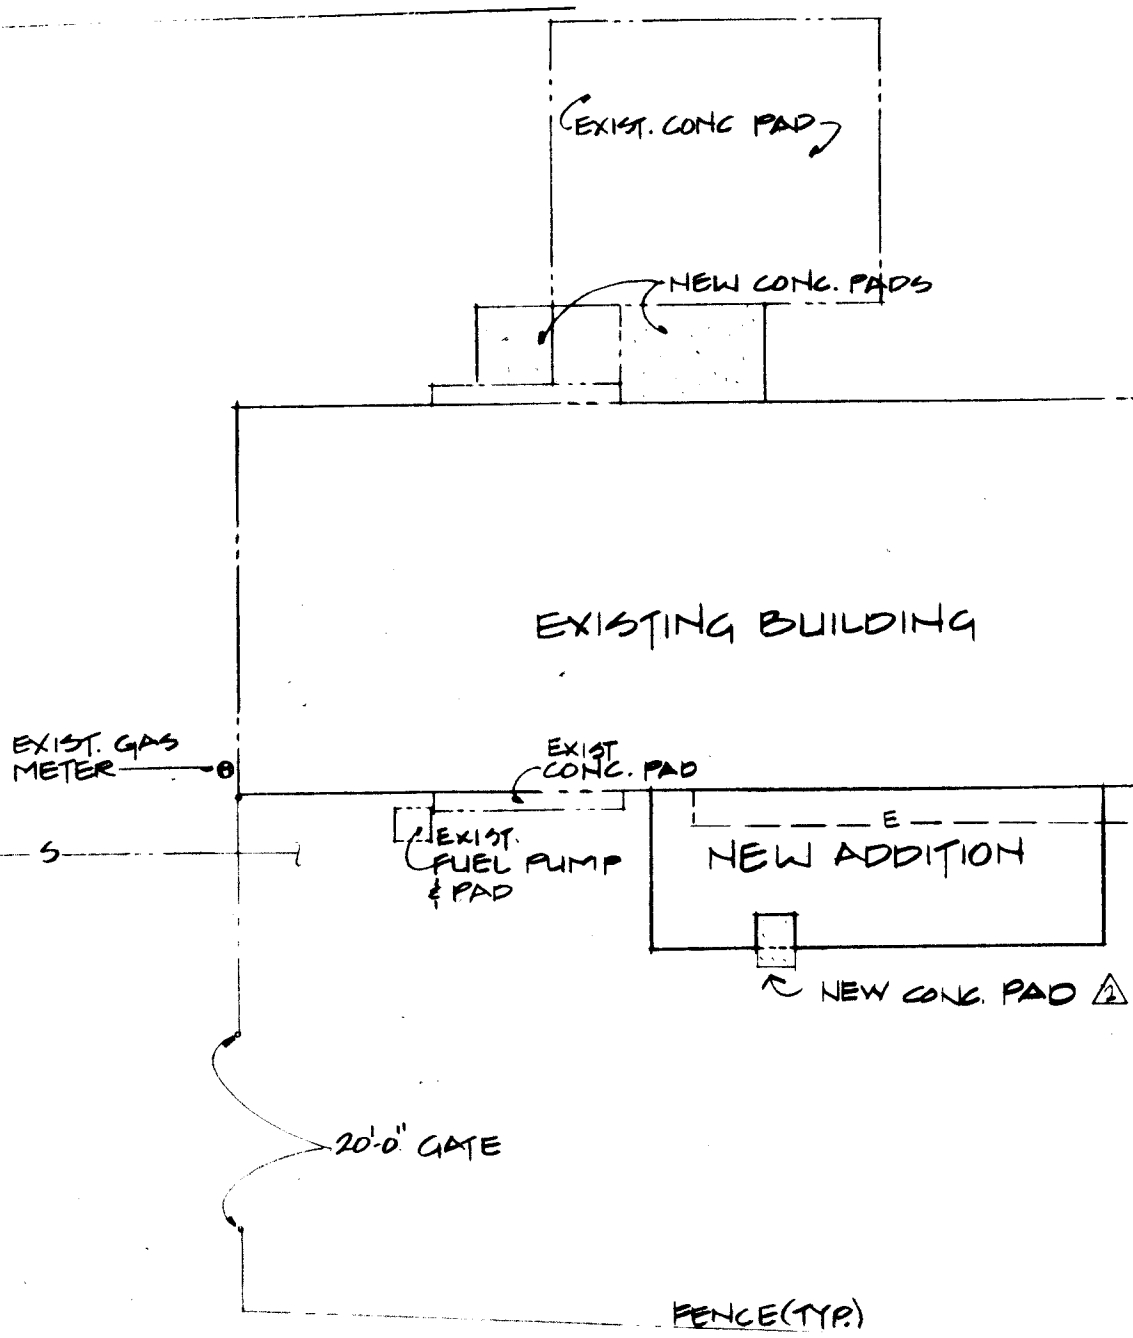

SYMBOL LEGEND - PLUMBING

- WASTE PIPE
- VENT PIPE
- CW PIPE
- HW PIPE

NOTE: CONTR TO VERIFY EXIST. PLUMBING FOR REMOVAL. ALL EXIST PIPING TO BE ABANDONED BELOW SLAB TO BE CAPPED OFF FINISH FLOOR & ALL WATER PIPING REMOVED TO NEW SERVICE CONNECT. CONTR TO PATCH ALL FLOORS, WALLS, ETC. TO MATCH NEW FINISH.

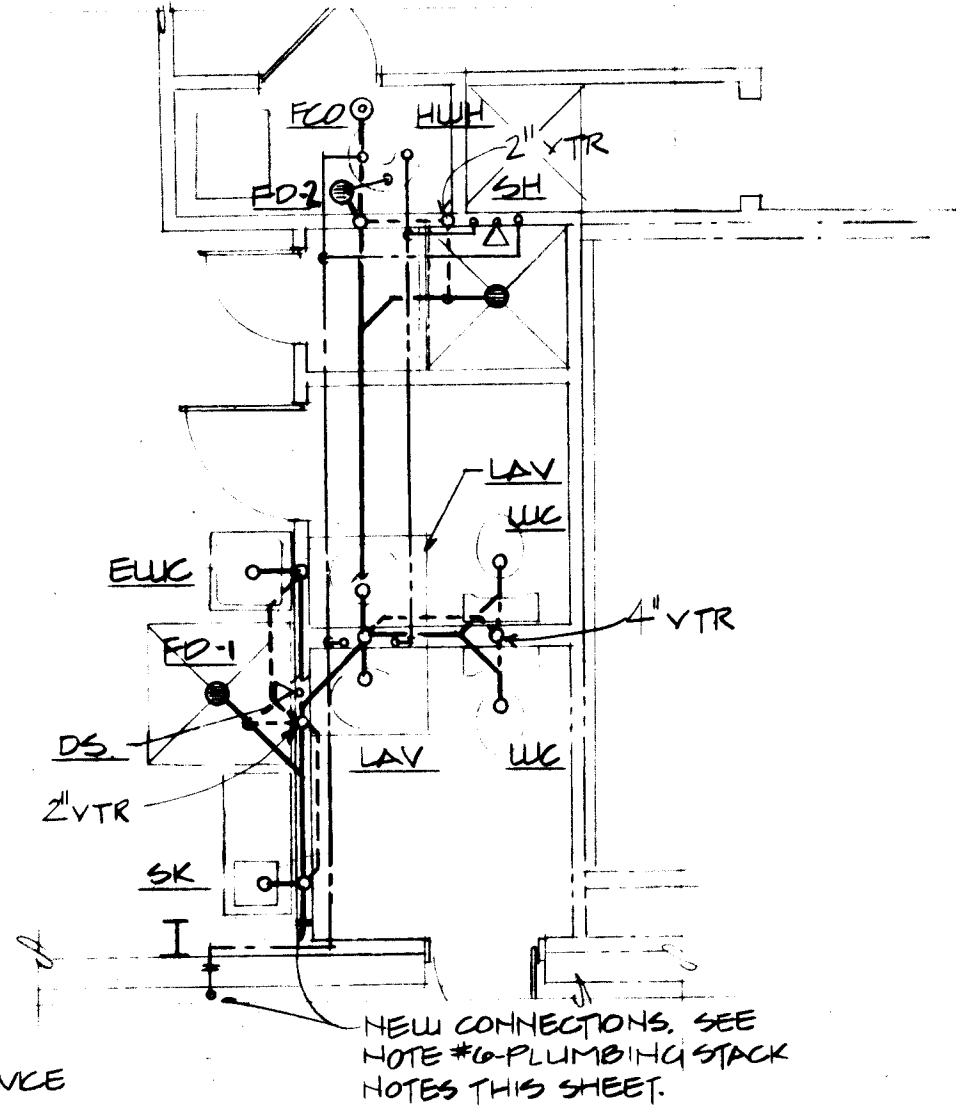

2 TOILETS & MECH. AREA - PLUMBING
SCALE: 1/4" = 1'-0"

AS-BUILT: SEE ARCHITECTURAL FOR REVISED TOILET ROOM PLAN

MECHANICAL FLOOR PLAN NOTES:

- FURNACE TO BE PAYNE 344 G, 000025, 125,000 BTU/H INFL, 100 CFM, 0.3 EXT. 3.6 MIN. INS ALL W/ 1/2" SAFETY CUTOFF & ADJUSTED FOR ALTITUDE. 1/2" GAS CONNECTION W/ 3/4" FLUE. SEE NOTE ON PLAN FOR ROUTING OF FLUE. RETURN AIR LOCATED INSIDE OF FURNACE. MAKE FLEXIBLE DUCT CONNECTION TO FURNACE FOR SUPPLY & RETURN DUCTS.
- FURNACE TO BE PAYNE 344 G, 000050, 1/2" 20.9" IN INFL, 60 CFM, 0.3 EXT. 3.6 MIN. INS ALL W/ 1/2" SAFETY CUTOFF & ADJUSTED FOR ALTITUDE. 1/2" GAS CONNECTION W/ 4" FLUE THRU ROOF. RETURN AIR LOCATED INSIDE OF FURNACE. MAKE FLEXIBLE DUCT CONNECTION TO FURNACE FOR SUPPLY & RETURN DUCTS.
- SIDEWALL REGISTERS TO BE AIR-VATE 24" V-0 (B2).
- EVAP COOLER TO BE ARCTIC CIRCLES #22013-2, W/ RECIRCULATING PUMP VAP. MAKE FLEXIBLE CONNECT FROM COOLER TO SUPPLY DUCT. MOUNT COOLER TO PLATFORM ON EXTERIOR BLOCK. PER MECH. PLAN.
- EXHAUST FAN EQ. TO BIRDAIR #66B3, 50 CFM, CEILING RECESSED, COMPLETE PACKAGE UNIT W/ BUILT-IN DAMPER. PROVIDE 1/2" DUCT UP THRU ROOF TO ROOF JACK.

GENERAL NOTES:


- All plumbing and mechanical systems shall comply with all applicable codes, ordinances, and OSHA standards.
- Location of existing fixtures, lines, etc., shown on the Drawings are approximate and shall be field verified.
- The water, waste and vent lines as shown on Drawings indicate approximate routing. Exact location of lines shall be coordinated w/field conditions and rough-in requirements of fixtures.
- Remove and replace existing floor slabs, walls and ceilings as required for installation of new plumbing lines and connection to existing services. Replace damaged construction to match new finishes.
- Contractor shall repair all damage to floors, walls, ceilings, etc., in a professional manner. Seal all wall or ceiling openings with matching material; this shall be done at no cost to the Owner. If roof needs to be penetrated, pitch pans and/or proper flashings are then required. The roof shall be patched and repaired as directed.
- Any damage to existing equipment, structure, building, etc., shall be patched and repaired as directed by Owner, at no additional cost to the Owner.
- All piping shall be concealed where possible (unless otherwise noted). All exposed piping where concealment is not possible shall be painted.
- No water piping shall be installed below floor, except as shown.
- All water piping shall be insulated. See Specifications for type.
- No water piping shall be located in outside walls, unless shown on these Drawings, and then piping is to be insulated per Specs.
- All branches shall be valved, all valves shall have unions adjacent. Access panels shall be furnished and installed for access to valves where required.
- All piping shall pitch to drain, and Contractor shall provide valving for drainage. Contractor shall deliver a marked-up set of Plans to the Owner (prior to final payment) showing all branch valves and all drainage points.
- Care shall be taken to avoid mechanical ductwork, electrical equipment and air handling equipment. This Contractor shall be responsible for coordinating routing of piping with Ceiling Contractor and Sheetmetal Contractor. Relocation of piping required by poor coordination by this Contractor shall be at his own expense.
- All water piping in Mechanical Equipment Room shall be insulated.

3 PLUMBING STACK
NO SCALE

PLUMBING FIXTURE SCHEDULE					
SYMBOL	ITEM	MANUF & NUMBER	DESCRIPTION	TRAP	WASTE
WC	WATER CLOSET	KOHLER #K-3475-BB	K-4632 SEAT, 3/8" SUPPLY WITH STOP	-	2"
LAV	LAVATORY	KOHLER #K-2030	20"x18" WITH K-7436T FAUCET & DRAIN. TRAP K-9000 & 3/8" SUPPLIES WITH STOPS.	1/4"	1/2"
SK	SINK	EXIST.	RELOCATE & USE EXISTING SINK AND FITTINGS.	1/2"	1/2"
ELWC	WATER COOLER	ELWC-4	1/4" P-TRAP, 3/8" SUPPLY W/ STOP	1/4"	1/2"
SH	SHOWER	ELWC #034-0910	30"x50" FIBERGLASS SHOWER UNIT. USE #FB-2-0350 FITTING W/ WATER-SAVING SHOWERHEAD & #B03-0625 STRAINER/DRAIN FITTING.	2"	2"
DS	DRENCH SHOWER	BRADLEY #S-1912	10" Ø PASTIC SHOWERHEAD, 1" STAY-OPEN BALL VALVE OPERATED BY PULL ROD, WALL BRACKET.	-	1/4"
FD-1	FLOOR DRAIN	WADE #W-1102	CAST IRON WITH 6" STANDARD SATIN NICKEL BRONZE STRAINER & 2" P-TRAP	2"	2"
FD-2	FLOOR DRAIN	WADE #W-1102	CAST IRON WITH 6" STANDARD SATIN NICKEL BRONZE STRAINER & 4" DIAMETER FUNNEL & 2" P-TRAP	2"	2"
FCO	FLOOR CLEANOUT	WADE #W-1004	CAST IRON 4" SIZE, WITH ADJUSTABLE HOUSING & STD. ROUND NICKEL BRASS SCRETTED TOP	-	4"
HWH	HOT WATER HEATER	SMITH #P4X-30	AGA APPROVED W/ 100% SAFETY CUTOFF & ADJUSTED FOR ALTITUDE. 30 GAL GLASS LINED STEEL TANK. 30,000 BTU/H INFL. INSTALL W/ HWH C/W, 3/4" FLUE, 1/2" GAS, 3/4" TP RELIEF VALVE.	-	3/4"

PLUMBING STACK NOTES:

- PIPING CONCEALED IN JOIST SPACE.
- PIPING CONCEALED IN WALL.
- PIPING BELOW SLAB.
- 1/2" x 12" AIR CHAMBERS.
- 3/4" PIPE FROM HWH TO PRELIEF VALVE. TAKE TO FLOOR DRAIN & LEAVE OPEN END 8" AFF.
- MAKE CONNECT W/ NEW PIPE TO EXIST. PIPE. CONTR TO VERIFY ACTUAL LOCATION OF EXIST, AS WELL AS FLOW DIRECTION OF WASTE.
- 3" HWH FLUE. COMBINE W/ FURNACE FLUE TO 6" FLUE THRU ROOF W/ SLEEVE & CAP. INSTALL W/ CERTIFIED DRAFT DIVERTER. SEE MECH. FLOOR PLAN THIS SHEET.

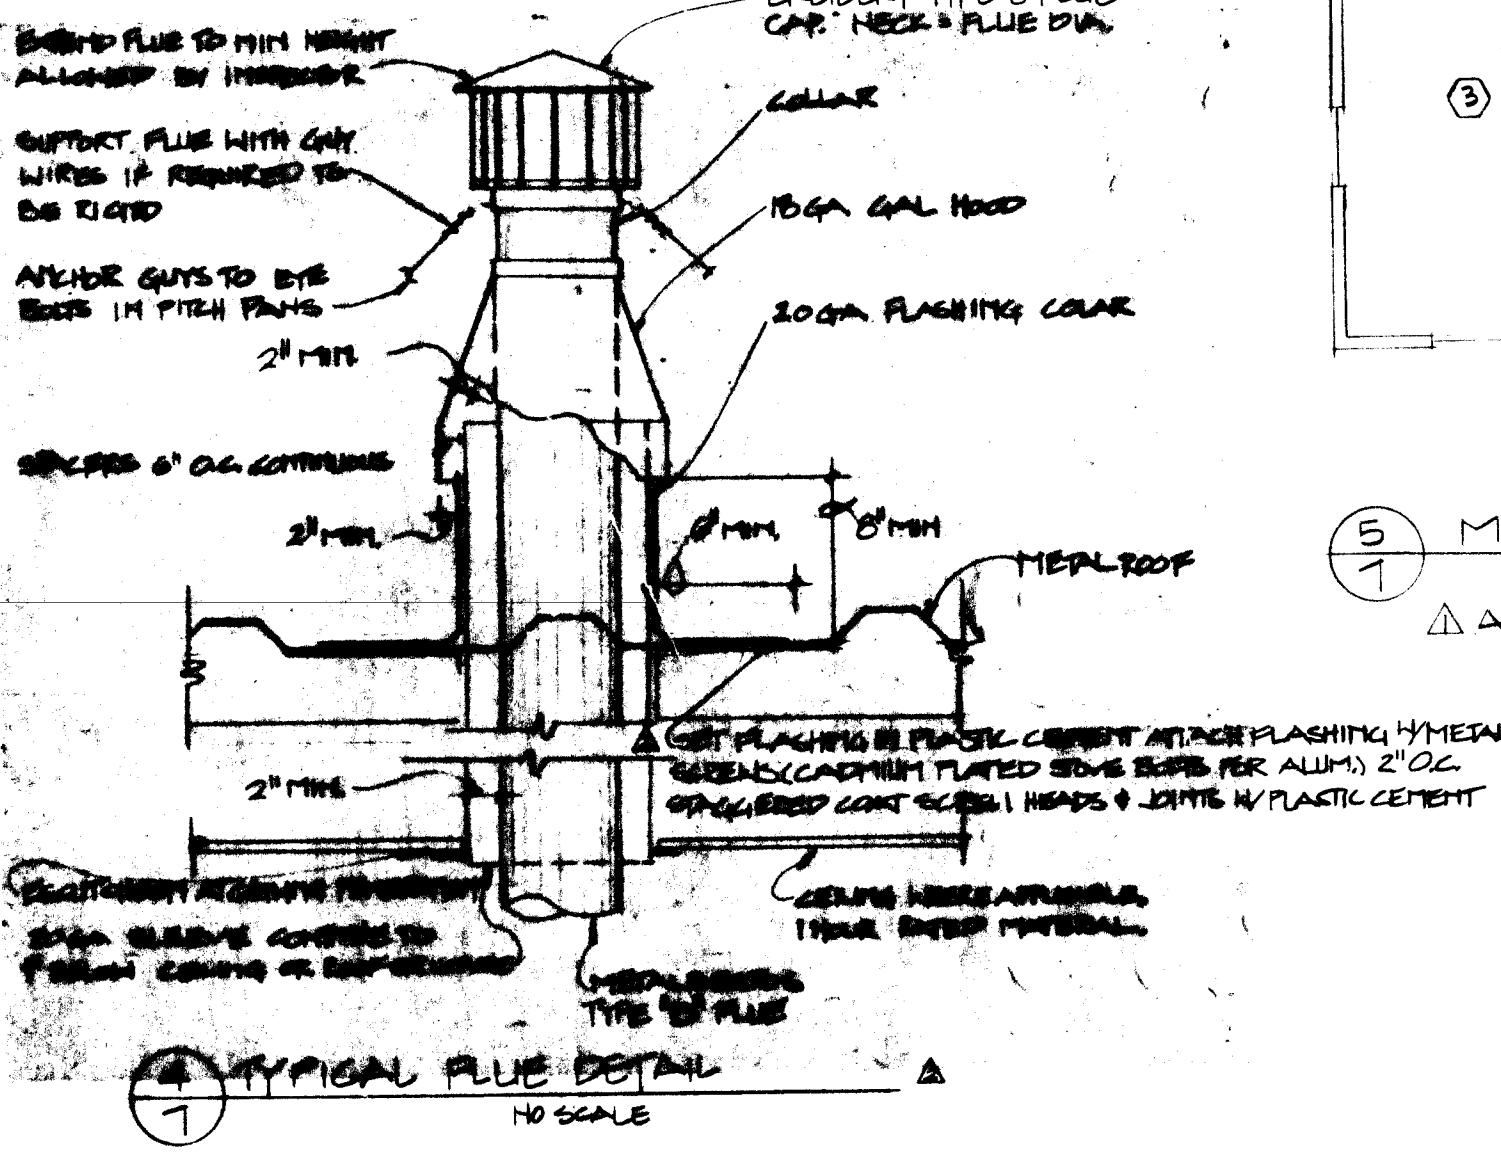

4 TYPICAL FLUE DETAIL
NO SCALE

5 MECHANICAL FLOOR PLAN
SCALE: 1/8" = 1'-0"

AS-BUILT: SEE ARCHITECTURAL FOR REVISED TOILET ROOM PLAN

1661

dekker & associates
architects & engineers & planners



3403 SUMMIT NE SUITE 200 ALBUQUERQUE, NEW MEXICO 87110 505 844 4688

ARRIVO DEL DESO GOLF COURSE 7001 mesa rd n e

job no. 8208 sheet 7

drn by JCH
ckd by AWP
issued 2-1-93

date revision
AS-BUILT 12/20/93

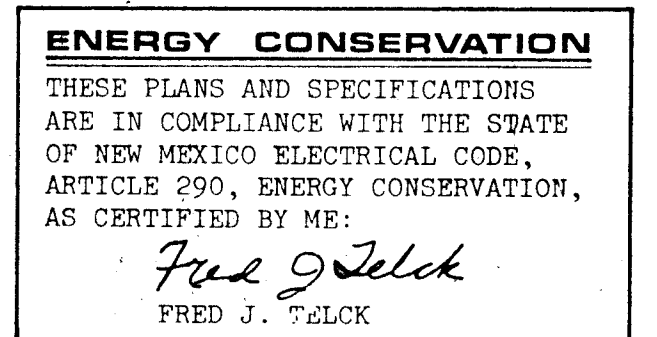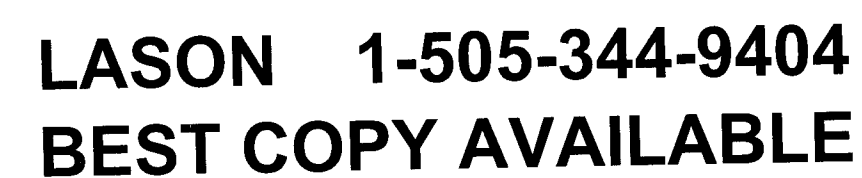

PROJECT DATA:

LAND DESCRIPTION LOS ALTOS

Tract 1
 Lot(s) 1
 Block MUNICIPAL ADDITION NO. 2
 Addition Map Reference K-20-2
 Zoned Map Reference K-20-2

STRUCTURAL DESIGN CRITERIA

Roof Live Load 20 PSF
 Floor Live Loads:
 Basement 10 PSF
 First 10 PSF OFFICE & LUNCH / 25 PSF RECREATION STORAGE
 (LOFT) 100 PSF
 Mezzanine 10 PSF
 Second 10 PSF
 Third 10 PSF
 Wind Load 25 PSF
 Seismic Zone 2
 Fire Zone 1
 Type of Construction II
 Occupancy B-1 & B-2 II 4
 Stress Values:
 Lumber 1200 F
 Steel 24000 PSI
 Soil Bearing Capacity 2000 PSF

CONCRETE STRENGTHS, 28 DAY TEST

Block Fill 3000 PSI
 Floor Slabs, Bond Beams 3000 PSI
 Footings, Walls 3000 PSI
 Exterior Walks, Slabs, Etc. 3000 PSI ARE ENTRAINED

FLOOR AREAS SQ. FT. ALLOWABLE


Basement Base
 First 220 (NEW) 220 (EXIST)
 Mezzanine 220 (NEW) 220 (EXIST)
 Second 220 (NEW) 220 (EXIST)
 Third 220 (NEW) 220 (EXIST)
 Total Area 220 (NEW) 220 (EXIST)
 Occupant Load 100
 Parking Required 100
 Parking Provided 100

REFUSE CONTAINERS

OWNER TO PROVIDE AS REQ'D BY CITY OF ALBUQUERQUE.

GENERAL NOTES

- Affected Contractors to verify exact location of all utilities.
- General Contractor to be responsible for compliance with requirements of city of Albuquerque Dept. of Environmental Health, Air Management Division, regarding control of dust from excavation and grading operations. Contractor to obtain topsoil removal permit.

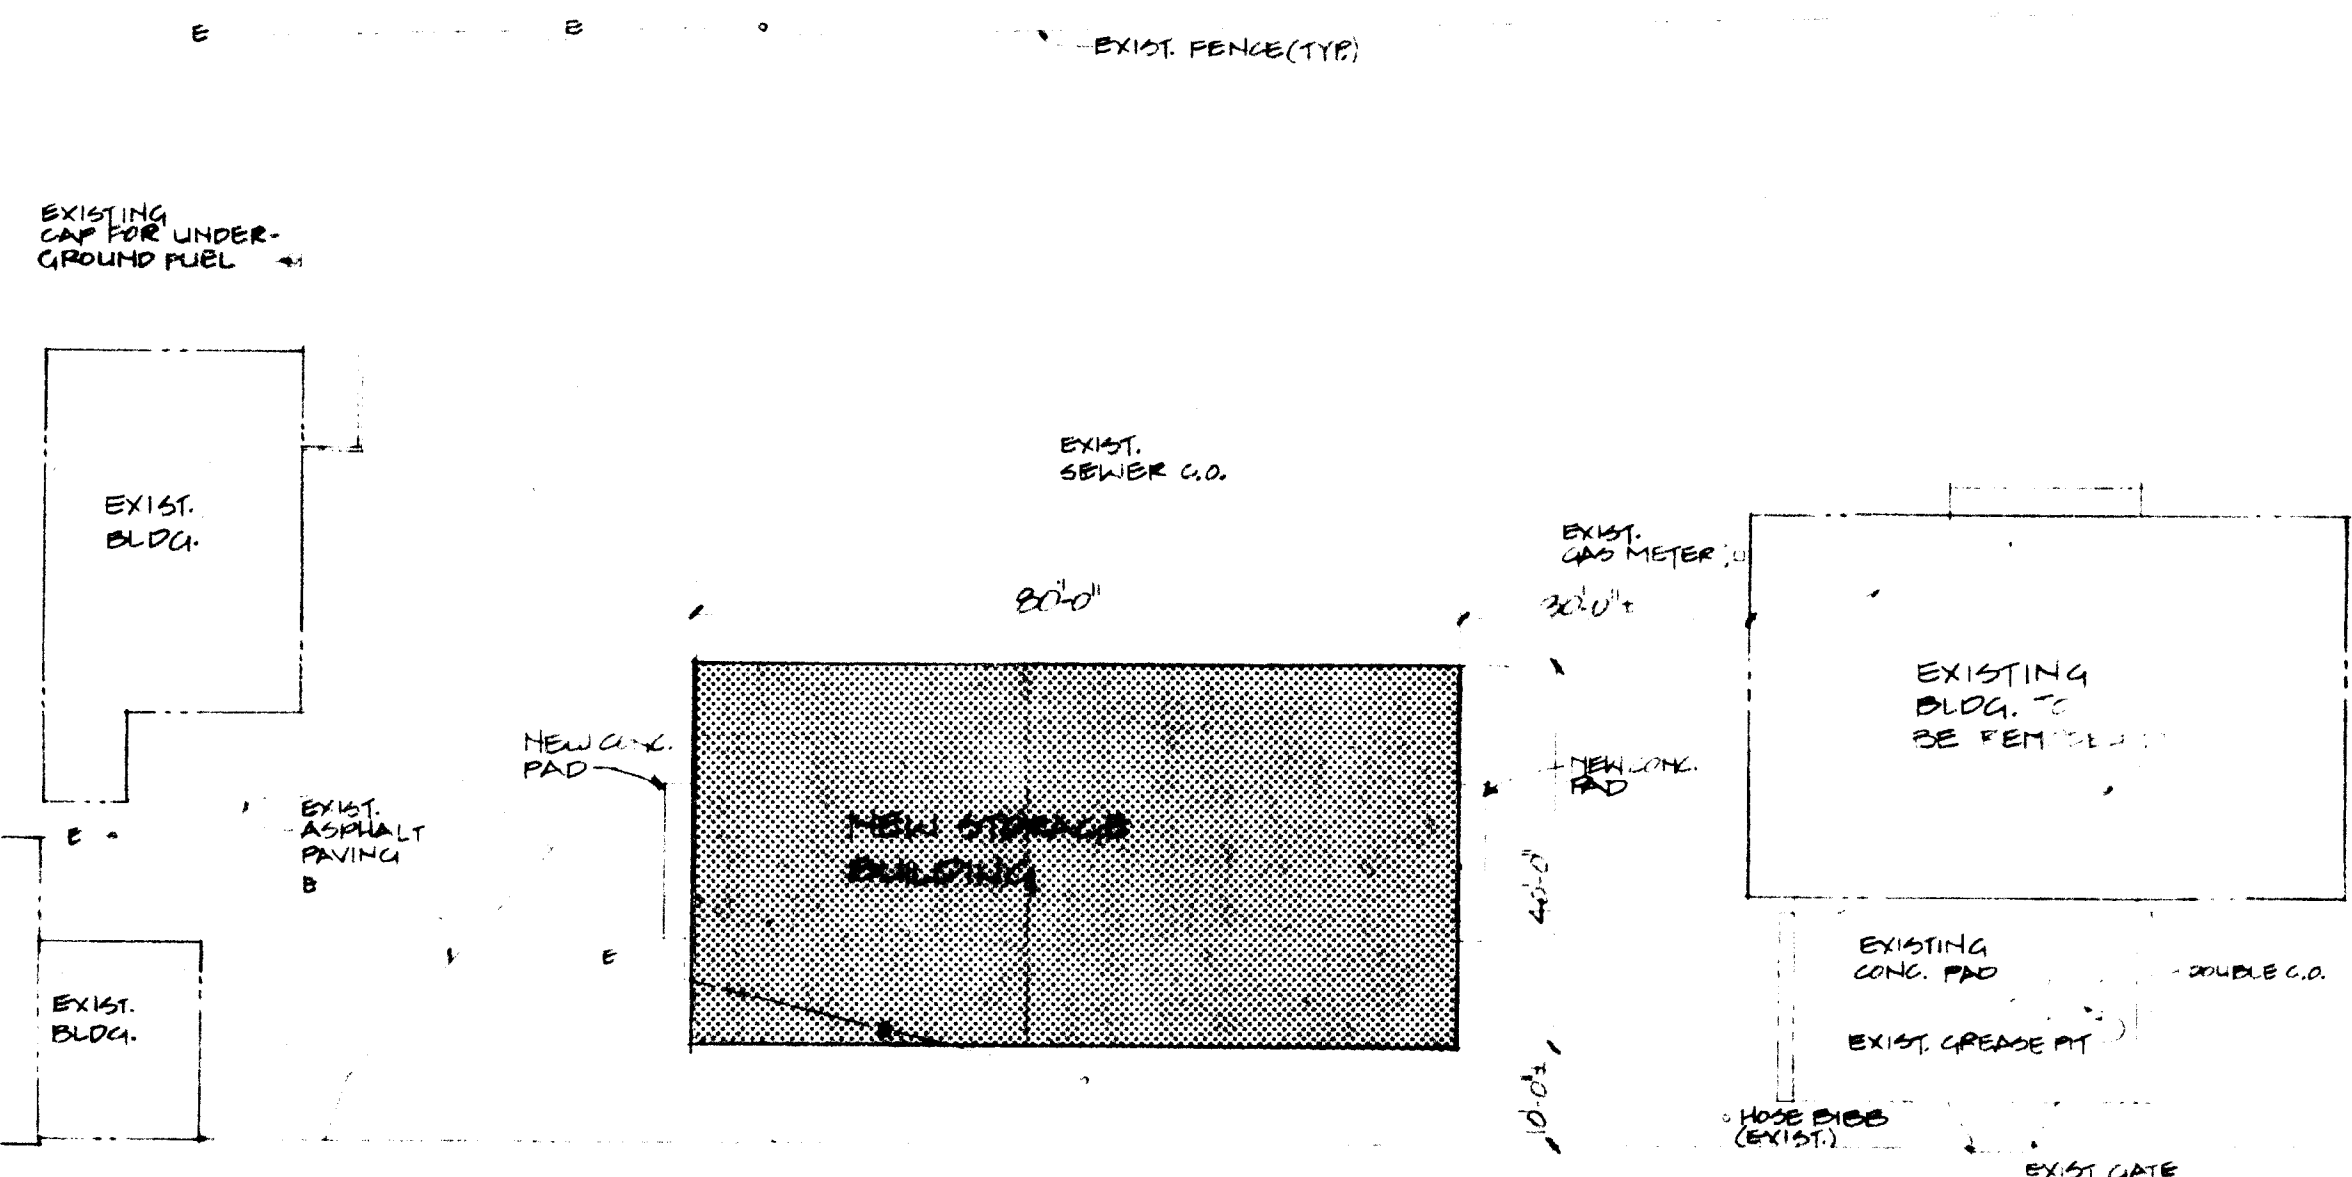

NOTE: CONTR TO VERIFY AND LOCATE ALL UNDERGROUND UTILITIES PRIOR TO EXCAVATION.

LOS ALTOS

SITE PLAN

SCALE: 1"=20'-0"



LOCATION PLAN

INDEX TO DRAWINGS


ARROYO DEL OSO	SPORTS STADIUM
1. SITE PLAN, PROJECT DATA, ENERGY CALCULATIONS	17. SITE PLAN, PROJECT DATA, ENERGY CALCULATIONS
2. DRAINAGE INFORMATION AND DETAILS	18. DRAINAGE INFORMATION AND DETAILS
3. DEMOLITION AND REMOVAL PLAN AND NOTES	19. DEMOLITION AND REMOVAL, FLOOR PLANS, SCHEDULES
4. FLOOR PLAN, FOUNDATION & FRAMING, SCHEDULES	20. ELEVATIONS AND SECTIONS
5. ELEVATIONS AND SECTIONS	21. UTILITY SITE PLAN, HVAC AND PLUMBING
6. DETAILS	
7. UTILITY SITE PLAN, HVAC AND PLUMBING	
8. ELECTRICAL, LIGHTING AND POWER	
LOS ALTOS	PUERTO DEL SOL
9. SITE PLAN, PROJECT DATA, ENERGY CALCULATIONS	23. SITE PLAN, PROJECT DATA, ENERGY CALCULATIONS
10. DRAINAGE INFORMATION AND CALCULATIONS	24. DRAINAGE INFORMATION AND DETAILS
11. DEMOLITION AND REMOVAL PLAN AND NOTES	25. DEMOLITION AND REMOVAL, FLOOR PLANS, SCHEDULES
12. FLOOR PLANS, FOUNDATION & FRAMING, SCHEDULES	26. ELEVATIONS AND SECTIONS
13. ELEVATIONS, SECTIONS	27. DETAILS
14. DETAILS	28. UTILITY SITE PLAN, HVAC, PLUMBING
15. UTILITY SITE PLAN, HVAC AND PLUMBING	29. ELECTRICAL LIGHTING AND POWER
16. ELECTRICAL LIGHTING AND POWER	

MAINTENANCE AND STORAGE FACILITIES PARKS AND RECREATION DEPARTMENT CITY OF ALBUQUERQUE PROJECT 82-23

LOS ALTOS GOLF COURSE

LASON 1-505-344-9404
BEST COPY AVAILABLE

UBC CHAPTER 53 REQUIREMENTS			
PROJECT: LOS ALTOS GOLF COURSE (EXISTING BLDG.)		BLDG. TYPE B-1 Page 1 of 1	
Summer	Winter	Degree Days 3911	Latitude 35
Inside 78°F	70°F	"U ₀ ", Roof, Max. = 0.09	By: JCH
Outside 91°F	17°F	"U ₀ ", Wall, Max. = 0.32	Date: 10/29/82
Difference 19°F	53°F	OTTV, Max. = 32	
WALL TYPE "A"; TD _{ea} = 44		WALL TYPE "B"; TD _{ea} = 44	
0.04 STEEL PANEL INSUL. 1.5A	0.17 0.0 11.0 0.00	STILL AIR 0.15 1/2" GYP BO 0.08 STL STUDS 10.0 0.45 INSUL. 0.02 1/2" GYP BO 0.45	0.08 0.08 0.45 0.45
Total "R" Value 11.85	Total "R" Value 2.20	Total "R" Value 12.58	Total "R" Value 11.85
Total "U" Value 0.084	Total "U" Value 0.44	Total "U" Value 0.08	Total "U" Value 0.084
Aver. "U" Value 0.084	Aver. "U" Value 0.13	Aver. "U" Value 0.08	Aver. "U" Value 0.084
WALL TYPE "A" = 1142 #	WINDOW U = 0.58	ROOF TYPE "A" = 1686 # (HEATED)	
WALL TYPE "B" = 580	DOOR "A" U = 0.59	SKYLIGHT AREA =	
GLAZING AREA "A" = 35	DOOR "B" U = 0.56	ROOF VENT AREA =	
GLAZING AREA "B" =	Stud Spacing Framing Cavity	OTHER =	
DOOR AREA "A" = 123	12" .17 .83	OTHER =	
DOOR AREA "B" = 100	16" .15 .85	OTHER =	
DOOR AREA "C" =	24" .10 .90	OTHER =	
GROSS WALL AREA = 1980 #		GROSS ROOF AREA = 1686 #	
WALLS U ₀ = 1142(0.084) + 580(0.13) + 35(0.58) + 123(0.59) + 100(0.56) / 1980 U ₀ = 0.16 < 0.32 ∴ OK ROOF U ₀ = 1686(0.084) / 1686 U ₀ = 0.084 < 0.09 ∴ OK TOTAL HEAT LOSS (BTU) MAX. BY CODE ROOF 0.09 x 1686 x 53 = 8042.2 WALLS 0.16 x 1980 x 53 = 20800.8 TOTAL 41623.0 ACTUAL ROOF 0.084 x 1686 x 53 = 7500 WALLS 0.16 x 1980 x 53 = 20800.8 TOTAL 28300.8			
WALLS OTTV = 1142(0.084) + 580(0.13) + 35(0.58) + 123(0.59) + 100(0.56) / 1980 OTTV = 9.1 < 32 ∴ OK ROOF U ₀ = 1686(0.084) / 1686 U ₀ = 0.084 < 0.09 ∴ OK			

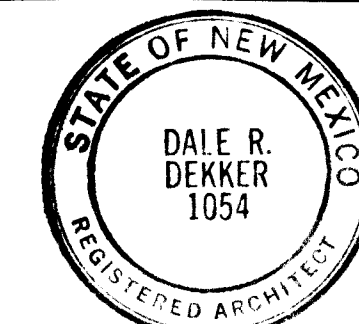

dekker & associates
architects & engineers & planners


2403 San Mateo, N.E. suite P-15 Albuquerque, New Mexico 87110 505 364 3689
 LOS ALTOS GOLF COURSE 9717 copper ave n e
 albuquerque n m

job no.	8208	sheet	
drn. by	JCH		
ckd. by	AWD		
issued	2-1-82		
no. date revision			

9

29

LASON 1-505-344-9404
BEST COPY AVAILABLE

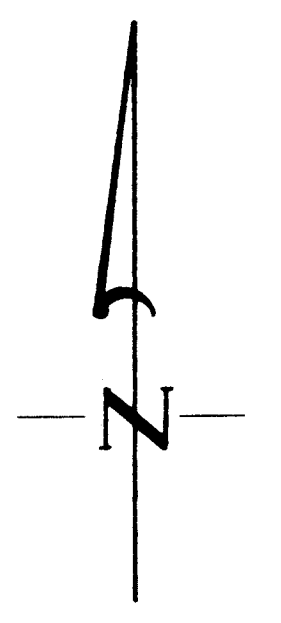

SCALE: 1"=10'-0"

SYMBOL LEGEND

- 87.5 EXIST. SPOT ELEVATION
- 85.1 NEW SPOT ELEVATION
- EXIST. CONTOUR
- NEW CONTOUR
- 88.0 NEW SPOT ELEV. TOP OF PAVING

NOTES:

ELEVATIONS ARE BASED ON ACS BENCH MARK NO. 1-K 20, A "I" CHISELED ON TOP OF CONCRETE CURB AT THE SSE RETURN AT LOMAS BLVD. NE AND HERNDON ST. NE. ELEVATION = 5380.954 (MSLD 1929)

TBM (SET) TOP OF CONCRETE FOOTING AT NW CORNER OF EXISTING BLDG. ELEVATION = 5389.10

25' GRID ORIGINATING AT NW CORNER OF BLDG. BASE LINE 25' NORTH OF BLDG.

1 FT. CONTOUR INTERVALS

DRAINAGE CALCULATIONS ARE BASED ON THE 100 YEAR, 6 HOUR ATTEM. BY USE OF THE RATIONAL METHOD.

This is to certify that I am Registered Land Surveyor. That this plat was prepared from field notes of a real survey made by me or under my supervision & that the same are true & correct to the best of my knowledge & belief.

Santraan D. Gutierrez NMLS #4251




12-20-83
AS-BUILT


NOTE: 10 MINUTE DRAINAGE IS PROVIDED FOR THIS SITE.

DRAINAGE CALCULATIONS		
	EXISTING	PROPOSED
AREA(A)	4,200 SQ. FT.	3,200 SQ. FT.
C	1.00	0.15
Q (C/A)	1.00	0.15
Q (1/4 PERCENT)	26	2.6
V (1/4 PERCENT)	26	2.6
V (1/4 PERCENT)	341 CUF. FT.	341 CUF. FT.

NOTES:
1. SOUTH SIDE OF BUILDING TO HAVE GUTTER WITH AN OUTLET ON WEST END, OR WITH 2% GRADING OFF AWAY FROM BUILDING, AND 1% FLOW LINE SLOPE RUNNING SOUTH PARALLEL TO BUILDING.
2. 10' DRAINAGE SHALL BE ALLOWED TO SHEET PLAN ACROSS THE HARD-PAVED EARTH AND NORMAL DRAINAGE WHERE THEY THEN ARE ACCEPTED BY A TRIBUTARY OF THE FREQUENT STORMWATER DRAINAGE CHANNEL.

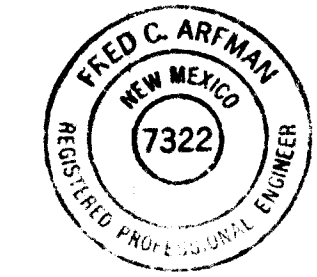


1661

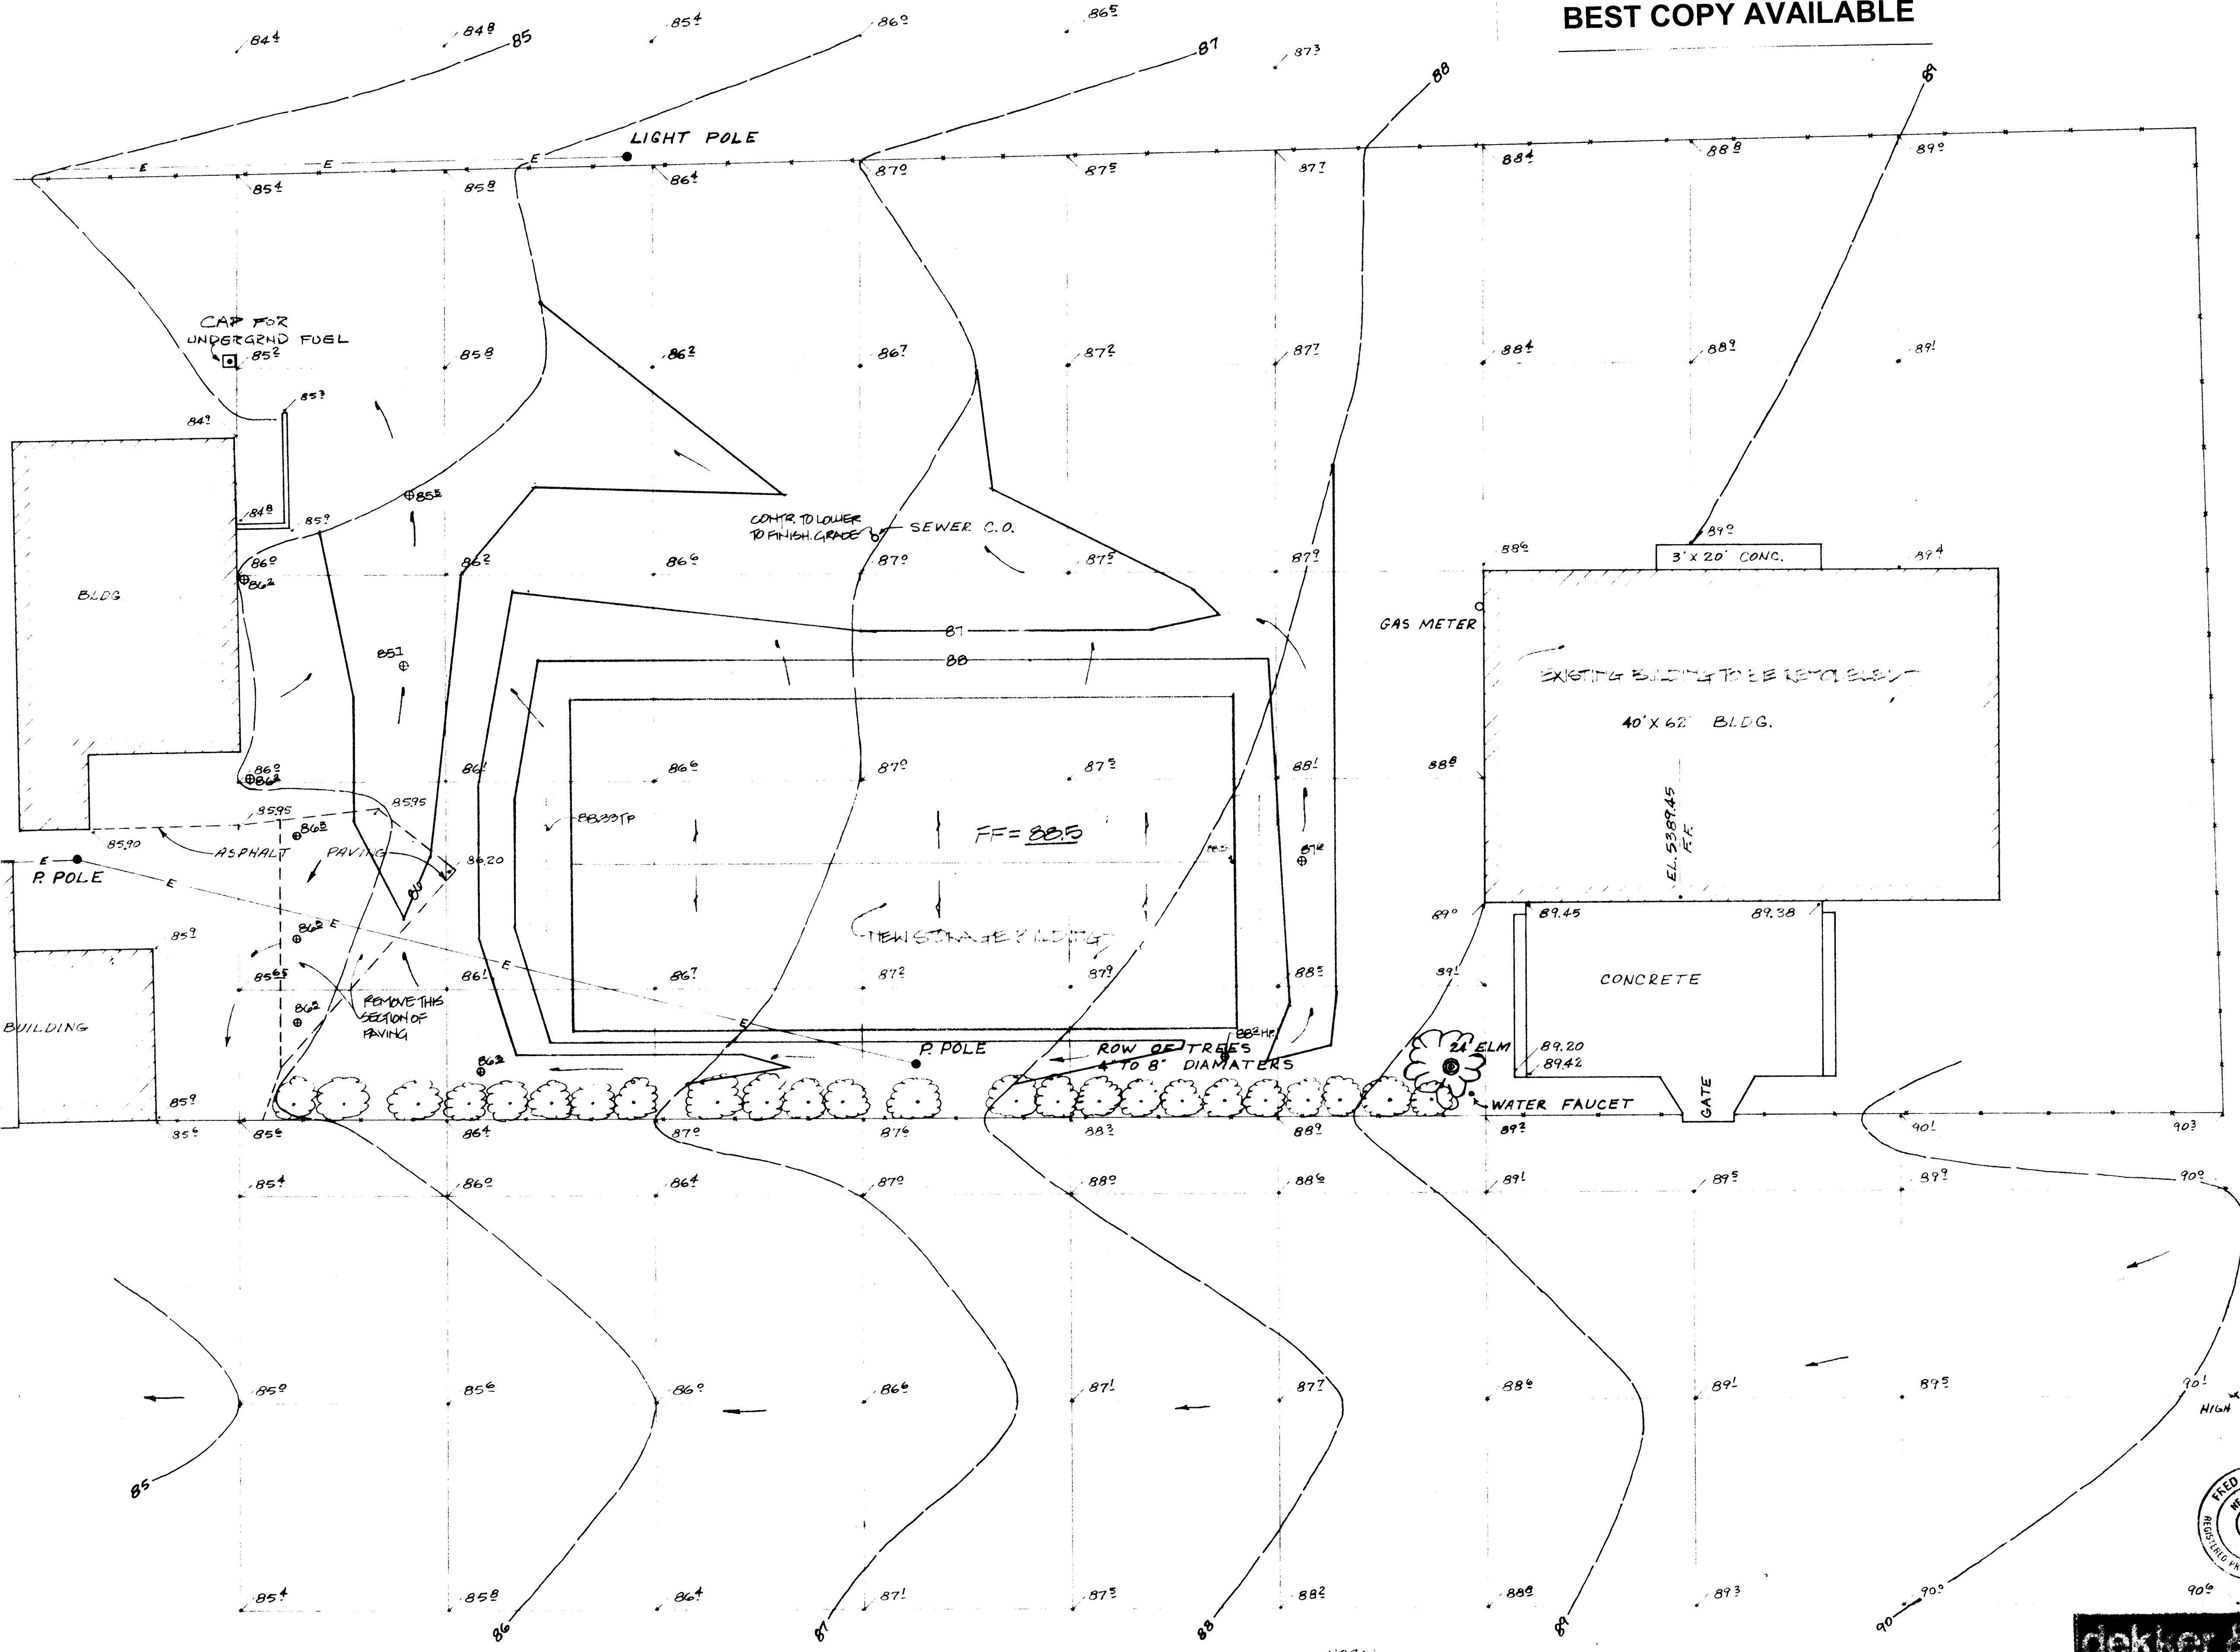


1 SITE DRAINAGE PLAN
10 SCALE: 1"=10'-0"



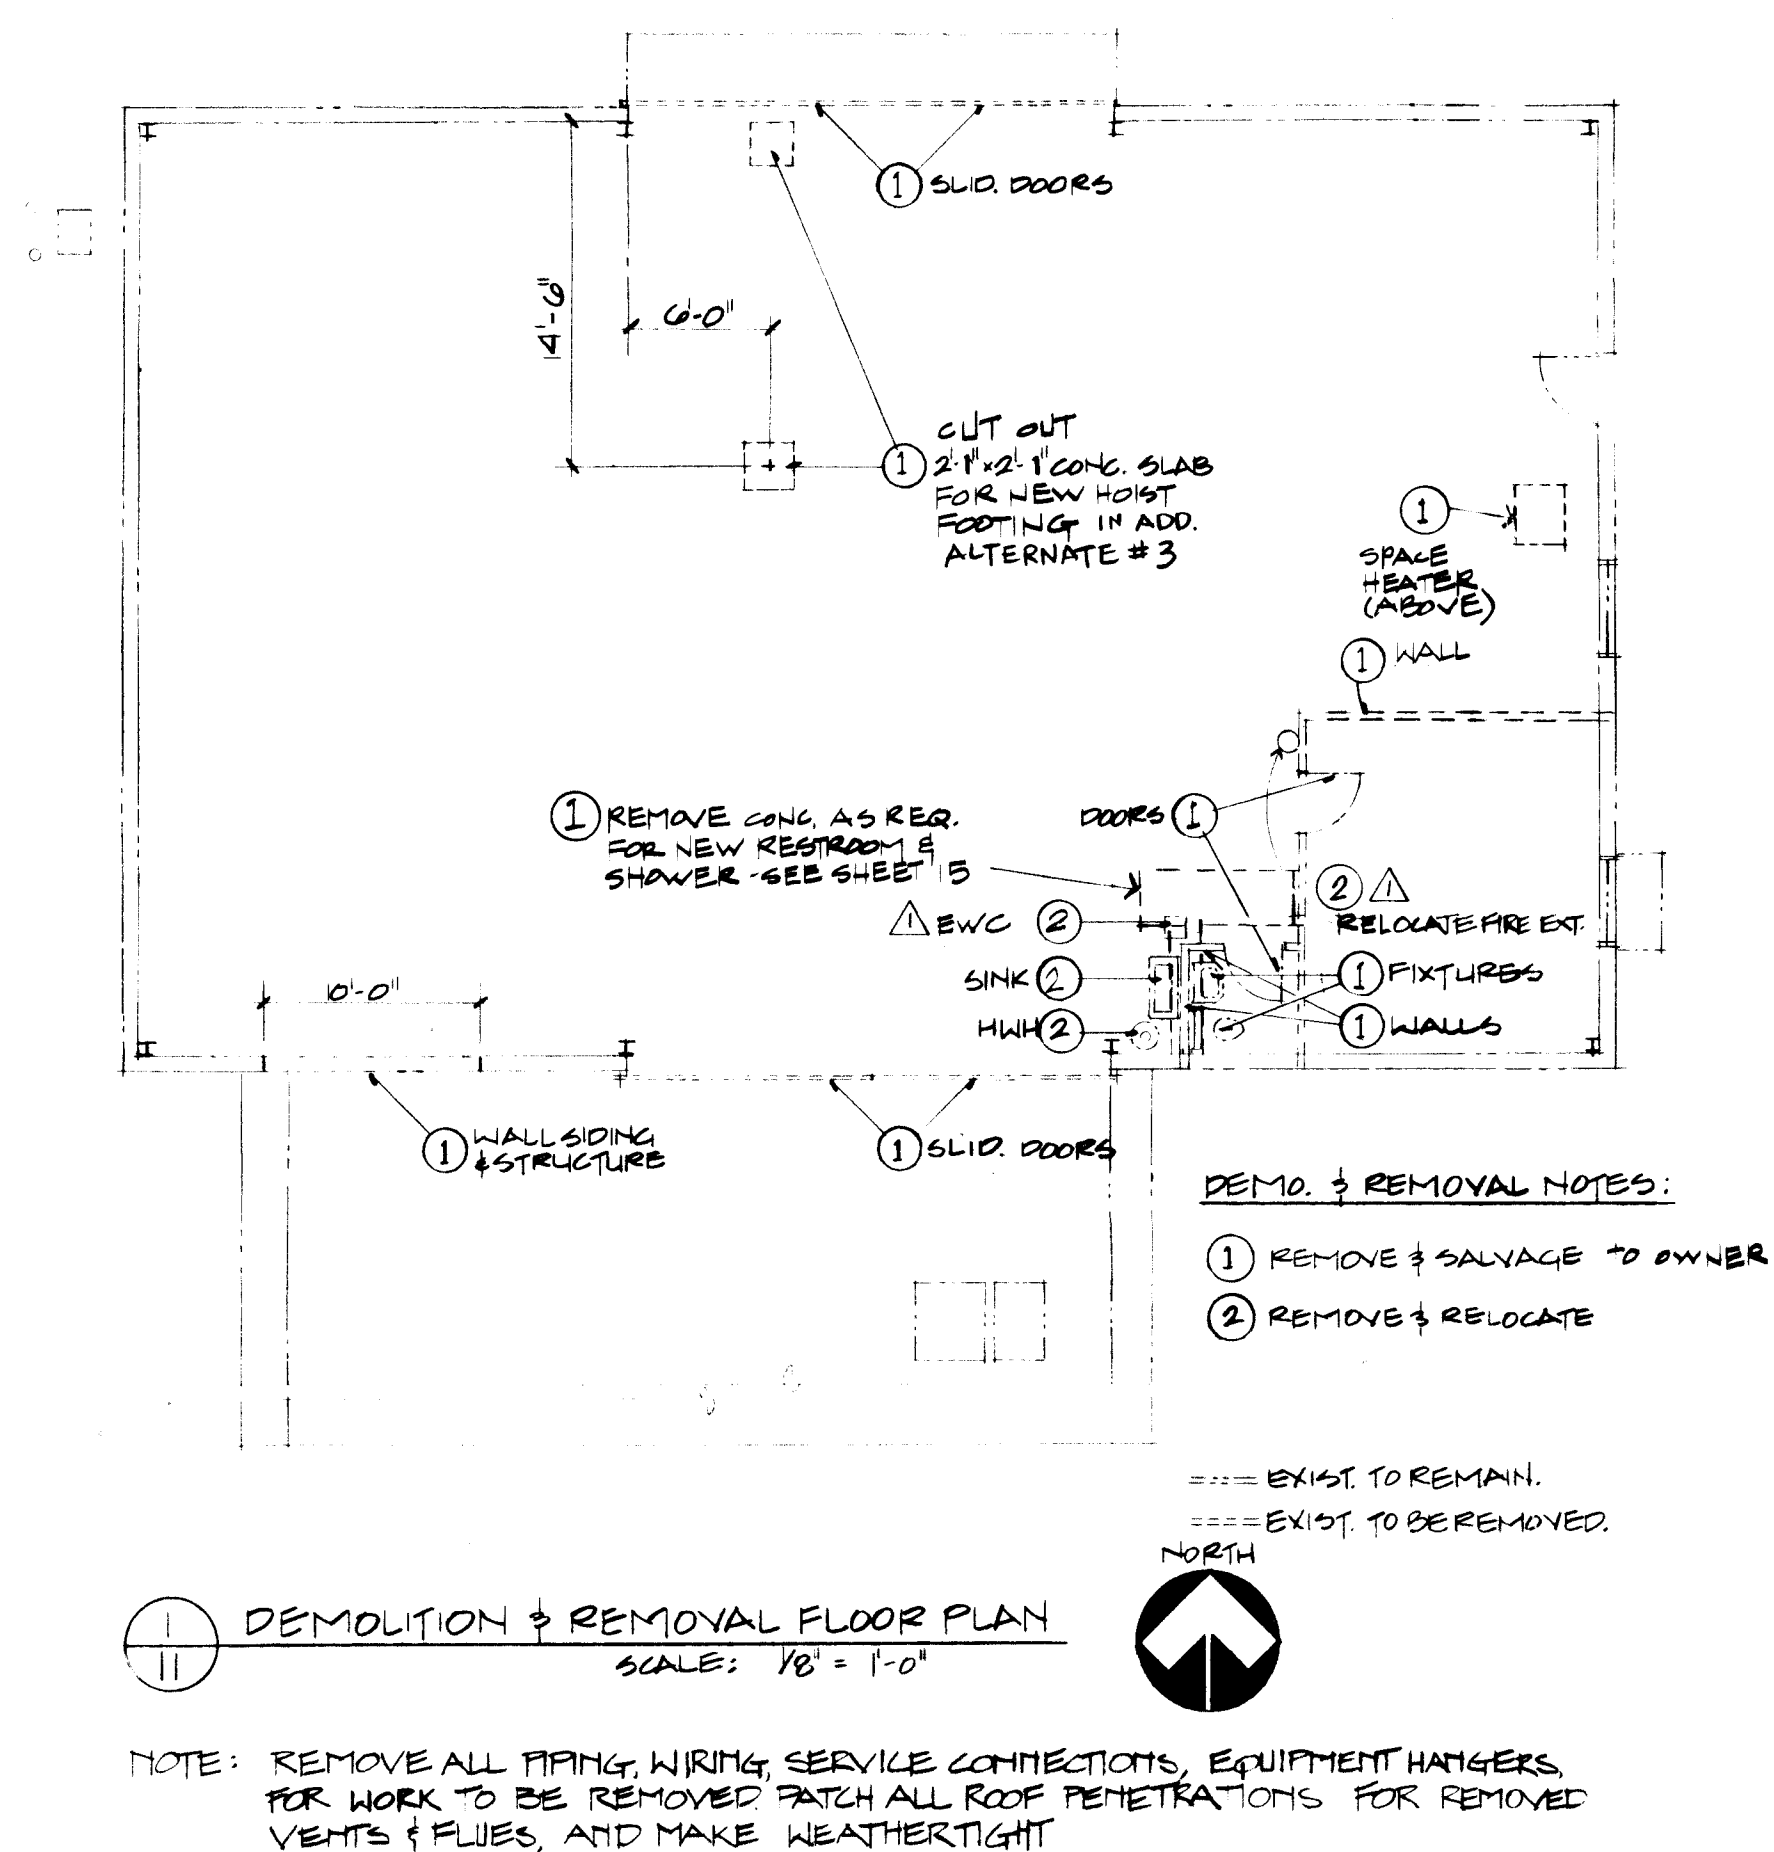

LASON 1-505-344-9404
BEST COPY AVAILABLE

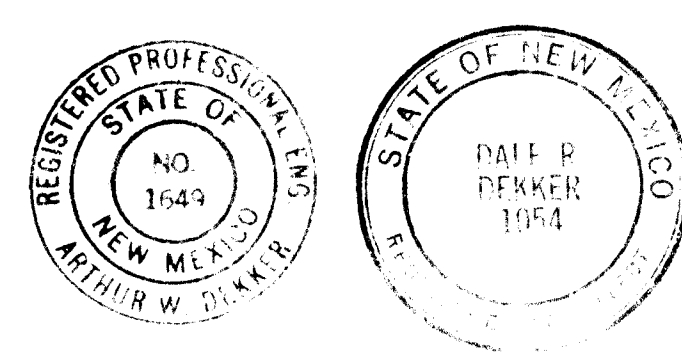

1661

dekker & associates
architects & engineers & planners
2401 San Mateo NE Suite 100 Albuquerque, New Mexico 87110 505 884 3689




job no. 8208 sheet
drn by JOH
ckd by AWD
issued 2-1-83 11

no date revision
AS BUILT 12/20/83


LOS ALTOS GOLF COURSE 8717 copper ave n e
Albuquerque, N.M.

26 1661 1183
2-23-83
AS-BUILT





of 28

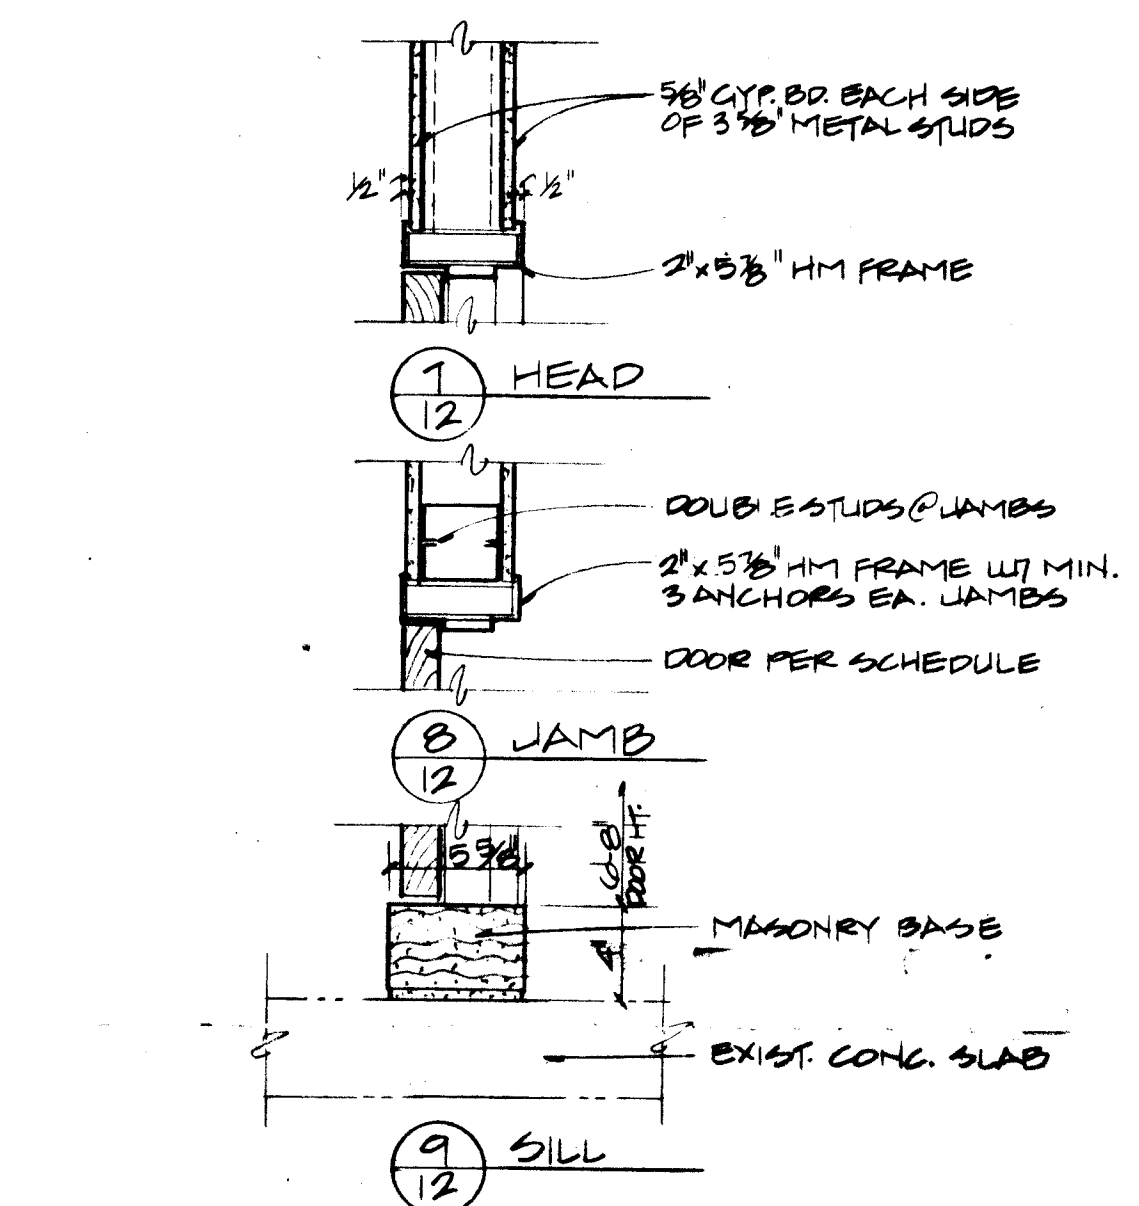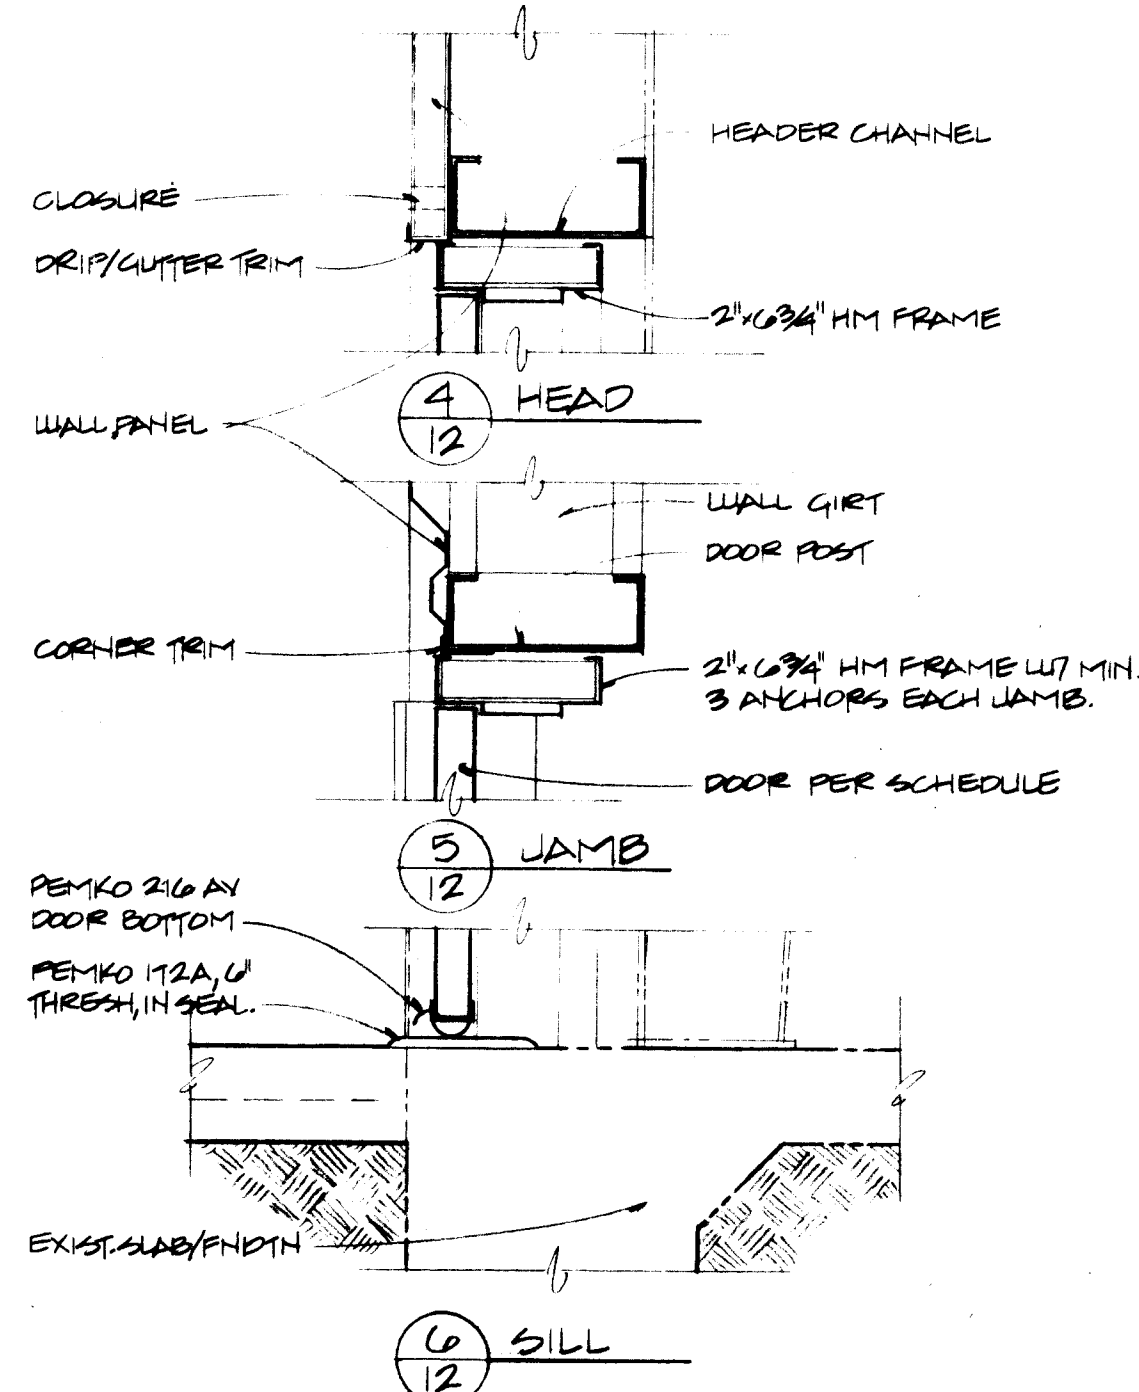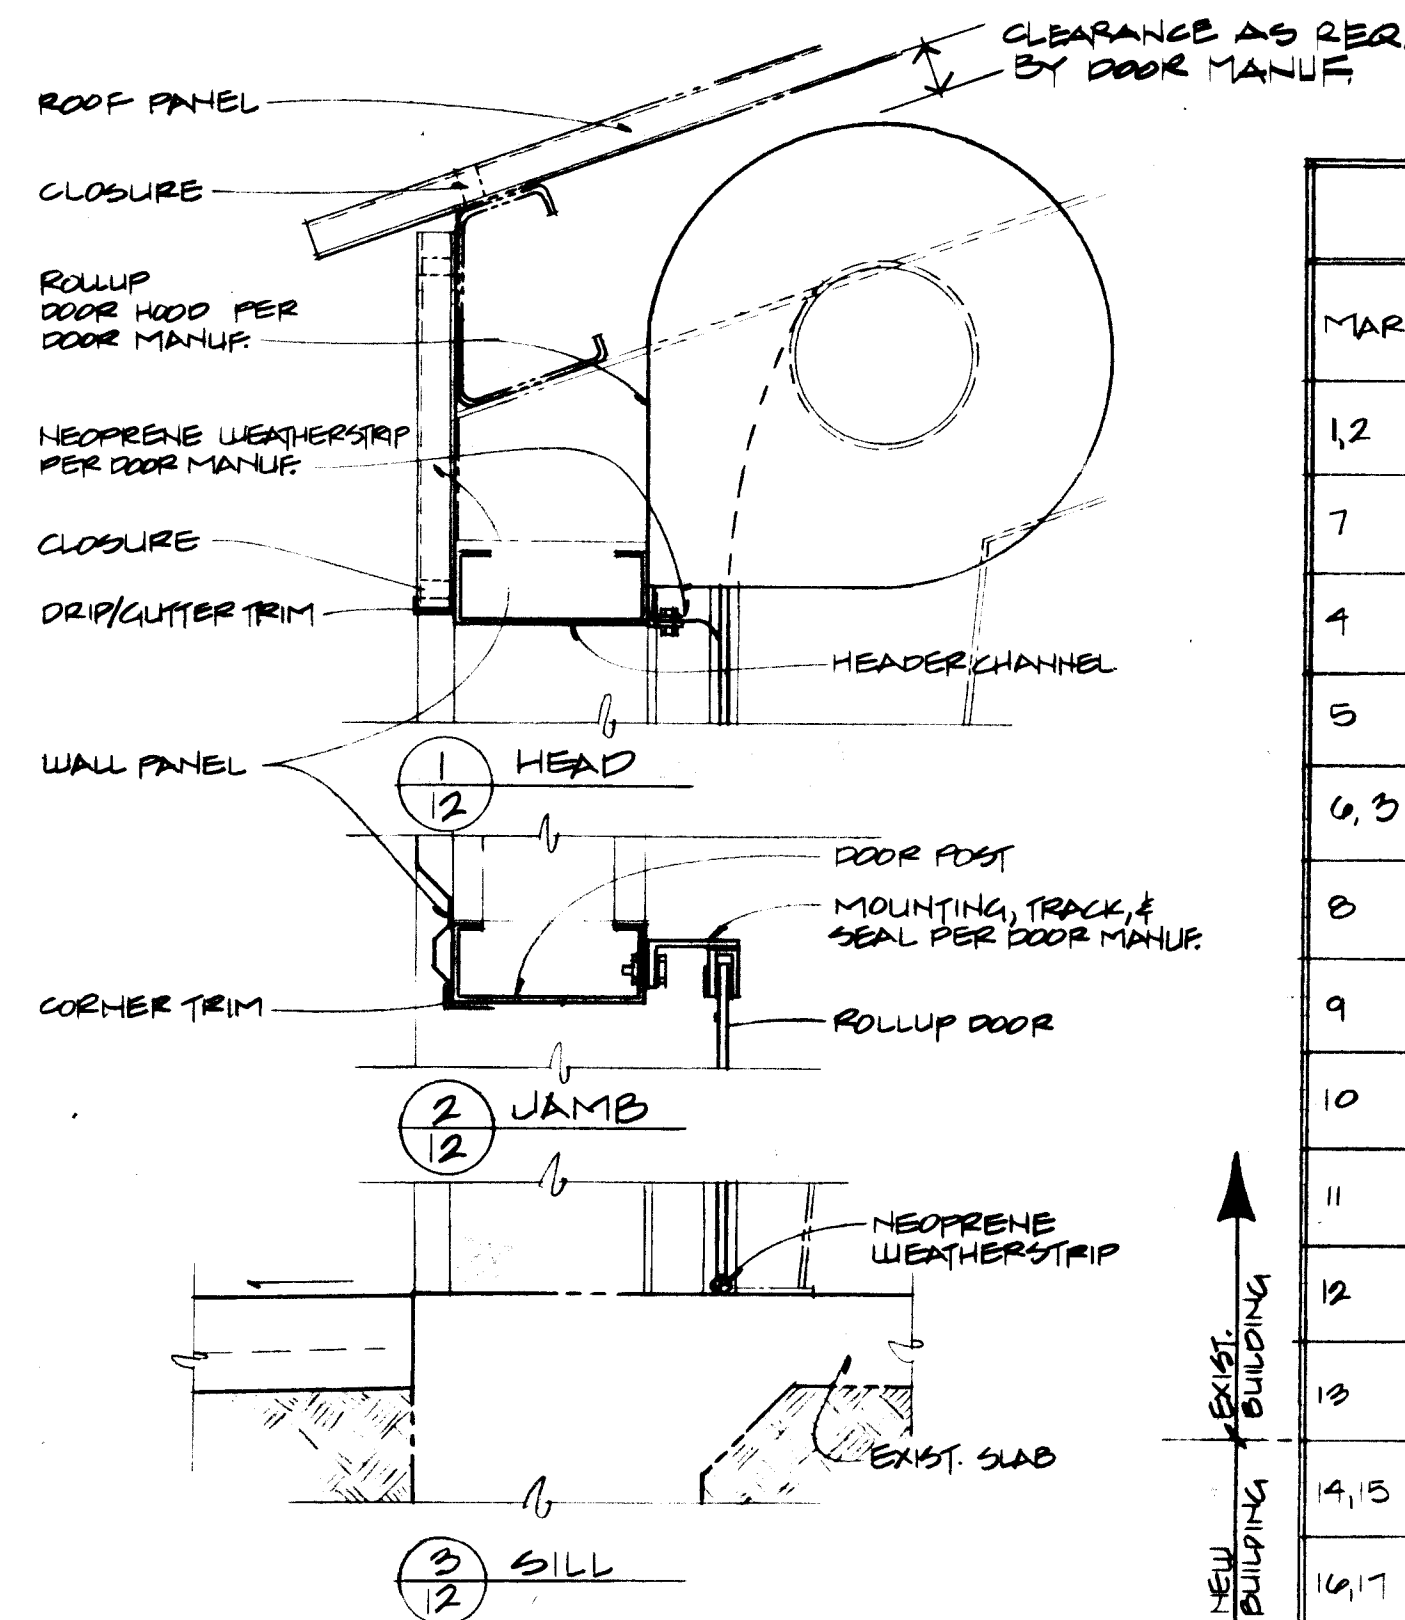


MARK	SIZE	THICK	TYPE	MAT'L	FRAM DET'S	HARDWARE	REMARKS
				WOOD METAL	HEAD JAMB SILL	BUTTS 1/2 PR LOCKSET STOP HOLDER	
1,2	10'-0" x 8'-0"	RU		STEEL	1 2 3	STANDARD W/ DOOR	
7	8'-0" x 6'-8"	1 3/4"	B	H.C.	7 8	F-179 3/4" x 3/4" GU 65 W-B12	
4	2'-0" x 6'-8"	1 3/4"	B	S.C.	7 8	PR-2000 1/2" x 1/2" GU 65	1-HR LABELED DOOR & FRAME
5	3'-0" x 6'-8"	1 3/4"	B	S.C.	1 8	PR-2000 1/2" x 1/2" GU 415	1-HR LABELED DOOR & FRAME
6,3	2'-0" x 6'-8"	1 3/4"	B	S.C.	7 8	PR-2000 1/2" x 1/2" GU 415 W-B12	1-HR LABELED DOOR & FRAME
8	2'-0" x 6'-8"	1 3/4"	B	H.C.	7 8	F-179 3/4" x 3/4" GU 65 W-B12	
9	2'-0" x 6'-8"	1 3/4"	B	S.C.	7 8	PR-2000 1/2" x 1/2" GU 415 W-B12	1-HR LABELED DOOR & FRAME
10	3'-0" x 6'-8"	1 3/4"	A	HM	7 8	F-179 3/4" x 3/4" GU 65 W-B12	24" W x 2" L OULVER N DOOR
11	3'-0" x 6'-8"	1 3/4"	A	HM	4 5 6	F-179 3/4" x 3/4" GU 65	
12	3'-0" x 6'-8"	1 3/4"	A	HM	7 8	PR-2000 1/2" x 1/2" GU 415 W-B12	1-HR LABELED DOOR & FRAME
13	3'-0" x 6'-8"	1 3/4"	A	HM	4 5 6	F-179 3/4" x 3/4" GU 65	
14,15	3'-0" x 6'-8"	1 3/4"	A	HM	4 5 6	F-179 3/4" x 3/4" GU 65	
16,17	10'-0" x 10'-0"	RU		STEEL	1 2 3	STANDARD W/ DOOR	

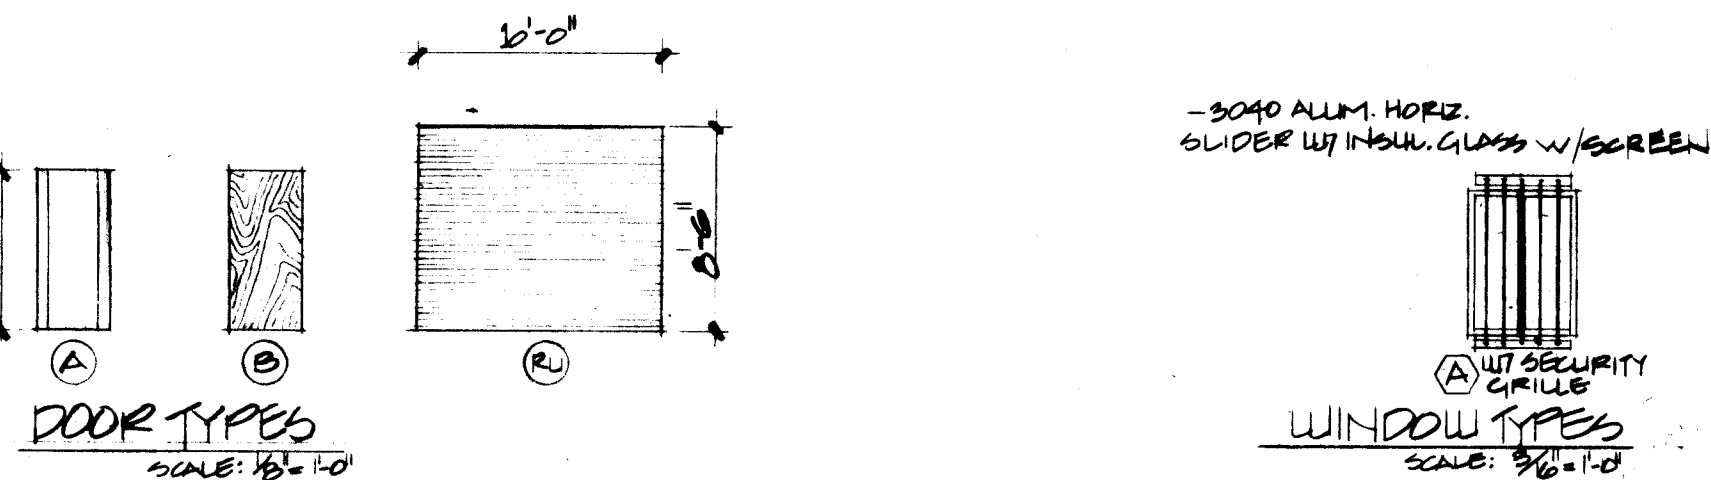

MARK	FLOOR	BASE	WALLS	CEILING	REMARKS
1,2					
7					
4					
5					
6,3					
8					
9					
10					
11					
12					
13					
14,15					
16,17					

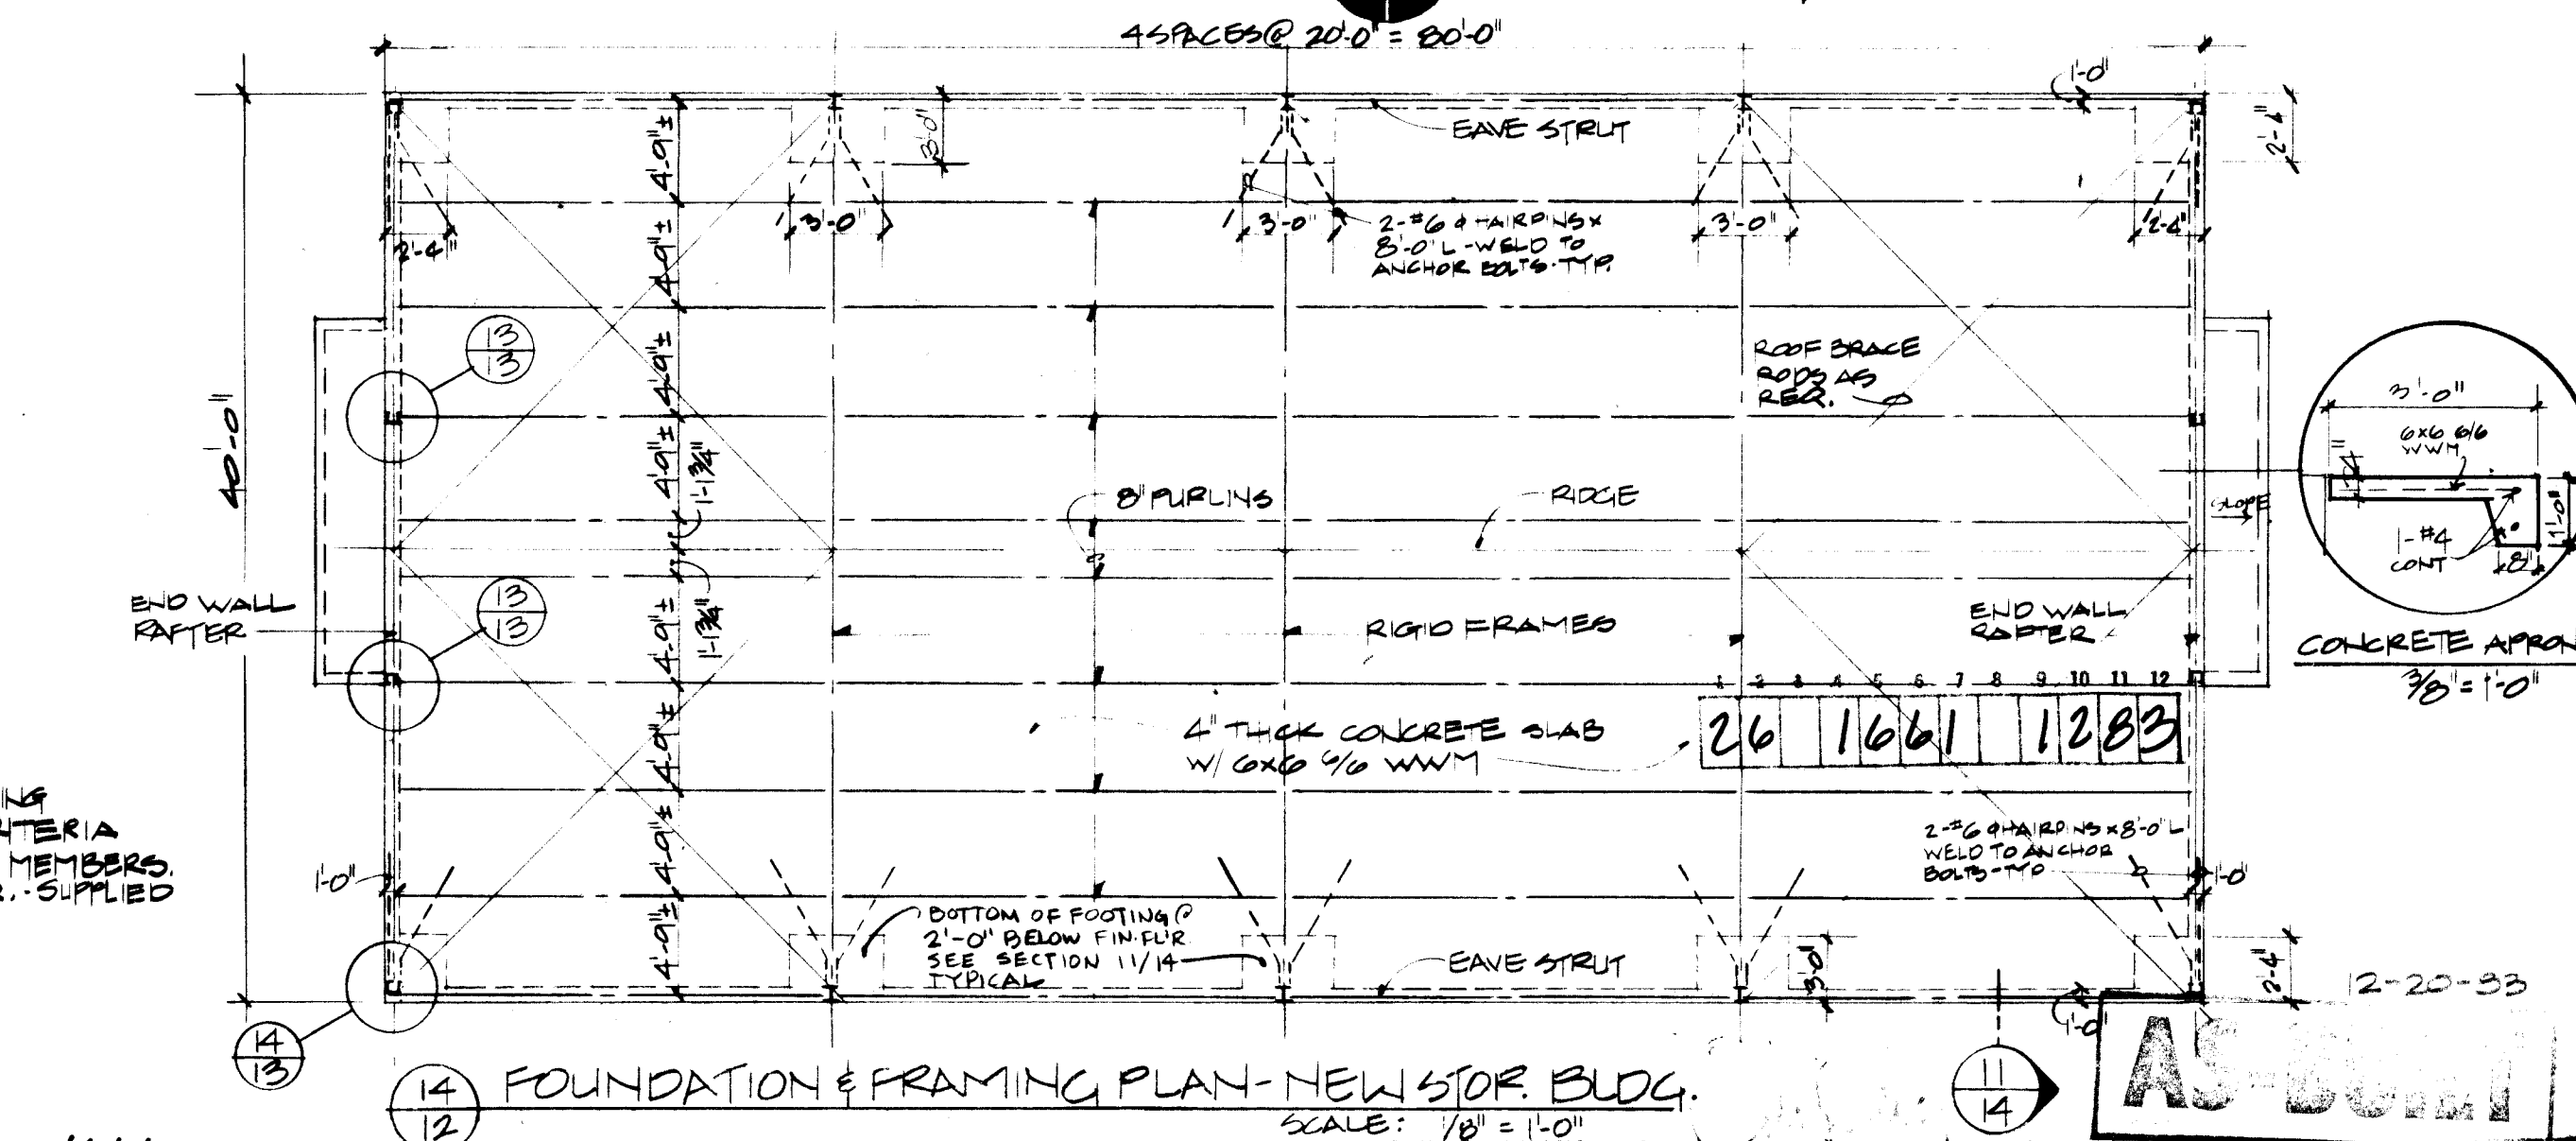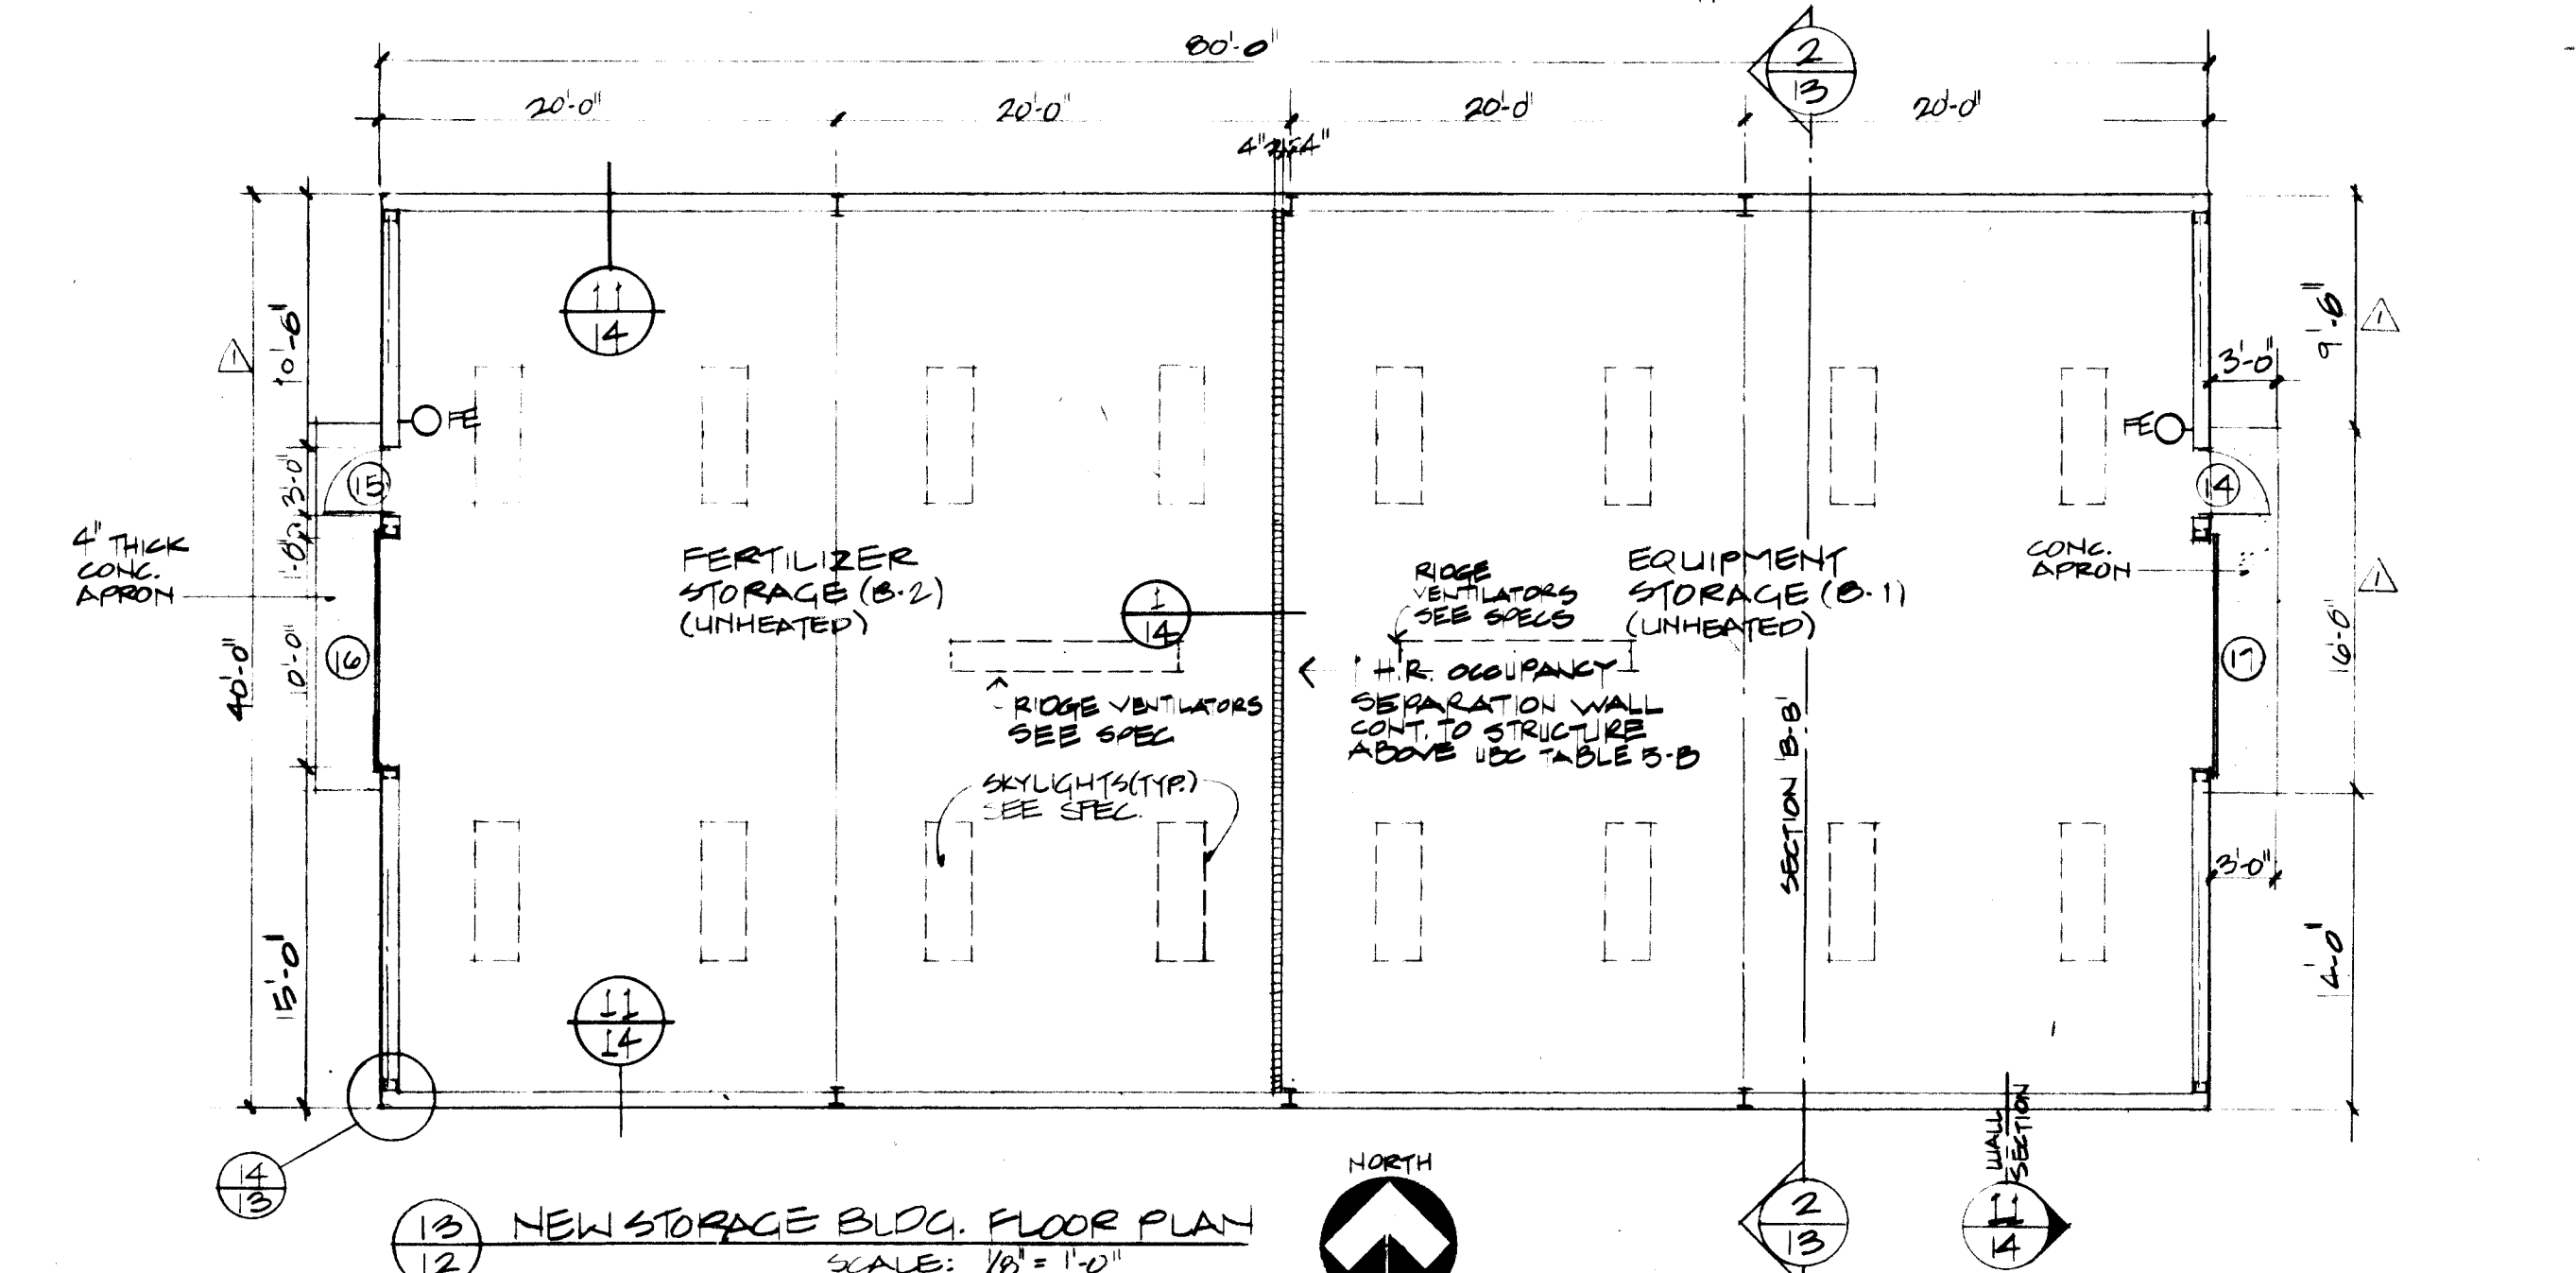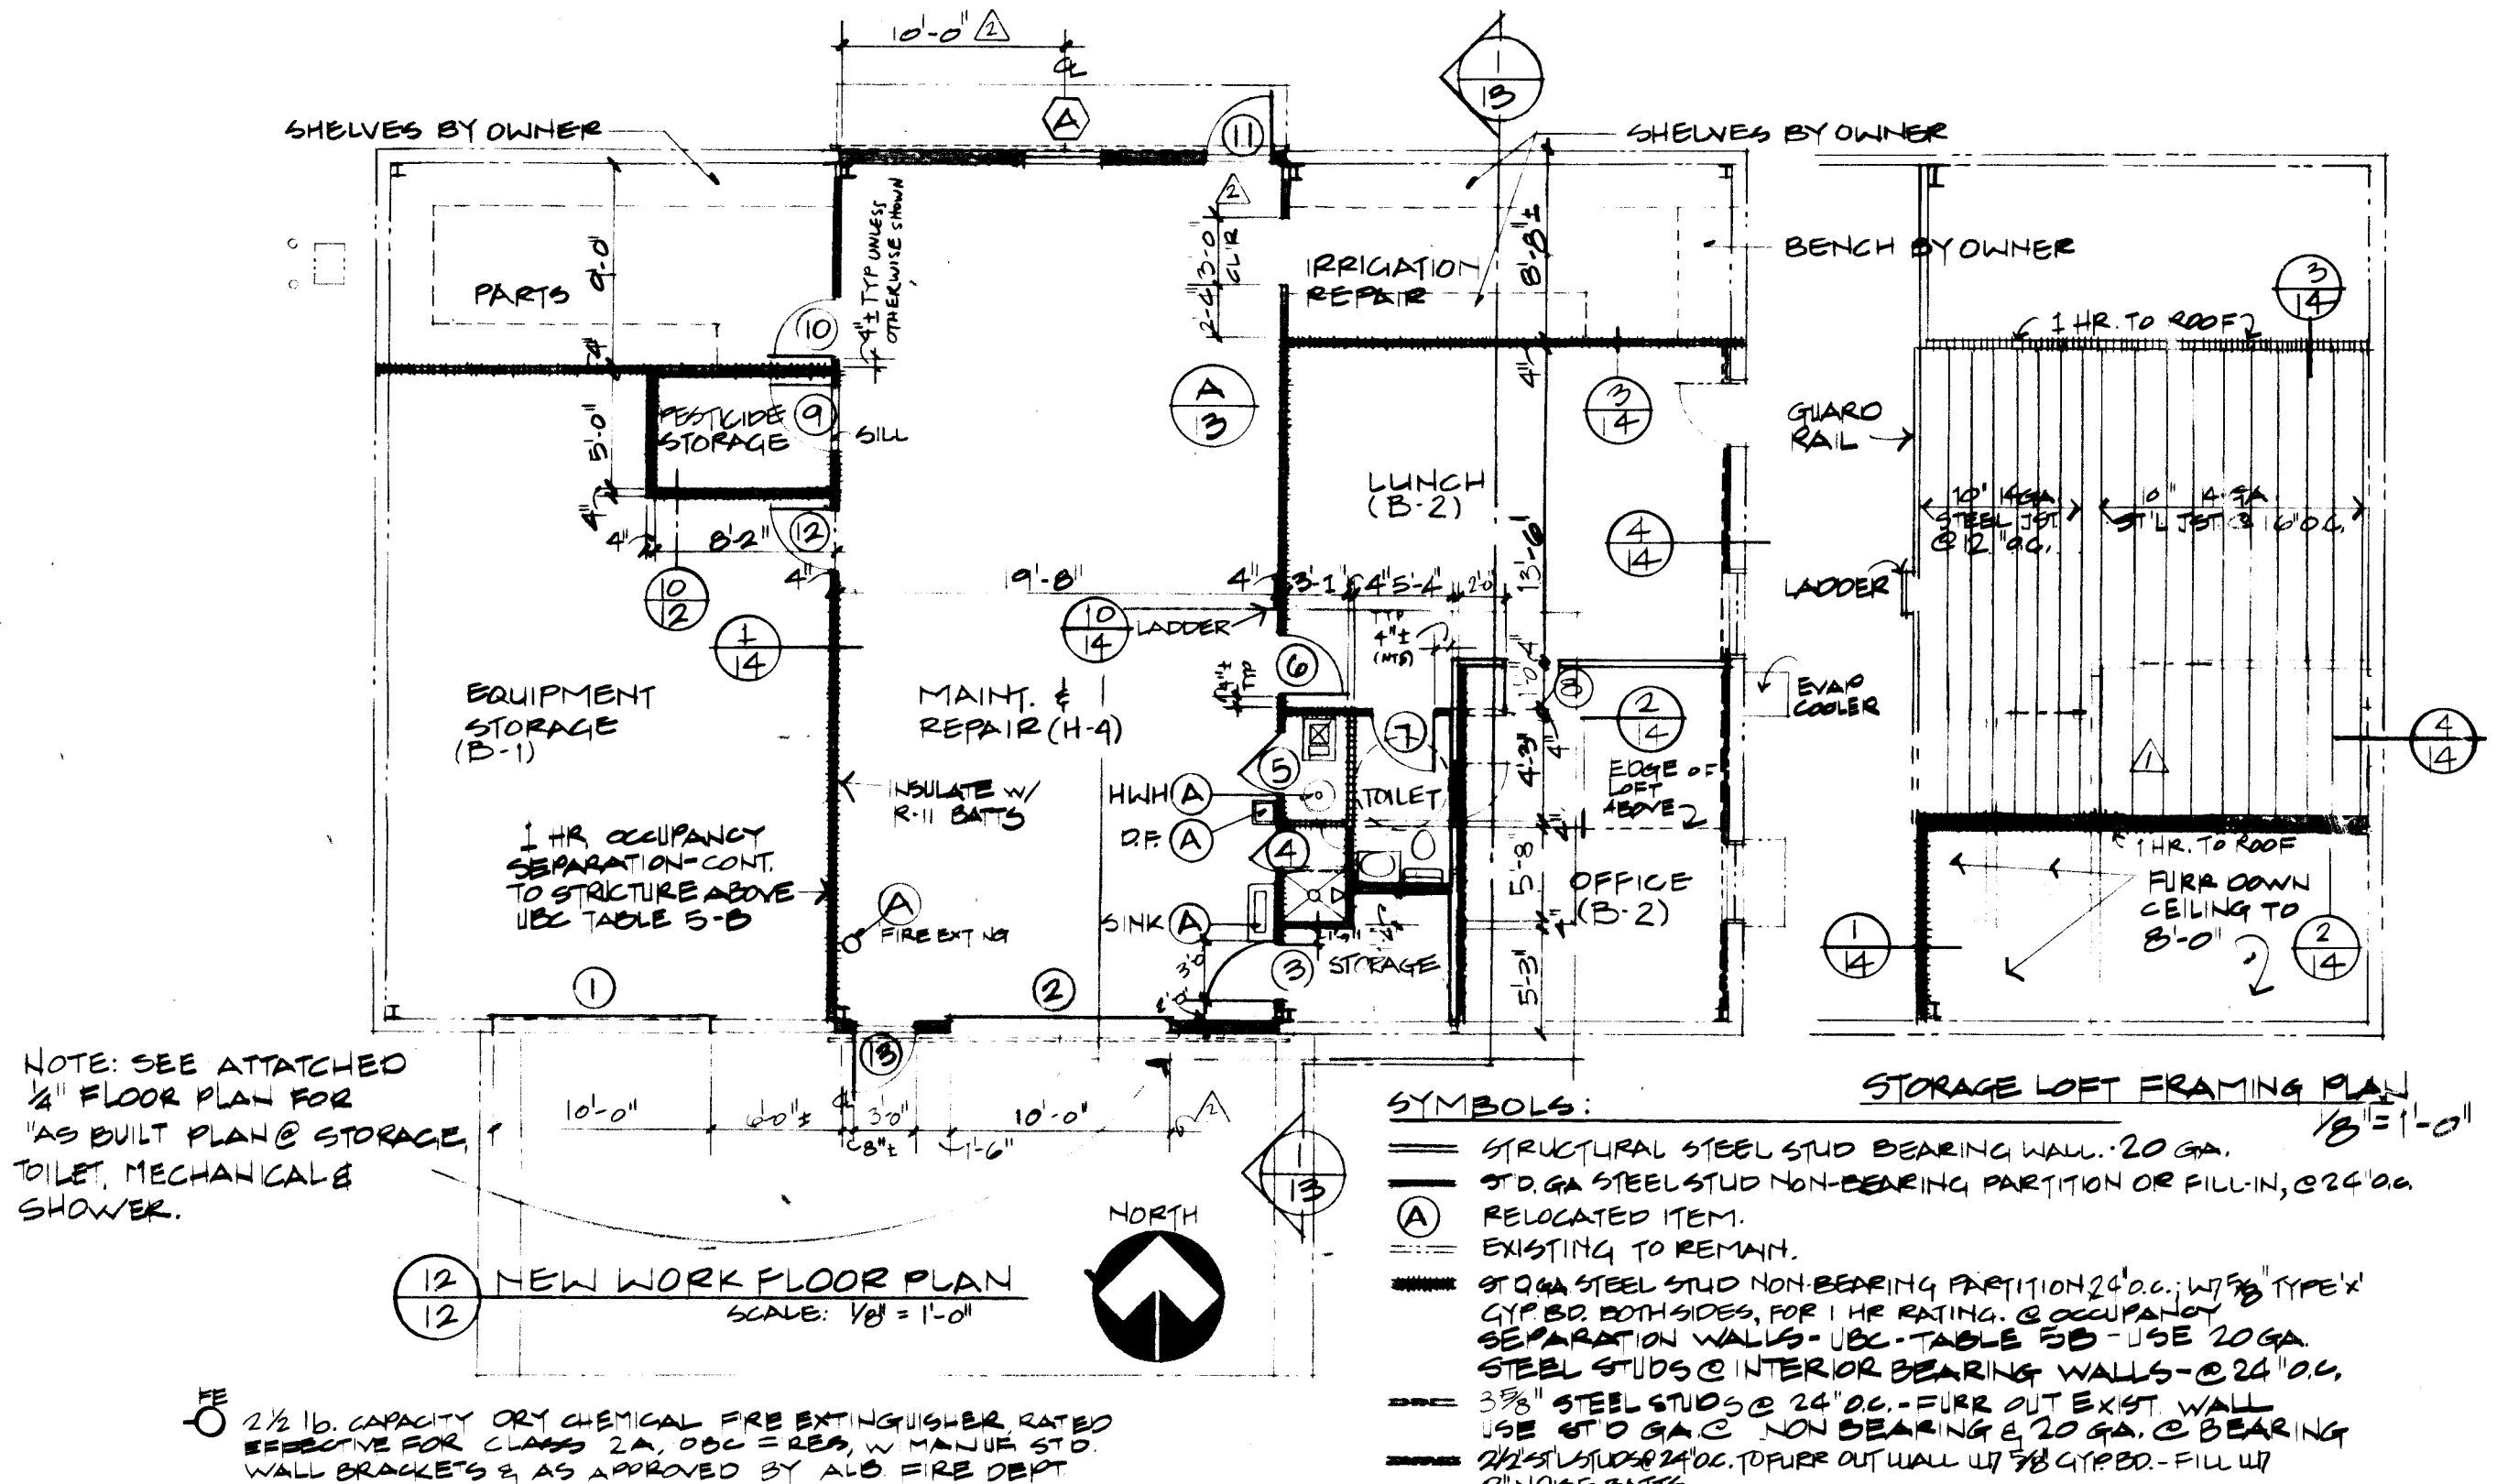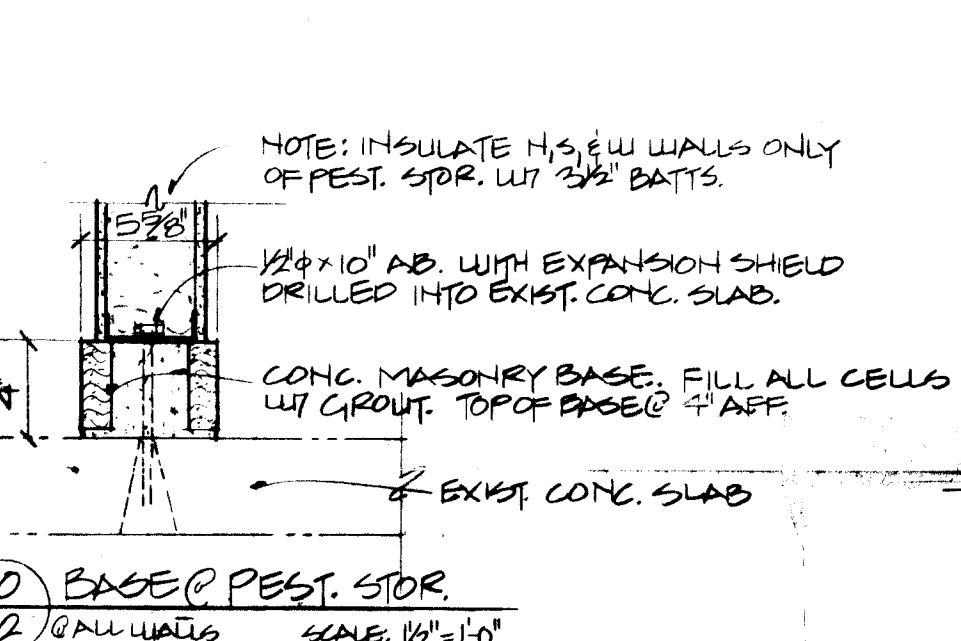


LASON 1-505-344-9404
BEST COPY AVAILABLE

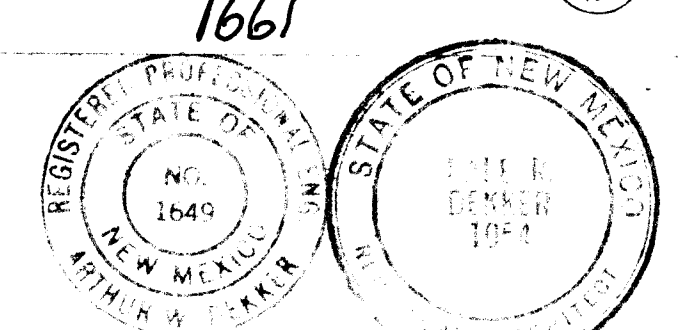


dekker & associates
architects & engineers & planners
4413 San Mateo NE Suite 215, Albuquerque, NM 87112 505-854-9089
Los Altos Golf Course 8717 Cedar Ave. N.E. Albuquerque, NM

Job no. 0208
Drawn by JCH
Checked by ALW
Issued 2-1-83
Revised 12-27-83
AS BUILT 12/27/83
11/23 REVIEW COMMENTS





sheet 12

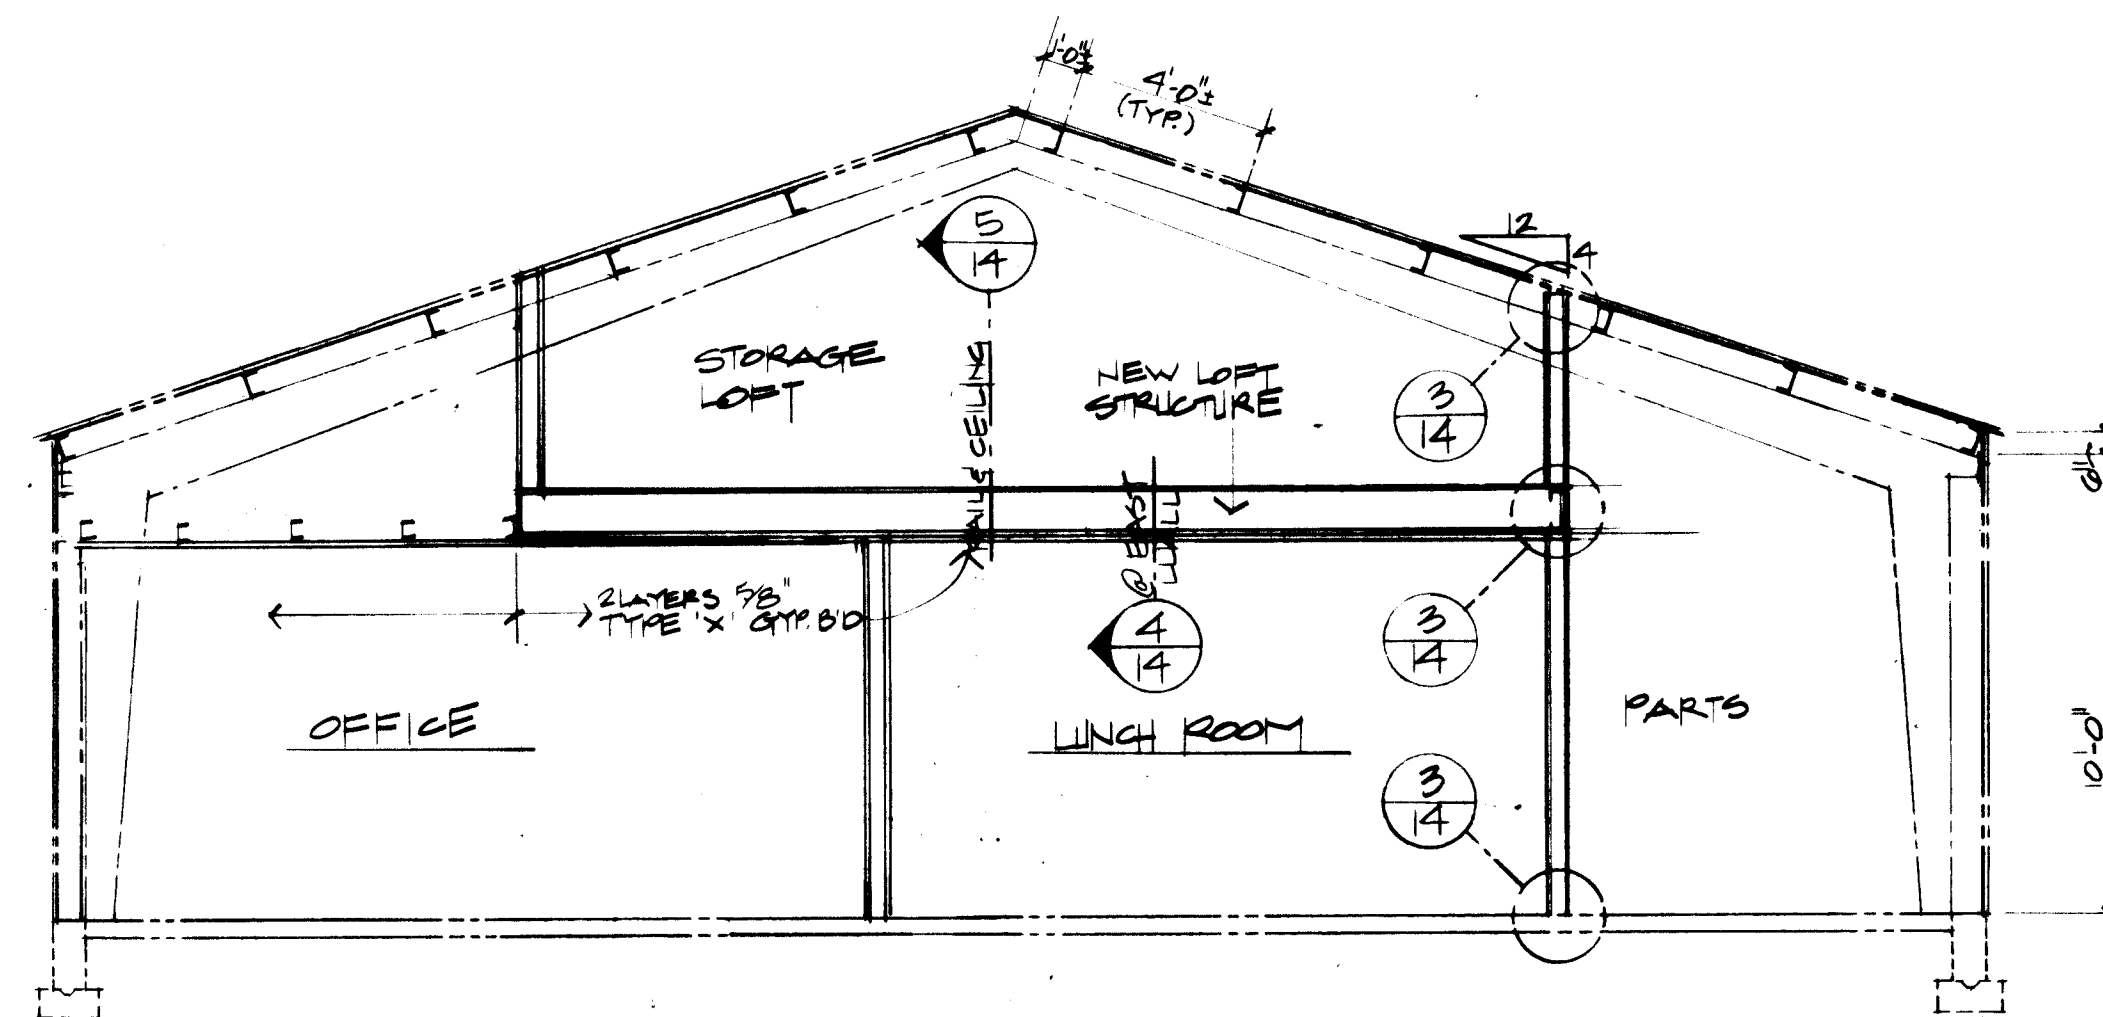


13 SECTION 'A-A'
SCALE: 1/4" = 1'-0"

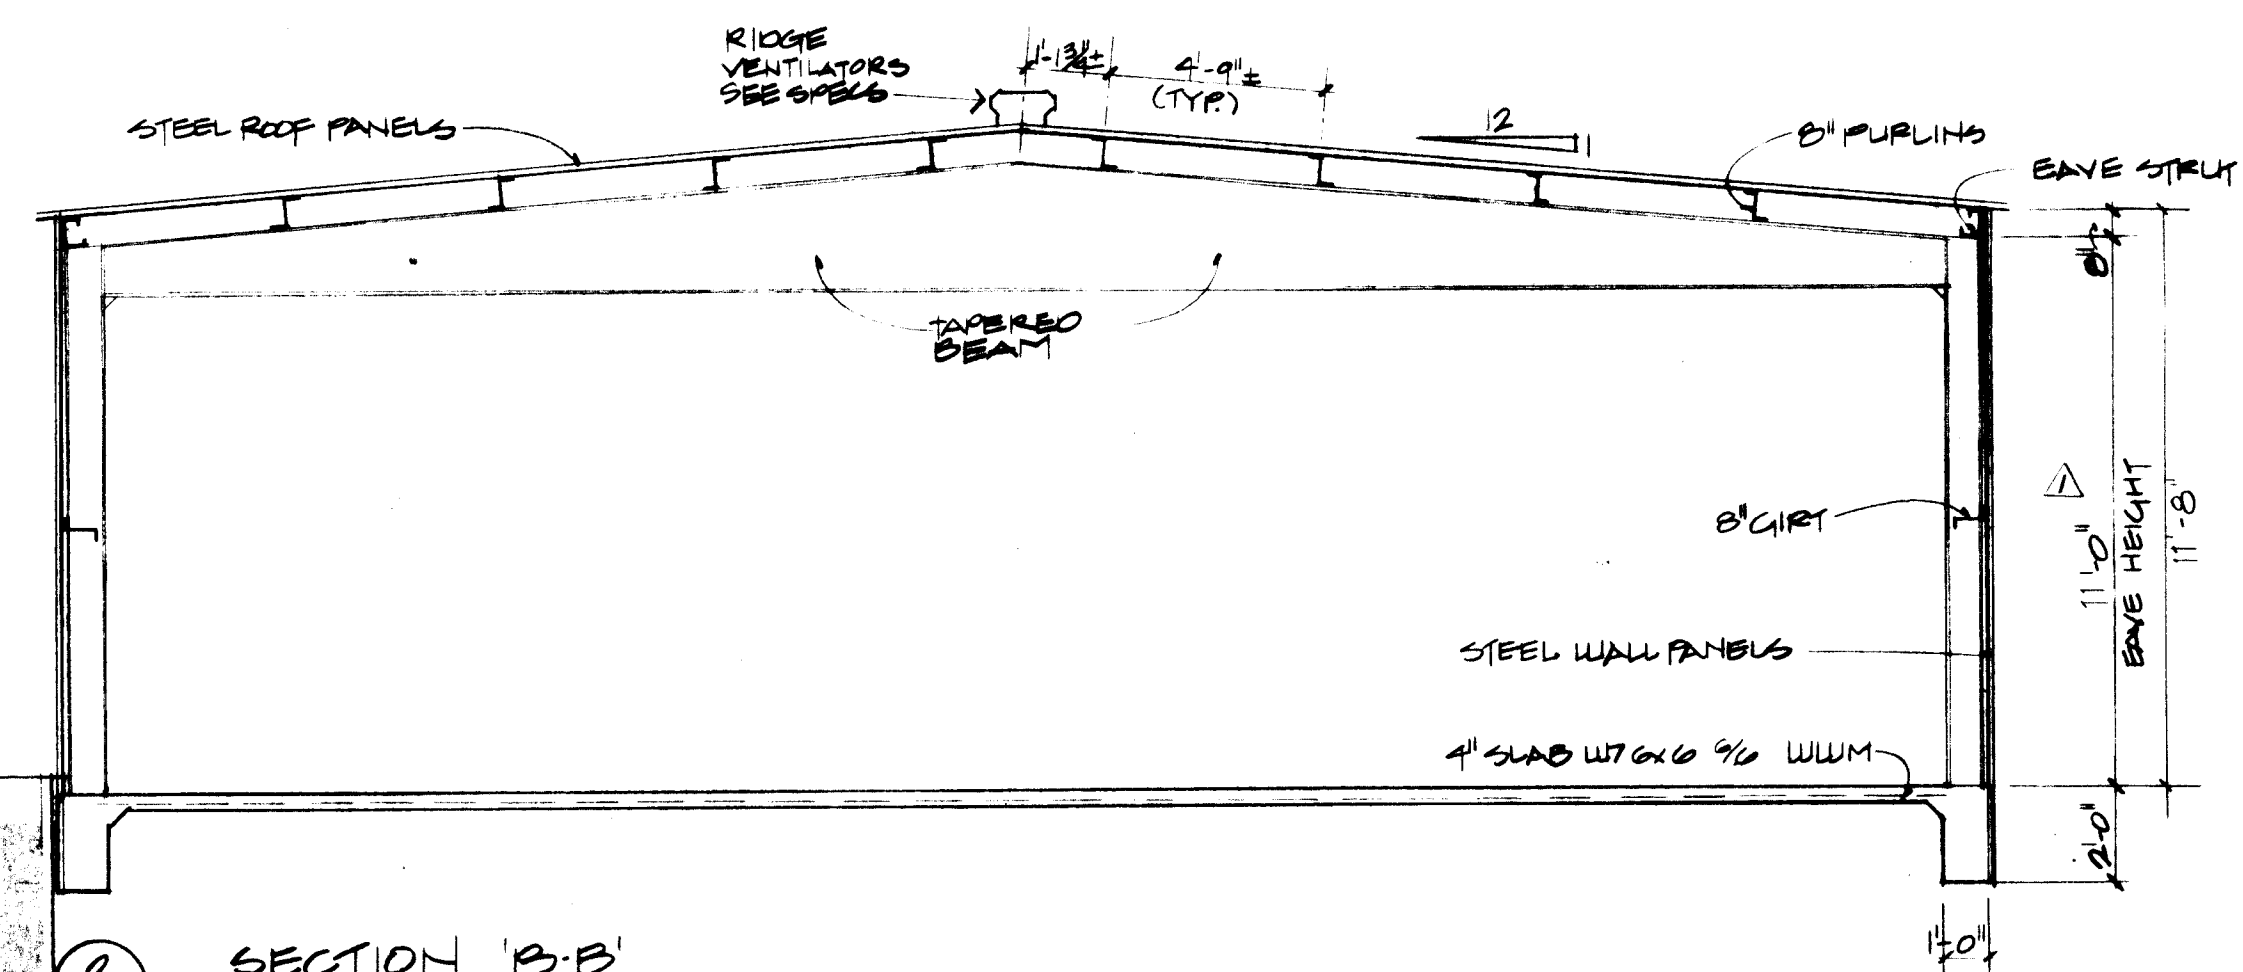


2 SECTION 'B-B'
SCALE: 1/4" = 1'-0"

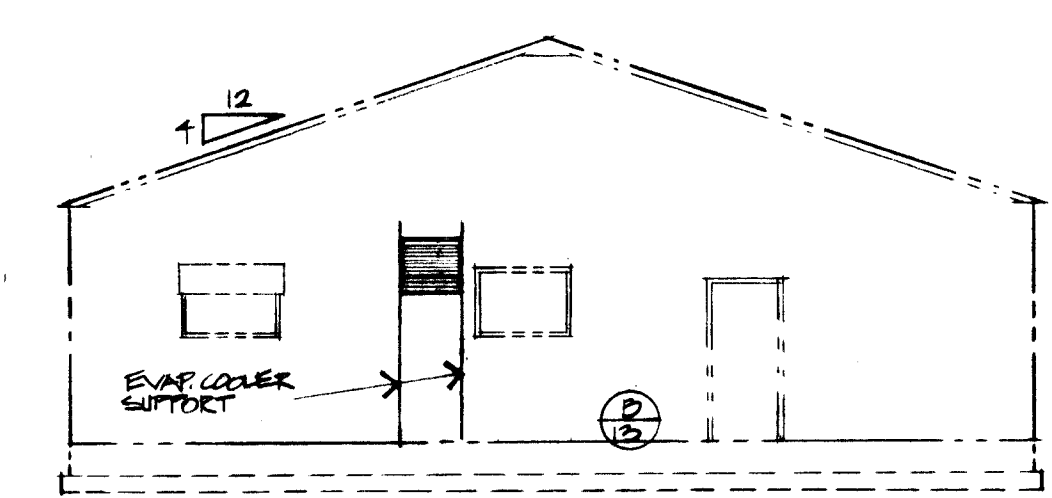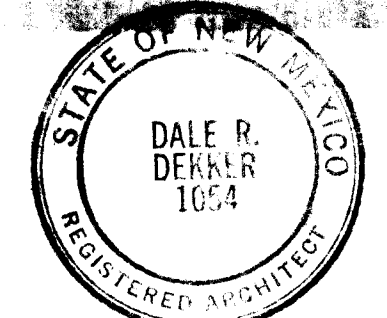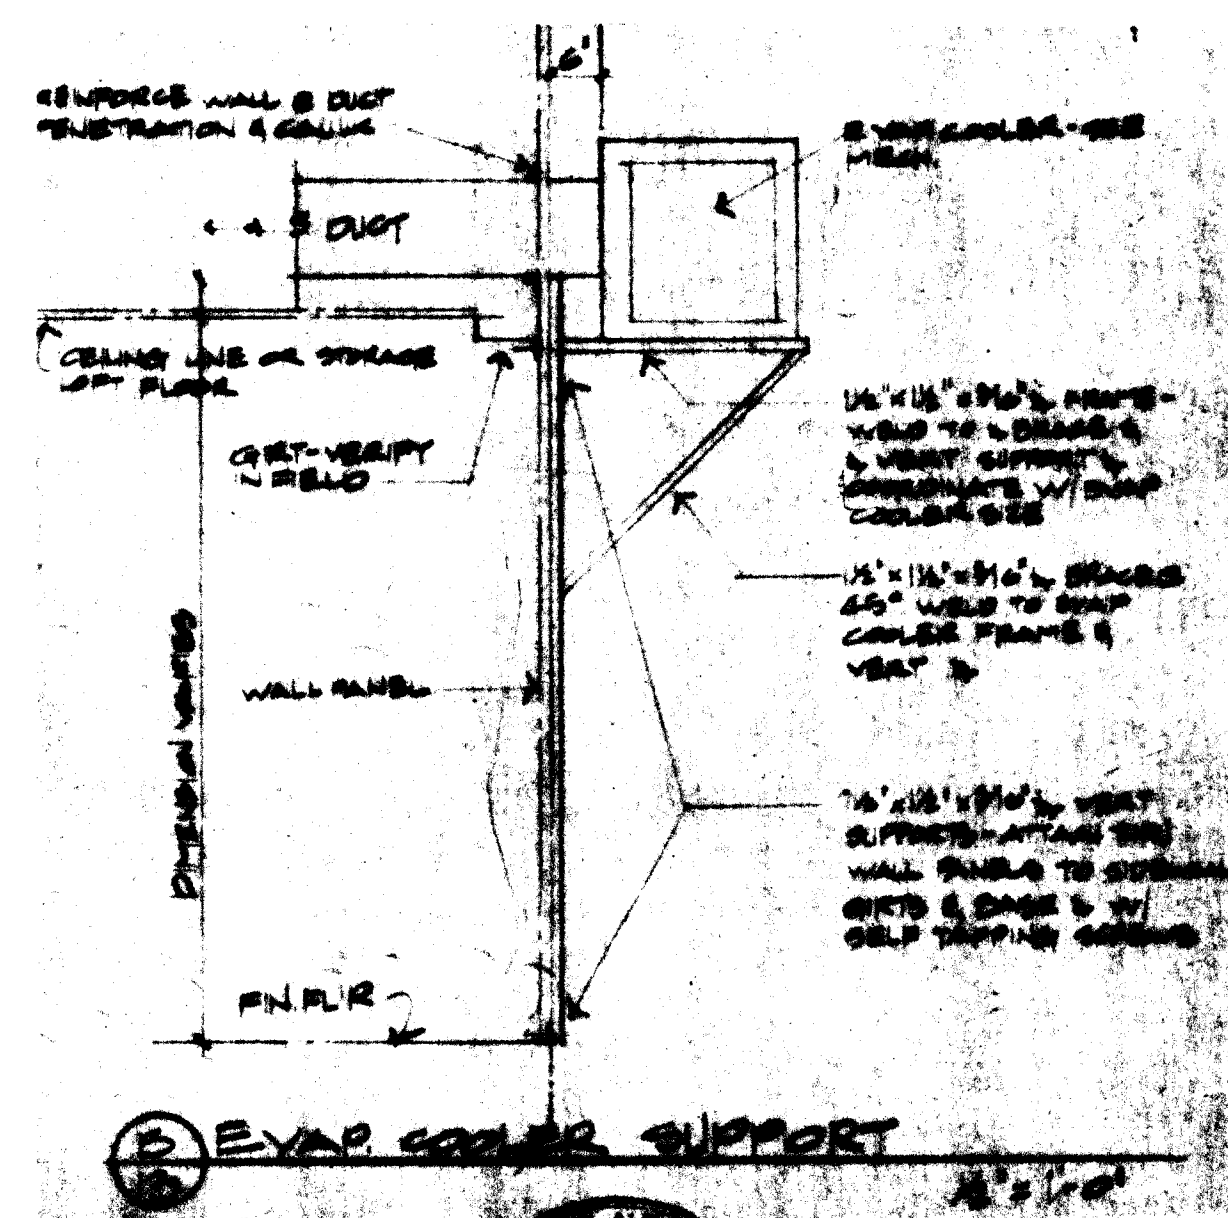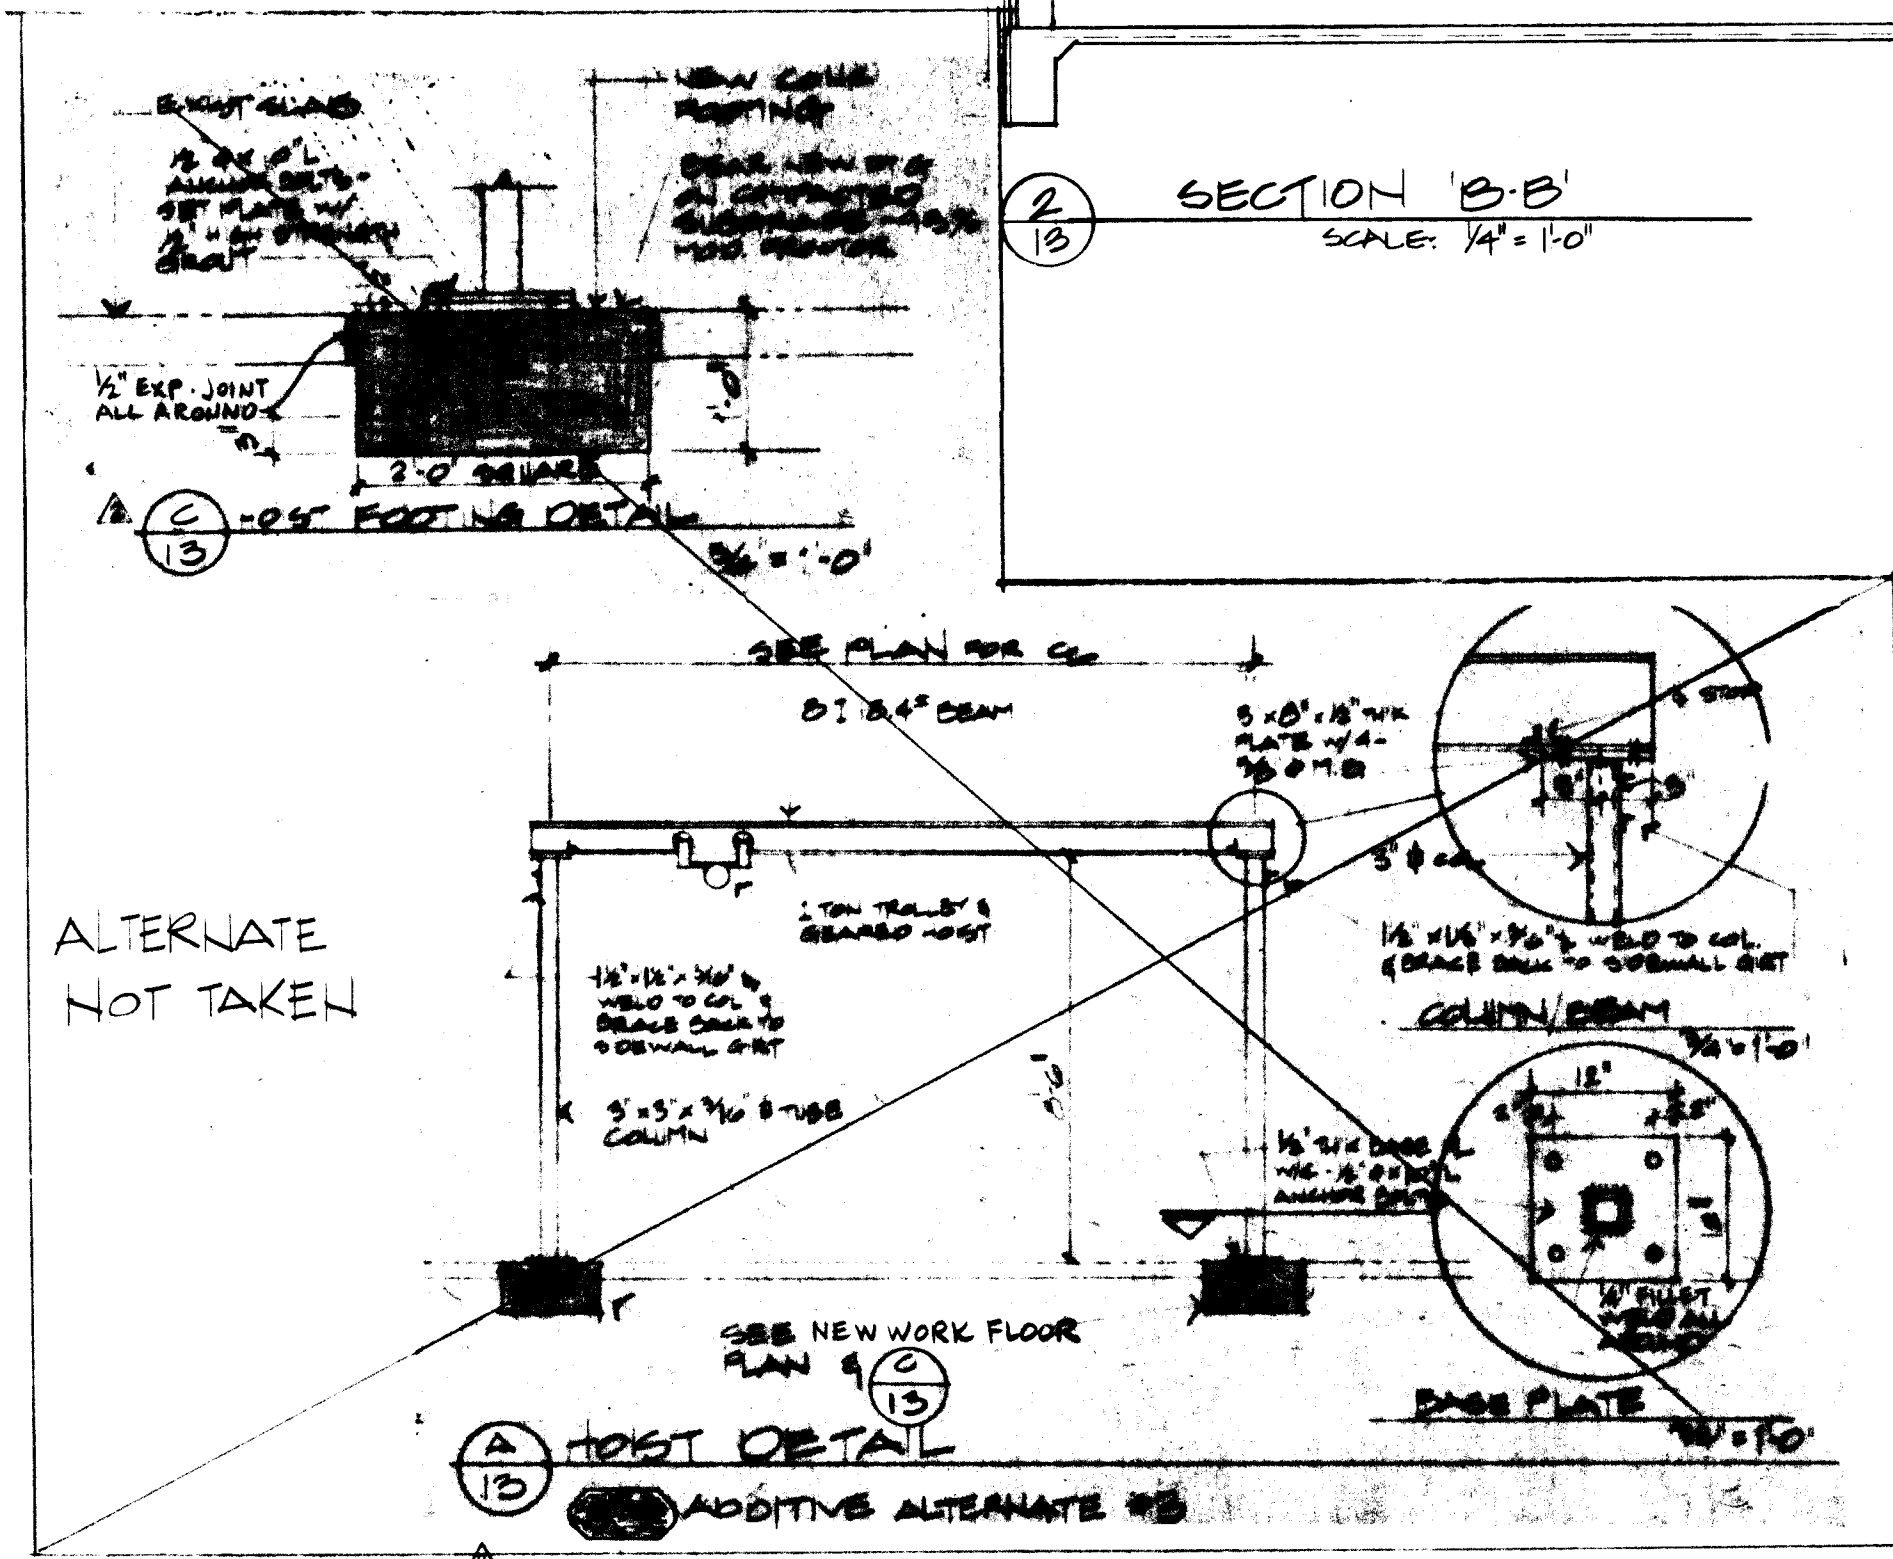


3 EAST ELEVATION-EXIST. MAINT. BLDG.
SCALE: 1/8" = 1'-0"

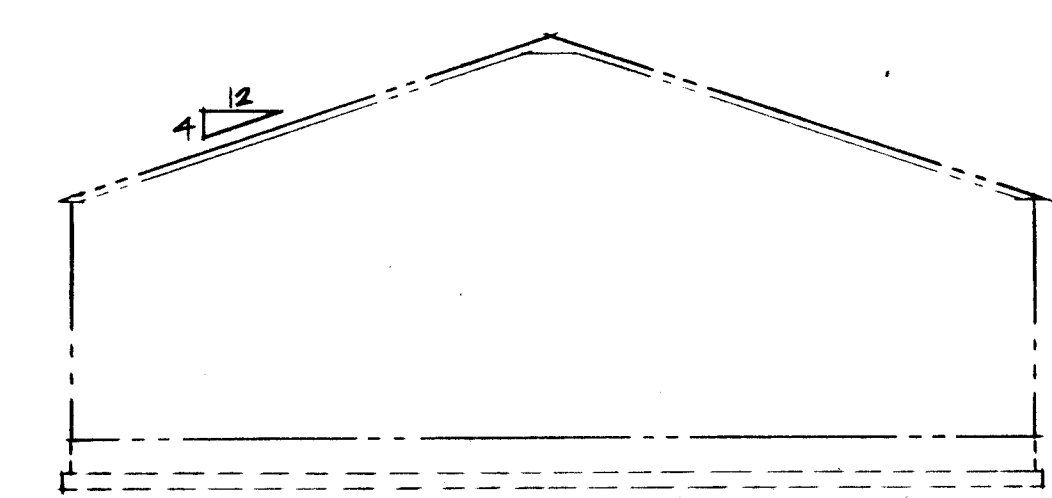


5 WEST ELEVATION-EXIST. MAINT. BLDG.
SCALE: 1/8" = 1'-0"

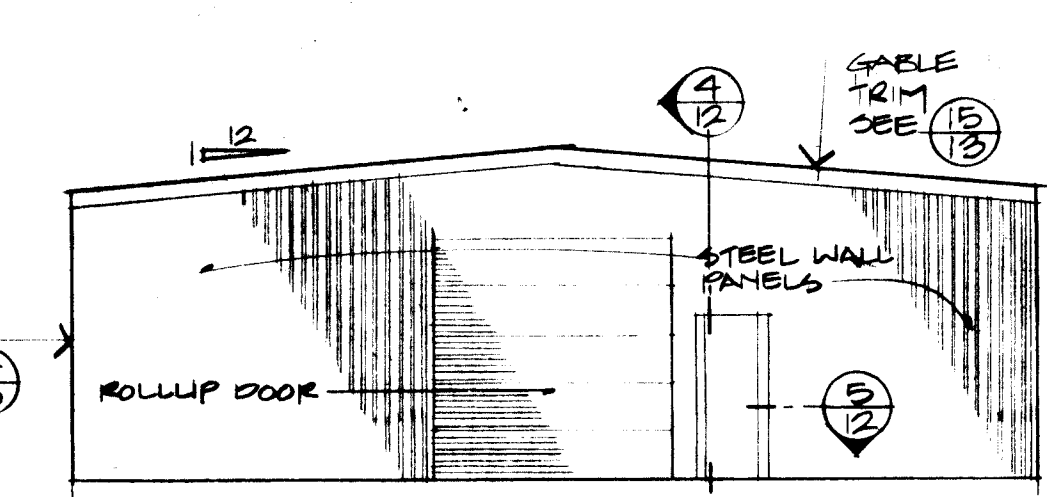


7 EAST ELEVATION-NEW STOR. BLDG.
SCALE: 1/8" = 1'-0"

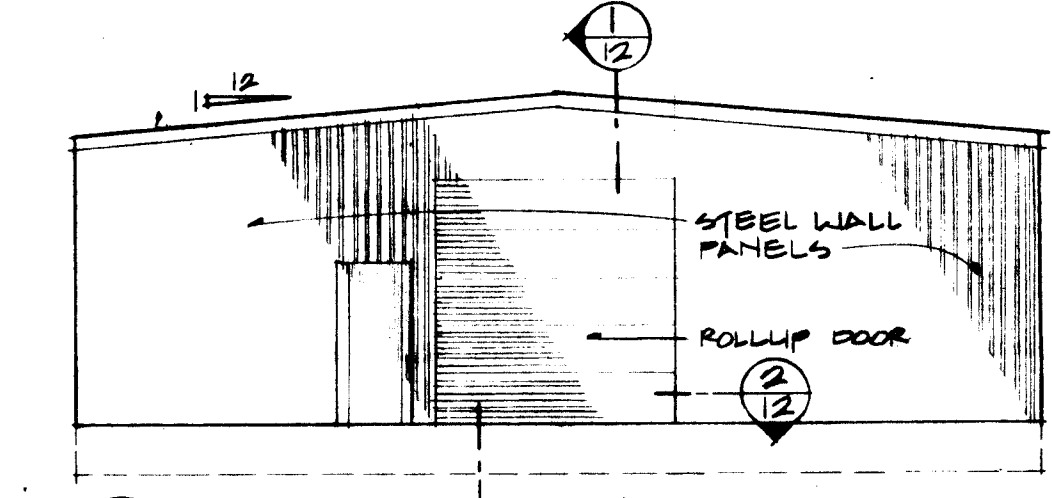


9 WEST ELEVATION-NEW STOR. BLDG.
SCALE: 1/8" = 1'-0"

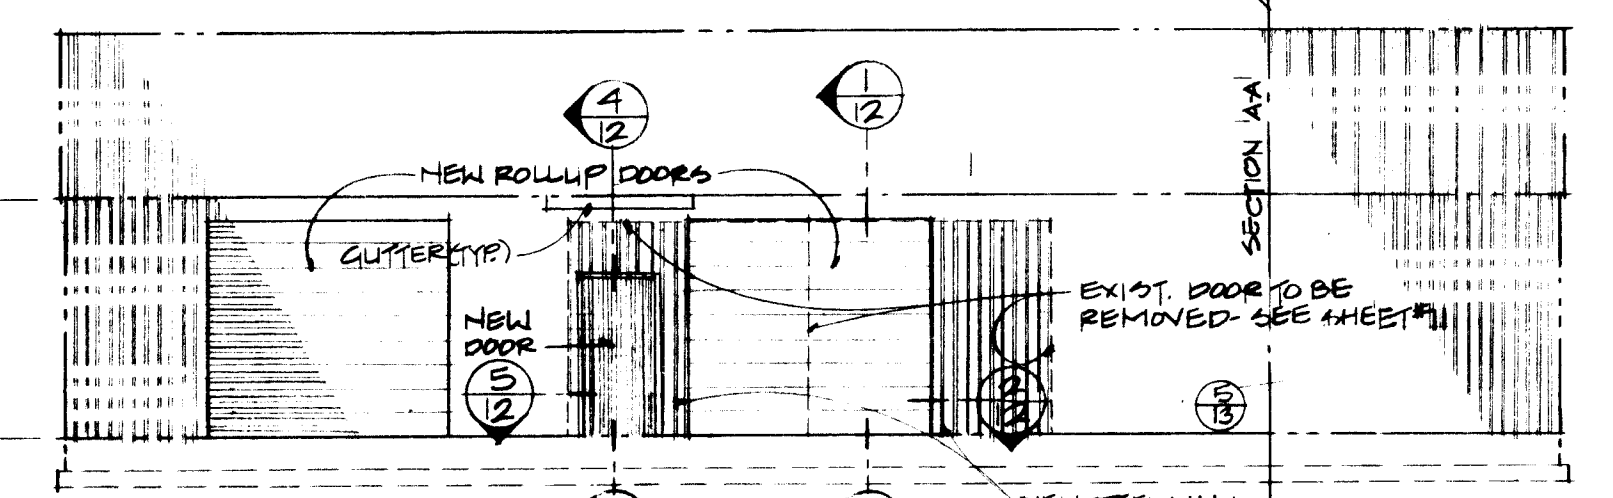


4 SOUTH ELEVATION-EXIST. MAINT. BLDG.
SCALE: 1/8" = 1'-0"

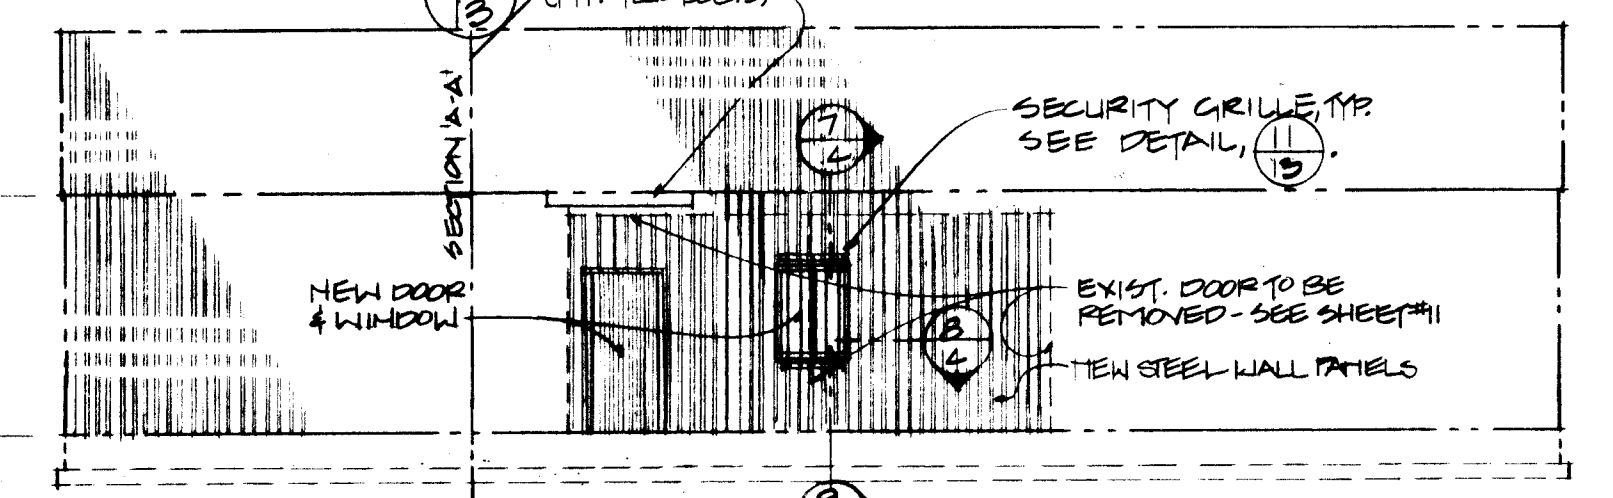

6 NORTH ELEVATION-EXIST. MAINT. BLDG.
SCALE: 1/8" = 1'-0"

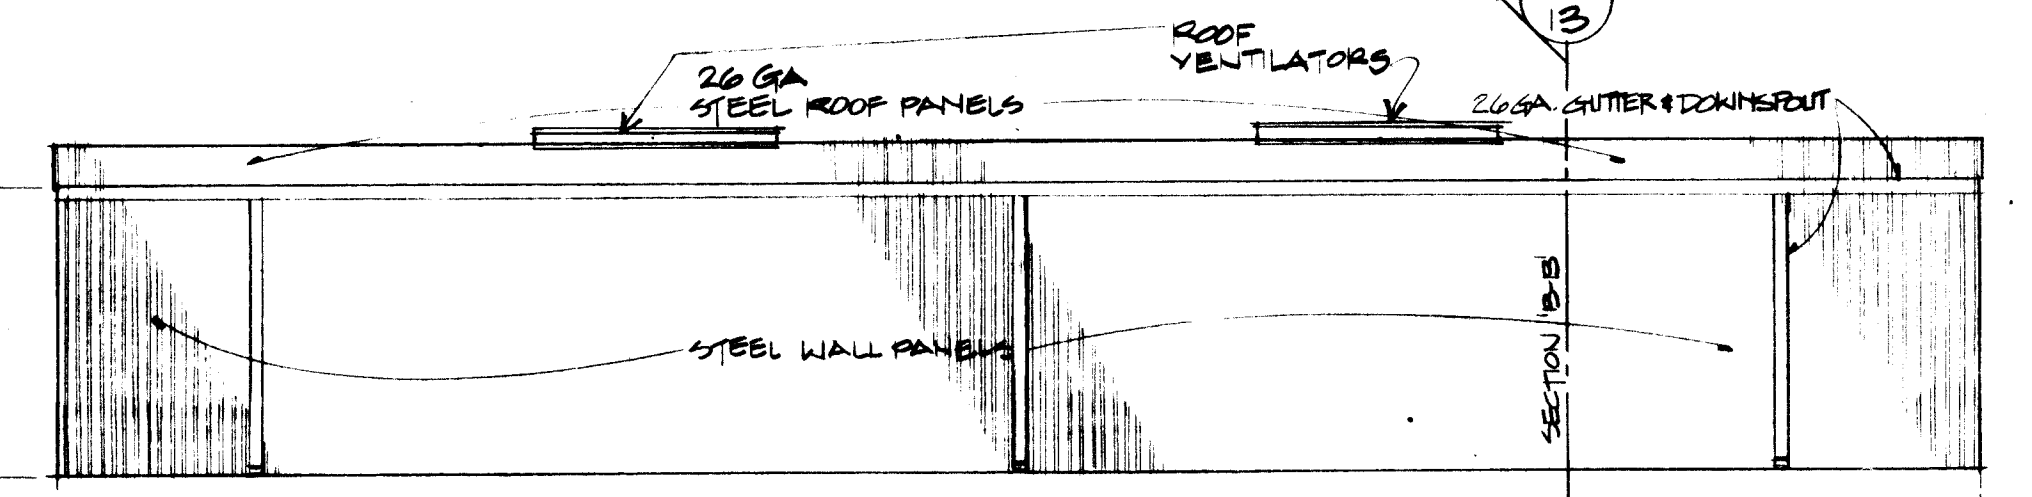


8 SOUTH ELEVATION-NEW STOR. BLDG.
SCALE: 1/8" = 1'-0"

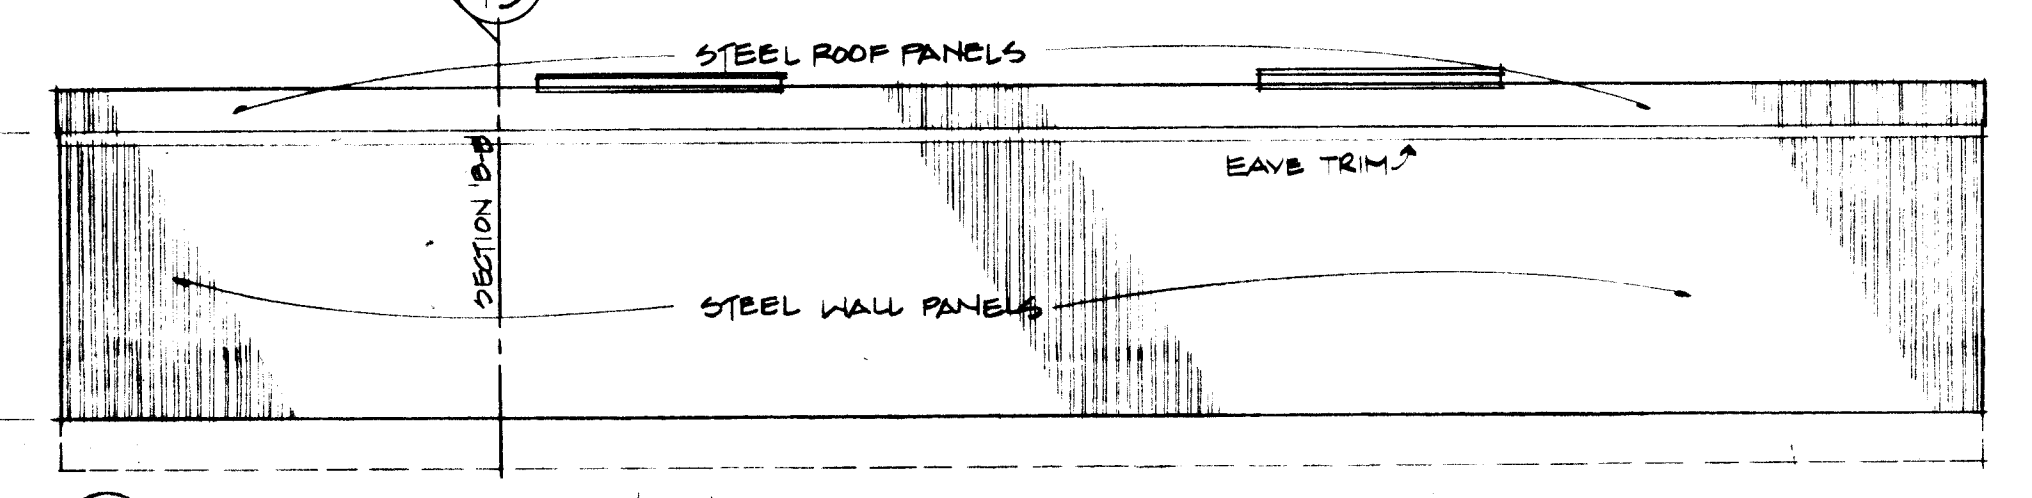


10 NORTH ELEVATION-NEW STOR. BLDG.
SCALE: 1/8" = 1'-0"


LASON 1-505-344-9404
BEST COPY AVAILABLE

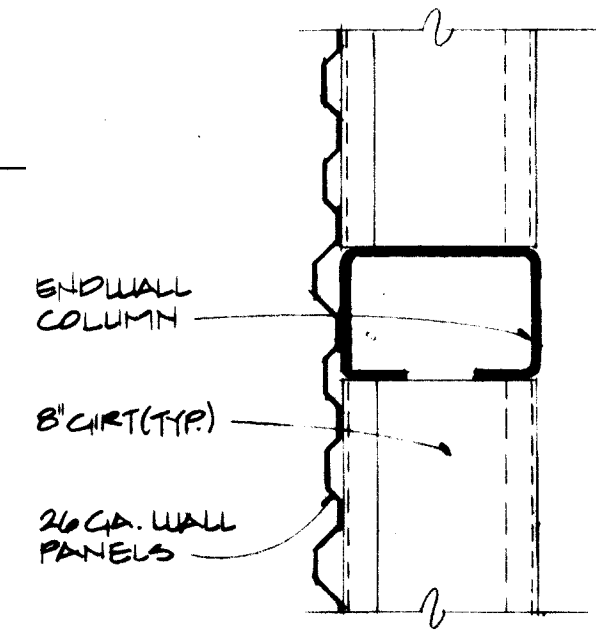



13 ENDWALL DET.

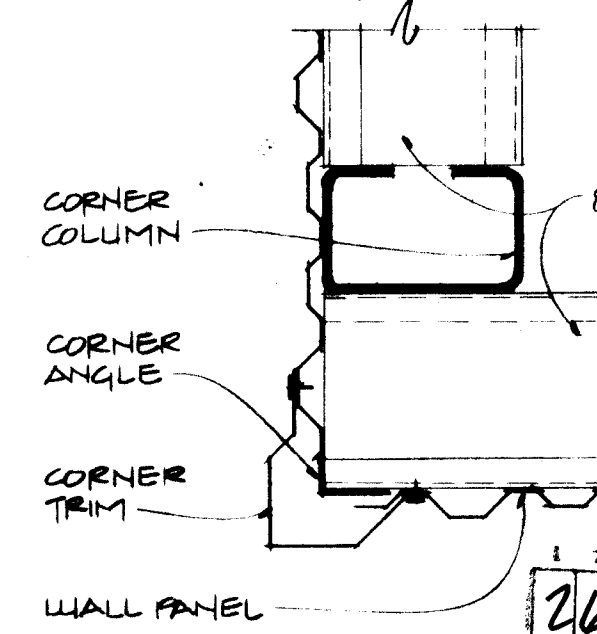


14 CORNER TRIM DET.

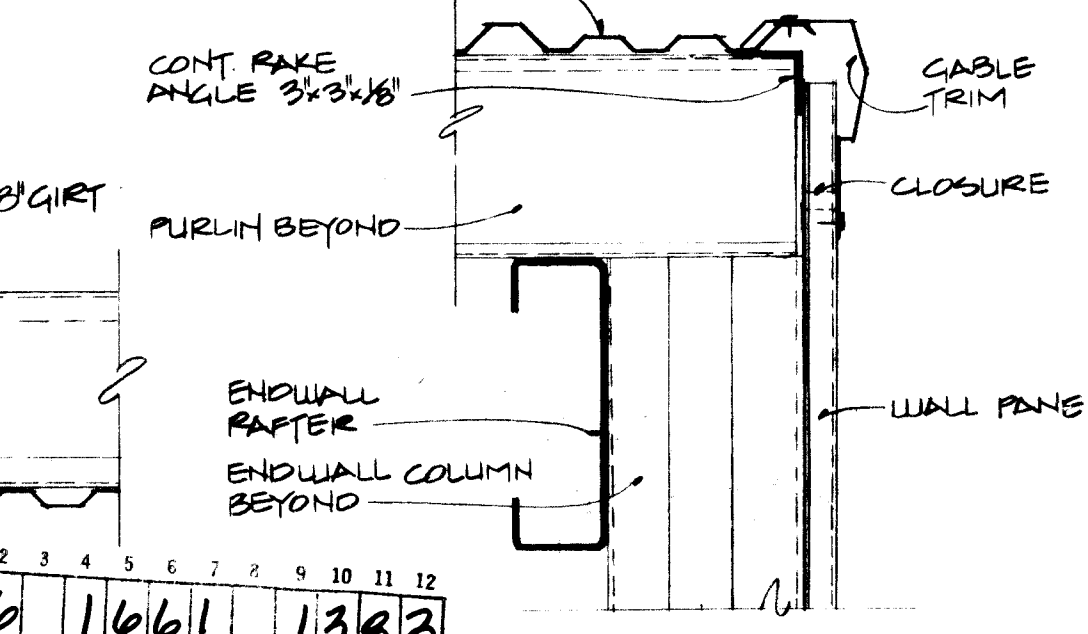


15 CABLE TRIM DET.

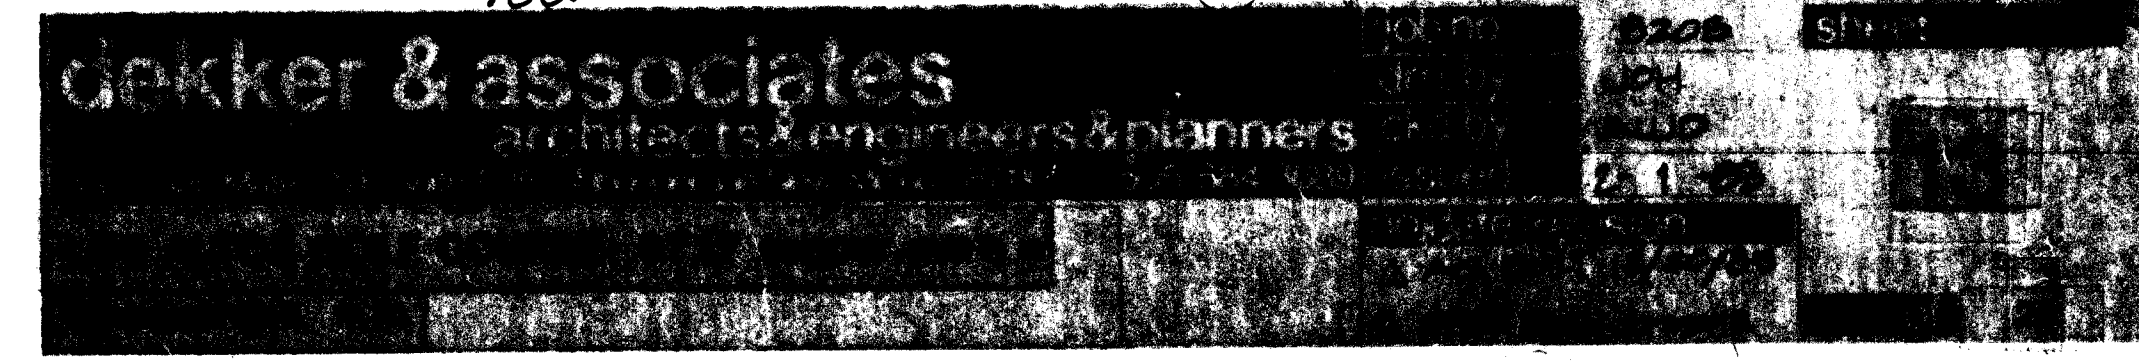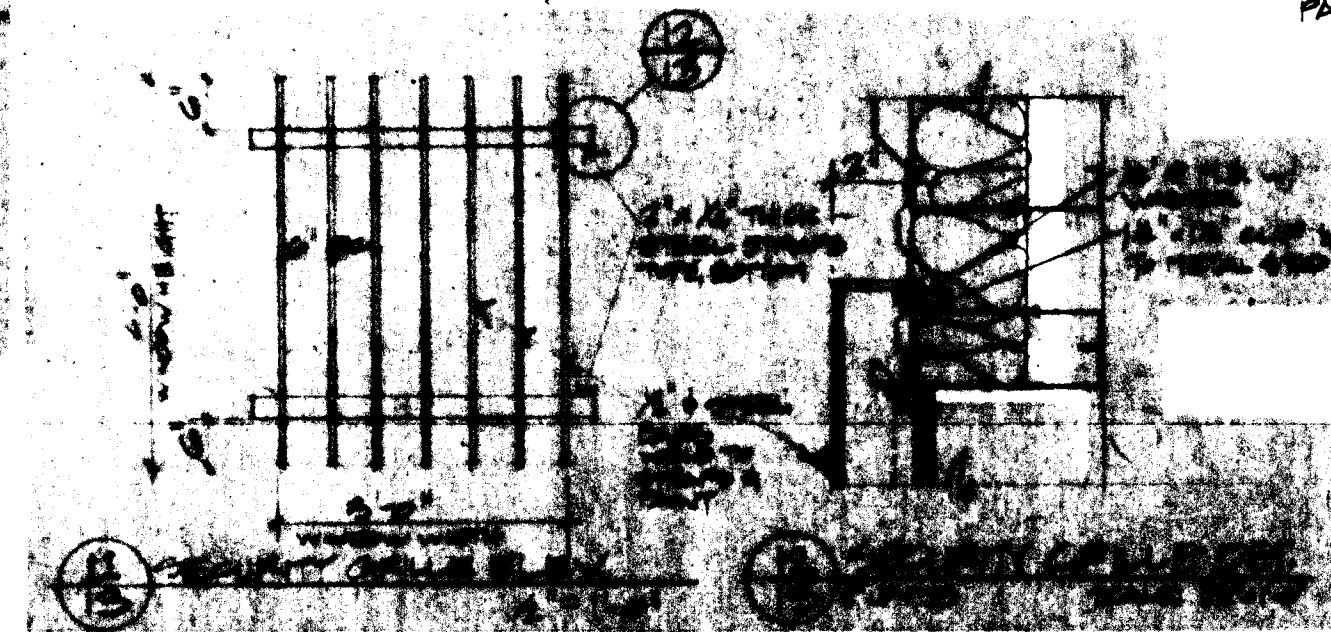

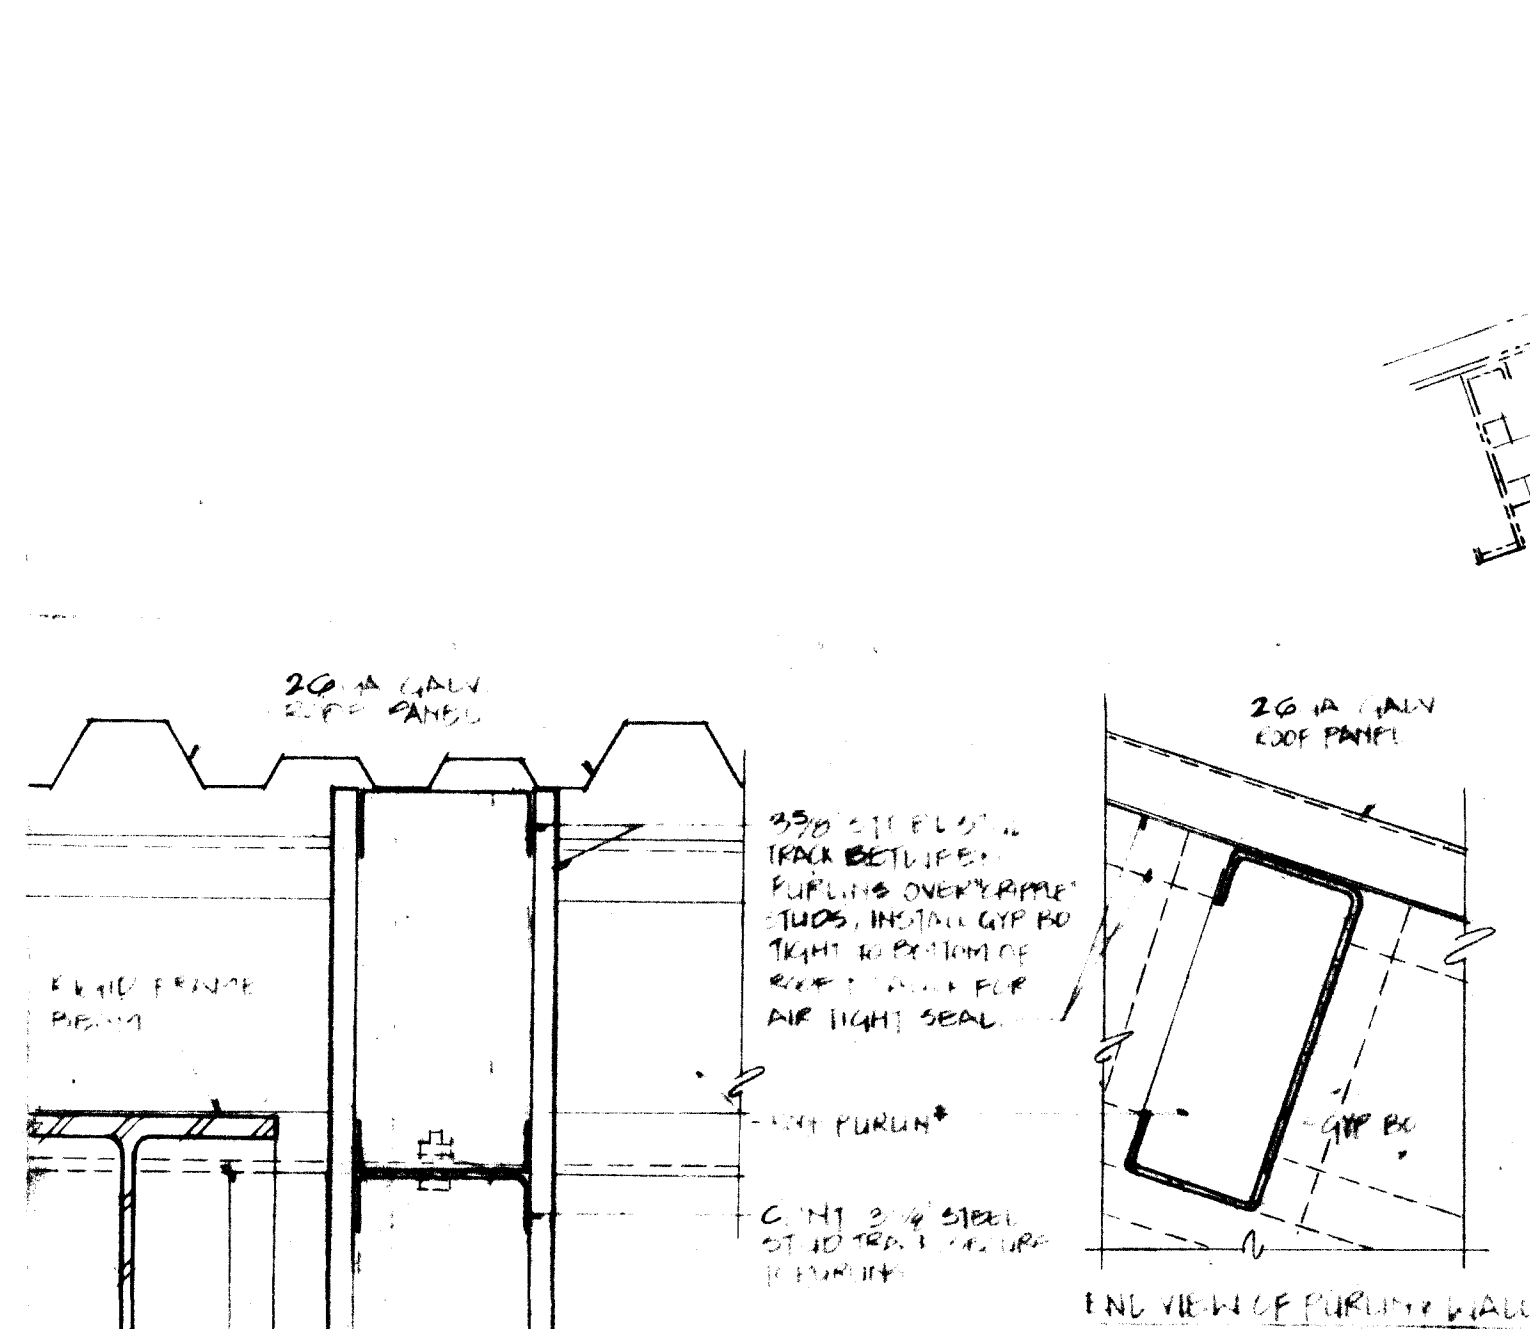


* WALL SECTION
1. WALL SECTION
2. WALL SECTION
3. WALL SECTION
4. WALL SECTION

1 WALL SECTION @
4 ROOF 3' = 1'-0"

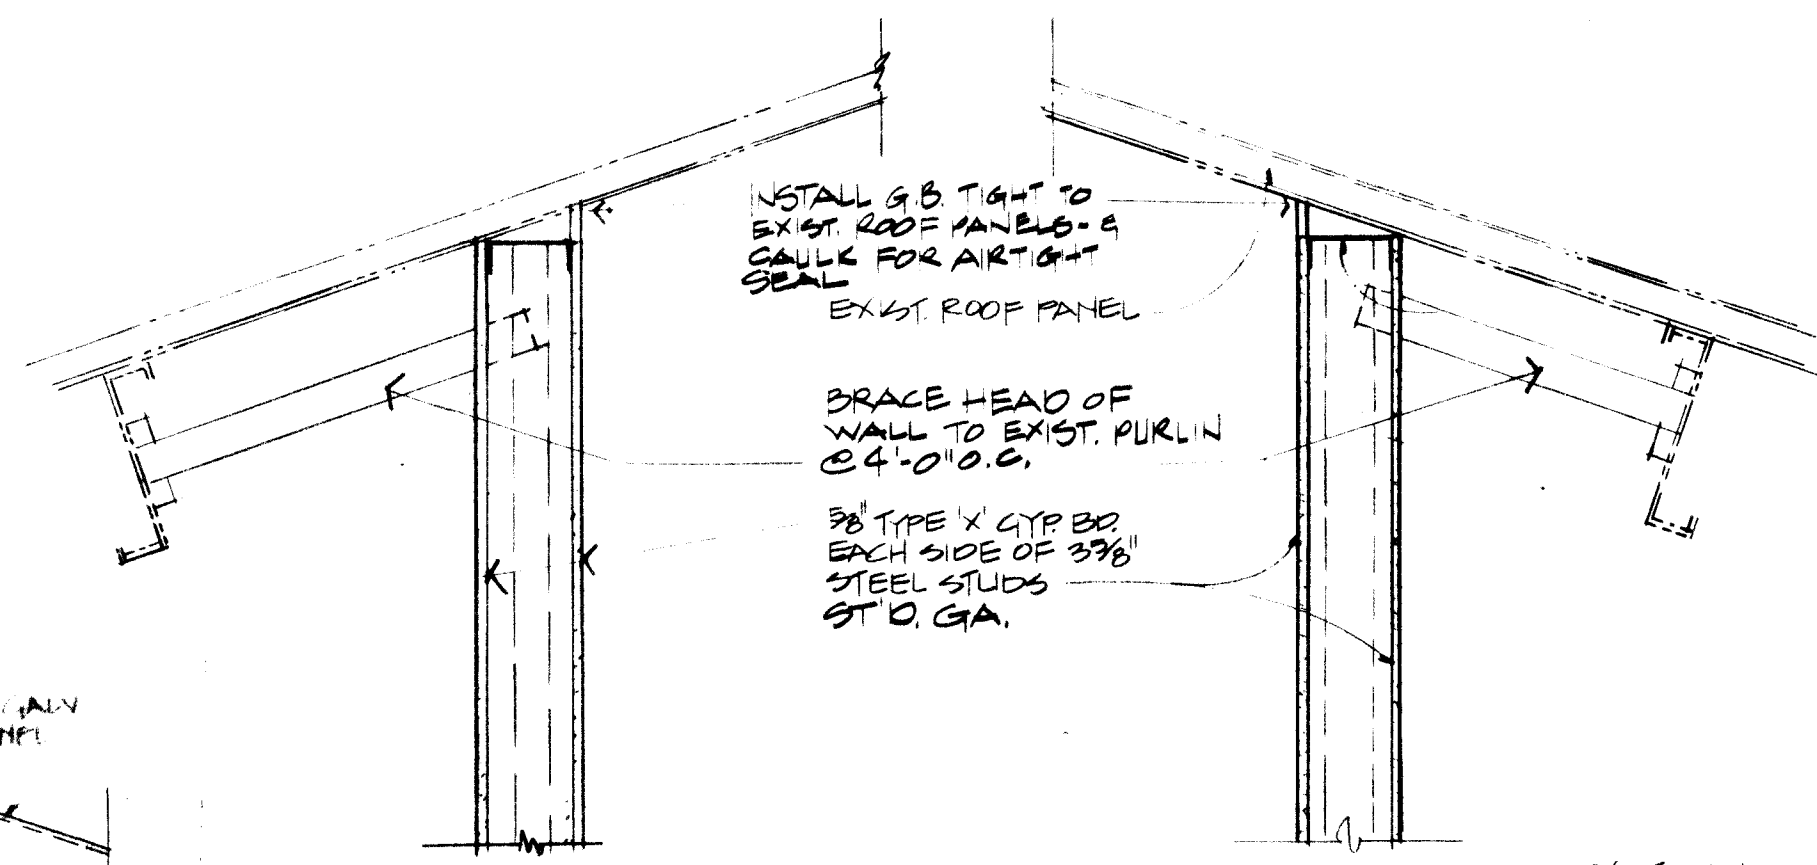


STORAGE LOFT

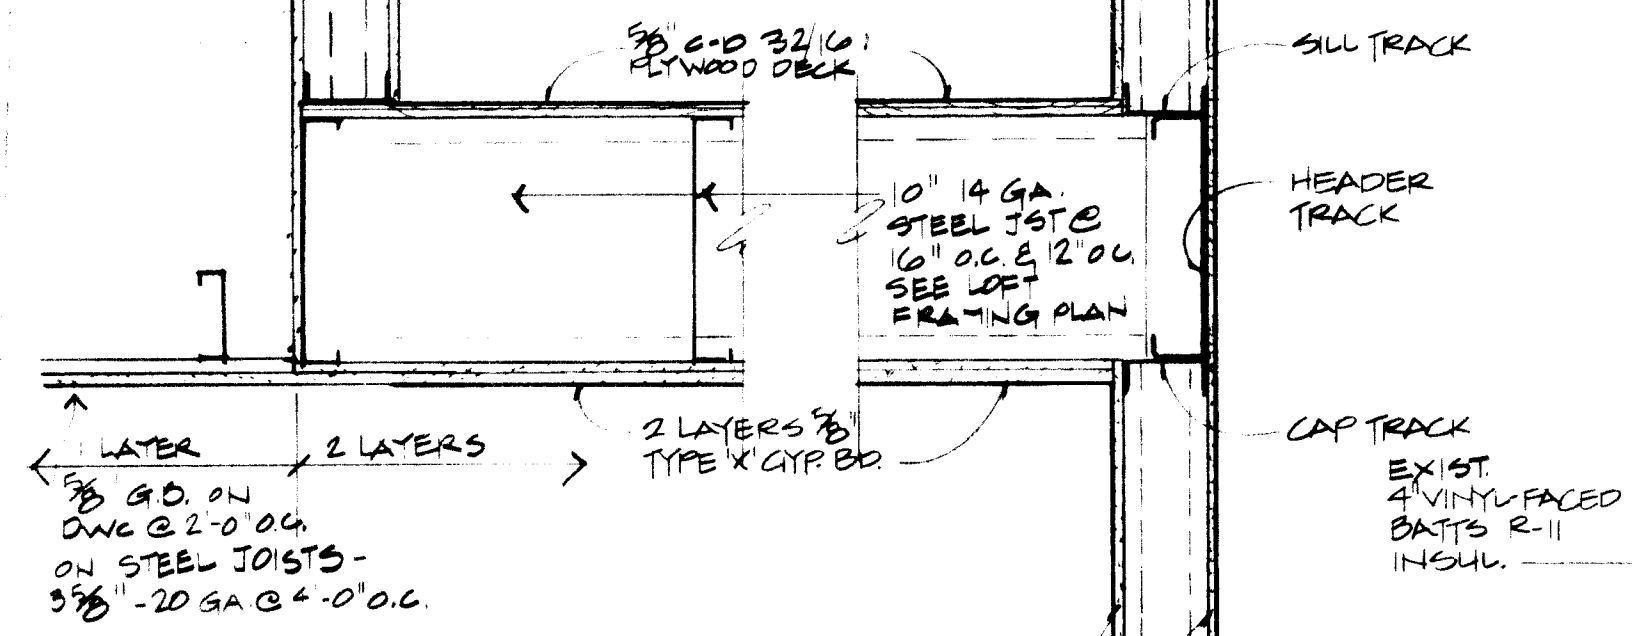


2 LOFT @ SOUTH WALL
1 1/2' = 1'-0"

4 LOFT @ EAST WALL
1 1/2' = 1'-0"



3 RAIL/LOFT DETAIL
1 1/2' = 1'-0"

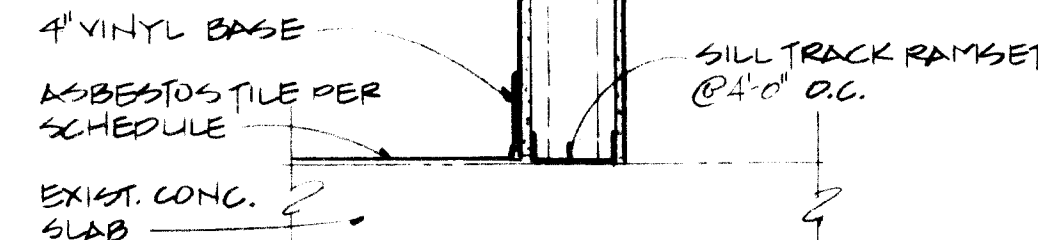

3 WALL/FLOOR/LOFT/ROOF @ NORTH WALL
1 1/2' = 1'-0"

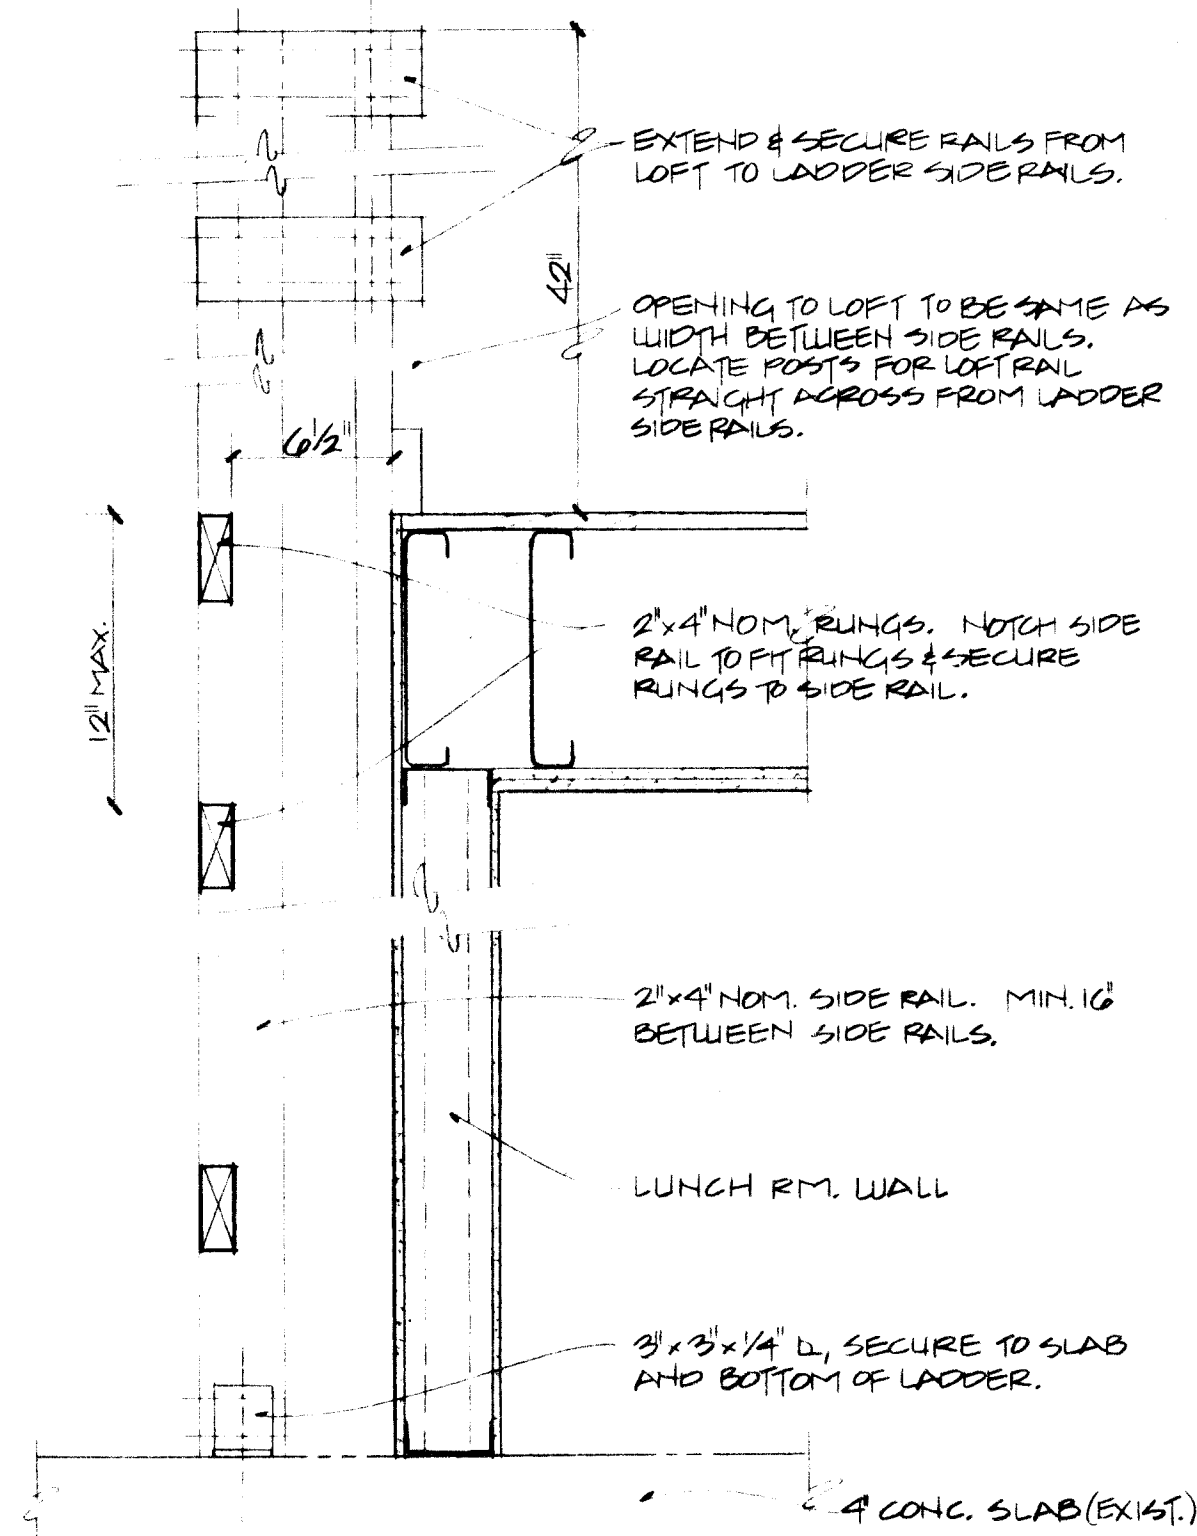


10 LADDER DETAIL
SCALE: 1/2\"/>

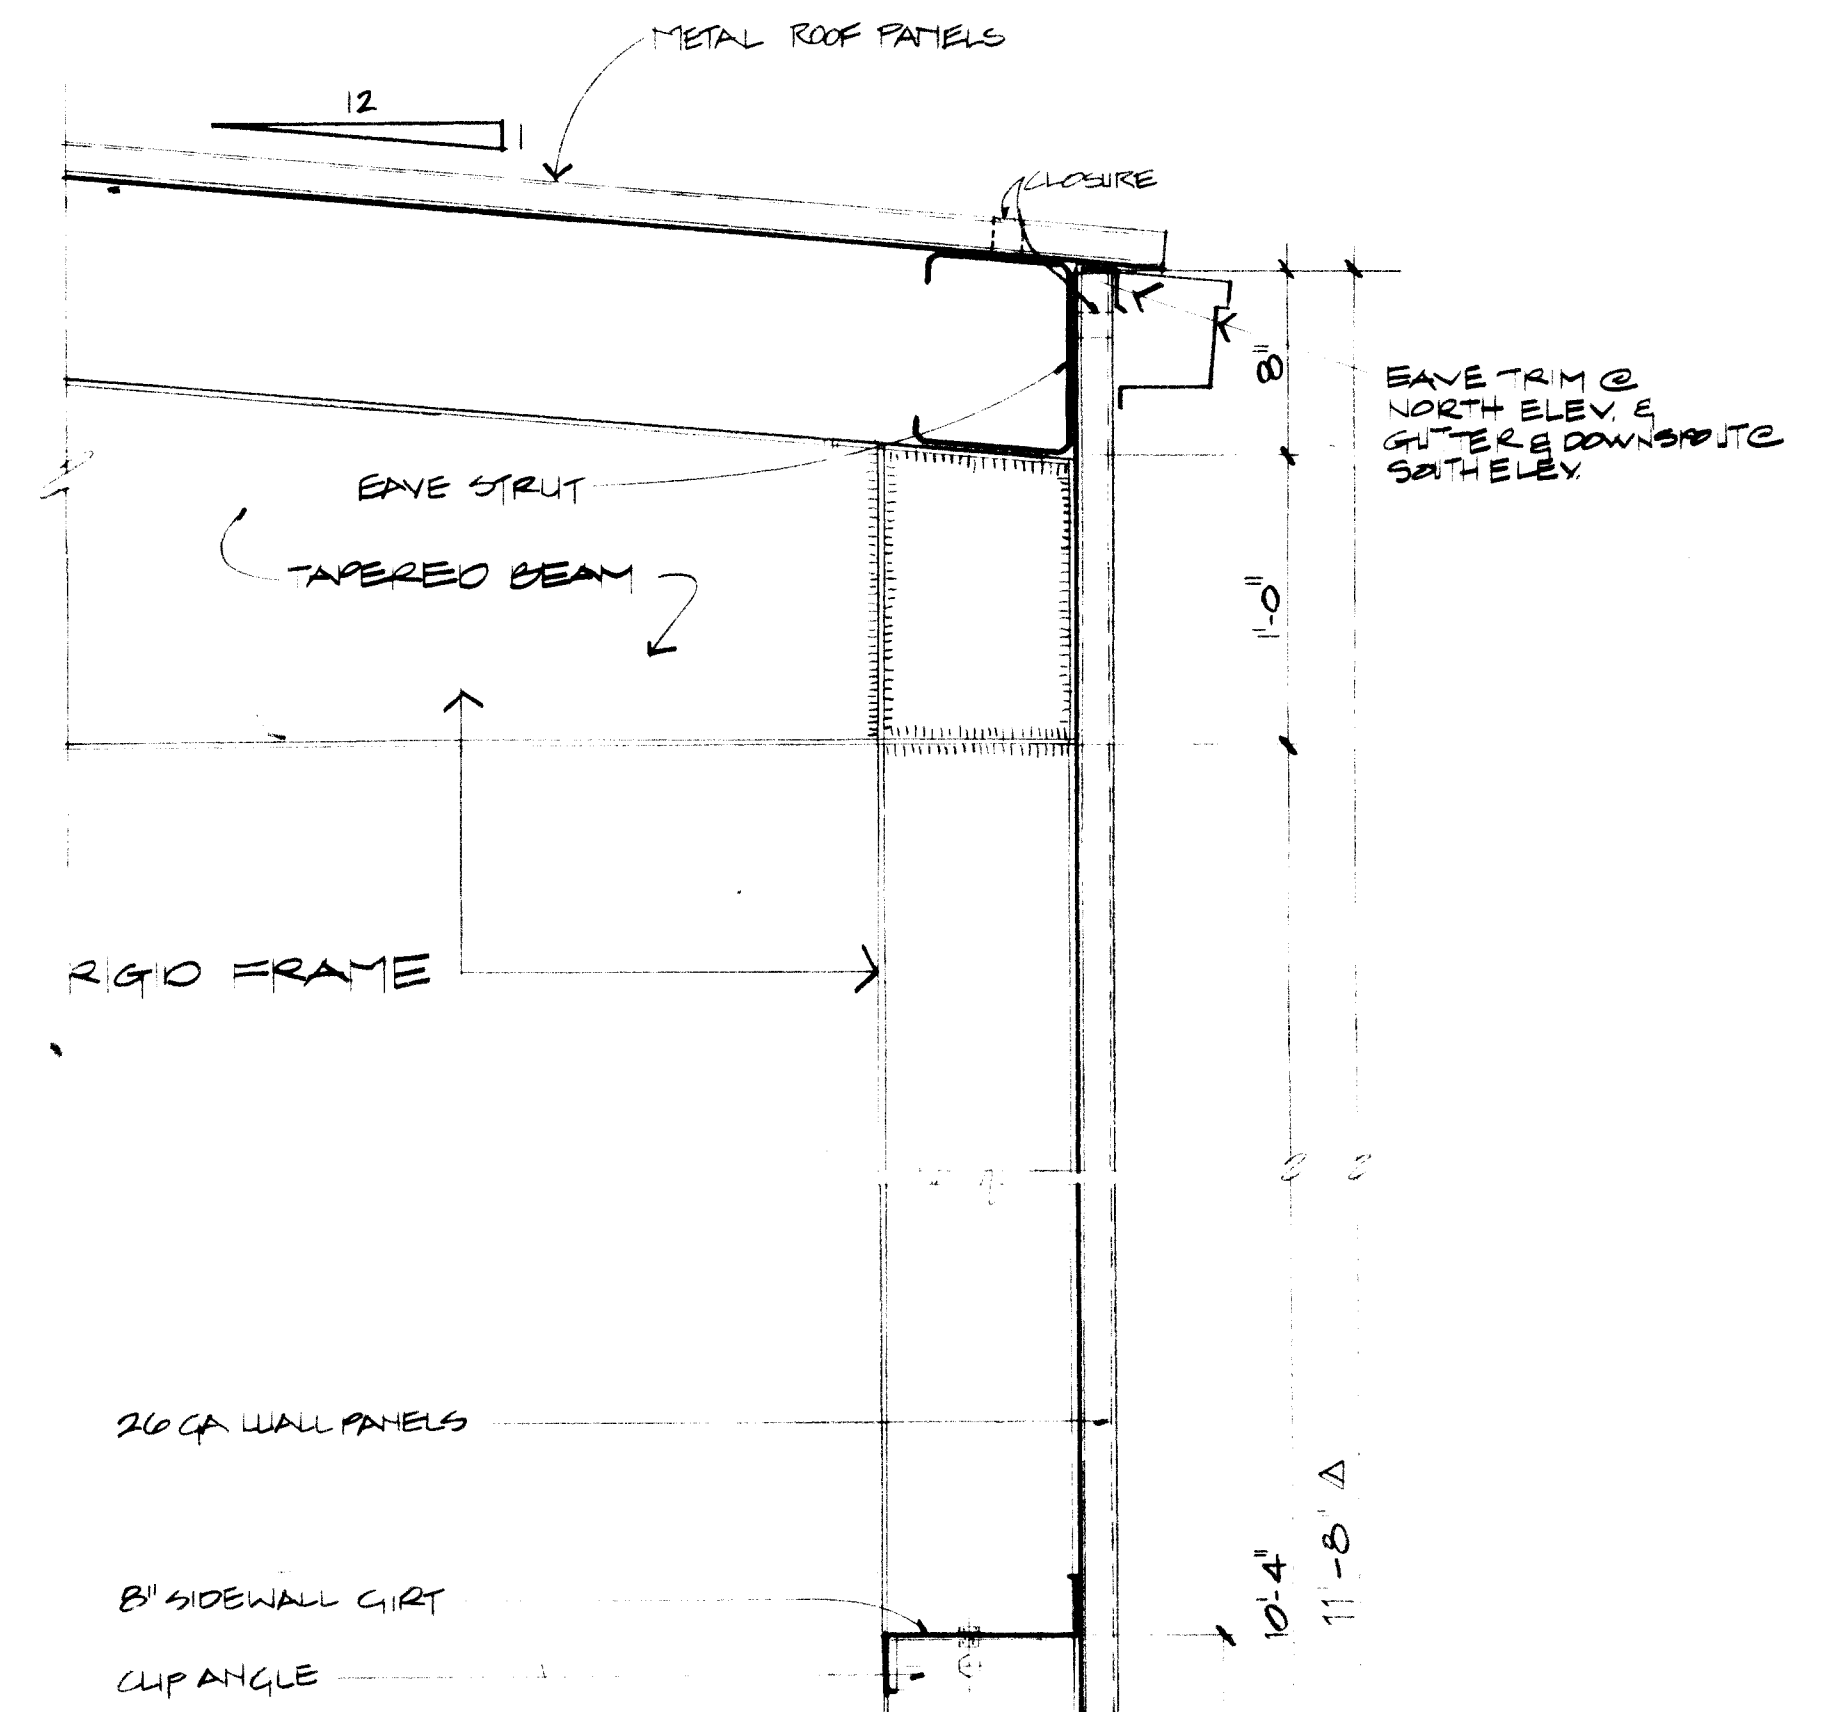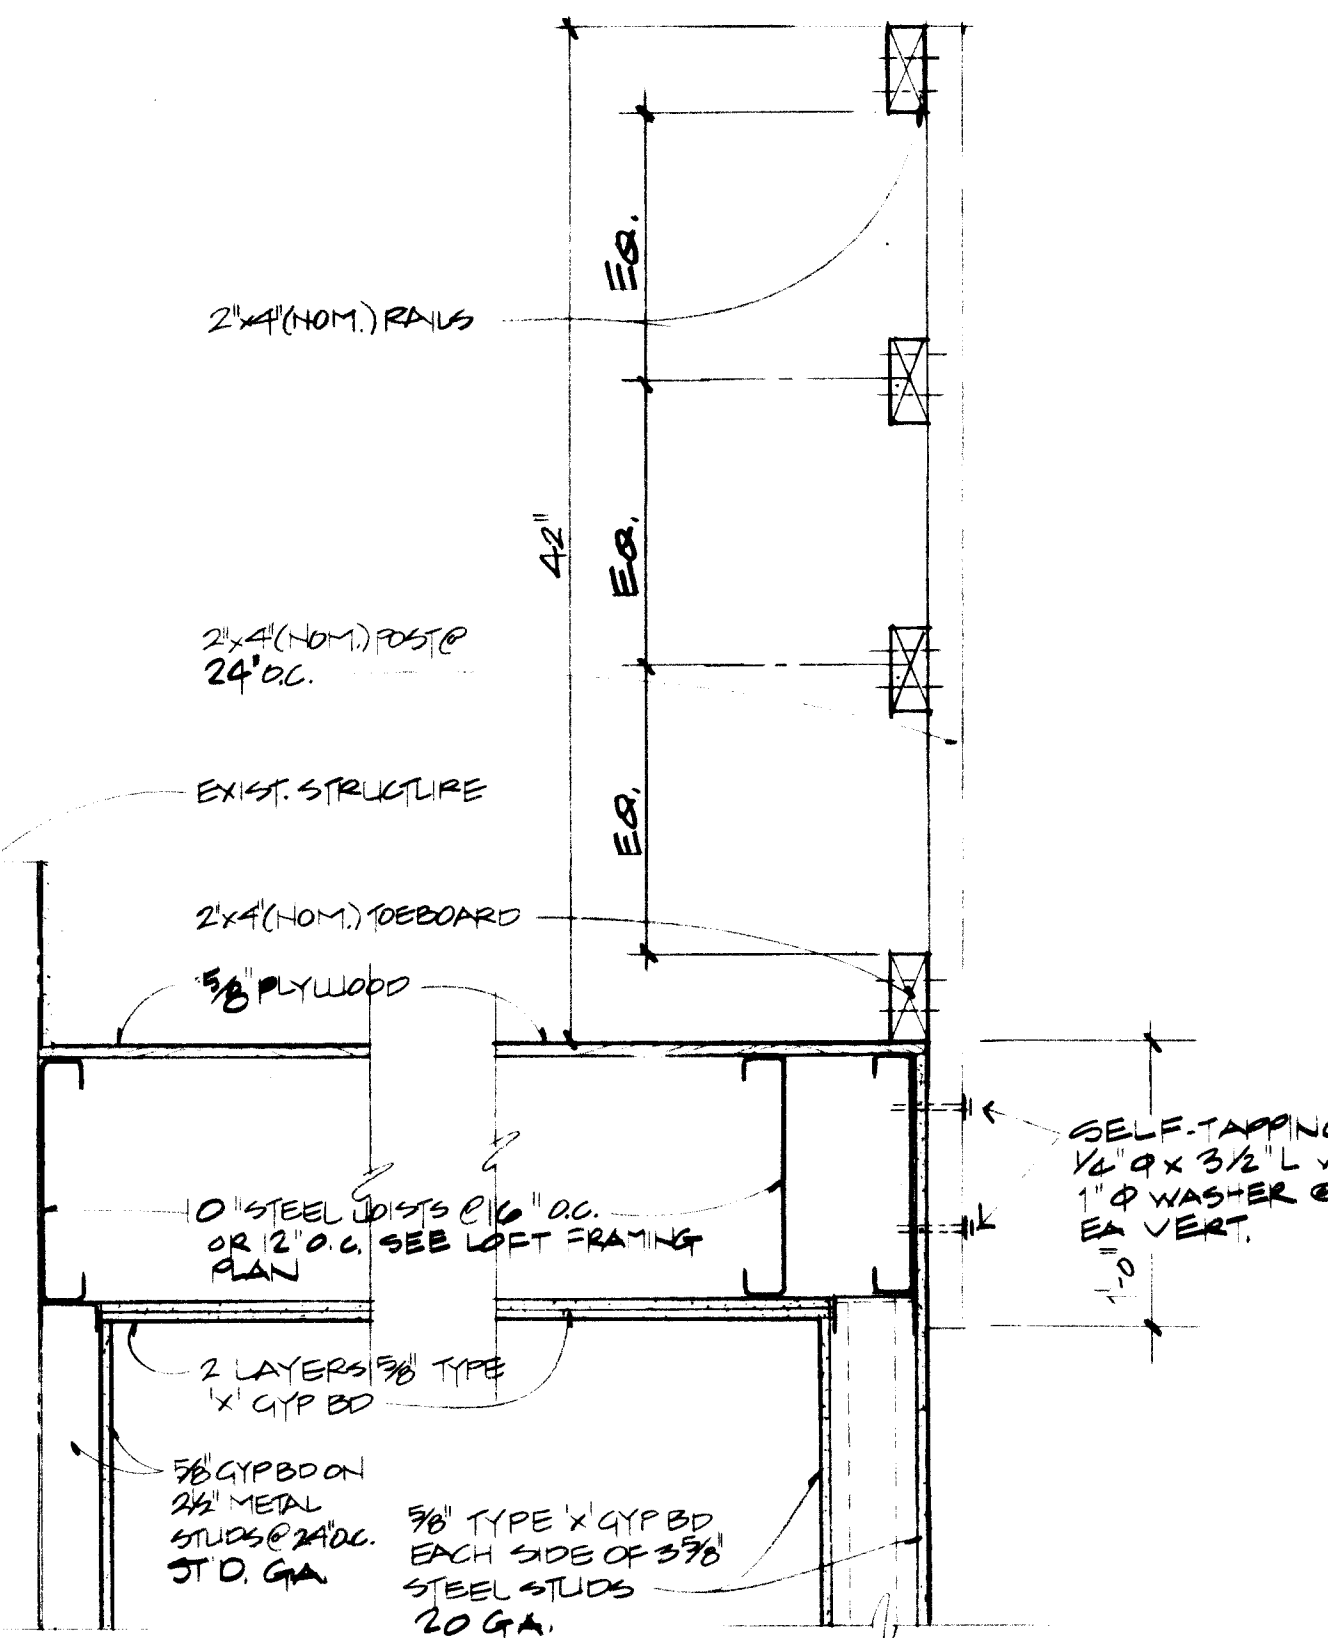

NOTE: SEE SPECIFICATIONS FOR METAL BUILDING STRUCTURAL DESIGN CRITERIA. STRAIGHT COLUMN-TAPERED BEAM DESIGN.

NOTE: BUILDING ANCHOR BOLTS & RELATED ANCHORAGE SHALL BE IN ACCORDANCE WITH DESIGN CRITERIA AS SET FORTH IN THE SPECIFICATIONS & DESIGN OF BUILDING. ALL BOLTS SHALL BE BY BUSHING MANUFACTURER ANCHOR BOLTS SHALL BE FURNISHED BY GENERAL CONTRACTOR & ACCURATELY PLACED IN ACCORDANCE WITH ANCHOR BOLT SETTING PLAN TO BE FURNISHED BY BUDGET MANUFACTURER.


SEE SPECS FOR EOL PREPARATION

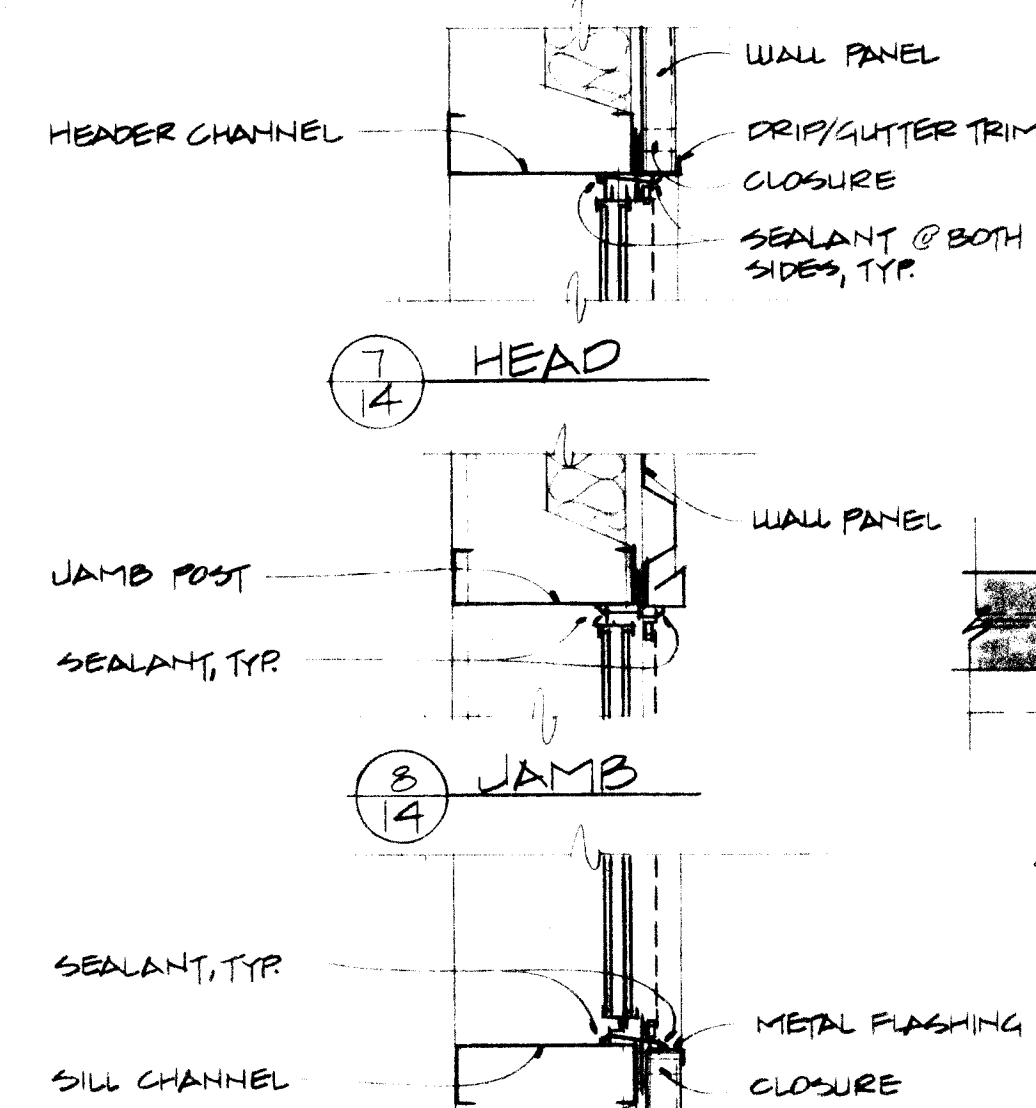


7 HEAD
1 1/2' = 1'-0"

8 JAMB
1 1/2' = 1'-0"

9 SILL
SCALE: 1/2\"/>

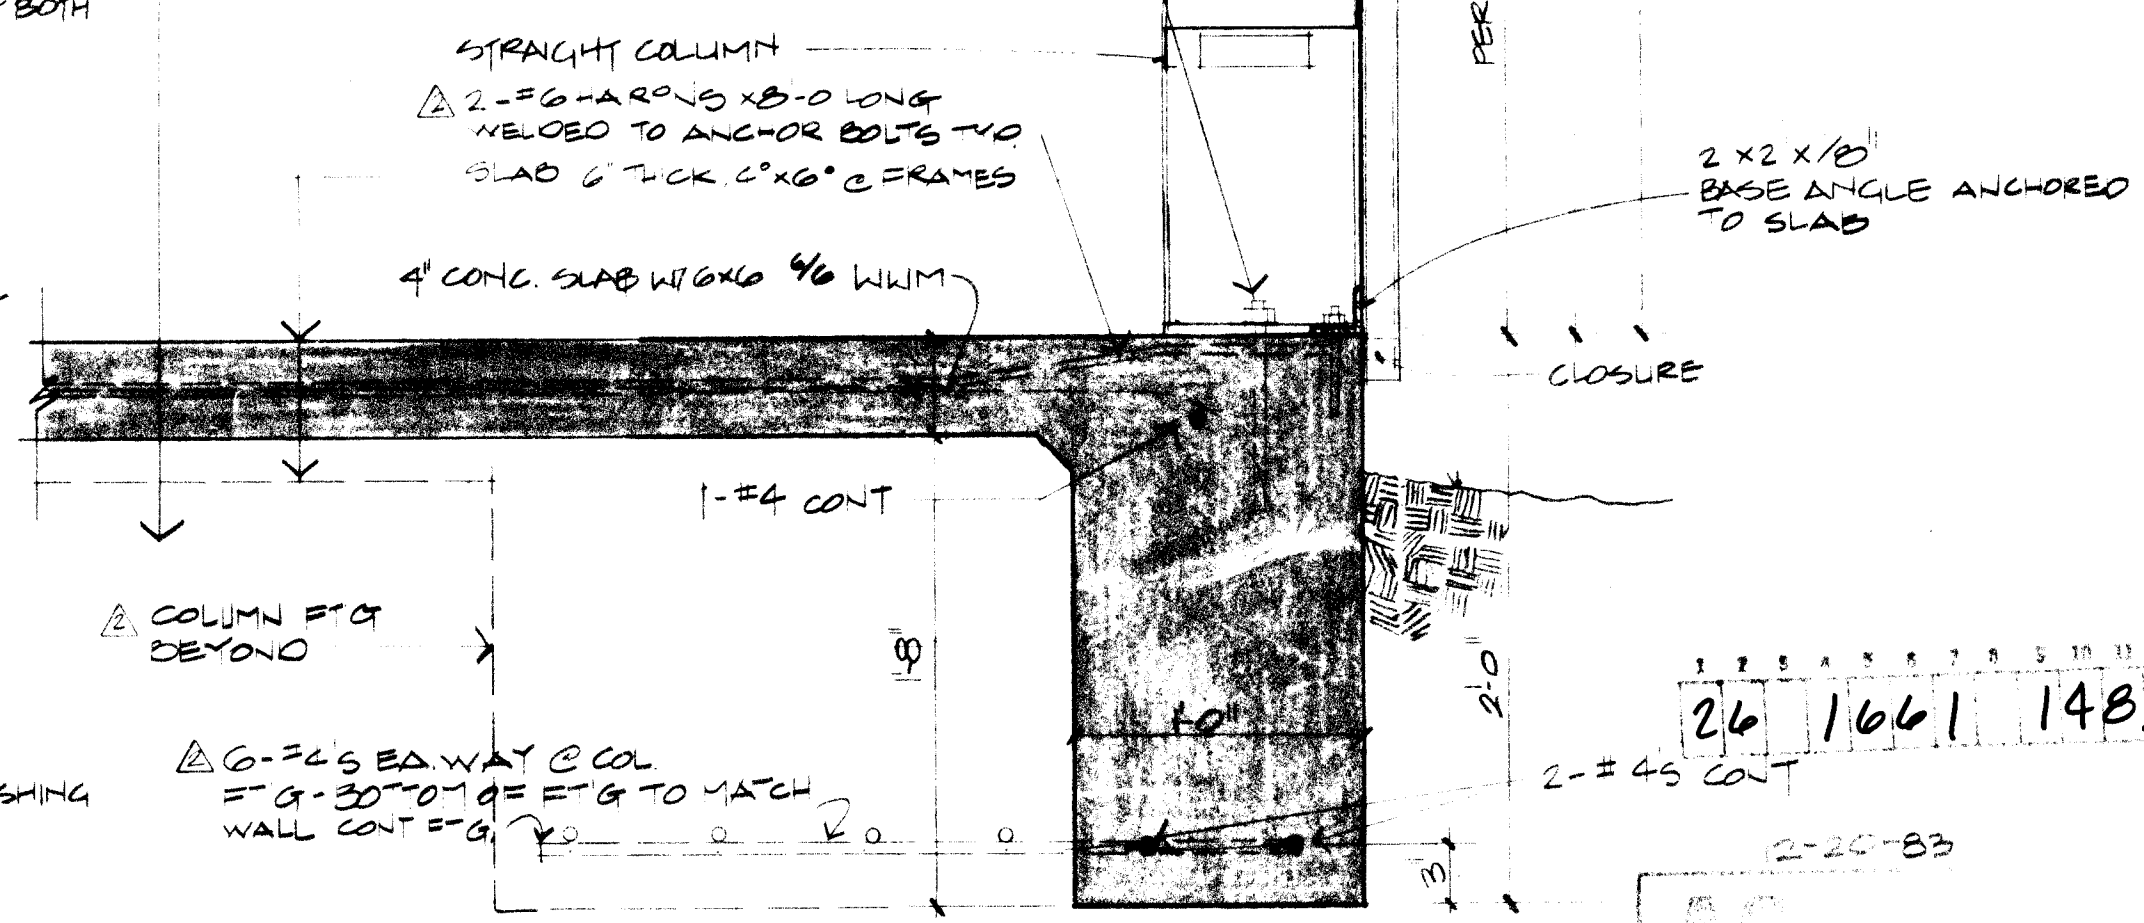

11 WALL SECTION
SCALE: 1 1/2\"/>

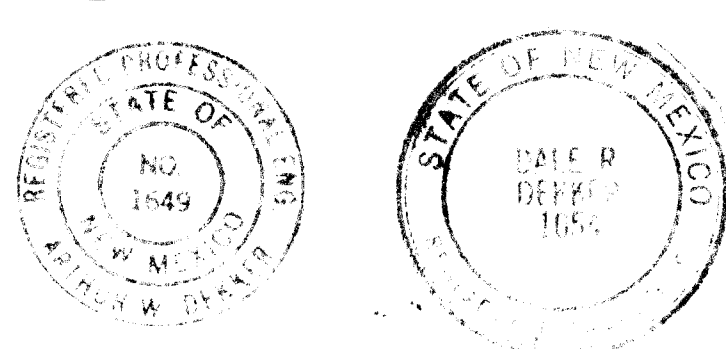

1661

dekker & associates
architects & engineers & planners
2403 San Mateo NE, Suite P-15, Albuquerque, New Mexico 87110 505.884.3689

job no. B208
drn. by JWH
chkd by ALW
issued 2-1-83
no date revision
AS BUILT 1/20/83
2/1/83

sheet 14

LOS ALTOS GOLF COURSE 8717 copper ave n.e. albuquerque, n.m.

These Drawings reflect information on utilities gathered by site inspection, discussions with local utilities engineering officials, and previous construction drawings, provided to the Architect. It is possible that the exact location of lines in the immediate vicinity of the proposed building may be slightly different from the location shown on this Drawing. If additional lines are encountered, they shall be exposed and identified by the Contractor. If the Contractor determines that a differing location is warranted, the Contractor shall request that the Architect make a ruling as to any necessary change of materials, re-routing, abandoning or relocating of such lines. All lines encountered that interfere with construction shall be relocated to clear construction (if active) and shall be removed if inactive by this Contractor under this contract. All bidders are cautioned to investigate site conditions before submitting their bids. All existing piping shall have minimum earth coverage and depth as indicated as required by applicable codes and local laws. The Contractor shall be responsible for obtaining all permits, line extensions, meter installation, etc., as required by local governing utilities engineering officials.



This Contractor shall be responsible for the complete installation of all work related to mechanical utilities including: trenching; backfill; supports; cleanout pads; service stops and boxes; service lines, testing; cleaning; and any work not accepted by the Architect or Mechanical Engineer due to improper workmanship or lack of proper coordination shall be removed and correctly installed at the Mechanical Contractor's expense, as directed.

Refer to Architectural Plans for finish and existing grades.

This Contractor shall coordinate cutoff of existing utilities for new connections with local utilities engineering officials and shall conform to their requirements

Utilities connection points are approximate only. Each bidder shall satisfy himself as to existing site conditions before submitting his bid. No allowance shall be made after the contract is awarded to compensate for lack of pre-bid inspection of the site by the successful bidder. Verify exact size, location and depth of existing sewer before setting any new inverts. Verify exact size, location and pressure of existing water mains.


Contractor shall connect new service lines as approved and directed by local governing utilities engineering officials and conform to their requirements.

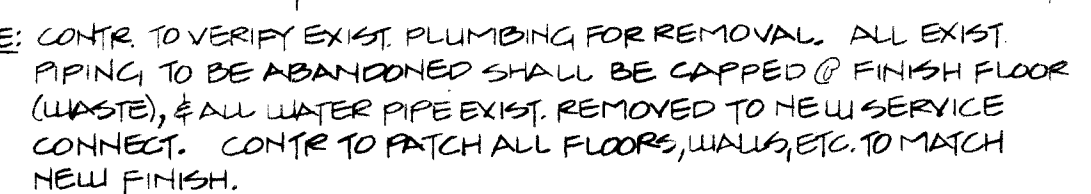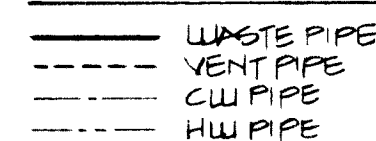

15 SEE ARCHITECTURAL FOR
 Δ REVISED TOILET ROOM PLAN



- ① PIPING CONCEALED IN JOIST SPACE
- ② PIPING CONCEALED IN WALL.
- ③ PIPING BELOW SLAB.
- ④ 1/2 x 12" AIR CHAMBER.
- ⑤ 3/4" PIPE FROM HEAVY TIE RELIEF VALVE. TAKE TO FLOOR DRAIN, LEAVING OPEN END A/F.
- ⑥ MAKE CONNECTION W/IT HEAVY PIPE TO EXIST. PIPE. CONTR TO VERIFY ACTUAL LOCATION OF EXIST., AS WELL AS FLOW DIRECTION OF WASTE.
- ⑦ 3" Ø H/WH FLUE. COMBINE W/ FURNACE FLUE TO 6" Ø FLUE THRU ROOF W/ SUEVEE & CAP. INSTALL W/ CERTIFIED DRAFT DIVERTER. SEE MECH. FLOOR PLAN THIS SHEET.

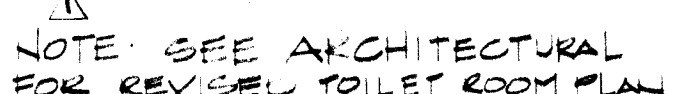

- ① FURNACE TO BE PRYNE 994C, 000150; 150,000 BTU/H INPUT, 1200 CFM @ 0.3 SUCT. SP. MIN. INSTALL W/ 100% SAFETY CUTOFF & 1" INSULATED FOR ALTITUDE, 1/2" CONNECTION WITH 60# PLE. SEE NOTE ON PLAN FOR ROUTING OF FUE. RETURN AIR LOCATED IN S/C OF FURNACE. MAKE FLEXIBLE DUCT CONNECTION TO FURNACE FOR SUPPLY AND RETURN DUCTS.
- ② SIDEWALL REGISTERS TO BE AIRRATE 240-NO.080 CEILING REGISTERS TO BE HART & COOLY ROYALAIR (600) COORDINATE DIFFUSERS IN CEILINGS WITH LIGHT FIXTURES.
- ③ EVAP. COOLER TO BE ARCTIC CIRCLE #2220 B.3, WITH RECIRCULATING PUMP, 1/4 HP. MAKE FLEX. CONNECT. FROM COOLER TO SUPPLY DUCT. MOUNT COOL. ON PLANT ON EXTERIOR OF COOL. PER MECH. PLAN.
- ④ EXHAUST FAN REQ. TO DRAIN #008 @ 600 CFM. CEILING RECESSED, COMPLETE PACKAGE UNIT W/ BUILT-IN DAMPER. PROMOTE 3" DUCT UP THRU ROOF TO ROOF JACK.

SYMBOL	ITEM	MANUF. # NUMBER	DESCRIPTION	TRAP	WASTE	VENT	HOT	C.O.D.
WC	WATER CLOSET	KOHLER #K-3415 EB	K-4652 SEAT, 3/8" SUPPLY WITH STOP.		3"	2"	1/2"	
LAV	LAVATORY	KOHLER #K-2020	20" B" WITH K-1436 T FAUCET & C-RAN. TRAP K-9000 & 3/8" SUPPLIES WITH STOPS.	1/4"	1/2"	1/2"	3/8"	3/8"
SK	SINK	EXIST.	RELOCATE & USE EXIST. SINK & FITTINGS.	1/2"	1/2"	1/2"	3/8"	3/8"
EUC	WATER COOLER	EXIST.	RELOCATE & USE EXIST. EVOL. WATER COOLER.	1/4"	2"	1/2"	—	3/8"
SH	SHOWER	ELBER #094-0950	32" X 50" FIBERGLASS SHOWER UNIT. USE #532-0350 FITTING, STRAINER AND SHOWERHEAD & #533-0865 STRAINER IN SHOWER FITTING.	2"	2"	1 1/2"	1/2"	1 1/2"
FD	FLOOR DRAIN	WADE #LW-1102	CAST IRON 1/4" STANDARD SATIN NICKEL 1" STRAINER 4" DIAMETER FUNNEL, 1/4" 2" P-TAP	2"	2"	1 1/2"	—	—
FCO	FLOOR CLEANOUT	WADE #LW-1004	CAST IRON 1/4" SIZE, WITH ADJUSTABLE HOUSING & STANDARD ROUND NICKEL BRASS SCREWED TOP	—	4"	—	—	—
HWU	HOT WATER HEATER	EXIST.	RELOCATE & USE EXIST. HOT WATER HEATER. INSTALL WITH HWU & CUW CONNECTIONS, 3" SELLER, 1" NAT. GAS, & 3/4" T & P RELIEF VALVE. *VERIFY EXIST. SIZE IN FIELD	—	—	—	3/4"	3/4"

3 / 15
NOT TO SCALE

15 SCALE: 1/8" = 1'-0"

- 1 All plumbing and mechanical systems shall comply with all applicable codes, ordinances, and OSHA standards.
- 2 Location of existing fixtures, lines, etc., shown on the Drawings are approximate and shall be field verified.
- 3 The water, waste and vent lines as shown on Drawings indicate approximate routing. Exact location of lines shall be coordinated w/field conditions and rough-in requirements of fixtures.
- 4 Remove and replace existing floor slabs, walls and ceilings as required for installation of new plumbing lines and connection to existing services. Replace damaged construction to match new finishes.
- 5 Contractor shall repair all damage to floors, walls, ceilings, etc., in a professional manner. Seal all wall or ceiling opening with matching material; this shall be done at no cost to the Owner. If roof needs to be penetrated, pitch pans and/or proper flashings are then required. The roof shall be patched and repaired as directed.
- 6 Any damage to existing equipment, structure, building, etc., shall be patched and repaired as directed by Owner, at no additional cost to the Owner.

- 7 All piping shall be concealed where possible (unless otherwise noted). All exposed piping where concealment is not possible shall be painted.
- 8 No water piping shall be installed below floor, except as shown.
- 9 All water piping shall be insulated. See Specifications for type.
- 10 No water piping shall be located in outside walls, unless shown on these Drawings, and then piping is to be insulated per Specs.
- 11 All branches shall be valved, all valves shall have unions adjacent. Access panels shall be furnished and installed for access to valves where required.
- 12 All piping shall pitch to drain, and Contractor shall provide valving for drainage. Contractor shall deliver a marked-up set of Plans to the Owner (prior to final payment) showing all branch valves and all drainage points.
- 13 Care shall be taken to avoid mechanical ductwork, electrical equipment and air handling equipment. This Contractor shall be responsible for coordinating routing of piping with Ceiling Contractor and Sheetmetal Contractor. Relocation of piping required by poor coordination by this Contractor shall be at his own expense.
- 14 All water piping in Mechanical Equipment Room shall be insulated.



LOS ALTOS GOLF COURSE 8717 copper ave n e
duquesne n m

job no
drn by
ckd by
issued

0200
WON
ALLI, PT
23-1-00

sheet

15

no date revision
AS-BUILT 23-00


10

SYMBOL LEGEND	
SYMBOL	DESCRIPTION
Ⓐ Ⓑ	CEILING OR WALL BRACKET FIXTURE. SEE FIXTURE SCHEDULE
Ⓒ	FLUORESCENT OUTLET AND FIXTURE. SEE FIXTURE SCHEDULE
\$	SINGLE POLE WALL SWITCH, UP +48". "3" INDICATES THREE-WAY.
\$T	THERMAL O.L. SWITCH
Ⓜ	JUNCTION BOX FLUSH IN WALL WITH CONNECTION TO EQUIPMENT
Ⓜ	DUPLEX CONVENIENCE OUTLET, UP 12" OR AS INDICATED.
Ⓜ	THERMOSTAT, UP 48" UNLESS OTHERWISE INDICATED.
■	ELECTRIC PANEL. SEE PANEL SCHEDULE FOR CHARACTERISTICS
Ⓜ	MOTOR CONNECTION WITH HP INDICATED. "F" INDICATES FRACTIONAL.
—	BRANCH CIRCUIT IN WALLS OR CEILING WITH CONDUCTORS INDICATED.
—	BRANCH CIRCUIT IN WALLS OR UNDER FLOOR WITH CONDUCTORS INDICATED.
—A-1,3	HOME RUN TO PANEL, WITH BRANCH CIRCUIT NUMBERS INDICATED.
—T	TELEPHONE CONDUIT, MINIMUM 3/4" WITH PULL WIRE.
—T	TELEPHONE CONDUIT HOMERUN TO BACKBOARD, 1" MINIMUM WITH PULL WIRE.
▶	TELEPHONE OUTLET, UP 12" UNLESS OTHERWISE INDICATED.
Ⓜ	250V-2P-3W SPECIAL PURPOSE GROUNDING TYPE OUTLET. AMPERAGE AS SHOWN.
Ⓜ	PHOTOCELL ON ROOF WITH WINDOW FACING NORTH.
\$EC	EVAP COOLER SWITCHES, ONE TOGGLE SWITCH FOR PUMP AND ONE DPDT CENTER OFF FOR FAN.
□	DISCONNECT SWITCH, SIZE AND POLES FOR LOAD CONNECTED.
—E—	EXISTING CONDUIT AND WIRE REMAIN.
—R—	EXISTING CONDUIT AND WIRE REMOVED OR ABANDONED.
Ⓜ	EXISTING DEVICE REMAINS.
Ⓜ	EXISTING DEVICE REMOVED.


GENERAL NOTES

- THE ELECTRICAL CONTRACTOR SHALL FAMILIARIZE HIMSELF AT THE SITE WITH THE EXISTING CONDITIONS TO ALLOW HIM TO SUBMIT A COMPLETE BID WITHIN THE SCOPE OF THIS DRAWINGS AND SPECIFICATIONS. ANY QUESTIONS ARISING DURING THE BID PERIOD IN REGARD TO THE CONTRACTORS FUNCTIONS, THE SITES INVOLVED, THE SCOPE OF THE PROJECT, OR ANY OTHER ISSUE RELATED TO THIS PROJECT SHALL BE BROUGHT UP DURING THE BID PERIOD WITH THE ENGINEERS FOR CLARIFICATIONS, NOT AFTER THE CONTRACT HAS BEEN AWARDED.
- LOCATION OF EQUIPMENT, CONTROLS AND OTHER DEVICES SHOWN ON THE DRAWINGS ARE APPROXIMATE AND SHALL BE FIELD VERIFIED.
- ALL ELECTRICAL WIRING SHALL BE ROUTED IN CONDUIT. WIRING BELOW SUSPENDED CEILINGS SHALL BE CONCEALED IN WALLS. IN CASE OF SOLID WALLS, WIRING MUST BE UTILIZED BELOW SUSPENDED CEILINGS--EXCEPT IN AREAS WITH EXPOSED JOISTS.
- THE CONDUIT RUNS AS SHOWN ON DRAWINGS INDICATE APPROXIMATE ROUTING. EXACT LOCATION OF CONDUIT RUNS SHALL BE PER FIELD CONDITIONS. NO CONDUIT SHALL BE RUN EXPOSED ON OUTSIDE OF BUILDINGS UNLESS APPROVED BY ENGINEER.
- CONTRACTOR SHALL INSTALL PULL AND J-BOXES WHEREVER REQUIRED BY NEC.
- ALL WIRES SHALL BE TAGGED AT ALL PULL BOXES, J-BOXES, EQUIPMENT BOXES AND CABINETS WITH APPROVED PLASTIC TAGS, ACTION CRAFT BRADY OR APPROVED EQUAL.
- ALL MATERIALS UTILIZED SHALL HAVE U. L. LABEL.
- SHOULD ELECTRICAL CONTRACTOR AT ANY TIME NOTICE THAT THE ACTUAL FIELD CONDITIONS DO NOT CORRESPOND TO THE INFORMATION GIVEN ON THE DRAWINGS, THEN IT WILL BE HIS RESPONSIBILITY TO NOTIFY THE ELECTRICAL ENGINEER AS SOON AS POSSIBLE FOR CLARIFICATION.
- ELECTRICAL CONTRACTOR SHALL REPAIR ALL DAMAGE TO WALLS, CEILINGS, ETC., IN A PROFESSIONAL MANNER. SEAL ALL WALL OR CEILING OPENINGS WITH MATCHING MATERIAL; THIS SHALL BE DONE, AT NO COST TO THE OWNER. IF ROOF NEEDS TO BE PENETRATED, PITCH PANS ARE THEN REQUIRED. THE ROOF SHALL BE PATCHED AND REPAIRED AS DIRECTED.
- ANY DAMAGE TO EXISTING EQUIPMENT, STRUCTURE, BUILDING, ETC. SHALL BE PATCHED AND REPAIRED AS DIRECTED BY OWNER, AT NO ADDITIONAL COST TO THE OWNER.


FIXTURE SCHEDULE			
TYPE	DESCRIPTION	LAMPS	MOUNTING
A	LITHONIA #201-440-RN-A12	4/P40/RS/WM	RECESSED
B	LITHONIA #21-240	2/P40/RS/WM	SURFACE
C	LITHONIA #21-440-M-RN-A12	4/P40/RS/WM	SURFACE
D	LITHONIA #14-240-M-RN-A12	2/P40/RS/WM	SURFACE
E	FRESCOLITE #9428	1/FC6T9/CW	SURFACE
F	LITHONIA #224B-A1-220-WUD	2/P20/CW	WALL BRACKET
G	FRESCOLITE #21K-C-20	1/60W/1P	RECESSED
H	POPCELAIN LAMPHOLDER	1/60W/1P	SURFACE
I	HUBBELL #HRC-121-HP	1/50W/HPS	WALL BRACKET
FIXTURE SCHEDULE NOTES:			
1. ALL FLUORESCENT FIXTURES SHALL HAVE COMBINATION ENERGY SAVING LAMPS AND BALLASTS.			
2. ALL INCANDESCENT LAMPS SHALL BE RATED 130V.			
3. PROVIDE TYPE "B" FIXTURE WITH 0 DEGREE F RATED BALLAST.			

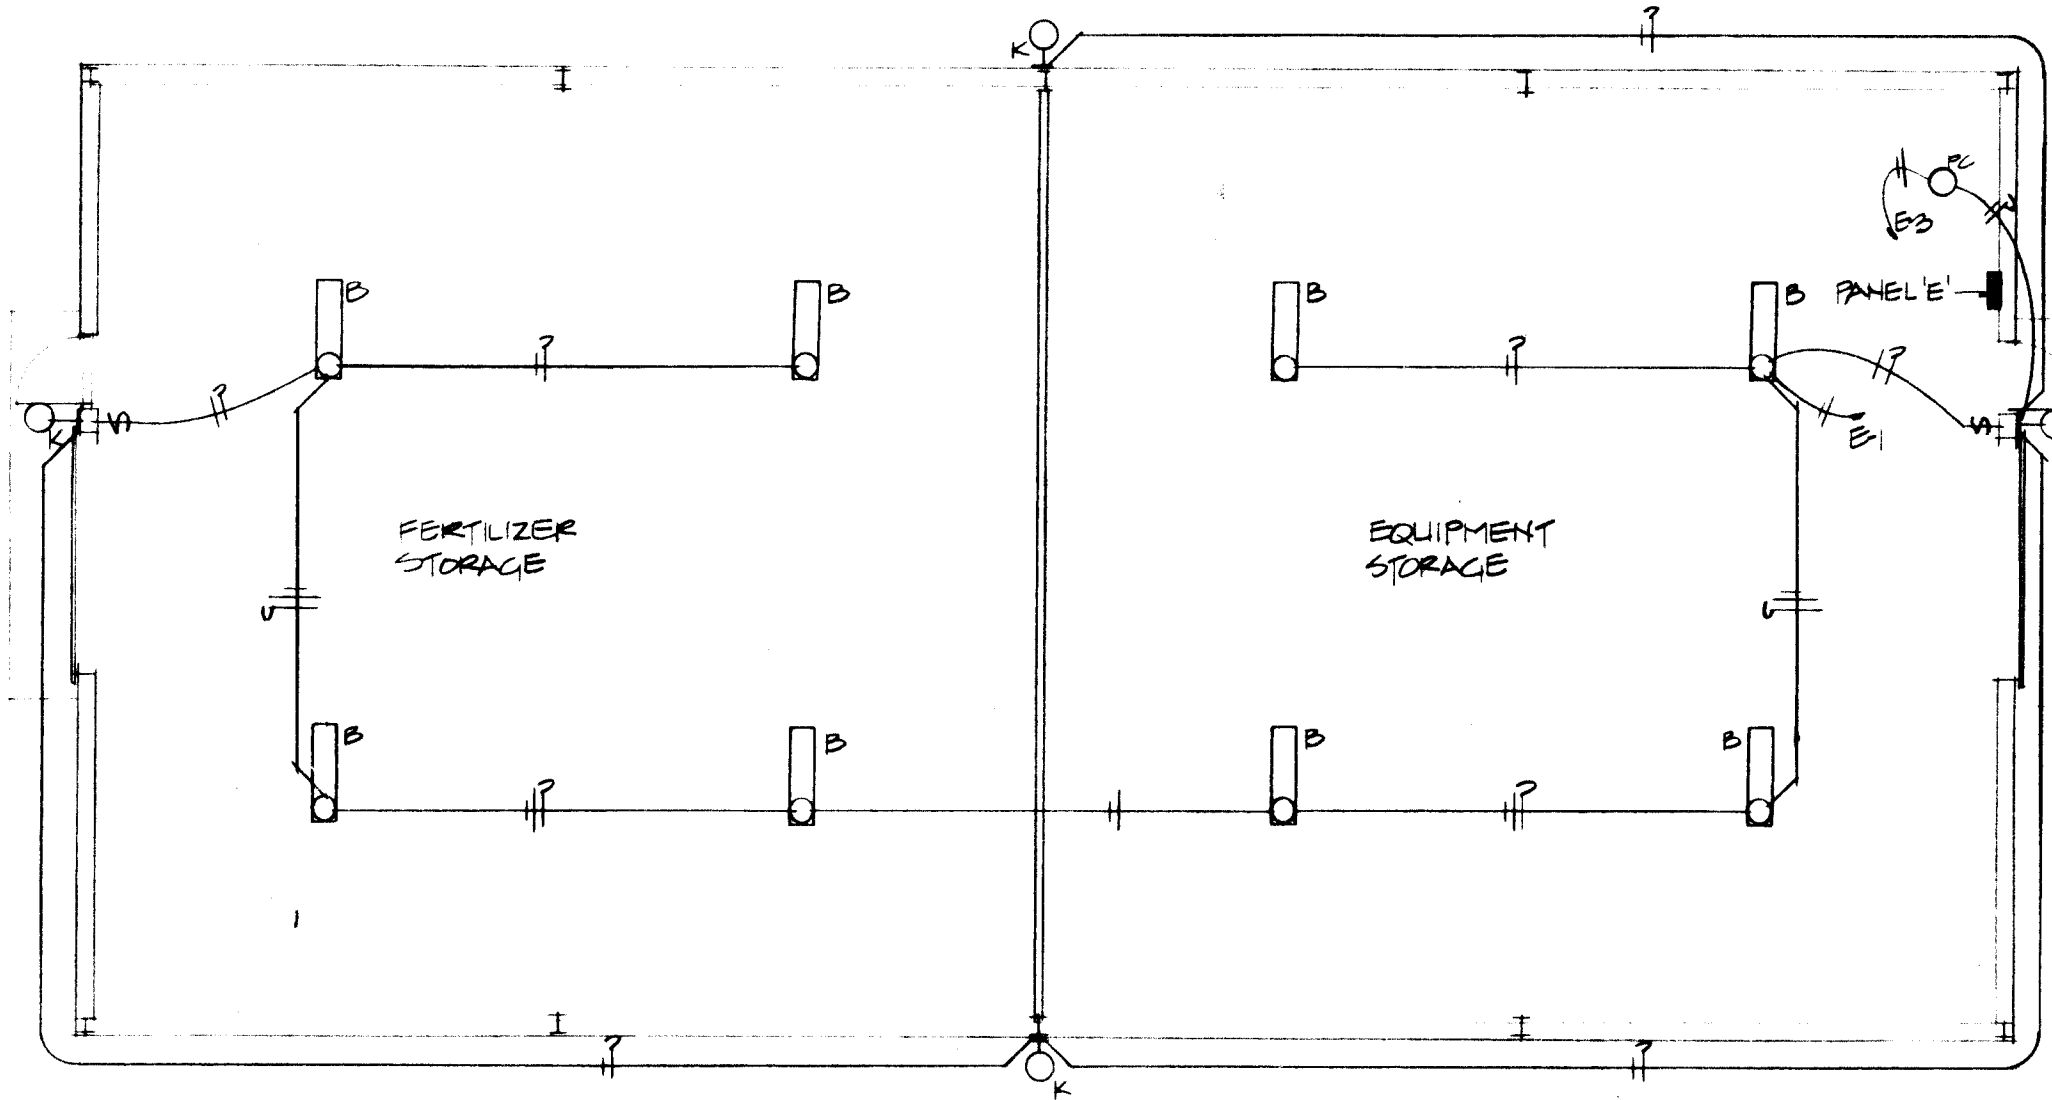


1 LIGHTING FLOOR PLAN - NEW STOR. BLDG.
10 ADDITIVE ALTERNATE #2 SCALE: 1/8" = 1'-0"

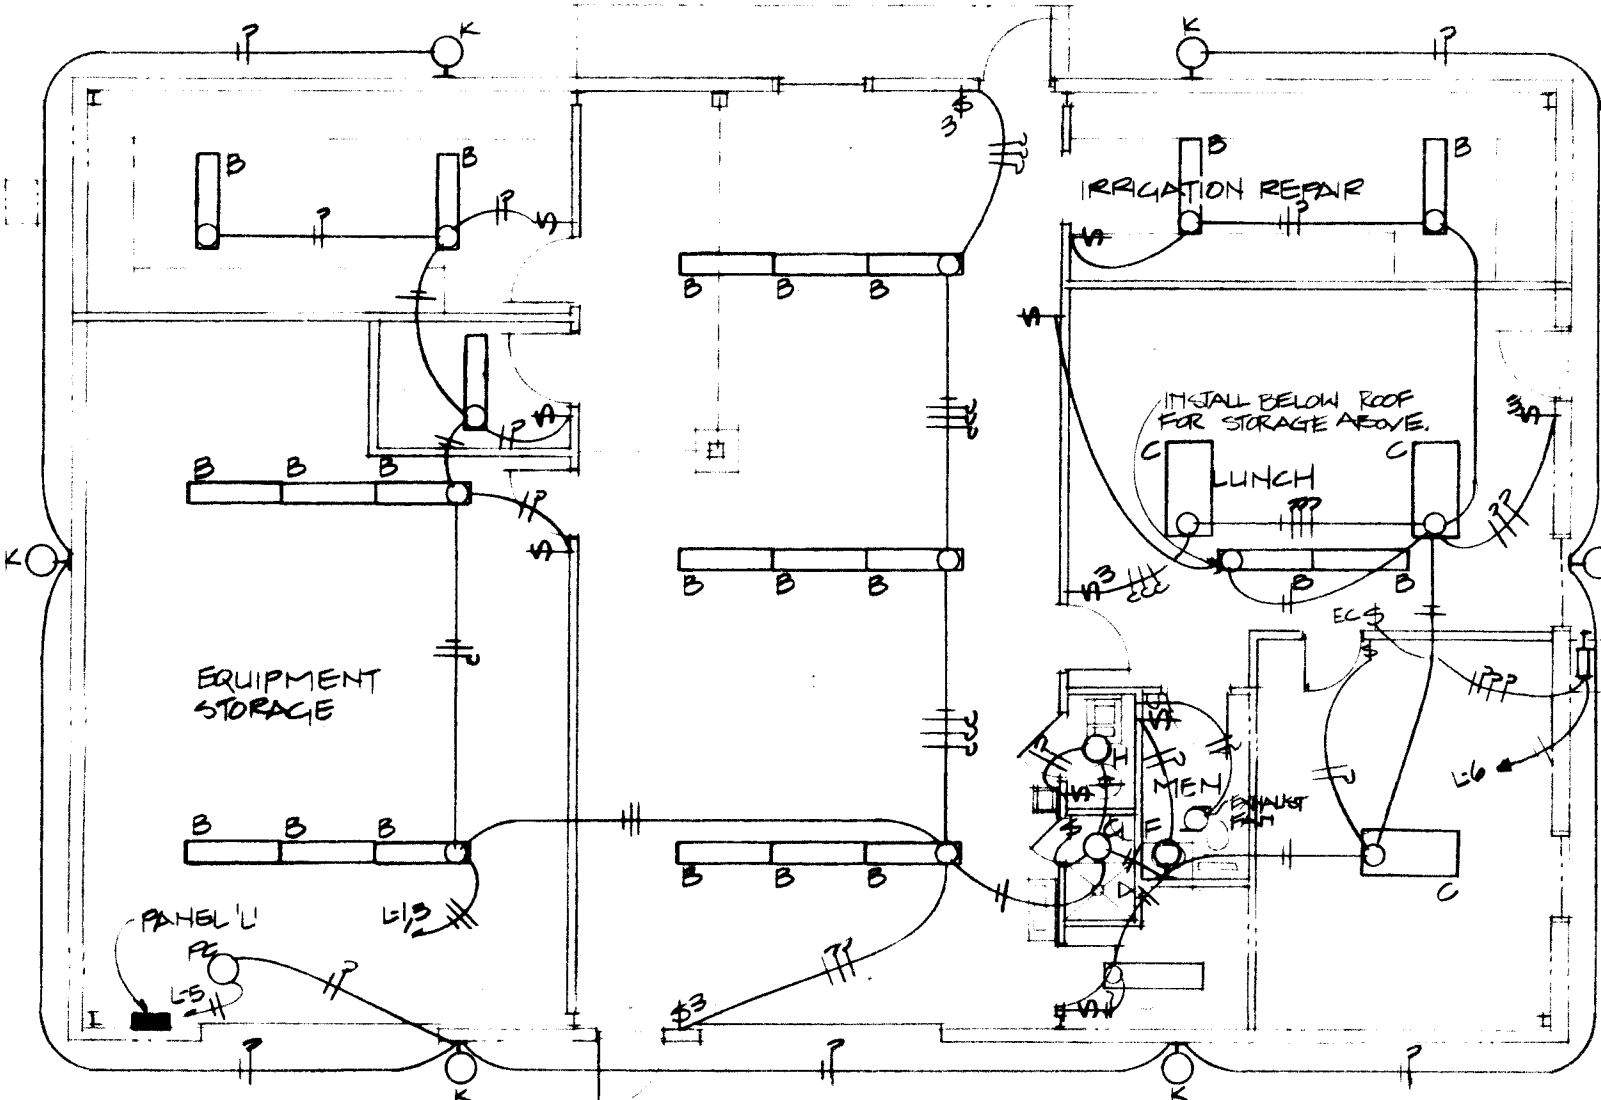

2 LIGHTING FLOOR PLAN - EXIST. MAINT. BLDG.
10 SCALE: 1/8" = 1'-0"

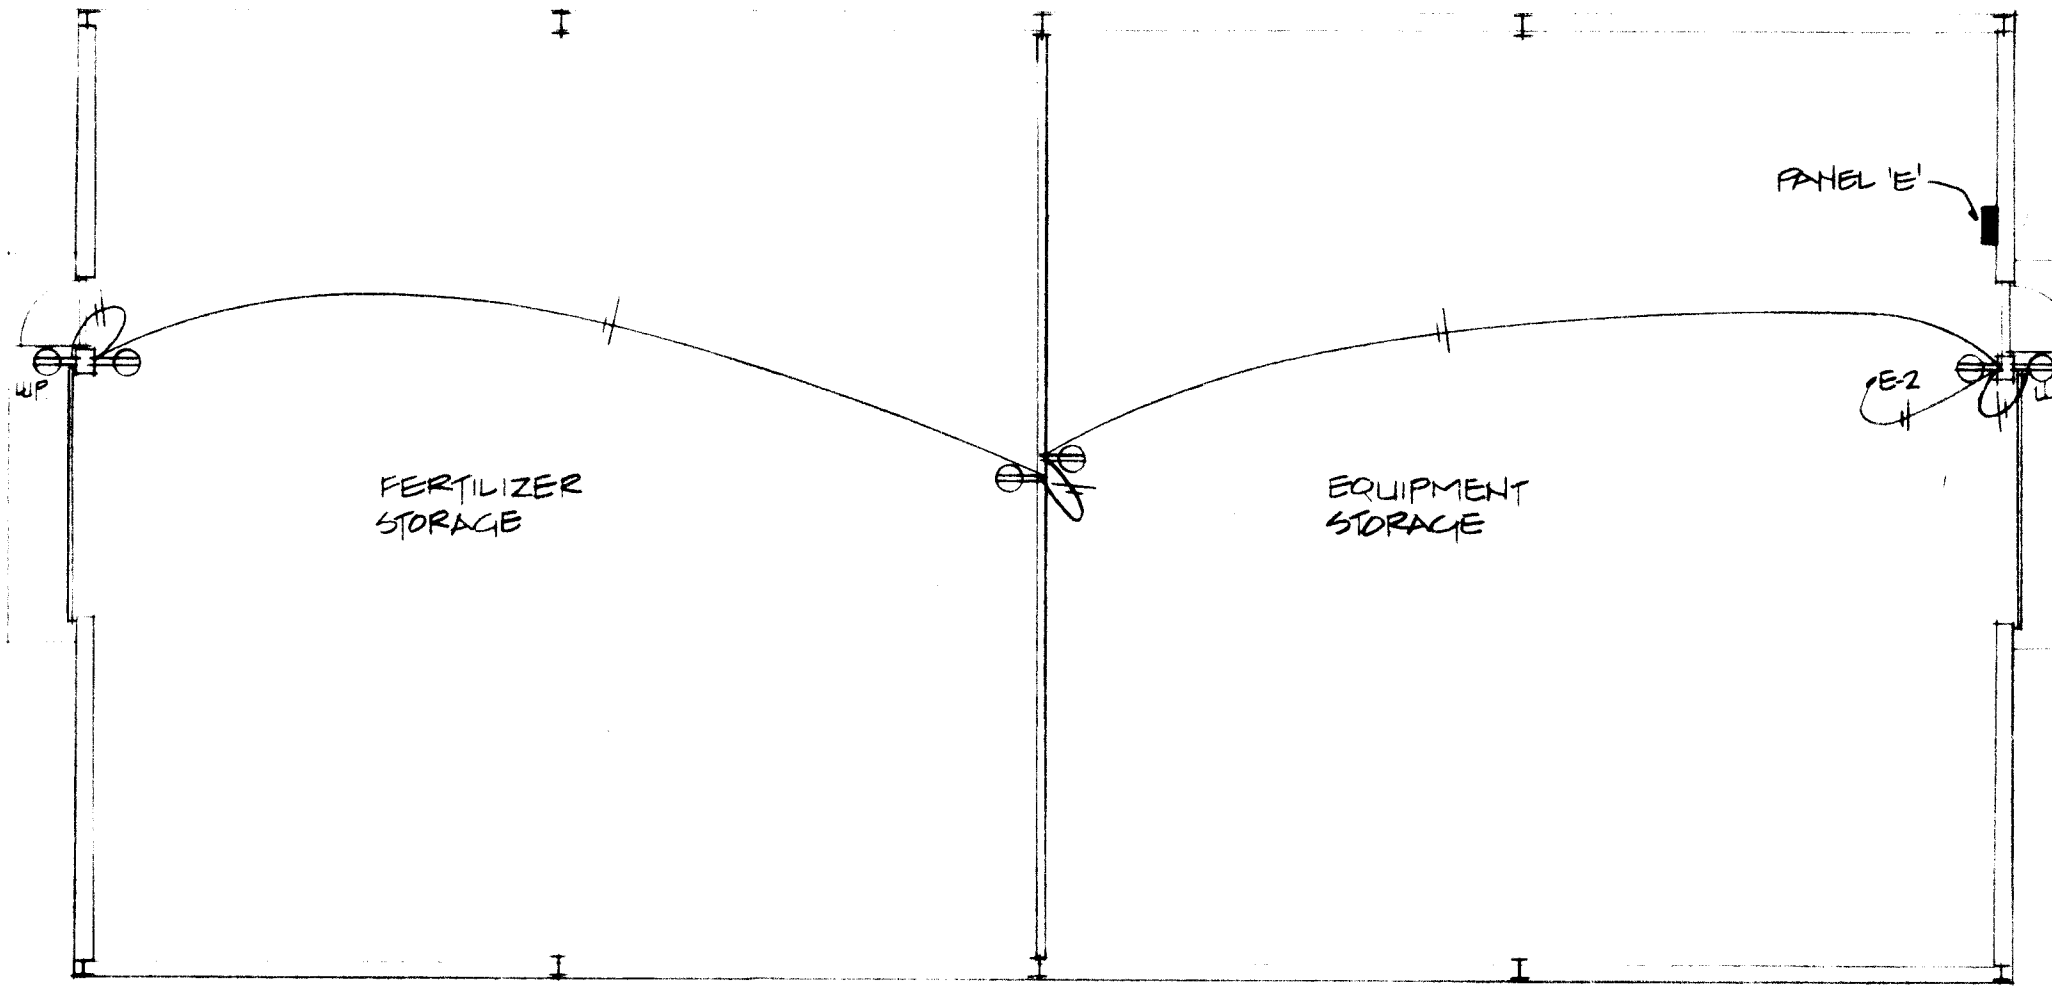


3 ELEC. POWER PLAN - NEW STORAGE BLDG.
10 ADDITIVE ALTERNATE #2 SCALE: 1/8" = 1'-0"

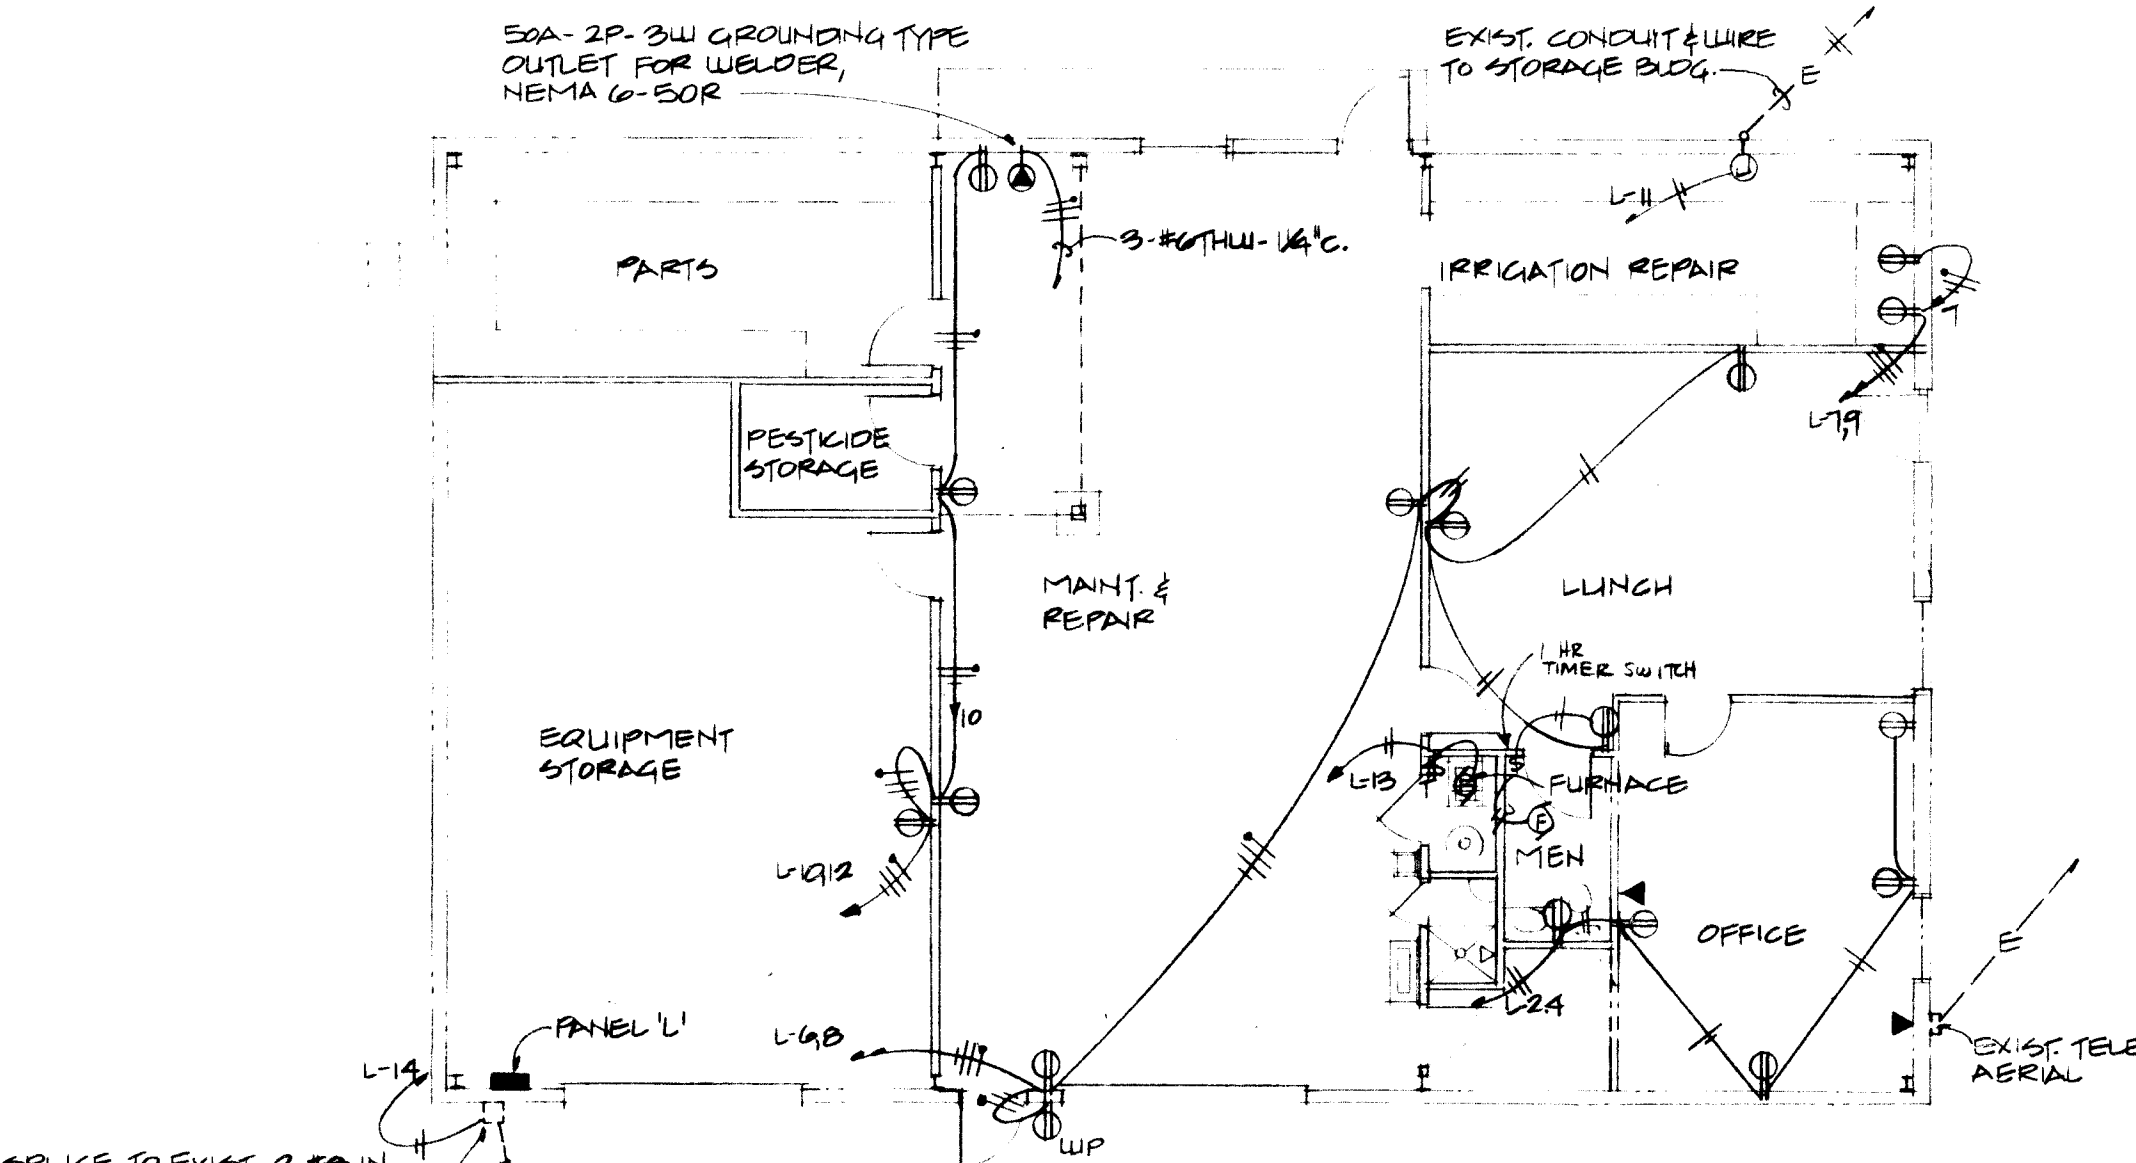


4 ELEC. POWER PLAN - EXIST. MAINT. BLDG.
10 SCALE: 1/8" = 1'-0"


ENERGY CONSERVATION
THESE PLANS AND SPECIFICATIONS
ARE IN COMPLIANCE WITH THE STATE
OF NEW MEXICO ELECTRICAL CODE,
ARTICLE 290, ENERGY CONSERVATION,
AS CERTIFIED BY ME:
Fred J. Telck
FRED J. TELCK

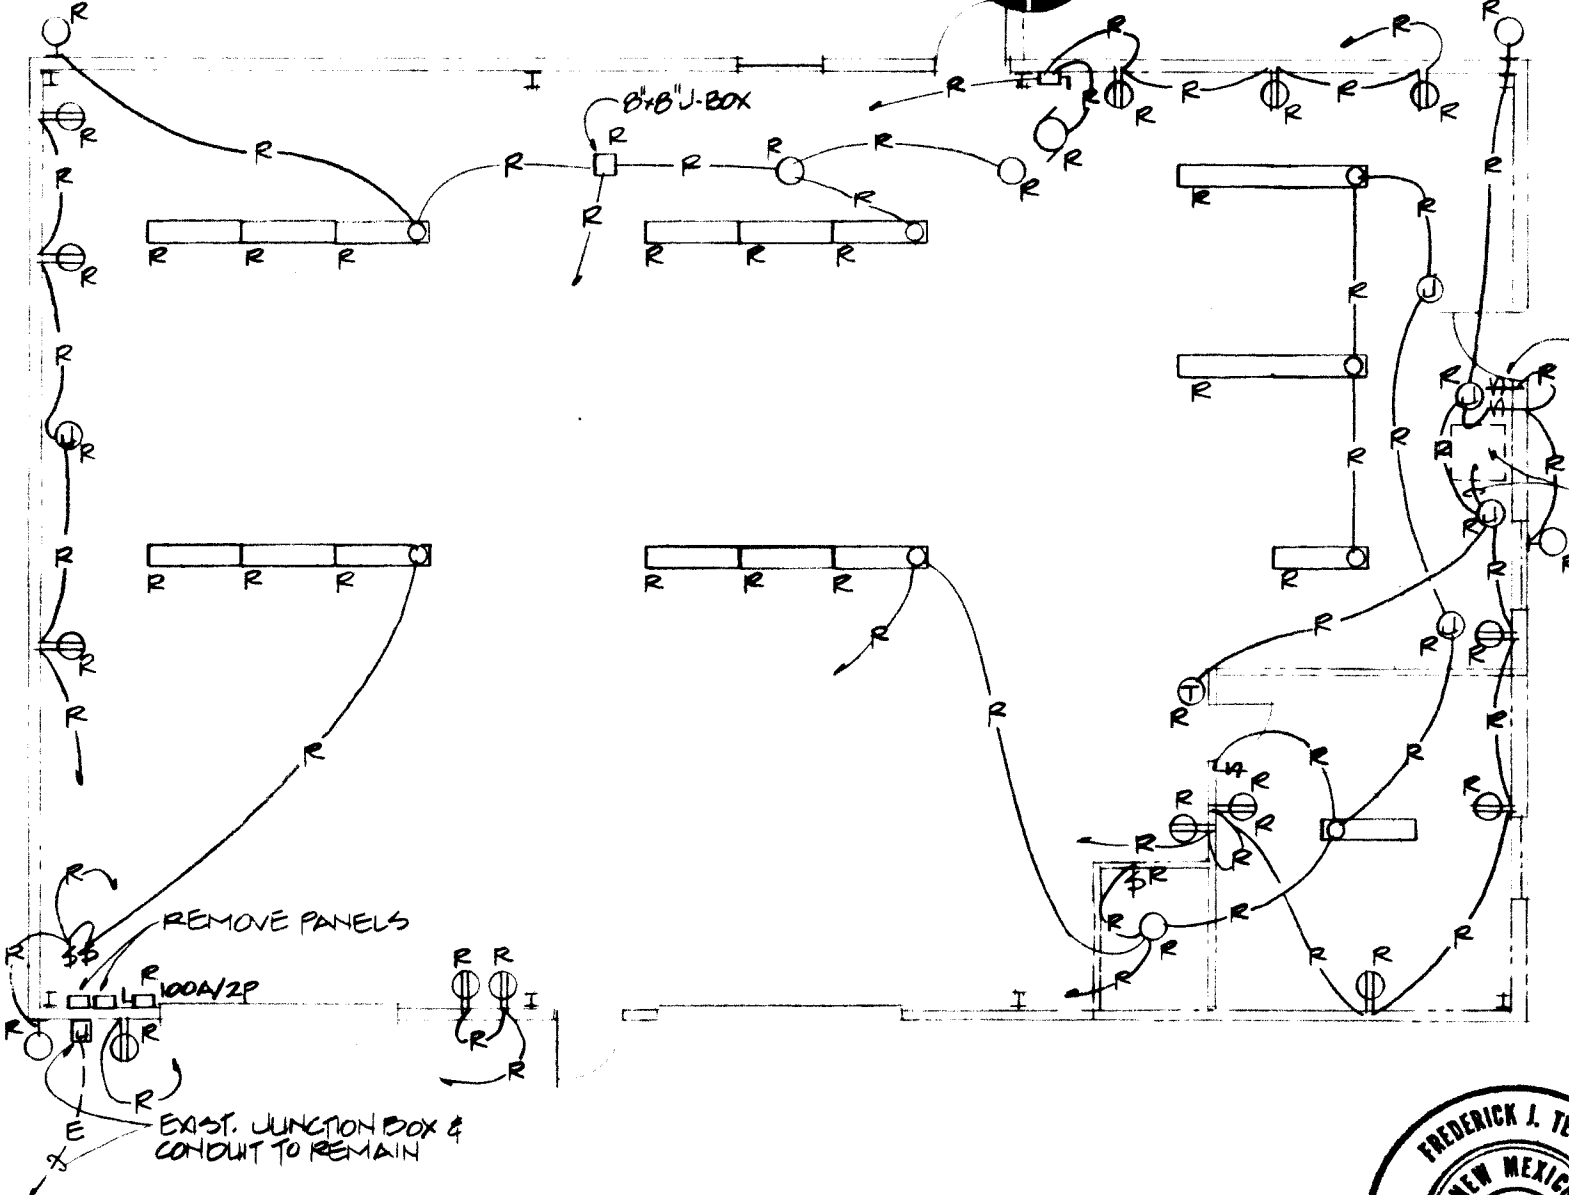

5 ELECTRICAL DEMO & REMOVAL PLAN
10 SCALE: 1/8" = 1'-0"

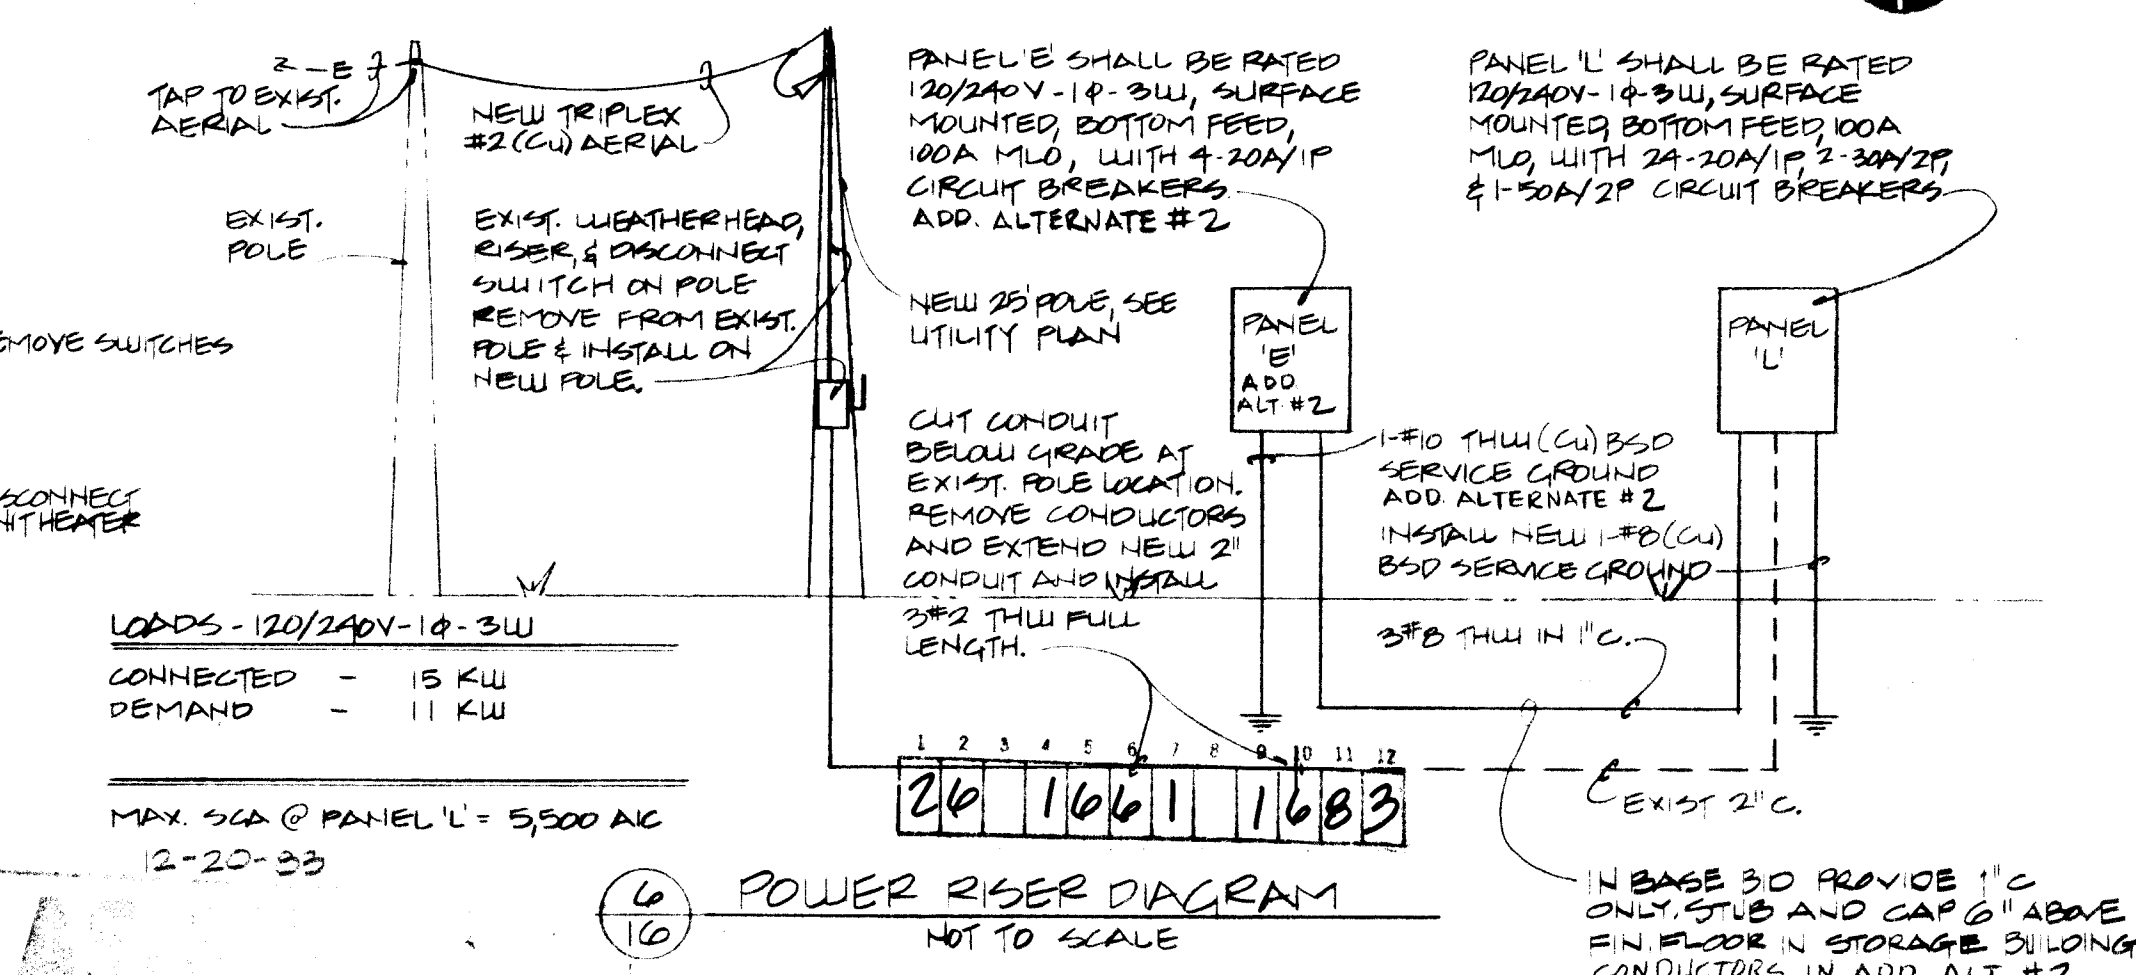

6 POWER RISER DIAGRAM
10 NOT TO SCALE

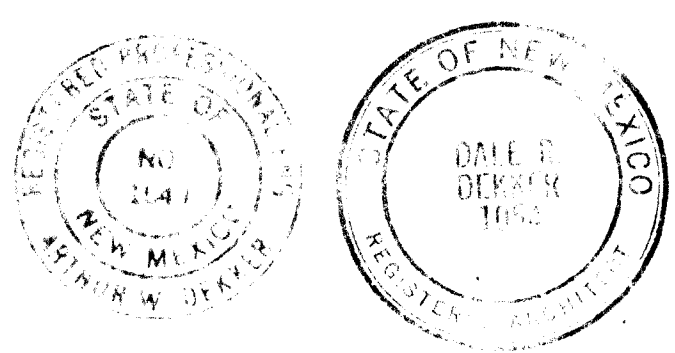

dekker & associates
architects & engineers & planners
100 ALPHE GOLF COURSE 6717 ALPHE GOLF COURSE
ALPHE, NM 87001 505.864.3689

job no. 8200 sheet
dwn by JAH
ckd by FT
issued 2-1-80
update revision
16

PROJECT DATA:

LAND DESCRIPTION SPORTS STADIUM

Tract _____
 Lot(s) _____
 Block _____
 Addition _____
 Zoned _____ Map Reference 2-E-2

STRUCTURAL DESIGN CRITERIA

Roof Live Load 20 PSF
 Floor Live Loads:
 Basement _____
 First 20 PSF OFFICE/LUNCH/20 PSF REPAIR SHOP
 Mezzanine 100 PSF
 Second _____
 Third _____
 Wind Load 25 PSF
 Seismic Zone 2
 Fire Zone _____
 Type of Construction 2-4
 Occupancy B-2
 Stress Values:
 Lumber 2400 F
 Steel 24,000 PSI
 Soil Bearing Capacity 2,000 PSF

CONCRETE STRENGTHS, 28 DAY TEST

Block Fill 2500 PSI
 Floor Slabs, Bond Beams 2500 PSI
 Footings, Walls 2500 PSI
 Exterior Walls, Slabs, Etc. 3000 PSI AIR ENTRAINED

FLOOR AREAS SQ. FT. ALLOWABLE


Basement _____
 First 22,200 (20,000) (20,000)
 Mezzanine _____
 Second _____
 Third _____
 Total Area 22,200 (20,000) (20,000)
 Occupant Load _____
 Parking Required _____
 Parking Provided _____

REFUSE CONTAINERS

OWNER TO PROVIDE AS REQD BY CITY OF ALBUQUERQUE.

GENERAL NOTES

- Affected Contractors to verify exact location of all utilities.
- General Contractor to be responsible for compliance with requirements of city of Albuquerque Dept. of Environmental Health, Air Management Division, regarding control of dust from excavation and grading operations. Contractor to obtain topsoil removal permit.

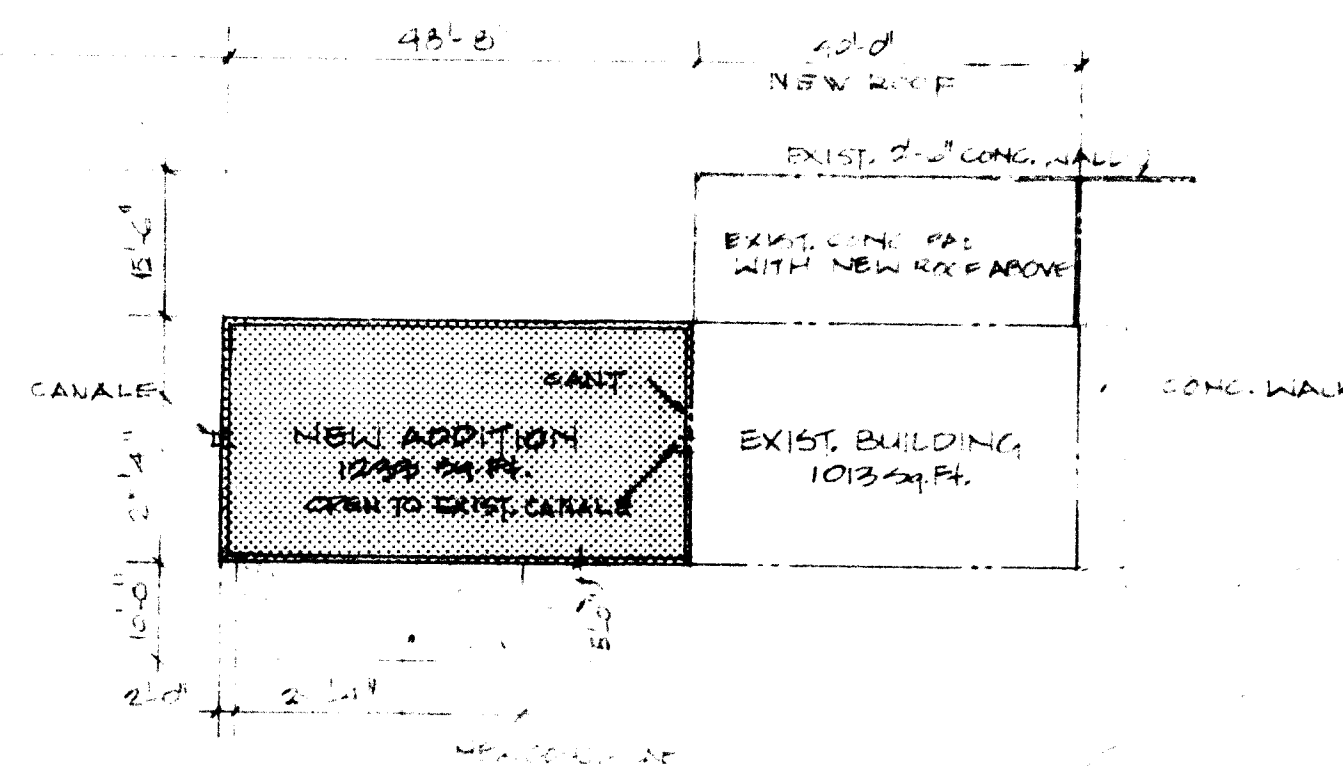


SPORTS STADIUM

SITE PLAN

SCALE: 1" = 20'-0"



NOTE: CONTRACTOR TO VERIFY AND LOCATE ALL UNDERGROUND UTILITIES PRIOR TO EXCAVATION.

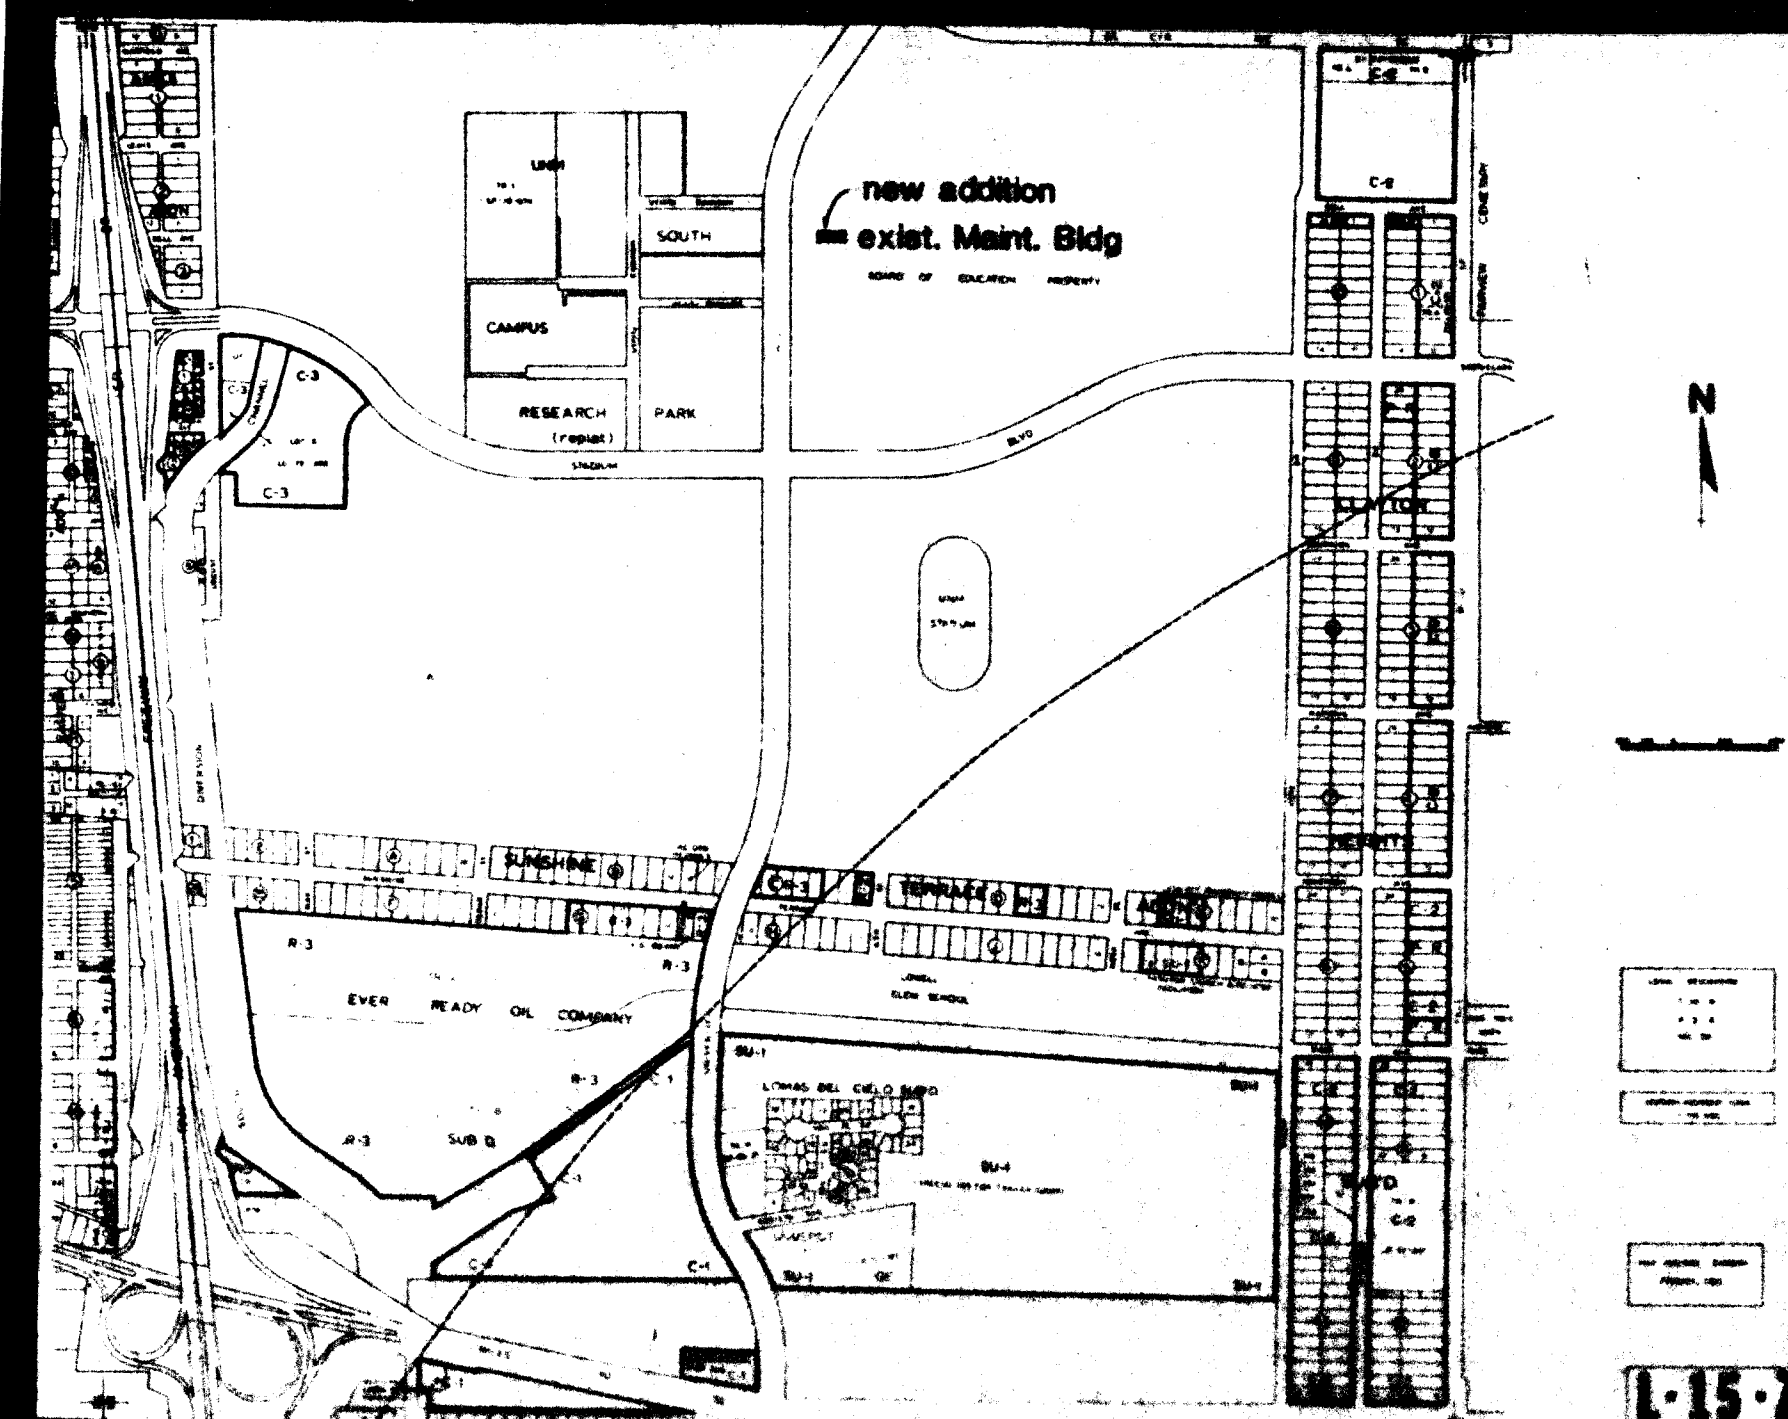

LOCATION PLAN

INDEX TO DRAWINGS

ARROYO DEL SOL	SPORTS STADIUM
1 SITE PLAN, PROJECT DATA, ENERGY CALCULATIONS	17 SITE PLAN, PROJECT DATA, ENERGY CALCULATIONS
2 DRAINAGE INFORMATION AND DETAILS	18 DRAINAGE INFORMATION AND DETAILS
3 DEMOLITION AND REMOVAL PLAN AND NOTES	19 DEMOLITION AND REMOVAL, FLOOR PLAN, SCHEDULES
4 FLOOR PLAN, FOUNDATION & FRAMING, SCHEDULES	20 ELEVATIONS AND SECTIONS
5 ELEVATIONS AND SECTIONS	21 UTILITY SITE PLAN, HVAC AND PLUMBING
6 DETAILS	22 ELECTRICAL LIGHTING AND POWER
7 UTILITY SITE PLAN, HVAC AND PLUMBING	
8 ELECTRICAL, LIGHTING AND POWER	
LOS ALTOS	PUERTO DEL SOL
9 SITE PLAN, PROJECT DATA, ENERGY CALCULATIONS	23 SITE PLAN, PROJECT DATA, ENERGY CALCULATIONS
10 DRAINAGE INFORMATION AND CALCULATIONS	24 DRAINAGE INFORMATION AND DETAILS
11 DEMOLITION AND REMOVAL PLAN AND NOTES	25 DEMOLITION AND REMOVAL, FLOOR PLANS, SCHEDULES
12 FLOOR PLAN, FOUNDATION & FRAMING, SCHEDULES	26 ELEVATIONS AND SECTIONS
13 ELEVATIONS, SECTIONS	27 DETAILS
14 DETAILS	28 UTILITY SITE PLAN, HVAC, PLUMBING
15 UTILITY SITE PLAN, HVAC AND PLUMBING	29 ELECTRICAL LIGHTING AND POWER
16 ELECTRICAL LIGHTING AND POWER	

MAINTENANCE AND STORAGE FACILITIES PARKS AND RECREATION DEPARTMENT CITY OF ALBUQUERQUE

SPORTS STADIUM

UBC CHAPTER 53 REQUIREMENTS

PROJECT: SPORTS STADIUM MAINTENANCE BLDG. BLDG. TYPE: 202 Page 1 of 1

	Summer	Winter	Degree Days	Roof, Max.	Wall, Max.	OTIV, Max.
Inside	78°F	70°F	2,000	0.09	0.04	10,000
Outside	91°F	17°F		0.22	0.11	
Difference	13°F	53°F				

WALL TYPE "A": TO	WALL TYPE "B": TO	WALL TYPE "C": TO	WALL TYPE "D": TO	WALL TYPE "E": TO	WALL TYPE "F": TO	WALL TYPE "G": TO	WALL TYPE "H": TO	WALL TYPE "I": TO	WALL TYPE "J": TO	WALL TYPE "K": TO	WALL TYPE "L": TO	WALL TYPE "M": TO	WALL TYPE "N": TO	WALL TYPE "O": TO	WALL TYPE "P": TO	WALL TYPE "Q": TO	WALL TYPE "R": TO	WALL TYPE "S": TO	WALL TYPE "T": TO	WALL TYPE "U": TO	WALL TYPE "V": TO	WALL TYPE "W": TO	WALL TYPE "X": TO	WALL TYPE "Y": TO	WALL TYPE "Z": TO	
0.5A	0.1	0.1	0.1	0.1	0.1	0.1	0.1	0.1	0.1	0.1	0.1	0.1	0.1	0.1	0.1	0.1	0.1	0.1	0.1	0.1	0.1	0.1	0.1	0.1	0.1	0.1
0.5B	0.1	0.1	0.1	0.1	0.1	0.1	0.1	0.1	0.1	0.1	0.1	0.1	0.1	0.1	0.1	0.1	0.1	0.1	0.1	0.1	0.1	0.1	0.1	0.1	0.1	0.1
WALLS $U_o = \frac{822(0.26) + 544(0.3) + 12(0.58) + 4(0.59) + 100(0.56)}{1520}$
 $U_o = 0.24 < 0.32 \therefore OK$


ROOF $U_o = \frac{1055(0.05)}{1055}$
 $U_o = 0.05 < 0.09 \therefore OK$

WALLS $U_o = \frac{822(0.26) + 544(0.3) + 12(0.58) + 4(0.59) + 100(0.56) + 100(0.56)}{1520}$
 $U_o = 0.24 < 0.32 \therefore OK$

ROOF $U_o = \frac{1055(0.05)}{1055}$
 $U_o = 0.05 < 0.09 \therefore OK$

TOTAL HEAT LOSS (BTU)
 MAX. BY CODE
 ROOF $0.05 \times 1055 \times 53 = 29,250$
 WALLS $0.24 \times 1520 \times 53 = 19,344$
 TOTAL $48,594$


ACTUAL
 ROOF $0.05 \times 1055 \times 53 = 29,250$
 WALLS $0.24 \times 1520 \times 53 = 19,344$
 TOTAL $48,594$

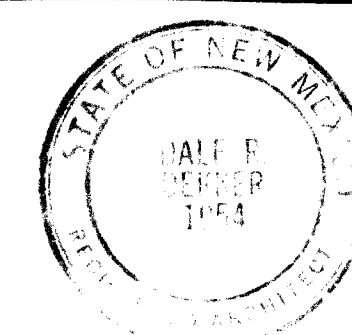

dekker & associates
 architects & engineers & planners
 2403 San Mateo, N.E. suite P15 Albuquerque, New Mexico 87110 505 384 3689
 SPORTS STADIUM university and stadium s e
 albuquerque n m


job no. 0208 sheet
 drn. by JCH
 ckd. by AWD
 issued 1-1-82
 no date revision
 17
 of 29

UNIVERSITY BLVD SE

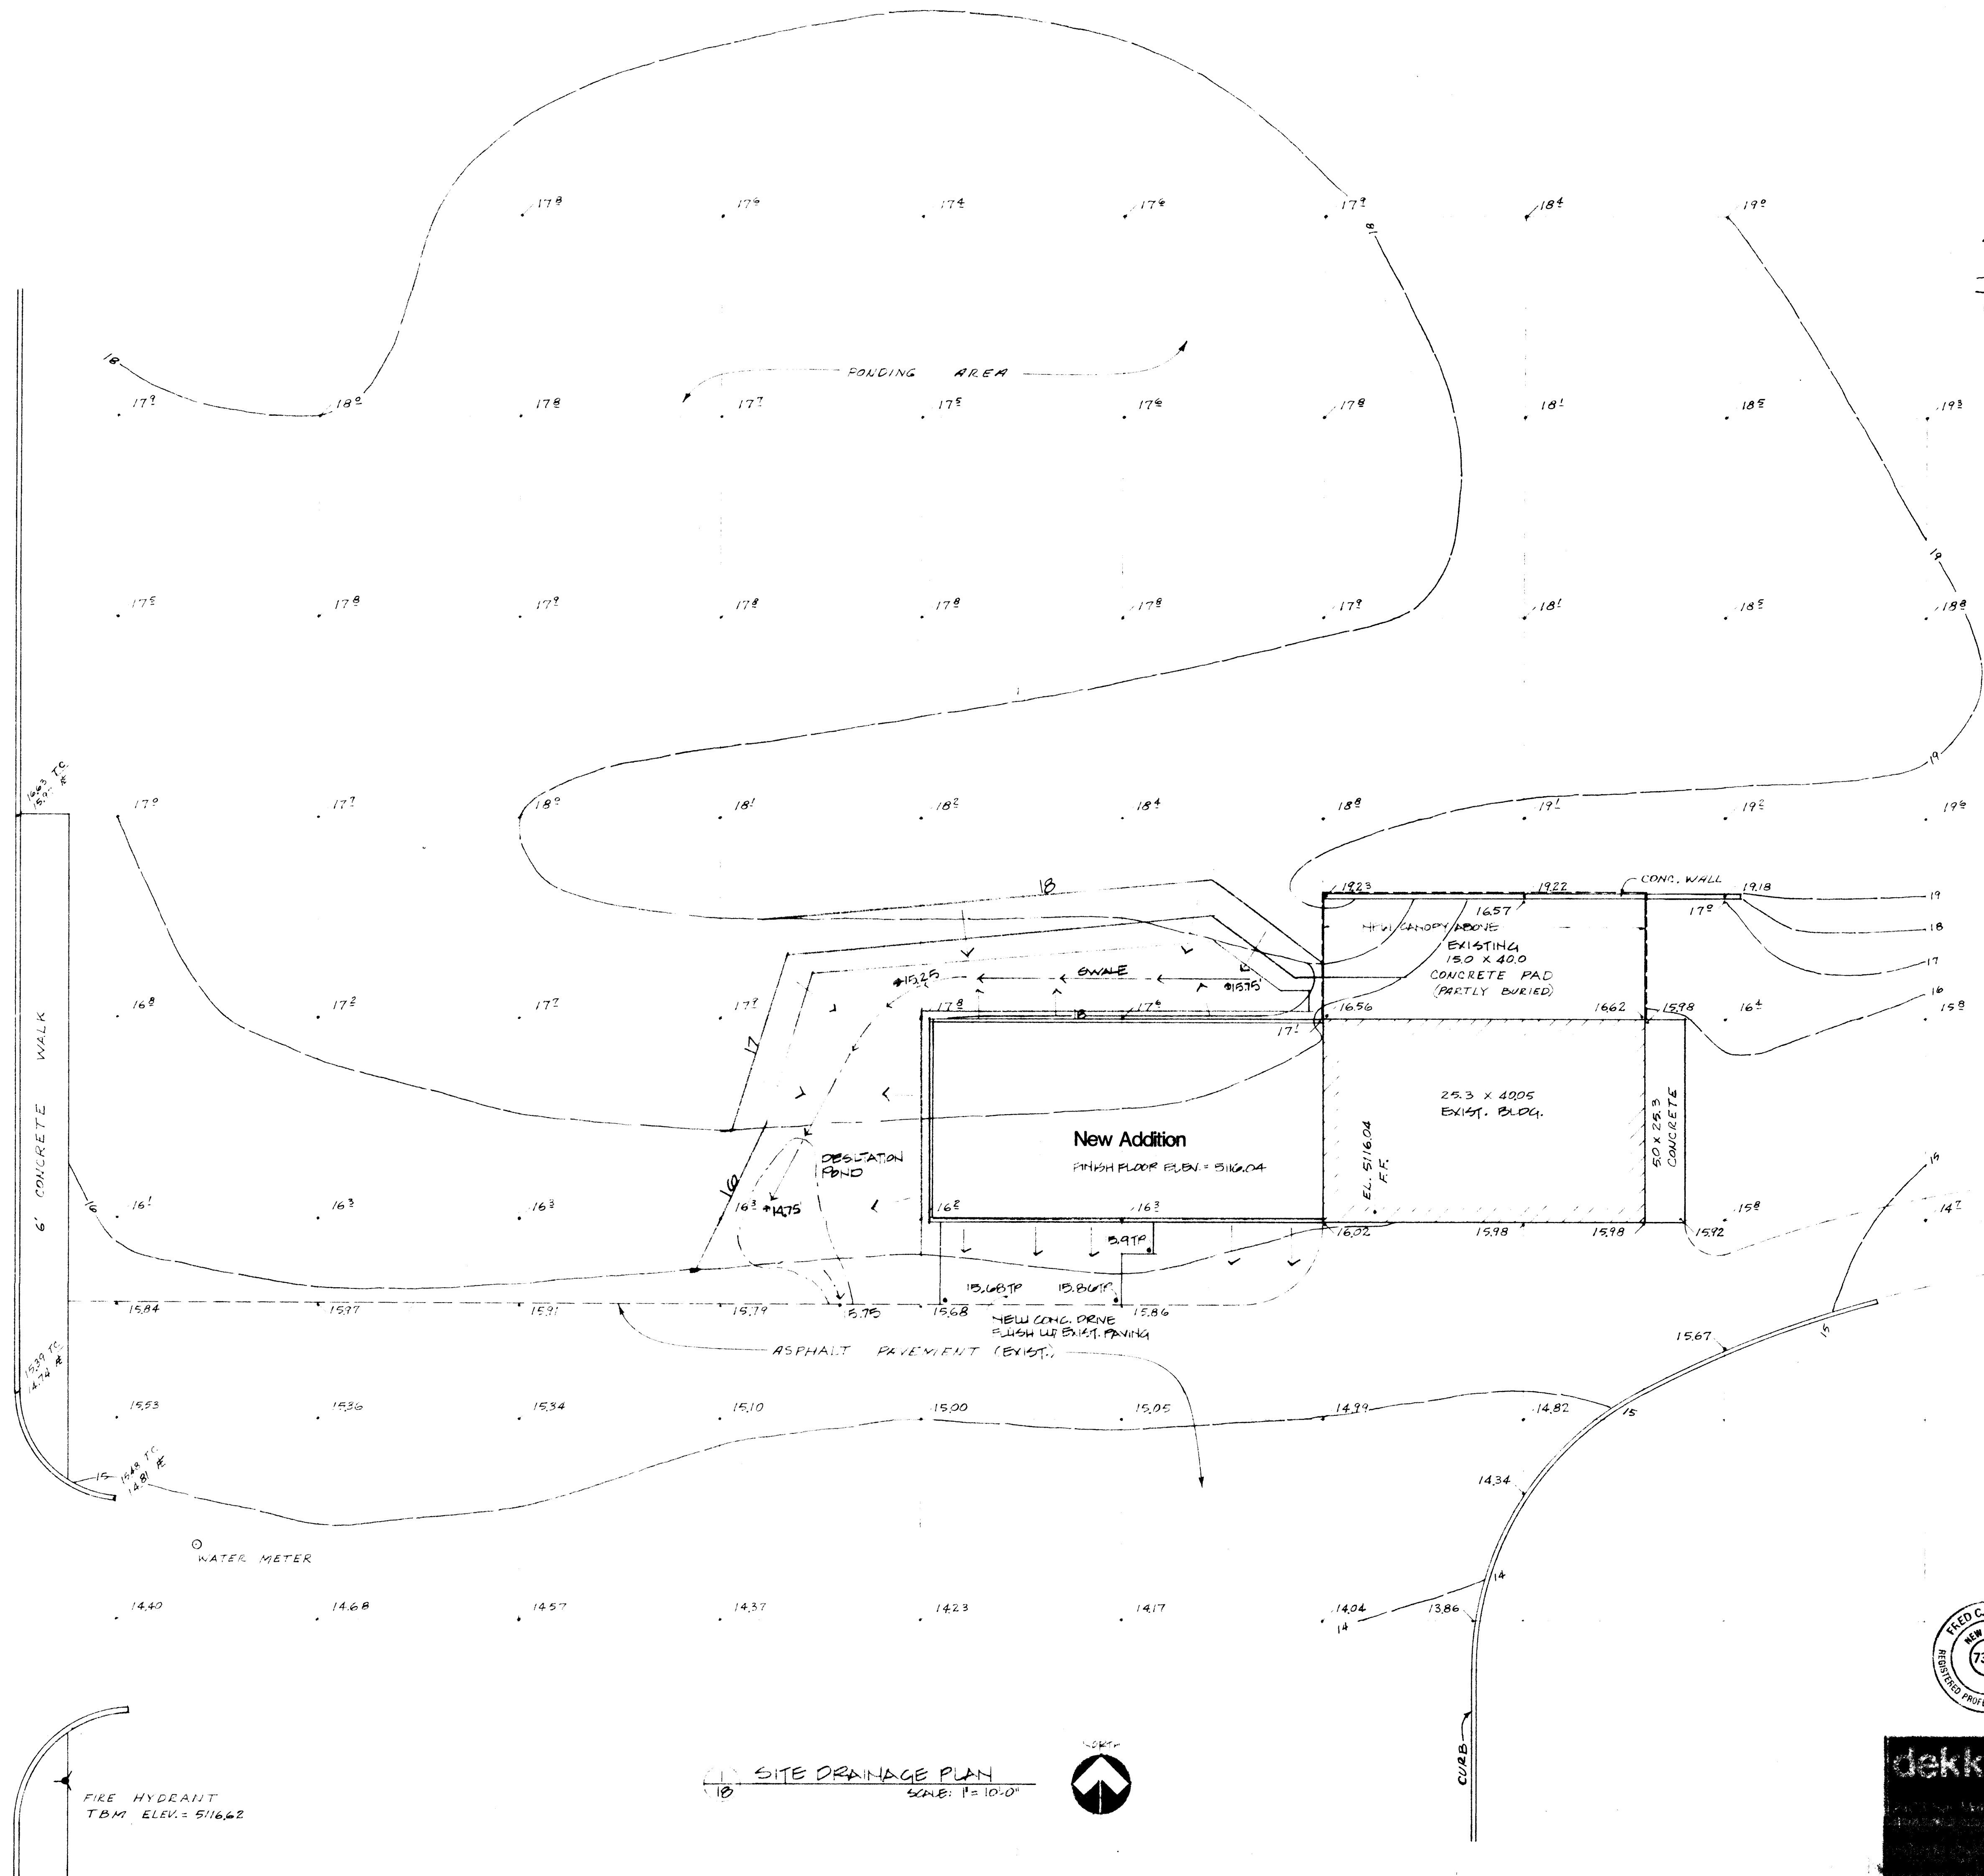

SYMBOL LEGEND

- 17.8 EXIST. SPOT ELEV.
- 15.25 NEW SPOT ELEV.
- EXIST. CONTOUR
- NEW CONTOUR
- 5.91 TP. NEW SPOT ELEV. - TOP OF PAVING

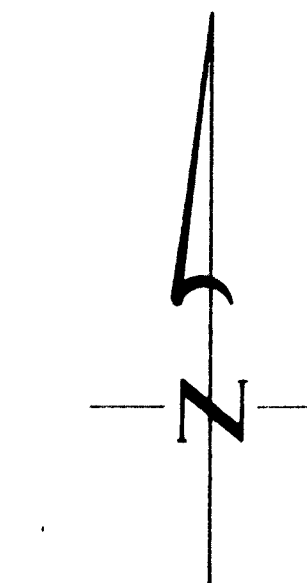

SCALE: 1" = 10'-0"

NOTES:

ELEVATIONS ARE BASED ON STATION "K-159", A BRASS CAP SET IN CONCRETE FOR THE NORTH 1/4 CORNER OF SECTION 28. ELEVATION = 5117.817 (MSLD 1929)

SET TBM: + ON NE BONNET BOLT ON FH. ELEVATION = 5116.62


25' GRID ORIGINATING AT NW CORNER OF BLDG. BASE LINES 25' NORTH AND 75' SOUTH FROM NORTH EDGE OF BLDG.

1 FT CONTOUR INTERVALS

DRAINAGE CALCULATIONS ARE BASED ON THE 100 YEAR, 6 HOUR STORM, BY USE OF THE RATIONAL METHOD.

I hereby certify that I am Registered Land Surveyor in the State of New Mexico, and that this plan was prepared from a true and correct survey made by me or under my supervision, and that the same is true and correct to the best of my knowledge and belief.

Santiago O. Gutierrez, L.S. #4251

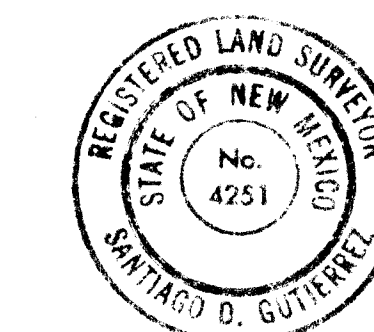

12-25-93

PR. 10/1/93

DRAINAGE CALCULATIONS		
	EXISTING	PROPOSED
AREA (A)	1465 SQ. FT.	1465 SQ. FT.
TO	10 MINUTES (1/4")	10 MINUTES (1/4")
I	5.85	5.85
C	0.20*	0.25
Q (CFS)	21.2 CFS	0.19 CFS**
Q (INCREASE)		0.07 CFS
V = CFS		
V	2.4"	2.4"
V (INCREASE)		
V	178.8 CU. FT.	218.35 CU. FT.
V (INCREASE)		102.55 CU. FT.**
POINT OF OVERFLOW	OVERLAND FLOW TO THE SOUTH	OVERLAND FLOW TO THE SOUTH

NOTES:
 * A 0.00 'C' VALUE IS HIGH FOR EXPOSED BARTH, BUT JUSTIFIED DUE TO THE HARD PACK CONDITIONS OF THIS NATURAL GROUND.
 ** THESE VALUES INDICATE MINIMAL INCREASES, AND SHOULD NOT ADVERSELY AFFECT THE AREAS DRAINAGE CHARACTERISTICS.




1661

26 1661 1883

dekker & associates
 architects & engineers

10 SITE DRAINAGE PLAN
 SCALE: 1" = 10'-0"



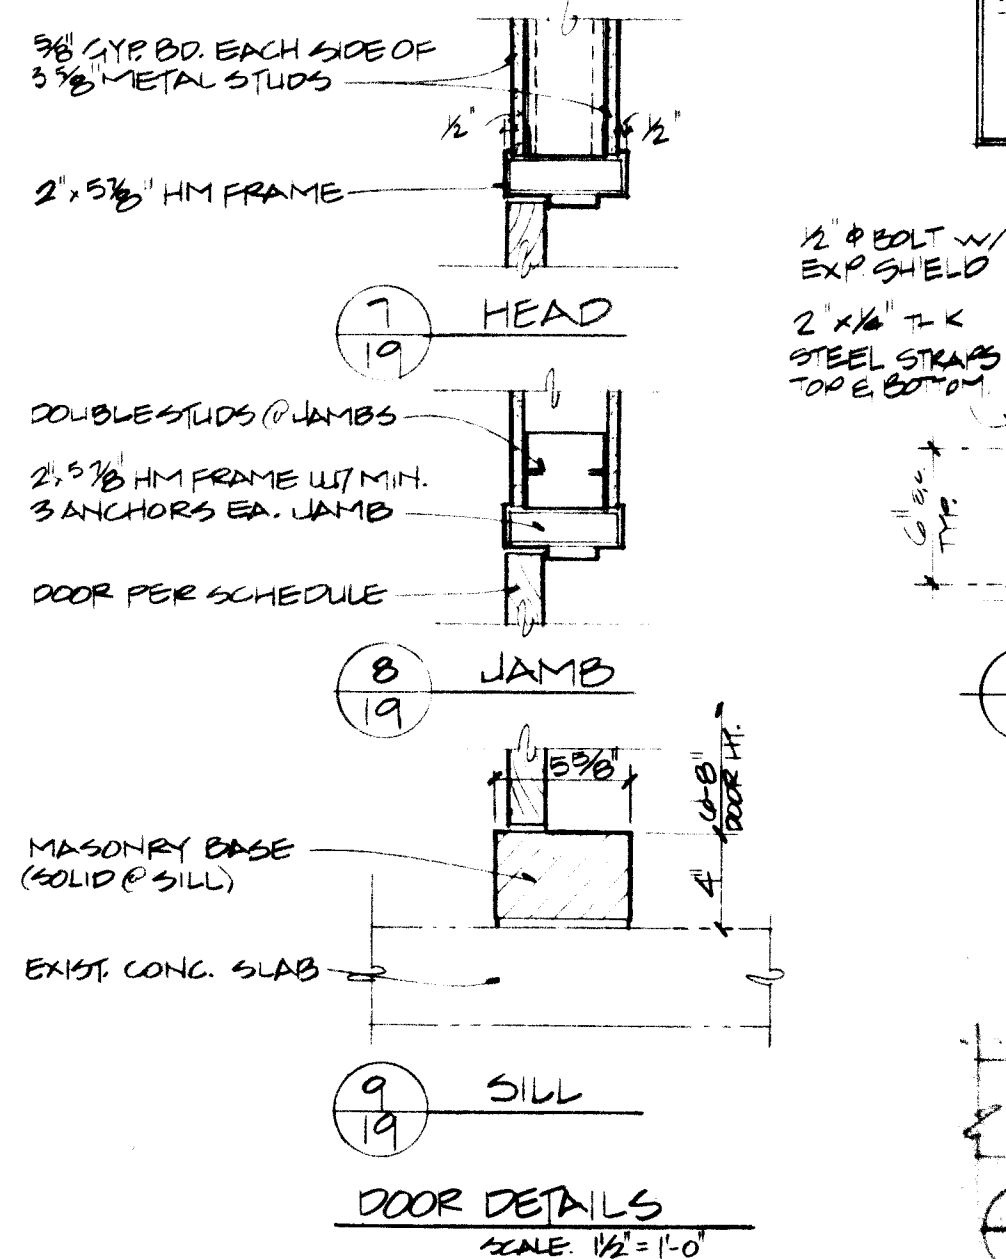

DOOR TYPES


WINDOW TYPES









FINISH SCHEDULE

	FLOOR	BASE	WALLS				CEILING				REMARKS			
	SALES ON TEMP. CONG.	EXPOSED CONC.	VINYL MASSES, TILE	4" VINYL	4" MASONRY	GYPSO- TAPE, EXPOSED ONLY	GYPSO- TAPE, 1/2" BMT	EXPOSED MASONRY	EXPOSED STRUCT.	TYP. GYPSO- TAPE, EXPOSED ONLY	GYPSO- TAPE, 1/2" BMT	EXPOSED MASONRY	HEIGHT OR STRUCTURE AFF.	
WALL & BASE FINISH ORIENTATION														1. ALL FINISHES SHALL COMPLY WITH USC TABLE H2 42 B.
ROOM OR AREA														2. PROVIDE VINYL REDUCER STRIP @ DISCONTINUOUS EDGE OF VINYL TILE FLOOR FINISH.
SPECIAL ITEMS	●					●	●	●	●				10'-6"±	
FERTILIZER STOR.	●					●	●	●	●				10'-6"±	
EQUIPMENT STOR.	●					●	●	●	●				10'-6"±	
OFFICE		●	●			●	●	●				●	8'-0"	
LUNCH		●	●			●	●	●				●	8'-0"	
FLAM STOR.	○		●			●	●	●	○			○	10'-6"±	
MAINT. & REPAIR	○					○	○	○	○			○	10'-6"±	
DUKES STORAGE	○					○	○	○	○			○	10'-6"±	
SAND STORAGE	○					○	○	○	○			○	10'-6"±	OPEN @ EAST & WEST END THEREFORE NO FINISHES

SYMBOLS:


- NEW CONST.
- EXIST. CONST.
- NEW & EXIST. CONST. - SEE PLANS

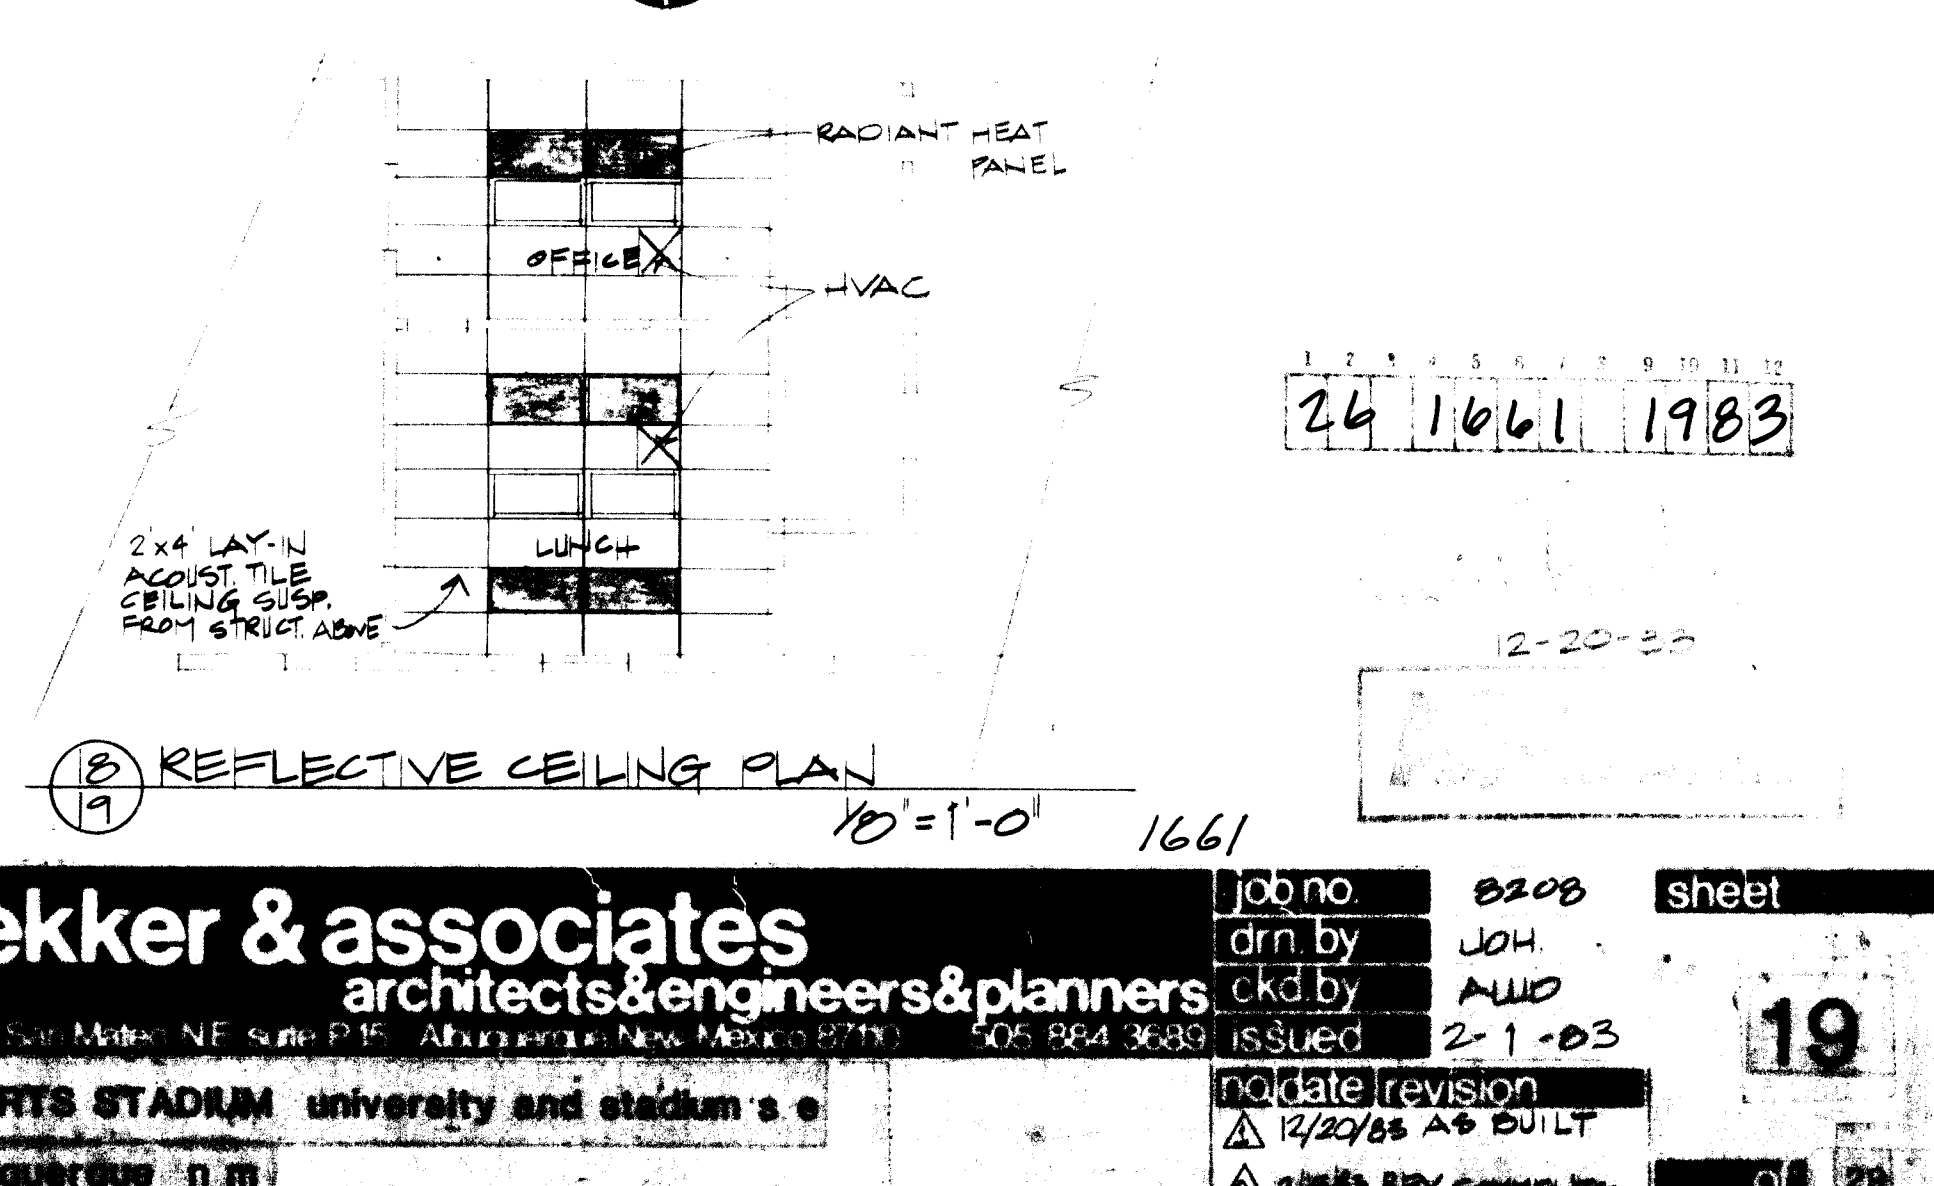

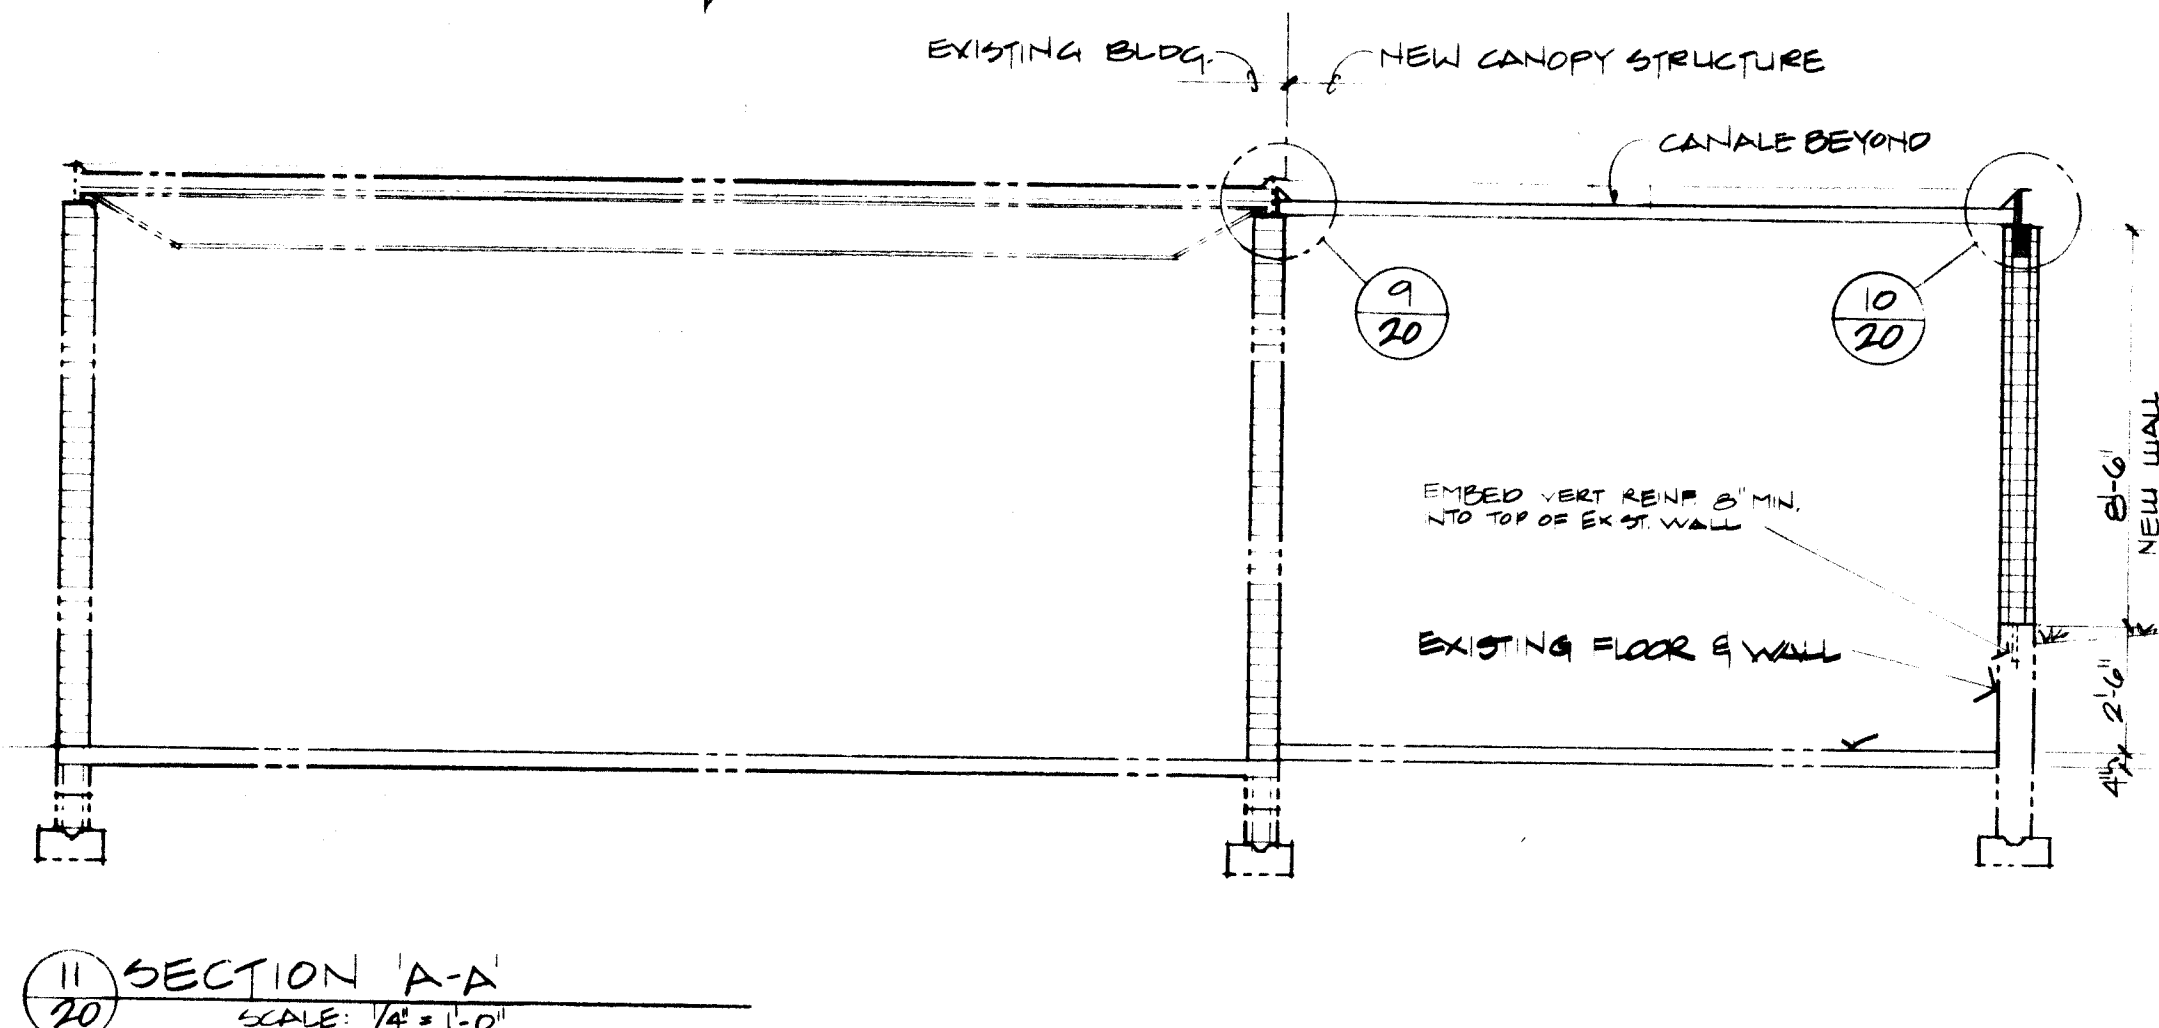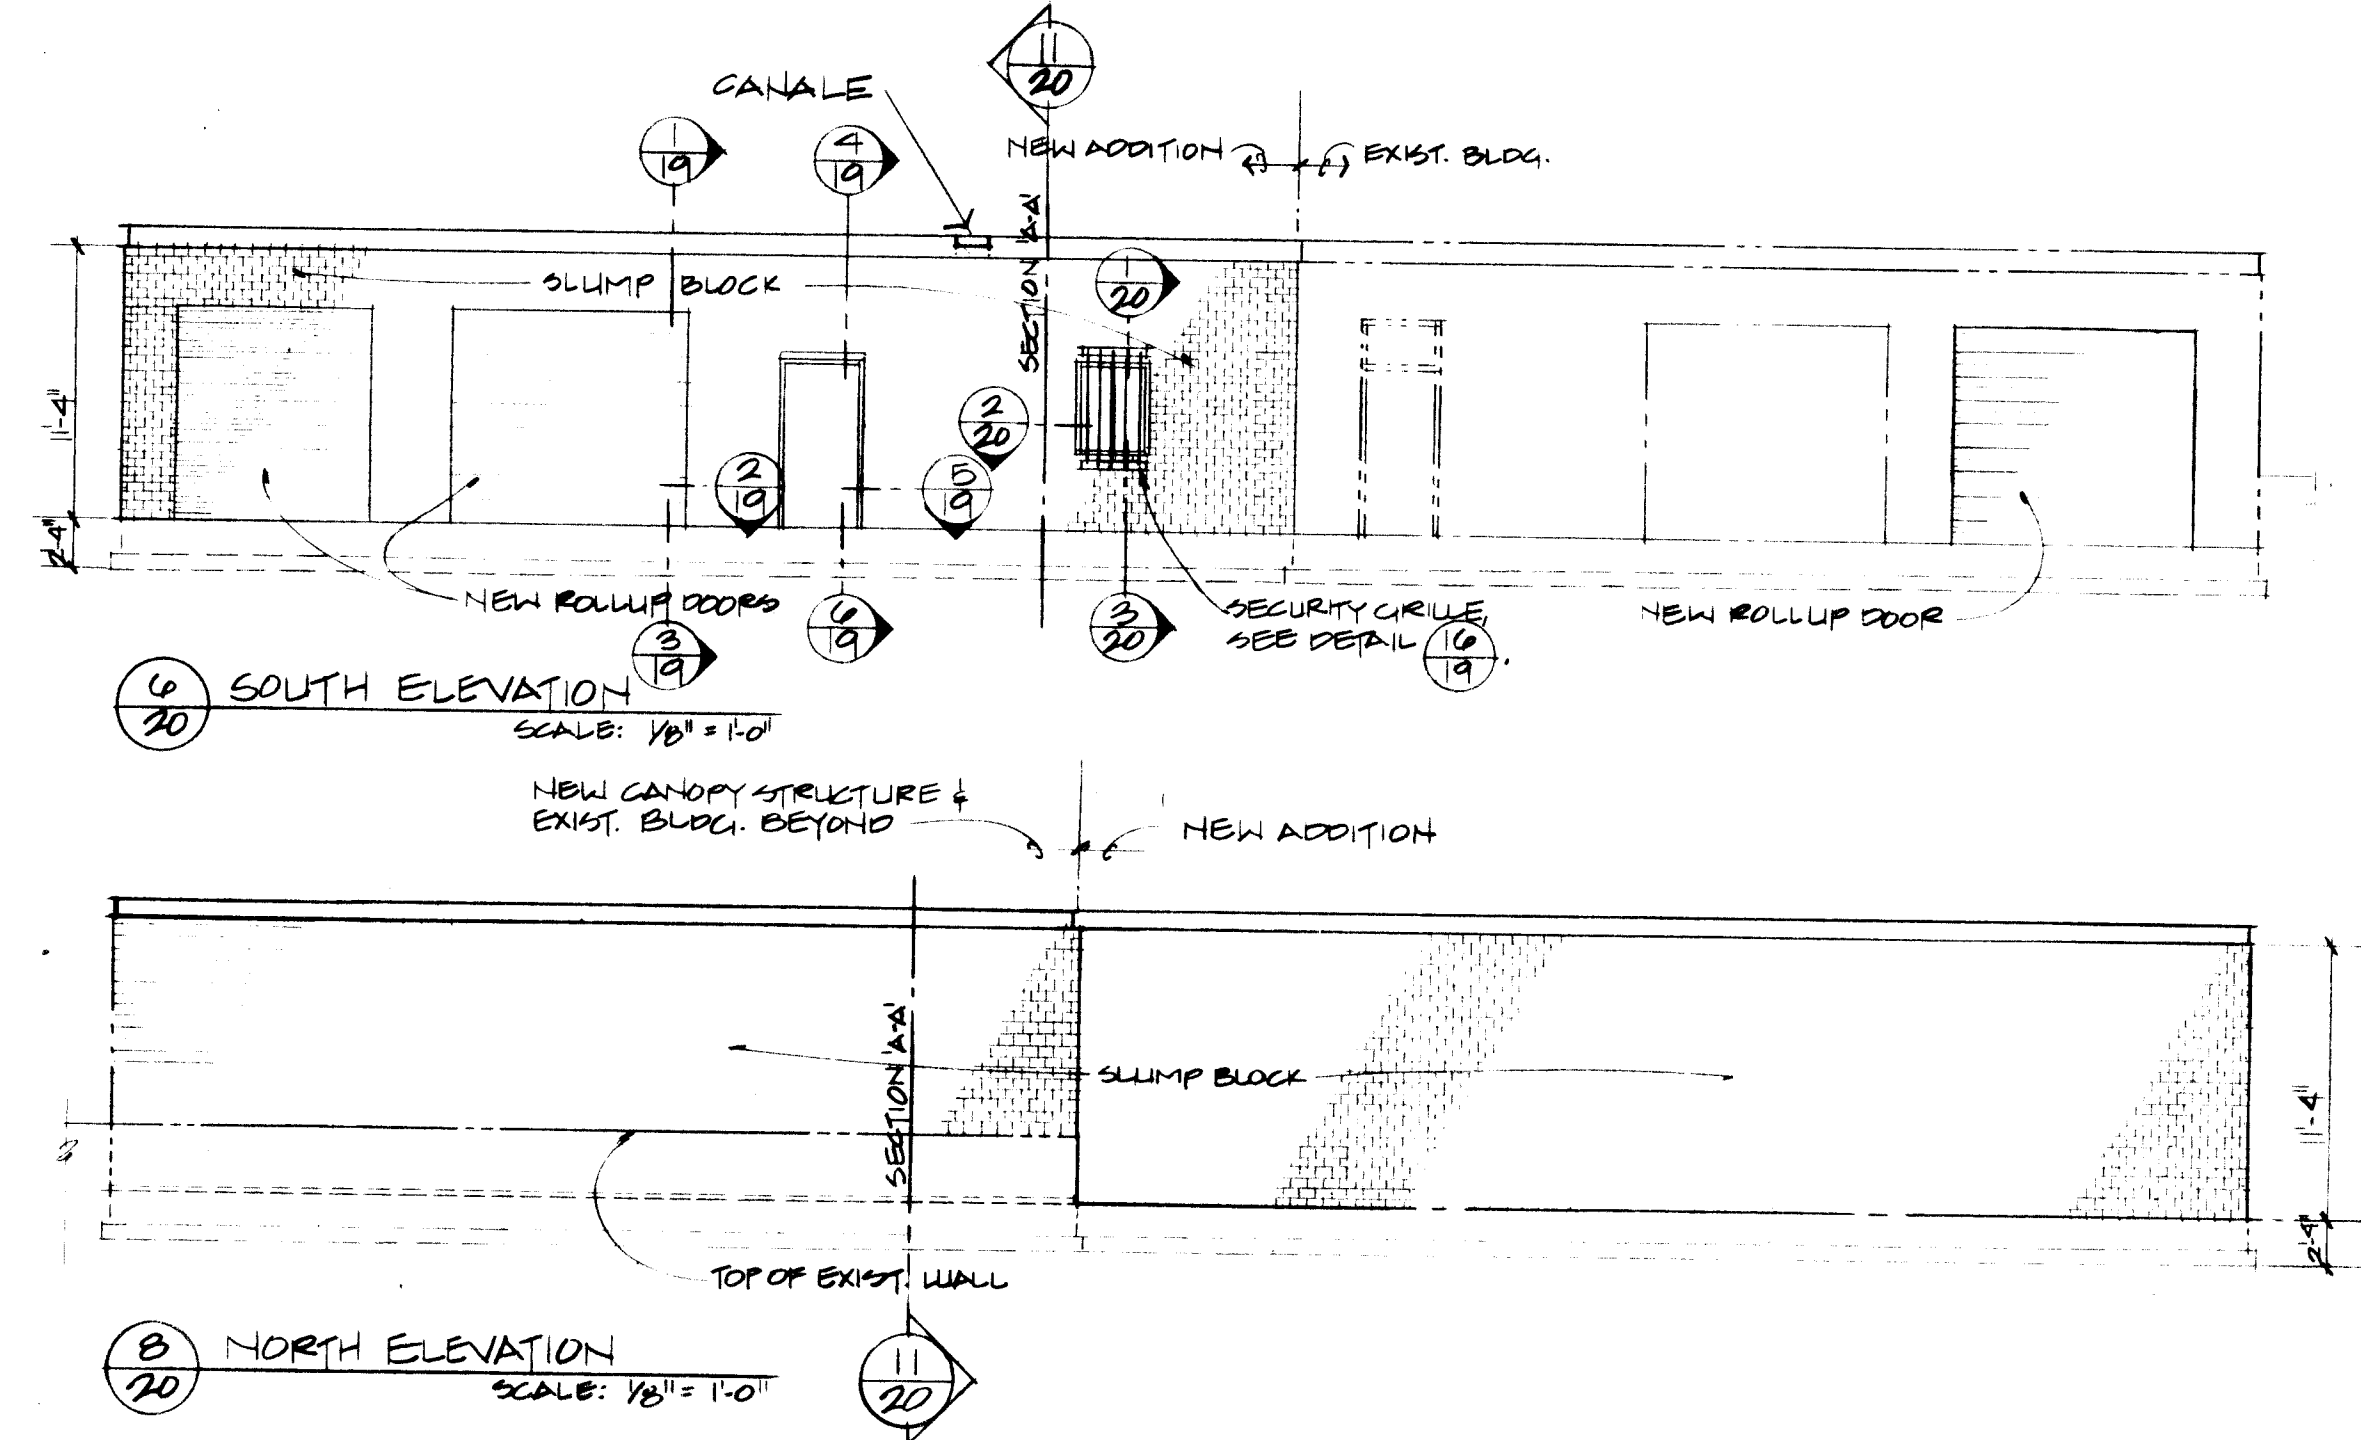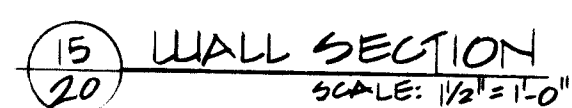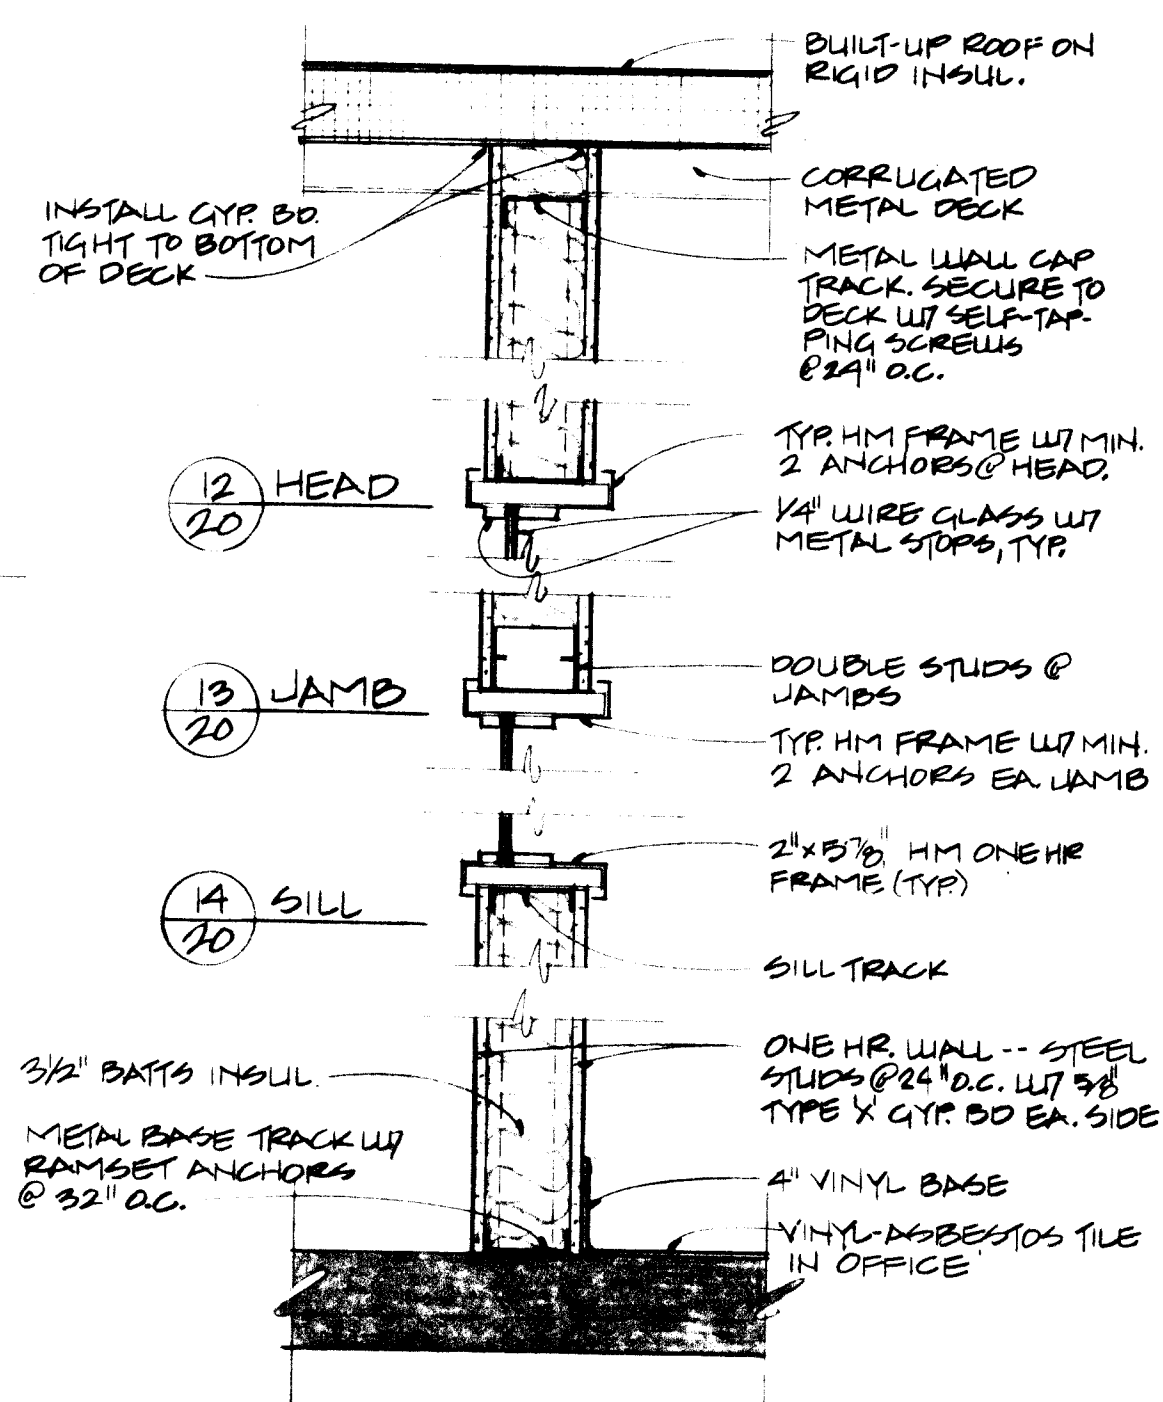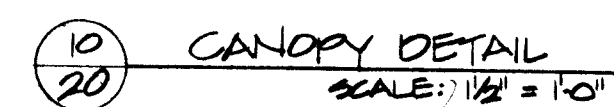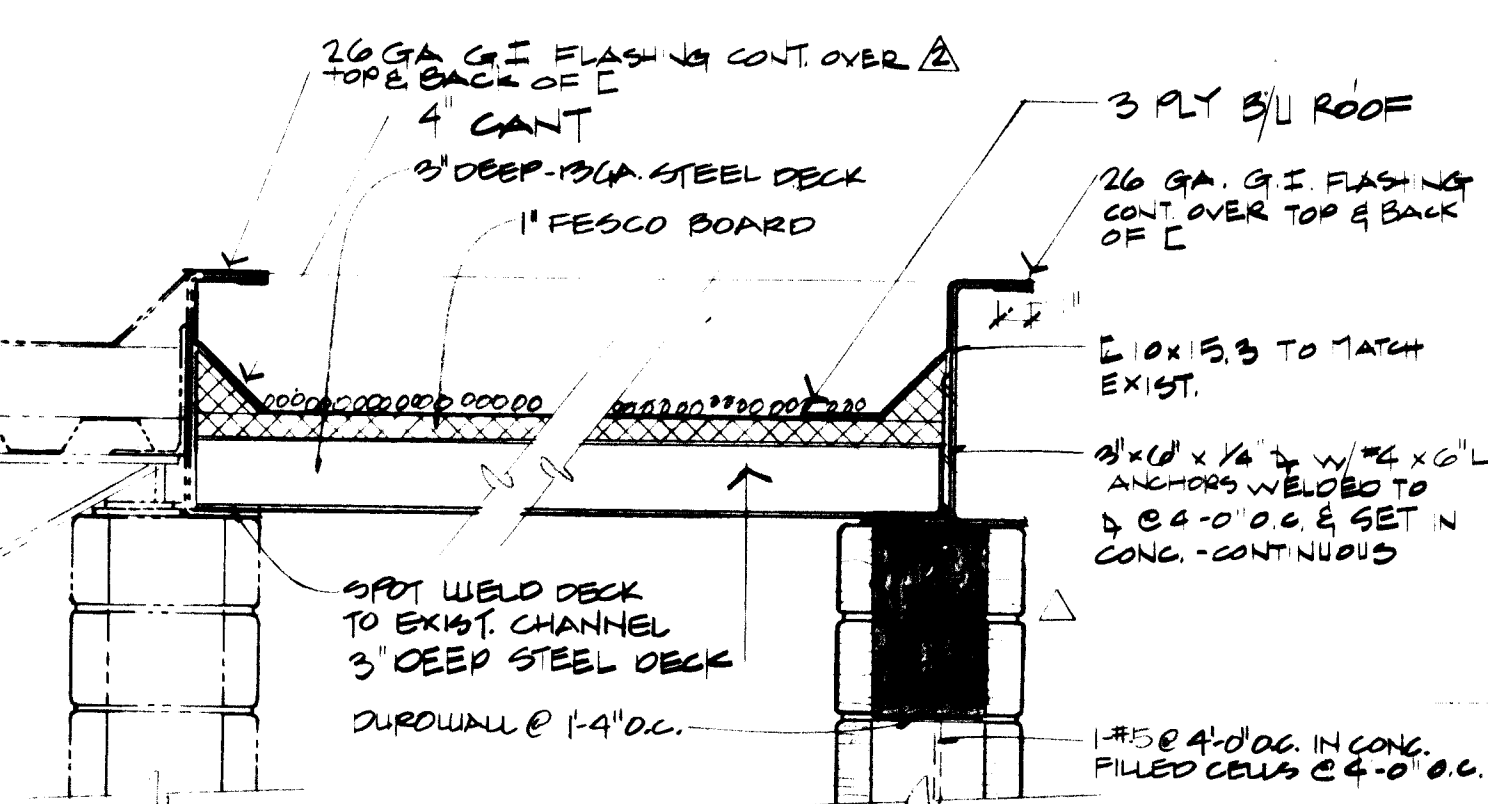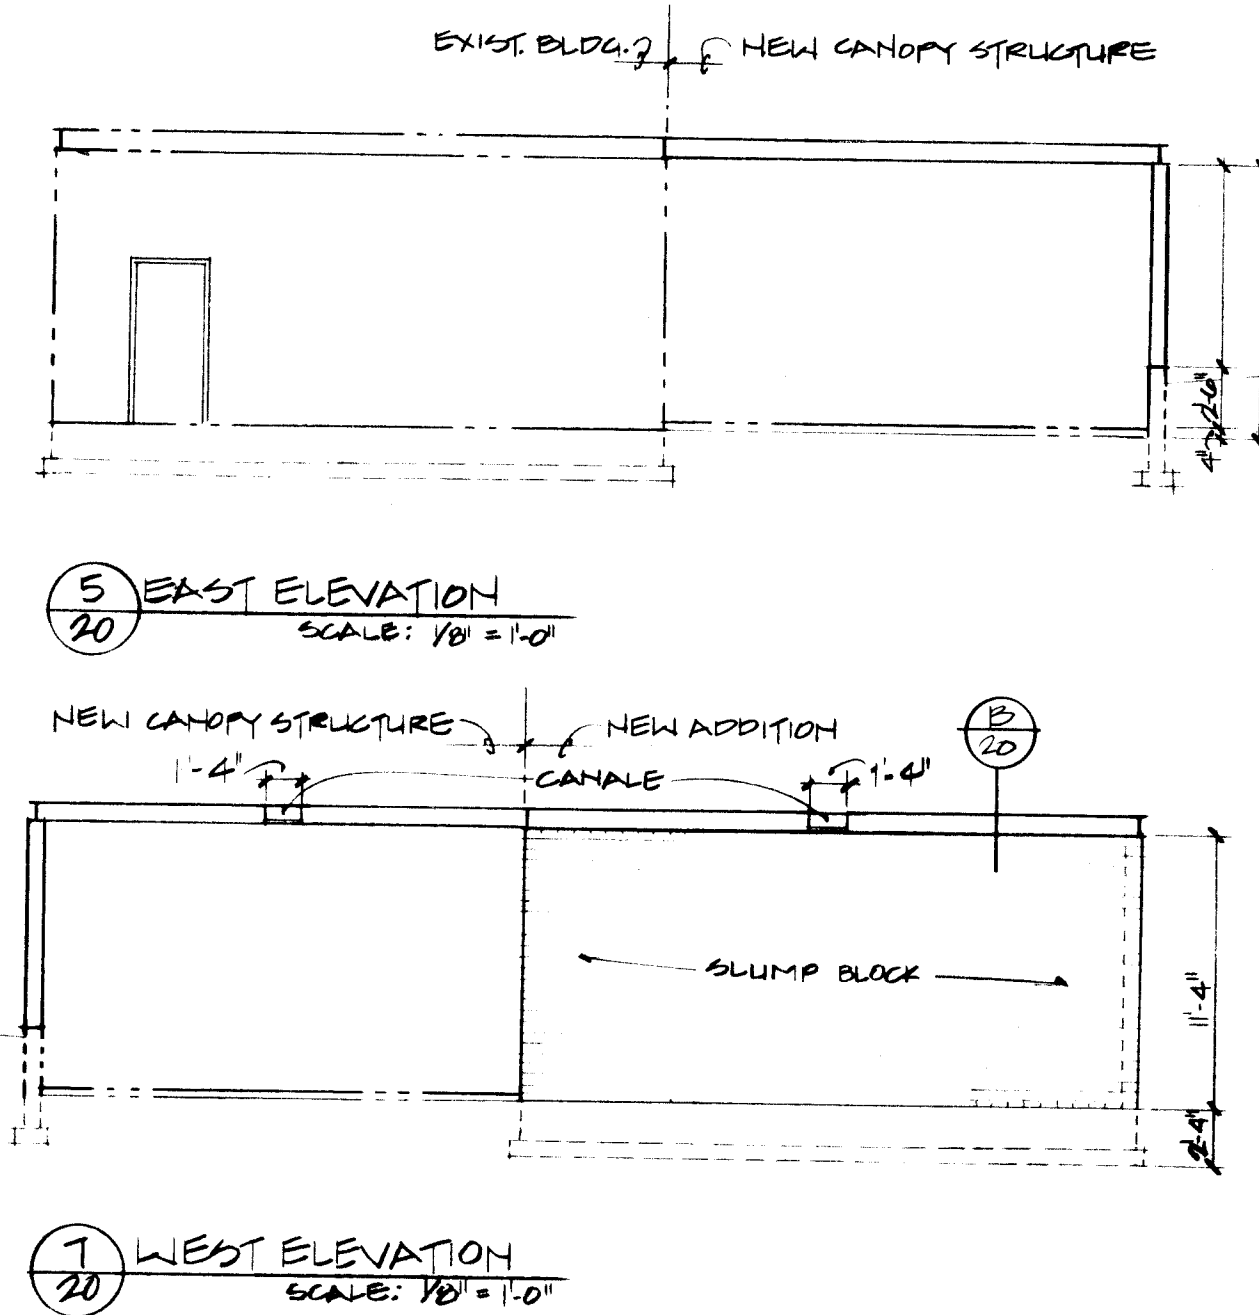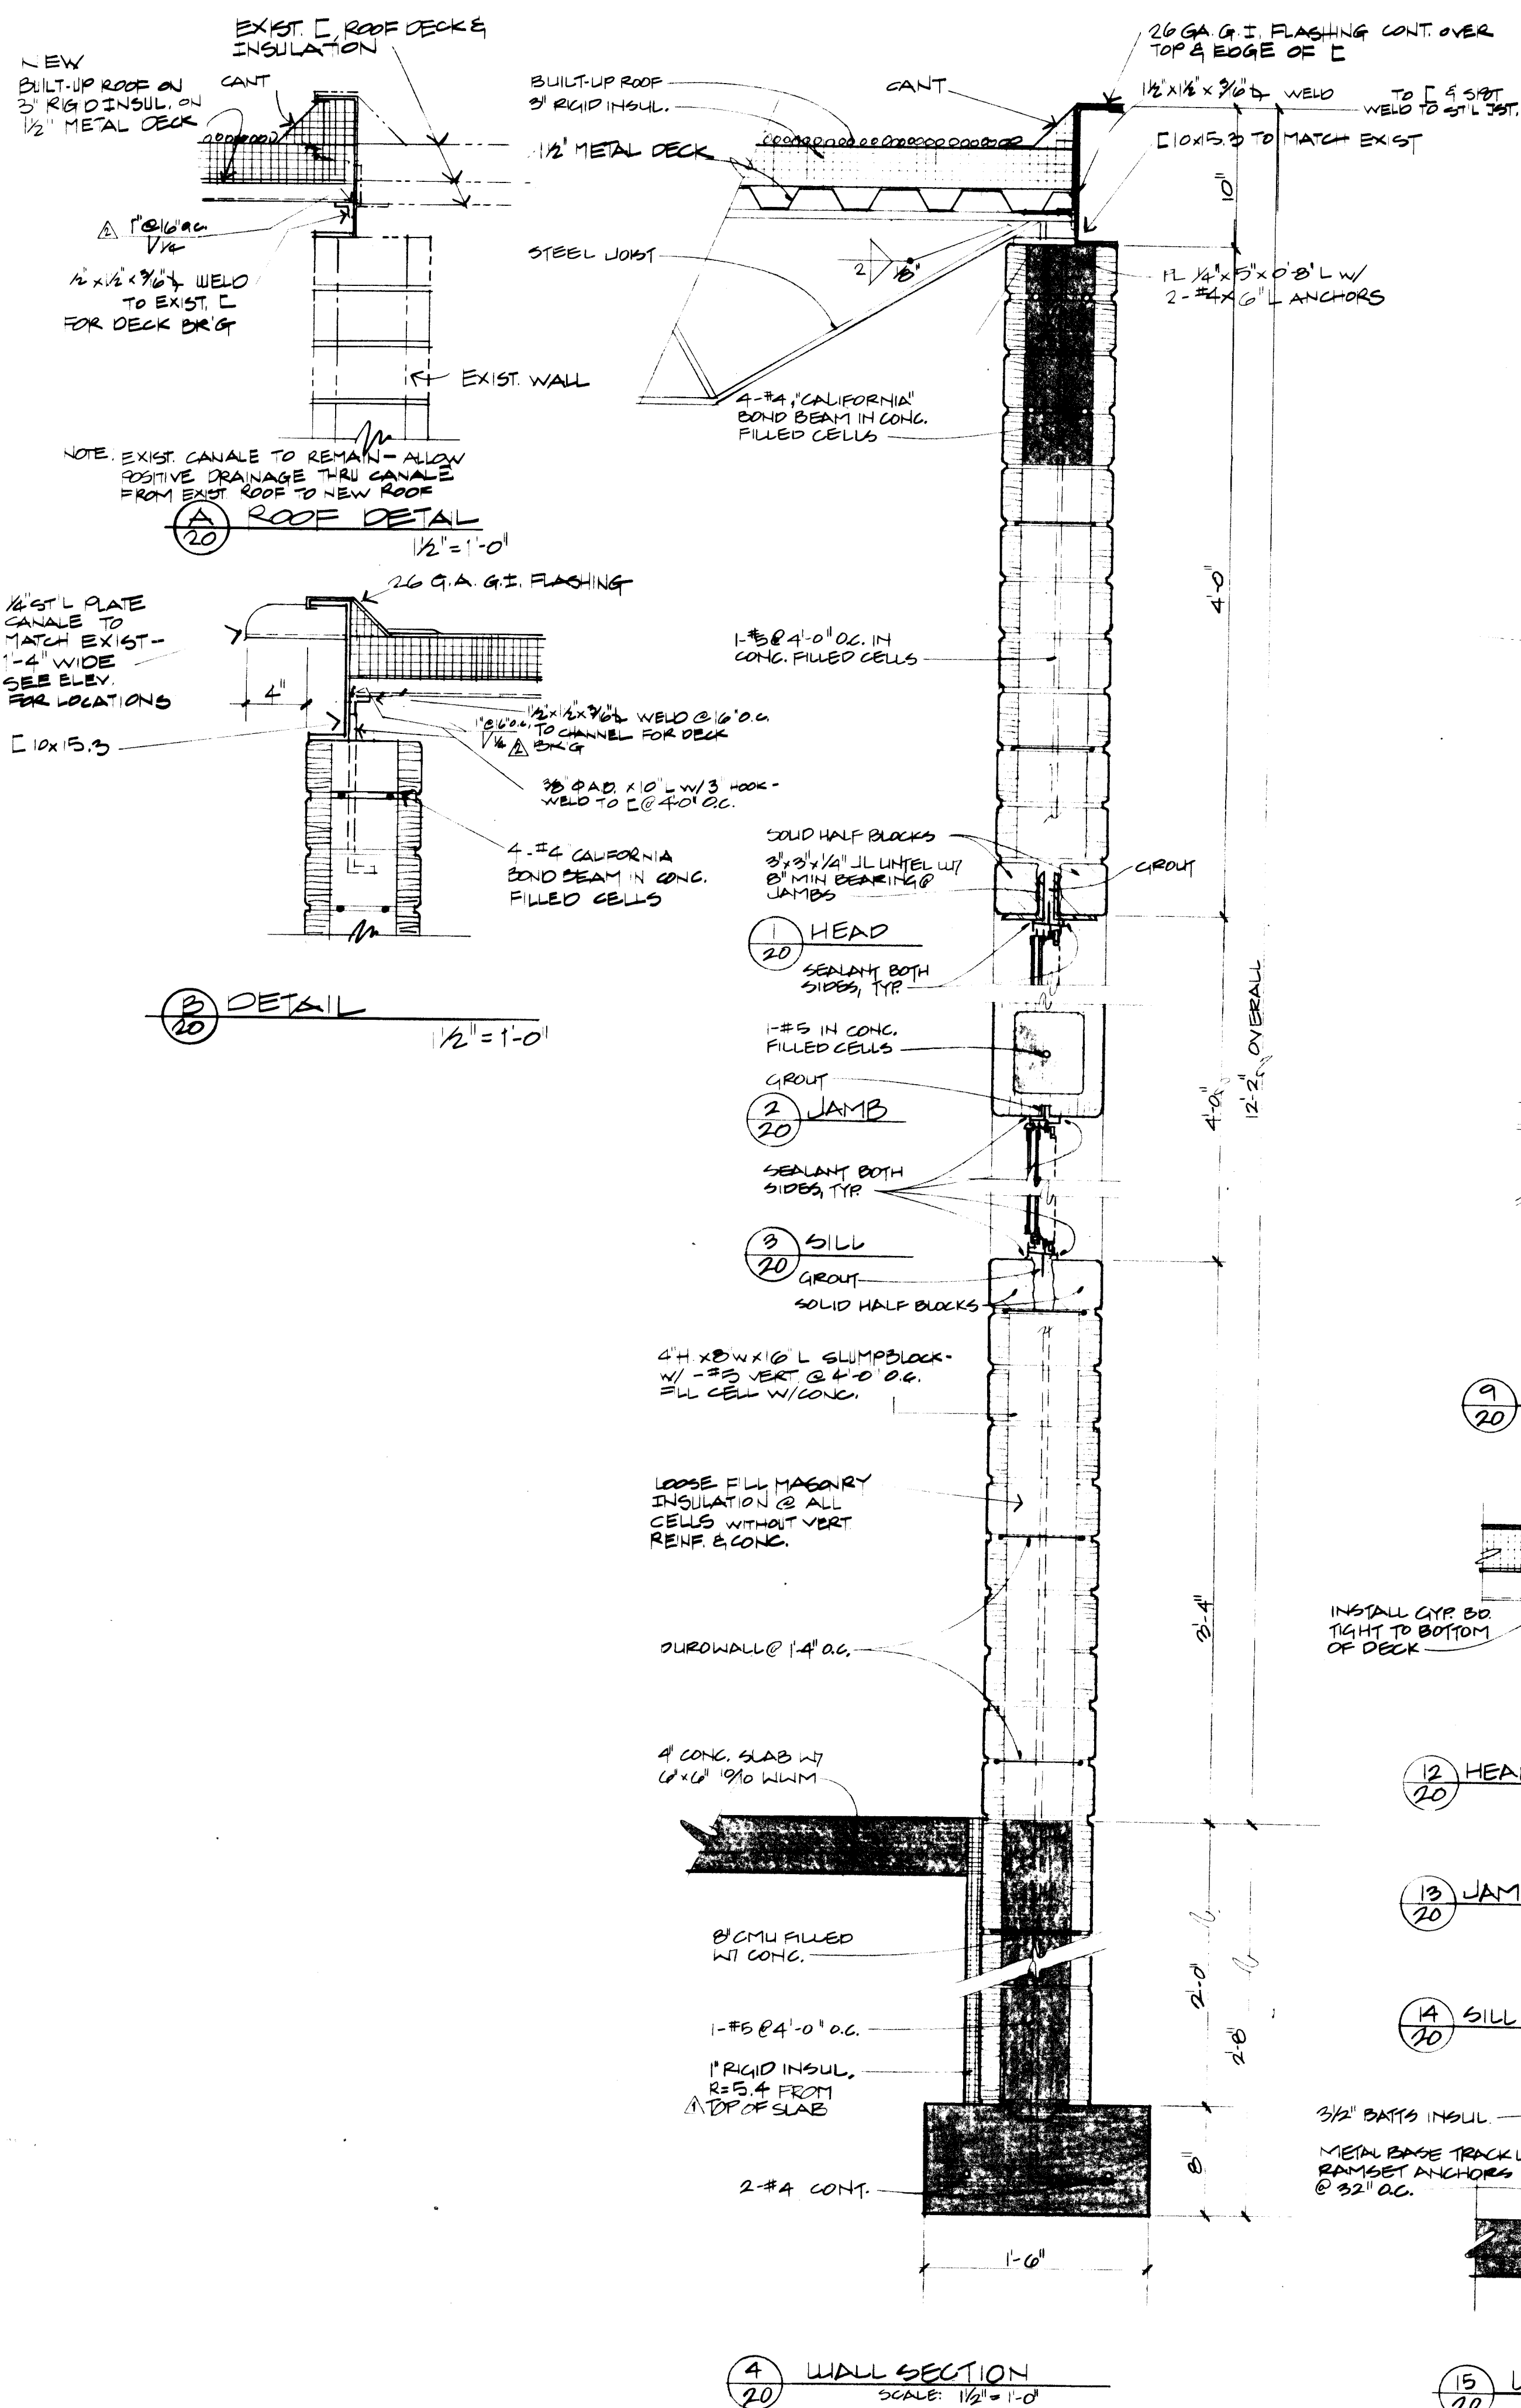

UNIVERSITY BLVD. SE.

NOTE: THERE ARE NO CHANGES FOR WATER, SEWER, ELEC., & TELE. SERVICE TO THIS SITE.

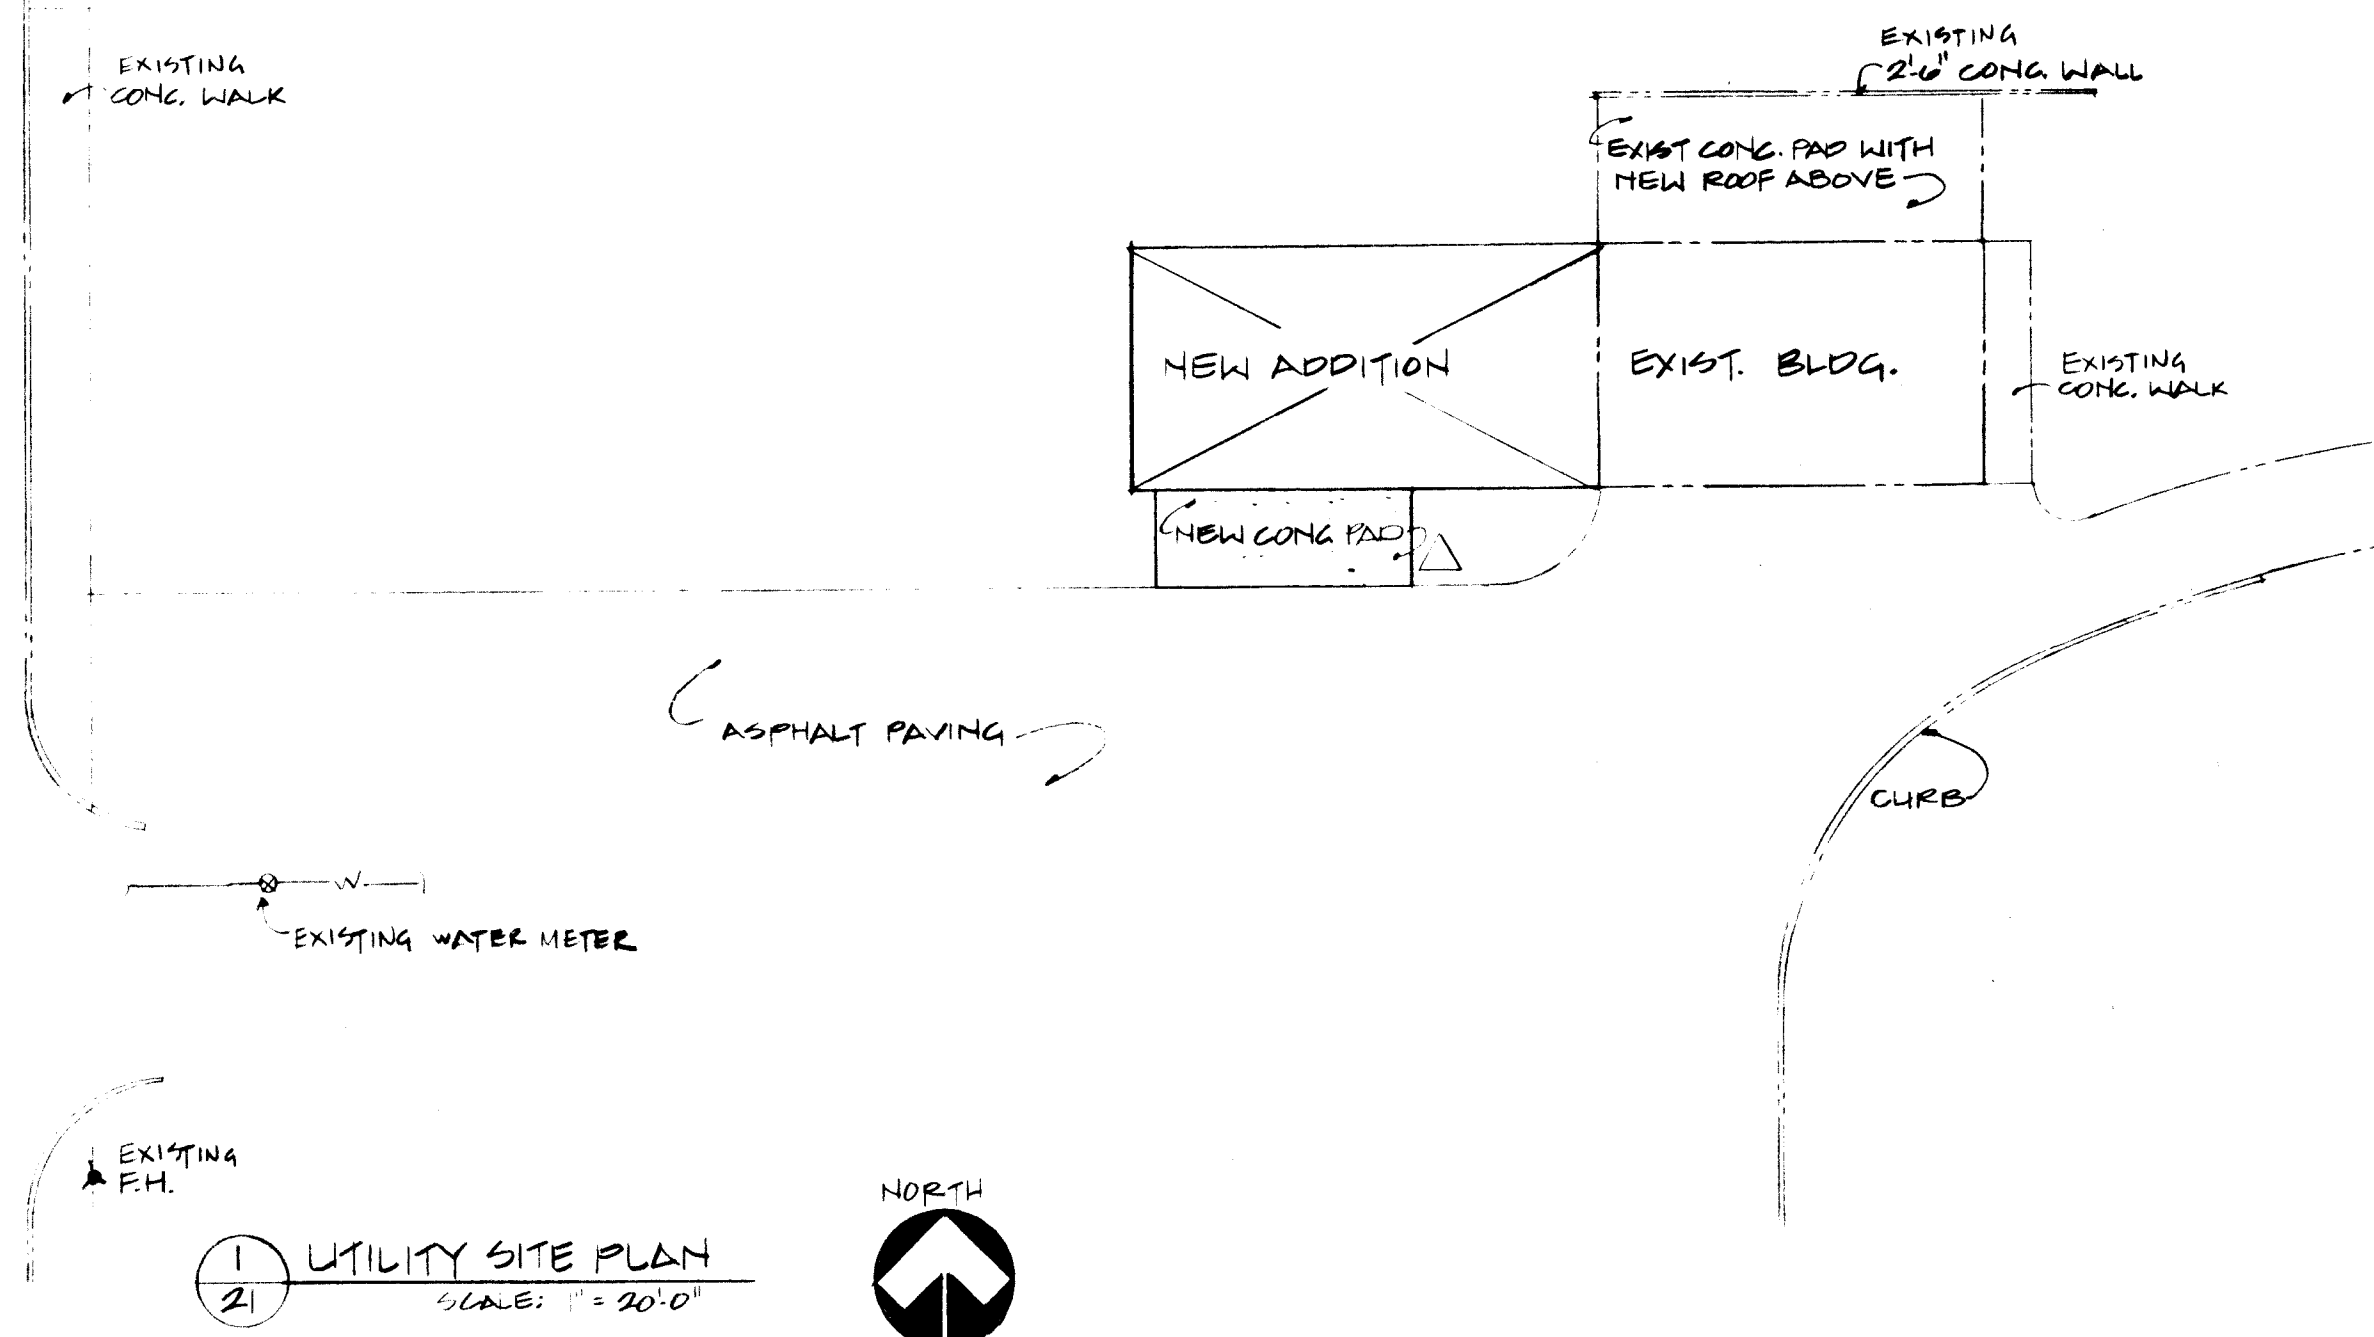

MECHANICAL CONTRACTOR NOTE:

These Drawings reflect information on utilities gathered by site inspection, discussions with local utilities engineering officials, and previous construction drawings, provided to the Architect. It is possible that the exact location of lines in the immediate vicinity of the proposed building may be slightly different from the location shown on this Drawing. If additional lines are encountered, they shall be exposed and identified by this Contractor. Where additional lines and/or differing locations are encountered, this Contractor shall request that the Architect make a ruling as to any necessary change of materials, re-routing, abandoning or relocating of such lines. All lines encountered that interfere with construction shall be relocated to clear construction (if active) and shall be removed if inactive by this Contractor under this contract. All bidders are cautioned to investigate site conditions before submitting their bids. All existing piping shall have minimum earth coverage and depths shall be adjusted as required to provide minimum coverage due to new grades or construction. Contractor shall pay for any and all costs of permits, line extensions, meter installation, etc., as required by local governing utilities engineering officials.

GENERAL MECHANICAL UTILITIES NOTES:

This Contractor shall be responsible for the complete installation of all work related to mechanical utilities including: trenching; backfill; supports; cleanout pads; service stops and boxes; service lines, testing; cleaning; and any work not accepted by the Architect or Mechanical Engineer due to improper workmanship or lack of proper coordination shall be removed and correctly installed at the Mechanical Contractor's expense, as directed.

MINIMUM DEPTHS BELOW GRADE (COVER): WATER -- 42" SEWER -- 30"

Refer to Architectural Plans for finish and existing grades.


This Contractor shall coordinate cutoff of existing utilities for new connections with local utilities engineering officials and shall conform to their requirements.

Utilities connection points are approximate only. Each bidder shall satisfy himself as to existing site conditions before submitting his bid. No allowance shall be made after the contract is awarded to compensate for lack of pre-bid inspection of the site by the successful bidder. Verify exact size, location and depth of existing sewer before setting any new inverts. Verify exact size, location and pressure of existing water mains.

Contractor shall connect new service lines as approved and directed by local governing utilities engineering officials and conform to their requirements.

GENERAL NOTES:

- 1 All plumbing and mechanical systems shall comply with all applicable codes, ordinances, and OSHA standards.
- 2 Location of existing fixtures, lines, etc., shown on the Drawings are approximate and shall be field verified.
- 3 The water, waste and vent lines as shown on Drawings indicate approximate routing. Exact location of lines shall be coordinated w/field conditions and rough-in requirements of fixtures.
- 4 Remove and replace existing floor slabs, walls and ceilings as required for installation of new plumbing lines and connection to existing services. Replace damaged construction to match new finishes.
- 5 Contractor shall repair all damage to floors, walls, ceilings, etc., in a professional manner. Seal all wall or ceiling openings with matching material; this shall be done at no cost to the Owner. If roof needs to be penetrated, pitch pans and/or proper flashings are then required. The roof shall be patched and repaired as directed.
- 6 Any damage to existing equipment, structure, building, etc., shall be patched and repaired as directed by Owner, at no additional cost to the Owner.
- 7 All piping shall be concealed where possible (unless otherwise noted). All exposed piping where concealment is not possible shall be painted.
- 8 No water piping shall be installed below floor, except as shown.
- 9 All water piping shall be insulated. See Specifications for type.
- 10 No water piping shall be located in outside walls, unless shown on these Drawings, and then piping is to be insulated per Specs.
- 11 All branches shall be valved, all valves shall have unions adjacent. Access panels shall be furnished and installed for access to valves where required.
- 12 All piping shall pitch to drain, and Contractor shall provide valving for drainage. Contractor shall deliver a marked-up set of Plans to the Owner (prior to final payment) showing all branch valves and all drainage points.
- 13 Care shall be taken to avoid mechanical ductwork, electrical equipment and air handling equipment. This Contractor shall be responsible for coordinating routing of piping with Ceiling Contractor and Sheetmetal Contractor. Relocation of piping required by poor coordination by this Contractor shall be at his own expense.
- 14 All water piping in Mechanical Equipment Room shall be insulated.

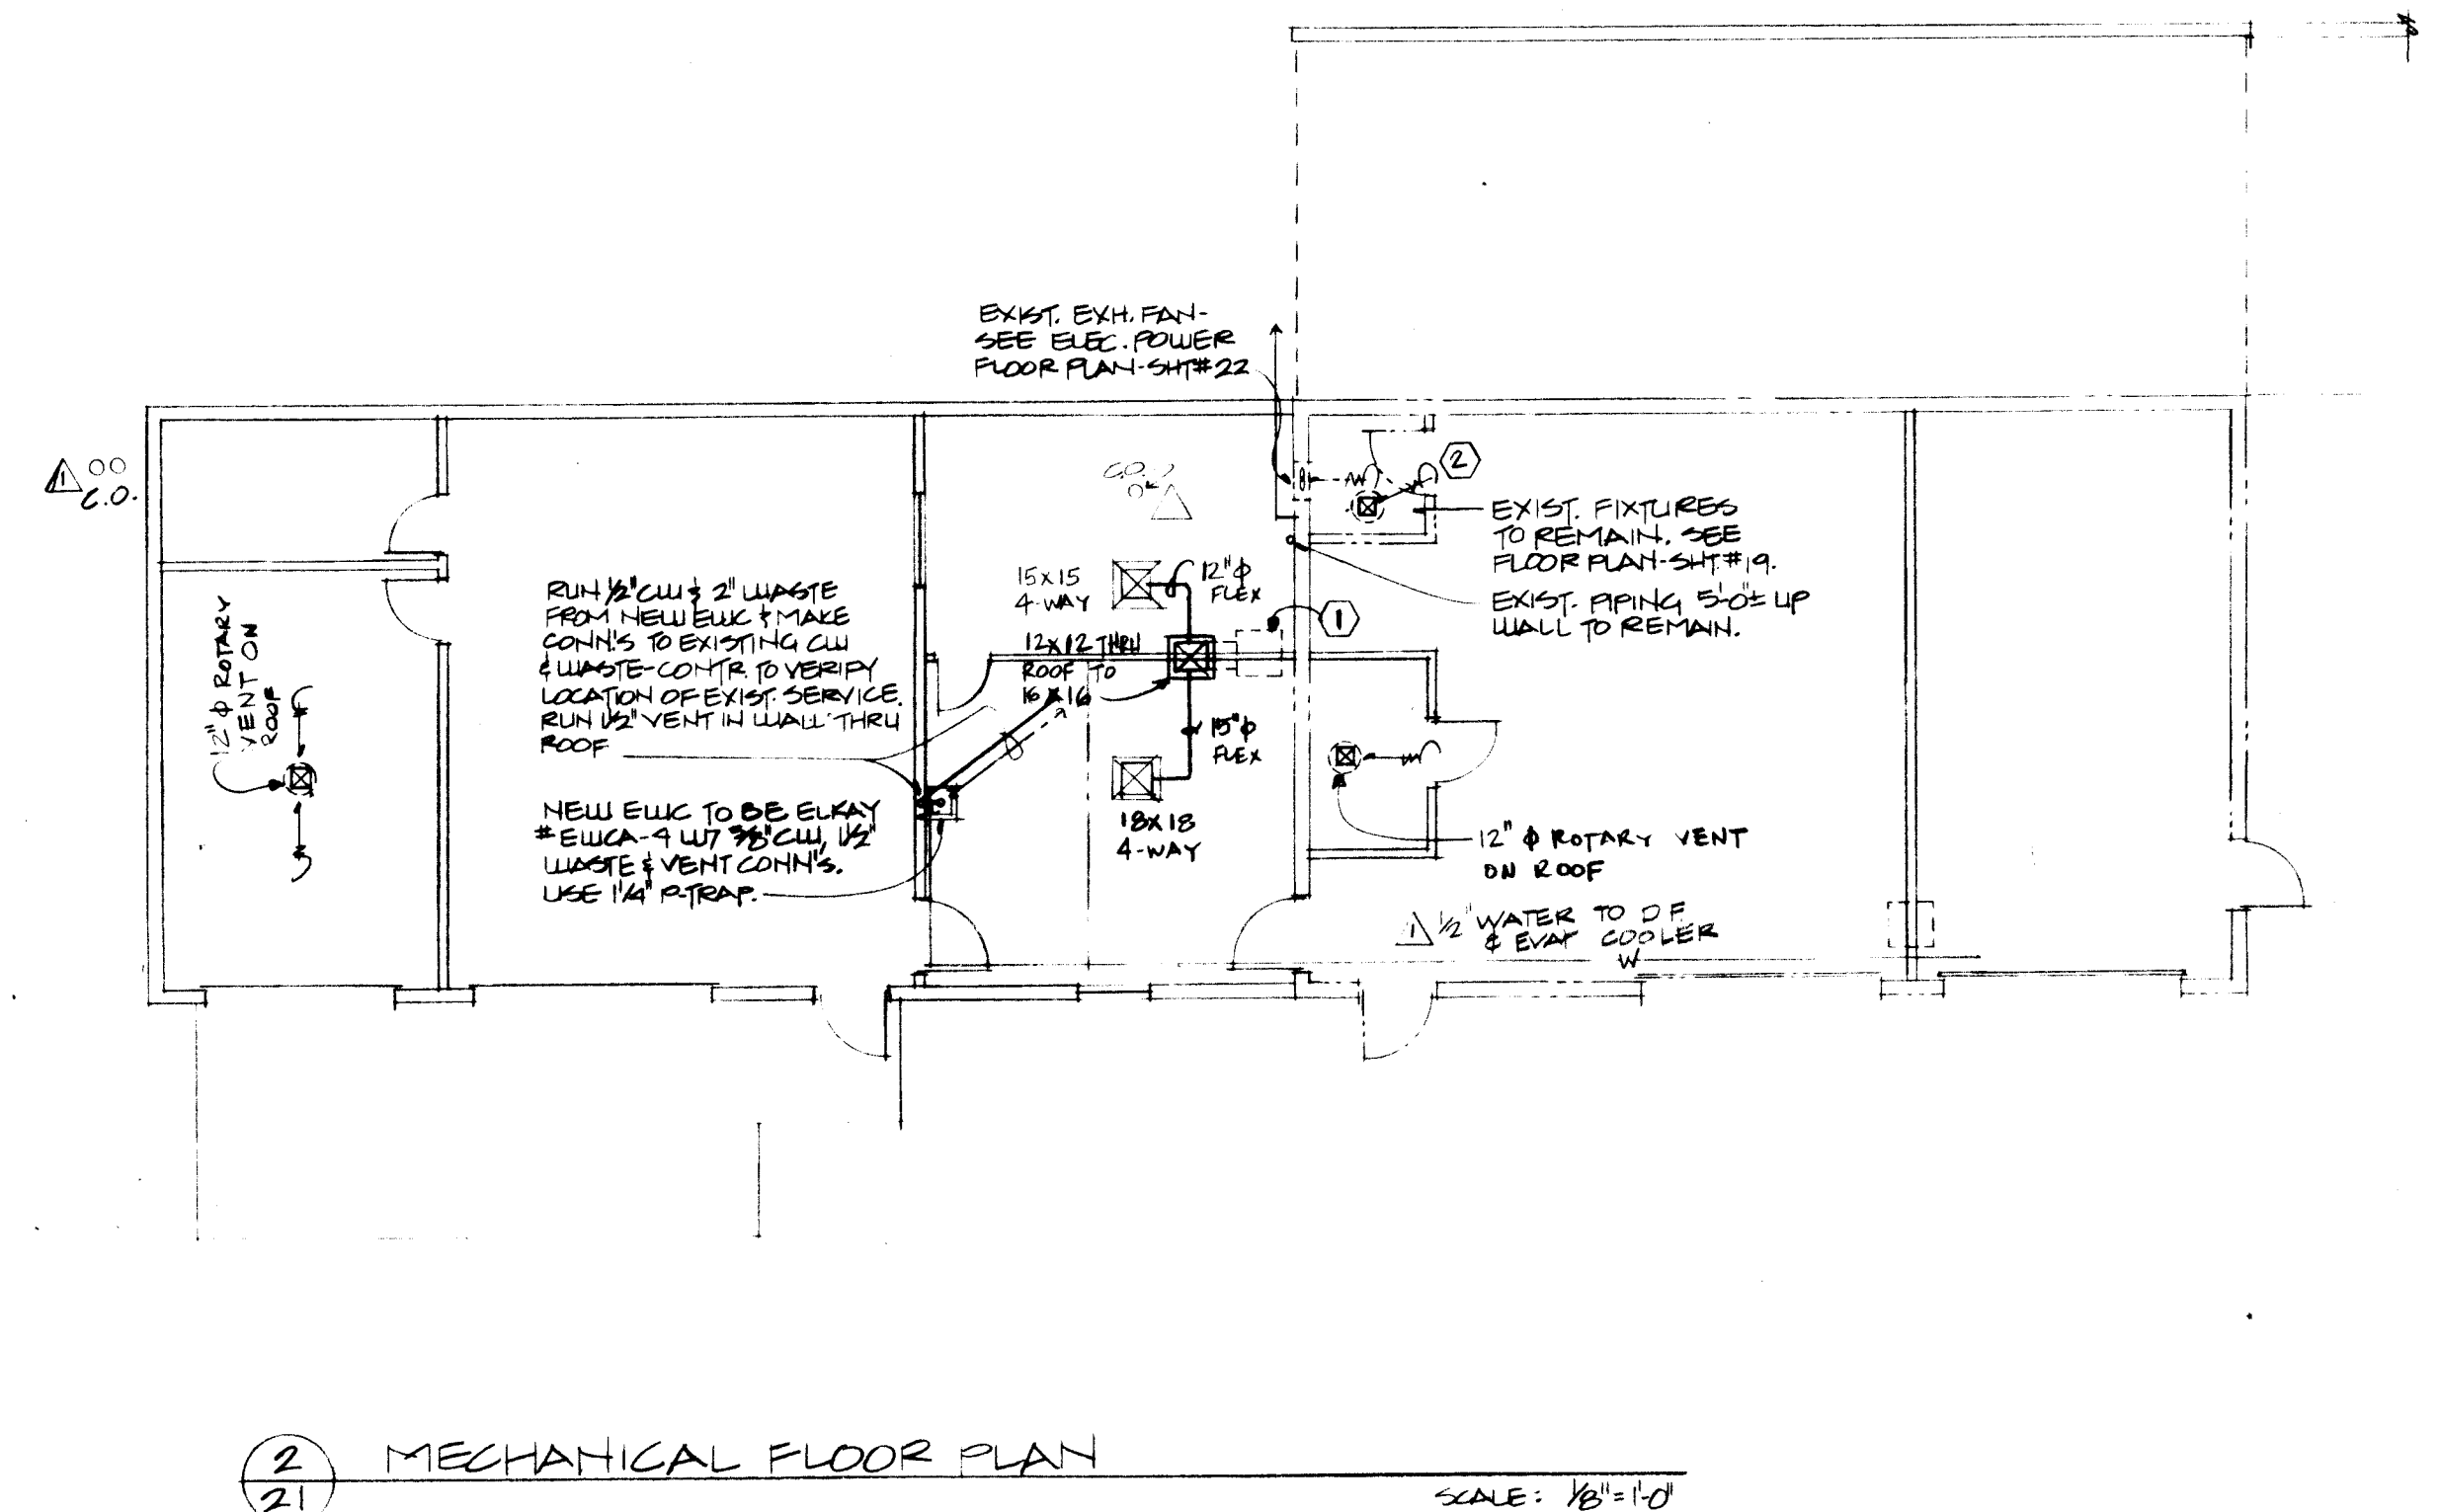


MECHANICAL FLOOR PLAN NOTES

- 1 EXH. COOLER TO BE ARTIC. CIRCLE #2200 B-2, WITH RECIRCULATING PUMP 1/4 HP. MAKE FLEXIBLE CONNECTION FROM COOLER TO SUPPLY PILT MOUNT COOLER ABOVE ROOF ON 4x4 REDWOOD SKIDS MAPPED INTO ROOF.
- 2 EXHAUST FAN EQ. TO BE BRONX #000, 50 CFM, CEILING RECESSED, COMPLETE PACKAGE UNIT W/ BUILT-IN FANPER. PROVIDE 8" Ø PILT UP THRU ROOF TO ROOF JACK.

26 1661 21 83

12-22-03

1661

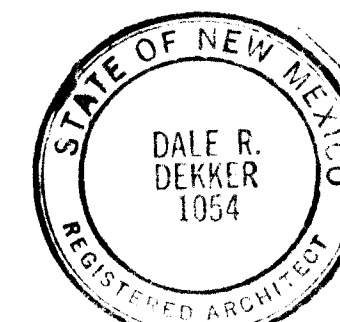

dekker & associates
architects & engineers & planners

job no. 8200
dwn by JCH
chkd by ALWD
ISSUED 2-1-03
revisions
1998 MOD 15

sheet 21 of 28

KEYED NOTES

1. INSTALL NEW 50A/3P CIRCUIT BREAKER IN SPACE OF EXIST. PANEL.
2. DISCONNECT FOURTEEN (14) SPRINKLER VALVE CONTROL WIRES. REMOVE & RELOCATE CONTROLLER. INSTALL 8"X8"X8" JUNCTION BOX, SPLICE & EXTEND NEW 14-#12 THW-2" C. TO RELOCATED CONTROLLER. LABEL & TERMINATE RESPECTIVE ZONE SAME AS BEFORE.
3. INSTALL WIREMOLD BOX ON EXIST. WALL. INSTALL RECEPTACLE. INSTALL WIREMOLD #500 UP EXIST. WALL TO ABOVE NEW LAY-IN CEILING. INSTALL WIREMOLD TO CONDUIT ADAPTER AND EXTEND CONDUIT TO J-BOX AS SHOWN.
4. REMOVE EXIST. SWITCH, SPLICE CONDUCTORS FOR CONTINUITY, AND INSTALL BLANK IN SWITCH PLATE.
5. REMOVE 2-#12 IN EXIST. CONDUIT & INSTALL 3-#12 AS SHOWN. RECONNECT LIGHTS AND EXTEND HOT & NEUTRAL SO LIGHTS IN "DUKES SPECIAL STORAGE" CAN BE SWITCHED SEPARATELY.
6. DISCONNECT AND REMOVE EXIST. CONDUIT AND WIRES.
7. DISCONNECT AND REMOVE EXIST. FLUSH MOUNTED RECEPTACLE. INSTALL WIREMOLD EXTENSION BOX AND REINSTALL AND RECONNECT RECEPTACLE. EXTEND CIRCUIT AS SHOWN.
8. DISCONNECT & REMOVE EXIST. FIXTURE & INSTALL NEW FIXTURE TYPE AS INDICATED.
9. DISCONNECT & REMOVE EXIST. UNIT HEATER. SALVAGE TO OWNER.

FIXTURE SCHEDULE			
TYPE	DESCRIPTION	LAMPS	MOUNTING
A	LITHONIA #2GP-440-RN-A12	4/F40/RS/WM	RECESSED
B	LITHONIA #EJ-240	2/F40/RS/WM	SURFACE
C	LITHONIA #2M-440-M-RN-A12	4/F40/RS/WM	SURFACE
D	LITHONIA #M-240-M-RN-A12	2/F40/RS/WM	SURFACE
E	PRESCOLITE #9428	1/F06T9/CW	SURFACE
F	LITHONIA #22HB-A4-220-WUD	2/F20/CW	WALL BRACKET
G	PRESCOLITE #21K-S-20	1/60W/IF	RECESSED
H	PORCELAIN LAMPHOLDER	1/60W/IF	SURFACE
K	HUBBELL #NRG-121-HP	1/50W/HPS	WALL BRACKET

FIXTURE SCHEDULE NOTES:


1. ALL FLUORESCENT FIXTURES SHALL HAVE COMBINATION ENERGY SAVING LAMPS AND BALLASTS.
2. ALL INCANDESCENT LAMPS SHALL BE RATED 130V.
3. PROVIDE TYPE "B" FIXTURE WITH 0 DEGREE F RATED BALLAST.

GENERAL NOTES


1. THE ELECTRICAL CONTRACTOR SHALL FAMILIARIZE HIMSELF AT THE SITE WITH THE EXISTING CONDITIONS TO ALLOW HIM TO SUBMIT A COMPLETE BID WITHIN THE SCOPE OF THE DRAWINGS AND SPECIFICATIONS. ANY QUESTIONS ARISING DURING THE BID PERIOD IN REGARD TO THE CONTRACTORS FUNCTIONS, THE SITES INVOLVED, THE SCOPE OF THE PROJECT, OR ANY OTHER ISSUE RELATED TO THIS PROJECT SHALL BE BROUGHT UP DURING THE BID PERIOD WITH THE ENGINEERS FOR CLARIFICATIONS, NOT AFTER THE CONTRACT HAS BEEN AWARDED.
2. LOCATION OF EQUIPMENT, CONTROLS AND OTHER DEVICES SHOWN ON THE DRAWINGS ARE APPROXIMATE AND SHALL BE FIELD VERIFIED.
3. ALL ELECTRICAL WIRING SHALL BE ROUTED IN CONDUIT. WIRING BELOW SUSPENDED CEILINGS SHALL BE CONCEALED IN WALLS. IN CASE OF SOLID WALLS, WIREMOLD MUST BE UTILIZED BELOW SUSPENDED CEILINGS--EXCEPT IN AREAS WITH EXPOSED JOISTS.
4. THE CONDUIT RUNS AS SHOWN ON DRAWINGS INDICATE APPROXIMATE ROUTING. EXACT LOCATION OF CONDUIT RUNS SHALL BE PER FIELD CONDITIONS. NO CONDUIT SHALL BE RUN EXPOSED ON OUTSIDE OF BUILDINGS UNLESS APPROVED BY ENGINEER.
5. CONTRACTOR SHALL INSTALL PULL AND J-BOXES WHEREVER REQUIRED BY NEC.
6. ALL WIRES SHALL BE TAGGED AT ALL PULL BOXES, J-BOXES, EQUIPMENT BOXES AND CABINETS WITH APPROVED PLASTIC TAGS, ACTION CRAFT BRADY OR APPROVED EQUAL.
7. ALL MATERIALS UTILIZED SHALL HAVE U. L. LABEL.
8. SHOULD ELECTRICAL CONTRACTOR AT ANY TIME NOTICE THAT THE ACTUAL FIELD CONDITIONS DO NOT CORRESPOND TO THE INFORMATION GIVEN ON THE DRAWINGS, THEN IT WILL BE HIS RESPONSIBILITY TO NOTIFY THE ELECTRICAL ENGINEER AS SOON AS POSSIBLE FOR CLARIFICATION.
9. ELECTRICAL CONTRACTOR SHALL REPAIR ALL DAMAGE TO WALLS, CEILINGS, ETC., IN A PROFESSIONAL MANNER. SEAL ALL WALL OR CEILING OPENINGS WITH MATCHING MATERIAL; THIS SHALL BE DONE, AT NO COST TO THE OWNER. IF ROOF NEEDS TO BE PENETRATED, PITCH PANS ARE THEN REQUIRED. THE ROOF SHALL BE PATCHED AND REPAIRED AS DIRECTED.
10. ANY DAMAGE TO EXISTING EQUIPMENT, STRUCTURE, BUILDING, ETC. SHALL BE PATCHED AND REPAIRED AS DIRECTED BY OWNER, AT NO ADDITIONAL COST TO THE OWNER.

SYMBOL LEGEND	
SYMBOL	DESCRIPTION
Ⓐ Ⓑ	CEILING OR WALL BRACKET FIXTURE. SEE FIXTURE SCHEDULE
□	FLUORESCENT OUTLET AND FIXTURE. SEE FIXTURE SCHEDULE
Ⓕ	SINGLE POLE WALL SWITCH, UP +48". "3" INDICATES THREE-WAY.
Ⓖ	THERMAL O.L. SWITCH
Ⓜ	JUNCTION BOX FLUSH IN WALL WITH CONNECTION TO EQUIPMENT
Ⓢ	DUPLEX CONVENIENCE OUTLET, UP 12" OR AS INDICATED.
Ⓣ	THERMOSTAT, UP 48" UNLESS OTHERWISE INDICATED.
■	ELECTRIC PANEL. SEE PANEL SCHEDULE FOR CHARACTERISTICS
Ⓢ	MOTOR CONNECTION WITH HP INDICATED. "F" INDICATES FRACTIONAL.
—	BRANCH CIRCUIT IN WALLS OR CEILING WITH CONDUCTORS INDICATED.
—	BRANCH CIRCUIT IN WALLS OR UNDER FLOOR WITH CONDUCTORS INDICATED.
—A-1,3	HOME RUN TO PANEL, WITH BRANCH CIRCUIT NUMBERS INDICATED.
—T	TELEPHONE CONDUIT, MINIMUM 3/4" WITH PULL WIRE.
—T—	TELEPHONE CONDUIT HOMERUN TO BACKBOARD, 1" MINIMUM WITH PULL WIRE.
▶	TELEPHONE OUTLET, UP 12" UNLESS OTHERWISE INDICATED.
Ⓢ	250V-2P-3W SPECIAL PURPOSE GROUNDING TYPE OUTLET. AMPERAGE AS SHOWN.
ⓈEC	PHOTOCELL ON ROOF WITH WINDOW FACING NORTH.
ⓈEC	EVAP COOLER SWITCHES, ONE TOGGLE SWITCH FOR PUMP AND ONE DPDT CENTER OFF FOR FAN.
□	DISCONNECT SWITCH, SIZE AND POLES FOR LOAD CONNECTED.
—E—	EXISTING CONDUIT AND WIRE REMAIN.
—R—	EXISTING CONDUIT AND WIRE REMOVED OR ABANDONED.
○	EXISTING DEVICE REMAINS.
○	EXISTING DEVICE REMOVED.


ENERGY CONSERVATION
THESE PLANS AND SPECIFICATIONS
ARE IN COMPLIANCE WITH THE STATE
OF NEW MEXICO ELECTRICAL CODE,
ARTICLE 290, ENERGY CONSERVATION,
AS CERTIFIED BY ME:
Fred J. Telck
FRED J. TELCK

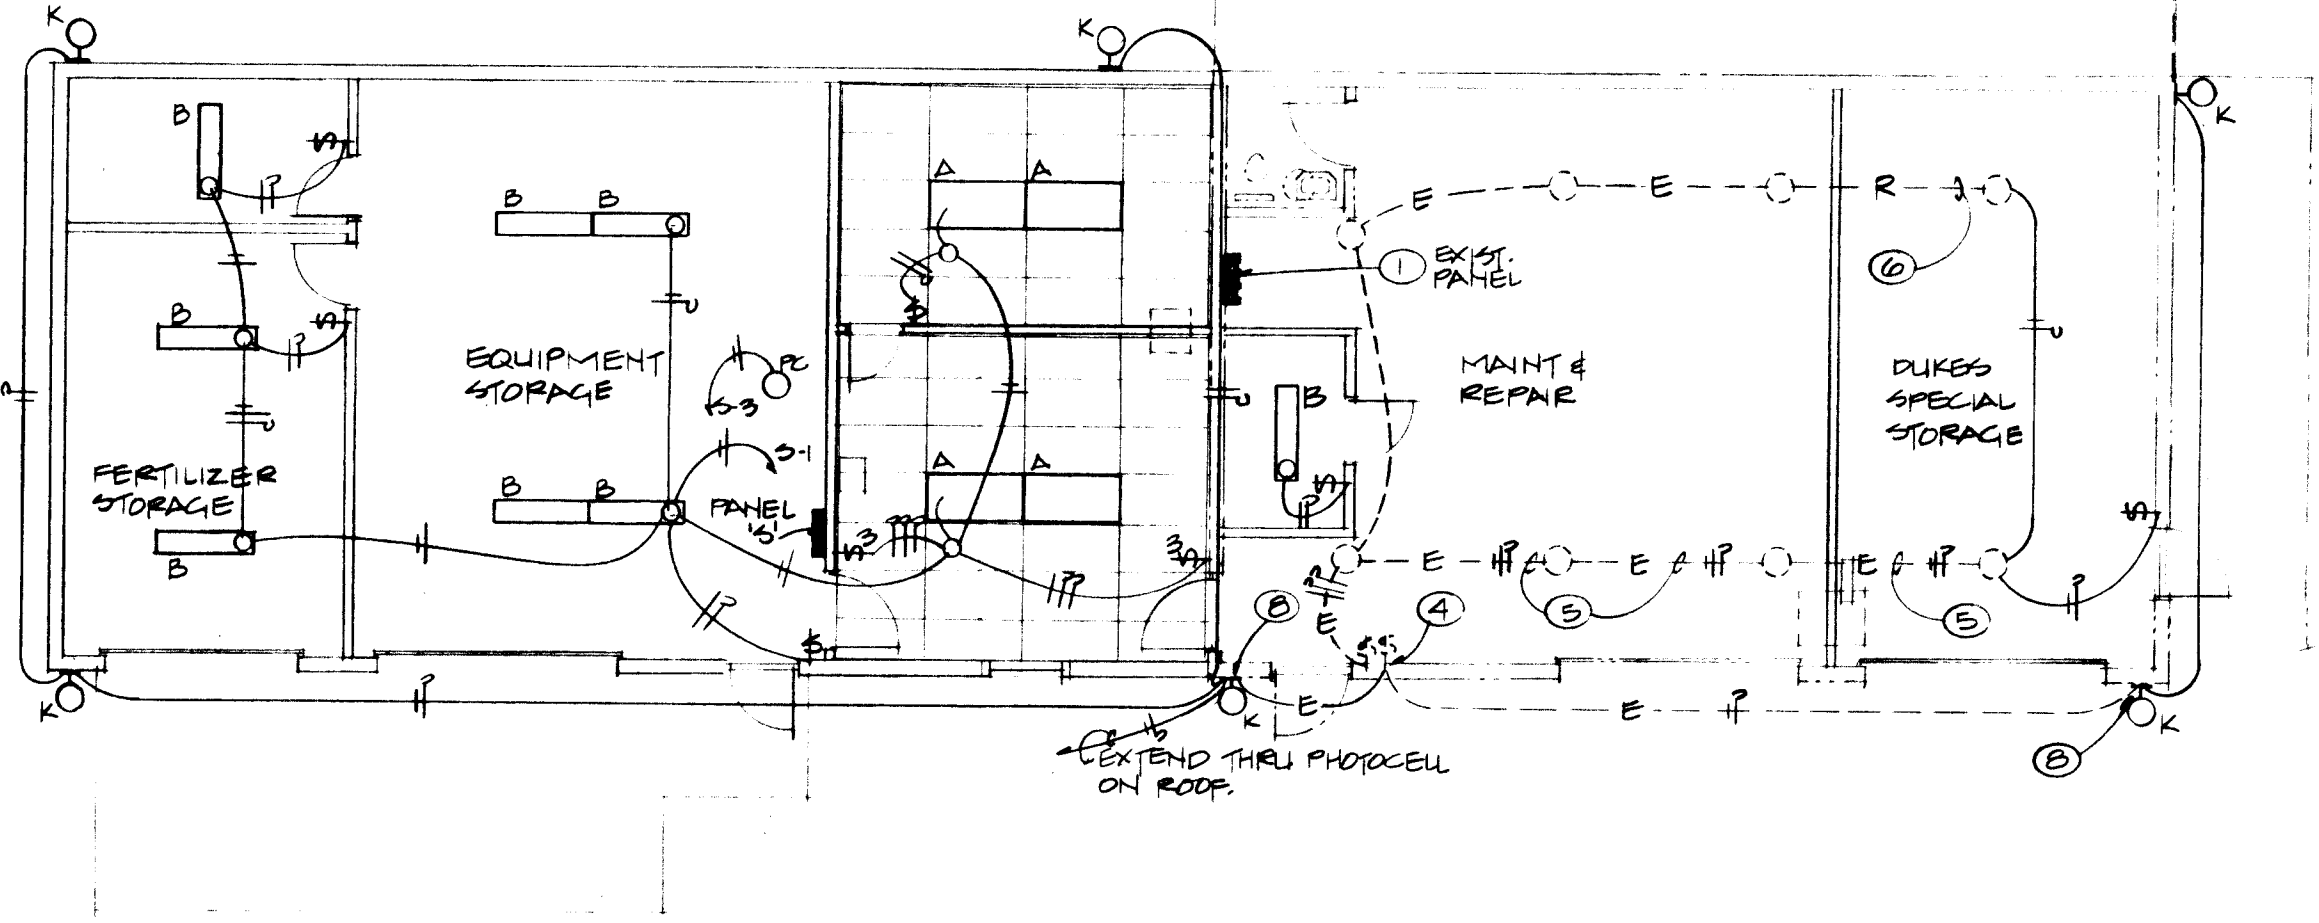

1 LIGHTING FLOOR PLAN
SCALE: 1/8" = 1'-0"

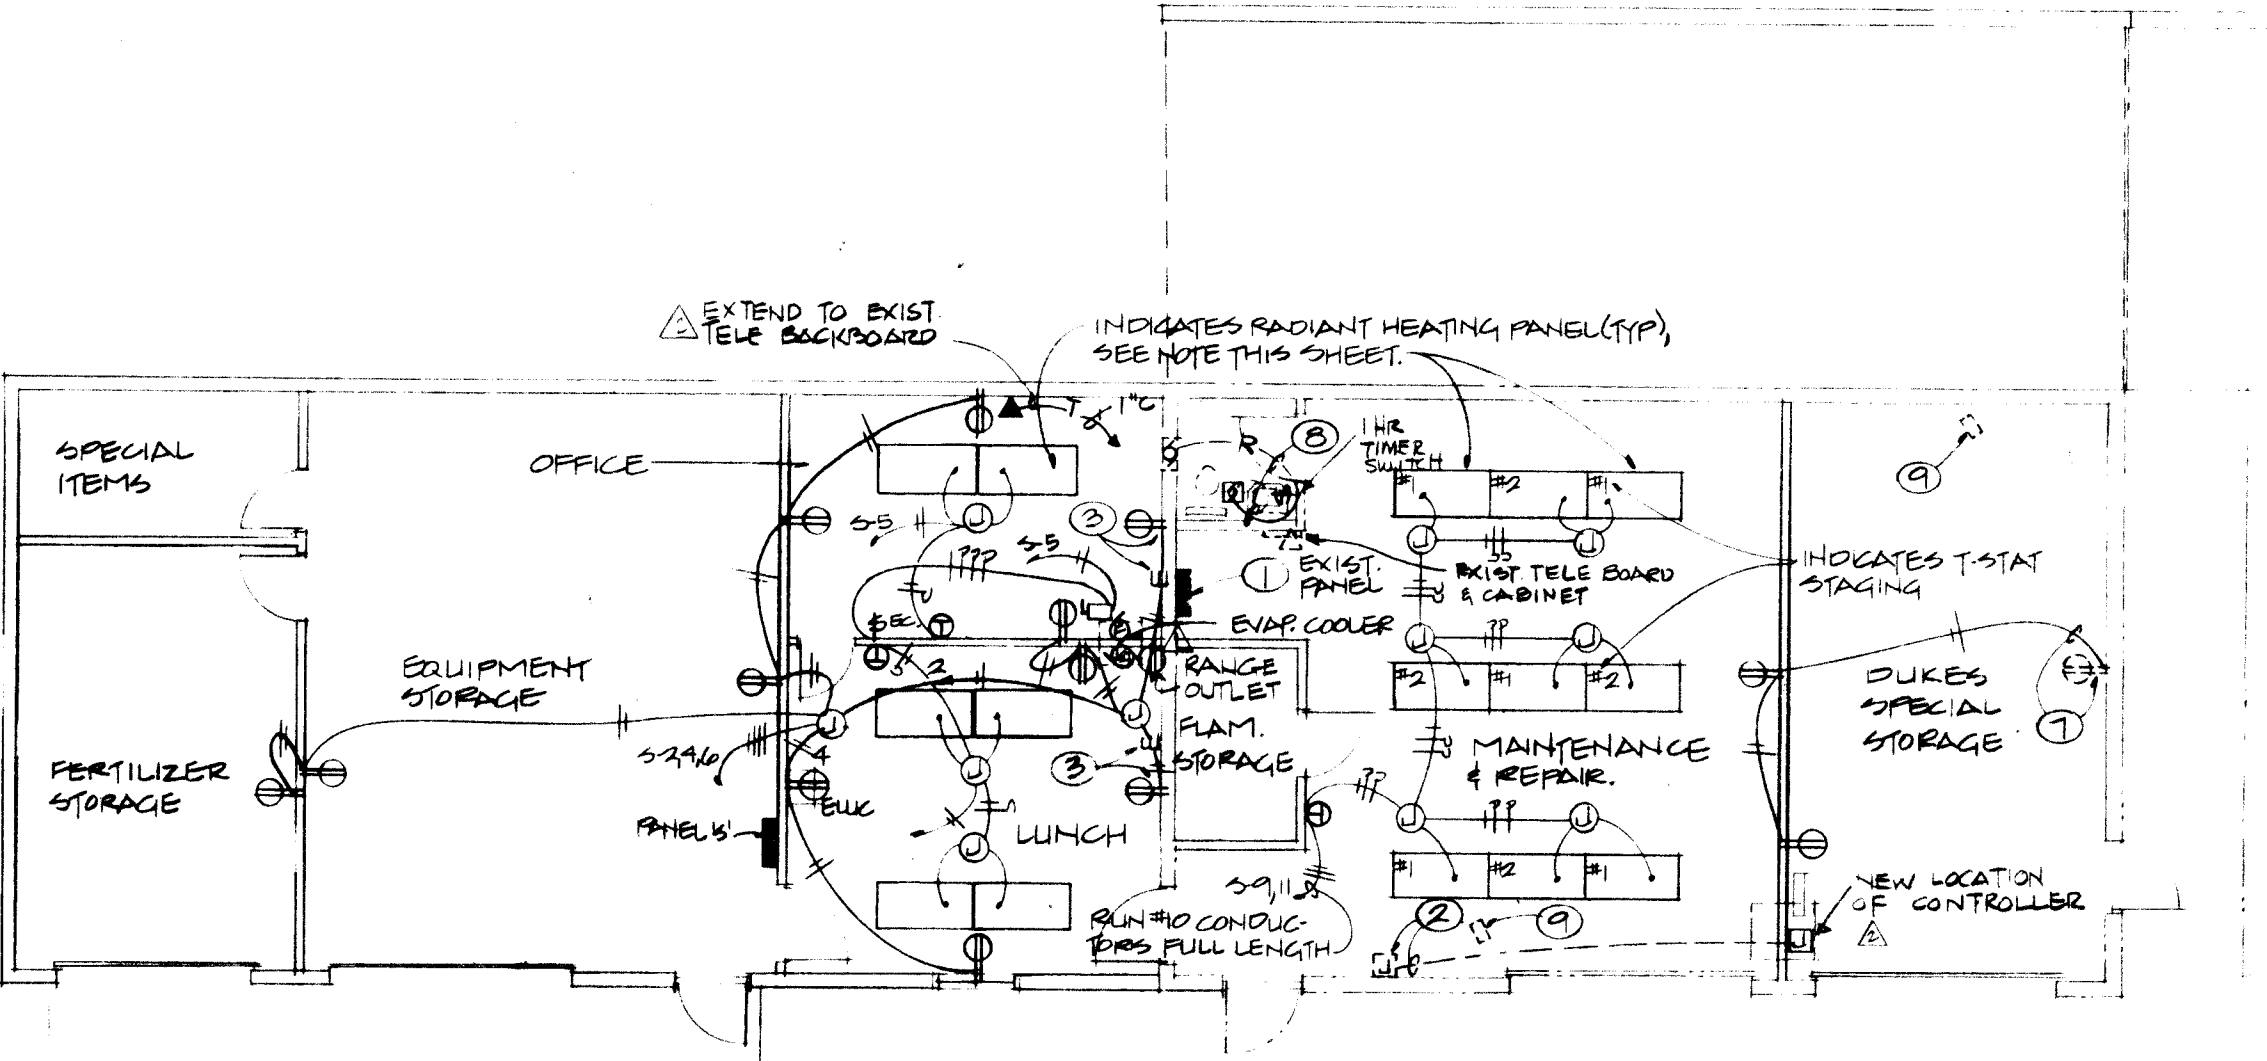


2 ELEC. POWER FLOOR PLAN
SCALE: 1/8" = 1'-0"

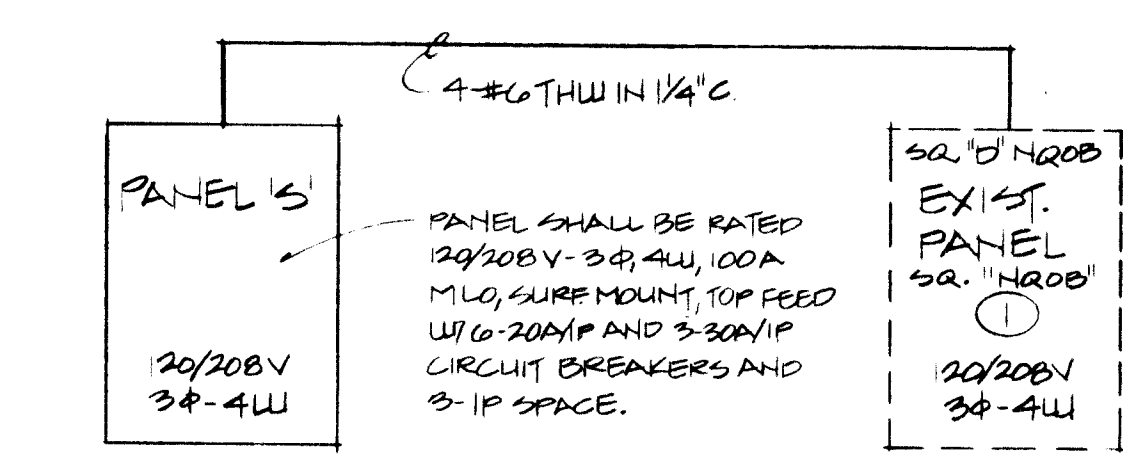

3 PARTIAL POWER RISER DIAGRAM
SCALE: 1/2" = 1'-0"

NOTE: RADIANT HEATING PANELS SHALL BE AZTEC INTERNATIONAL OR EQUAL, RATED 500W, 120V, ATL, AND SHALL BE LAY-IN TYPE IN OFFICE & LUNCH ROOM, AND SURFACE-MOUNT IN MAINTENANCE/REPAIR, AND HUNG FROM JOISTS IN LITCHAIN. THERMOSTATS IN OFFICE & LUNCH ROOM SHALL BE LINE VOLTAGE. THERMOSTAT IN MAINT./REPAIR SHALL BE LINE VOLTAGE TWO-STATE AND WIRED AS SHOWN.

LOADS - 20/240V-10-3LL	
CONNECTED DEMAND	21 KW 18 KW
SHORT CIRCUIT ANALYSIS	
MAX. SCA @ EXIST. PANEL =	4200 AC
MAX. SCA @ PANEL 15, 16, 17, 99, 100	

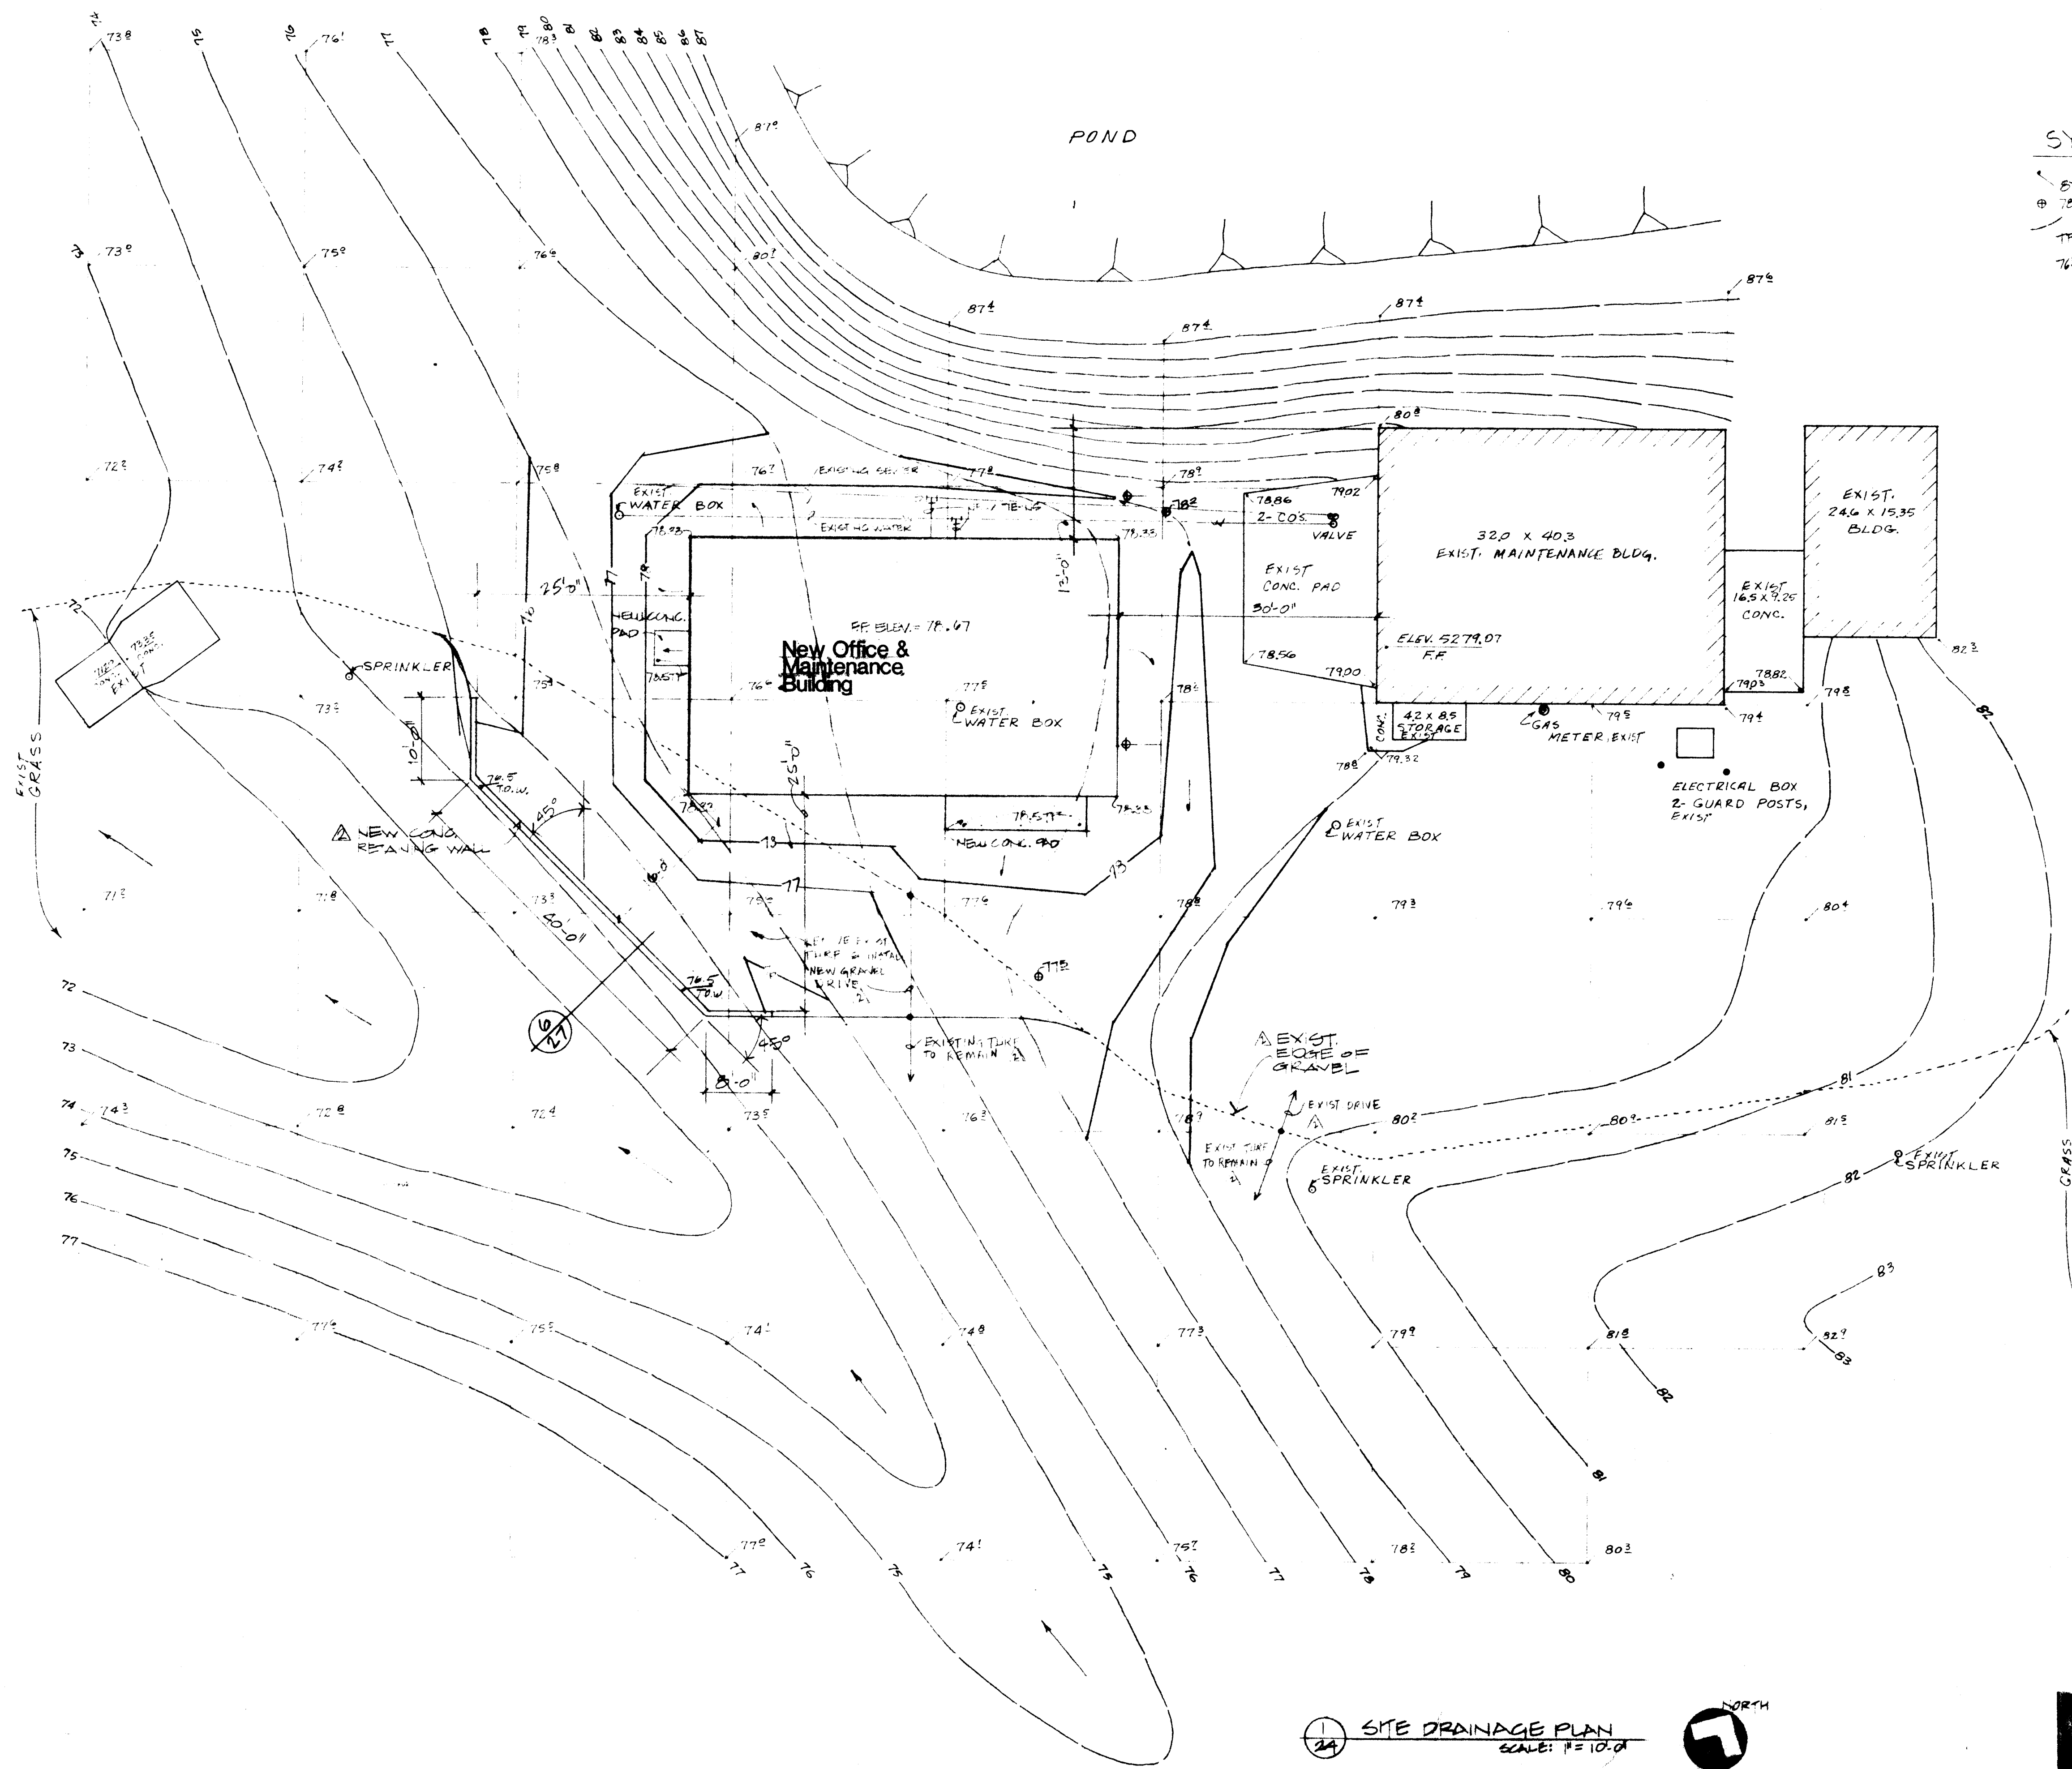

SYMBOL LEGEND:

- 87' EXIST. SPOT ELEVATION
- 70' NEW SPOT ELEVATION
- EXIST'G. CONTOUR
- TO NEW SPOT ELEVATION TO REMAIN
- 76' ON TOP OF WALL

SCALE: 1" = 10'-0"

NOTES:

ELEVATIONS ARE BASED ON ACS BENCH MARK NO. 11-L16, A 1" CHISELED IN TOP OF CONCRETE CURB AT THE SSW RETURN AT VAIL AVE. SE AND GIRARD BLVD. SE. ELEVATION = 5270.78 (MSLD 1929)


25' GRID ORIGINATING AT SW CORNER OF BLDG.

1 FT. CONTOUR INTERVALS

DRAINAGE CALCULATIONS ARE BASED ON THE 100 YEAR, 6 HOUR STORM, BY USE OF THE RATIONAL METHOD.


This is to certify that I am a Registered Professional Engineer in the State of New Mexico. That the plan was prepared from field notes of actual surveys made by me or under my supervision & that the same are true & correct to the best of my knowledge & belief.

Signature: [Signature] NMES #4281

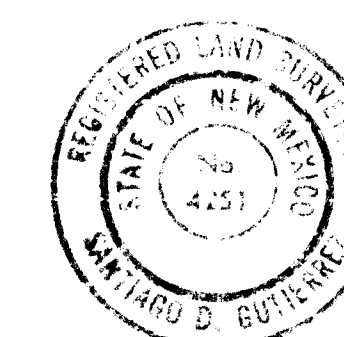

DRAINAGE CALCULATIONS		
	EXIST'G.	PROPOSED
AREA A	5.44	15.60 SQ. FT.
1	0.45	5.85
2	0.45	0.45
3 - C/A	0.095 CFS	0.42 CFS
4 - INCREASE		0.10 CFS
5 - C/A		
6 - INCREASE	0.4"	2.4"
7	1.1 CUPH	2.00 CUPH
8 - INCREASE		1.57 CUPH


DRAINAGE STATEMENT: A FINISH FLOOR ELEVATION OF 71.0' REMOVED THIS STRUCTURE FROM THE FLOOD HAZ. THE INCREASED RUNOFF (0.1 CFS) AND VOLUME (0.1 CUPH) SHALL BE CONSIDERED NEGLIGIBLE DUE TO THEIR INSIGNIFICANT VALUES AND THE STRUCTURES PROXIMITY TO THE DRAINAGE COURSE.

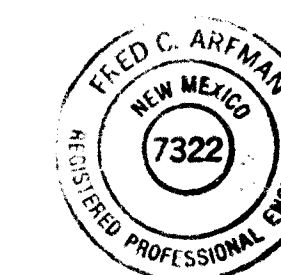

1 SITE DRAINAGE PLAN
SCALE: 1" = 10'-0"



1661

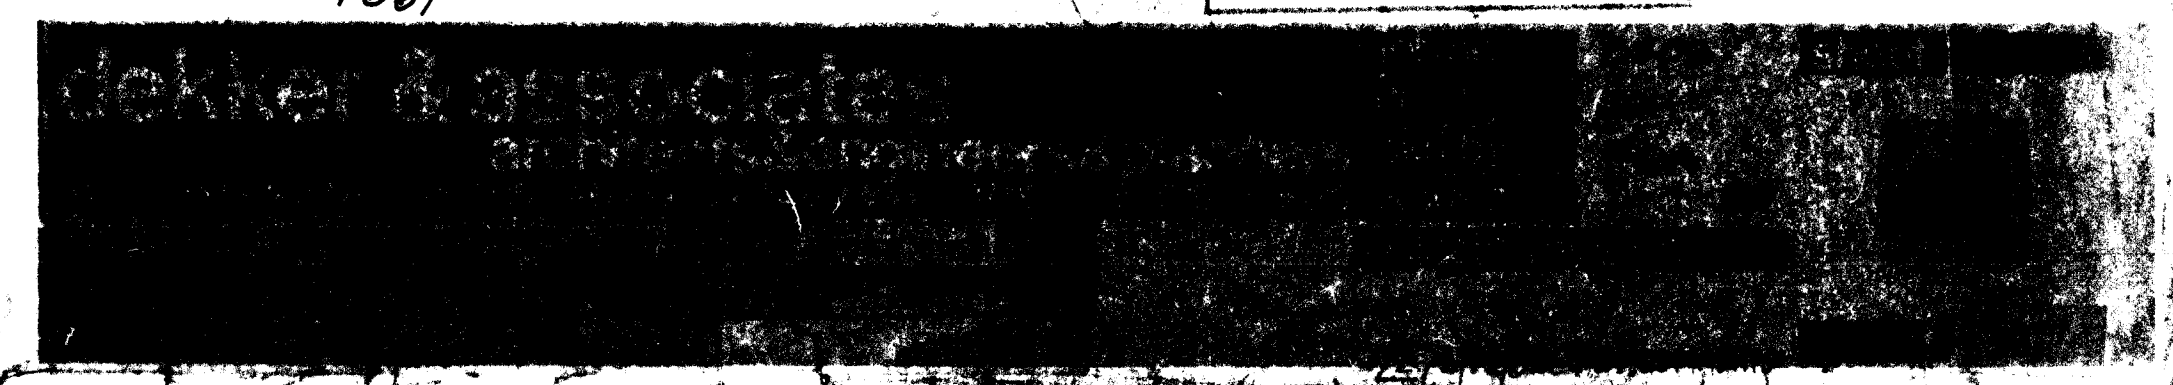

2-20-93 26 1661 2483

DOOR SCHEDULE

DOOR TYPES

(A) (B) (C)

3040 ALUM. HORIZ. SLIDER
W/ INBUL. GLASS W/ SCREEN

(A)

SECURITY GRILLE
OVER WINDOW (A)

WINDOW TYPES

SCALE: 3/8" = 1'-0"

NOTES & SYMBOLS:

- NEW CONSTRUCTION
- EXISTING CONSTRUCTION
- ① NEW & EXISTING CONSTRUCTION — SEE PLANS

5 ENDWALL DET.
25

6 CORNER TRIM DET.
25

7 CABLE TRIM DET.
25

8 FOUNDATION & FRAMING PLAN - NEW BLDG
25 SCALE: 1/8" = 1'-0"

4 DEMO. REMOVAL EXIST. MAINT. BLDG.
25 \$NEW WORK SCALE: 1/8" = 1'-0"

NOTE: REMOVE ALL TRIM, WIRING, SEVERE CONNECTIONS, EQUIPMENT, HANGERS
FOR WORK TO BE REMOVED. PATCH ALL ROOF PENETRATIONS FOR REMOVED
VENTS, FLUES AND MAKE WATERTIGHT
DEMOLITION \$NEW WORK NOTES:

- 1 REMOVE & SALVAGE TO OWNER.
- 2 REMOVE & RELOCATE.
- 3 ITEM TO REMAIN
- 4 REMOVED BY OWNER.
- 5 MOODY & REUSE

STO STEEL STUD NON-BEARING PARTITION OR PULL IN 24" O.C.
STO. STEEL STUD PARTITION 24" O.C. WITH 5/8 TYPE 'X'
GYPS. BR. BOTH SIDES FOR 1 HOUR RATING.

EXIST. TO REMAIN
EXIST. TO BE REMOVED.

FURRED WALL - 24" - STD GYA STEEL STUDS @ 24" O.C.
W 3/8 GYP BR. - ROOM SIDE ONLY











26 166 2583







6'x6' 90WLM

1-STD CONT. 200 EBM

TURN DOWN EDGE

dekker & associates		job no.	B200	sheet
architects&engineers&planners		dwn by	JGH	
243 San Mateo NE Suite R15 Albuquerque New Mexico 87102		chkd by	ALW	
		issued	2-1-83	25
PUERTO DEL SOL GOLF COURSE		1700 girard st		
albuquerque n.m.		no date revision		
		A 1/1/83 PLAN CHECK		
		A 2/1/83 REVISED		
		A 2/20/83 ADJUT.		

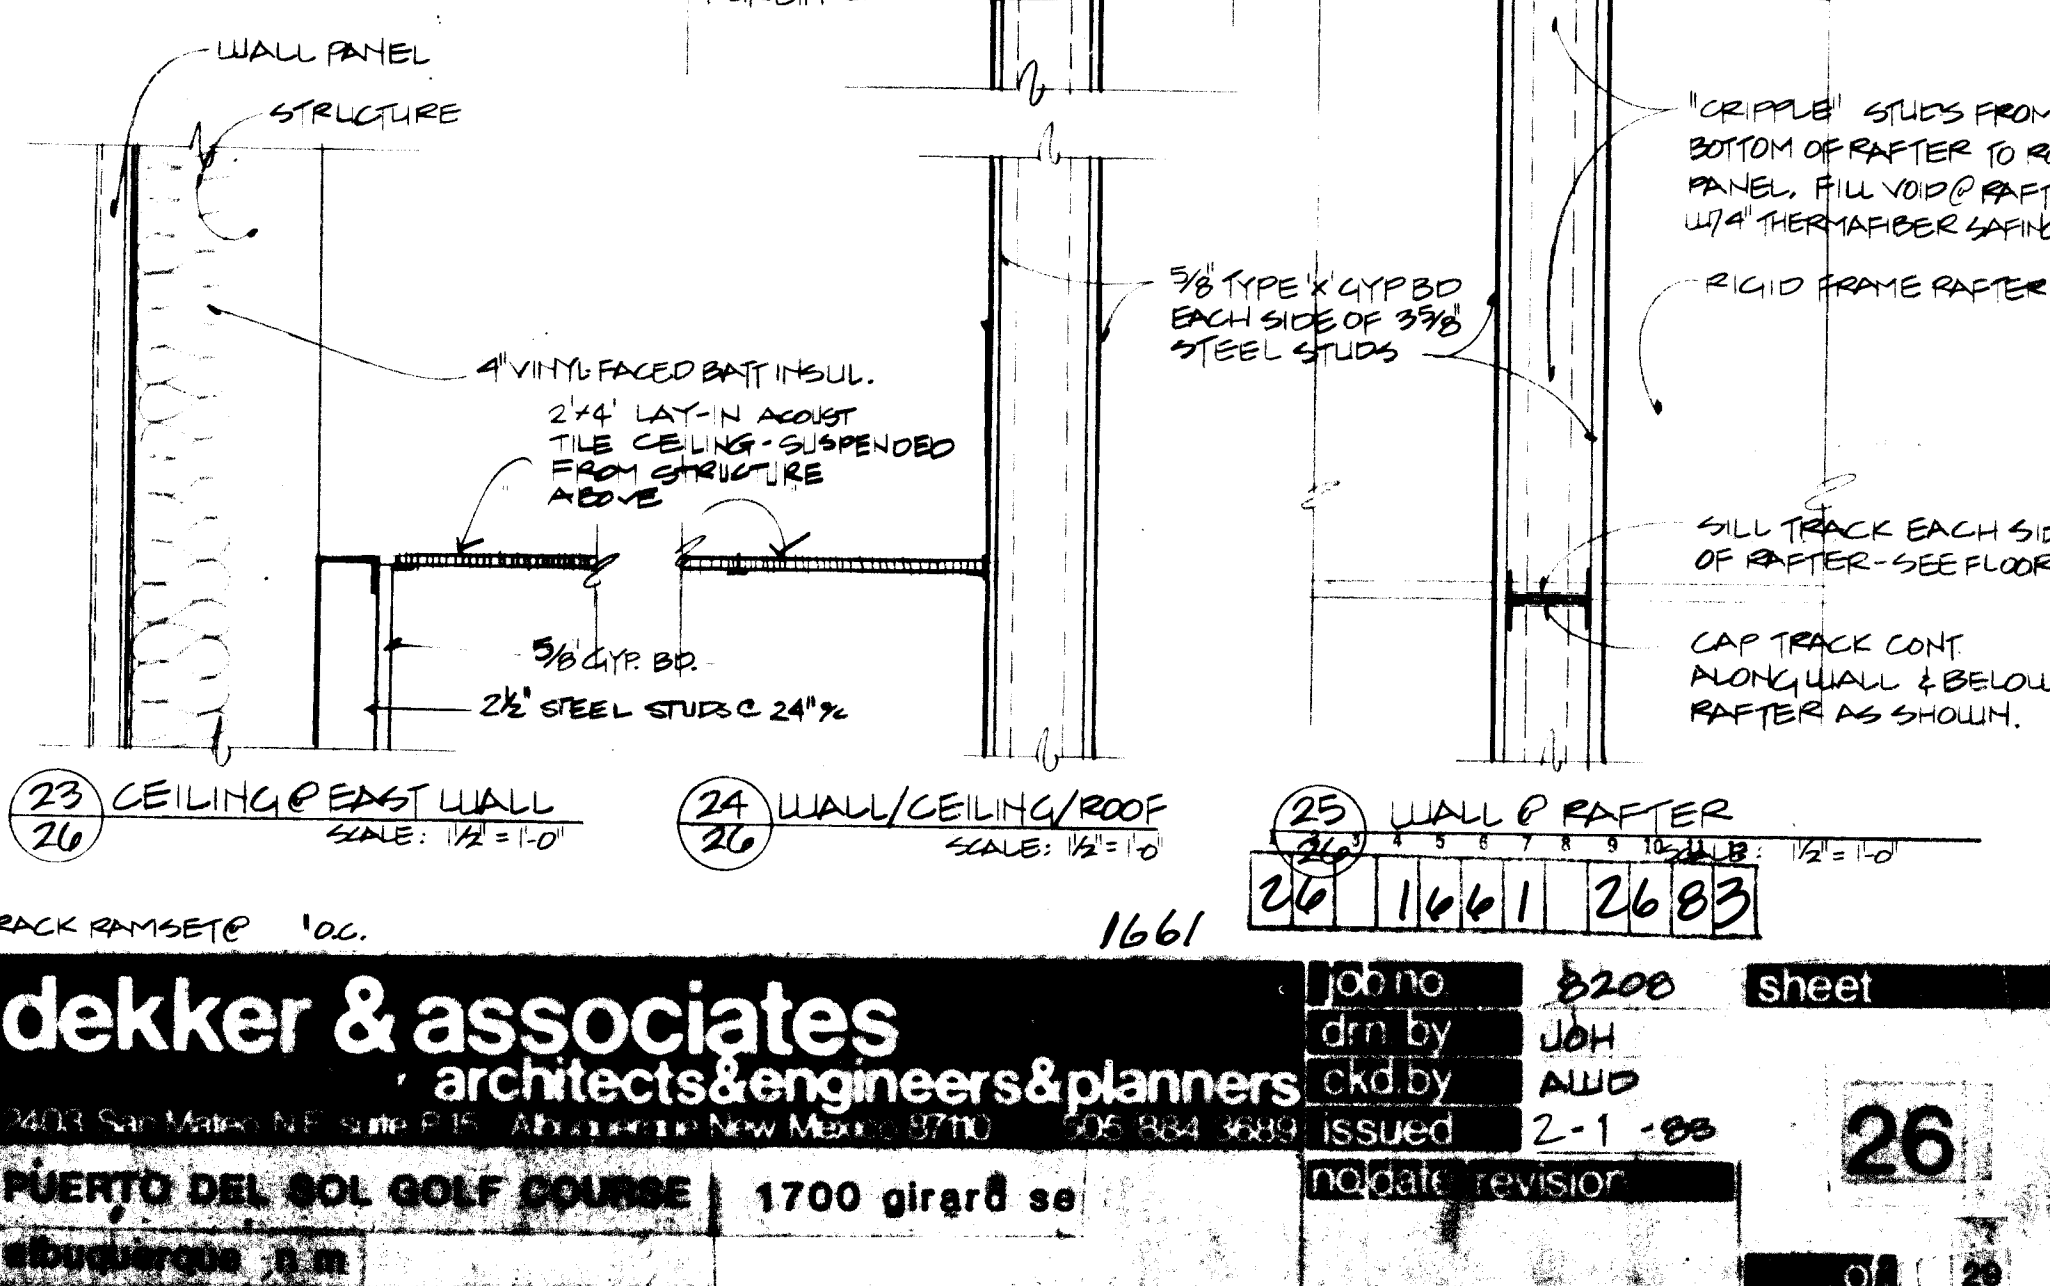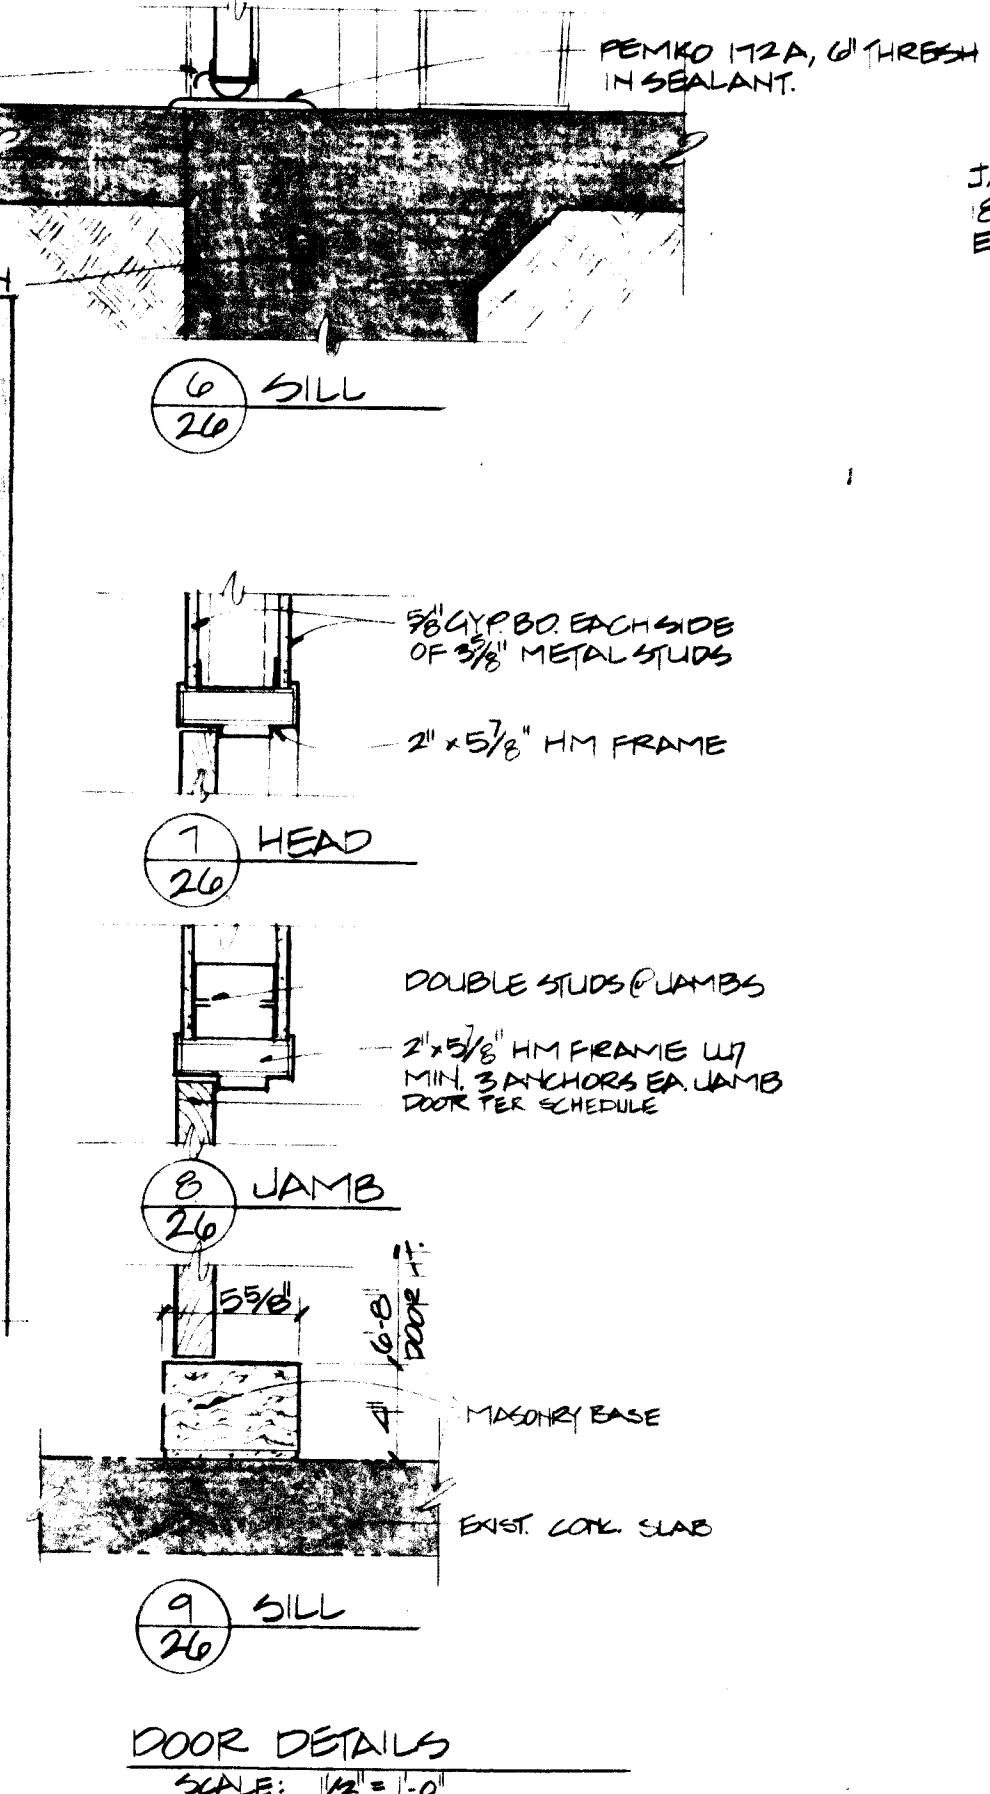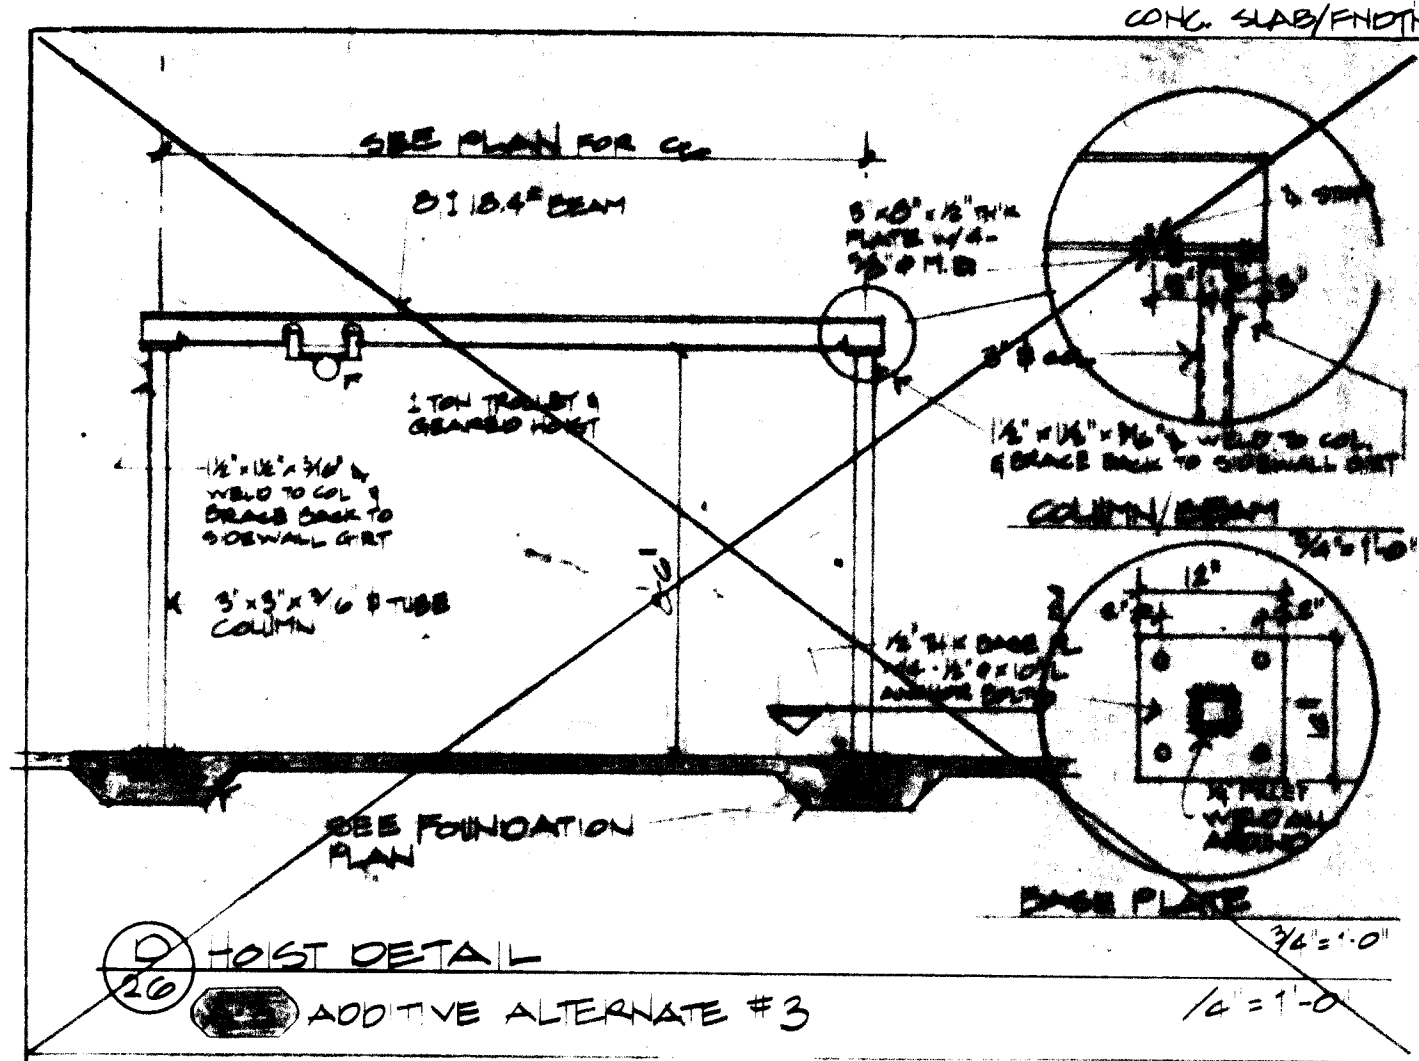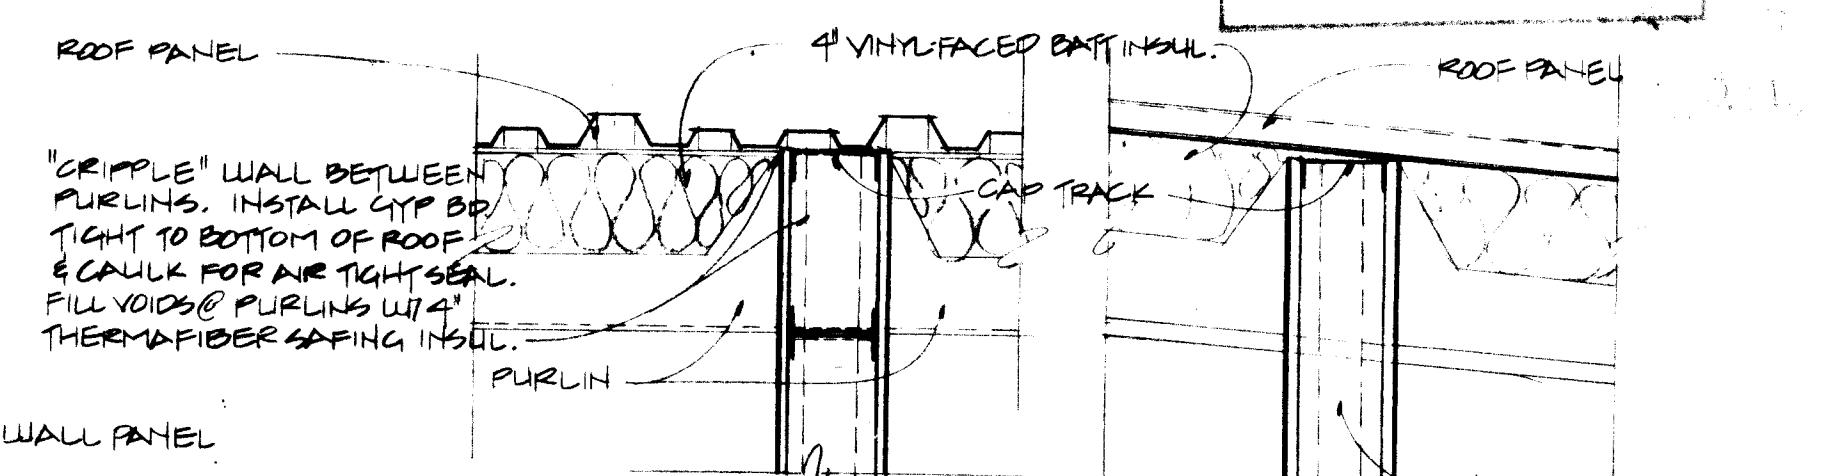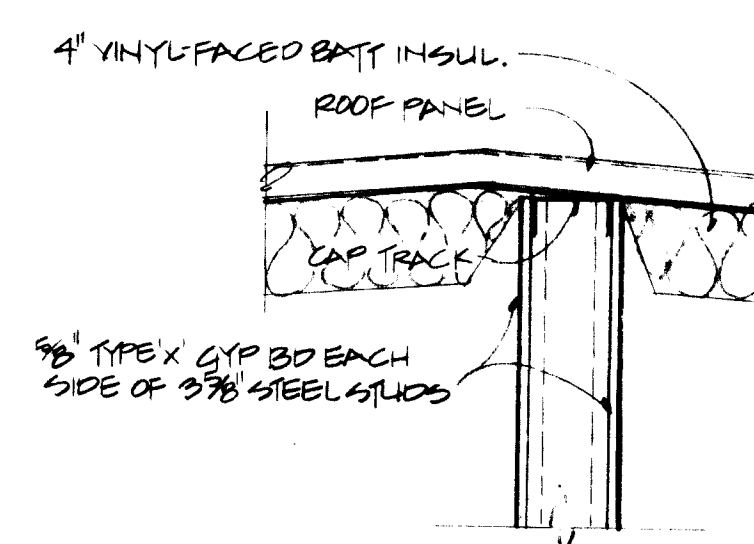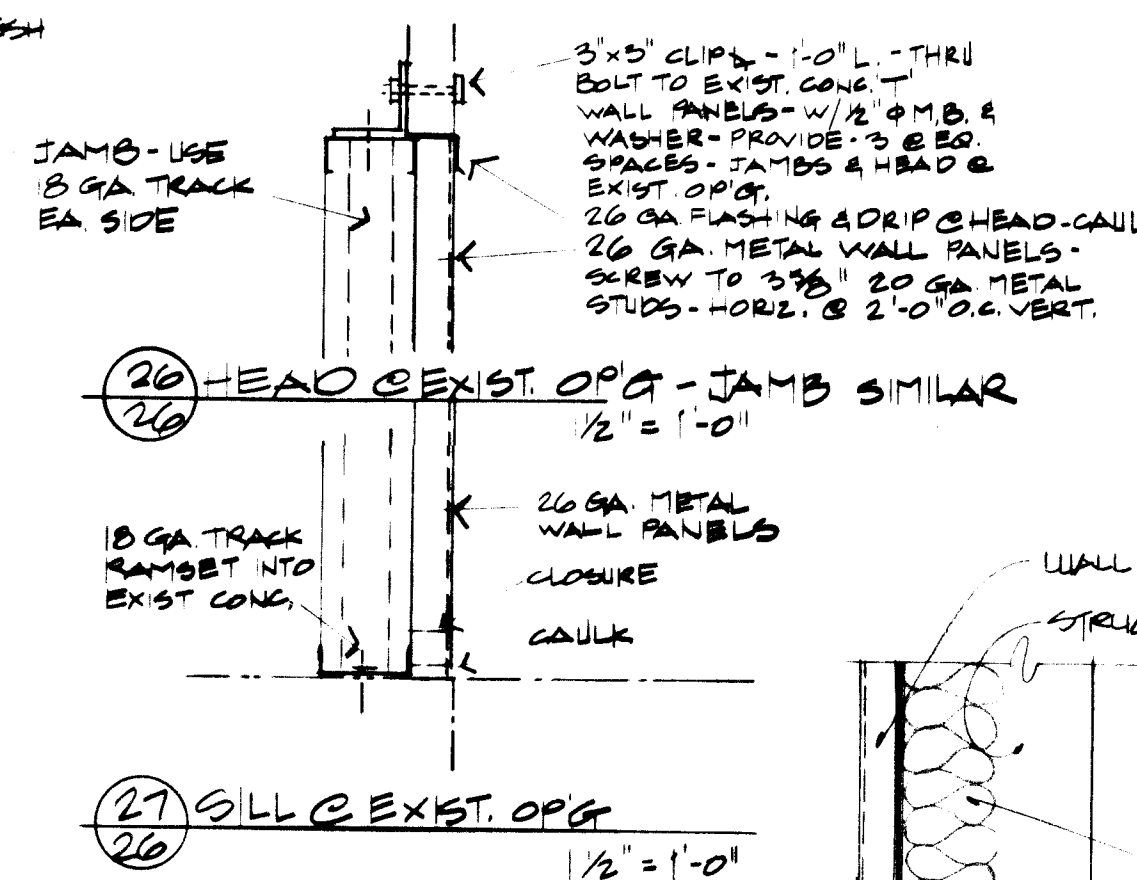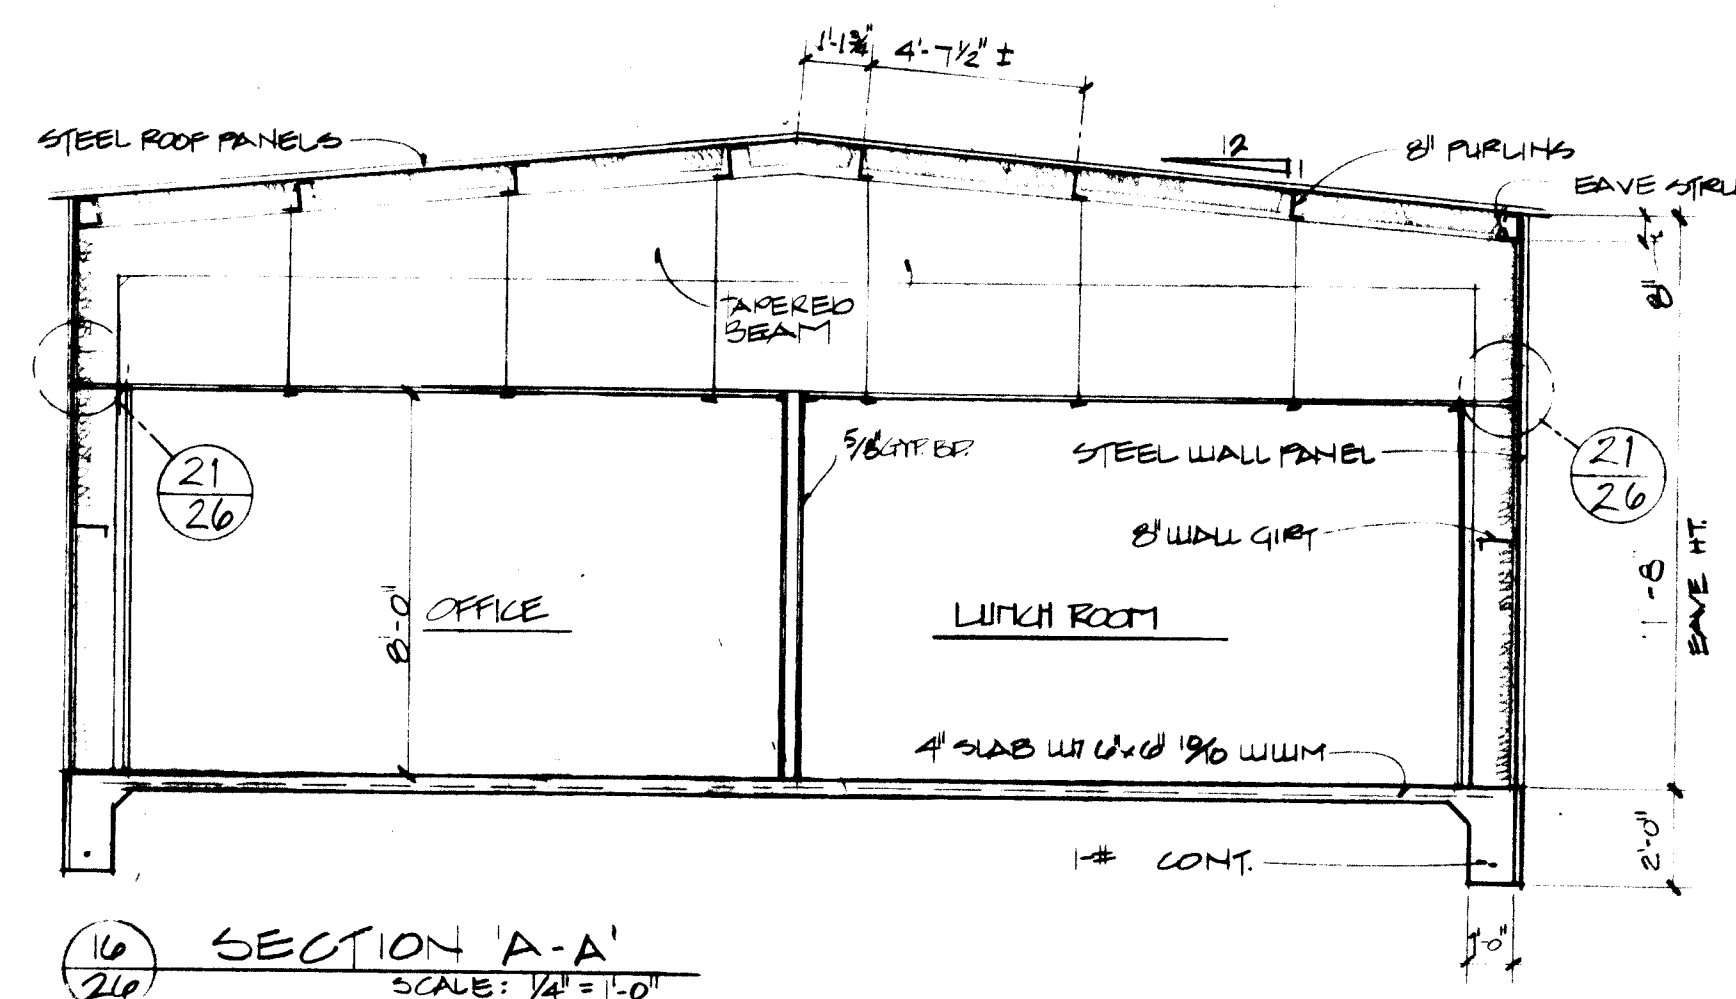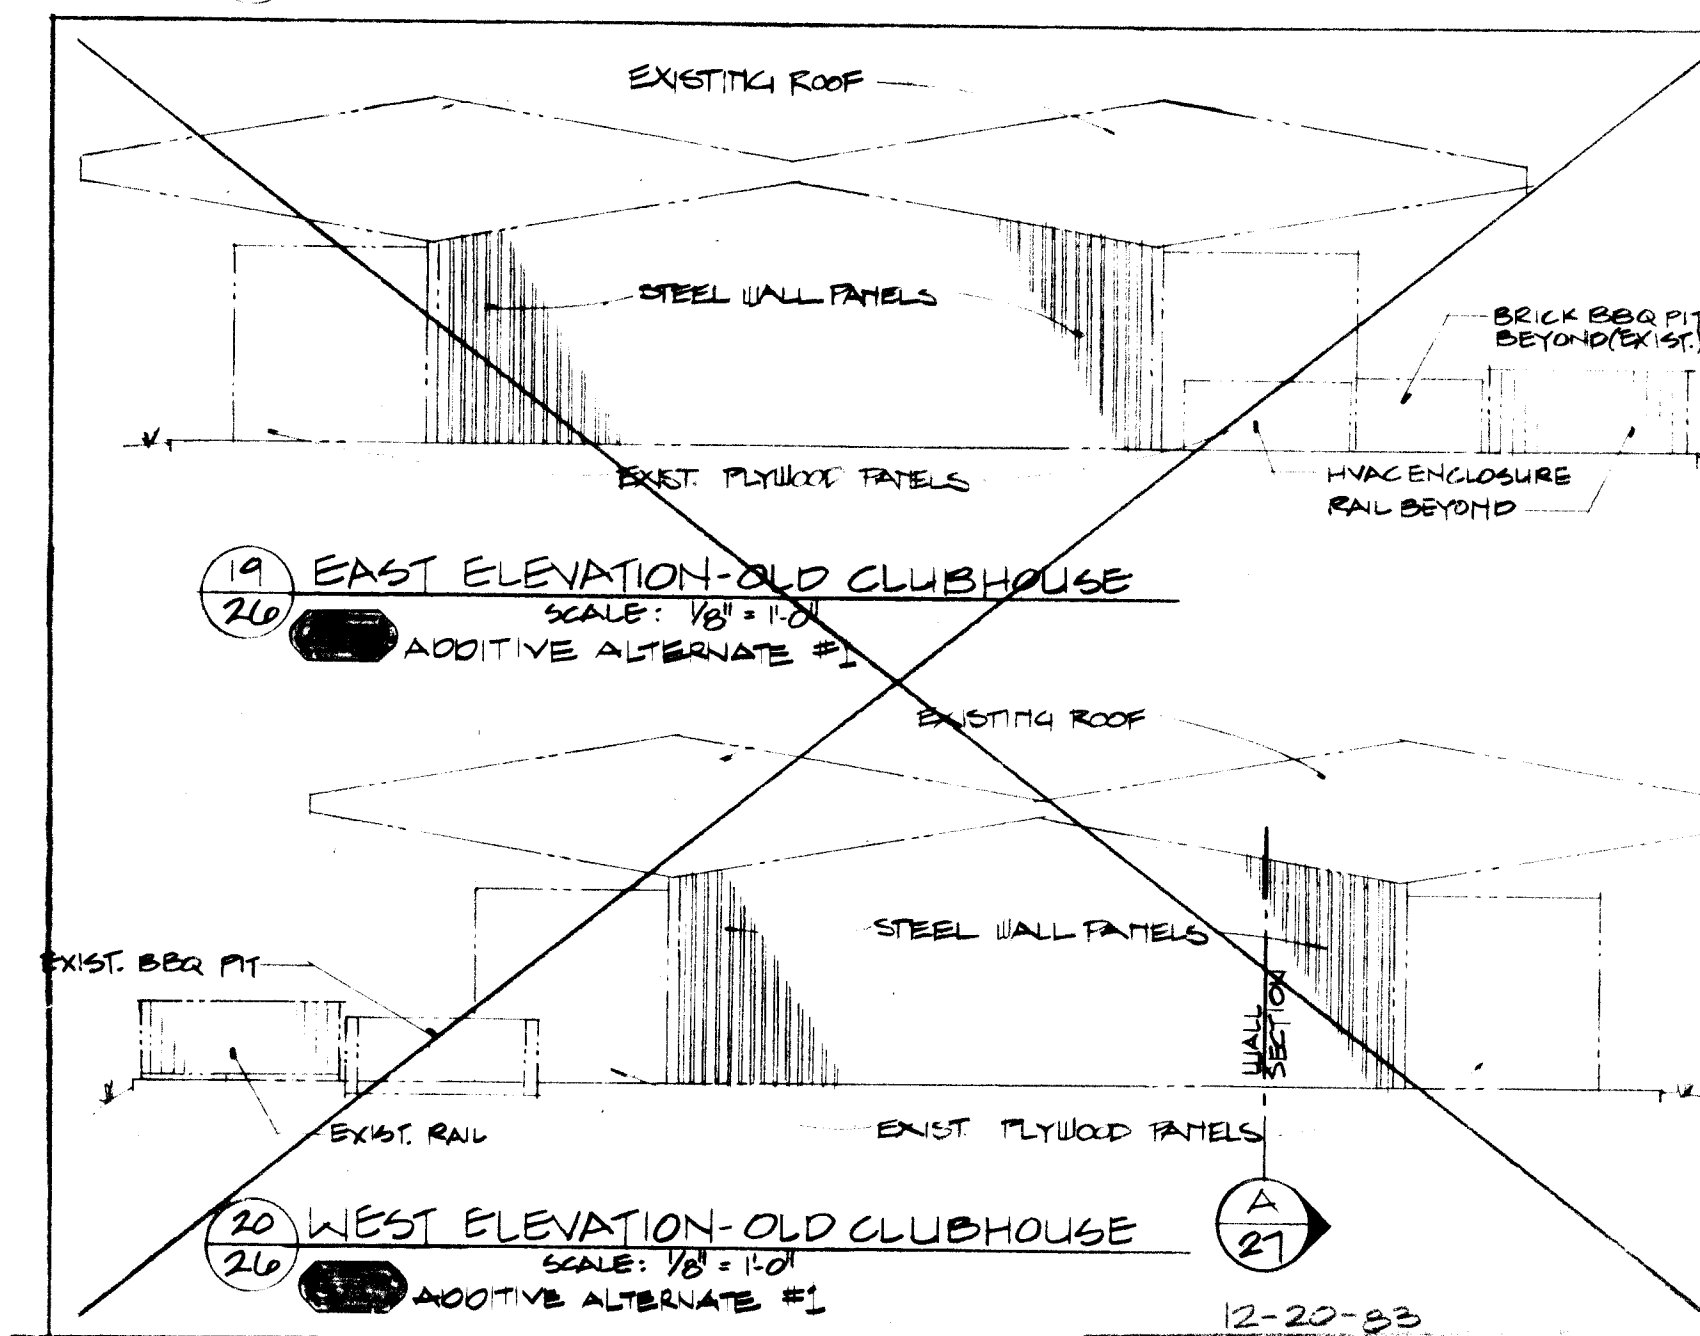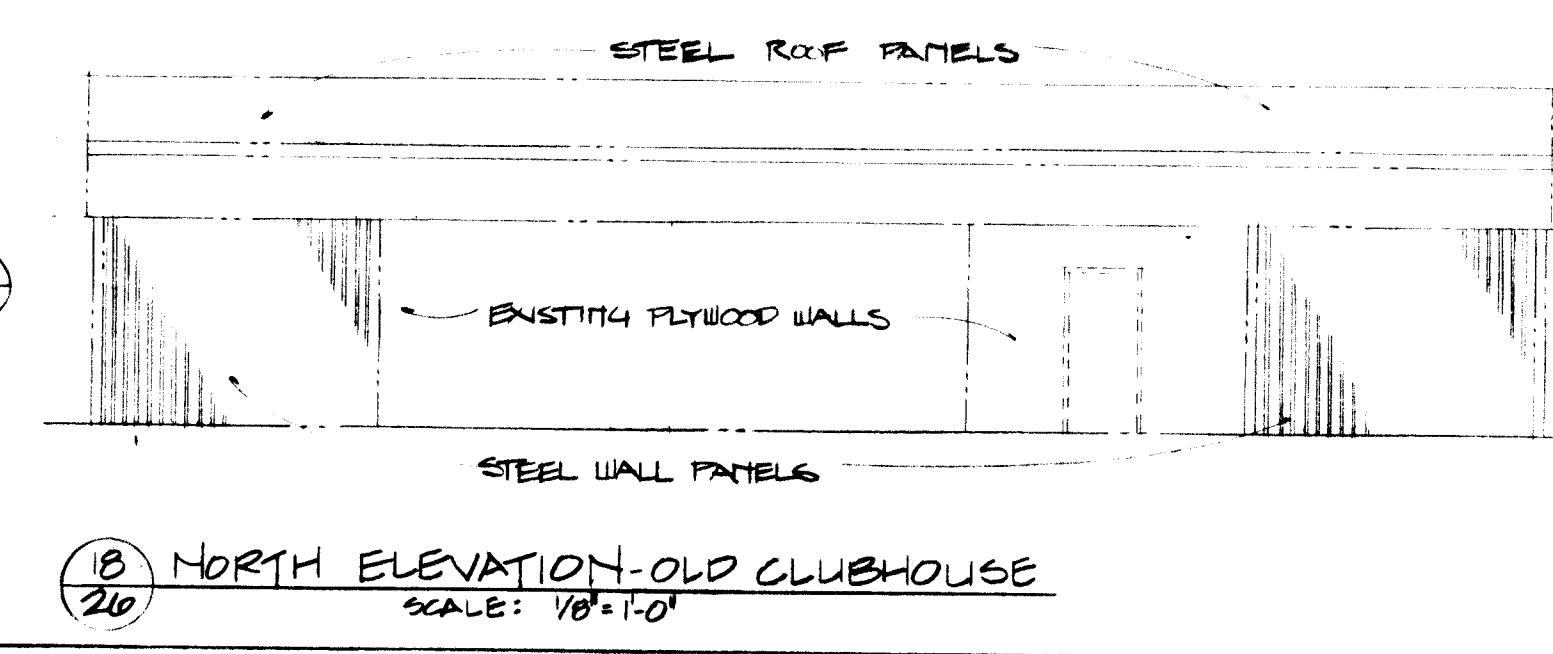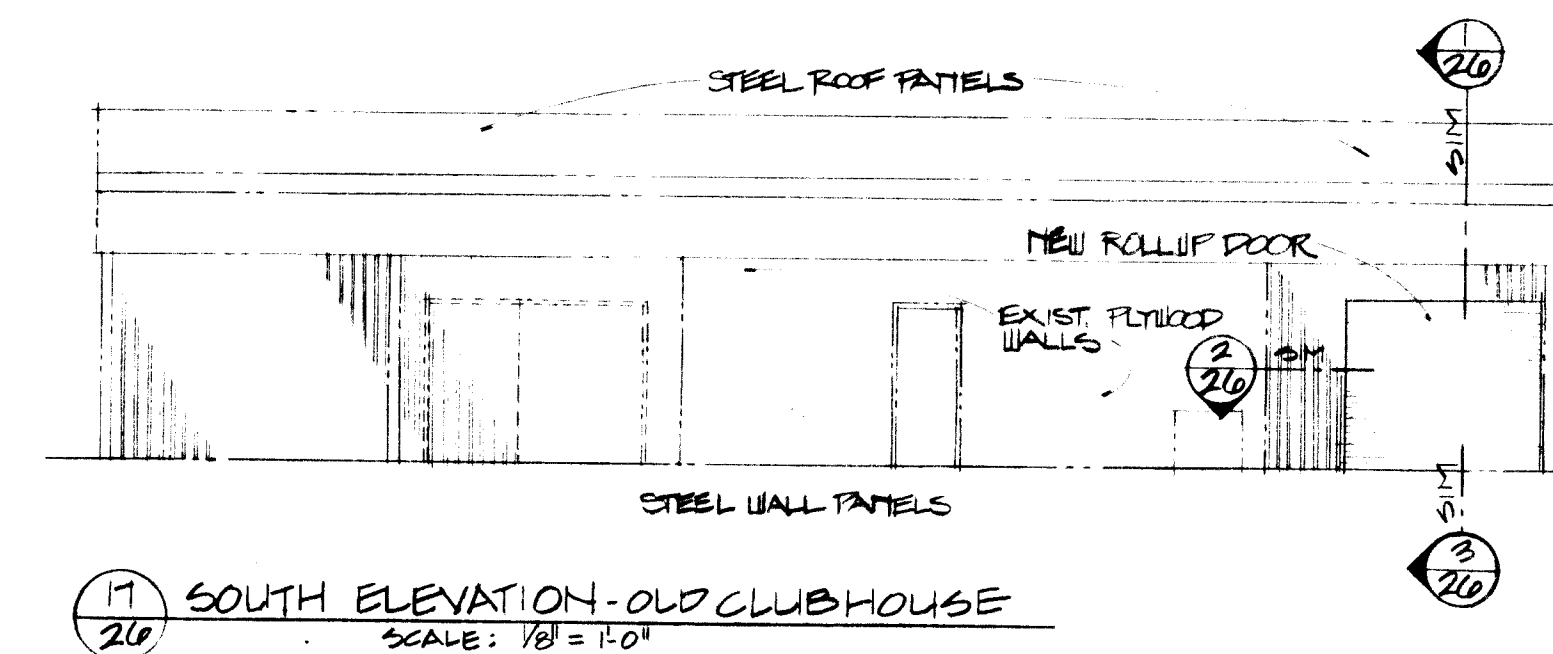

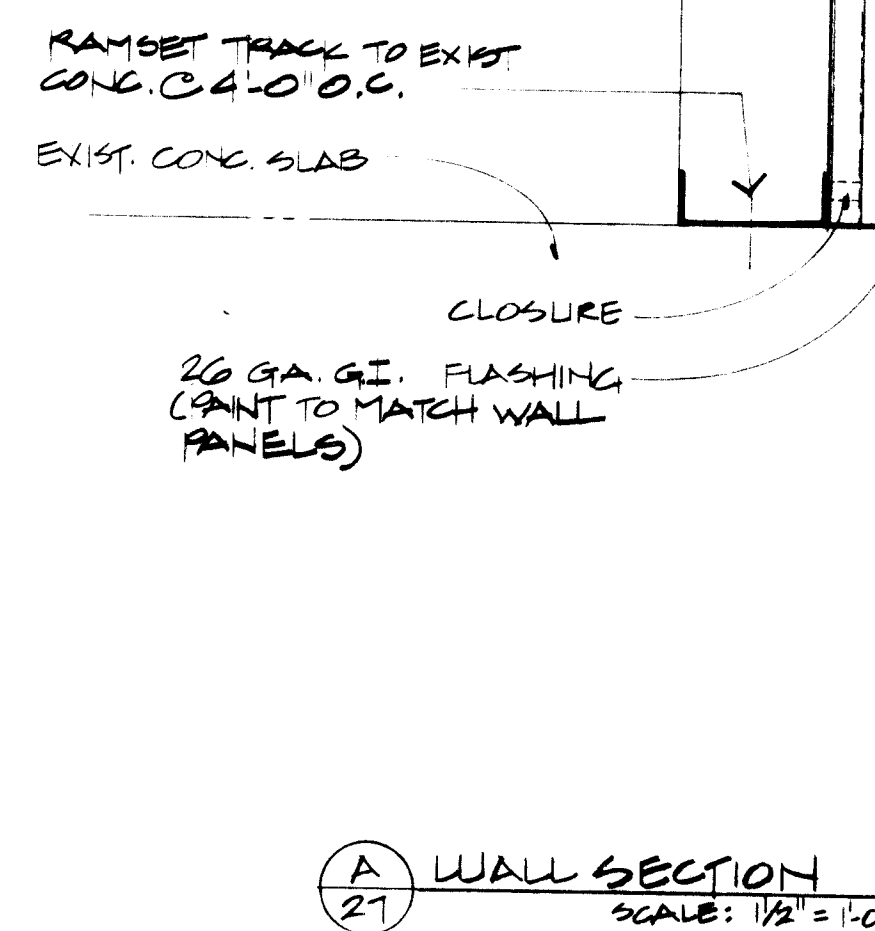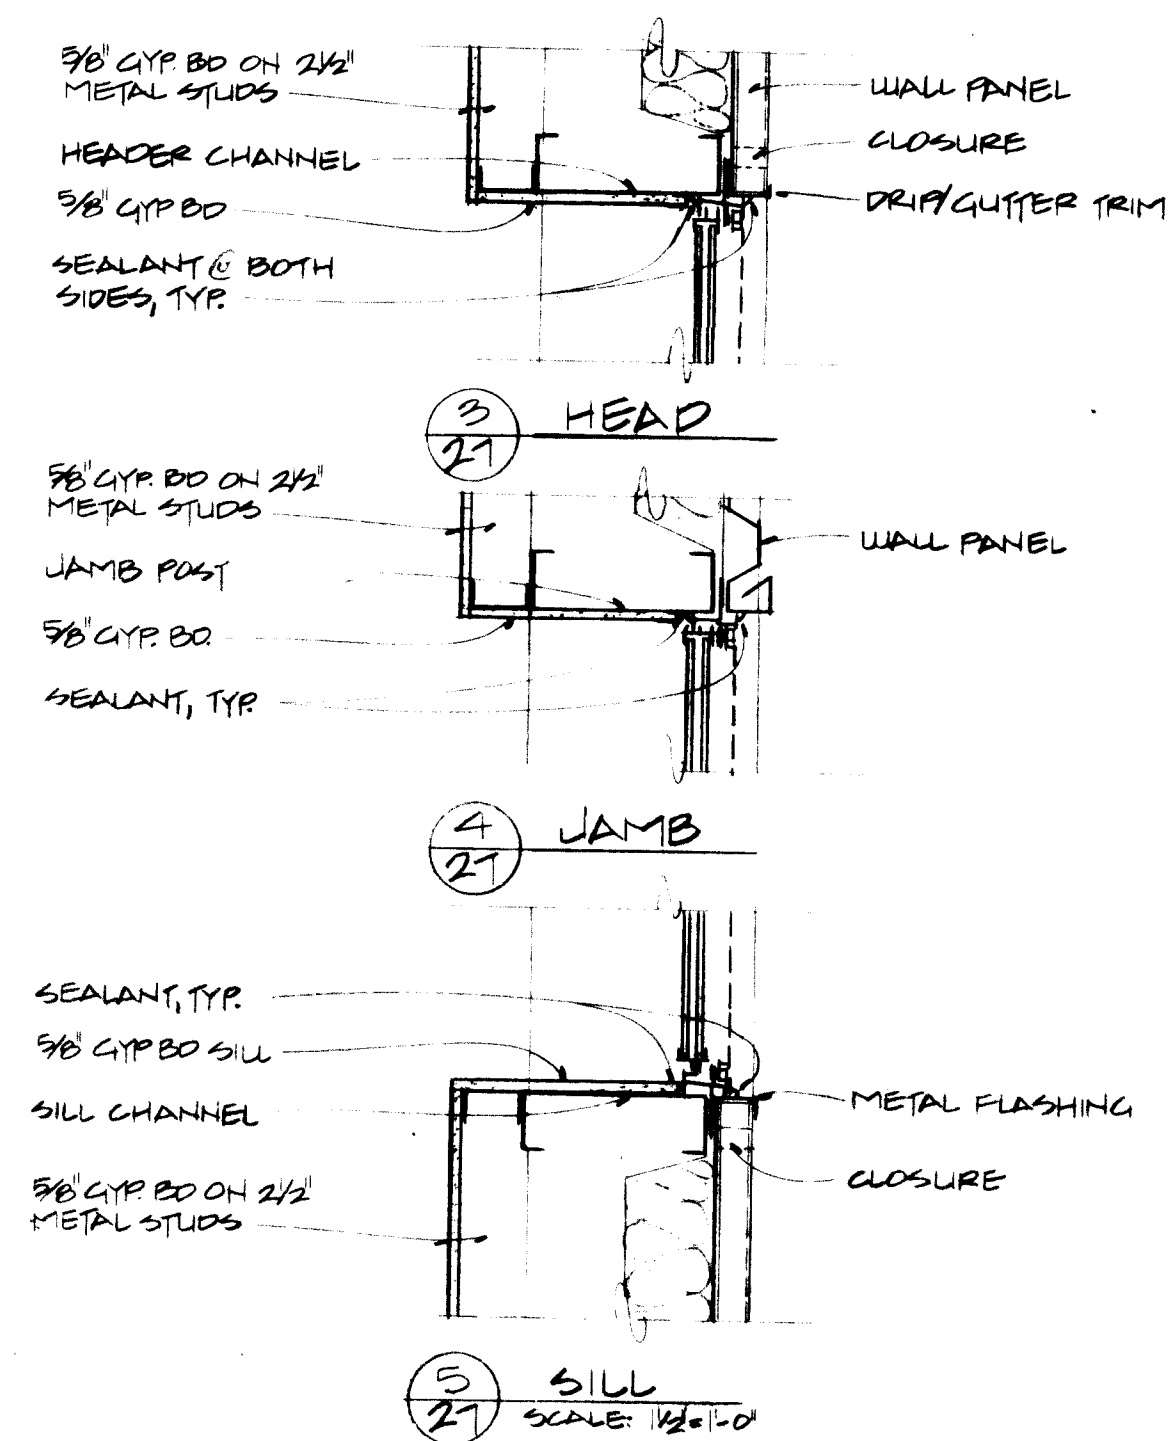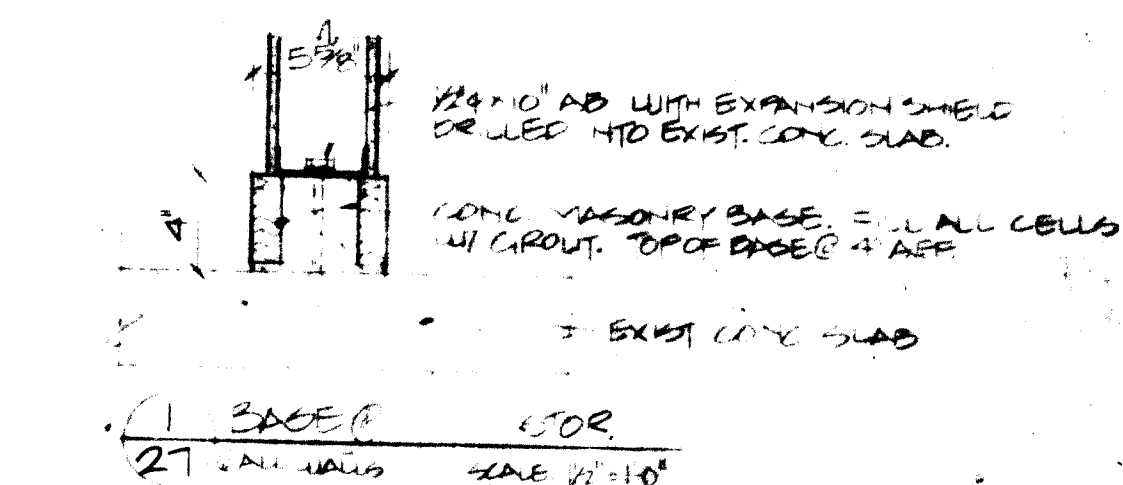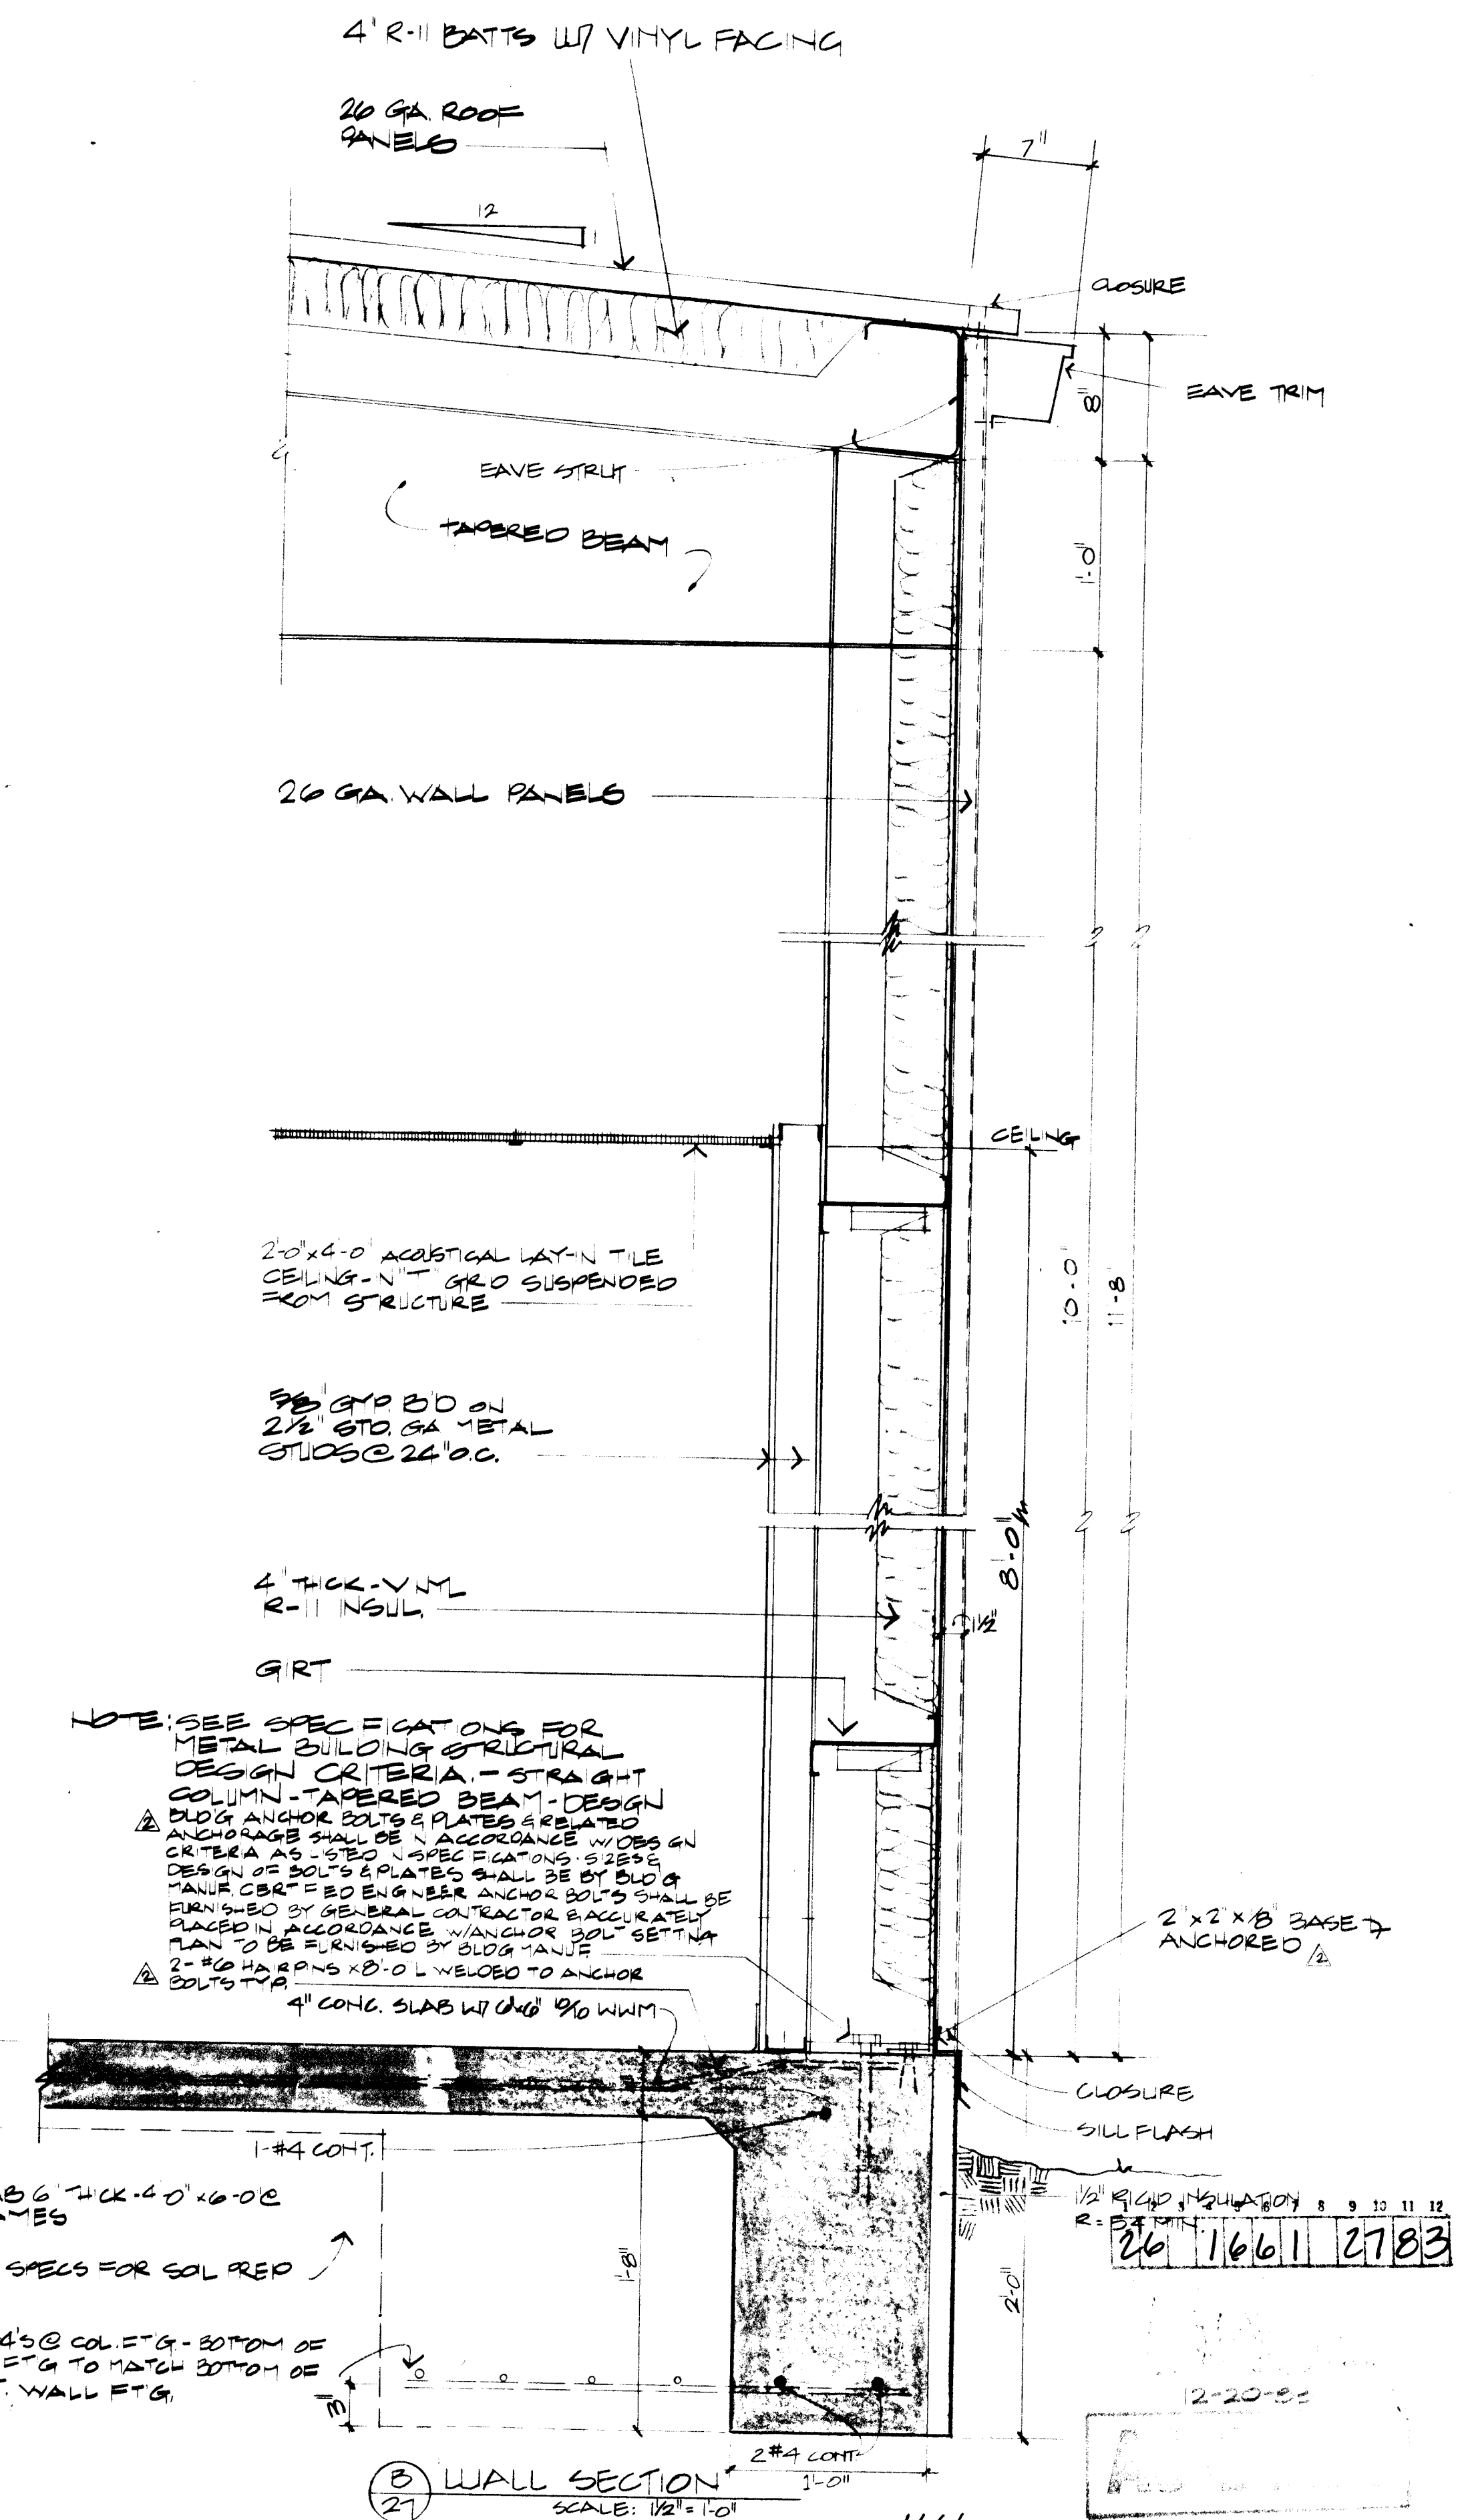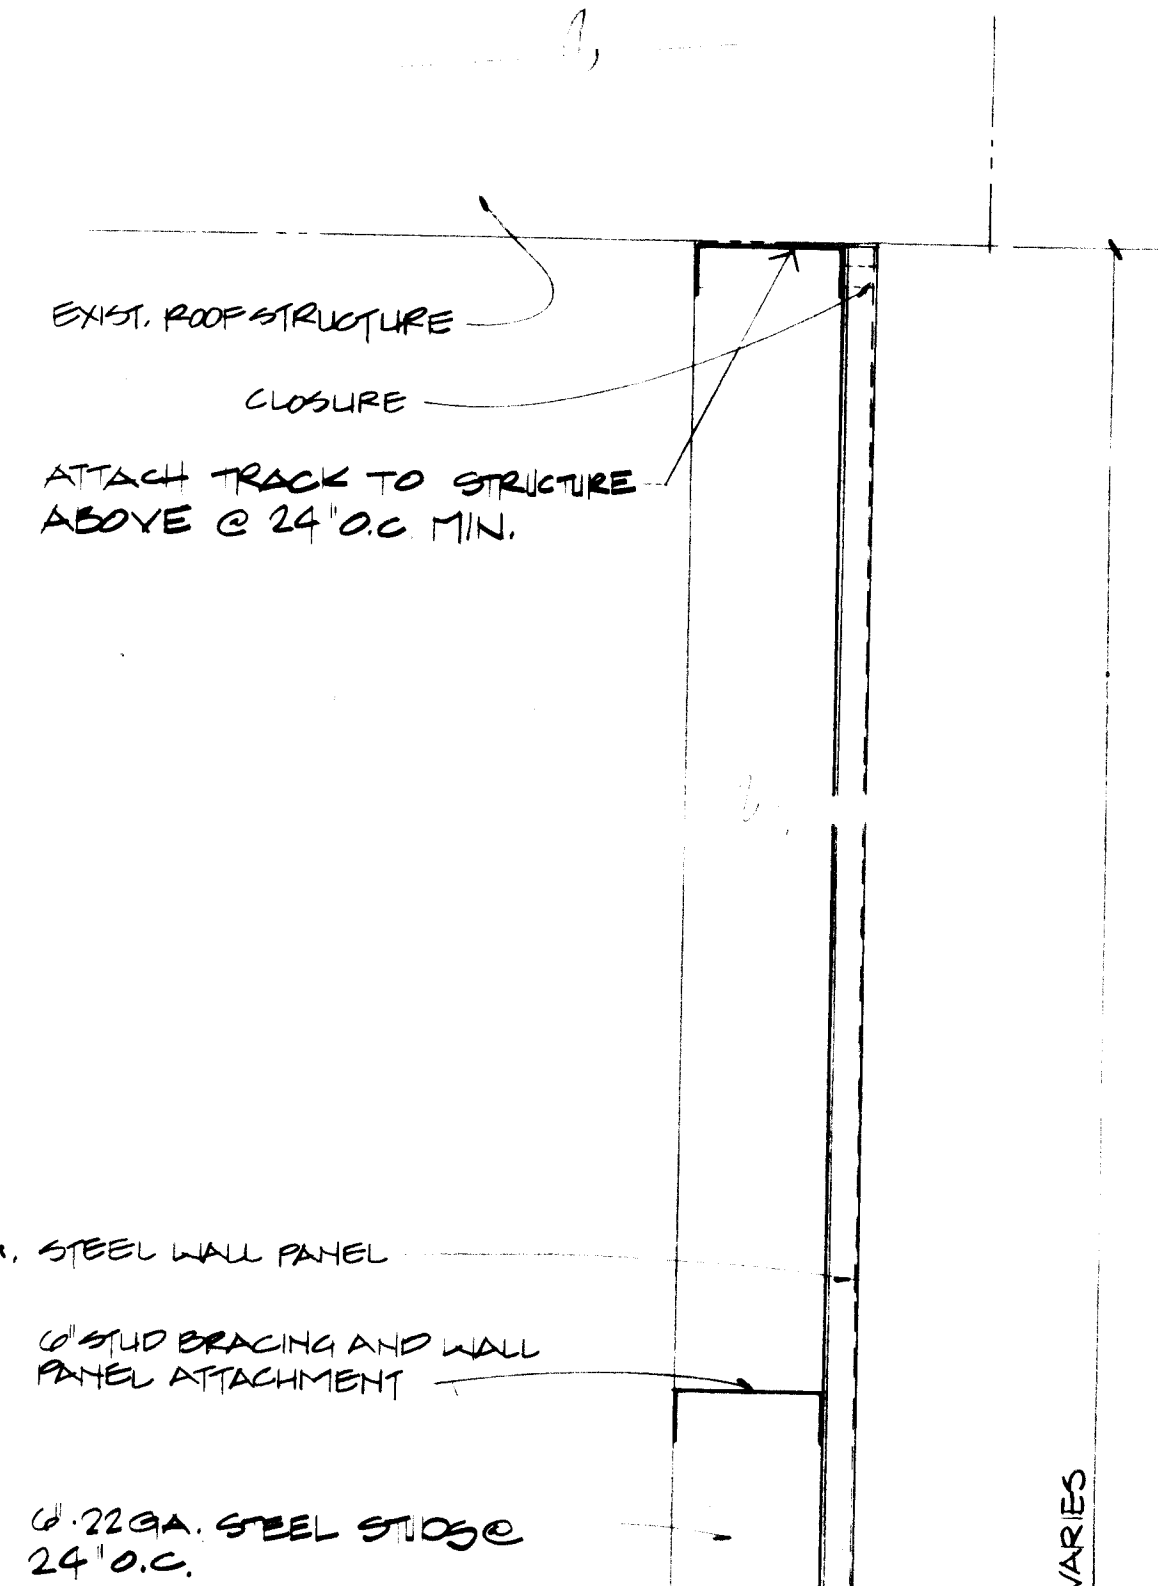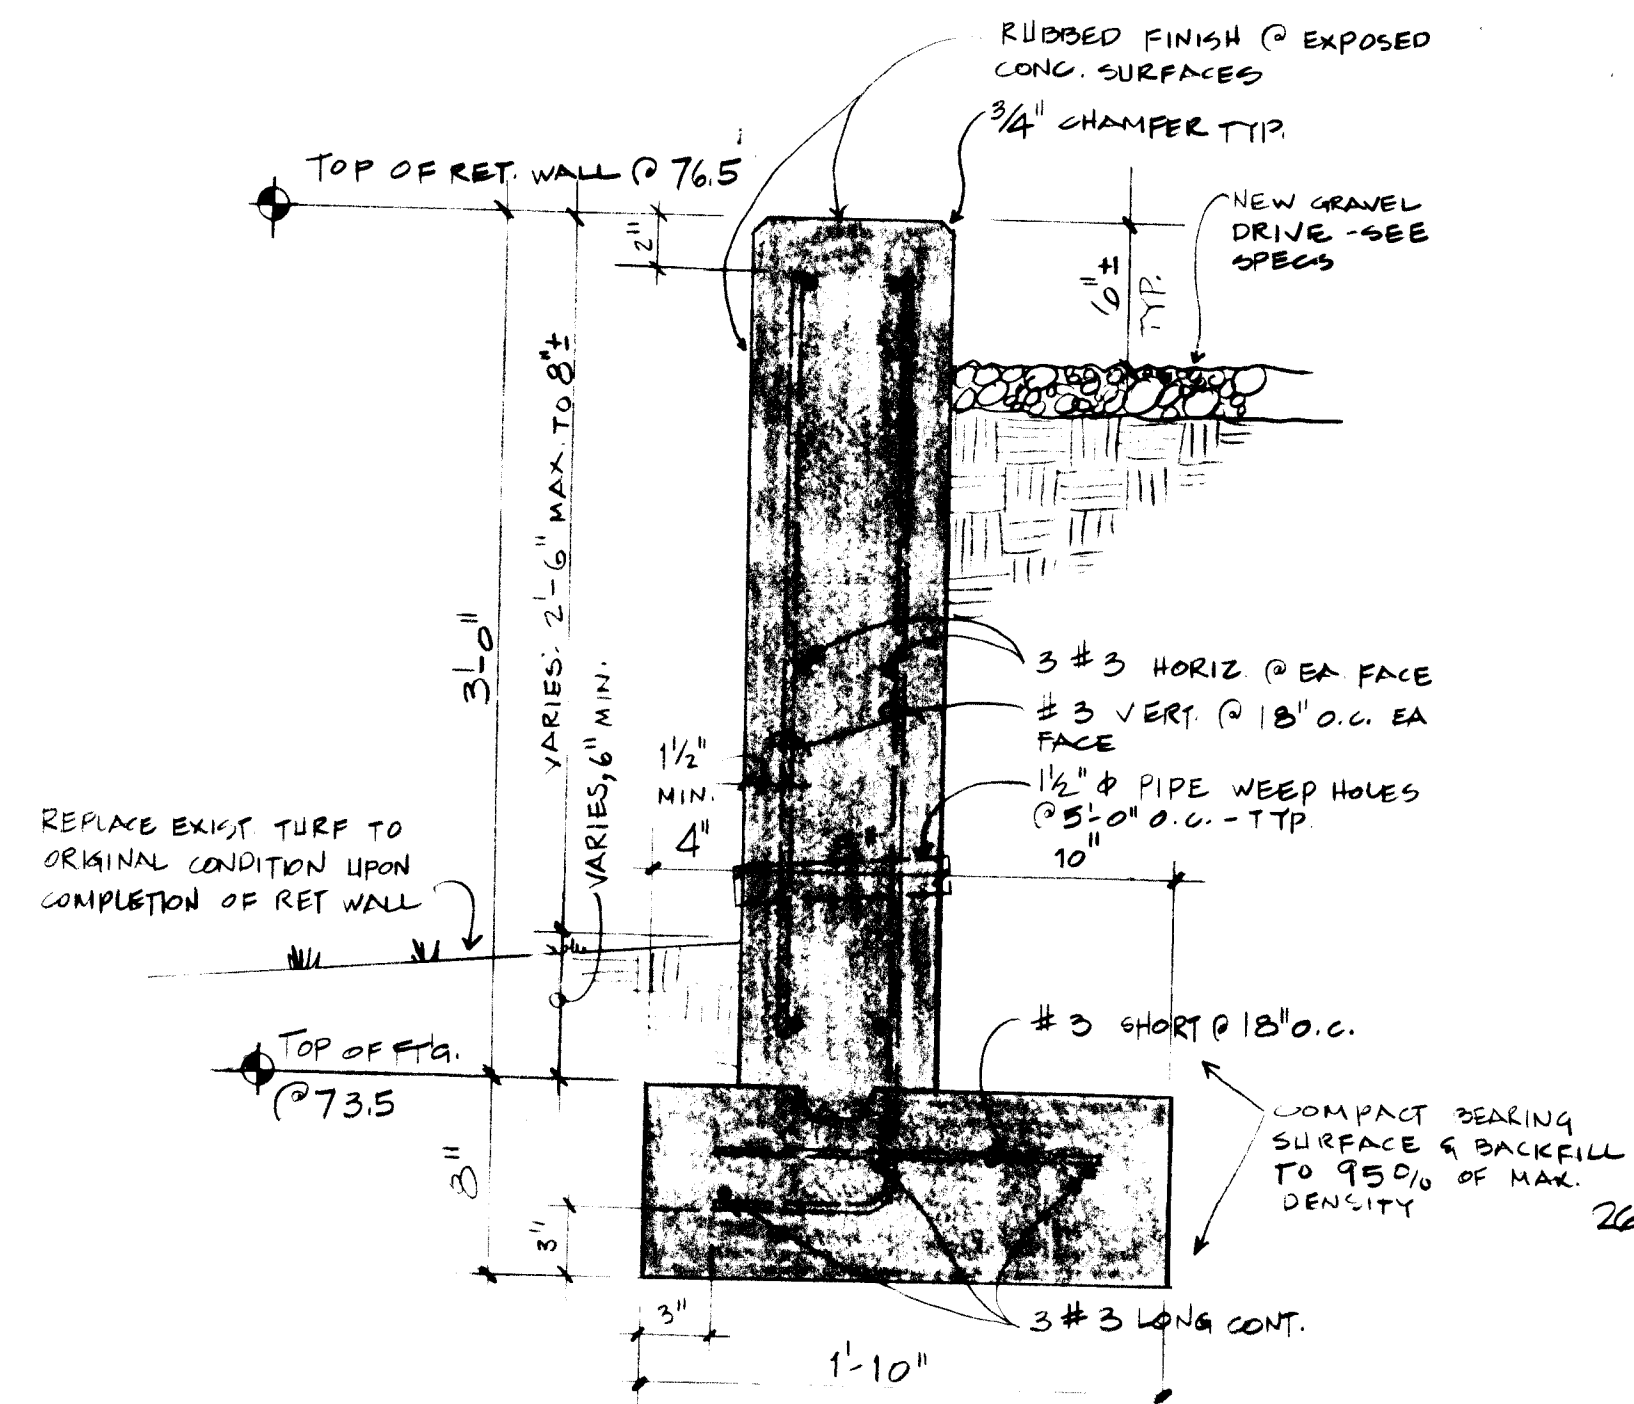

MECHANICAL CONTRACTOR NOTE:

These Drawings reflect information on utilities gathered by site inspection, discussions with local utilities engineering officials, and previous construction drawings, provided to the Architect. It is possible that the exact location of lines in the immediate vicinity of the proposed building may be slightly different from the location shown on this Drawing. If additional lines are encountered, they shall be exposed and identified by this Contractor. Where additional lines and/or differing locations are encountered, this Contractor shall request that the Architect make a ruling as to any necessary change of materials, re-routing, abandoning or relocating of such lines. All lines encountered that interfere with construction shall be relocated to clear construction (if active) and shall be removed if inactive by this Contractor under this contract. All bidders are cautioned to investigate site conditions before submitting their bids. All existing piping shall have minimum earth coverage and depths shall be adjusted as required to provide minimum coverage due to new grades or construction. Contractor shall pay for any and all costs of permits, line extensions, meter installation, etc., as required by local governing utilities engineering officials.

GENERAL MECHANICAL UTILITIES NOTES:

This Contractor shall be responsible for the complete installation of all work related to mechanical utilities including: trenching; backfill; supports; cleanout pads; service stops and boxes; service lines; testing; cleaning; and any work not accepted by the Architect or Mechanical Engineer due to improper workmanship or lack of proper coordination shall be removed and correctly installed at the Mechanical Contractor's expense, as directed.


MINIMUM DEPTHS BELOW GRADE (COVER): WATER -- 42" SEWER -- 30"

Refer to Architectural Plans for finish and existing grades.


This Contractor shall coordinate cutoff of existing utilities for new connections with local utilities engineering officials and shall conform to their requirements.

Utilities connection points are approximate only. Each bidder shall satisfy himself as to existing site conditions before submitting his bid. No allowance shall be made after the contract is awarded to compensate for lack of pre-bid inspection of the site by the successful bidder. Verify exact size, location and depth of existing sewer before setting any new inverts. Verify exact size, location and pressure of existing water mains.


Contractor shall connect new service lines as approved and directed by local governing utilities engineering officials and conform to their requirements.

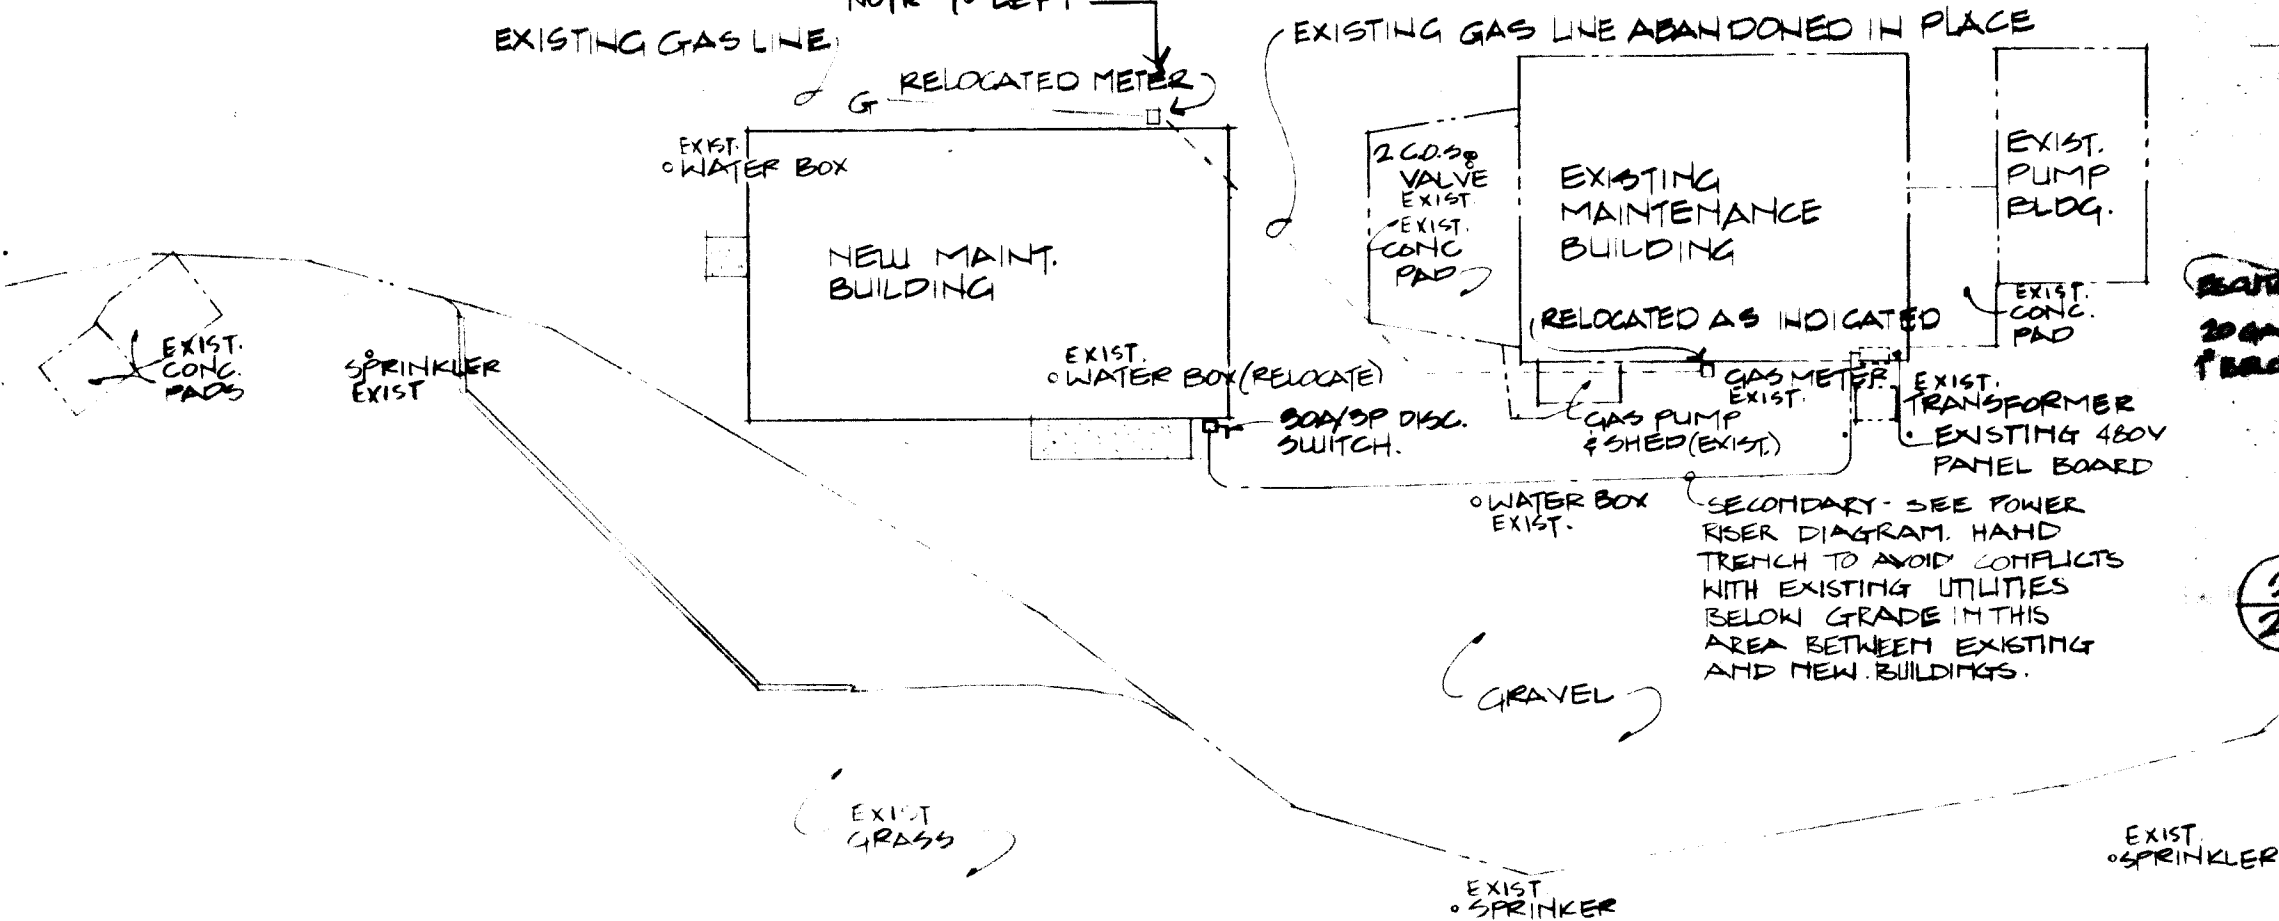

UTILITY SITE PLAN
SCALE: 1" = 20'-0"

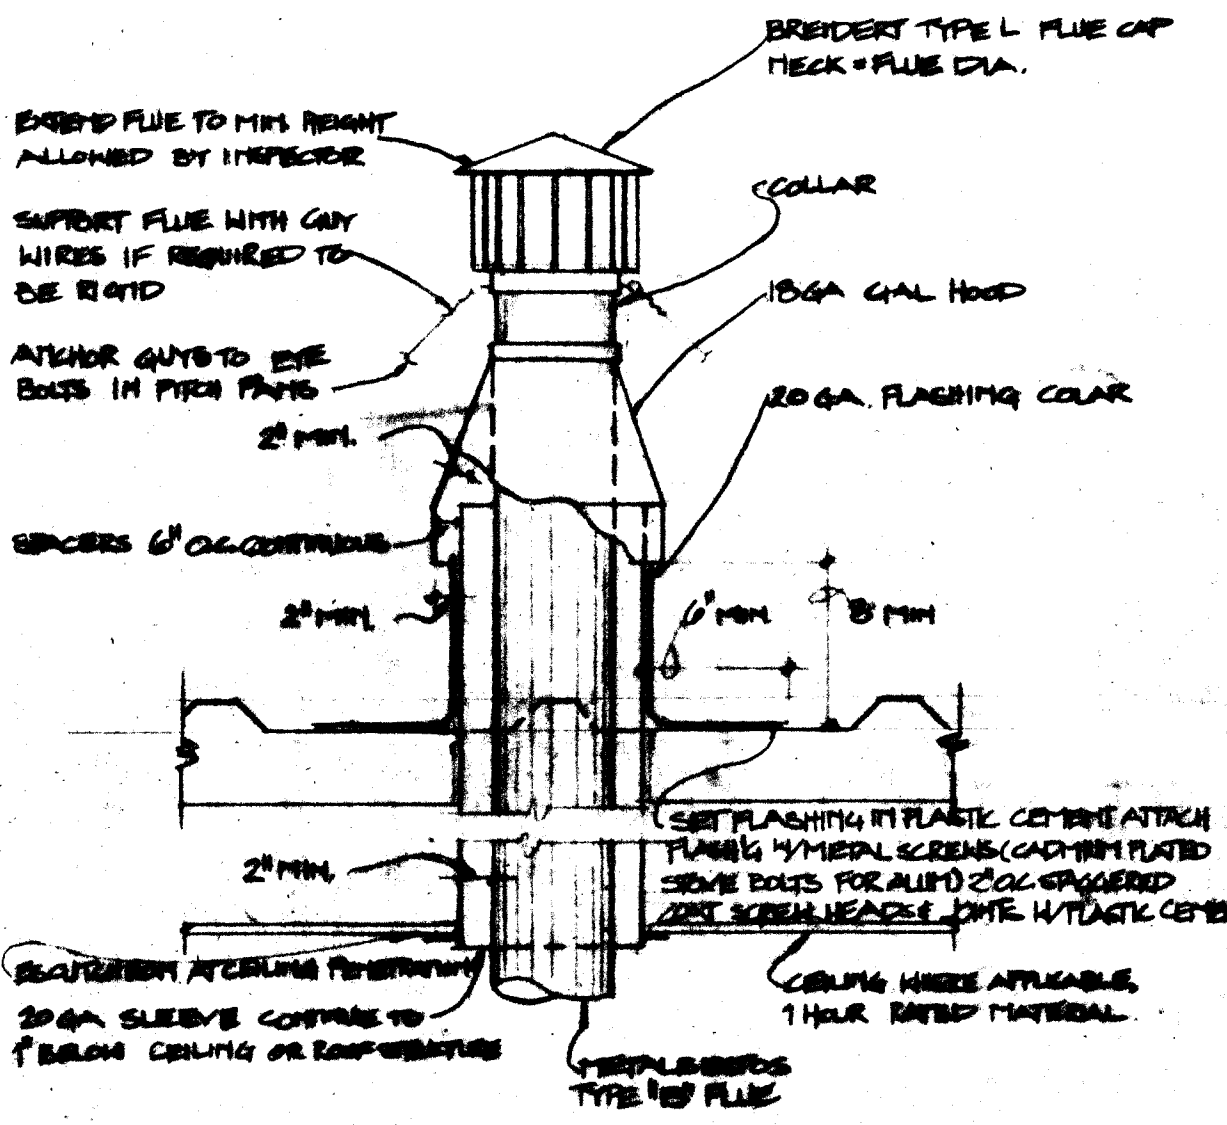

TYPICAL FLUE DETAIL
SCALE: 1/4" = 1'-0"

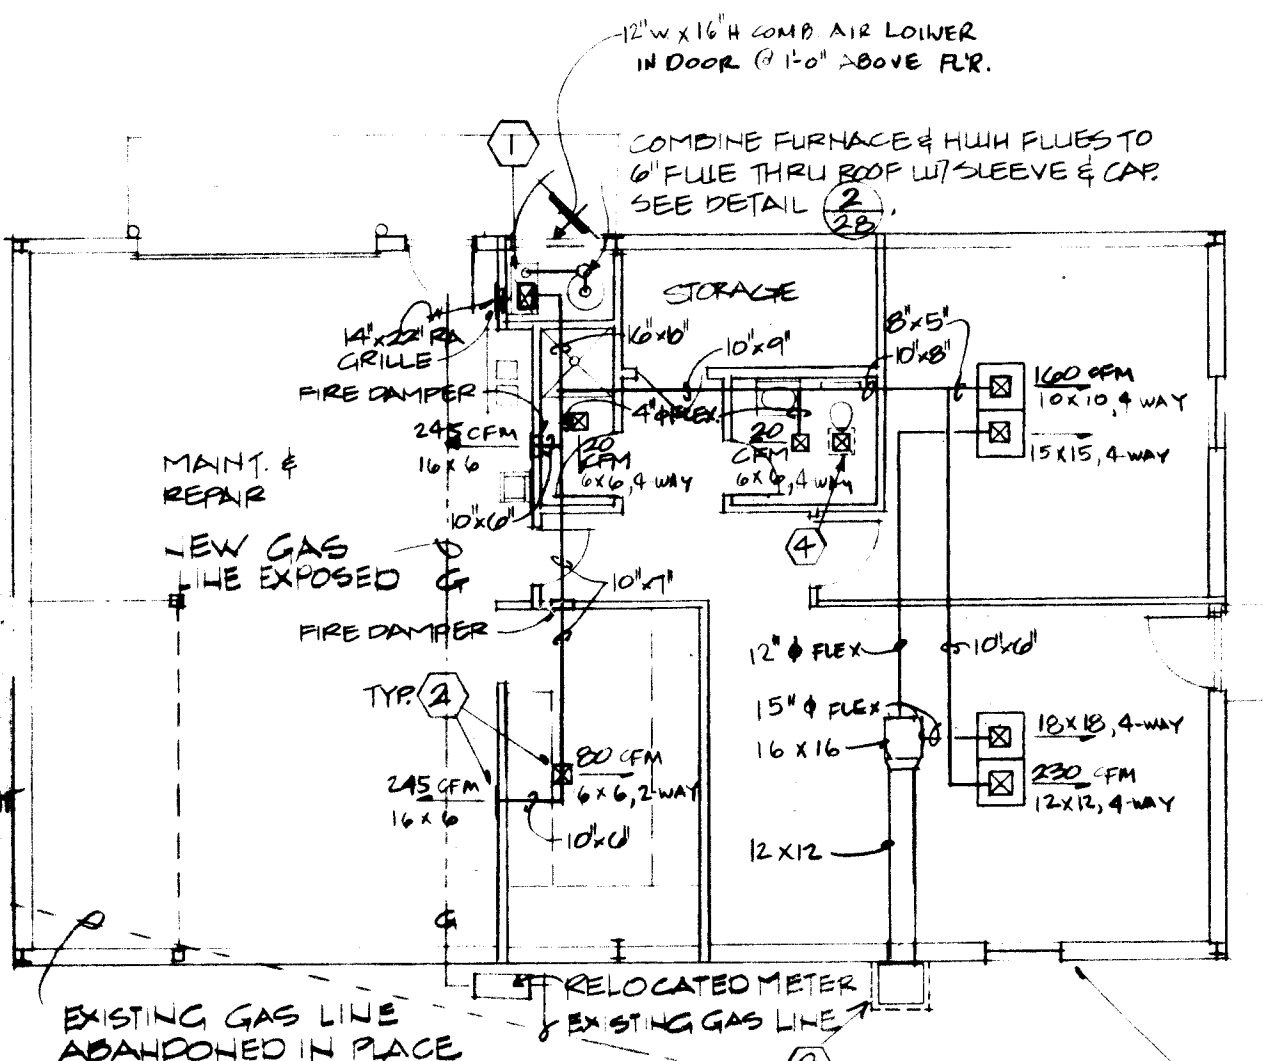


MECHANICAL FLOOR PLAN - NEW MAINT. BLDG.
SCALE: 1/8" = 1'-0"

NOTE: BLDG. POSITION ON SITE IS SHOWN. SEE UTILITY SITE PLAN FOR CORRECT ORIENTATION.



MECH. FLOOR PLAN NOTES:

- FURNACE TO BE FRANK 30A41, 100,000 BTU/H INPUT, 100 CFM @ 0.3 IN. W.G. MIN. INSTALL W/ 100% SAFETY CUTOFF & ADJUSTED FOR ALTITUDE, 1/2" GAS CONN. W/ 5/8" FLUE. SEE NOTE ON PLAN FOR ROUTING OF FLUE. RETURN AIR LOCATED IN SIDES OF FURNACE. MAKE FLEX DUCT CONNS. TO FURNACE FOR RETURN AND SUPPLY DUCTS.
- SIDEWALL REGISTERS TO BE AIRMATE 240 V0 (080). CEILING REGISTERS TO BE HART & COOLEY 25 (080). COORDINATE DIFFUSERS IN CEILINGS WITH LIGHT FIXTURES.
- EVAP COOLER TO BE ARCTIC CIRCLE #2200 B-2, WITH RECIRCULATING PUMP, 1/4 HP. MAKE FLEXIBLE CONNECTION FROM COOLER TO SUPPLY DUCT. MOUNT COOLER TO PLATFORM ON EXTERIOR OF BUILDING PER MECH FLOOR PLAN. SEE DETAIL (6/28).
- EXHAUST FAN EQ. TO BROWN #608, 50 CFM, CEILING RECESSED. COMPLETE PACKAGE UNIT W/ BUILT-IN DAMPER. PROVIDE 3" DIA. DUCT UP THRU ROOF TO ROOF JACK.

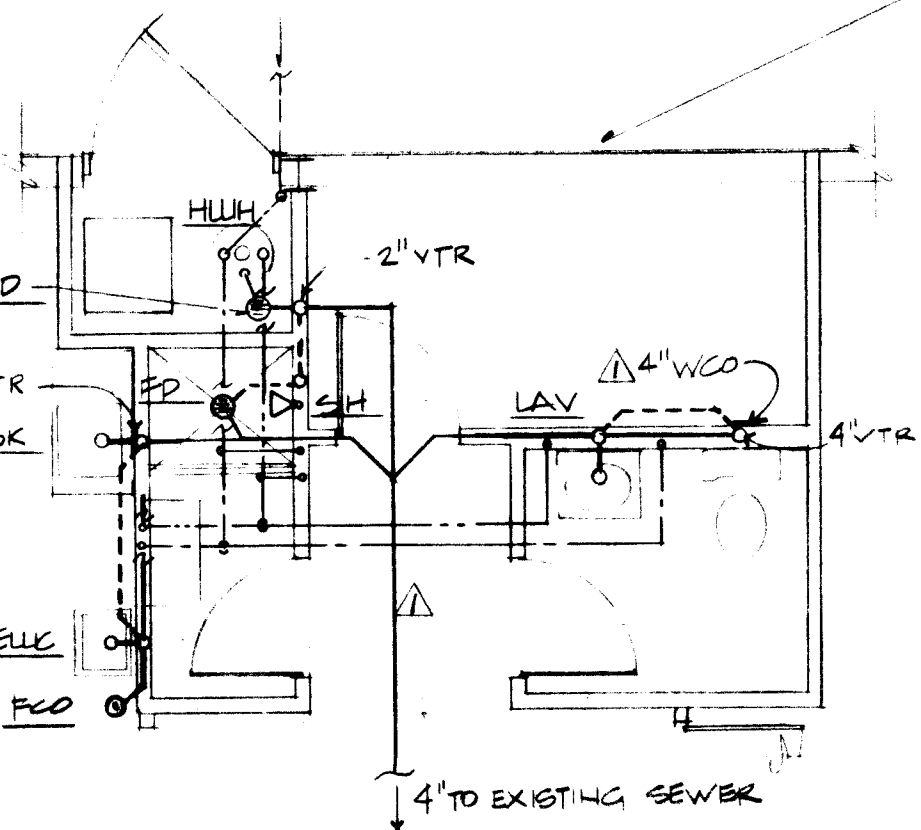


TOILETS & MECH AREA - PLUMBING
SCALE: 1/4" = 1'-0"



GENERAL NOTES:

- All plumbing and mechanical systems shall comply with all applicable codes, ordinances, and OSHA standards.
- Location of existing fixtures, lines, etc., shown on the Drawings are approximate and shall be field verified.
- The water, waste and vent lines as shown on Drawings indicate approximate routing. Exact location of lines shall be coordinated w/field conditions and rough-in requirements of fixtures.
- Remove and replace existing floor slabs, walls and ceilings as required for installation of new plumbing lines and connection to existing services. Replace damaged construction to match new finishes.
- Contractor shall repair all damage to floors, walls, ceilings, etc., in a professional manner. Seal all wall or ceiling openings with matching material; this shall be done at no cost to the Owner. If roof needs to be penetrated, pitch pans and/or proper flashings are then required. The roof shall be patched and repaired as directed.
- Any damage to existing equipment, structure, building, etc., shall be patched and repaired as directed by Owner, at no additional cost to the Owner.
- All piping shall be concealed where possible (unless otherwise noted). All exposed piping where concealment is not possible shall be painted.
- No water piping shall be installed below floor, except as shown.
- All water piping shall be insulated. See Specifications for type.
- No water piping shall be located in outside walls, unless shown on these Drawings, and then piping is to be insulated per Specs.
- All branches shall be valved, all valves shall have unions adjacent. Access panels shall be furnished and installed for access to valves where required.
- All piping shall pitch to drain, and Contractor shall provide valving for drainage. Contractor shall deliver a marked-up set of Plans to the Owner (prior to final payment) showing all branch valves and all drainage points.
- Care shall be taken to avoid mechanical ductwork, electrical equipment and air handling equipment. This Contractor shall be responsible for coordinating routing of piping with Ceiling Contractor and Sheetmetal Contractor. Relocation of piping required by poor coordination by this Contractor shall be at his own expense.
- All water piping in Mechanical Equipment Room shall be insulated.

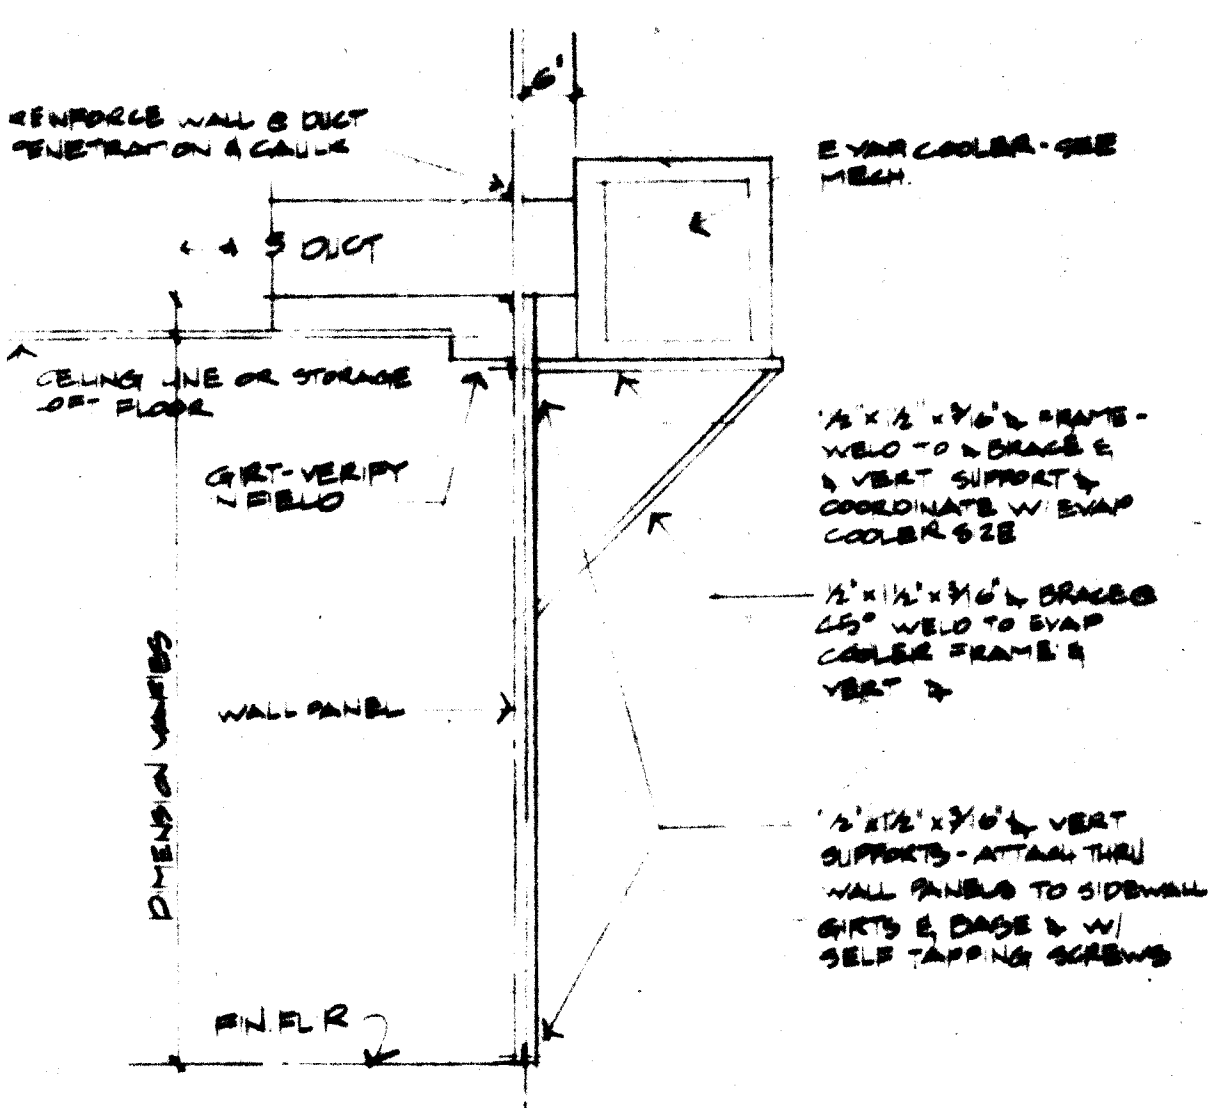


EVAP COOLER SUPPORT
SCALE: 1/2" = 1'-0"

PLUMBING STACK NOTES:



- PIPING ABOVE CEILING
- PIPING CONCEALED IN WALL.
- PIPING BELOW SLAB.
- 1/2" x 12" AIR CHAMBER
- 3/4" PIPE FROM HUWH T&P RELIEF VALVE. TAKE TO FLOOR DRAIN & LEAVE OPEN END @ AFF.
- TAKE NEW WATER & WASTE PIPING TO EXIST. SERVICE LINES. SEE UTILITY SITE PLAN.
- 3" HUWH FLUE. COMBINE WITH FURNACE FLUE PER MECH. FL. PLAN THIS SHEET. INSTALL W/ CERTIFIED DRAFT DIVERTER.
- NEW BLDG. WATER SERVICE. RUN 'RER EXPOSED W/ SHUT OFF VALVE.

SYMBOL LEGEND - PLUMBING

- WASTE PIPE
- VENT PIPE
- CW PIPE
- HUW PIPE

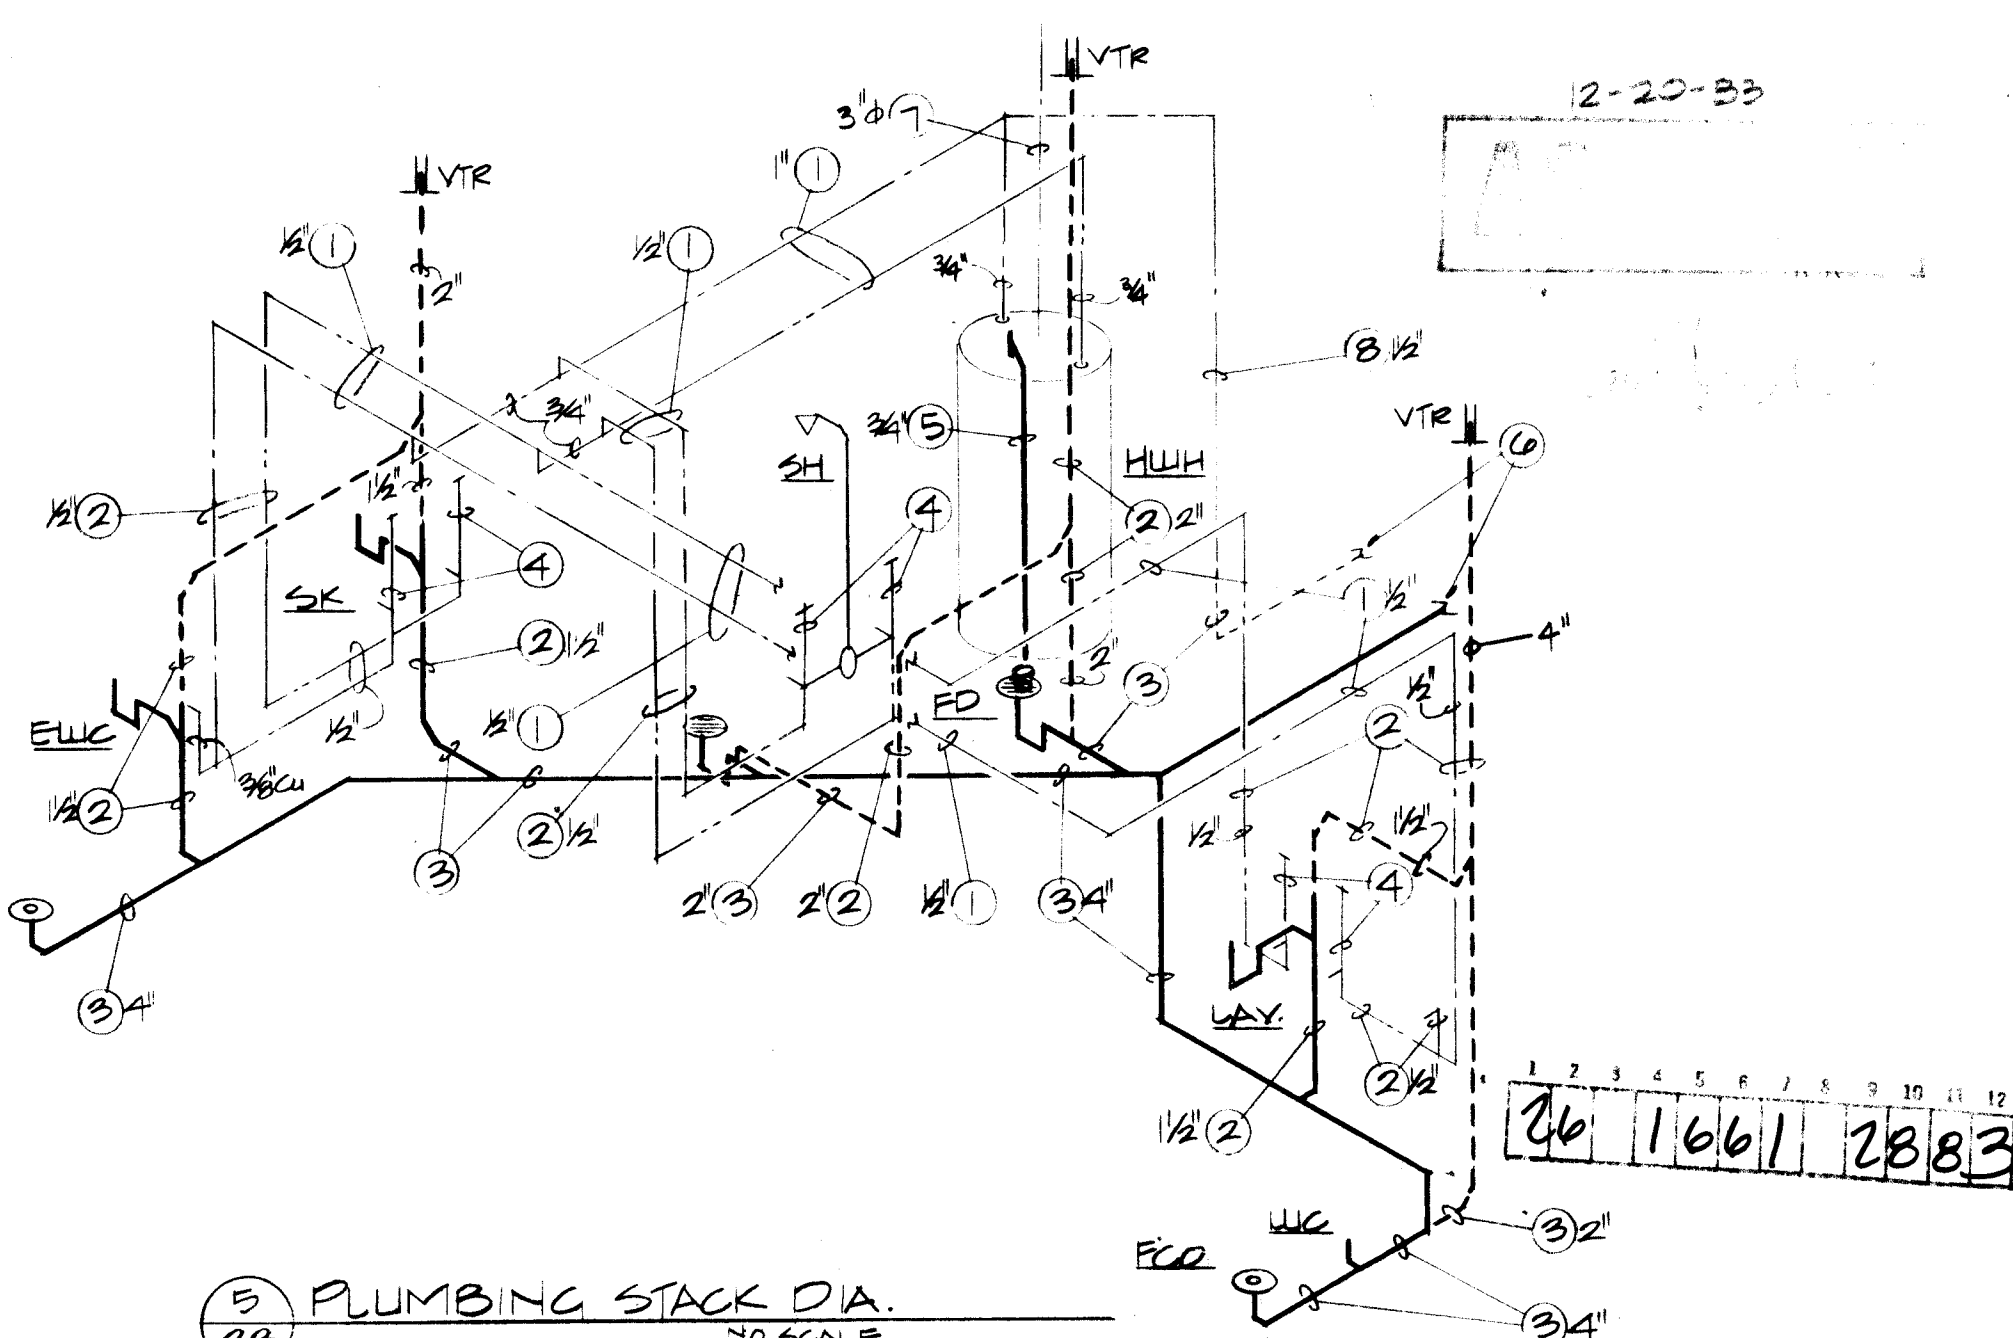

PLUMBING STACK DIA.
SCALE: 1/4" = 1'-0"

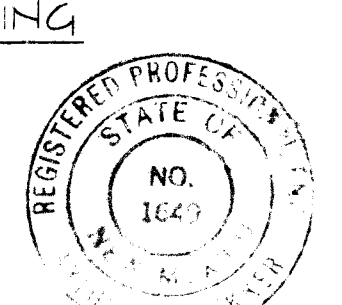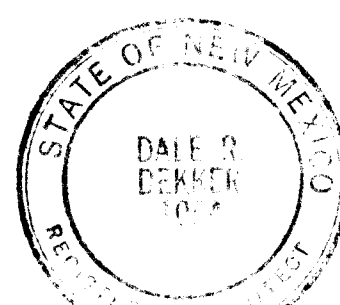

dekker & associates
architects & engineers & planners
2419 San Mateo NE, Suite 215, Albuquerque, New Mexico 87109
505.884.3885
PUERTO DEL SOL GOLF COURSE 1700 girard se
albuquerque, NM

job no 8208
drn by JCH, BH
ckd by PJA, WD
2-1-83
no date revision
1/2/83 AS BUILT
2/15/83 REVISION COMMENTS

sheet 28


FIXTURE SCHEDULE			
TYPE	DESCRIPTION	LAMPS	MOUNTING
A	LITHONIA #20P-440-RN-A12	4/F40/RS/MM	RECESSED
B	LITHONIA #5J-240	2/F40/RS/MM	SURFACE
C	LITHONIA #2M-440-M-RN-A12	4/F40/RS/MM	SURFACE
D	LITHONIA #M-240-M-RN-A12	2/F40/RS/MM	SURFACE
E	FRESCOLITE #9428	1/FC679/CW	SURFACE
F	LITHONIA #22HB-A4-220-WUD	2/F20/CW	WALL BRACKET
G	FRESCOLITE #21K-S-20	1/60W/IP	RECESSED
H	PORCELAIN LAMP HOLDER	1/60W/IP	SURFACE
K	RUBBELL #NMG-121-HP	1/50W/HPS	WALL BRACKET

- FIXTURE SCHEDULE NOTES:
- ALL FLUORESCENT FIXTURES SHALL HAVE COMBINATION ENERGY SAVING LAMPS AND BALLASTS.
 - ALL INCANDESCENT LAMPS SHALL BE RATED 130V.
 - PROVIDE TYPE "B" FIXTURE WITH 0 DEGREE F RATED BALLAST.

GENERAL NOTES

- THE ELECTRICAL CONTRACTOR SHALL FAMILIARIZE HIMSELF AT THE SITE WITH THE EXISTING CONDITIONS TO ALLOW HIM TO SUBMIT A COMPLETE BID WITHIN THE SCOPE OF THE DRAWINGS AND SPECIFICATIONS. ANY QUESTIONS ARISING DURING THE BID PERIOD IN REGARD TO THE CONTRACTORS FUNCTIONS, THE SITES INVOLVED, THE SCOPE OF THE PROJECT, OR ANY OTHER ISSUE RELATED TO THIS PROJECT SHALL BE BROUGHT UP DURING THE BID PERIOD WITH THE ENGINEERS FOR CLARIFICATIONS, NOT AFTER THE CONTRACT HAS BEEN AWARDED.
- LOCATION OF EQUIPMENT, CONTROLS AND OTHER DEVICES SHOWN ON THE DRAWINGS ARE APPROXIMATE AND SHALL BE FIELD VERIFIED.
- ALL ELECTRICAL WIRING SHALL BE ROUTED IN CONDUIT. WIRING BELOW SUSPENDED CEILINGS SHALL BE CONCEALED IN WALLS. IN CASE OF SOLID WALLS, WIREMOLD MUST BE UTILIZED BELOW SUSPENDED CEILINGS--EXCEPT IN AREAS WITH EXPOSED JOISTS.
- THE CONDUIT RUNS AS SHOWN ON DRAWINGS INDICATE APPROXIMATE ROUTING. EXACT LOCATION OF CONDUIT RUNS SHALL BE PER FIELD CONDITIONS. NO CONDUIT SHALL BE RUN EXPOSED ON OUTSIDE OF BUILDINGS UNLESS APPROVED BY ENGINEER.
- CONTRACTOR SHALL INSTALL PULL AND J-BOXES WHEREVER REQUIRED BY NEC.
- ALL WIRES SHALL BE TAGGED AT ALL PULL BOXES, J-BOXES, EQUIPMENT BOXES AND CABINETS WITH APPROVED PLASTIC TAGS, ACTION CRAFT BRADY OR APPROVED EQUAL.
- ALL MATERIALS UTILIZED SHALL HAVE U. L. LABEL.
- SHOULD ELECTRICAL CONTRACTOR AT ANY TIME NOTICE THAT THE ACTUAL FIELD CONDITIONS DO NOT CORRESPOND TO THE INFORMATION GIVEN ON THE DRAWINGS, THEN IT WILL BE HIS RESPONSIBILITY TO NOTIFY THE ELECTRICAL ENGINEER AS SOON AS POSSIBLE FOR CLARIFICATION.
- ELECTRICAL CONTRACTOR SHALL REPAIR ALL DAMAGE TO WALLS, CEILINGS, ETC., IN A PROFESSIONAL MANNER. SEAL ALL WALL OR CEILING OPENINGS WITH MATCHING MATERIAL; THIS SHALL BE DONE, AT NO COST TO THE OWNER. IF ROOF NEEDS TO BE PENETRATED, PITCH PANS ARE THEN REQUIRED. THE ROOF SHALL BE PATCHED AND REPAIRED AS DIRECTED BY APS.
- ANY DAMAGE TO EXISTING EQUIPMENT, STRUCTURE, BUILDING, ETC. SHALL BE PATCHED AND REPAIRED AS DIRECTED BY OWNER, AT NO ADDITIONAL COST TO THE OWNER.

SYMBOL LEGEND	
SYMBOL	DESCRIPTION
Ⓐ Ⓑ	CEILING OR WALL BRACKET FIXTURE. SEE FIXTURE SCHEDULE
ⓐ ⓑ	FLUORESCENT OUTLET AND FIXTURE. SEE FIXTURE SCHEDULE
Ⓢ	SINGLE POLE WALL SWITCH, UP +48". "3" INDICATES THREE-WAY.
ⓈT	THERMAL O.L. SWITCH
ⓐ	JUNCTION BOX FLUSH IN WALL WITH CONNECTION TO EQUIPMENT
Ⓢ	DUPLEX CONVENIENCE OUTLET, UP 12" OR AS INDICATED.
ⓐ	THERMOSTAT, UP 48" UNLESS OTHERWISE INDICATED.
Ⓢ	ELECTRIC PANEL. SEE PANEL SCHEDULE FOR CHARACTERISTICS
ⓐ	MOTOR CONNECTION WITH HP INDICATED. "F" INDICATES FRACTIONAL.
Ⓢ	BRANCH CIRCUIT IN WALLS OR CEILING WITH CONDUCTORS INDICATED.
Ⓢ	BRANCH CIRCUIT IN WALLS OR UNDER FLOOR WITH CONDUCTORS INDICATED.
Ⓢ A-1,3	HOME RUN TO PANEL, WITH BRANCH CIRCUIT NUMBERS INDICATED.
Ⓢ	TELEPHONE CONDUIT, MINIMUM 3/4" WITH PULL WIRE.
Ⓢ	TELEPHONE CONDUIT HOMERUN TO BACKBOARD, 1" MINIMUM WITH PULL WIRE.
Ⓢ	TELEPHONE OUTLET, UP 12" UNLESS OTHERWISE INDICATED.
Ⓢ	250V-2P-3W SPECIAL PURPOSE GROUNDING TYPE OUTLET. AMPERAGE AS SHOWN.
Ⓢ	PHOTOCELL ON ROOF WITH WINDOW FACING NORTH.
Ⓢ EC	EVAP COOLER SWITCHES, ONE TOGGLE SWITCH FOR PUMP AND ONE DPDT CENTER OFF FOR FAN.
Ⓢ	DISCONNECT SWITCH, SIZE AND POLES FOR LOAD CONNECTED.
---	EXISTING CONDUIT AND WIRE REMAIN.
---	EXISTING CONDUIT AND WIRE REMOVED OR ABANDONED.
Ⓢ	EXISTING DEVICE REMAINS.
Ⓢ	EXISTING DEVICE REMOVED.

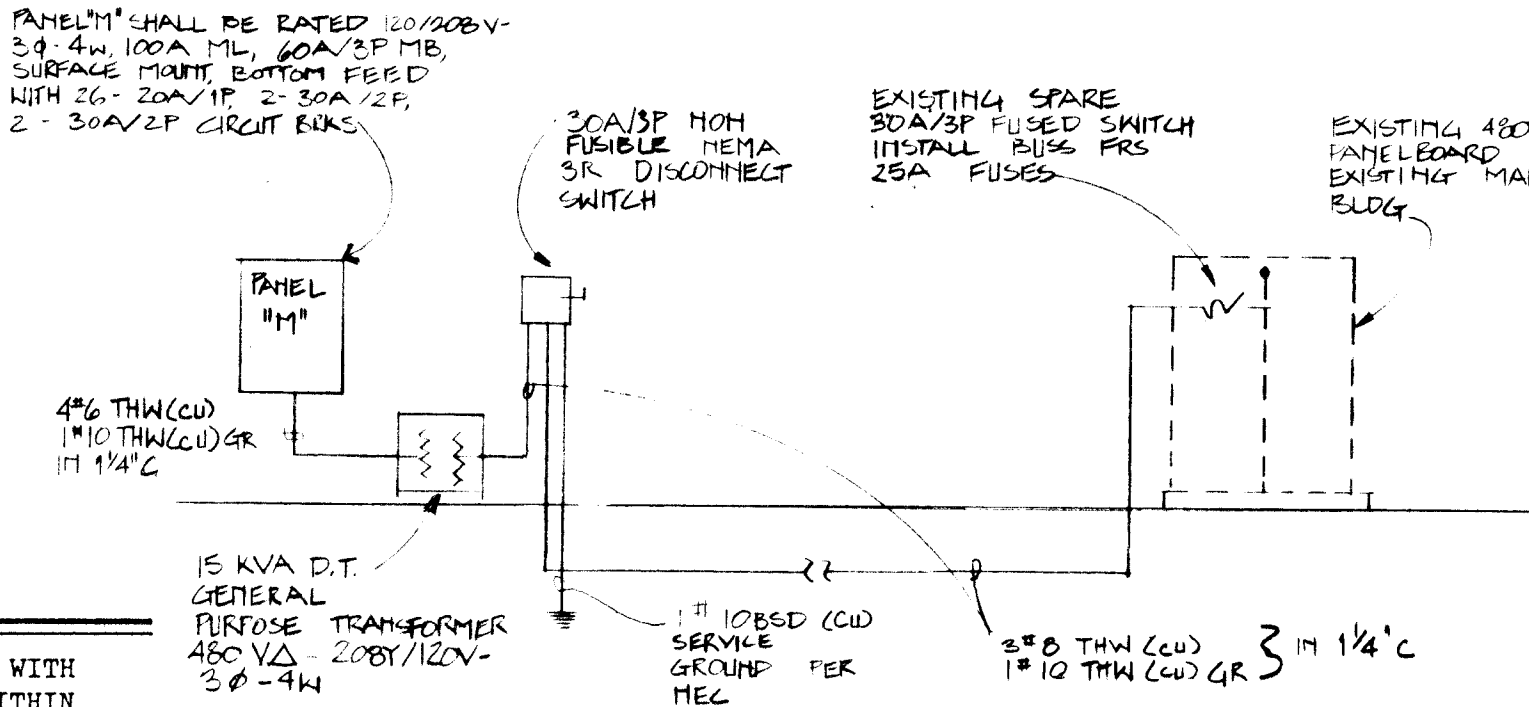

POWER RISER DIAGRAM

LOADS - 120/208V - 3Ø-4W

CONTRACTED - 13 KW
DEMAND - 10 KW


SHORT CIRCUIT ANALYSIS

MAXIMUM SCAT AT PANEL
"M" = 2000 ACI

ENERGY CONSERVATION

THESE PLANS AND SPECIFICATIONS ARE IN COMPLIANCE WITH THE STATE OF NEW MEXICO ELECTRICAL CODE, ARTICLE 290, ENERGY CONSERVATION, AS CERTIFIED BY ME:


Fred J. Telck
FRED J. TELCK

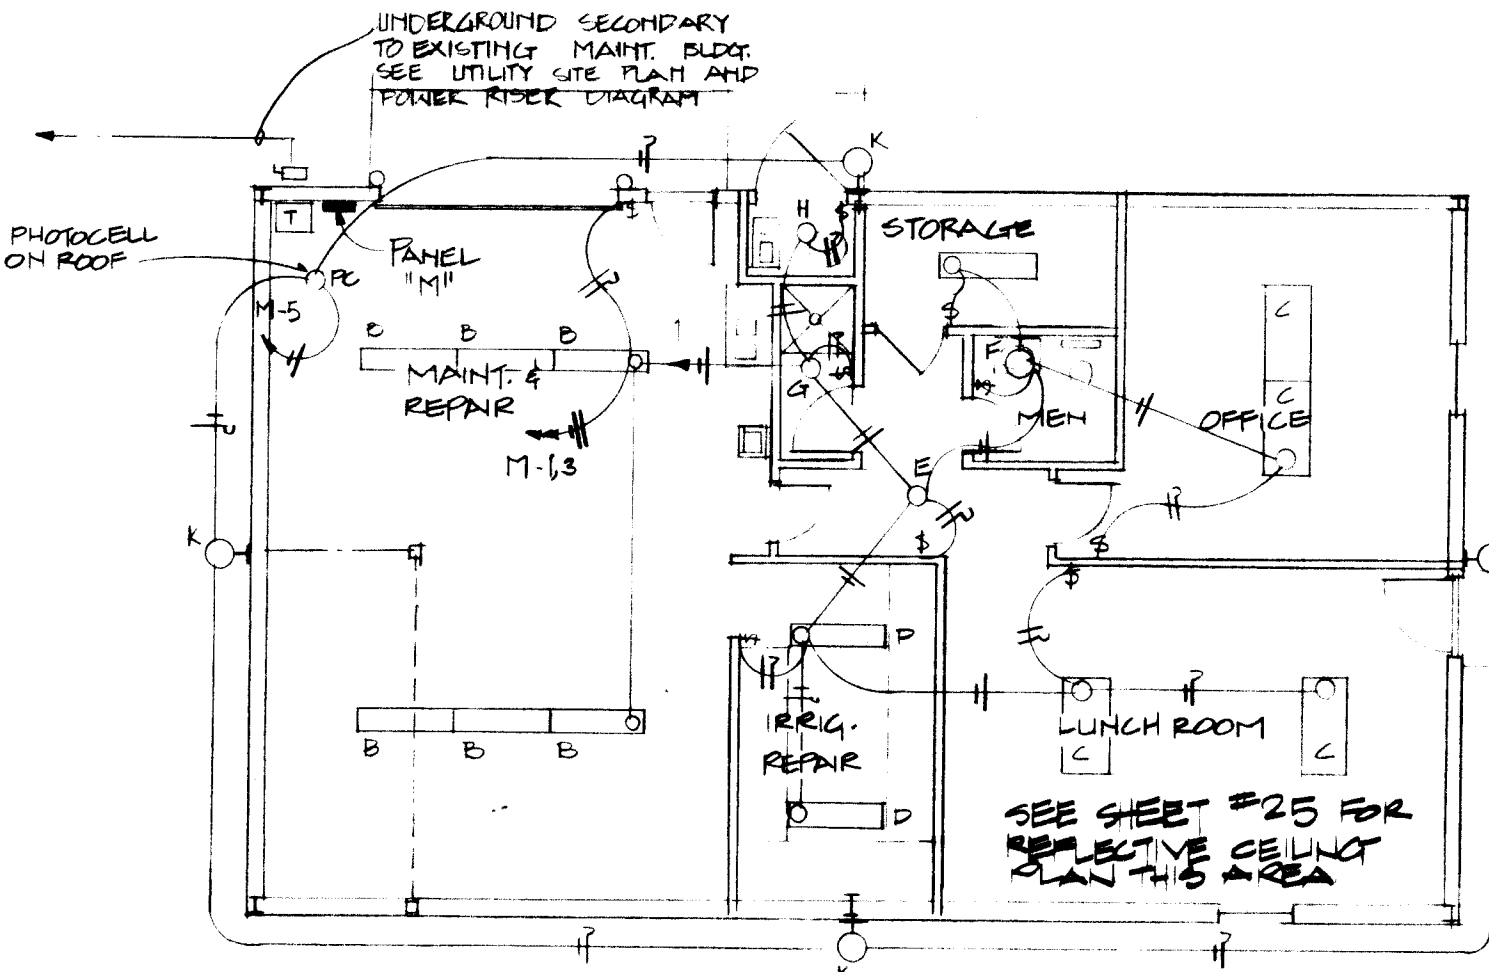

NOTE: BLDG POSITION ON SITE IS ROTATED SEE UTILITY SITE PLAN FOR CORRECT ORIENTATION.


29 LIGHTING PLAN-NEW MAINT. BUILDING

SCALE: 1/8" = 1'-0"

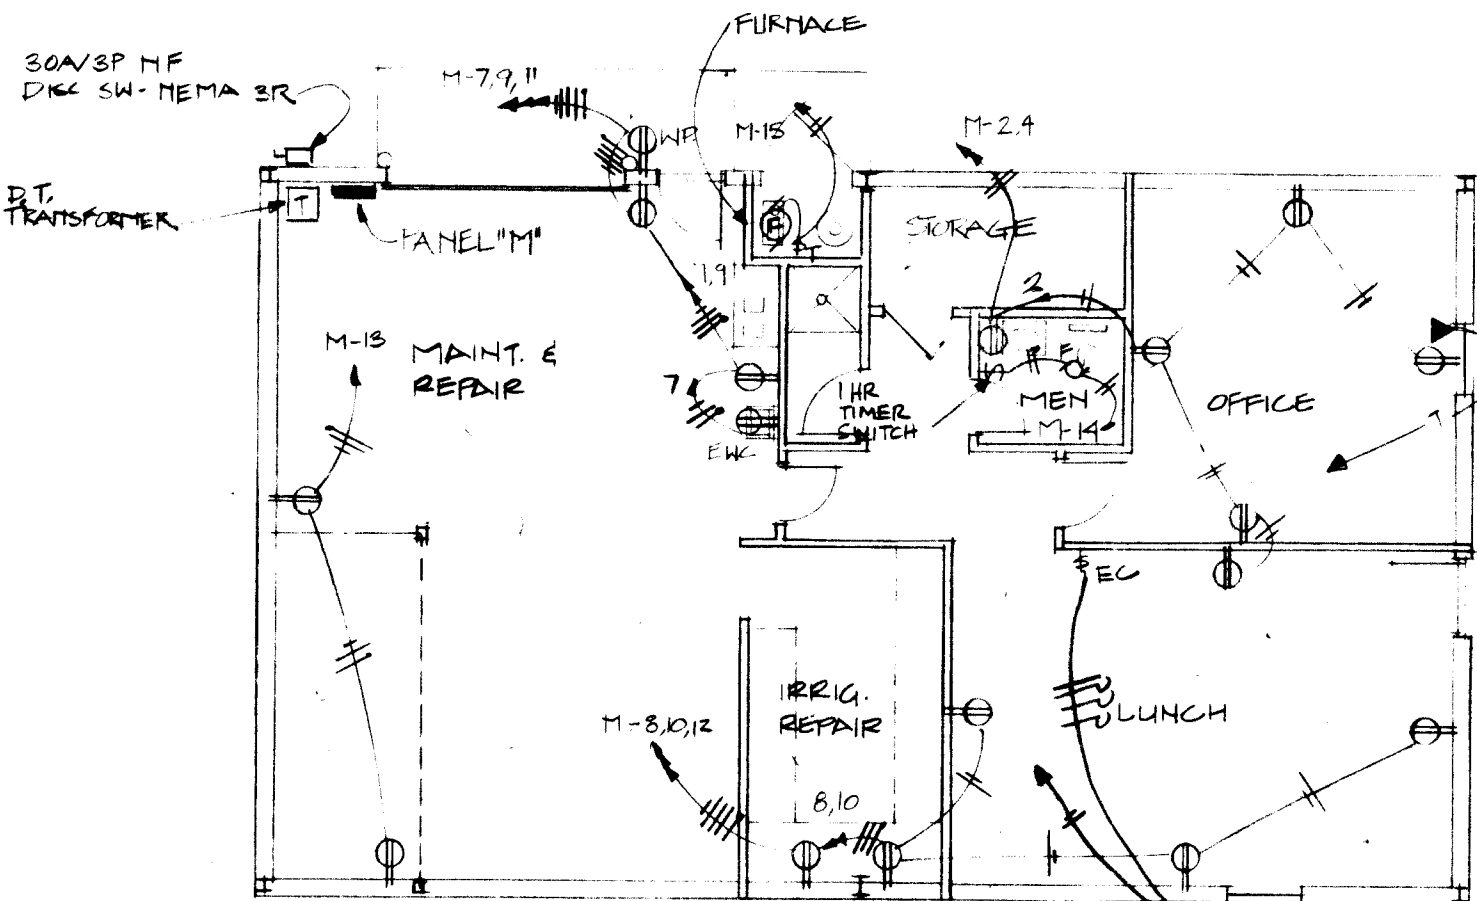

29 ELEC. POWER PLAN-NEW MAINT. BLDG.

SCALE: 1/8" = 1'-0"

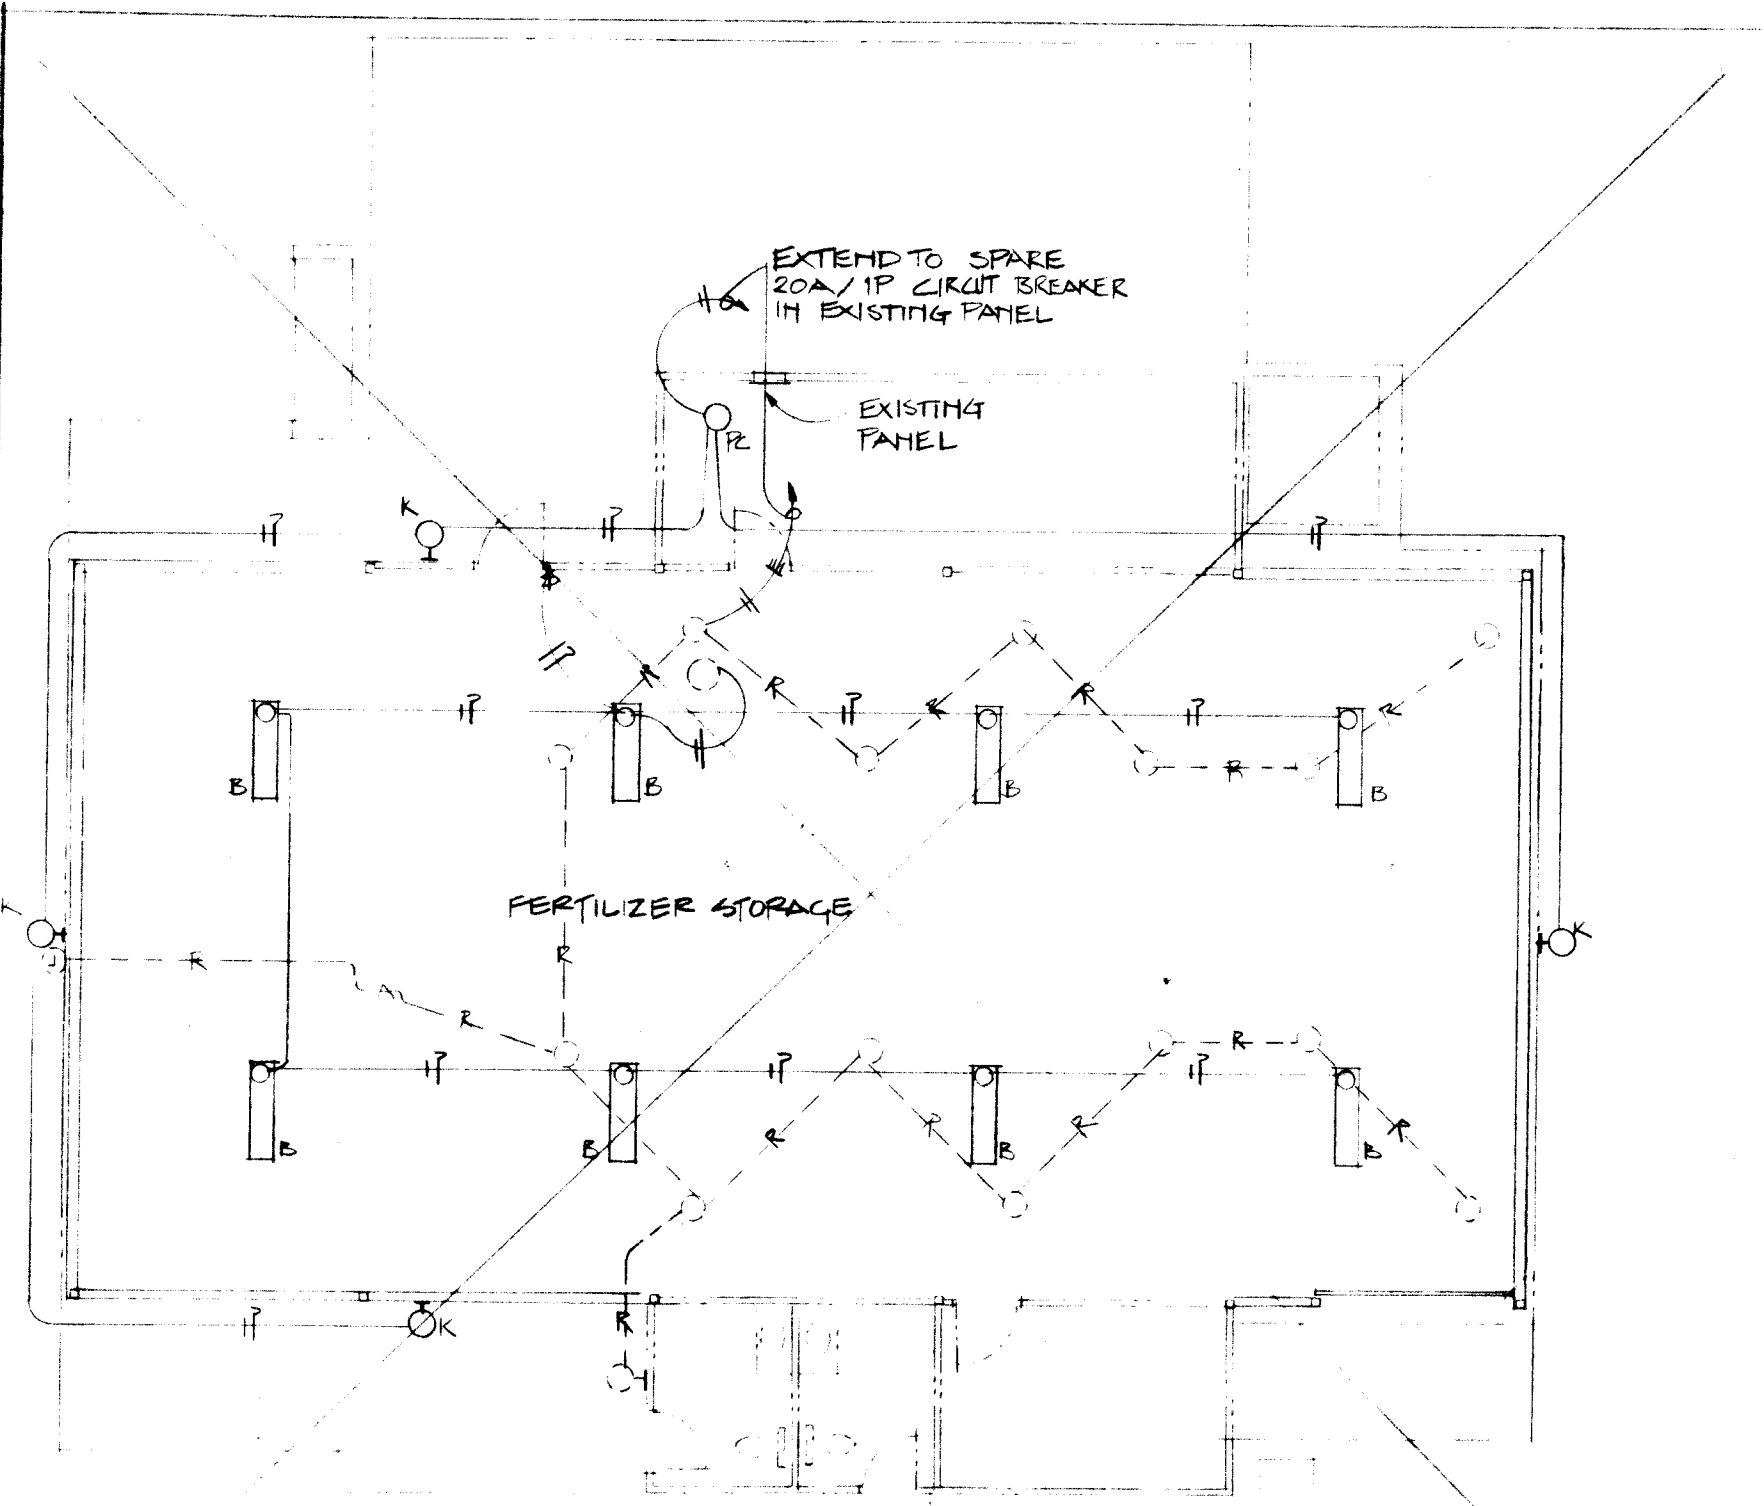

ALTERNATE NOT TAKEN

29 LIGHTING & ELEC. POWER PLAN-EXIST. OLD CLUBHOUSE


SCALE: 1/8" = 1'-0"

ADDITIVE ALTERNATE #1



26 1661 2983

1661

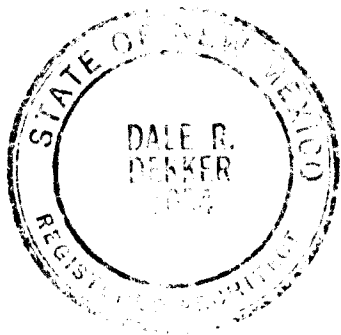

dekker & associates
architects & engineers & planners


1500 N. 10th St., Suite 100, Albuquerque, NM 87102
505.844.3644

job no. 8208
drn by JDM, DM
ckd by PT
issued 2-1-83
update revision


sheet 29

1 2 3 4 5 6 7 8 9 10 11 12

2-29-83

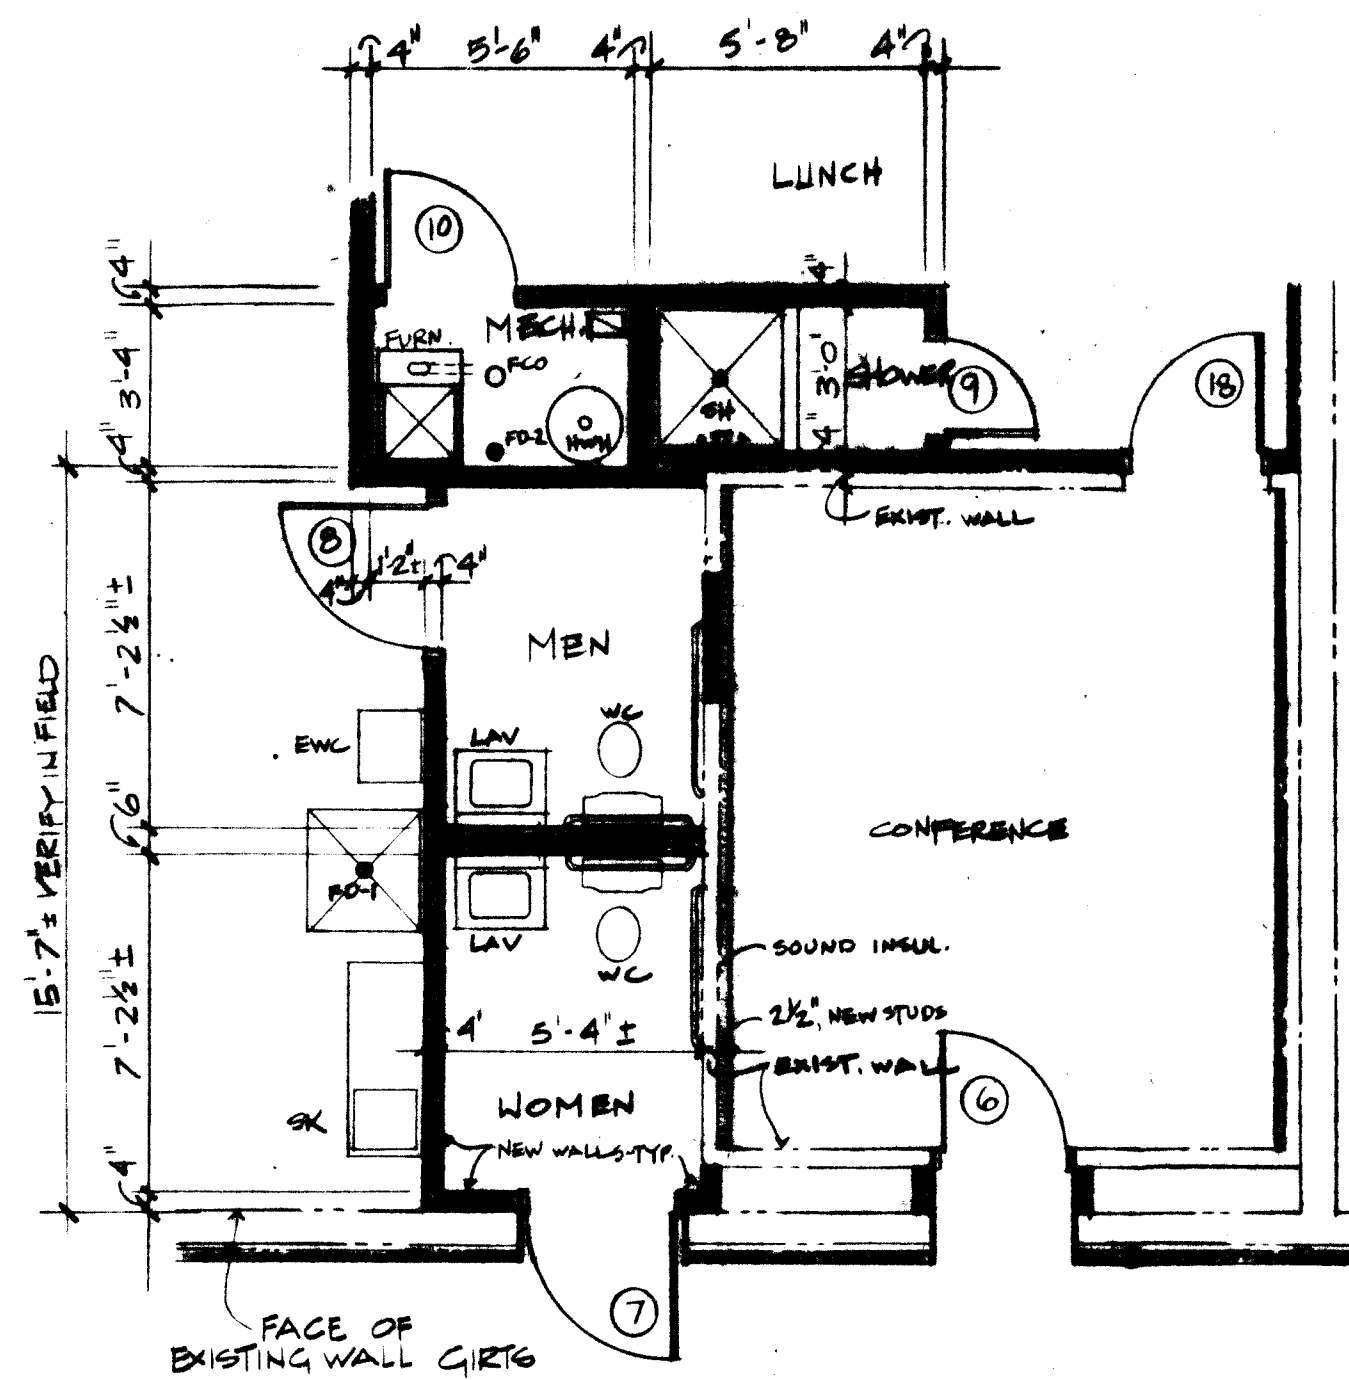

PLAN REVISION EXIST. BUILDING 8/16/83
 ARROYO DEL OSO GOLF COURSE SCALE 1/4" = 1'-0"
 7001 OSUNA RD NE.
 ALBUQUERQUE, NM

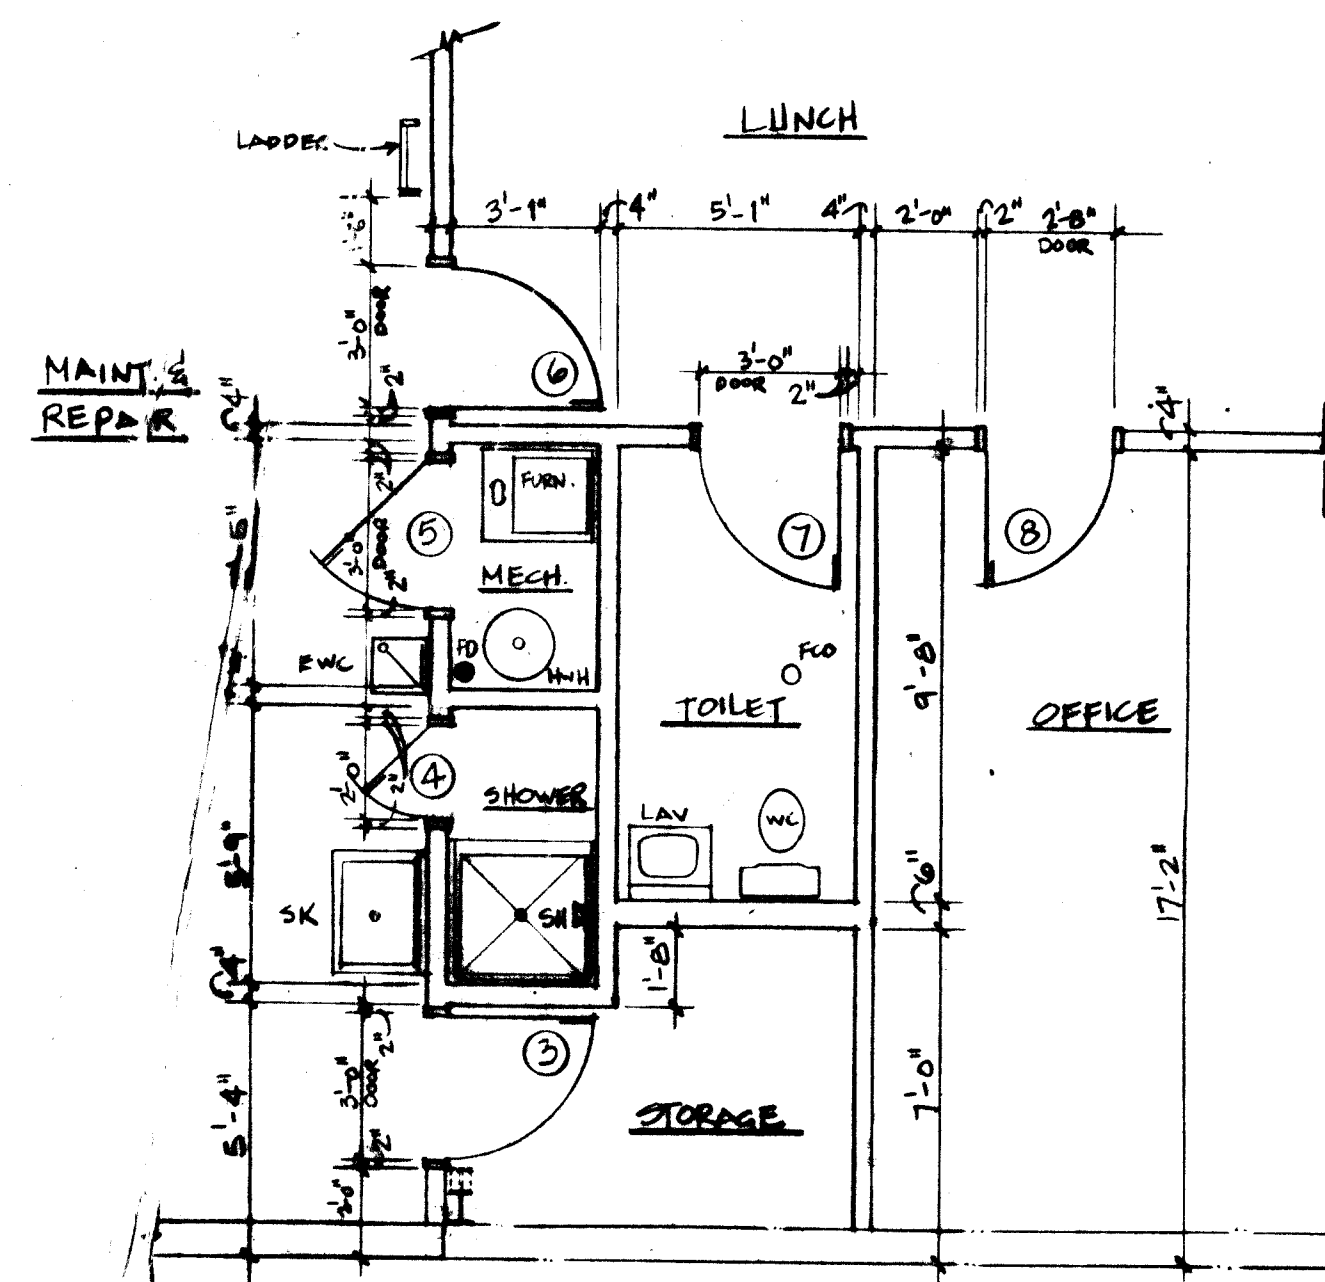

PLAN REVISION @ EXISTING BLDG 4/8/83
 LOS ALTOS GOLF COURSE SCALE 1/4" = 1'-0"
 9717 COPPER AVE. NE
 ALBUQUERQUE, NM

REVISIONS

26 1661 3083