

CONSTRUCTION PLANS FOR RIO GRANDE BOULEVARD


GRIEGOS ROAD TO THE GRIEGOS LATERAL
FOR
CITY OF ALBUQUERQUE - TRANSPORTATION DEPT.

INDEX TO DRAWINGS

1. TITLE SHEET
2. RIGHT OF WAY MAP
3. RIGHT OF WAY MAP
4. PLAN & PROFILE - RIO GRANDE BLVD.
5. PLAN & PROFILE - RIO GRANDE BLVD.
6. PLAN DETAIL-RIO GRANDE BLVD.,
GRIEGOS RD. INTERSECTION
7. CROSS SECTIONS
8. CROSS SECTIONS
9. CROSS SECTIONS & GRIEGOS ROAD PLAN & PROFILE
10. TRAFFIC CONTROL PLAN
11. ROADWAY DATA

PREPARED BY

GREINER ENGINEERING

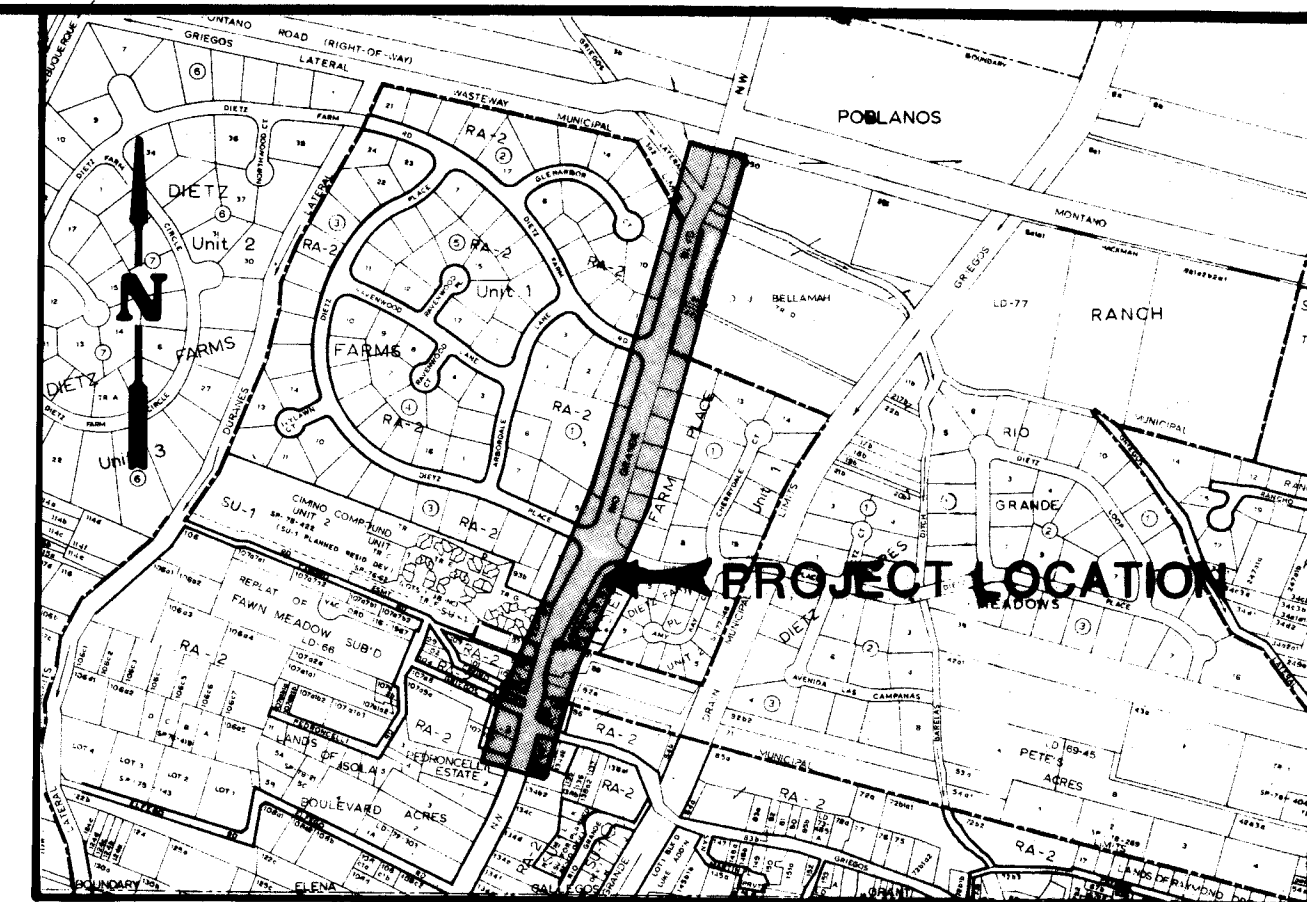

VICINITY MAP
SCALE: 1" = 800' (approx)
MAP #F-13

GENERAL NOTES

1. All dimensions are to back of curb.
2. Match flowlines of gutters when connecting new curb and gutter to existing.
3. Curb and gutter shown as existing and not to be removed under this contract which is damaged or displaced by the Contractor shall be removed and replaced by the Contractor at his expense.
4. When removal of existing curb and gutter or sidewalk is required, remove back to nearest joint.
5. The Contractor shall notify the utility companies by calling 765-1234 before commencing work in areas near underground utility lines, Two (2) working days prior to any excavation.
6. It will be the Contractor's responsibility to protect and maintain in service all existing utilities.
7. The Contractor is to exercise due care when removing existing pavement to avoid disturbing any existing underground utilities. It shall be his responsibility to coordinate with the utility companies in order to prevent any service disruption.
8. Exact relocation of traffic signal foundations shall be determined by Traffic Engineering Department.
9. Provide ground rod on pedestals used at splice cabinet bases and control bases.
10. All gas valve boxes, gas manholes, electrical manholes, T.V. cable enclosures, telephone manholes & Enclosures and utility poles will be adjusted to grade or relocated by others.
11. All water valve boxes and sewer manholes in the construction area are to be adjusted to finish grade under this contract.
12. Adjustment of manhole rims shall include adjustment of barrel and cone where necessary.
13. The Contractor will be responsible for maintaining and removing all construction material from the manholes during construction and until the project has been accepted.
14. All earthwork and typical section street grading and excavation shall be considered incidental to subgrade preparation.

CONSTRUCTION NOTES

1. Construct pavement per typical roadway section, sheet 6 of 10.
2. Permanent striping, traffic signalization and traffic sign removal and replacement shall be done by the City of Albuquerque's Traffic Engineering Division. The contractor shall coordinate this portion of the work with the Traffic Engineer and give three working days notification before any work is expected to be done.
3. All stationing is based on the survey base line.
4. The Contractor shall contact the Albuquerque City Surveyor for the re-establishment of A.C.S. Brass Tablet II-F13 if it is to be disturbed or relocated.
5. Pave west side of road to R/W from Sta. 107+00.25 to Sta. 109+00.74 & Pave to existing curb on east side of road from Sta. 162+67 to E.S.E. Return of Olafz Place approx. Sta. 164+60.
6. All removals required and not specifically called for elsewhere, shall be paid for under bid item 11-25, Miscellaneous Removals.
7. The Contractor shall install a temporary 4' chainlink fence along the South R/W of Griegos Rd (West) as shown on sheet 6 of the Plans & shall be considered incidental to the cost of the project.
8. Prior to relocating the water meters indicated as part of the work for this project, the contractor is to contact the Customer Services Division of the City's Water Resources Department at 823-4045.
9. A disposal site for all excess excavation material, asphalt paving, concrete paving etc., shall be obtained by the contractor in compliance with applicable environmental regulations. All costs incurred in obtaining a disposal site and haul thereto shall be considered incidental to the completion of the project and no separate payment will be made.
10. The Contractor shall maintain access to adjacent properties during construction except during actual paving operations.
11. The Contractor will be required to confine his work within the construction limits and/or Row to preserve existing vegetation and private property. Overnight parking of construction equipment shall not obstruct driveway openings or designated traffic lanes. Overnight parking of equipment within the roadway or median will not be permitted unless the area is completely barricaded off due to construction operations.
12. Fifty (50) ton roller operation shall not be used in this project where underground utilities are present. The required compaction at these locations shall be effected by means of other types of rolling available.
13. All excavation for storm drains, and other excavations as necessary shall be governed by federal, state, and local laws, rules and regulations concerning construction safety and health.
14. Prior to construction, the Contractor shall excavate and verify the horizontal and vertical locations of all obstructions. Should a conflict exist, the Contractor shall notify the Engineer so that the conflict can be resolved with a minimum amount of delay.
15. As permitted by the Engineer, traffic may be placed on a cleaned milled area. A temporary asphalt taper shall be placed on a 6:1 minimum slope at both longitudinal and transverse joints in order to provide a smooth transition from a milled to an unmilled area. The cost of tapers is to be included on the unit bid price for cold milling. The temporary asphalt tapers shall be removed prior to subsequent work.
16. All signs and coding will be in accordance with the "Manual of Uniform Traffic Control Devices for Streets and Highways", current edition, published by the U. S. Department of Transportation. This pertains to construction signing for this contract.
17. The Contractor shall inform the public, through the news media, of lane closing, detours, and other construction activities which affect traffic flow.
18. Standard specifications shall be as per the New Mexico Standard Specifications for Public Works Construction, 1979 Edition, as revised by City Wide Utilities and Cash Paving No. 31 and as revised for this project, except for the 5/8" seal coat and aggregate gradation for asphalt concrete where New Mexico State Highway Department Specifications latest edition, as revised for this project, shall be used. Standard details shall be as per City of Albuquerque Contract Documents for City Wide Utilities and Cash Paving No. 31.

1 2 3 4 5 6 7 8 9 10 11 12
26 16680185

RECORD DRAWING

APPROVAL OF AS BUILT DRAWINGS
ASST. CITY ENGINEER - FIELD
Loz. M. Jarama
DATE 10-1-85

REV	SHEETS	CITY ENGR	DATE	USER DEPT.	DATE	USER DEPT.	DATE
456							

APPROVAL OF REVISIONS

PREPARED UNDER THE
SUPERVISION OF

NEW MEXICO
REGISTERED PROFESSIONAL ENGINEER
J. L. HART JR.
8768
8-27-84

Greiner Engineering
2601 WYOMING BLVD, NE
ALBUQUERQUE, NM 87112
(505)292-1936


CIP No. 1668

APPROVED FOR
CONSTRUCTION

CITY ENGINEER
C. J. Jarama
TRANSPORTATION DEPT. 9/5/84

SHEET 1 OF 11

SET NO.

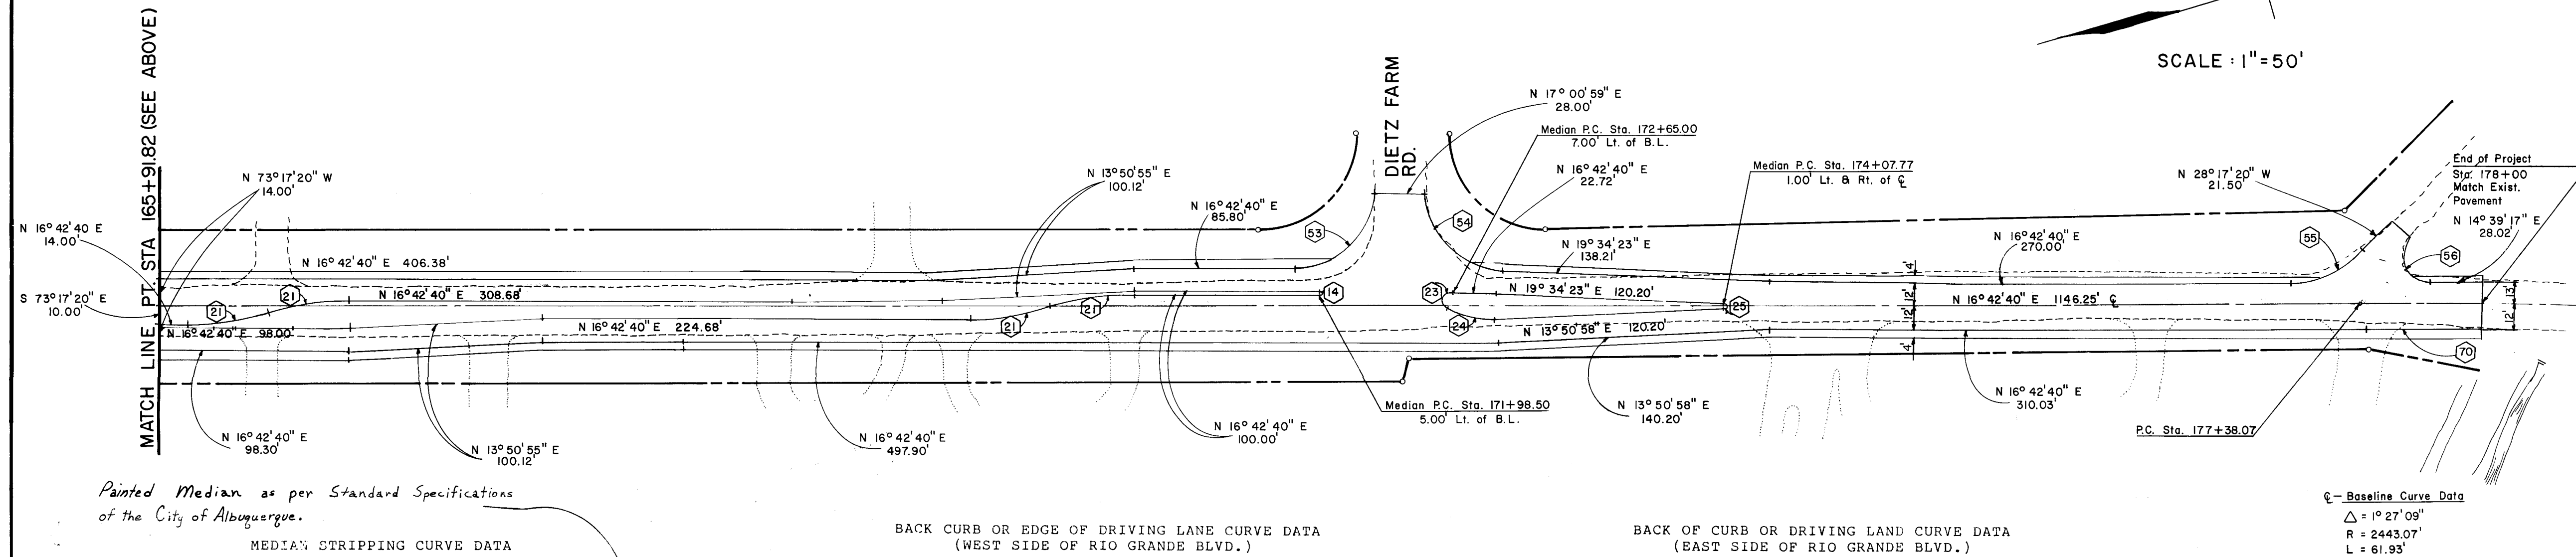

<u>CURVE NO.</u>	<u>CENTRAL ANGLE</u>	<u>RADIUS</u>	<u>LENGTH</u>
40	67° 0' 43" 20"	25.00'	29.55'
41	11° 25' 53"	453.70'	90.52'
42	101° 0' 23" 25"	25.00'	44.09'
43	01° 25' 53"	3100.00'	77.44'
44	04° 00' 00" 00"	1147.00'	80.08'
45	07° 46' -32" 06° 06' 12"	1000.00' 617.00'	135.71' 65.72'
46	89° -10' -03" 07° 22' 12"	20.00' 15.00'	31.15' 22.07'
47	01° 37' -33" 03° 30' 12"	2254.91' 617.00'	63.99' 39.16'
48	03° 40' 00" 00"	1503.00'	105.30'
49	05° 01' 21"	900.73'	16.07'
50	93° 39' 49"	40.00'	65.39'
51	93° 33' 49"	40.00'	65.32'
52	04° 13' 41"	900.73'	66.47'
53	90° 00' 00" 00"	40.00'	62.83'
54	87° 00' 18"	40.00'	60.83'
55	45° 00' 00" 00"	50.00'	39.27'
56	135° 00' 00" 00"	15.00'	35.34'
1030	00° - 07' - 31"	2254.91'	4.92'
1034	89° - 10' - 13"	20.00'	31.15'
1011	01° - 37' - 33"	2254.91'	63.99'

THE UNDERSIGNED
INFORMATION FURNISHED
ENGINEERING (EN
ACTUALLY ACCOMPLISHED

PREPARED UNDER THE
DATE 24


Greg O'Leary
GREENER ENGINEERING

[illegible]

POINT NO.	N	E	STATION
1	1,505,122.1594	374,868.2081	155+60.40
2	1,505,521.2587	374,955.5745	159+68.95
4	1,505,654.9801	375,006.2860	161+12.48
5	1,505,899.5382	375,142.9027	163+92.61
7	1,506,082.6160	375,220.4261	165+91.82

LEGEND

- ▲ SET 1/2" REBAR OR NAIL
- POUND REBAR, PIPE OR NAIL
- WATER METER
- MAIL BOX
- POLE W/ANCHOR
- TREE OR BUSH
- BASE LINE
- RIGHT-OF-WAY LINE
- ++ CURB LINE
- EDGE OF ASPHALT
- FENCE LINE
- MUNICIPAL LIMITS

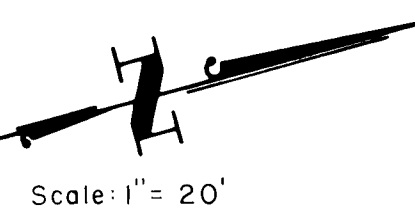


Scale: 1" = 20'

Begin Baseline Sta. 155+60.40, coordinates on New Mexico Coordinate System, Central Zone 13, 11a alpha -00°14' 27". Combined Sea Level and Grid Factor 0.9996979.
 x 1,505,122.1594
 y 374,868.2081


I, Jeryl Hart, Jr., Registered Professional Land Surveyor, New Mexico License Number 7474, do hereby certify that this Right-of-Way map and legal descriptions were prepared by me or under my supervision from an actual field survey and are true and correct to the best of my knowledge and belief.

Jeryl Hart, Jr. New Mexico Registered Professional Land Surveyor No. 7474

7/10/81

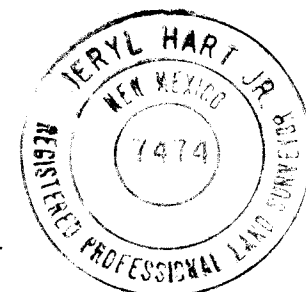

Rev. 8-9-84
 JH

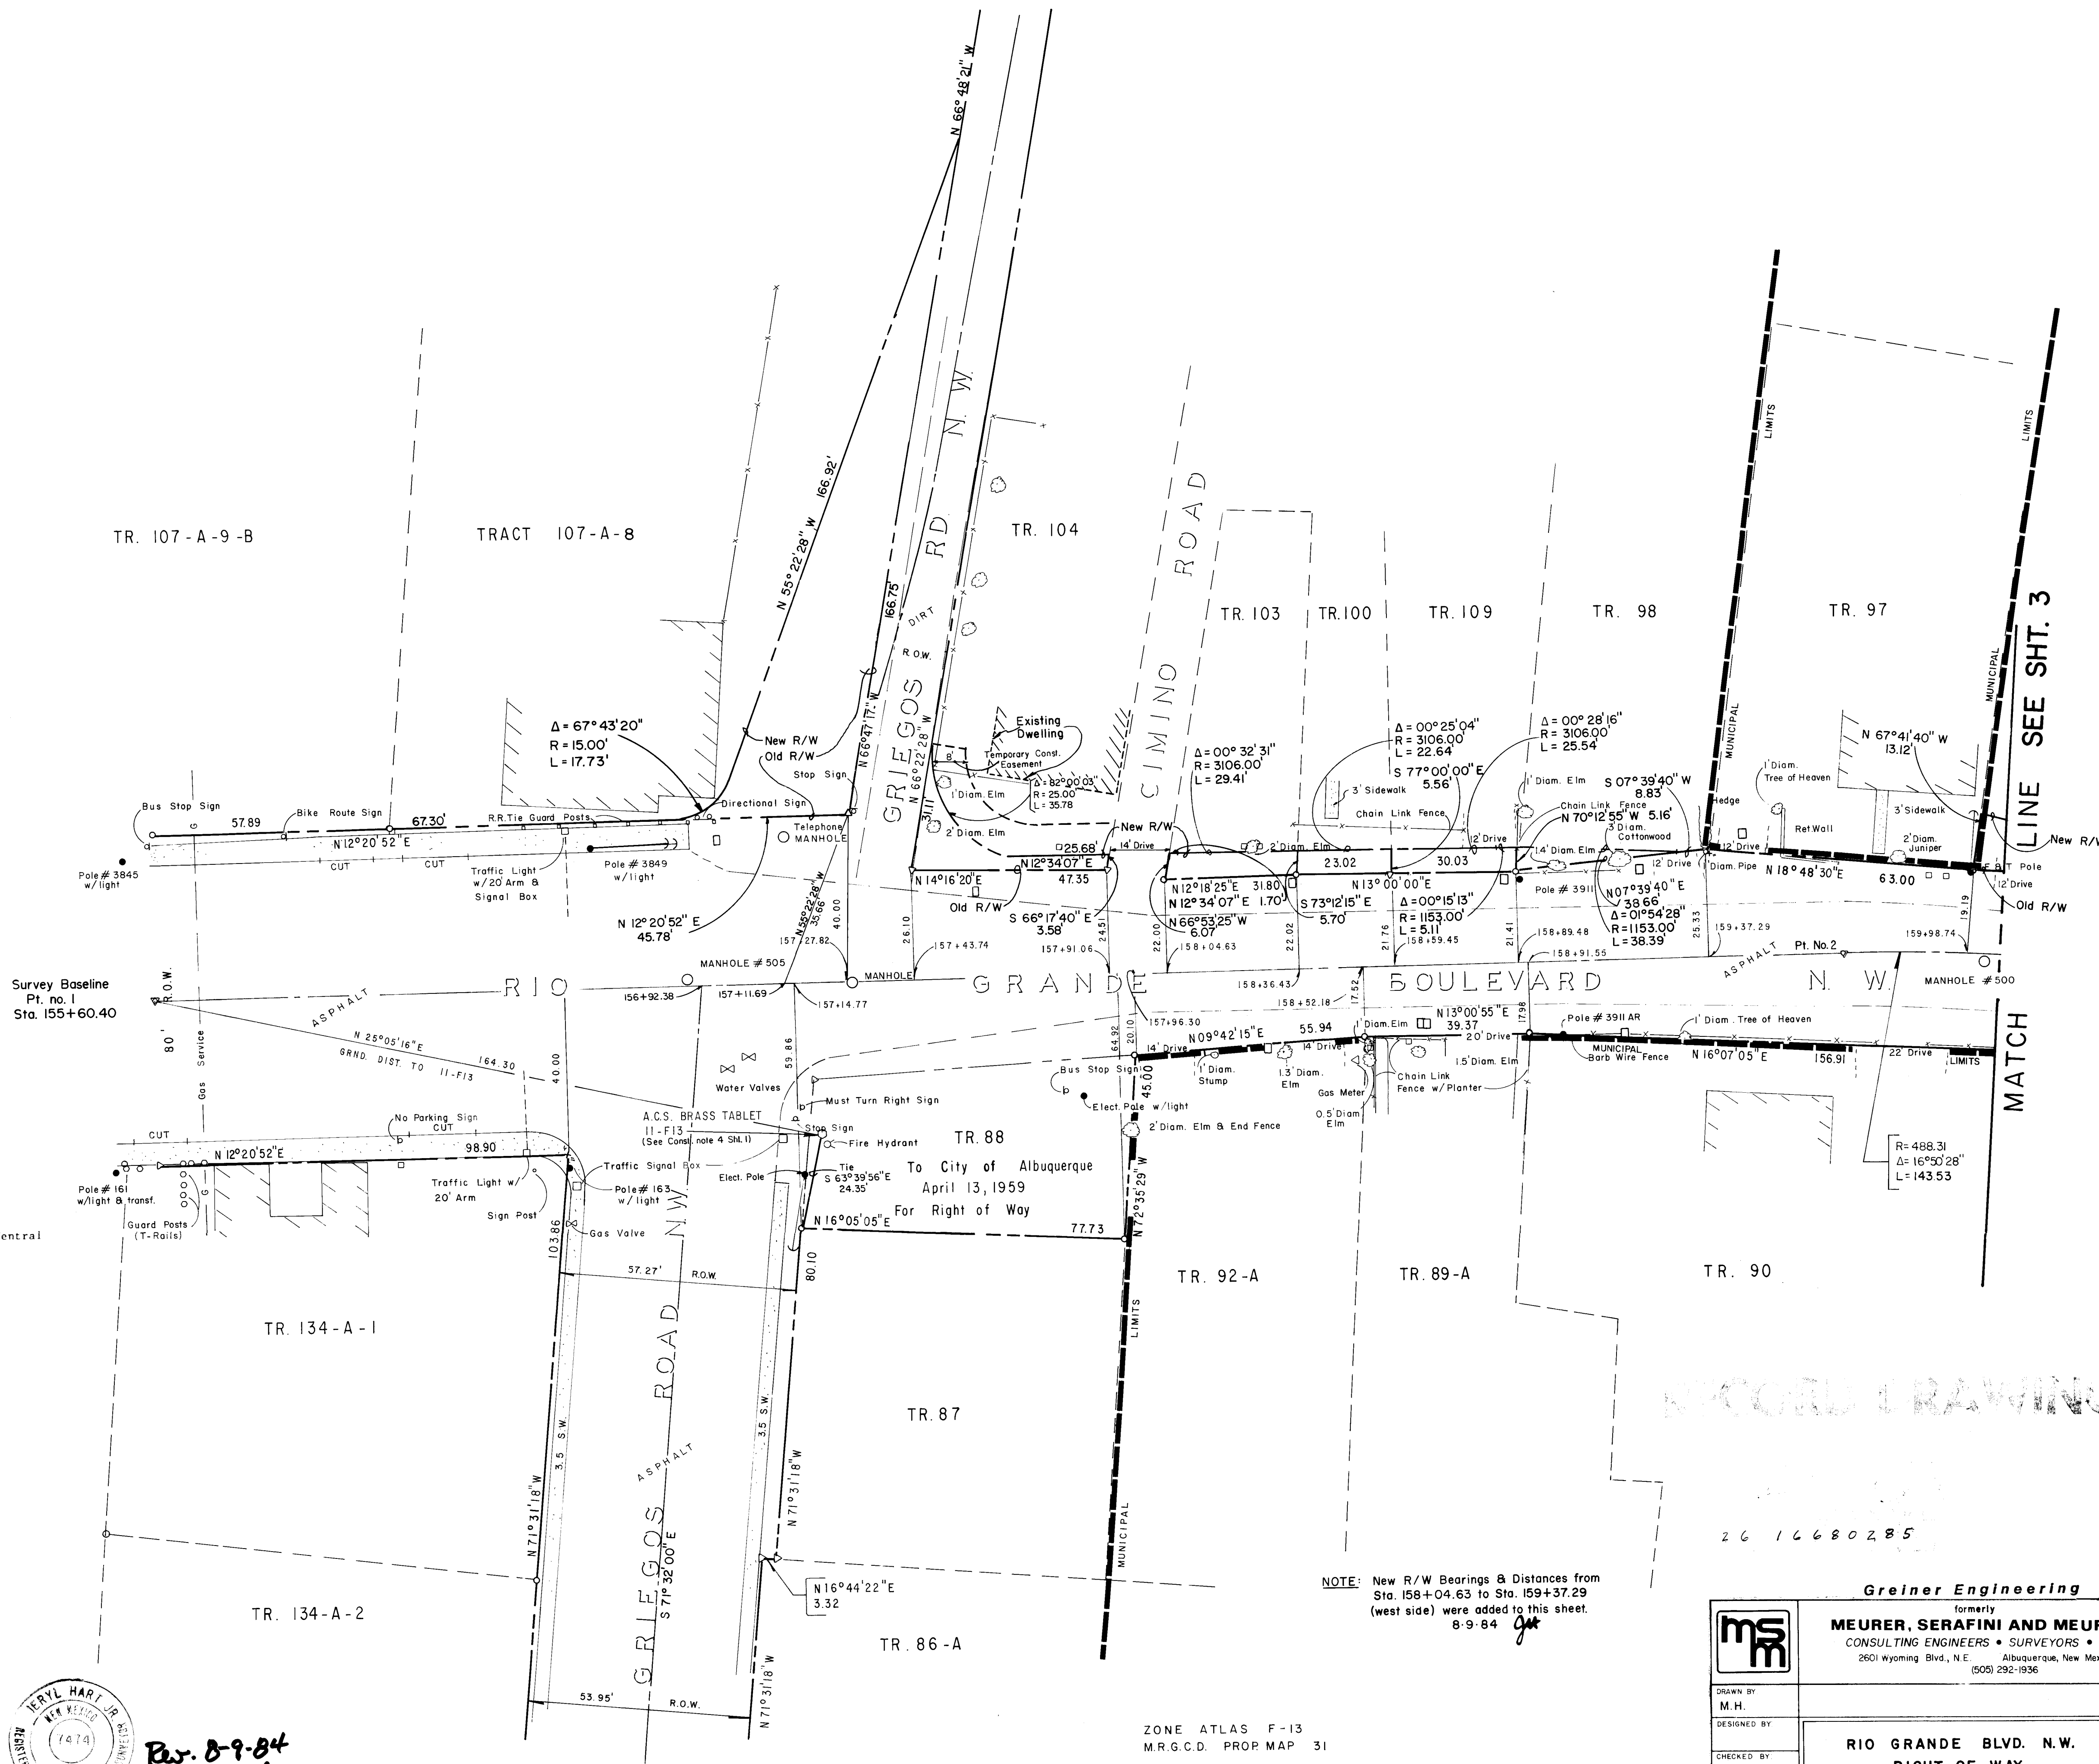

NOTE: New R/W Bearings & Distances from Sta. 158+04.63 to Sta. 159+37.29 (west side) were added to this sheet. 8-9-84 JH

ZONE ATLAS F-13
 M.R.G.C.D. PROP. MAP 31

Greiner Engineering formerly MEURER, SERAFINI AND MEURER, INC. CONSULTING ENGINEERS • SURVEYORS • PLANNERS 2601 Wyoming Blvd., N.E. Albuquerque, New Mexico 87112 (505) 292-1936		FILE NO. 0640242
DRAWN BY M.H.	DESIGNED BY	SCALE 1" = 20'
CHECKED BY	DATE APRIL '81	SHEET NO. 2 of 11
APPROVED BY J.H.	RIO GRANDE BLVD. N.W. RIGHT OF WAY MAP	


CIP No. 1668

5-70-A


BRUNING 44 135

JN 0690013

SEE SHEET 2

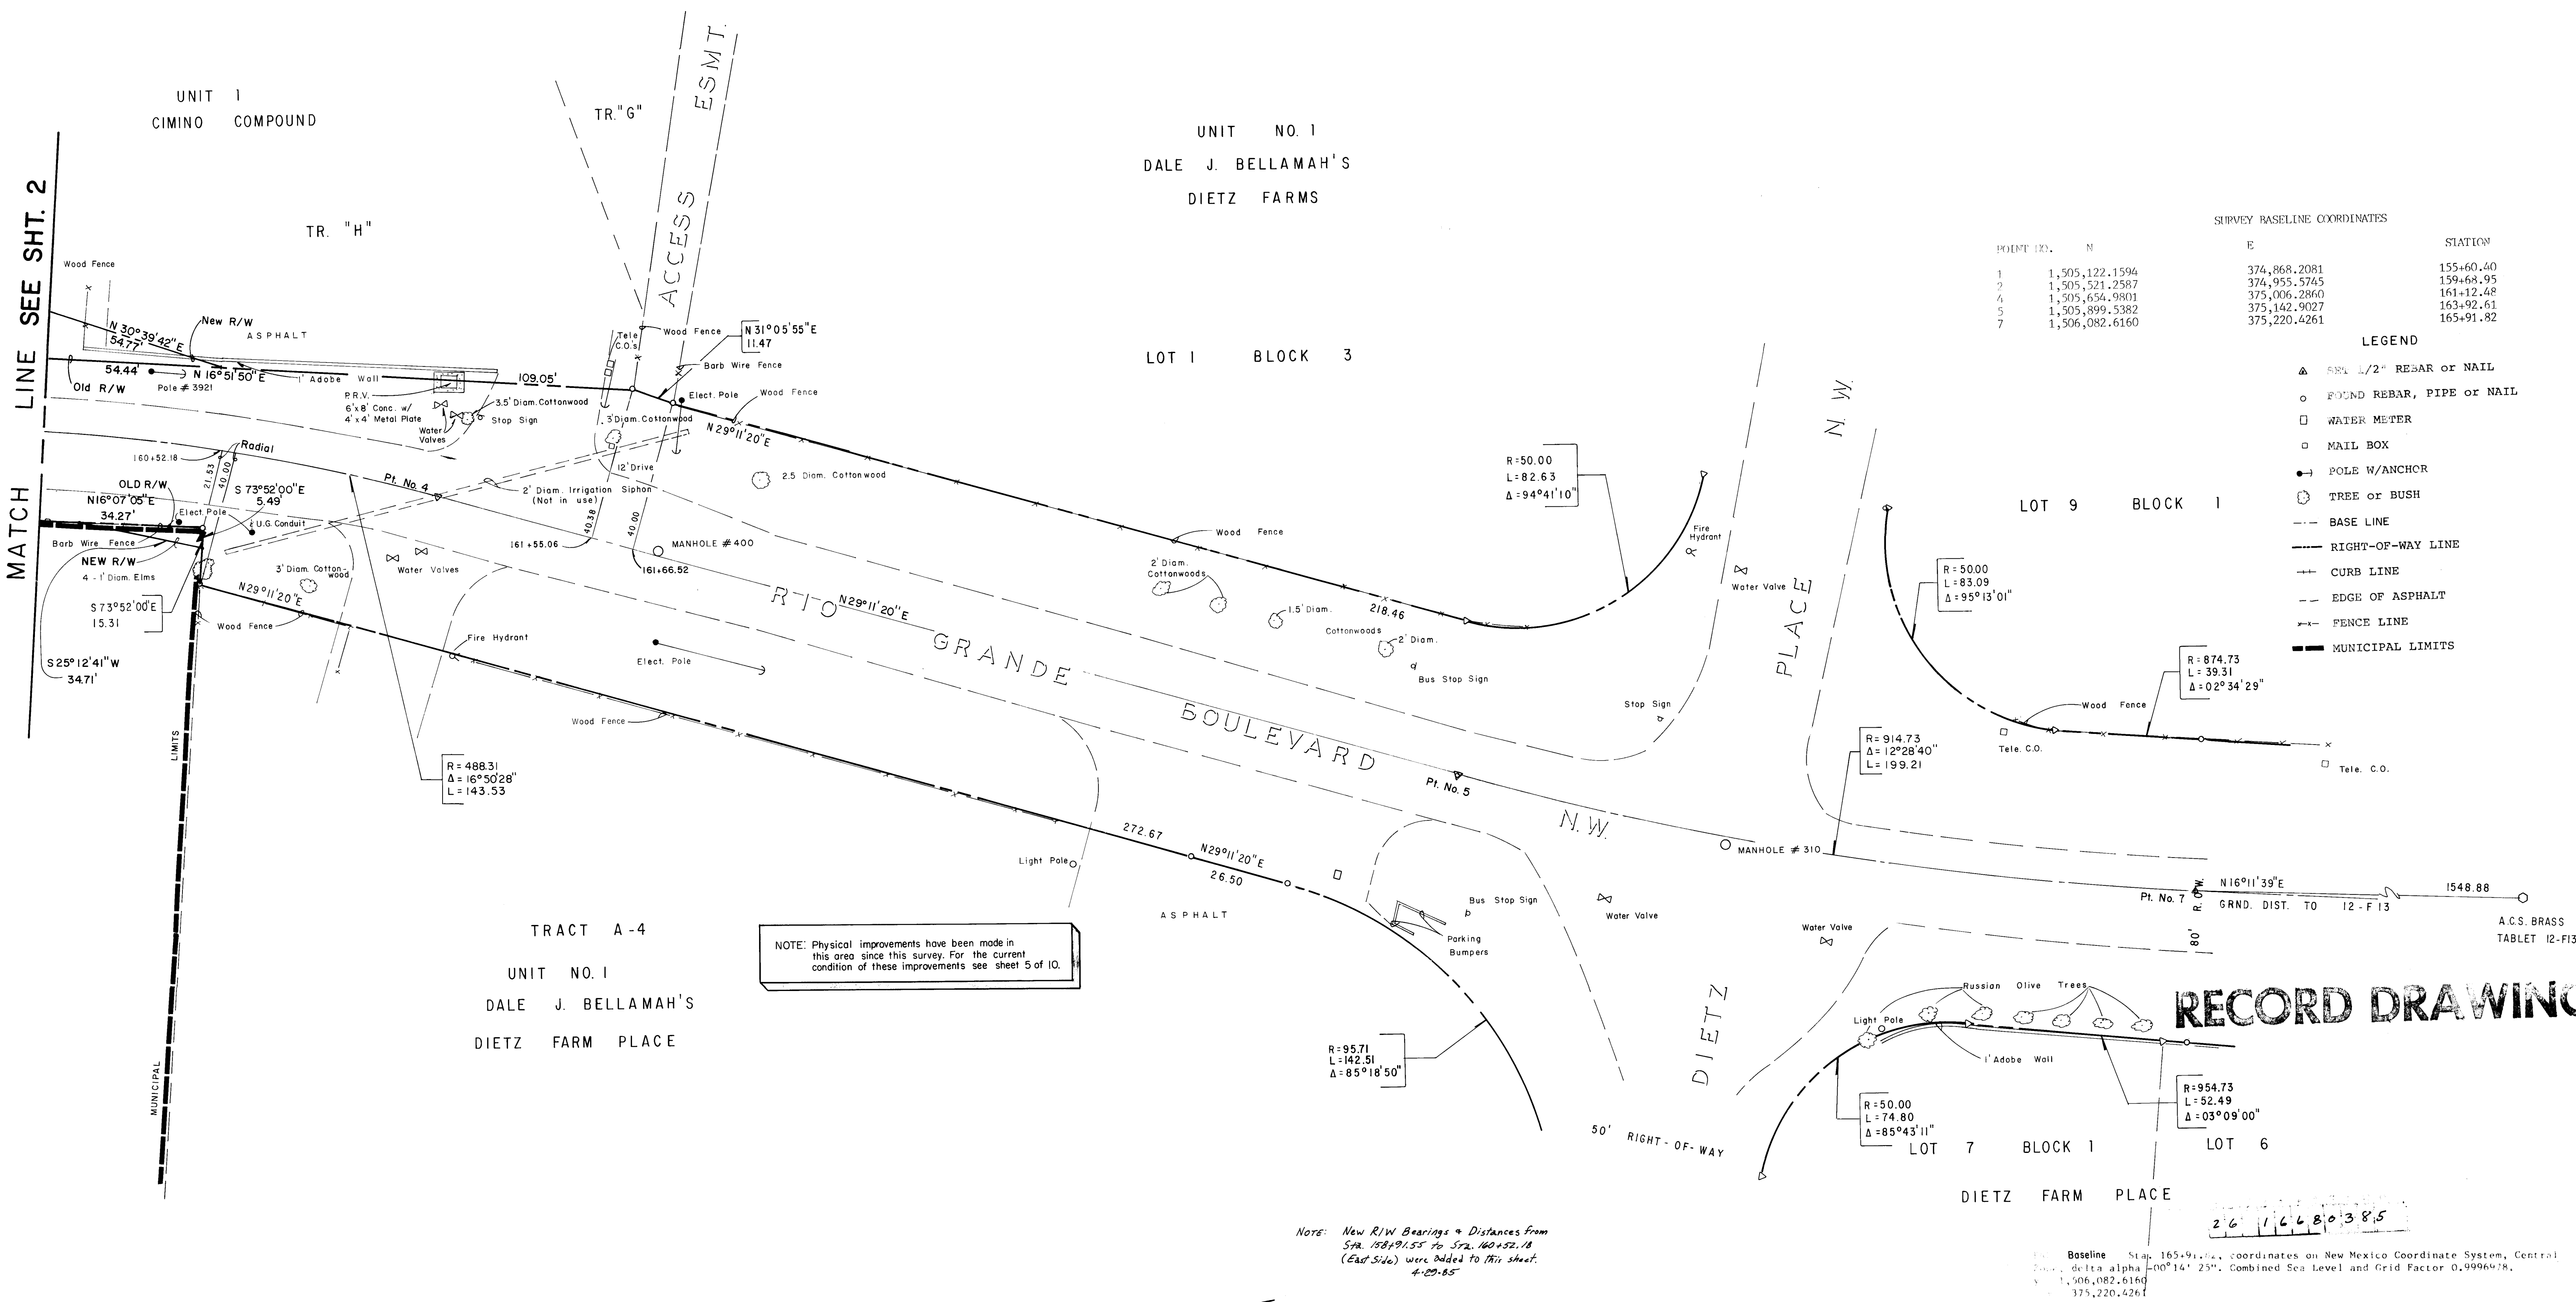

RECORD DRAWING

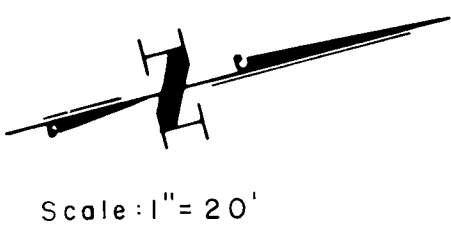

Scale: 1" = 20'

I, Jeryl Hart, Jr., Registered Professional Land Surveyor, New Mexico License Number 7474, do hereby certify that this Right-of-Way map and legal descriptions were prepared by me or under my supervision from an actual field survey and are true and correct to the best of my knowledge and belief.

Jeryl Hart Jr. 7/19/81
Jeryl Hart, Jr. New Mexico Registered Professional Land Surveyor No. 7474

ZONE ATLAS F-13
M.R.G.C.D. PROP. MAP 31



Greiner Engineering formerly MEURER, SERAFINI AND MEURER, INC. CONSULTING ENGINEERS • SURVEYORS • PLANNERS 2501 Wyoming Blvd., N.E. Albuquerque, New Mexico 87112 (505) 292-1936	
DRAWN BY M.H.	FILE NO. 0640242
DESIGNED BY	SCALE 1" = 20'
CHECKED BY	DATE APRIL '81
APPROVED BY J.H.	SHEET NO. 3 of 11


RIO GRANDE BLVD. N.W.
RIGHT OF WAY
MAP

CIP No. 1668

5-70-

W 0690013


1. Where new pavement ends and meets existing, match the new pavement elevation to the existing elevation and provide a smooth riding surface. See edge of pavement detail sheet 6 of II.
2. For cross-section of each full station at 100 ft. intervals see sheets 7, 8 and 9.
3. For edge of driving surface offsets every 50 feet and at PC's and PT's, see the elevations and offsets table this sheet. In the plan view a tick mark has been made on the edge of driving surface to coincide with the PC's and PT's listed in the table.
4. See sheet 6 of II for typical roadway sections.
5. Permanent striping, traffic signalization and traffic sign removal and replacement shall be done by the City of Albuquerque Traffic Engineering Division. The Contractor shall coordinate this portion of the work with the Traffic Engineer and give three working days notice before any work is expected to be done.
6. All median, lane and edge striping, and any other required pavement markings will be done by the City's Traffic Engineering Division. See Sht. II of II for stations & curve data.
7. All stationing is based on the survey base line.
8. Provide earth fill as required at all existing dirt surfaced turn outs to provide a smooth riding surface. Earth fill compaction shall be to a density of not less than 95% of maximum density for the upper six inches as determined by ASTM D 1557. Soil bearing value shall be 20 or more. Transition earth fill from edge of new pavement to existing driving surface. Delete the borrow ditch in these areas. This work is incidental to the completion of the project and no direct payment shall be made for earth fill.

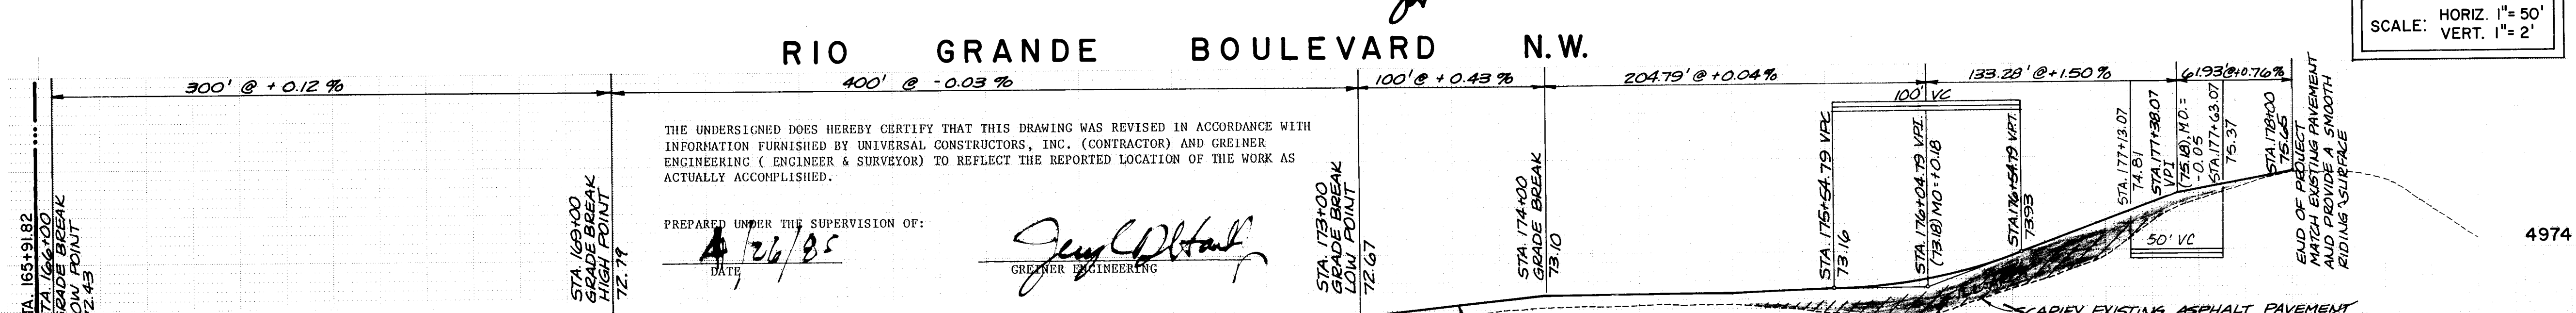

	CITY ENGINEER	DATE	DRAWING NO.	668
--	---------------	------	-------------	-----

[illegible]

NOTE: AN AREA OF GREATER WIDTH THAN 18" MAY REQUIRE REMOVAL IF SAWCUTTING REVEALS THE ASPHALT DEPTH TO BE ONLY 3 INCHES. PAVEMENT REMOVAL IS NECESSARY UNTIL THE 6 INCH PAVEMENT DEPTH IS FOUND. 42" TYPICALLY REQ. 9"

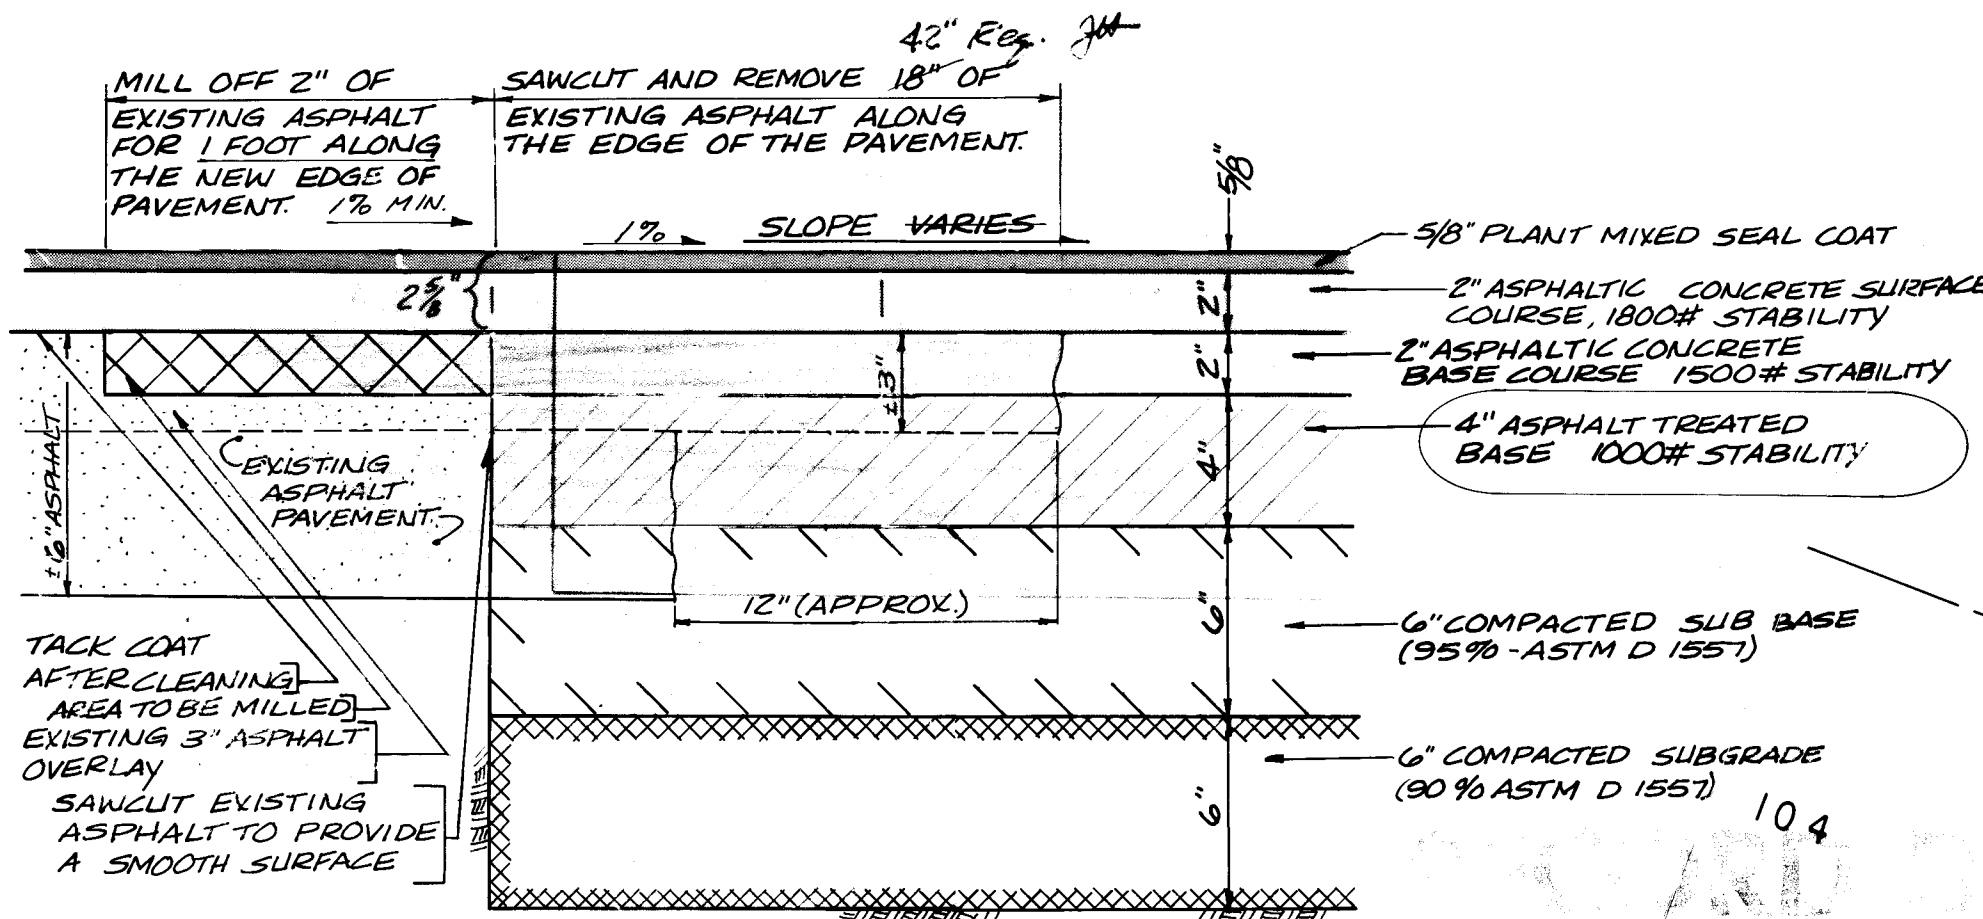


KEY DETAIL
SCALE: 1" = 6"

THE UNDERSIGNED DOES HEREBY CERTIFY THAT THIS DRAWING WAS REVISED IN ACCORDANCE WITH INFORMATION FURNISHED BY UNIVERSAL CONSTRUCTORS, INC. (CONTRACTOR) AND GREINER ENGINEERING (ENGINEER & SURVEYOR) TO REFLECT THE REPORTED LOCATION OF THE WORK AS ACTUALLY ACCOMPLISHED.

PREPARED UNDER THE SUPERVISION OF:


DATE: 4/26/85

GREINER ENGINEERING

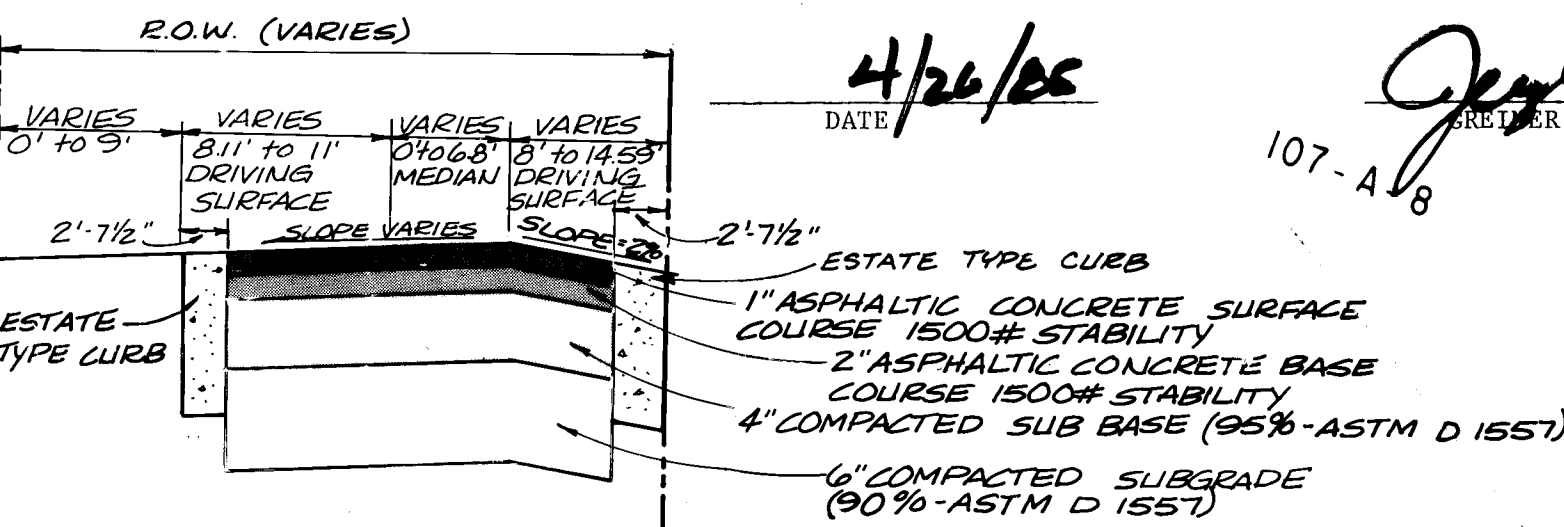


TYPICAL ROADWAY SECTION - GRIEGOS WEST
SCALE: HORIZ. 1" = 10' VERT. 1" = 1'

STREET SIDE SLOPE GRADING IS INCIDENTAL TO SUBGRADE PREPARATION.

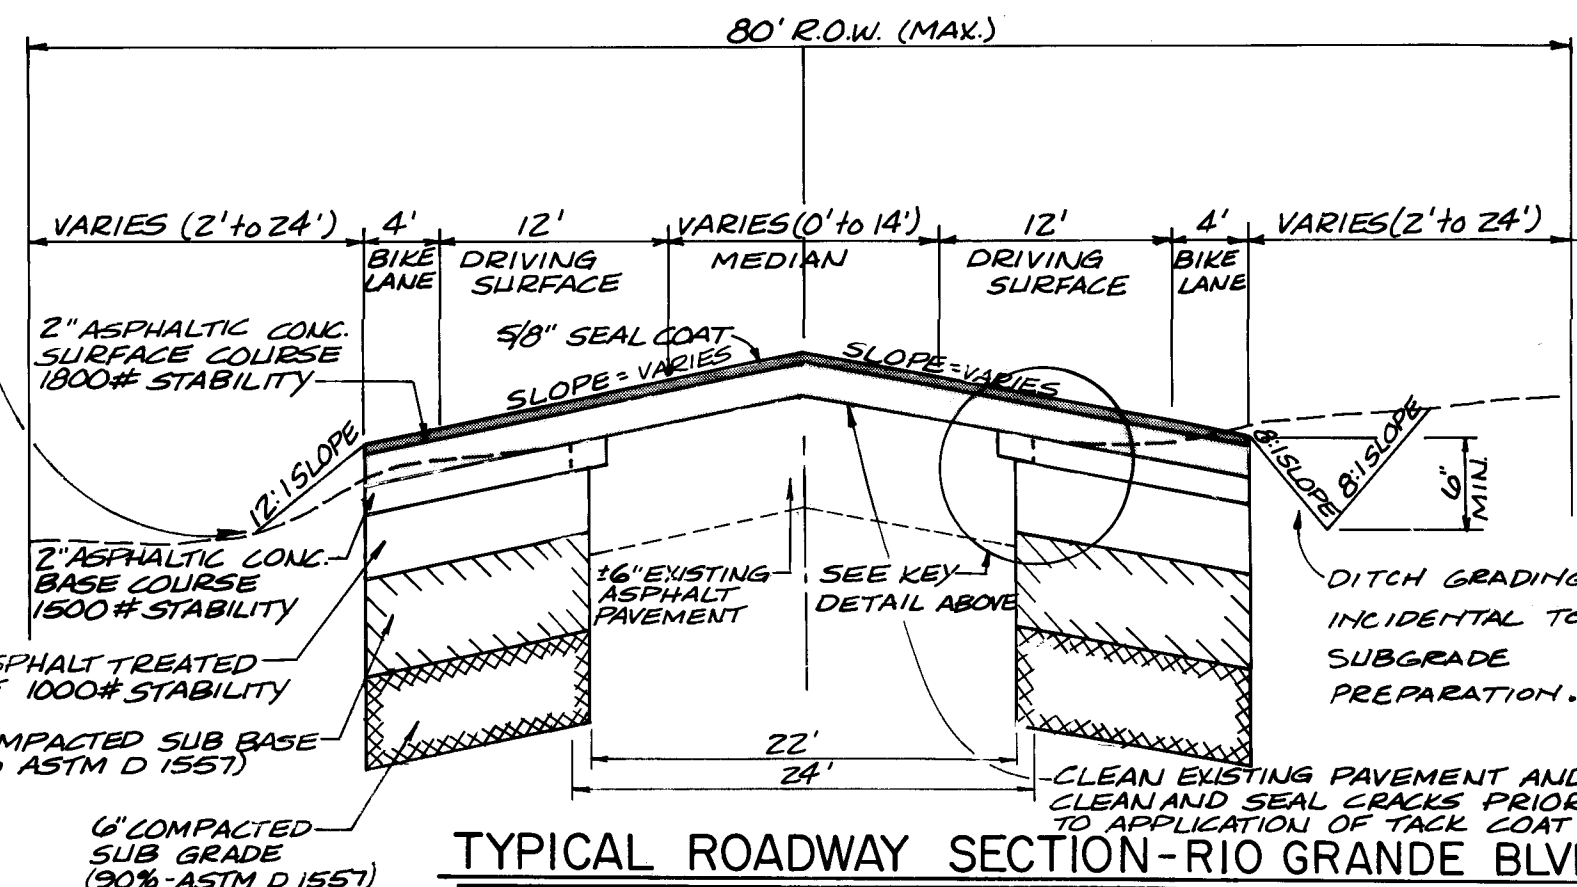

TYPICAL ROADWAY SECTION - RIO GRANDE BLVD.
SCALE: HORIZ. 1" = 10' VERT. 1" = 1'

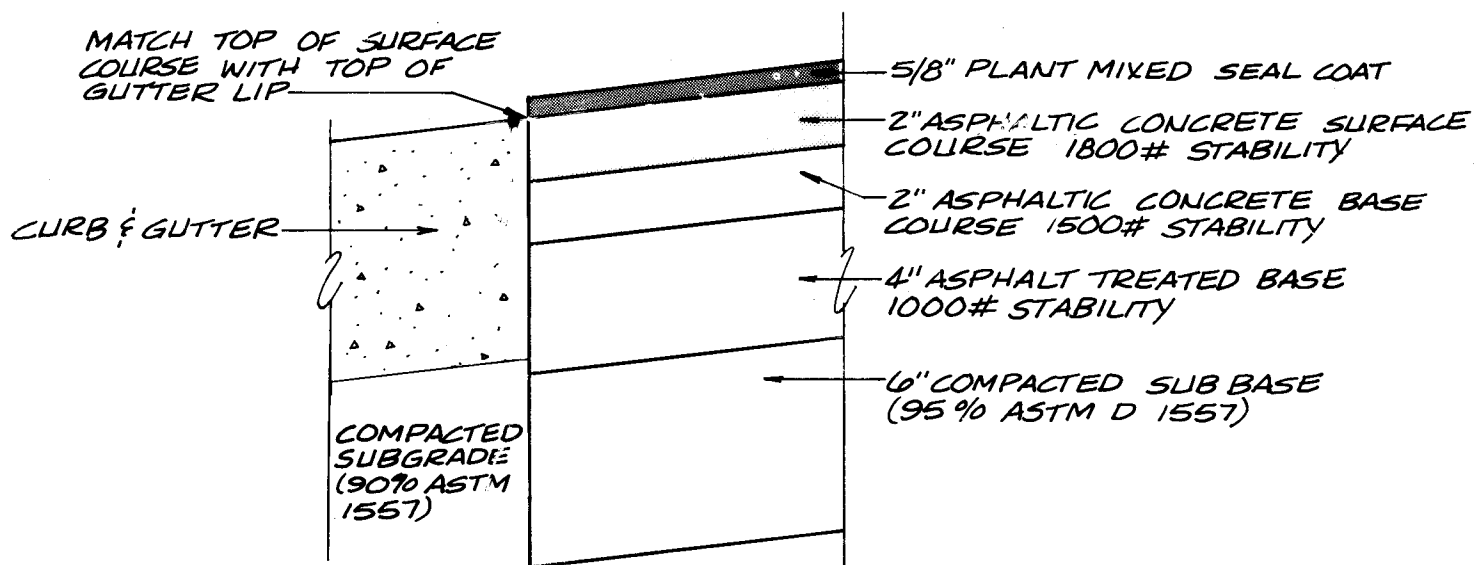


GUTTER-PAVEMENT MATCH DETAIL
SCALE: 1" = 6"

GRADE AS NECESSARY WITHIN RIGHT OF WAY TO ROUTE RUNOFF TO GUTTER FLOW LINE


NOTE: SWALE NEAR EDGE OF BIKE LANE

TRAFFIC SIGNALIZATION NOTES:

1. USE 2" CONDUIT EXCEPT AS NOTED
2. PB - PULLBOX STANDARD T-4
3. SP TYPE I - PEDESTAL SIGNAL FOUNDATION TYPE I STD. T-5
4. MASTARM TYPE II FOUNDATION STD. T-6

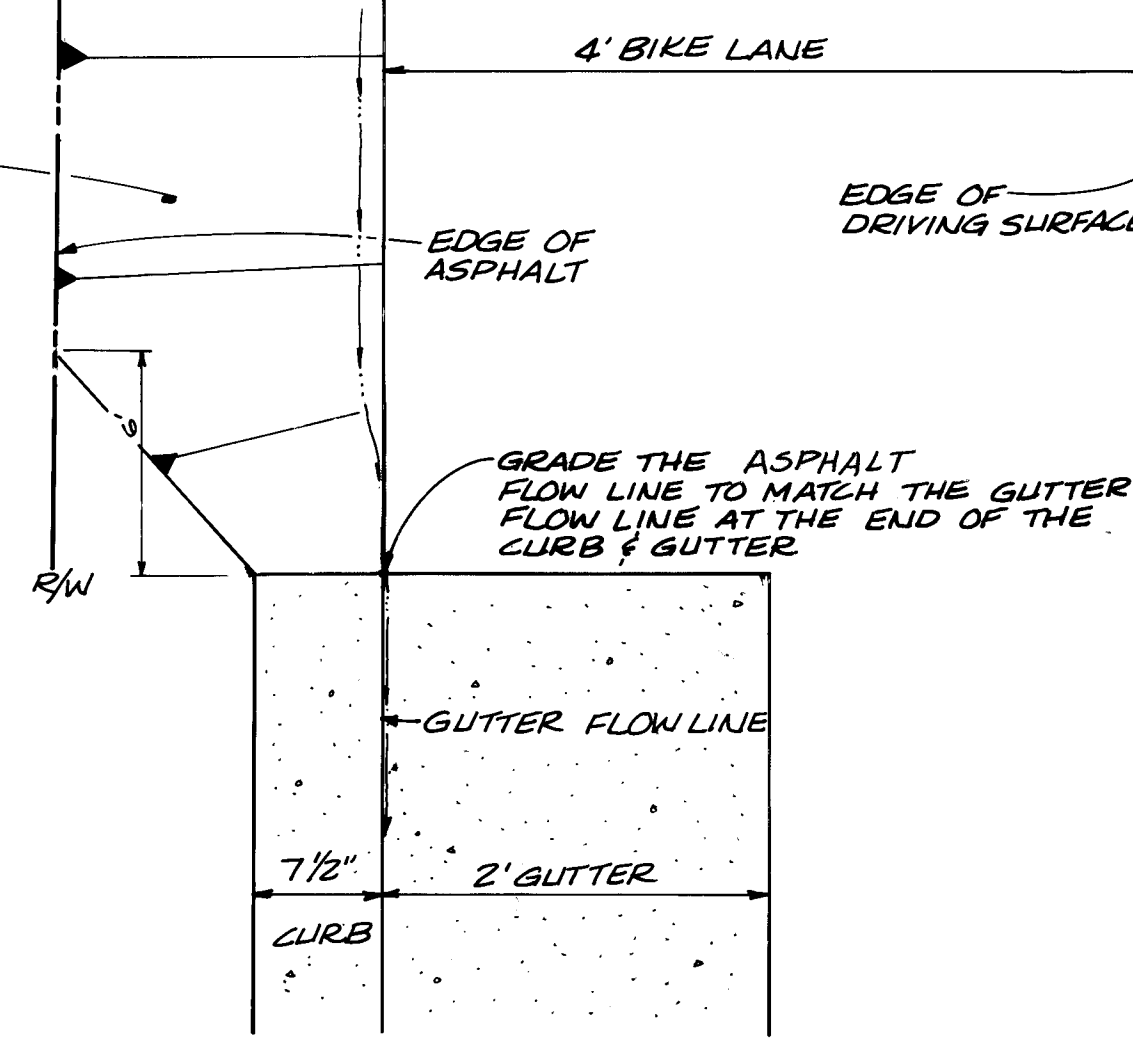

END CURB & GUTTER DETAIL
NOT TO SCALE

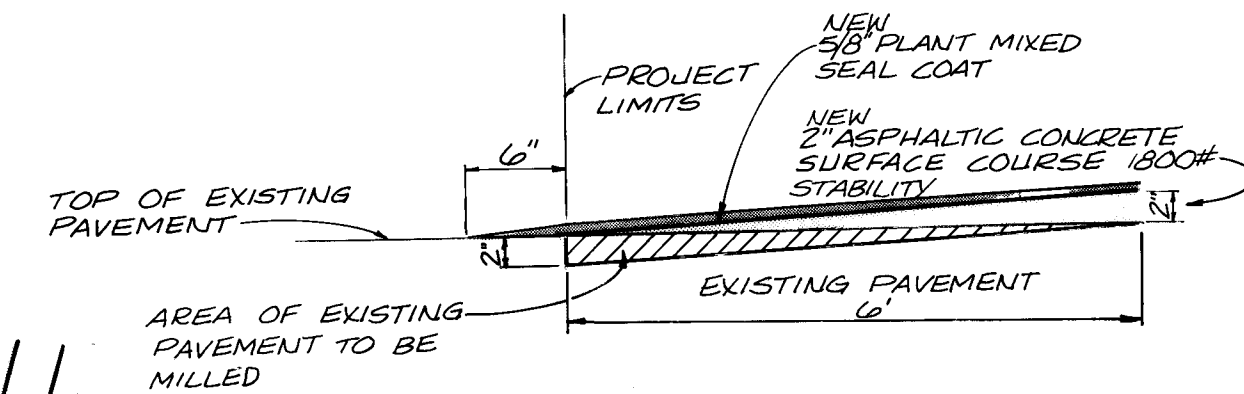

EDGE OF NEW ASPHALT DETAIL (A)
SCALE: HORIZ. 1/2" = 1'-0" VERT. 1" = 1'-0"

NOTES:


1. Where new pavement ends and meets existing, match the new pavement elevation to the existing elevation and provide a smooth riding surface. See edge of pavement detail sheet 6 of 11.
2. For cross-section of each full station at 100 ft. intervals see sheets 7, 8 and 9 of 11. See sheet 9 of 11 for Griegos Rd. West for profile.
3. See sheet 6 of 11 for typical roadway sections.
4. Permanent striping, traffic signalization and traffic sign removal and replacement shall be done by the City of Albuquerque Traffic Engineering Division. The Contractor shall coordinate this portion of the work with the Traffic Engineer and give three working days notice before any work is expected to be done.
5. All median, lane and edge striping, and any other required pavement markings will be done with reflectorized paint and/or raised and reflectorized pavement markers by the City's Traffic Engineering Division.
6. All stationing is based on the survey base line.
7. Provide earth fill as required at all existing dirt surfaced turn outs to provide a smooth riding surface. Earth fill compaction shall be to a density of not less than 95% of maximum density for the upper six inches as determined by ASTM D 1557. Soil bearing value shall be 20 or more. Transition earth fill from edge of new pavement to existing driving surface, delete the bottom ditch in these areas. This work is incidental to the completion of the project and no direct payment shall be made for earth fill.

Back of Curb Curve Data

Curve No.	Δ	R	L
①	101° 03' 25"	25.00'	44.09'
②	67° 43' 20"	25.00'	29.55'
③	79° 07' 58"	25.00'	34.53'
④	03° 54' 02"	600.00'	40.85'

LEGEND

=====	TEMP. 4" CHAINLINK FENCE
-----	BASE LINE
-----	RIGHT-OF-WAY LINE
=====	EDGE OF DRIVING SURFACE
=====	BIKE LANE
=====	SIDEWALK W/WHEELCHAIR RAMP
=====	VALLEY GUTTER
+	EXIST. STREET SIGN
+	EXIST. WATER VALVE
+	EXIST. WATER METER
+	EXIST. FIRE HYDRANT
+	EXIST. MANHOLE
+	EXIST. ELECTRIC POLE W/ANCHOR
+	EXIST. TRAFFIC SIGNAL BOX
+	EXIST. POST
+	EXIST. WOOD FENCE
+	EXIST. FOILAGE OR TREE
=====	FLOW DIRECTION
EG	EXIST. GROUND
EL	FLOW LINE
TC	TOP OF CURB
ER	END OF RETURN
EDS	EDGE OF DRIVING SURFACE
Δ	ASC BRASS TABLE 11-F13

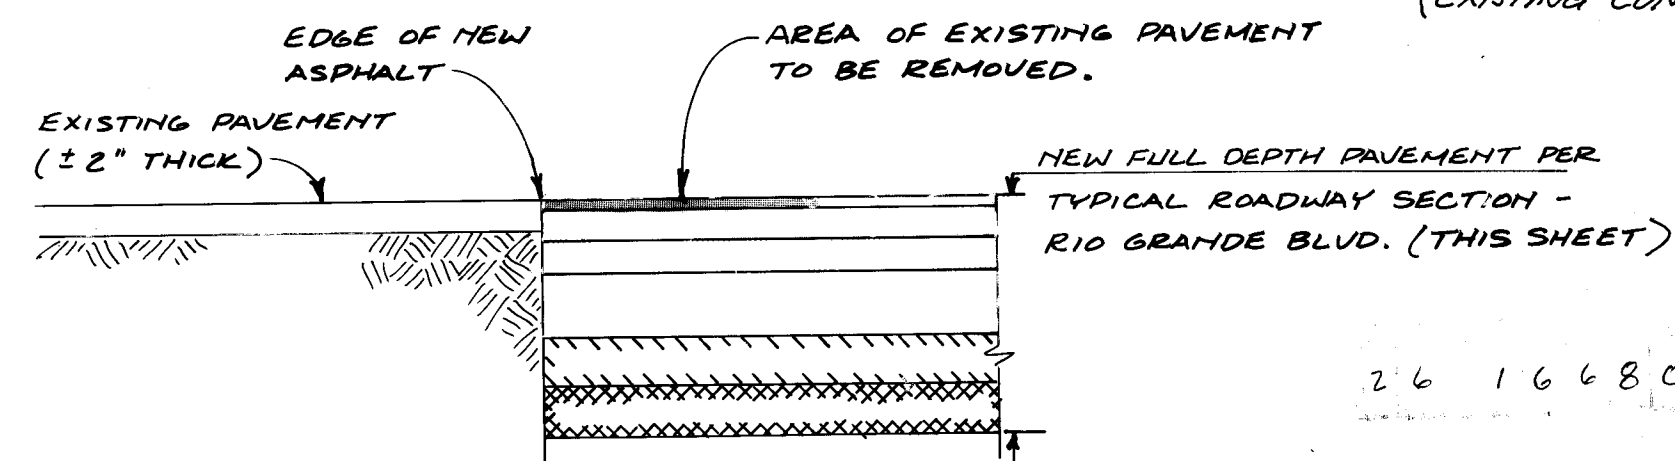


EDGE OF NEW ASPHALT DETAIL (B)
SCALE: HORIZ. 1/2" = 1'-0" VERT. 1" = 1'-0"


Greiner Engineering CONSULTING ENGINEERS - SURVEYORS - PLANNERS 2601 WYOMING BLVD., N.E. SUITE F ALBUQUERQUE, NEW MEXICO 87112 (505) 292-1936			CITY OF ALBUQUERQUE TRANSPORTATION DEPARTMENT ENGINEERING DIVISION		
TITLE: PLAN DETAIL RIO GRANDE BLVD., GRIEGOS RD. INTERSECTION					
APPROVALS	ENGINEER	DATE	APPROVALS	ENGINEER	DATE
City Engineer	C. H. Thompson	7/5/84	Liquid Waste	R. P. Pugh	8/29/84
A.C.E. - Design	R. P. Pugh	6/5/84	Traffic	R. P. Pugh	8/29/84
A.C.E. - Hydrology	R. P. Pugh	6/5/84	Water	R. P. Pugh	8/29/84
DRAWING NO. 1668			SHEET 6 OF 11		

A MINIMUM OF 2-5/8" OF BITUMINOUS PAVEMENT SHALL BE PLACED ON ALL EXISTING PAVEMENT.


THE EXISTING PAVEMENT STRUCTURE THAT IS NOT REMOVED IS TO HAVE AT LEAST A 2-5/8" OVERLAY (2" ASPHALT CONCRETE SURFACE COURSE, 1600 LB. STABILITY PLUS 5/8" PLANT MIX SEAL COAT) PLACED OVER IT EVERYWHERE AND NO MILLING OF THE EXISTING SURFACE IS TO BE DONE JUST TO MATCH THE PROFILE GRADE LINE OR TYPICAL SECTIONS. A THICKER OVERLAY OR EVEN LEVELING IS DESIRABLE AT THE DISCRETION OF THE ENGINEER TO ASSURE GOOD RIDEABILITY. ANY SUCH THICKER OVERLAY OR LEVELING WILL BE INCIDENTAL TO THE TOTAL COST OF THE PROJECT.

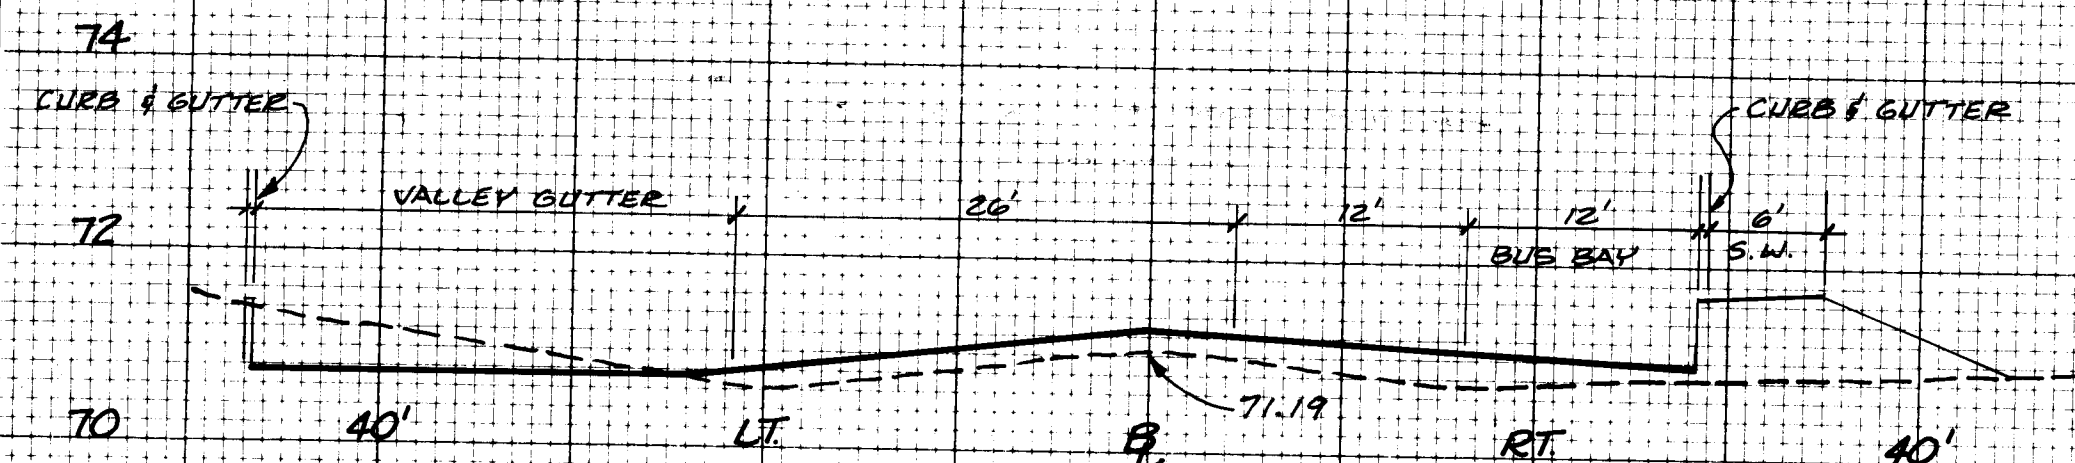


157+50

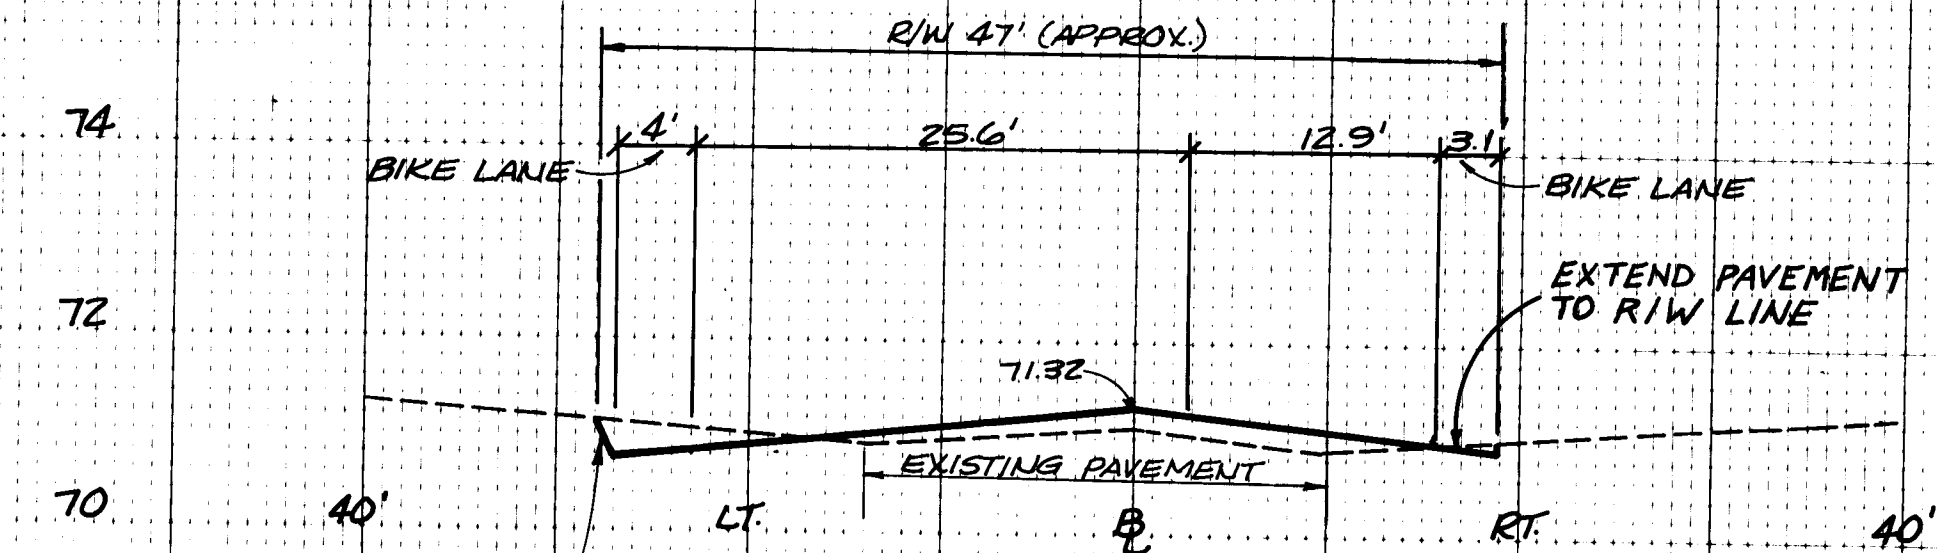


158+00

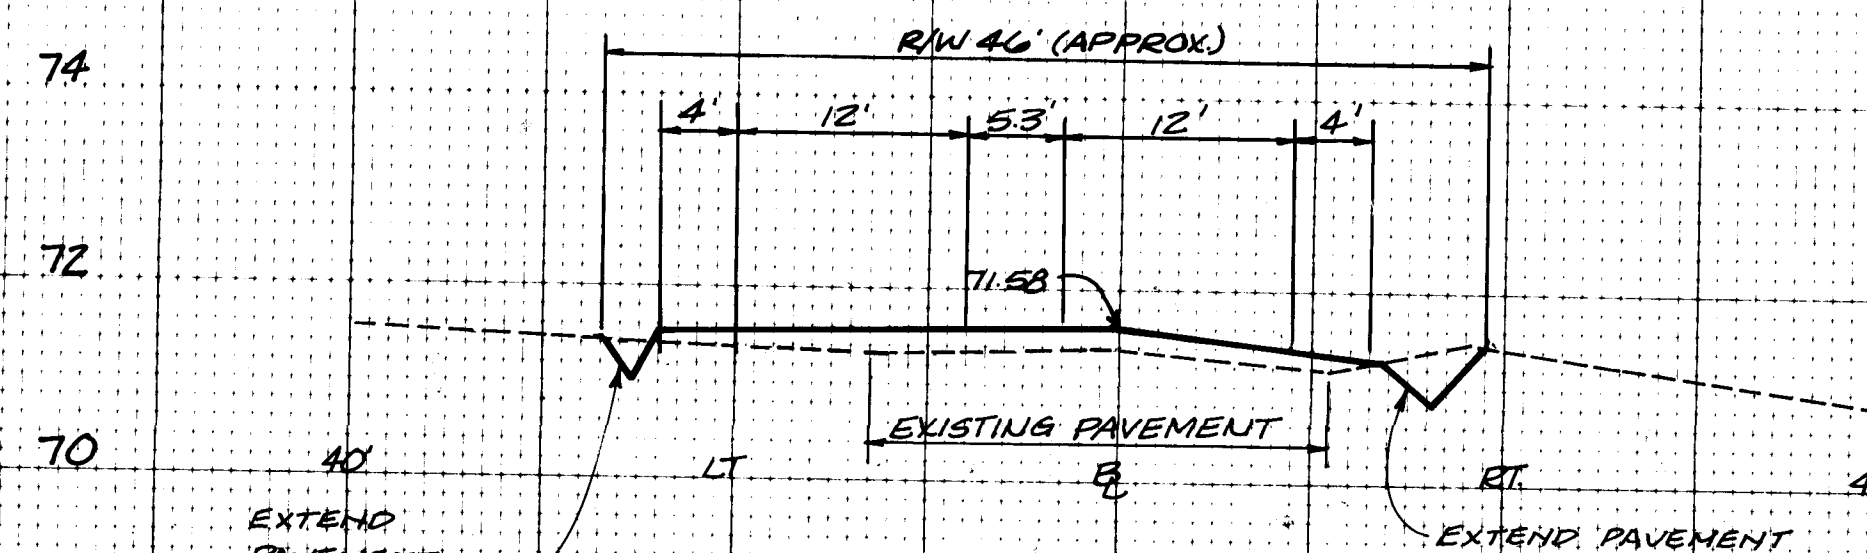


159+00

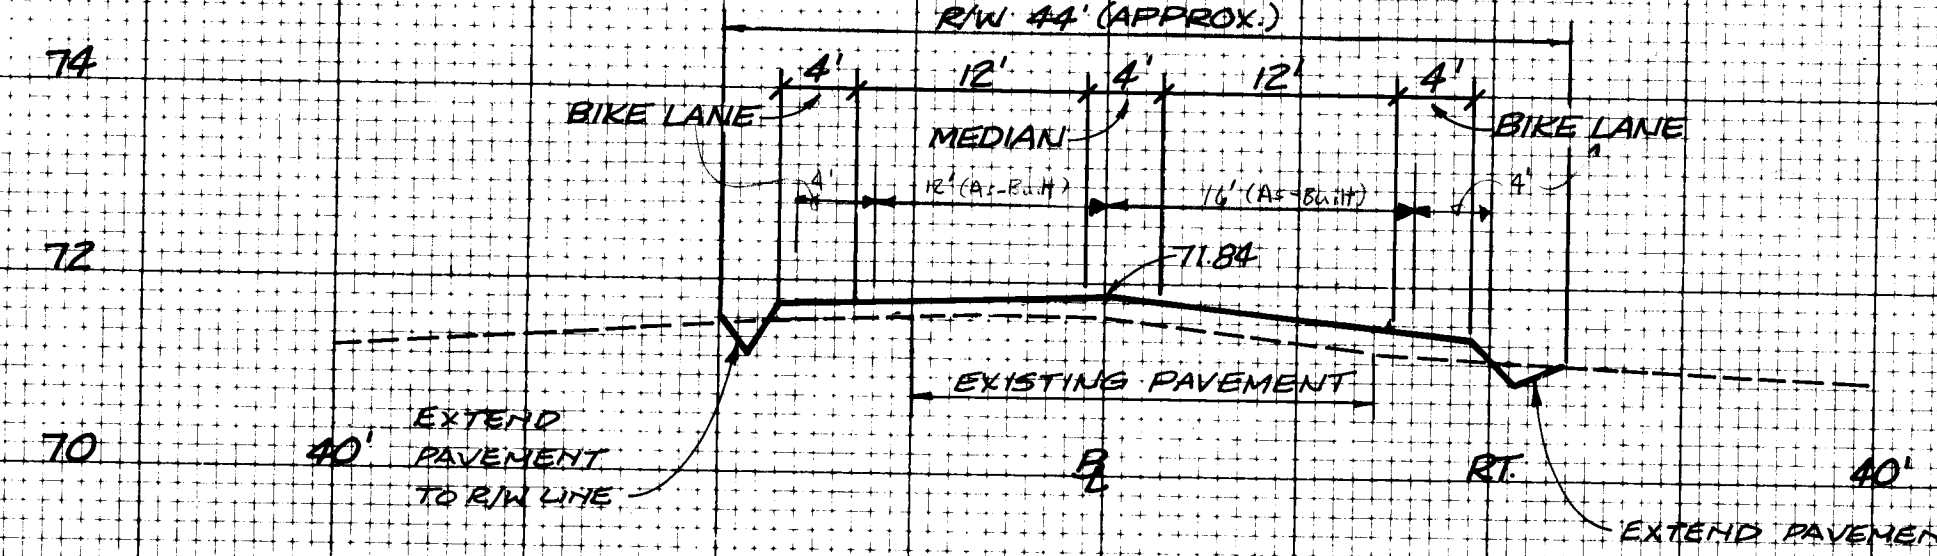


160+00

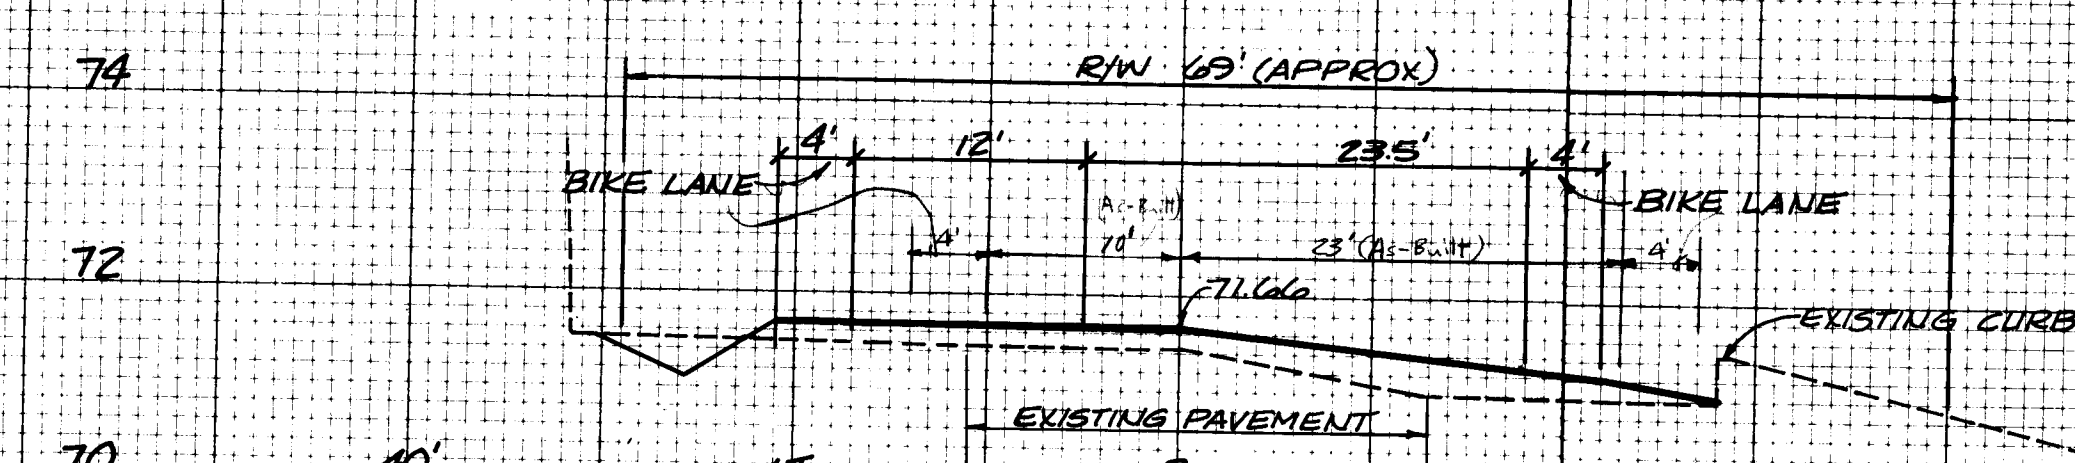


161+00

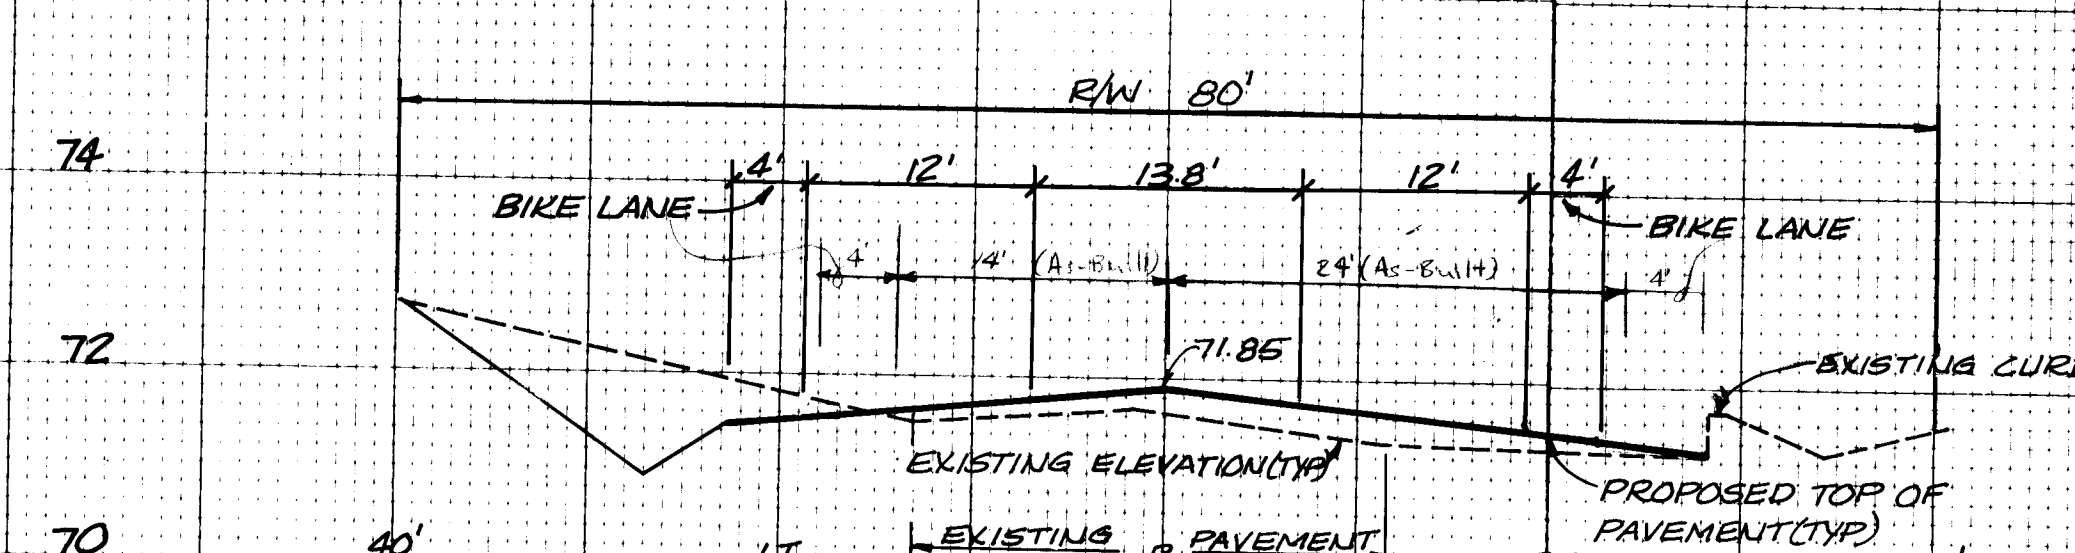


162+00

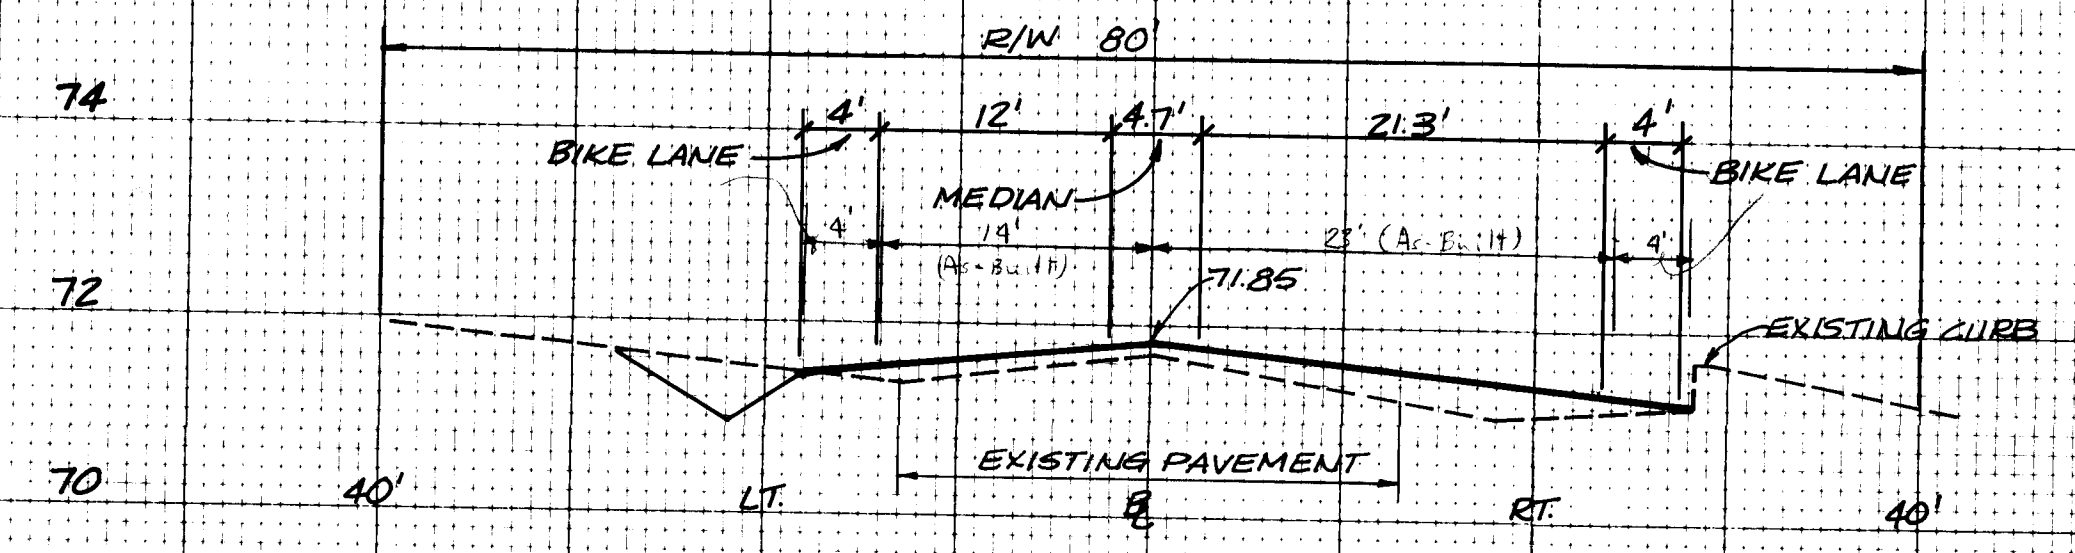

163+00

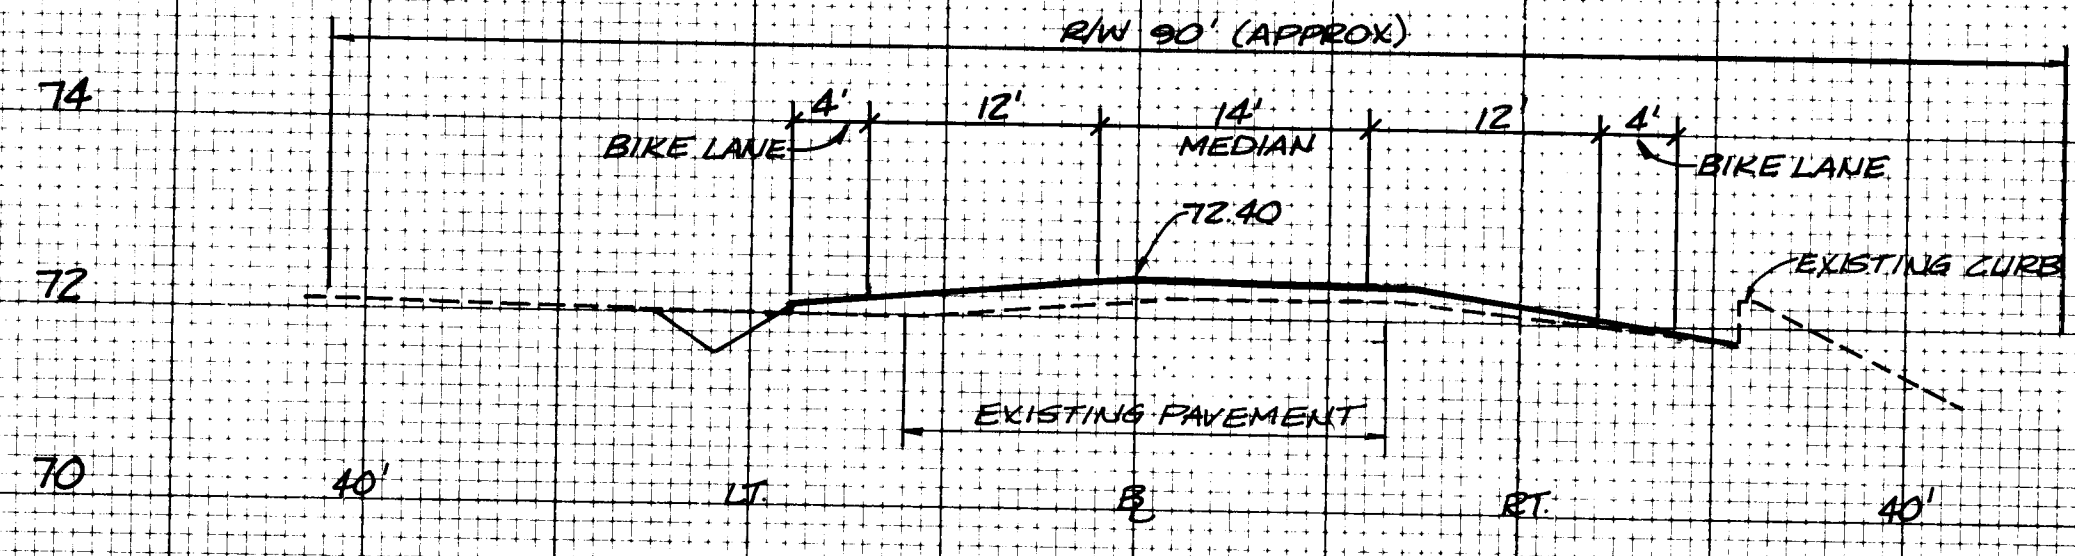

164+00

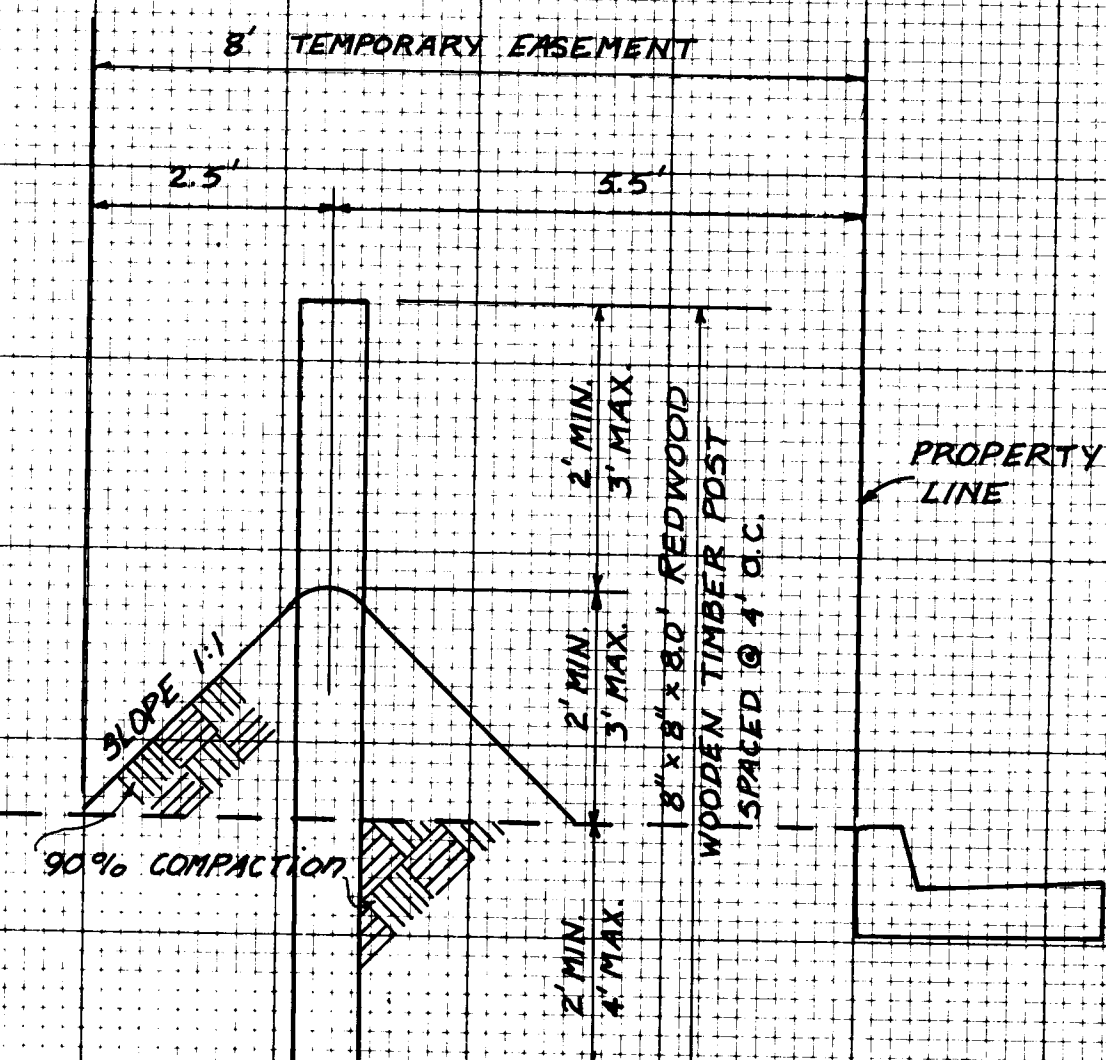

BERM DETAIL

SCALE: HORIZ. 1" = 2' VERT. 1" = 2'

THE UNDERSIGNED DOES HEREBY CERTIFY THAT THIS DRAWING WAS REVISED IN ACCORDANCE WITH INFORMATION FURNISHED BY UNIVERSAL CONSTRUCTORS, INC. (CONTRACTOR) AND GREINER ENGINEERING (ENGINEER & SURVEYOR) TO REFLECT THE REPORTED LOCATION OF THE WORK AS ACTUALLY ACCOMPLISHED.

PREPARED UNDER THE SUPERVISION OF:

4/24/05

Greiner Engineering

SCALE: HORIZ. 1" = 10' VERT. 1" = 2'

Greiner Engineering CONSULTING ENGINEERS - SURVEYORS - PLANNERS 2601 WYOMING BLVD., SUITE F ALBUQUERQUE, NEW MEXICO 87110 (505) 792-1936




CITY OF ALBUQUERQUE TRANSPORTATION DEPARTMENT ENGINEERING DIVISION

TITLE: CROSS SECTIONS RIO GRANDE BOULEVARD


DRAWING NO. 1668 SHEET 7 OF 11

AS BUILT INFORMATION				SURVEY INFORMATION				REFERENCES				REVISIONS			
CONTRACTOR	UNIVERSAL CONSTRUCTORS, INC.	DATE	4/1/05	MAP NO.	F-13	EST NO.		MAP NO.	F-13	EST NO.		NO.	DATE	BY	REMARKS
SCALE	BY Greiner Eng.	DATE	4/1/05	FIELD NOTES	ACS BM 7-F13, ELEV. 4970.766			NO.	WO. NO.						
INSPECTION	BY Greiner Eng.	DATE	4/1/05	DATE	ACS BM 9-F13, ELEV. 4974.738			1553							
VERIFICATION	BY Greiner Eng.	DATE	4/1/05	7-80	ACS BM 10-F13, ELEV. 4973.212			1546							
CORRECTION	BY Greiner Eng.	DATE	4/1/05	7-80											
MICRO-FILM INFORMATION				DESIGN				DESIGNED BY				DRAWN BY			
								D. GROCHOWSKI				C. SLOCOM			
								DATE 12/16/82				DATE 12/16/82			
								J.H.				J.H.			


The existing pavement structure that is not removed is to have at least a 2 5/8" overlay (2" Asphalt Concrete Surface Course, 1800 lb. stability plus 5/8" Plant Mix Seal Coat) placed over it everywhere and no milling of the existing surface is to be done until it matches the proposed grade line or typical sections of thicker overlay is required. It is desirable at the discretion of the Engineer to assure good rideability. Any such thicker overlay or assure leveling will be incidental to the total cost of the project.

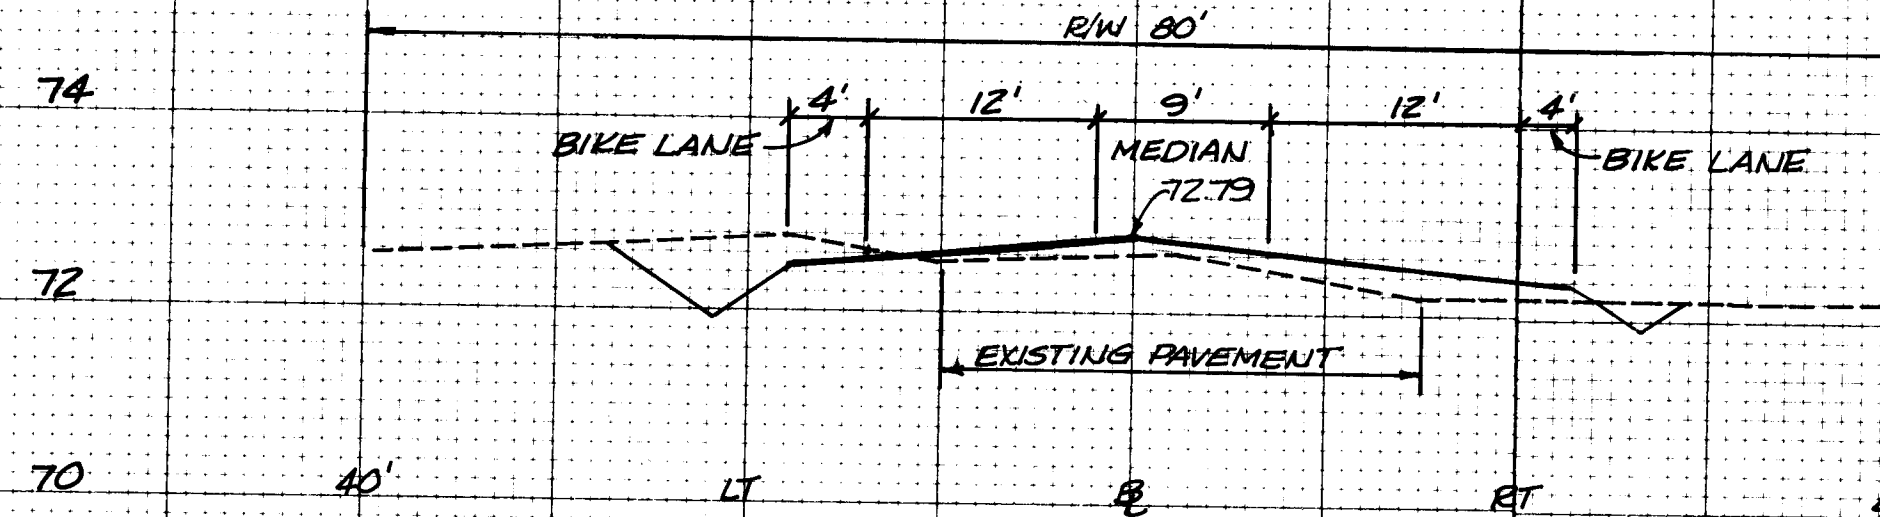


169+00

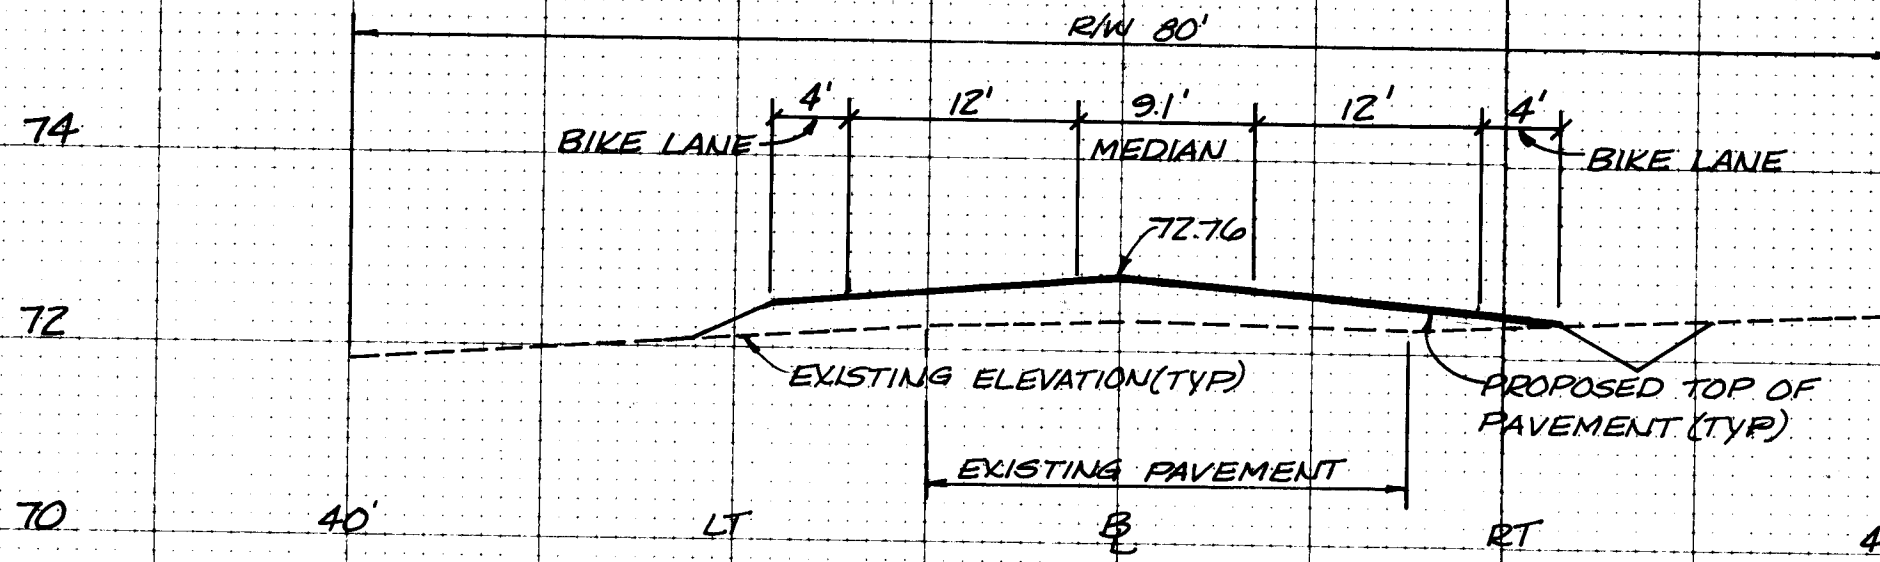

170+00

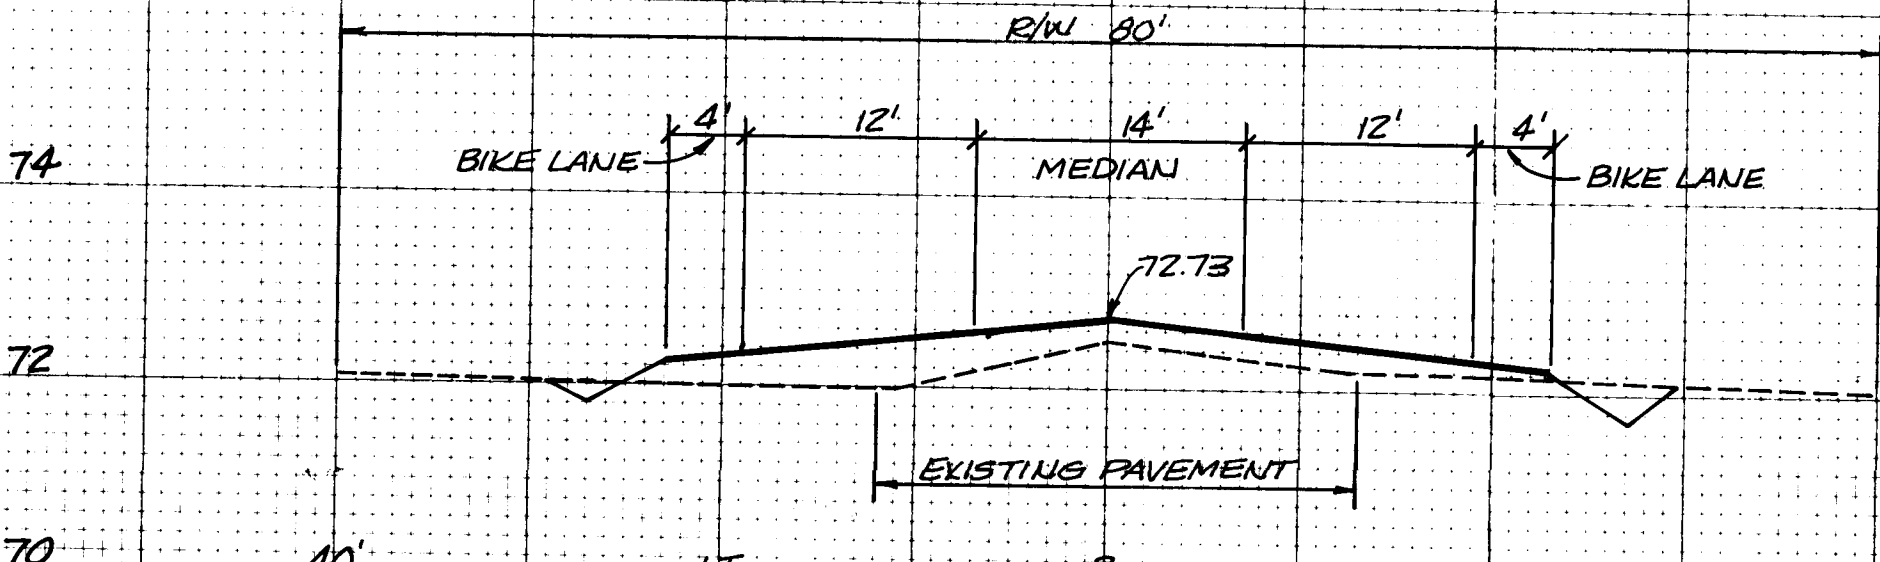


171+00

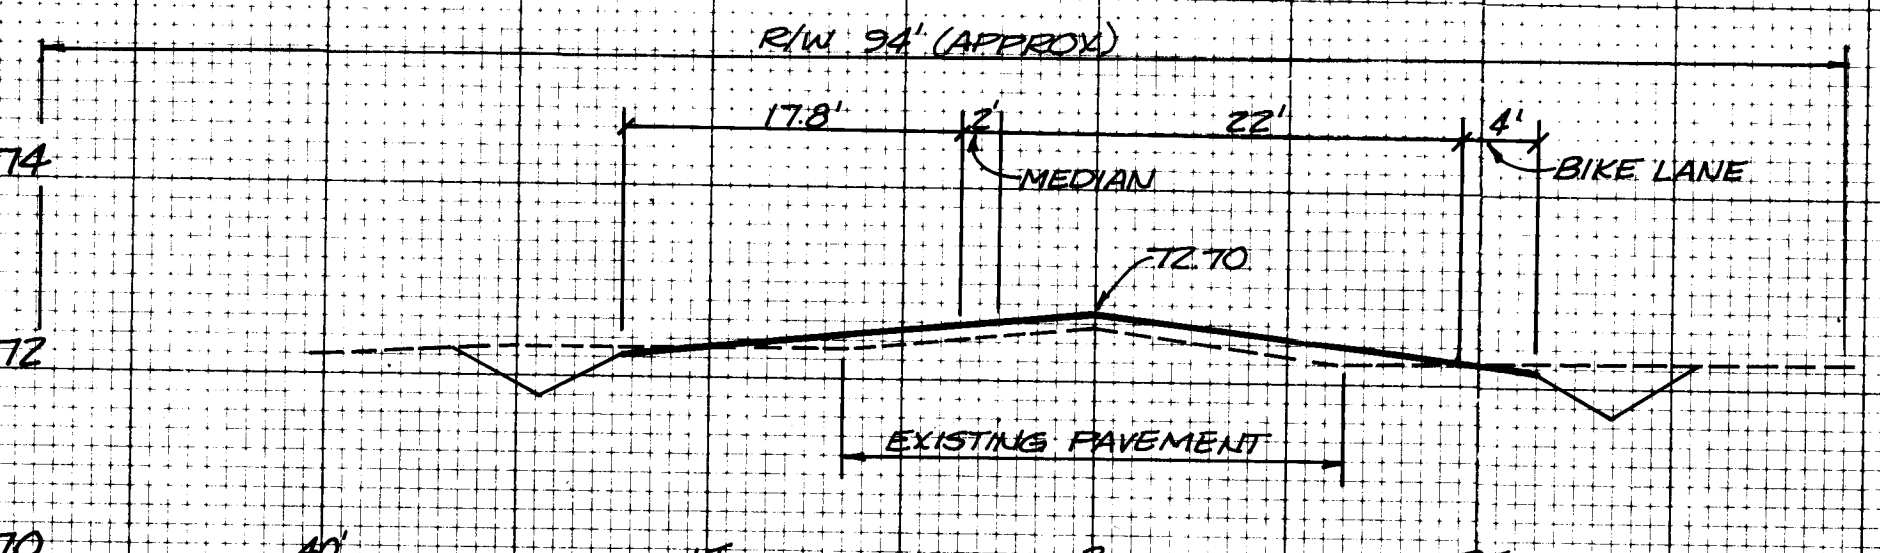


172+00

No Elevations As-Built


SCALE: HORIZ. 1" = 10'
VERT. 1" = 2'

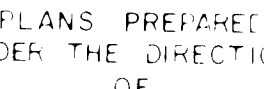GRAINEER ENGINEERING 2001 WYOMING BLVD., N.E., SUITE F ALBUQUERQUE, NEW MEXICO 87110 (505) 292-1936		CONSULTING ENGINEERS - SURVEYORS - PLANNERS		NO. ID	DESIGNER	DRAWN BY	CHECKED
PLANS PREPARED UNDER THE DIRECTION OF 		CITY OF ALBUQUERQUE TRANSPORTATION DEPARTMENT ENGINEERING DIVISION					
TITLE:		CROSS SECTIONS RIO GRANDE BOULEVARD					
APPROVALS:	ENGINEER	DATE	APPROVALS:	ENGINEER	DATE		
City Engineer	<i>C. D. Murphy</i>	<i>8/6/84</i>	Liquid Waste	<i>S. Torg</i>	<i>8/29/84</i>		
A C E - Design	<i>ALC</i>	<i>8/6/84</i>	Traffic	<i>R. J. [unclear]</i>	<i>8-29-84</i>		
A C E - Hydrology	<i>D. W. [unclear]</i>	<i>8/24/84</i>	Water	<i>K. [unclear]</i>	<i>8/29/84</i>		
APPROVED FOR CONSTRUCTION		CITY ENGINEER		DATE		SHEET 8 OF 11	
DRAWING NO.		1668					


A MINIMUM OF 2-5/8" OF BITUMINOUS PAVEMENT SHALL BE PLACED ON ALL EXISTING PAVEMENT.

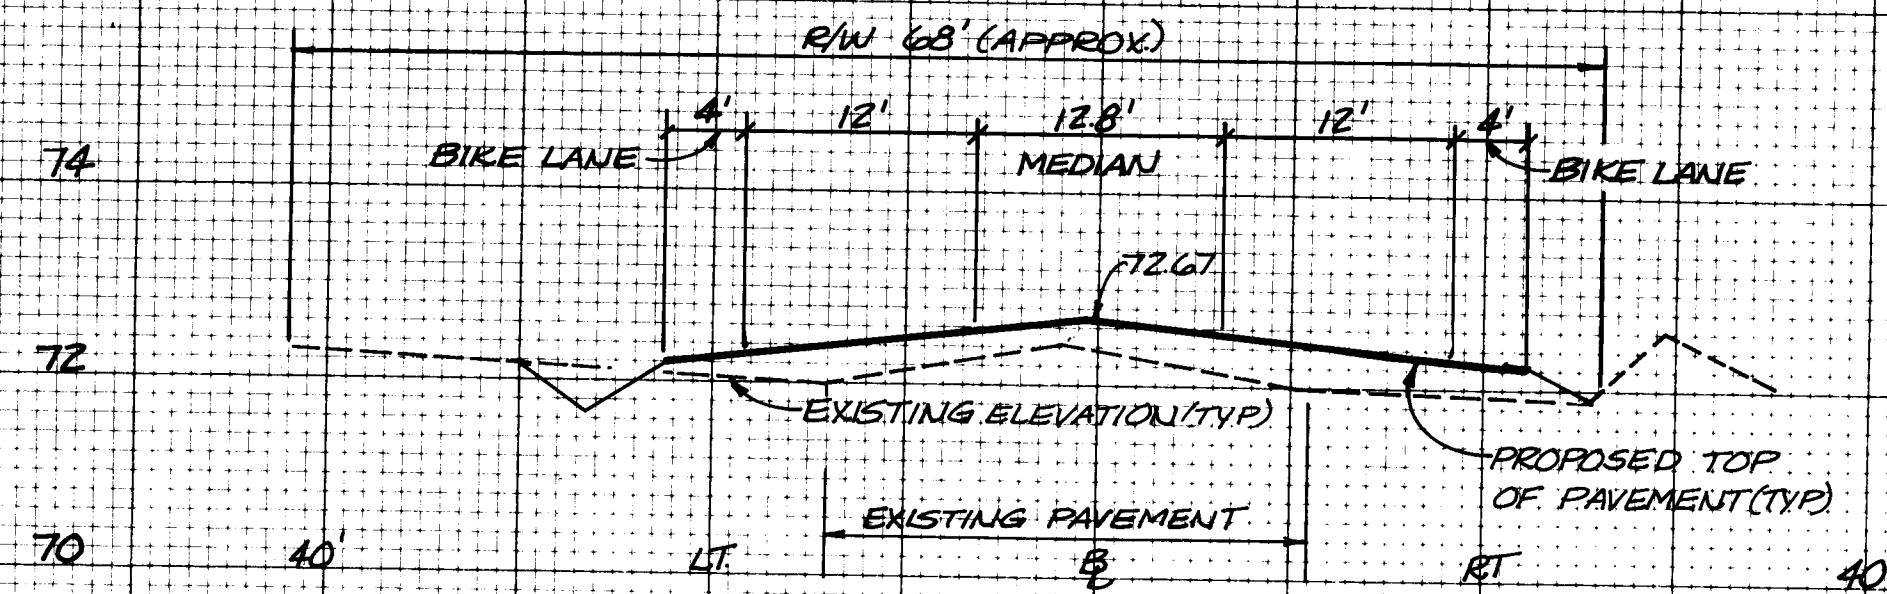


173+00

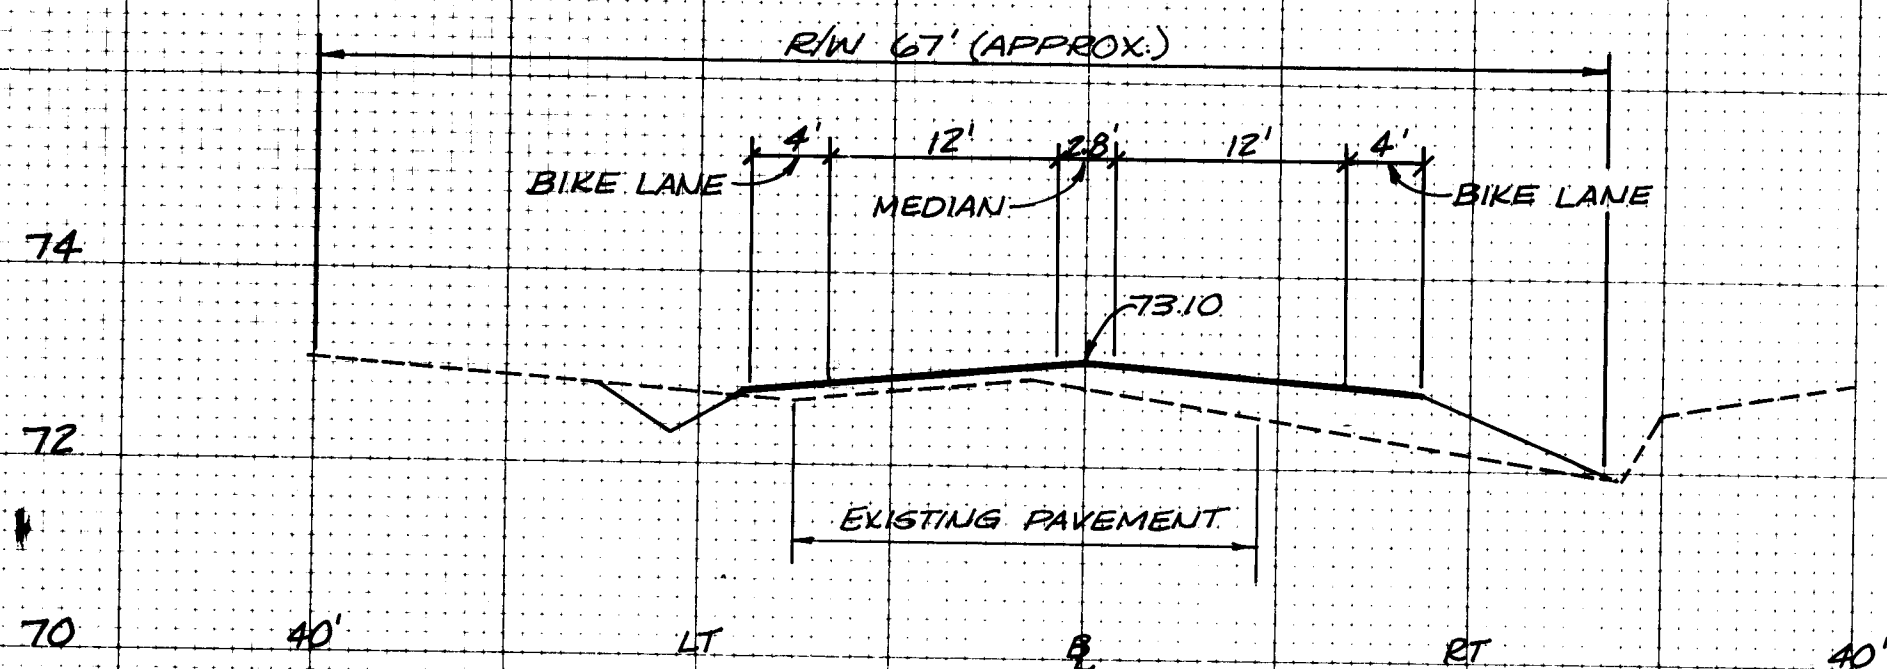


174+00

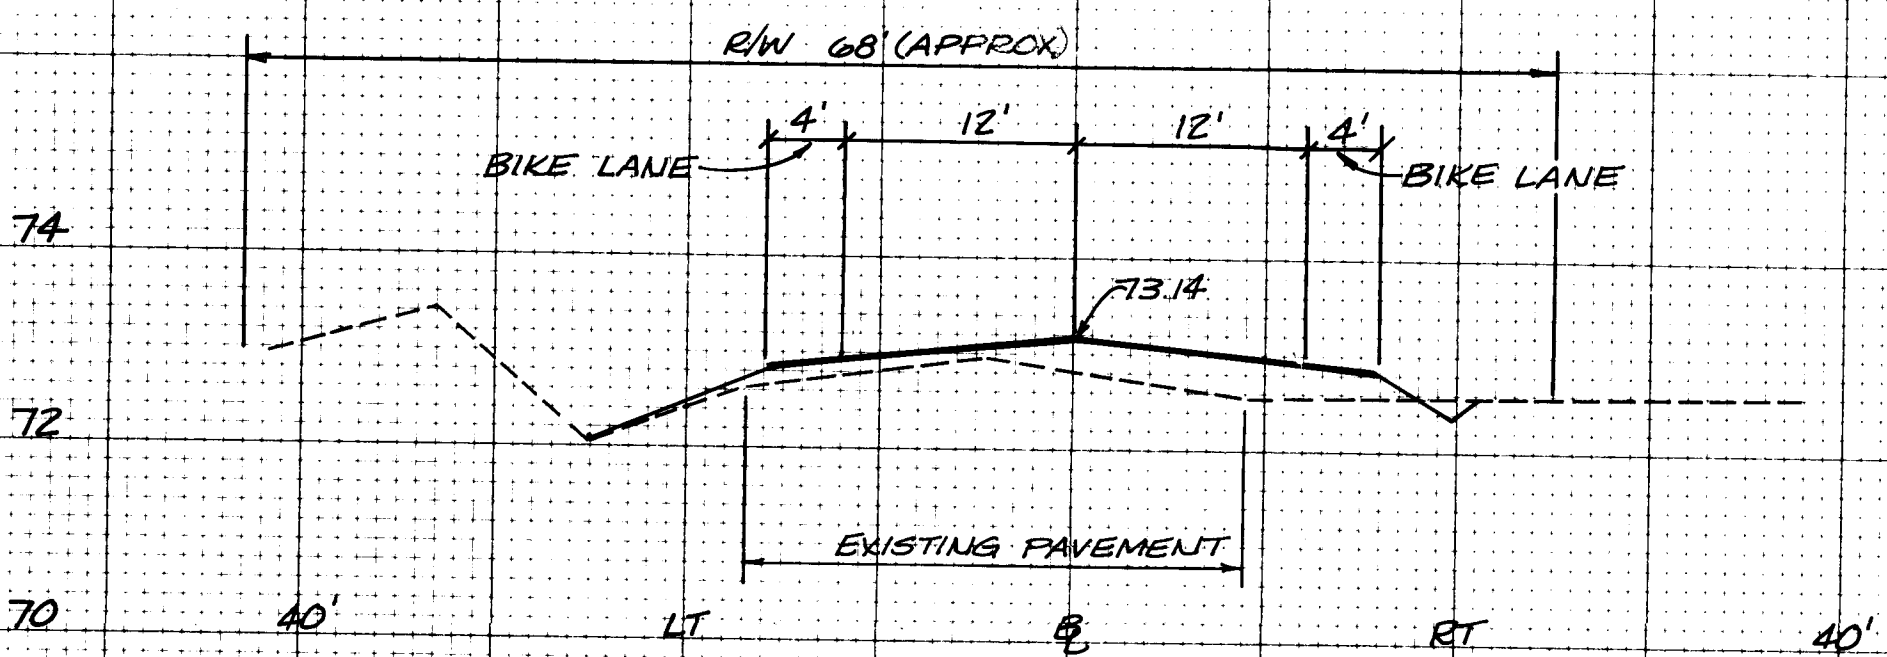


175+00

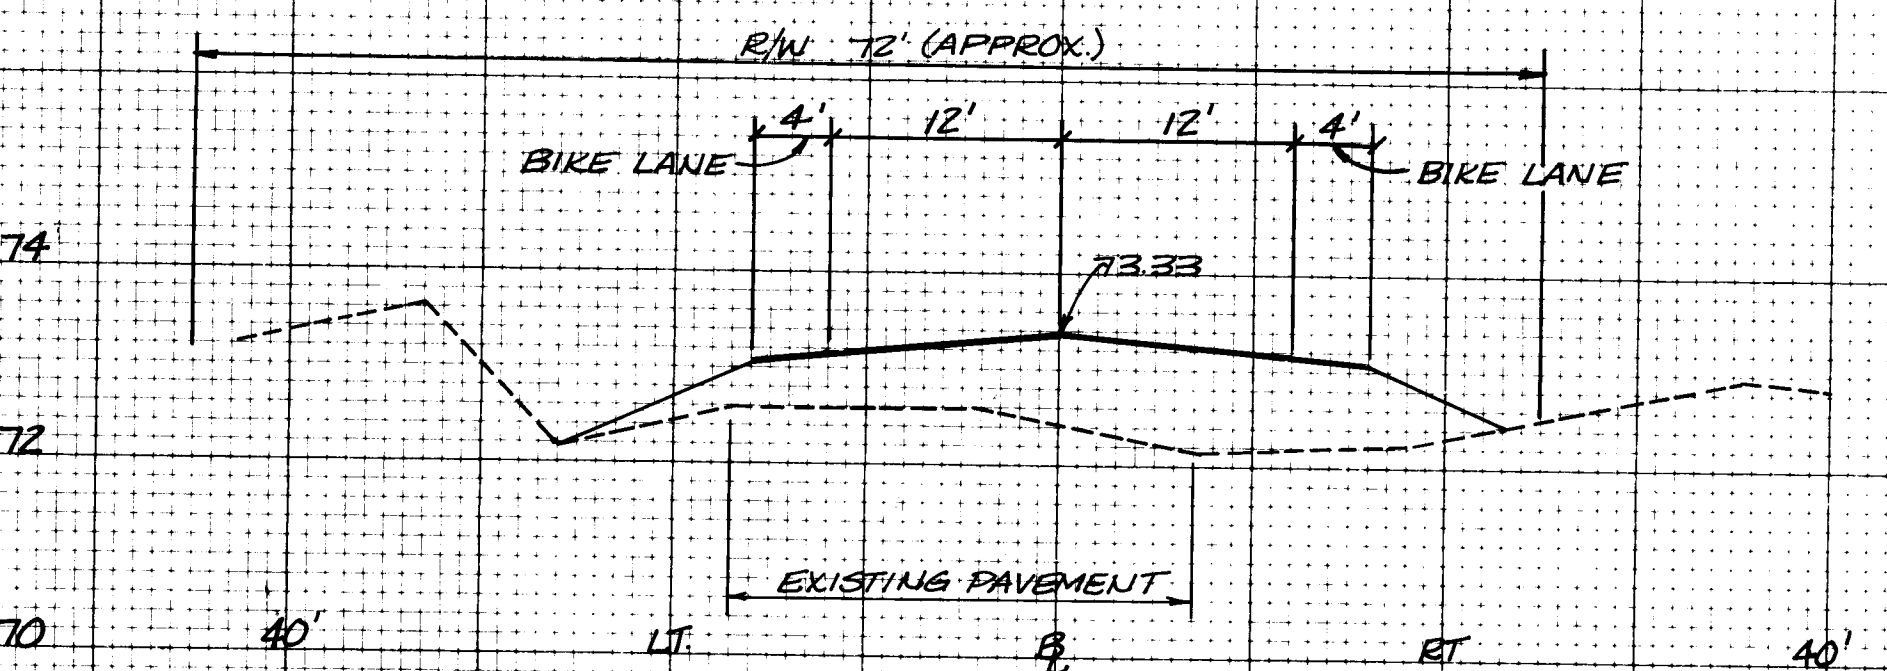


176+00

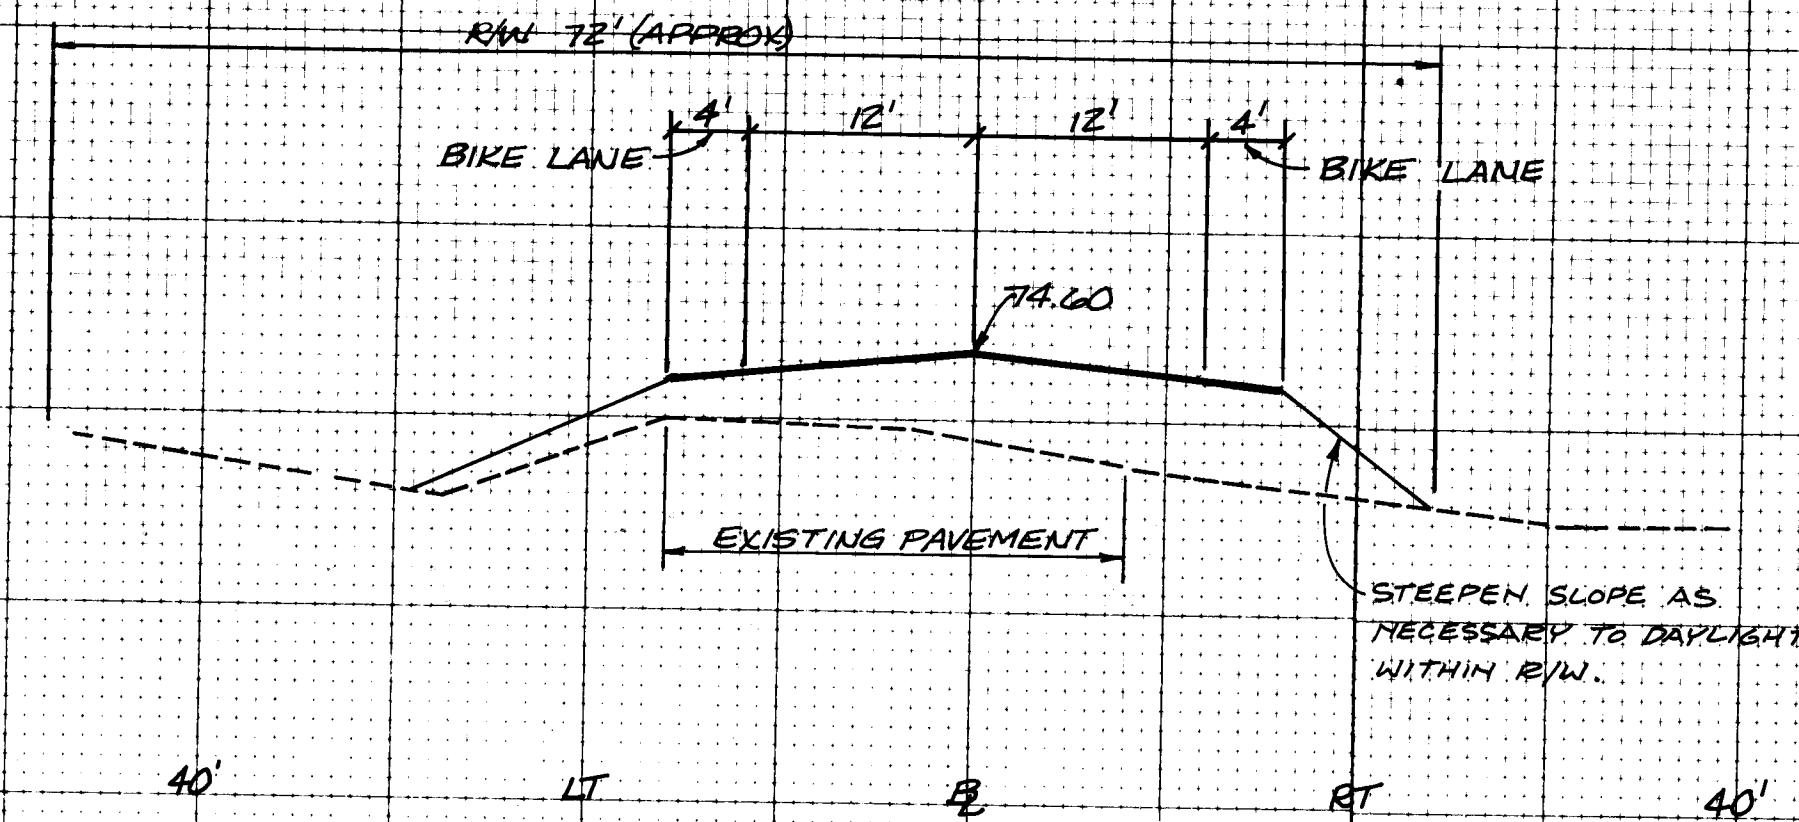

177+00

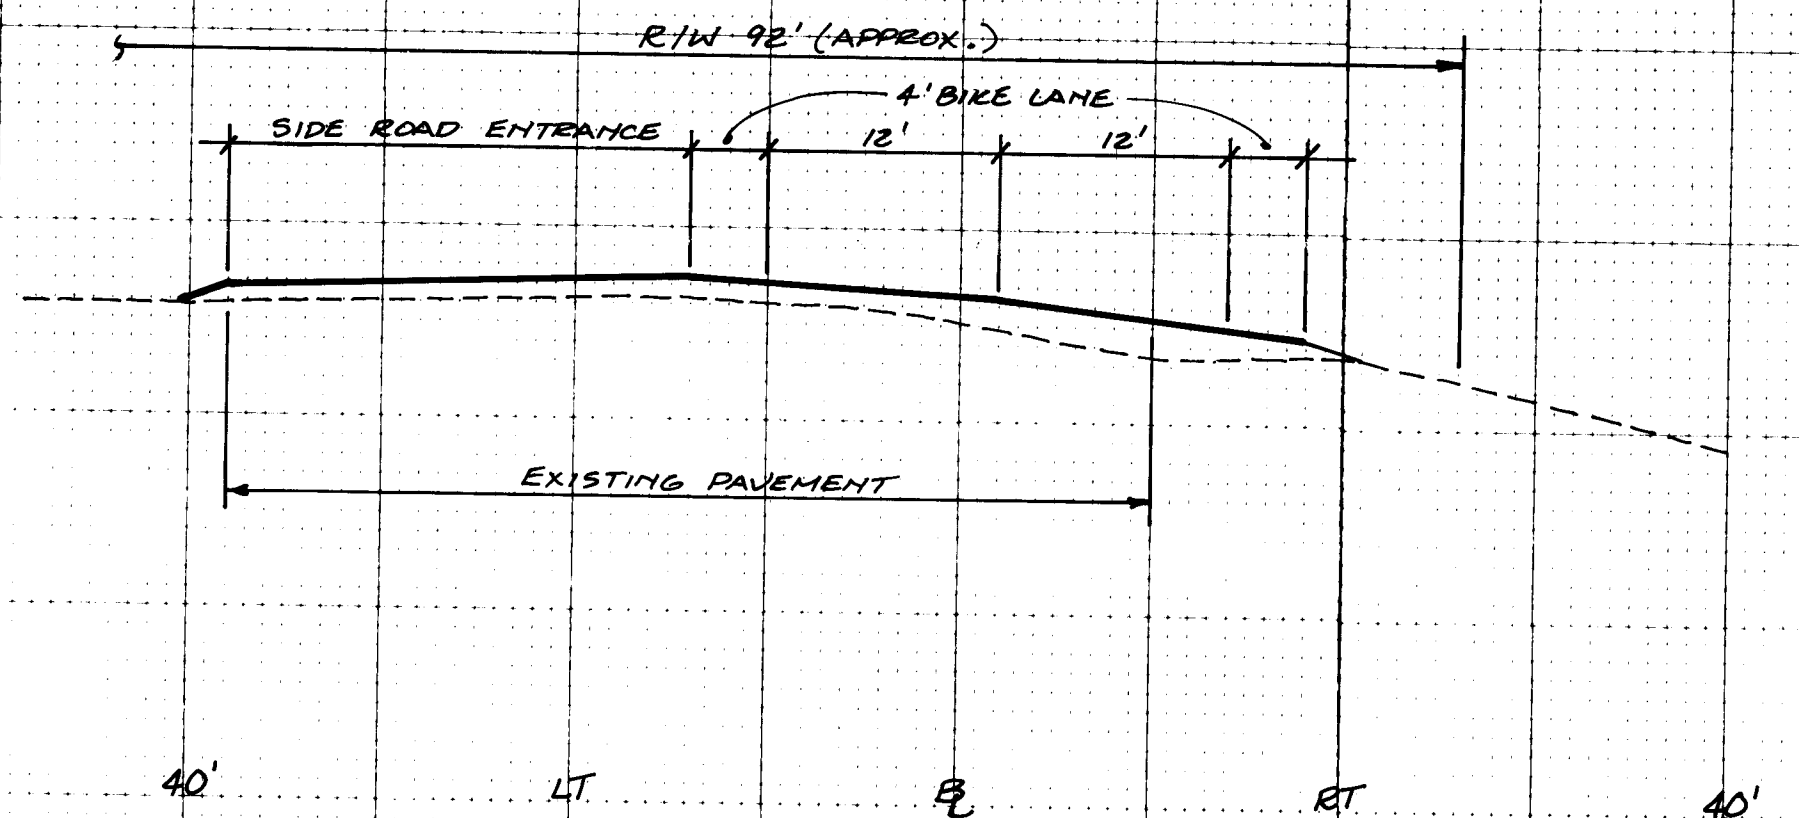


177+50

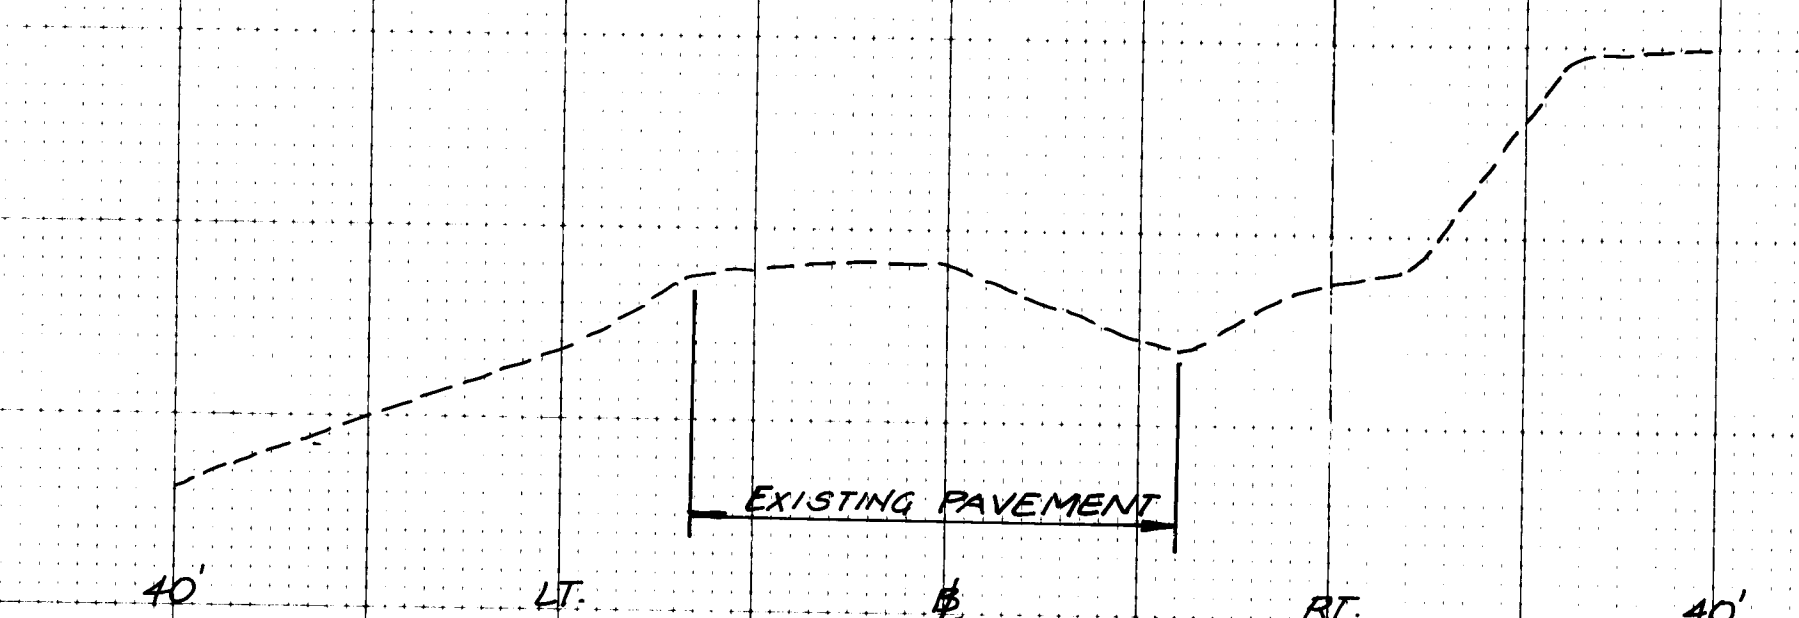

178+00
END OF PROJECT

SEE SHT. 6 FOR ADDITIONAL INFORMATION.

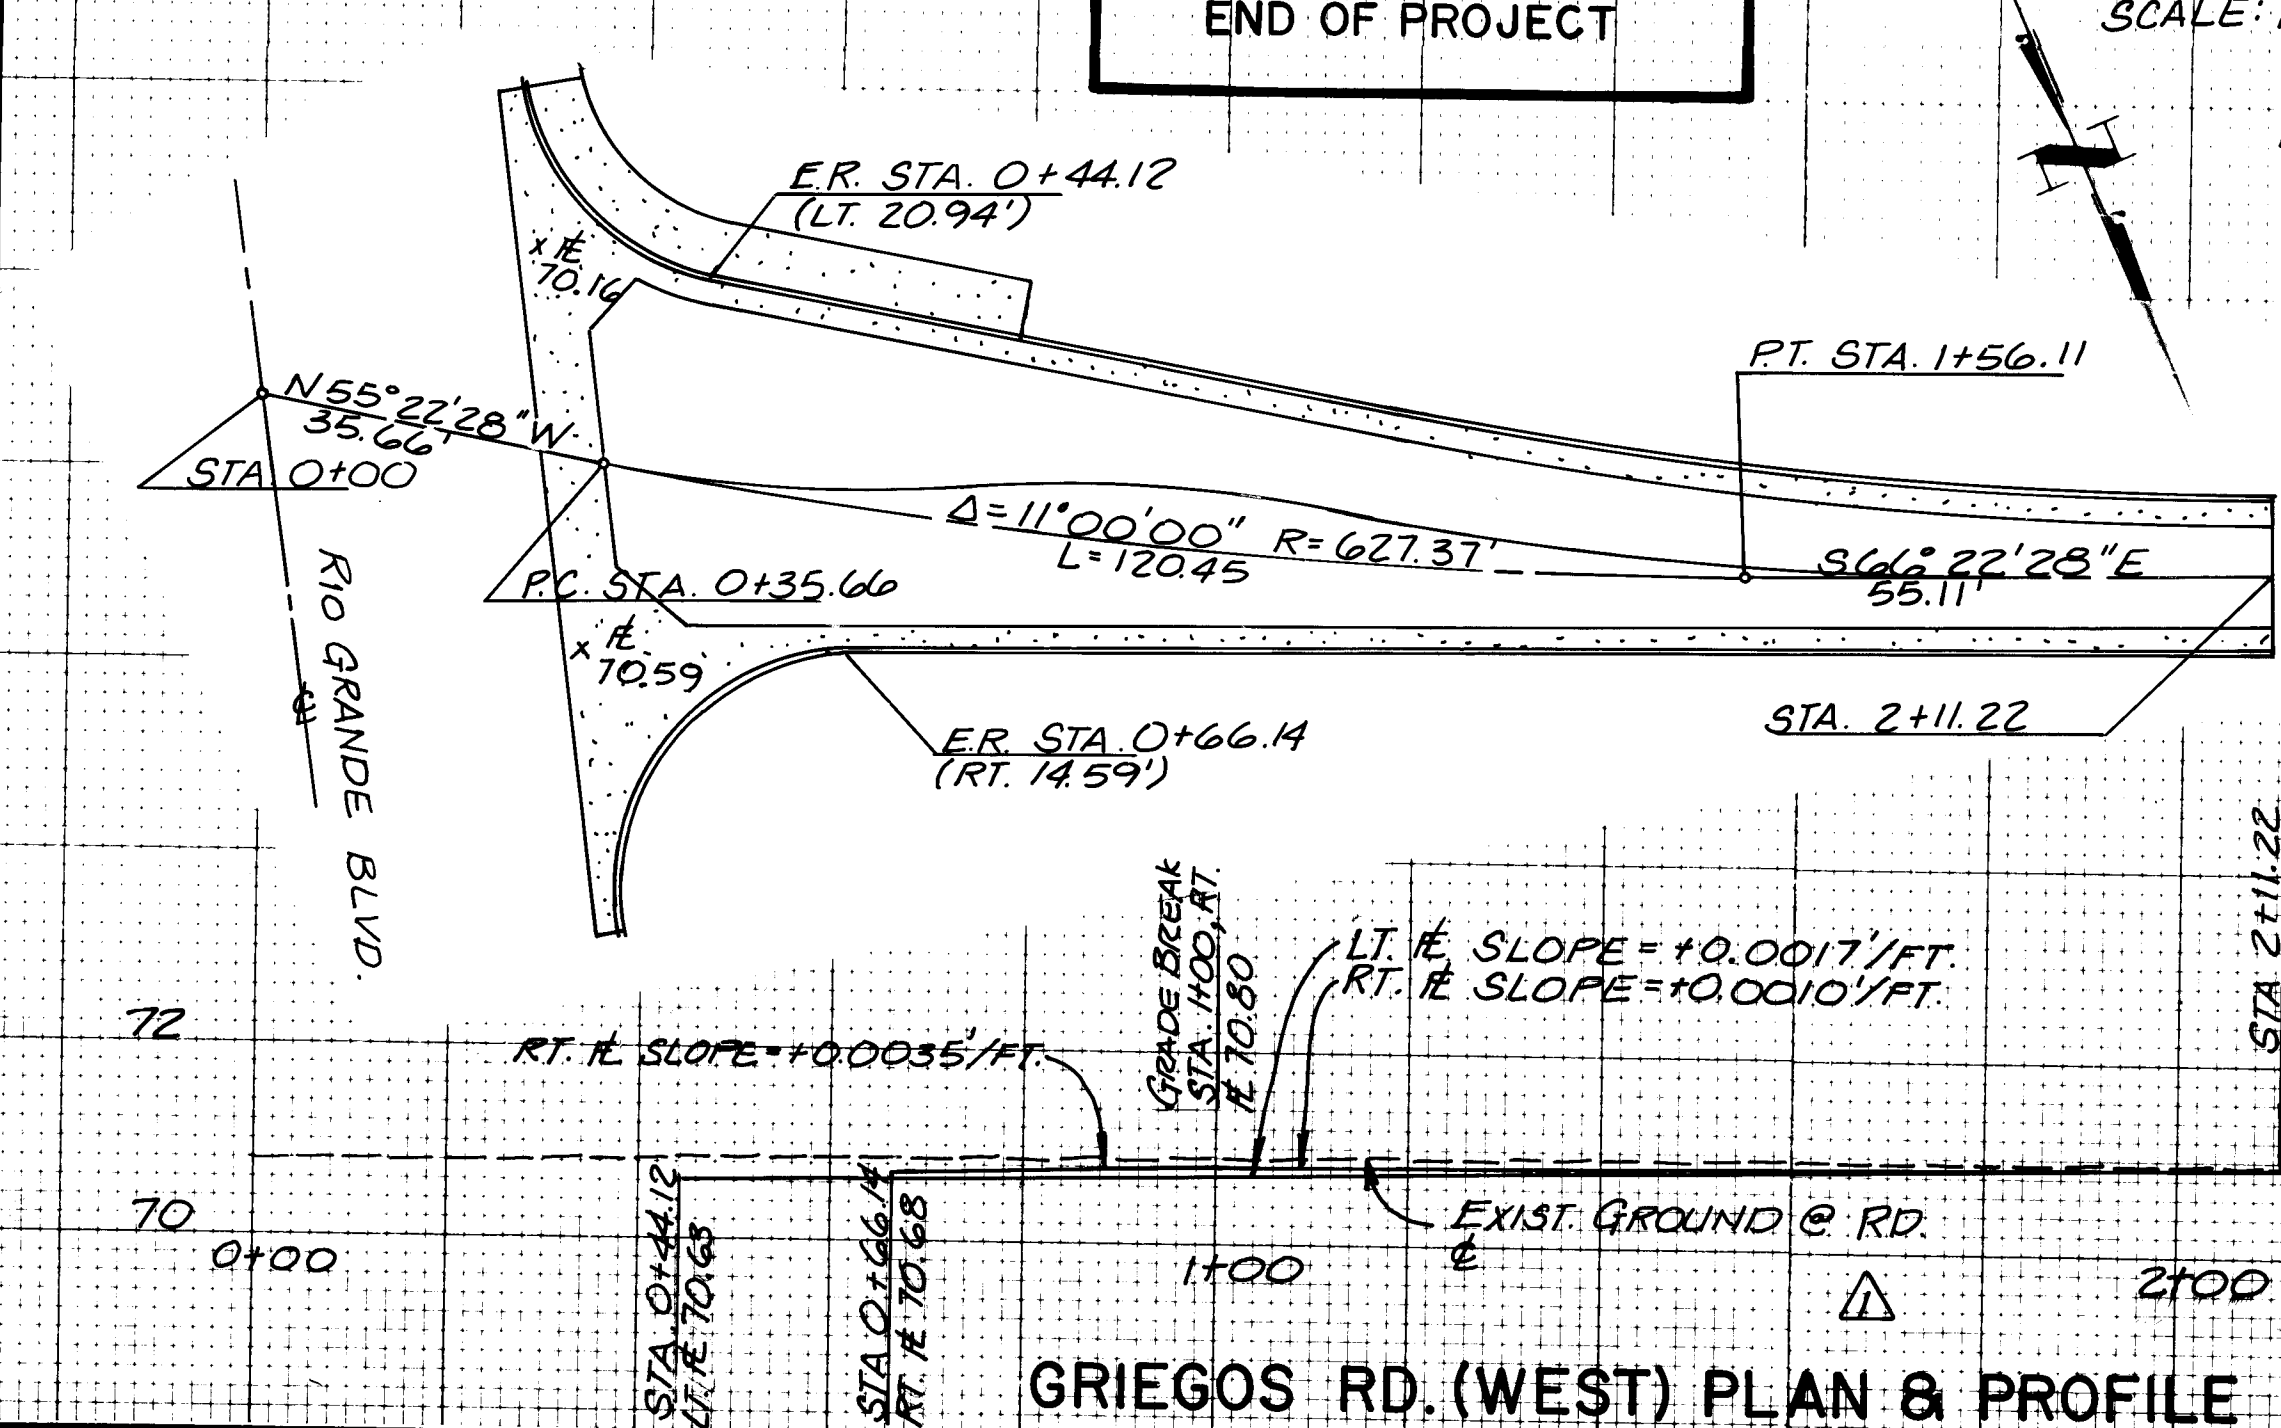

GRIEGOS RD. (WEST) PLAN & PROFILE

The existing pavement structure that is not removed is to have at least a 2 5/8" overlay (3" Asphalt Concrete Surface Course, 1800 lb. stability, plus 5/8" Plant Mix Seal Coat) placed over it everywhere and no milling of the existing surface is to be done just to match the profile grade line or typical sections. A thicker overlay or even leveling is desirable at the direction of the Engineer to assure good rideability. Any such thicker overlay or leveling will be incidental to the total cost of the project.

RECORD DRAWING

No Elevations
As-Built

SCALE: HORIZ. 1" = 10'
VERT. 1" = 2'
(CROSS SECTIONS ONLY)

Greiner Engineering CONSULTING ENGINEERS - SURVEYORS - PLANNERS

2101 WYOMING BLVD., SUITE F ALBUQUERQUE, NEW MEXICO 87102 (505) 242-1930

PLANS PREPARED BY: J. D. HANTZ

NEED THE LINE 1" = 20'

APPROVED FOR CONSTRUCTION

CITY OF ALBUQUERQUE

TRANSPORTATION DEPARTMENT

ENGINEERING DIVISION

TITLE RIO GRANDE BLVD. CROSS SECTIONS & GRIEGOS RD. (WEST) PLAN & PROFILE

DATE 8/29/82

ENGINEER R. L. HANTZ

DATE 8/29/82

DESIGNER R. L. HANTZ

DATE 8/29/82

DRAWING NO. 1668

SHEET 9 OF 11

AS BUILT INFORMATION	BENCH MARKS	SURVEY INFORMATION	REVISIONS
UNIVERSAL CONSTRUCTORS, INC.	ACS BM 7-F13, ELEV. 4970.766	FILED NOTES	DATE 12/16/82
GREINER ENGINEERING	ACS BM 9-F13, ELEV. 4974.738	NO. 1553	DATE 12/16/82
DATE 4/15/85	ACS BM 10-F13, ELEV. 4973.212	BY T. ALDRICH	DATE 12/16/82
DATE 4/15/85		NO. 1546	DATE 12/16/82
DATE 4/15/85		BY T. ALDRICH	DATE 12/16/82
DATE 4/15/85			DATE 12/16/82

