
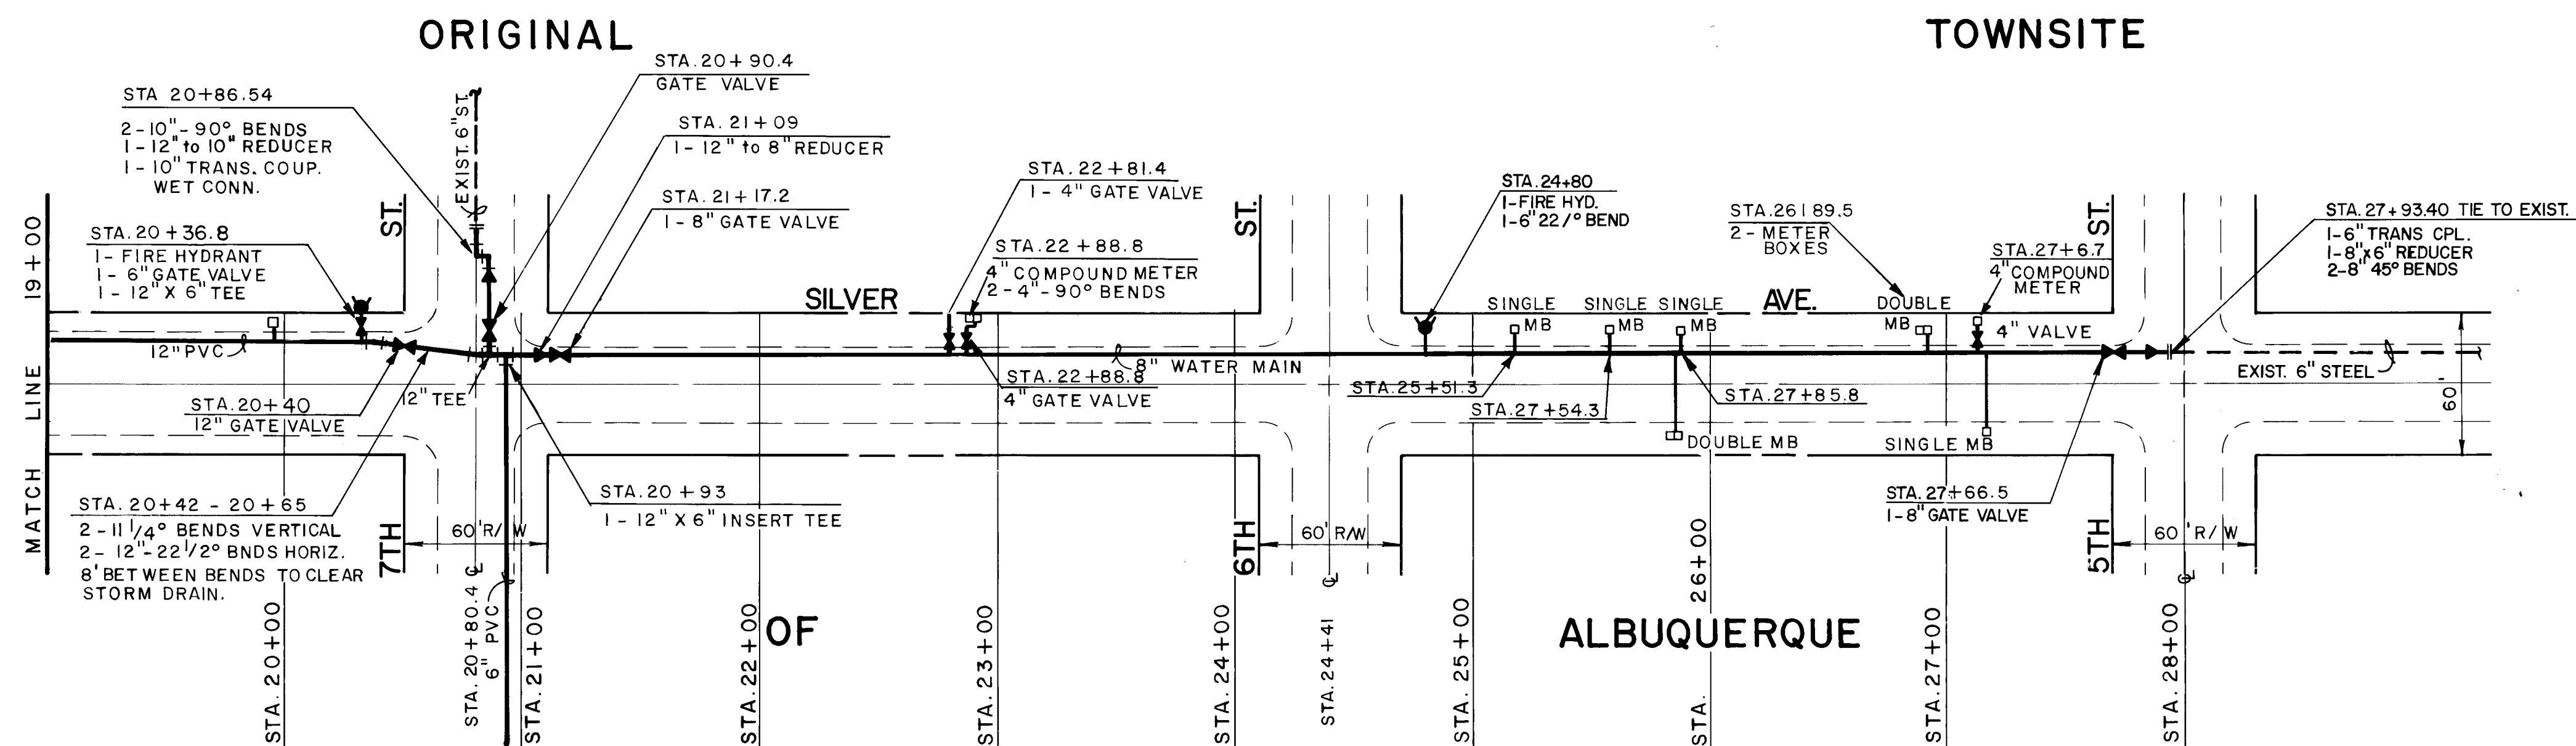


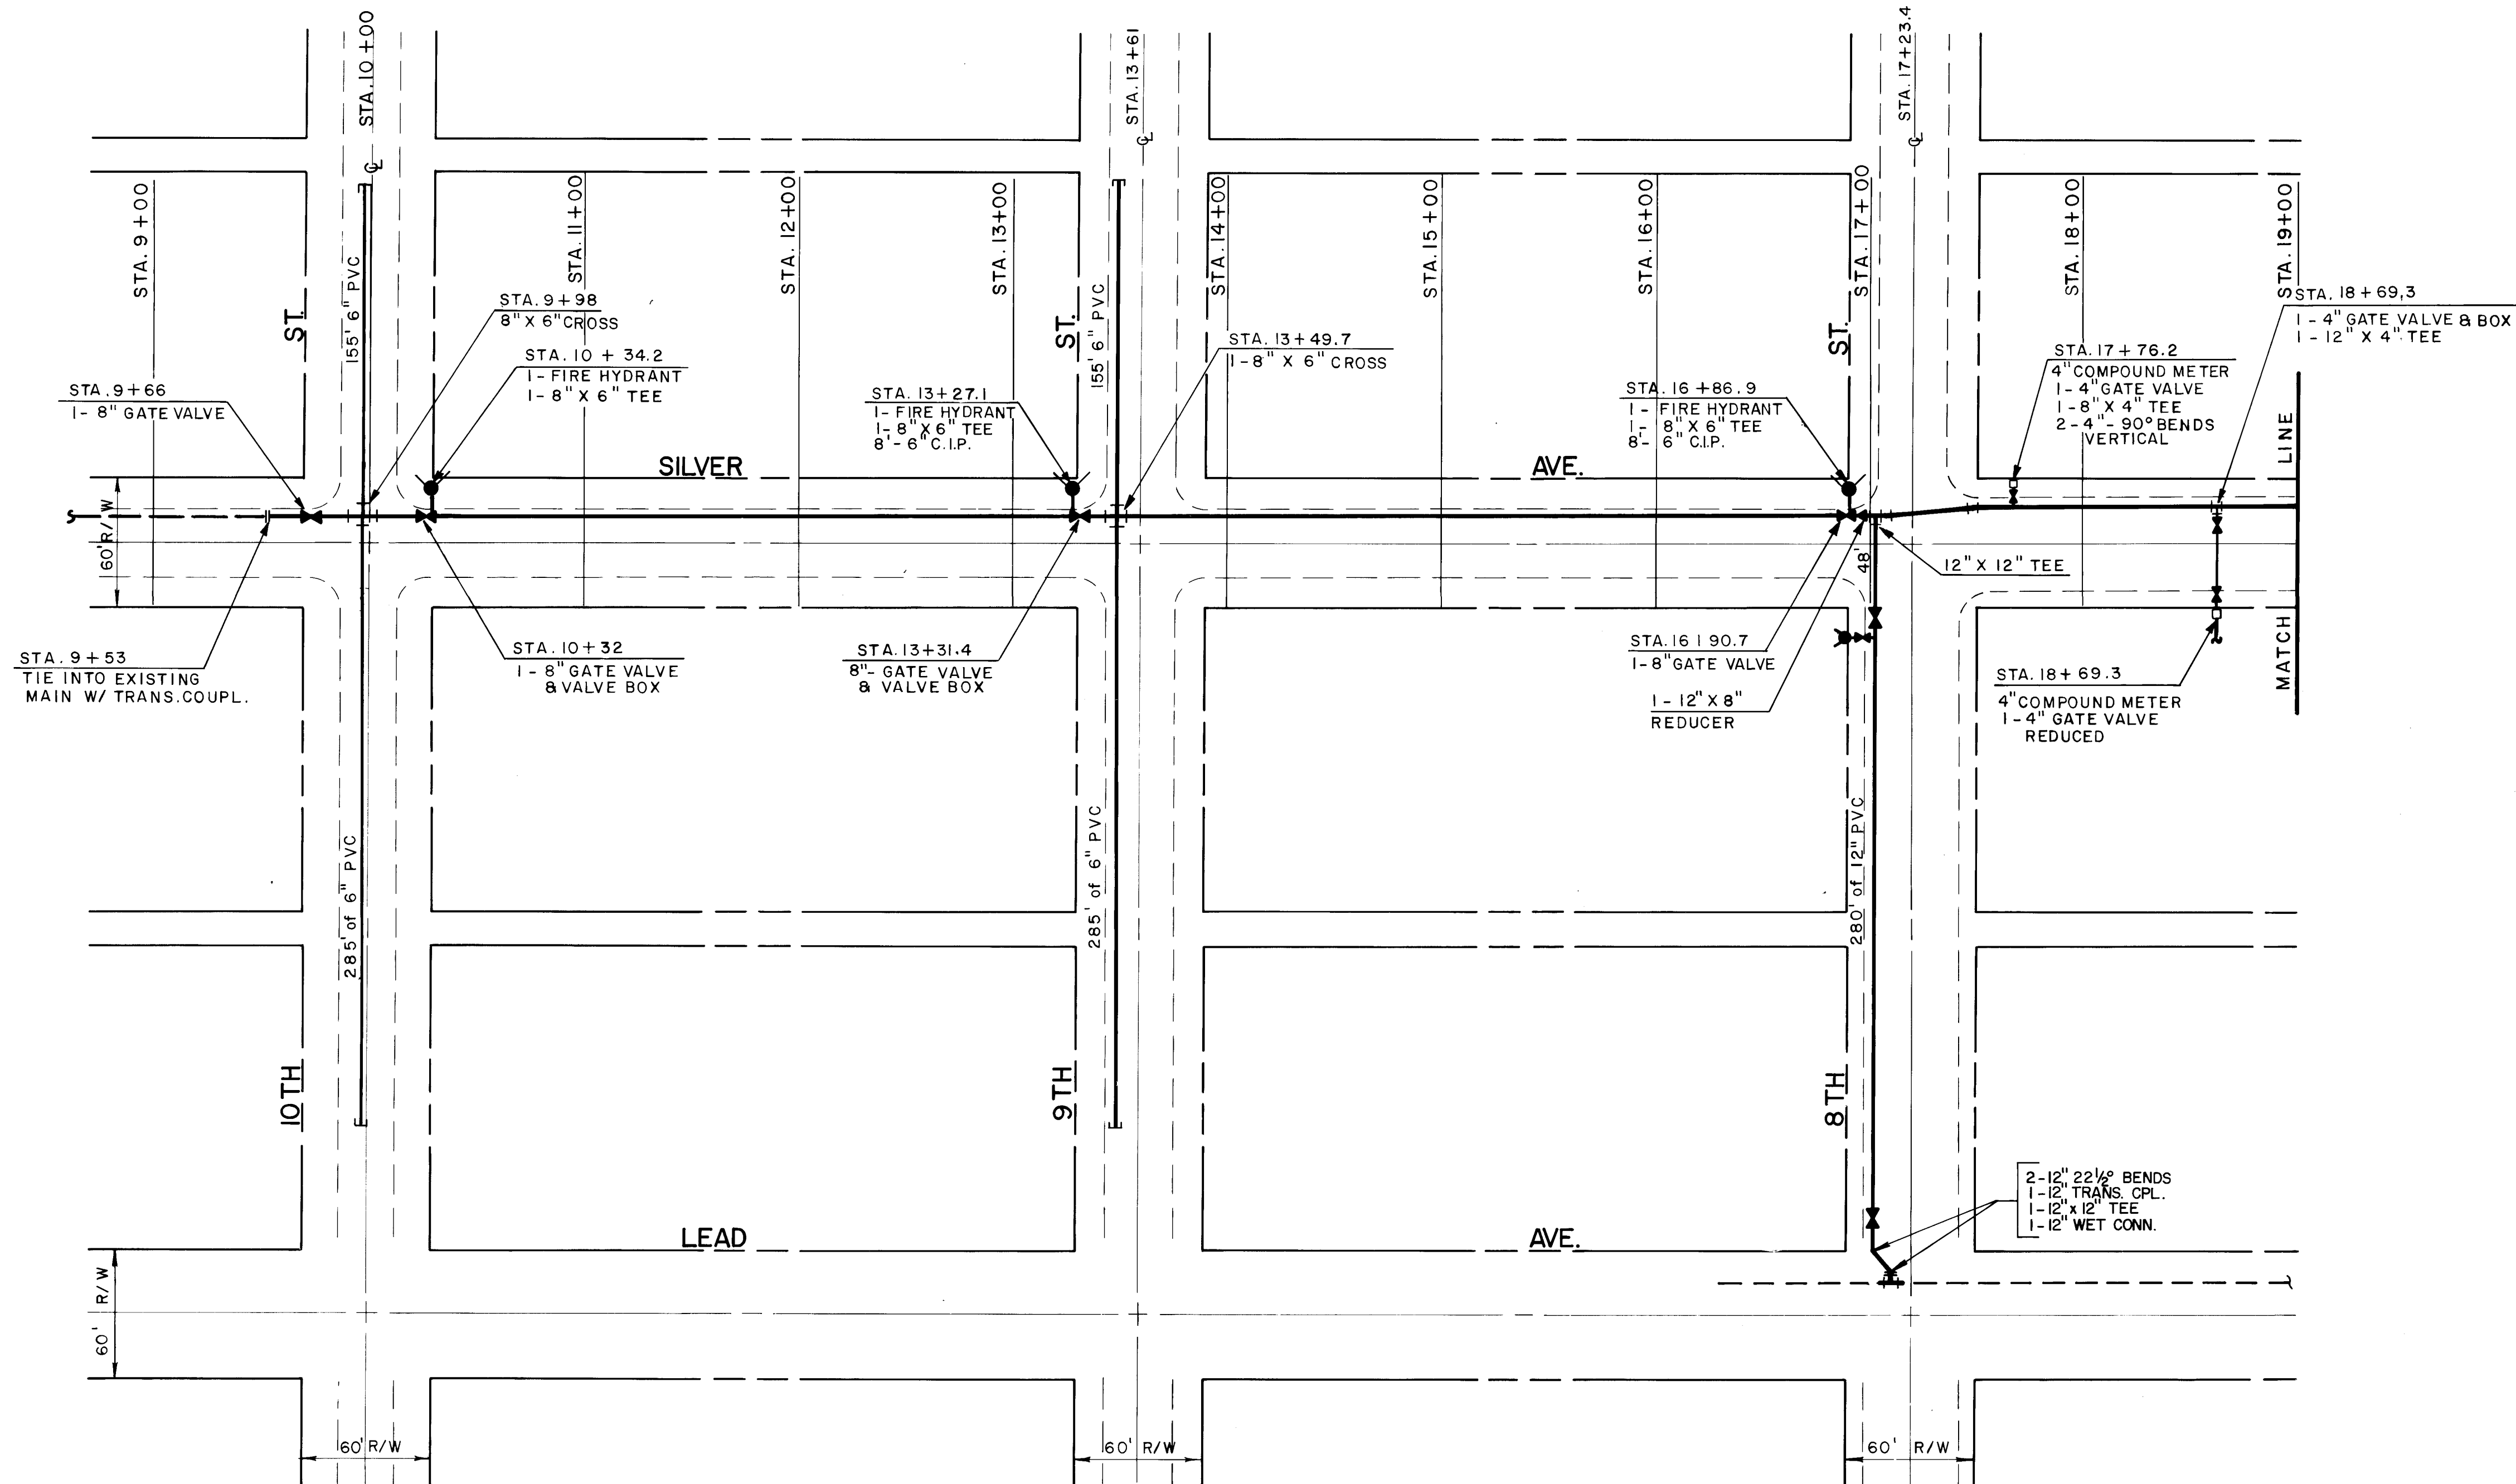

NOTE
THIS AS-BUILT COMPILED FROM FIELD NOTES AND FIELD ENGINEERS INSTRUCTIONS AND IS FOR RECORD PURPOSES.

26 1687 0184

APPROVED FOR CONSTRUCTION
W. J. McNamee
DATE 10/11/84

CITY OF ALBUQUERQUE MUNICIPAL DEVELOPMENT DEPARTMENT ENGINEERING DIVISION					
TITLE: WATER LINE REPLACEMENT SILVER AVE. BETWEEN 10TH ST. & 5TH ST. 8TH ST. SOUTH TO LEAD 9TH ST. & 10TH ST. NORTH & SOUTH OF SILVER					
APPROVALS	ENGINEER	DATE	APPROVALS	ENGINEER	DATE
City Engineer			Liquid Waste		
A.C.E. - Design			Traffic		
A.C.E. - Hydrology			Water		
DRAWING NO.	1687	MAP NO.	K-13,14	SHEET	1
				OF	1

SURVEY INFORMATION		ENGINEER'S SEAL		REVISIONS		AS BUILT INFORMATION	
NO.	BY	DATE	NO.	DATE	REMARKS	CONTRACTOR	WORK ORDER BY CITY OF ALBUQ. DATE
							INSPECTOR'S ACCEPTANCE BY 7/14/04 DATE 7/84
							VERIFICATION BY DATE 10/84
							DRAWING BY R.D. RMS. DATE 10/84
							RECORDED BY DATE
							MICRO-FILM INFORMATION
							NO