


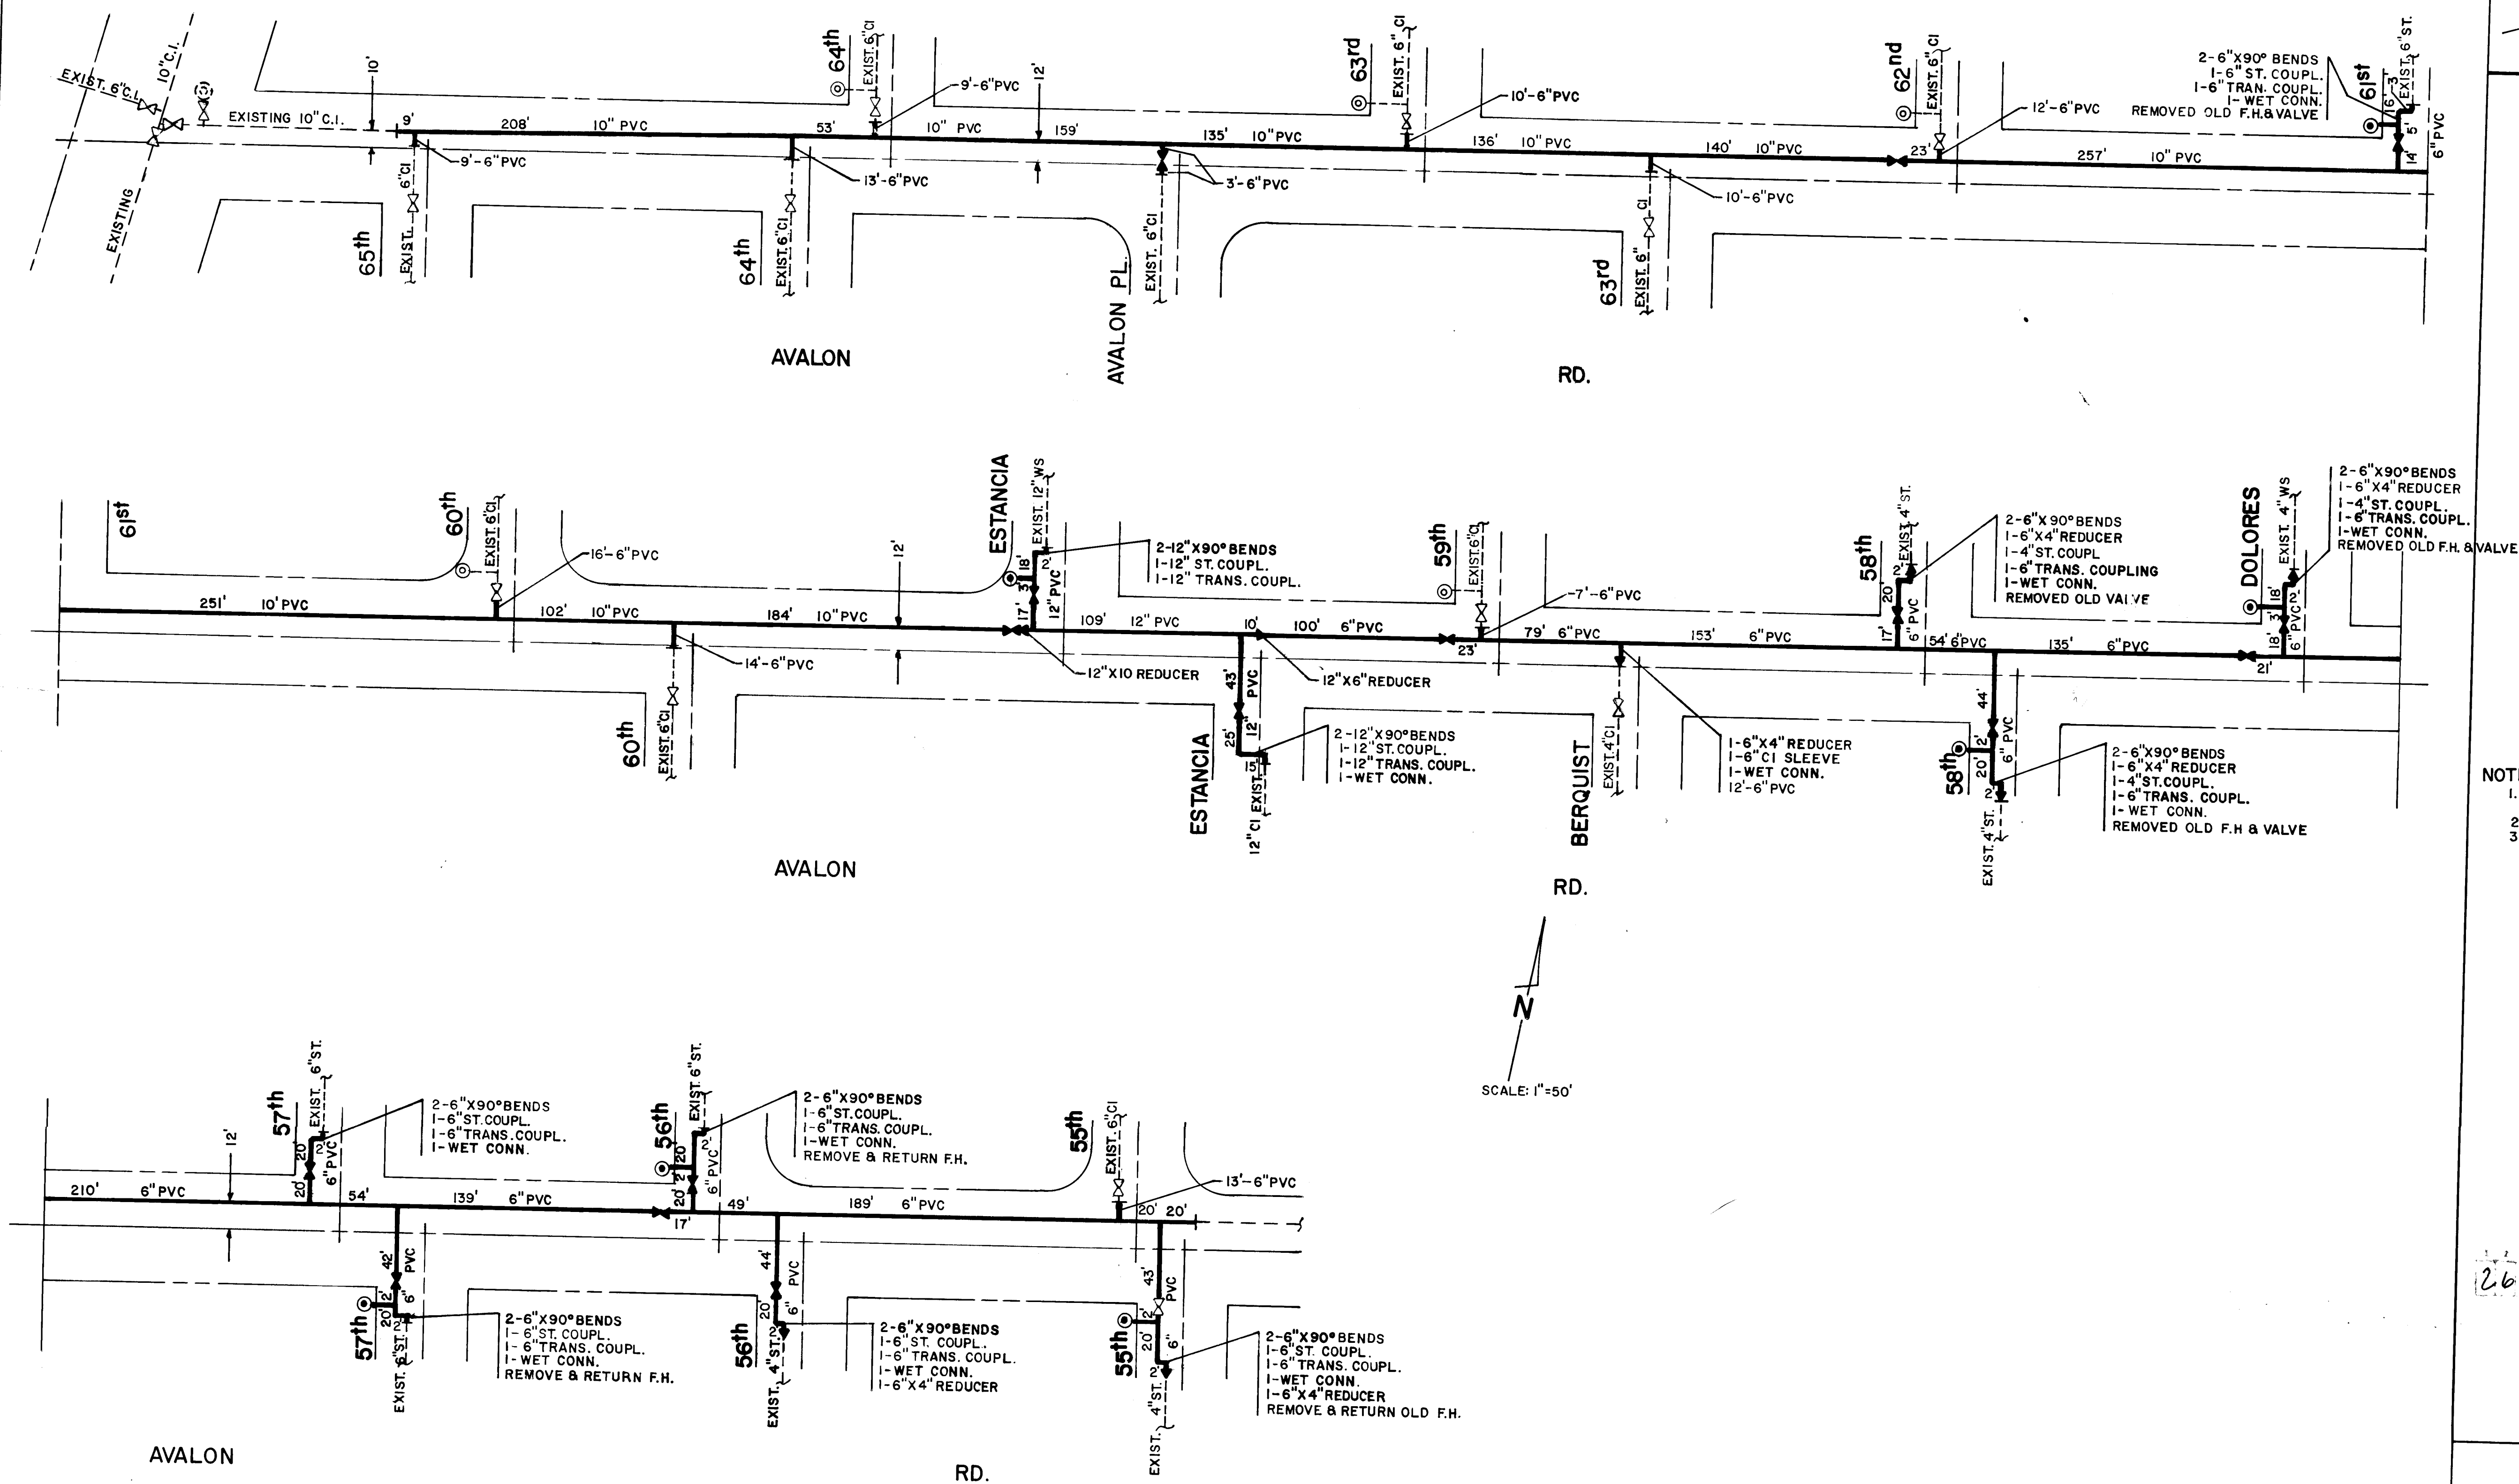

1. THE NEW WATER LINE IS TO BE 3.67' MIN. BELOW TOP OF CURB
2. CAP OLD LINE AND ABANDON IN PLACE
3. THIS AS-BUILT WAS COMPILED FROM FIELD NOTES AND IS FOR RECORD PURPOSES

26 1693 0183

APPROVAL OF AS BUILT DRAWINGS
ASST. CITY ENGINEER - FIELD
[Signature]
DATE 9.30/83

CITY OF ALBUQUERQUE
MUNICIPAL DEVELOPMENT DEPARTMENT
ENGINEERING DIVISION

TITLE: WATER LINE REPLACEMENT ON AVALON RD. FROM
COORS RD. TO 55th ST.

APPROVALS	ENGINEER	DATE	APPROVALS	ENGINEER	DATE
City Engineer			Liquid Waste		
A.C.E.-Design			Sludge		
A.C.E.-Hydrology			Water		

DRAWING NO. **1693** MAP NO. **K-11** SHEET **1** OF **1**