


MORRIS STREET STORM DRAIN

ALBUQUERQUE, NEW MEXICO

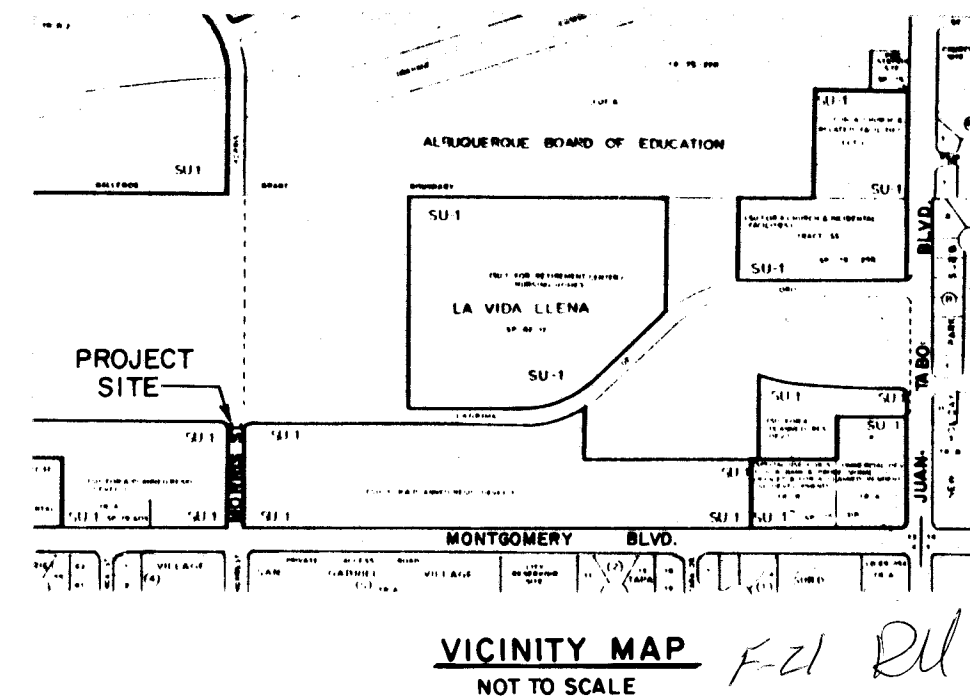

GENERAL NOTES

NOTICE TO CONTRACTORS


1. NEW MEXICO STANDARD SPECIFICATIONS FOR PUBLIC WORKS CONSTRUCTION-1979 EDITION WILL BE REFERRED TO HEREON AS THE "STANDARD SPECIFICATION."
2. ALL WORK DETAILED ON THESE PLANS TO BE PERFORMED UNDER CONTRACT SHALL, EXCEPT AS OTHERWISE STATED OR PROVIDED FOR HEREON, BE CONSTRUCTED IN ACCORDANCE WITH "CONTRACT DOCUMENTS FOR CITY-WIDE UTILITIES AND CASH PAVING NO. 31 AND THE STANDARD SPECIFICATION."
3. TWO WORKING DAYS PRIOR TO ANY EXCAVATION, CONTRACTOR MUST CONTACT LINE LOCATING SERVICE, 765-1234, FOR LOCATION OF EXISTING UTILITIES.
4. PRIOR TO CONSTRUCTION, THE CONTRACTOR SHALL EXCAVATE AND VERIFY THE HORIZONTAL AND VERTICAL LOCATIONS OF ALL OBSTRUCTIONS. SHOULD A CONFLICT EXIST, THE CONTRACTOR SHALL NOTIFY THE ENGINEER OR SURVEYOR SO THAT THE CONFLICT CAN BE RESOLVED WITH A MINIMUM AMOUNT OF DELAY.

THE FOLLOWING NOTES ALSO APPLY WHEN CHECKED

- ☒ ALL UTILITIES AND UTILITY SERVICE LINES SHALL BE INSTALLED PRIOR TO PAVING.
- ☒ BACKFILL COMPACTION SHALL BE ACCORDING TO SPECIFIED STREET USE.
- ☐ TACK COAT REQUIREMENTS SHALL BE DETERMINED BY THE CITY ENGINEER.
- ☐ SIDEWALKS AND WHEELCHAIR RAMPS WITHIN THE CURB RETURNS SHALL BE CONSTRUCTED WHEREVER A NEW CURB RETURN IS CONSTRUCTED.
- ☐ IF CURB IS DEPRESSED FOR A DRIVEPAD, THE DRIVEPAD SHALL BE CONSTRUCTED PRIOR TO ACCEPTANCE OF CURB AND GUTTER.
- ☒ ALL STORM DRAINAGE FACILITIES SHALL BE COMPLETED PRIOR TO FINAL ACCEPTANCE.
- ☒ THE REQUESTOR OR DEVELOPER SHALL BE RESPONSIBLE FOR REPAIR OR REPLACEMENT OF ALL CURB AND GUTTER OR SIDEWALK DAMAGED AFTER APPROVAL BY THE CITY ENGINEER OF WORK COMPLETED BY THE CONTRACTOR.


INDEX

SHEET NO.	DESCRIPTION
1	TITLE SHEET
2	MORRIS STREET STORM DRAIN DESIGN

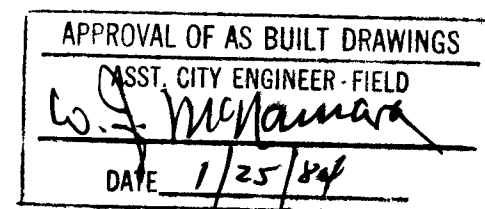

26 1694 0184

REV	SHEETS	CITY ENGINEER	DATE	USER	DEPT.	DATE	USER	DEPT.	DATE
1	2	<i>[Signature]</i>	4/1/22						
APPROVAL OF REVISIONS									

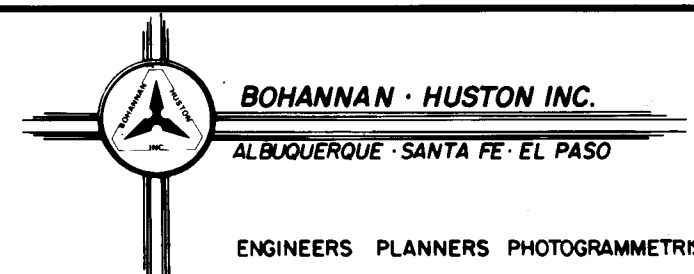





APPROVED FOR CONSTRUCTION

[Signature]
4-15-22
CE

PROJECT NUMBER

1694

SHEET 1 OF 2

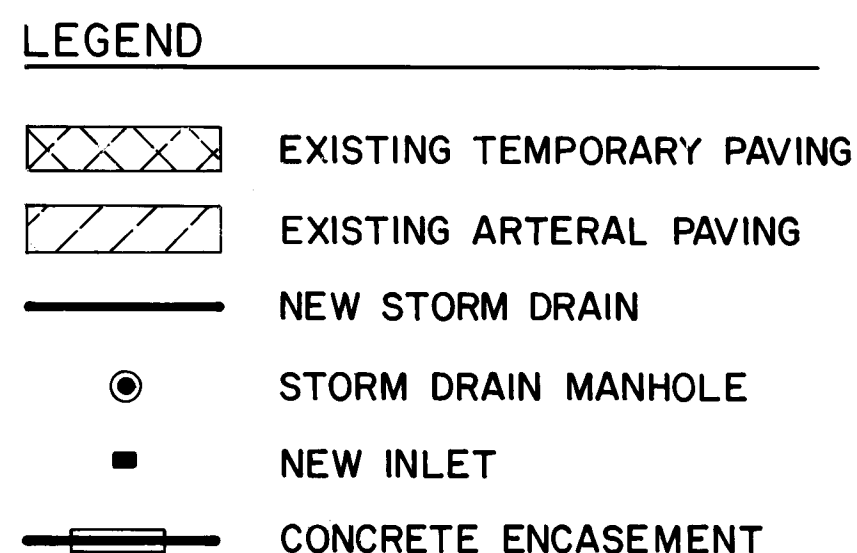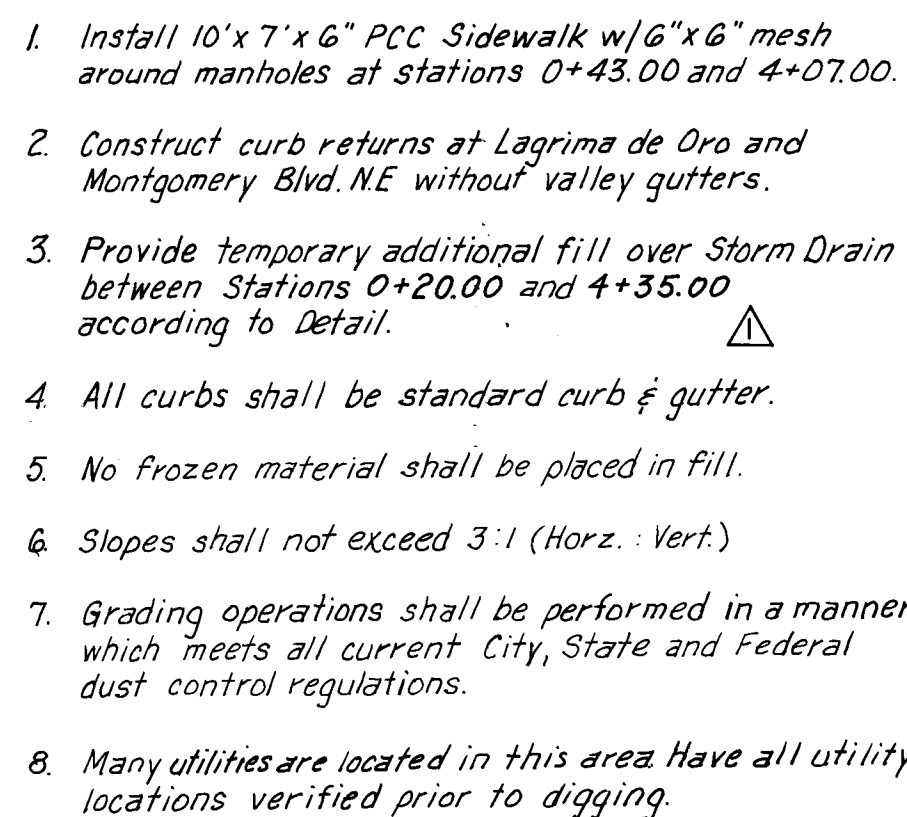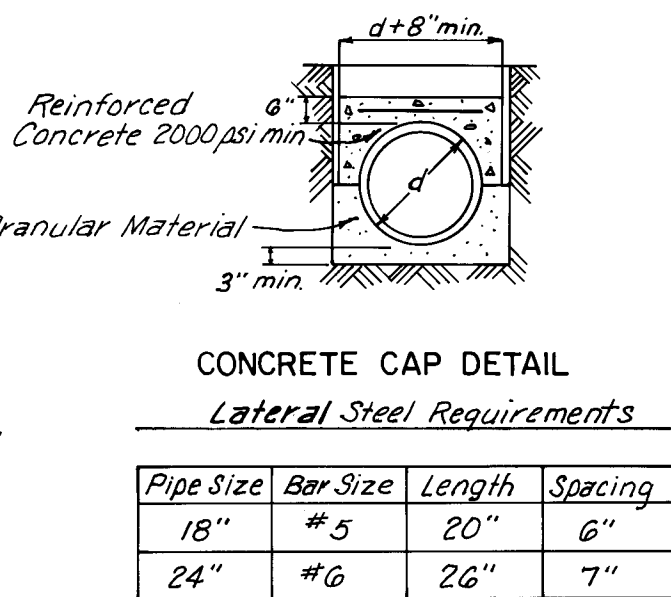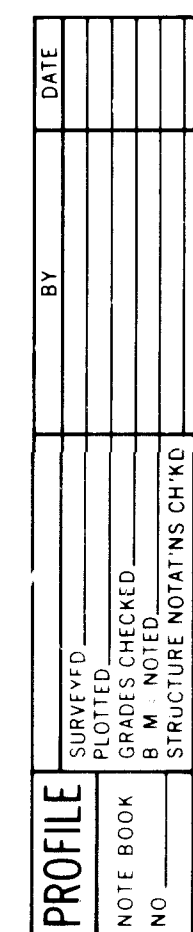

SCALE: 1" = 50' HOR.
1" = 5' VERT.

PREPARED UNDER THE DIRECTION OF 	CITY OF ALBUQUERQUE MUNICIPAL DEVELOPMENT DEPARTMENT ENGINEERING DIVISION																									
	TITLE: MORRIS STREET STORM DRAIN DESIGN																									
APPROVED FOR CONSTRUCTION 	<table border="1"> <thead> <tr> <th>APPROVALS</th> <th>ENGINEER</th> <th>DATE</th> <th>APPROVALS</th> <th>ENGINEER</th> <th>DATE</th> </tr> </thead> <tbody> <tr> <td>City Engineer</td> <td><i>R. J. Smith</i></td> <td>4/24/83</td> <td>Liquid Waste</td> <td><i>W. J. [unclear]</i></td> <td>4-11-83</td> </tr> <tr> <td>A.C.E.-Design</td> <td><i>J. R. [unclear]</i></td> <td>4-24-83</td> <td>Traffic</td> <td><i>[unclear]</i></td> <td>4-11-83</td> </tr> <tr> <td>A.C.E.-Hydrology</td> <td><i>[unclear]</i></td> <td>4-14-83</td> <td>Water</td> <td><i>[unclear]</i></td> <td>4-11-83</td> </tr> </tbody> </table>		APPROVALS	ENGINEER	DATE	APPROVALS	ENGINEER	DATE	City Engineer	<i>R. J. Smith</i>	4/24/83	Liquid Waste	<i>W. J. [unclear]</i>	4-11-83	A.C.E.-Design	<i>J. R. [unclear]</i>	4-24-83	Traffic	<i>[unclear]</i>	4-11-83	A.C.E.-Hydrology	<i>[unclear]</i>	4-14-83	Water	<i>[unclear]</i>	4-11-83
	APPROVALS	ENGINEER	DATE	APPROVALS	ENGINEER	DATE																				
City Engineer	<i>R. J. Smith</i>	4/24/83	Liquid Waste	<i>W. J. [unclear]</i>	4-11-83																					
A.C.E.-Design	<i>J. R. [unclear]</i>	4-24-83	Traffic	<i>[unclear]</i>	4-11-83																					
A.C.E.-Hydrology	<i>[unclear]</i>	4-14-83	Water	<i>[unclear]</i>	4-11-83																					
DRAWING NO. 1694		SHEET 2 OF 2																								