

LIST OF DRAWINGS		
SHEET NO.	DRAWING NO.	TITLE
1	WRD 82.15.01	TITLE SHEET, LEGEND, INDEX & GEN. NOTES
2 & 3	WRD 82.15.02-03	PROJECT LOCATION MAPS
4	WRD 82.15.04	15 TH. STREET S.W.
5	WRD 82.15.05	15 TH. STREET S.W.
6	WRD 82.15.06	PROSPECT AVE. N.W.
7	WRD 82.15.07	PROSPECT AVE. N.W.
7	WRD 82.15.07	CEDAR AVE. S.E.
8	WRD 82.15.08	CEDAR AVE. S.E.
9	WRD 82.15.09	FREDERICK CT. N.W.
10	WRD 82.15.10	WASHINGTON ST. N.E.
11	WRD 82.15.11	ESPANOLA ST. N.E.
12	WRD 82.15.12	ESPANOLA ST. N.E.
13	WRD 82.15.13	ESPANOLA ST. N.E.
14	WRD 82.15.14	ESPANOLA ST. N.E.
15	WRD 82.15.15	MARQUETTE, COPPER DOMINGO
16	WRD 82.15.16	ALLEY BTW BETTS & MORRISMAN, 505B-510J
17	WRD 82.15.17	4 TH. STREET N.W.
18	WRD 82.15.18	MENAU BLVD N.W.
19	WRD 82.15.19	SANITARY SEWER DIVERSION FACILITY LINE 107
20	WRD 82.15.20	SANITARY SEWER DIVERSION FACILITY LINE 107
21	WRD 82.15.21	SLOPE DETAILS
22	WRD 82.15.22	DETAILS
23	WRD 82.15.23	TRAFFIC CONTROL

NOT TO BE INCLUDED
IN THIS PROJECT

LEGEND	
	PROPOSED WATER LINE
	PROPOSED SEWER LINE
	PROPOSED GATE VALVE (WATER)
	PROPOSED FIRE HYDRANT
	PROPOSED TEE
	PROPOSED SANITARY MANHOLE
	EXISTING WATER LINE & VALVE
	EXISTING SEWER LINE & MANHOLE
	EXISTING STORM DRAIN & MANHOLE
	GAS MAIN
	UNDERGROUND TELEPHONE MANHOLE
	UTILITY POLE
	EXISTING TEE (WATER)
	EXISTING CURB & GUTTER WITH STORM INLET
	EXISTING BUILDING
	EXISTING WATER METER
	METER BOX REHABILITATION
	RELOCATE BOX & PLATE
	REPLACE EXISTING SERVICE LINE OR INSTALL NEW SERVICE LINE
	REPLACE EXISTING SERVICE LINE ONLY
	INSTALL DOUBLE BOX & PLATE

WATER & SANITARY SEWER REPLACEMENT II

6" WATERMAIN -15 TH. STREET S.W.
6" " -PROSPECT AVENUE N.W.
6" " -CEDAR AVENUE S.E.
6" " -FREDERICK COURT N.W.
8" SANITARY SEWER-WASHINGTON STREET N.E.
8" " /ESPANOLA STREET N.E.
6" WATERMAIN
8" " -COPPER AVENUE N.E.
6" " -MARQUETTE AVENUE N.E.
MISC. WATERMAIN WORK -DOMINGO ROAD N.E.
8" SANITARY SEWER-ALLEY EAST OF BETTS ST., NORTH OF LOMAS BLVD.
8",18",21" SANITARY SEWER- 4 TH. ST. & MENAU N.W.

~~SANITARY SEWER DIVERSION FACILITY LINE 107~~

- GENERAL NOTES
- THE LOCATION OF ALL EXISTING UTILITIES, AS SHOWN ON THE DRAWINGS, ARE APPROXIMATE LOCATIONS. THE CONTRACTOR SHALL BE RESPONSIBLE FOR MAKING FINAL UTILITY LOCATION DETERMINATION IN THE FIELD DURING CONSTRUCTION. THIS IS INCIDENTAL TO THE CONTRACT.
 - THE CONTRACTOR SHALL NOTIFY ALL UTILITY COMPANIES BY CALLING "SUBTAKES" AT 765-1234 AT LEAST 48 WORKING HOURS PRIOR TO COMMENCING WORK IN ANY PART OF THE PROJECT AREA.
 - THE CONTRACTOR SHALL BE RESPONSIBLE FOR PROTECTING AND MAINTAINING IN SERVICE ALL EXISTING UTILITIES.
 - THE CONTRACTOR SHALL CONFINED HIS WORK TO WITHIN THE CONSTRUCTION LIMITS AND/OR RIGHT-OF-WAYS TO PRESERVE EXISTING VEGETATION AND PRIVATE PROPERTY. OVERNIGHT PARKING OF CONTRACTOR'S EQUIPMENT SHALL NOT OBSTRUCT DRIVEWAY OPENINGS OR DESIGNATED TRAFFIC LINES. THE CONTRACTOR SHALL SCHEDULE HIS TRENCHING, INSTALLATION AND BACKFILL OPERATIONS SO THAT ACCESS TO ANY DRIVEWAY IS NOT DISRUPTED LONGER THAN ONE WORKING DAY.
 - THE CONTRACTOR SHALL COORDINATE HIS ACTIVITIES WITH THE ENGINEER TO MINIMIZE TRAFFIC DISRUPTIONS. NO CONSTRUCTION WILL BE ALLOWED ADJACENT TO PUBLIC SCHOOLS, EXCEPT DURING SCHOOL HOLIDAYS AND/OR BREAKS.
 - A DISPOSAL SITE FOR ALL EXCESS EXCAVATION MATERIALS SHALL BE OBTAINED BY THE CONTRACTOR AND APPROVED BY THE ENGINEER. ALL COSTS INCURRED IN OBTAINING A DISPOSAL SITE, HAULING THERE TO AND PROPER DISPOSAL THEREOF SHALL BE CONSIDERED INCIDENTAL TO CONSTRUCTION AND NO DIRECT PAYMENT WILL BE MADE THEREFOR.
 - THE CITY OF ALBUQUERQUE STANDARD DETAILS ARE INCLUDED IN THE SPECIFICATIONS AND MADE A PART OF THIS CONTRACT.
 - THE NEW MEXICO STANDARD SPECIFICATIONS FOR PUBLIC WORKS CONSTRUCTION, 1979 EDITION AND SUPPLEMENTAL SPECIFICATIONS WILL GOVERN WORK ON THIS PROJECT, UNLESS OTHERWISE NOTED IN THE CONTRACT DOCUMENTS.
 - ENDS OF ALL ABANDONED WATER LINES SHALL BE SECURED BY THE INSERTION OF A 12 INCH WROUGHT PLUG. THIS WORK SHALL BE INCIDENTAL AND NO EXTRA PAYMENT SHALL BE MADE FOR SAID WORK.
 - ARTERIAL PAVEMENT IS TO BE USED ON WASHINGTON BLVD., NE, COAL AVE., SE, LEAD AVE., SE, CENTRAL AVE., NE.
 - WHERE CONCRETE BLOCKING IS CALLED FOR, WRAP ALL BENDS, TEES, AND OTHER FITTINGS WITH POLY ETHYLENE.
 - WATER SYSTEMS DIVISION SHALL BE THE ONLY AUTHORIZED PERSONNEL TO OPERATE EXISTING VALVES. PIPE SHUTOFFS MUST BE COORDINATED WITH SAID DIVISION THREE (3) FULL WORKING DAYS PRIOR TO PROPOSED SHUTOFFS. CALL 766-7100.
 - NEW WATER LINE TO EXISTING STEEL PIPE RECONNECTION-SEE SPECIAL NOTE ON STD., DRAWING W-1-2 IN CONTRACT DOCUMENTS WHEN NEW LINE MUST REDUCE IN SIZE TO EXISTING LINE.
 - PROPERTY OWNERS, ADJACENT TO THE PROJECT, MAY DESIRE REPLACEMENT OF THEIR EXISTING DETERIORATED SANITARY SEWER SERVICE AT THE TIME THE SERVICE IS EXPOSED DURING THE NORMAL CONSTRUCTION. THIS WORK SHALL BE SEPARATE AND SHALL BE PAID FOR BY THE REQUESTOR DIRECTLY TO: (a) THE PROJECT CONTRACTOR, OR (b) A PRIVATE PLUMBING CONTRACTOR WHO SHALL COORDINATE HIS ACTIVITIES WITH THE PROJECT CONTRACTOR.
 - WATER SYSTEMS DIVISION SHALL HAVE THE AUTHORITY TO CANCEL ALL SCHEDULED SHUTOFFS.
 - CONTRACTOR SHALL RECONNECT ALL SANITARY SEWER HOUSE SERVICES IN THE MANNER AND DIRECTION AS ORIGINALLY FOUND; EVEN IF THIS SHALL MEAN THE SERVICE MAY BE AT AN ANGLE OTHER THAN 90 DEGREES FROM THE MAIN; PER AGREEMENT WITH THE MECHANICAL SECTION/CODE ADMINISTRATION DIVISION.
 - THE CONTRACTOR SHALL COMPLETE ALL SANITARY SEWER AND WATER WORK INTENDED FOR A STREET BEFORE MOVING ON TO ANOTHER STREET IN THE PROJECT, UNLESS OTHERWISE AUTHORIZED BY THE ENGINEER. ONCE ALL SANITARY SEWER AND WATER WORK HAS BEEN DONE IN A STREET, THE CONTRACTOR SHALL HAVE TWO (2) WEEKS TO LAY CURB AND GUTTER, SIDEWALK, SUBGRADE, AND BASE COURSE WITHIN THE STREET. SURFACE COURSE SHALL BE LAID ONLY AFTER SUCCESSFUL TESTING OF ALL OTHER WORK WITHIN THE STREET.
 - THE CARE AND PROTECTION OF ALL OTHER UTILITIES, CURB AND GUTTER, SIDEWALK, AND OTHER STREET APPURTENANCES THAT ARE NOT A PART OF THE INTENDED WORK, AS SHOWN ON PLANS ARE THE RESPONSIBILITY OF THE CONTRACTOR. IF DAMAGED, IN OR OUTSIDE OF THE PROJECT, OR OTHERWISE IMPROPERLY DISTURBED, THESE ITEMS WILL BE REPAIRED AT THE CONTRACTOR'S EXPENSE.
 - BROKEN CONCRETE STRUCTURES AND/OR CONCRETE MASONRY UNITS TO BE REPLACED AS PART OF THE WORK SHALL BE PREPARED AND DELIVERED TO OWNER SITE LOCATIONS BY THE CONTRACTOR AS DESCRIBED WITHIN SECTION 212 OF THE SUPPLEMENTAL TECHNICAL SPECIFICATIONS.
 - WHEN SO CALLED ON THE PLANS, MANHOLE REHABILITATION FOR LINES TO BE REPLACED SHALL INCLUDE THE WORK DESCRIBED IN THE SUPPLEMENTAL TECHNICAL SPECIFICATIONS OF THE CONTRACT DOCUMENTS, SECTIONS 600.13 AND 552.076. WHEN SO CALLED ON THE PLANS, MANHOLE REHABILITATION ON LINES TO BE REPLACED SHALL BE THE WORK DESCRIBED IN SECTION 552.076 ONLY.
 - SAN CRISTOBAL, 15TH, CEDAR, AND PROSPECT STREETS SHALL BE OVERLAIN WITH NEW SURFACE COURSE BY THE CITY TRANSPORTATION DEPARTMENT. IN THESE STREETS, THE CONTRACTOR SHALL REPLACE 4-6" ASPHALT CONCRETE BASE COURSE (WITH SUBGRADE) TO THE TOP OF THE EXISTING PAVEMENT SURFACE ON EITHER SIDE OF THE TRENCH.
 - IN FREDERICK COURT, THE ENGINEER SHALL DETERMINE WHETHER THERE WILL BE FULL WIDTH OR TRENCH ONLY PAVEMENT REMOVAL AND REPLACEMENT AFTER THE PROJECT HAS BEEN AWARDED.
 - IF, AFTER LAYING BASE COURSE, ALL OR A PORTION OF THE WORK SHOULD FAIL TESTING AND REQUIRE EXCAVATION, THE REMOVAL AND REPLACEMENT OF THE BASE COURSE (AND ALL OTHER NECESSARY WORK TO REPAIR DEFECTIVE WORK AS SET FORTH IN THE CONTRACT DOCUMENTS) SHALL BE AT THE CONTRACTOR'S EXPENSE.
 - 20" STEEL WATER LINE IN ESPANOLA STREET SHALL BE ABANDONED IN PLACE OR REMOVED AT THE CONTRACTOR'S OPTION; HOWEVER, REMOVING THE PIPE SHALL BE INCIDENTAL TO THE PROJECT AND NO SEPARATE PAYMENT WILL BE MADE. IF ABANDONED IN PLACE, PAYMENT WILL BE MADE FOR FILLING THE ABANDONED PIPE WITH A SAND SURGEY.

1 2 3 4 5 6 7 8 9 10 11 12
2 10 1 7 0 0 1 8 4

MARCH 1983


REV.	SHEETS	CITY	ENGR.	DATE	USER	DEPT.	DATE	USER	DEPT.	DATE
APPROVAL OF REVISIONS										

Sanit. Sewer
107


107

APPROVED FOR CONSTRUCTION 3/15/83 WRD CHIEF ENGINEER	APPROVED FOR CONSTRUCTION 766-600 3-15-83 CITY ENGINEER
PROJECT NO (WRD 82.15) 1700	SHEET 1 OF 23

CITY OF ALBUQUERQUE BERNALILLO COUNTY WATER RESOURCES DEPARTMENT

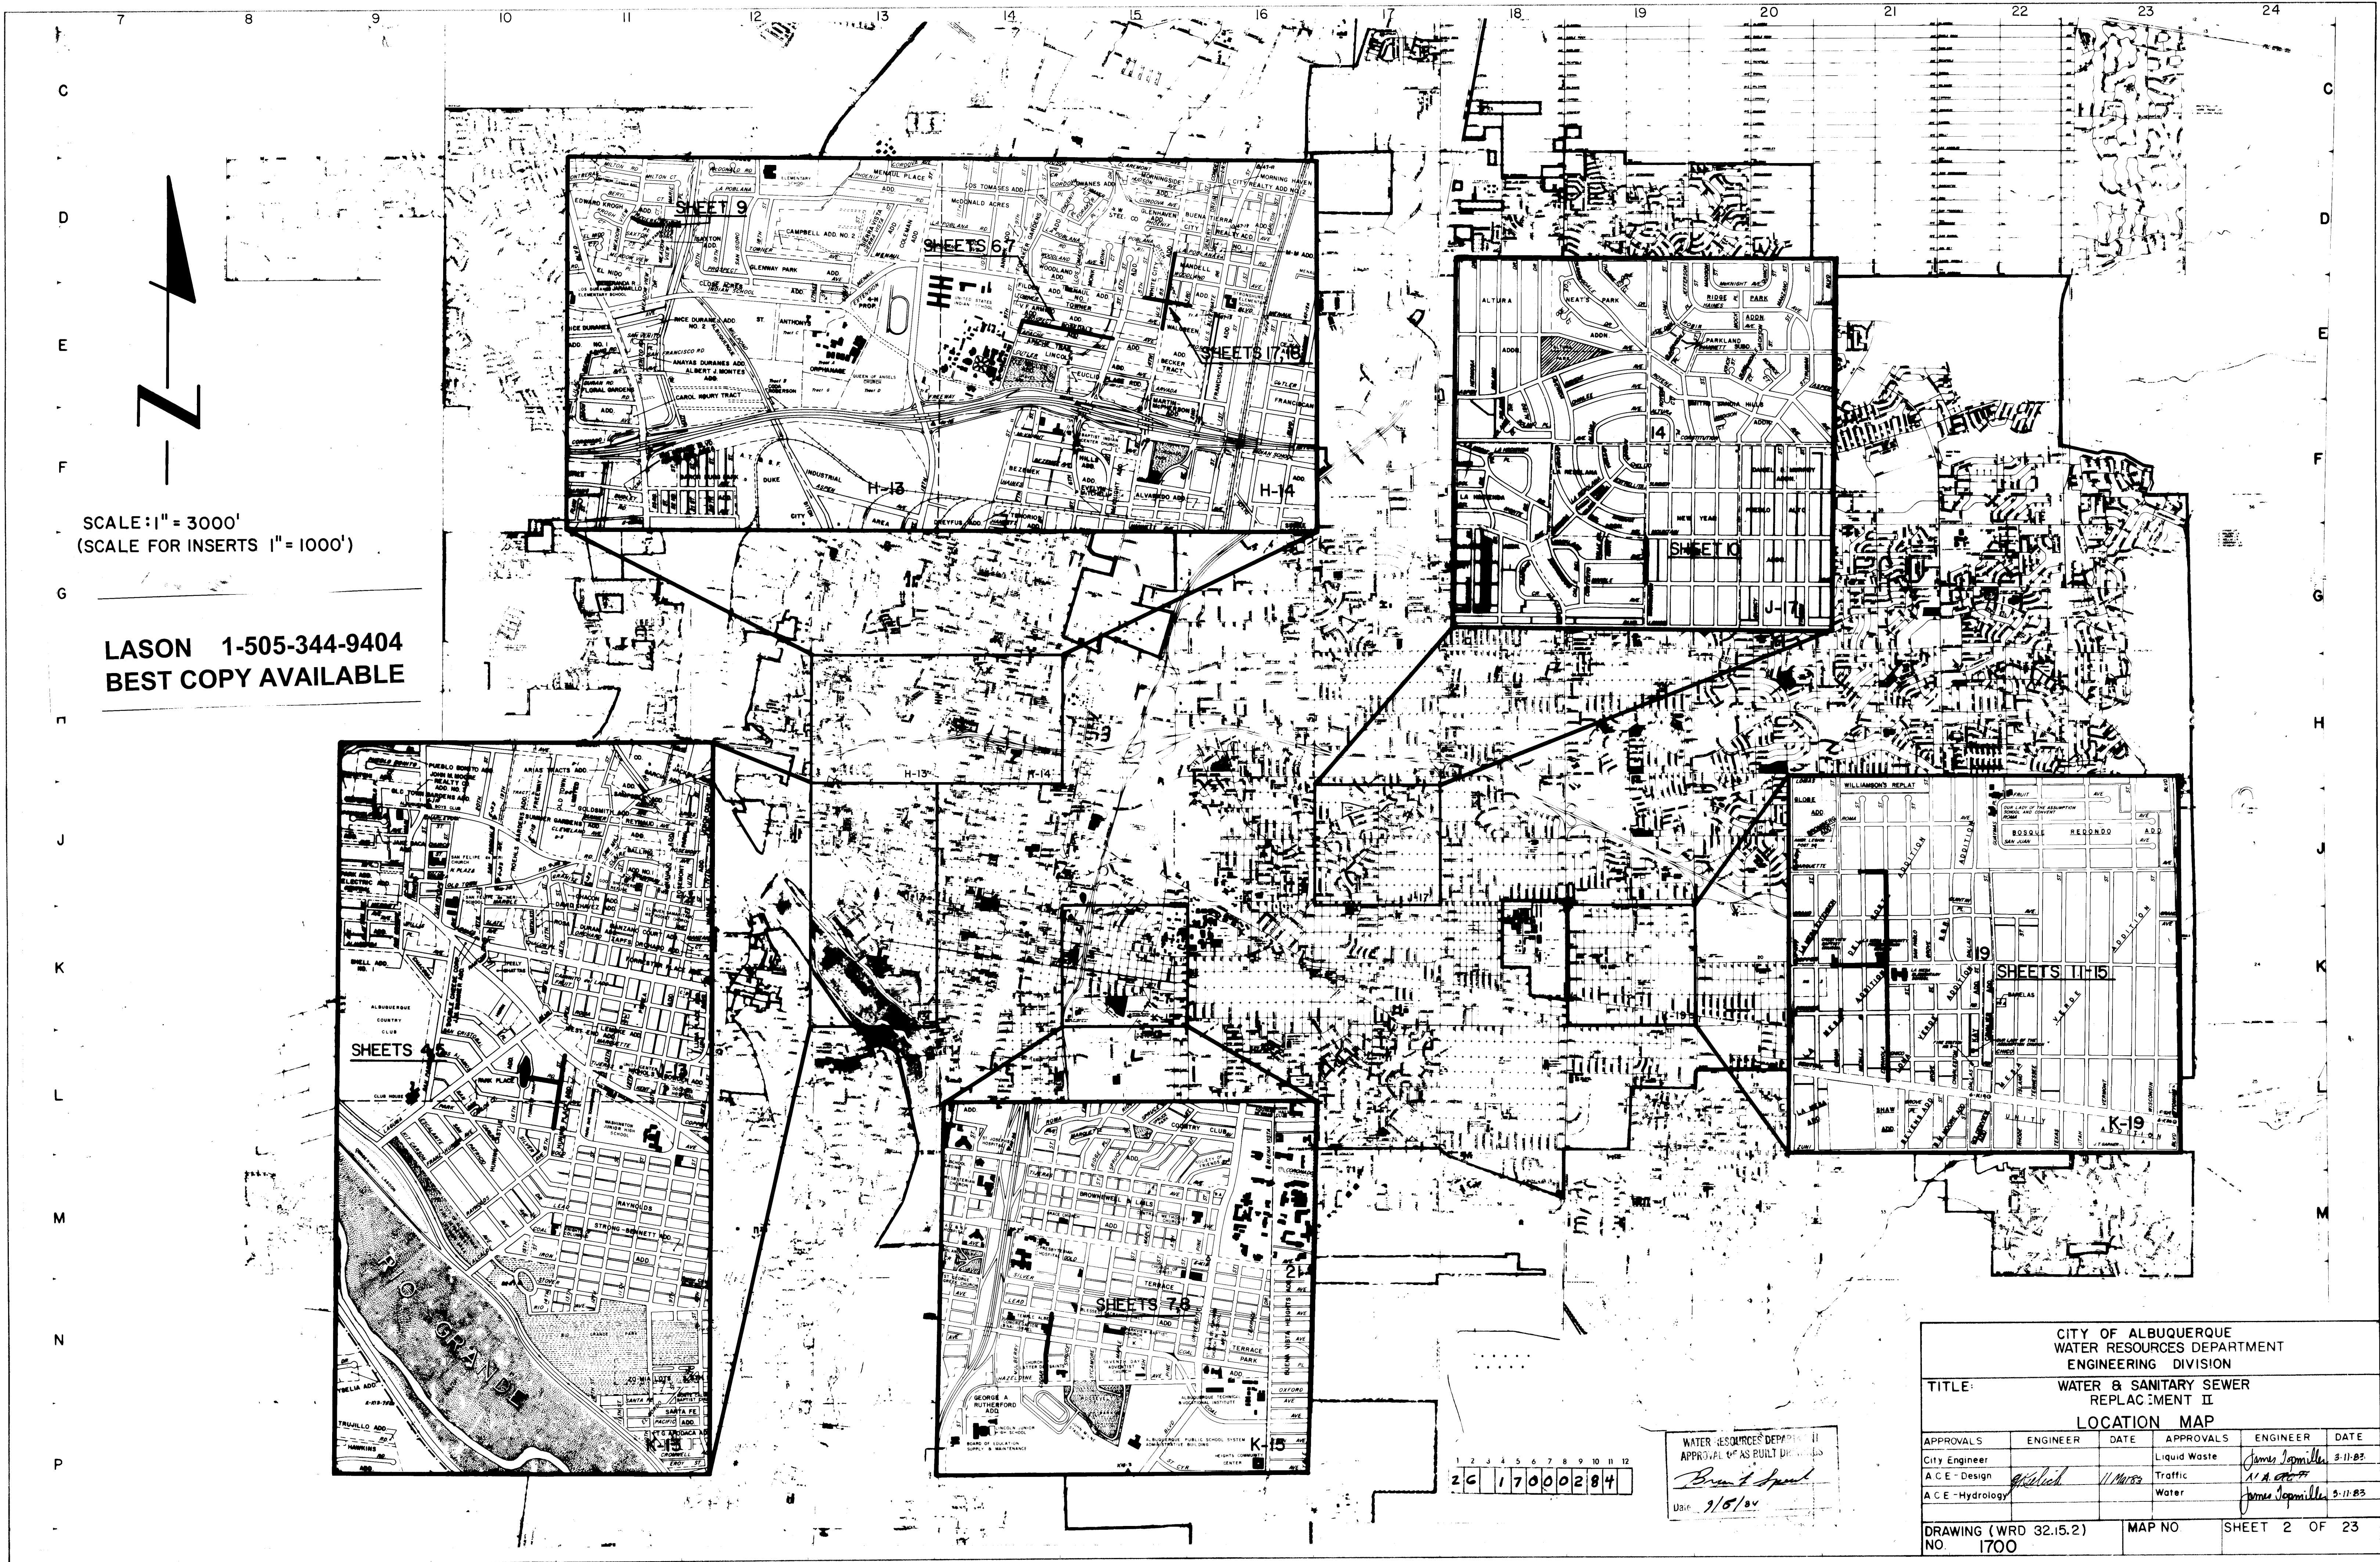

CITY OF ALBUQUERQUE WATER RESOURCES DEPARTMENT ENGINEERING DIVISION					
TITLE: WATER & SANITARY SEWER REPLACEMENT II					
LOCATION MAP					
APPROVALS	ENGINEER	DATE	APPROVALS	ENGINEER	DATE
CITY ENGINEER			Liquid Waste	James Jaramilla	3-11-85
A.C.E. Design	<i>Robert</i>	11/10/85	Traffic	A. J. Jaramilla	3-11-85
A.C.E. Hydrology			Water	James Jaramilla	3-11-85
DRAWING (WRD 32.5.2)		MAP NO		SHEET 2 OF 23	
NO 1700					

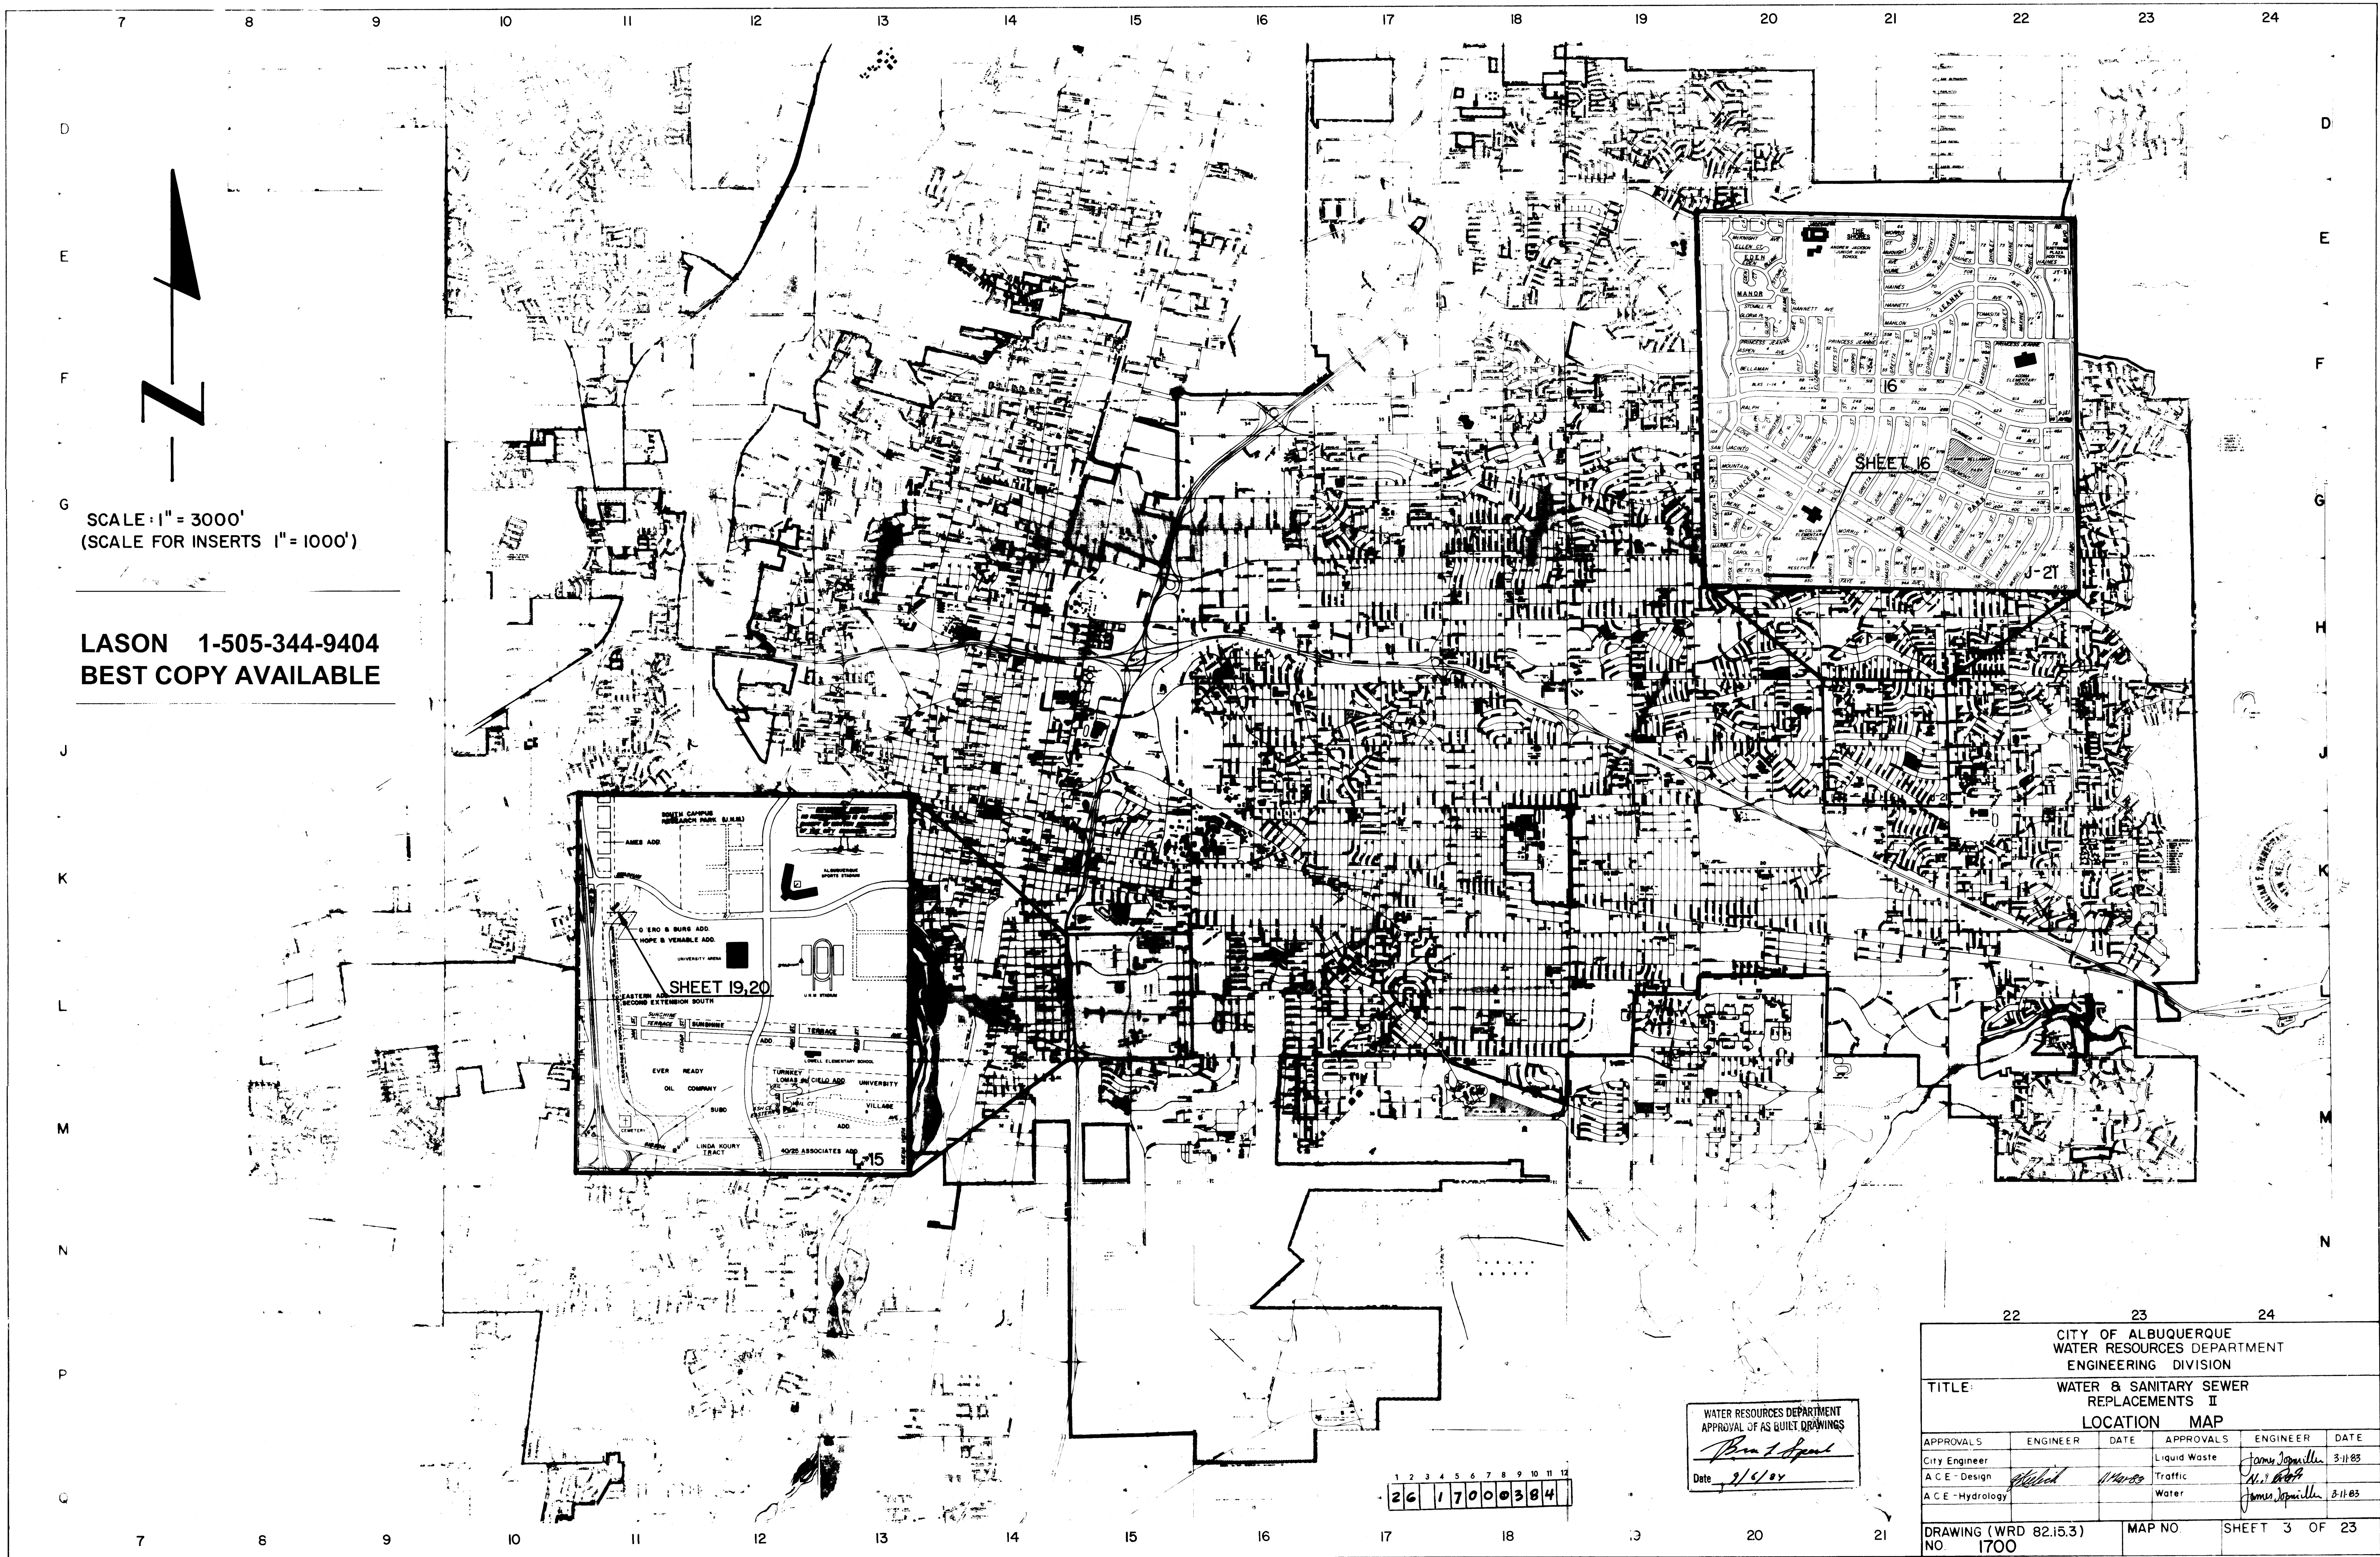

SCALE: 1" = 3000'
(SCALE FOR INSERTS 1" = 1000')

LASON 1-505-344-9404
BEST COPY AVAILABLE

WATER RESOURCES DEPARTMENT
APPROVAL OF AS BUILT DRAWINGS
Barbara L. Lopez
Date 3/1/85



CITY OF ALBUQUERQUE WATER RESOURCES DEPARTMENT ENGINEERING DIVISION					
TITLE: WATER & SANITARY SEWER REPLACEMENTS					
LOCATION			MAP		
APPROVALS	ENGINEER	DATE	APPROVALS	ENGINEER	DATE
CITY Engineer			Liquid Waste	James Ignatelli	3/1/85
A.C.E. Design	<i>[Signature]</i>	1/1/85	Traffic	<i>[Signature]</i>	
A.C.E. Hydrology			Water	James Ignatelli	3/1/85
DRAWING (WRD 82.15.3)			MAP NO.	SHEET 3 OF 23	
NO 1700					

SURVEY INFORMATION		BENCH MARKS		AS BUILT INFORMATION	
NO.	FIELD NOTES		BM: 6-K13	CONTRACTOR: CASH, JAMES L. JR.	
	BY	DATE		WORK ORDER NO. BY INSPECTOR'S	DATE
			ELEV - 4956.95 FT <td>ACCEPTANCE BY: W.R.D <td>DATE: 10/14/83</td> </td>	ACCEPTANCE BY: W.R.D <td>DATE: 10/14/83</td>	DATE: 10/14/83
			LOCATION - APPROX. 23' N.E. OF THE INTERSECTION OF	FIELD LOCATION BY: W.R.D <td>DATE</td>	DATE
			ALCALDE PL. & TINGLEY DR. SW.	DRAWINGS	
				CORRECTED BY: W.R.D <td>DATE</td>	DATE
				MICRO-FILM INFORMATION	
				RECORDED BY	DATE
				NO	

A circular professional engineer seal for the State of Michigan. The outer ring contains the text "STATE OF MICHIGAN" at the top and "REGISTERED PROFESSIONAL ENGINEER" at the bottom. The inner circle contains the text "NO. 1304" and the year "1994".

[illegible]

CITY OF ALBUQUERQUE WATER RESOURCES DEPARTMENT ENGINEERING DIVISION					
TITLE: WATER & SANITARY SEWER REPLACEMENTS II					
15TH ST. S.W. & SAN CRISTOBAL RD. S.W.					
APPROVALS	ENGINEER	DATE	APPROVALS	ENGINEER	DATE
City Engineer			Liquid Waste	<i>James Segumiller</i>	3-16-83
A.C.E. - Design	<i>J. G. Smith</i>	11 Mar 83	Traffic	<i>N. A. Galt</i>	
A.C.E. - Hydrology			Water	<i>James Segumiller</i>	3-16-83
DRAWING (WRD 82.15.4)		MAP NO.	SHEET 4 OF 23		
NO. 1700		J13			

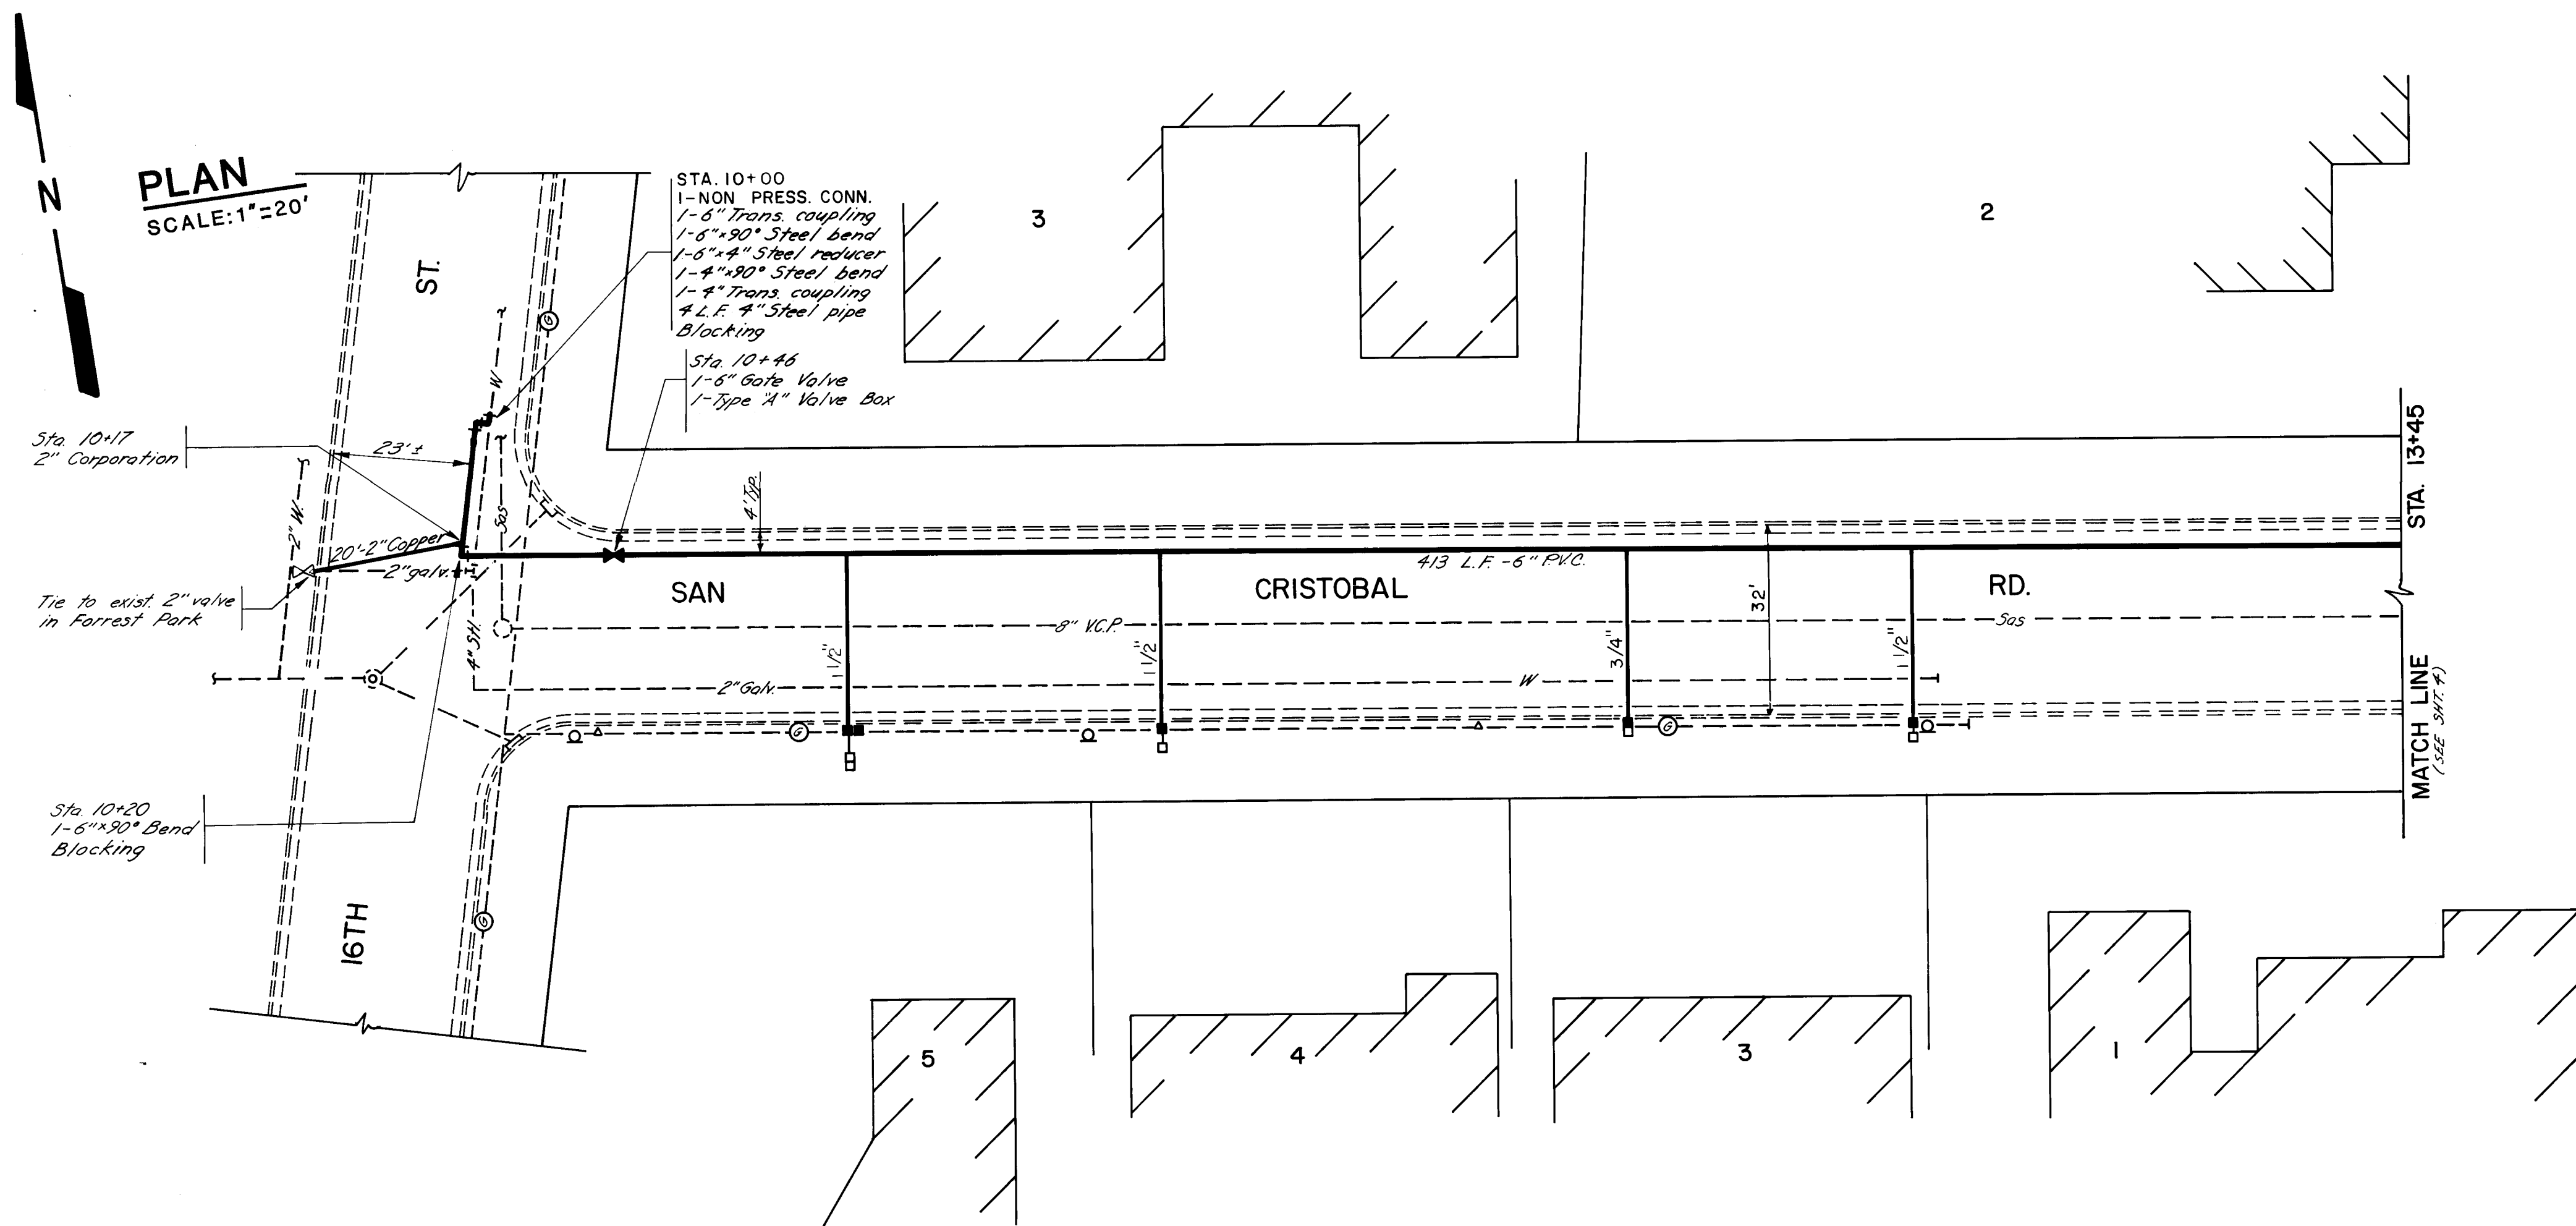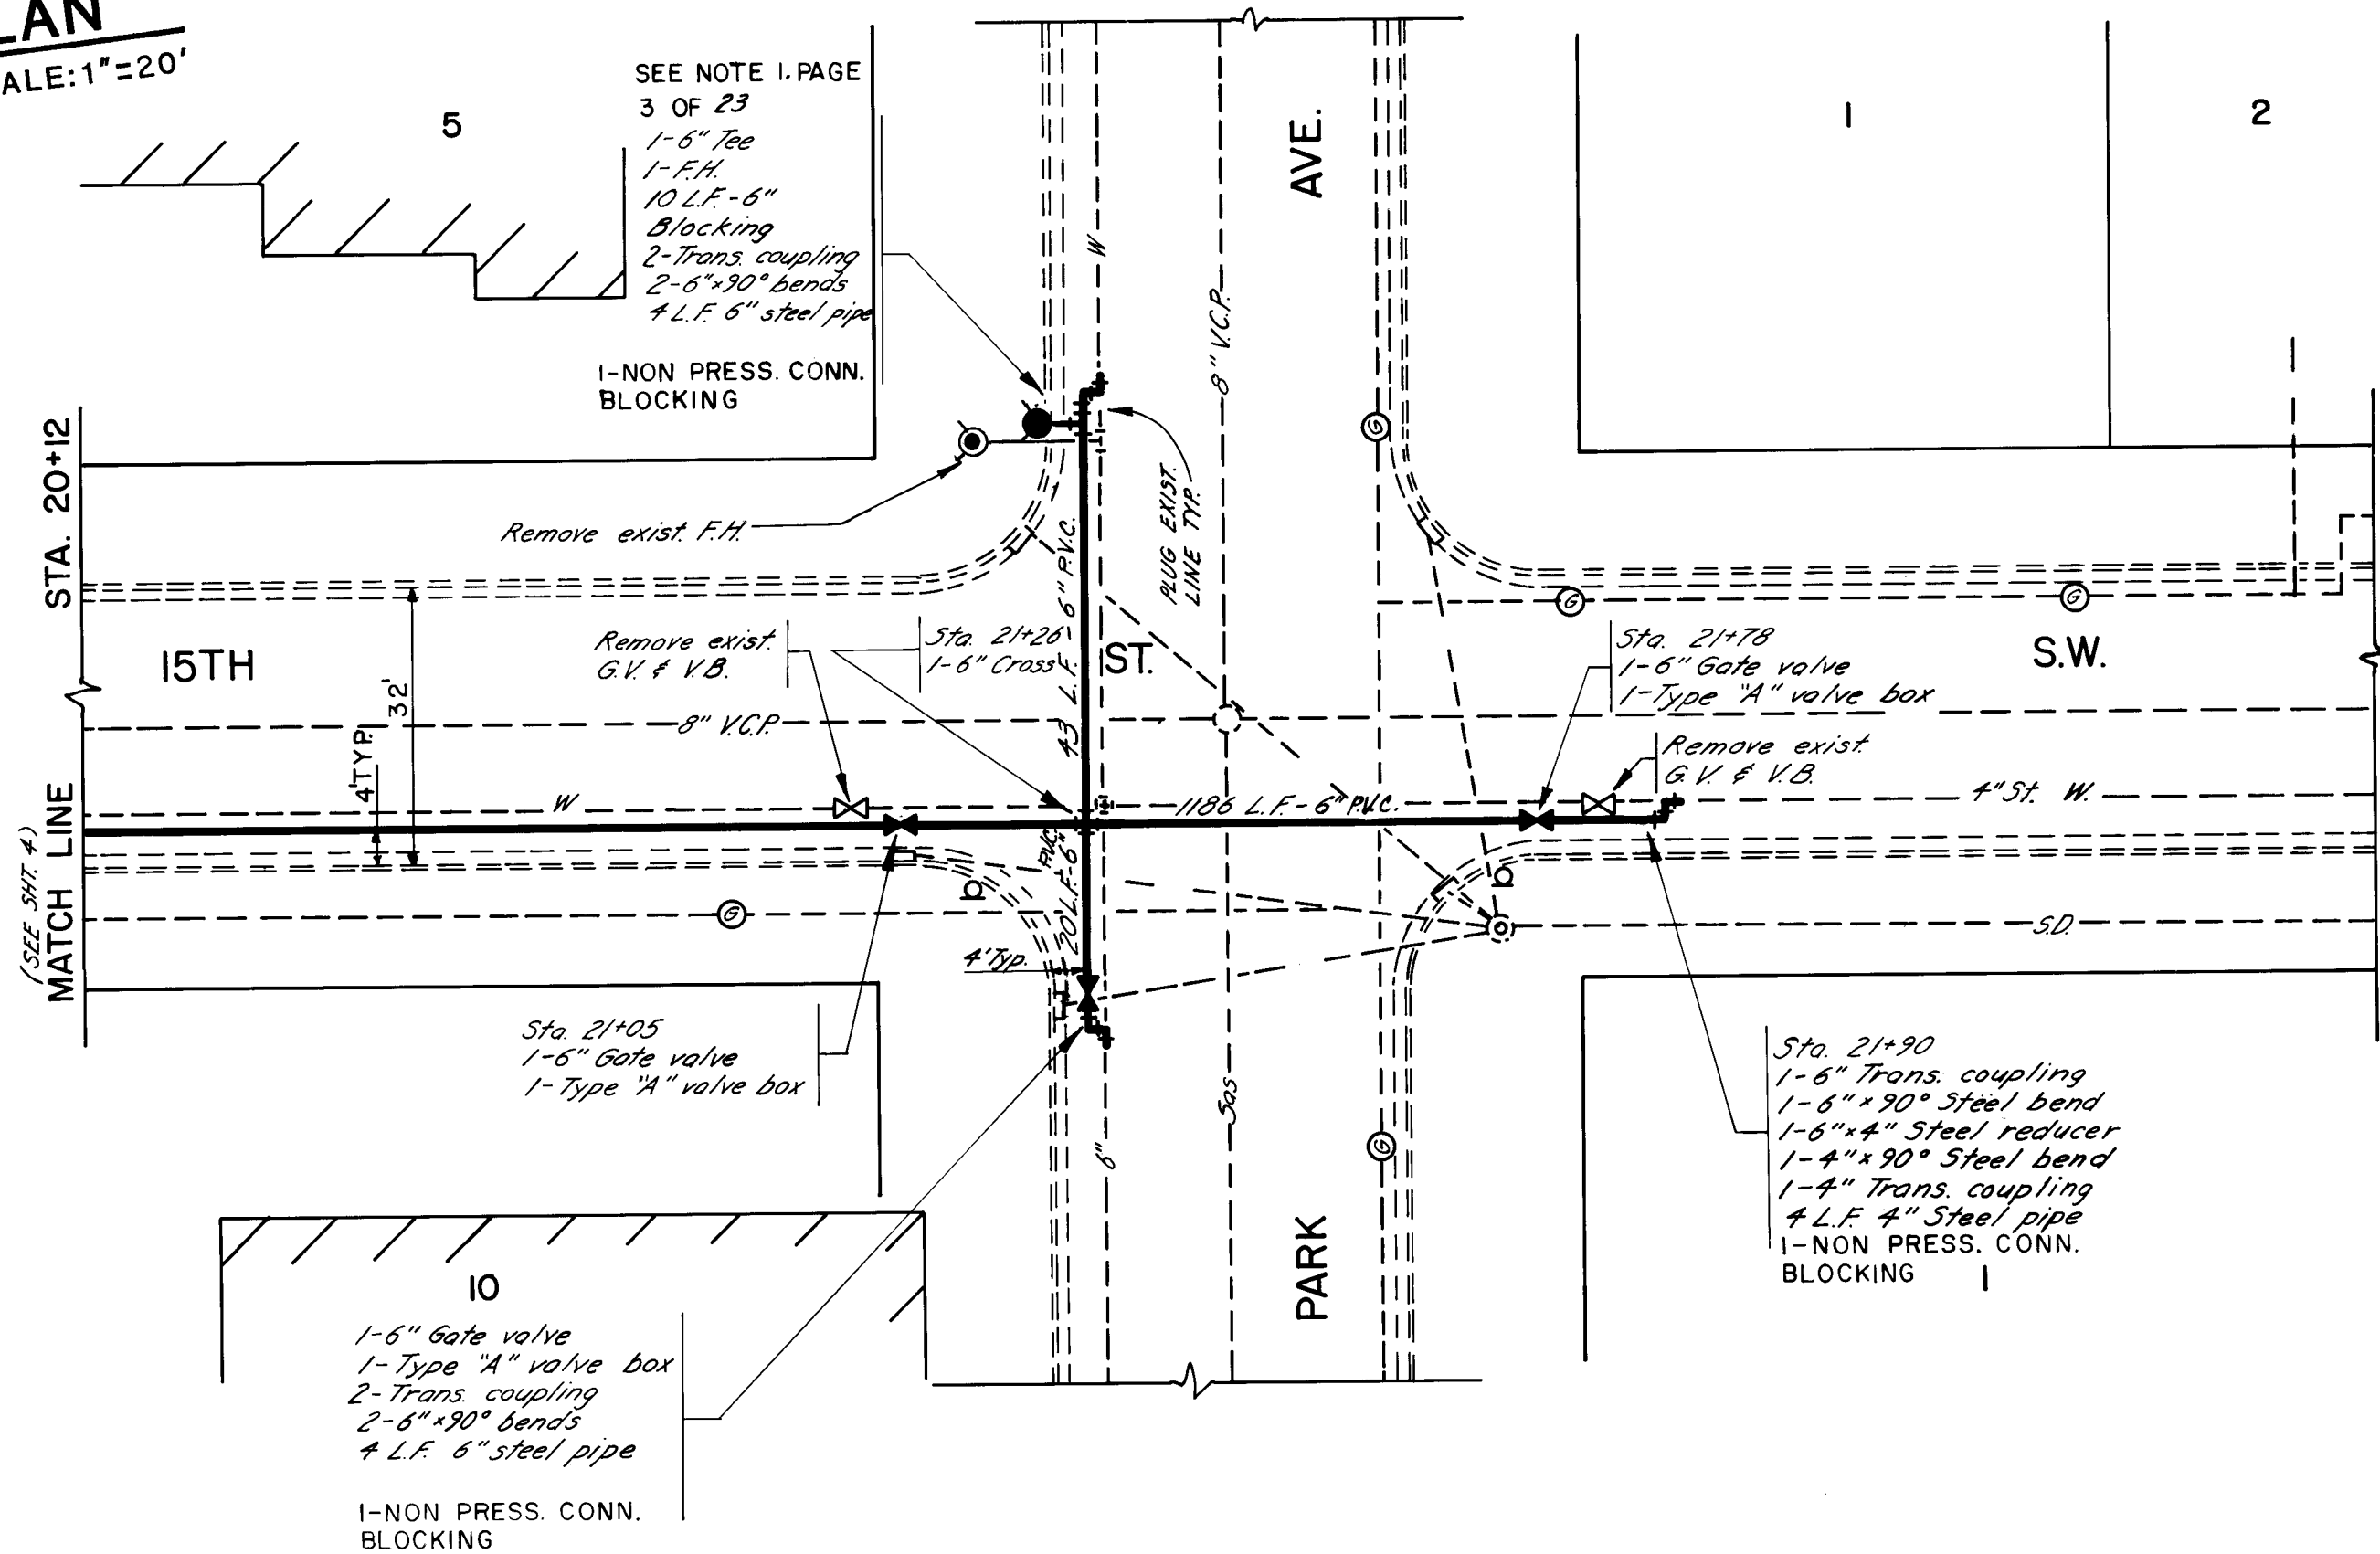


26 17000584


BRUNNEN & SPOHN
2/4/20

CITY OF ALBUQUERQUE					
WATER RESOURCES DEPARTMENT					
ENGINEERING DIVISION					
TITLE:		WATER & SANITARY SEWER REPLACEMENTS II 15TH ST. S.W. & SAN CRISTOBAL RD. S.W.			
APPROVALS	ENGINEER	DATE	APPROVALS	ENGINEER	DATE
City Engineer			Liquid Waste	James Jopannille	3-11-83
A.C.E. - Design	<i>J. Hellick</i>	<i>4/14/83</i>	Traffic	<i>N.A. Hellick</i>	
A.C.E. - Hydrology			Water	James Jopannille	3-11-83
DRAWING (WRD 82.15.5)		MAP NO.		SHEET 5 OF 23	
NO. 1700		J 13			


PLAN
SCALE: 1"=20'

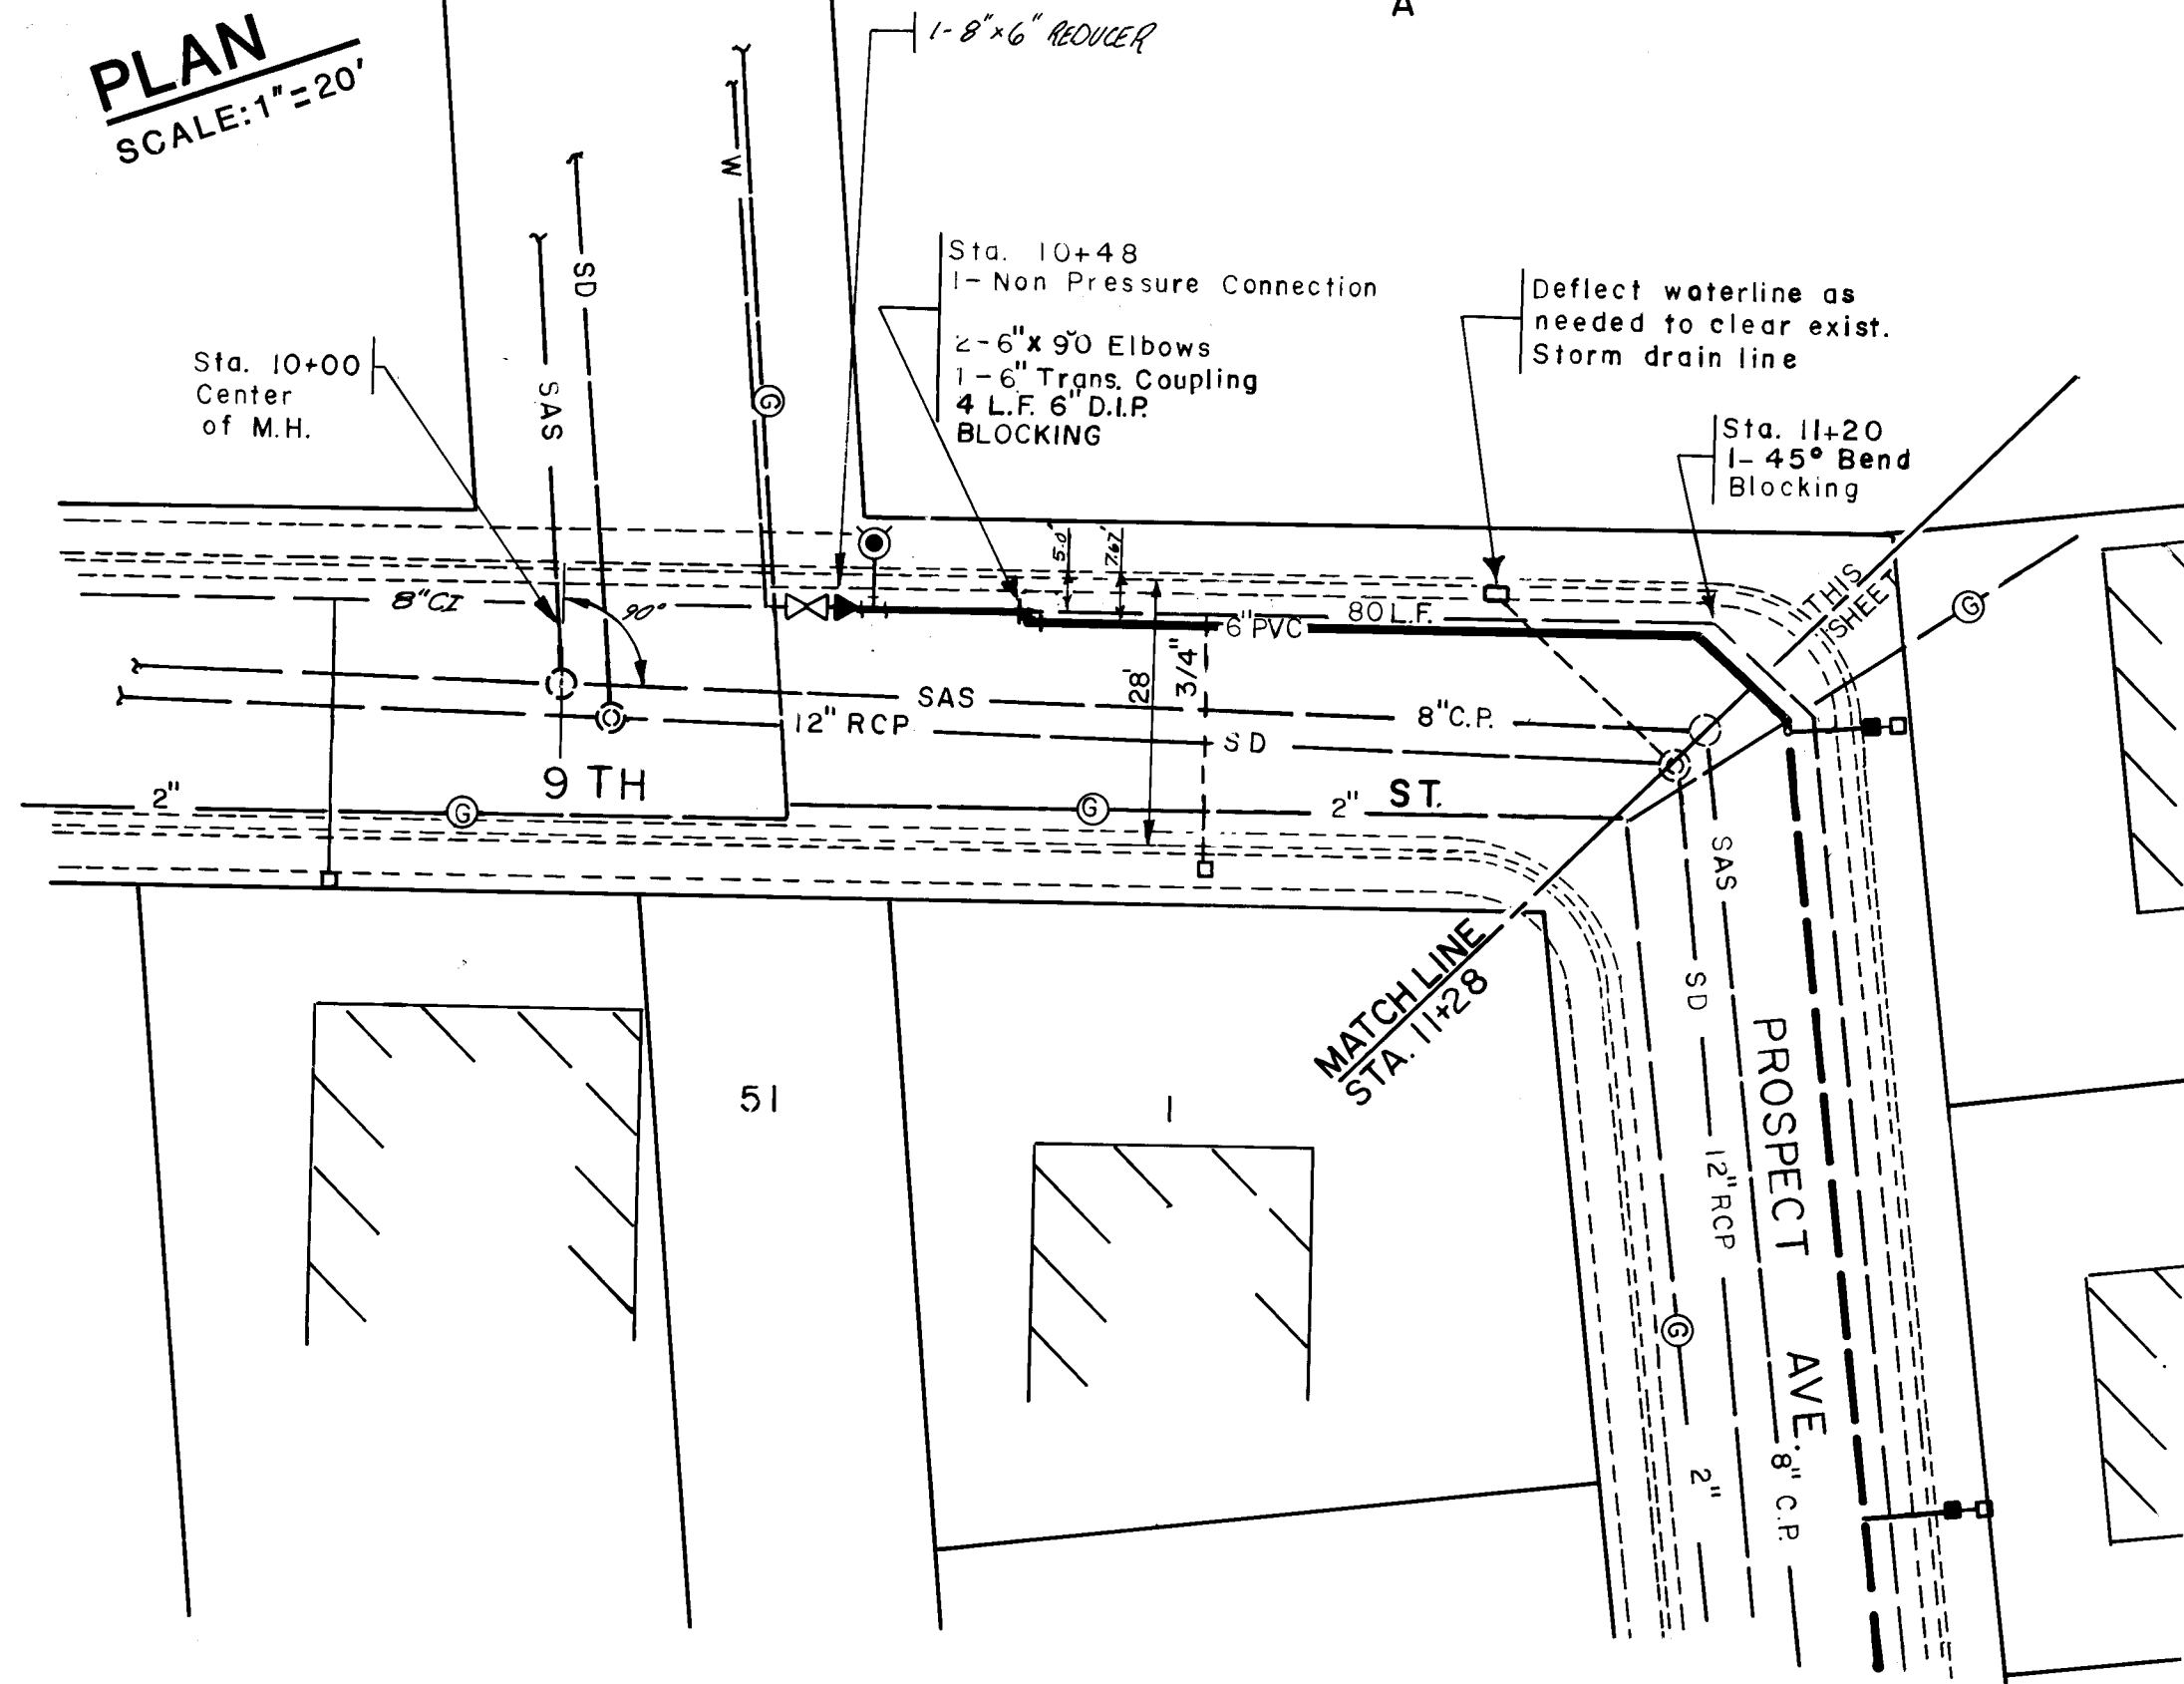

PLAN
SCALE: 1"=20'

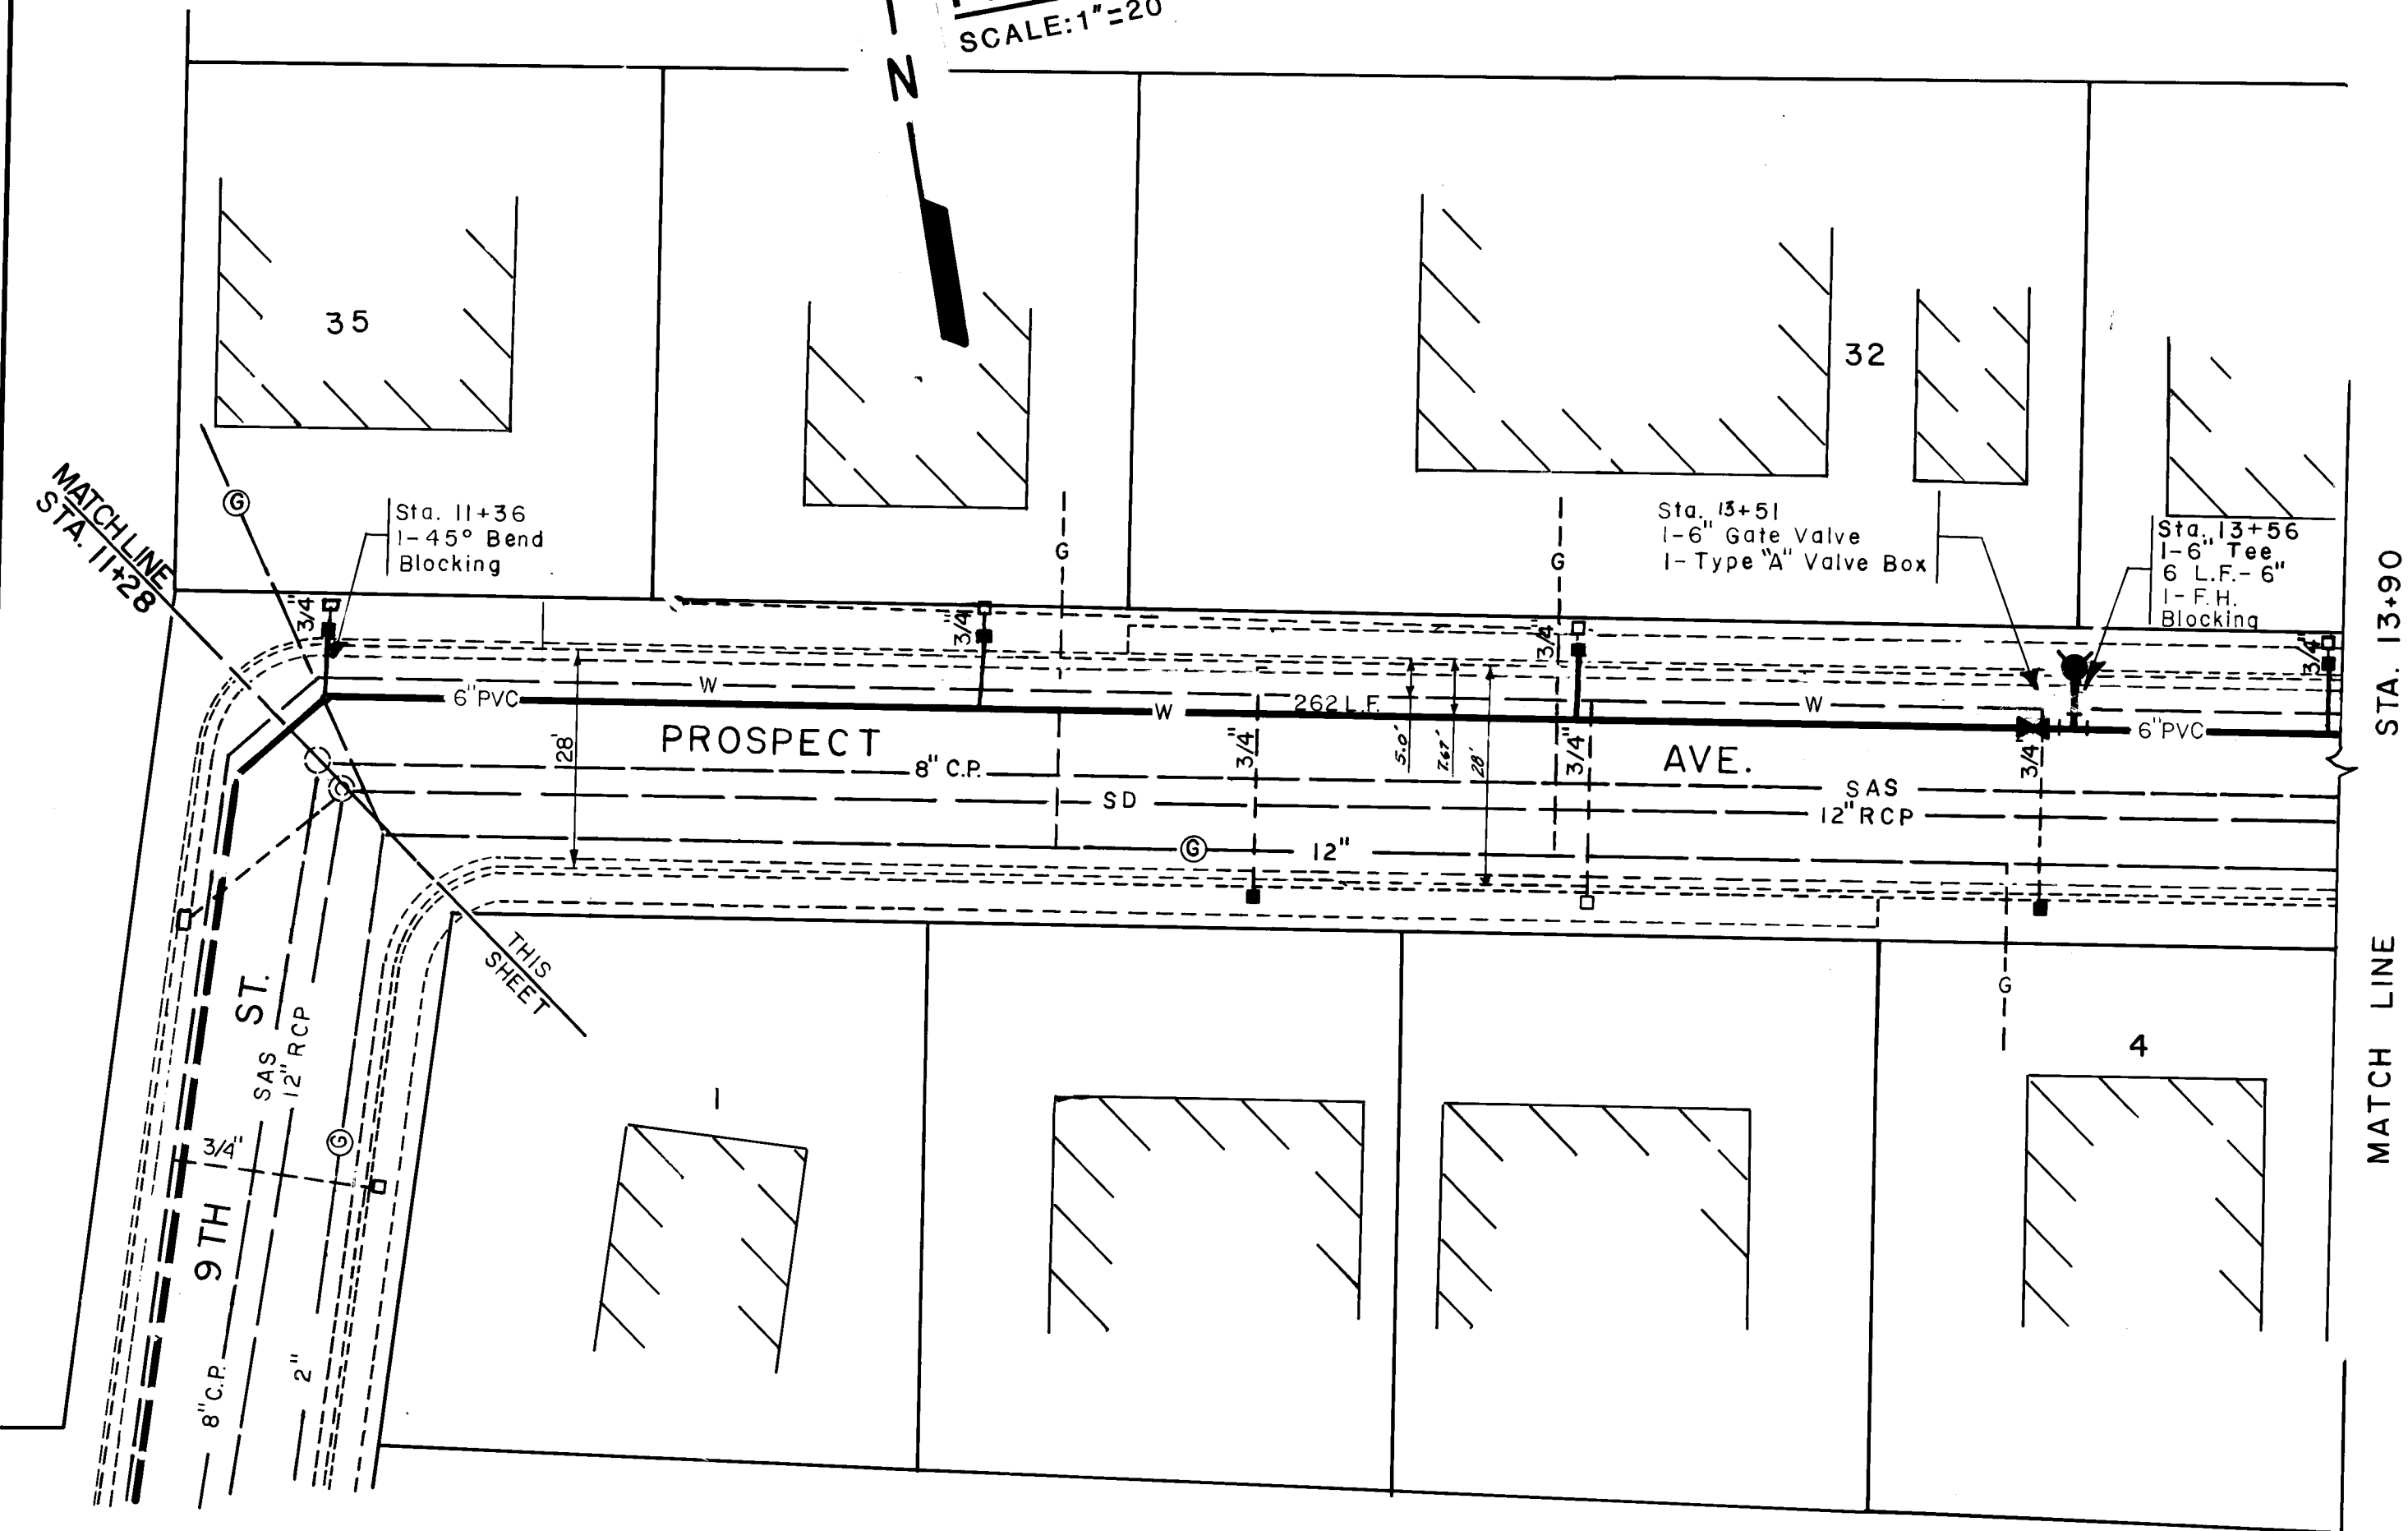

PLAN
SCALE: 1"=20'

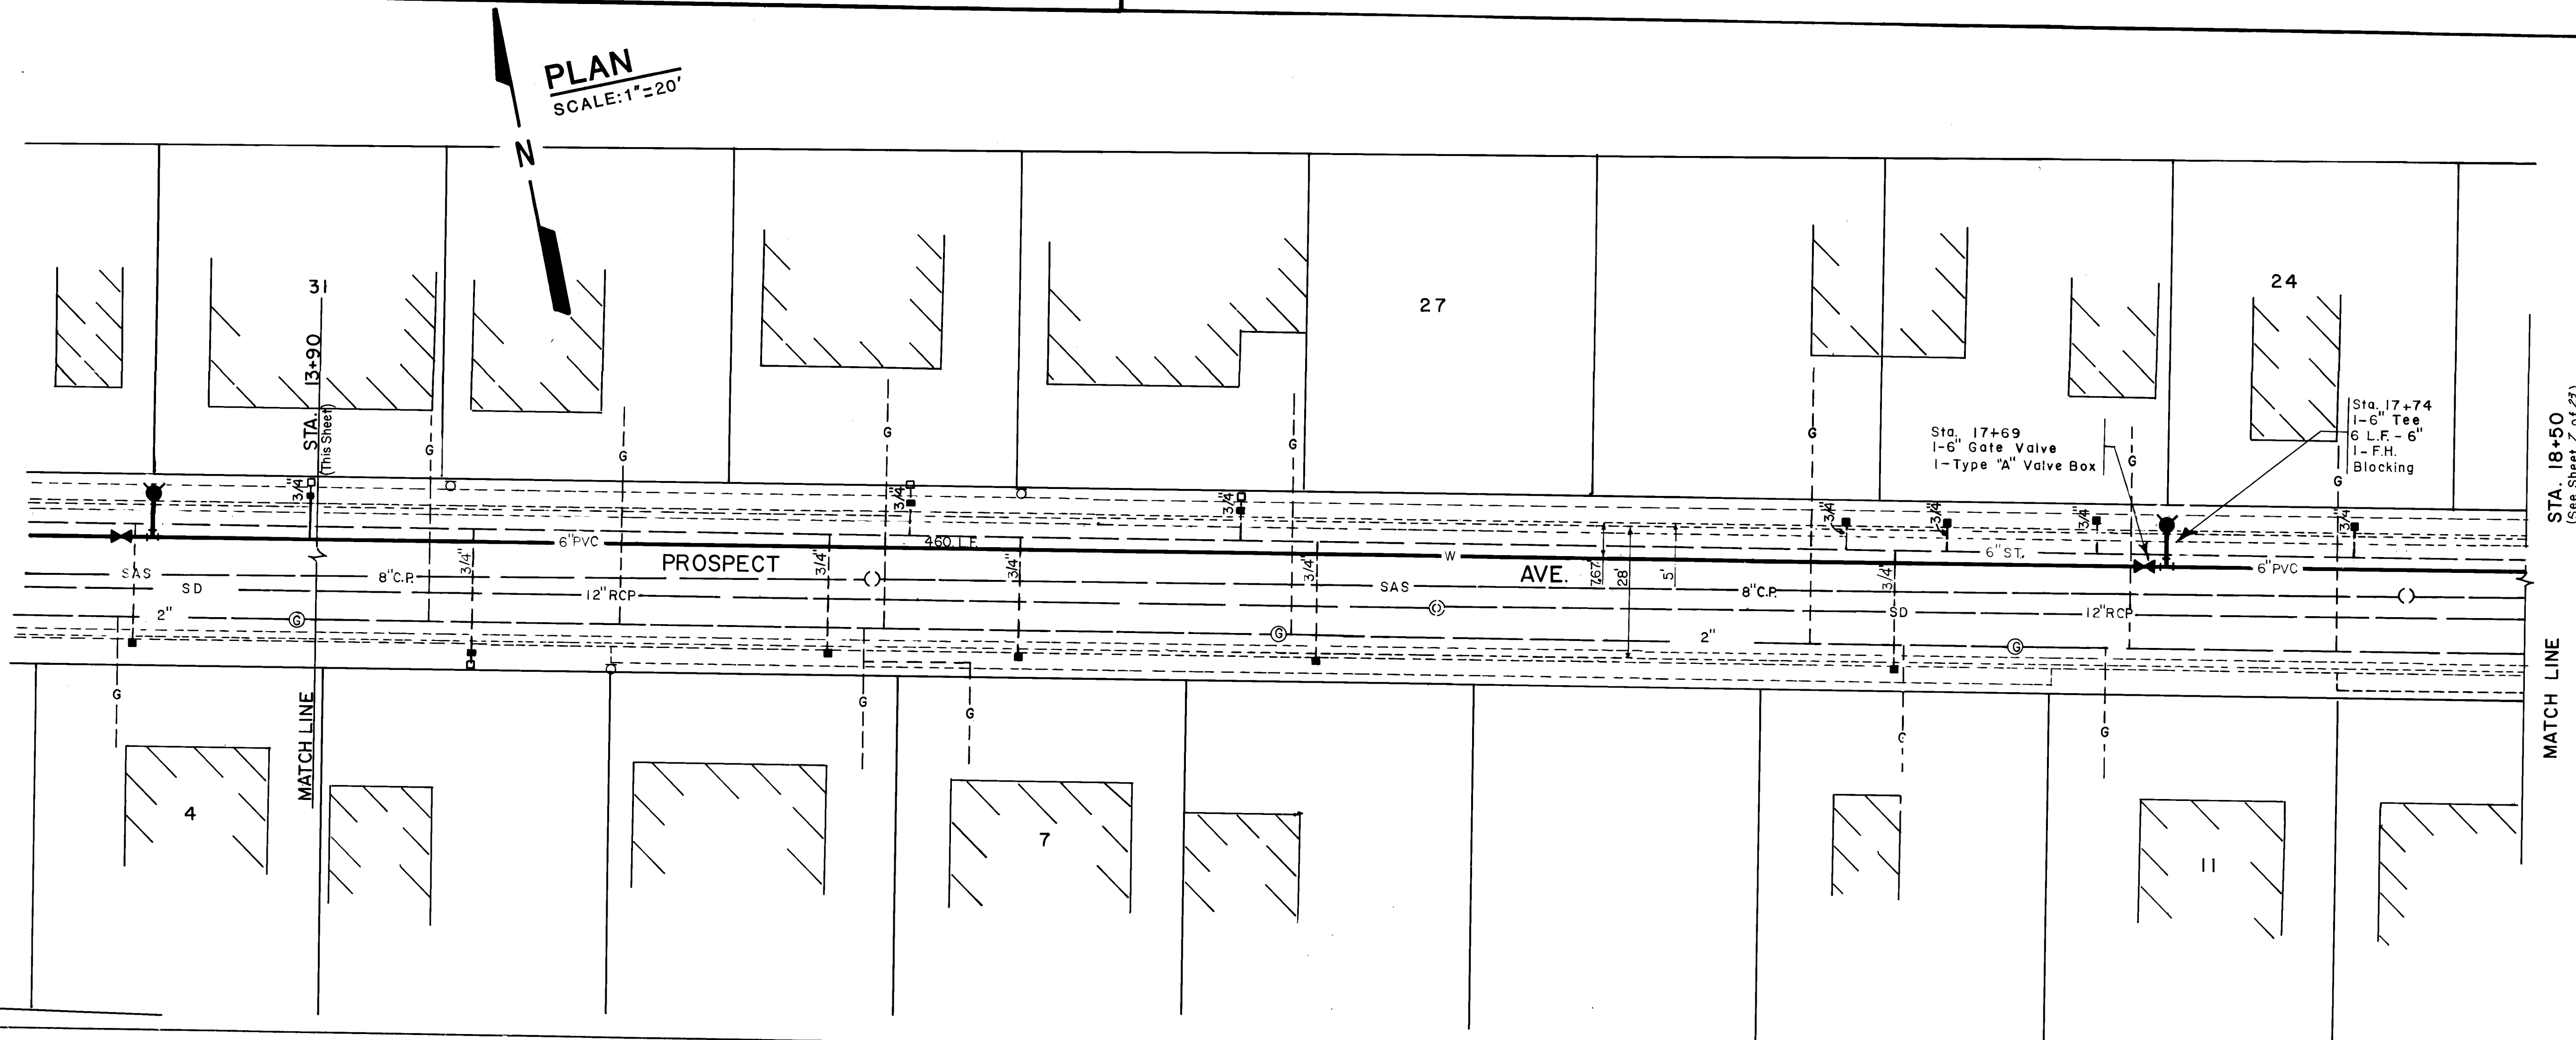

AS BUILT INFORMATION			BENCH MARKS			SURVEY INFORMATION			ENGINEER'S SEAL							
CONTRACTOR	COOK	00057 02	4-H14 LOCATED AT THE INTERSECTION OF 4th & MENAUL N.W. IN THE SOUTHEAST QUADRANT OF THE INTERSECTION. A SQUARE, CHISELED ON TOP OF CONCRETE CURB AT THE S.E. CURB RETURN. ELEVATION 4965.488	NO.	BY	DATE		REVISIONS	BY	DATE	DESIGNED BY JER	DATE SEPT. 82				
INSPECTOR'S	COOK															
FIELD CHECKED BY	WRD															
VERIFICATION BY	WRD															
CORRECTED BY	WRD															
MICRO-FILM INFORMATION																
RECORDED BY																
DATE																

26 17000684

Brown & Spauld
3/6/82


CITY OF ALBUQUERQUE
WATER RESOURCES DEPARTMENT
ENGINEERING DIVISION
TITLE: WATER & SANITARY SEWER
REPLACEMENTS II
PROSPECT AVE.

APPROVALS	ENGINEER	DATE	APPROVALS	ENGINEER	DATE
City Engineer			Liquid Waste	James Jaramilla	3/1/82
A.C.E. - Design	<i>[Signature]</i>	11/14/83	Traffic	<i>N.A. [Signature]</i>	
A.C.E. - Hydrology			Water	James Jaramilla	3/1/82

DRAWING (WRD 82.15.6)
NO. 1700

MAP NO.
H 14

SHEET 6 OF 23


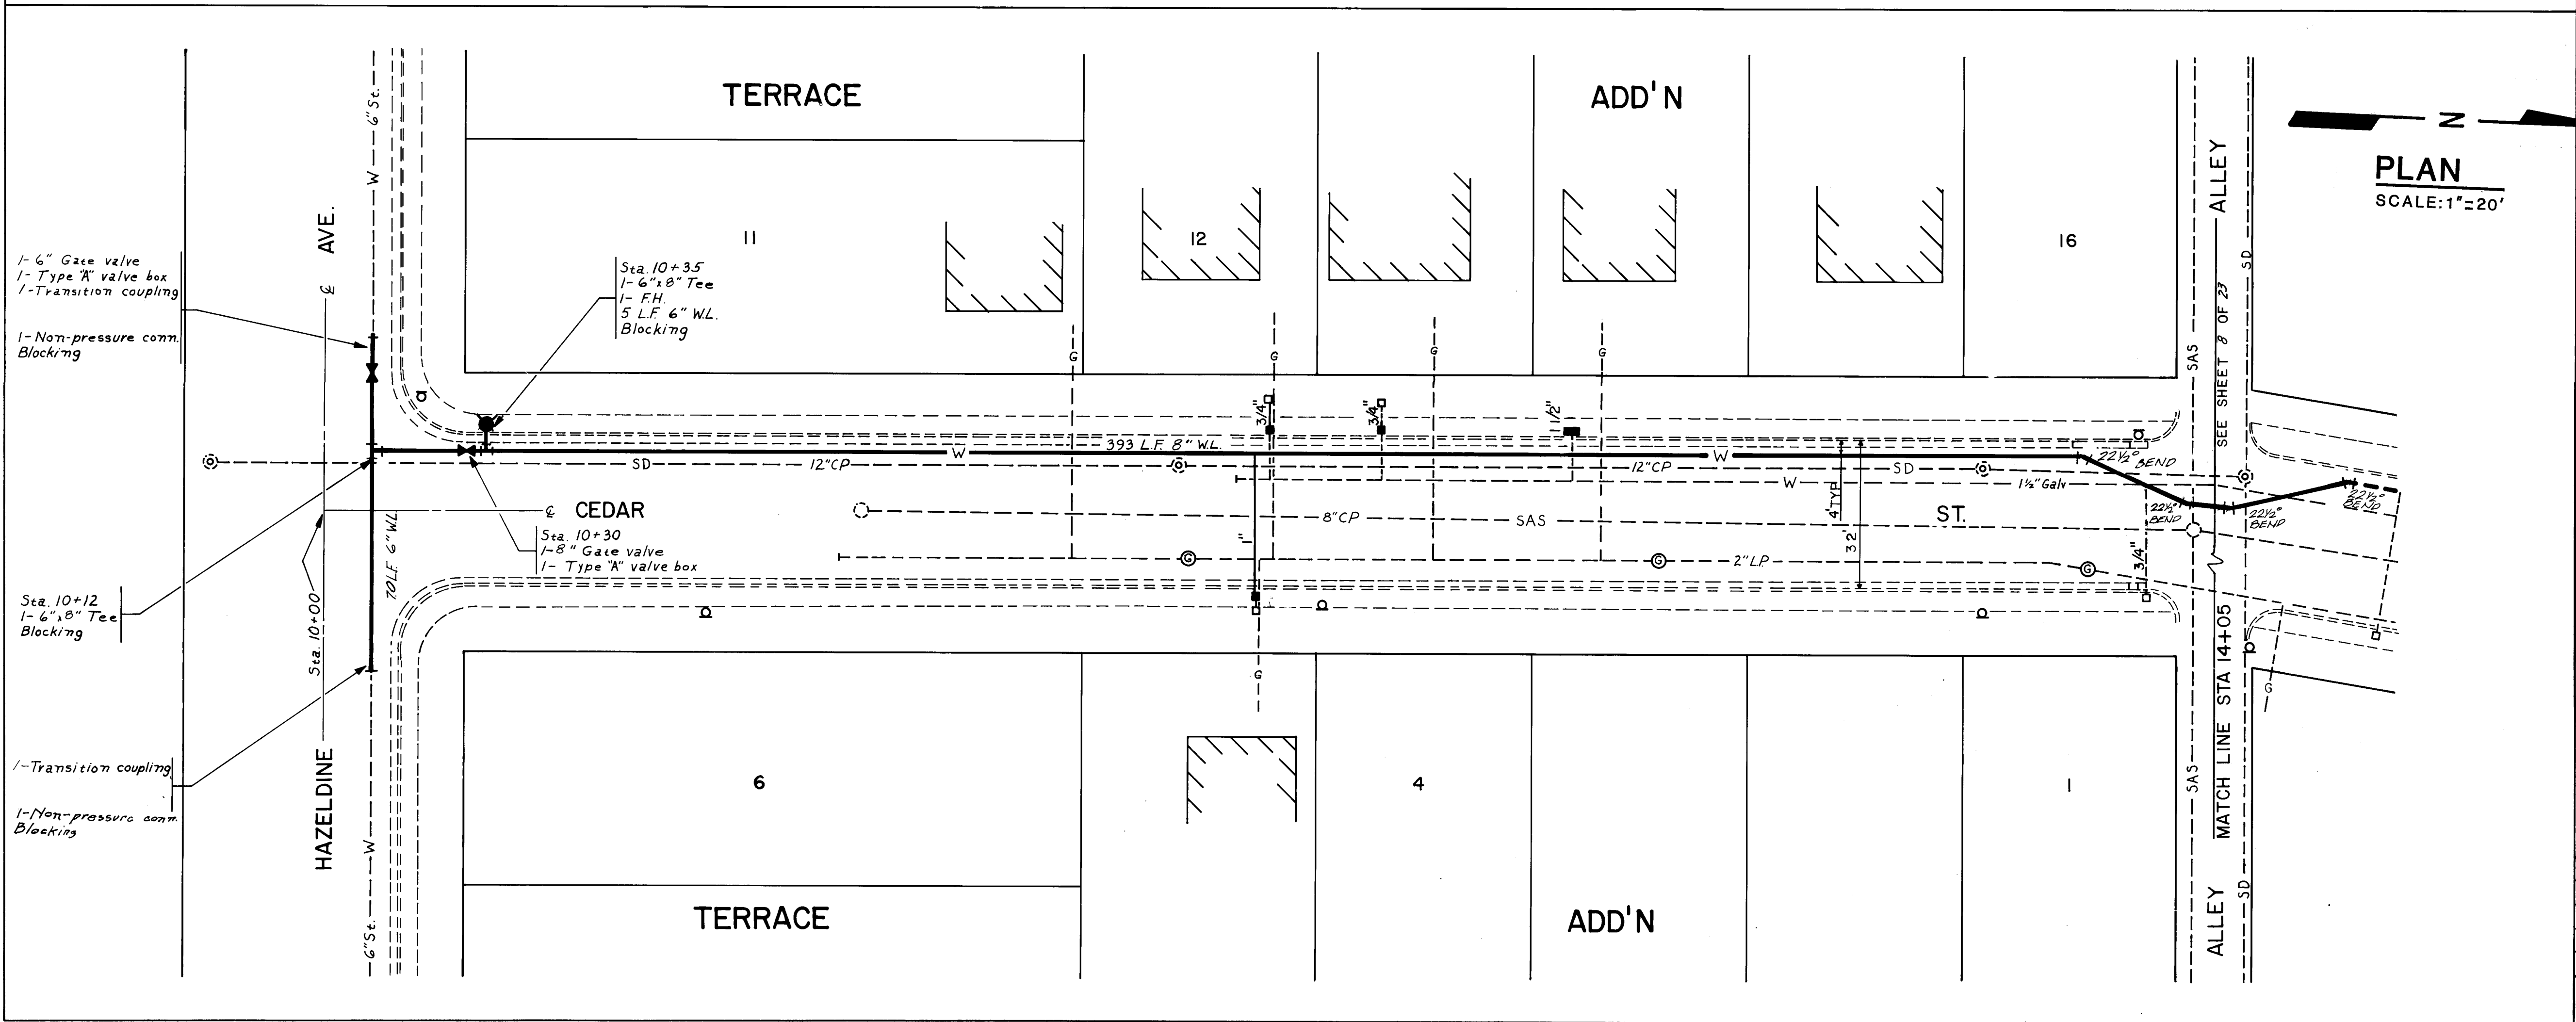


NOTES

1. If field verification indicates steel, replace as necessary to 6th St. intersection.

[illegible]

CITY OF ALBUQUERQUE WATER RESOURCES DEPARTMENT ENGINEERING DIVISION					
TITLE:		WATER & SANITARY SEWER REPLACEMENTS II PROSPECT AVE. CEDAR ST.			
APPROVALS	ENGINEER	DATE	APPROVALS	ENGINEER	DATE
City Engineer			Liquid Waste	<i>James Joplin</i>	3-11-83
A.C.E. - Design	<i>J. Joplin</i>	11 Mar 83	Traffic	<i>N.A. RFB</i>	
A.C.E. - Hydrology			Water	<i>James Joplin</i>	2-11-83
DRAWING (WRD 8215.7) NO. 1700			MAP NO. H-14-K-15		
			SHEET 7 OF 23		

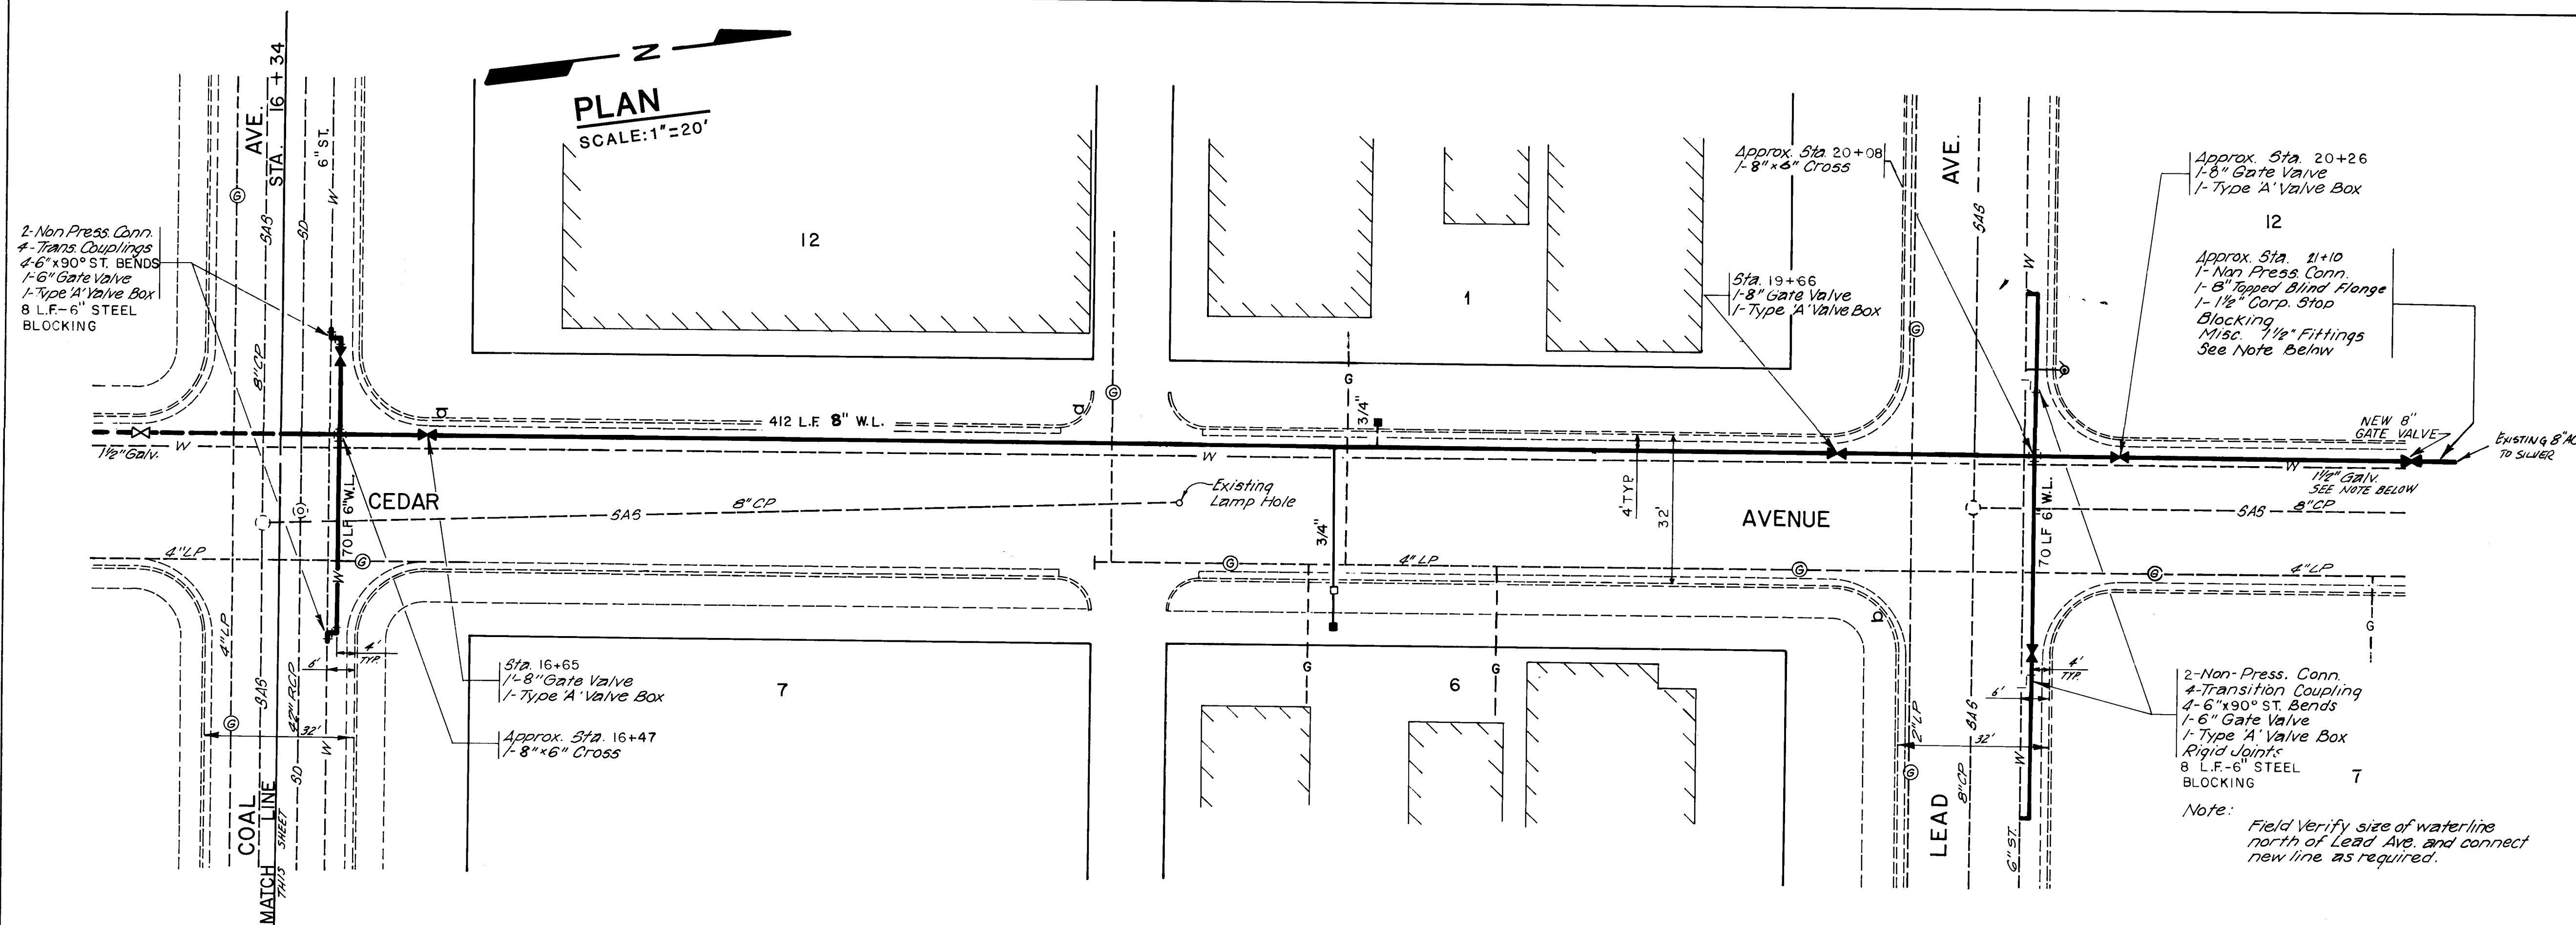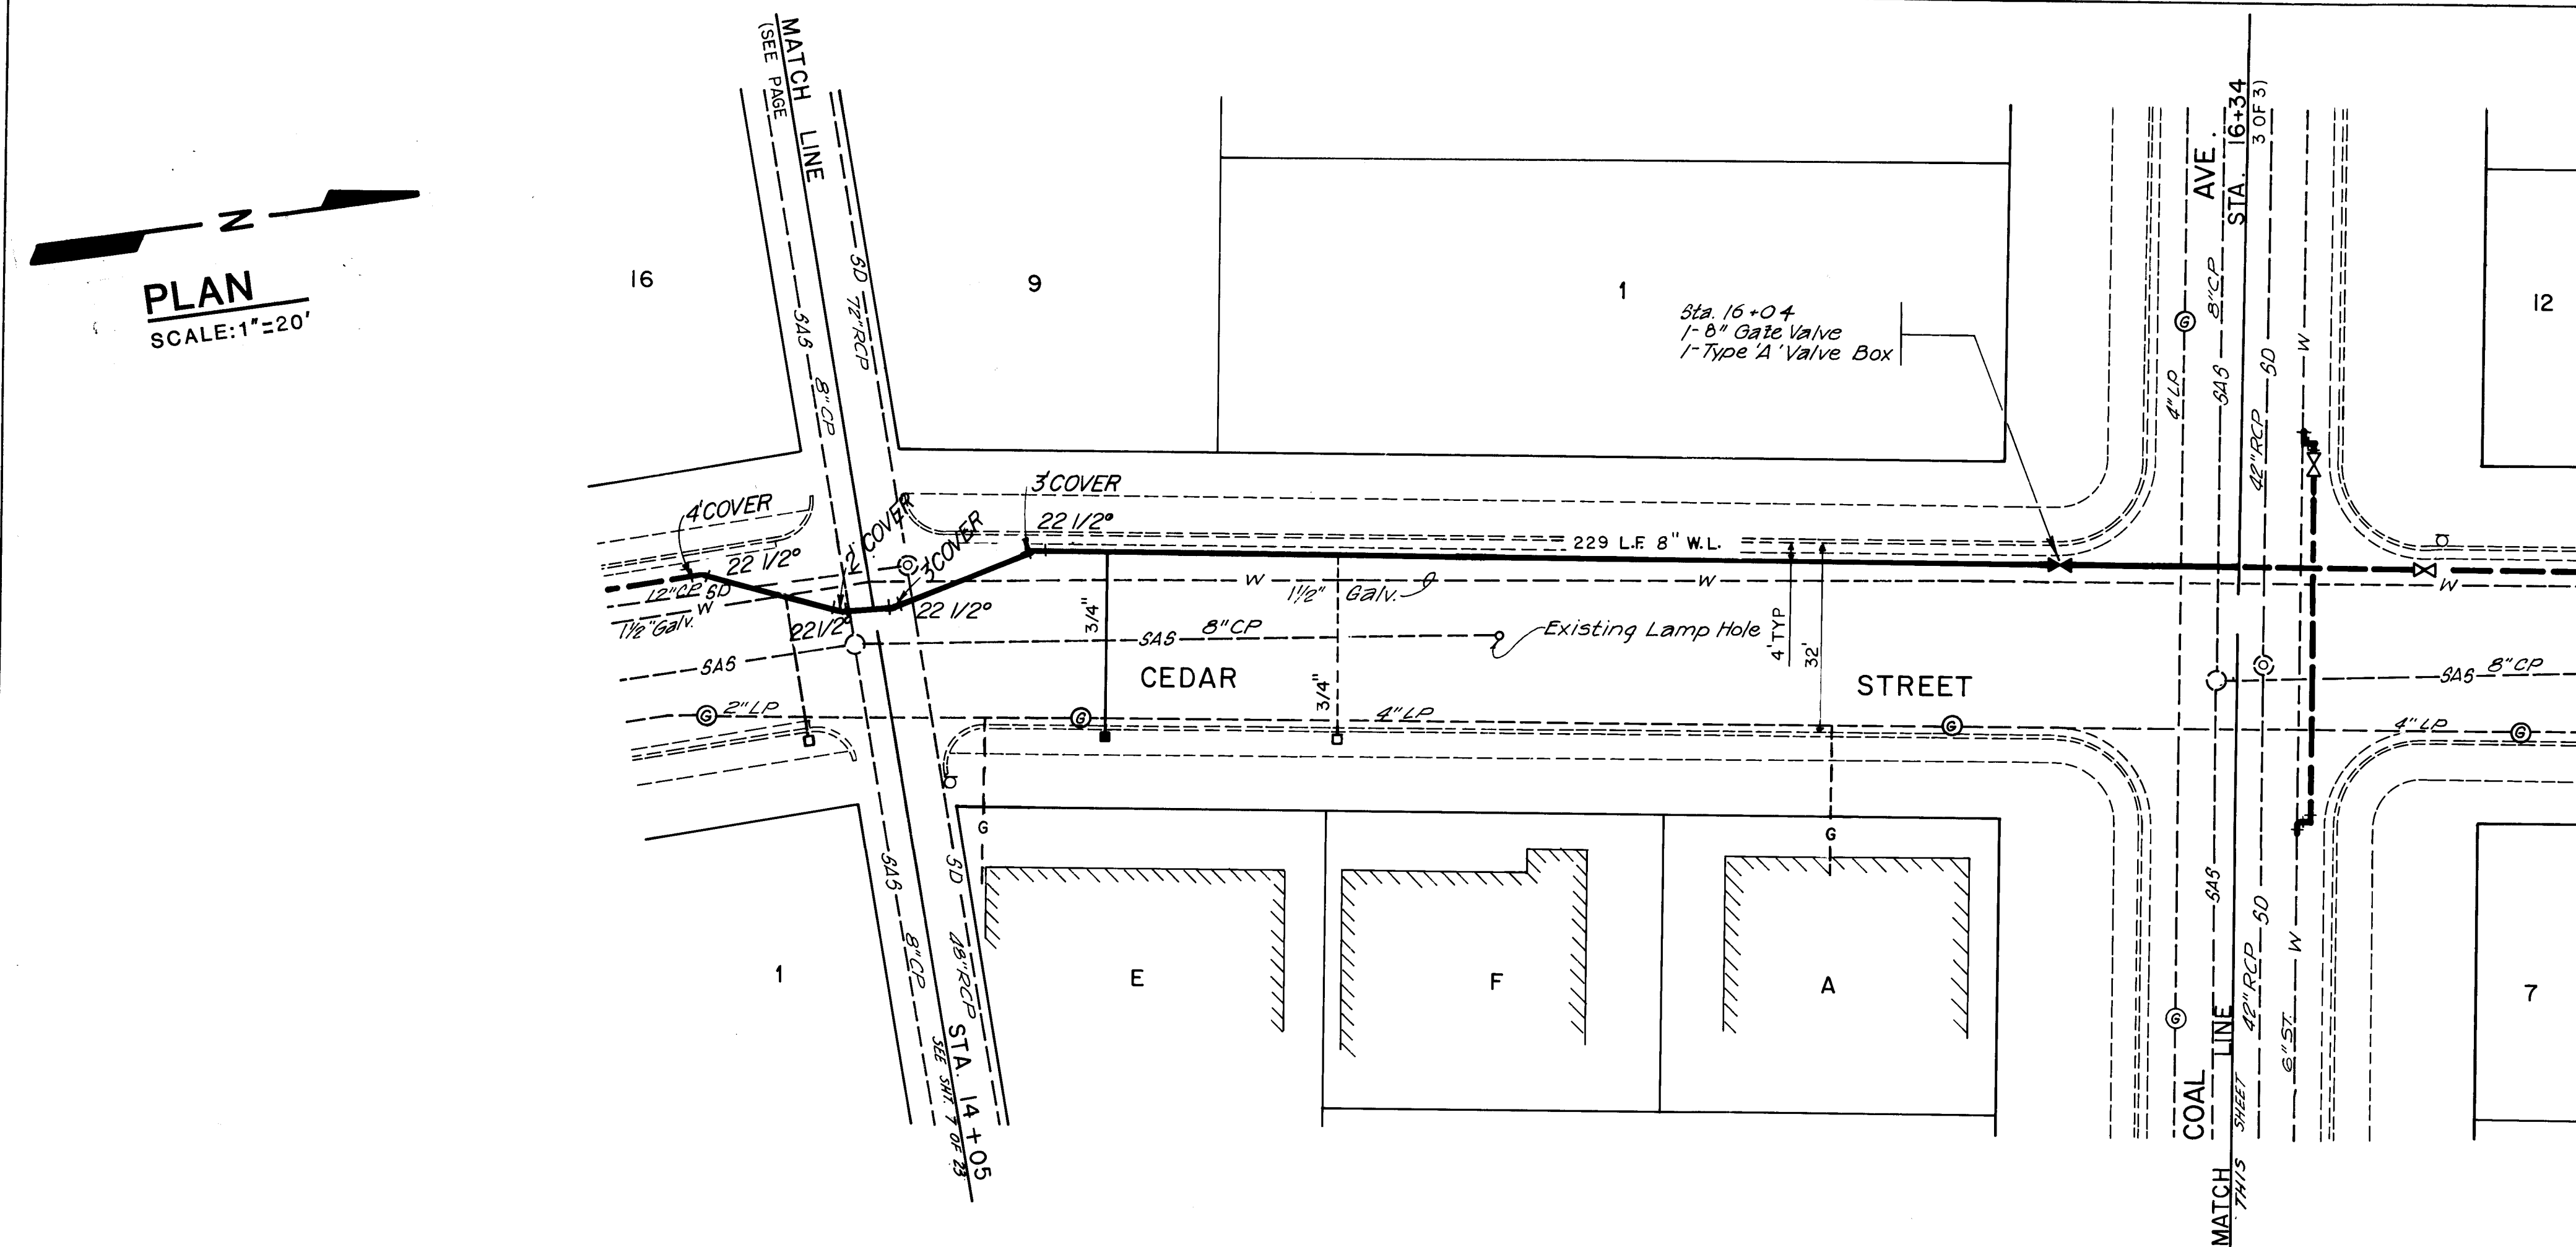

26 17000884

9/6/34

CITY OF ALBUQUERQUE
WATER RESOURCES DEPARTMENT
ENGINEERING DIVISION

TITLE: WATER AND SANITARY SEWER
REPLACEMENTS II
CEDAR STREET

APPROVALS	ENGINEER	DATE	APPROVALS	ENGINEER	DATE
City Engineer			Liquid Waste	James Jernigan	2-11-83
A.C.E.-Design	<i>Michael</i>	11/16/83	Traffic	N.A. 2247	
A.C.E.-Hydrology			Water	James Jernigan	2-11-83

DRAWING (WRD-82.15.8)
NO. 1700

MAP NO.
K15


SHEET 8 OF 23

AS BUILT INFORMATION	
CONTRACTOR	COOK CONST. CO.
WORK TAKEN BY	COOK
INSPECTOR'S ACCEPTANCE BY	WARD
FIELD	
REPLICATION BY	WARD
CORRECTED BY	WARD
MICRO-FILM INFORMATION	
RECORDED BY	
DATE	1/1/83
DATE	

[illegible][illegible]

ENGINEER'S SEAL

[illegible]

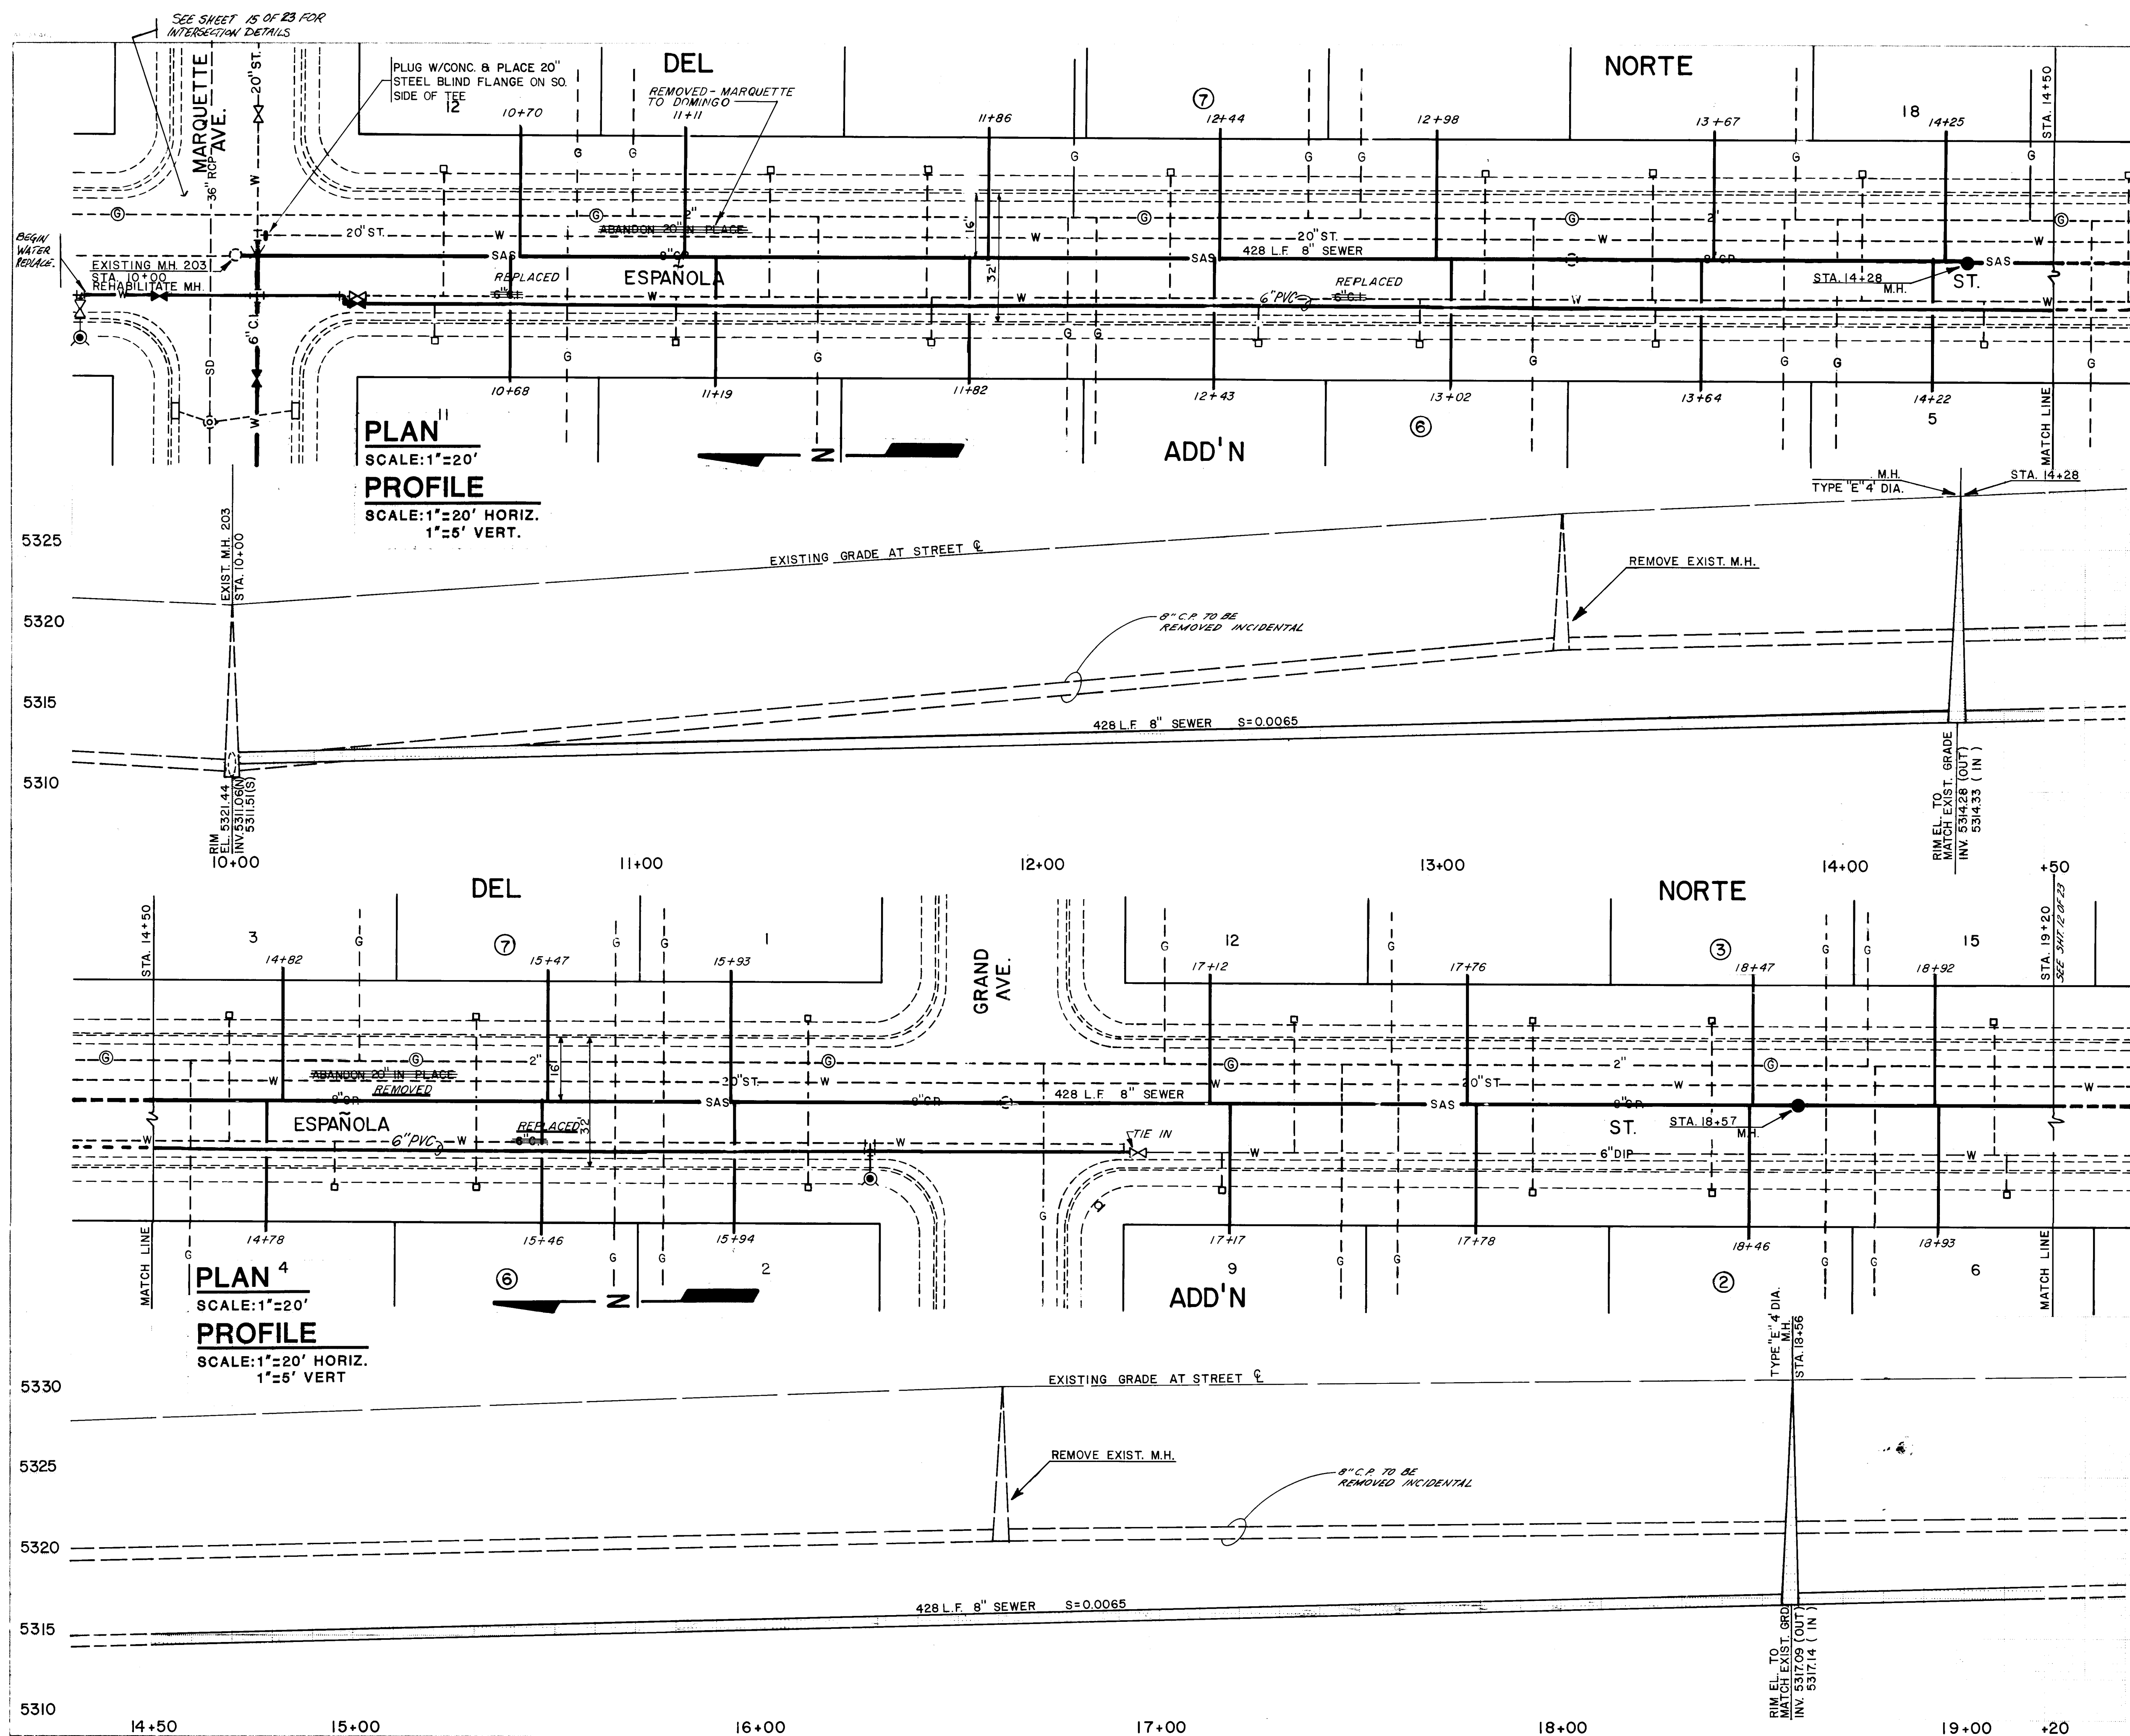

ENGINEER'S SEAL		SURVEY INFORMATION		BENCH MARKS		AS BUILT INFORMATION	
		NO.	BY	DATE	7-K19 LOCATED AT THE INTERSECTION OF CENTRAL AND LOUISIANA ON THE EAST MEDIAN OF THE INTERSECTION 65.5' FROM THE E OF LOUISIANA. ELEV. 5323.31	COOK CONST. CO.	
		REMARKS		DATE	COOK		
		BY		DATE			
NO. DATE		REVISIONS					
		DESIGN					
DESIGNED BY J.E.R.		DATE		SEPT. 82			
DRAWN BY P.E.E.		DATE		SEPT. 82			
CHECKED BY W.F.Z.		DATE		SEPT. 82			

2	6	1	7	0	0	1	1	8	4
---	---	---	---	---	---	---	---	---	---


WATER RESOURCES DEPARTMENT
APPROVED BY AGRICULTURE
Brian L. Smith
Date *7/5/04*

CITY OF ALBUQUERQUE
WATER RESOURCES DEPARTMENT
ENGINEERING DIVISION

TITLE: WATER & SANITARY SEWER
REPLACEMENTS II
ESPAÑOLA ST.

APPROVALS	ENGINEER	DATE	APPROVALS	ENGINEER	DATE
City Engineer			Liquid Waste	James J. Jannille	3-11-83
A.C.E. Design	<i>J. Kellard</i>	4/11/83	Traffic	<i>H.A. N.A.</i>	
A.C.E. Hydrology			Water	James J. Jannille	3-11-83

DRAWING (WRD 82.15.11) NO. 1700	MAP NO. K19	SHEET 11 OF 23
------------------------------------	----------------	----------------

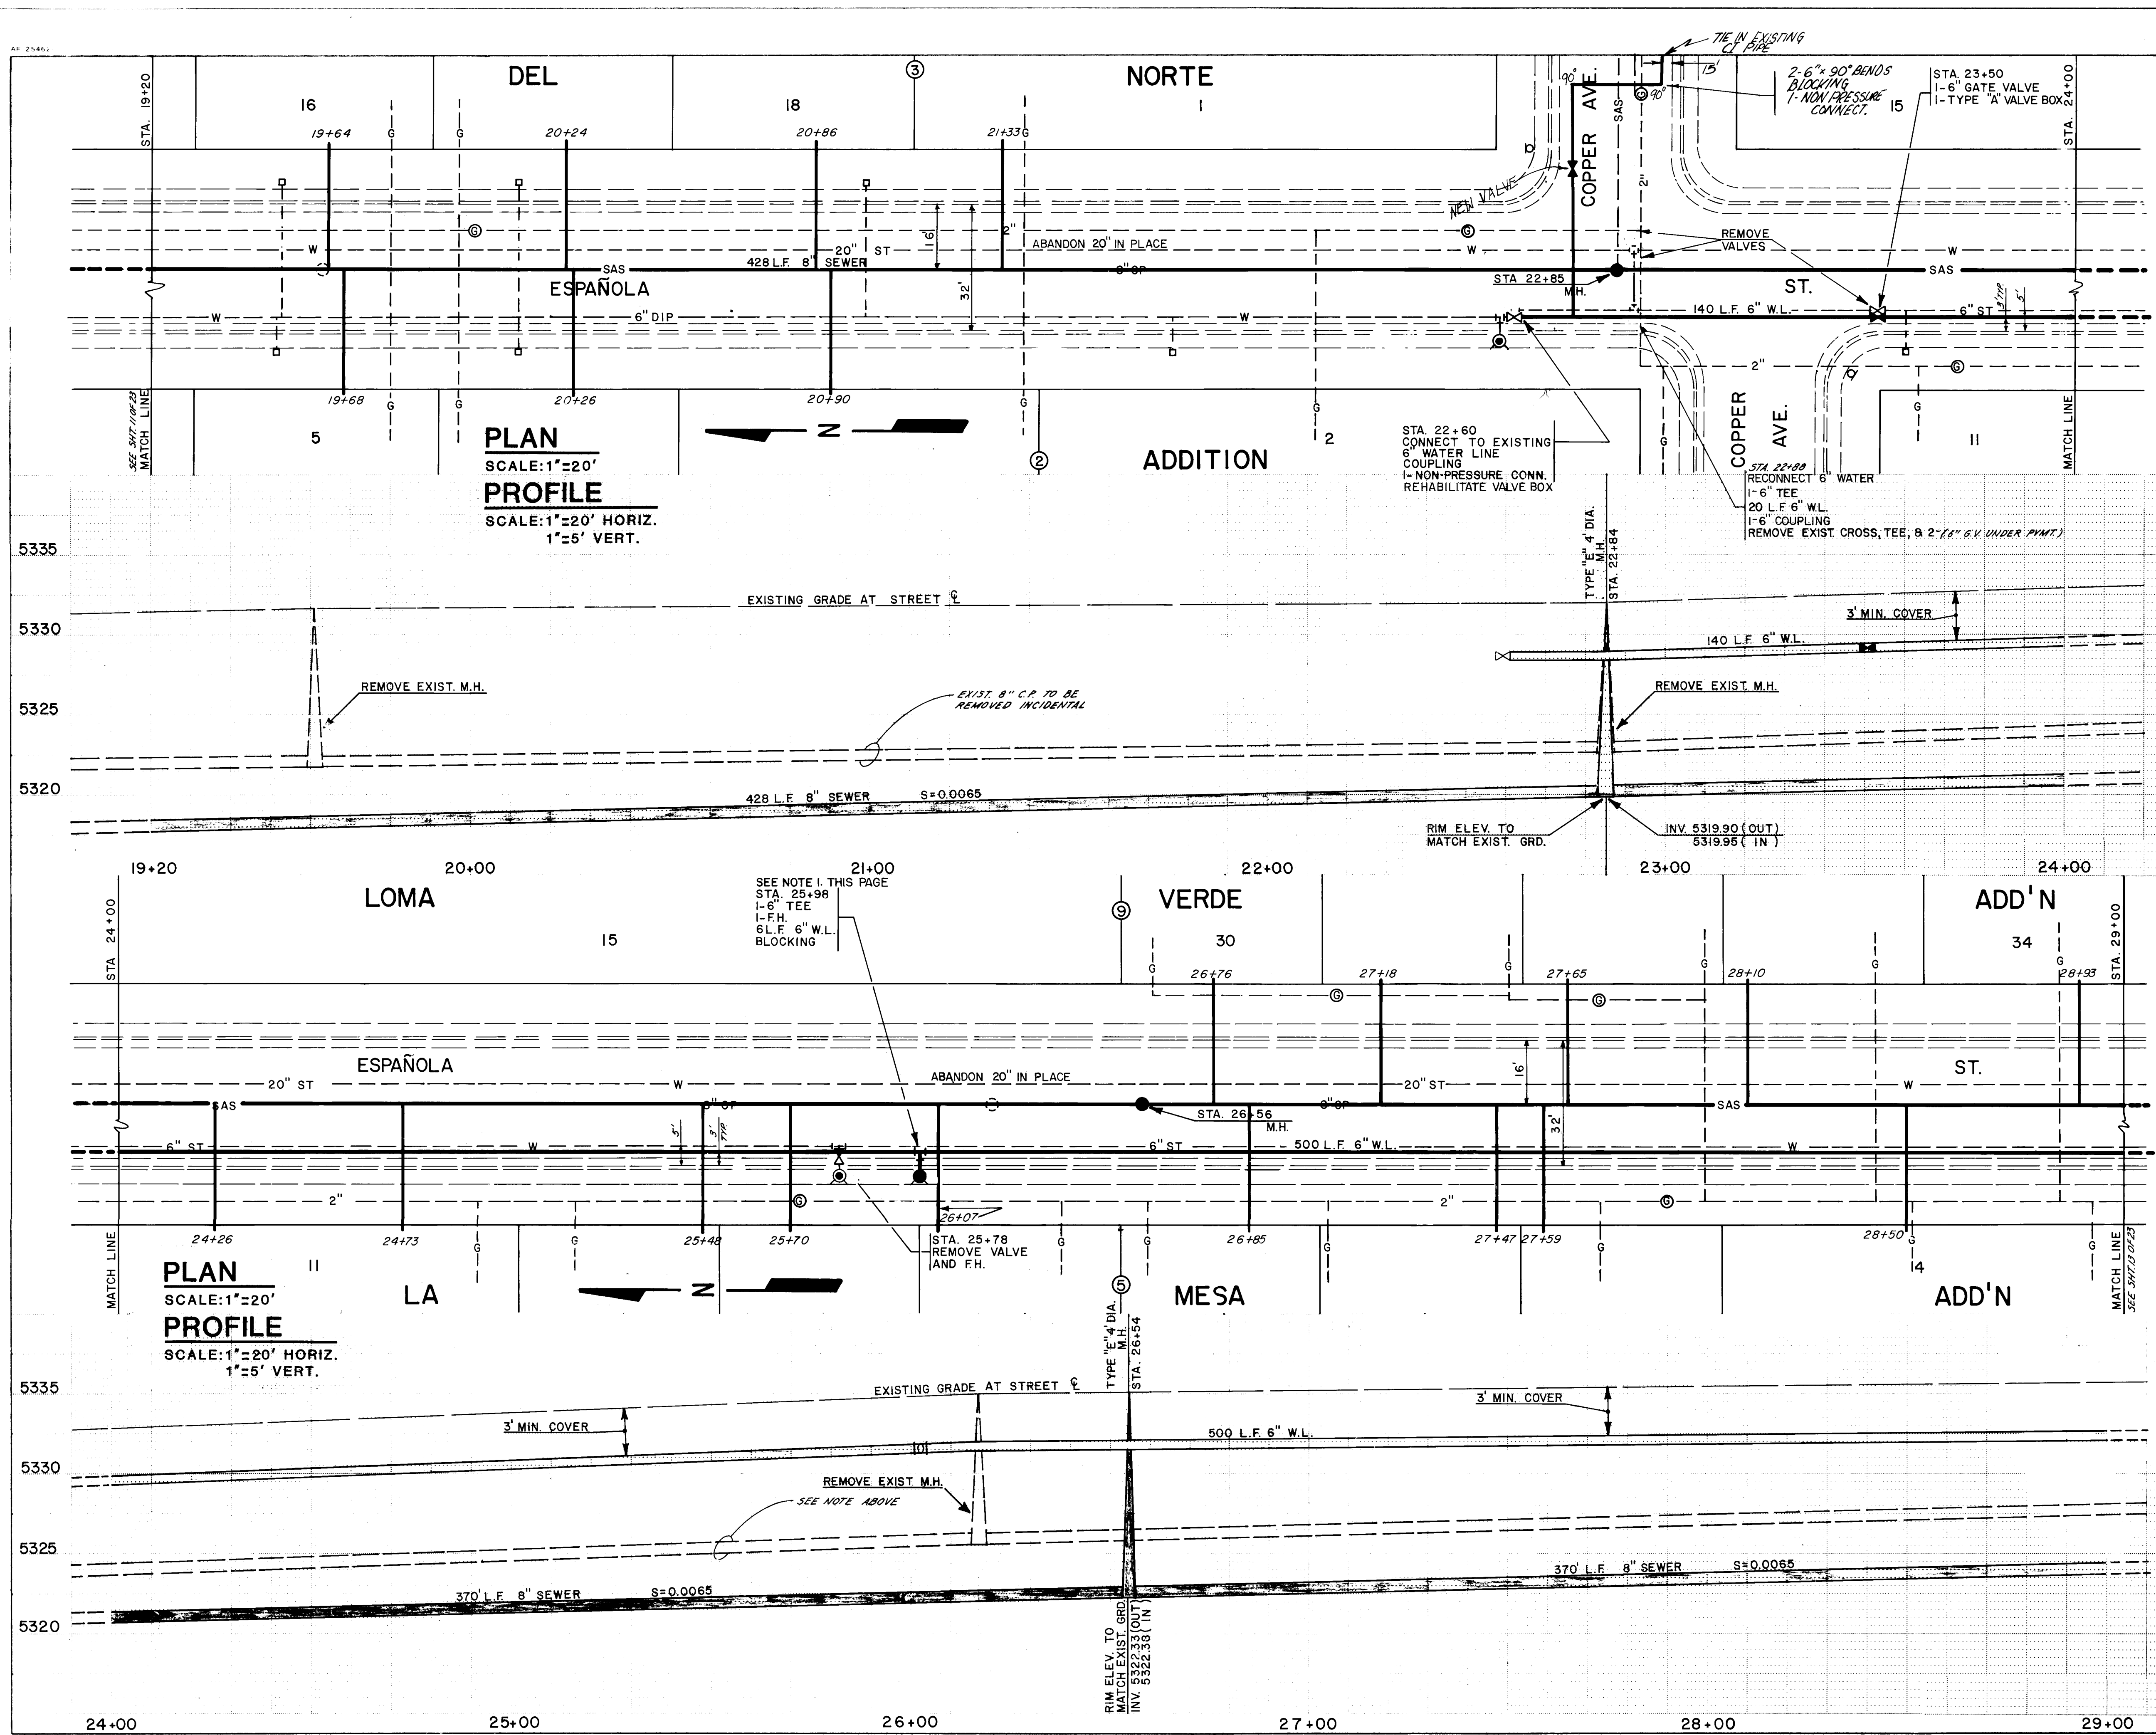

NOTES

1) IF THE HYDRANT AT STA. 25 + 78 HAS A MECHANICAL JOINT SHOE AND IS WORKING PROPERLY (AS DETERMINED BY LINE MAINTENANCE, WATER SYSTEMS DIVISION), THIS HYDRANT SHALL BE RELOCATED TO STA. 25 + 98 INSTEAD OF INSTALLING A NEW HYDRANT AS SHOWN.

AS BUILT INFORMATION

7-K19 LOCATED AT THE INTERSECTION OF CENTRAL AND LOUISIANA ON THE EAST MEDIAN OF THE INTERSECTION 655' FROM THE E. OF LOUISIANA. ELEV. 5323.31.

ENGINEER'S SEAL

Professional Engineer Seal for James J. Joplin, State of New Mexico, No. 4851.

REVISIONS

NO.	DATE	REMARKS
1	7-5-82	DESIGN

CITY OF ALBUQUERQUE
WATER RESOURCES DEPARTMENT
ENGINEERING DIVISION


TITLE: WATER & SANITARY SEWER REPLACEMENTS II
ESPAÑOLA ST.

APPROVALS	ENGINEER	DATE	APPROVALS	ENGINEER	DATE
City Engineer			Liquid Waste	James Joplin	8-11-83
A.C.E. - Design			Traffic	N.A. Joplin	
A.C.E. - Hydrology			Water	James Joplin	8-11-83

DRAWING (WRD 82.15.12)
NO. 1700


MAP NO.
K-19

SHEET 12 OF 23

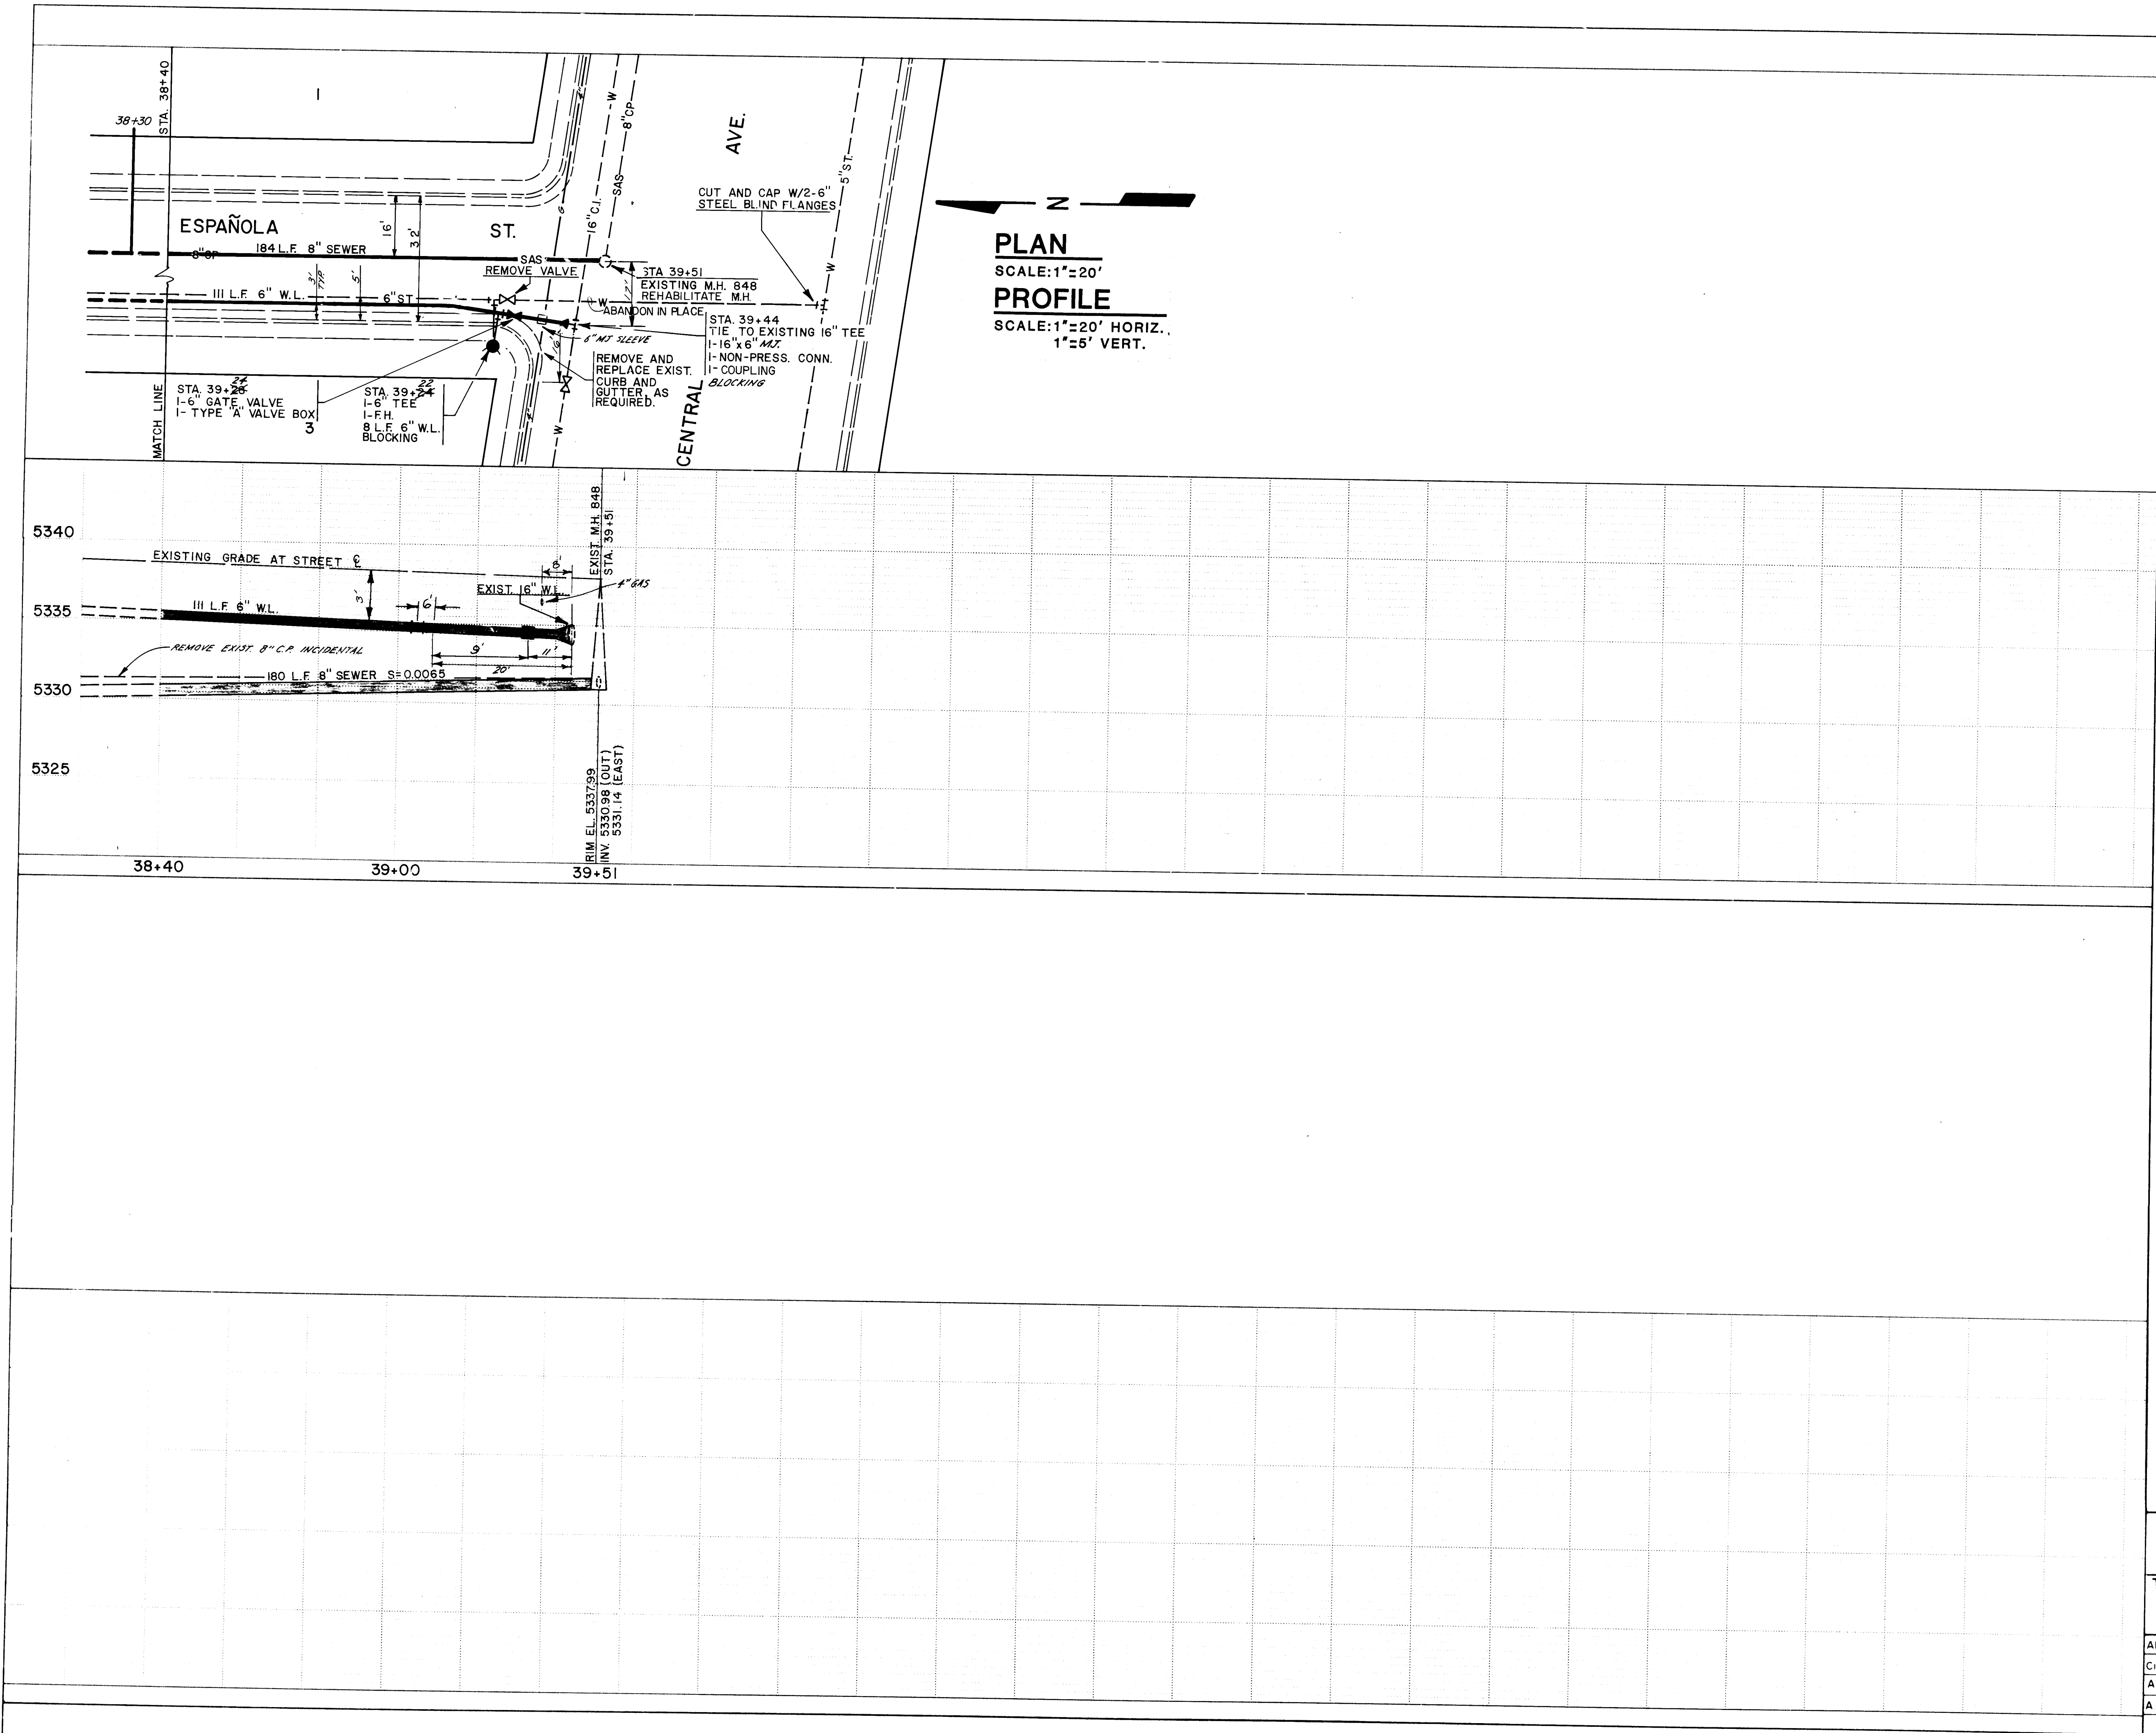

26 1 001 54

Ben L. Spaul
9/6/82




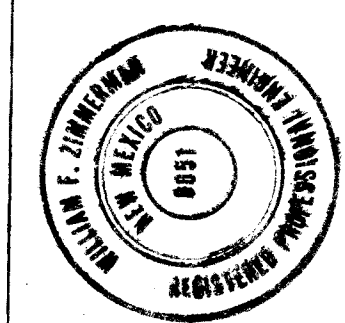
ENGINEER'S SEAL			SURVEY INFORMATION		BENCH MARKS		AS BUILT INFORMATION	
			FIELD NOTES		7-K19 LOCATED AT THE INTERSECTION OF CENTRAL AND LOUISIANA ON THE EAST MEDIAN OF THE INTERSECTION SECTION 65.5' FROM THE C. OF LOUISIANA. ELEV. 5323.31		COOK CONST. CO.	
			NO.	BY	DATE	DATE		
REVISIONS			REMARKS		DATE <td colspan="2">DATE</td>		DATE	
DESIGNED BY			JER.		DATE		DATE	
DRAWN BY			JER.		DATE		DATE	
CHECKED BY			W.F.Z.		DATE		DATE	

CITY OF ALBUQUERQUE
WATER RESOURCES DEPARTMENT
ENGINEERING DIVISION

TITLE: WATER & SANITARY SEWER REPLACEMENTS II
ESPANOLA ST.

APPROVALS	ENGINEER	DATE	APPROVALS	ENGINEER	DATE
City Engineer			Liquid Waste	James Aguilera	3/1/83
A.C.E. - Design	<i>[Signature]</i>	11/14/82	Traffic	<i>[Signature]</i>	
A.C.E. - Hydrology			Water	James Aguilera	2/1/83

DRAWING (WRD 82.15.14) NO. 1700 MAP NO. K-19 SHEET 14 OF 23

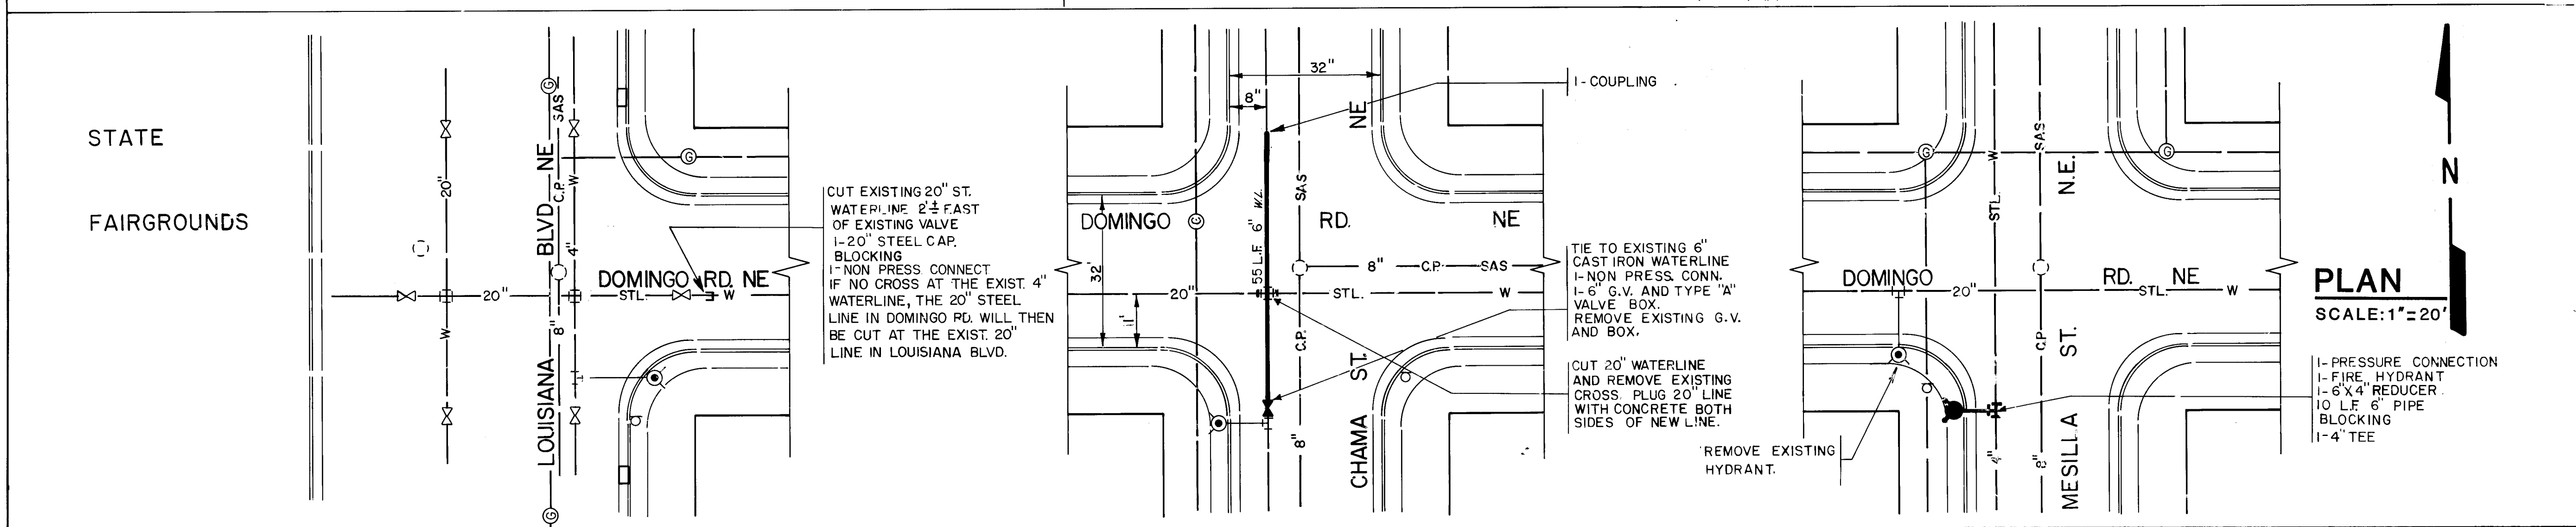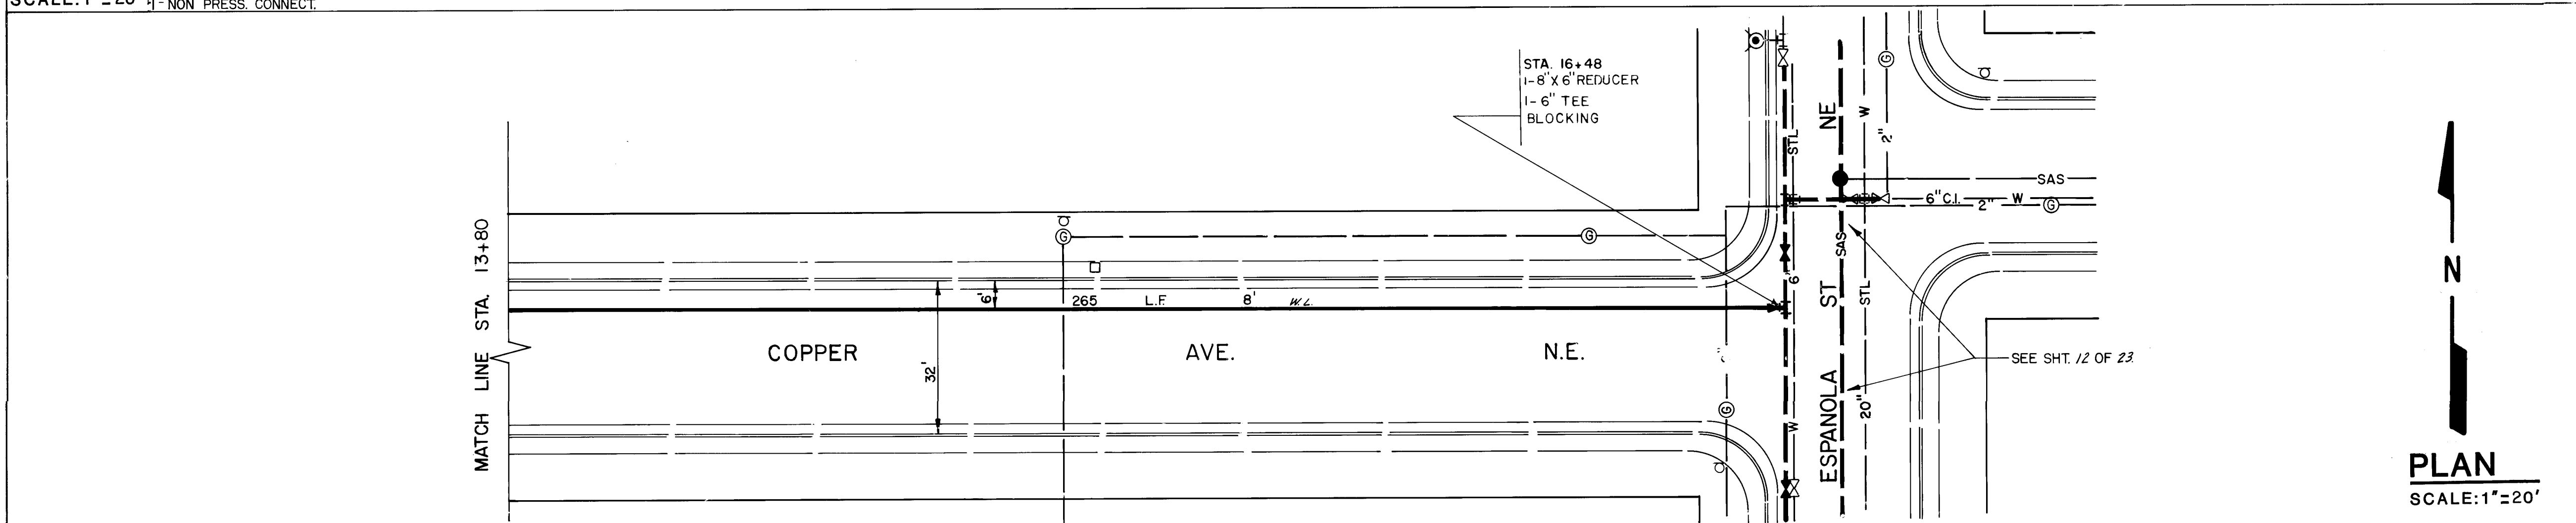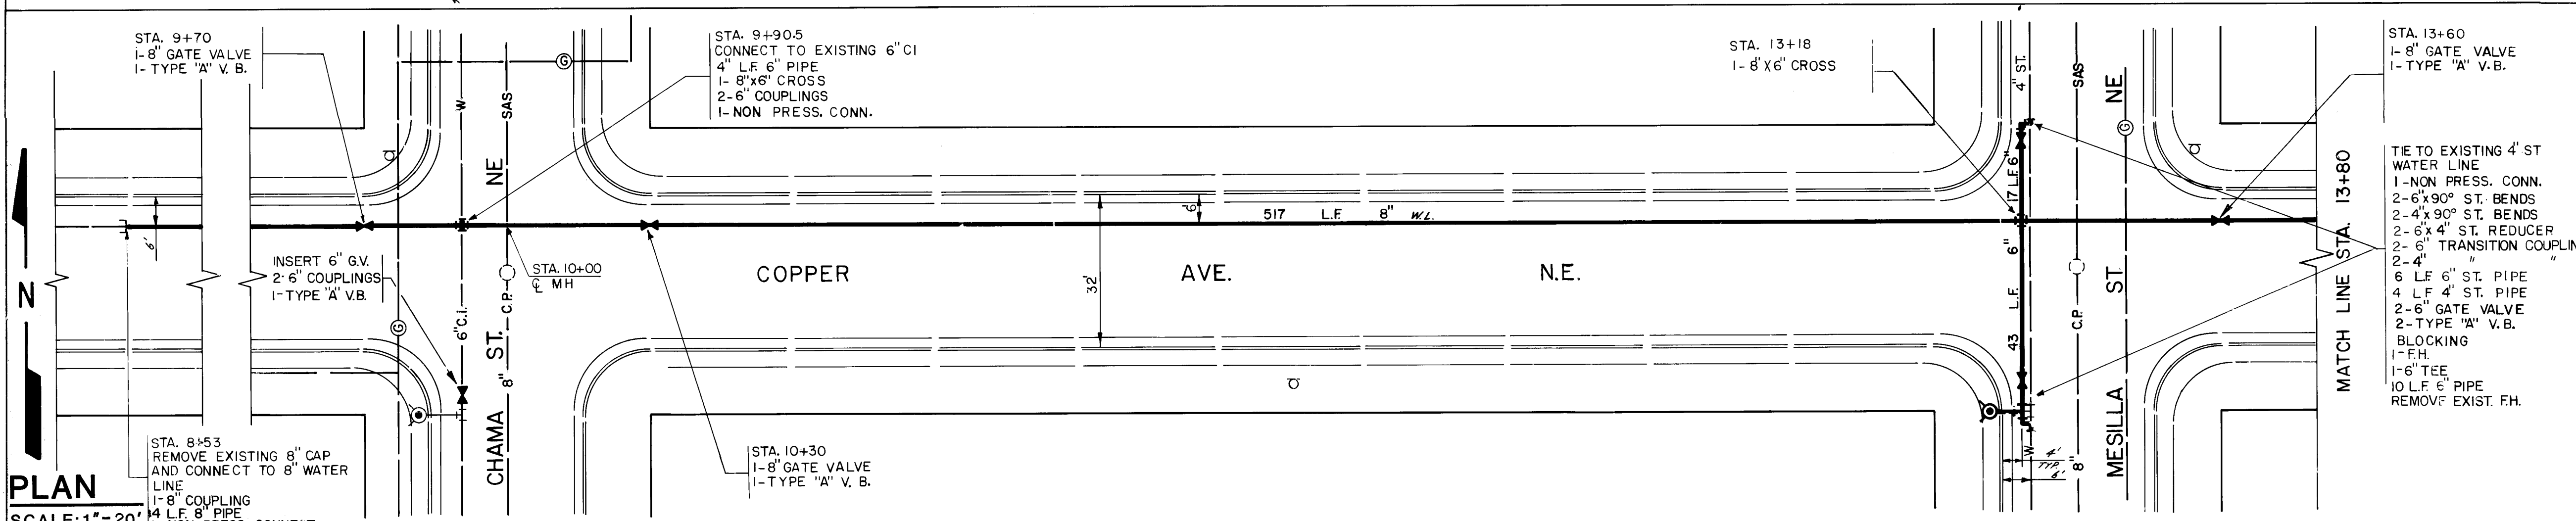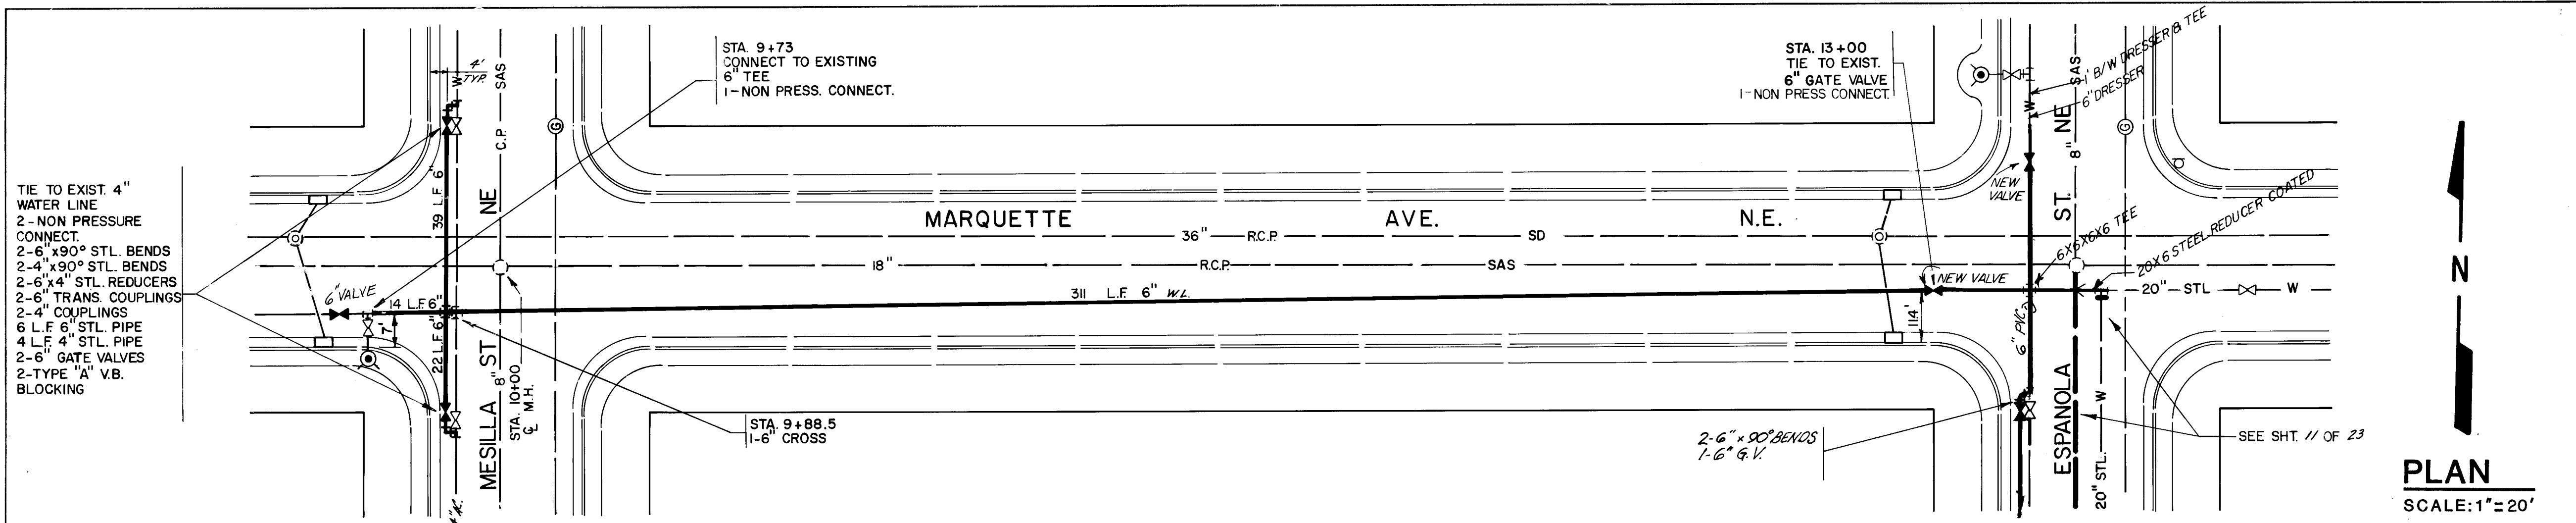

TRAFFIC CONTROL NOTE

Construction in the La Mesa and Del Norte additions will be subject to some restrictions due to the proximity to the State Fairgrounds and other construction in the area. The contractor shall submit a detailed construction schedule and traffic control plan for approval of the Project Engineer and City Traffic Engineer prior to any work in that area. This work will be incidental to the project and no separate payment shall be made.

AS BUILT INFORMATION				BENCH MARKS				SURVEY INFORMATION				ENGINEER'S SEAL				
NO.	DATE	BY	REMARKS	NO.	DATE	BY	REMARKS	NO.	DATE	BY	REMARKS	NO.	DATE	BY	REMARKS	
1	11/11/83	WPD	FIELD	7-K19	LOCATED AT THE INTERSECTION OF CENTRAL & LOUISIANA ON THE EAST MERIDIAN OF THE INTERSECTION 65.5' FROM THE C. OF LOUISIANA. ELEV. 5323.31											
2																
3																
NOTE

The existing 20" steel waterline shall be abandoned and filled with a sand slurry in Domingo Road from Louisiana Blvd. to Espanola Street. The sand slurry, if possible, shall be pumped into the line at locations where other work is being done.


**CITY OF ALBUQUERQUE
WATER RESOURCES DEPARTMENT
ENGINEERING DIVISION**

**TITLE: WATER & SANITARY SEWER REPLACEMENTS II
MARQUETTE AVE., COPPER AVE., DOMINGO RD.**

APPROVALS	ENGINEER	DATE	APPROVALS	ENGINEER	DATE
City Engineer			Liquid Waste	JAMES J. JENNIFER	3-11-83
A C E - Design			Traffic	N. A. JENNIFER	3-11-83
A C E - Hydrology			Water	JAMES J. JENNIFER	3-11-83



**DRAWING (WRD 82.15.15)
NO. 1700**

MAP NO. K-19 SHEET 15 OF 23

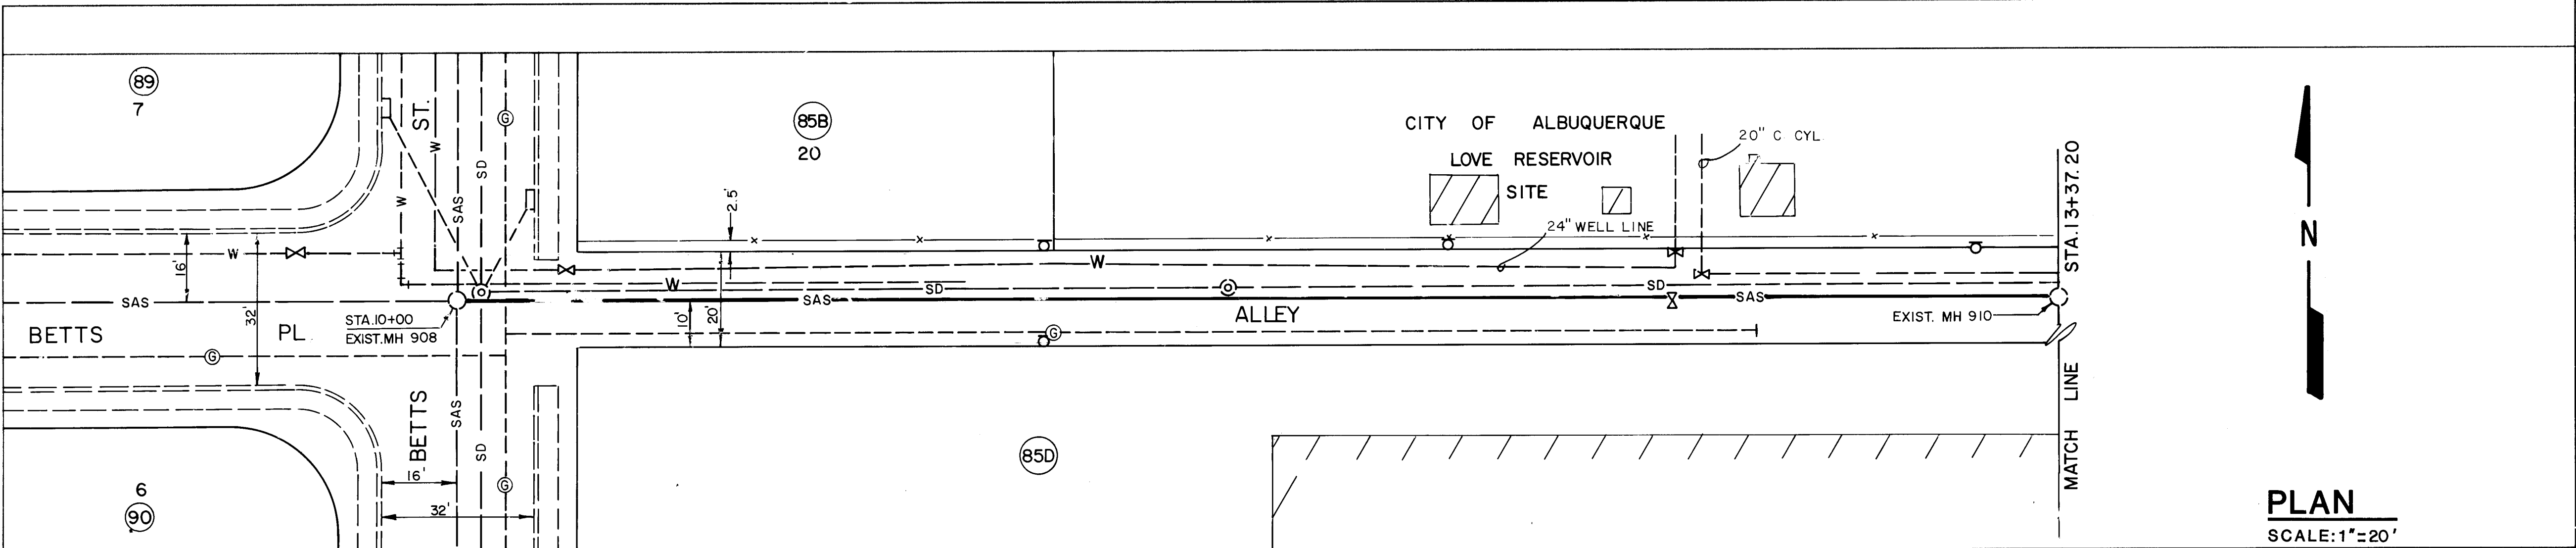


PLAN
SCALE: 1"=20'

PROFILE
SCALE: 1"=20' HORIZ.
1"=5' VERT.

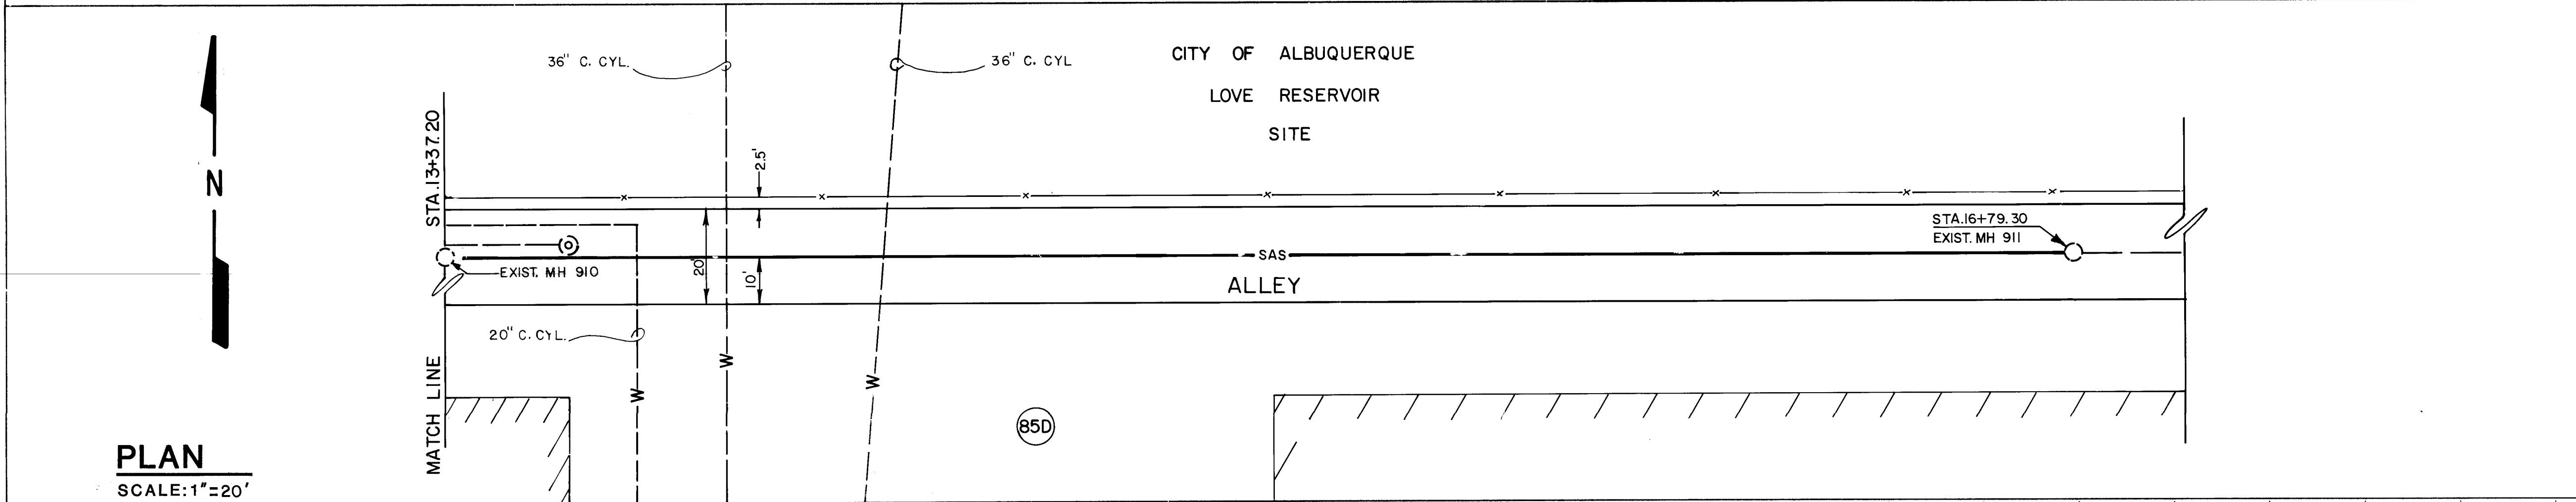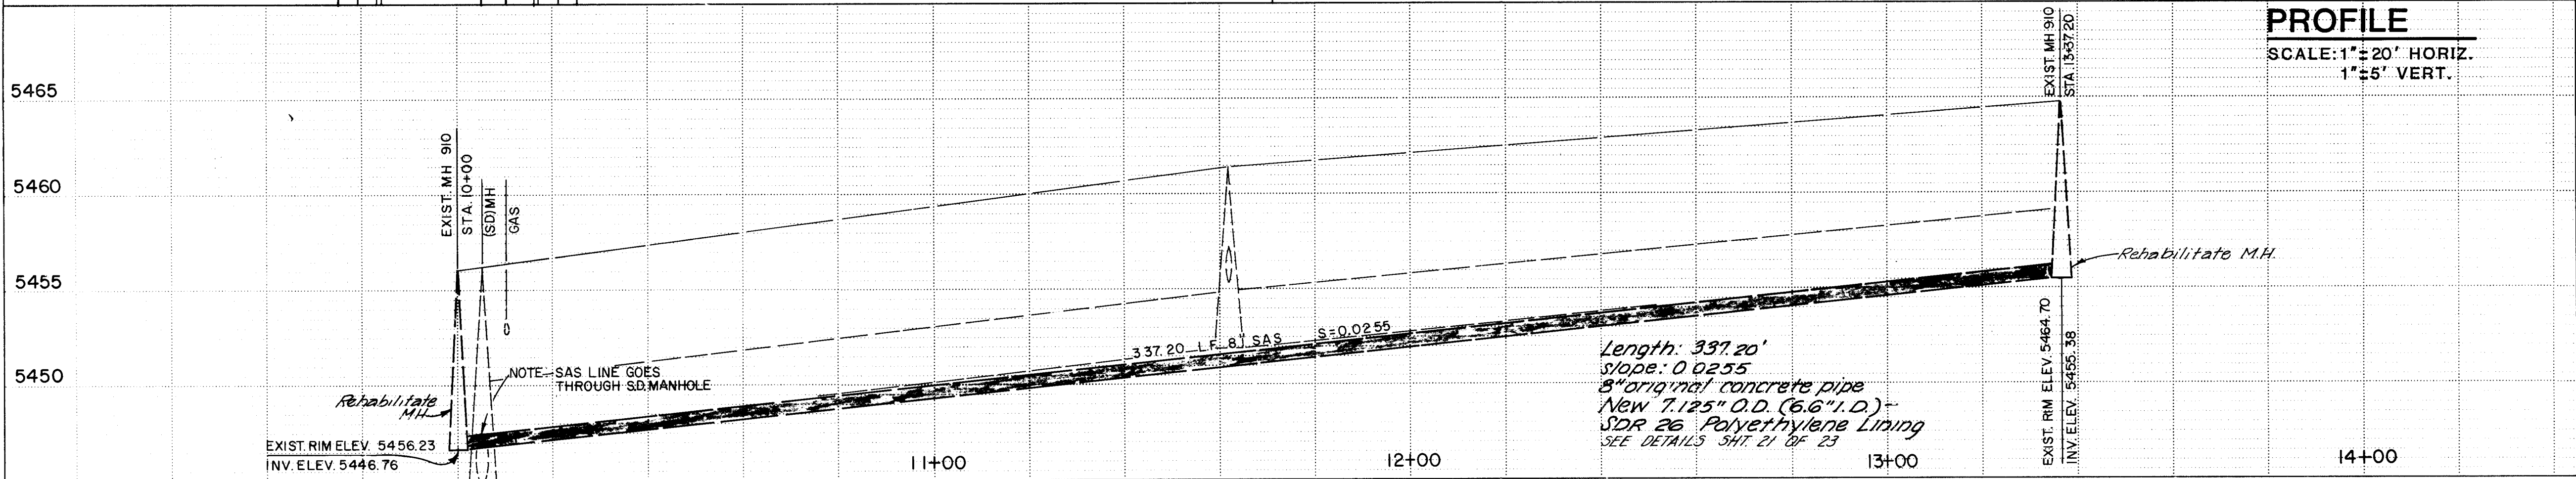

PLAN
SCALE: 1"=20'

PROFILE
SCALE: 1"=20' HORIZ.
1"=5' VERT.

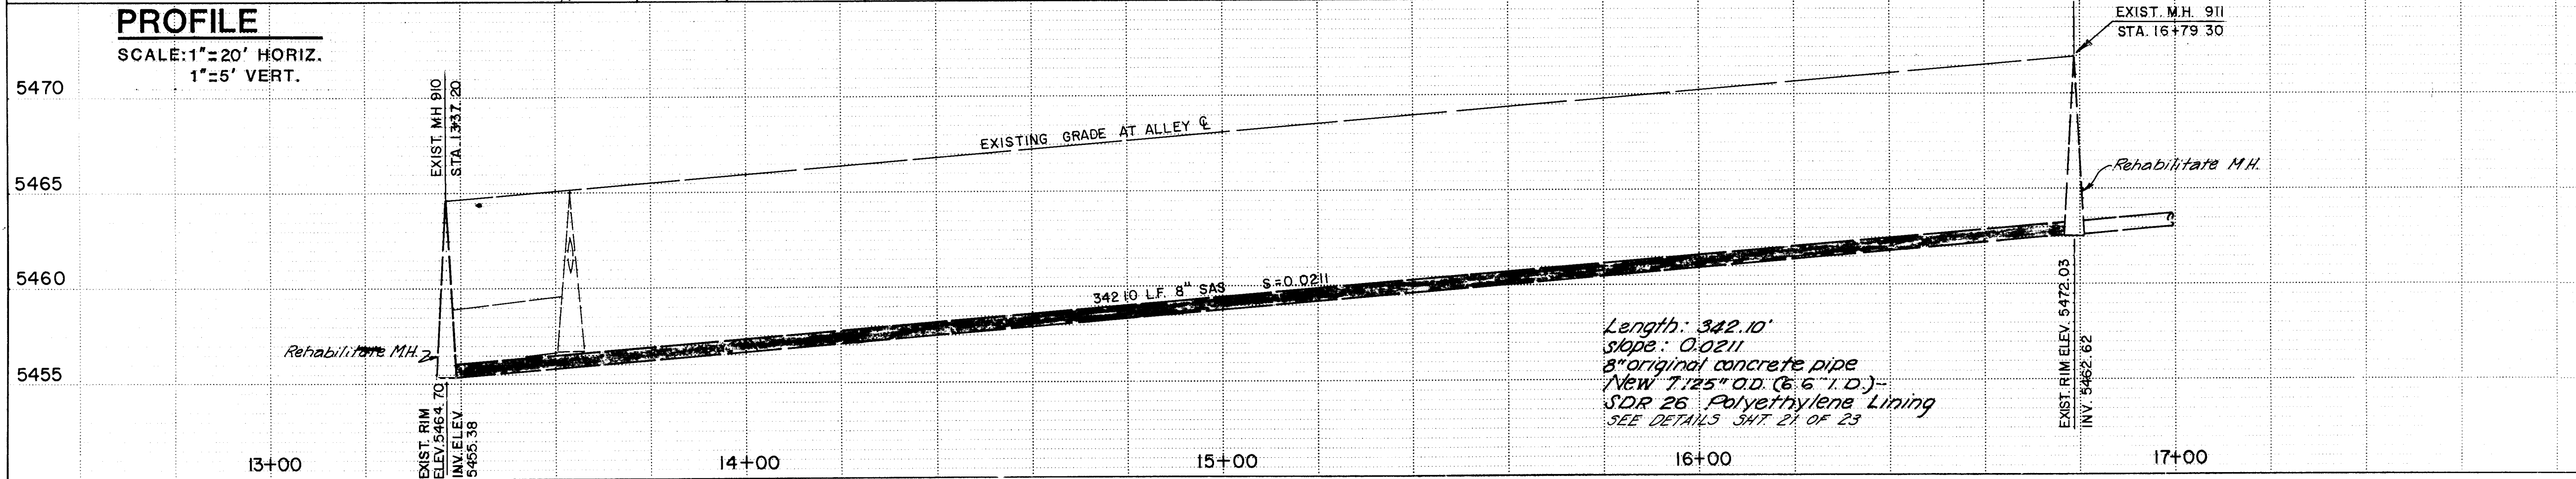


NOTE:
The location of water lines within the alley are drawn from the best information available. However, the information has been conflicting and the locations shown are approximate. Contractor should exercise extreme caution. All lines should be verified in the field before further construction.

AS BUILT INFORMATION				BENCH MARKS				SURVEY INFORMATION				ENGINEER'S SEAL			
CONTRACT NO.	2004-0001	DATE	3/1/83	2-121	LOCATED AT THE INTERSECTION OF LOMAS BLVD AND MORRIS ST. NE, IN THE NE QUADRANT OF THE INTERSECTION. A SQUARE CHISELED ON TOP OF CONCRETE CURB AT ENE CURB RETURN.	DATE	3/1/83	NO.	BY	DATE					
WORK	CONTRACT	DATE	3/1/83	INTERSECTION	DATE	3/1/83	DATE	DATE	DATE	DATE					
FIELD	DATE	DATE	DATE	DATE	DATE	DATE	DATE	DATE	DATE	DATE		NO.	DATE	REMARKS	BY
CORRECTED BY	DATE	DATE	DATE	DATE	DATE	DATE	DATE	DATE	DATE	DATE		DESIGNED BY	DATE	DATE	DATE
RECORDED BY	DATE	DATE	DATE	DATE	DATE	DATE	DATE	DATE	DATE	DATE		DRAWN BY	DATE	DATE	DATE
												CHECKED BY	DATE	DATE	DATE

26 17 00 1684

Ben J Spiller
3.1.83

CITY OF ALBUQUERQUE WATER RESOURCES DEPARTMENT ENGINEERING DIVISION					
TITLE: WATER & SANITARY SEWER REPLACEMENTS II BTW. MHS 908 & 911 ALLEY BETWEEN BETTS AND MORRIS					
APPROVALS	ENGINEER	DATE	APPROVALS	ENGINEER	DATE
City Engineer			Liquid Waste	James J. Spiller	3/1/83
A C E - Design	Ben J Spiller	11/10/83	Traffic	N.A. Spiller	
A C E - Hydrology			Water	James J. Spiller	3/1/83


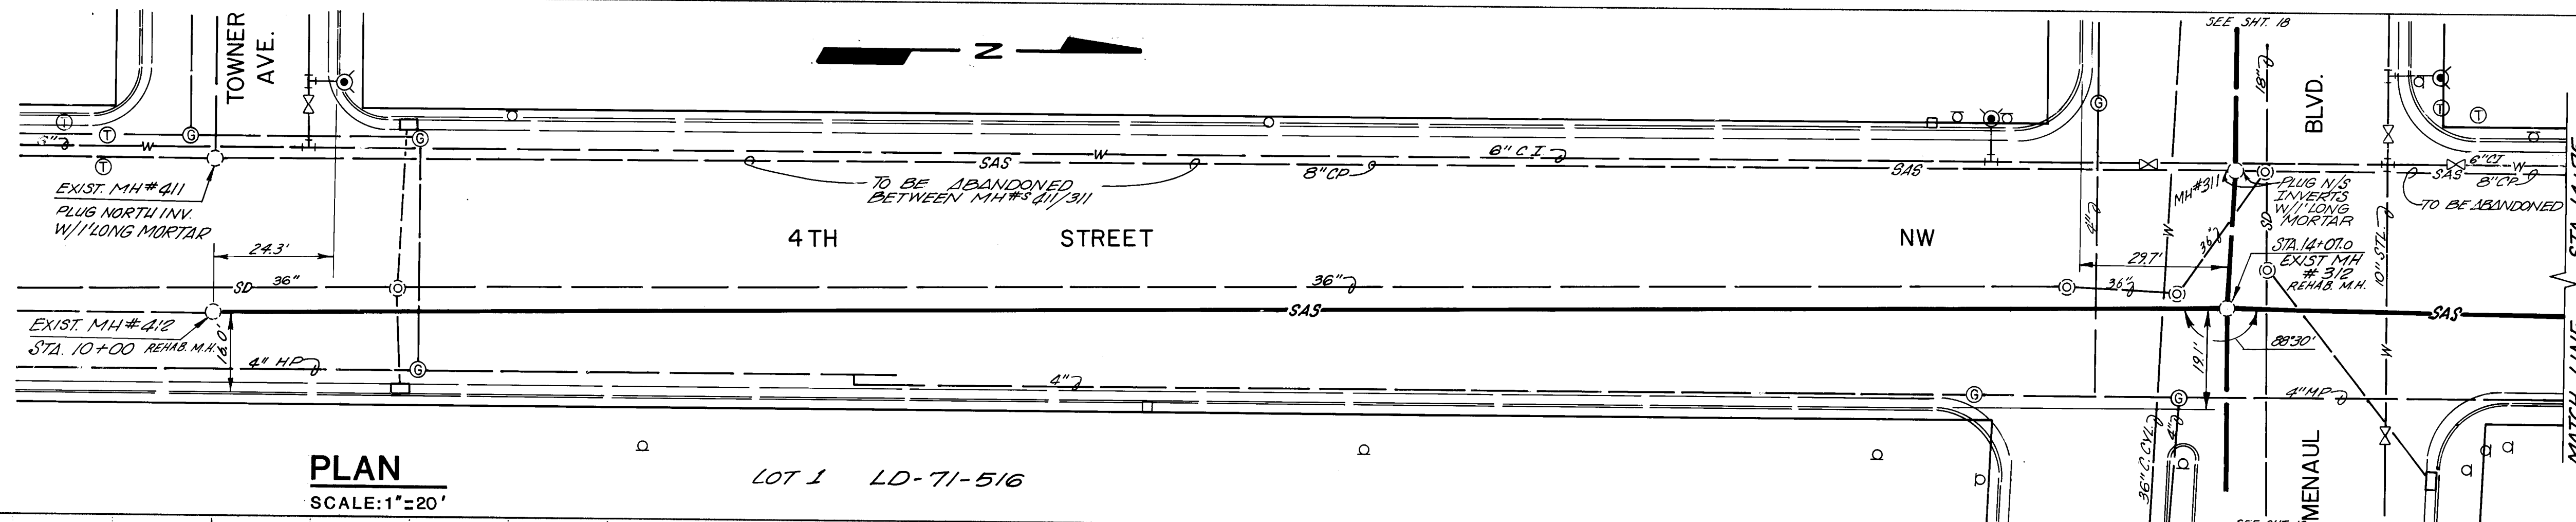


PLAN

SCALE: 1"=20'

PROFILE

SCALE: 1"=20' HORIZ.
1"=5' VERT.

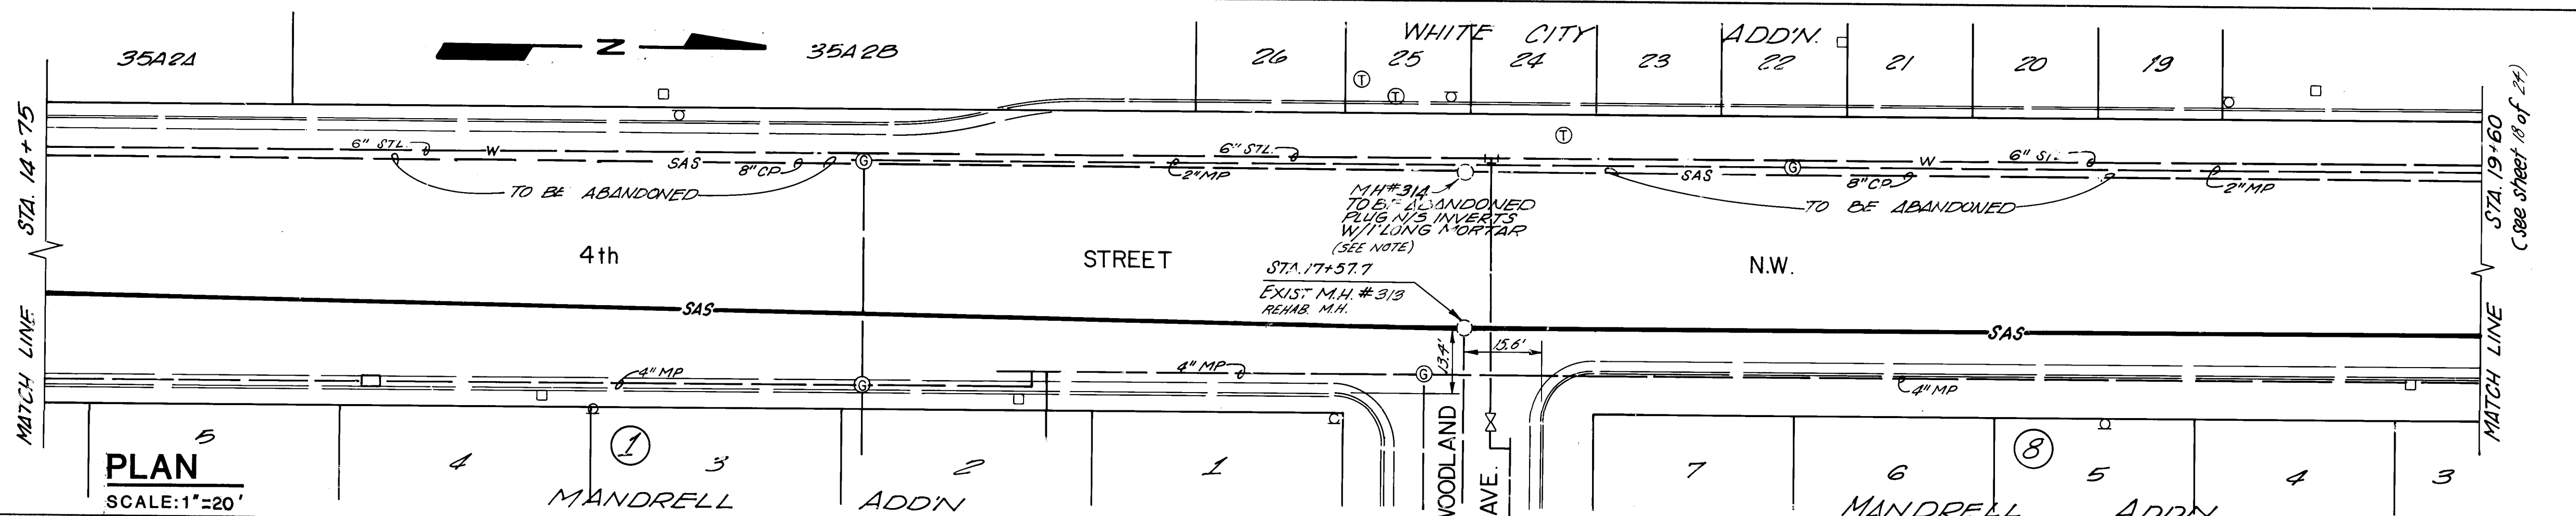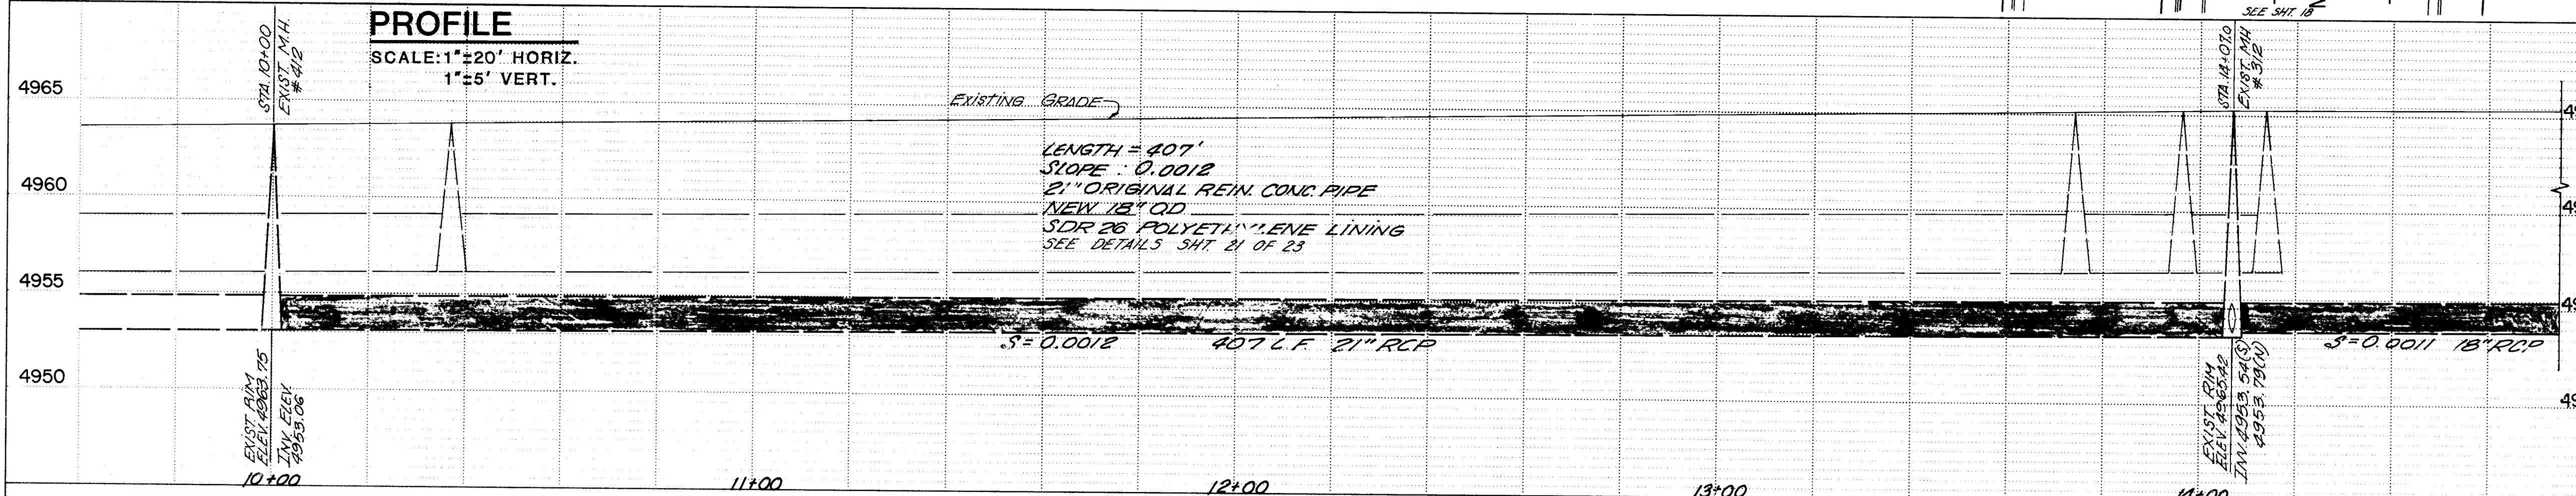


PLAN

SCALE: 1"=20'

PROFILE

SCALE: 1"=20' HORIZ.
1"=5' VERT.

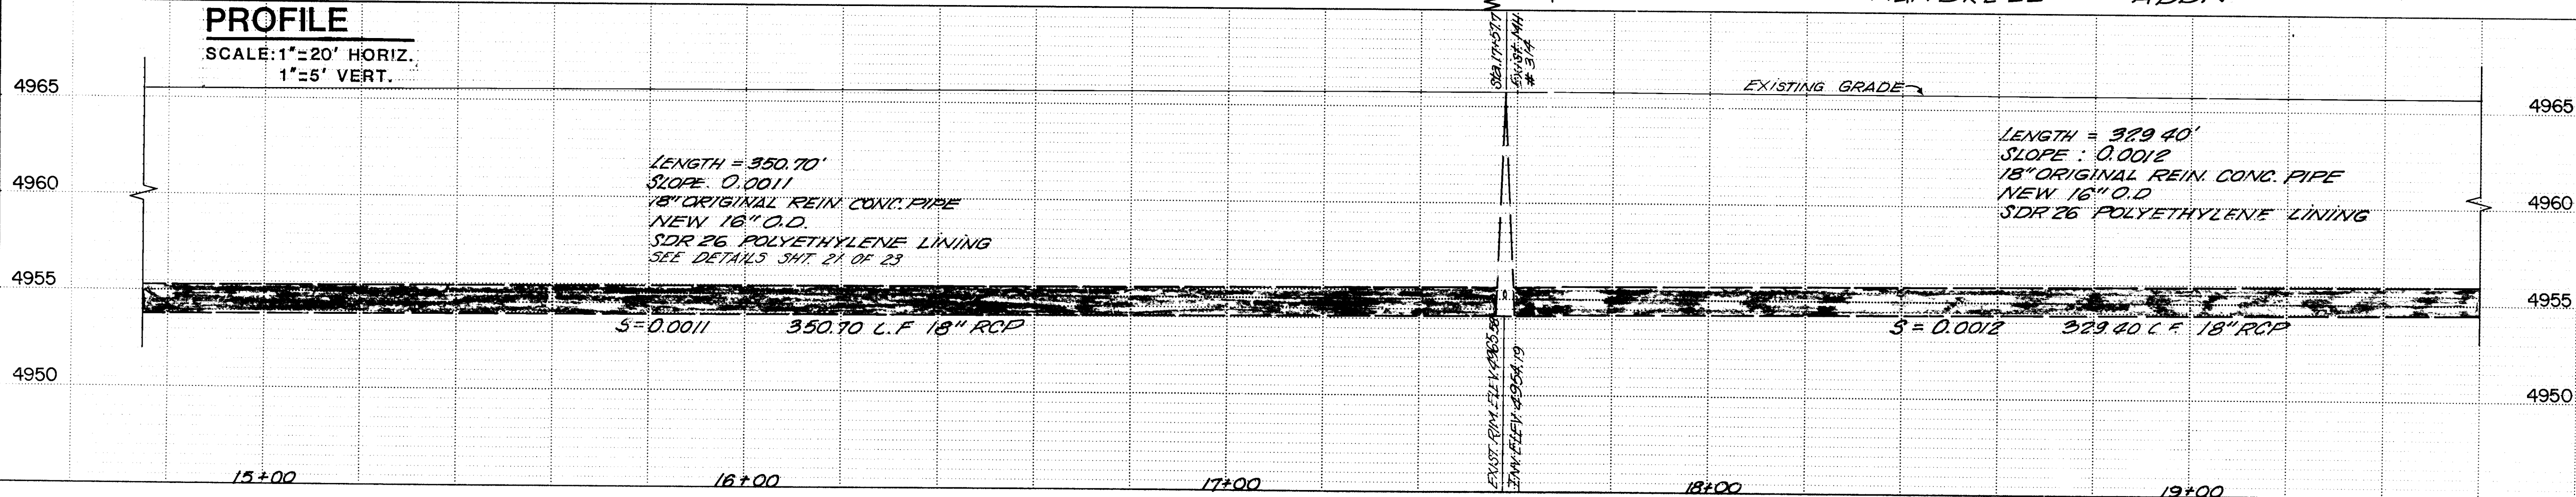

NOTES:

The insertion pit for installing liner pipe in 4th street shall not be placed within the 4th and Menaul intersection.

Any and all dewatering shall be considered incidental to the project and no separate payment shall be made.

MANHOLES TO BE ABANDONED IN PLACE SHALL HAVE THE FOLLOWING WORK DONE:

- ALL INGOING AND OUTGOING LINES SHALL BE PLUGGED WITH 12" CONCRETE MORTAR.
- MANHOLE LID AND FRAME SHALL BE RETURNED TO CITY YARDS.
- MANHOLE BOTTOM WILL BE PULVERIZED AND MANHOLE FILLED TO RIM WITH CEMENT TREATED BASE MATERIAL.
- SANITARY SEWER SERVICES SHALL BE RECONNECTED FROM THE ABANDONED SEWER LINE TO THE NEW LINE.

AS BUILT INFORMATION			BENCH MARKS			SURVEY INFORMATION			ENGINEER'S SEAL		
CONTRACTOR	DATE	BY	BM 4-H14	DATE	BY	FIELD NOTES	DATE	BY	NO.	DATE	BY
COOK CONST CO			BM 4-H14 LOCATED AT THE INTERSECTION OF 4TH & MENAUL N.W. IN THE SE. QUADRANT OF THE INTERSECTION. A SQUARE [X] CHISELED ON TOP OF CONC. CURB AT THE CURB RETURN. ELEV. = 4965.49								

26 17001784

Burn 1 Spent
9/6/84

TRAFFIC CONTROL NOTES

In order to minimize the disruption of traffic construction in and around the intersection of 4th and Menaul will be subject to some restrictions. It may, then, be necessary for portions of that work to be conducted at night or on a weekend. The contractor shall submit a detailed construction schedule and traffic control plan for approval of the Project Engineer and City Traffic Engineer prior to any work in that area. This work will be incidental to the project and no separate payment shall be made.

CITY OF ALBUQUERQUE
WATER RESOURCES DEPARTMENT
ENGINEERING DIVISION



TITLE: WATER & SANITARY SEWER REPLACEMENTS II
4TH ST. N.W.

APPROVALS	ENGINEER	DATE	APPROVALS	ENGINEER	DATE
City Engineer			Liquid Waste	James Joplin	3/18/83
A.C.E. - Design	J. K. Kell	1/18/83	Traffic	N.A. 10/29	
A.C.E. - Hydrology			Water	James Joplin	3/11/83


DRAWING (WRD 92.15.17)
NO. 1700

MAP NO.
H-14

SHEET 17 OF 23

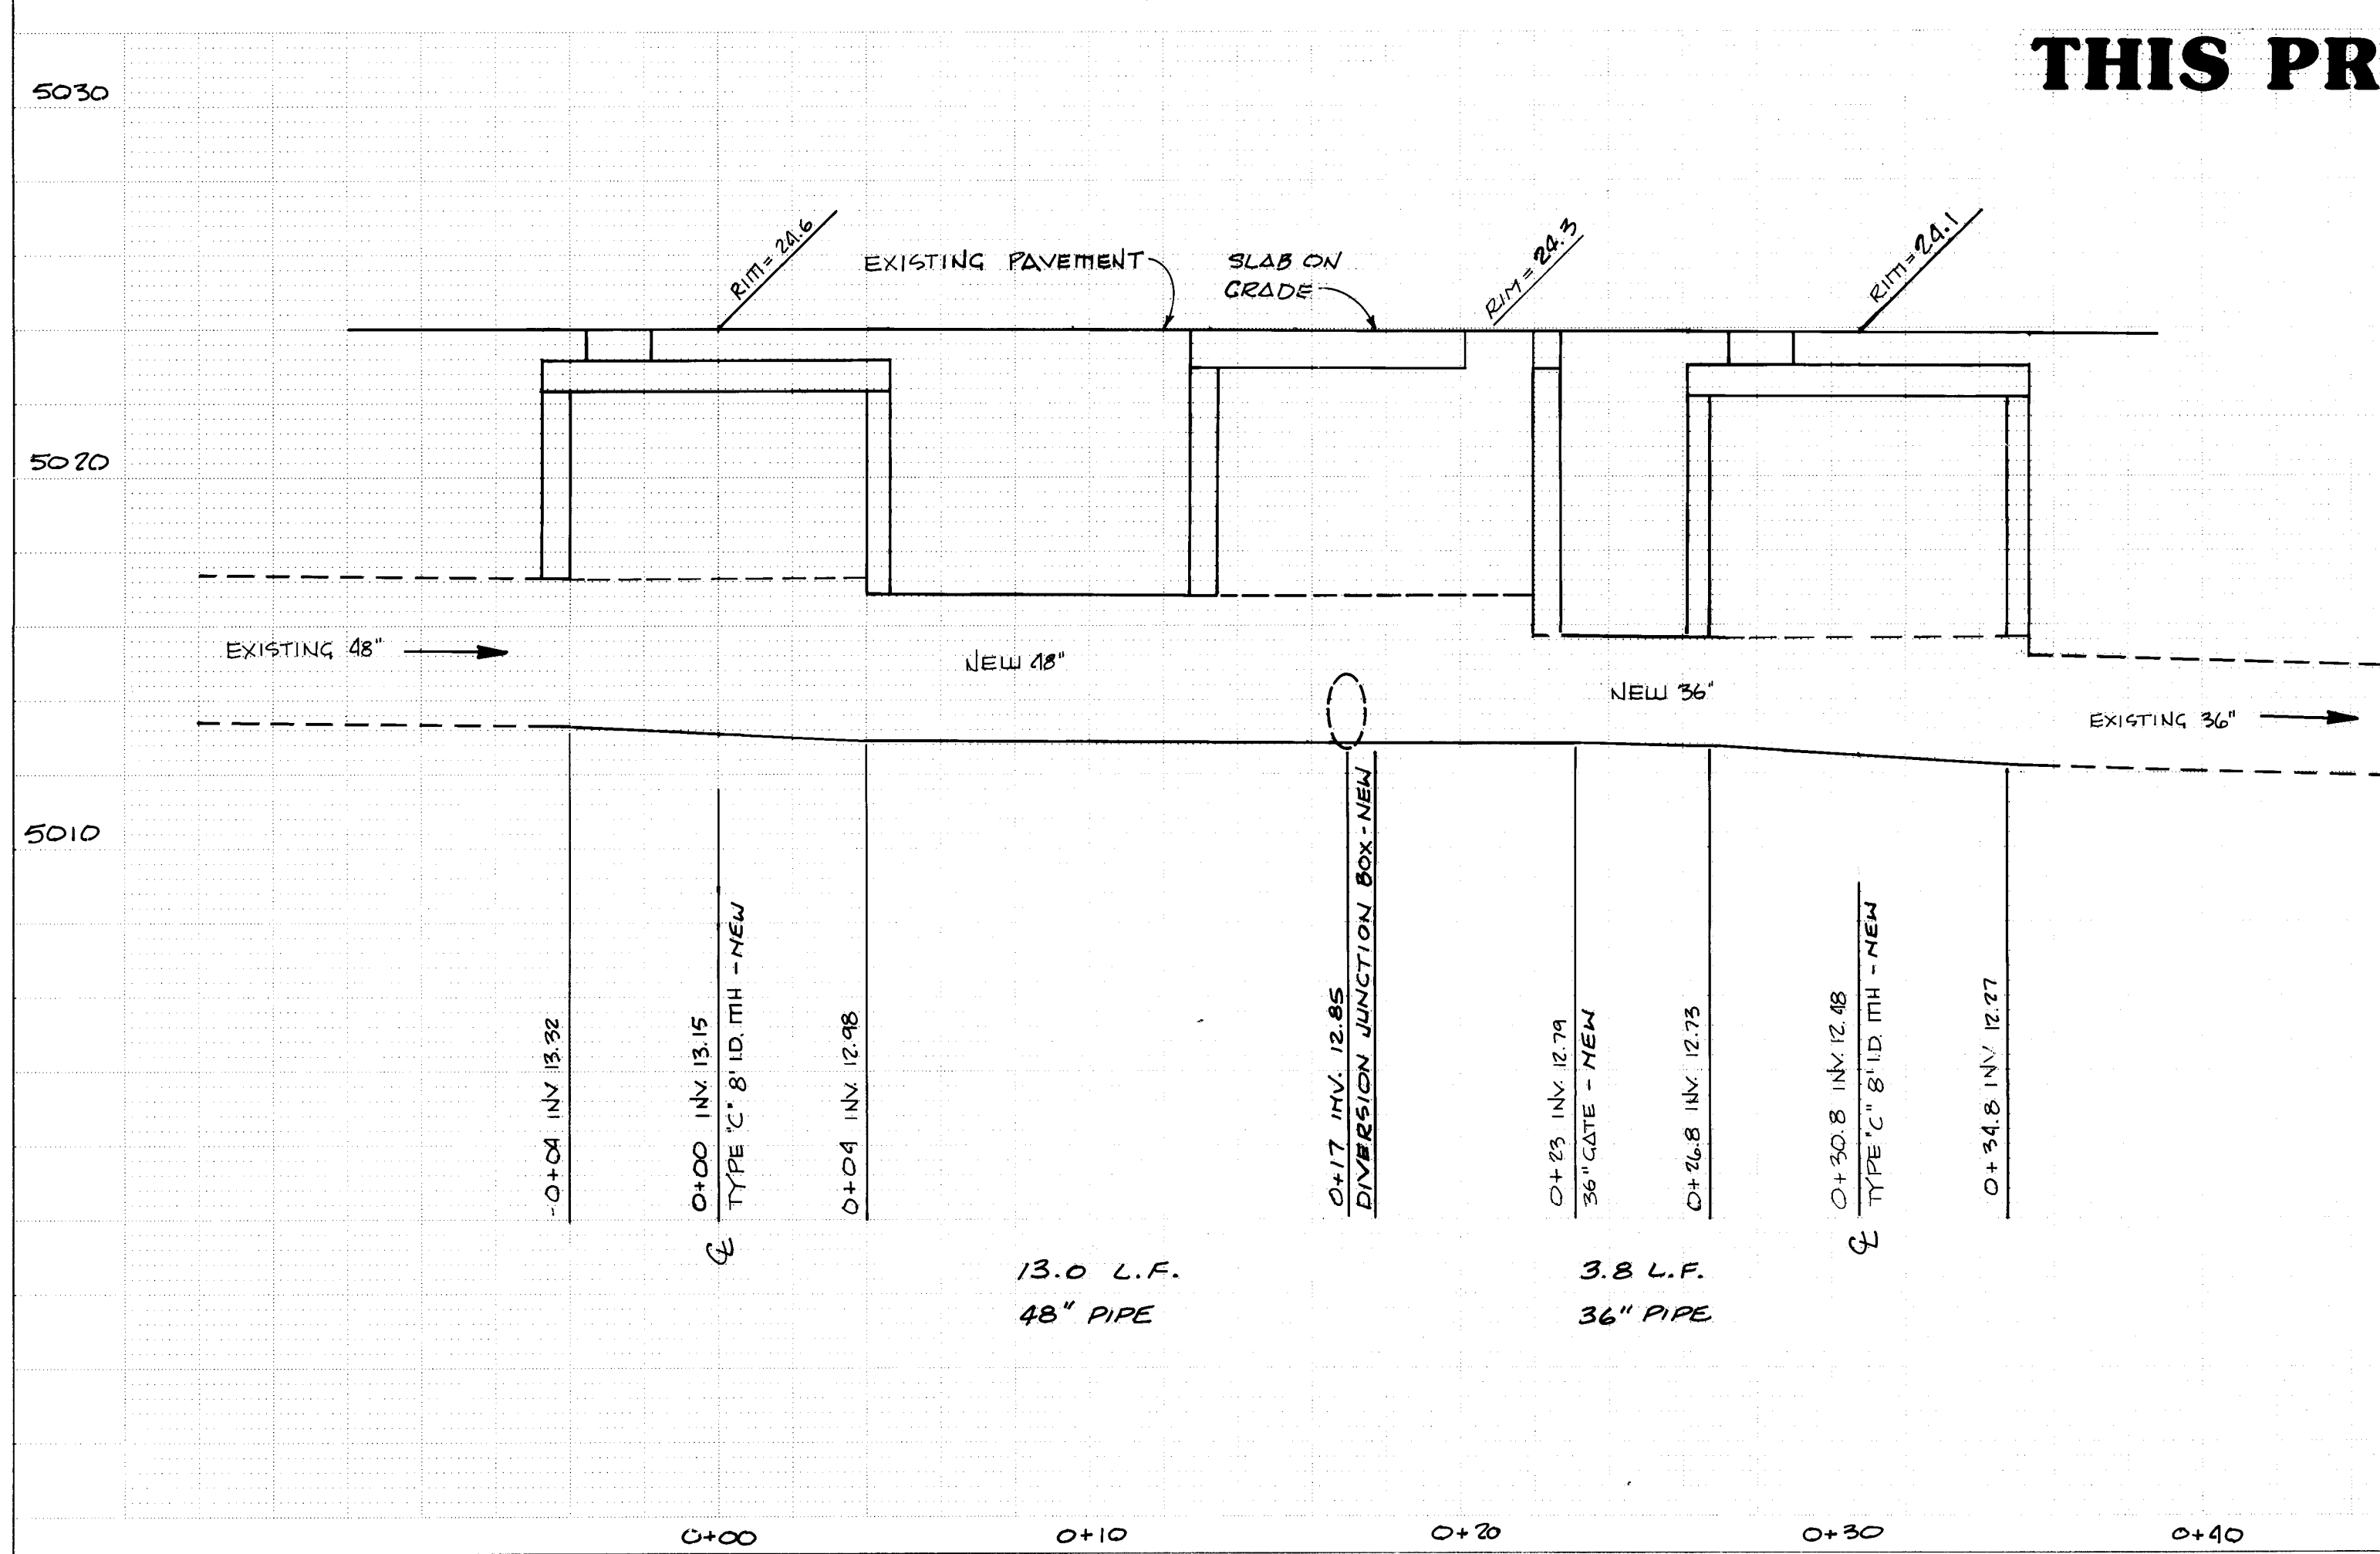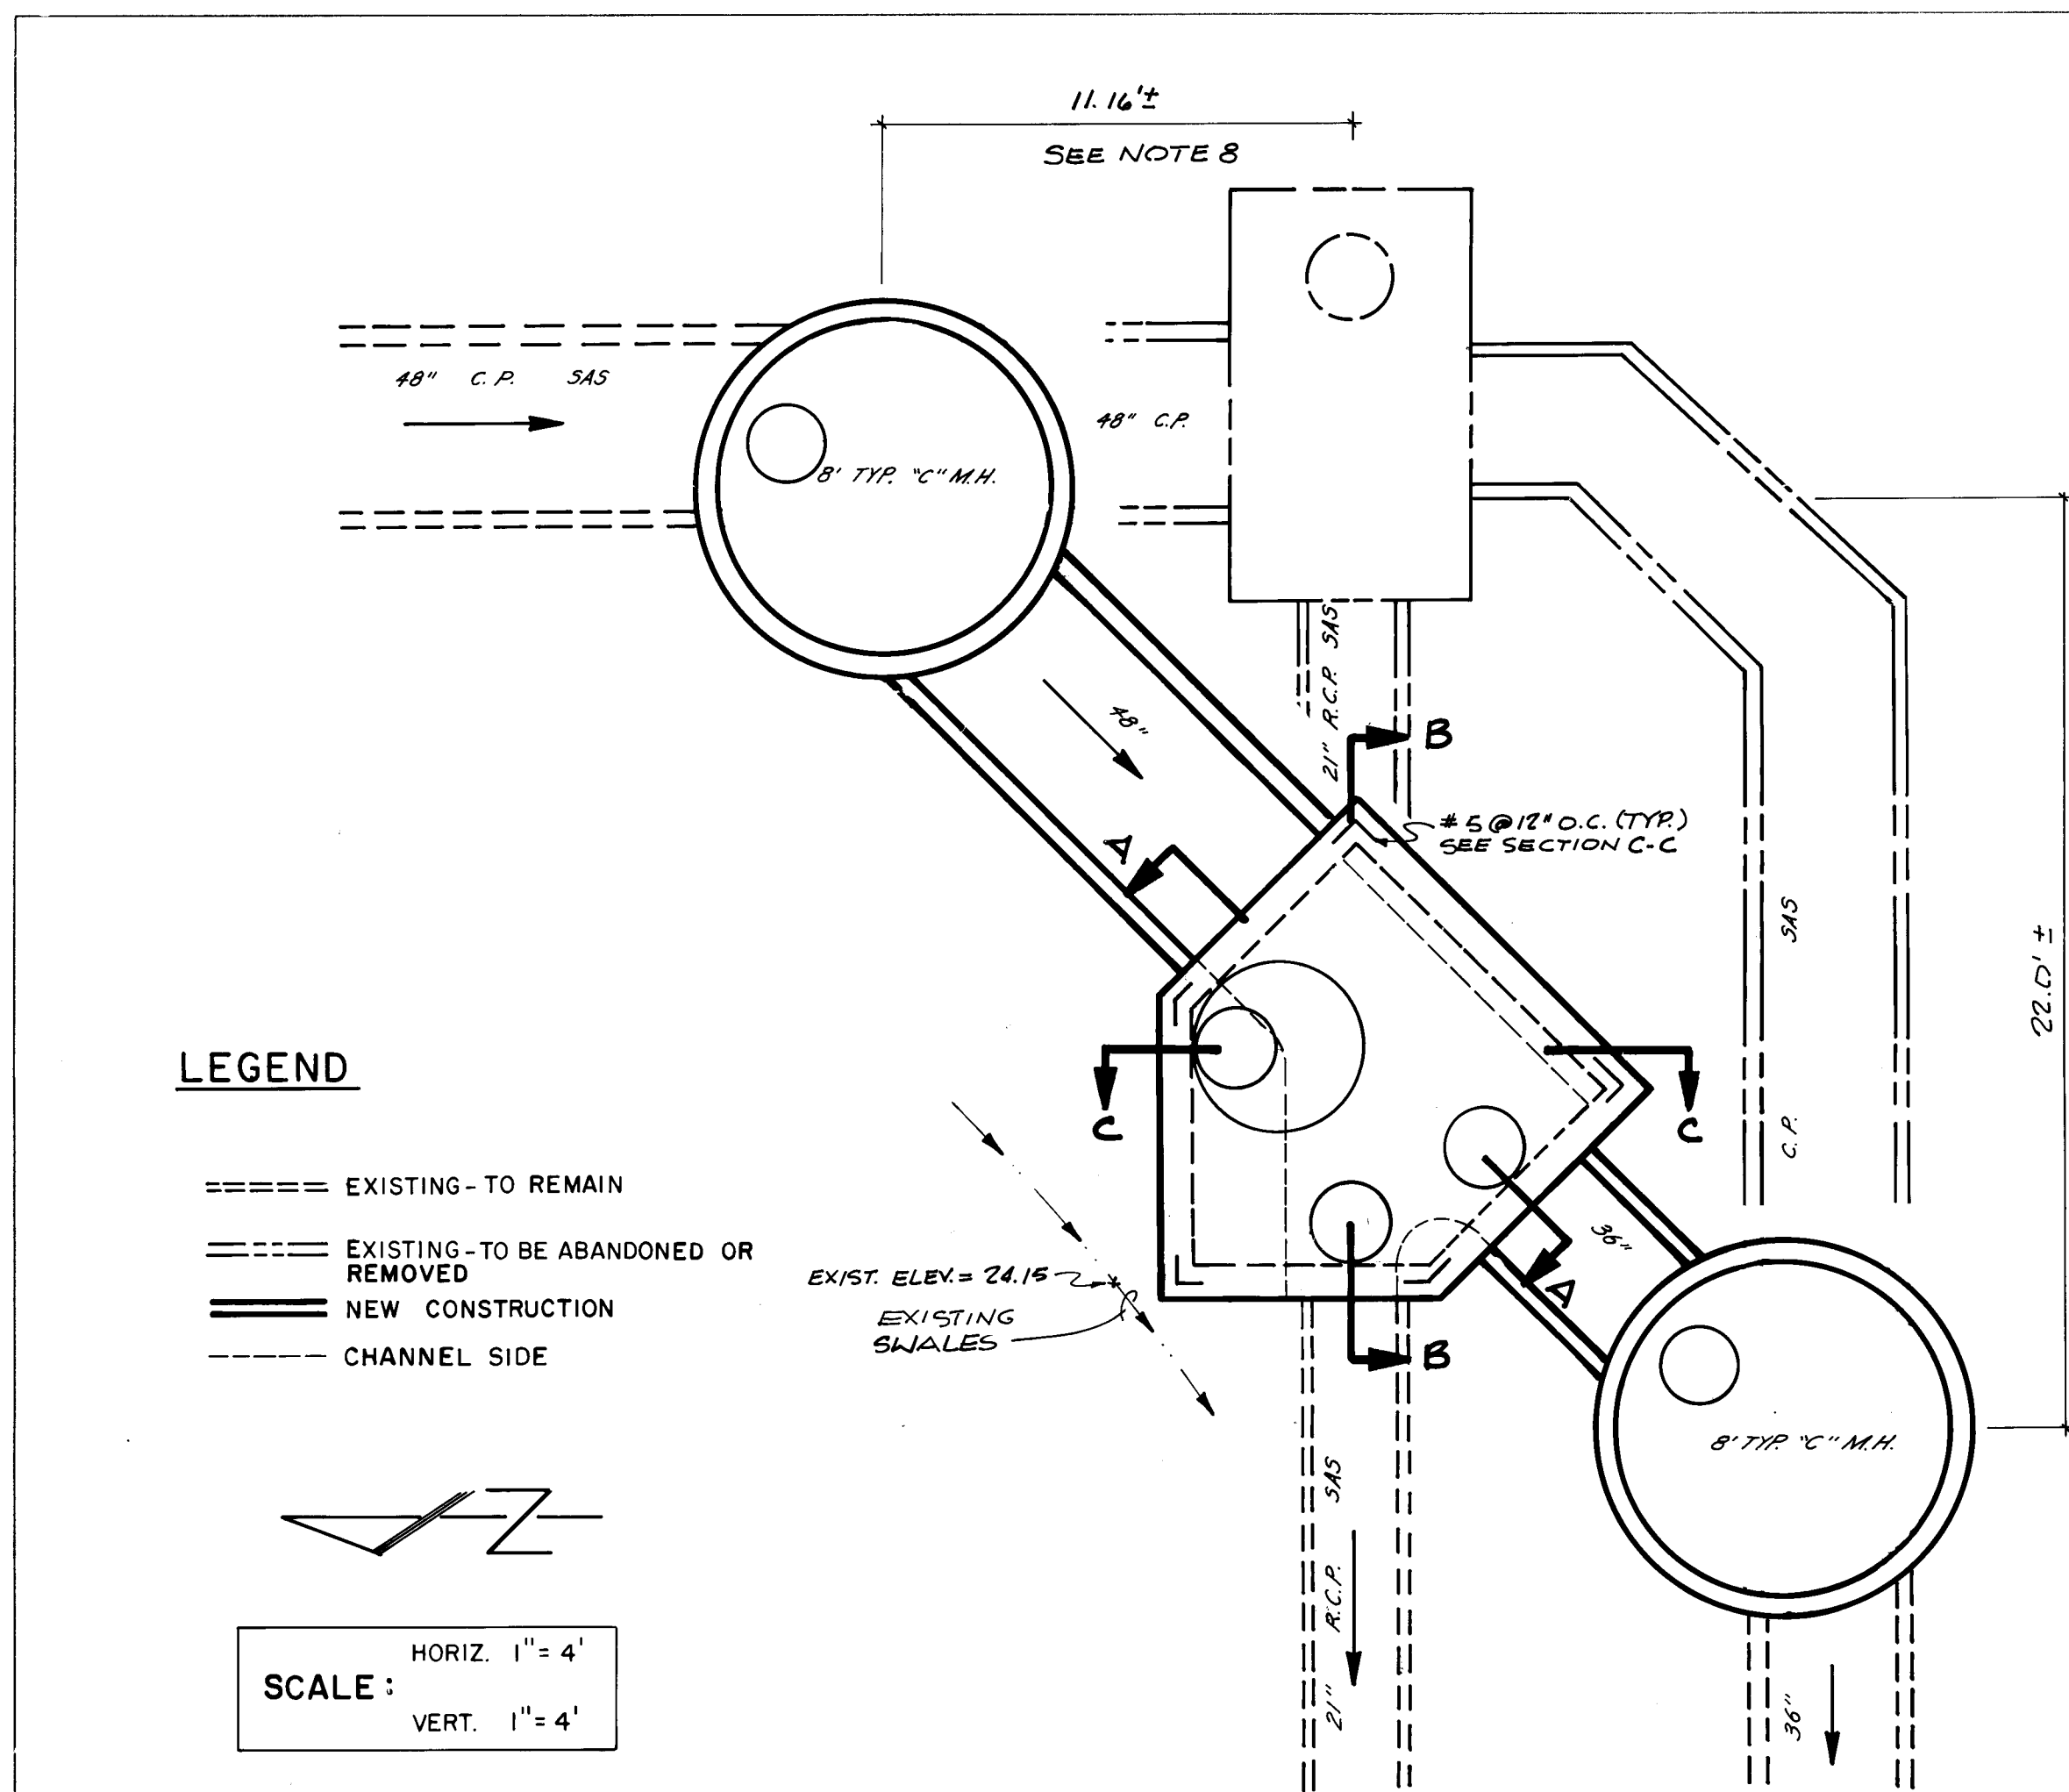

**NOT TO BE INCLUDED IN
THIS PROJECT**

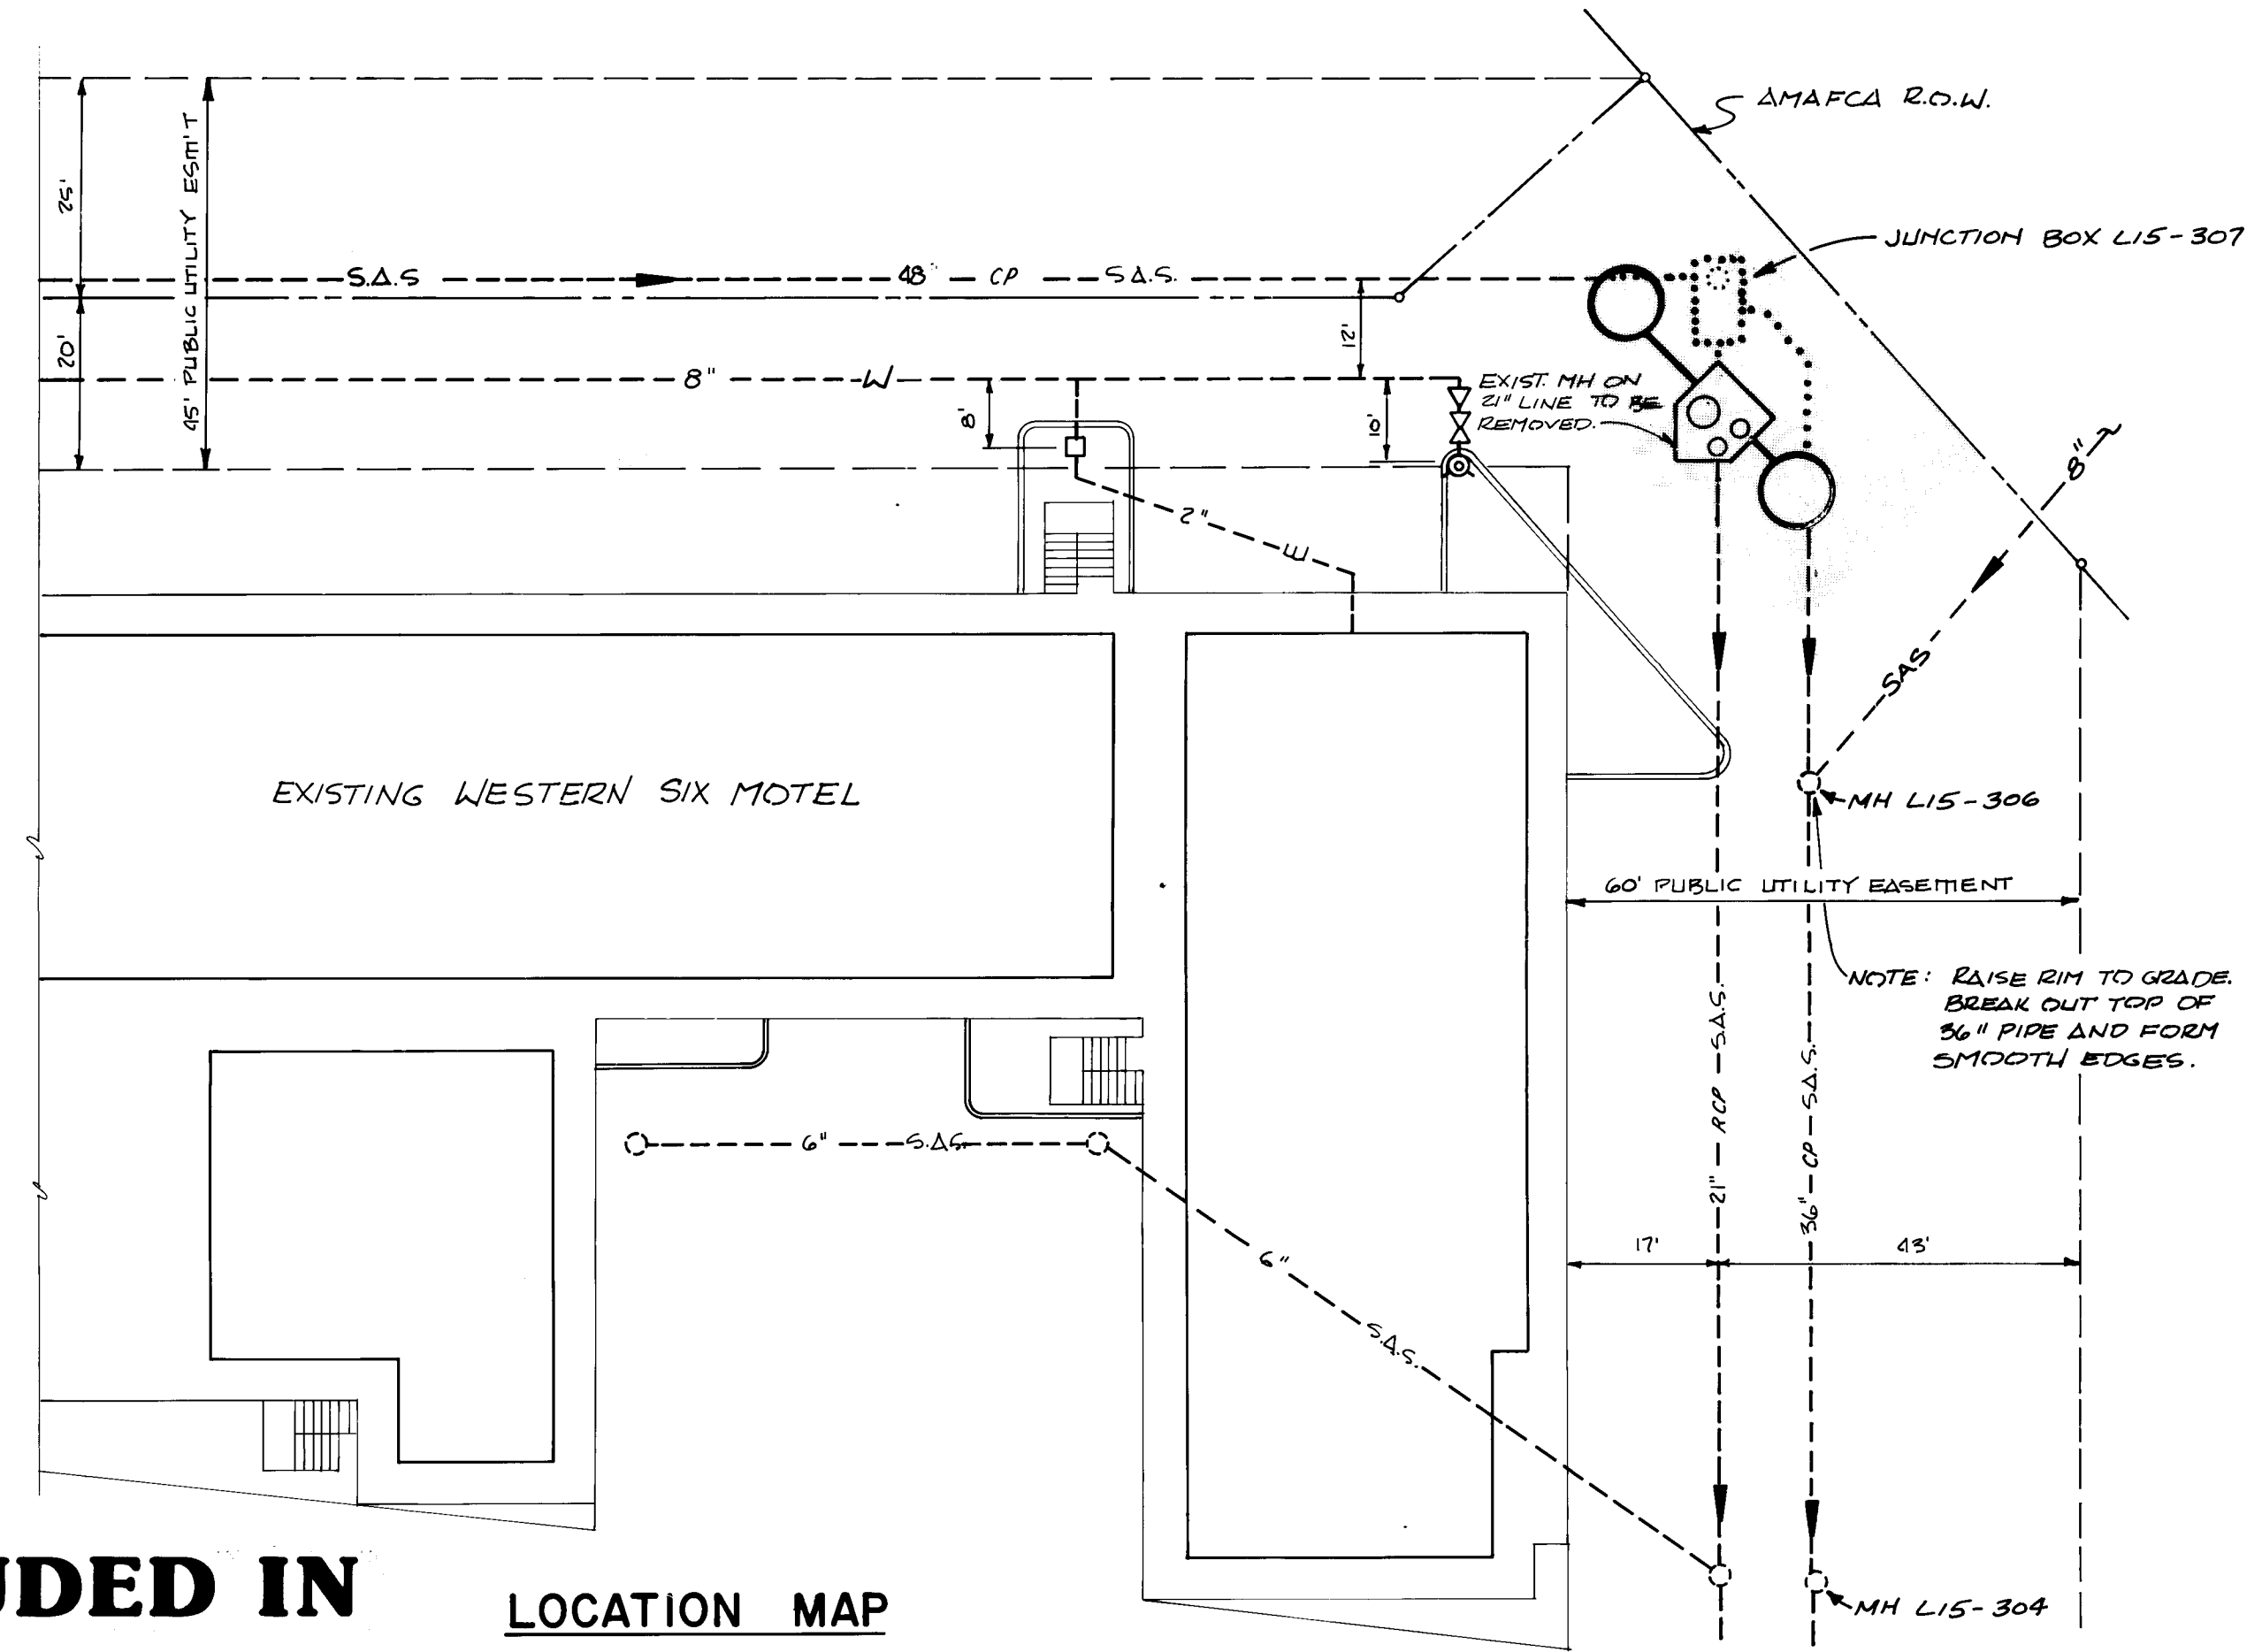

CONSTRUCTION SEQUENCE

- 1) Divert all flow to existing 36 inch line.
- 2) Remove existing manhole on 21 inch line and 21 inch line as required, at site of proposed junction box.
- 3) Construct new manholes, diversion junction box and pipe. Install sluice gates. Build new manholes around 48 inch and 36 inch lines.
- 4) Remove 48 inch pipe within new manhole. Form floor and invert per Std. Dwg. S-1-1. Plug abandoned 48 inch line. Divert all flow through new junction box to existing 21 inch line.
- 5) Remove 36 inch pipe within new manhole. Form floor and invert per Std. Dwg. S-1-1. Plug abandoned 36 inch line.

CONSTRUCTION NOTES

- 1) Pipe lengths are measured along pipe center line from wall to wall.
- 2) New pipe shall be Class IV R.C.P. with an Az factor of 0.52.
- 3) Pipe joints for proposed 48 inch and 36 inch lines shall be located 2 LF from the walls of the proposed manholes and junction box.
- 4) Remove abandoned rings and covers and place to side. Notify Dean Wall (766-7768) to pick up.
- 5) Remove and replace existing asphalt concrete as necessary. Replacement asphalt to be 2\"/>

MSM CONSULTANTS, INC.

CONSULTING ENGINEERS-SURVEYORS-PLANNERS

PLANS PREPARED UNDER THE DIRECTION OF		CITY OF ALBUQUERQUE WATER RESOURCES DEPARTMENT ENGINEERING DIVISION	
OF		TITLE: WATER & SANITARY SEWER REPLACEMENT II SEWER DIVERSION FACILITY-LINE 107	
APPROVALS	ENGINEER	DATE	APPROVALS
City Engineer			Liquid Waste
A.C.E.-Design			Traffic
A.C.E.-Hydrology			Water
APPROVED FOR CONSTRUCTION		DESIGNED BY M.H.	
ENGINEER		DATE 6/82	
DATE		DRAWN BY Z.W.	
		CHECKED BY M.H., C.L., J.H.	
DRAWING (WRD 82.15.19)		SHEET 19 OF 23	
NO. 1700		MAP NO. L-15	

0690161

LIST OF DRAWINGS

SHEET NO.	DRAWING NO.	TITLE
1	WRD 82.15.01	TITLE SHEET, LEGEND, INDEX, & GEN. NOTES
2 & 3	WRD 82.15.02-03	PROJECT LOCATION MAPS
4	WRD 82.15.04	15 TH. STREET S.W.
5	WRD 82.15.05	15 TH. STREET S.W.
6	WRD 82.15.06	PROSPECT AVE. N.W.
7	WRD 82.15.07	PROSPECT AVE. N.W.
7	WRD 82.15.07	CEDAR AVE. S.E.
8	WRD 82.15.08	CEDAR AVE. S.E.
9	WRD 82.15.09	FREDERICK CT. N.W.
10	WRD 82.15.10	WASHINGTON ST. N.E.
11	WRD 82.15.11	ESPANOLA ST. N.E.
12	WRD 82.15.12	ESPANOLA ST. N.E.
13	WRD 82.15.13	ESPANOLA ST. N.E.
14	WRD 82.15.14	ESPANOLA ST. N.E.
15	WRD 82.15.15	MARQUETTE, COPPER DOMINGO
16	WRD 82.15.16	ALLEY BTW BETTS & MORRIS(MH. 506-911)
17	WRD 82.15.17	4 TH. STREET N.W.
18	WRD 82.15.18	MENAU, BLVD N.W.
19	WRD 82.15.19	ESPANOLA ST. N.E.
20	WRD 82.15.20	ESPANOLA ST. N.E.
21	WRD 82.15.21	SUPLINE DETAILS
22	WRD 82.15.22	DETAILS
23	WRD 82.15.23	TRAFFIC CONTROL

NOT TO BE INCLUDED
IN THIS PROJECT

LEGEND

W.L.	PROPOSED WATER LINE	□	EXISTING WATER METER
SAS	PROPOSED SEWER LINE	■	METER BOX REHABILITATION
+	PROPOSED GATE VALVE (WATER)	□	RELOCATE BOX & PLATE
+	PROPOSED FIRE HYDRANT	—■	REPLACE EXISTING SERVICE LINE/OR
+	PROPOSED TEE	—■	INSTALL NEW SERVICE LINE
●	PROPOSED SANITARY MANHOLE	—□	REPLACE EXISTING SERVICE LINE ONLY
—W—	EXISTING WATER LINE & VALVE	—■	INSTALL DOUBLE BOX & PLATE
—SAS—	EXISTING SEWER LINE & MANHOLE		
—SD—	EXISTING STORM DRAIN & MANHOLE		
—G—	GAS MAIN		
—T—	UNDERGROUND TELEPHONE		
—P—	TELEPHONE MANHOLE		
—U—	UTILITY POLE		
—T—	EXISTING TEE (WATER)		
—C—	EXISTING CURB & GUTTER		
—I—	WITH STORM INLET		
///	EXISTING BUILDING		

WATER & SANITARY SEWER REPLACEMENT II

6" WATERMAIN -15 TH. STREET S.W.
6" " -PROSPECT AVENUE N.W.
6" " -CEDAR AVENUE S.E.
6" " -FREDERICK COURT N.W.
8" SANITARY SEWER-WASHINGTON STREET N.E.
8" " " / ESPANOLA STREET N.E.
6" WATERMAIN /
8" " - COPPER AVENUE N.E.
6" " -MARQUETTE AVENUE N.E.
MISC. WATERMAIN WORK -DOMINGO ROAD N.E.
8" SANITARY SEWER-ALLEY EAST OF BETTS ST., NORTH OF LOMAS BLVD.
8",18",21" SANITARY SEWER-4 TH. ST. & MENAU N.W.

~~SANITARY SEWER DIVERSION FACILITY LINE 107~~


MARCH 1983

26 17000184

Don L. Spence
12 14




- GENERAL NOTES
1. THE LOCATION OF ALL EXISTING UTILITIES, AS SHOWN ON THE DRAWINGS, ARE APPROXIMATE LOCATIONS. THE CONTRACTOR SHALL BE RESPONSIBLE FOR MAKING FINAL UTILITY LOCATION DETERMINATION IN THE FIELD DURING CONSTRUCTION; THIS IS INCIDENTAL TO THE CONTRACT.
 2. THE CONTRACTOR SHALL NOTIFY ALL UTILITY COMPANIES BY CALLING "BLUESTAKES" AT 765-1724 AT LEAST 48 WORKING HOURS PRIOR TO COMMENCING WORK IN ANY PART OF THE PROJECT AREA.
 3. THE CONTRACTOR SHALL BE RESPONSIBLE FOR PROTECTING AND MAINTAINING IN SERVICE ALL EXISTING UTILITIES.
 4. THE CONTRACTOR SHALL CONFINED HIS WORK TO WITHIN THE CONSTRUCTION LIMITS AND/OR RIGHT-OF-WAYS TO PRESERVE EXISTING VEGETATION AND PRIVATE PROPERTY. OVERNIGHT PARKING OF CONTRACTOR'S EQUIPMENT SHALL NOT OBSTRUCT DRIVEWAY OPENINGS OR DESIGNATED TRAFFIC LINES. THE CONTRACTOR SHALL SCHEDULE HIS TRENCHING INSTALLATION AND BACKFILL OPERATIONS SO THAT ACCESS TO ANY DRIVEWAY IS NOT DISRUPTED LONGER THAN ONE WORKING DAY.
 5. THE CONTRACTOR SHALL COORDINATE HIS ACTIVITIES WITH THE ENGINEER TO MINIMIZE TRAFFIC DISRUPTIONS. NO CONSTRUCTION WILL BE ALLOWED ADJACENT TO PUBLIC SCHOOLS, EXCEPT DURING SCHOOL HOLIDAYS AND/OR BREAKS.
 6. A DISPOSAL SITE FOR ALL EXCESS EXCAVATION MATERIALS SHALL BE OBTAINED BY THE CONTRACTOR AND APPROVED BY THE ENGINEER. ALL COSTS INCURRED IN OBTAINING A DISPOSAL SITE, HAULING THERE TO AND PROPER DISPOSAL THEREOF SHALL BE CONSIDERED INCIDENTAL TO CONSTRUCTION AND NO DIRECT PAYMENT WILL BE MADE THEREFOR.
 7. THE CITY OF ALBUQUERQUE STANDARD DETAILS ARE INCLUDED IN THE SPECIFICATIONS AND MADE A PART OF THIS CONTRACT.
 8. THE NEW MEXICO STANDARD SPECIFICATIONS FOR PUBLIC WORKS CONSTRUCTION, 1979 EDITION AND SUPPLEMENTAL SPECIFICATIONS WILL GOVERN WORK ON THIS PROJECT, UNLESS OTHERWISE NOTED IN THE CONTRACT DOCUMENTS.
 9. ENDS OF ALL ABANDONED WATER LINES SHALL BE SECURED BY THE INSERTION OF A 12 INCH PORTLAND CEMENT PILE, UNLESS OTHERWISE NOTED. THIS WORK SHALL BE INCIDENTAL AND NO EXTRA PAYMENT SHALL BE MADE FOR SAID WORK.
 10. ARTERIAL PAVEMENT IS TO BE USED ON WASHINGTON BLVD., NE, COAL AVE., SE, LEAD AVE., SE, CENTRAL AVE., NE.
 11. WHERE CONCRETE BLOCKING IS CALLED FOR, WRAP ALL BENDS, TEES, AND OTHER FITTINGS WITH POLYETHYLENE.
 12. WATER SYSTEMS DIVISION SHALL BE THE ONLY AUTHORIZED PERSONNEL TO OPERATE EXISTING VALVES, FIRE HYDRANTS, AND OTHER STREET APPURTENANCES THAT ARE NOT A PART OF THE INTENDED WORK. ALL WORK SHUTOFFS MUST BE COORDINATED WITH SAID DIVISION THREE (3) DAYS PRIOR TO PROPOSED SHUTOFFS. CALL 765-1724.
 13. NEW WATER LINE TO EXISTING STEEL PIPE RECONNECTION-SEE SPECIAL NOTE ON STD. DRAWING W-1-2 IN CONTRACT DOCUMENTS WHEN NEW LINE MUST REDUCE IN SIZE TO EXISTING LINE.
 14. PROPERTY OWNERS ADJACENT TO THE PROJECT, MAY DESIRE REPLACEMENT OF THEIR EXISTING DETEIORATED SANITARY SEWER SERVICE AT THE TIME THE SERVICE IS EXPOSED DURING THE NORMAL CONSTRUCTION. THIS WORK SHALL BE SEPARATE FROM THIS PROJECT AND SHALL BE PAID FOR BY THE REQUESTOR DIRECTLY TO THE PROJECT CONTRACTOR OR BY A PRIVATE PLUMBING CONTRACTOR AND SHALL COORDINATE HIS ACTIVITIES WITH THE PROJECT CONTRACTOR.
 15. WATER SYSTEMS DIVISION SHALL HAVE THE AUTHORITY TO CANCEL ALL SCHEDULED SHUTOFFS.
 16. CONTRACTOR SHALL RECONNECT ALL SANITARY SEWER HOUSE SERVICES IN THE MANNER AND DIRECTION AS ORIGINALLY FOUND; EVEN IF THIS SHALL MEAN THE SERVICE MAY BE AT AN ANGLE OTHER THAN 90 DEGREES FROM THE MAIN; PER AGREEMENT WITH THE MECHANICAL SECTION/CODE ADMINISTRATION DIVISION.
 17. THE CONTRACTOR SHALL COMPLETE ALL SANITARY SEWER AND WATER WORK INTENDED FOR A STREET BEFORE MOVING ON TO ANOTHER STREET IN THE PROJECT, UNLESS OTHERWISE AUTHORIZED BY THE ENGINEER. ONCE ALL SANITARY SEWER AND WATER WORK HAS BEEN DONE IN A STREET, THE CONTRACTOR SHALL HAVE TO LAY CURB AND GUTTER, SIDEWALK, SURFACE, AND BASE COURSE ONLY WITHIN THE STREET. SURFACE COURSE SHALL BE LAID ONLY AFTER SUCCESSFUL TESTING OF ALL OTHER WORK WITHIN THE STREET.
 18. THE CARE AND PROTECTION OF ALL OTHER UTILITIES, CURB AND GUTTER, SIDEWALK, AND OTHER STREET APPURTENANCES THAT ARE NOT A PART OF THE INTENDED WORK, AS SHOWN ON PLANS ARE THE RESPONSIBILITY OF THE CONTRACTOR. IF DAMAGED, LOST, OR MISSING, OR OTHERWISE IMPROPERLY DISTURBED, THESE ITEMS WILL BE REPAIRED AT THE CONTRACTOR'S EXPENSE.
 19. BROKEN CONCRETE STRUCTURES AND/OR CONCRETE MASONRY UNITS TO BE REPLACED AS PART OF THE WORK SHALL BE PREPARED AND DELIVERED TO OWNER SITE LOCATIONS BY THE CONTRACTOR AS DESCRIBED WITHIN SECTION 212 OF THE SUPPLEMENTAL TECHNICAL SPECIFICATIONS.
 20. WHEN SO CALLED ON THE PLANS, MANHOLE REHABILITATION FOR LINES TO BE SLIP LINED SHALL INCLUDE THE WORK DESCRIBED IN THE SUPPLEMENTAL TECHNICAL SPECIFICATIONS OF THE CONTRACT DOCUMENTS, SECTIONS 552.073 AND 552.076. WHEN SO CALLED ON THE PLANS, MANHOLE REHABILITATION ON LINES TO BE REPLACED SHALL BE THE WORK DESCRIBED IN SECTION 552.076 ONLY.
 21. SAN CRISTOBAL, 15TH, CEDAR, AND PROSPECT STREETS SHALL BE OVERLAIN WITH NEW SURFACE COURSE BY THE CITY TRANSPORTATION DEPARTMENT. IN THESE STREETS, THE CONTRACTOR SHALL REPLACE 4-6" ASPHALT CONCRETE BASE COURSE (WITH SUBGRADE) TO THE TOP OF THE EXISTING PAVEMENT SURFACE ON EITHER SIDE OF THE TRENCH.
 22. IN FREDERICK COURT, THE ENGINEER SHALL DETERMINE WHETHER THERE WILL BE FULL WIDTH OR TRENCH ONLY PAVEMENT REMOVAL AND REPLACEMENT AFTER THE PROJECT HAS BEEN AWARDED.
 23. IF, AFTER LAYING BASE COURSE, ALL OR A PORTION OF THE WORK SHOULD FAIL TESTING AND REQUIRE EXCAVATION, THE REMOVAL AND REPLACEMENT OF THE BASE COURSE (AND ALL OTHER NECESSARY WORK TO REPAIR DEFECTIVE WORK AS SET FORTH IN THE CONTRACT DOCUMENTS) SHALL BE AT THE CONTRACTOR'S EXPENSE.
 24. 20" STEEL WATER LINE IN ESPANOLA STREET SHALL BE ABANDONED IN PLACE OR REMOVED AT THE CONTRACTOR'S OPTION; HOWEVER, REMOVING THE PIPE SHALL BE INCIDENTAL TO THE PROJECT AND NO SEPARATE PAYMENT WILL BE MADE. IF ABANDONED IN PLACE, PAYMENT WILL BE MADE FOR FILLING THE ABANDONED PIPE WITH A SAND SLURRY.

REV.	SHEETS	CITY	ENGR.	DATE	USER	DEPT.	DATE	USER	DEPT.	DATE
APPROVAL OF REVISIONS										

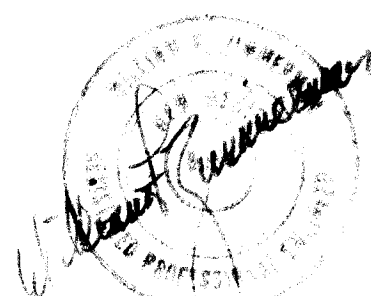

APPROVED FOR CONSTRUCTION <i>John W. Nickerson Jr.</i> 3/15/83 WRD. CHIEF ENGINEER	APPROVED FOR CONSTRUCTION <i>Don L. Spence</i> 3-10-83 CITY ENGINEER
PROJECT NO. (WRD 82.15) 1700	SHEET 1 OF 23

CITY OF ALBUQUERQUE BERNALILLO COUNTY WATER RESOURCES DEPARTMENT

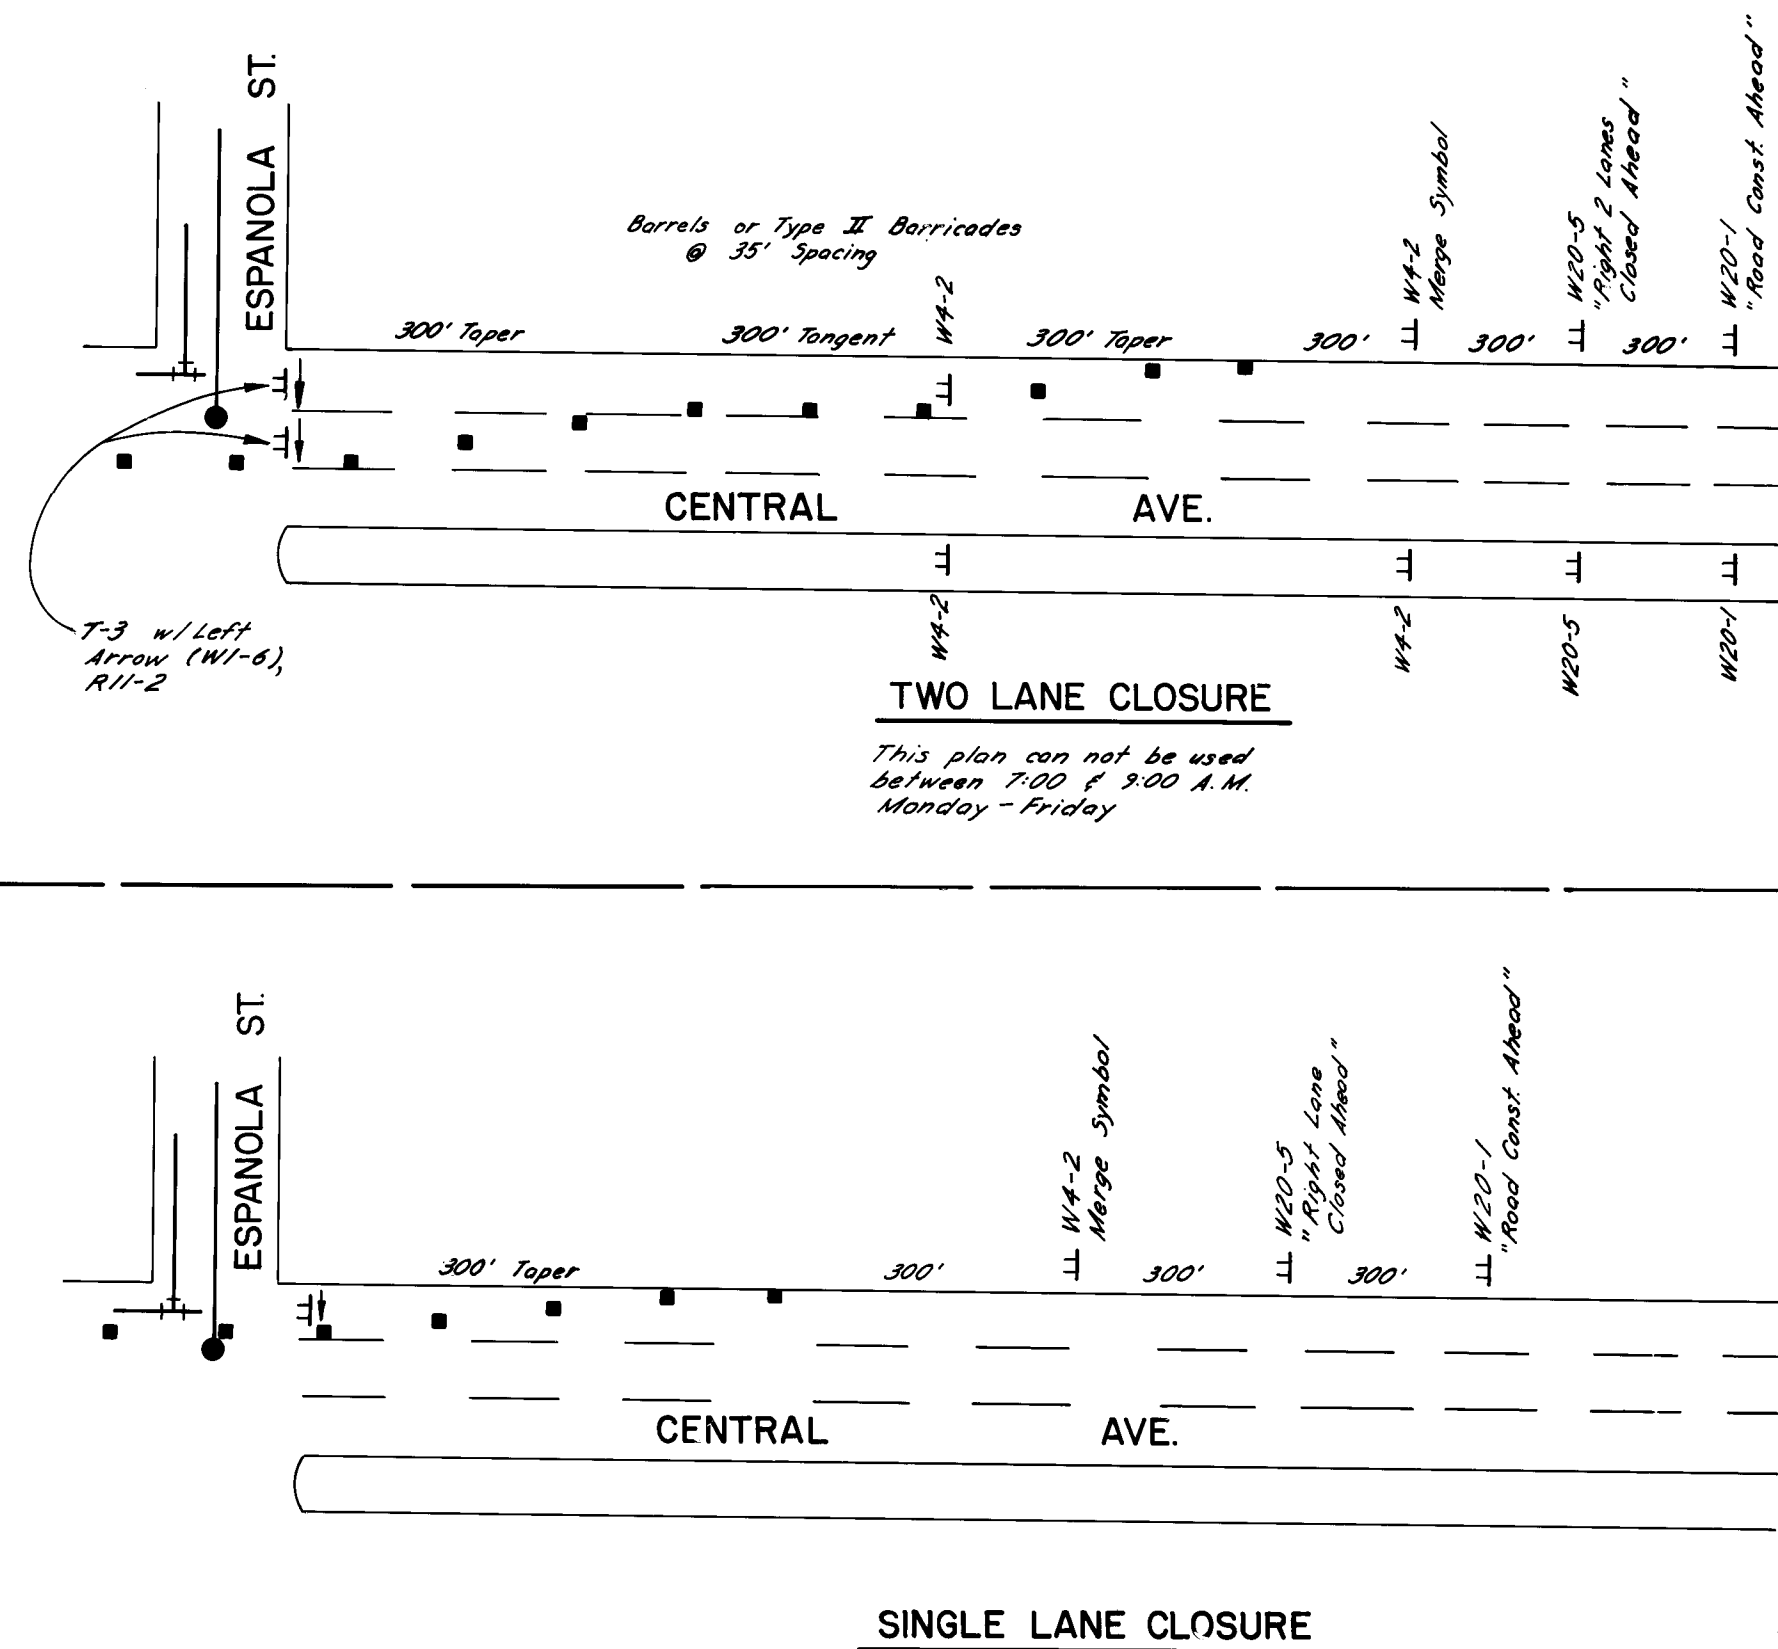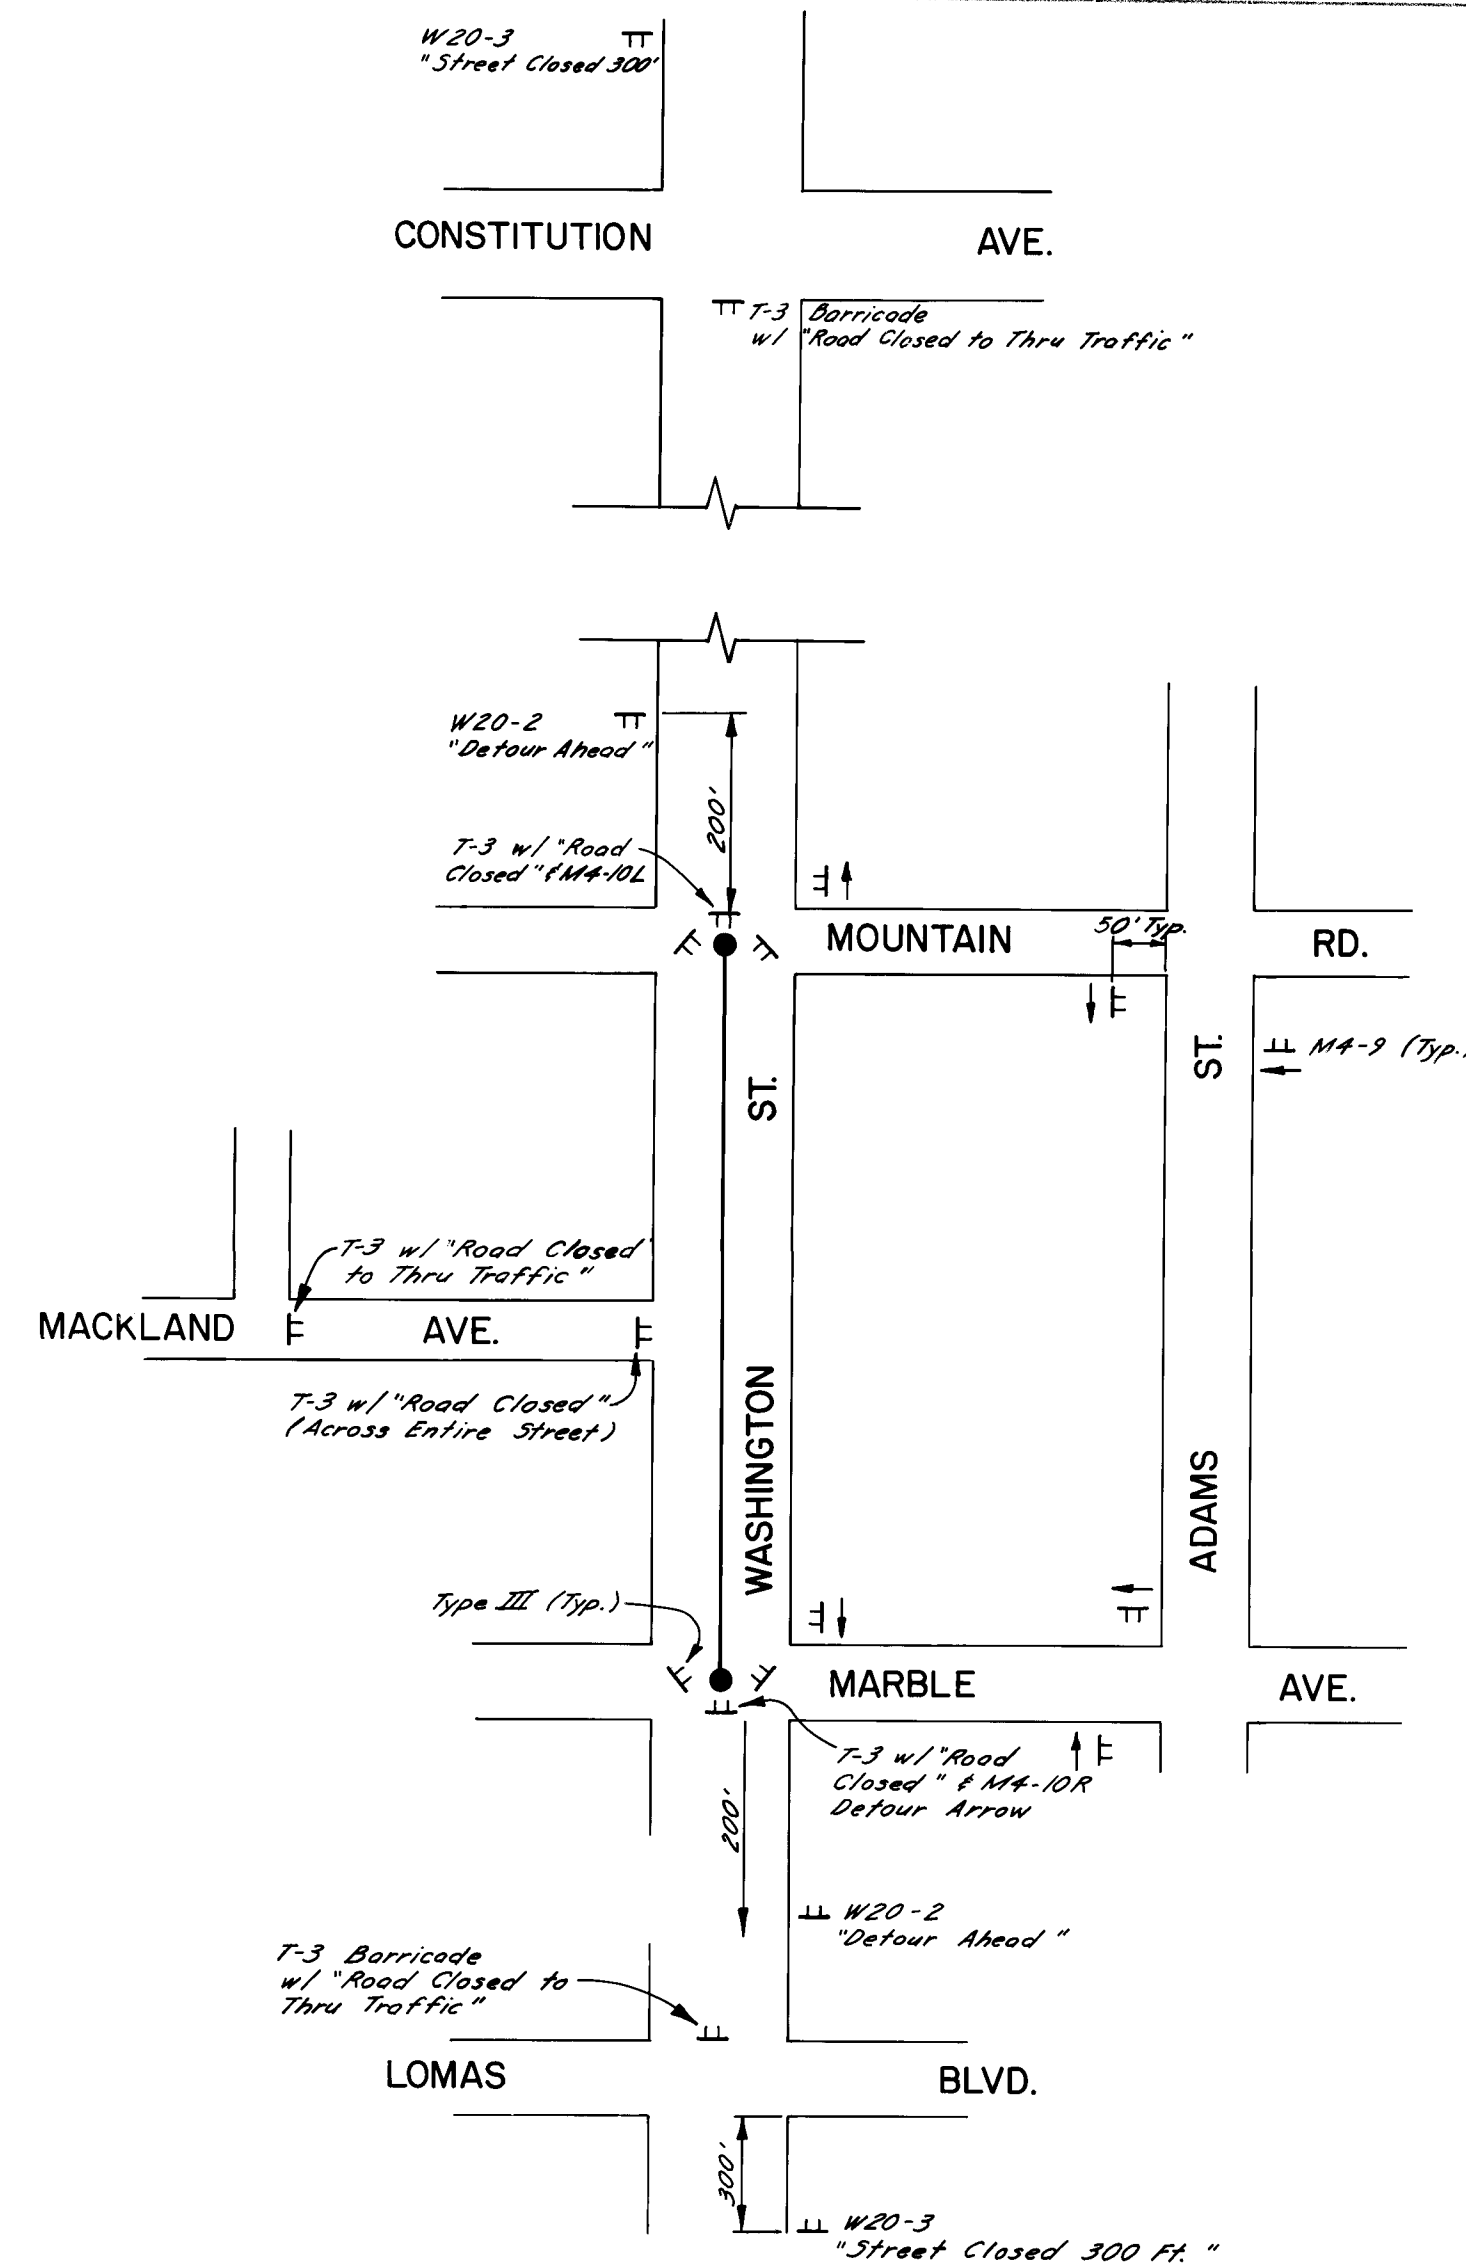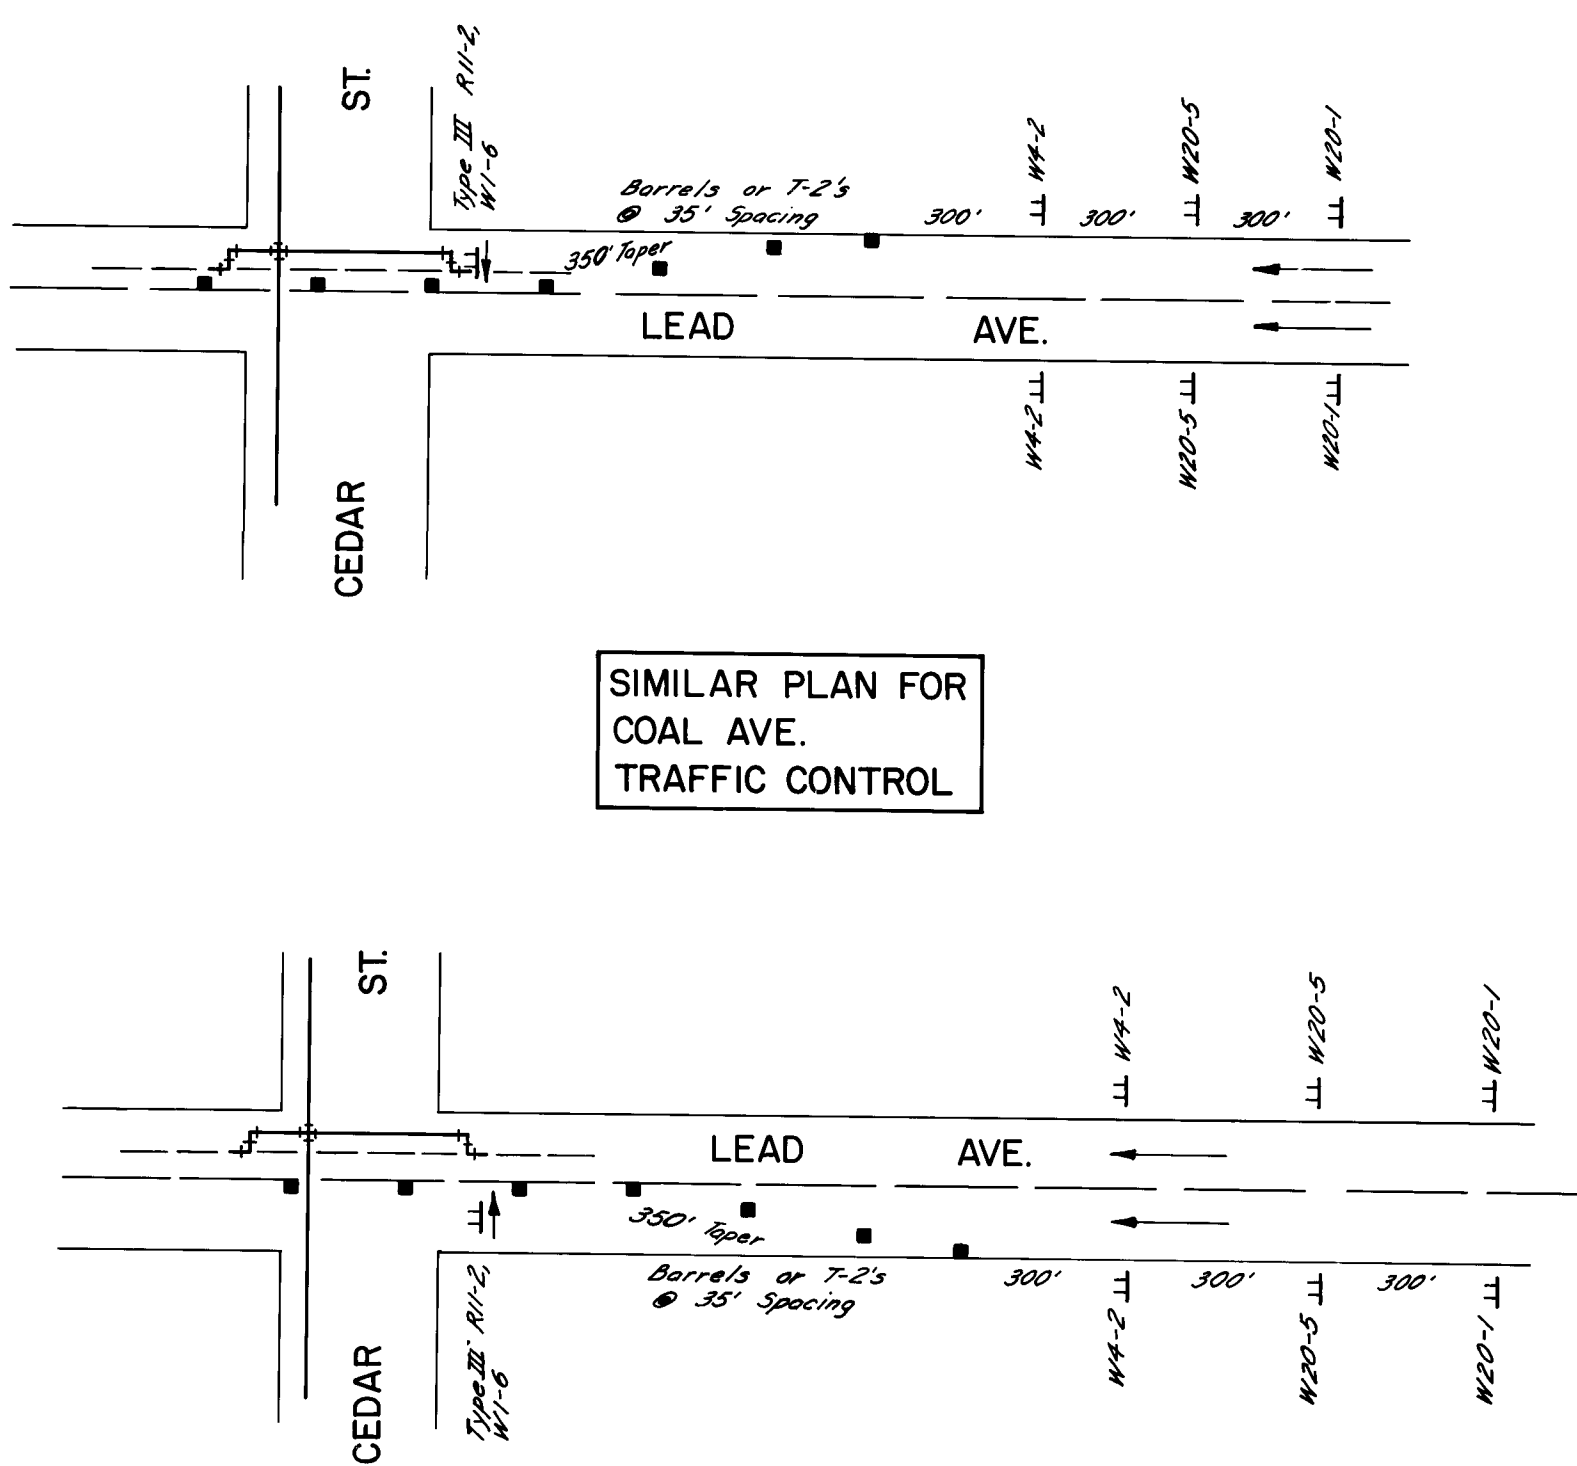

- ## GENERAL NOTES
1. ALL TRAFFIC CONTROL DEVICES SHALL COMPLY WITH CHAPTER VI OF THE 1978 EDITION "MANUAL FOR UNIFORM TRAFFIC CONTROL DEVICES".
 2. THE CONTRACTOR SHALL PREPARE AND SUBMIT TO THE PROJECT ENGINEER A DETAILED DETOUR PLAN, WHICH IS SUBJECT TO THE APPROVAL OF THE CITY TRAFFIC ENGINEER, 3 WORKING DAYS IN ADVANCE OF ANY REQUIRED LANE CLOSURES OTHER THAN THOSE SHOWN ON THESE PLANS.
 3. ALL SIGNS MUST BE INSTALLED BEFORE CONSTRUCTION BEGINS AS DIRECTED BY THE ENGINEER. THE BOTTOM OF CONSTRUCTION WARNING SIGNS SHALL BE 7-FEET ABOVE THE SIDEWALK LEVEL.
 4. ALL SIGNS, BARRICADES AND/OR BARRELS WILL BE REFLECTORIZED. ALL BARRELS MAY HAVE SAND OR WATER BALLAST LIMITED TO 100 LBS.
 5. ALL SIGN LOCATIONS WILL BE SELECTED IN THE FIELD AND APPROVED BY THE PROJECT ENGINEER. DISTANCES MAY BE ADJUSTED FOR LOCAL CONDITIONS.
 6. ALL SIGNS WILL BE GROUND MOUNTED ON SINGLE OR DOUBLE POSTS. EXISTING POSTS MAY BE USED AT SOME LOCATIONS, WITH THE APPROVAL OF THE PROJECT ENGINEER. PORTABLE SIGNS SUPPORTS WILL BE ACCEPTABLE AS AN ALTERNATE, PROVIDED THAT THEY DO NOT UNDUPLY OBSTRUCT THE SIDEWALK.
 7. ALL SIGNS WILL BE MOVED FORWARD AS THE CONSTRUCTION PROGRESSES.
 8. THE CONTRACTOR SHALL MAINTAIN ACCESS TO BUSINESS AND RESIDENCES ADJACENT TO THE CONSTRUCTION AREA.
 9. WHEN BARRIERS ARE REQUIRED AFTER DARK, ALL ADVANCE WARNING SIGNS AND ALL BARRICADES SHALL BE EQUIPPED WITH FLASHING WARNING LIGHTS (TYPE A), EXCEPT THAT THAT ALL CHANNELIZING BARRICADES SHALL HAVE STEADY BURNING WARNING LIGHTS (TYPE C).
 10. ALL EXISTING REGULATORY SIGNS THAT NEED TO BE REMOVED, RELOCATED OR REINSTALLED SHALL BE DONE BY THE CITY OF ALBUQUERQUE TRAFFIC ENGINEERING DIVISION. THE CONTRACTOR SHALL NOTIFY THE TRAFFIC ENGINEERING DIVISION 3 WORKING DAYS IN ADVANCE OF ANY REQUIRED WORK.
 11. THE CONTRACTOR SHALL PROVIDE AND MAINTAIN A SAFE AND ADEQUATE MEANS OF CHANNELLING PEDESTRIAN TRAFFIC AROUND ALL WORK AREAS THROUGHOUT THE PERIOD OF CONSTRUCTION. ALL SUCH CHANNELIZATION SHALL BE ARRANGED TO PREVENT PEDESTRIANS FROM HAVING TO ENTER THE ROADWAY IN ORDER TO PASS AROUND THE WORK AREAS.
 12. ALL CONSTRUCTION SIGNING SHALL BE BLACK ON A REFLECTORIZED ORANGE FIELD UNLESS OTHERWISE SPECIFIED.
 13. DO NOT MIX CHANNELIZATION BARRELS WITH TYPE II BARRICADES.
 14. ALL ADVANCE WARNING SIGNS SHALL BE 48" x 48".
 15. ALL CONSTRUCTION TIES TO EXISTING MANHOLES AND WATER LINES, IN CENTRAL AVENUE MUST NOT EXCEED TWO (2) WORKING DAYS.
 16. CONSTRUCTION IN WASHINGTON STREET, N.E. SHALL NOT EXCEED FOURTEEN (14) CONSECUTIVE CALENDAR DAYS.

[illegible]

26	1	7	0	0	2	3	8	4
----	---	---	---	---	---	---	---	---

CITY OF ALBUQUERQUE					
WATER RESOURCES DEPARTMENT					
ENGINEERING DIVISION					
TITLE:					
TRAFFIC CONTROL					
APPROVALS	ENGINEER	DATE	APPROVALS	ENGINEER	DATE
City Engineer			Liquid Waste	<i>James Donnell</i>	3-11-83
A C E - Design	<i>Michael</i>	11 Mar 83	Traffic	<i>James Donnell</i>	3/10/83
A C E - Hydrology			Water	<i>James Donnell</i>	3-16-83
DRAWING (WRD 82.15.23)			MAP NO.		
NO. 1700			SHEET 23 OF 23		