

ALBUQUERQUE METROPOLITAN ARROYO FLOOD CONTROL AUTHORITY

WESTGATE DIVERSION CHANNELS

SNOW VISTA CHANNEL-PHASE II & III



PROJECT LOCATION: ALBUQUERQUE NEW MEXICO

INDEX OF DRAWINGS

PHASE II	
SHEET NO.	TITLE
1 OF 49	TITLE AND INDEX OF DRAWINGS
2 OF 49	LOCATION MAP AND GENERAL NOTES
3 OF 49	PLAN AND PROFILE STA. 17+08.38 TO STA. 32+00
4 OF 49	PLAN AND PROFILE STA. 32+00 TO STA. 47+00
5 OF 49	PLAN AND PROFILE STA. 47+00 TO STA. 58+17.16
6 OF 49	DROP STRUCTURE, RUNDOWN, GRADE CONTROL RIPRAP & MISCELLANEOUS DETAILS
7 OF 49	TYPICAL CONCRETE CHANNEL DETAILS AND SIDE CHANNEL DETAILS - STA. 46+58.50
8 OF 49	TYPICAL CHANNEL SECTION DETAILS
9 OF 49	TYPICAL CHANNEL SECTION DETAILS
10 OF 49	WATERLINE RELOCATION BENAVIDES RD. AND SANITARY SEWER RELOCATION - STA. 27+24.36
11 OF 49	MISCELLANEOUS DETAILS
12 OF 49	BENAVIDES SIDE CHANNEL & DISSIPATOR CHANNEL LAYOUT
13 OF 49	CHANNEL DISSIPATOR DETAILS & SECTIONS
14 OF 49	PIPE PENETRATION DETAILS
15 OF 49	BENAVIDES ROAD CONC. BOX CULV. PLAN & SECTION
16 OF 49	BENAVIDES ROAD C.B.C. REINFORCEMENT DETAILS
17 OF 49	BENAVIDES ROAD C.B.C. REINFORCEMENT DETAILS
18 OF 49	BARRIER RAIL & SPECIAL PEDESTRIAN RAILING DETAILS
19 OF 49	METAL BRIDGE RAILING - GEN. NOTES & TYP. DETAILS
20 OF 49	METAL BRIDGE RAILING - TYPE B
21 OF 49	GIBSON BLVD. CONC. BOX CULV. LAYOUT & GRADING PLAN
22 OF 49	GIBSON BLVD. CONC. BOX CULVERT PLAN AND SECTIONS
23 OF 49	GIBSON BLVD. CONC. BOX CULVERT REINFORCEMENT DETAILS
24 OF 49	GIBSON BLVD. SEWER LINE CROSSING & MISC. DETAILS
25 OF 49	CROSS SECTIONS - STA. 17+08.38 TO STA. 22+00
26 OF 49	CROSS SECTIONS - STA. 23+00 TO STA. 29+00
27 OF 49	CROSS SECTIONS - STA. 30+00 TO STA. 36+00
28 OF 49	CROSS SECTIONS - STA. 37+00 TO STA. 41+37.25
29 OF 49	CROSS SECTIONS - STA. 41+78.85 TO STA. 45+00
30 OF 49	CROSS SECTIONS - STA. 45+50 TO STA. 49+00
31 OF 49	CROSS SECTIONS - STA. 49+50 TO STA. 53+00
32 OF 49	CROSS SECTIONS - STA. 53+50 TO STA. 56+94
33 OF 49	TRAFFIC DETOUR PLANS & SIGN DETAILS
34 OF 49	BENAVIDES STORM DRAIN - STA. 0+69.4 TO STA. 6+00
35 OF 49	BENAVIDES STORM DRAIN - STA. 6+00 TO STA. 7+32

PHASE III	
SHEET NO.	TITLE
36 OF 49	LOCATION MAP AND GENERAL NOTES
37 OF 49	PLAN AND PROFILE STA. 58+07.01 TO STA. 71+00
38 OF 49	PLAN AND PROFILE STA. 71+00 TO STA. 85+00
39 OF 49	PLAN AND PROFILE STA. 85+00 TO STA. 100+73
40 OF 49	LAYOUT AT GIBSON BLVD.
41 OF 49	TYPICAL CHANNEL SECTIONS
42 OF 49	TYPICAL SECTIONS AND MISCELLANEOUS DETAILS
43 OF 49	REINFORCING STEEL AND MISCELLANEOUS DETAILS
44 OF 49	SPLITTER WALL LAYOUT AND DETAILS
45 OF 49	STRUCTURAL TRANSITION AND HEADWALL DETAILS
46 OF 49	CROSS SECTIONS STA. 58+07.01 TO STA. 76+00
47 OF 49	CROSS SECTIONS STA. 76+00 TO STA. 95+00
48 OF 49	CROSS SECTIONS STA. 95+00 TO STA. 100+00
49 OF 49	SIDE CHANNEL PROFILE & CROSS SECTIONS STA. 2+25 TO STA. 4+64.94
49A OF 49	TOWER ROAD CONC. BOX CULV. PLAN & SECTION
49B OF 49	TOWER ROAD CONC. BOX CULV. REINFORCEMENT DETAILS
49C OF 49	TOWER ROAD CONC. BOX CULV. REINFORCEMENT DETAILS

DATE: SEPTEMBER, 1986

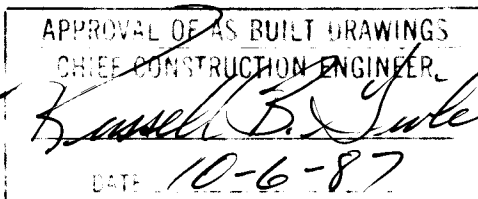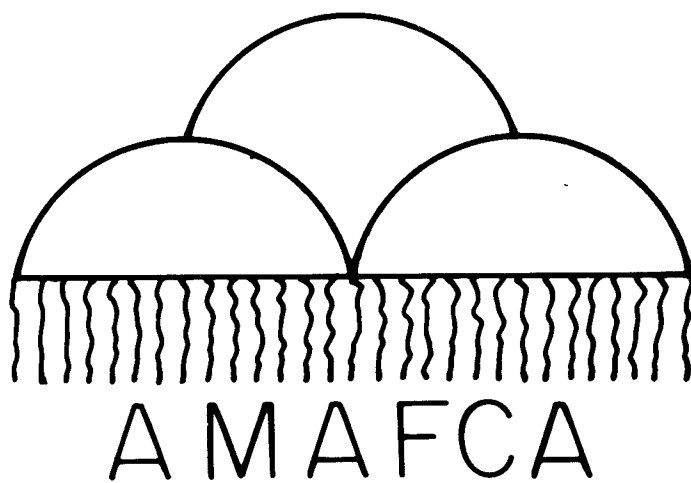


26 17230187

1723

REVISED 11/6/86

5194.11

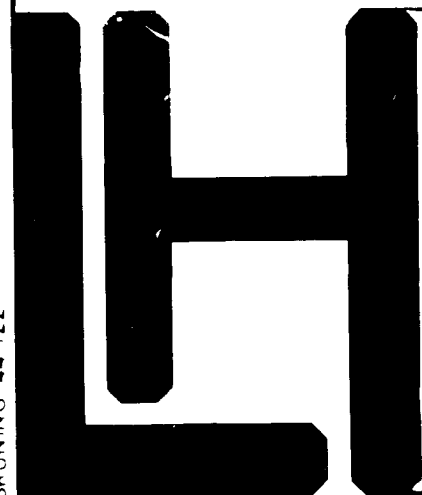

LEEDSHILL - HERKENHOFF, INC.
Copper Square, 500 Copper Ave. N.W.
P.O. Box 1217
Albuquerque, New Mexico 87103
(505) 247-0294

A SUBSIDIARY OF GORDON HERKENHOFF AND ASSOCIATES, INC.

ALBUQUERQUE

SANTA FE

PHOENIX

SAN FRANCISCO

SAN DIEGO

RECORD DRAWING


Date:

JUL 10 1987

These drawings have been revised based
on field data and every reasonable attempt
has been made to depict construction as
actually performed.



SHEET 1 OF 49

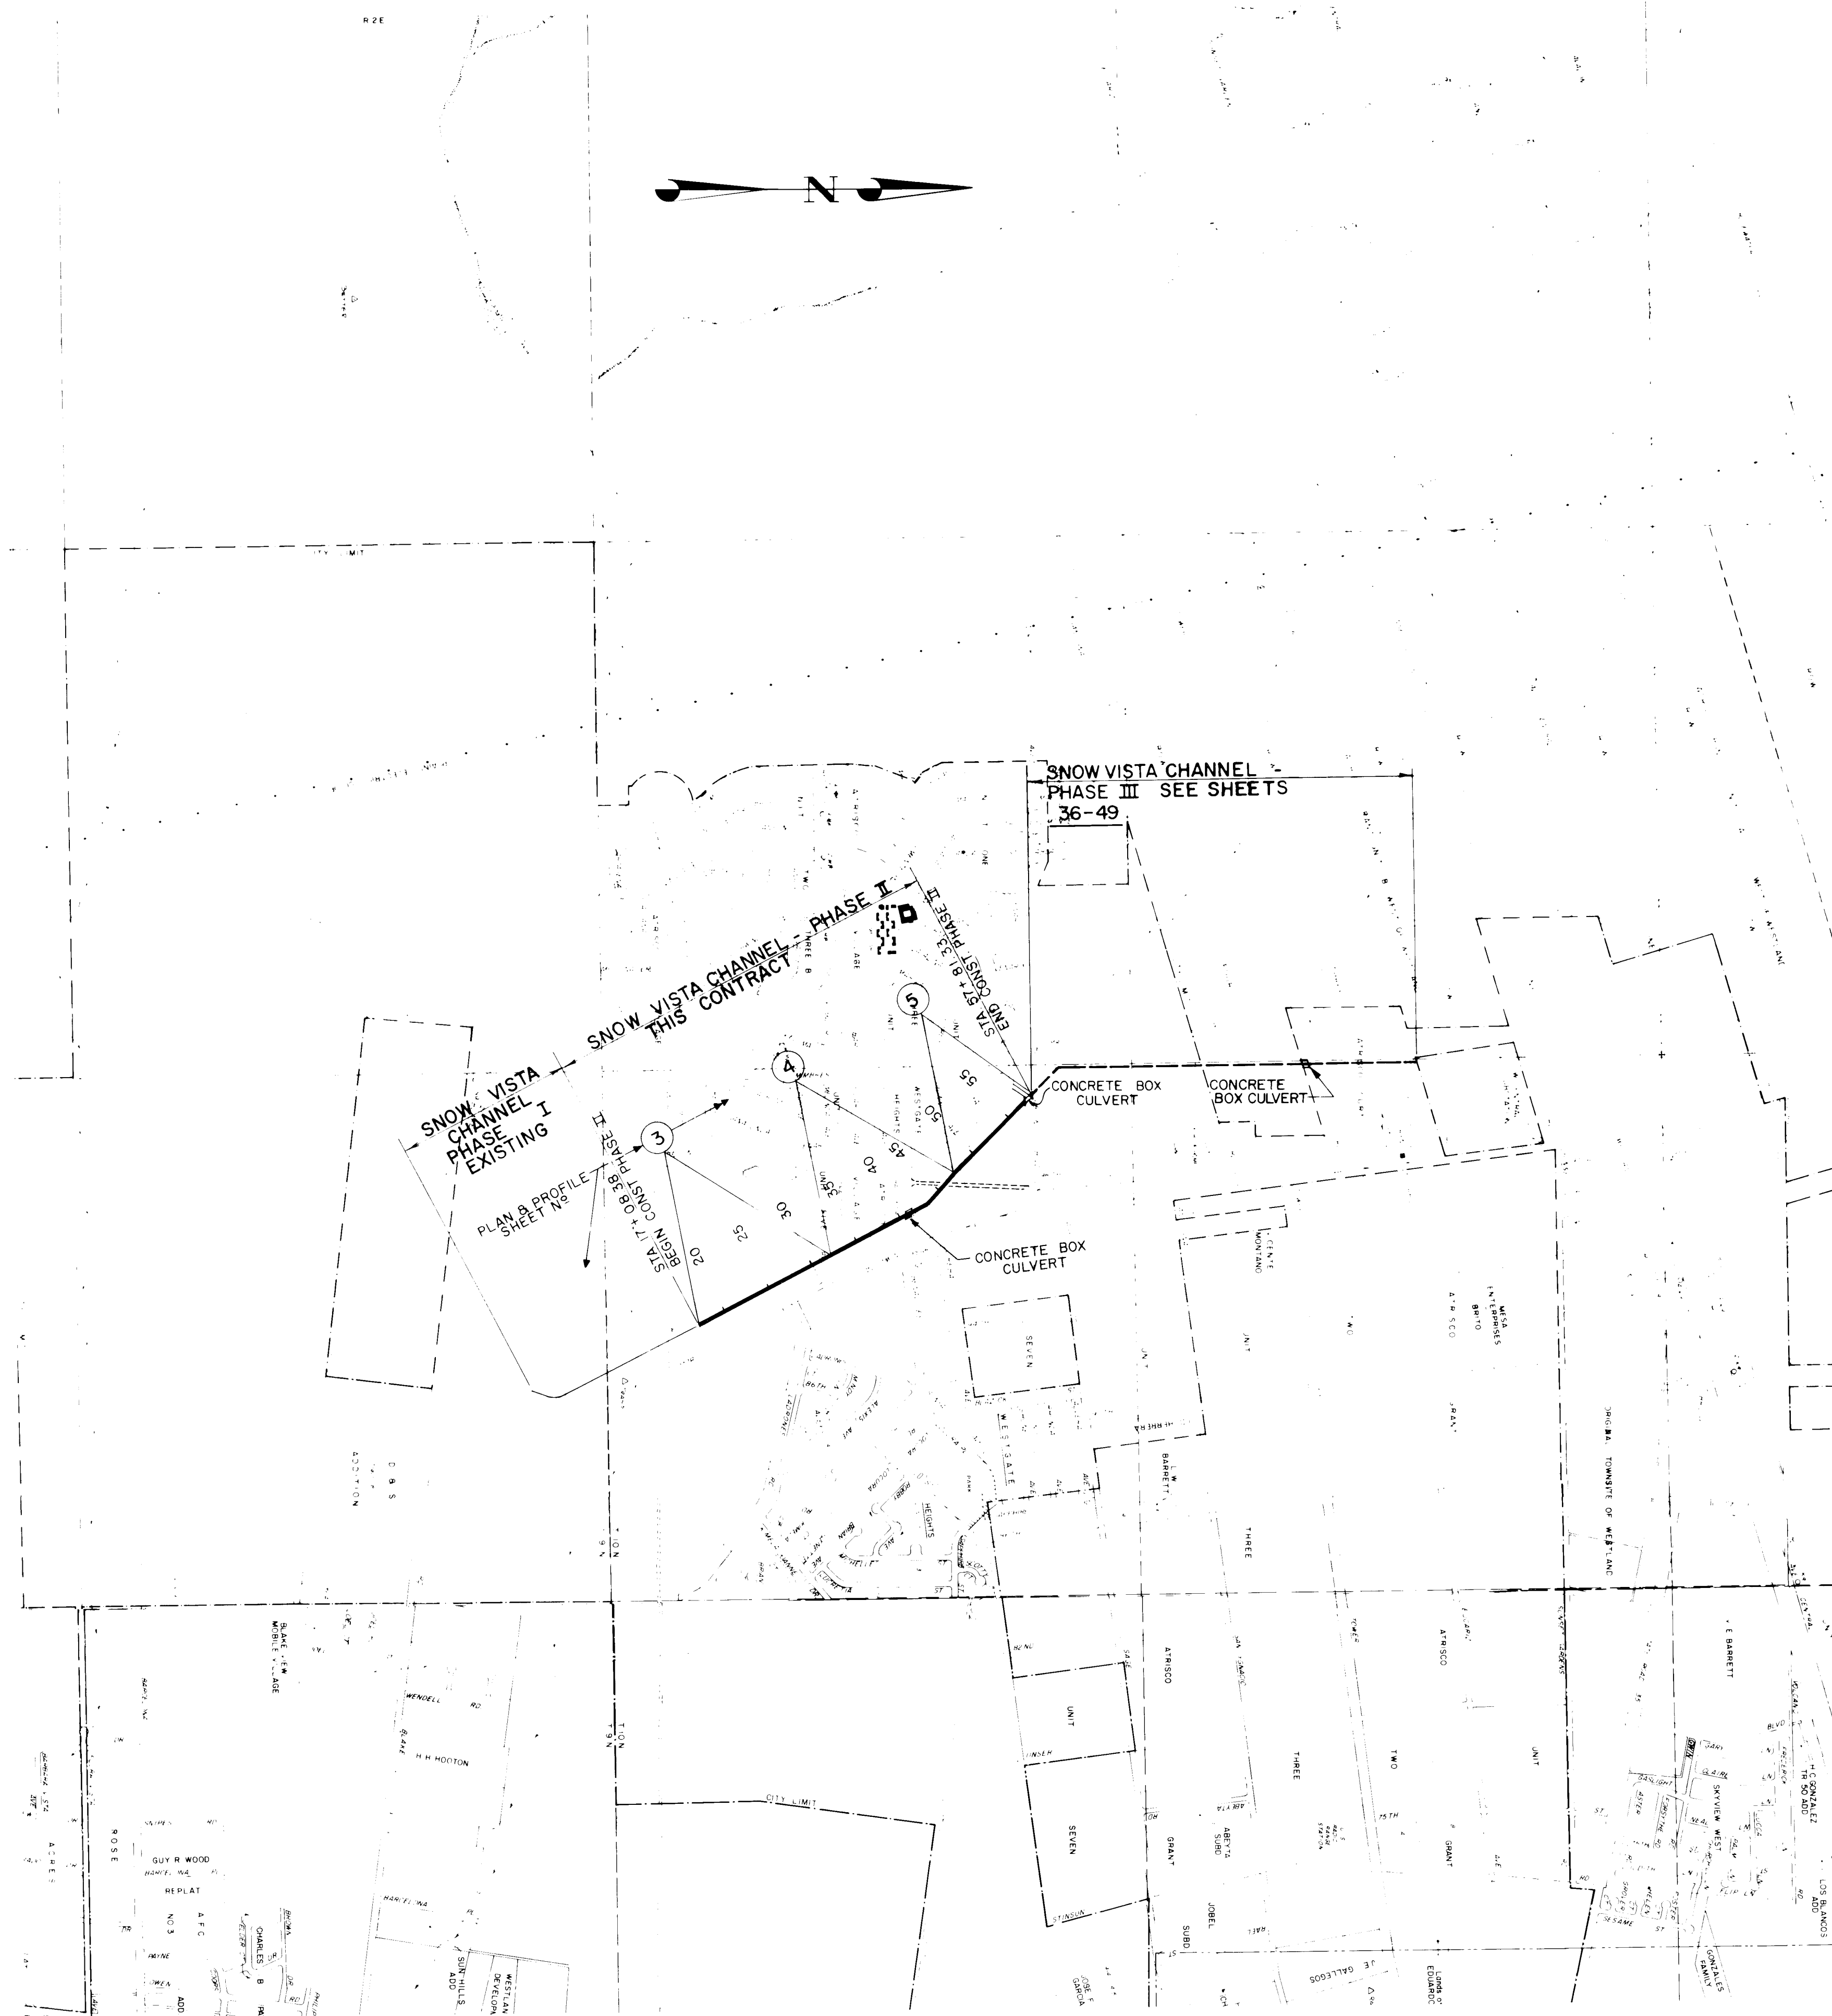

GENERAL NOTES

1. TWO (2) WORKING DAYS PRIOR TO ANY EXCAVATION, CONTRACTOR MUST CONTACT LINE LOCATING SERVICE, 765-1234, FOR LOCATION OF EXISTING UTILITIES.
2. PRIOR TO CONSTRUCTION, THE CONTRACTOR SHALL EXCAVATE AND VERIFY THE HORIZONTAL AND VERTICAL LOCATIONS OF ALL OBSTRUCTIONS. SHOULD A CONFLICT EXIST, THE CONTRACTOR SHALL NOTIFY THE ENGINEER SO THAT THE CONFLICT CAN BE RESOLVED WITH MINIMUM AMOUNT OF DELAY.
3. ALL NEW STREET PAVING, DRIVEWAYS, SIDEWALKS, AND CURB AND GUTTERS ABUTTING EXISTING AREAS SHALL MATCH THE ELEVATION OF THOSE AREAS.
4. THE CONTRACTOR SHALL ASSUME RESPONSIBILITY FOR ANY DAMAGE TO EXISTING PAVING OR CURB AND GUTTER DURING CONSTRUCTION, APART FROM THOSE SECTIONS INDICATED FOR REMOVAL ON THE PLANS, AND SHALL REPAIR OR REPLACE SAME AT HIS OWN EXPENSE. HE SHALL SUITABLY PROTECT THE CURB AND GUTTER FROM INCIDENTAL SPLASHING DURING THE TACK COAT APPLICATION AND SHALL BE RESPONSIBLE FOR CLEANING SAME AT HIS OWN COST SHOULD SPLASHING OCCUR.
5. ALL UTILITY LINES WHICH ARE NOT SPECIFICALLY DESIGNATED TO BE REMOVED AND REPLACED ON THE PLANS SHALL BE MAINTAINED IN SERVICE. SHORING, SHEETING, AND OTHER MEANS OF SUPPORT SHALL BE EMPLOYED BY THE CONTRACTOR TO PREVENT DAMAGE OR LOSS OF THESE EXISTING UTILITIES. BEAM AND CABLE OR OTHER ADEQUATE SUPPORTS SHALL BE USED FOR TEMPORARY SUPPORT OF ALL UTILITY LINES WHICH CROSS TRENCHES. ANY DAMAGE TO EXISTING UTILITIES SHALL PROMPTLY BE REPAIRED AT THE CONTRACTOR'S EXPENSE. THE ENGINEER SHALL BE IMMEDIATELY NOTIFIED OF ANY SIGNIFICANT DEVIATION OF EXPOSED UTILITIES FROM THE LOCATIONS SHOWN ON THE PLANS SO THAT CONFLICTS CAN BE RESOLVED IN A TIMELY MANNER.
6. ALL MANHOLE AND CHANNEL STEPS SHALL BE 1/2" GRADE 60 STEEL REINFORCING ROD ENCAPSULATED IN A CO-POLYMER POLYPROPYLENE AS MANUFACTURED BY M.A. INDUSTRIES, INC. (MODEL #P-2-PFS) STEPS ARE NOT TO BE PRECAST IN PLACE BUT SHALL BE INSTALLED AS RECOMMENDED BY THE MANUFACTURER.
7. ALL MANHOLE COVERS, WATER VALVES, OR OTHER SERVICE ACCESS SHALL MATCH EXISTING GRADE OF PAVEMENT ON UNPAVED SURFACES. THESE SHALL MATCH EXISTING GROUND SURFACES OR FINAL GRADES, WHICHEVER APPLIES.
8. PAVEMENT REPLACEMENT. ALL ASPHALT PAVEMENT REPLACEMENT SHALL BE IN ACCORDANCE WITH STD. DWG. P-25. ARTERIAL SECTION SHALL BE USED ON GIBSON BLVD. RESIDENTIAL SECTION SHALL BE USED ON ALL REMAINING STREETS.
9. DRIVEPADS SHALL MEET THE 6.5' MINIMUM DEPTH REQUIREMENT PER ALBUQUERQUE STANDARD DRAWINGS P-11 UNLESS RIGHT-OF-WAY IS UNAVAILABLE.
10. RIGHT-OF-WAY SHOWN IS APPARENT RIGHT-OF-WAY DETERMINED FROM PLAT MAPS AND LOCATED PROPERTY TIES.
11. ALL WATER CONNECTIONS ARE WET CONNECTIONS UNLESS OTHERWISE NOTED ON PLANS.
12. THE CONTRACTOR IS TO COORDINATE UTILITY RELOCATIONS TO BE PERFORMED BY OTHERS DURING ALL PHASES OF CONSTRUCTION.
13. ALL DISTURBED AREAS WITH SLOPES EQUAL TO OR FLATTER THAN 4H:1V SHALL BE SEEDDED WITH CLASS 'A' SEEDING, EXCEPT FOR THE BOTTOM OF EARTHEN CHANNELS, AND ALL DISTURBED AREAS WITH SLOPES STEEPER THAN 4H:1V SHALL BE SEEDDED WITH CLASS 'B' SEEDING, UNLESS OTHERWISE DIRECTED BY THE ENGINEER.
14. CASEMENT SLEEVES AND WATER LINE AND SANITARY SEWER LINE REPLACEMENTS SHALL BE INSTALLED IN ACCORDANCE WITH THE TECHNICAL SPECIFICATIONS OF THE "CITY OF ALBUQUERQUE INTERIM STANDARD SPECIFICATIONS FOR PUBLIC WORKS CONSTRUCTION, 1985 EDITION.

CONCRETE NOTES

1. CONCRETE FOR BOX CULVERT STRUCTURES SHALL BE CLASS 'A' OR 'B' AS NOTED AND SHALL HAVE A SPECIFIED MINIMUM COMPRESSIVE STRENGTH OF 4000 PSI AT 28 DAYS.
2. CONCRETE FOR CHANNEL LINING AND CHANNEL APPURTENANCES SHALL BE CLASS 'E' UNLESS OTHERWISE SPECIFICALLY SHOWN ON THE PLANS.
3. REINFORCING SHALL CONFORM TO THE REQUIREMENTS OF ASTM A615 GRADE 60.
4. UNLESS OTHERWISE NOTED, LAPS, SPLICES OR EMBEDMENT LENGTHS SHALL CONFORM TO TABLE 20.1 ACI MANUAL SP-17 CLASS B SPLICE.
5. UNLESS OTHERWISE NOTED, CONCRETE COVER UNDER STEEL SHALL BE 2" FOR FORMED CONCRETE AND 3" FOR CONCRETE CAST AGAINST EARTH.
6. REINFORCING SHALL BE CONTINUOUS AROUND ALL CORNERS UNLESS SHOWN OTHERWISE.
7. UNLESS OTHERWISE SHOWN, ALL EXPOSED CORNERS SHALL HAVE 3/4" CHAMFER OR TOOLED EDGE AS DIRECTED.
8. CHANNEL REBAR SHALL BE SUPPORTED ON 3 1/2" SAND CHAIRS AT A MAXIMUM SPACING OF 5' PERPENDICULAR TO THE CHANNEL CENTERLINE.

BENCH MARK

CITY OF ALBUQUERQUE
B.M. 1-M3 BRASS CAP
S.W. QUADRANT OF INTERSECTION
OF 98th ST. & GIBSON BLVD.
44' WEST FROM CENTER OF 98th
27.5' SOUTH OF E. OF GIBSON BLVD.
E.L. 5147.80

TBM
BENAVIDES RD. & JENARO ST.
S.E. CURB RETURN (BACK OF CURB)
E.L. 5154.93

RECORD DRAWING

Date: 9/1/86
These drawings have been revised based on field data and every reasonable attempt has been made to depict construction as actually performed.

Hydrologic and System Reference

William Matotán & Associates, "Drainage Management Plan, Western Albuquerque Metropolitan Area", 1975.

Gordon Herkenhoff and Associates, "Preliminary Design Analyses, Westgate Diversion Channels" April, 1986.

Gordon Herkenhoff and Associates, "Interim Design Report, Westgate Diversion Channels", Dec., 1986.

Gordon Herkenhoff and Associates, "Final Design Report, Snow Vista Channel Phase II", July 1987.

Drainage Areas and Design Discharges are shown at Points of Confluence on these Construction Drawings. The hydraulic information is shown for ultimate development.

Hydraulic Profile Legend

Q₁₀₀ = 100 yr. return frequency discharge

D_N = Normal flow depth

V_N = Normal flow velocity

D_C = Critical flow depth

F_R = Froude Number

n = Manning's friction factor

REACH	17	18	2A	2B	2C	2D	2E
Profile Type	Backwater	Backwater	Channel Basin	Expansion	Transition	Transition	Transition
Original (ft)	1.00	1.00	1.00	1.00	1.00	1.00	1.00
n	0.013	0.013	0.013	0.013	0.013	0.013	0.013
D or D _N (ft)	3.10	3.13	2.81	2.80	2.58	2.69	2.92
V or V _N (fps)	19.71	19.44	19.40	19.41	21.73	22.53	20.20
D _C (ft)	4.88	4.88	4.51	4.51	4.57	4.76	4.76
F _R	2.32	2.28	2.38	2.38	2.76	2.75	2.38
CHANNELS	Ultimate	Riprap	Lining				

REACH	3A	3B	3C	3D	3E
Profile Type	Supercritical	Forewater	Supercritical	Transition	Supercritical
		45+58.65		53+50	
		46+63.65		54+50	
Q _{P100} (cfs)	990	990	850	850	850
n	0.013	0.013	0.013	0.013	0.013
D or D _N (ft)	3.10	3.13	2.81	2.80	2.58
V or V _N (fps)	19.71	19.44	19.40	19.41	21.73
D _C (ft)	4.88	4.88	4.51	4.51	4.57
F _R	2.32	2.28	2.38	2.38	2.76

Superelevation =
0.65'

Superelevation =
0.33'

LASON 1-505-344-9404
BEST COPY AVAILABLE

26 17230287

AMAFCA

WESTGATE DIVERSION CHANNELS

SNOW VISTA CHANNEL PHASE II


LOCATION MAP &
GENERAL NOTES

GORDON HERKENHOFF & ASSOCIATES, INC.
ENGINEERS ARCHITECTS PLANNERS
ALBUQUERQUE SANTA FE

PLAN	BY	DATE
SURVEYED		
NOTED		
ALIGNED		
RT OF WAY		
NO		


DESIGNED BY
KOOGLER & POLLS ENGINEERING
13300 COMANCHE NE, ALBUQUERQUE, NM 87110

PROFILE	BY	DATE
SURVEYED		
NOTED		
ALIGNED		
RT OF WAY		
NO		

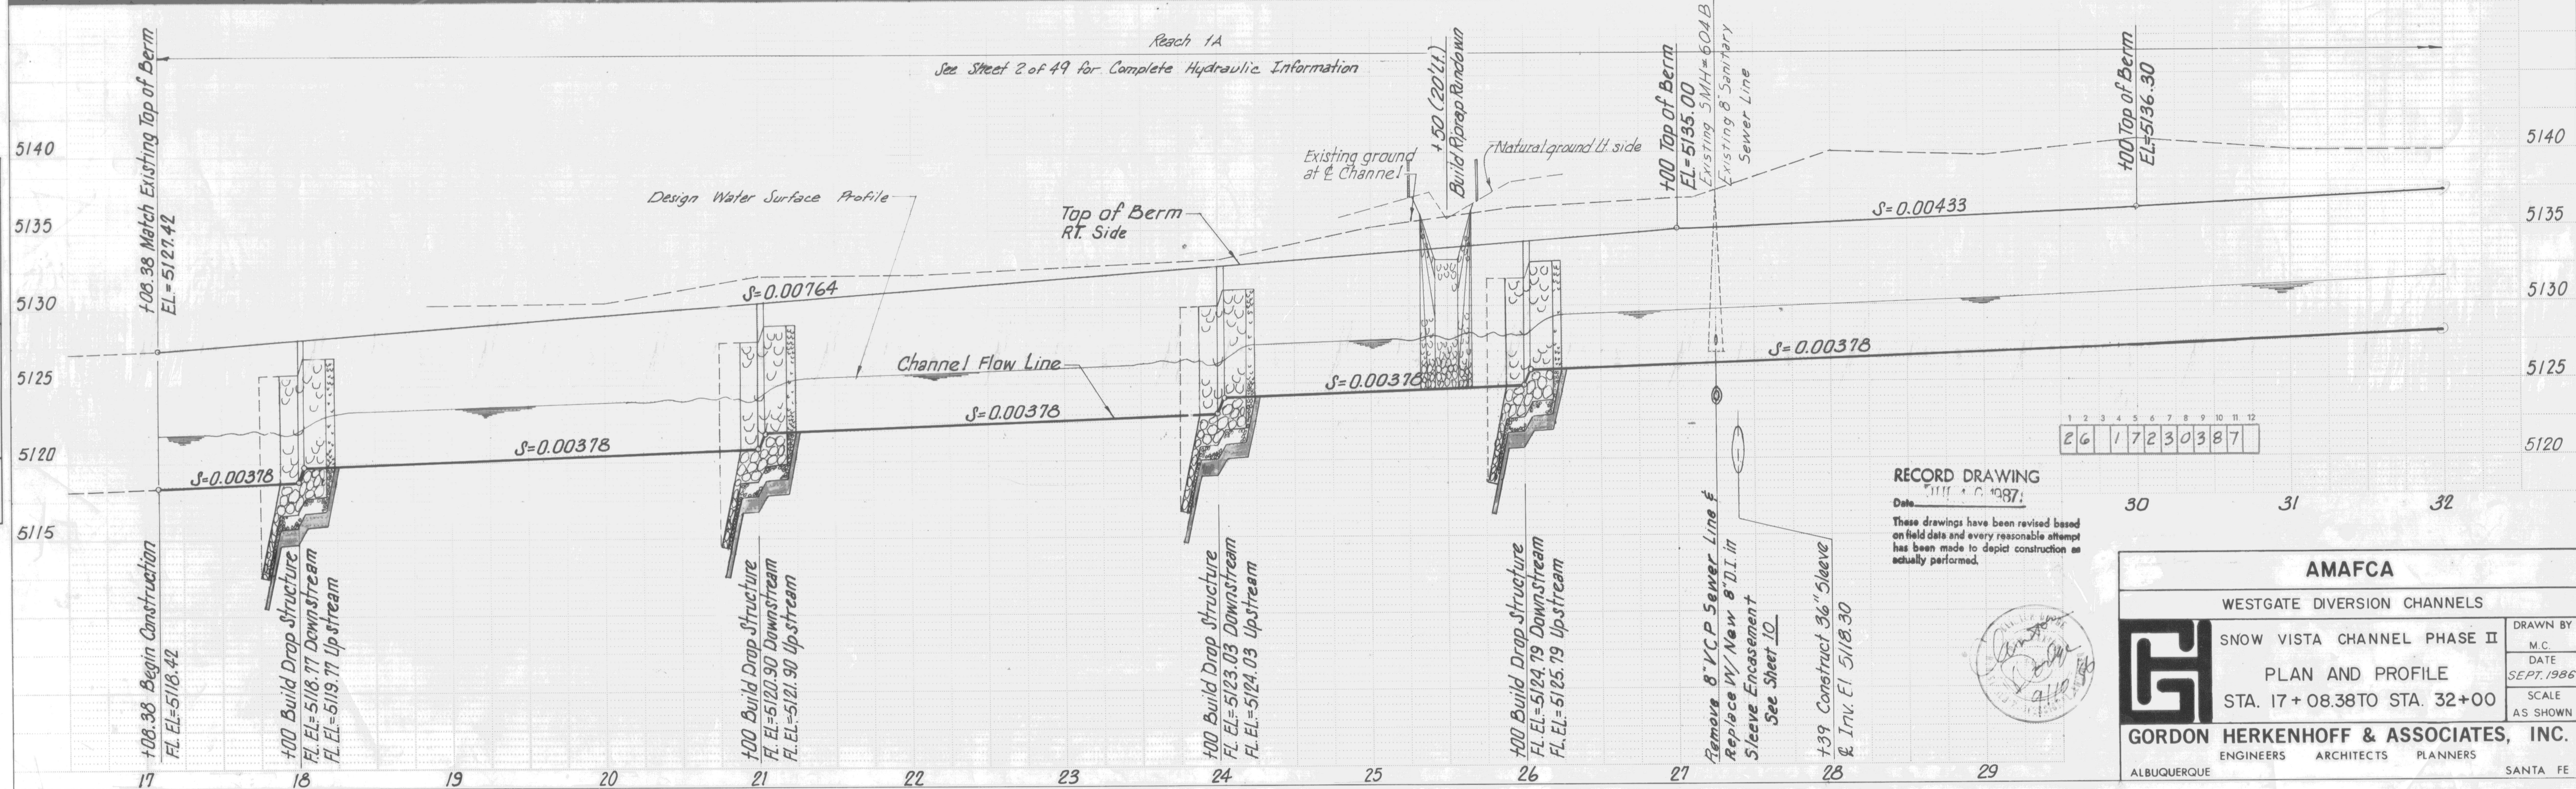

RECORD DRAWING
Date: 11/11/87
These drawings have been revised based on field data and every reasonable attempt has been made to depict construction as actually performed.



AMAFCA	
WESTGATE DIVERSION CHANNELS	
SNOW VISTA CHANNEL PHASE II	
PLAN AND PROFILE	
STA. 17+08.38 TO STA. 32+00	
GORDON HERKENHOFF & ASSOCIATES, INC.	
ENGINEERS ARCHITECTS PLANNERS	
ALBUQUERQUE	SANTA FE

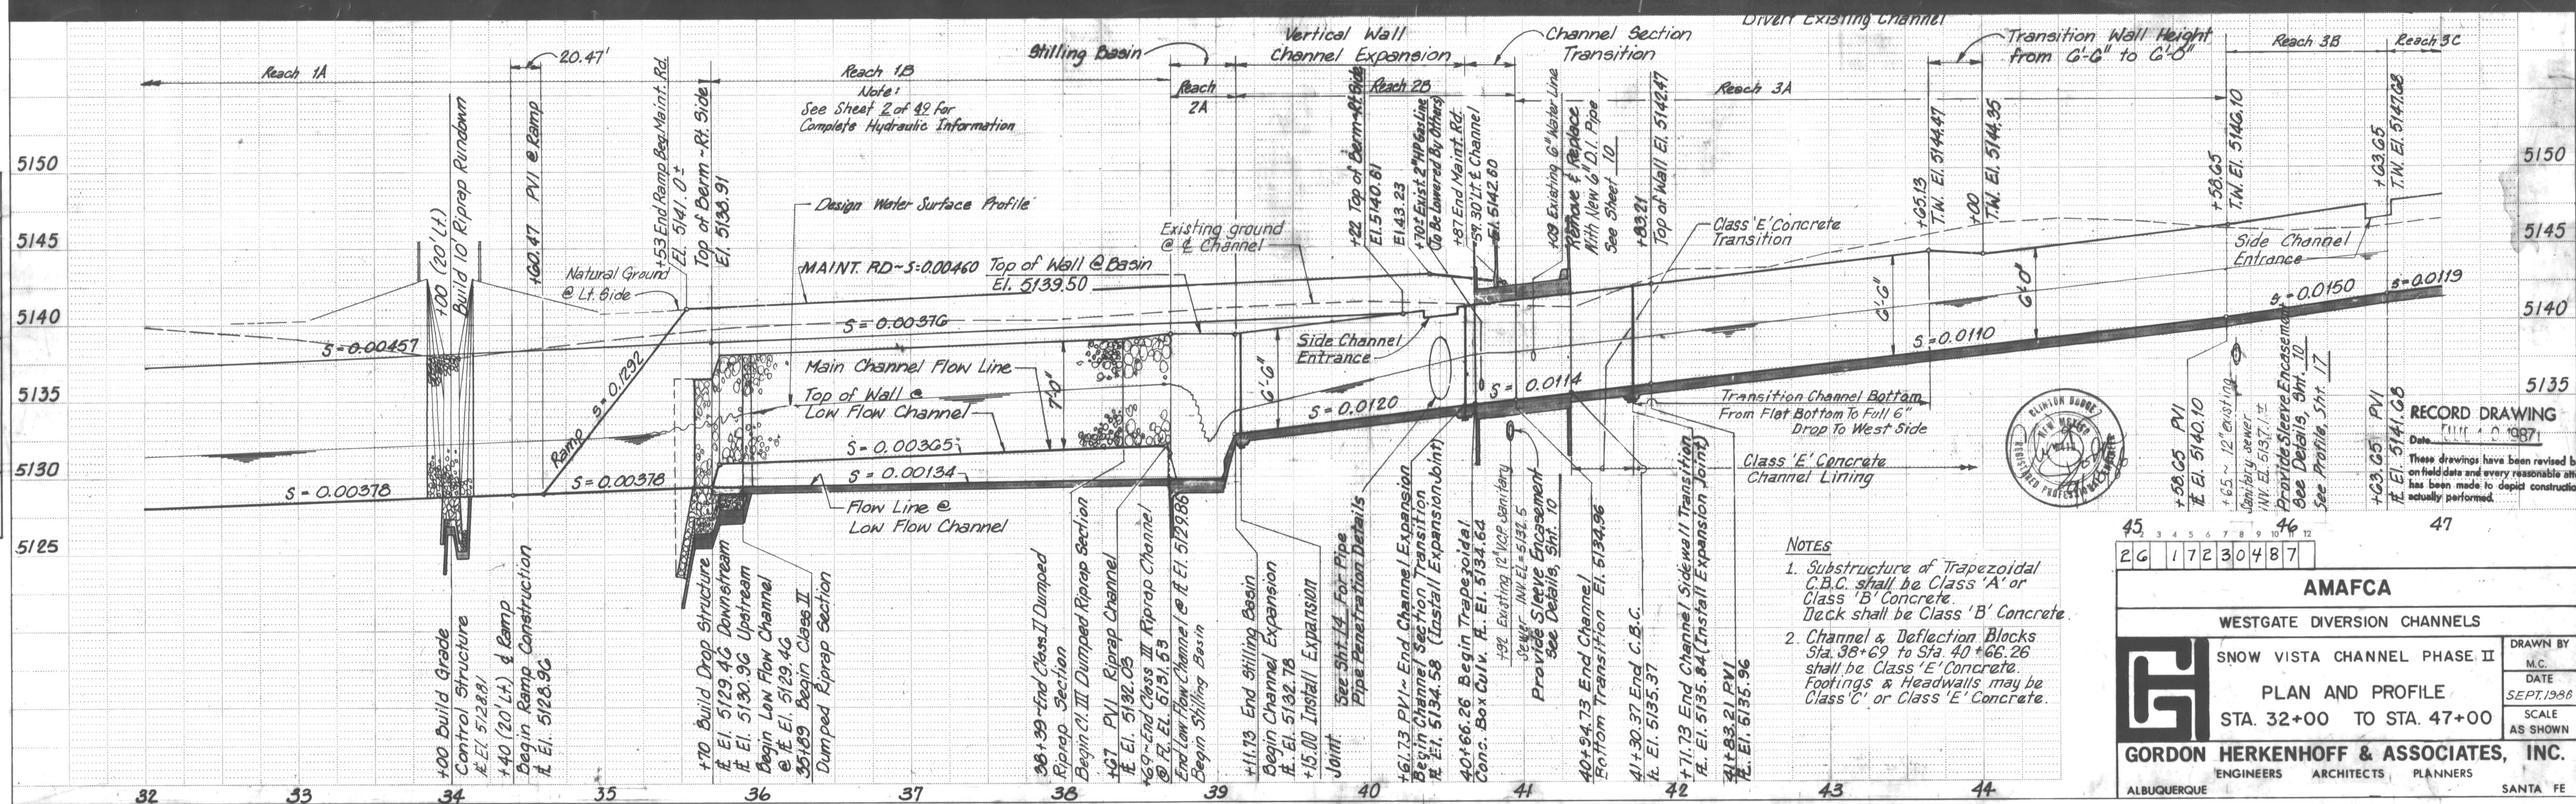

PLAN	DATE	BY	DATE
SURVEYED			
PLOTTED			
NOTED			
NO			

PHOTOGRAPHY BY
KODAK SAFETY FILM
KODAK SAFETY FILM
KODAK SAFETY FILM

PROFILE	DATE	BY	DATE
SURVEYED			
PLOTTED			
NOTED			
NO			

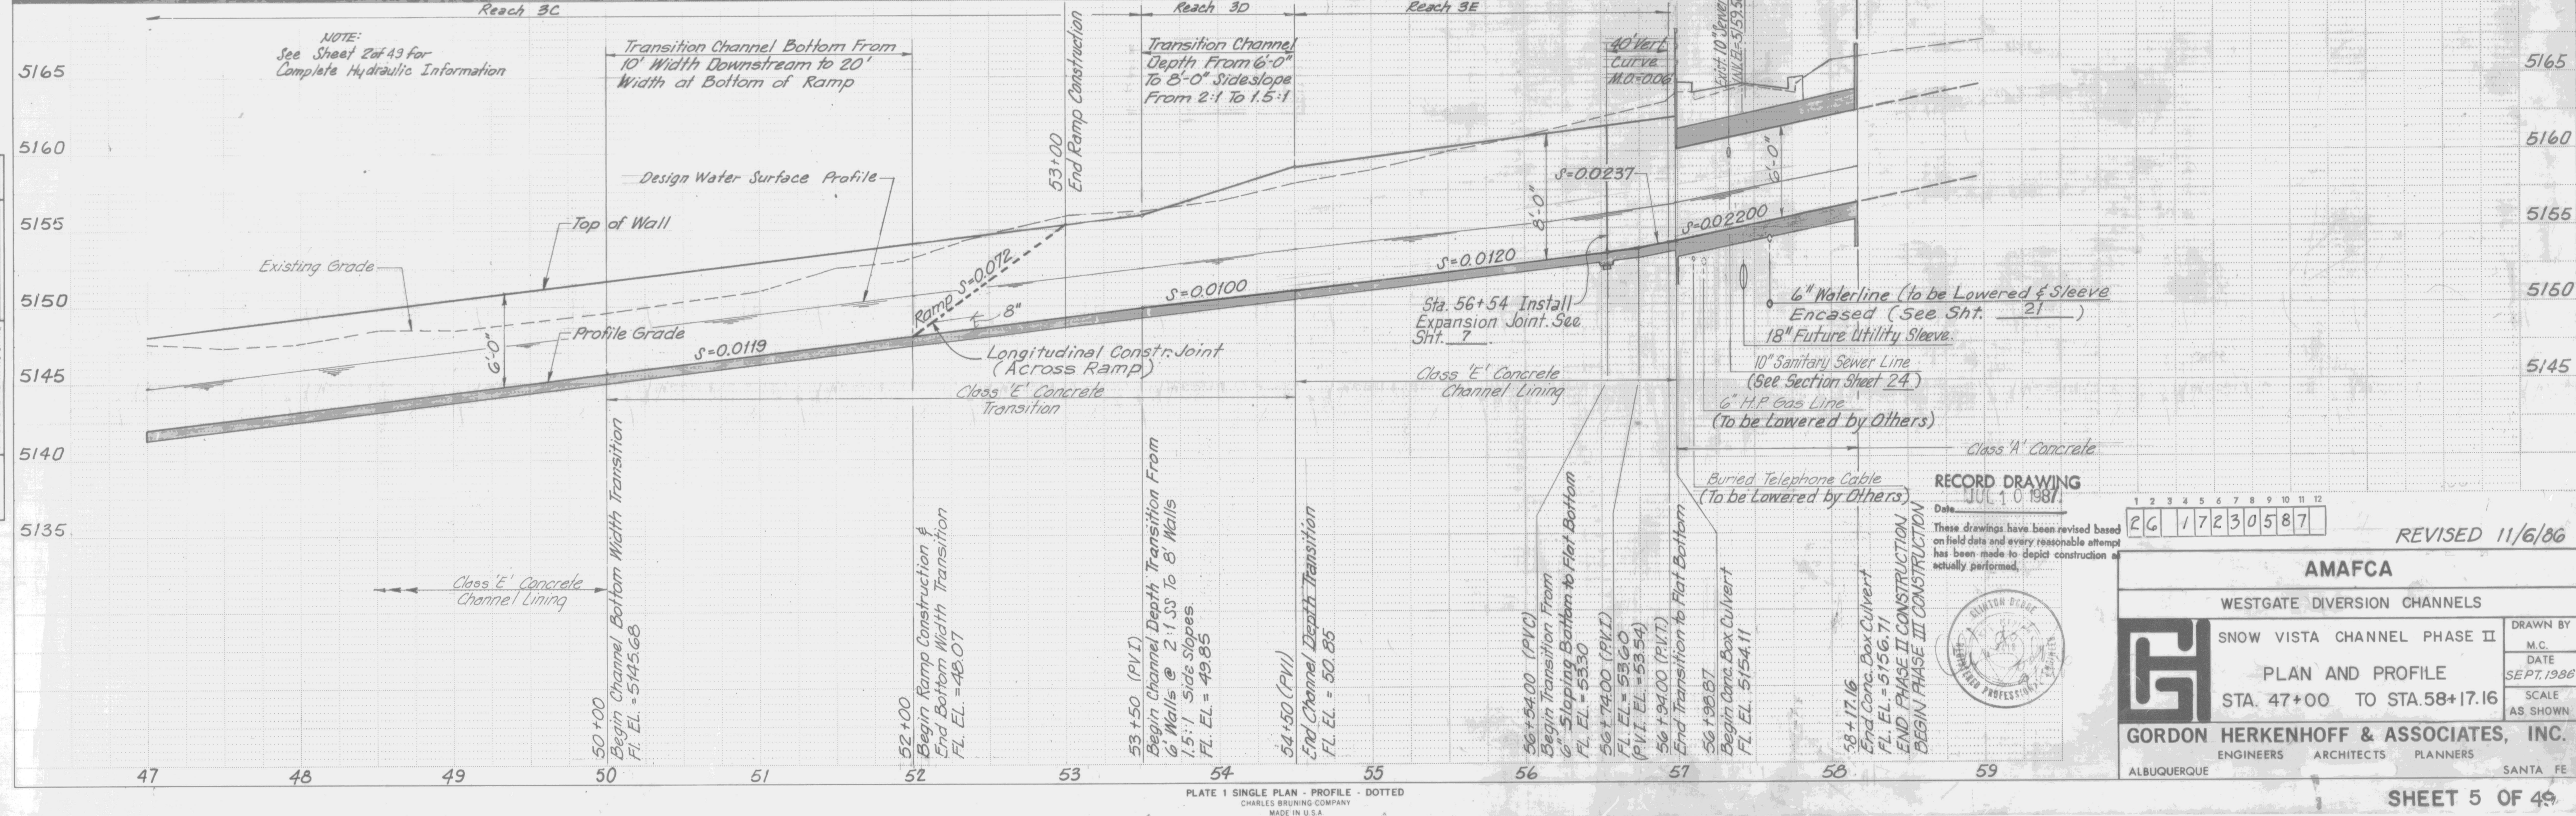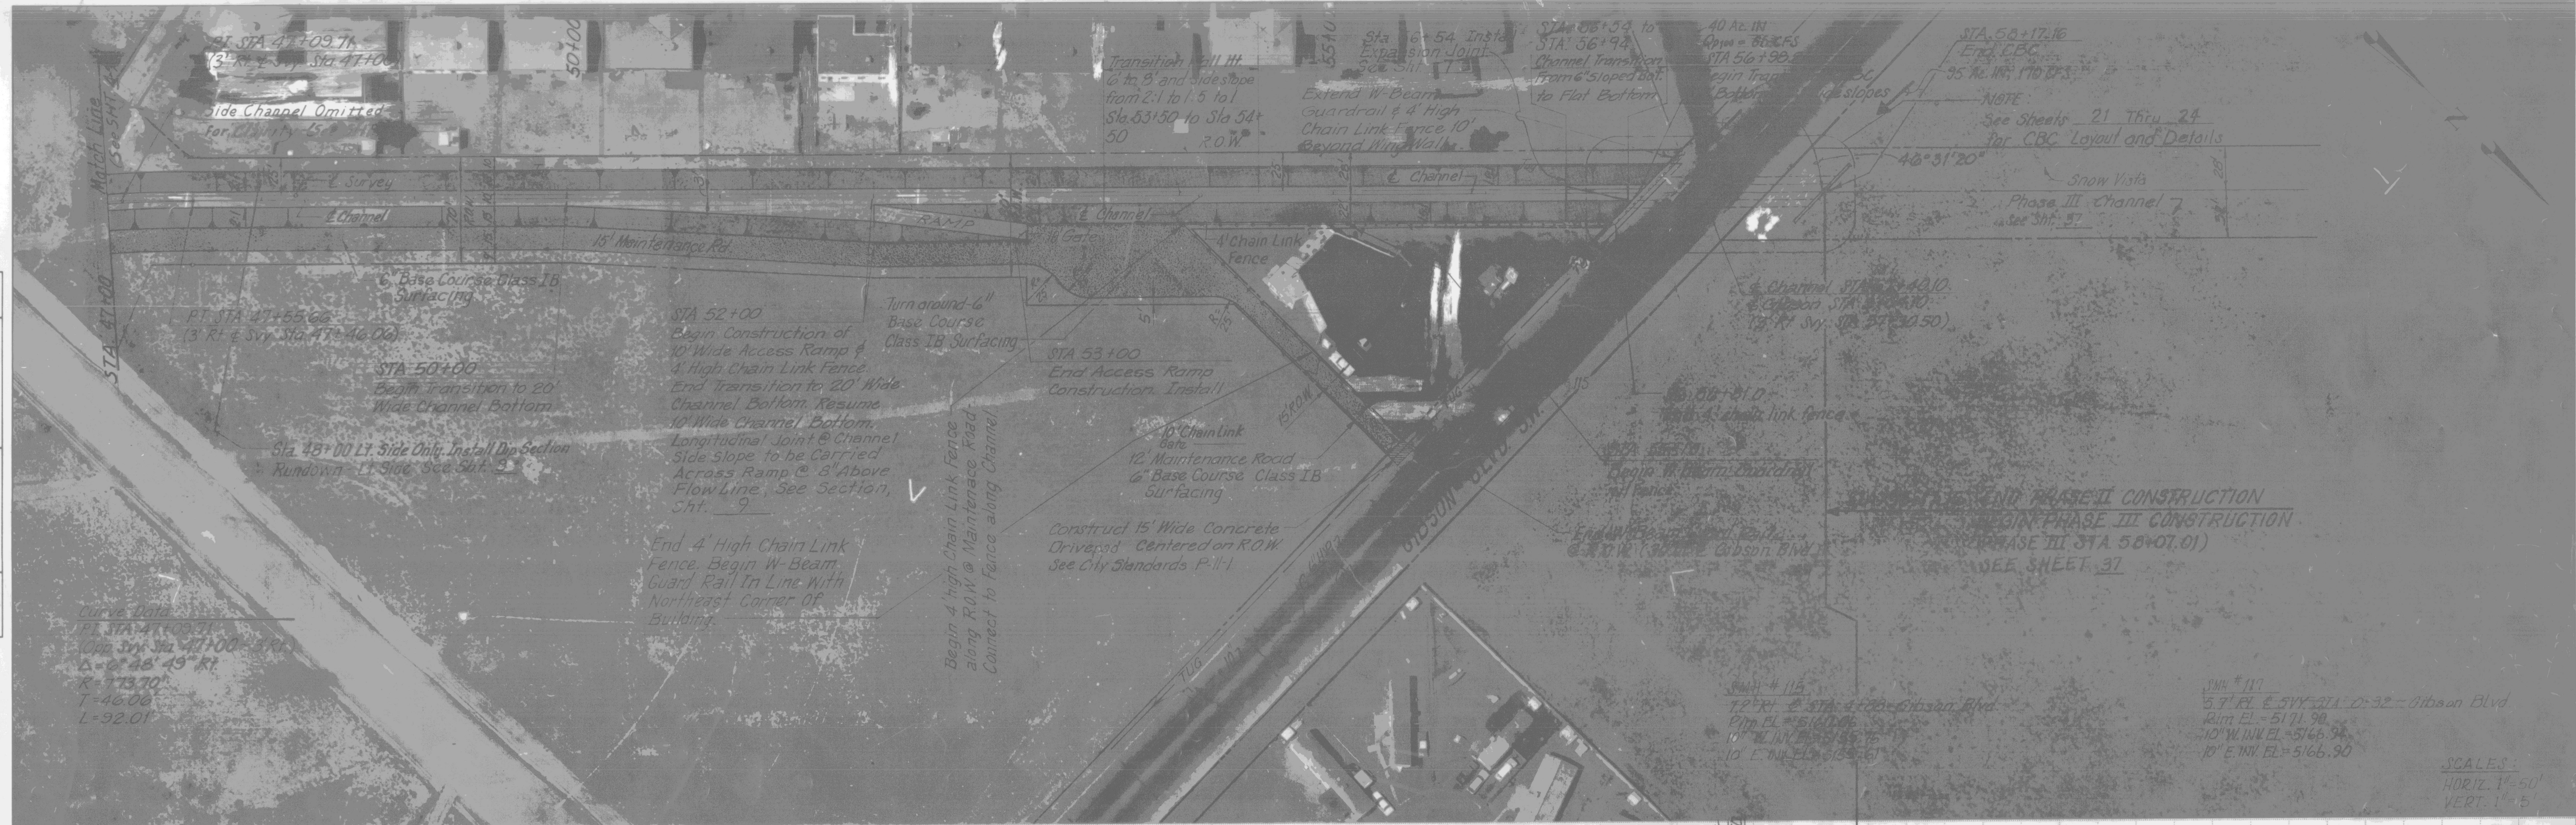

RECORD DRAWING
JUL 10 1987

These drawings have been revised based on field data and every reasonable attempt has been made to depict construction as actually performed.

1 2 3 4 5 6 7 8 9 10 11 12
26 17230587


REVISED 11/6/86

AMAFCA
WESTGATE DIVERSION CHANNELS

SNOW VISTA CHANNEL PHASE II
PLAN AND PROFILE
STA. 47+00 TO STA. 58+17.6

GORDON HERKENHOFF & ASSOCIATES, INC.
ENGINEERS ARCHITECTS PLANNERS
ALBUQUERQUE SANTA FE


DRAWN BY
M.C.
DATE
SEPT. 1986
SCALE
AS SHOWN

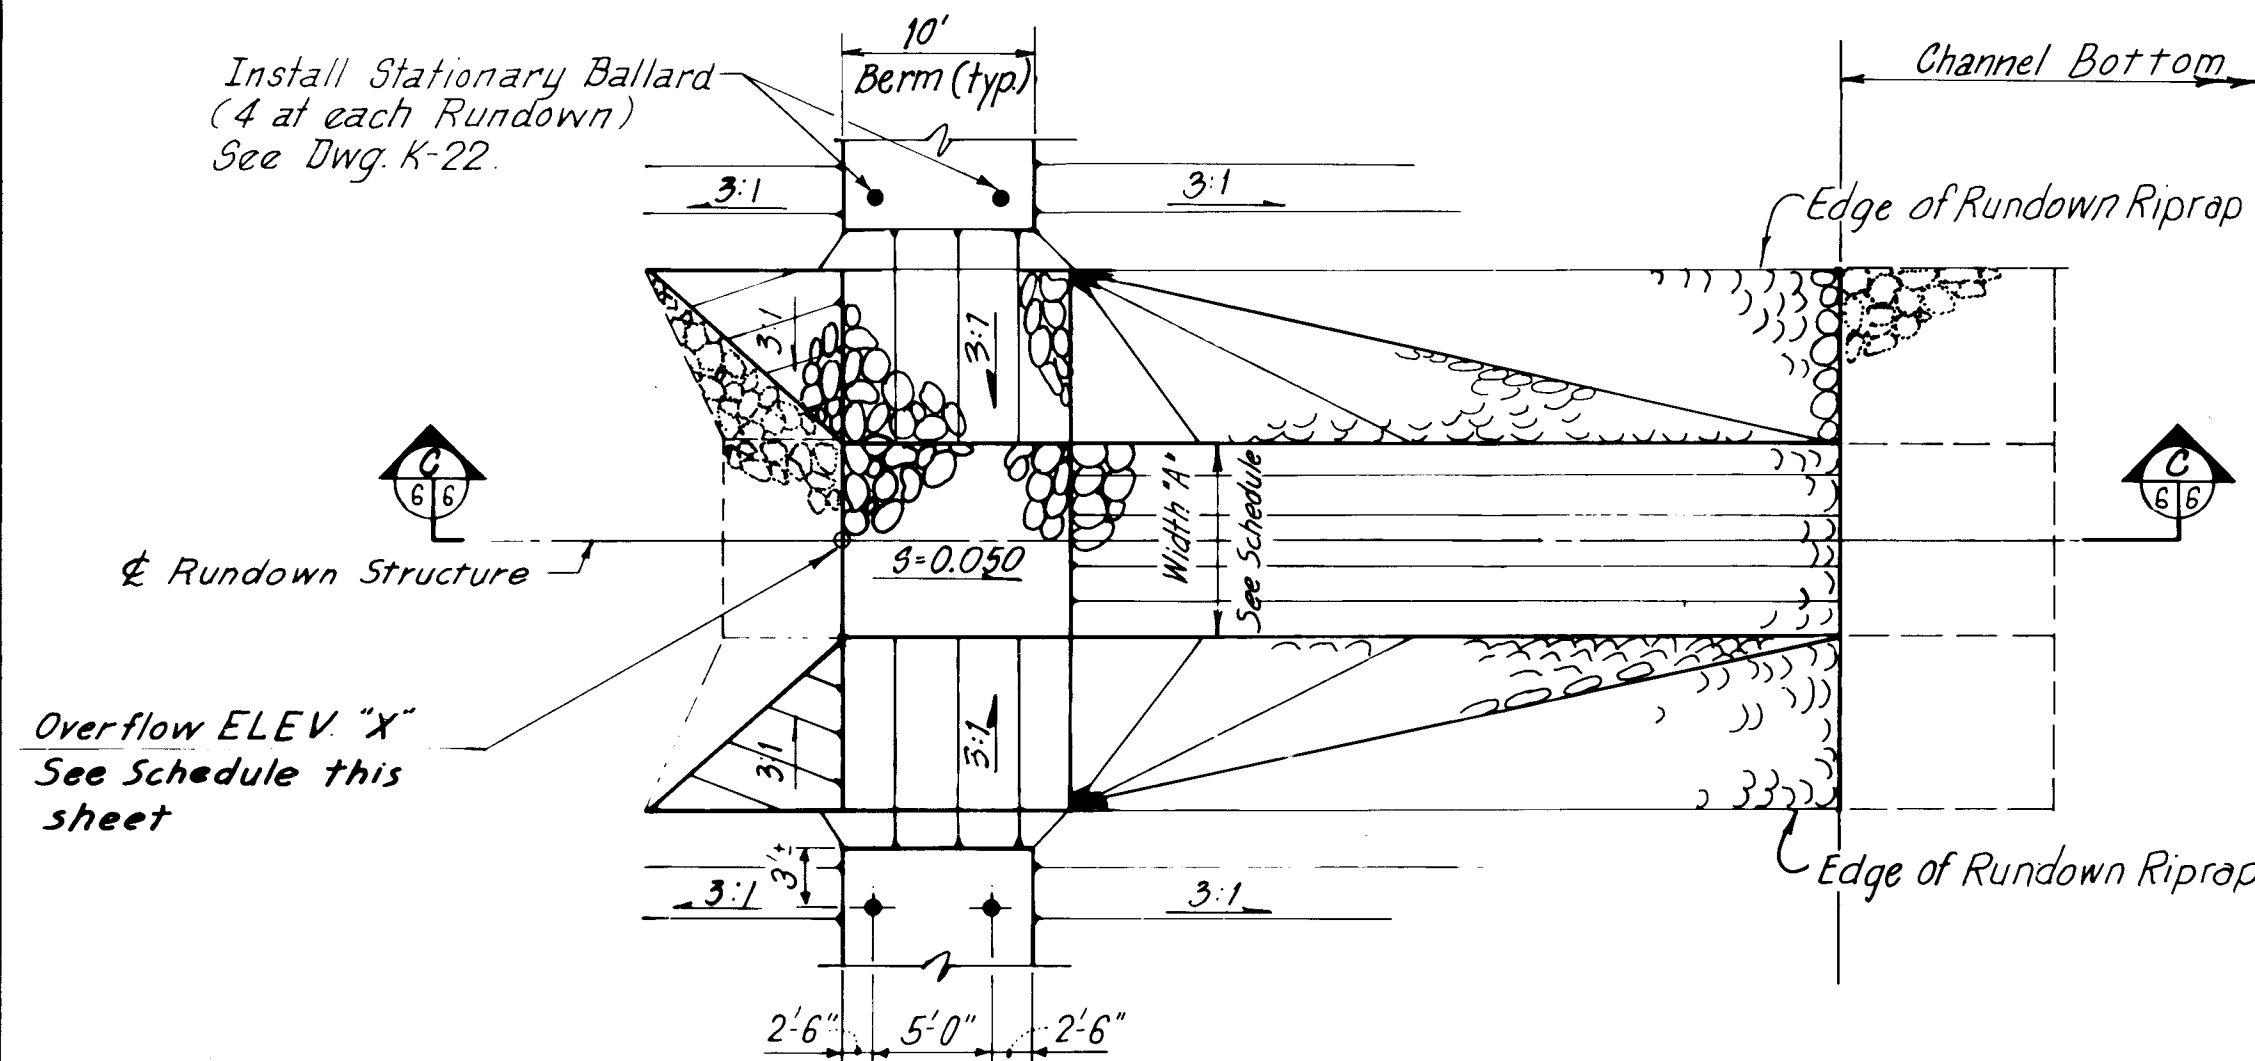


PLAN

STA.	WIDTH 'A'	OVERFLOW
25+50	15'	5133.0
34+00	10'	5138.0


NOTE: See Sheets 3 & 4 For Riprap Rundown Locations

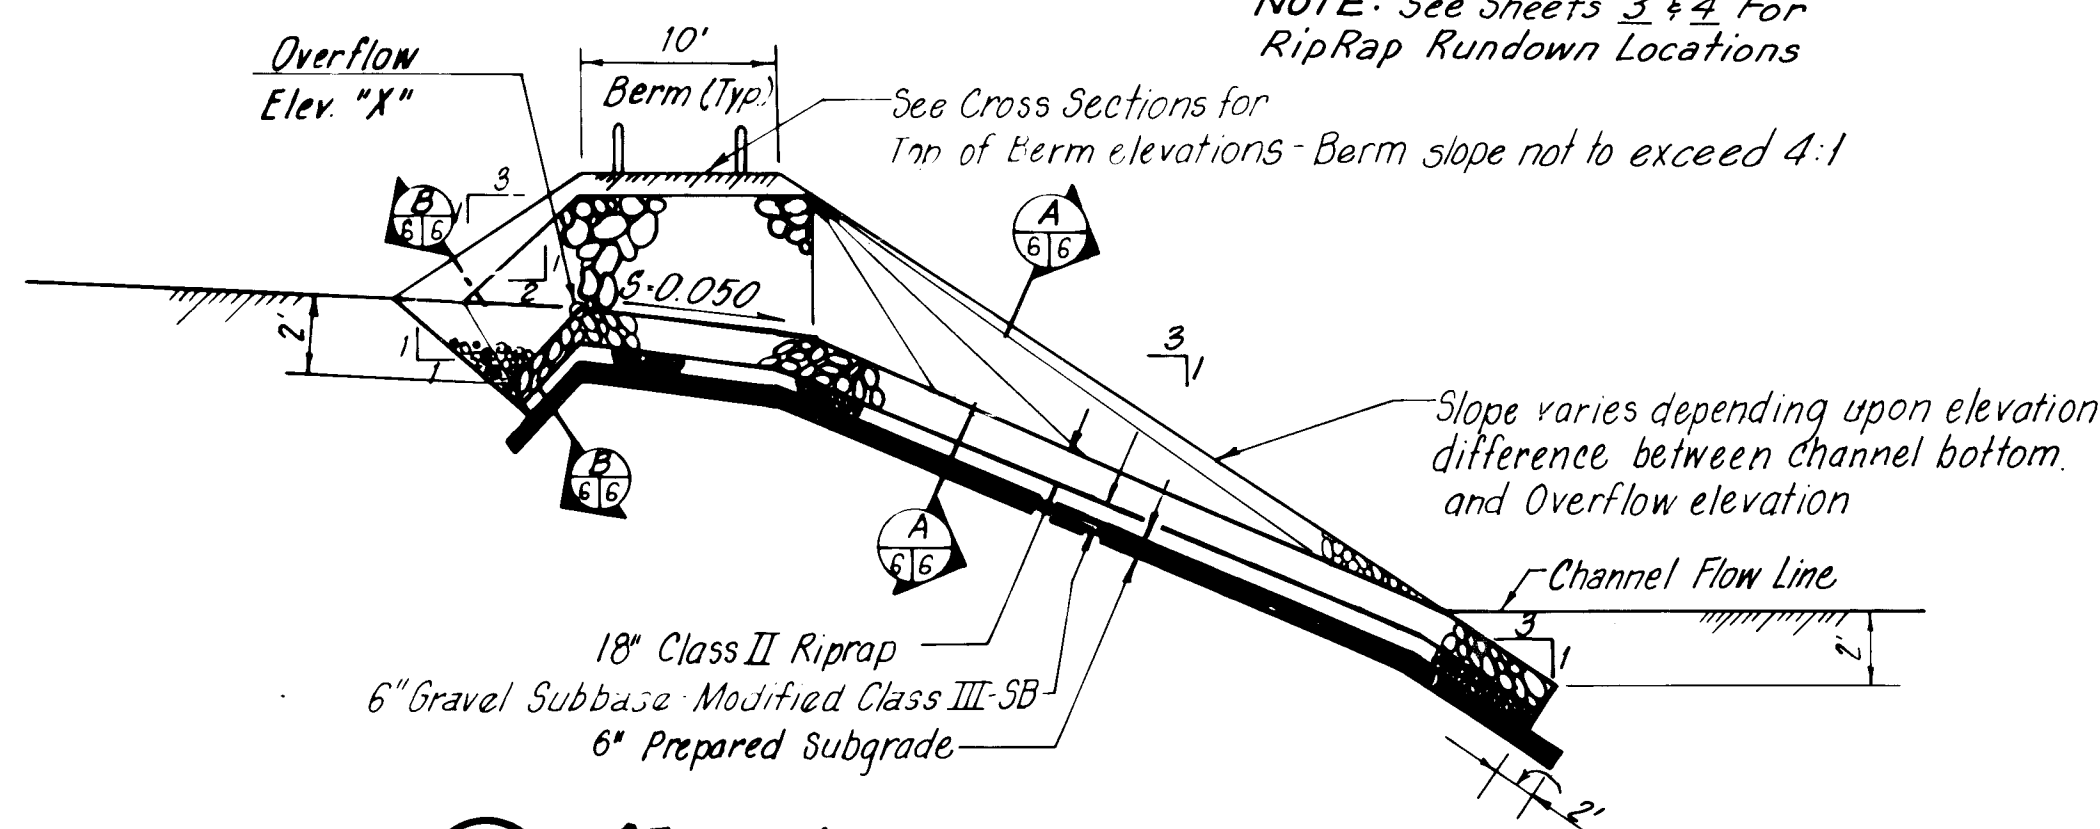

SECTION

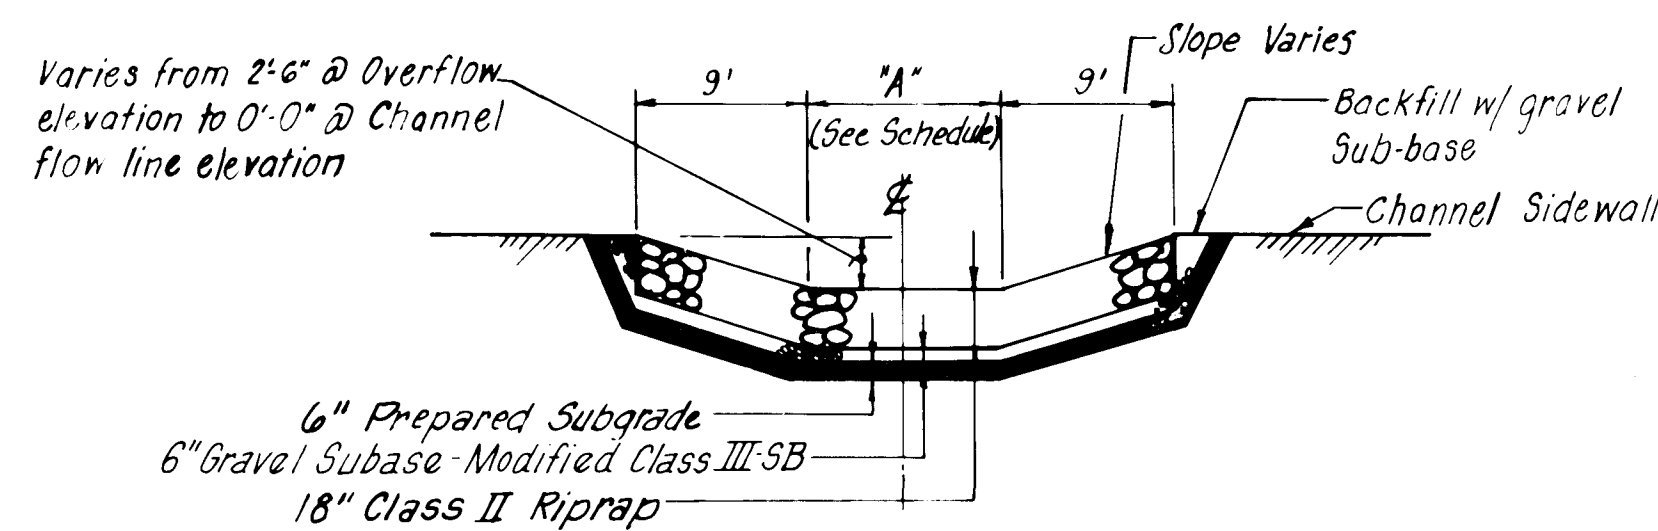


SECTION

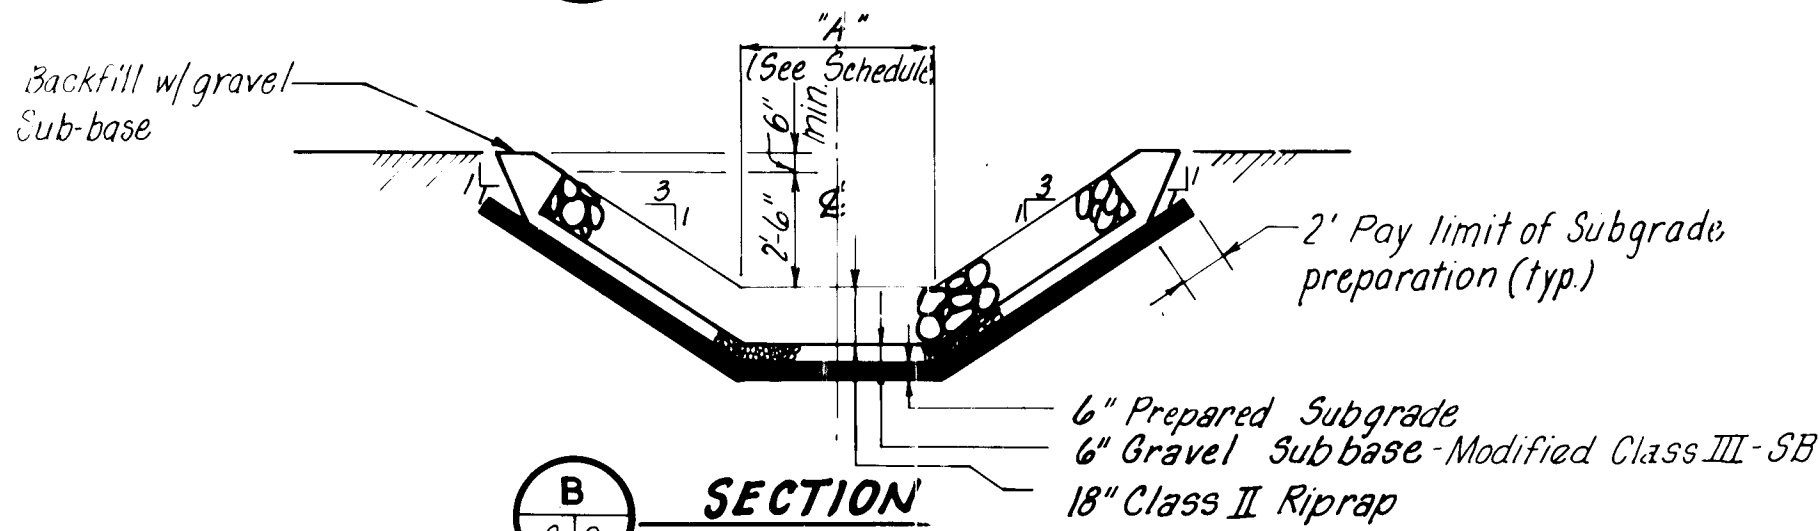

SECTION


RIPRAP RUNDOWN DETAILS

Scale: Horiz: 1" = 10'
Vert: 1" = 5'

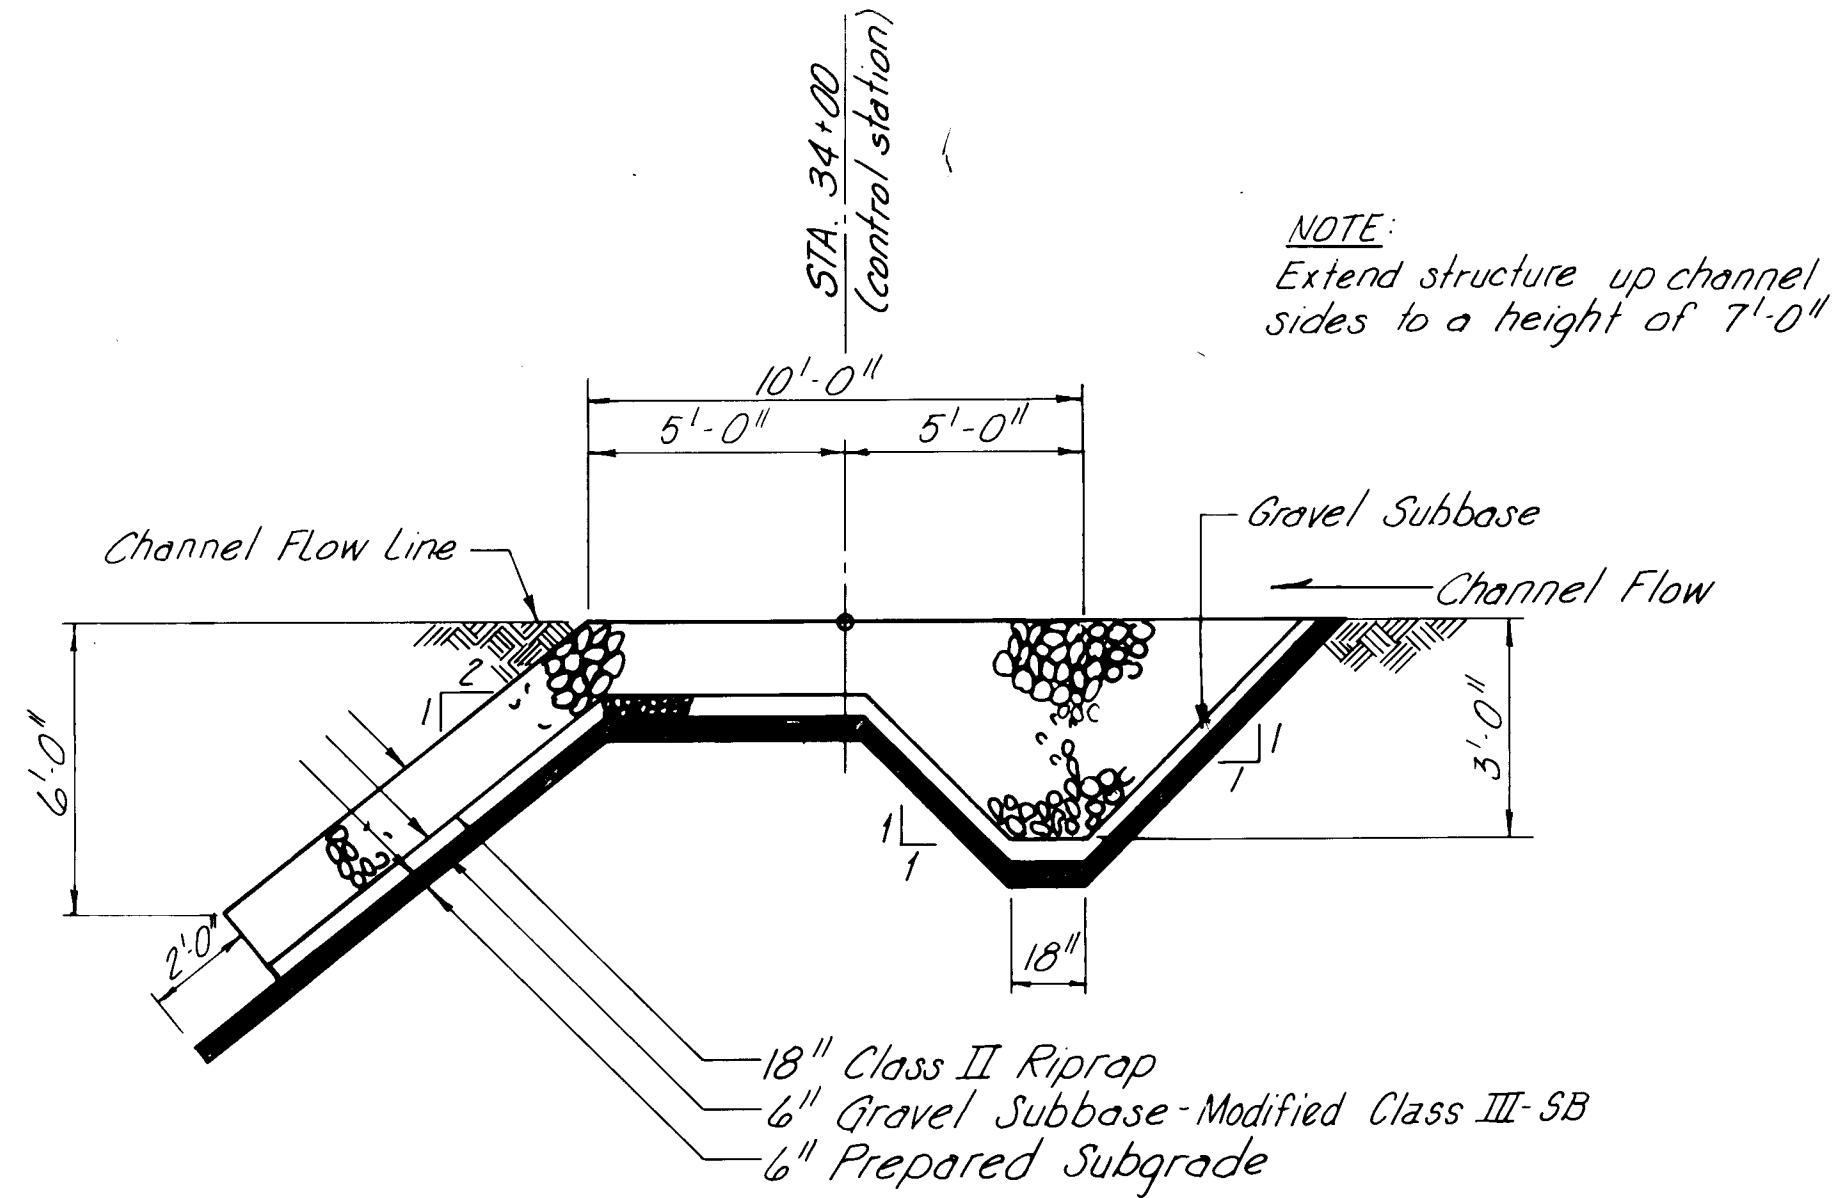


SECTION-RIPRAP GRADE CONTROL STRUCTURE

Scale: 1" = 4'

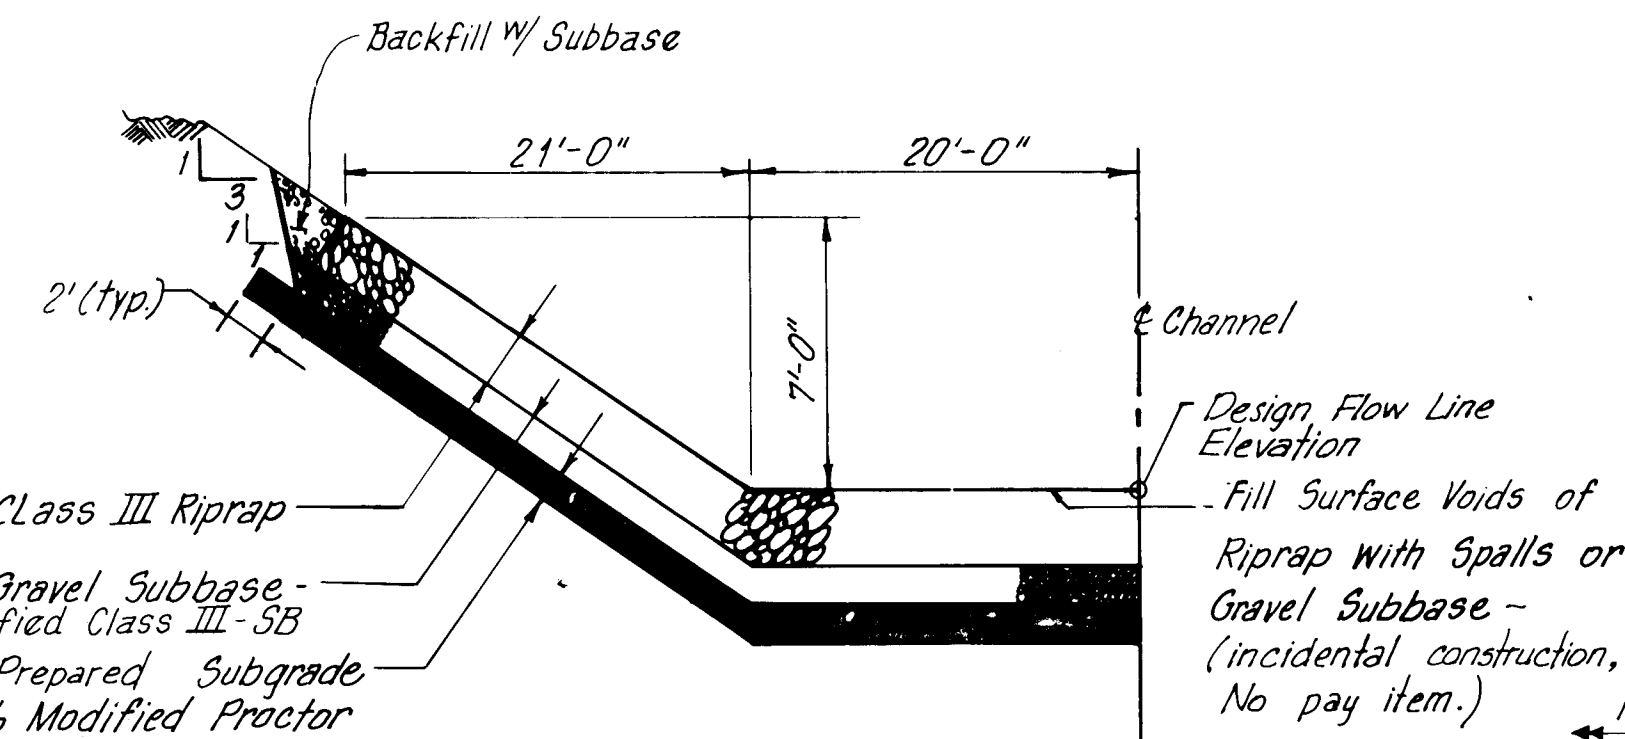


HALF SECTION

Scale: Horiz: 1" = 10'
Vert: 1" = 5'

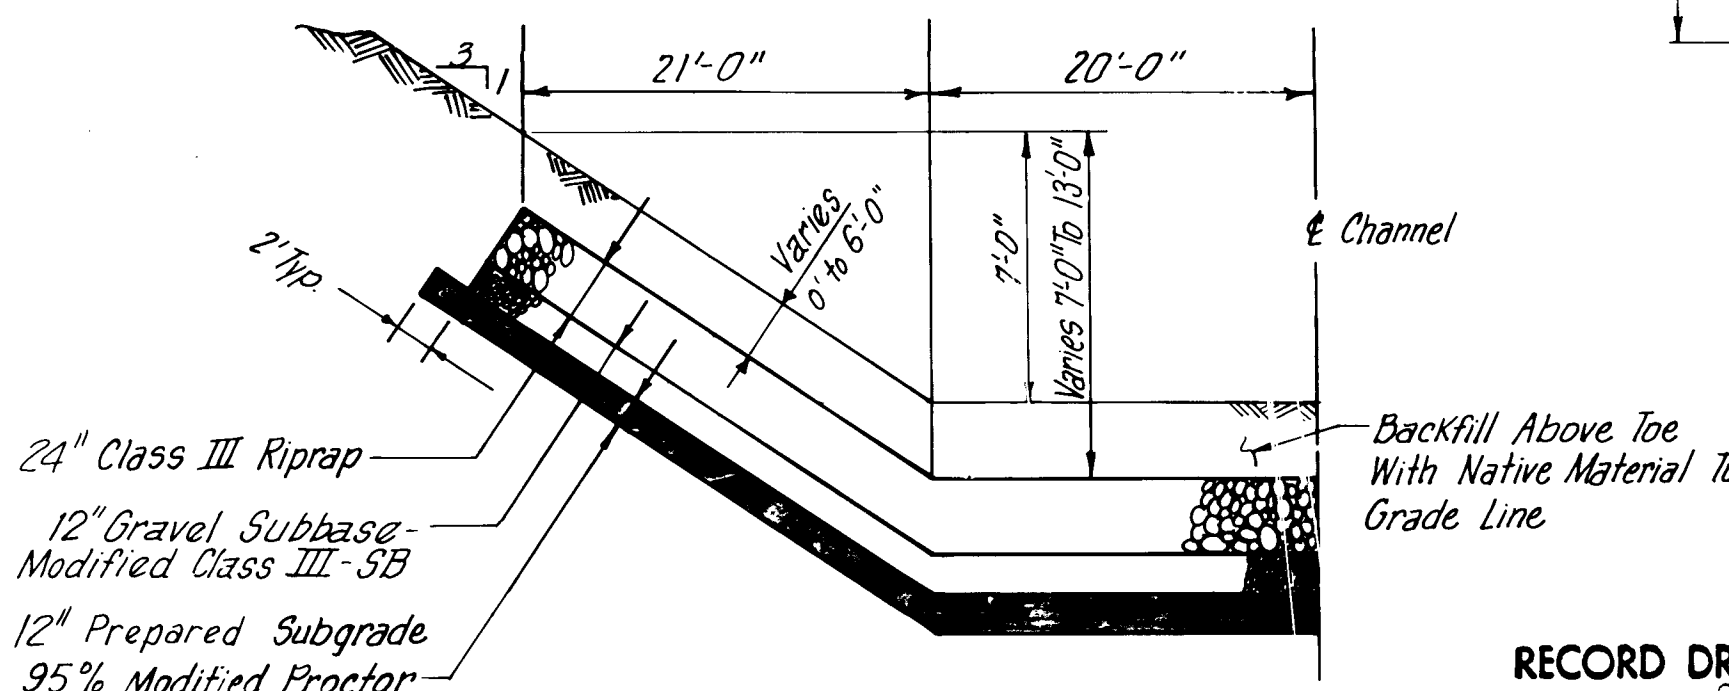


HALF SECTION

Scale: Horiz: 1" = 10'
Vert: 1" = 5'

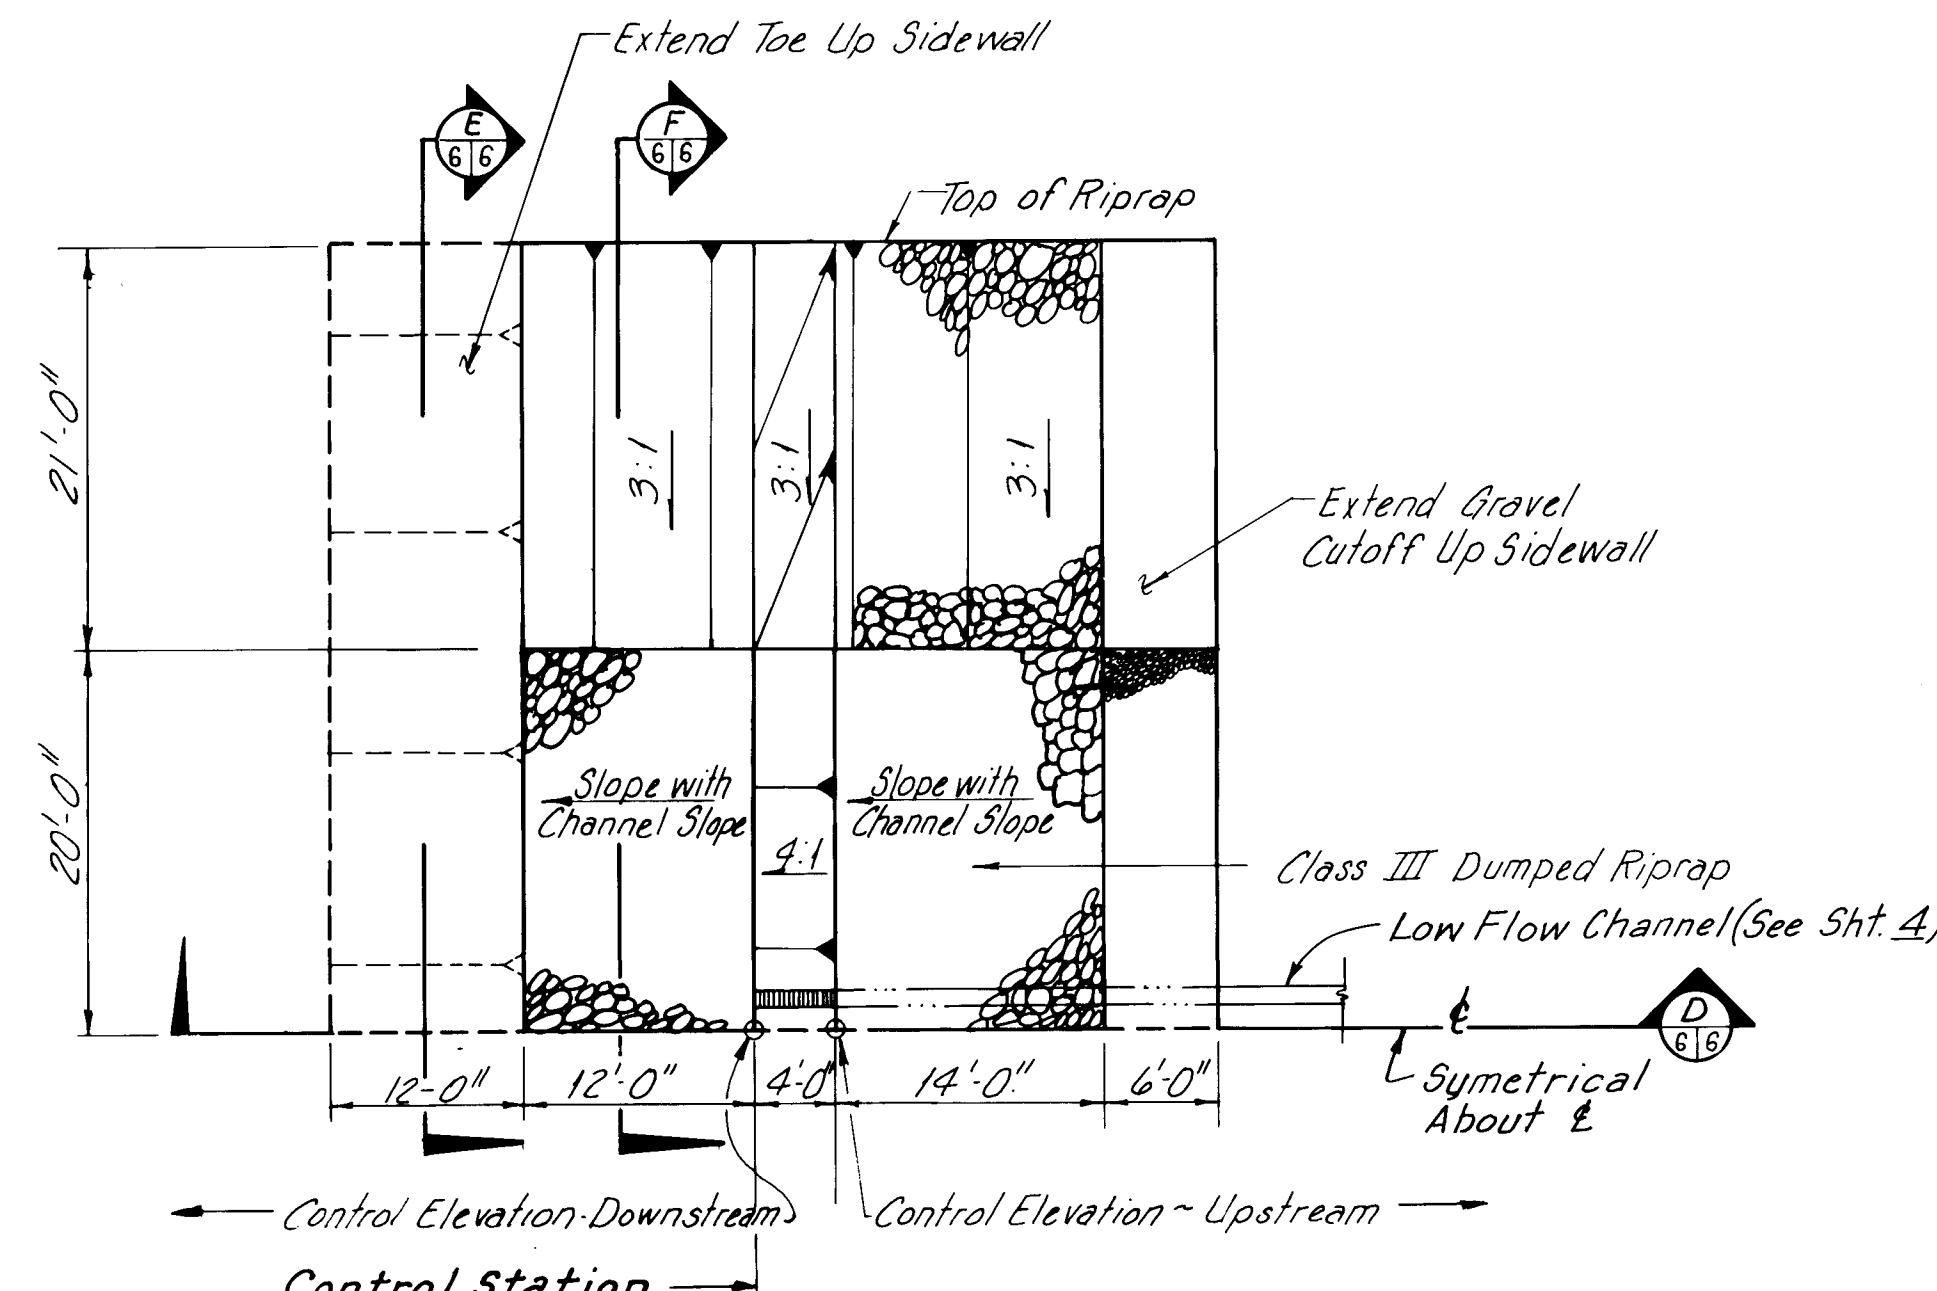

HALF PLAN-RIPRAP DROP STRUCTURE DETAIL

Scale: 1" = 10'

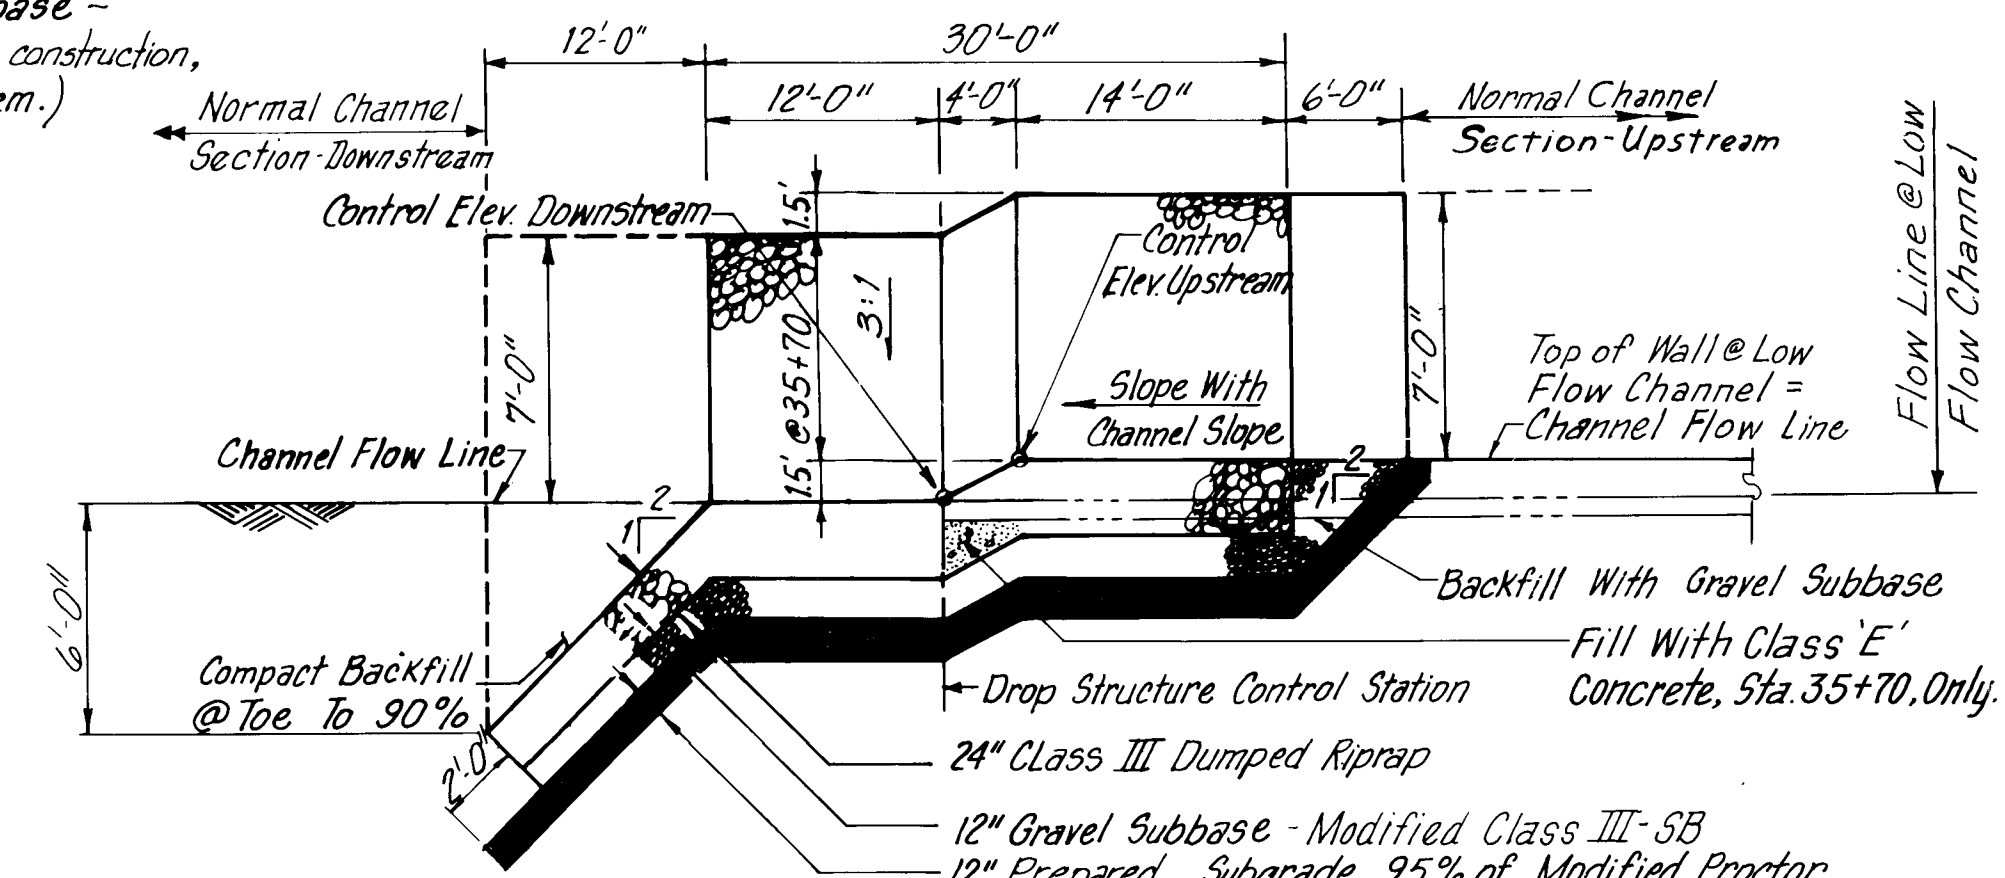

SECTION


Scale: Horiz: 1" = 10'
Vert: 1" = 5'

RECORD DRAWING
Date: JUL 10 1987
These drawings have been revised based on field data and every reasonable attempt has been made to depict construction as actually performed.




AMAFCA	
WESTGATE DIVERSION CHANNELS	
SNOW VISTA CHANNEL PHASE II DROP STRUCTURE, RUNDOWN, GRADE CONTROL RIPRAP & MISC. DETAILS	
GORDON HERKENHOFF & ASSOCIATES, INC.	
ALBUQUERQUE	SANTA FE


DRAWN BY ELK	DATE SEPT 1986
SCALE AS SHOWN	

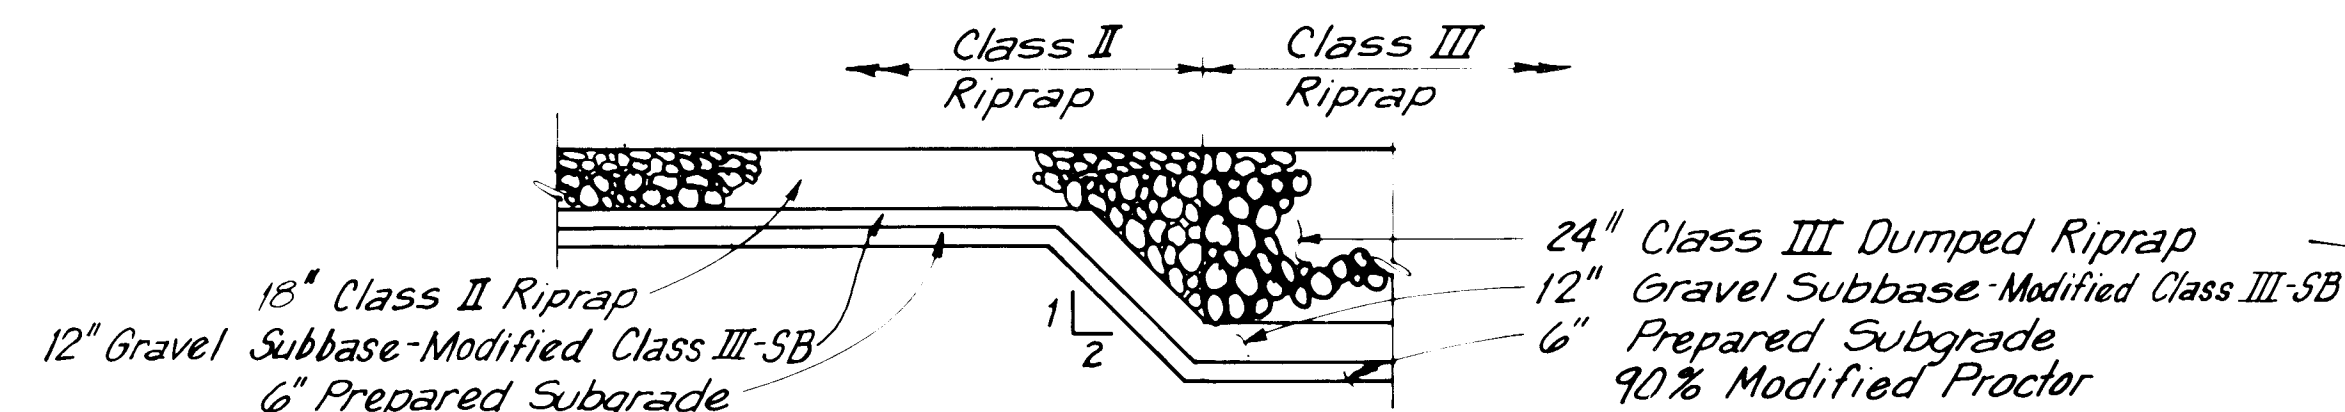


LONGITUDINAL SECTION @ STA. 38+39
(Transition from Class II Riprap to Class III Riprap)
Not to Scale

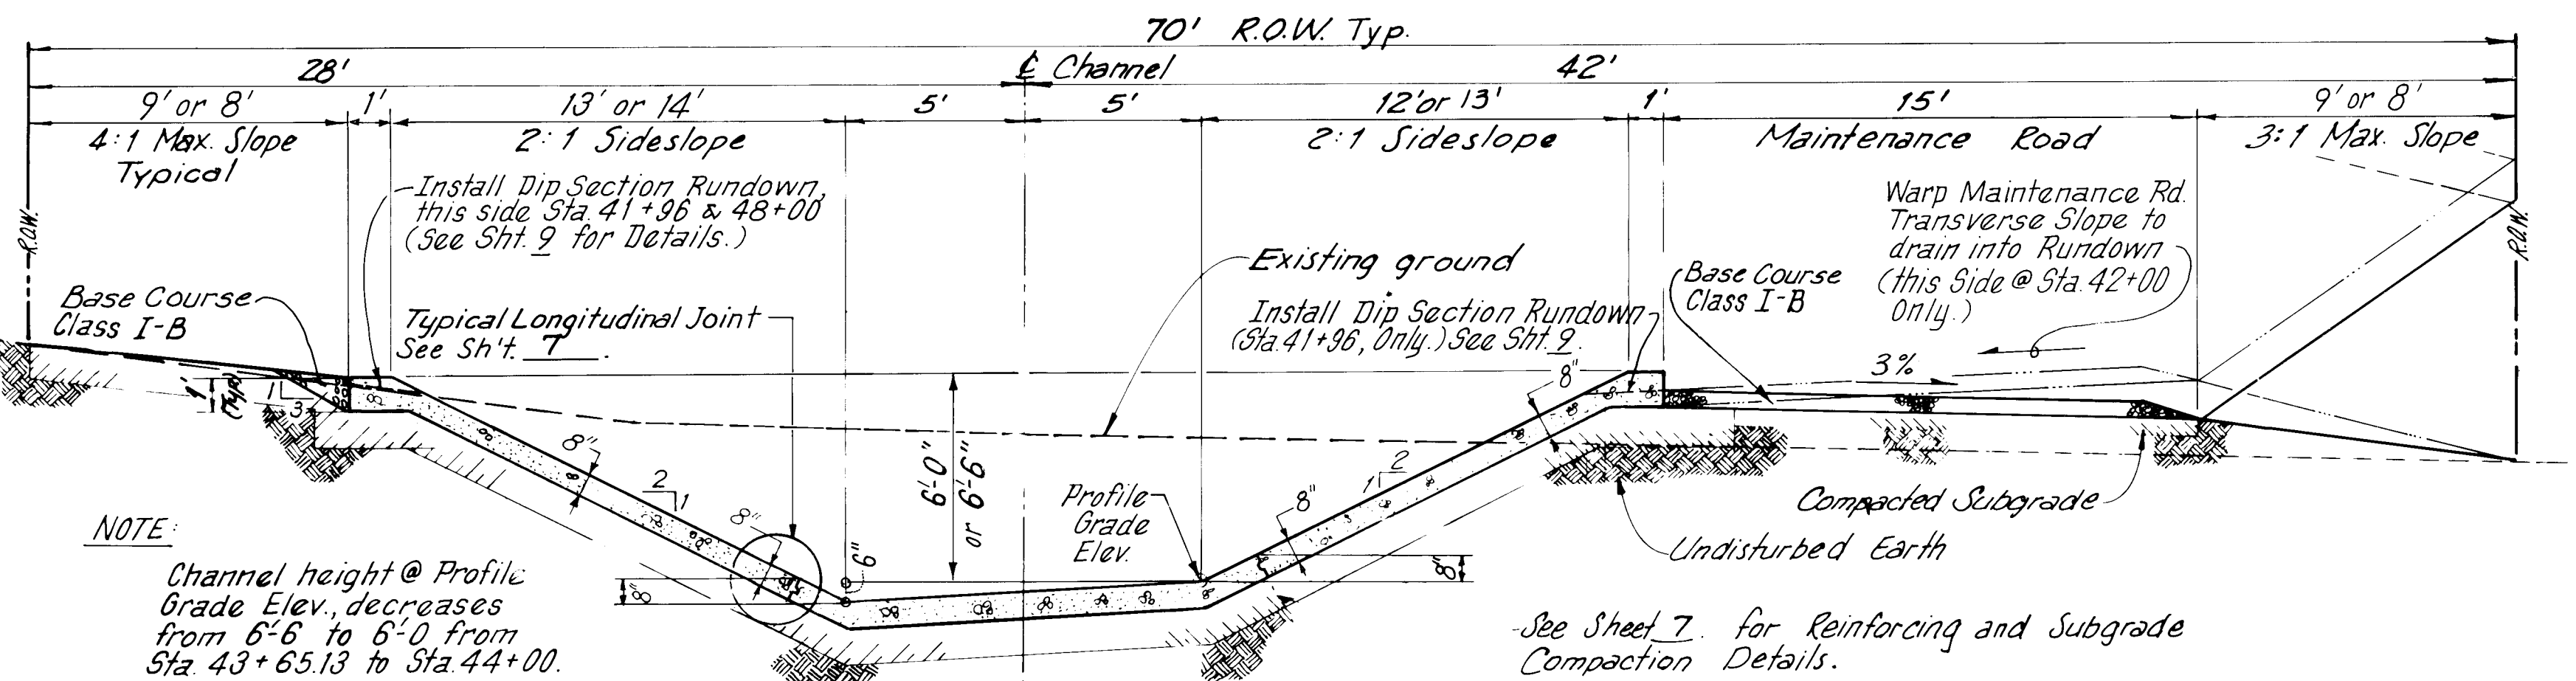


TYPICAL SECTION ~ STA. 43+65.13 to STA. 50+00
Scale: 1/4" = 1'-0"

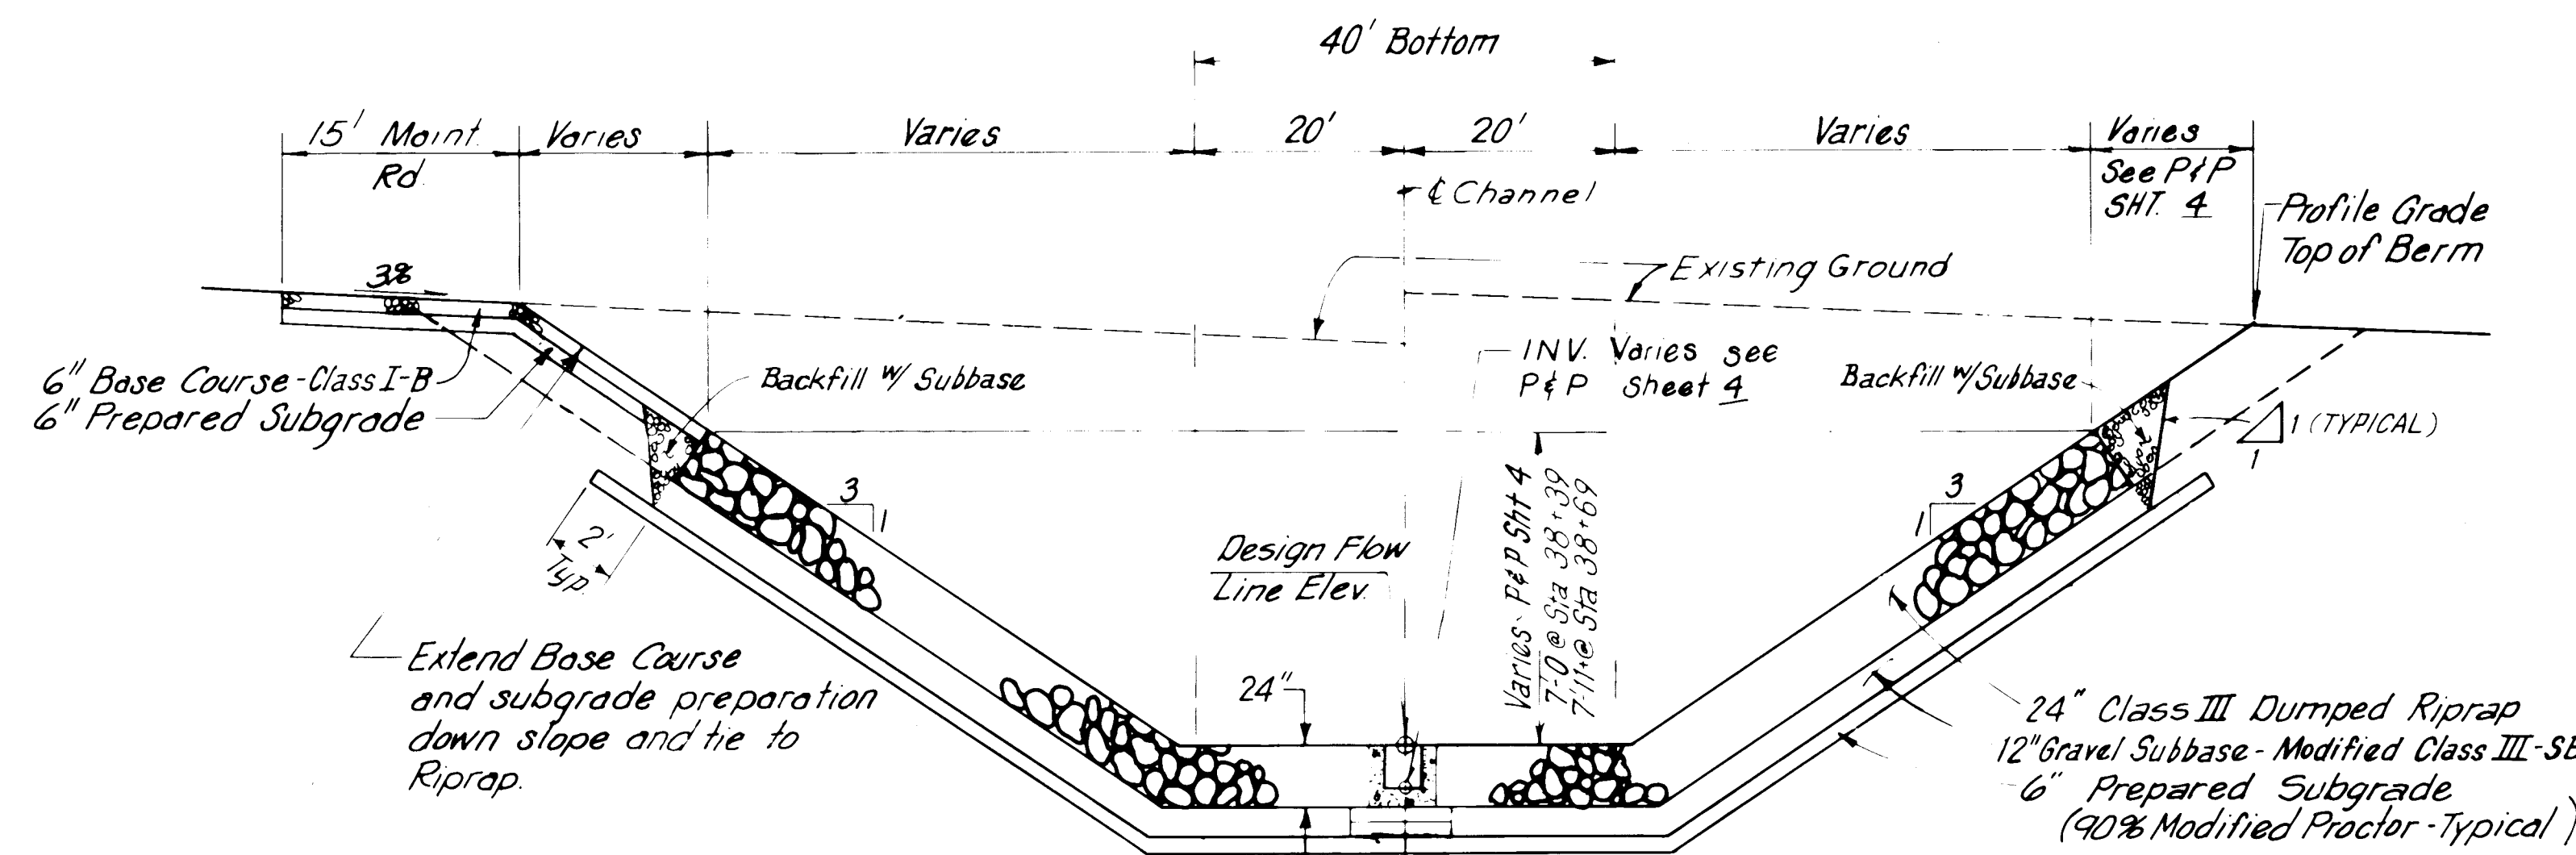


TYPICAL SECTION — CLASS III DUMPED RIPRAP
STA 38+39 to STA 38+69
Not to Scale

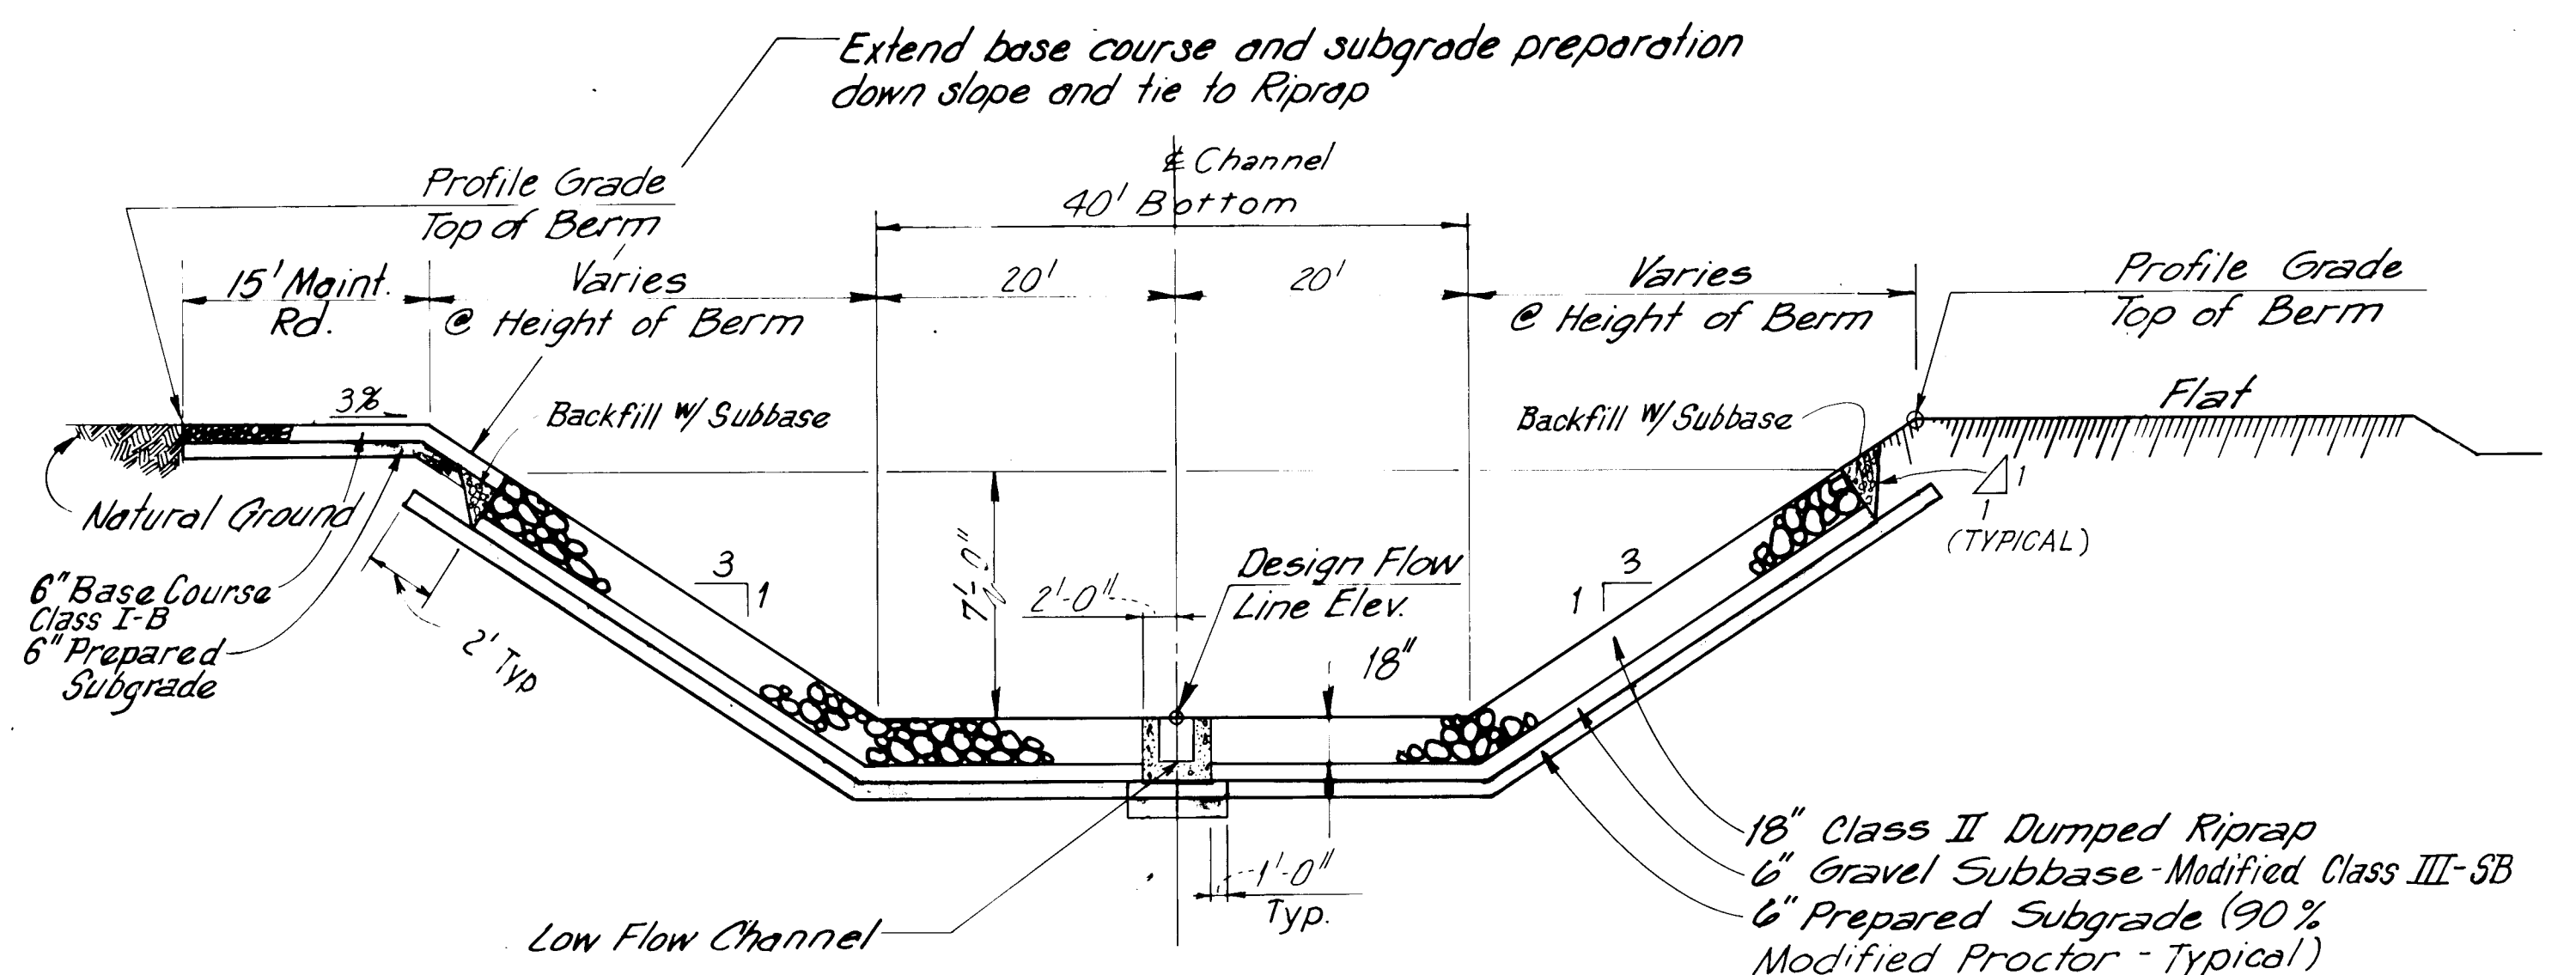

CLASS II DUMPED RIPRAP SECTION
STA 35+89 to STA 38+39 — 40' BOTTOM WIDTH
Not to Scale

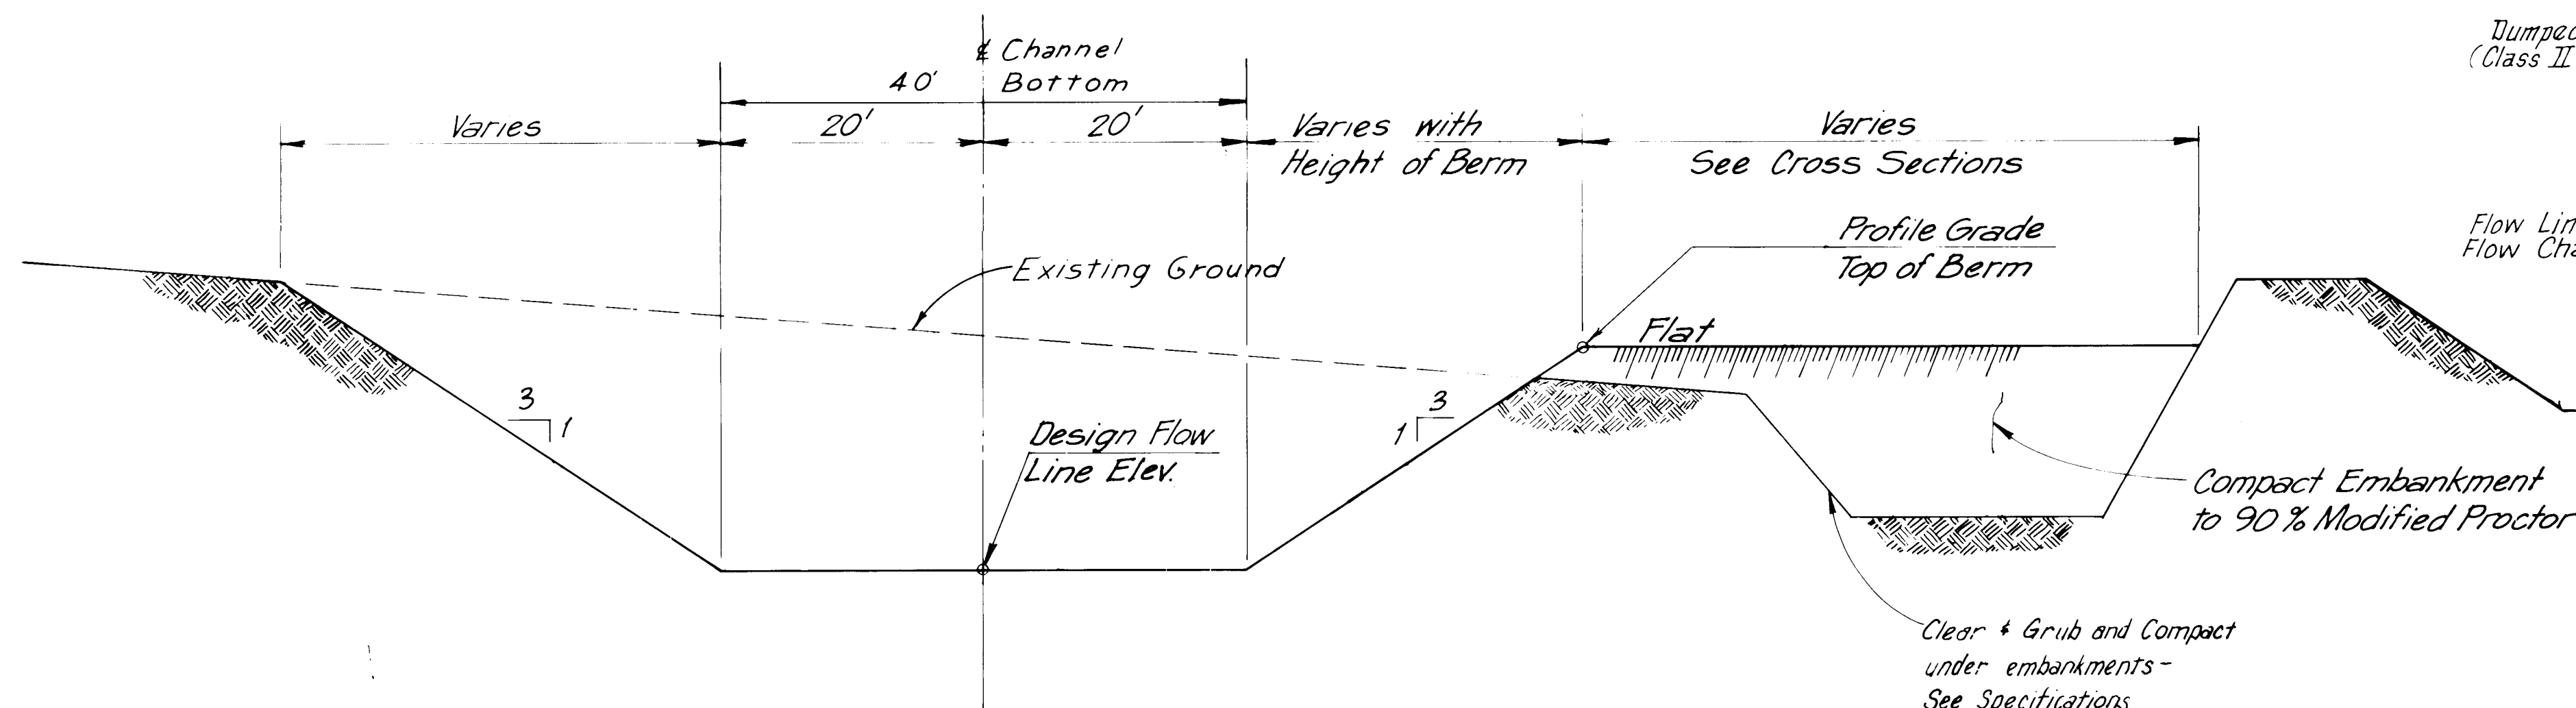

TYPICAL SECTION STA 17+08.38 to STA 35+89
(Left Side in Cut, Right Side in Fill)
Scale: 1/4" = 1'-0"

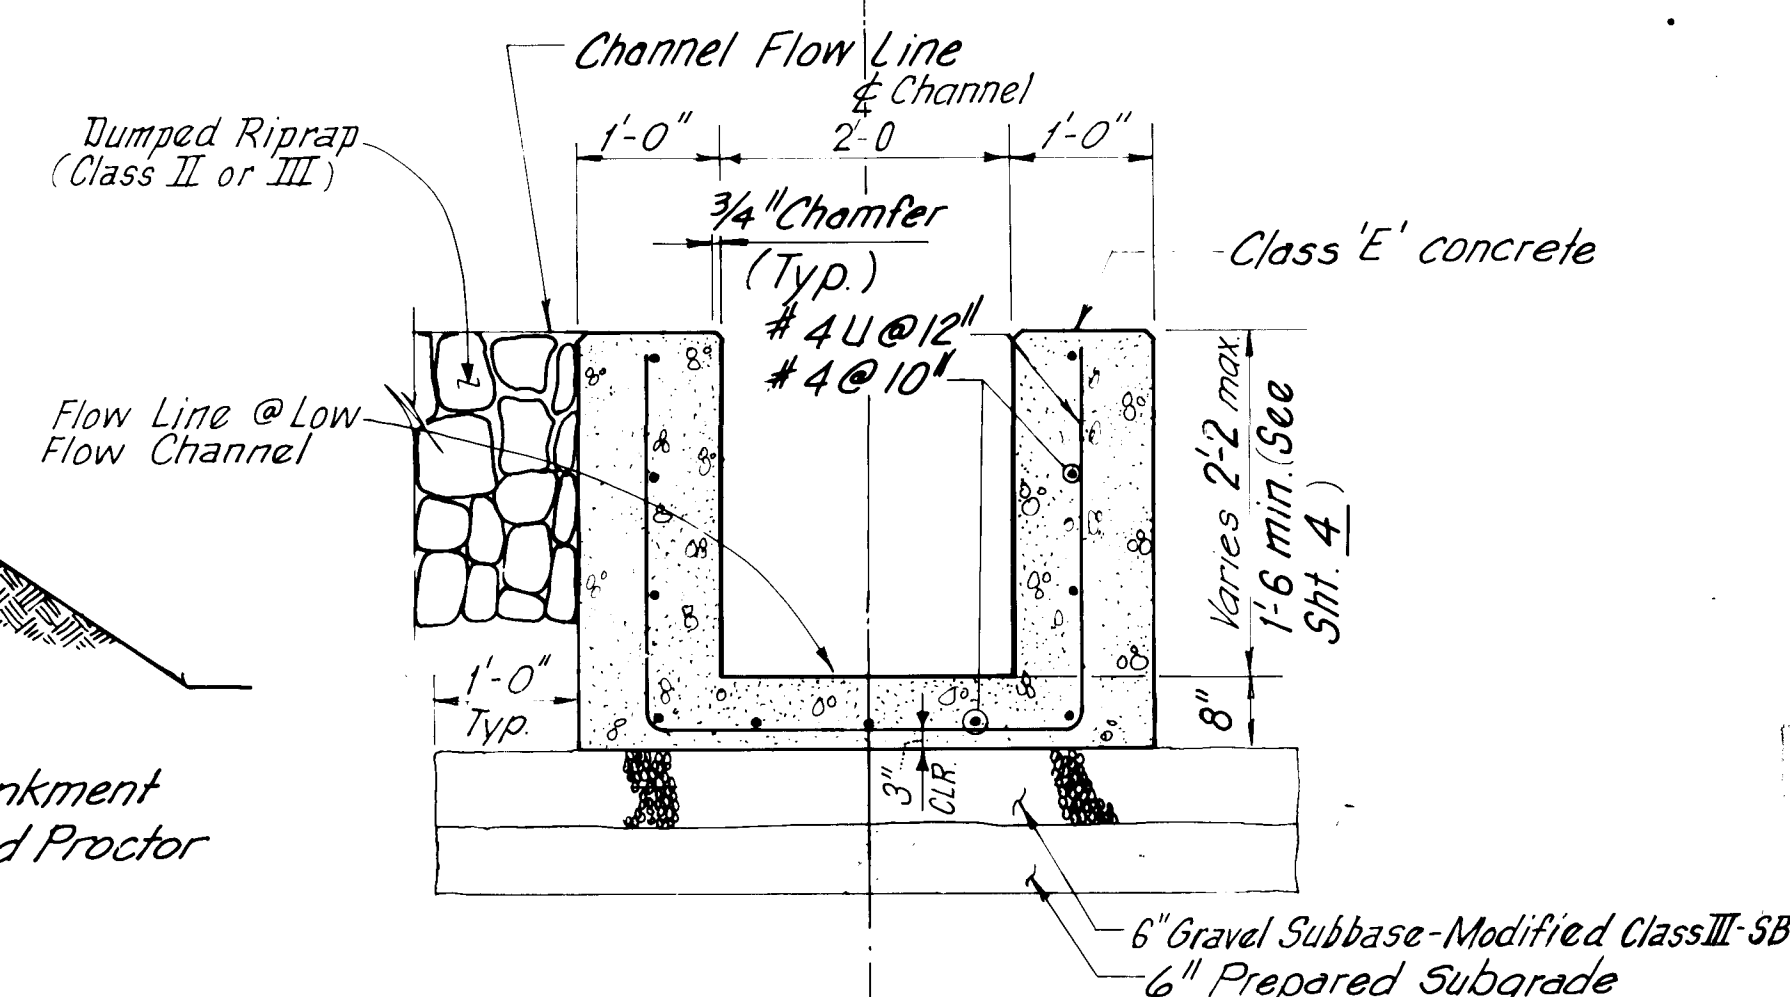

LOW FLOW CHANNEL DETAIL
Not to Scale

RECORD DRAWING


Date: 11/10/1987

These drawings have been revised based on field data and every reasonable attempt has been made to depict construction as actually performed.

26 17230887

AMAFCA

WESTGATE DIVERSION CHANNELS

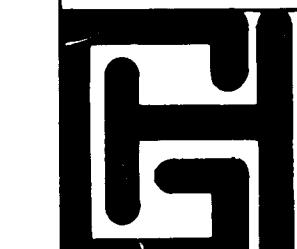

SNOW VISTA CHANNEL PHASE II

TYPICAL CHANNEL


SECTION DETAILS

GORDON HERKENHOFF & ASSOCIATES, INC.






ENGINEERS ARCHITECTS PLANNERS

ALBUQUERQUE

SANTA FE

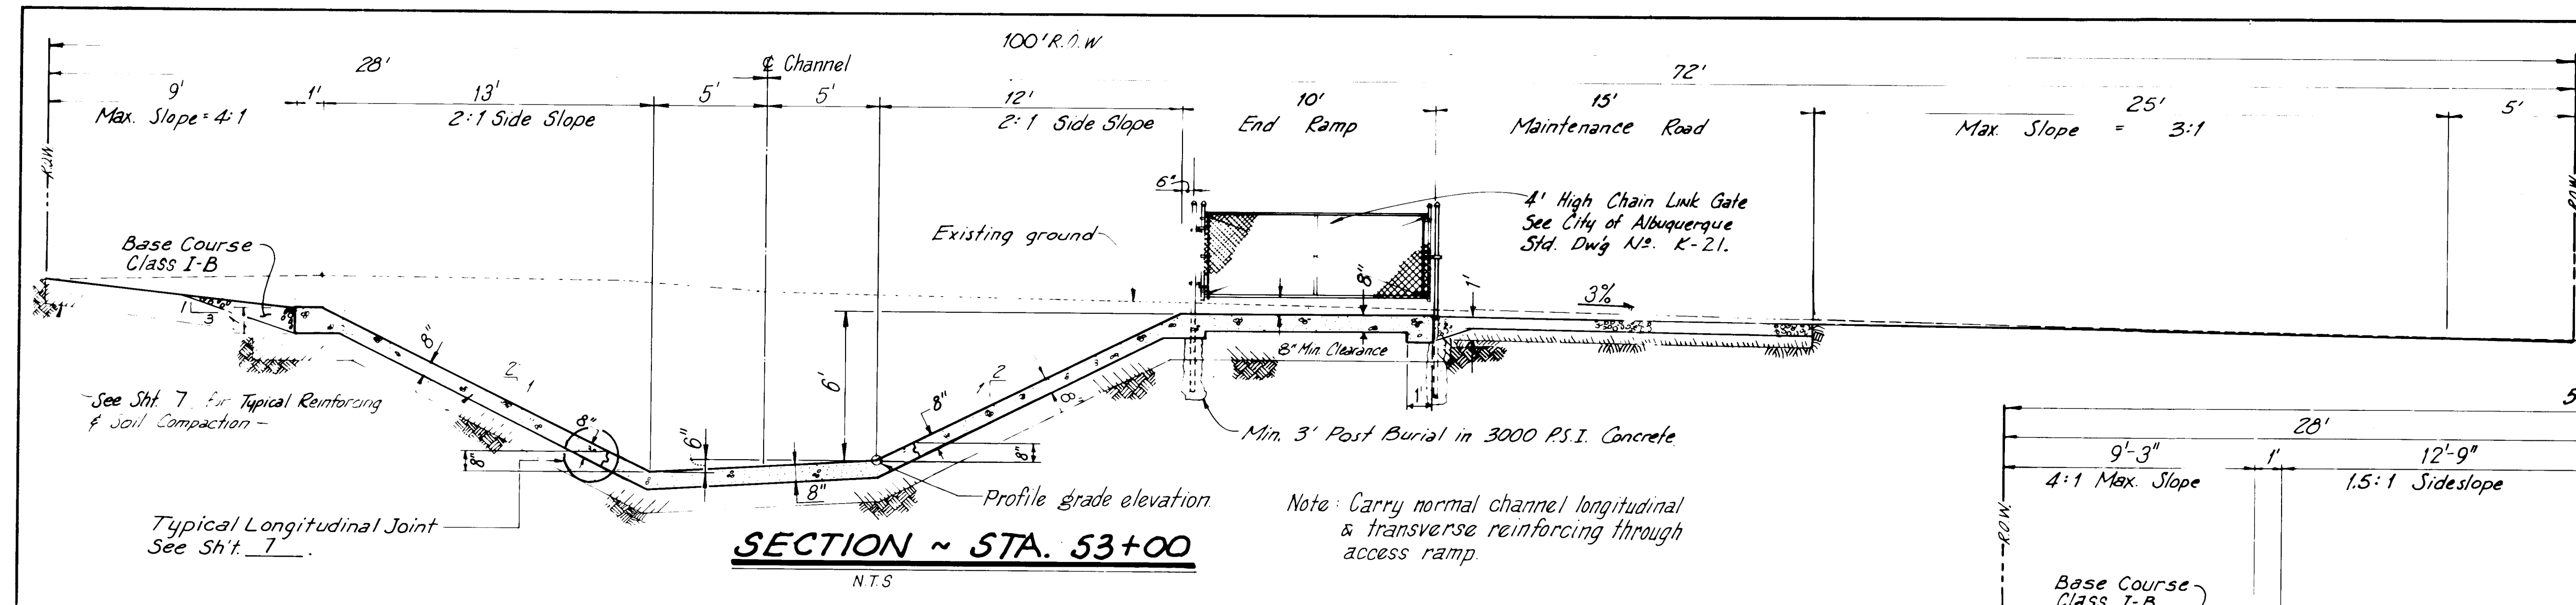

- GENERAL NOTES**
- Channel Sidewall Height transitions from 6' @ Sta. 53+50 to 8' @ Sta. 54+50 and Sideslope from 2:1 to 1.5:1
 - Sloping Bott. Channel transitions to Flat Bottom Channel from Sta. 56+54 to Sta. 56+94.
 - Bottom Channel Width transitions from 10' @ Sta. 50+00 to 20' @ Sta. 52+00.
 - Right of Way transitions from 70' @ Sta. 50+00 to 80' @ Sta. 52+00.

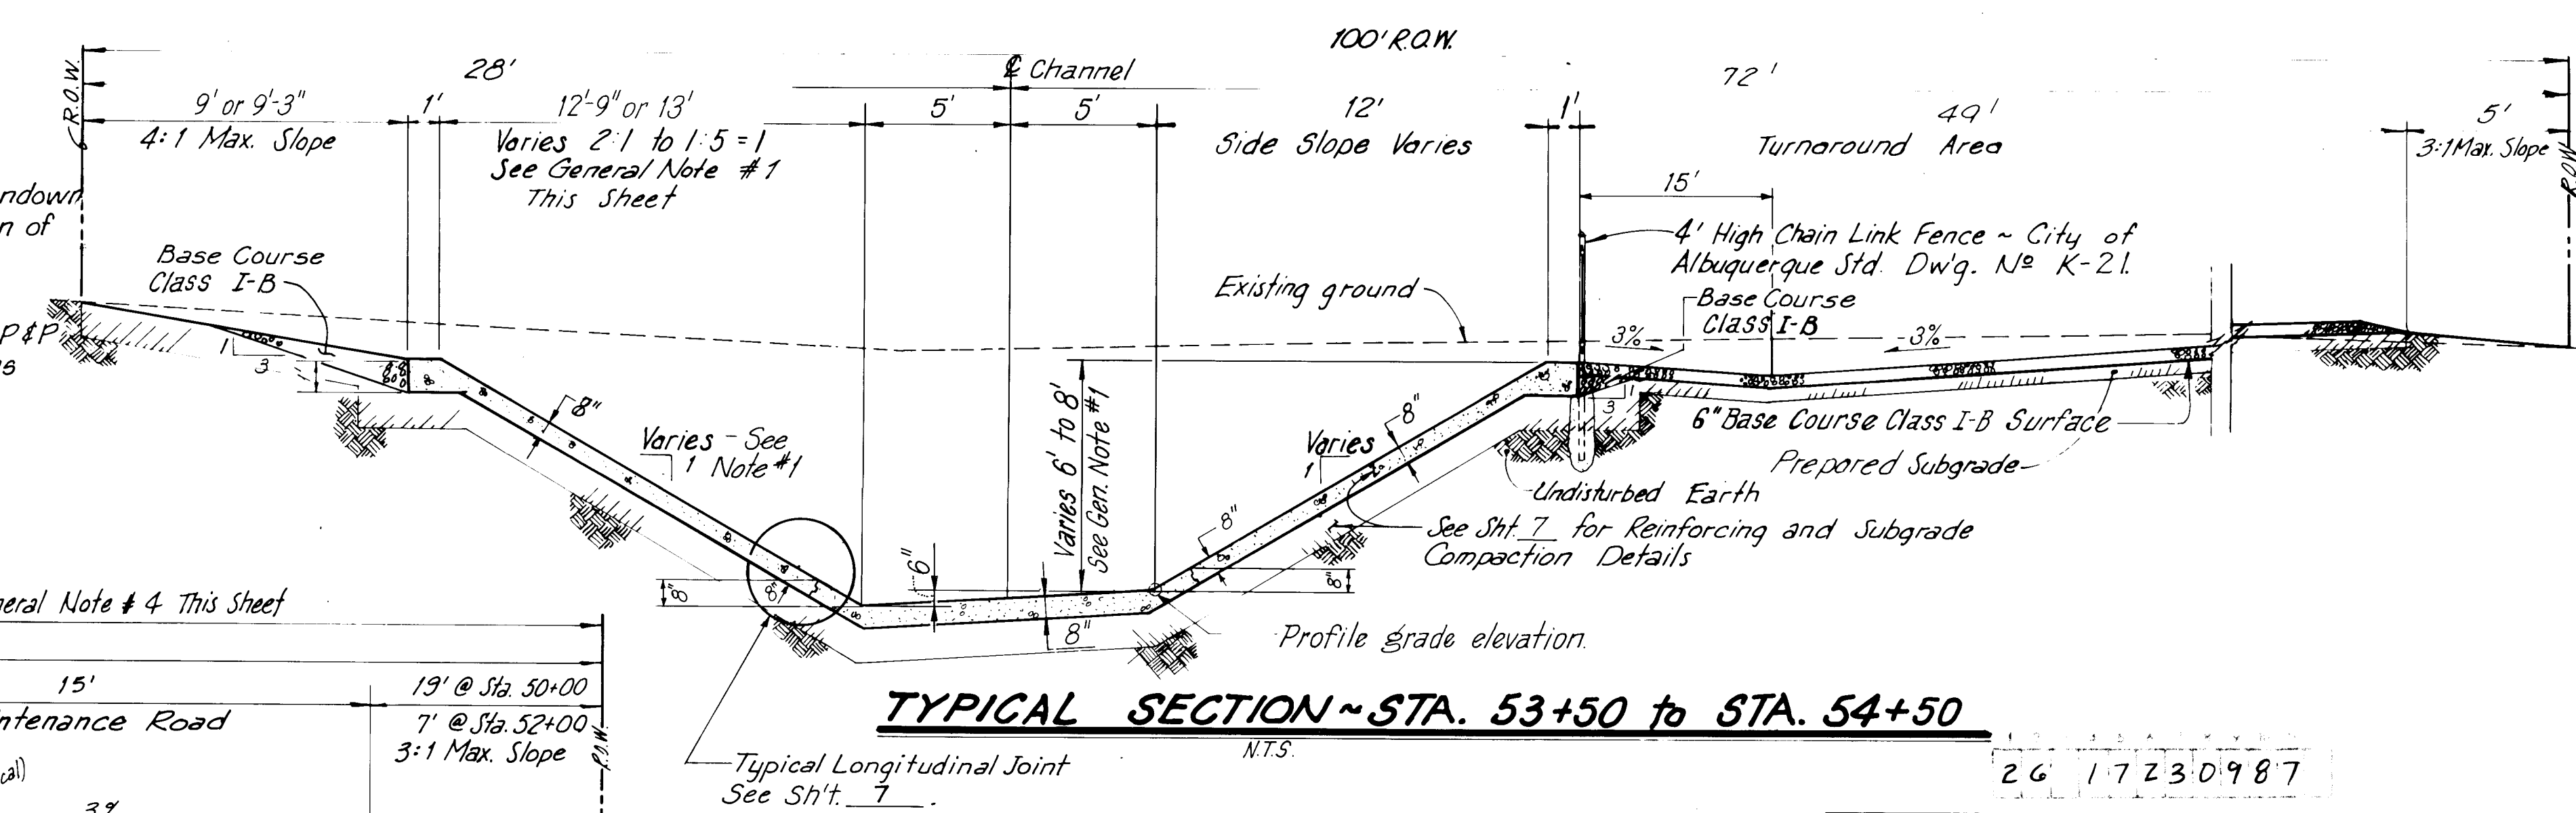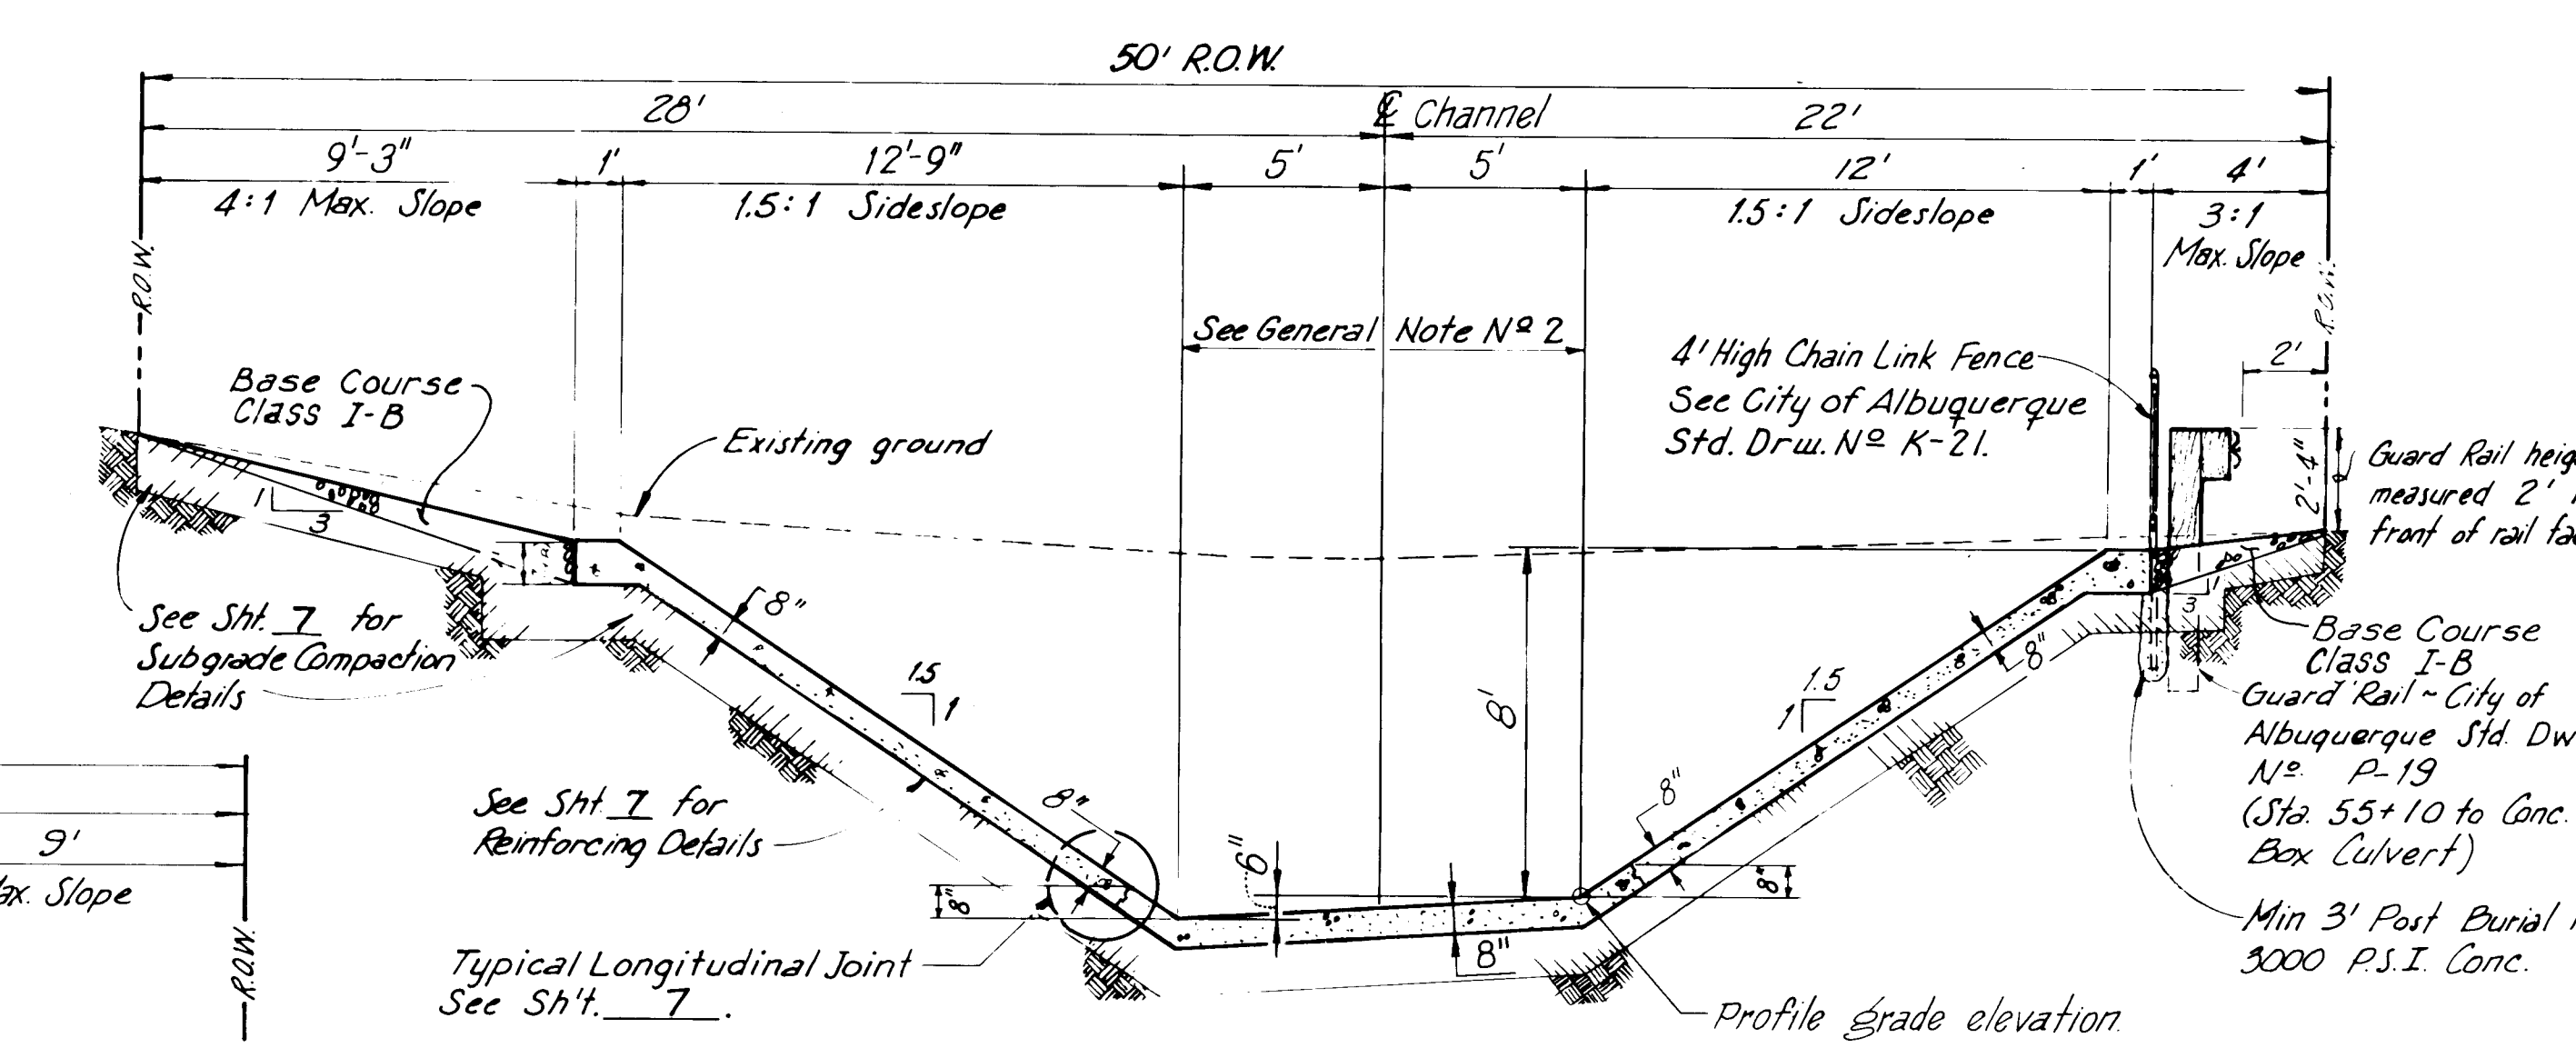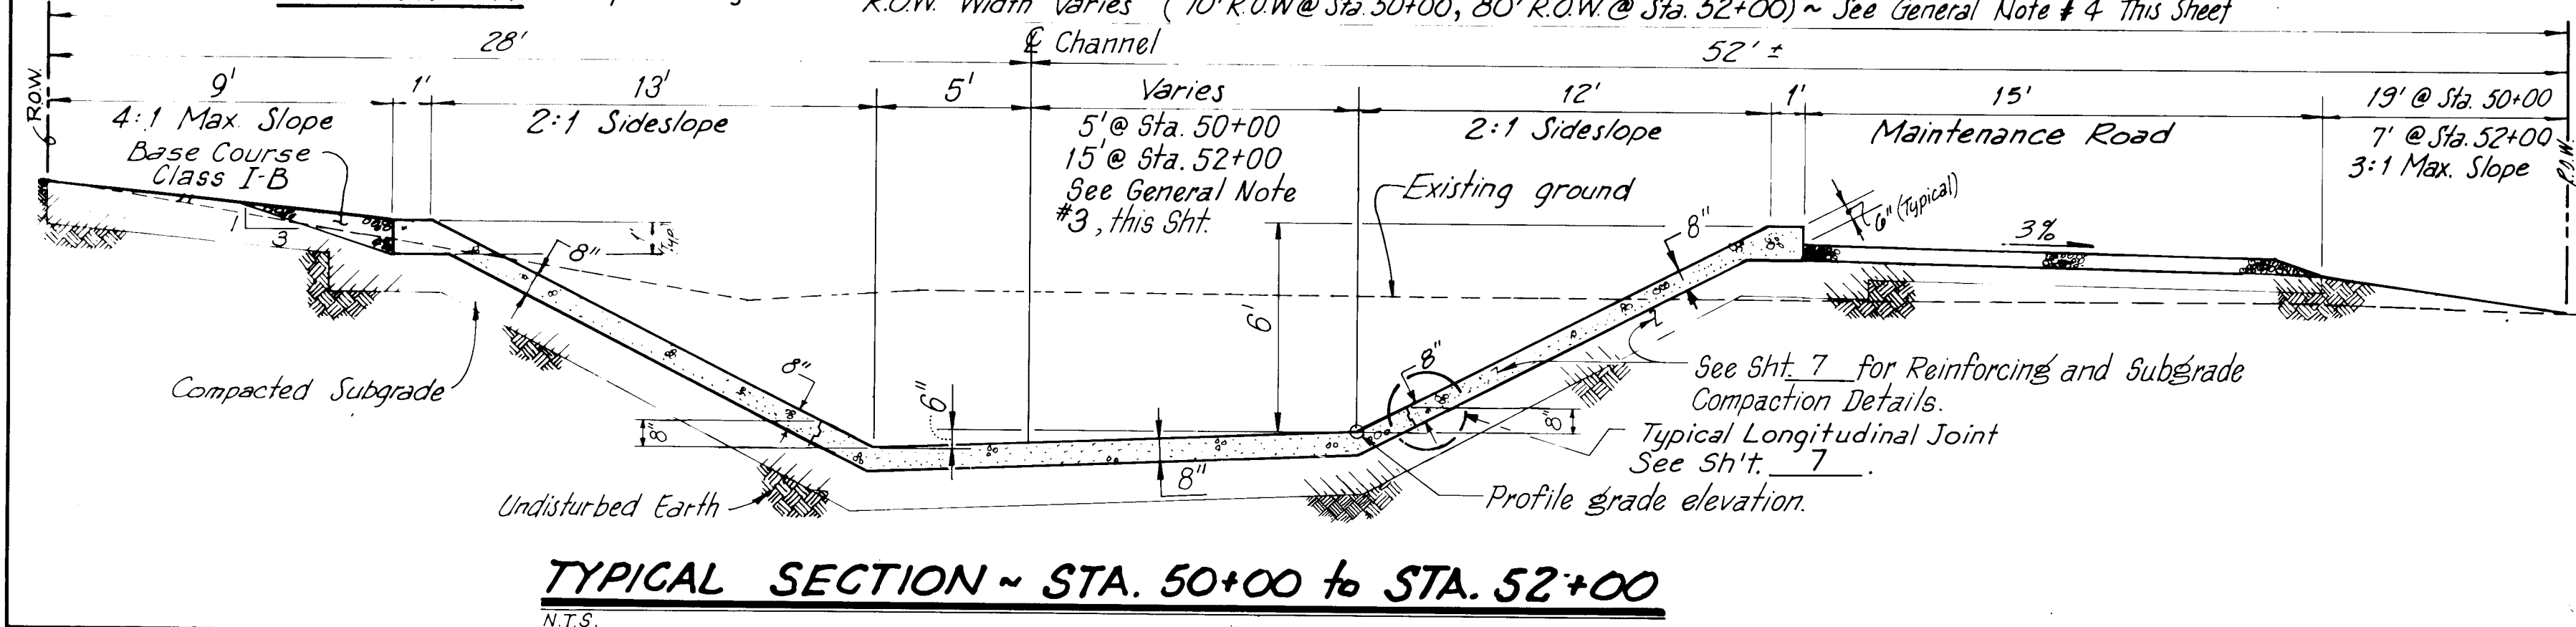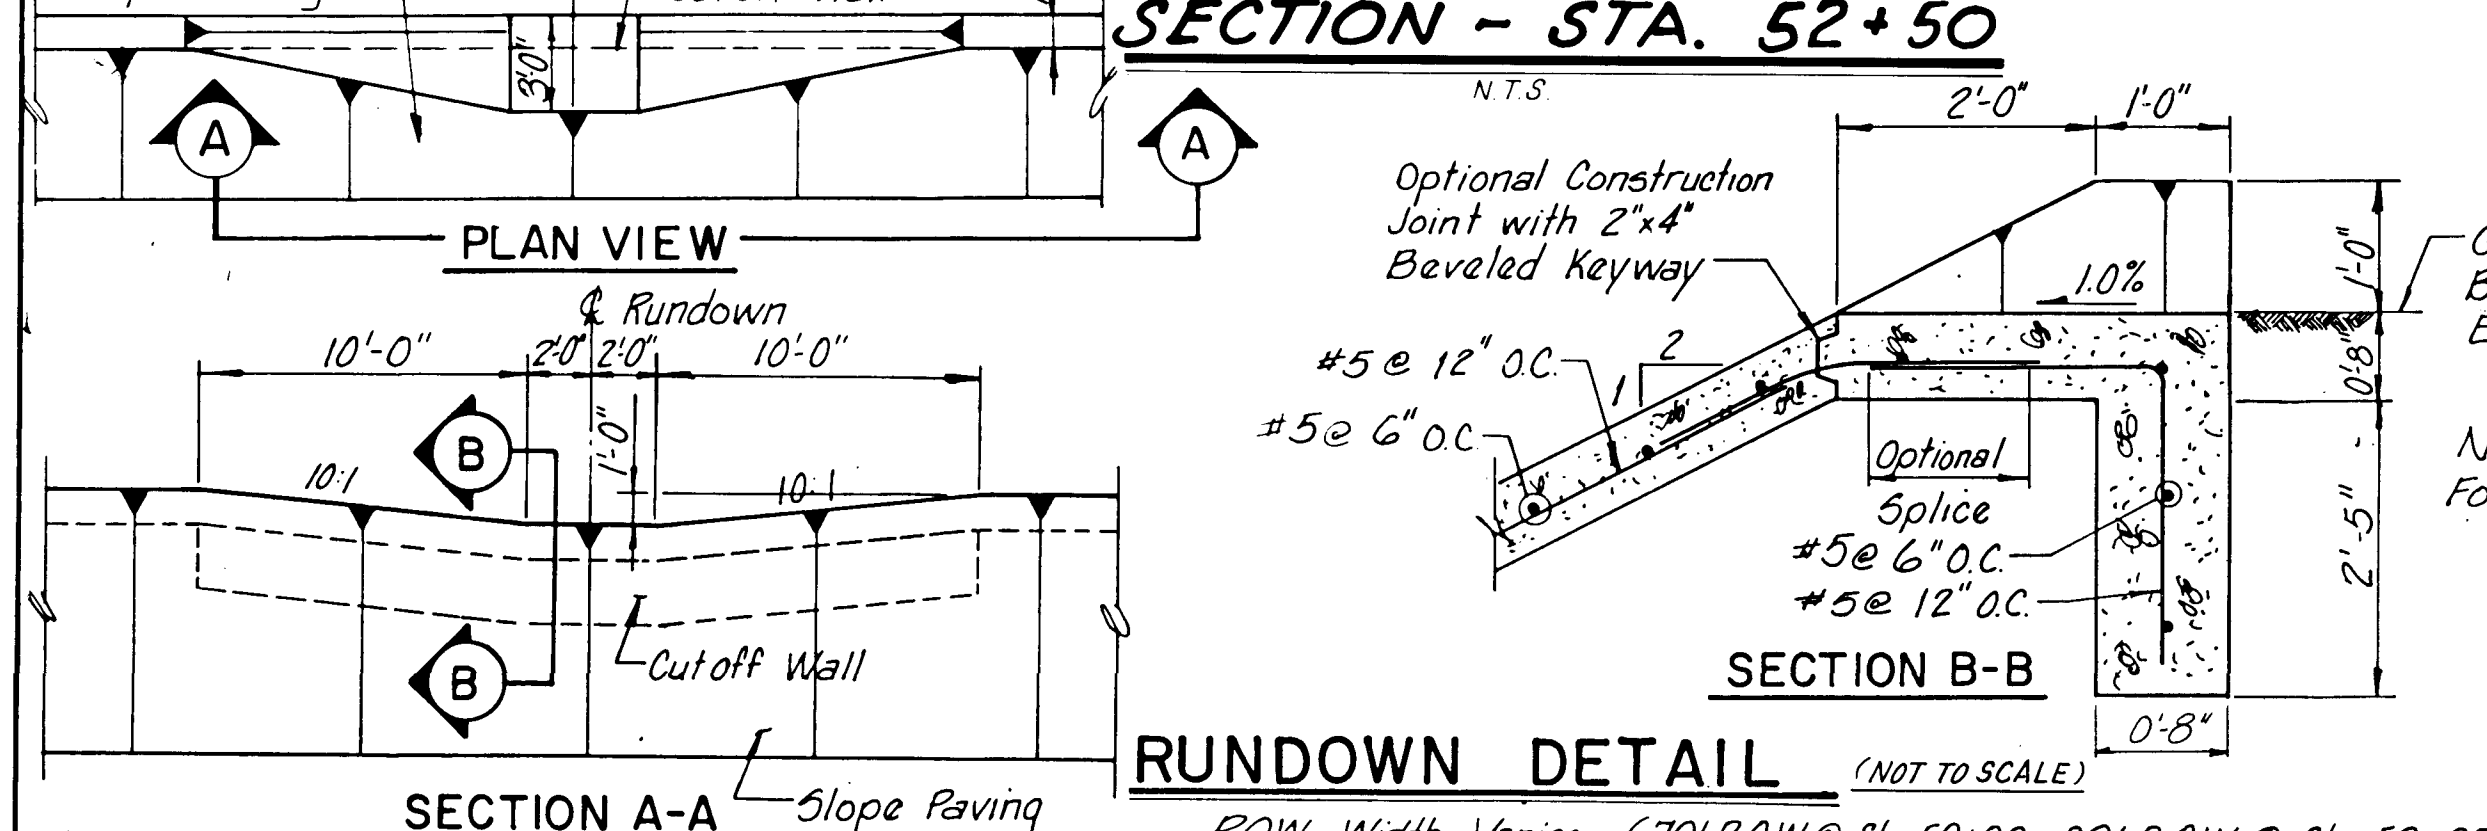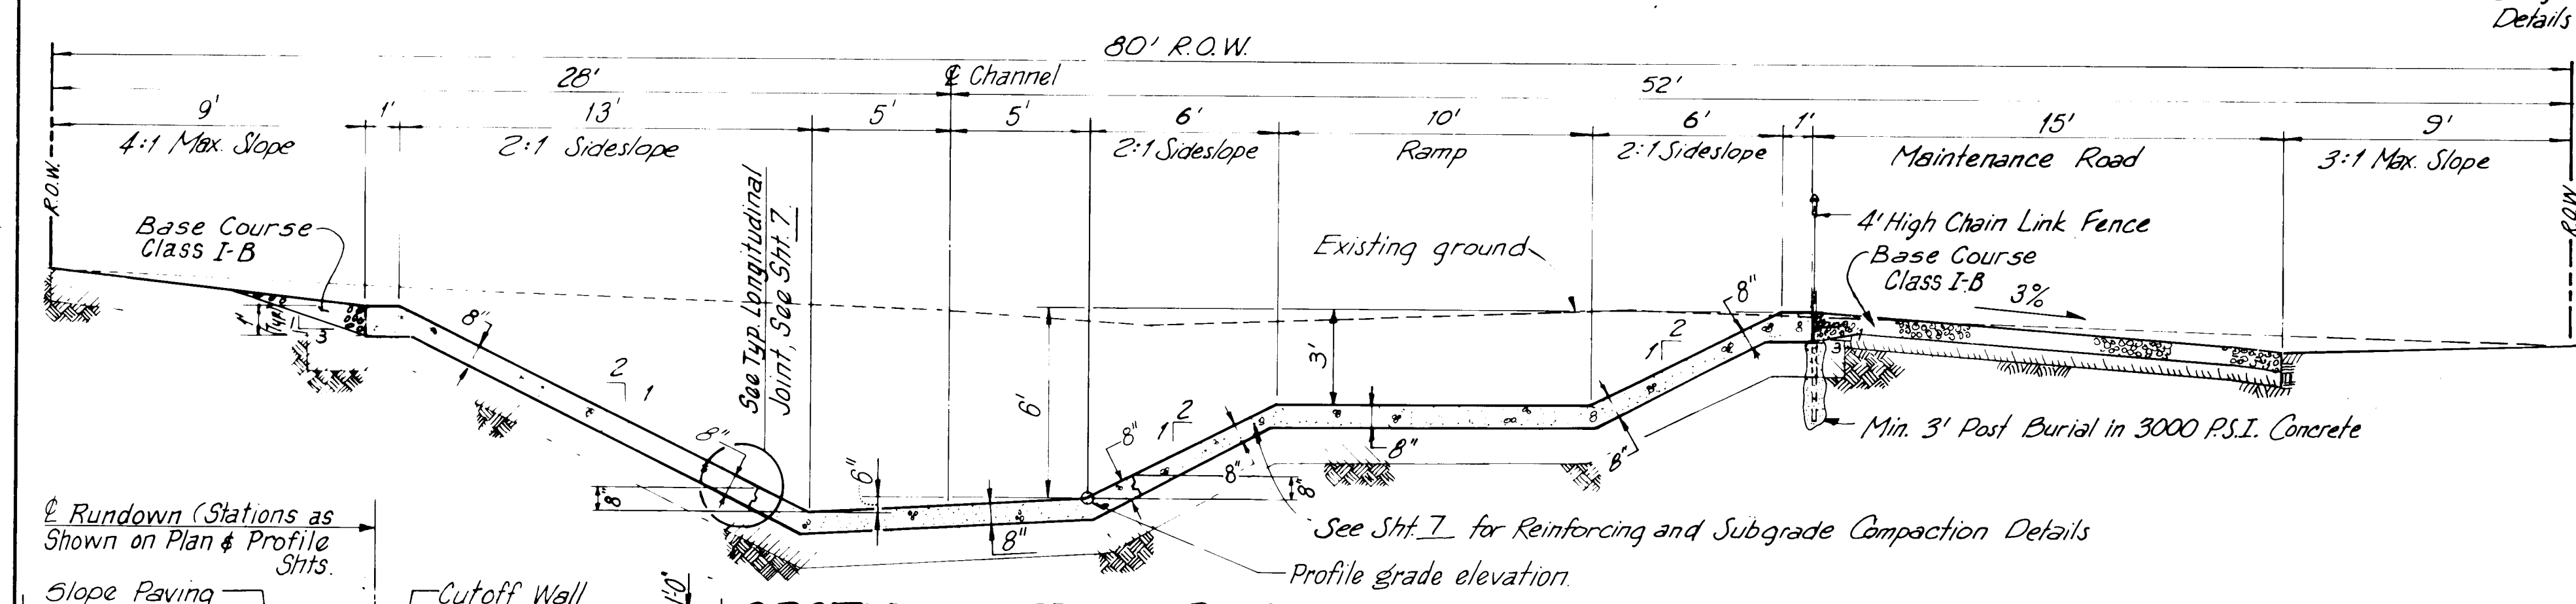

AMAFCA

WESTGATE DIVERSION CHANNELS

SNOW VISTA CHANNEL PHASE II

TYPICAL CHANNEL SECTION DETAILS

DATE: 11/11/10

SCALE: N.T.S.

GORDON HERKENHOFF & ASSOCIATES, INC.


ENGINEERS ARCHITECTS PLANNERS

ALBUQUERQUE SANTA FE

RECORD DRAWING

Date: 11/11/10

These drawings have been revised based on field data and every reasonable attempt has been made to depict construction as actually performed.

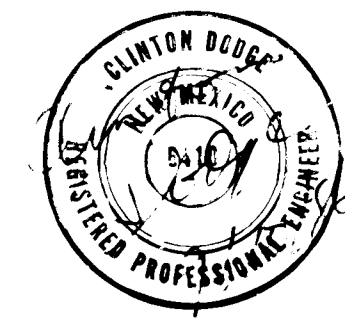

BRUNING 44 122 34226

PLAN	DATE	BY
DATE		
BY		
CHECKED		
NOTED		
NO.		

PROFILE	DATE	BY
DATE		
BY		
CHECKED		
NOTED		
NO.		

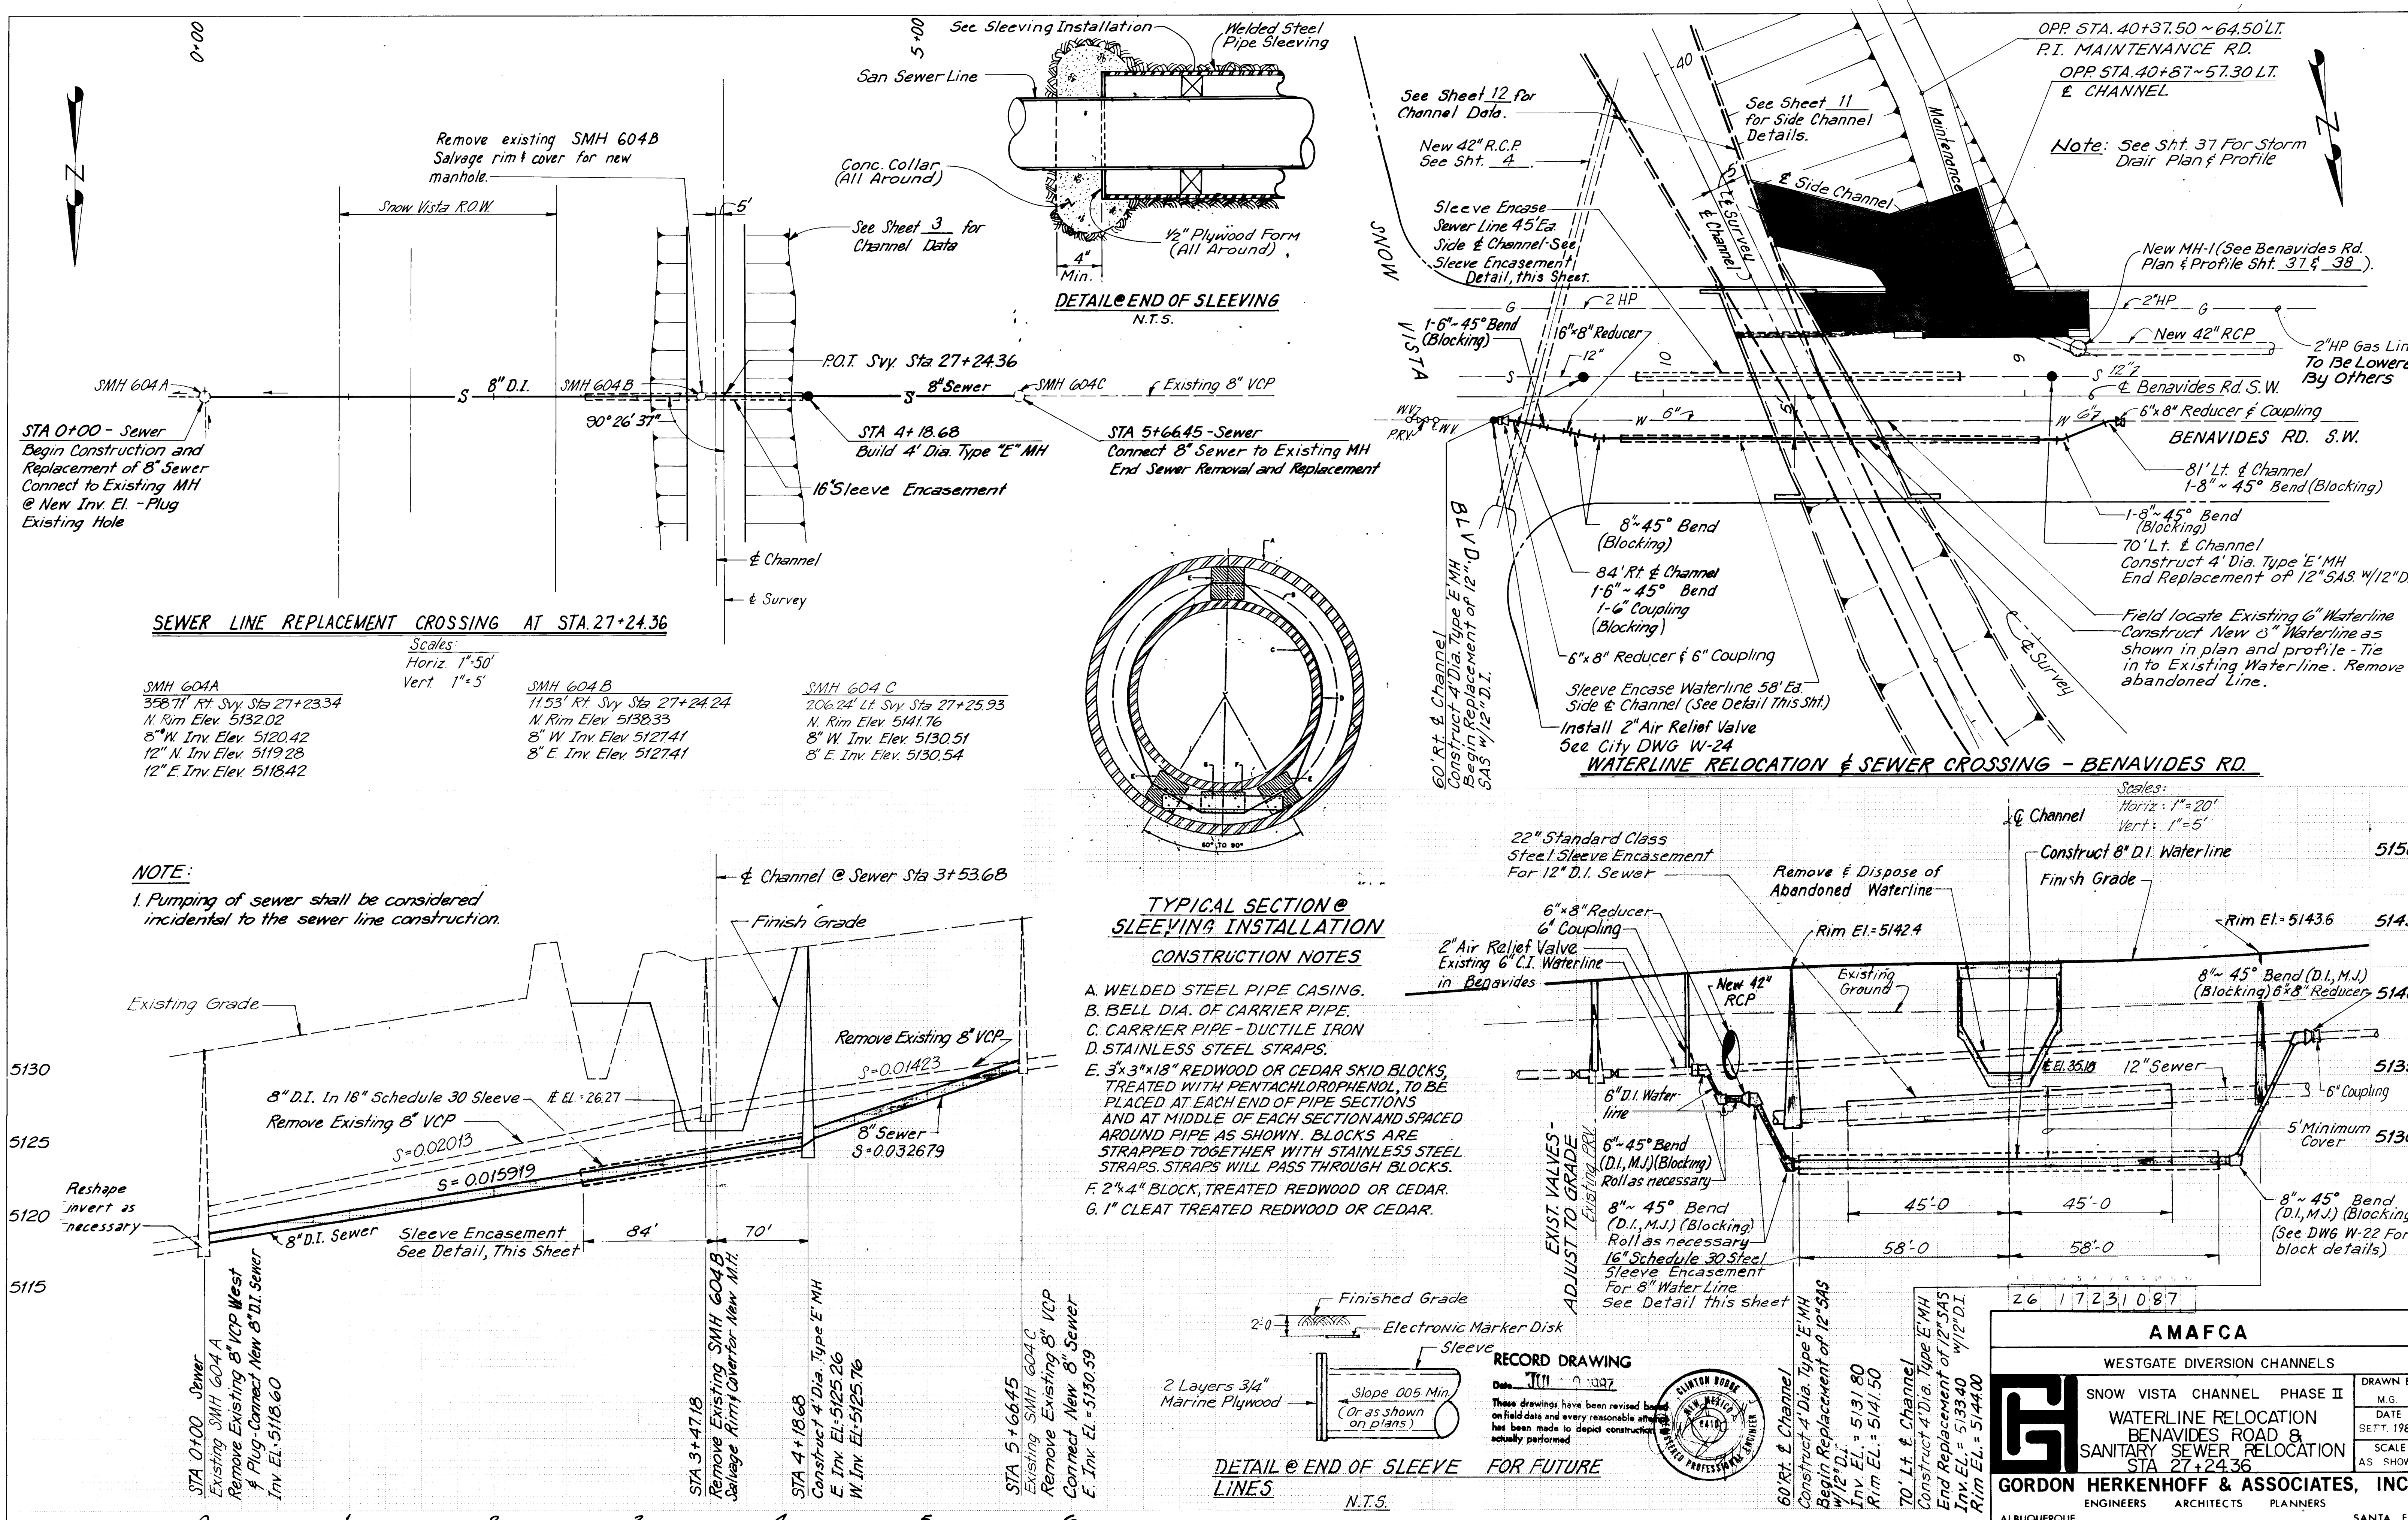


PLATE 1 SINGLE PLAN - PROFILE - DOTTED
CHARLES BRUNING COMPANY
MADE IN U.S.A.

AMAFCA

WESTGATE DIVERSION CHANNELS

SNOW VISTA CHANNEL PHASE II

WATERLINE RELOCATION
BENAVIDES ROAD 8
SANITARY SEWER LOCATION
STA 27+24.36

GORDON HERKENHOFF & ASSOCIATES, INC.
ENGINEERS ARCHITECTS PLANNERS

ALBUQUERQUE SANTA FE

DRAWN BY M.G.
DATE SEPT. 1986
SCALE AS SHOWN



PIPE RAIL FENCE DETAIL

NOT TO SCALE

10'-0" oc Max

4" Steel Pipe, 10.7# x 1/4"

Concrete filled Posts

2" Galv. Pipe, 3.65 #/ft

Rails

1/8" Min.

Run-down Paving

Glass "E" concrete finish flush w/ run-down paving

S-0.00460%

40+00

See Sheet No. 11 for Typical Post Mounting Details

For Pipe Penetration Detail, See Sheet No. 14

See Sheet No. 11 for Typical Post Mounting Details

150.00' Channel Expansion Transition from 40.00' to 16.58'

OPP STA 40+00

TW EL=54.50

Metal ReflectORIZED Delineators @ 10'-0" oc - 5 Req'd.

Class "E" Concrete Dissipator Channel

5' Chain Link Fence (See Sht. 14)

See Sheet No. 11 for Rail Post Mounting Detail

S-0.0120

Opp Sta 40+57.31

6" deep Notch in Side wall

Opp Sta 40+38.77

4'-8" R.C.P Storm Drain Opp Sta 40+48.04

See Sht. 14 for Pipe Penetration Details

GENERAL NOTES

- All exposed edges shall have 3/4" chamfer unless otherwise noted.
- All dissipation channel concrete shall be Class "E" except for headwalls & footings which shall be either Class "C" or Class "Z".

LONGITUDINAL SECTION @ C

Scale: 1" = 10'

PLAN

Scale: 1" = 10'

RECORD DRAWING

Date: 11/11/97

These drawings have been revised based on field data and are hereby responsible owner has been made to deposit information as equally performed

AMAFCA

WESTGATE DIVERSION CHANNELS

SNOW VISTA CHANNEL PHASE II

BENAVIDES SIDE CHANNEL AND DISSIPATOR CHANNEL LAYOUT

GORDON HERKENHOFF & ASSOCIATES, INC.

ENGINEERS ARCHITECTS PLANNERS

ALBUQUERQUE SANTA FE

DRAWN BY J.C.D.

DATE SEPT. 1998

SCALE AS SHOWN


GENERAL NOTES 26 17231287

GENERAL NOTES 26 17231287


Exposed edges shall have $\frac{3}{4}$ " chamfer unless otherwise noted.

Asphalt or channel concrete shall be Class "F" except for
piles & footings which shall be either Class "C" or Class "E."


AMAFCA	
WESTGATE DIVERSION CHANNELS	
	SNOW VISTA CHANNEL PHASE II
	BENAVIDES SIDE CHANNEL AND DISSIPATOR CHANNEL LAYOUT
	DRAWN BY J. C. COLE
	DATE SEPT. 1986
GORDON HERKENHOFF & ASSOCIATES, INC.	
ENGINEERS	ARCHITECTS
PLANNERS	
ALBUQUERQUE	SANTA FE

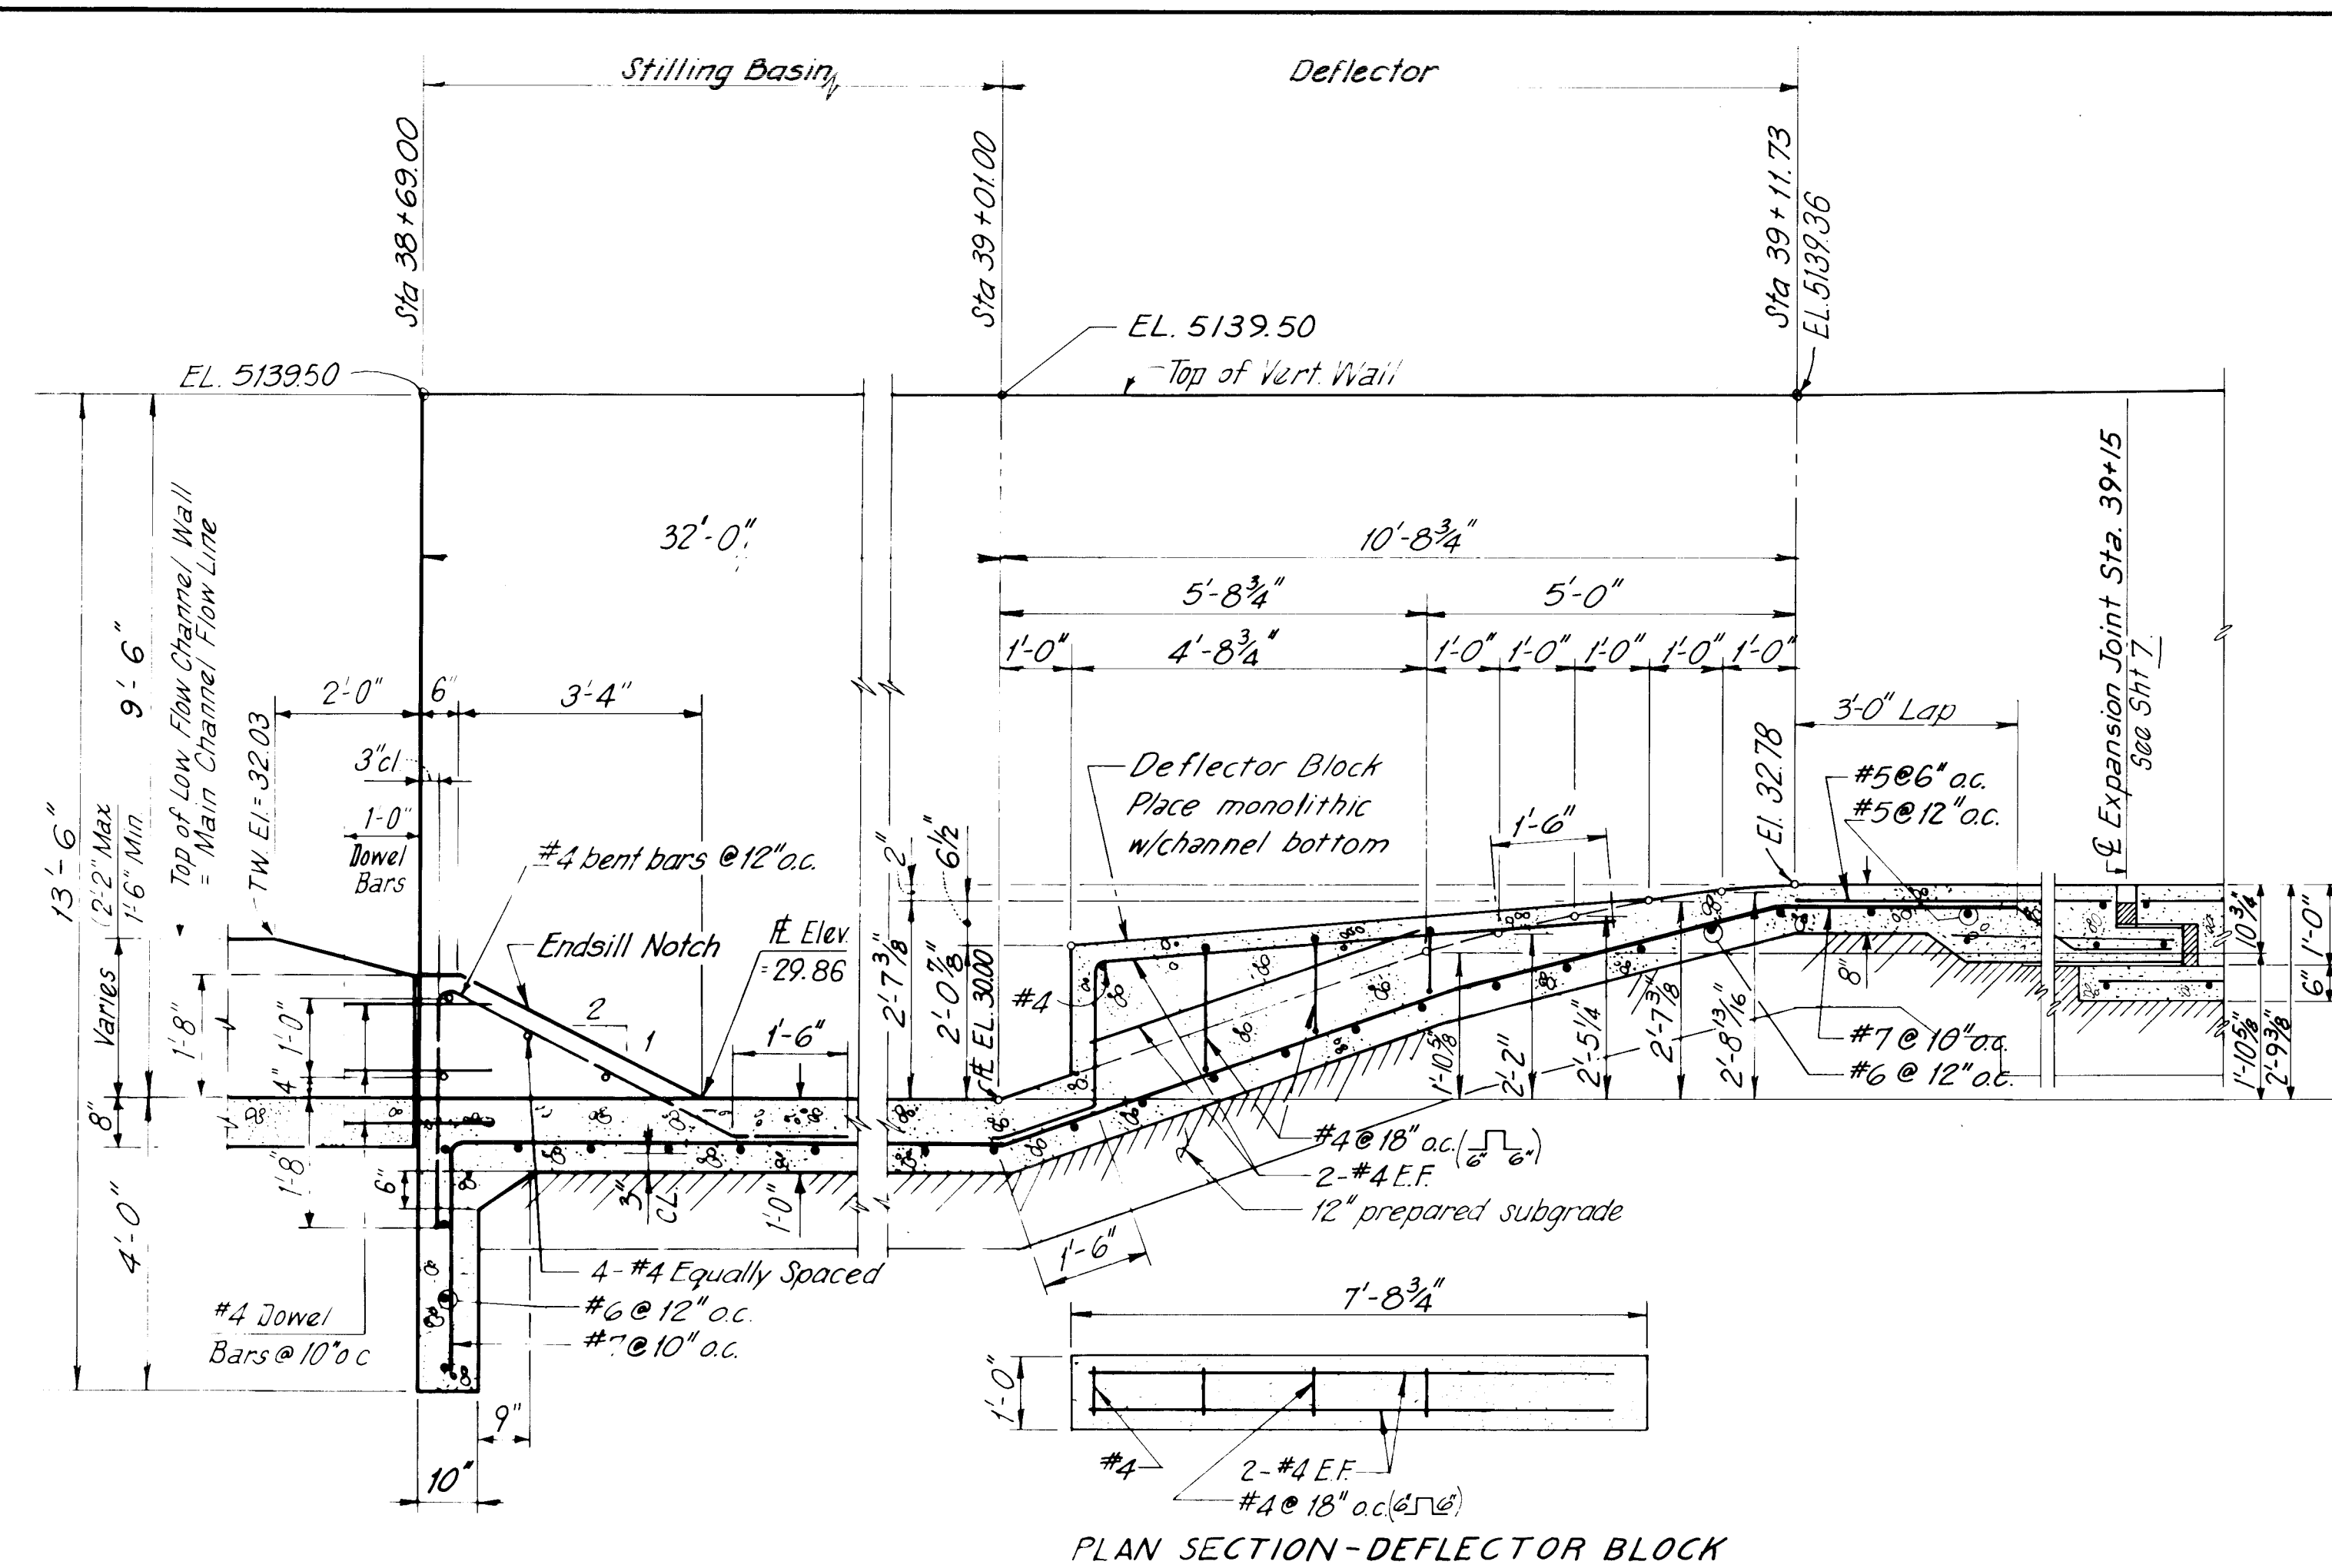



SECTION - STILLING BASIN

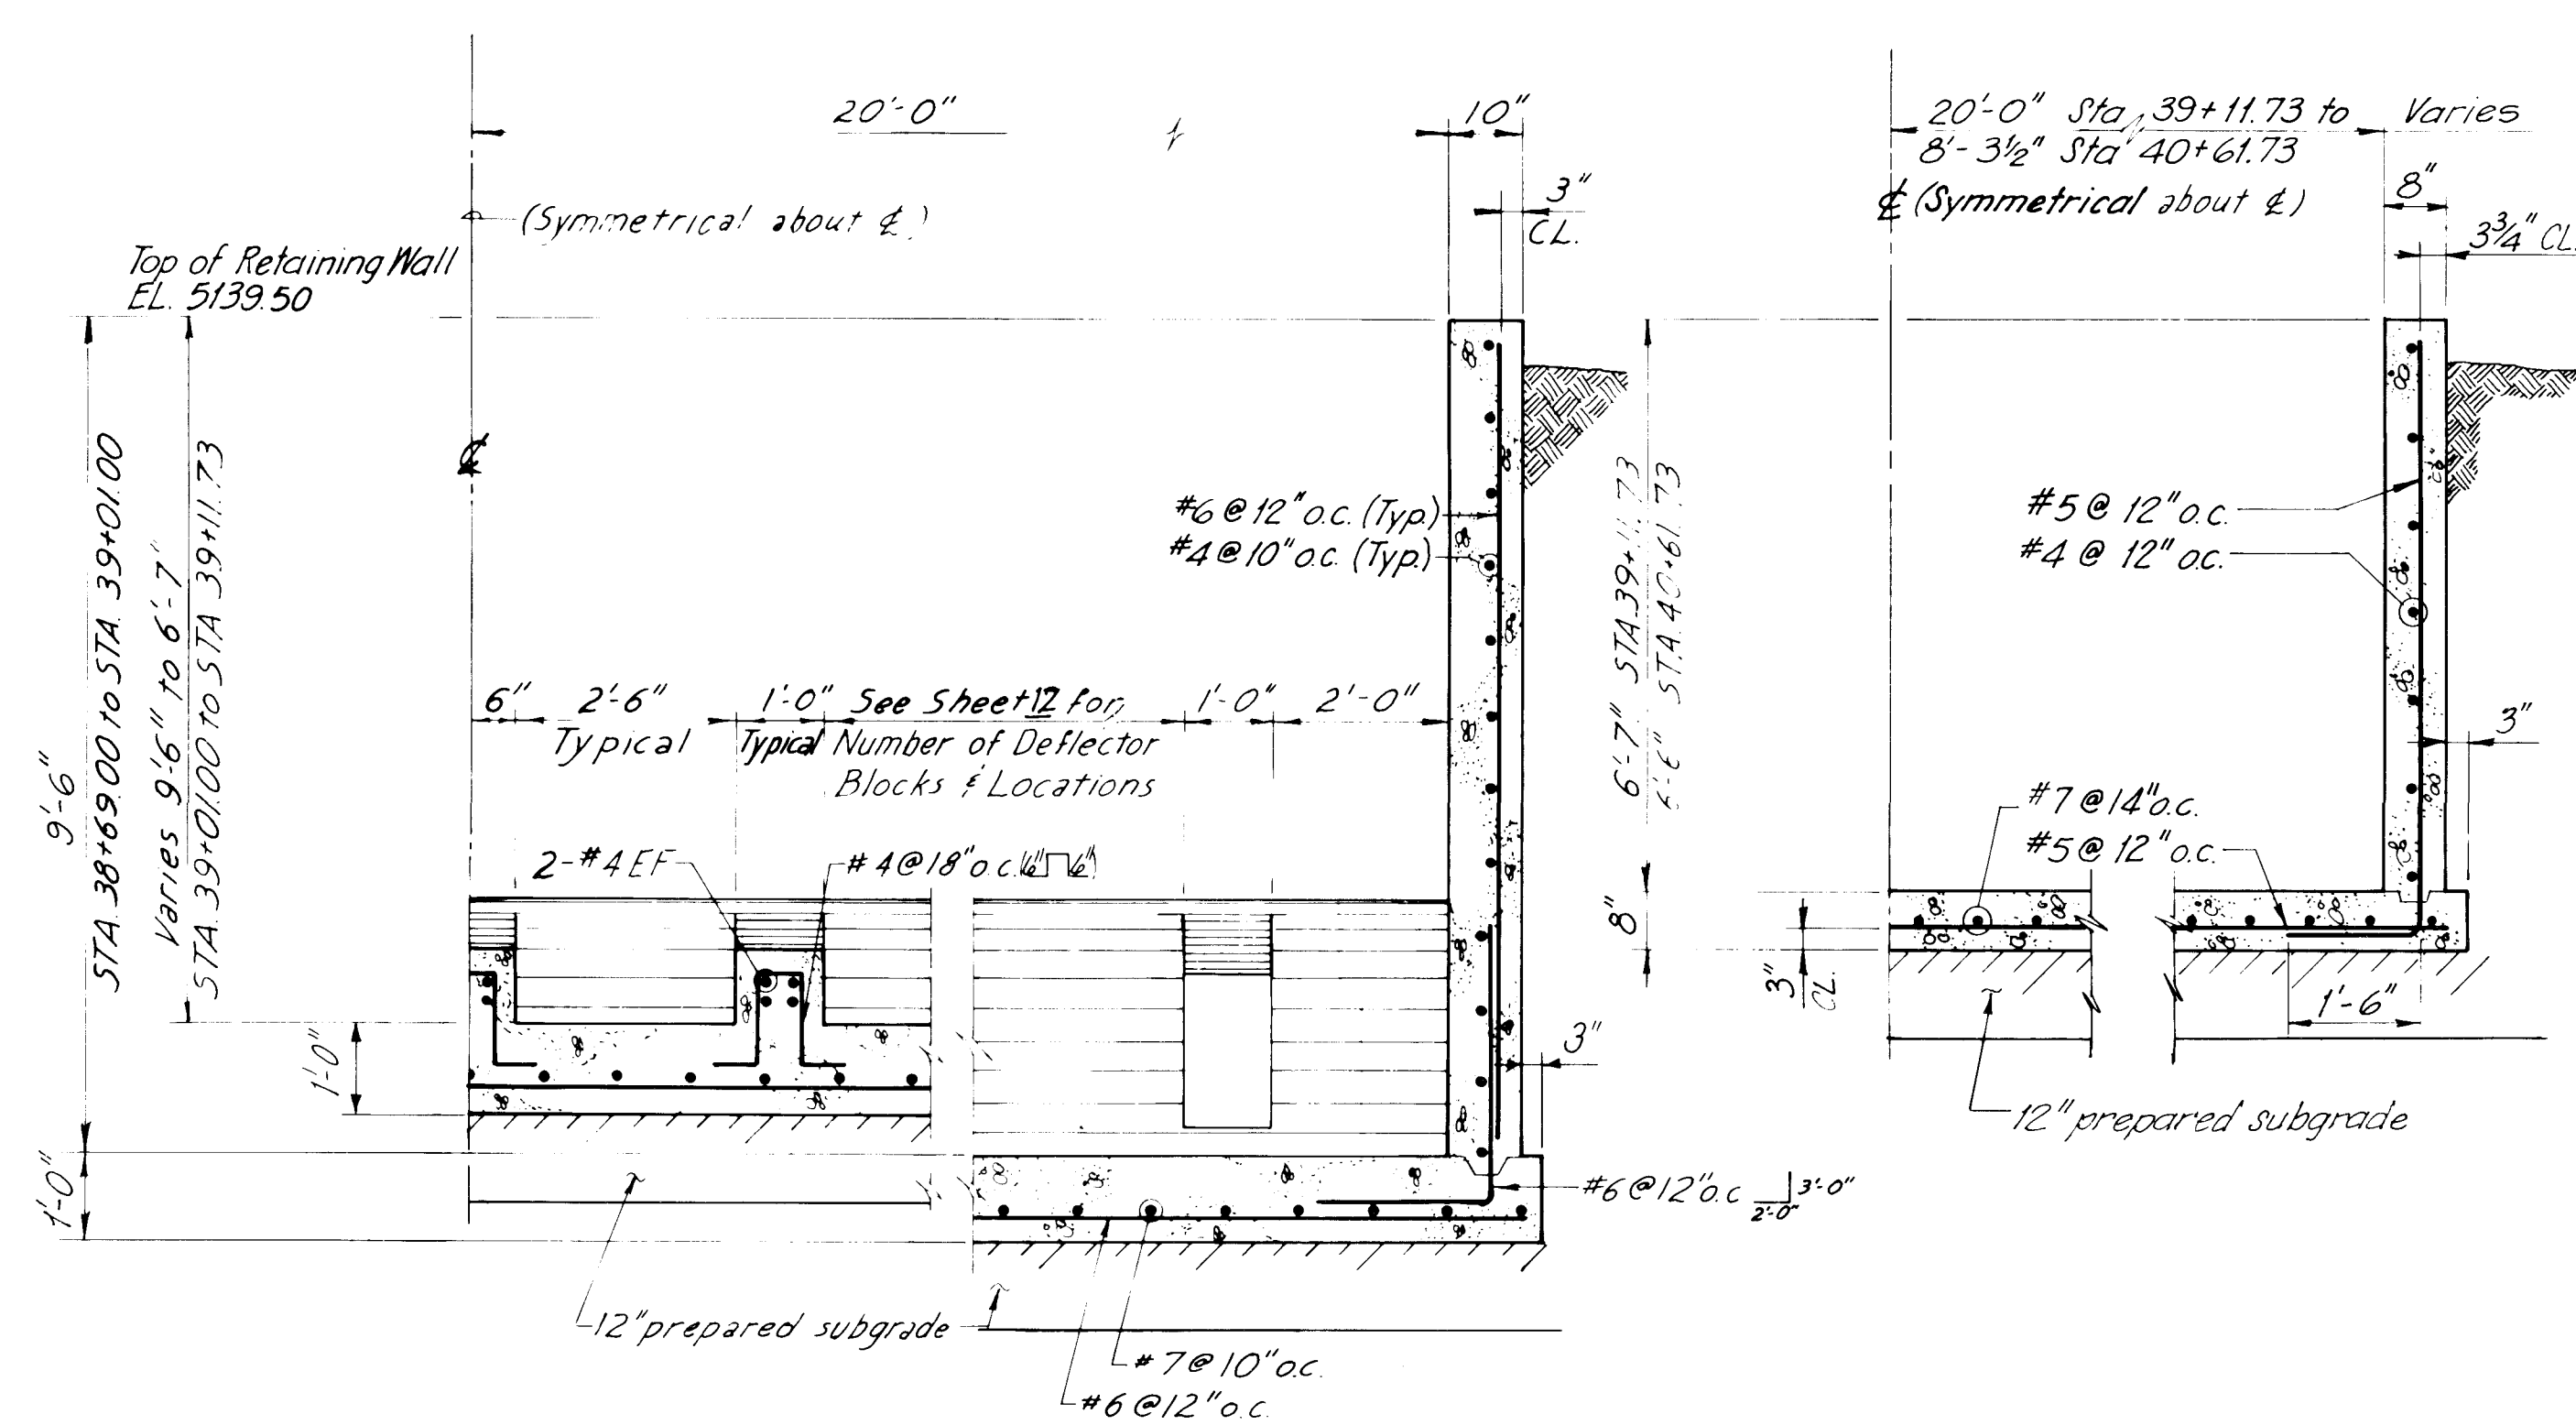


SECTION
STA 38+69.00 to STA 39+11.73

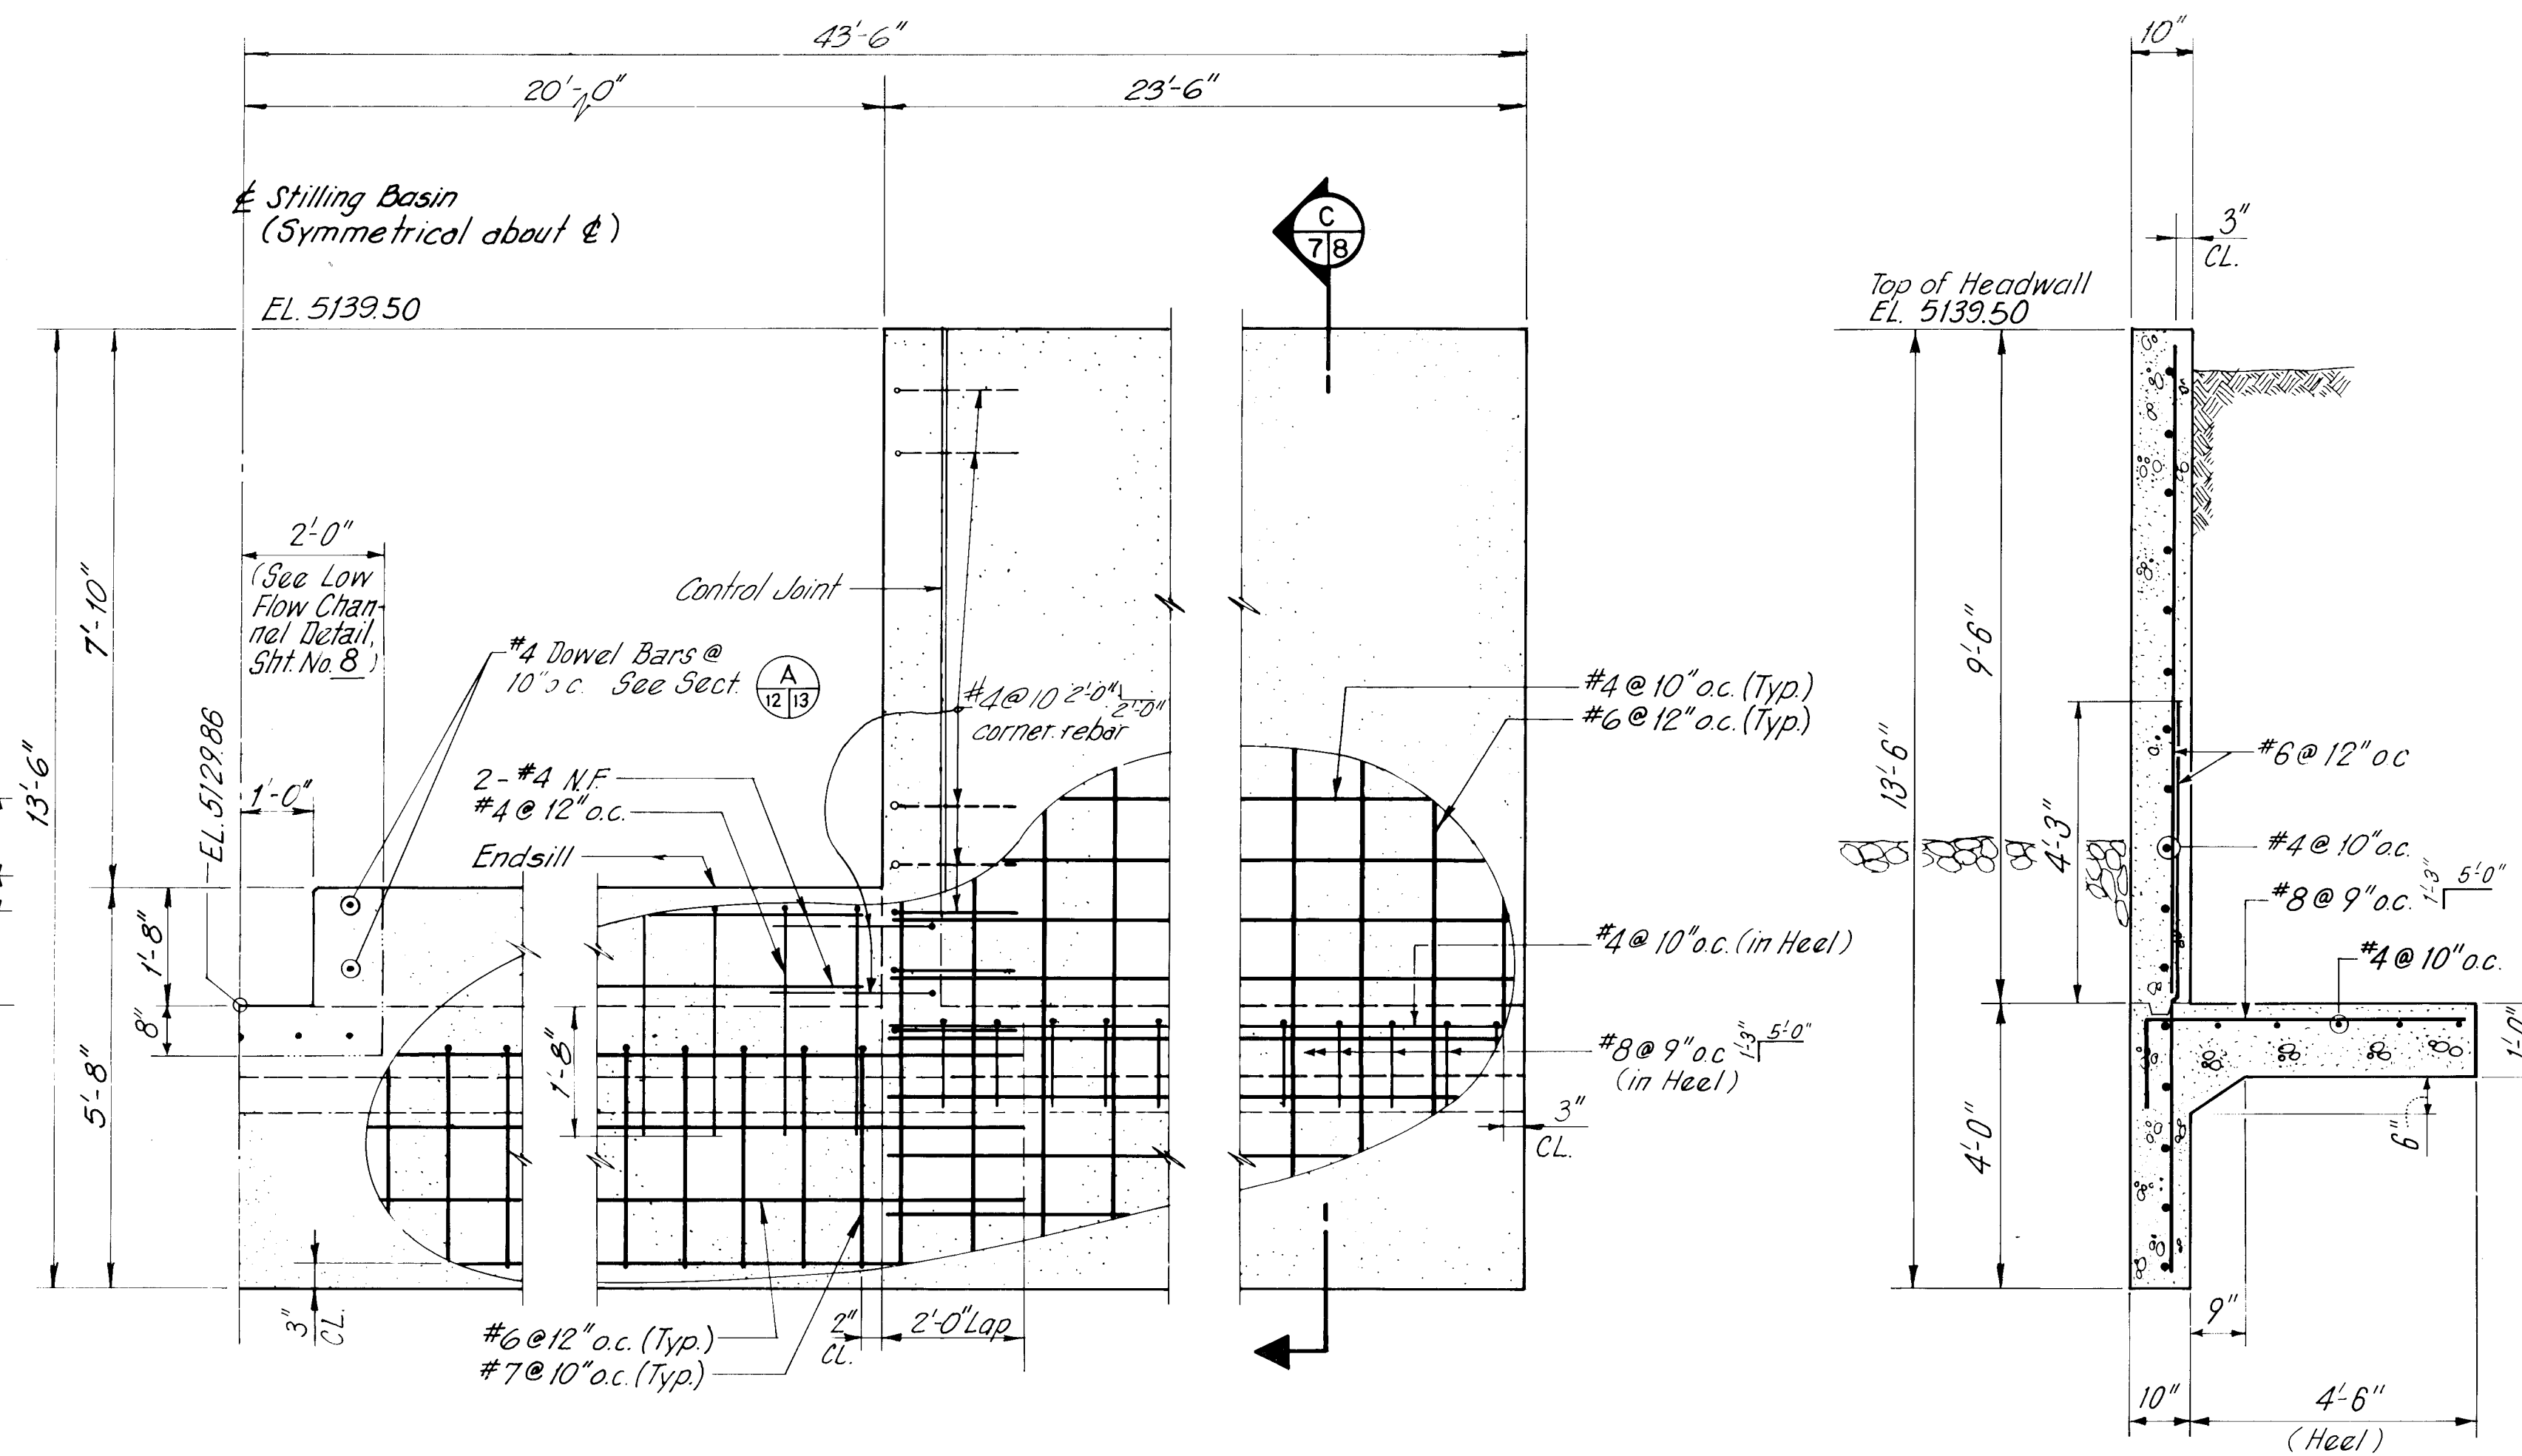

(B) HEADWALL ELEVATION

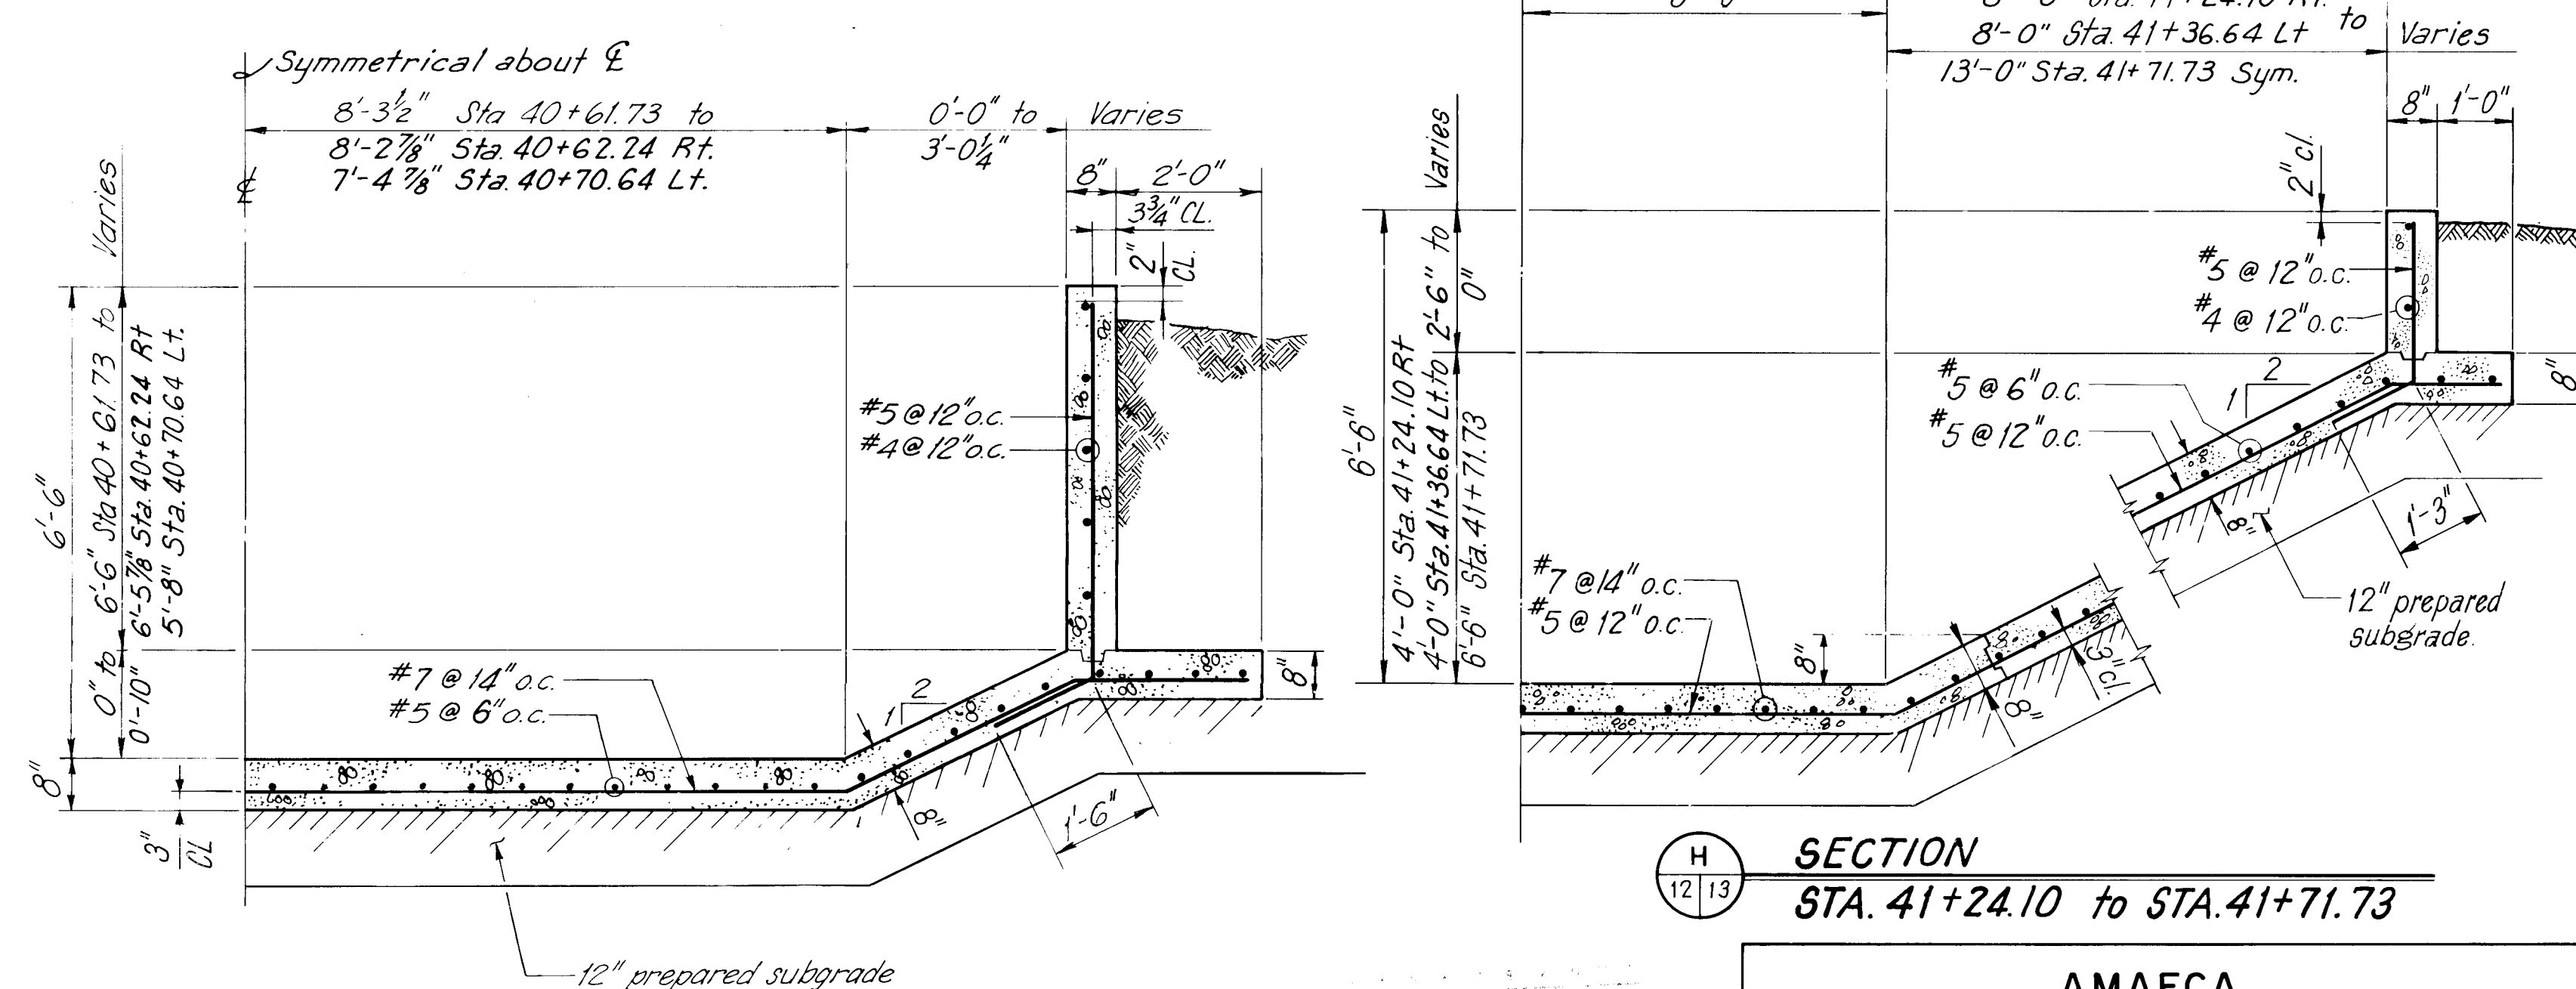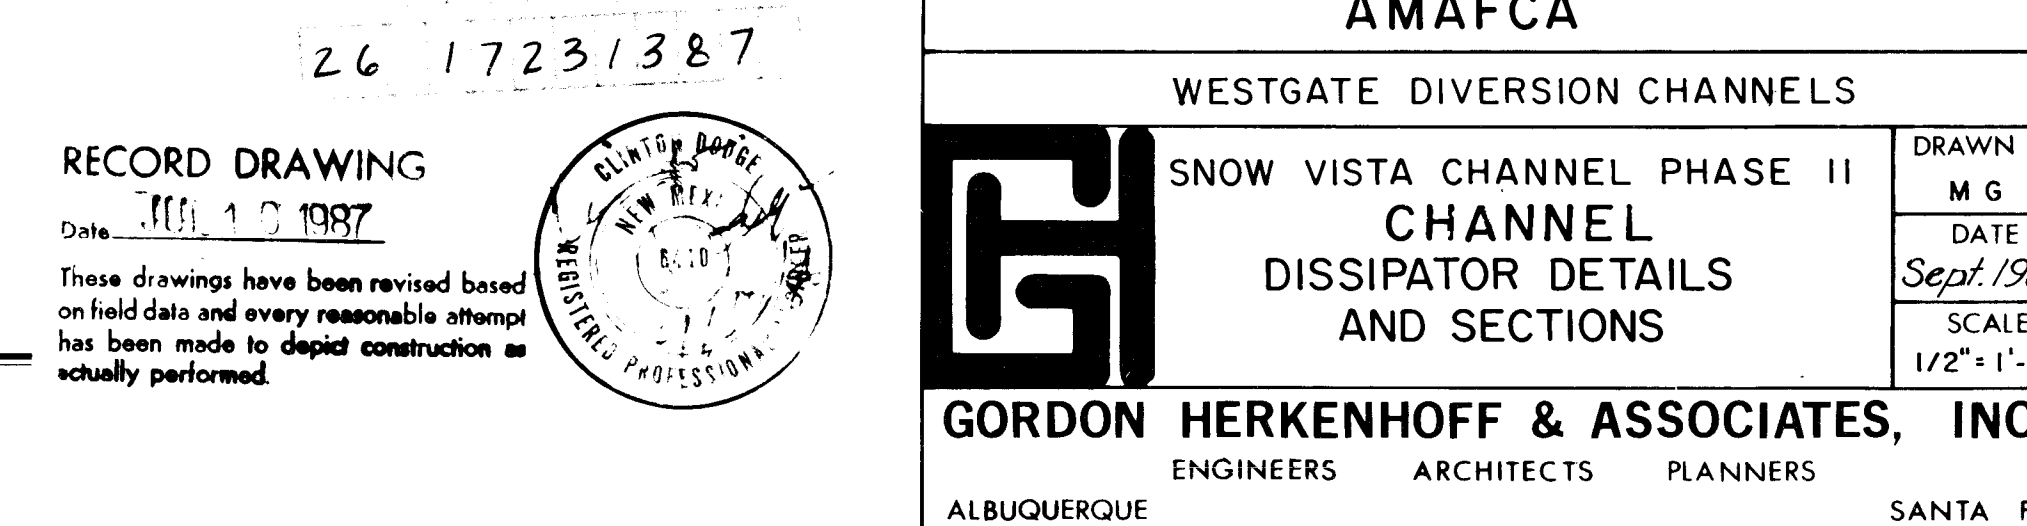SECTION
STA. 41+24.10 to STA. 41+71.73


BRUNING 242035

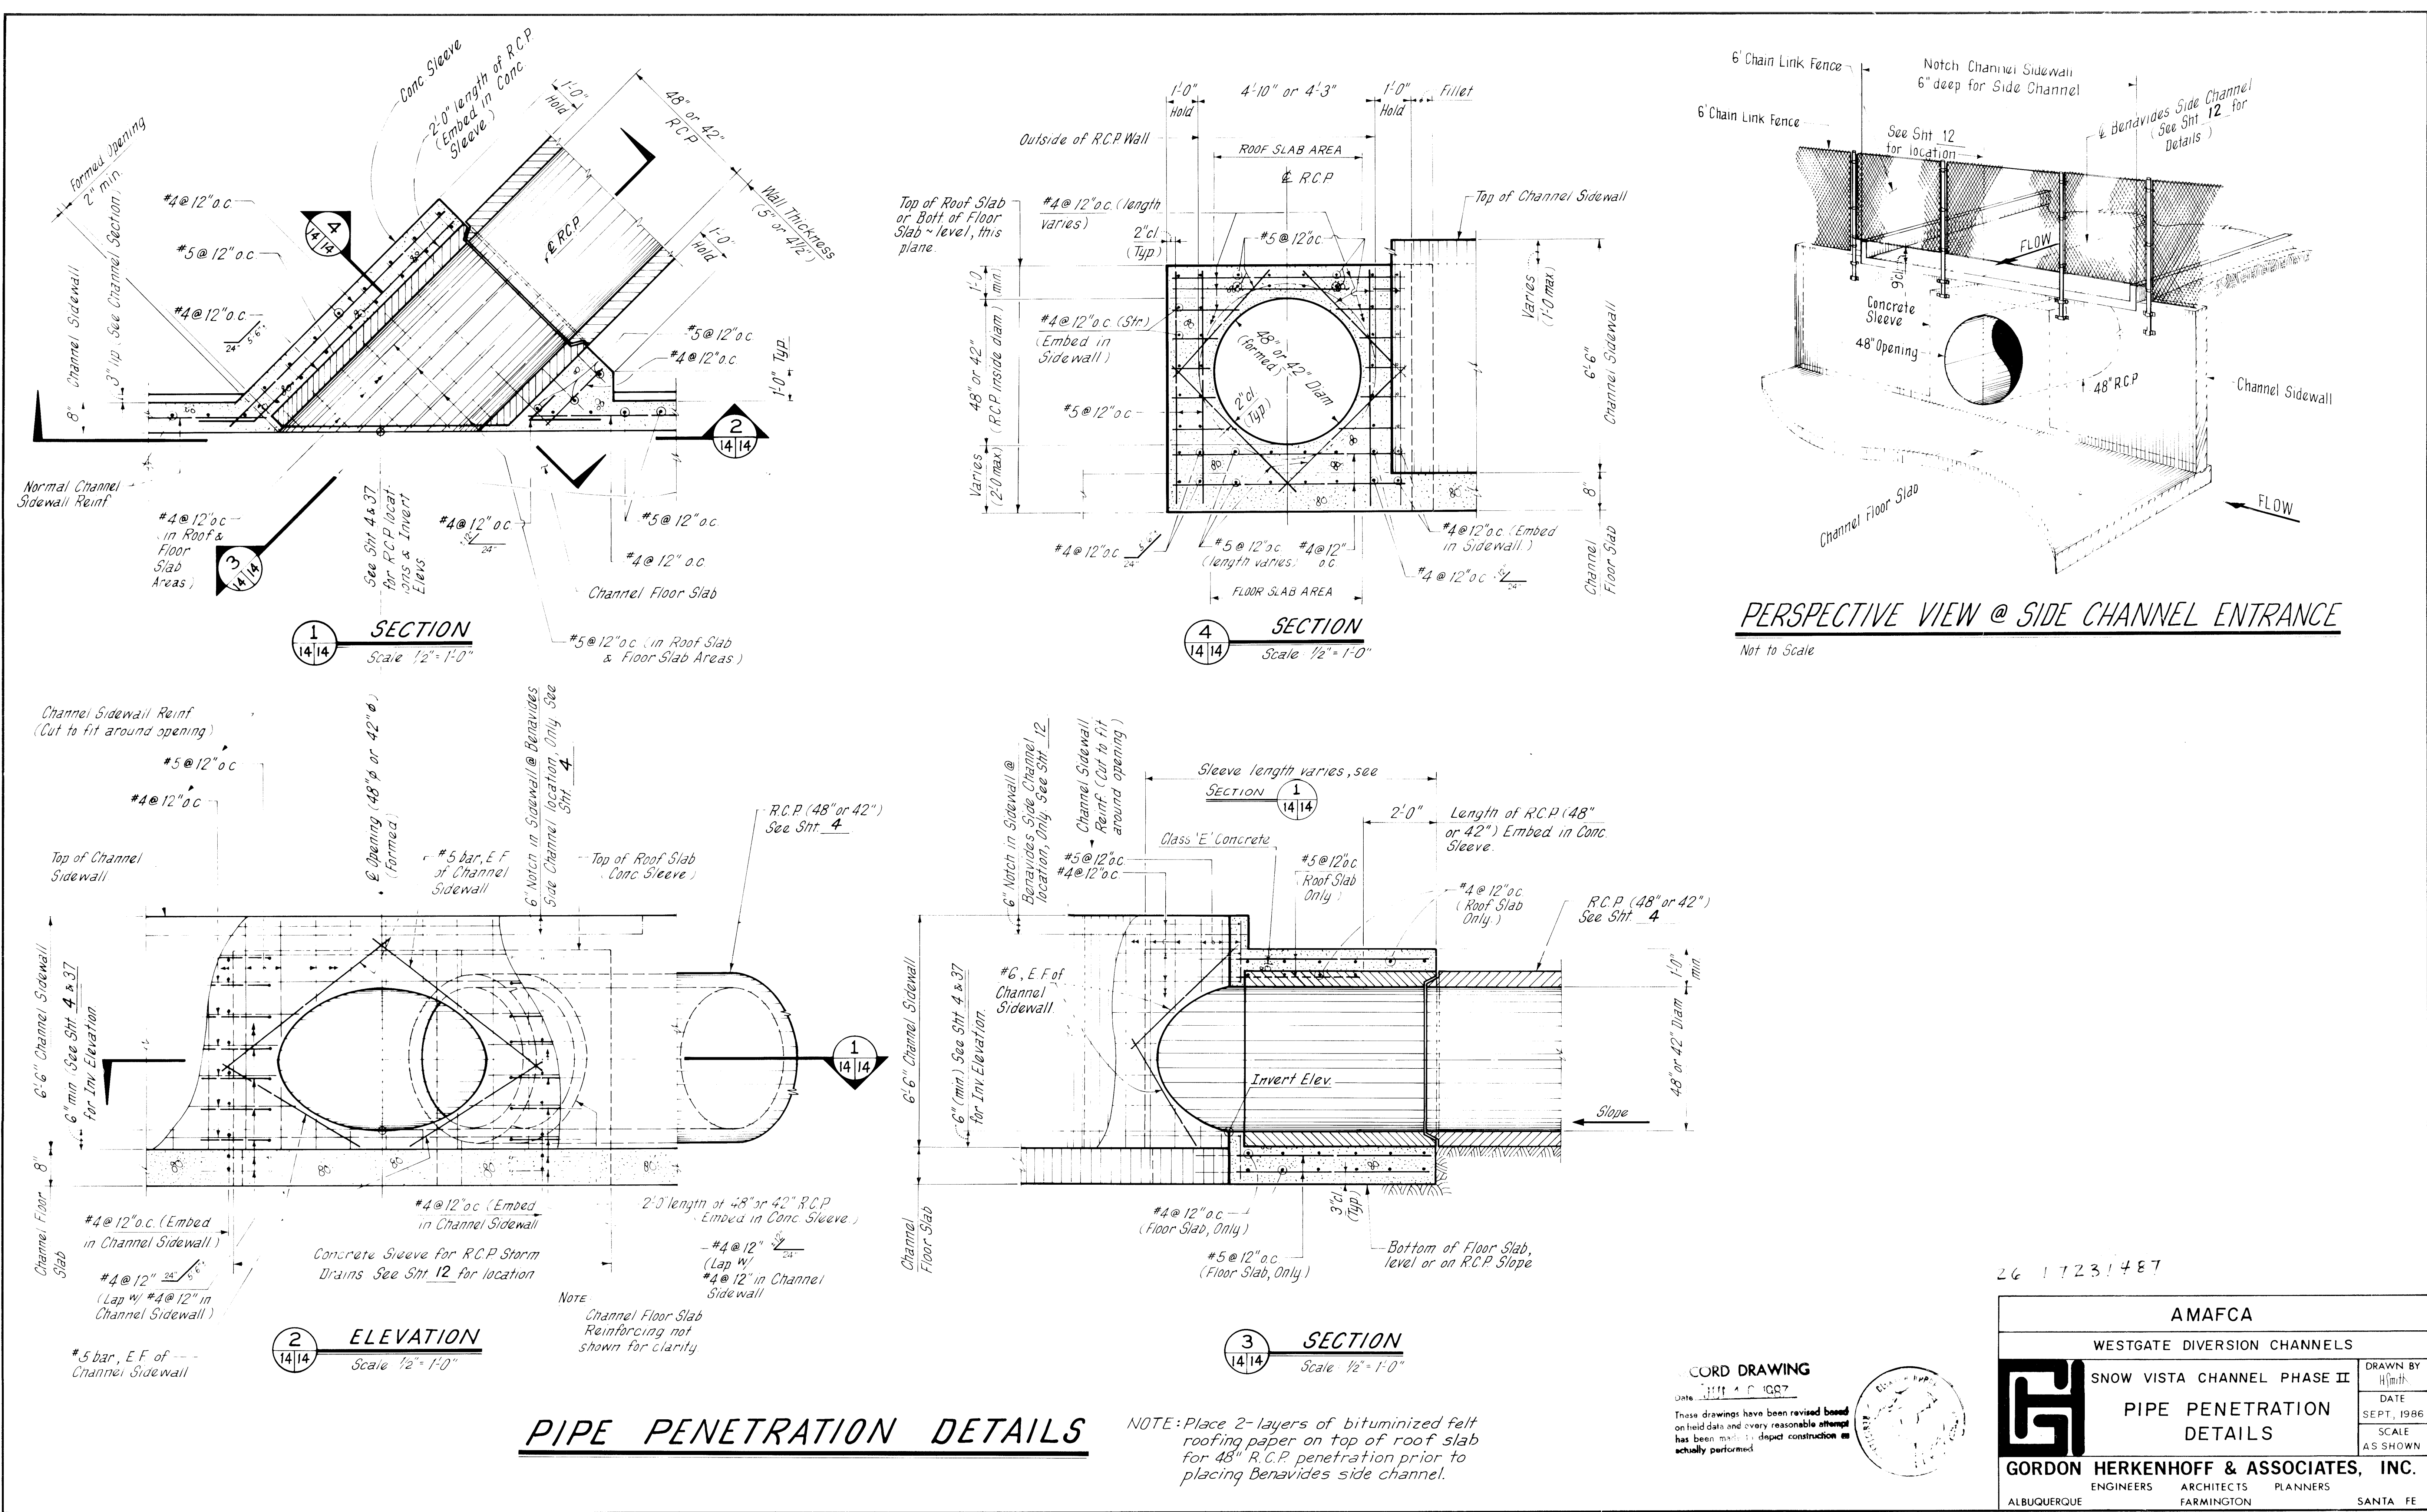

26 1 2 3 4 5 7


AMAFCA			
WESTGATE DIVERSION CHANNELS			
	SNOW VISTA CHANNEL PHASE II	DRAWN BY	HJH
	PIPE PENETRATION DETAILS	DATE	SEPT., 1986
	GORDON HERKENHOFF & ASSOCIATES, INC.	SCALE	AS SHOWN
	ENGINEERS ARCHITECTS PLANNERS		
ALBUQUERQUE	FARMINGTON	SANTA FE	



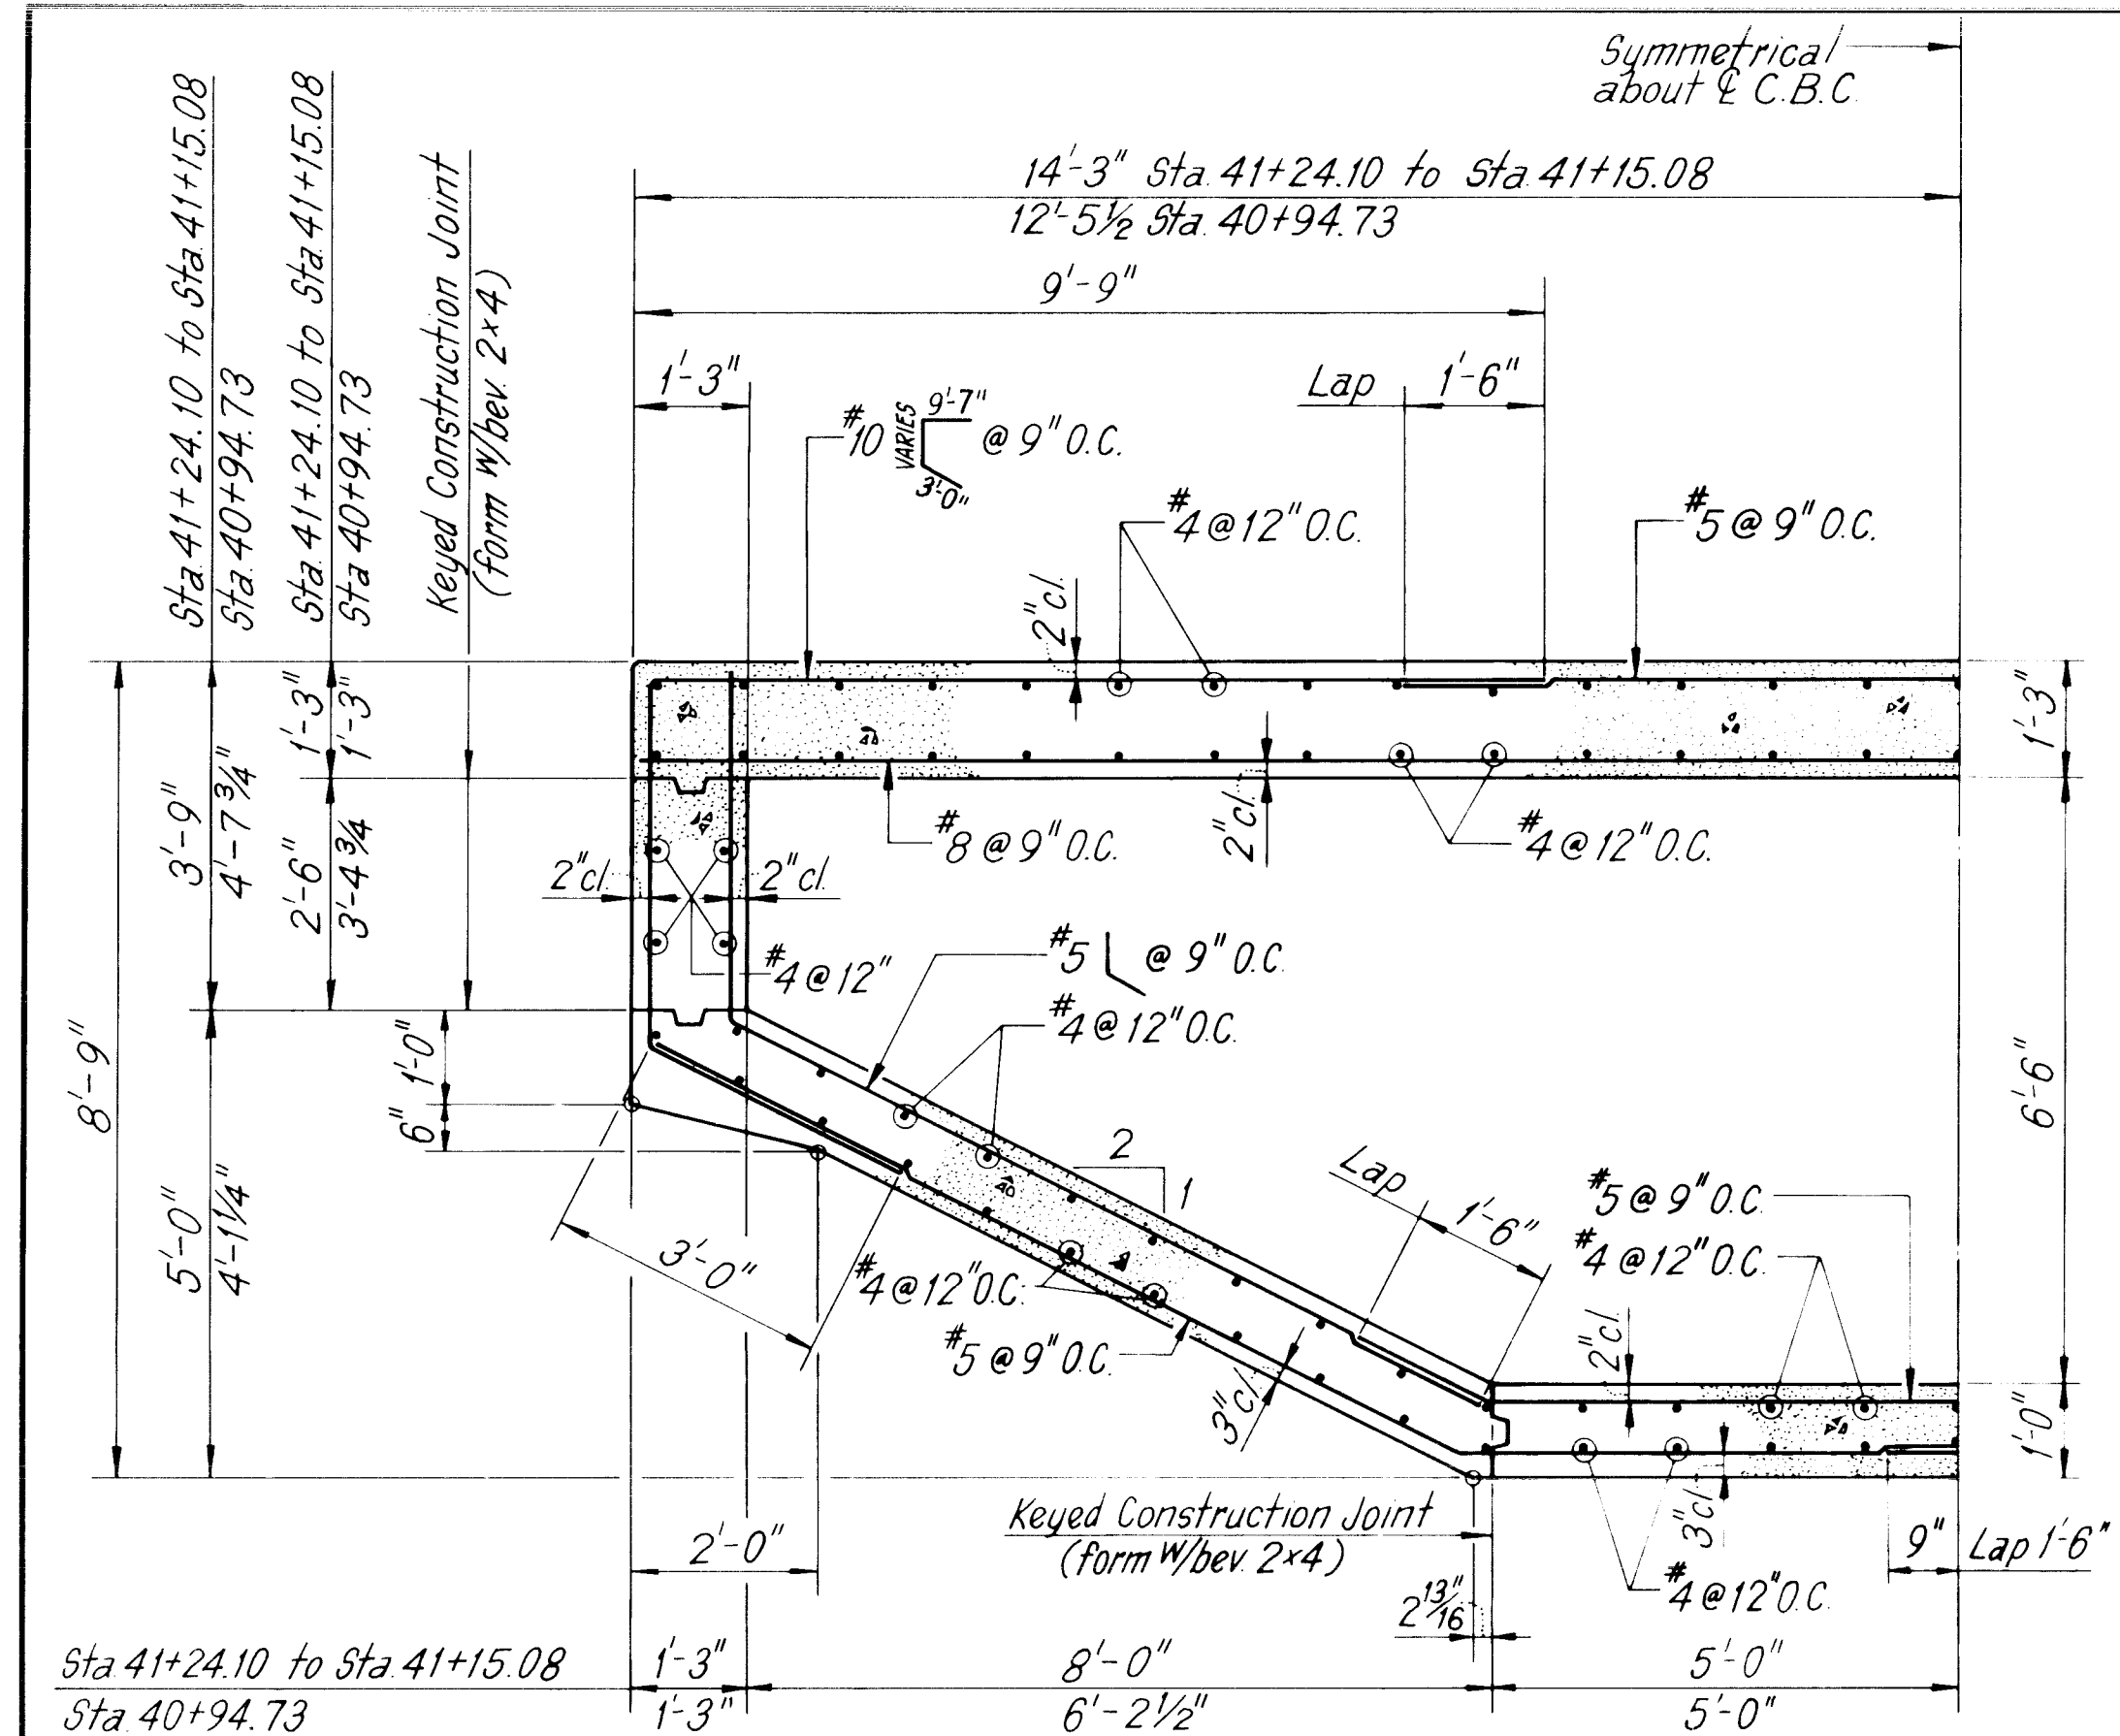


Note:
Use same reinforcing Sta 41+24.10
to Inlet Sta 41+36.64

2 HALF SECTION
SCALE: 1/2" = 1'-0"

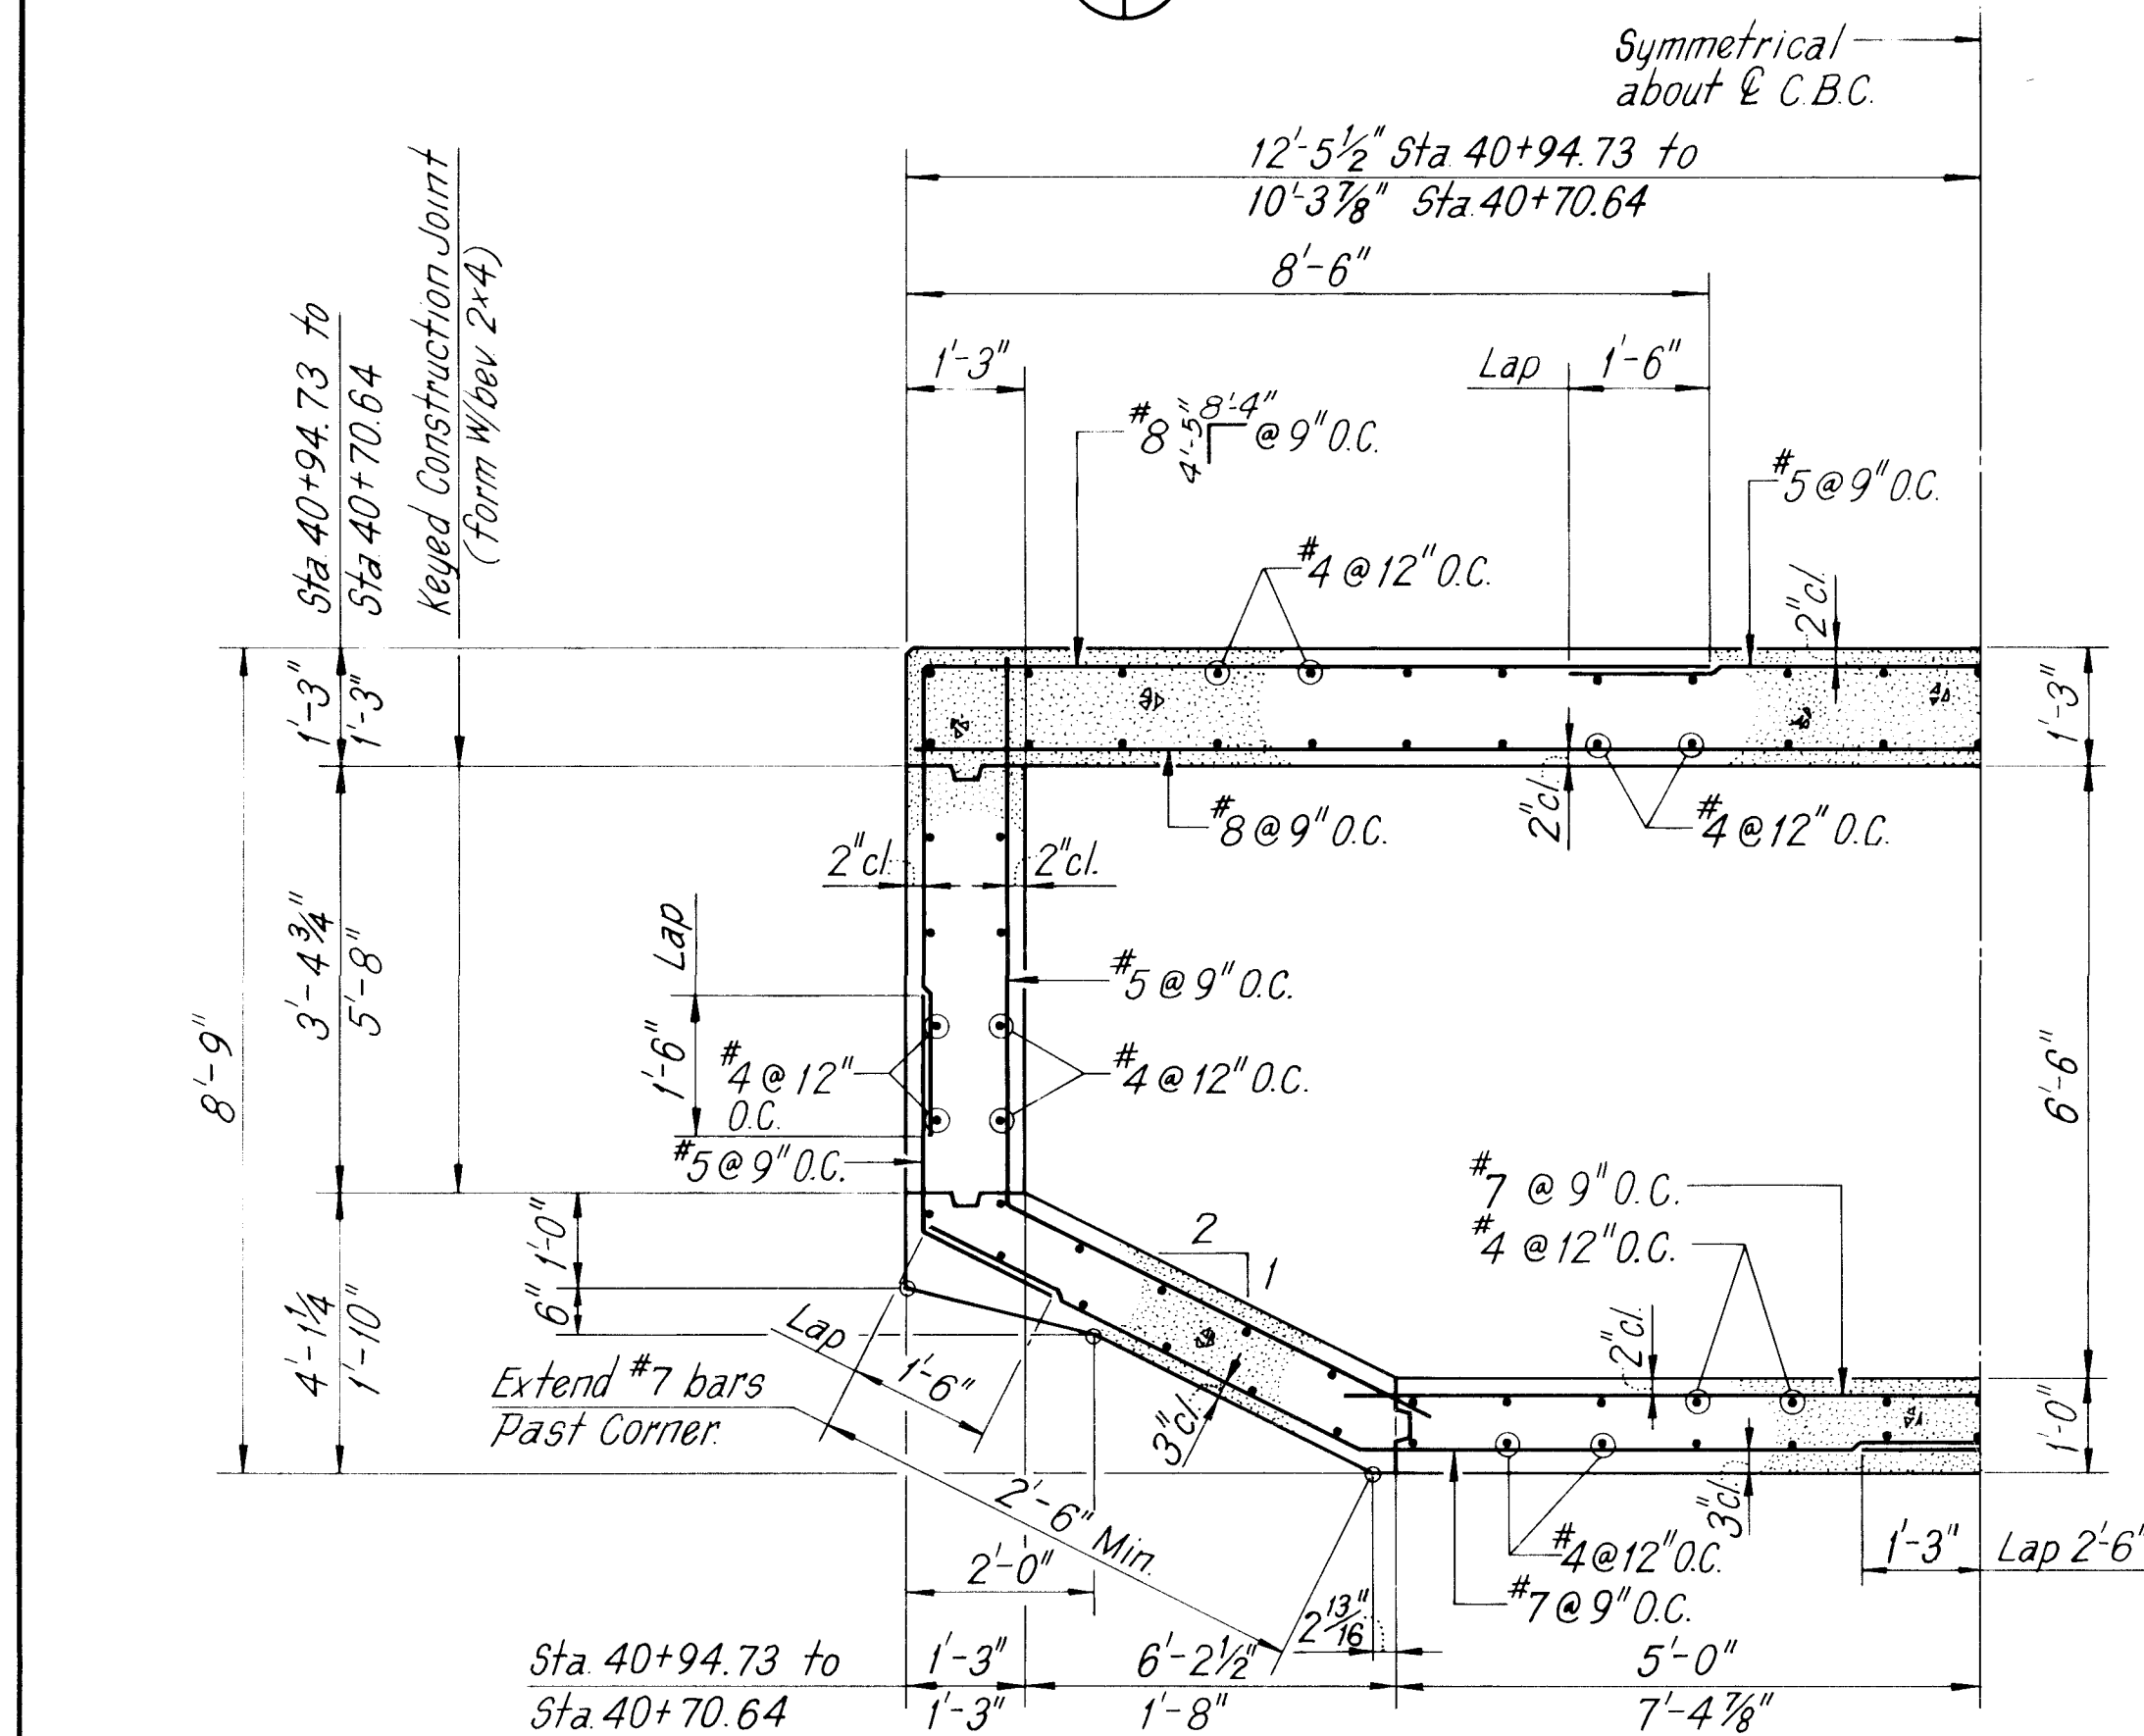


Note:
Use same reinforcing Sta 40+70.64
to Outlet Sta 40+82.24


1 HALF SECTION
SCALE: 1/2" = 1'-0"

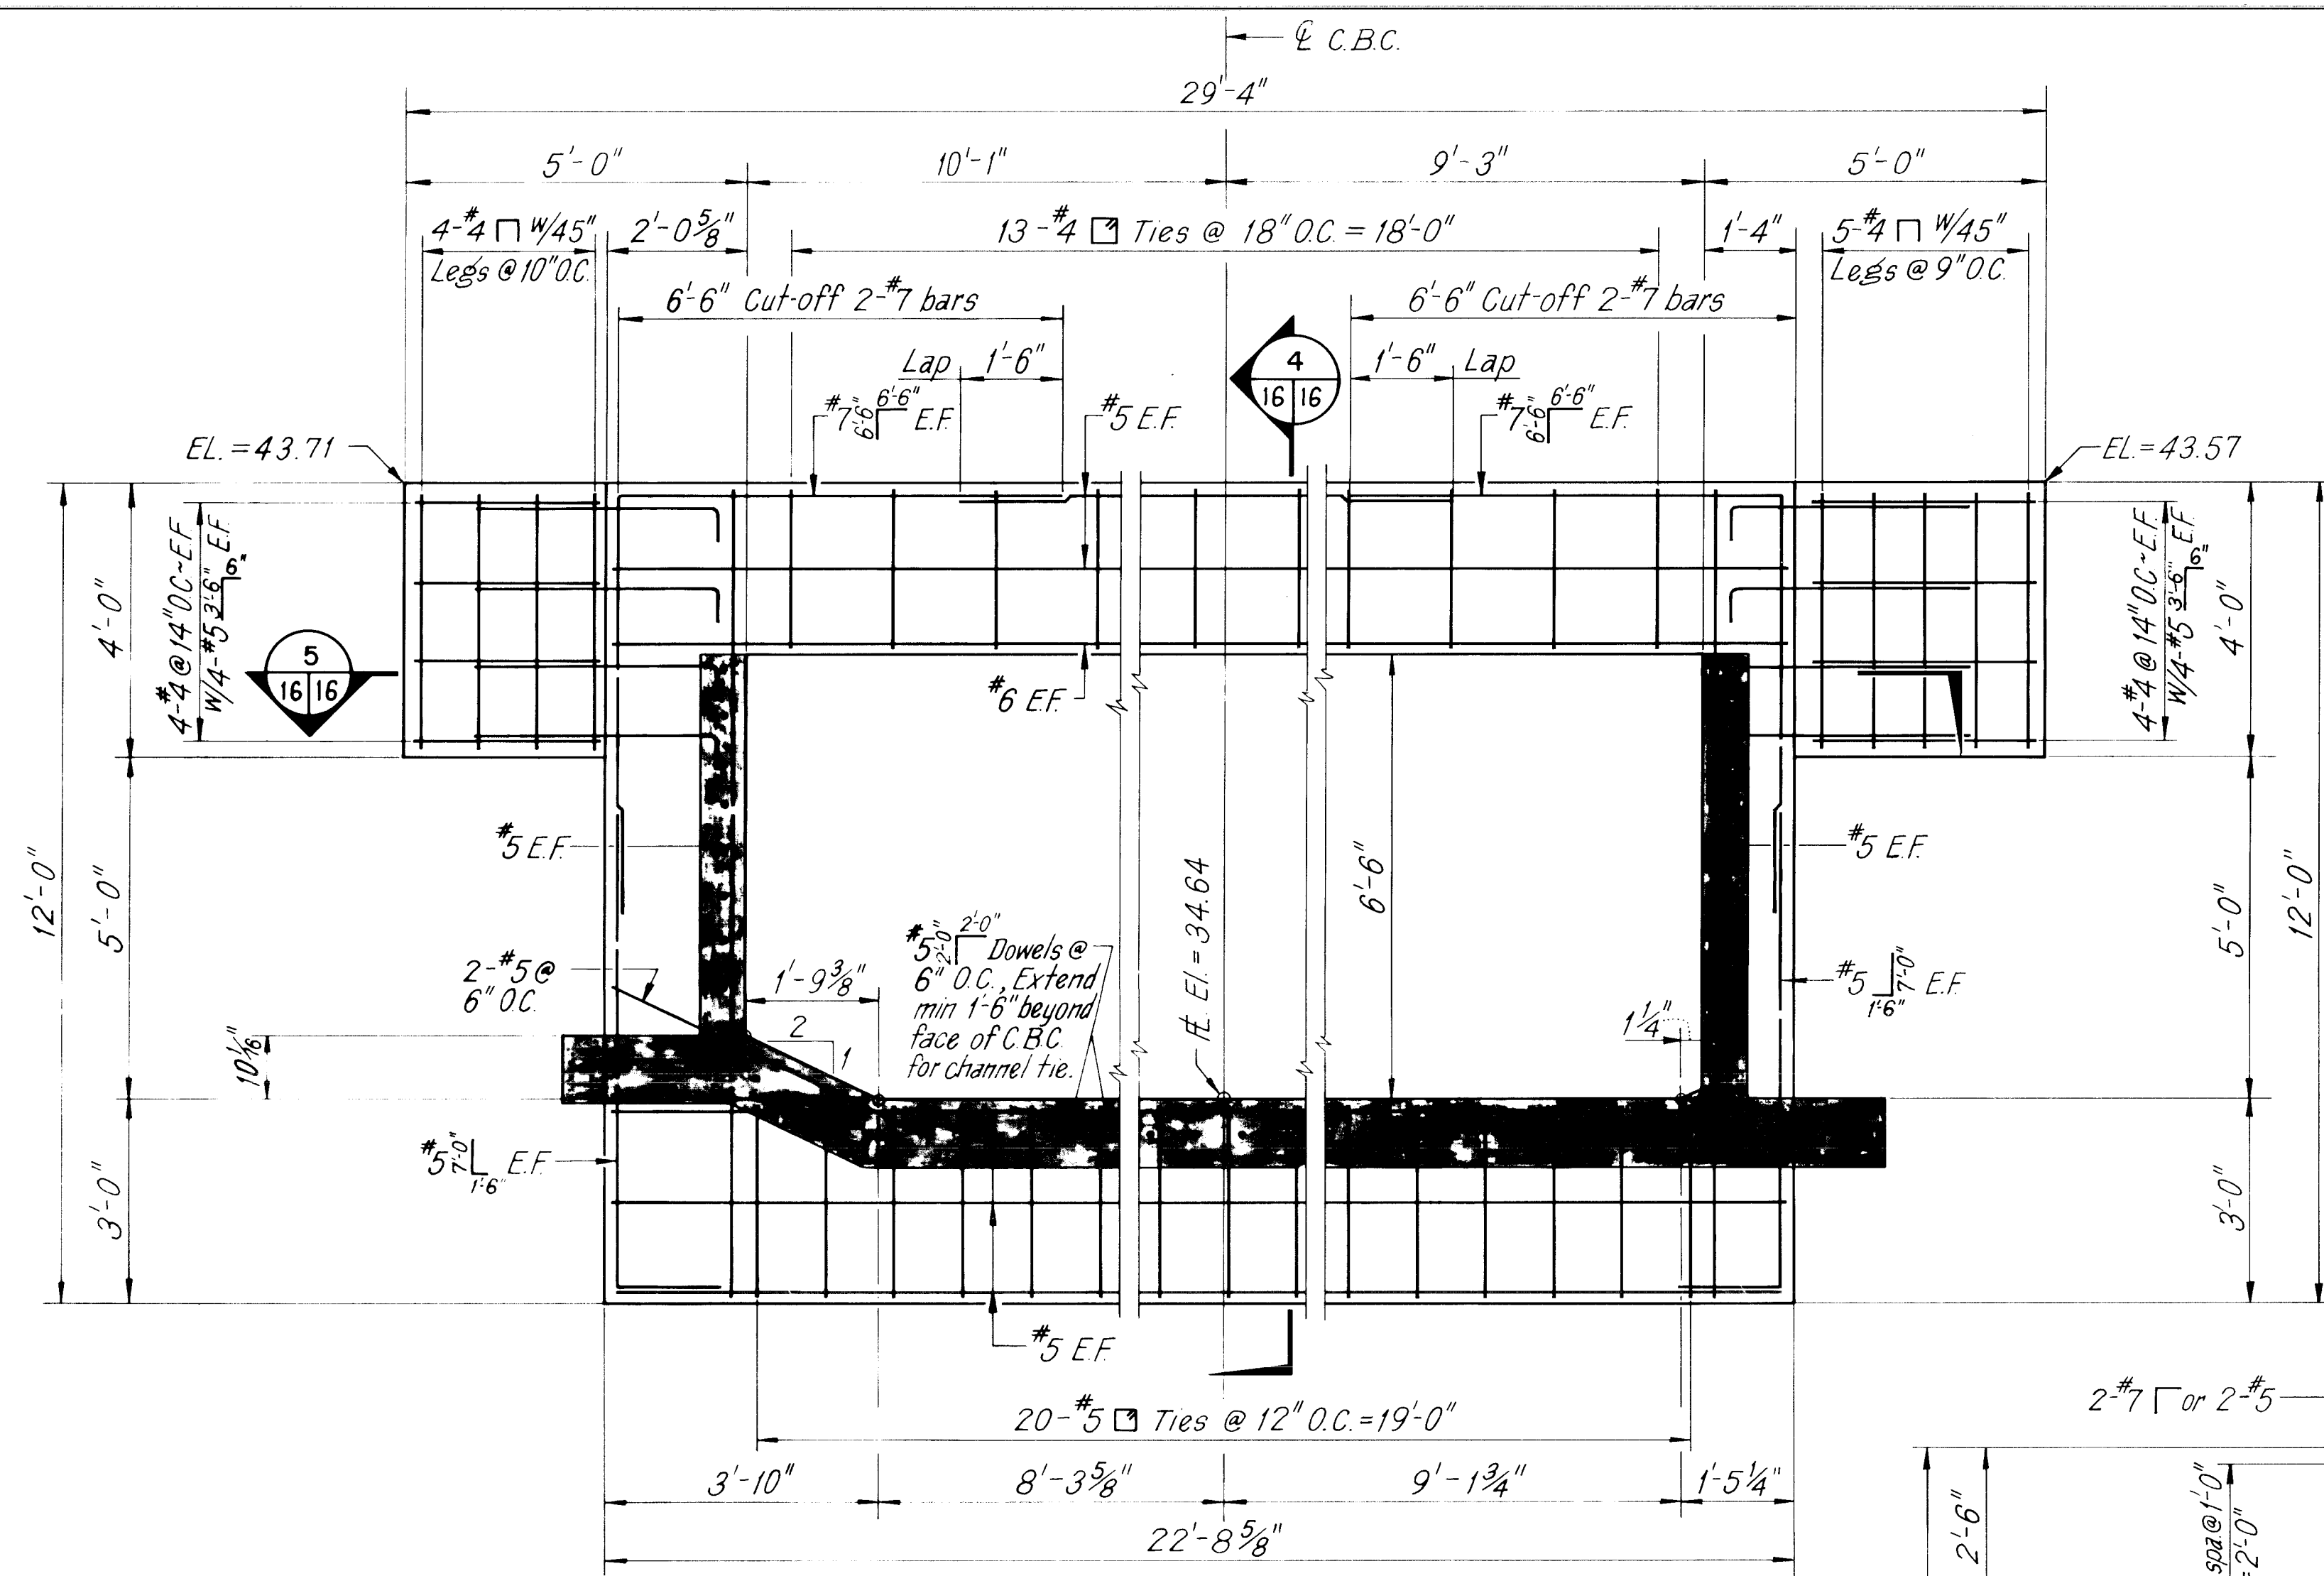

3 ELEVATION AT OUTLET
SCALE: 1/2" = 1'-0"

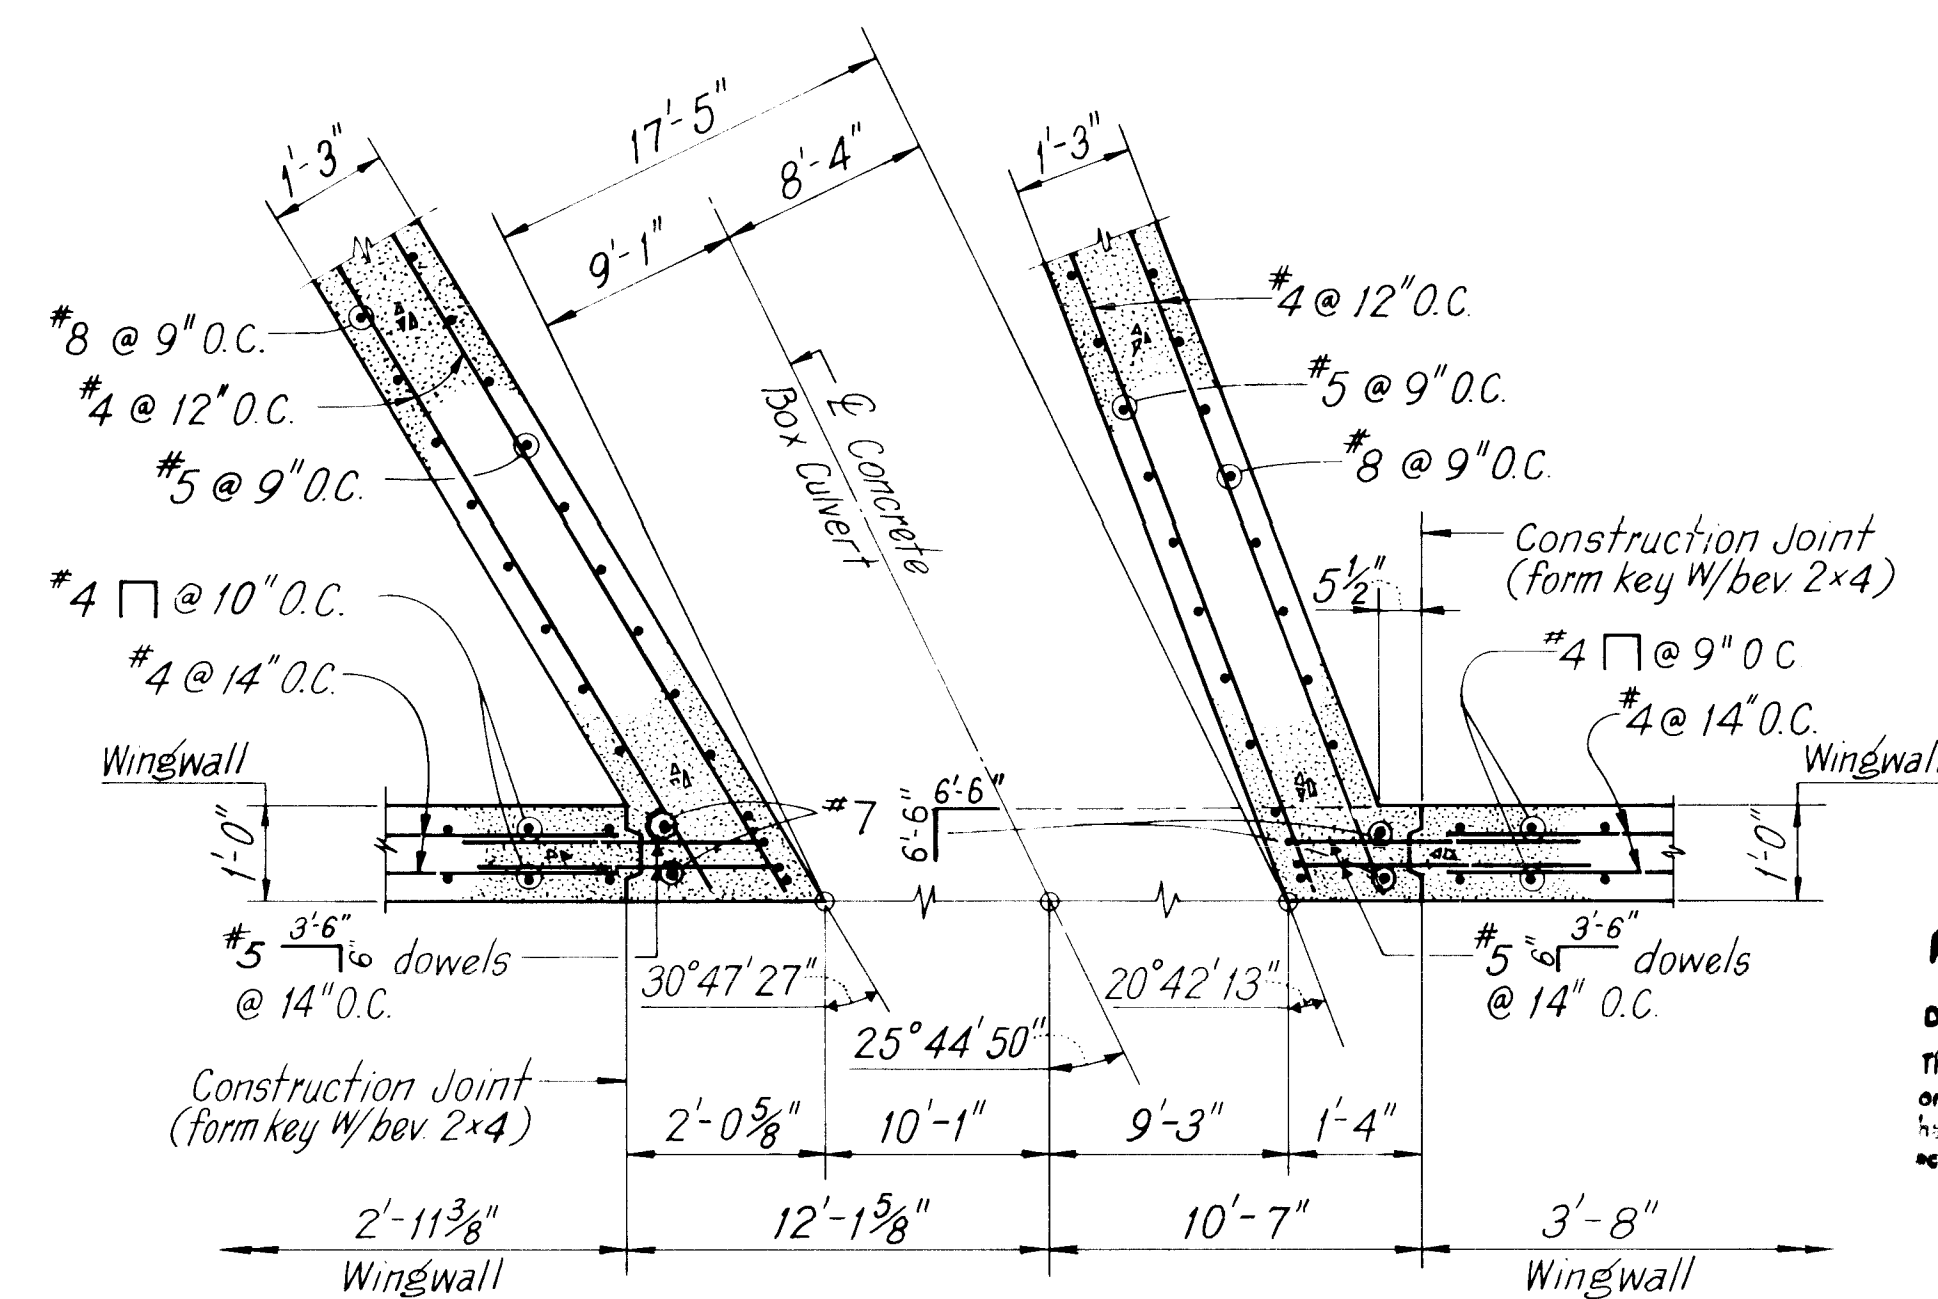


5 WINGWALL CONNECTION DETAILS
SCALE: 1/2" = 1'-0"

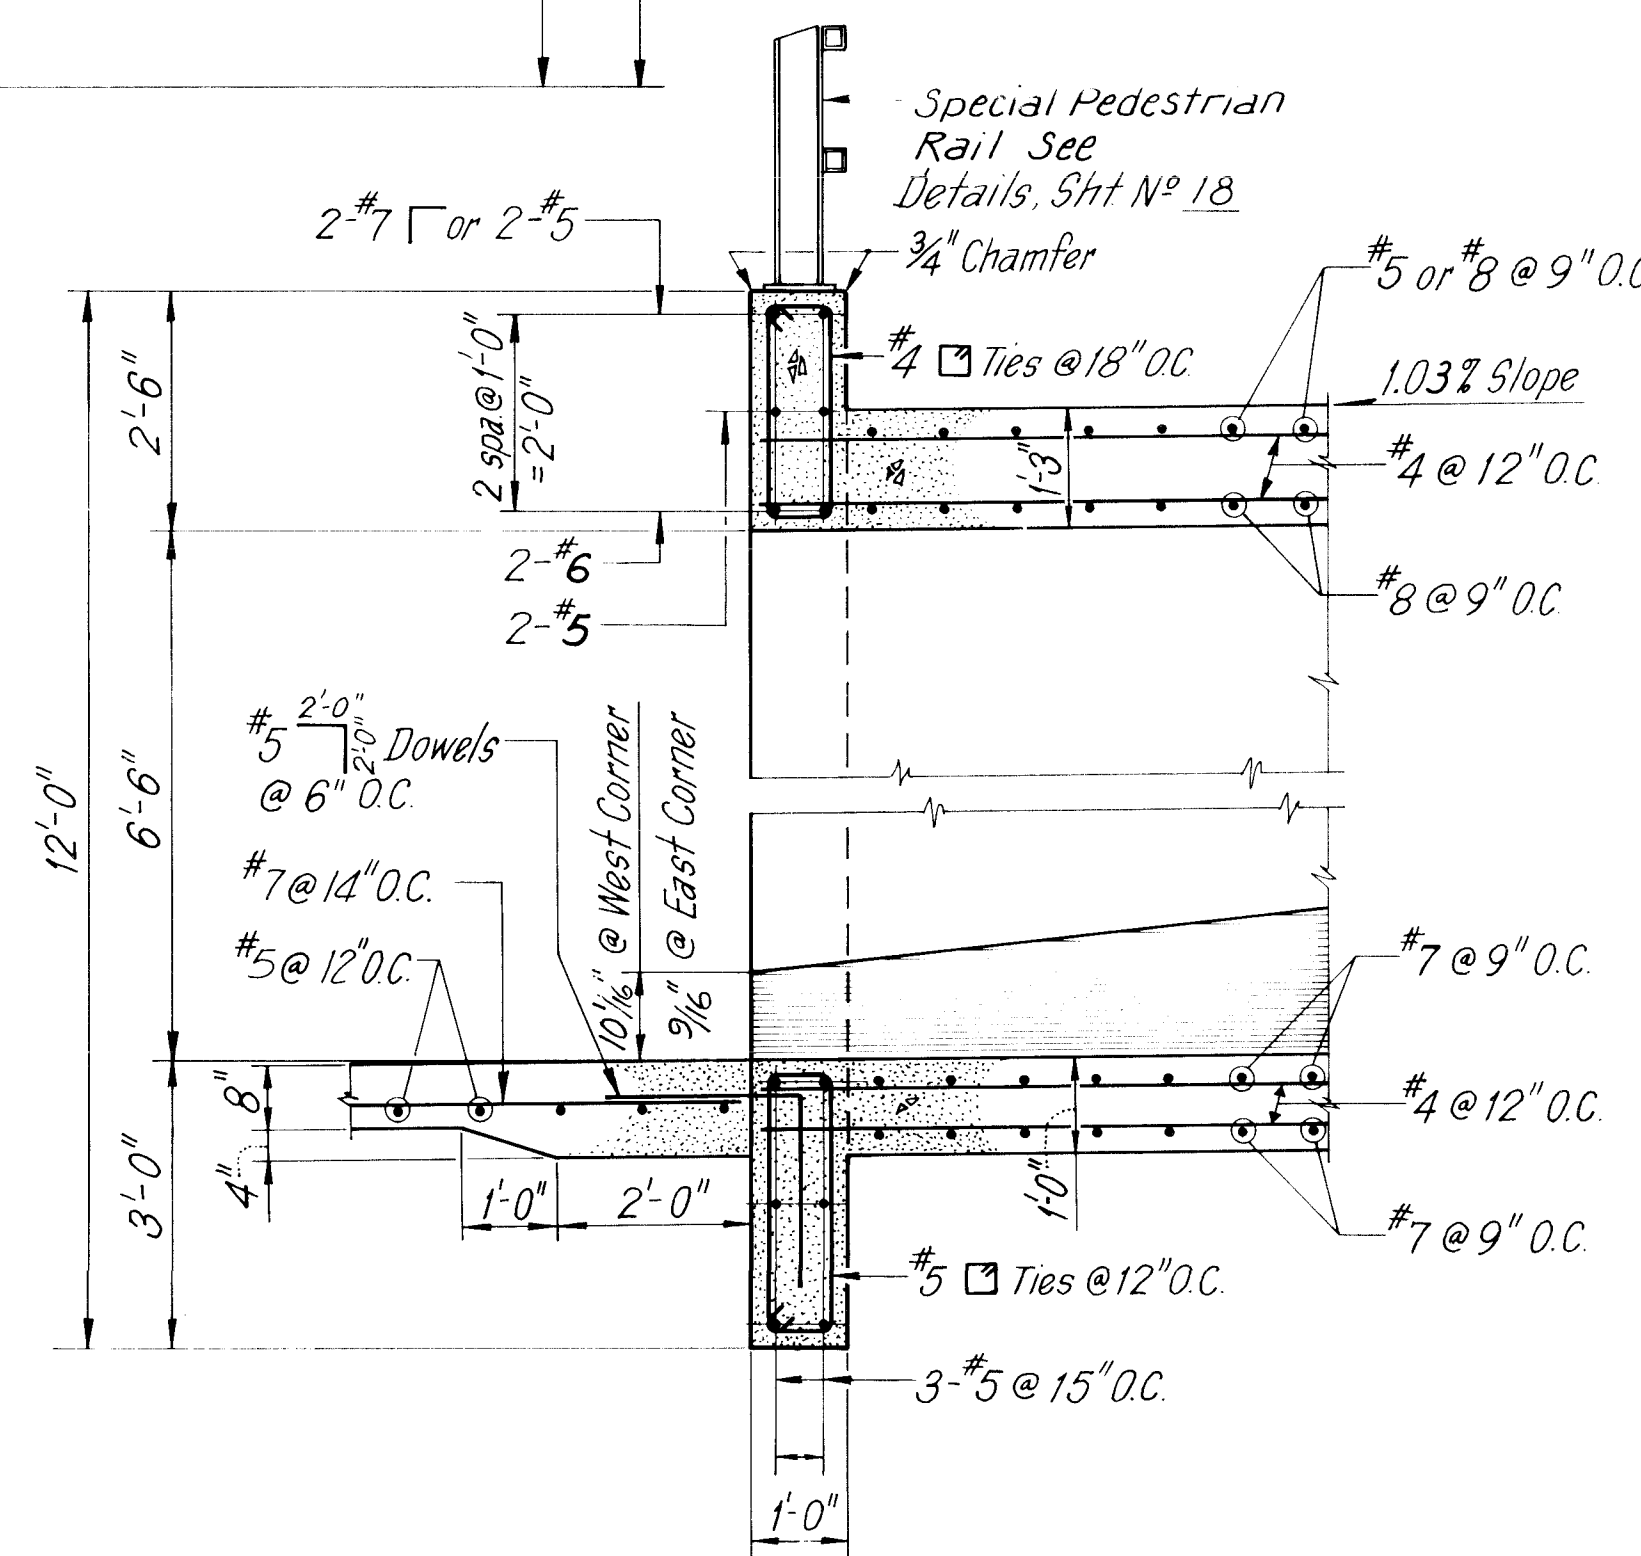






4 SECTION AT OUTLET END
SCALE: 1/2" = 1'-0"

RECORD DRAWING

These drawings have been revised based
on field data and every reasonable attempt
has been made to depict construction as
actually performed.

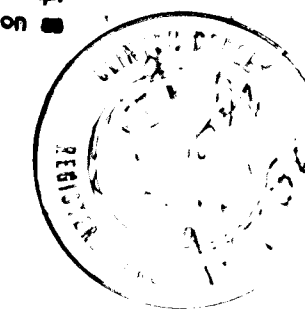

AMAFCA	
WESTGATE DIVERSION CHANNELS	
SNOW VISTA CHANNEL PHASE II	
BENAVIDES ROAD C.B.C.	
REINFORCEMENT DETAILS	
GORDON HERKENHOFF & ASSOCIATES, INC.	ENGINEERS ARCHITECTS PLANNERS
ALBUQUERQUE	FARMINGTON SANTA FE

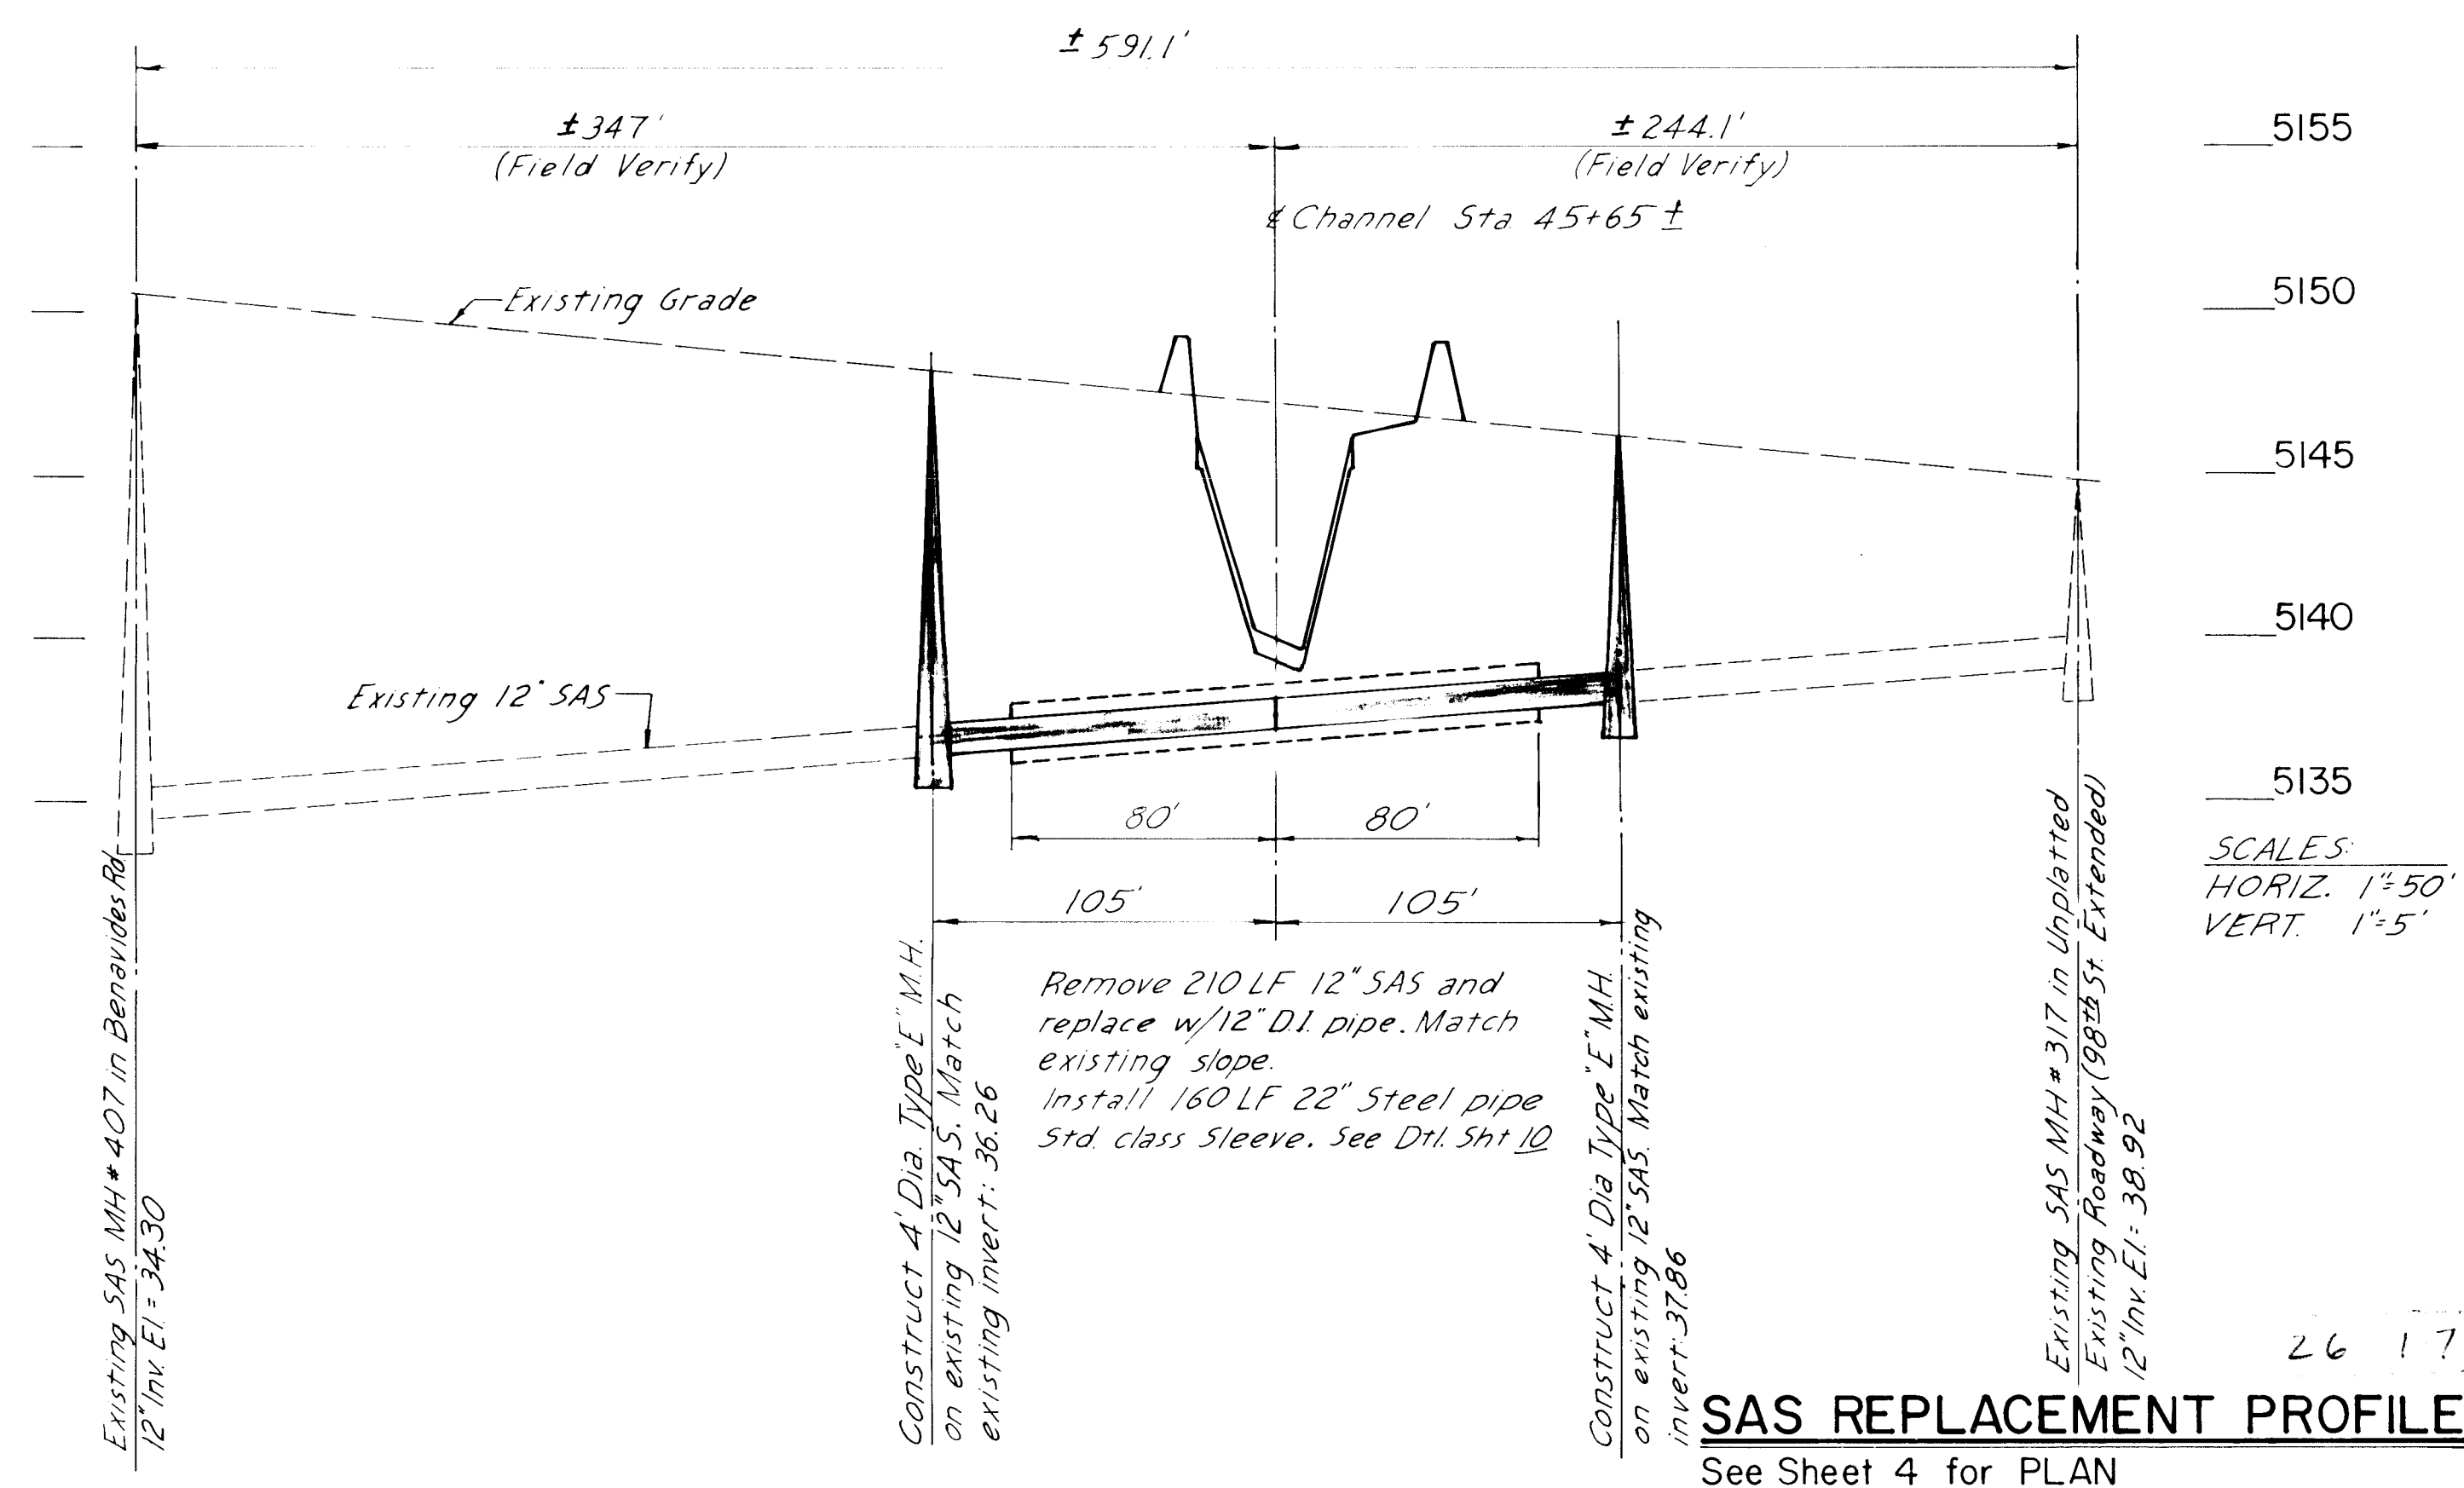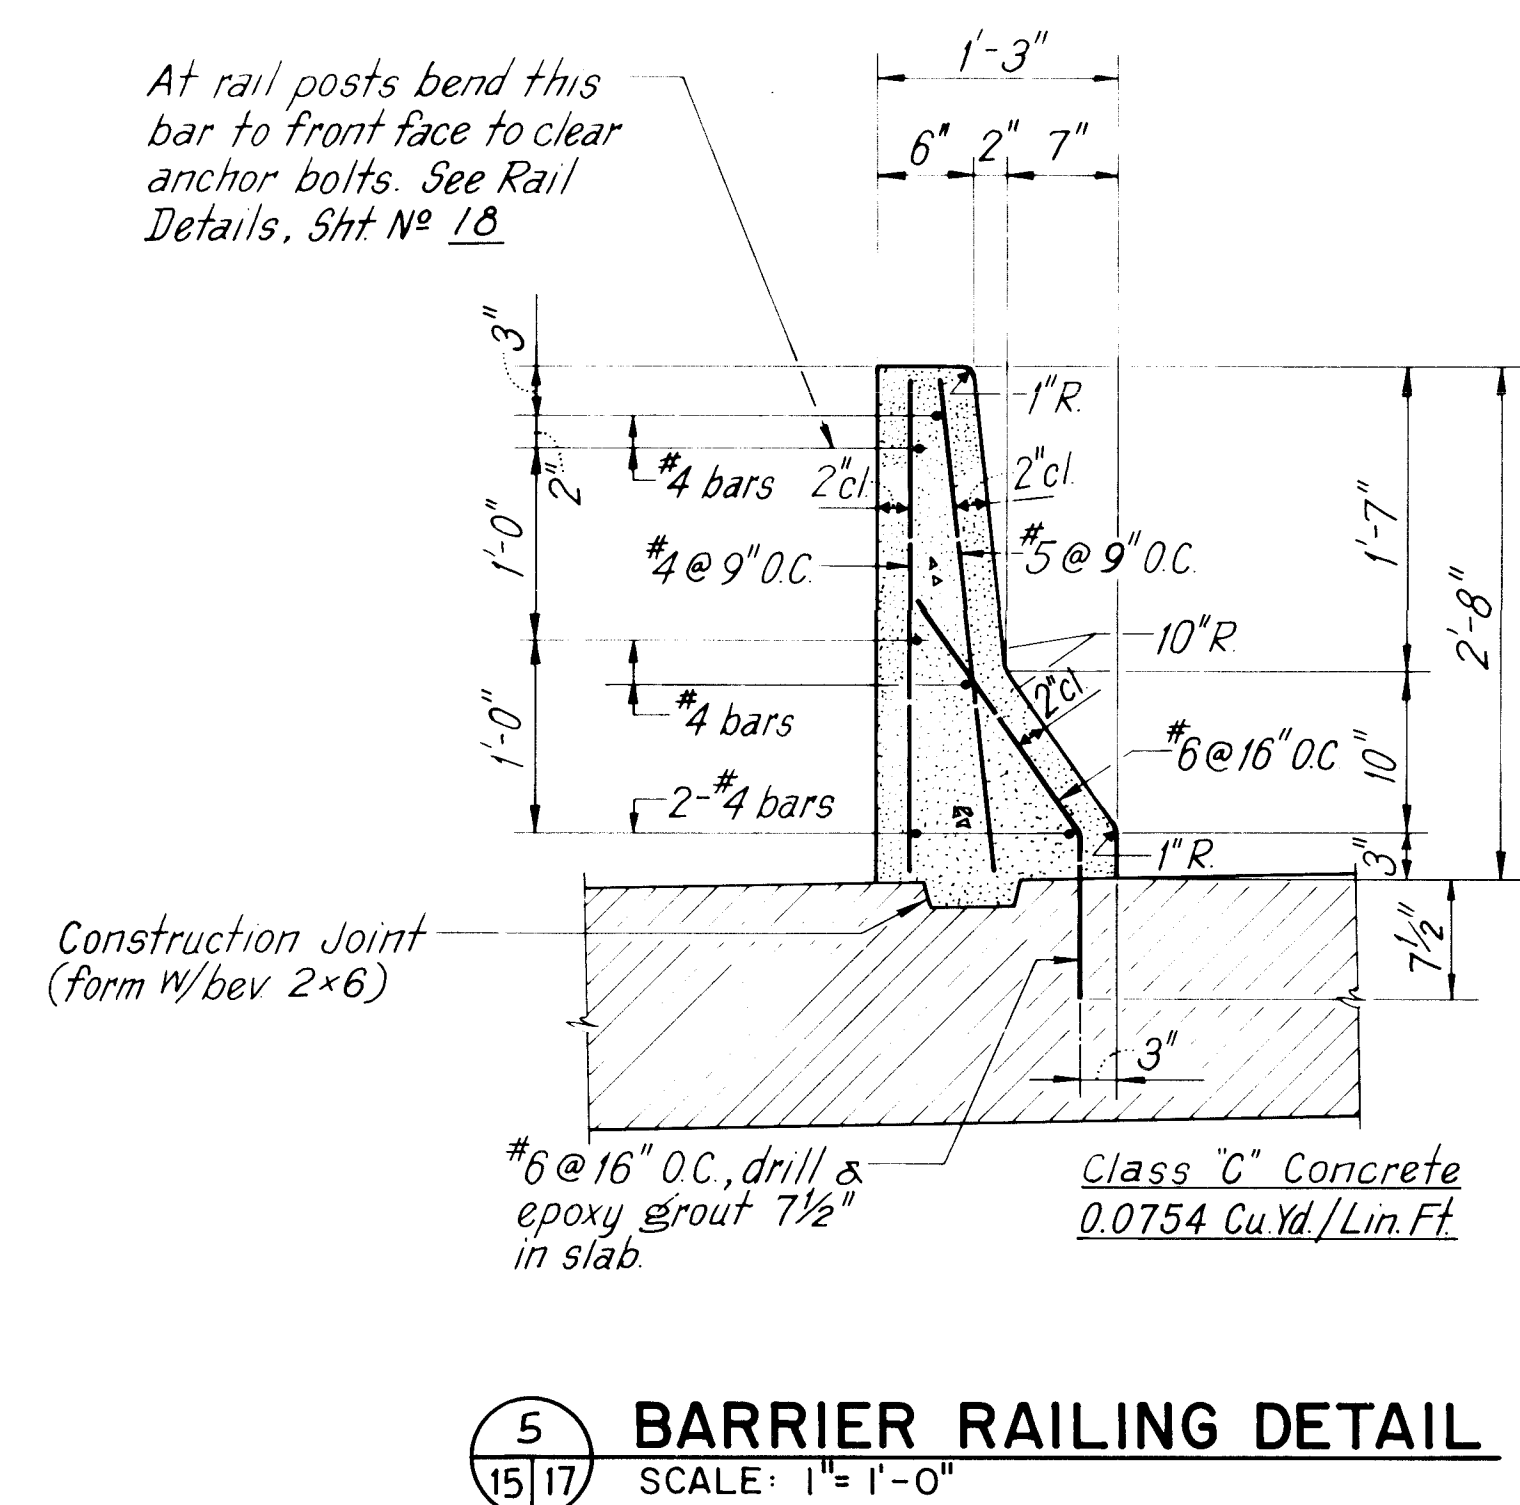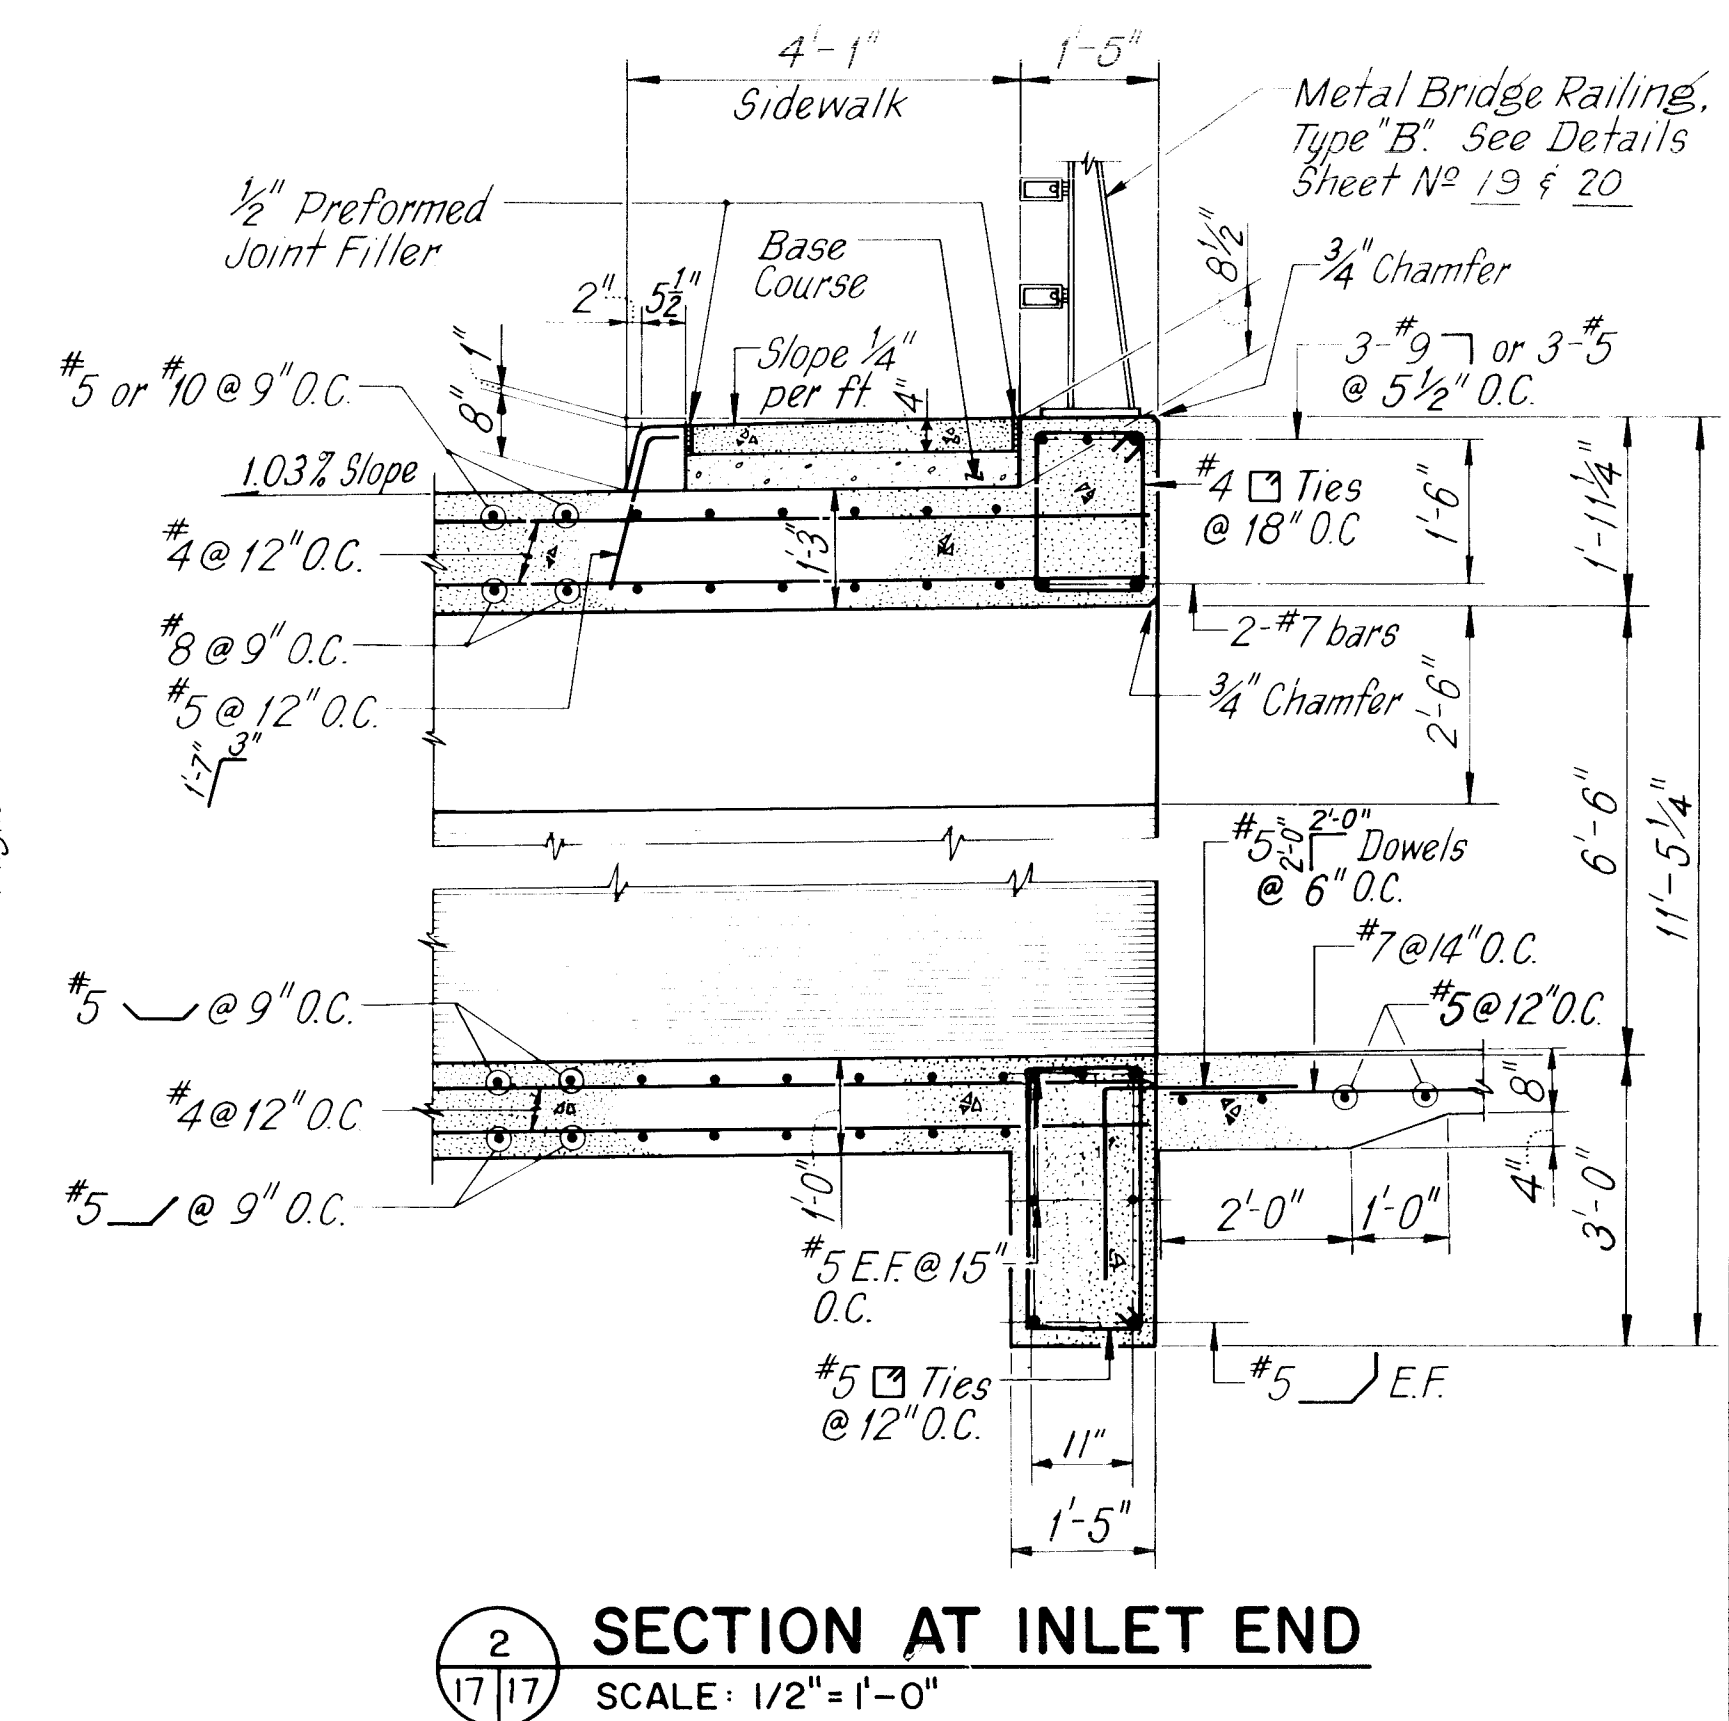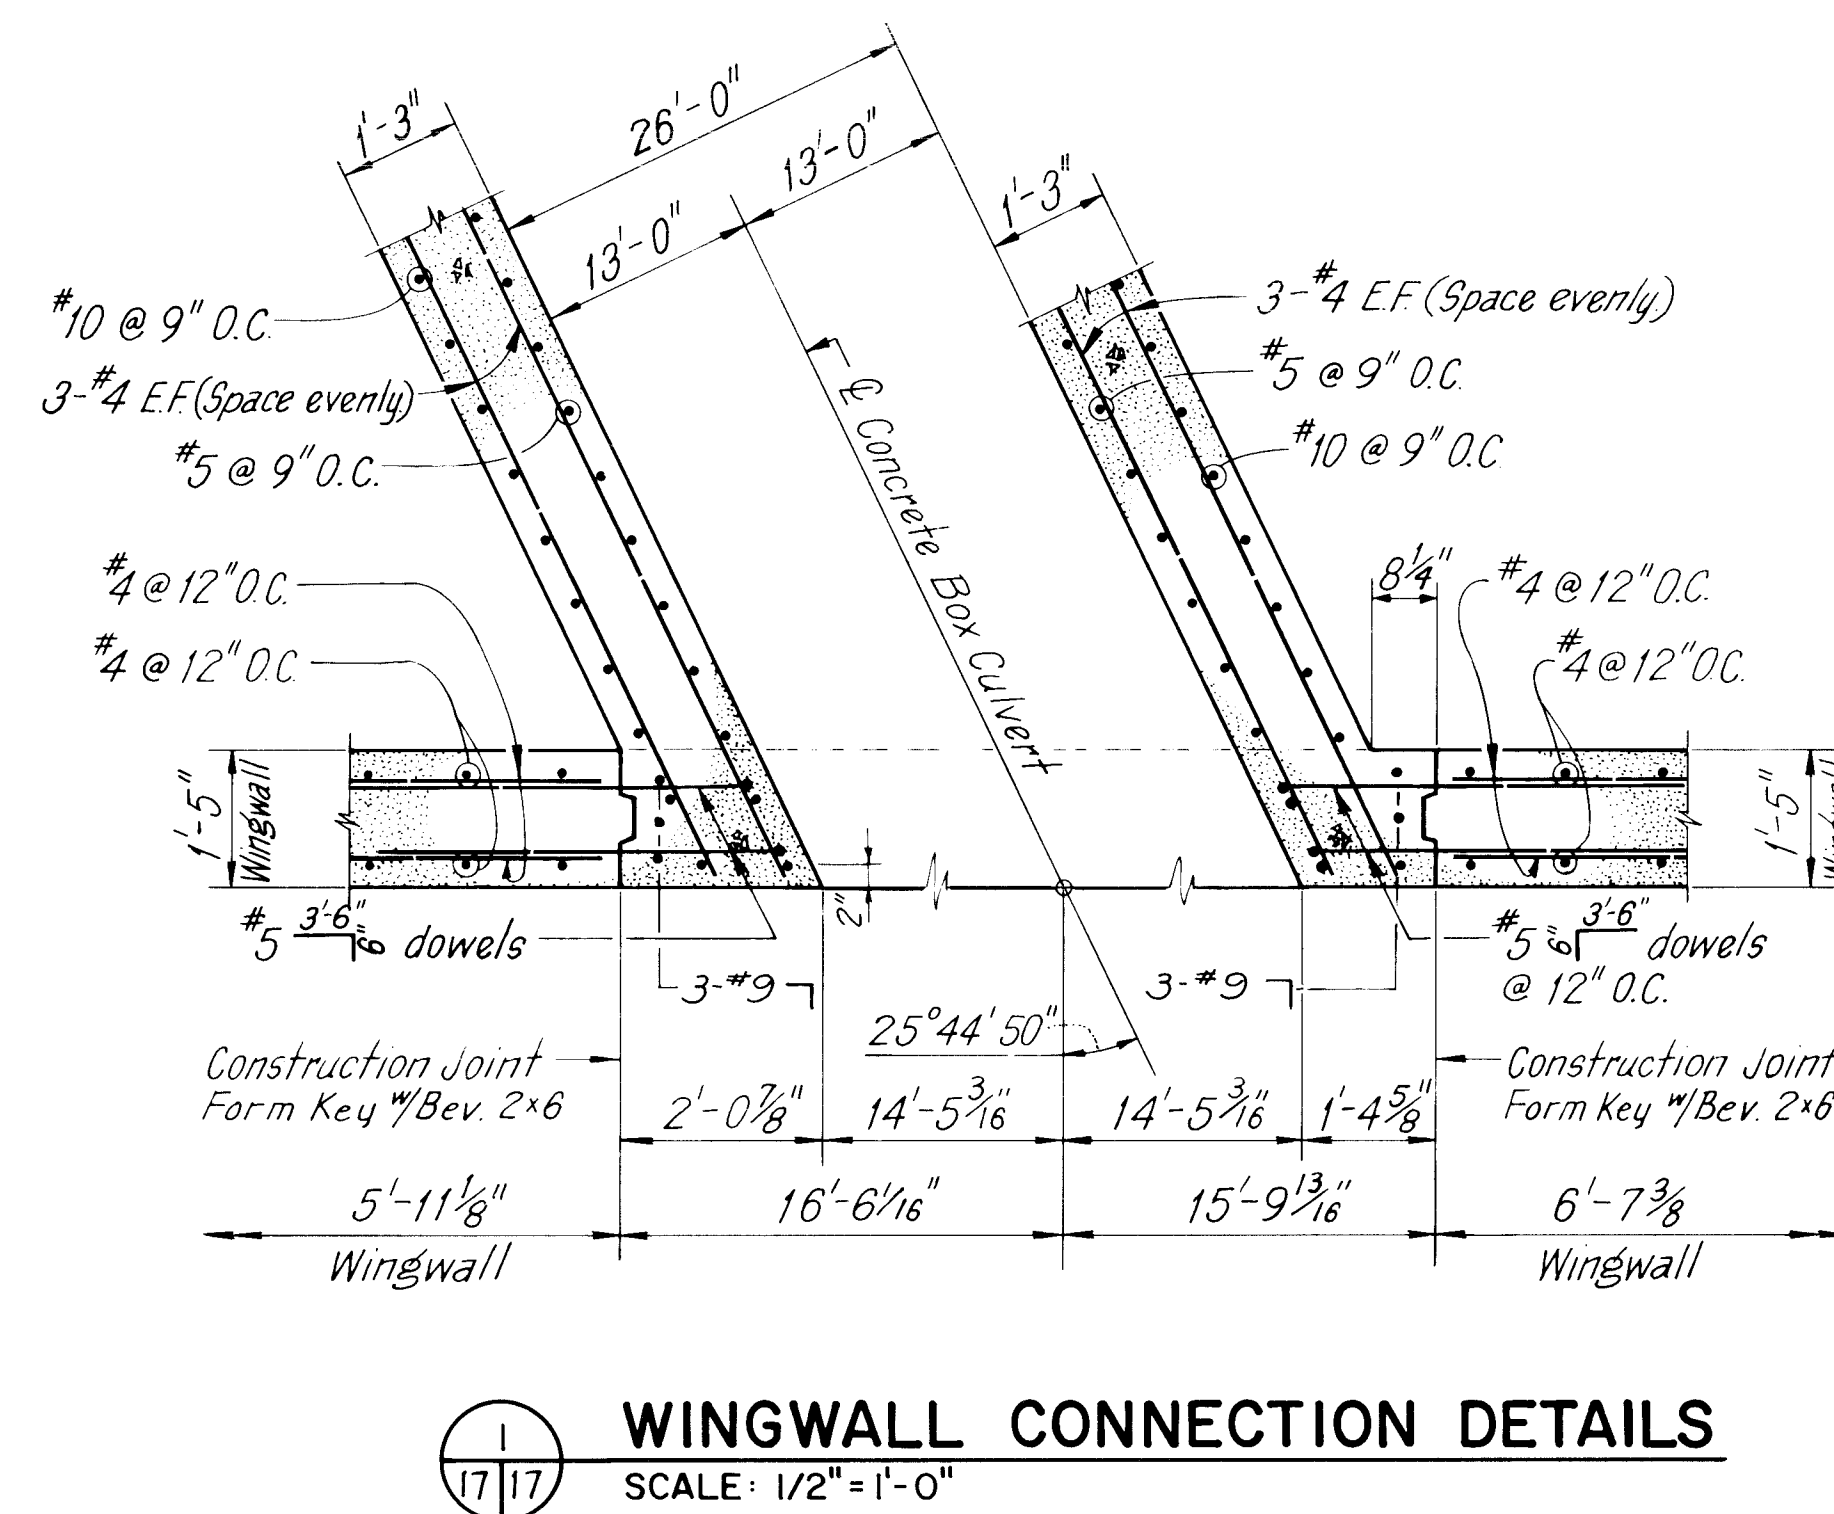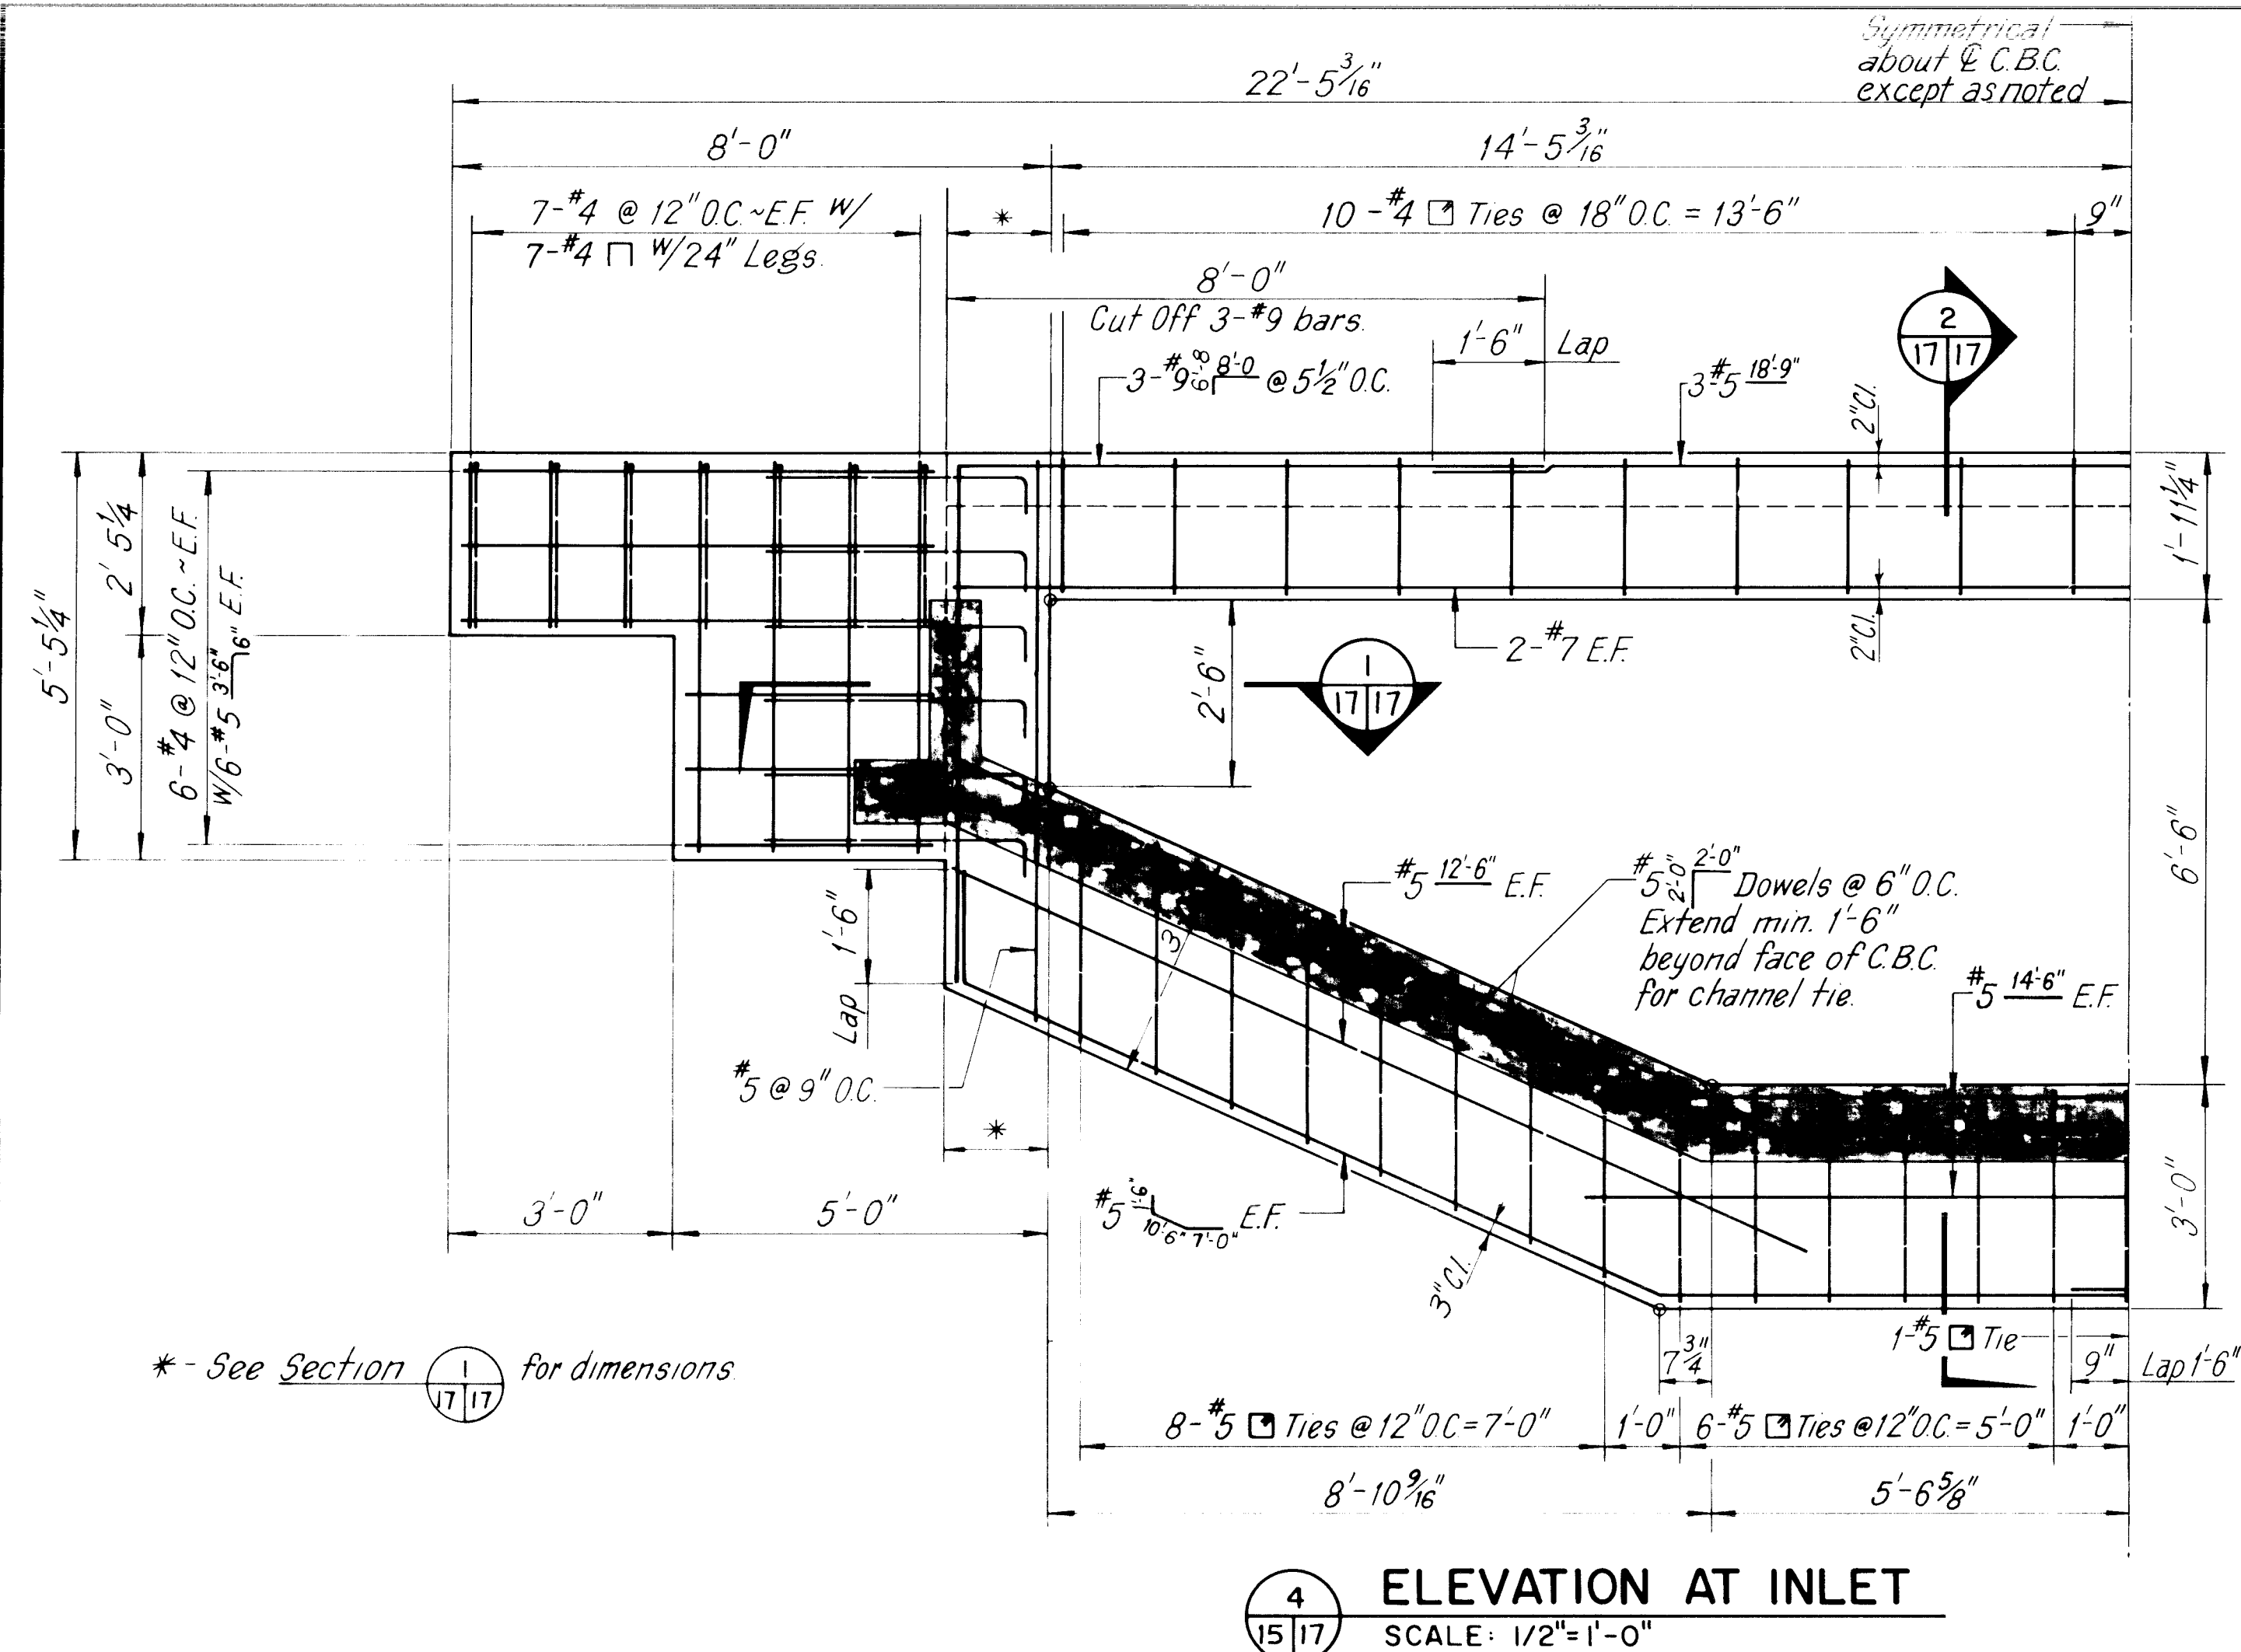

RECORD DRAWING

Date JUL 10 1987

These drawings have been revised based on field data and every reasonable attempt has been made to depict construction as actually performed.



AMAFCA

WESTGATE DIVERSION CHANNELS


SNOW VISTA CHANNEL PHASE II

BENAVIDES ROAD C.B.C.

REINFORCEMENT DETAILS



GORDON HERKENHOFF & ASSOCIATES, INC.

ENGINEERS ARCHITECTS PLANNERS
ALBUQUERQUE FARMINGTON SANTA FE

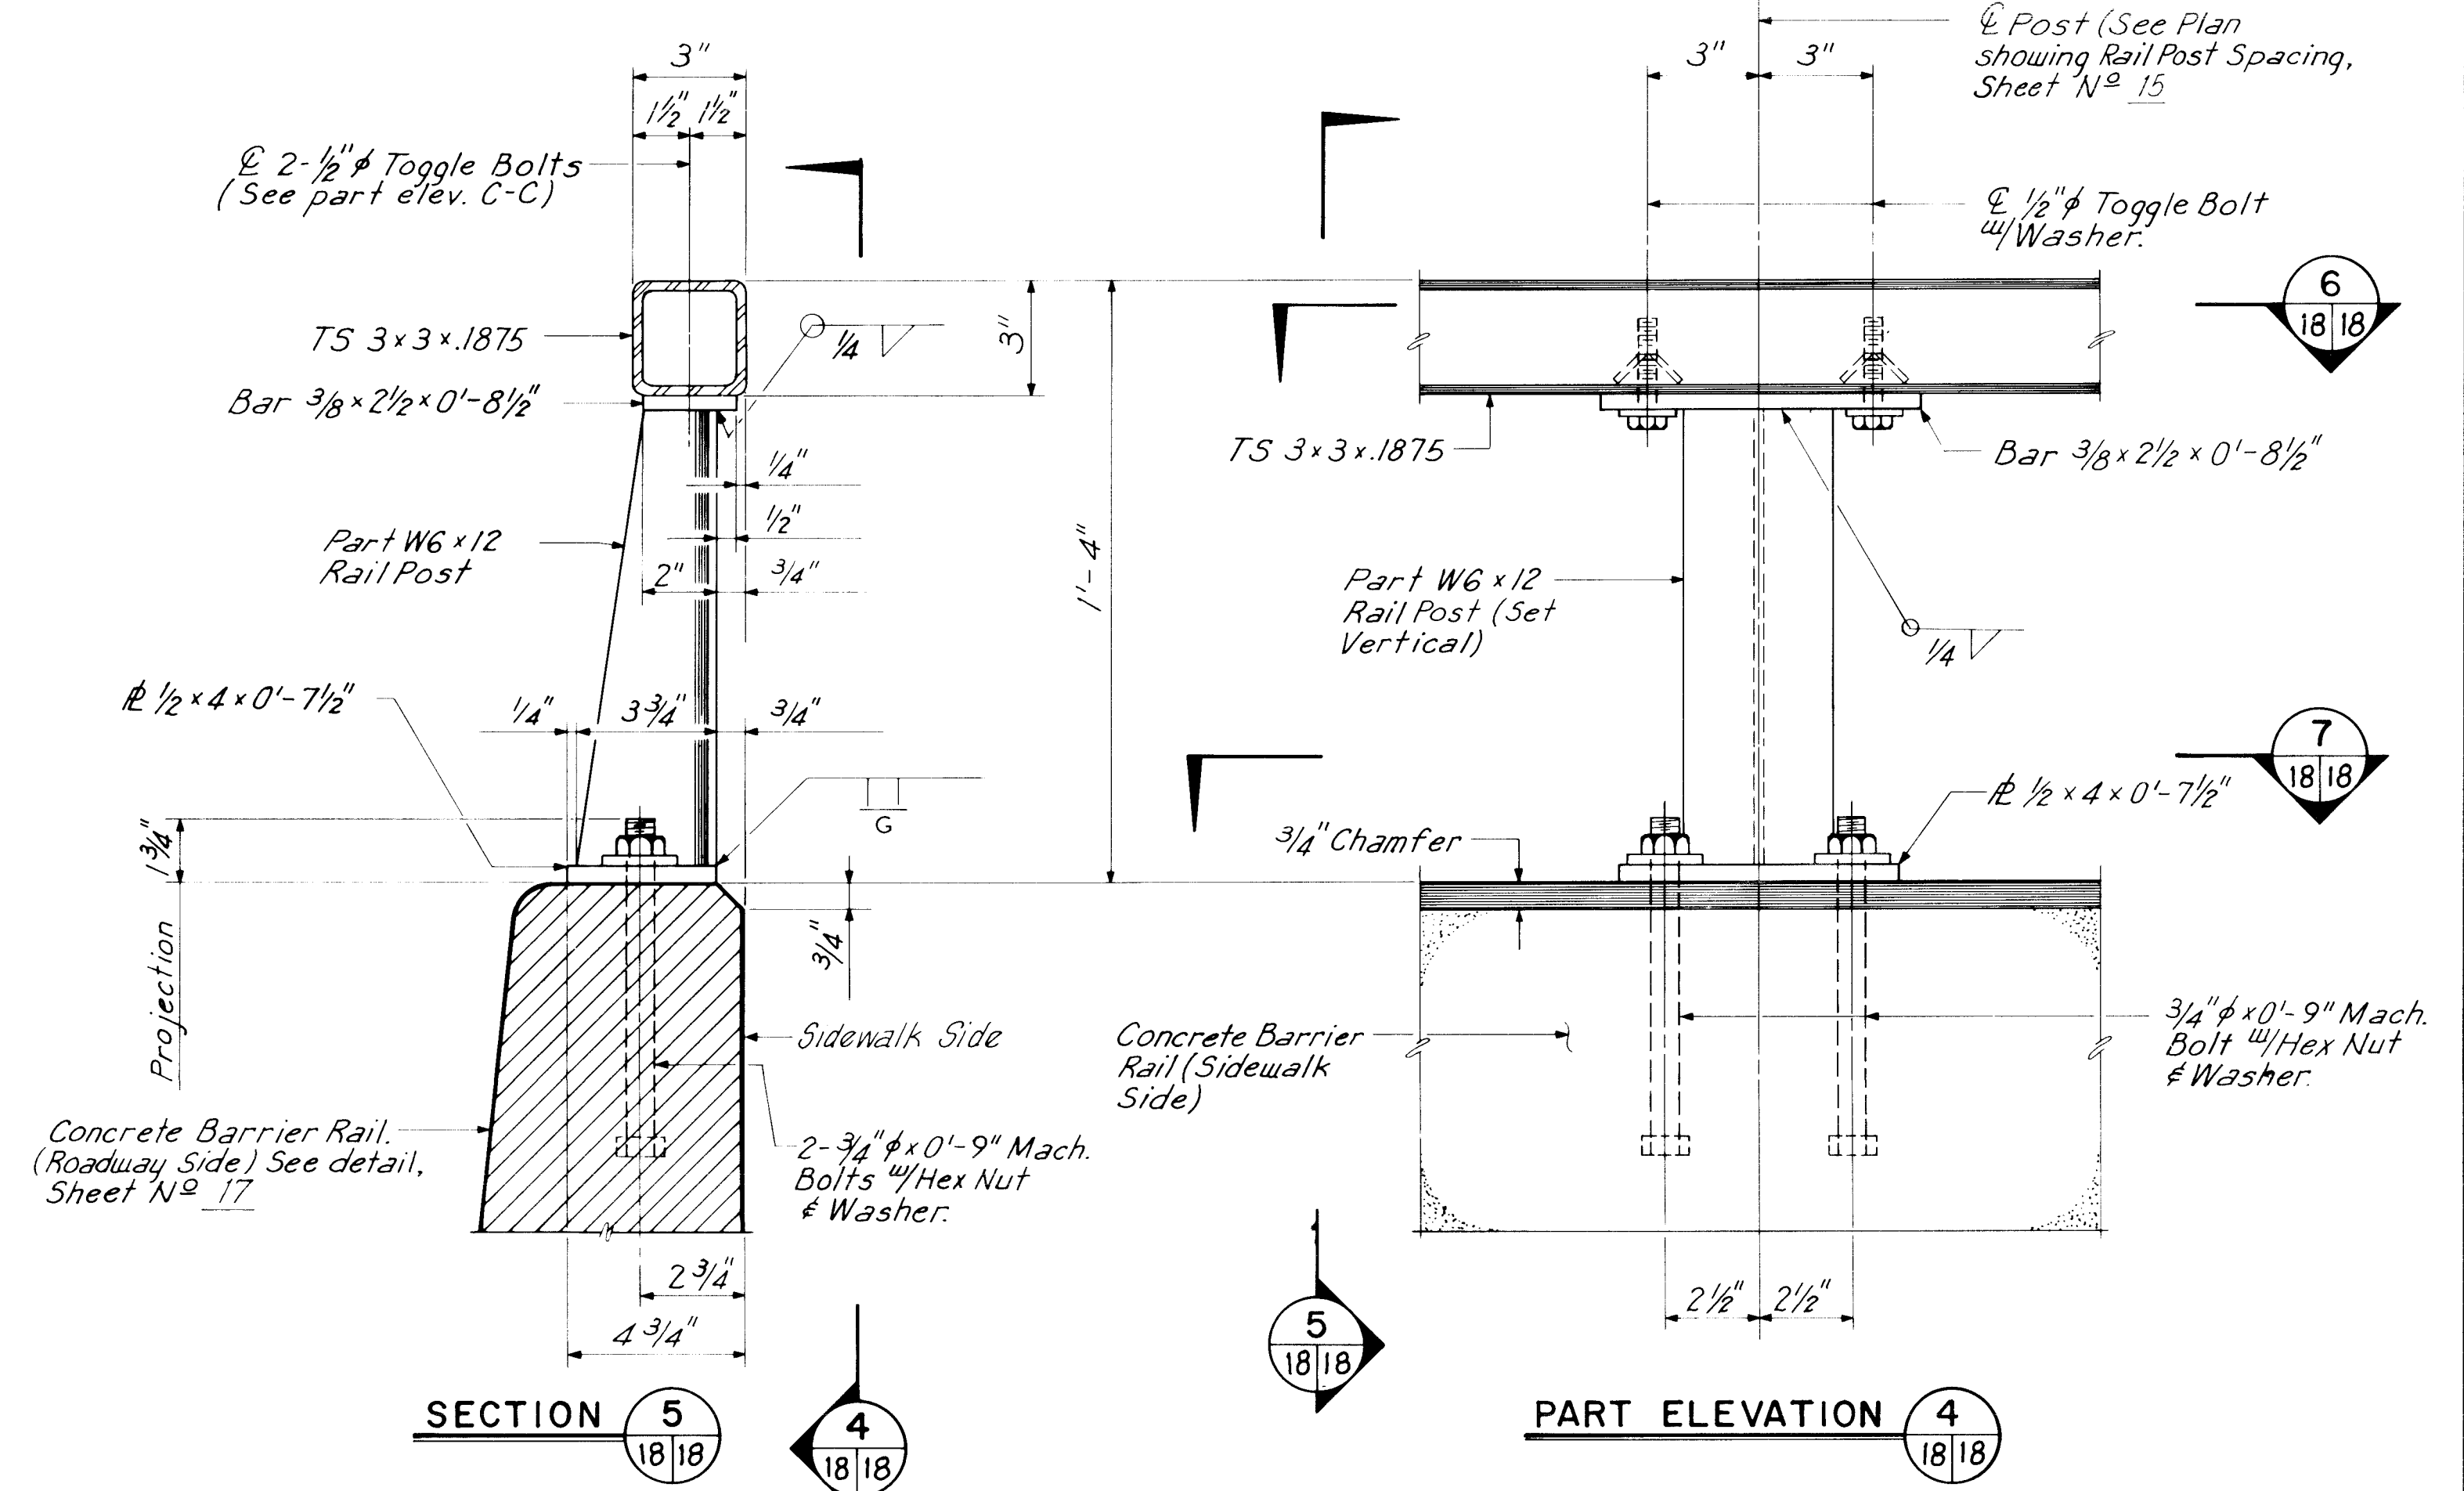

Scale : 1" = 1'-0"

Scale: 3" = 1'-0"

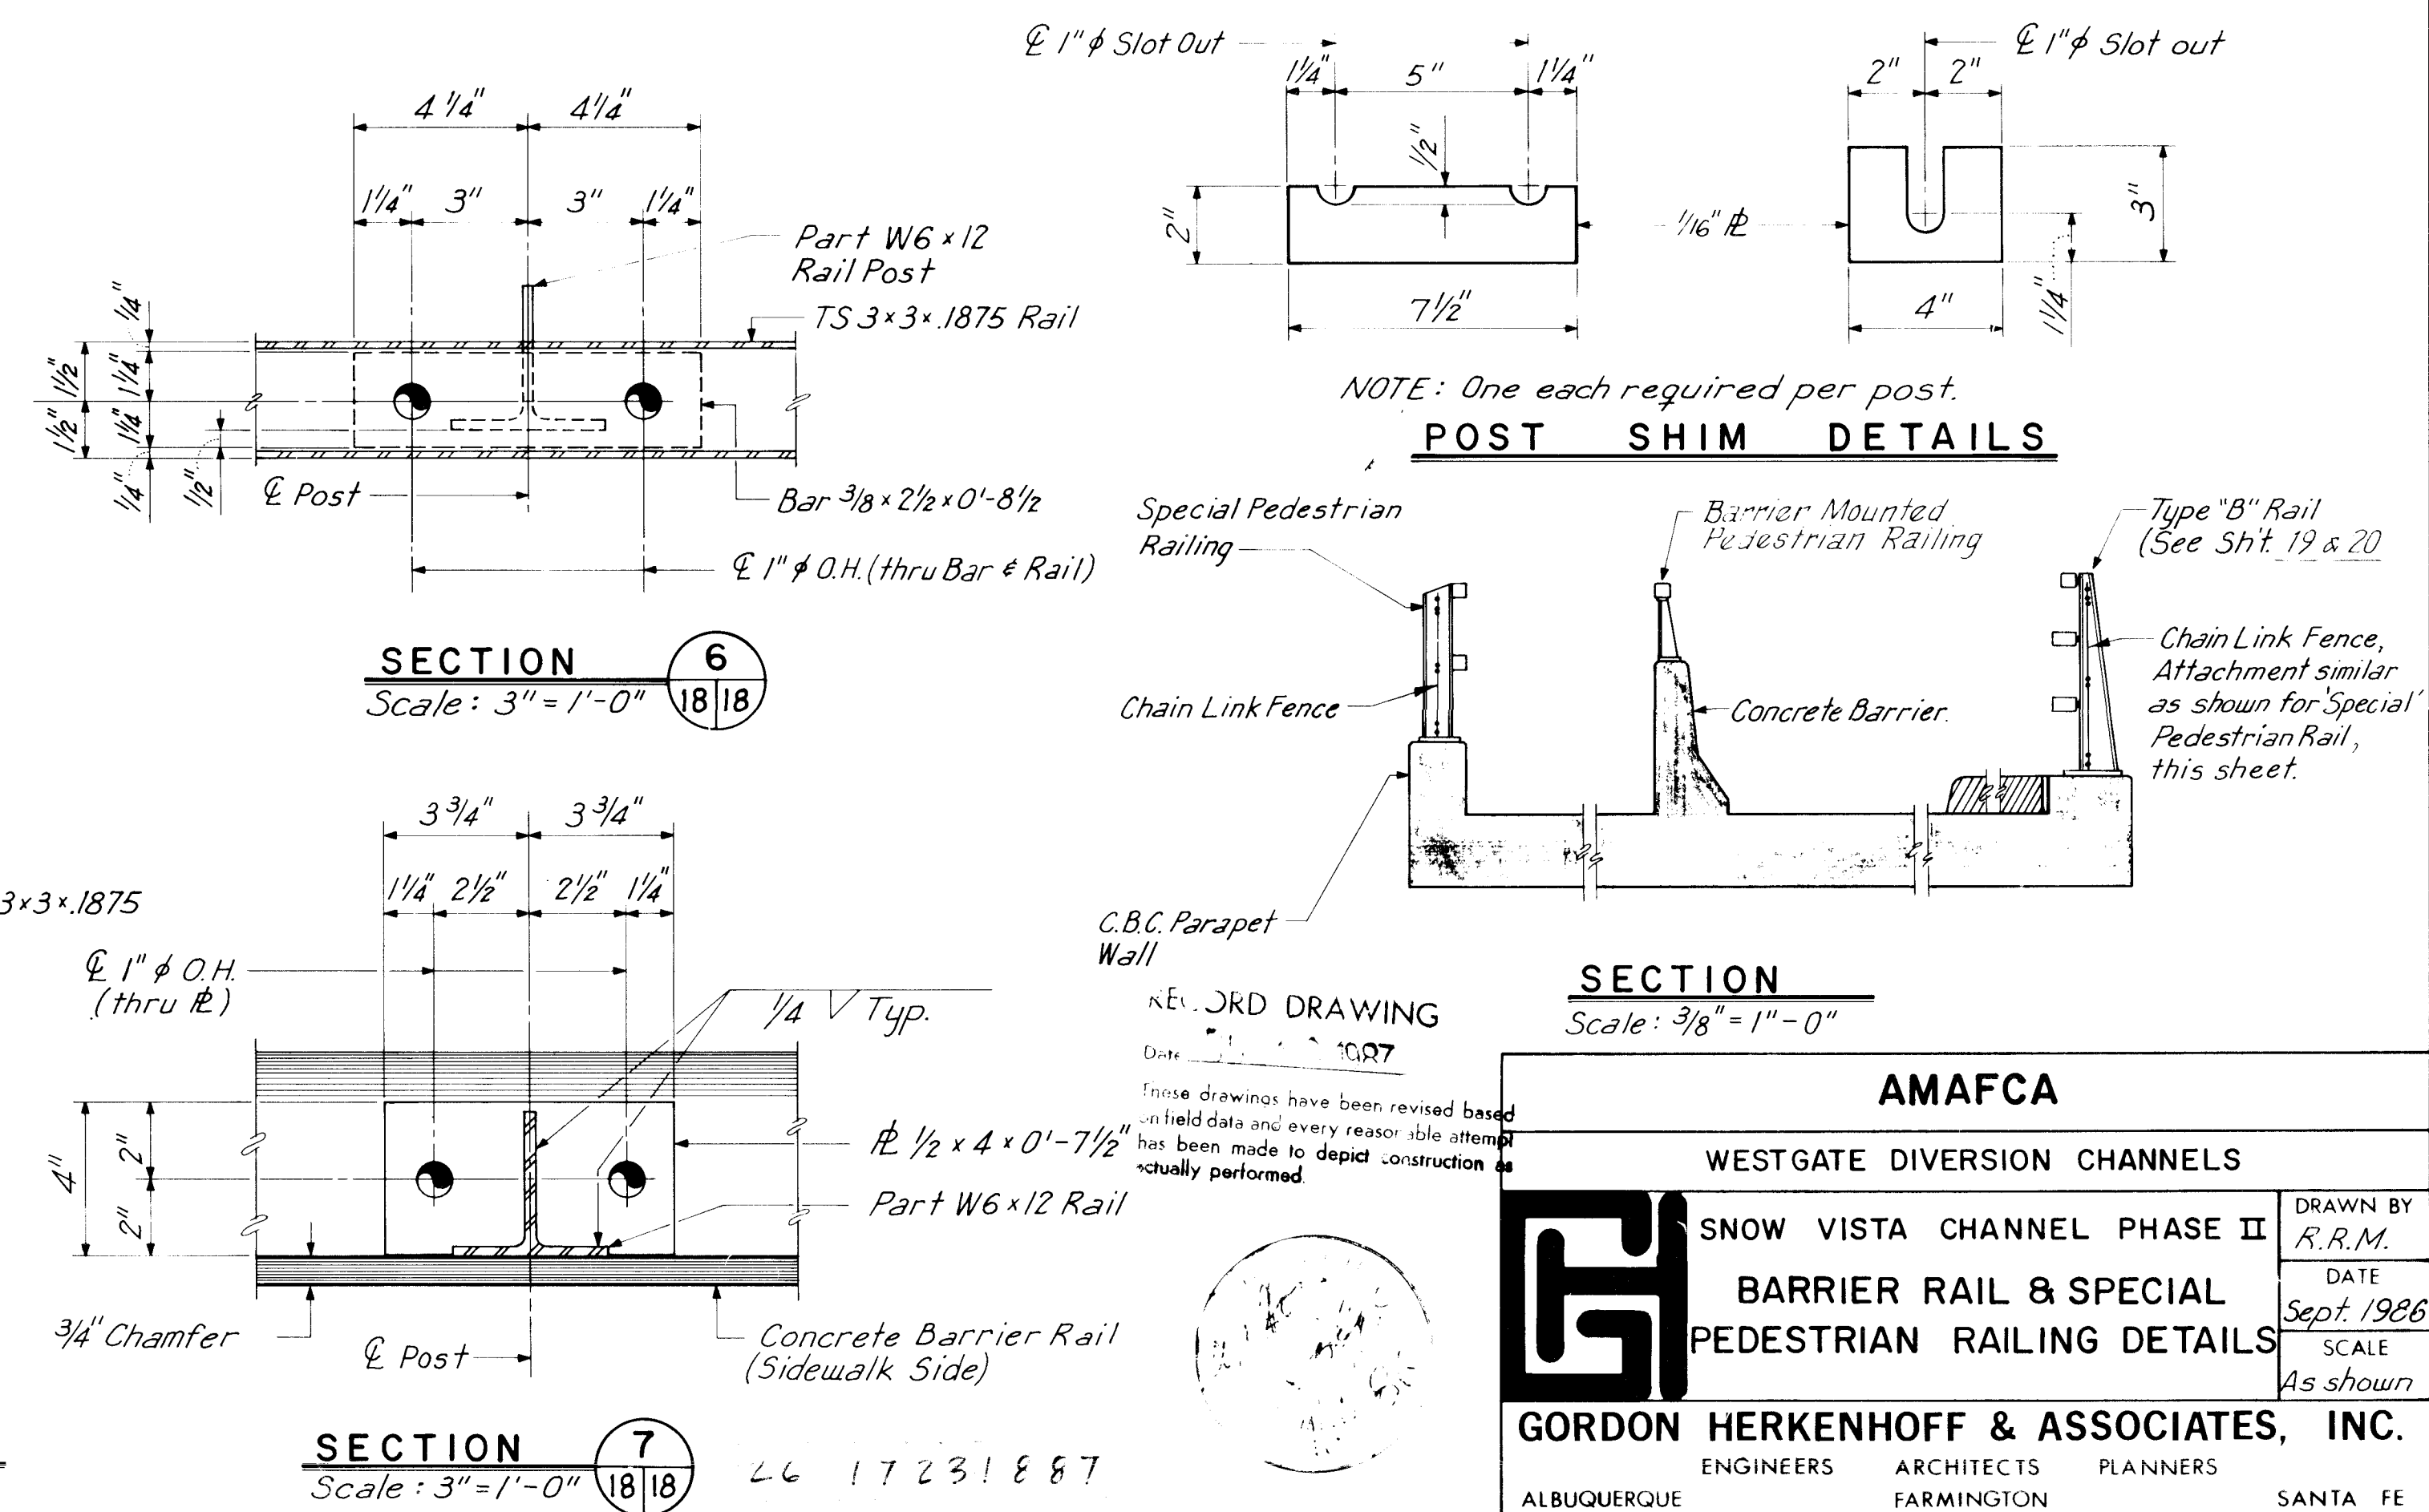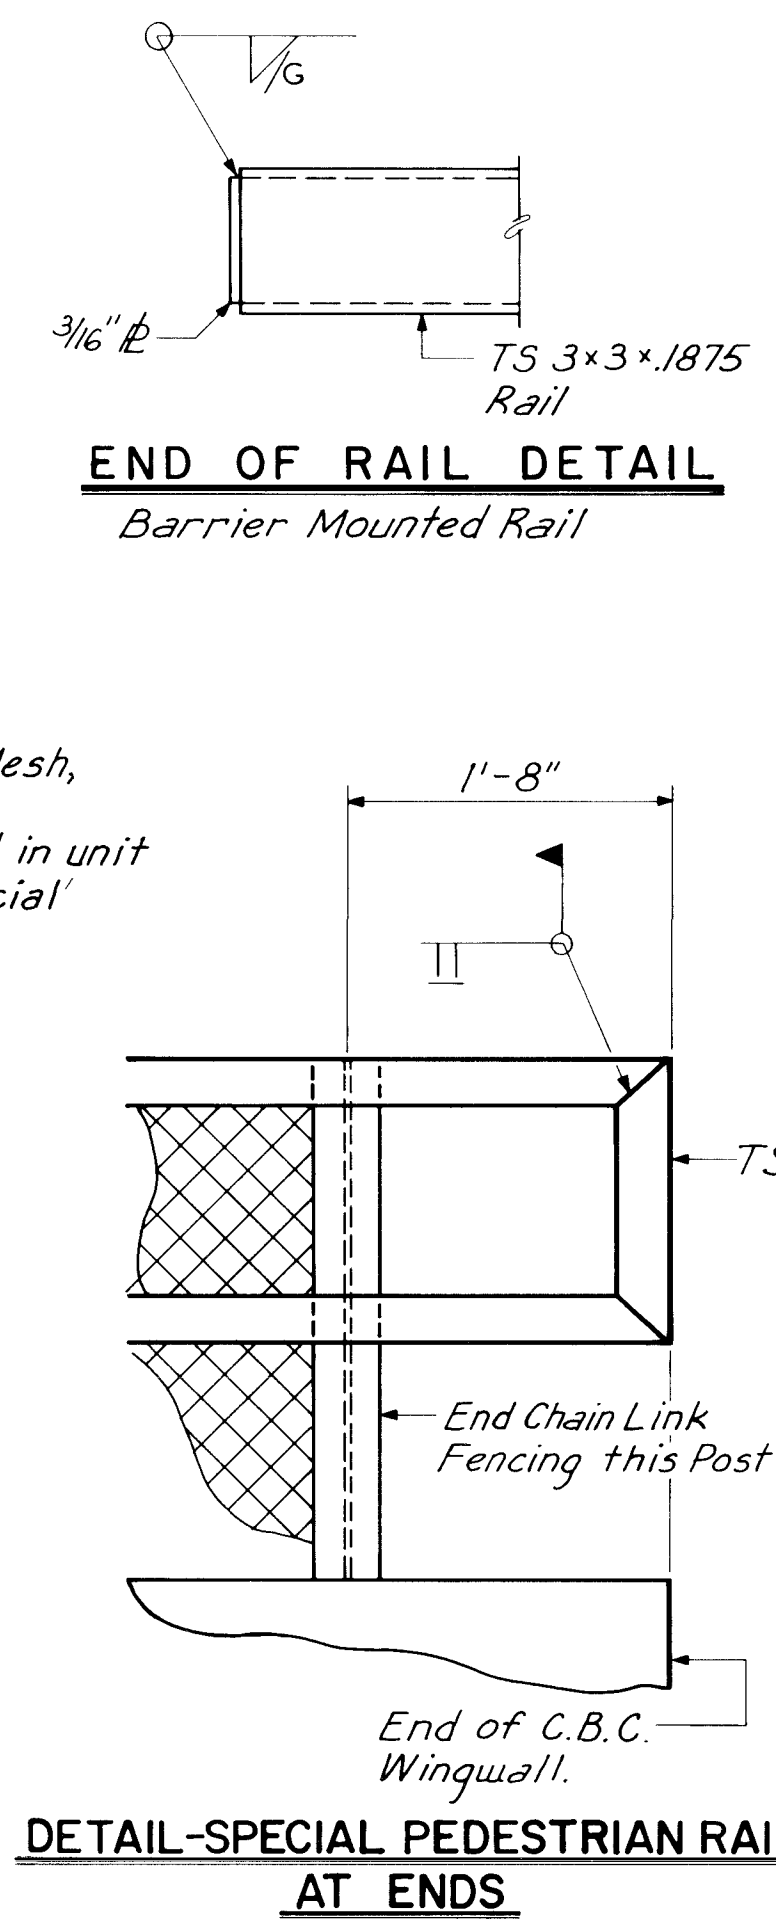


head end
approx. proj. $\frac{1}{16}$ " thread


tackweld nut
 $\frac{7}{8}$ " HS rod conforming to A.I.S.I. C-1144
or C-1045 w/2 HH nuts & 2
washers

ALTERNATE POST ANCHOR BOLT DETAIL (TYPE A & B RAIL)

$\frac{7}{8}$ " HS. bolts w/2 washers each,
galvanized. 1" x 2" horizontal
slotted hole in $\frac{5}{16}$ " R.

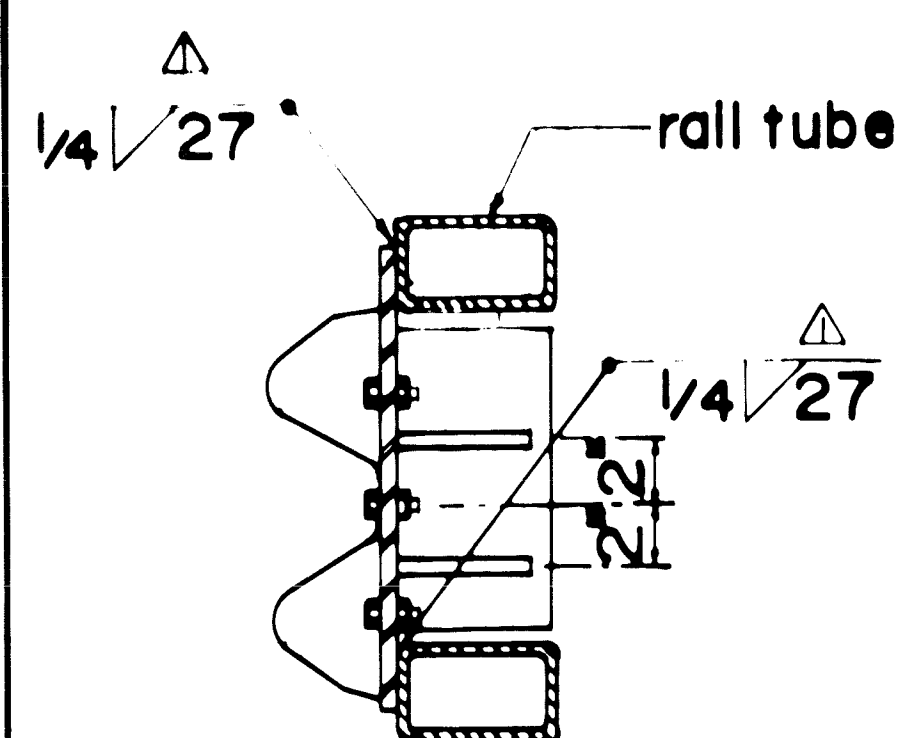


SECTION B-B

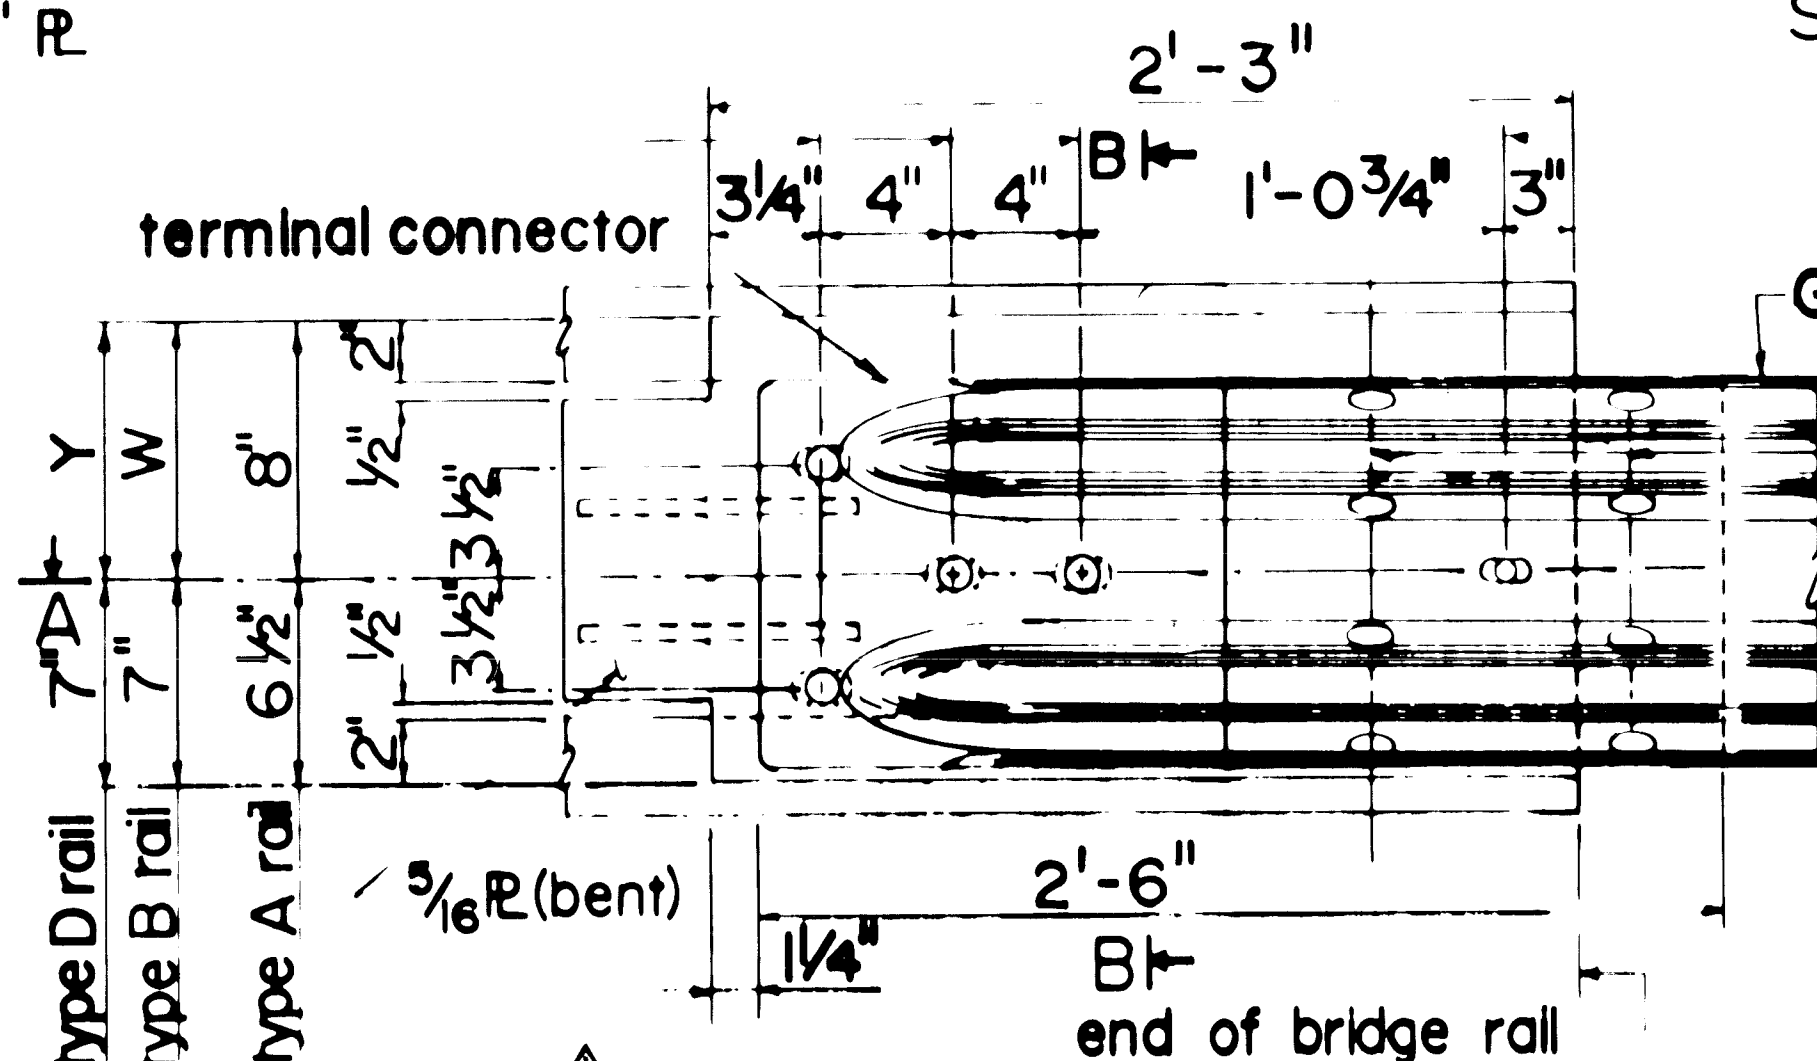

ELEVATION
 $Y = H_1 - H_2 + 1' - 3\frac{1}{2}"$
 $W = H_1 - H_2 + 1' - 2"$


See sheet 3 for dimensions H_1 & H_2

Note: Lap guard rail and terminal connector
so that the projecting edge faces away from
approaching traffic.

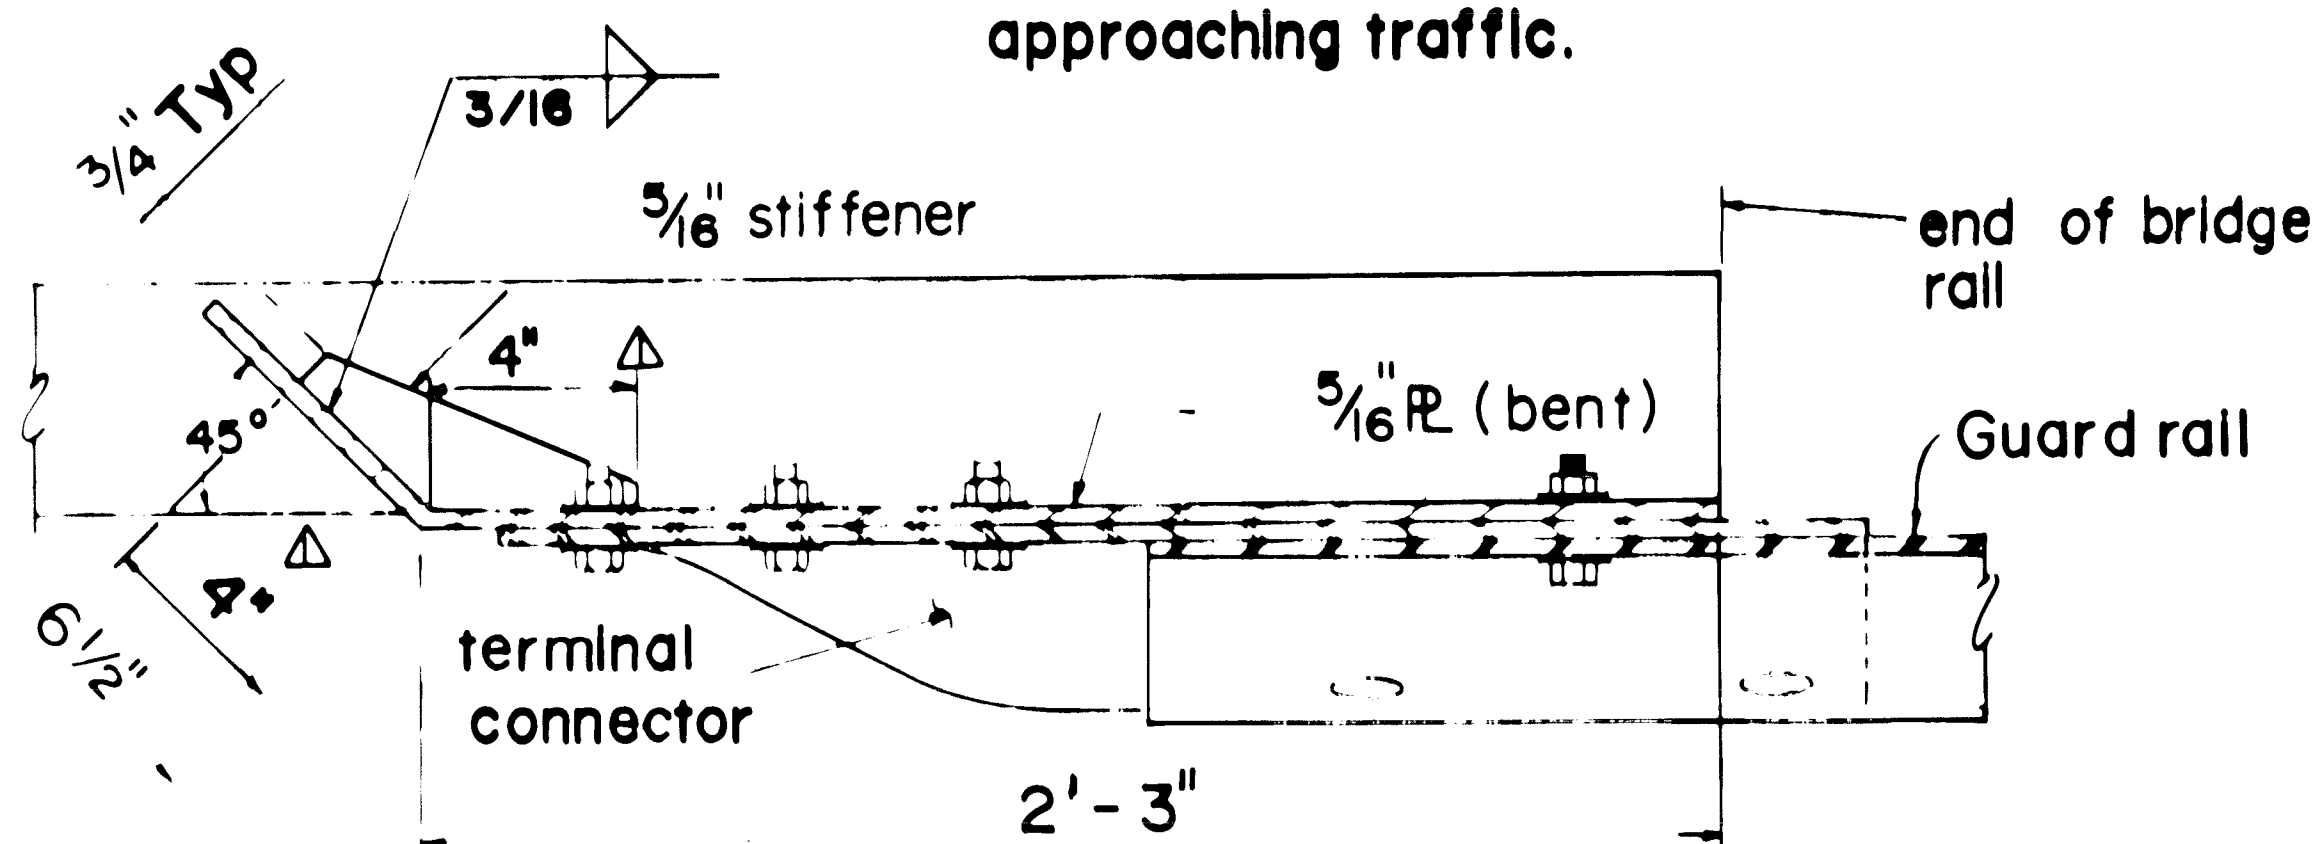

SECTION A-A

GUARD RAIL CONNECTION DETAILS

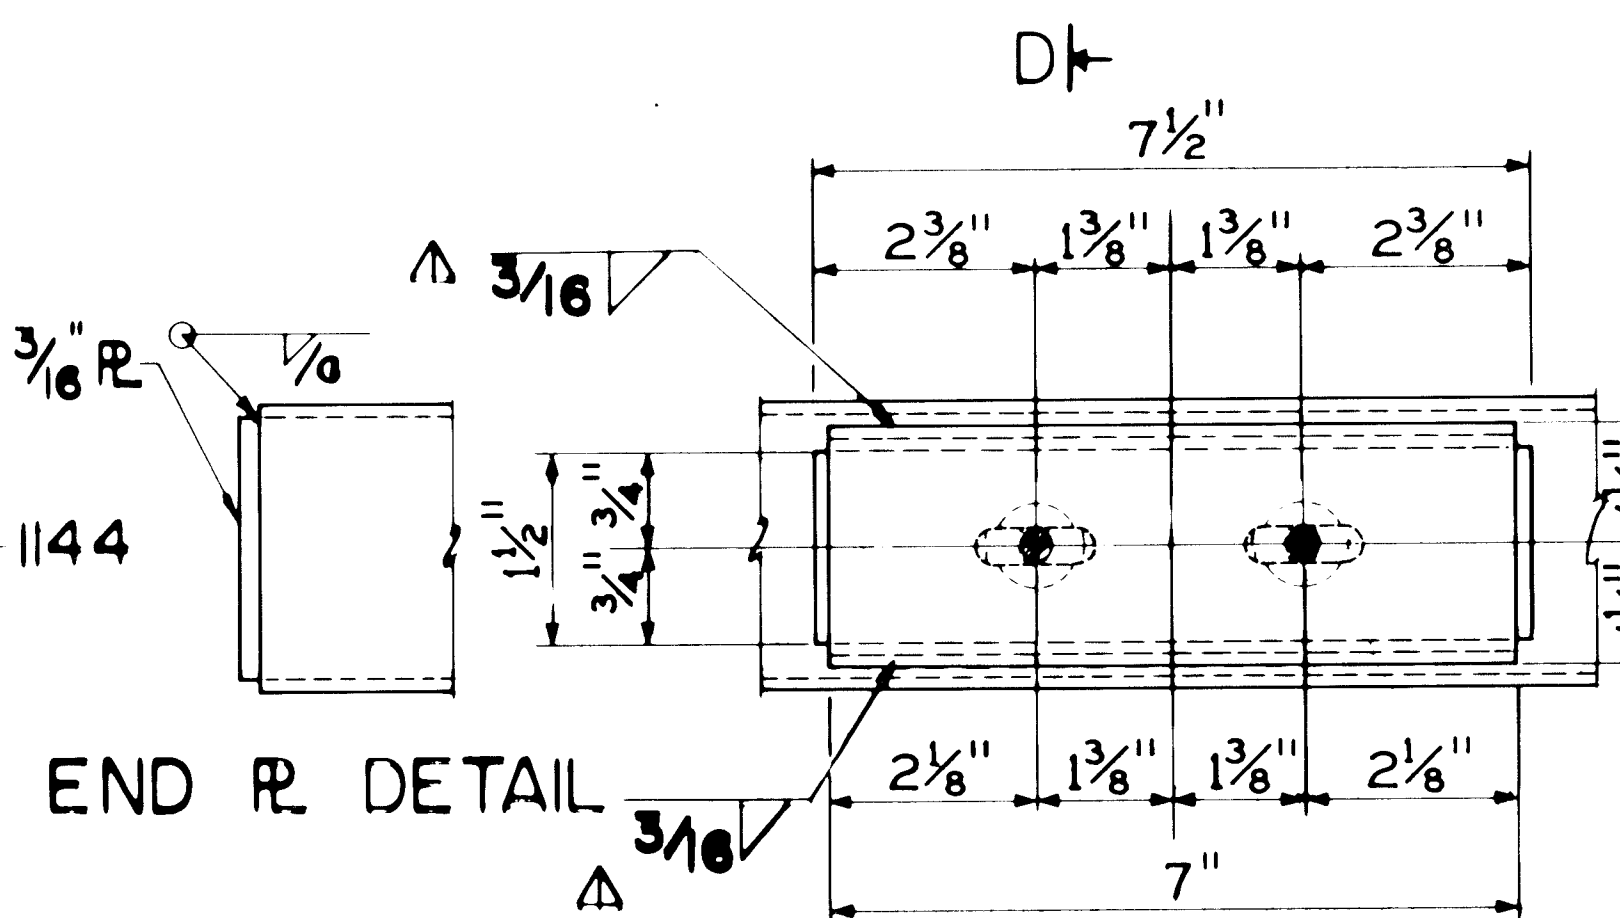


END RAIL DETAIL

SECTION E-E


$\frac{7}{8}$ " HS. Bolt Galvanized
 $\frac{15}{16}$ " O.H. in $\frac{5}{16}$ " R.

Guard rail
Standard guard
rail bolts

SPLICE MEMBER FOR TS 5 x 3 x .1875 RAIL

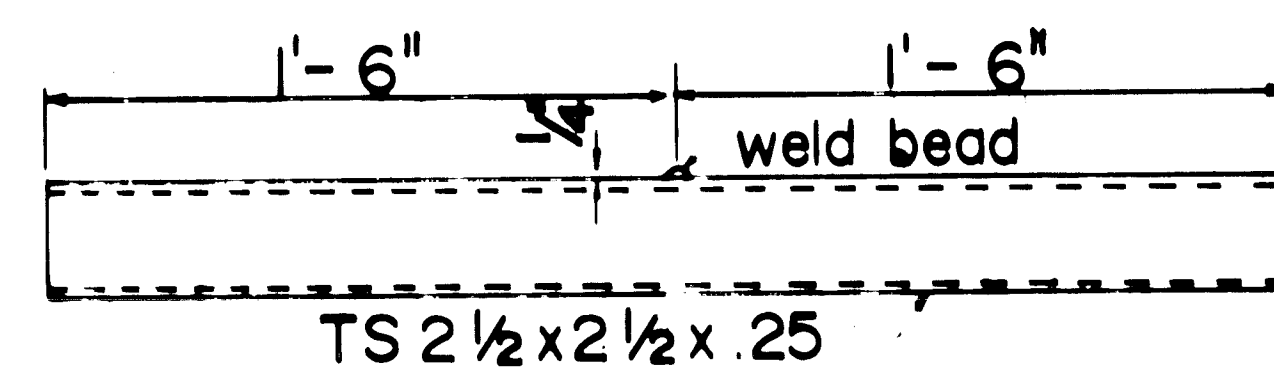

SPLICE MEMBER FOR TS 3 x 3 x .1875 RAIL

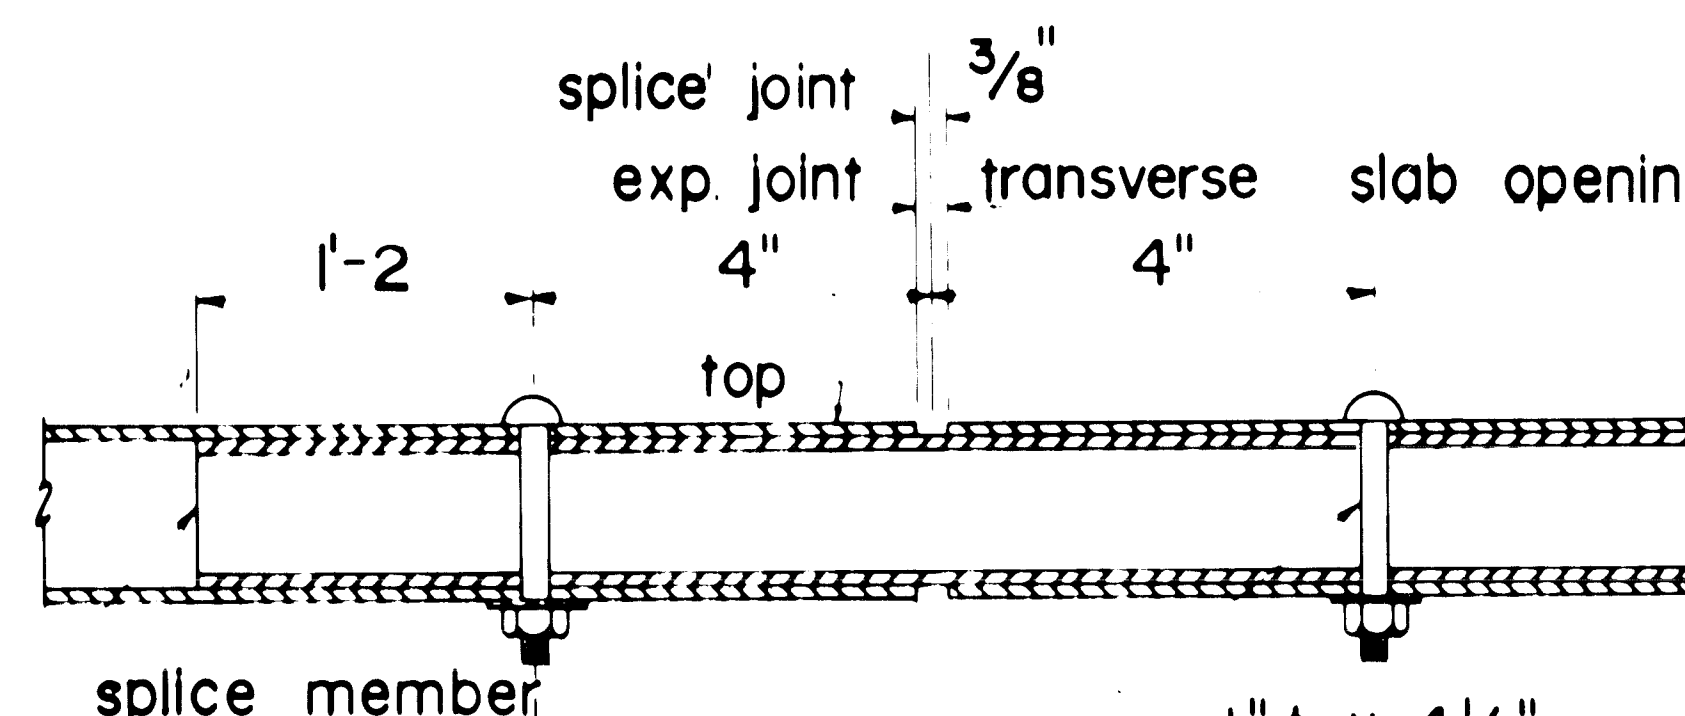


RAIL JOINT DETAIL

GENERAL NOTES


- Design in accordance with 1977 AASHTO Specifications.
- All rails to be parallel to grade unless otherwise shown.
- See structure details for post spacing and other details not shown.
- Details shown are for steel only. A steel or aluminum bridge railing of an alternate design may be substituted for the railing shown on these sheets provided the alternate design is approved by the Engineer before fabrication.
- Steel rail tubes shall conform to the requirements of ASTM designation A500 or A501. Post spacing shown on the plans is based on the use of TS5x3x.1875 conforming to the requirements of ASTM designation A500 grade B. If the contractor elects to use tubes of another grade, the post spacing shown on the plans will be revised by the Bridge Design Section.
- Metal bridge railing will be paid for at the unit price per foot.
- Terminal connector shall be AASHTO-ARBA STD HM-TF 13/RE-8, shall conform to AASHTO Specification M-180 be galvanized and of class B sheet thickness
- Back weld all threaded nuts or main bolt threads after tightening to prevent theft

STRENGTHENED RAIL-POST CONNECTION	2-6-80	E.R.D.
CHANGED SERIAL DESIGNATION	10-26-79	E.R.D.
CHANGED SPLICE JOINT DETAIL	1-26-79	J.D.G.
CHANGED SHEET NUMBER	6-16-78	J.A.H.
ADDED DIMENSIONS	6-16-78	J.A.H.
GEN. NOTES, RAIL CONNECT, MINOR REV.	5-25-77	J.A.H.
IDENT. NO.	DESCRIPTION	DATE BY
REVISIONS (OR CHANGE NOTICES)		
NEW MEXICO STATE HIGHWAY DEPARTMENT		
METAL BRIDGE RAILING		
GENERAL NOTES & TYPICAL DETAILS		
DESIGNED BY G.P.	APPROVAL	3-26-78
DRAWN BY G.V.	RECOMMENDED	BRIDGE ENGINEER DATE
CHECKED BY H.G.	APPROVED	3-7-78
	ENGINEER/OF DESIGN	DATE
SERIAL BMR-001-06		

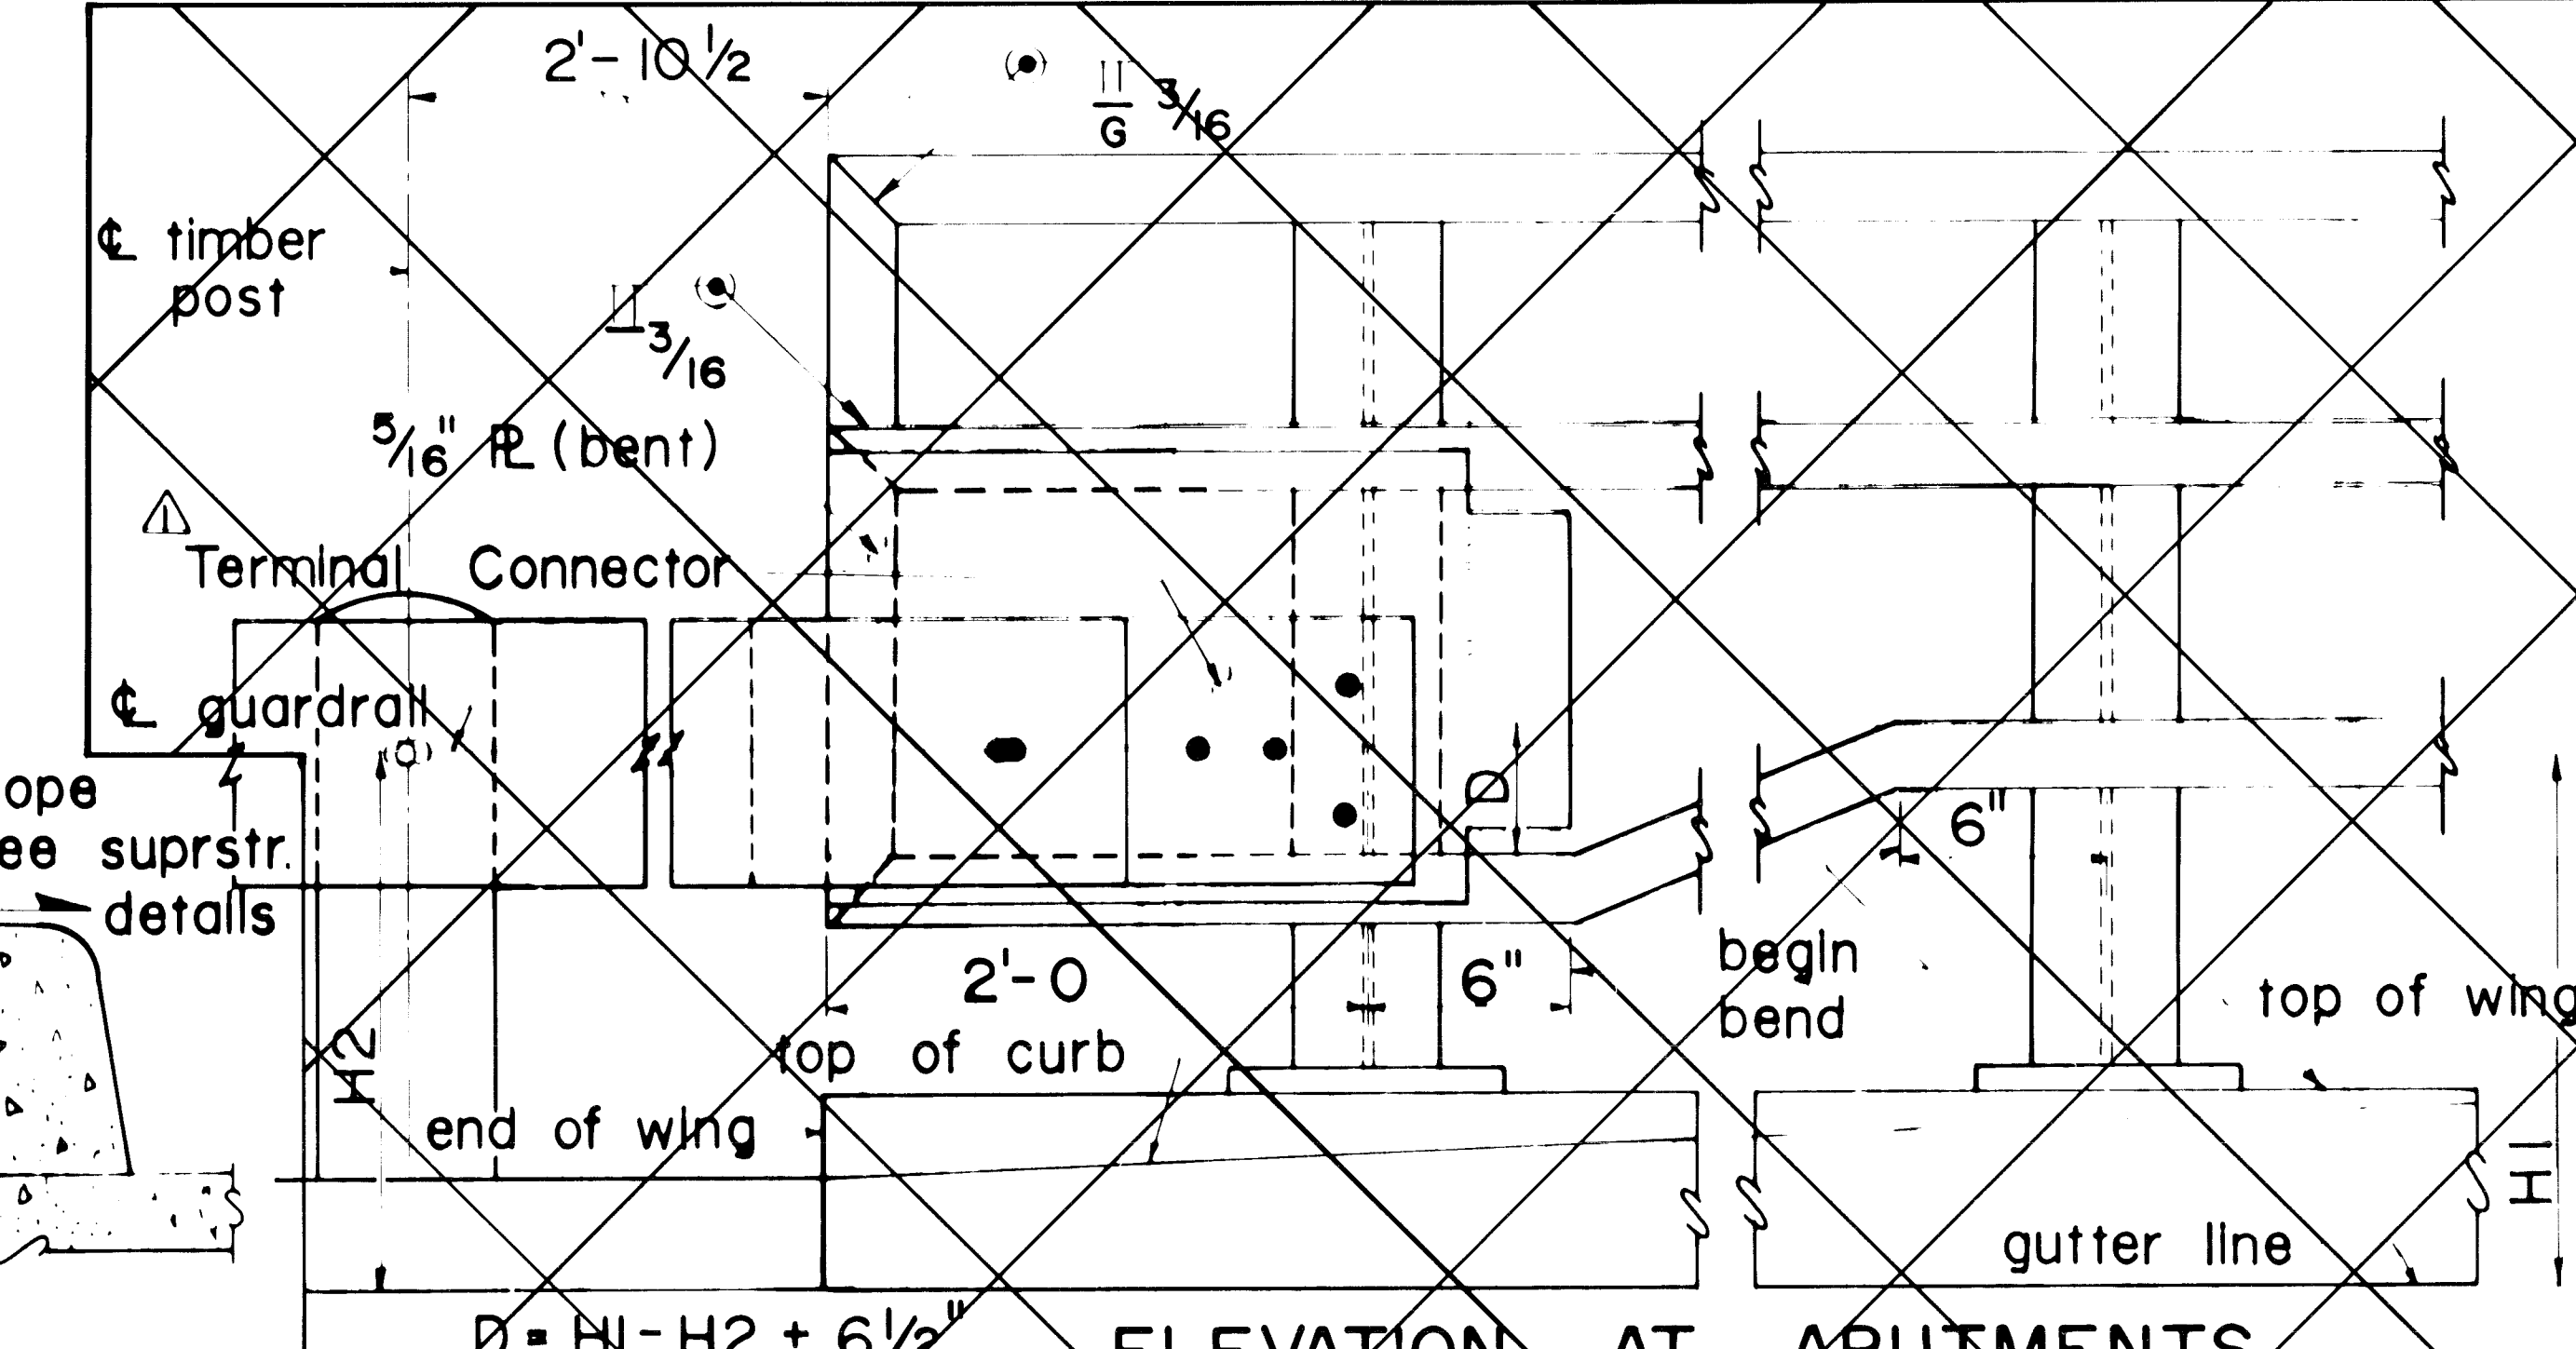

SECTION B-B


ELEVATION AT ABUTMENTS
(showing guardrail connection) For details not shown see Sh.#

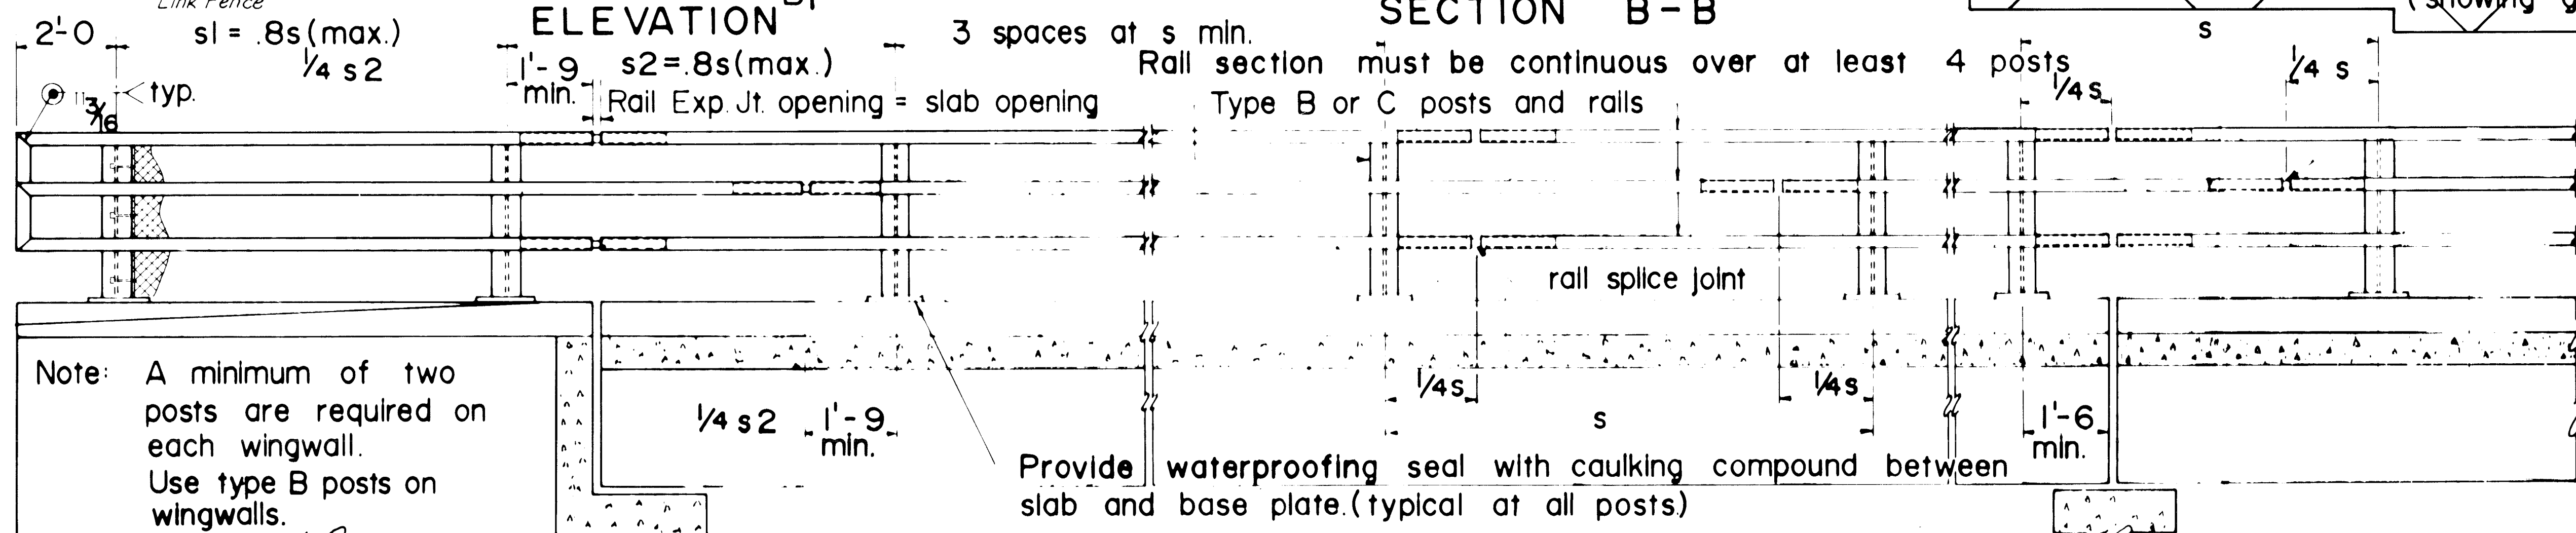

Roll expansion joint. Place near all piers in simple span bridges. Place at ends of continuous span units.

Serial BMR-001 must accompany this sheet. /5

ELEVATION OF RAILING

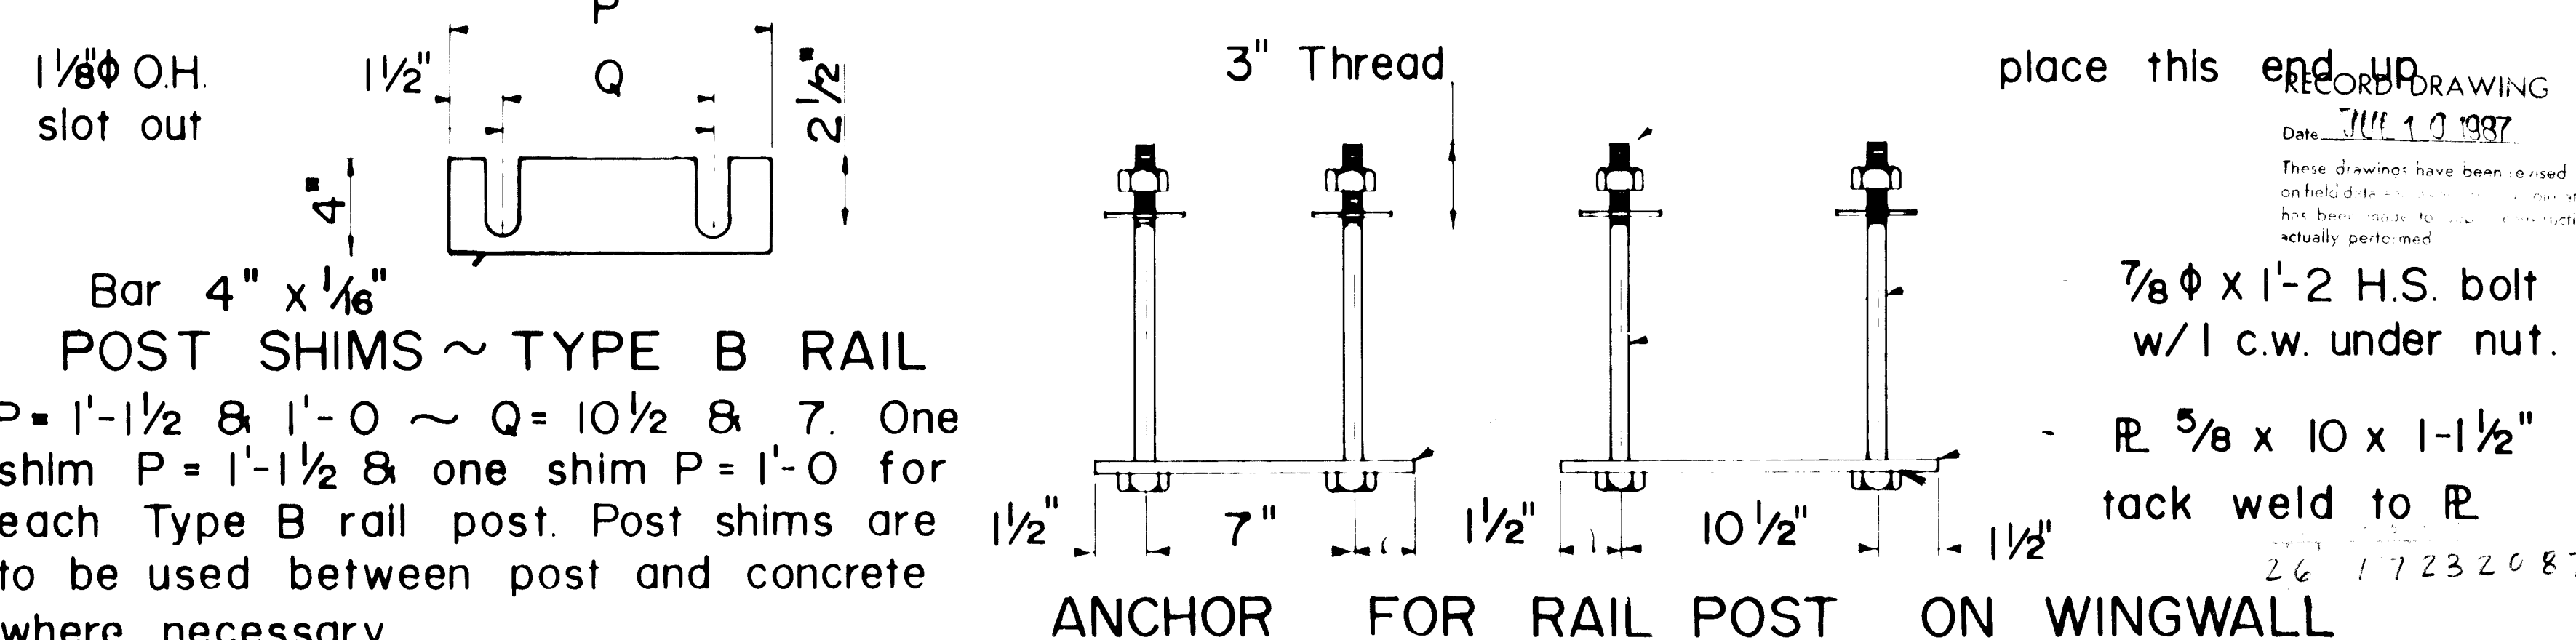

* Basis for spacing shown on plans.
See note 6.

Max. Δ S	Type of Steel	ASTM Desig.
7'-8	TS5 x 3 x .1875 A501	TS 3 x 3 x .155 A500 or A501
8'-4	A500 Grade A	A500 or A501
9'-10*	A500 Grade B	A500 or A501

Bar 4" x 1/16"

POST SHIMS ~ TYPE B RAIL

P = 1'-1/2 & 1'-0 ~ Q = 10 1/2 & 7. One shim P = 1'-1/2 & one shim P = 1'-0 for each Type B rail post. Post shims are to be used between post and concrete where necessary.

7/8 ϕ x 1'-2 H.S. bolt
w/ l.c.w. under nut.

R 5/8 x 10 x 1-1/2"
tack weld to R

ANCHOR FOR RAIL POST ON WINGWALL


8.	ADDED CROSS REFERENCE	24 HO	ER
9.	CHANGED SERIAL DESIGNATION	10-26-79	ER
4.	UPDATE POST SIZES	7 12 '78	JAH
3.	CHANGED SHEET NUMBER	6 16 '78	JAH
2.	Max. "S" & Minor Revisions	525-77	77
IDENT NO	DESCRIPTION	DATE	BY
RE-VISIONS (OR CHANGE NOTICES)			

NEW MEXICO
STATE HIGHWAY DEPARTMENT

METAL BRIDGE RAILING
TYPE B


DESIGNED BY: E. J. G.	APPROVAL
DRAWN BY: G. V.	RECOMMENDED BRIDGE ENGINEER DATE
CHECKED BY: E. J. G.	APPROVED <i>Ray E. G. G.</i> 3-9-16 ENGINEER OF DESIGN DATE
A SERIAL BMR-003-05	

55+00

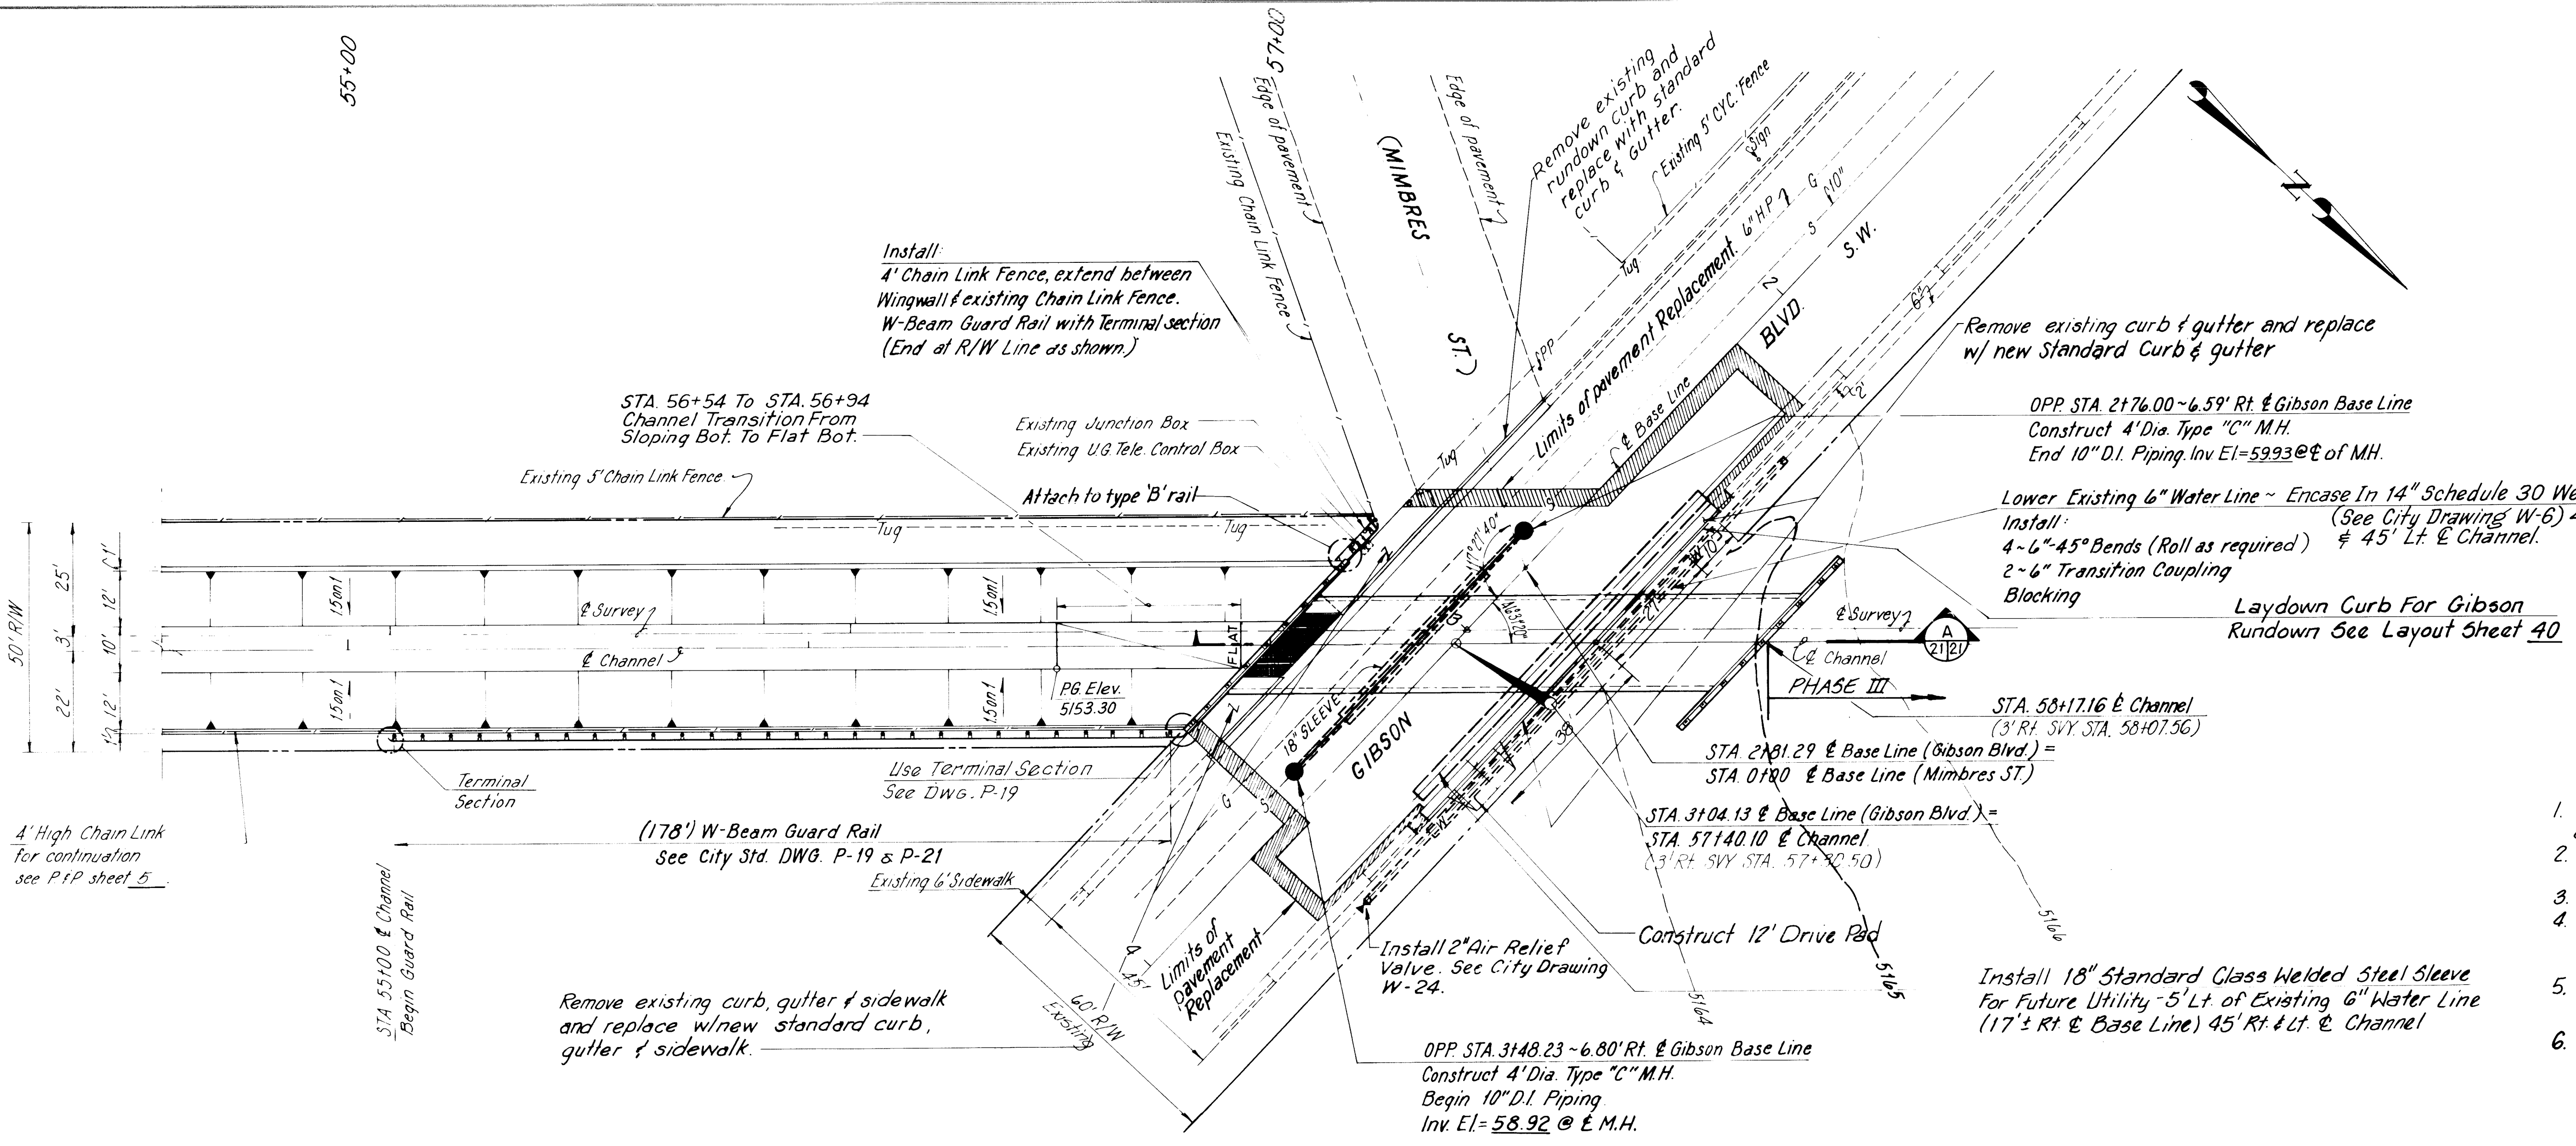

- General Notes**
1. All exposed edges shall have 3/4" chamfer unless otherwise shown.
 2. Concrete for box culvert shall be class 'A'.
 3. Finish shall conform to specifications.
 4. Contractor to field verify locations and depths of all utility lines prior to construction.
 5. Field verify size of sanitary sewer. Adjust sleeve size if required.
 6. Place stationary bollards 4' behind curb at all existing curb openings on north side of Gibson 500' either side of channel.

BOX CULVERT LAYOUT @ GIBSON CROSSING
Scale 1"=20'







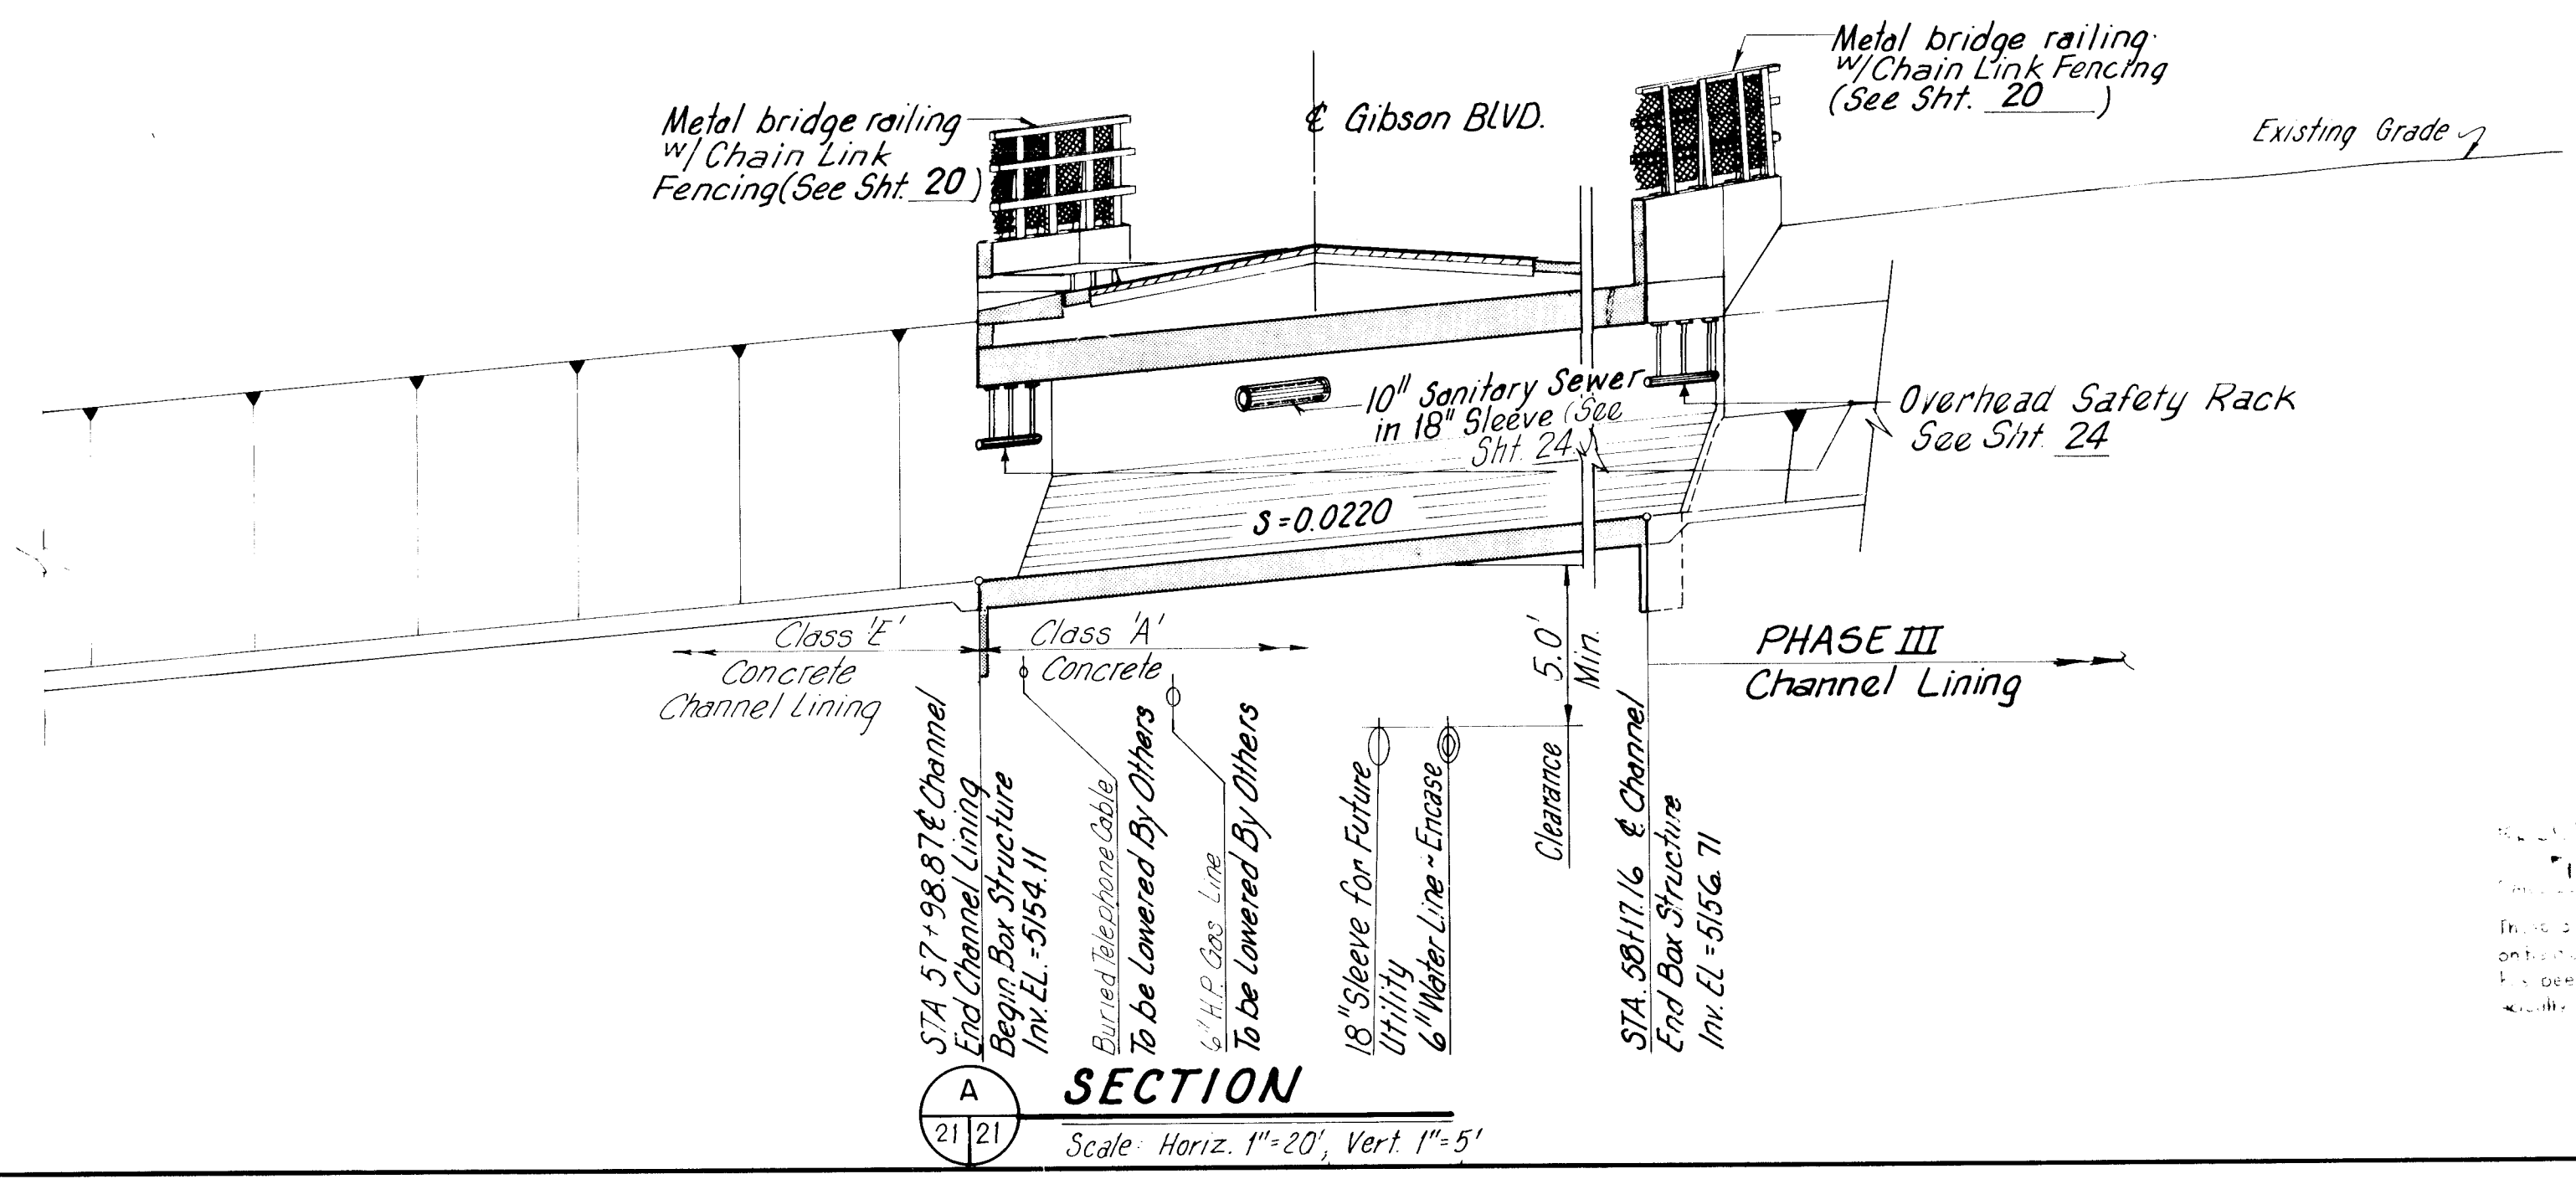


REVISED 11/6/86
REVISED 10/13/86 26 172321 87

AMAFCA	
WESTGATE DIVERSION CHANNELS	
	SNOW VISTA CHANNEL PHASE II GIBSON BLVD. CONCRETE BOX CULVERT LAYOUT & GRADING PLAN
	ENGINEERS ARCHITECTS PLANNERS
	ALBUQUERQUE
	SANTA FE

DRAWN BY J.C.D.
DATE SEPT 1986
SCALE AS SHOWN

BRUNING 34376

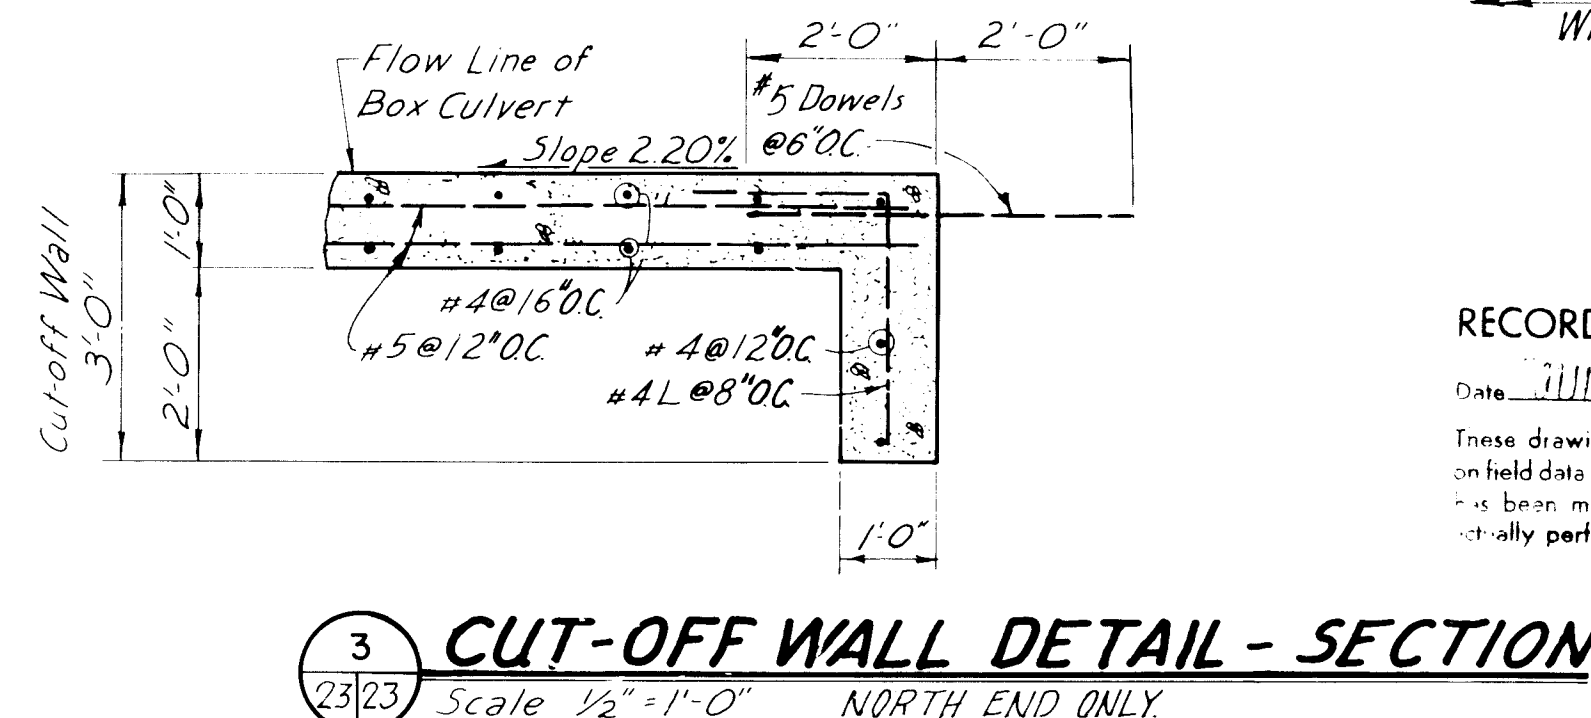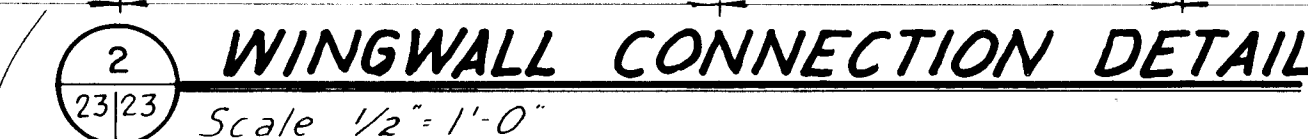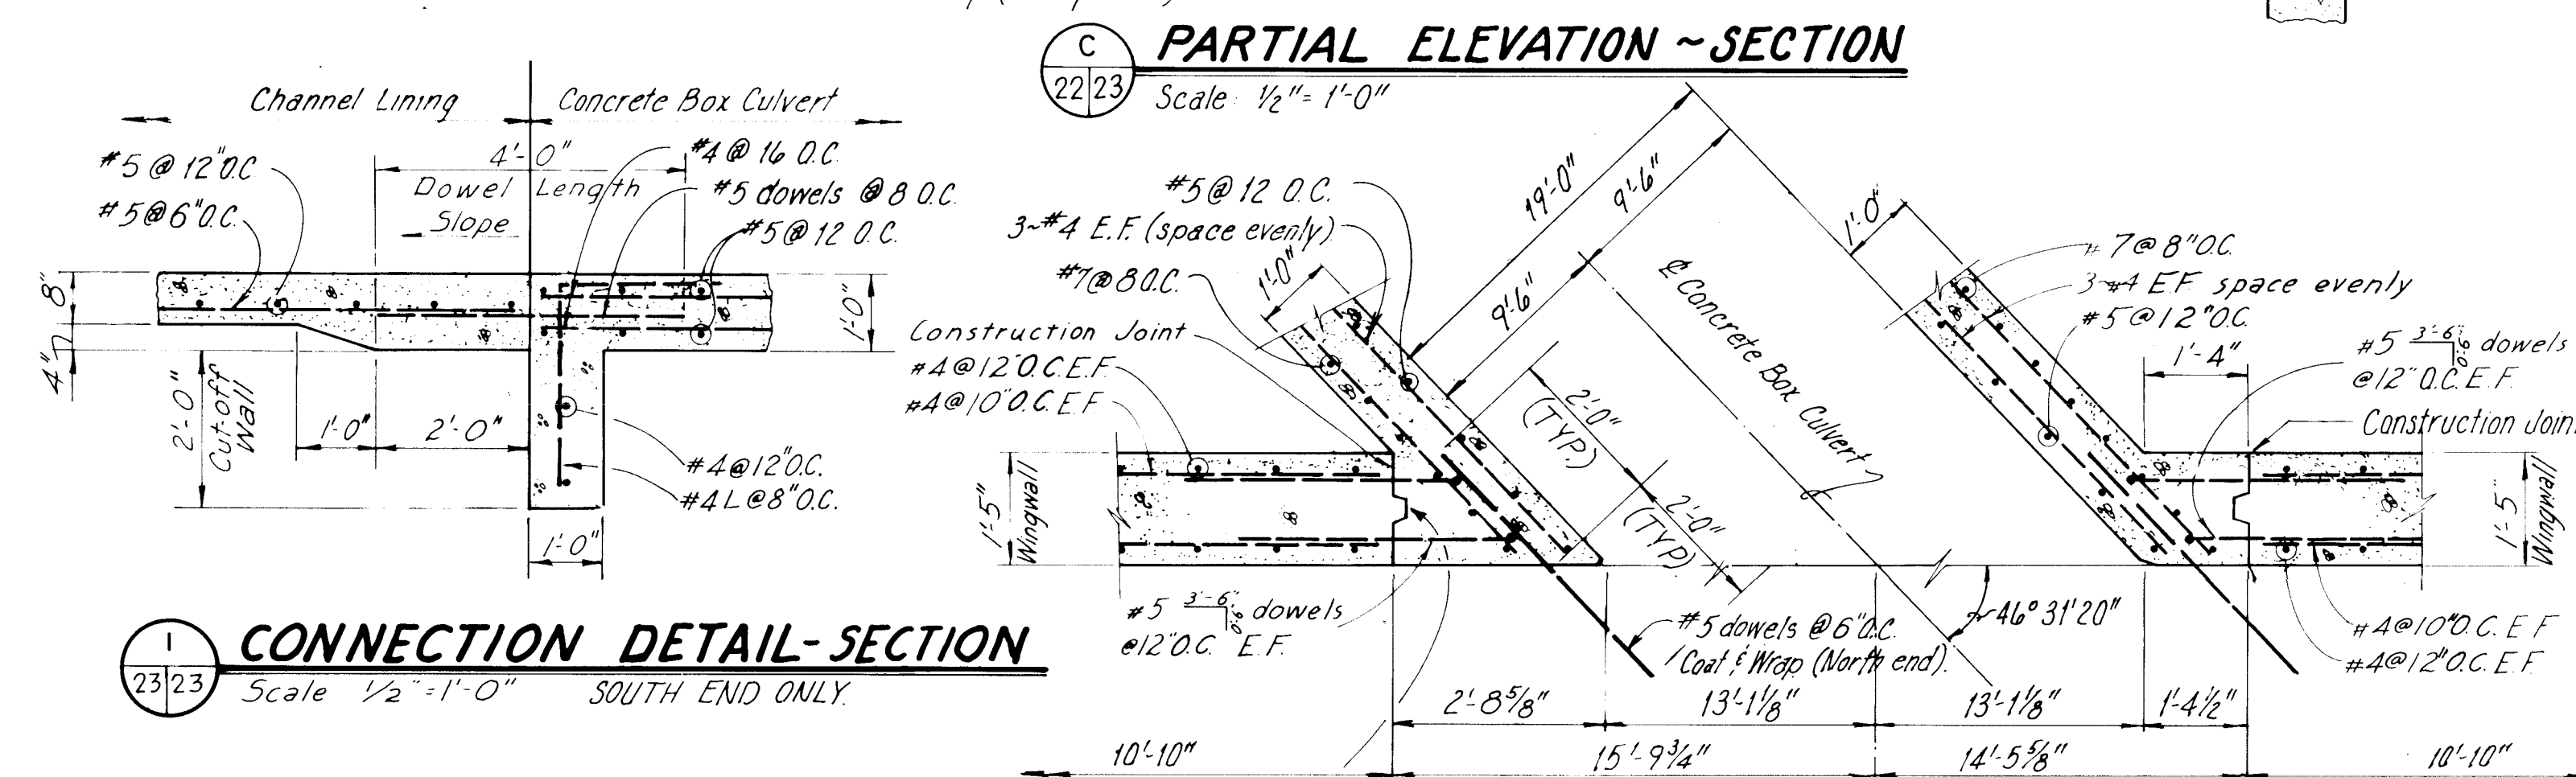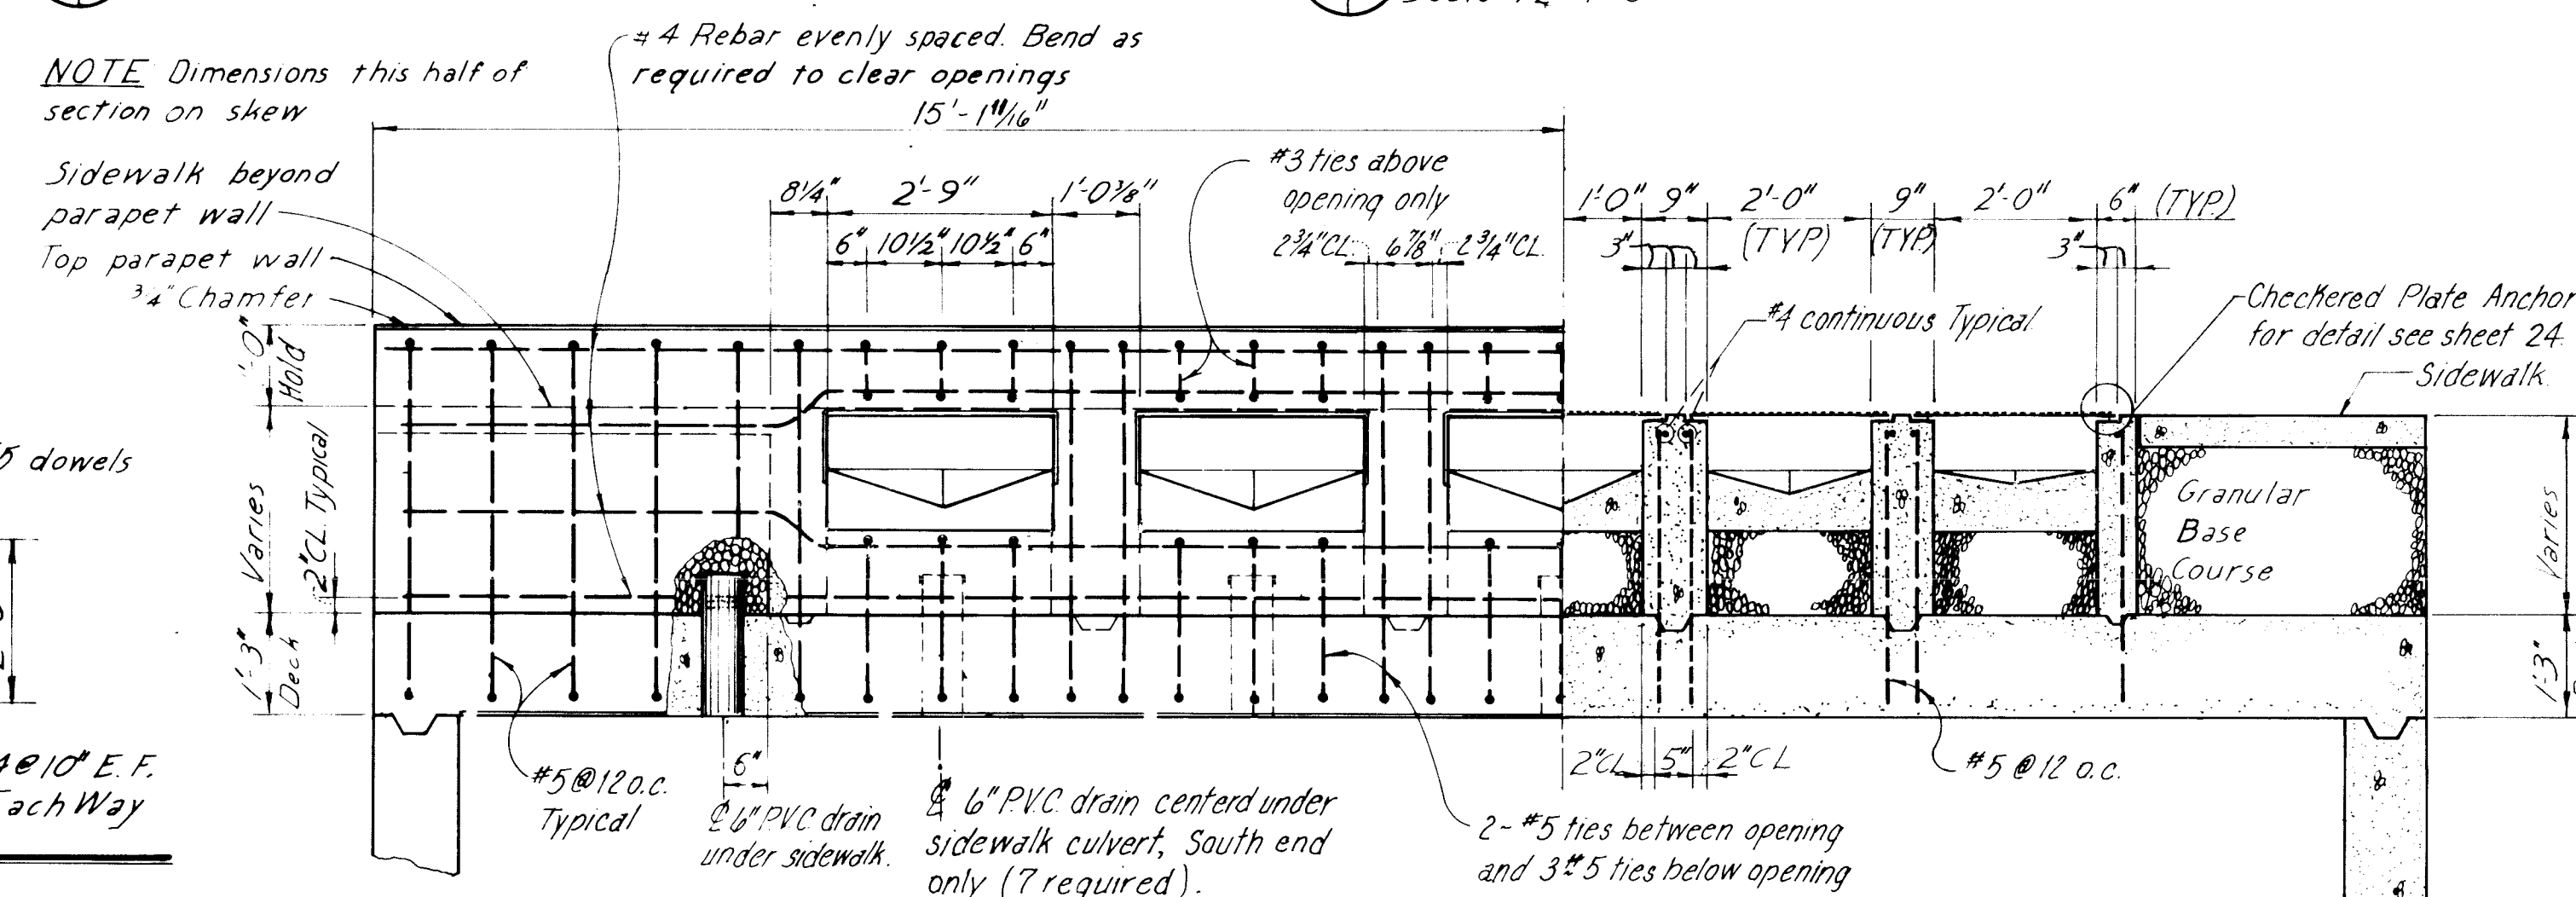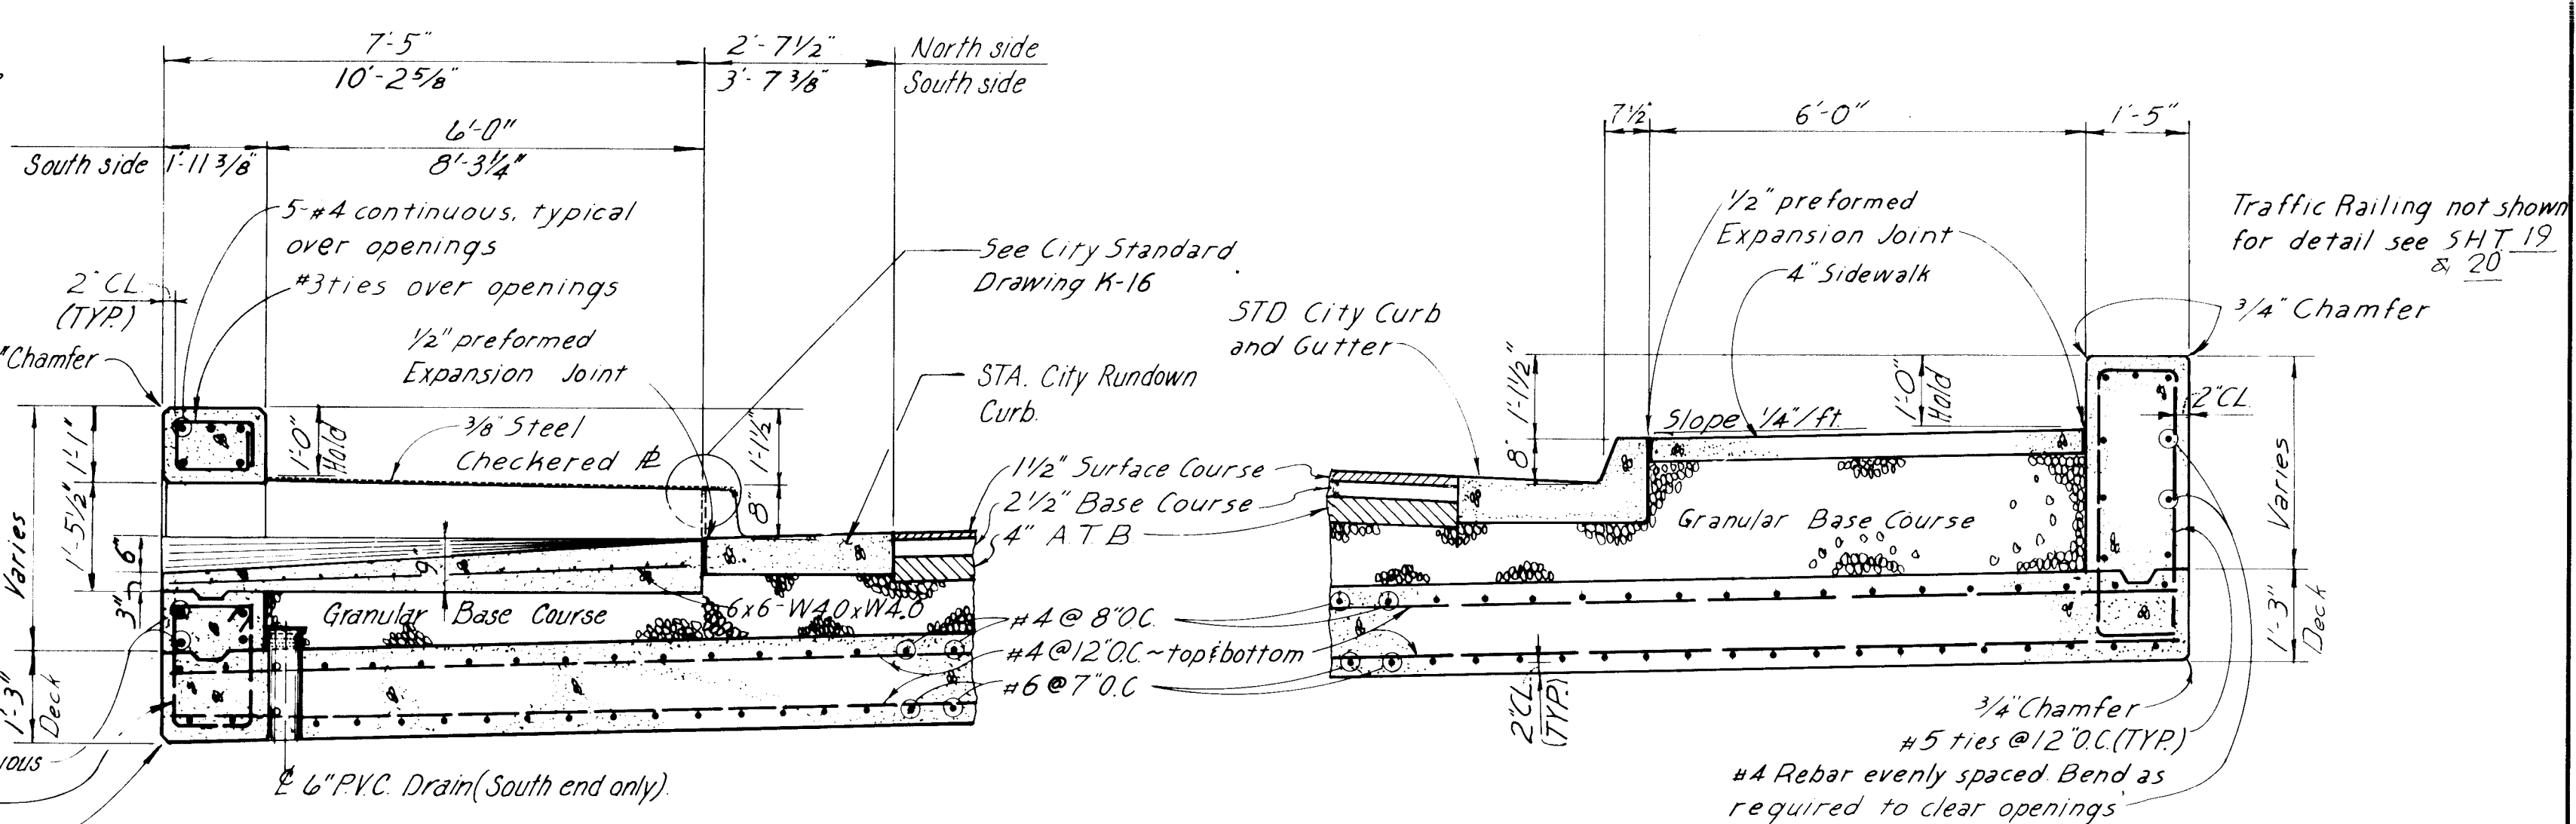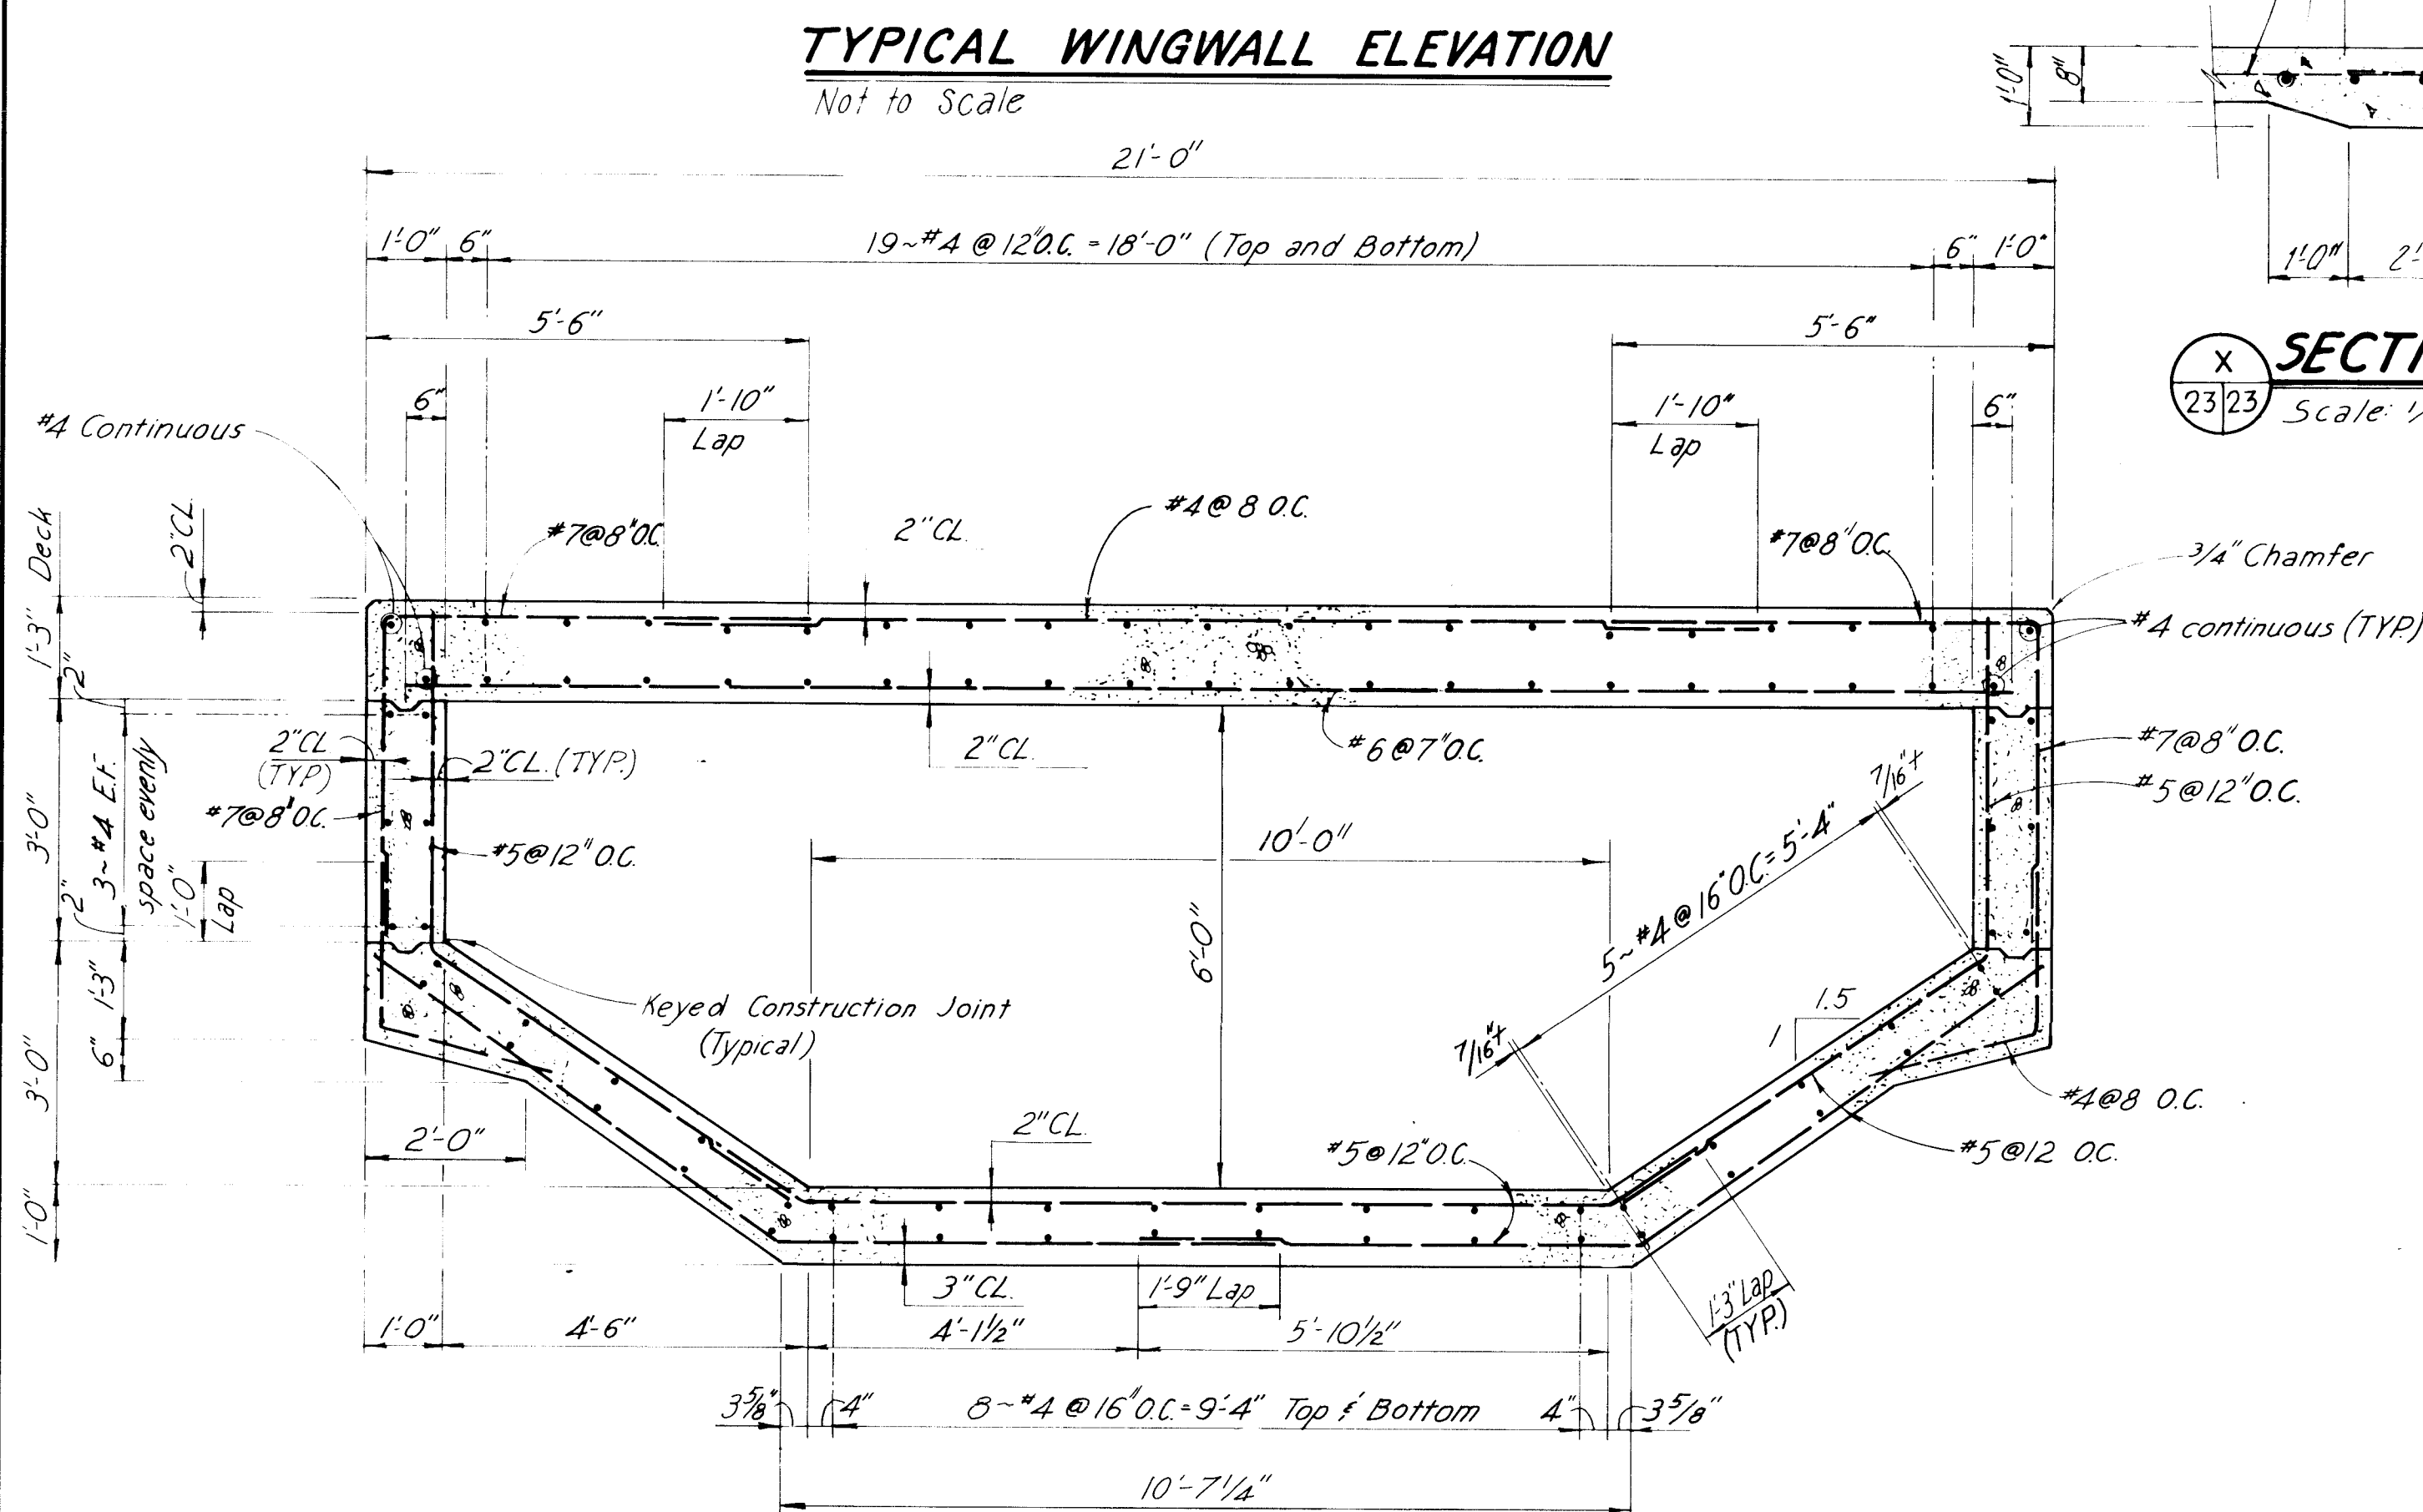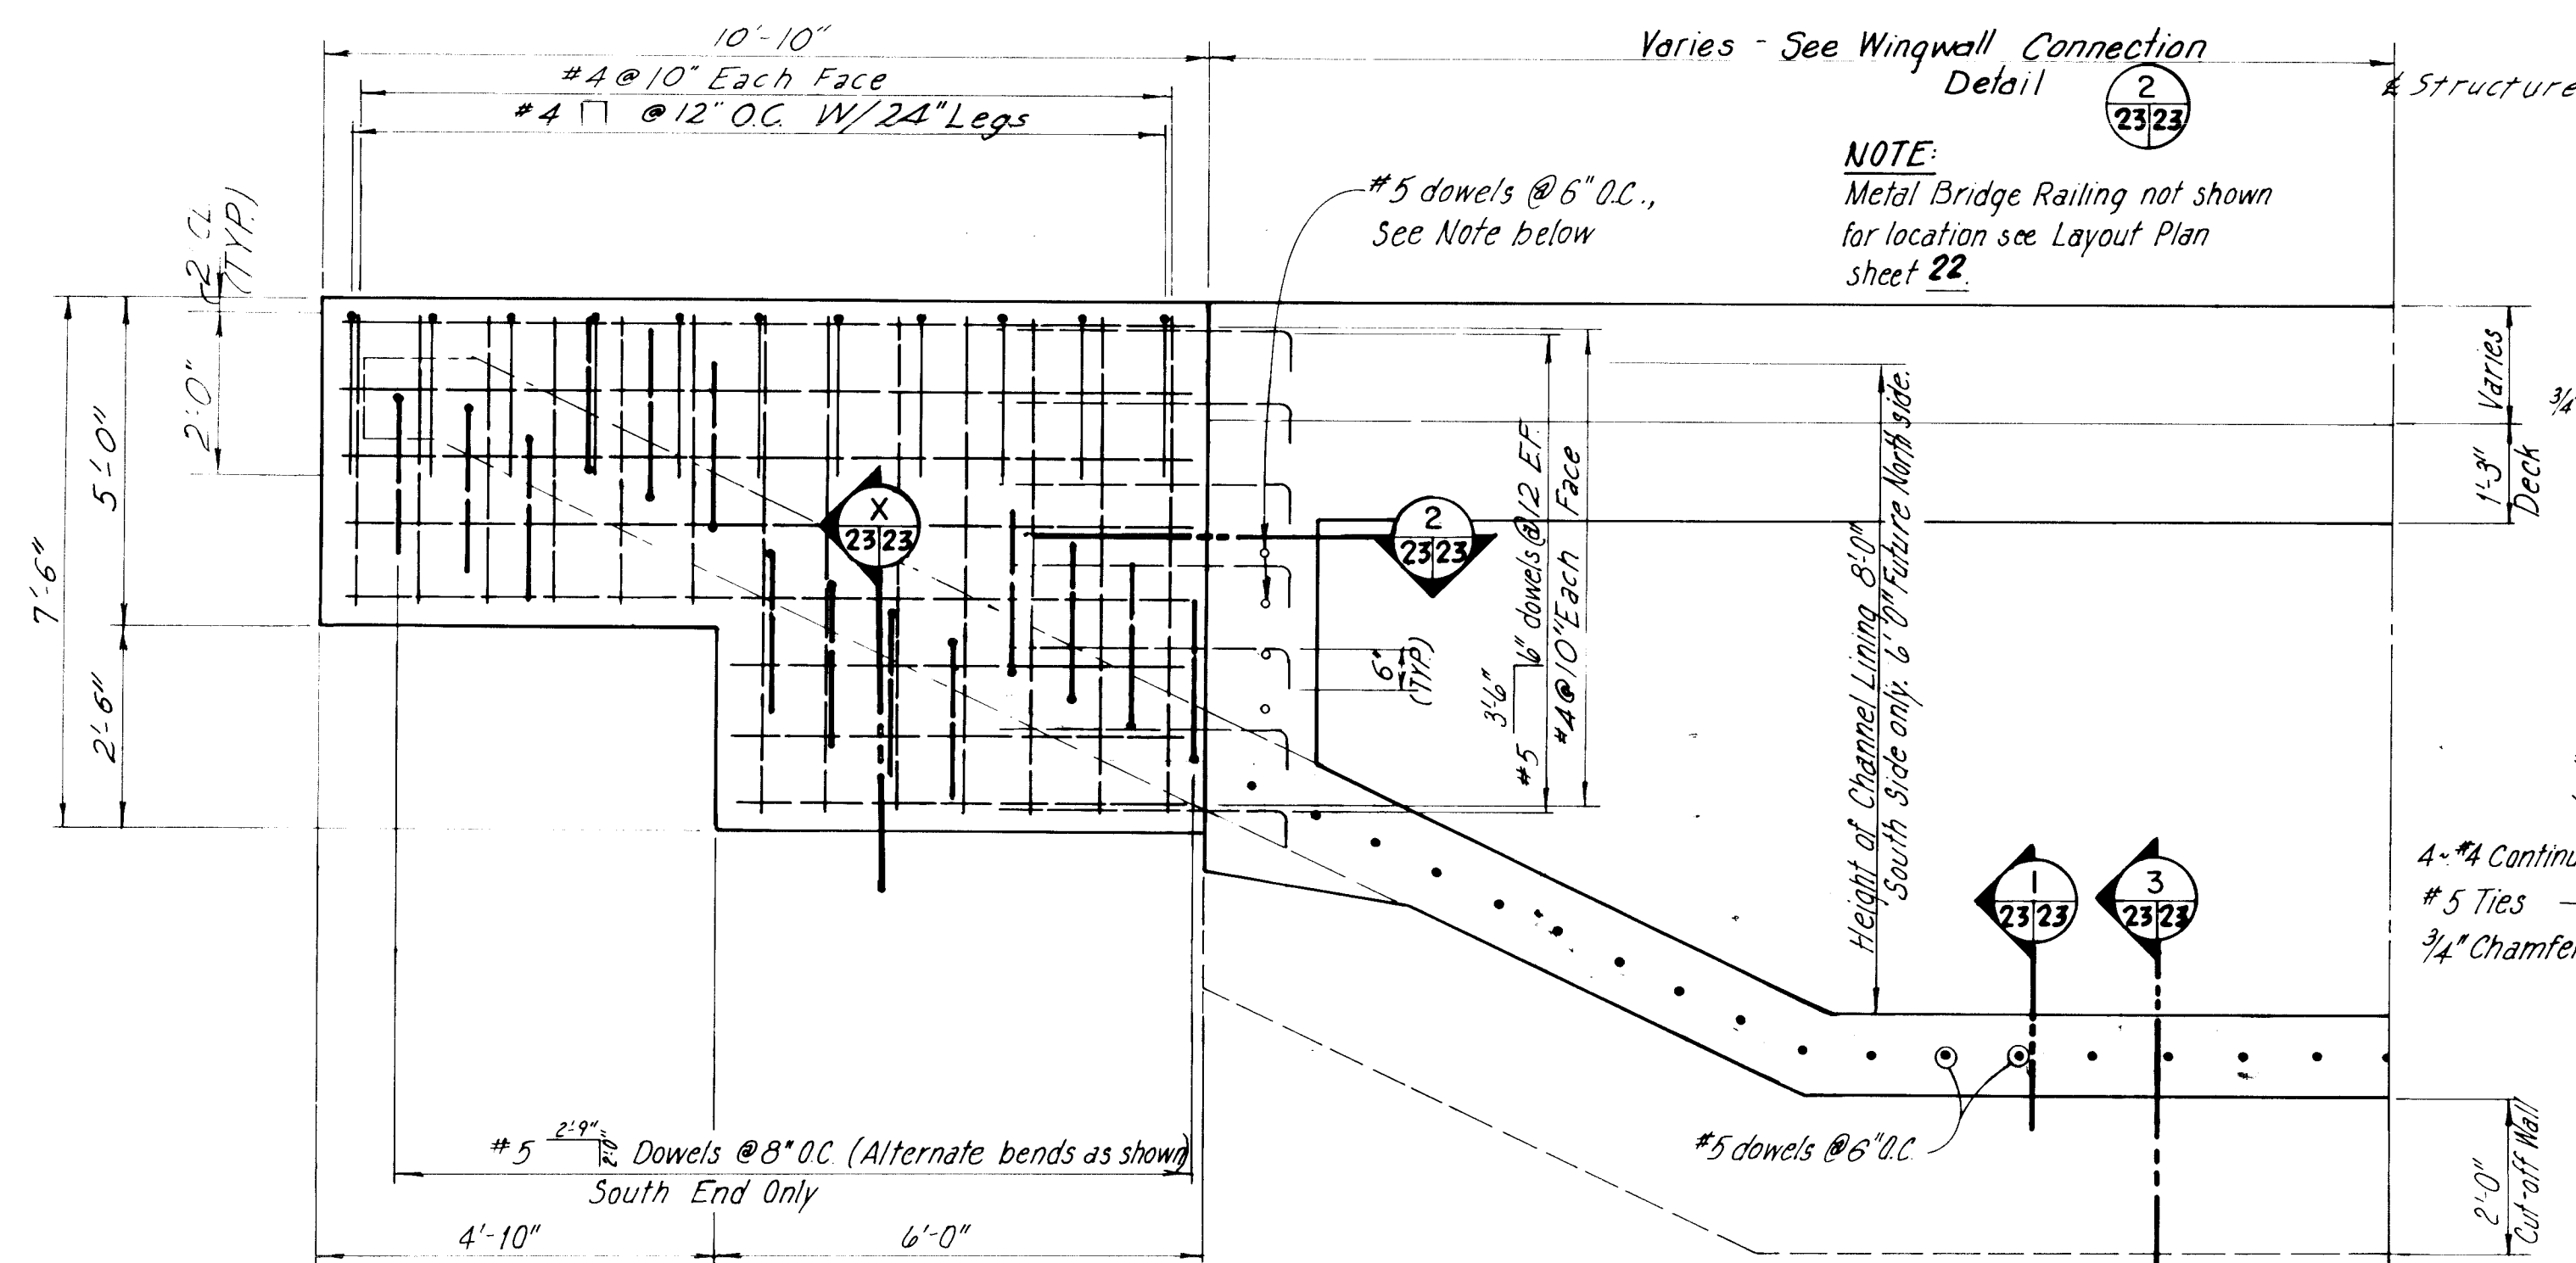

REVISED 12-18-86

AMAFCA

WESTGATE DIVERSION CHANNELS

SNOW VISTA CHANNEL PHASE II

SNOW VISTA CHANNEL PHASE II
GIBSON BLVD.

CONCRETE BOX CULVERT

REINFORCEMENT DETAILS

GORDON HERKENHOFF & ASSOCIATES, INC.

ENGINEERS ARCHITECTS PLANNERS

ALBUQUERQUE SANTA FE

DRAWN BY

K.H.K.

DATE
SEPT 1986

SCALE

AS SHOWN

S. INC.

RECORD DRAWING

2011 1 0 1957







These drawings have been revised based on field data and every reasonable attempt has been made to depict construction as actually performed.



26 1723 2387

SHEET 23 OF 49

	SURVEYED _____	BY _____	DATE _____
	PLOTTED _____		
	TEMPLATE _____		
	AREAS _____		
	AREAS CHECKED _____		

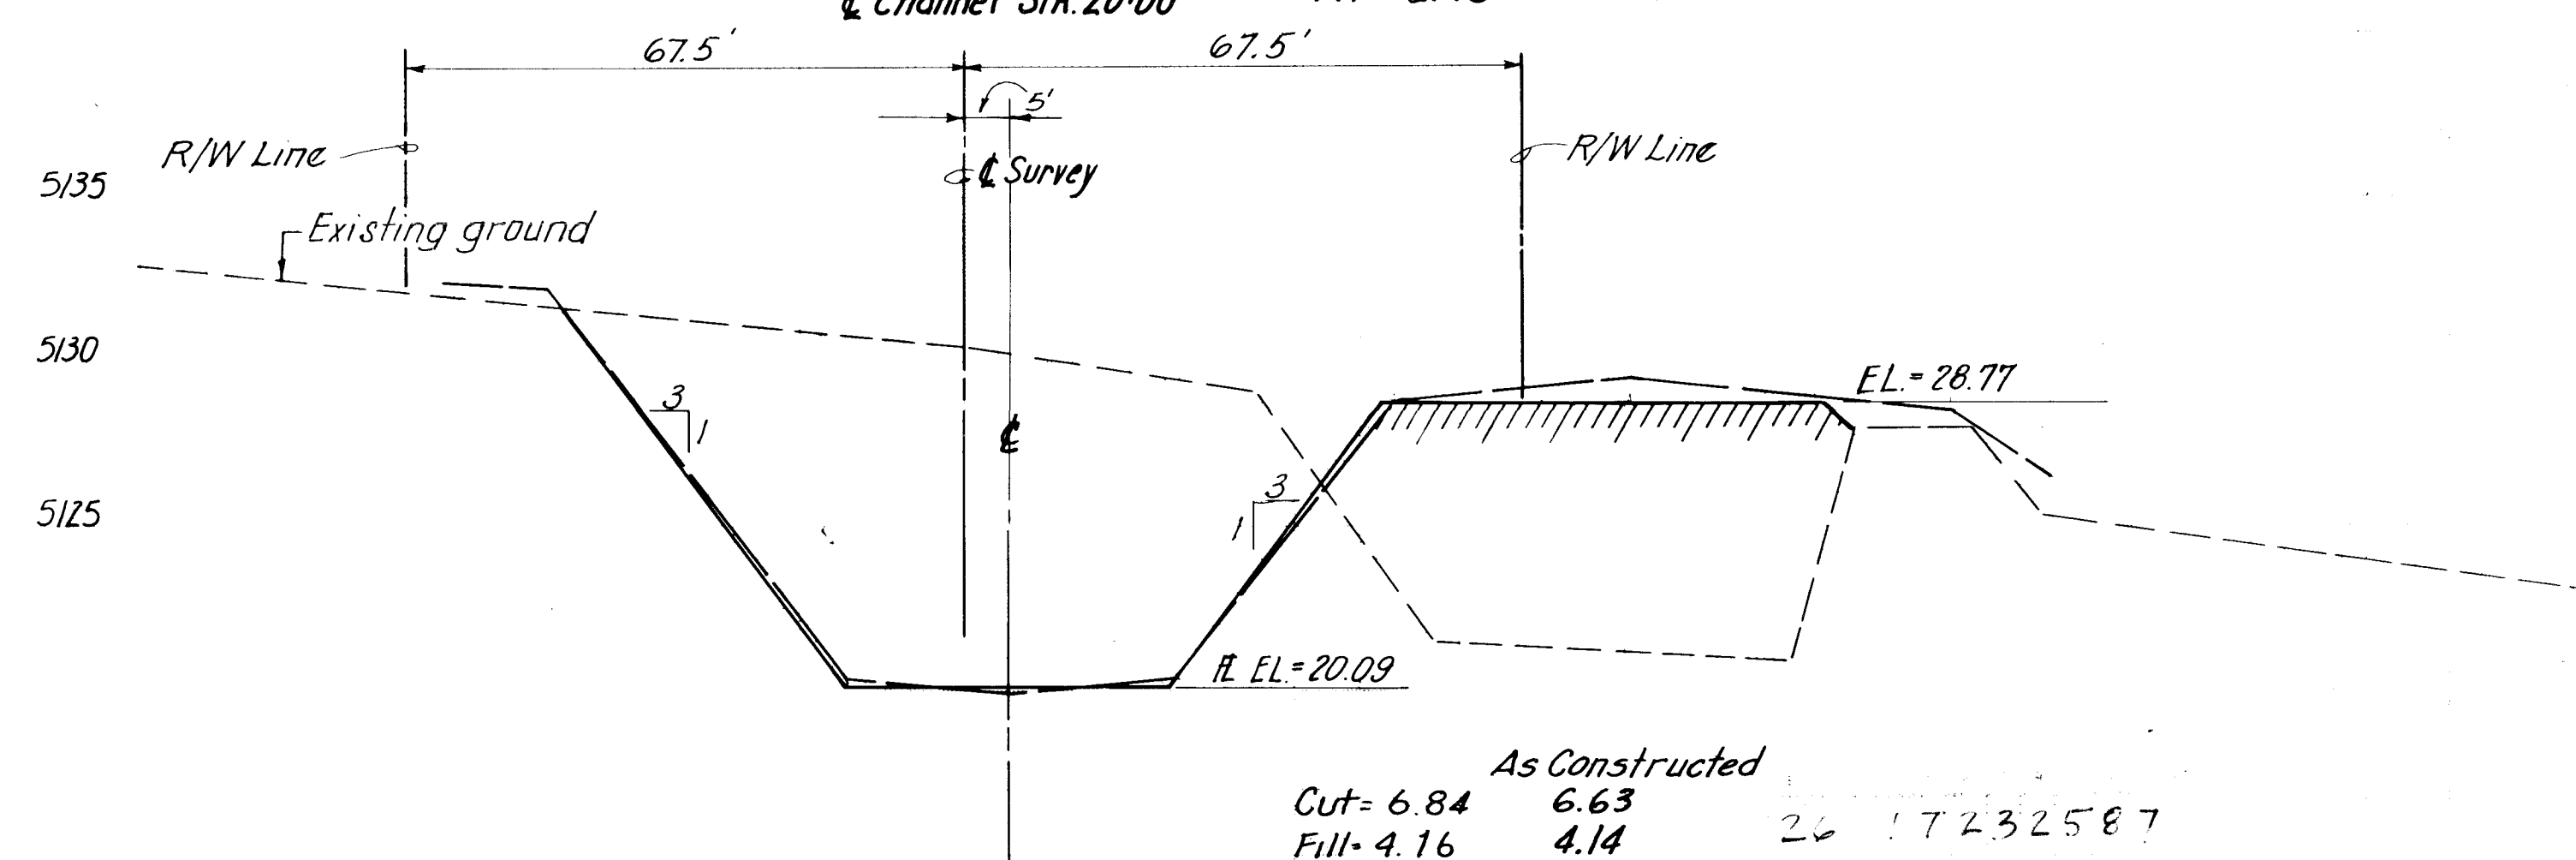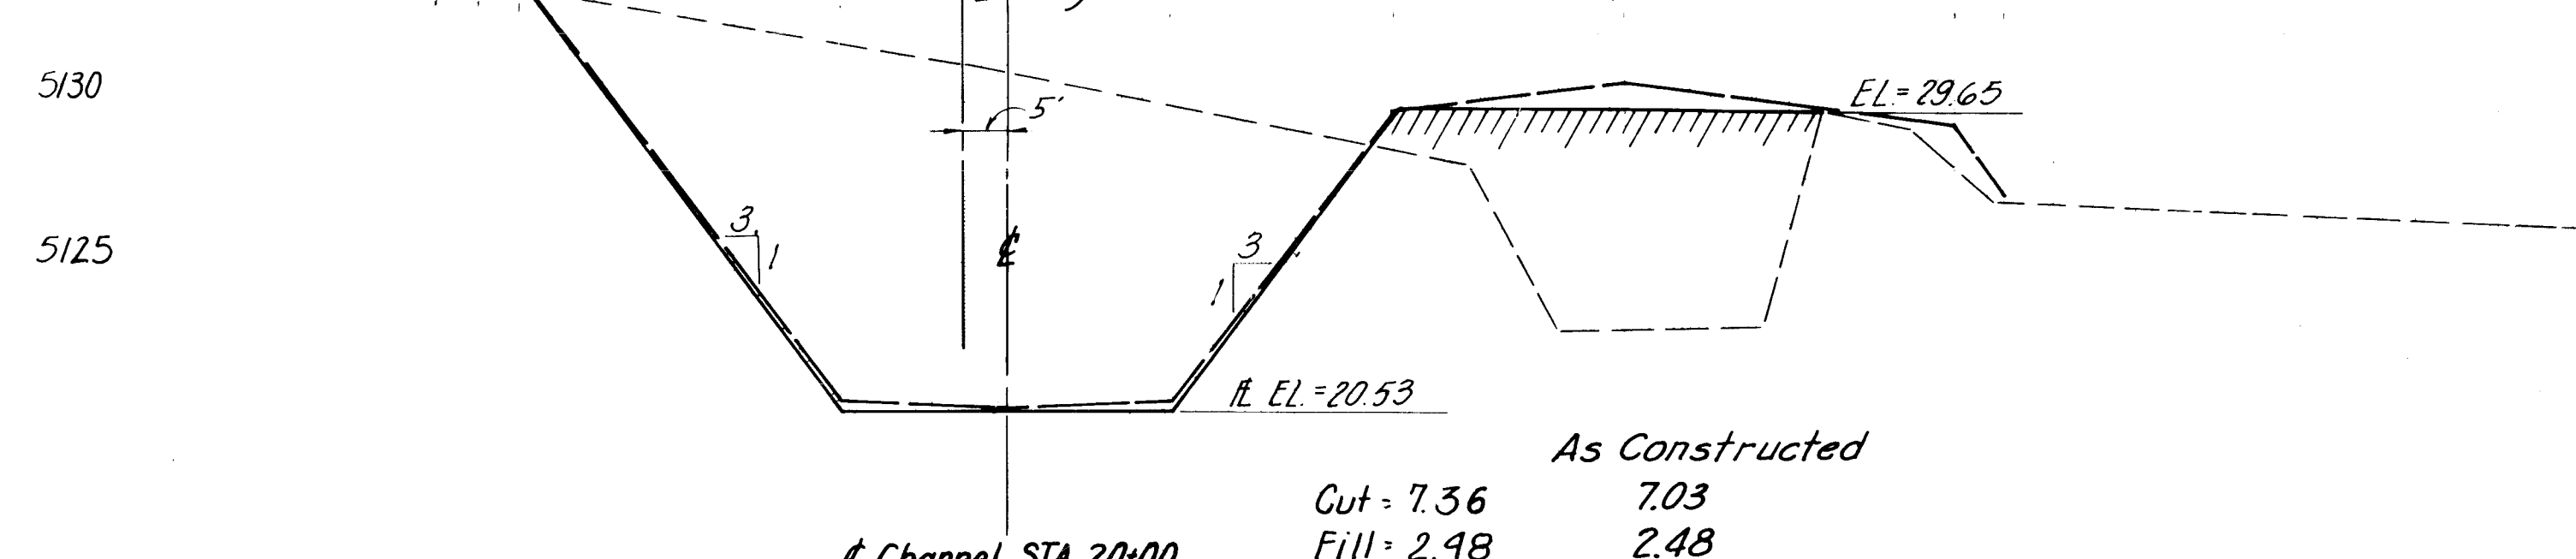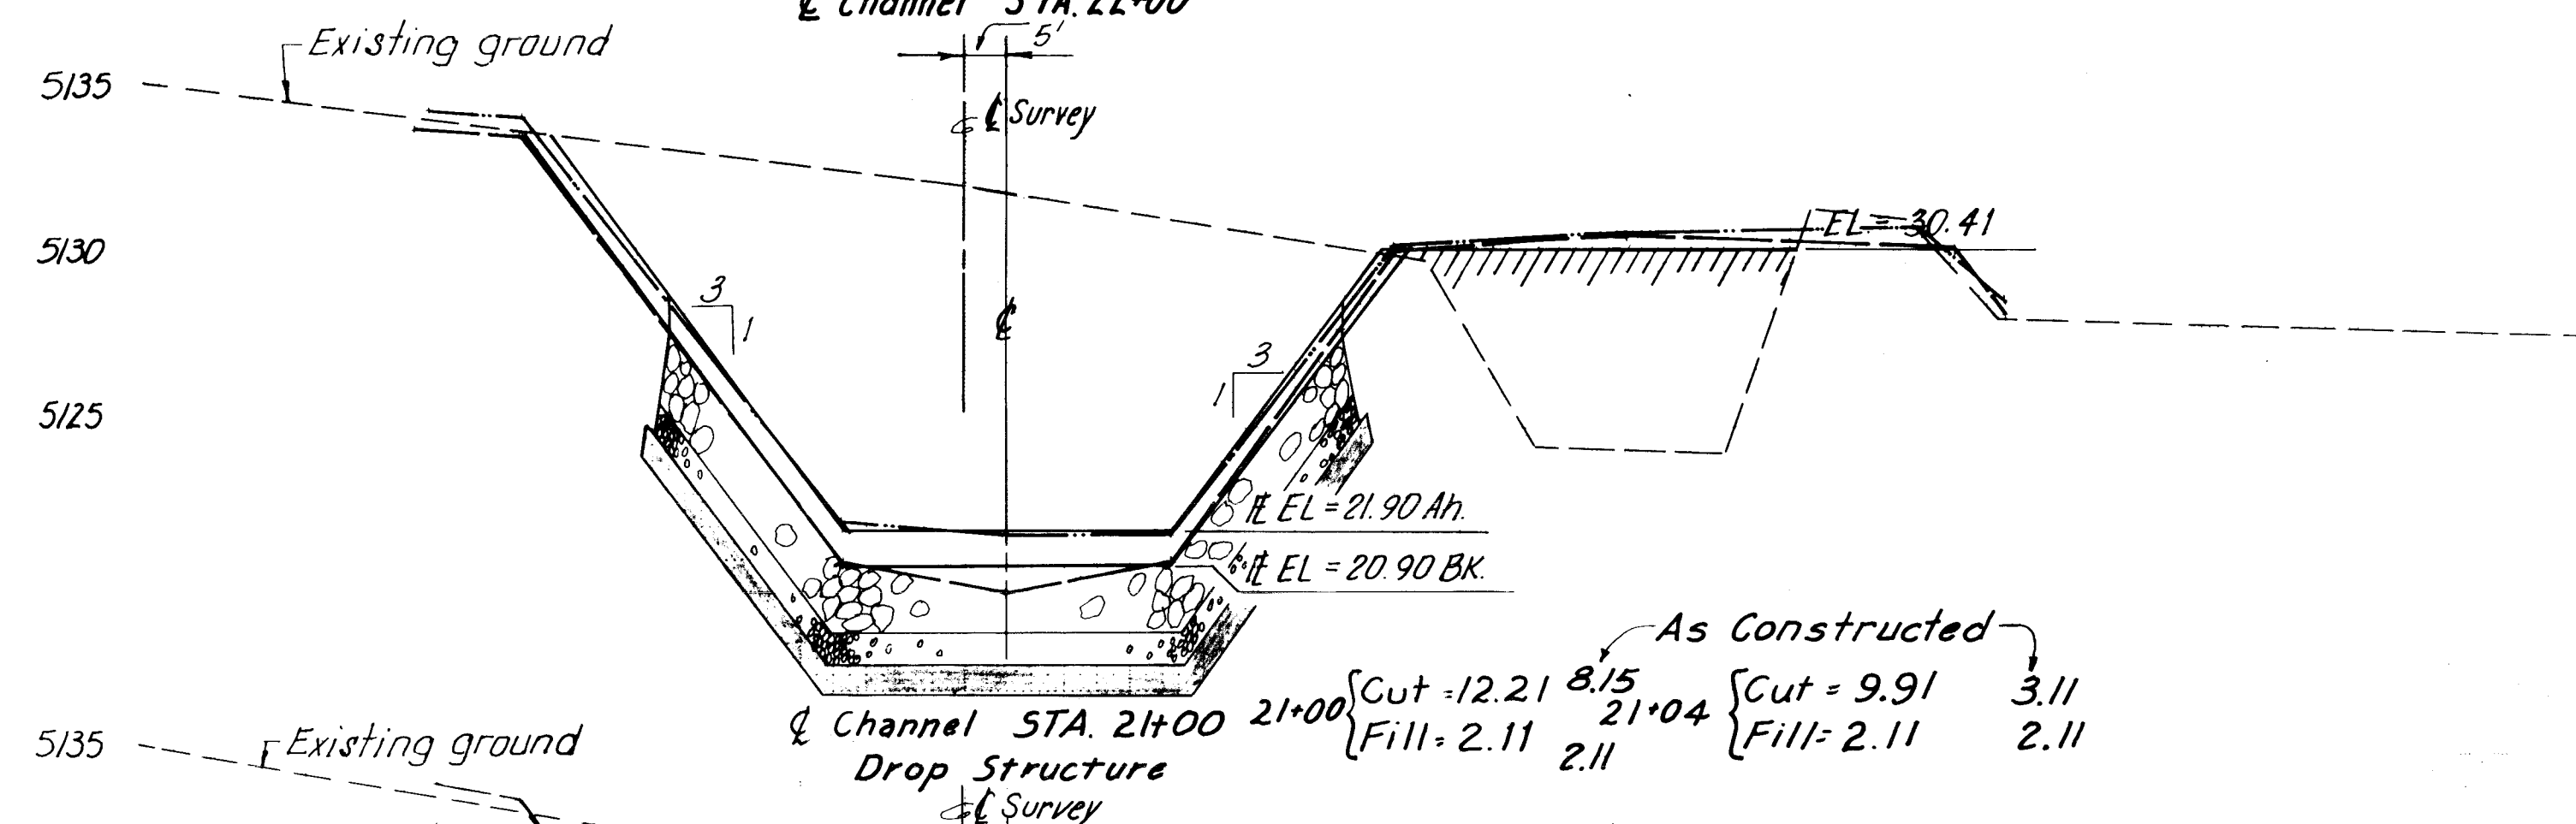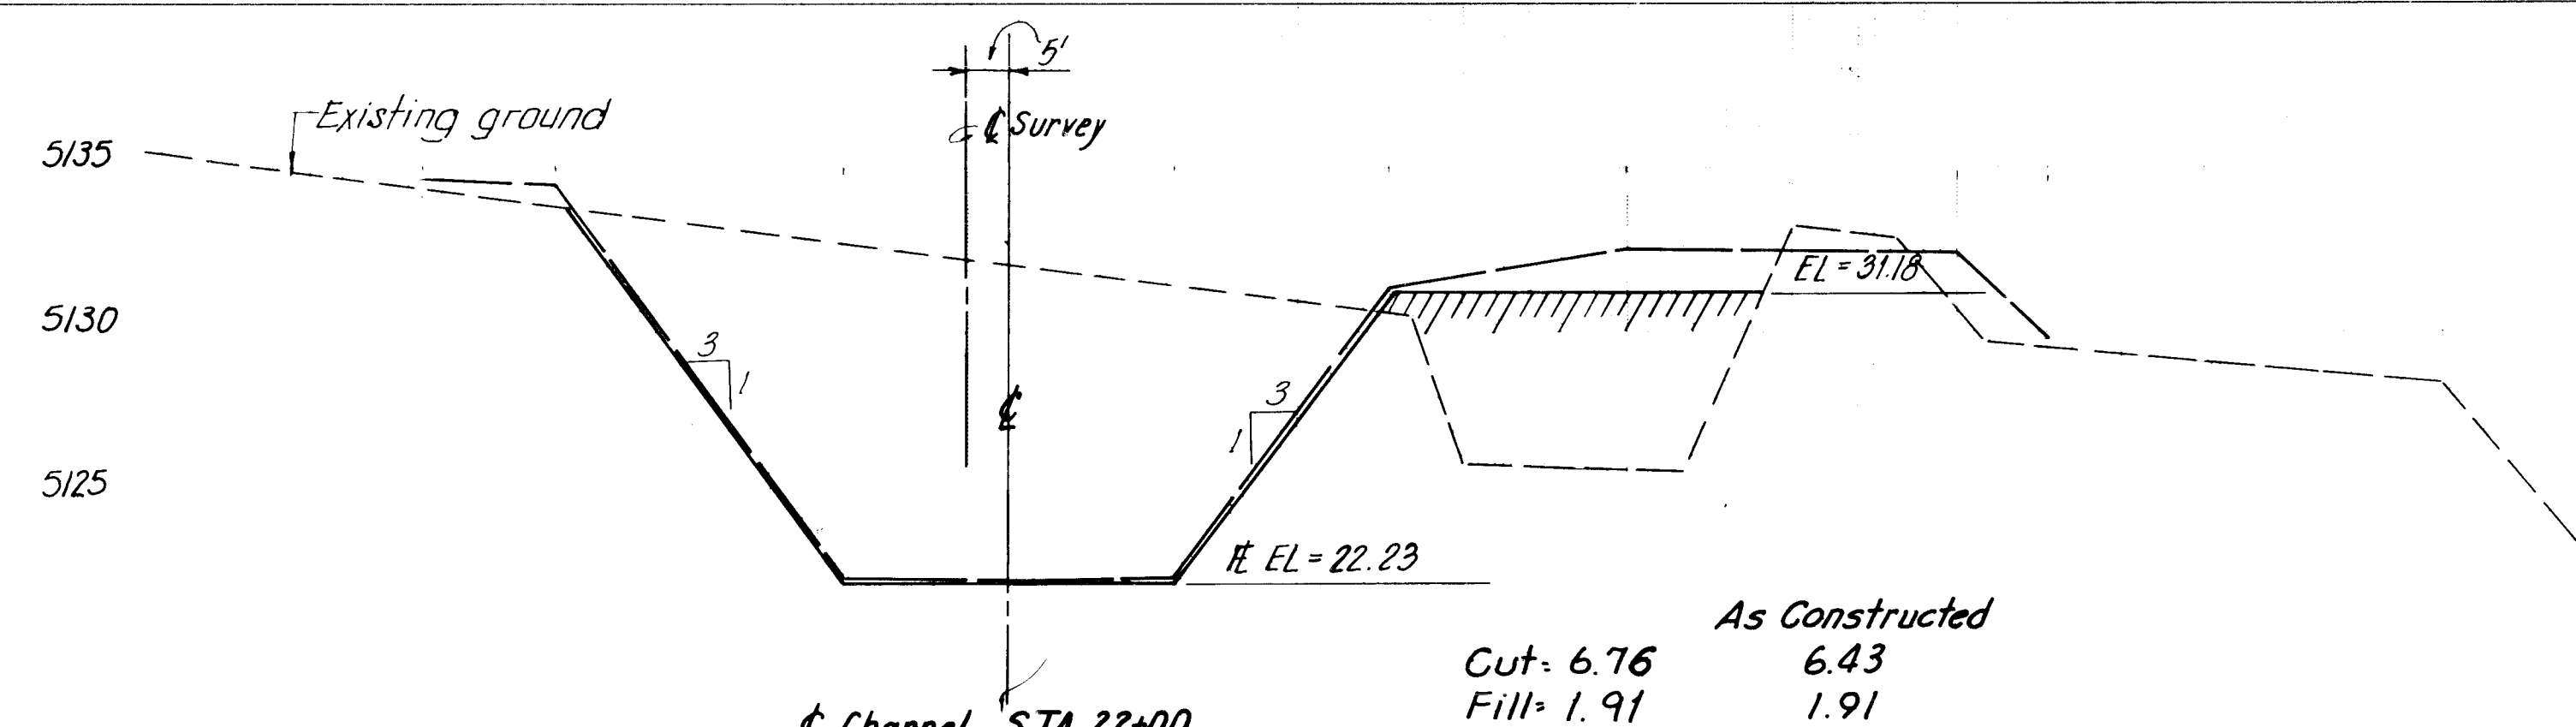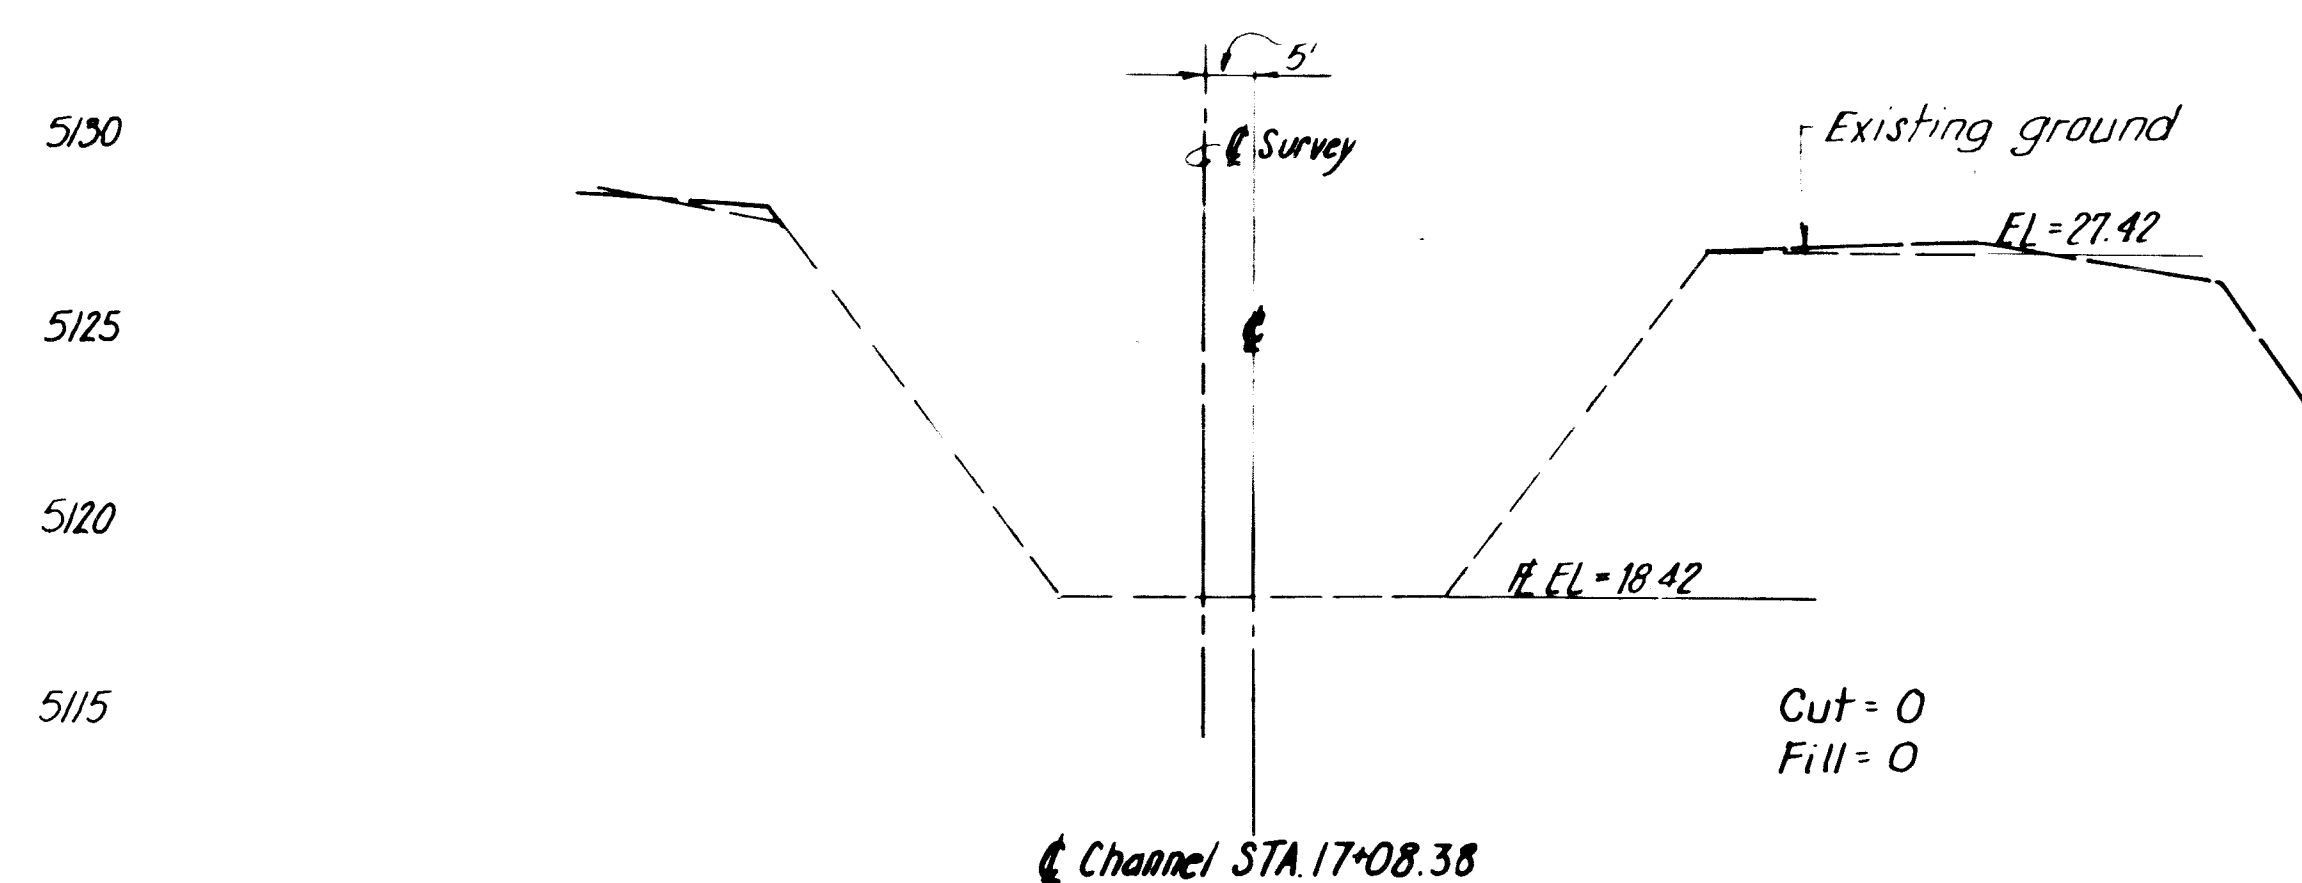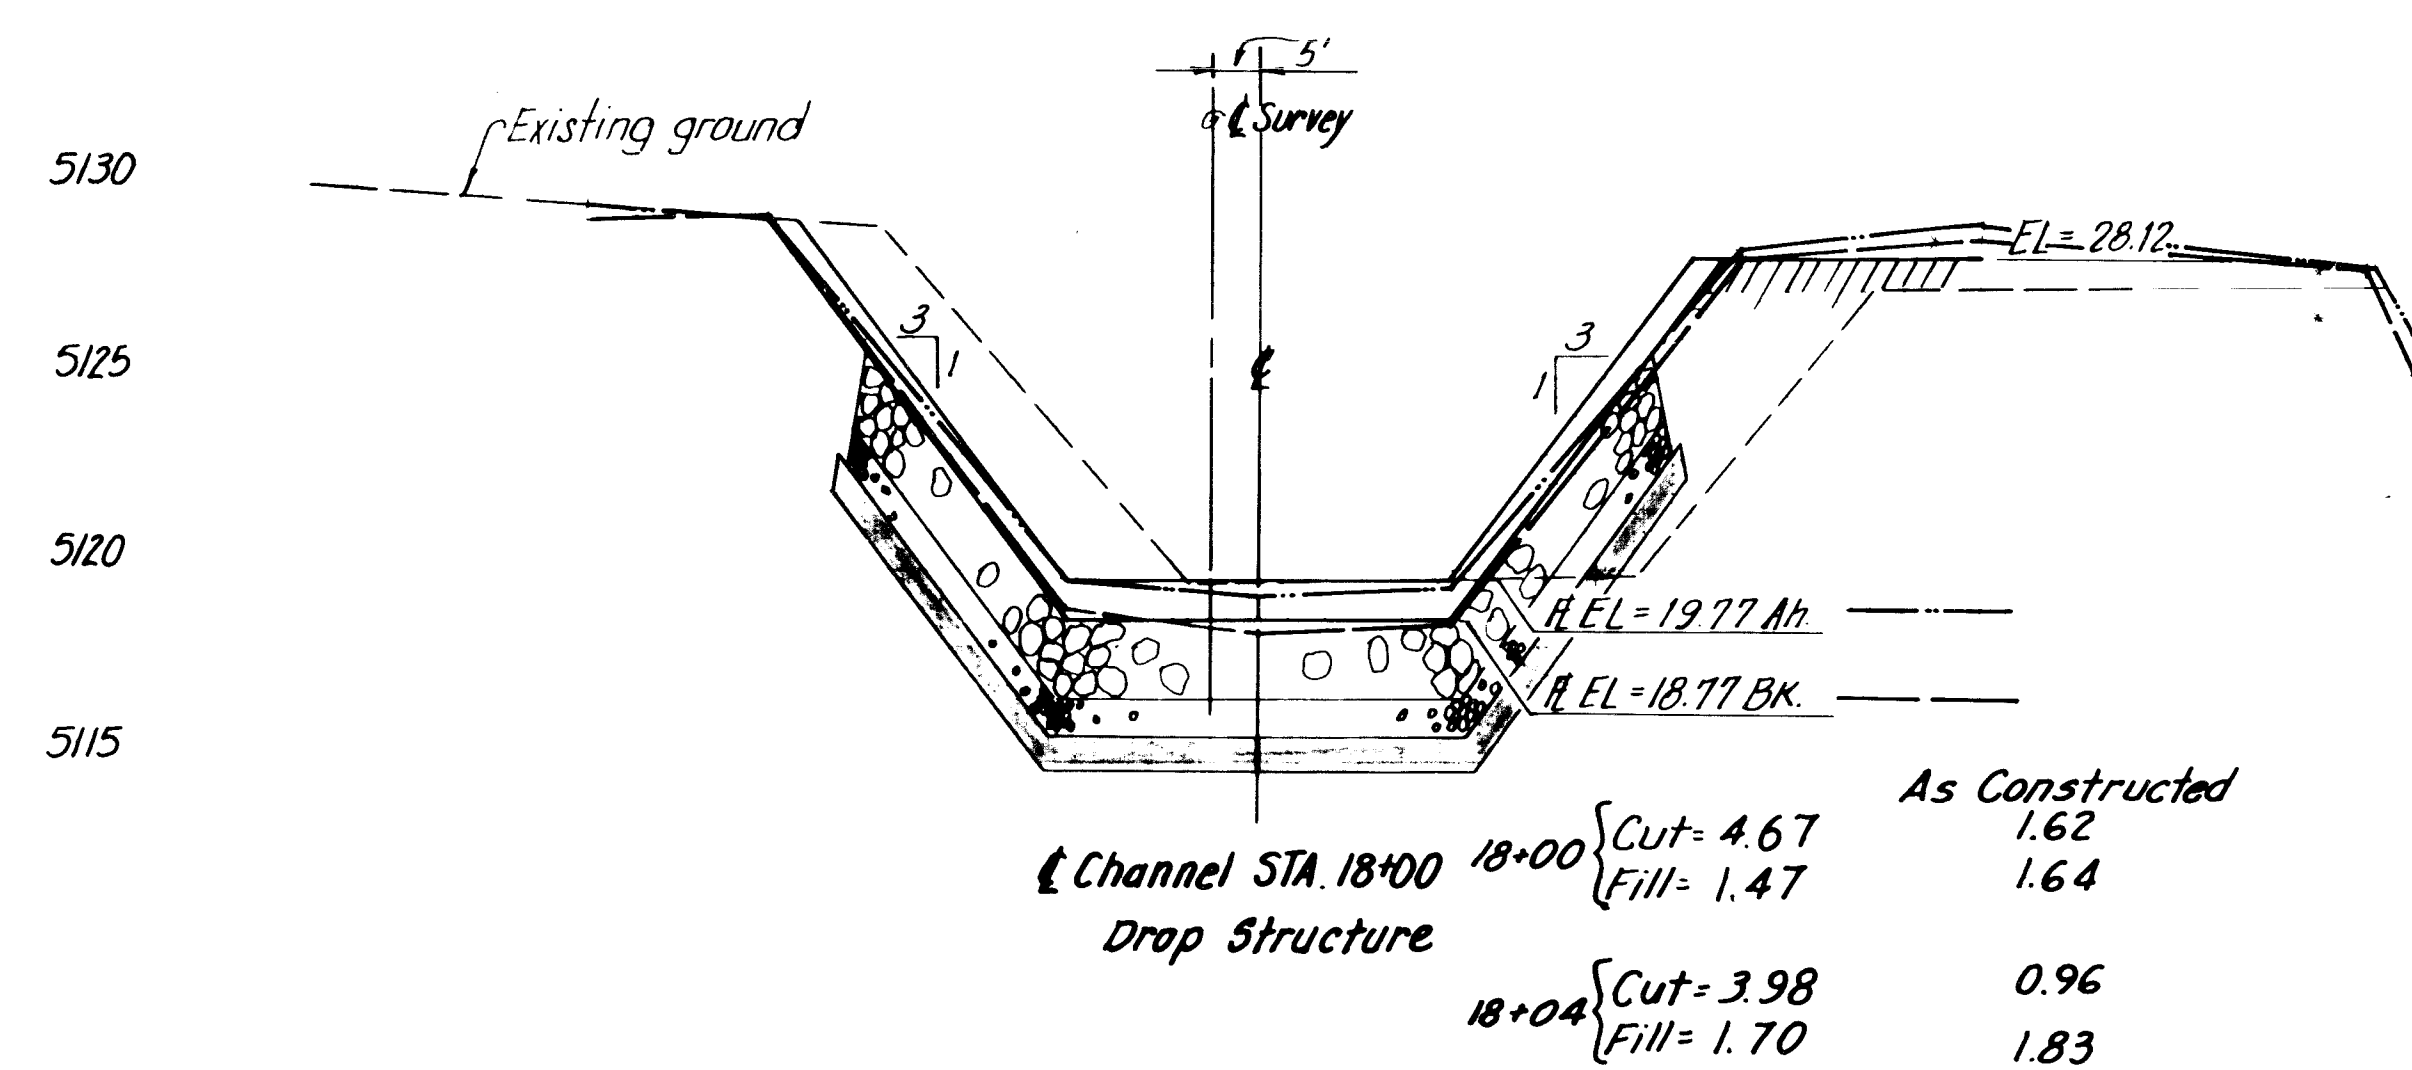

LEGEND

- _____ Exist. ground
 _____ Design
 _____ Field-Post construction at down stream
 for riprap structures.
 _____ Field-Post construction upstream of
 riprap structure.

SCALES:

Horiz: 1" = 20'


Vert: $1'' = 5'$

PLATE 3 CROSS SECTION - DOTTED
CHARLES BRUNING COMPANY
MADE IN U.S.A.

RECORD DRAWING

Date Jul 12 1987

These drawings have been revised based on field data and every reasonable attempt has been made to depict construction as actually performed.

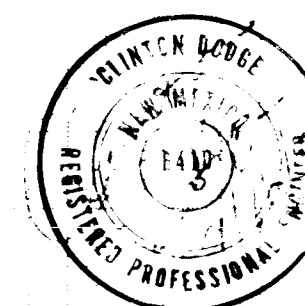

AMAFCA

WESTGATE DIVERSION CHANNELS

SNOW VISTA CHANNEL PHASE II

CROSS SECTIONS

STA. 17+08.38 TO STA. 22+00


GORDON HERKENHOFF & ASSOCIATES, INC.

ENGINEERS • PLANNERS

ALBUQUERQUE NEW MEXICO

SHEET 25 OF 49

ORIGIN No.	SURVEY	DATE	REMARKS	STATUS
1	1	1	1	1
2	2	2	2	2
3	3	3	3	3
100	100	100	100	100




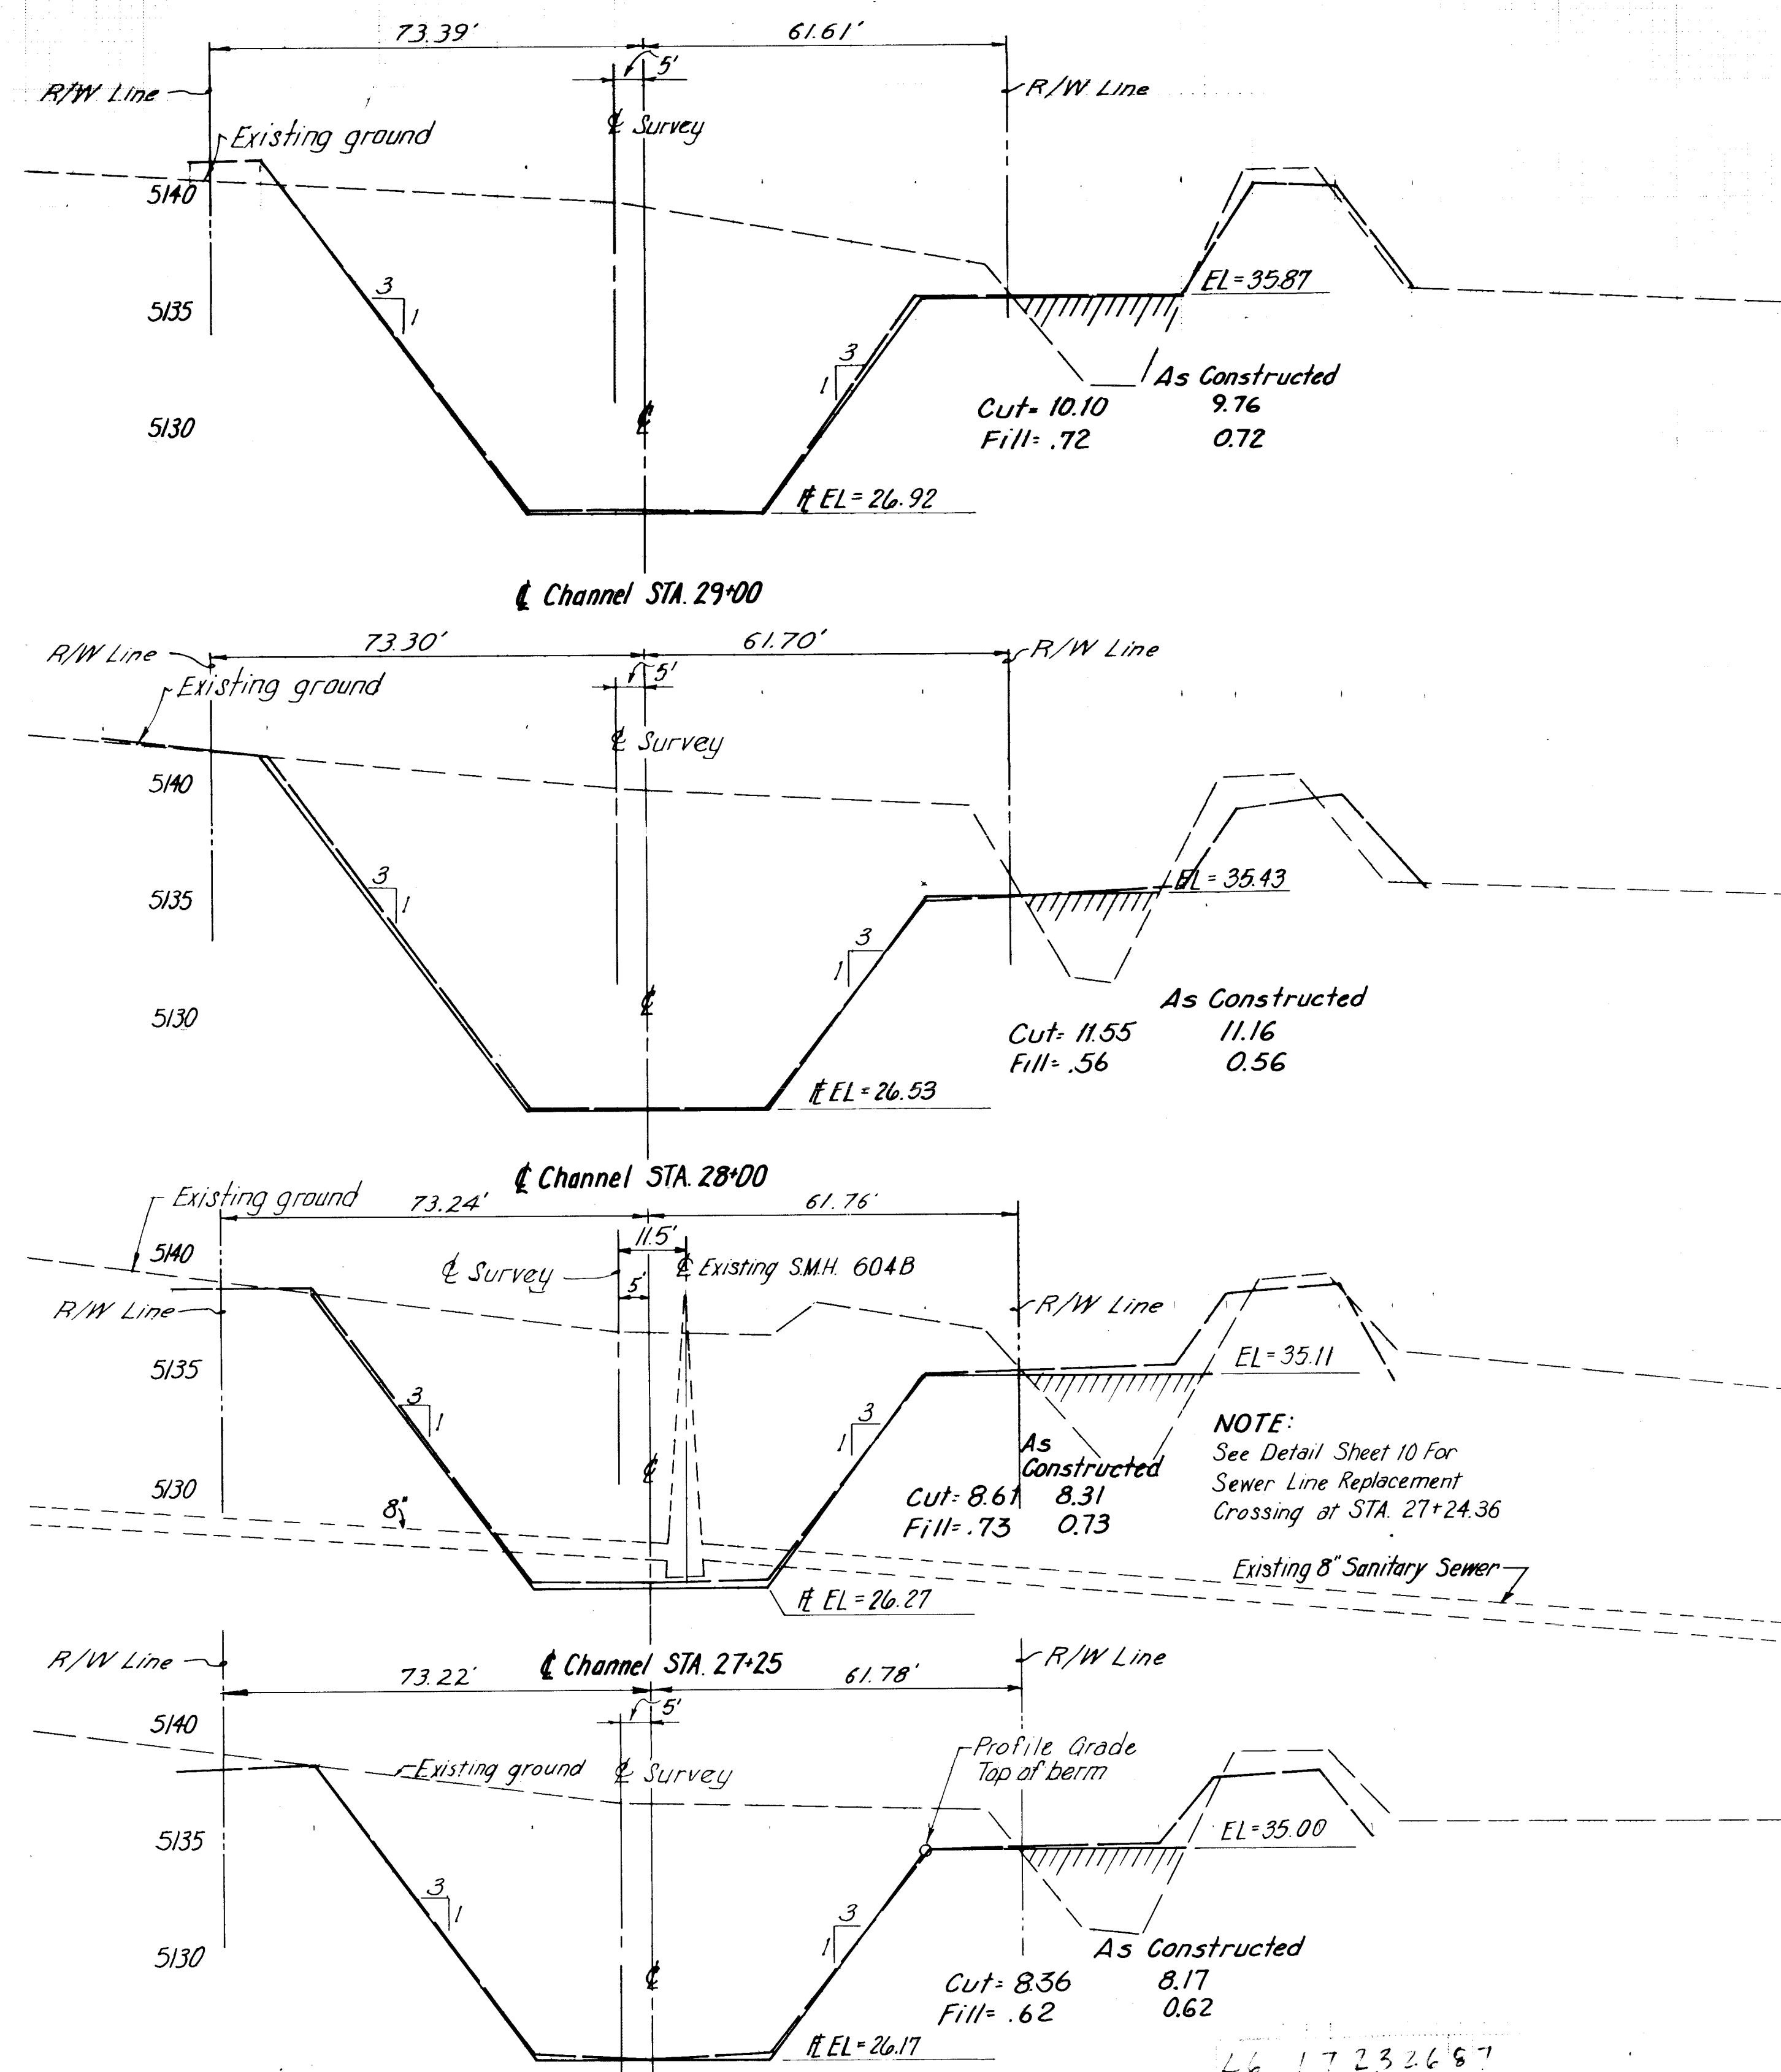


- Field-Post construction at down stream for riprap structures.
- Field-Post construction upstream of riprap structure.

These drawings have been revised based on field data and every reasonable attempt has been made to depict construction as actually performed.





GORDON HERKENHOFF & ASSOCIATES, INC.
ENGINEERS • PLANNERS
ALBUQUERQUE NEW MEXICO

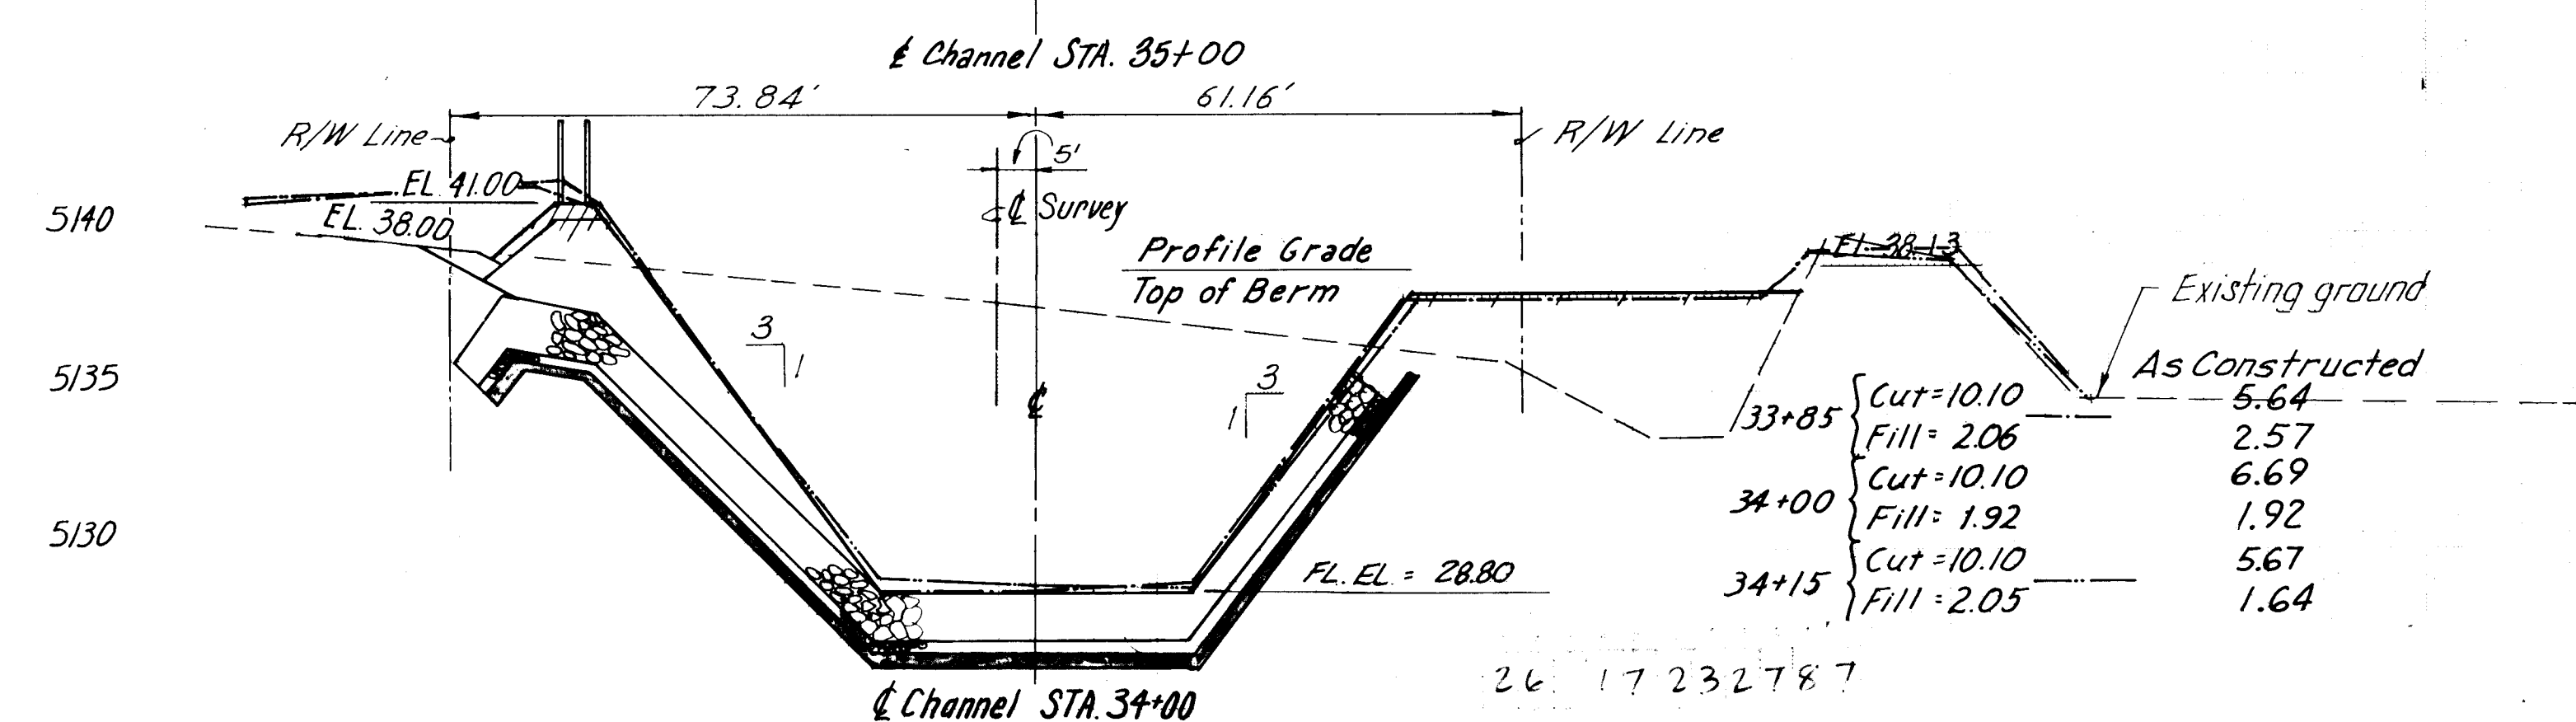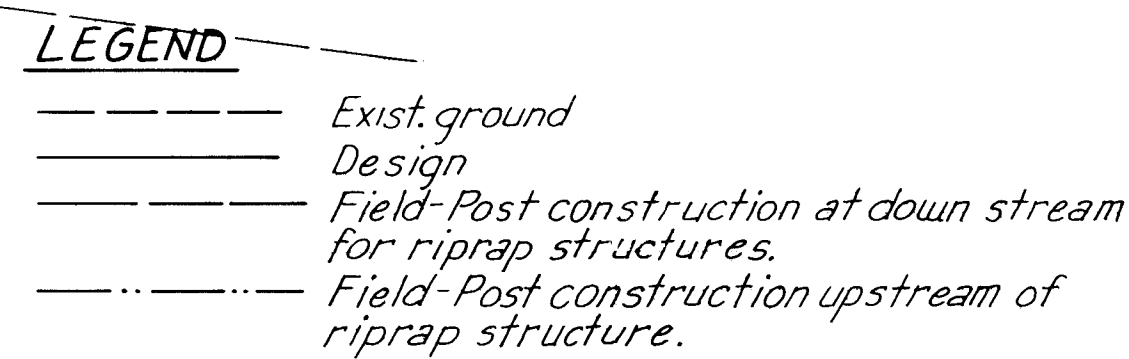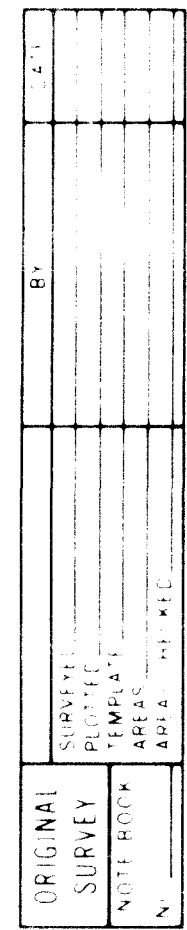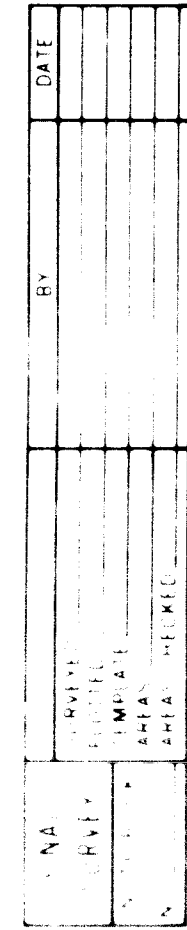

NEW MEXICO

DATE	
BY	
REVISION	
NO.	
DESCRIPTION	
FINAL SURVEY	
NOTE BOOK	
AREA CHECKED	

DATE	
BY	
REVISION	
NO.	
DESCRIPTION	
ORIGINAL SURVEY	
NOTE BOOK	
AREA CHECKED	

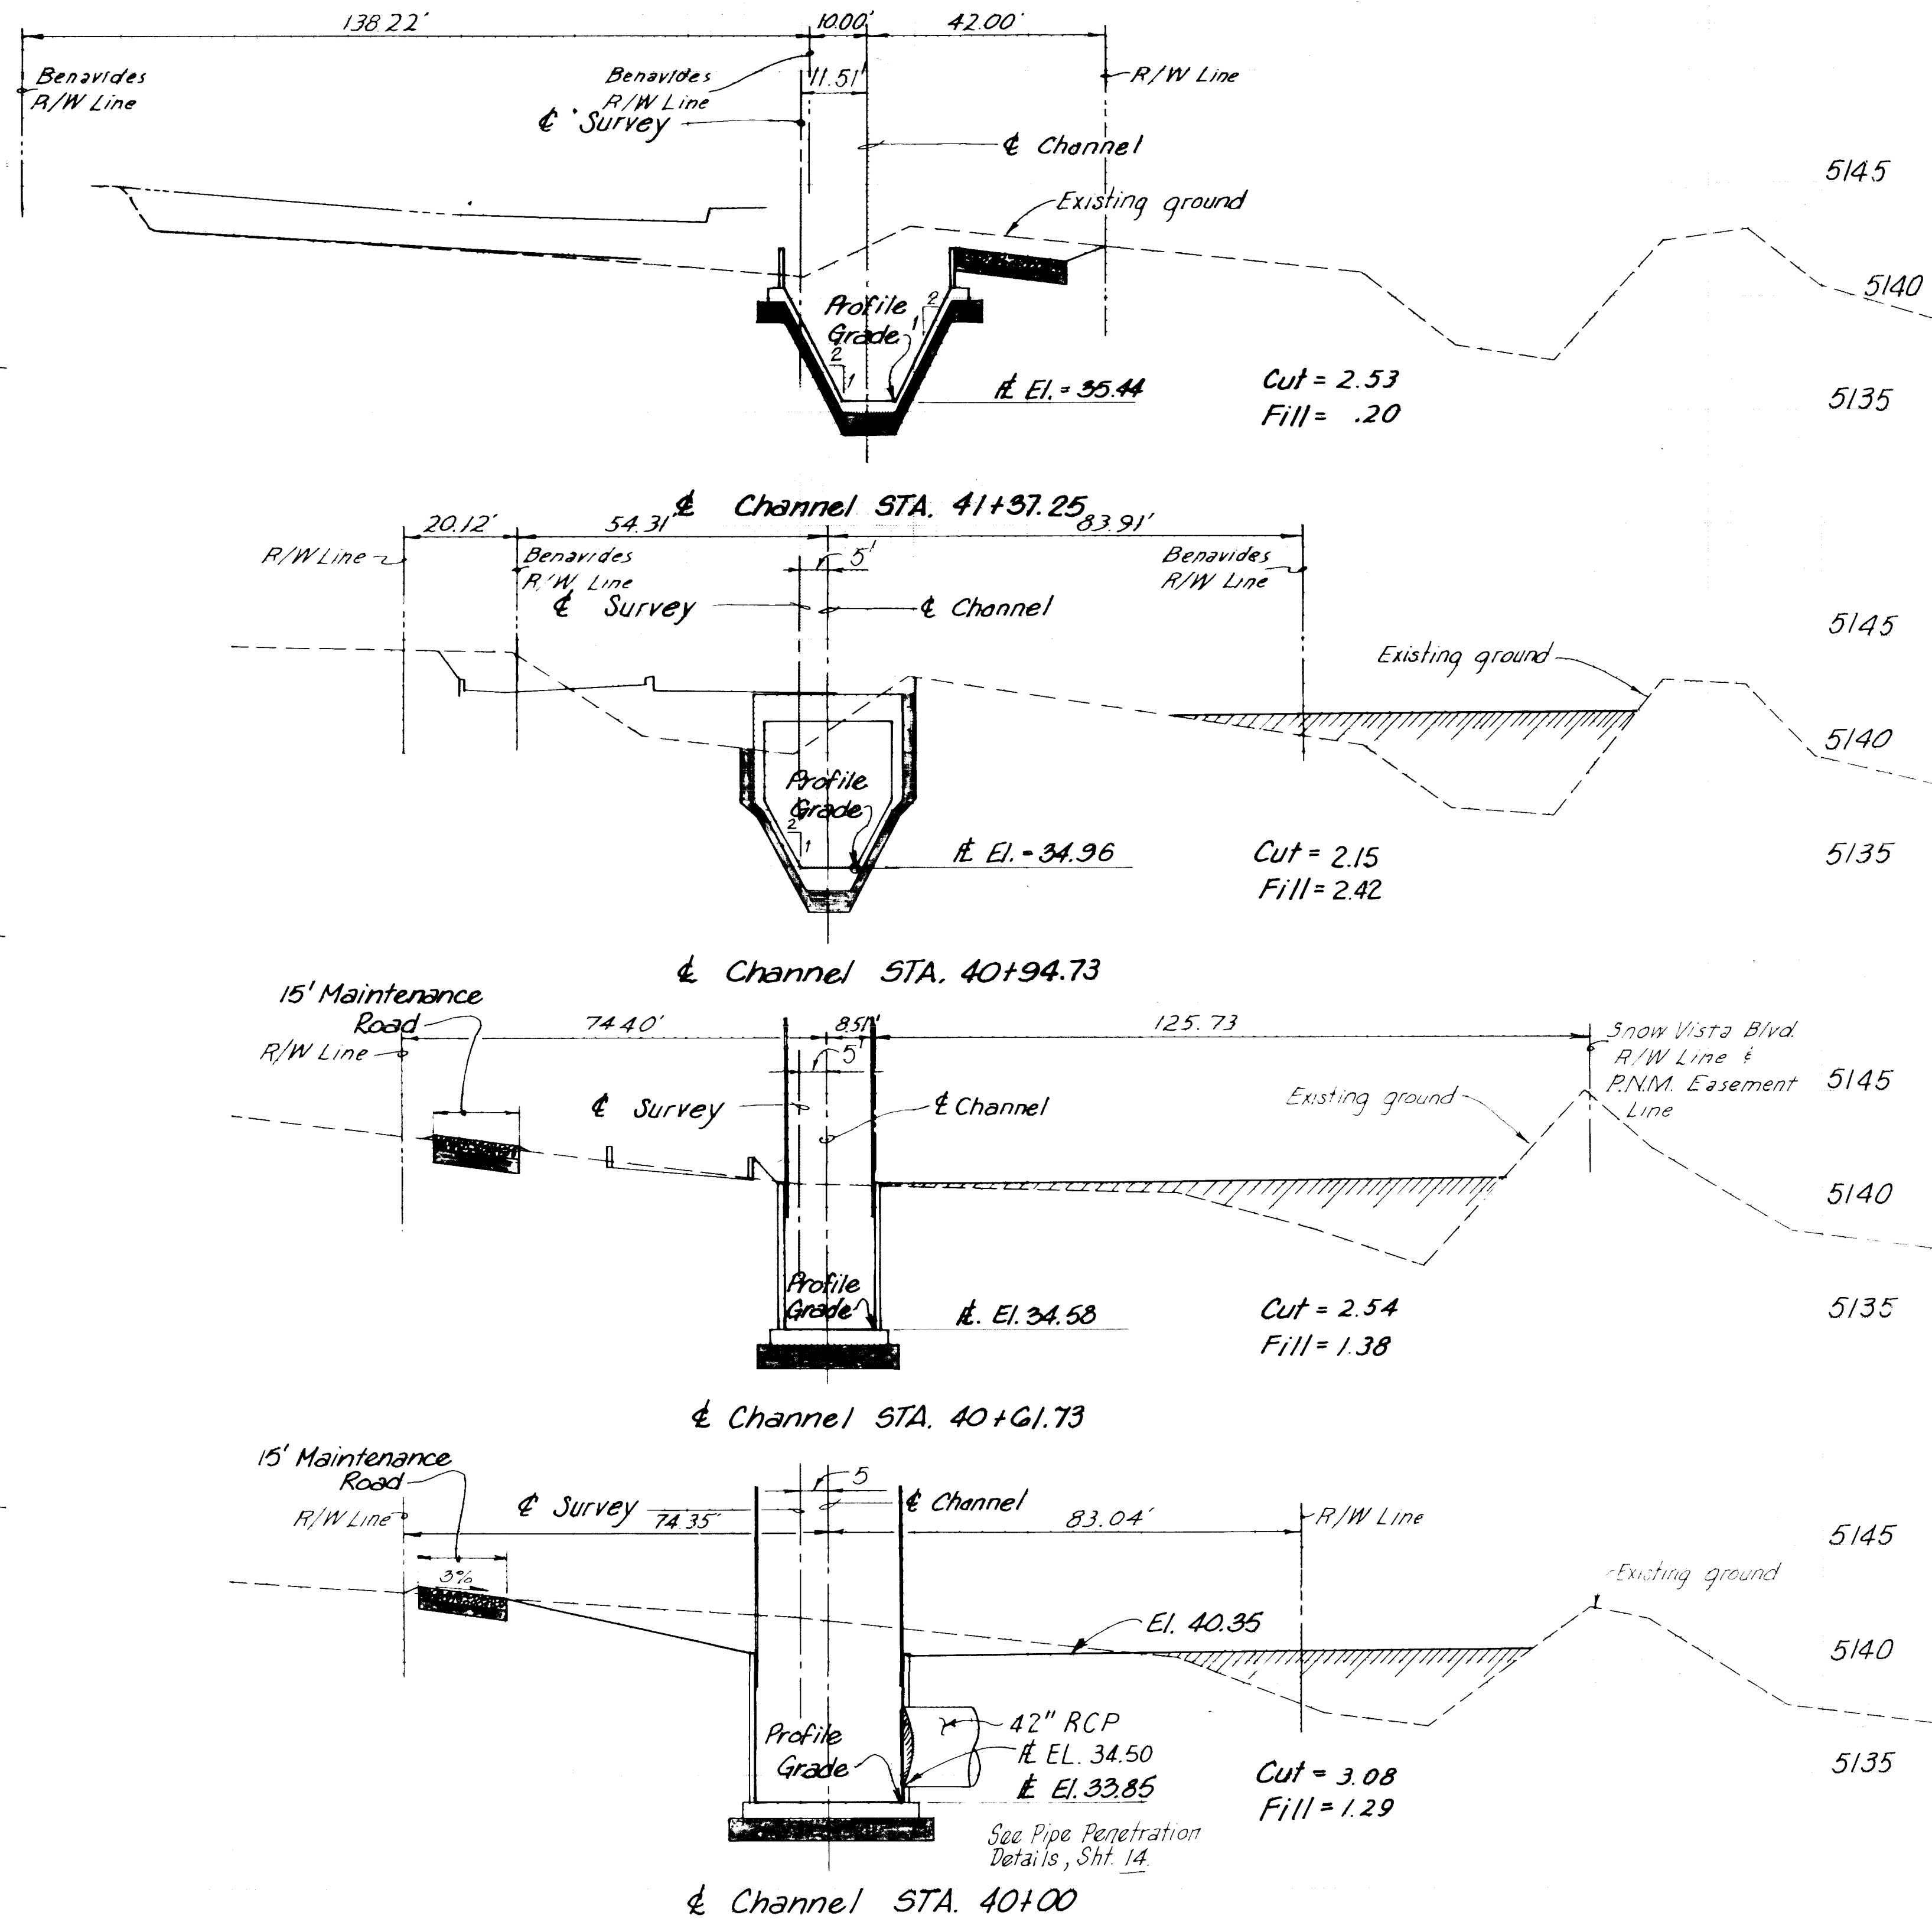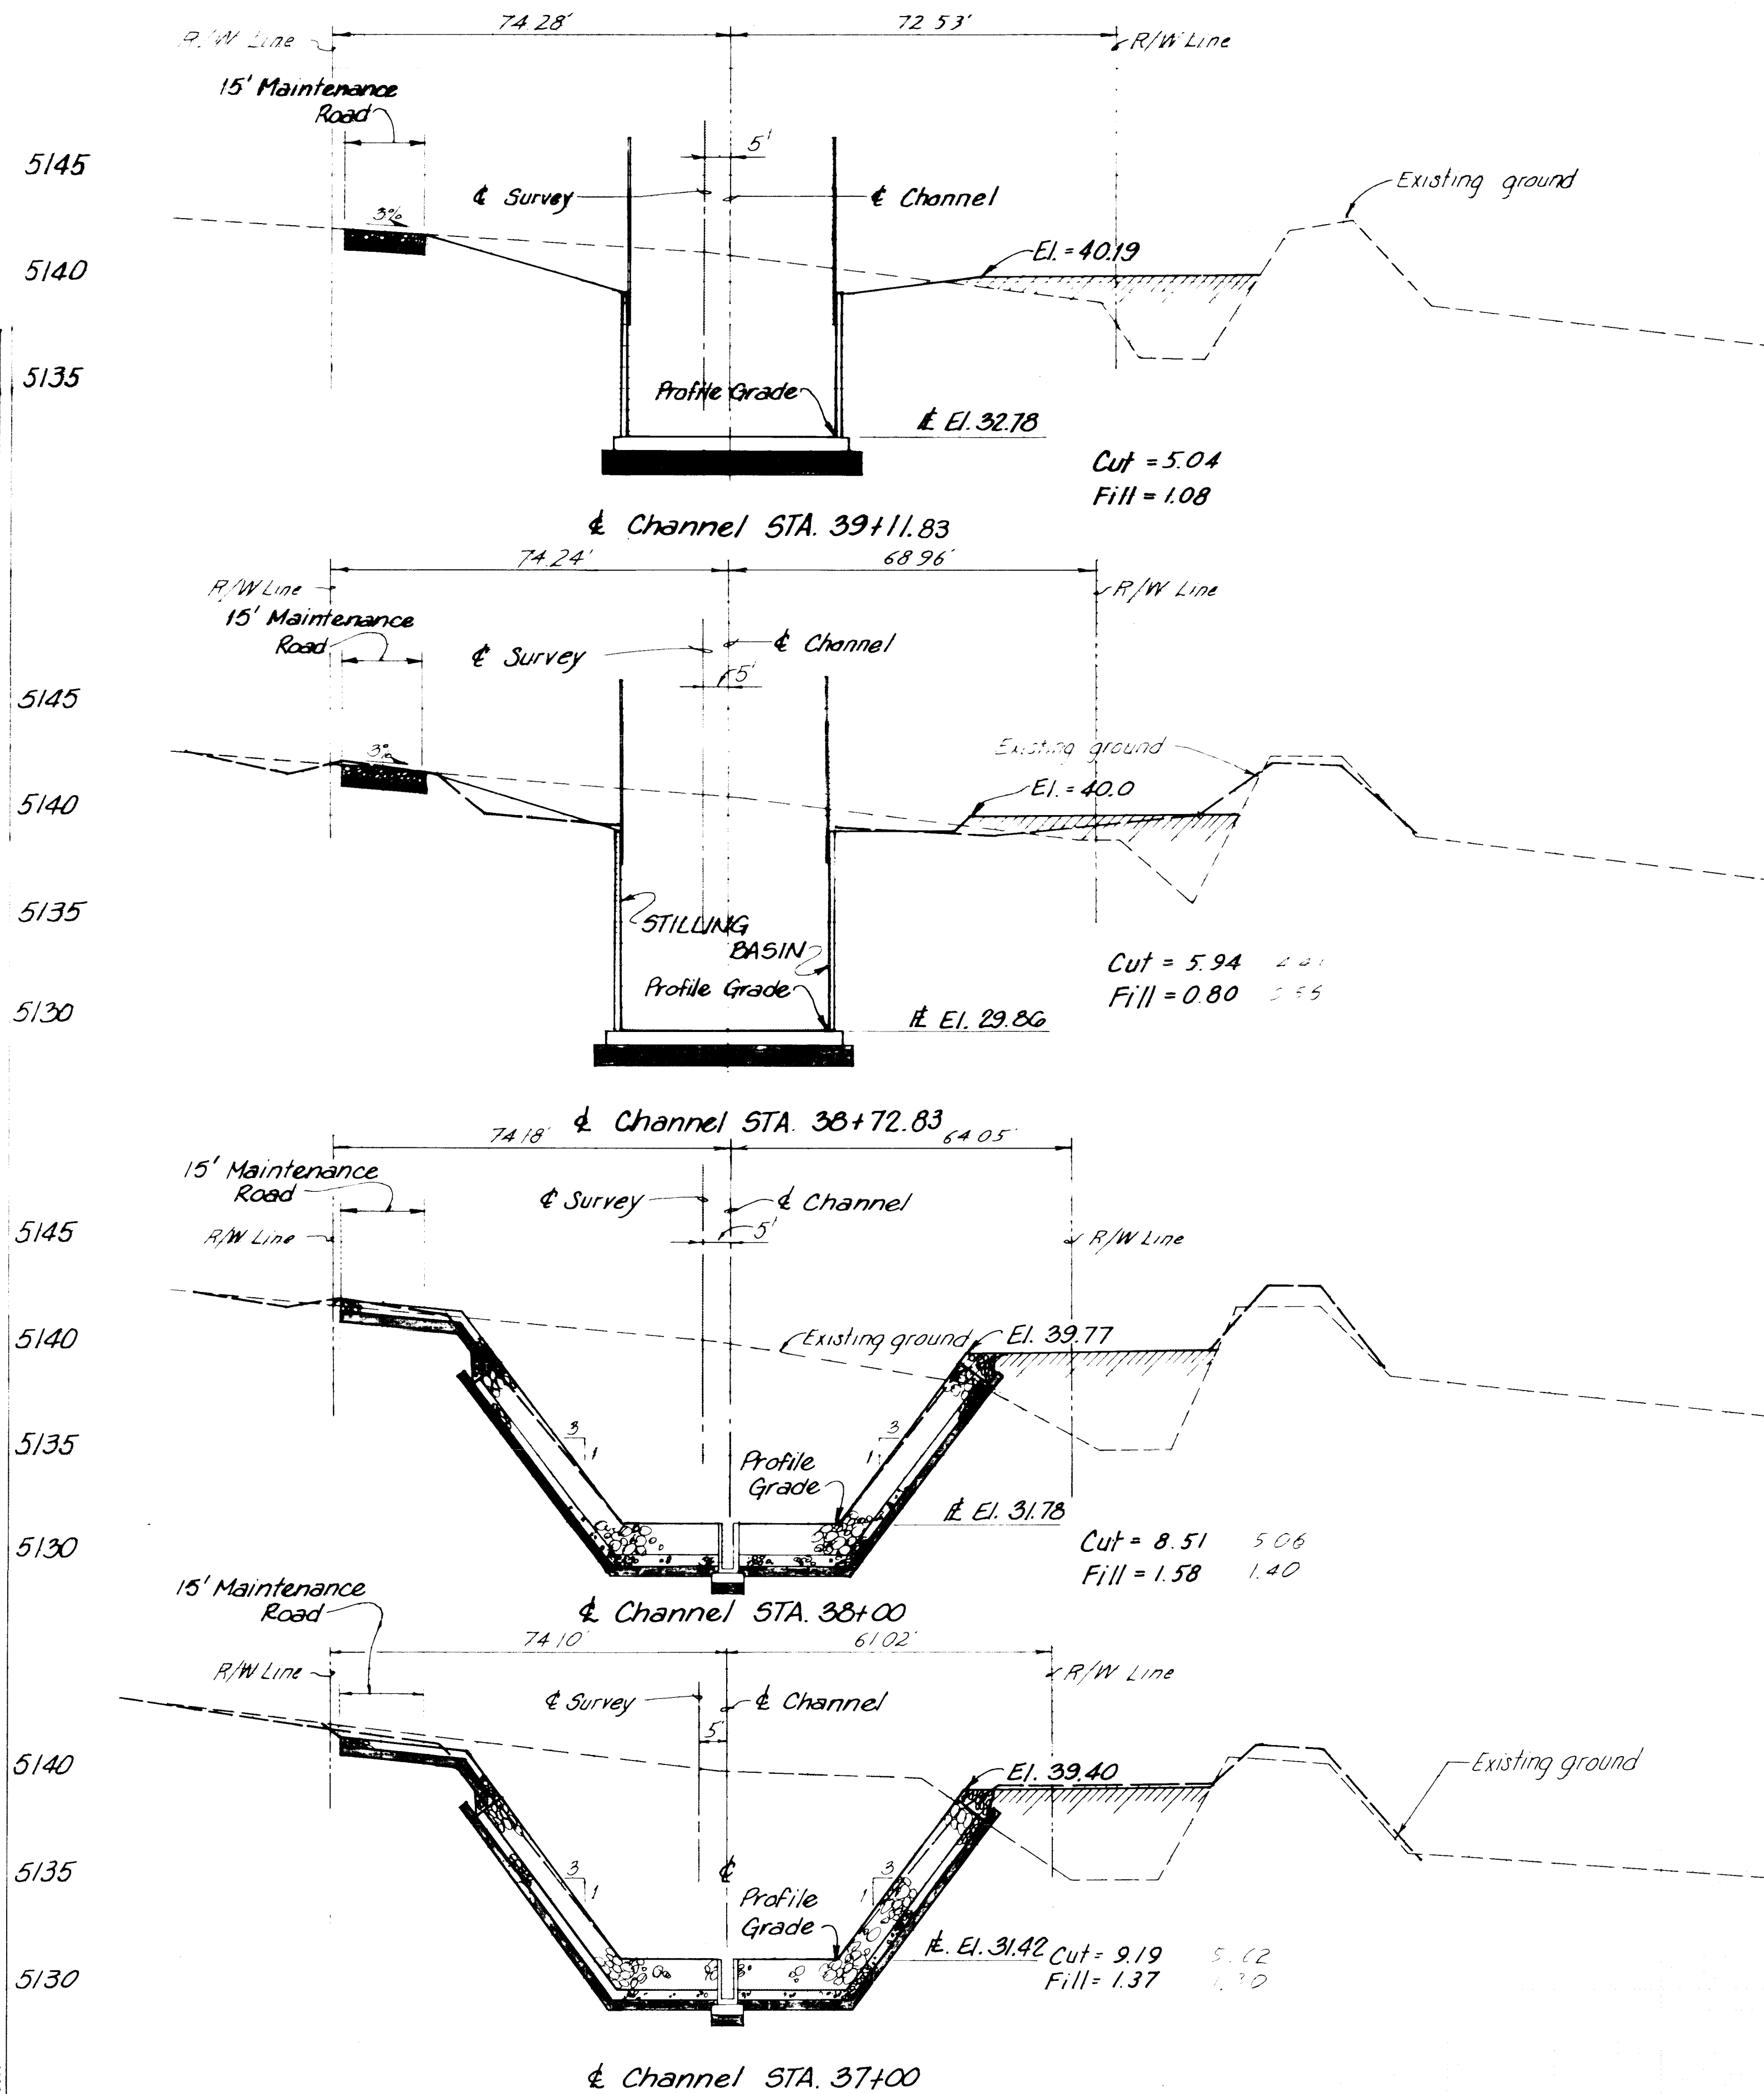


SCALE:
Horiz 1"=20'
Vert. 1"=5'

RECORD DRAWING

Date: JUL 10 1987

These drawings have been revised based on field data and every reasonable attempt has been made to depict construction as actually performed.

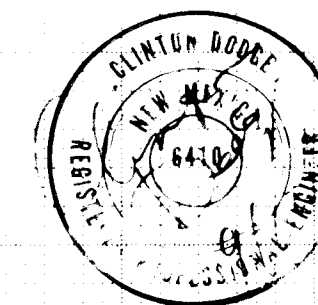

AMAFCA	
WESTGATE DIVERSION CHANNELS	
SNOW VISTA CHANNEL PHASE II	
CROSS SECTIONS	
STA. 37+00 TO STA. 41+37.25	
GORDON HERKENHOFF & ASSOCIATES, INC.	
ENGINEERS ARCHITECTS PLANNERS	
ALBUQUERQUE SANTA FE	
DRAWN BY	GC
DATE	SEPT 1986
SCALE	AS SHOWN

ORIGINAL SURVEY	SURVEYED _____	BY		DATE
	PLOTTED _____			
	TEMPLATE _____			
	AREAS _____			
	AREAS CHECKED _____			
NOTE BOOK				
NO.				

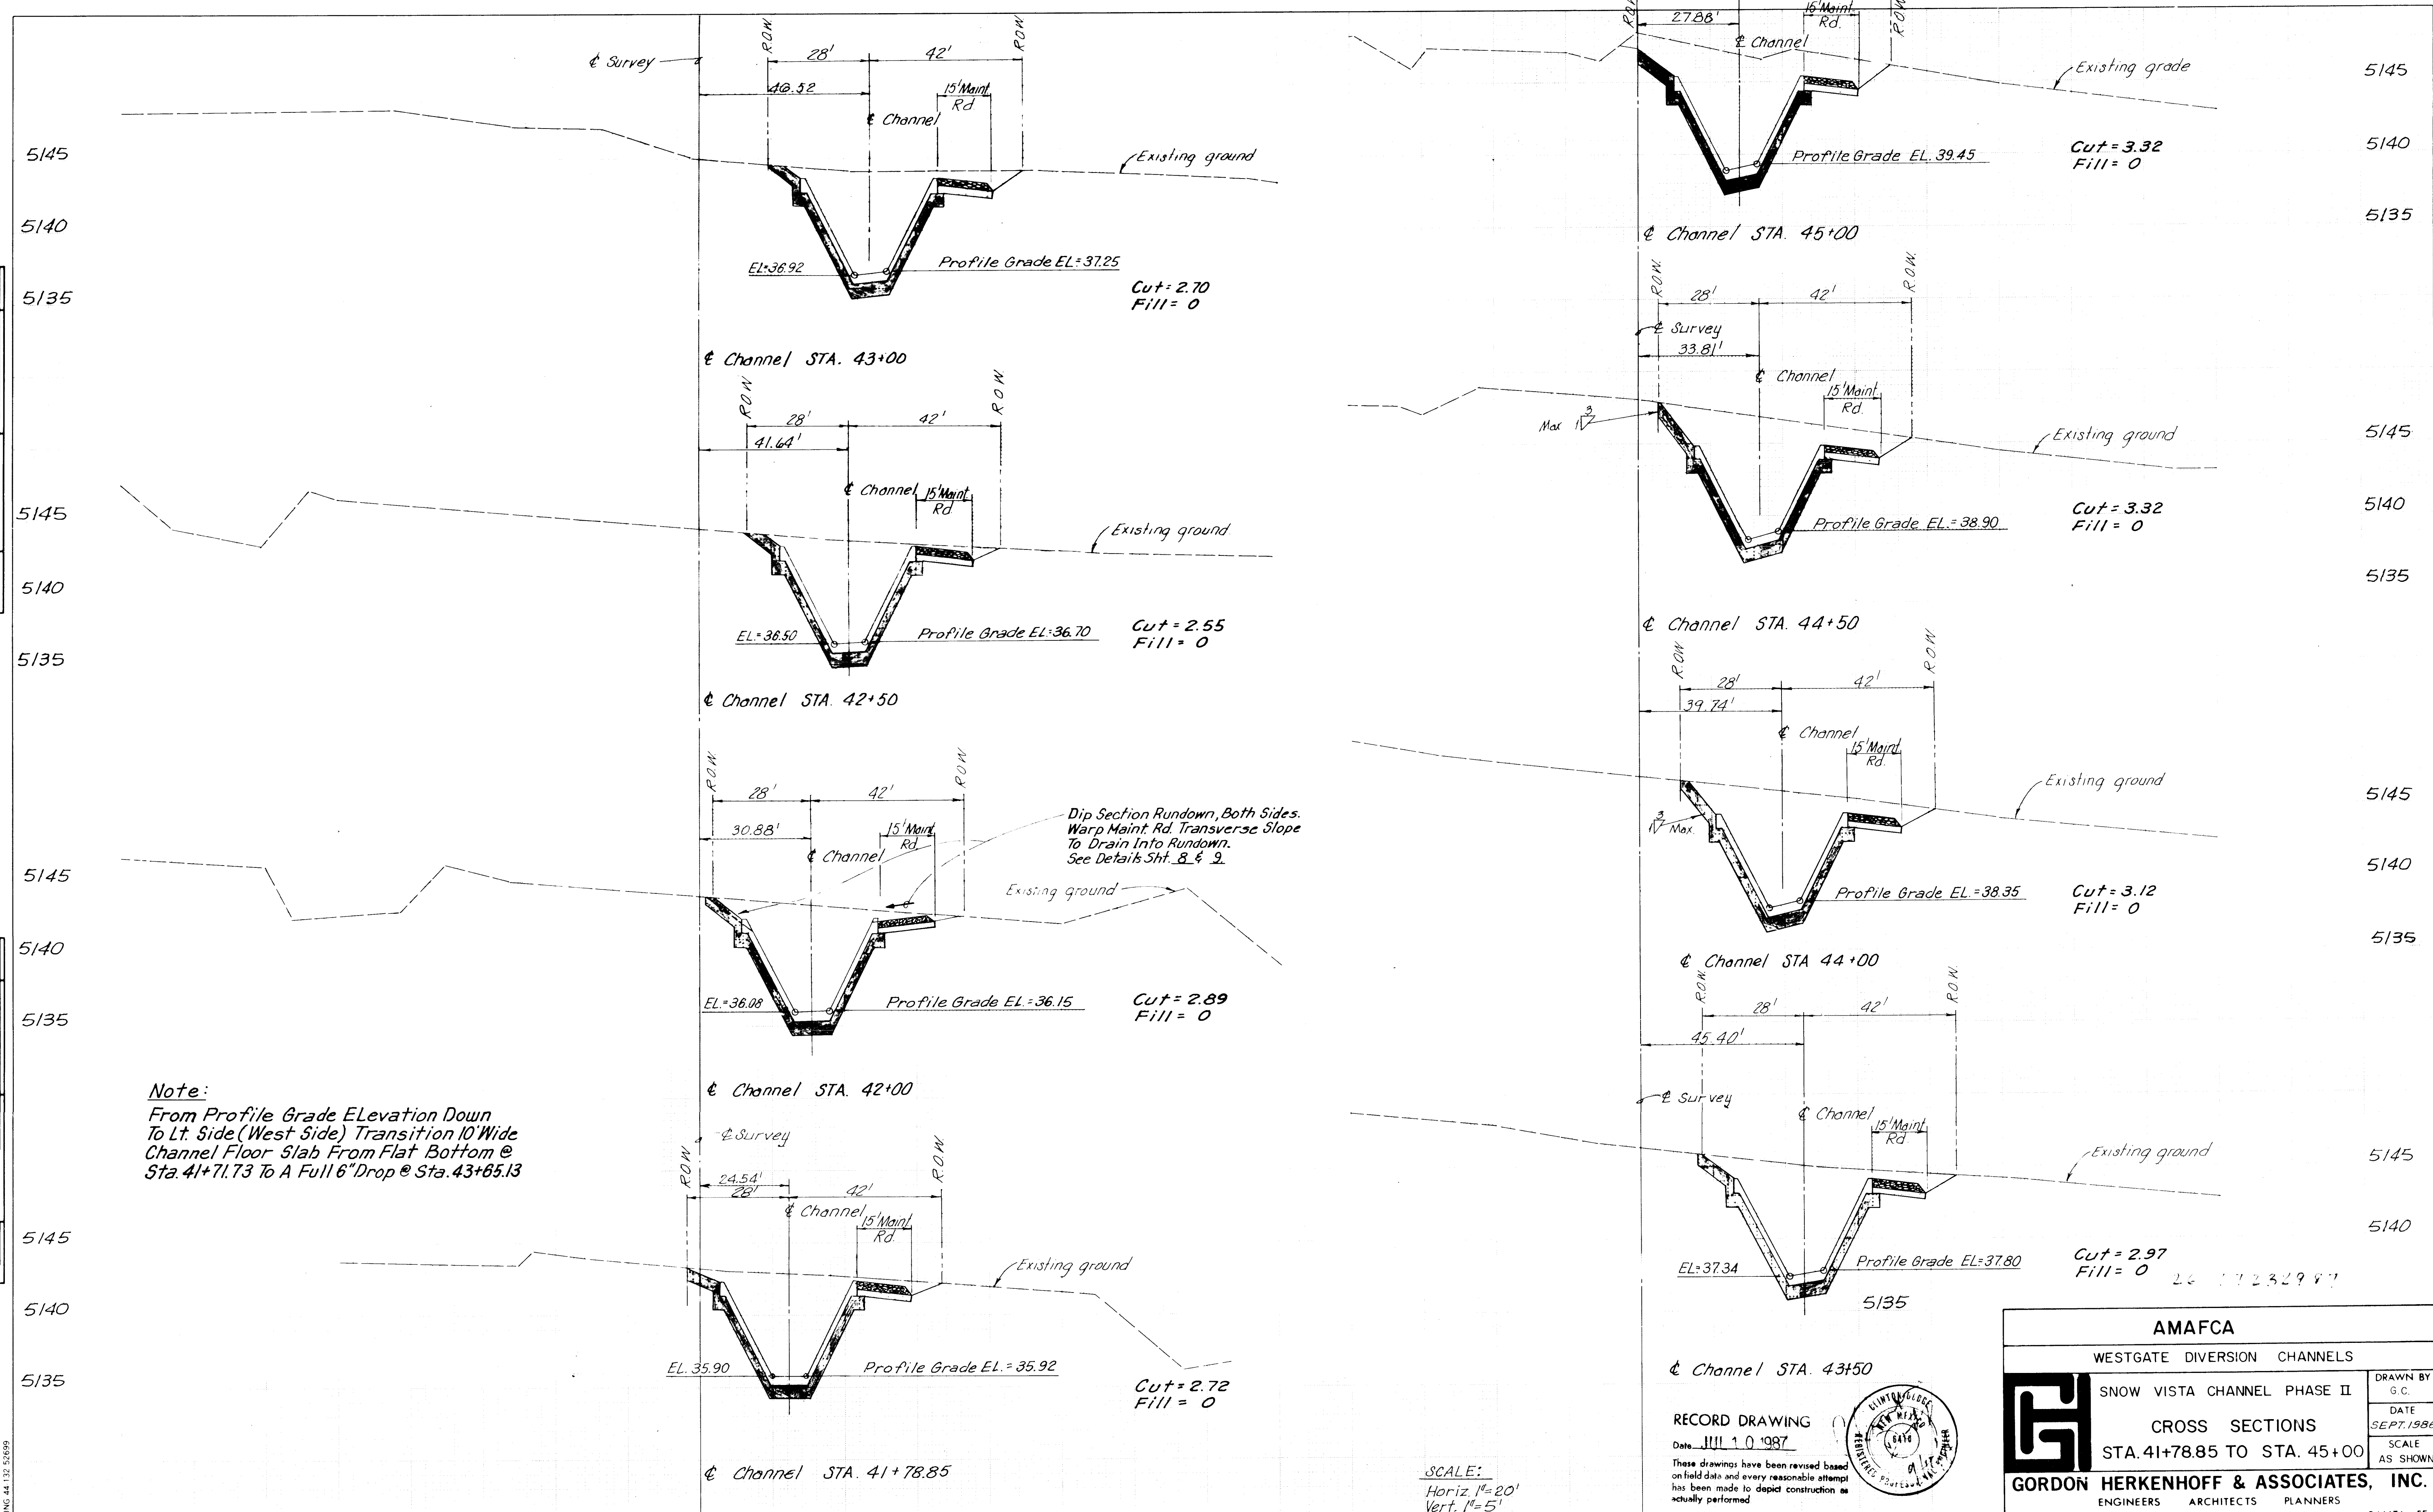



PLATE 3 CROSS SECTION - DOTTED
CHARLES BRUNING COMPANY
MADE IN U.S.A.

SCALE:
 Horiz. 1" = 20'
 Vert. 1" = 5'

RECORD DRAWING

Date JUL 10 1987

These drawings have been revised based on field data and every reasonable attempt has been made to depict construction as actually performed.

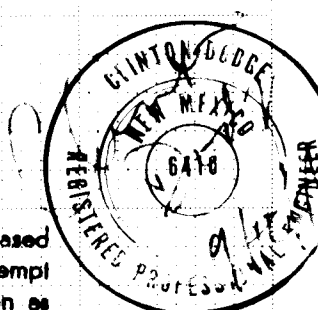

AMAFCA

WESTGATE DIVERSION CHANNELS

SNOW VISTA CHANNEL PHASE II

CROSS SECTIONS

STA. 41+78.85 TO STA. 45+00

GORDON HERKENHOFF & ASSOCIATES, INC.


ENGINEERS ARCHITECTS PLANNERS

ALBUQUERQUE

SANTA FE


FINAL	DATE
SURVEY	BY
NOTED	BY
BOOK	NO.
NO.	

ORIGINAL	DATE
SURVEY	BY
NOTED	BY
BOOK	NO.
NO.	

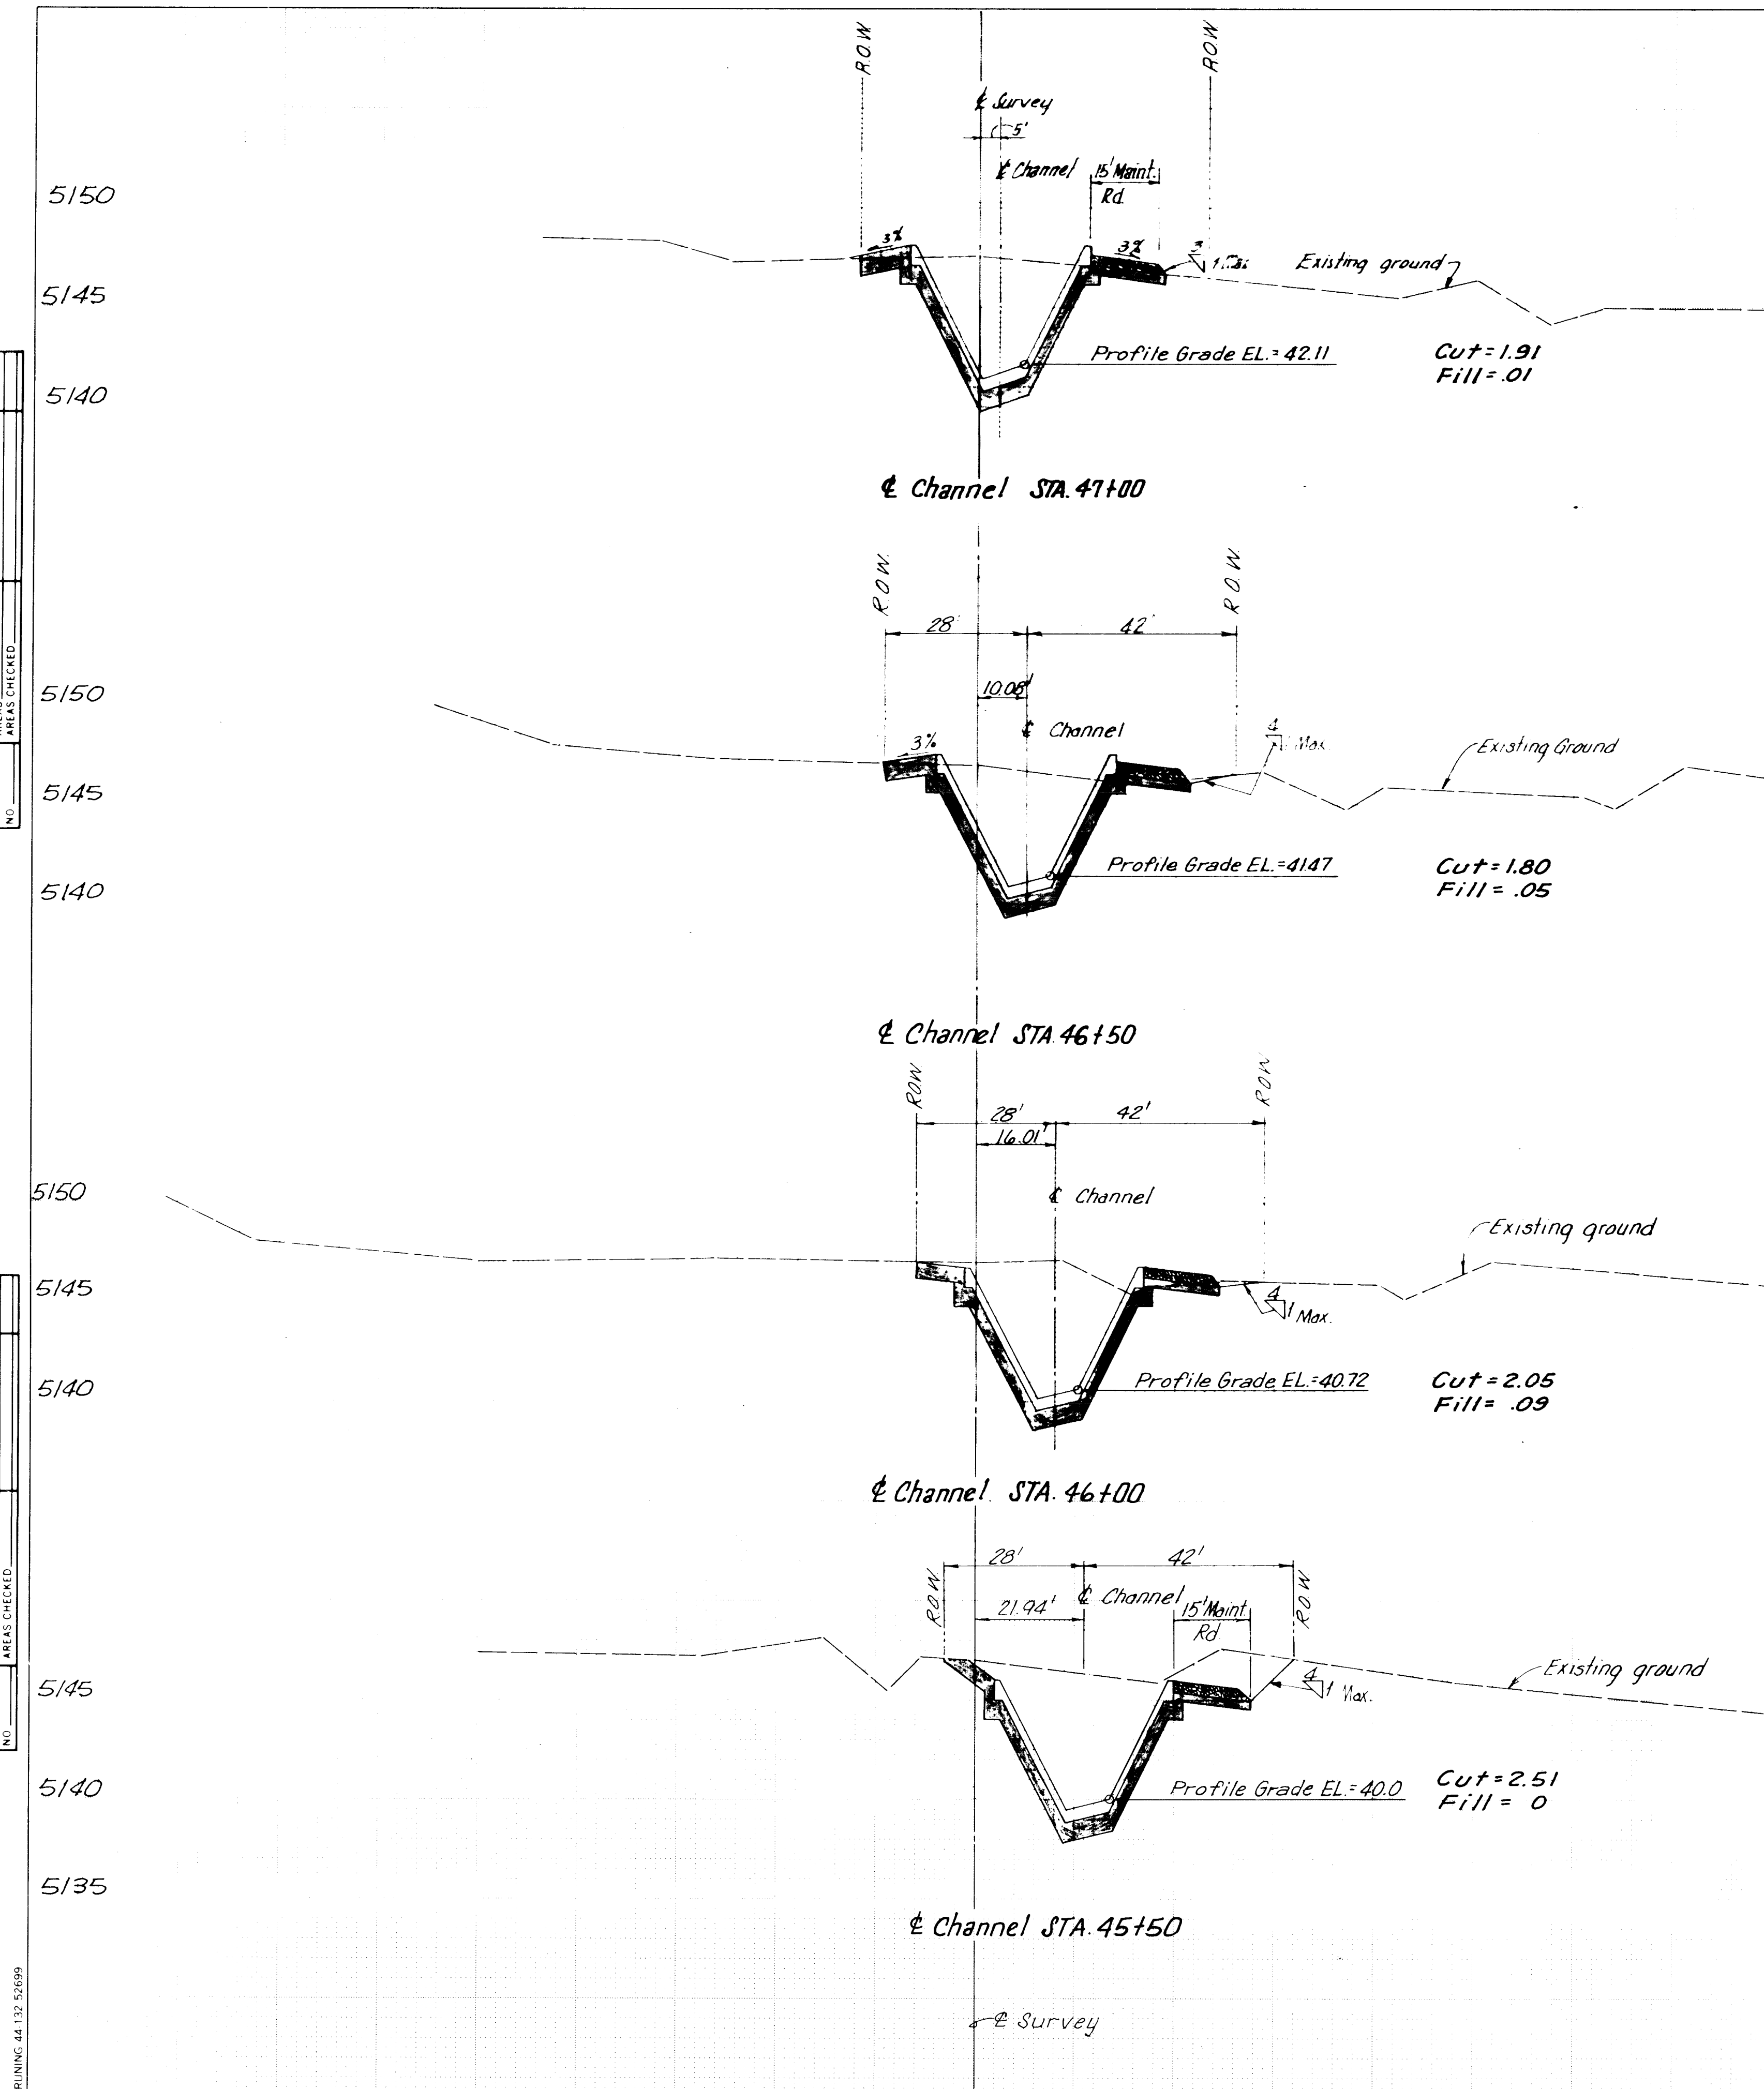

Dip Section Rundown,
This Side Only.
See Sht. 8 & 9.


SCALE:
Horiz. 1"=20'
Vert. 1"=5'

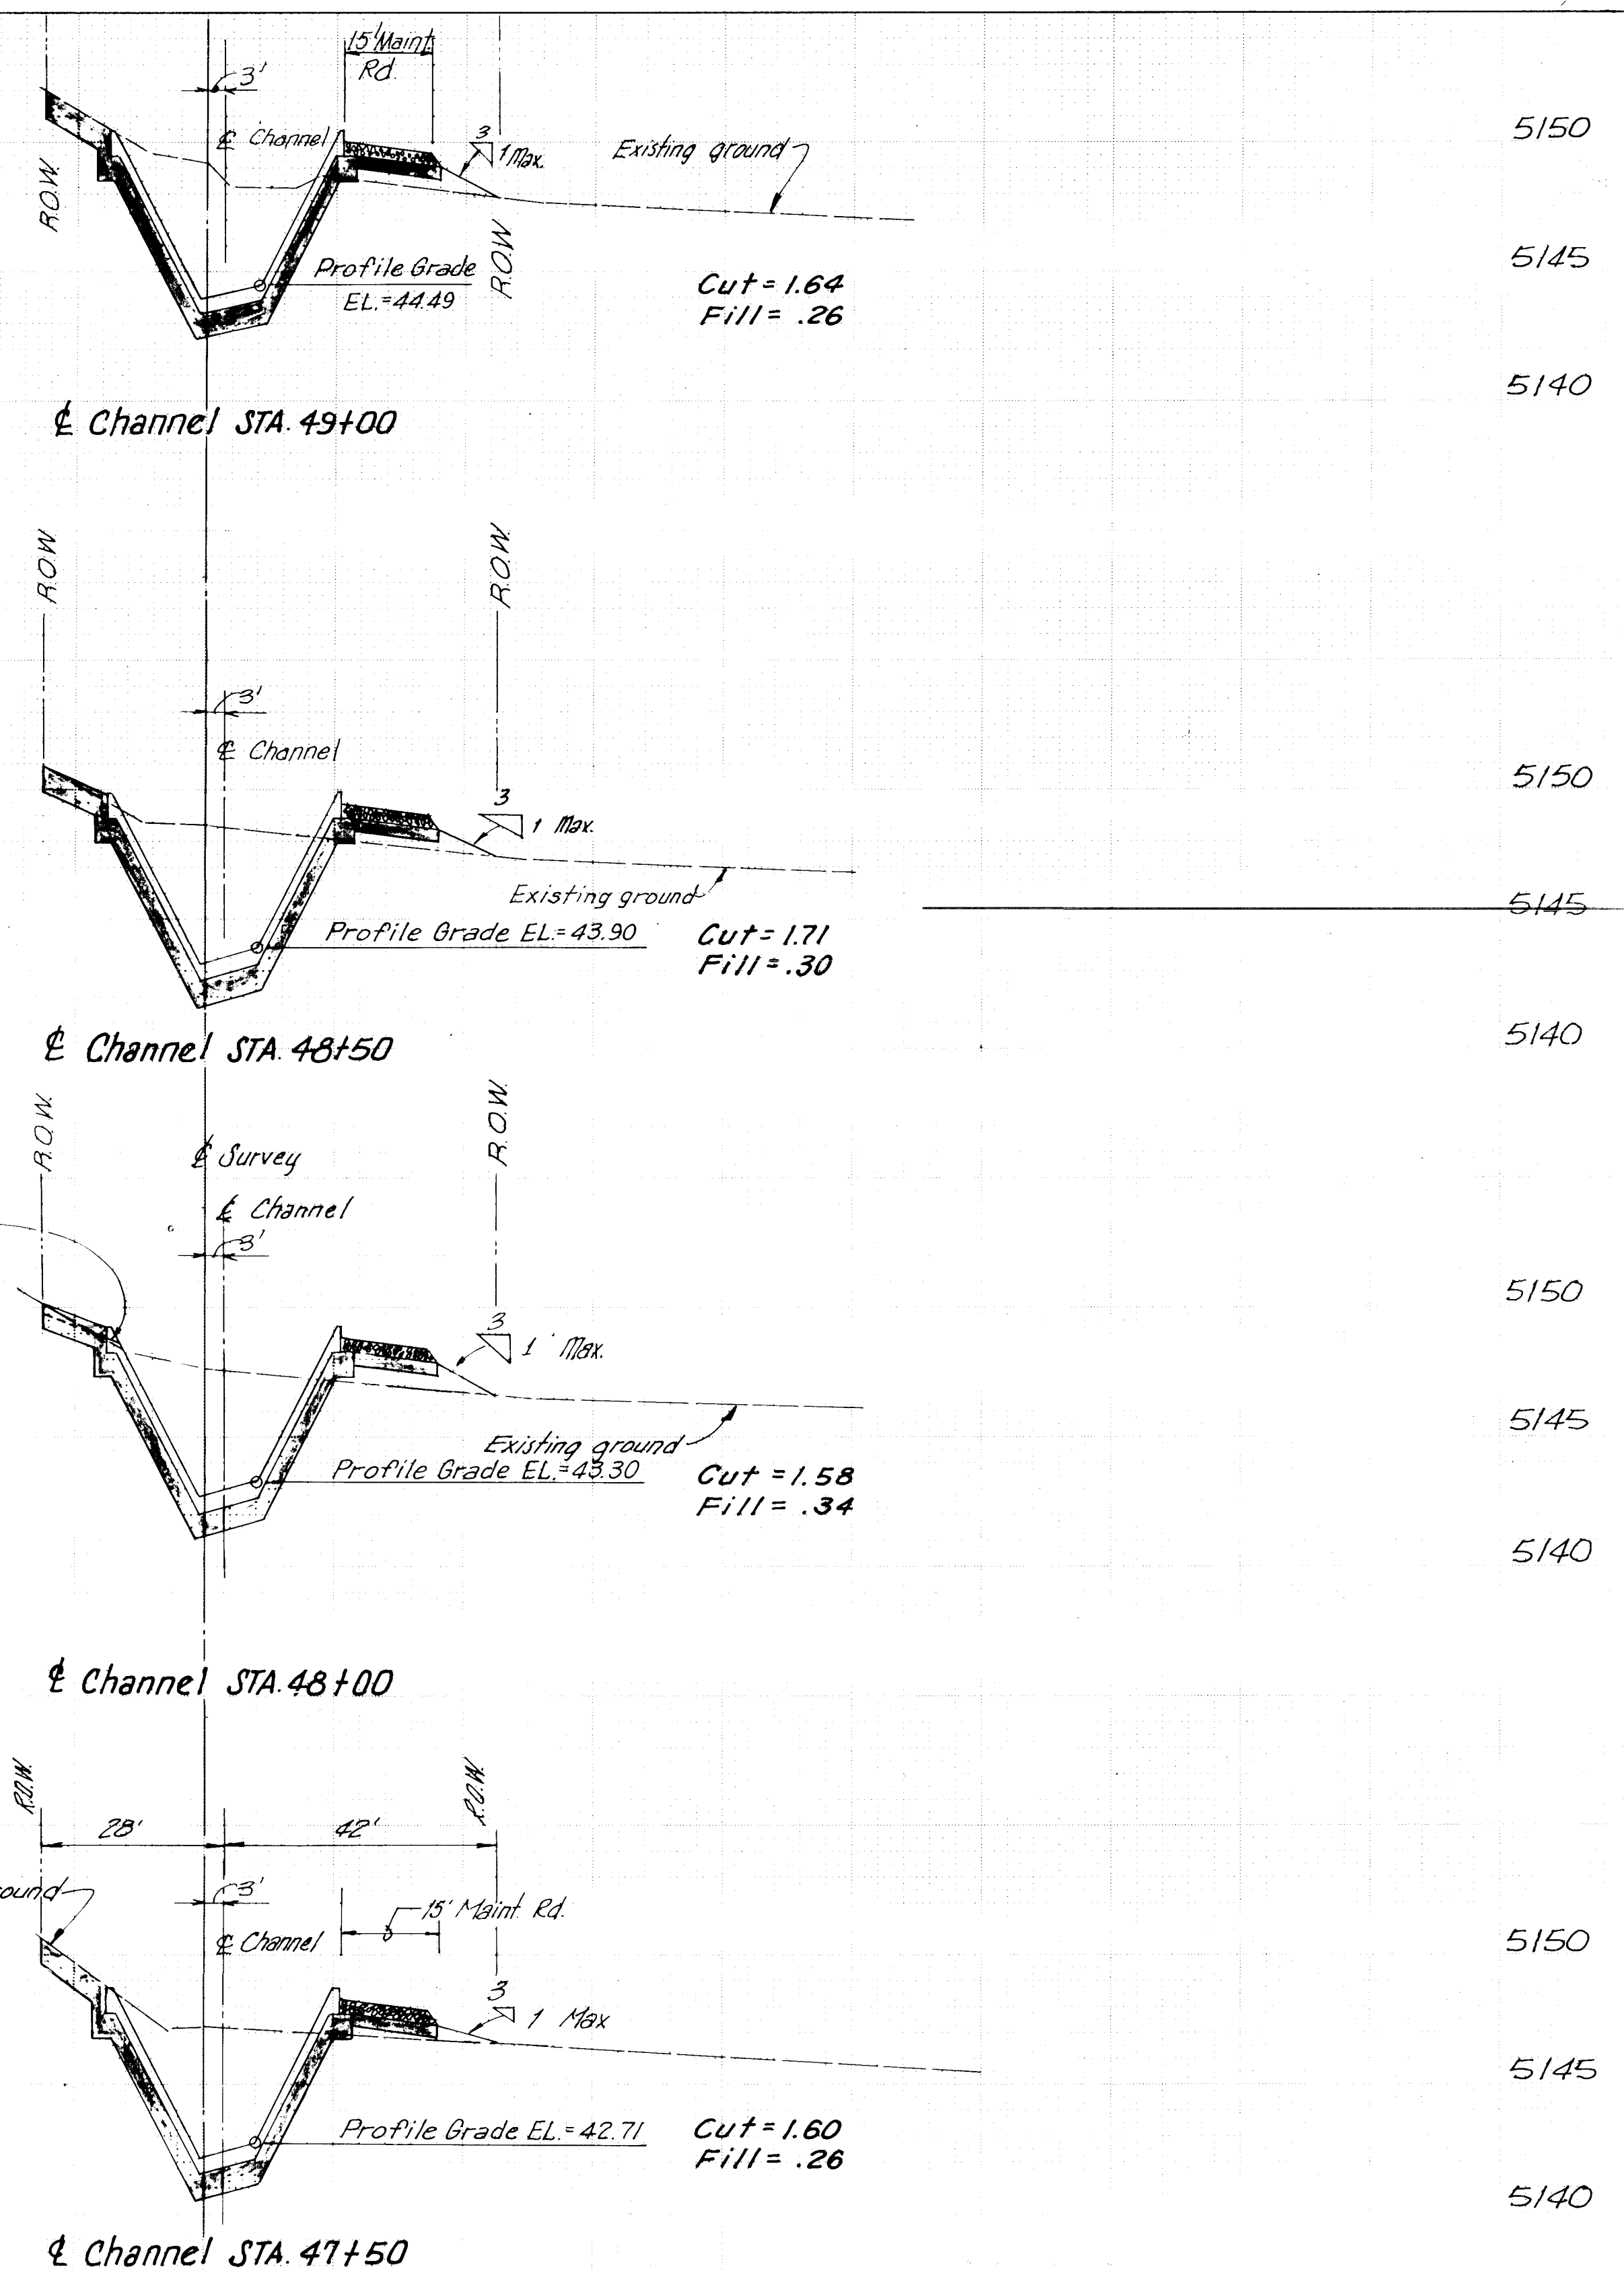

RECORD DRAWING



Date: 11/11/1987

These drawings have been revised based
on field data and every reasonable attempt
has been made to depict construction as
actually performed.

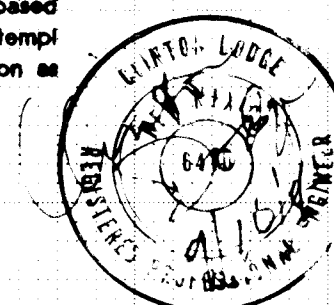

26 17233087

AMAFCA	
WESTGATE DIVERSION CHANNELS	
	SNOW VISTA CHANNEL PHASE II
	CROSS SECTIONS
	STA. 45+50 TO STA. 49+00
	GORDON HERKENHOFF & ASSOCIATES, INC.
ENGINEERS ARCHITECTS PLANNERS	SANTA FE

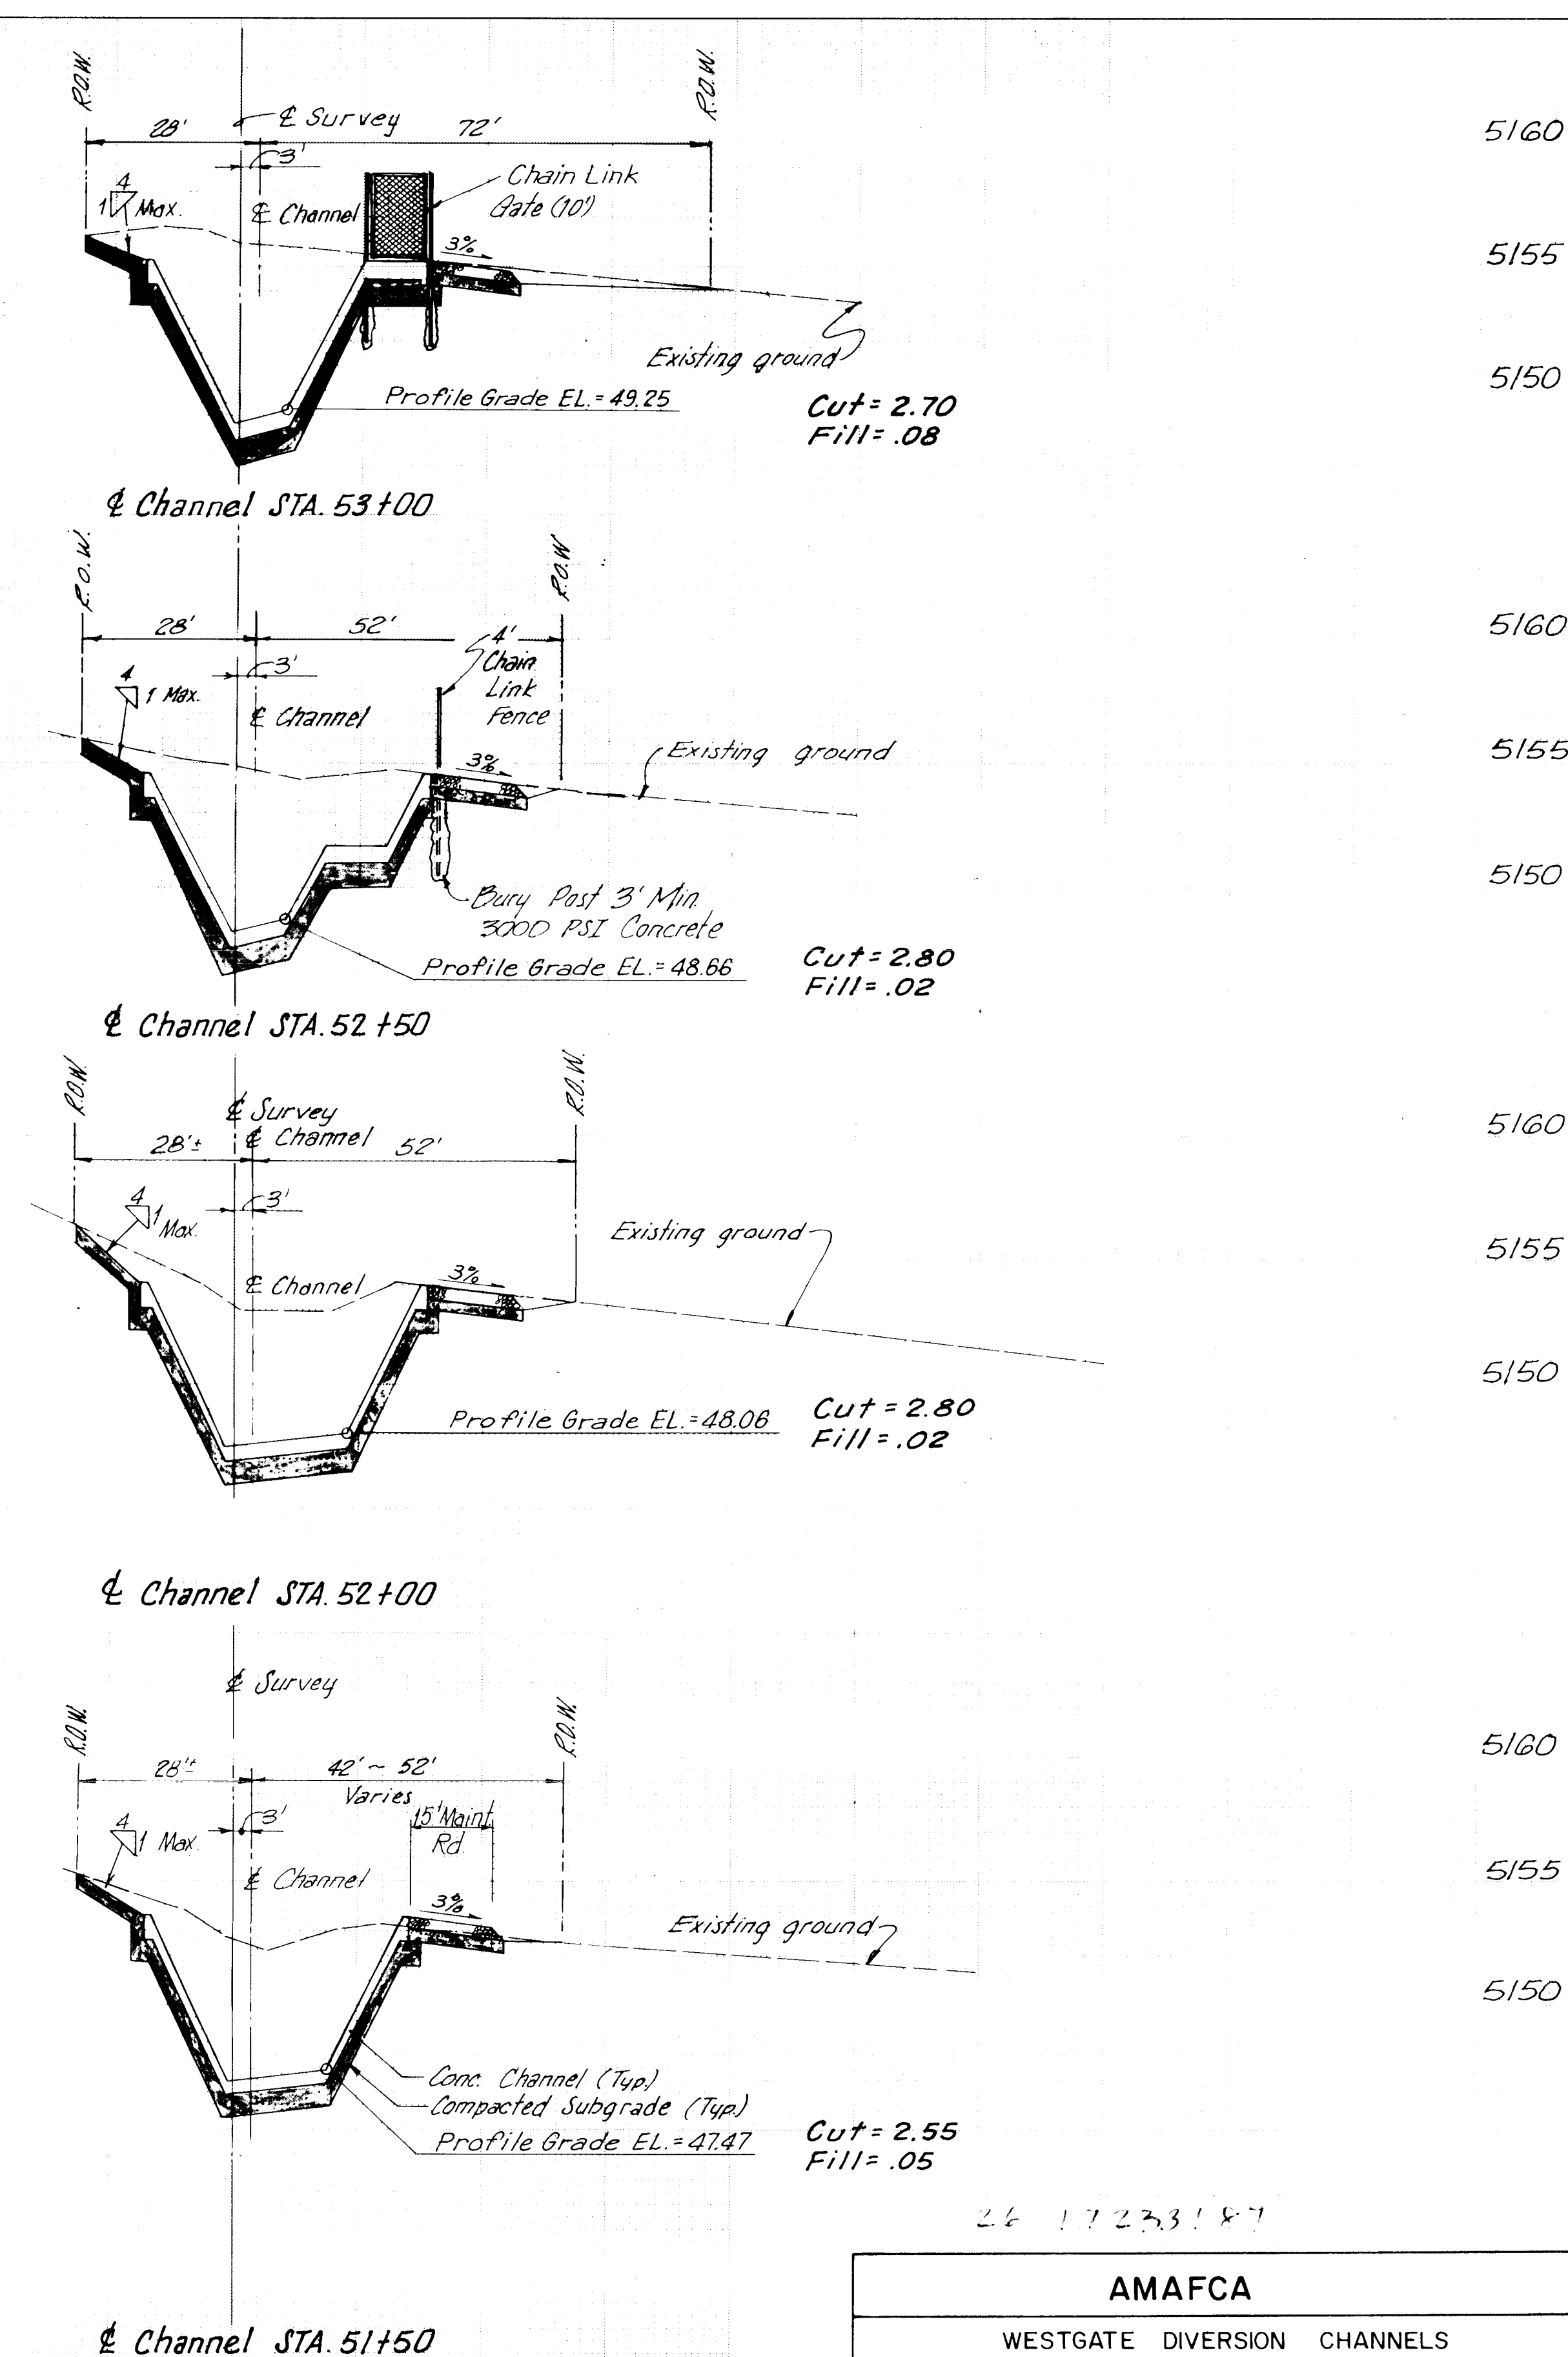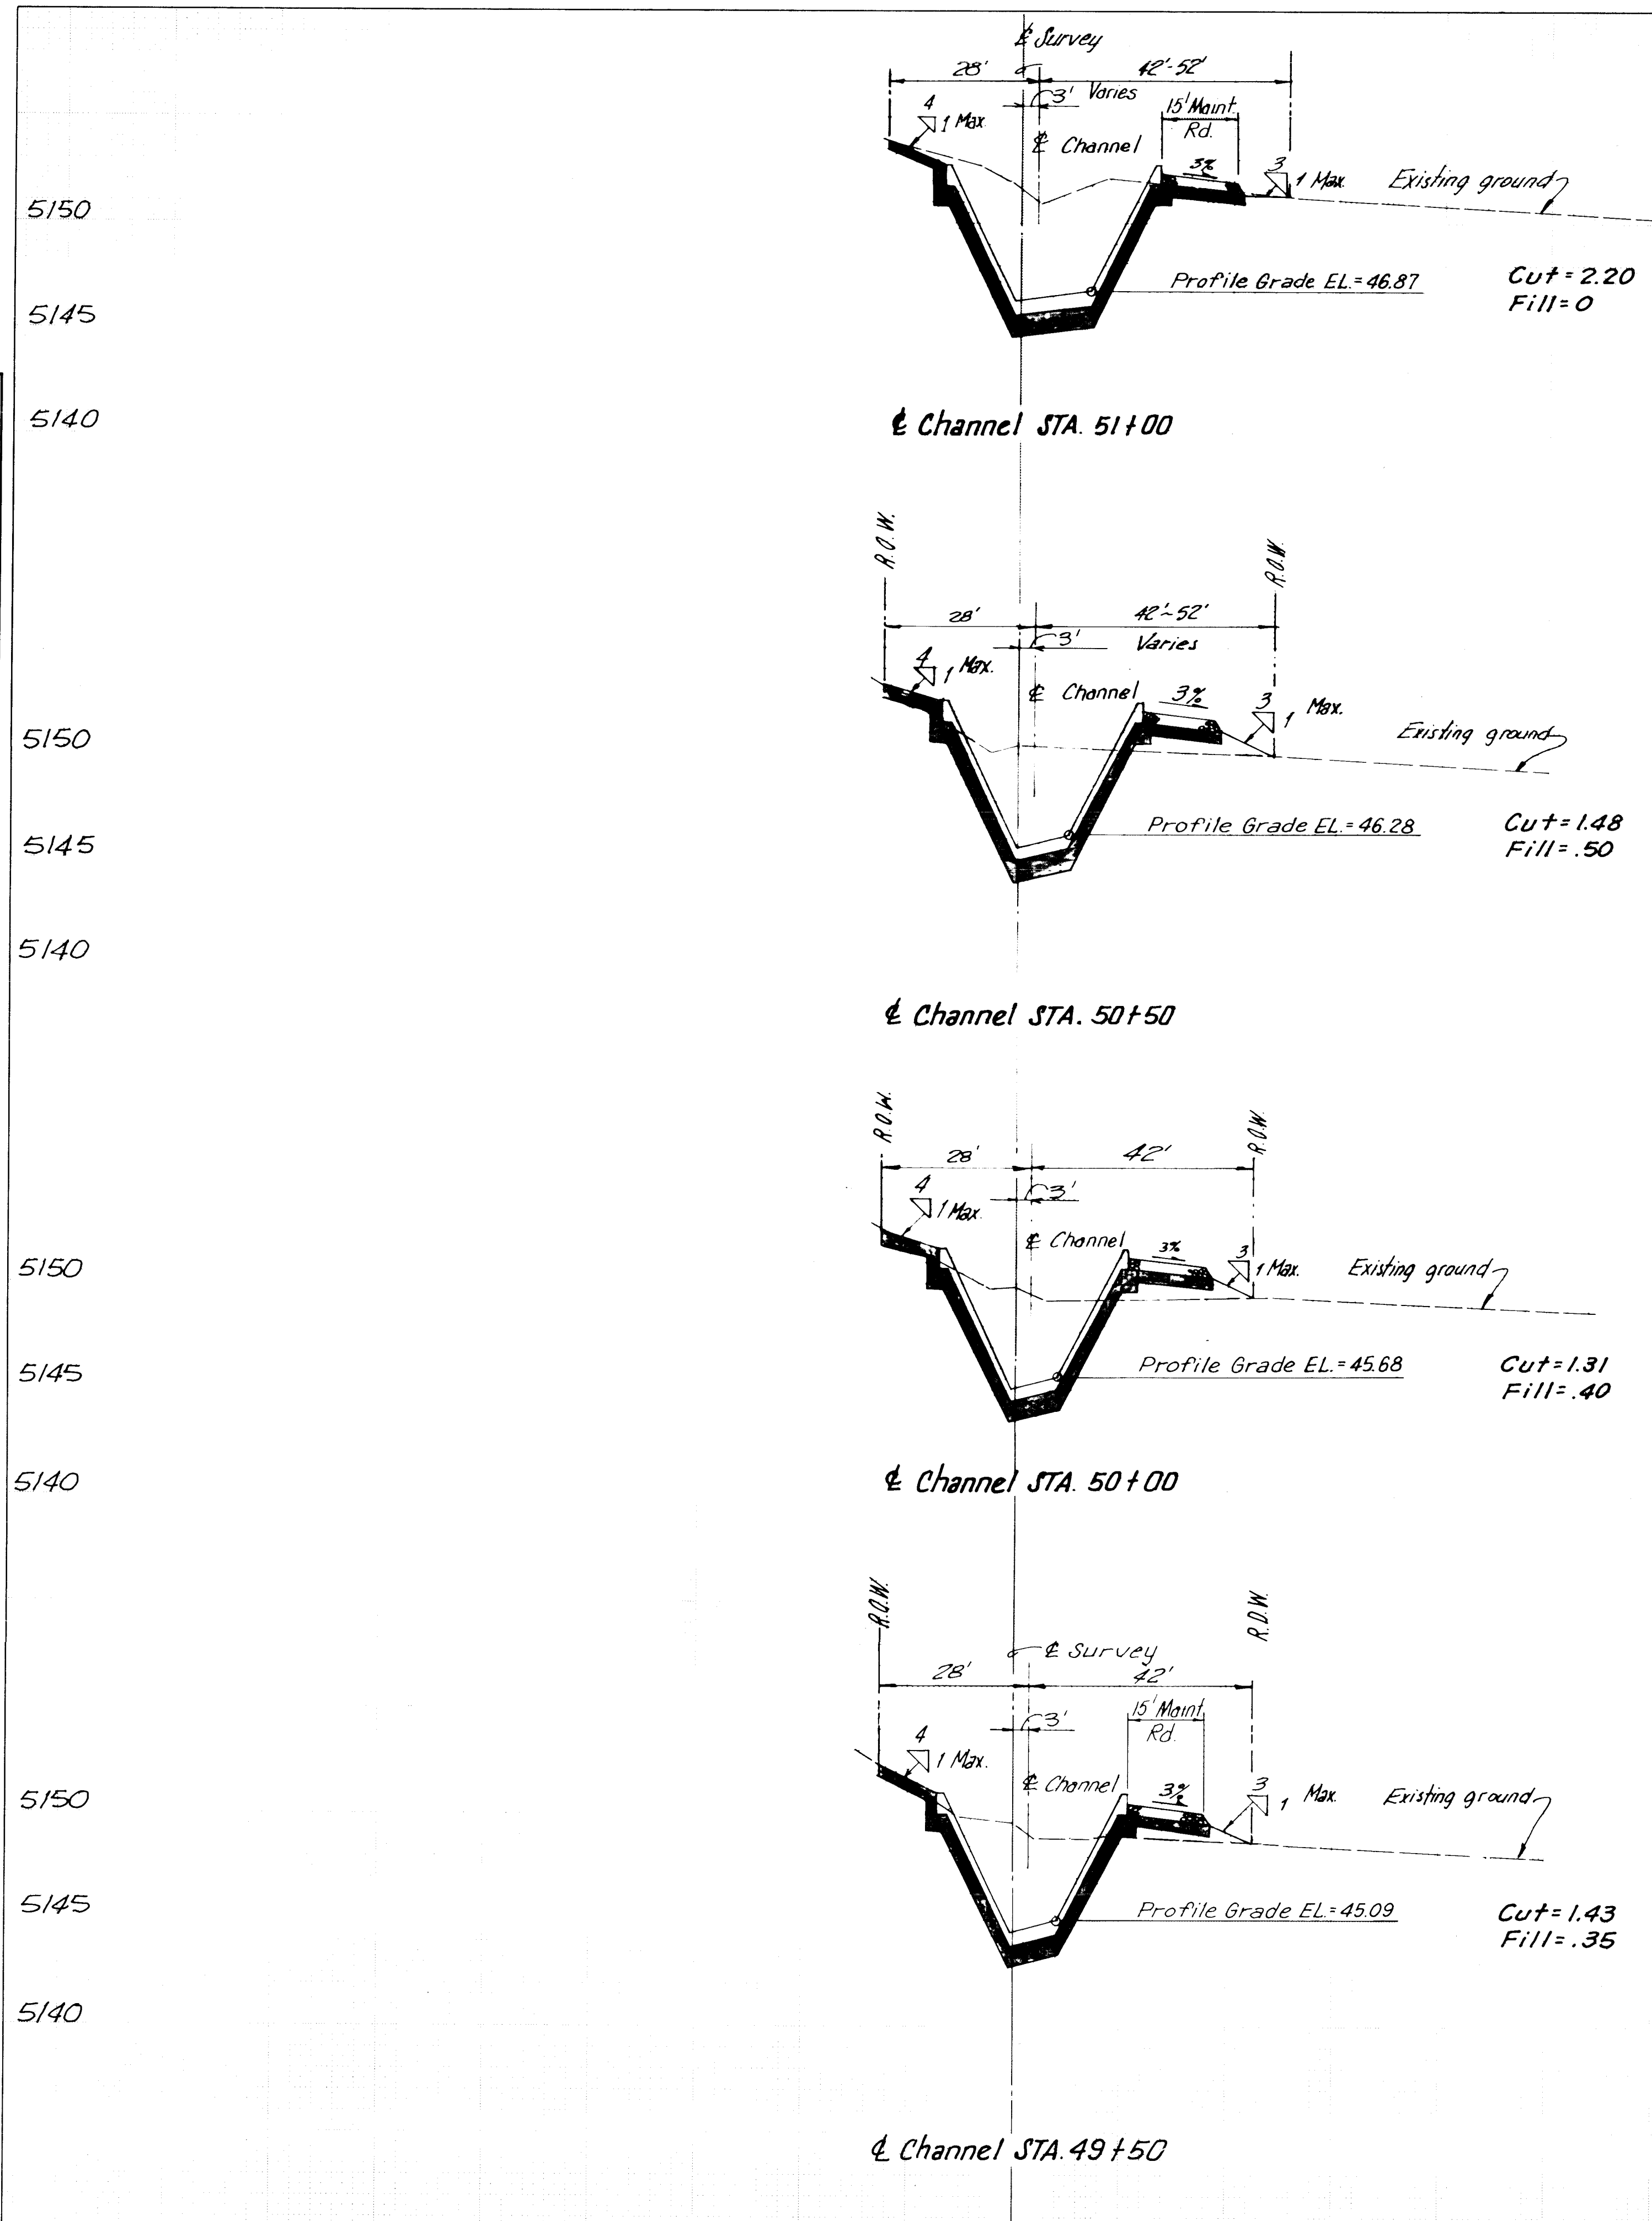[illegible]

26 1723.3187

AMAFCA

WESTGATE DIVERSION CHANNELS

SNOW VISTA CHANNEL PHASE II

CROSS SECTIONS

STA. 49+50 TO STA. 53+00

GORDON HERKENHOFF & ASSOCIATES, INC.


ENGINEERS ARCHITECTS PLANNERS
ALBUQUERQUE SANTA FE

SANTA FE

RECORD DRAWING

Date III 1 10 1907



These drawings have been revised based on field data and every reasonable attempt has been made to depict construction as actually performed.

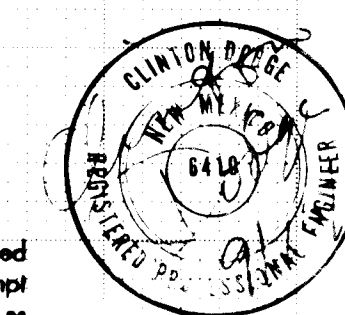

SCALE:
 Horiz. 1" = 20'
 Vert. 1" = 5'

PLATE 3 CROSS SECTION - DOTTED
CHARLES BRUNING COMPANY
MADE IN U.S.A.


ORIGINAL			
SURVEY	SURVEYED _____	BY _____	DATE _____
NOTE BOOK	PLOTTED _____		
	TEMPLATE _____		
	AREAS _____		
	AREAS CHECKED _____		
NO _____			

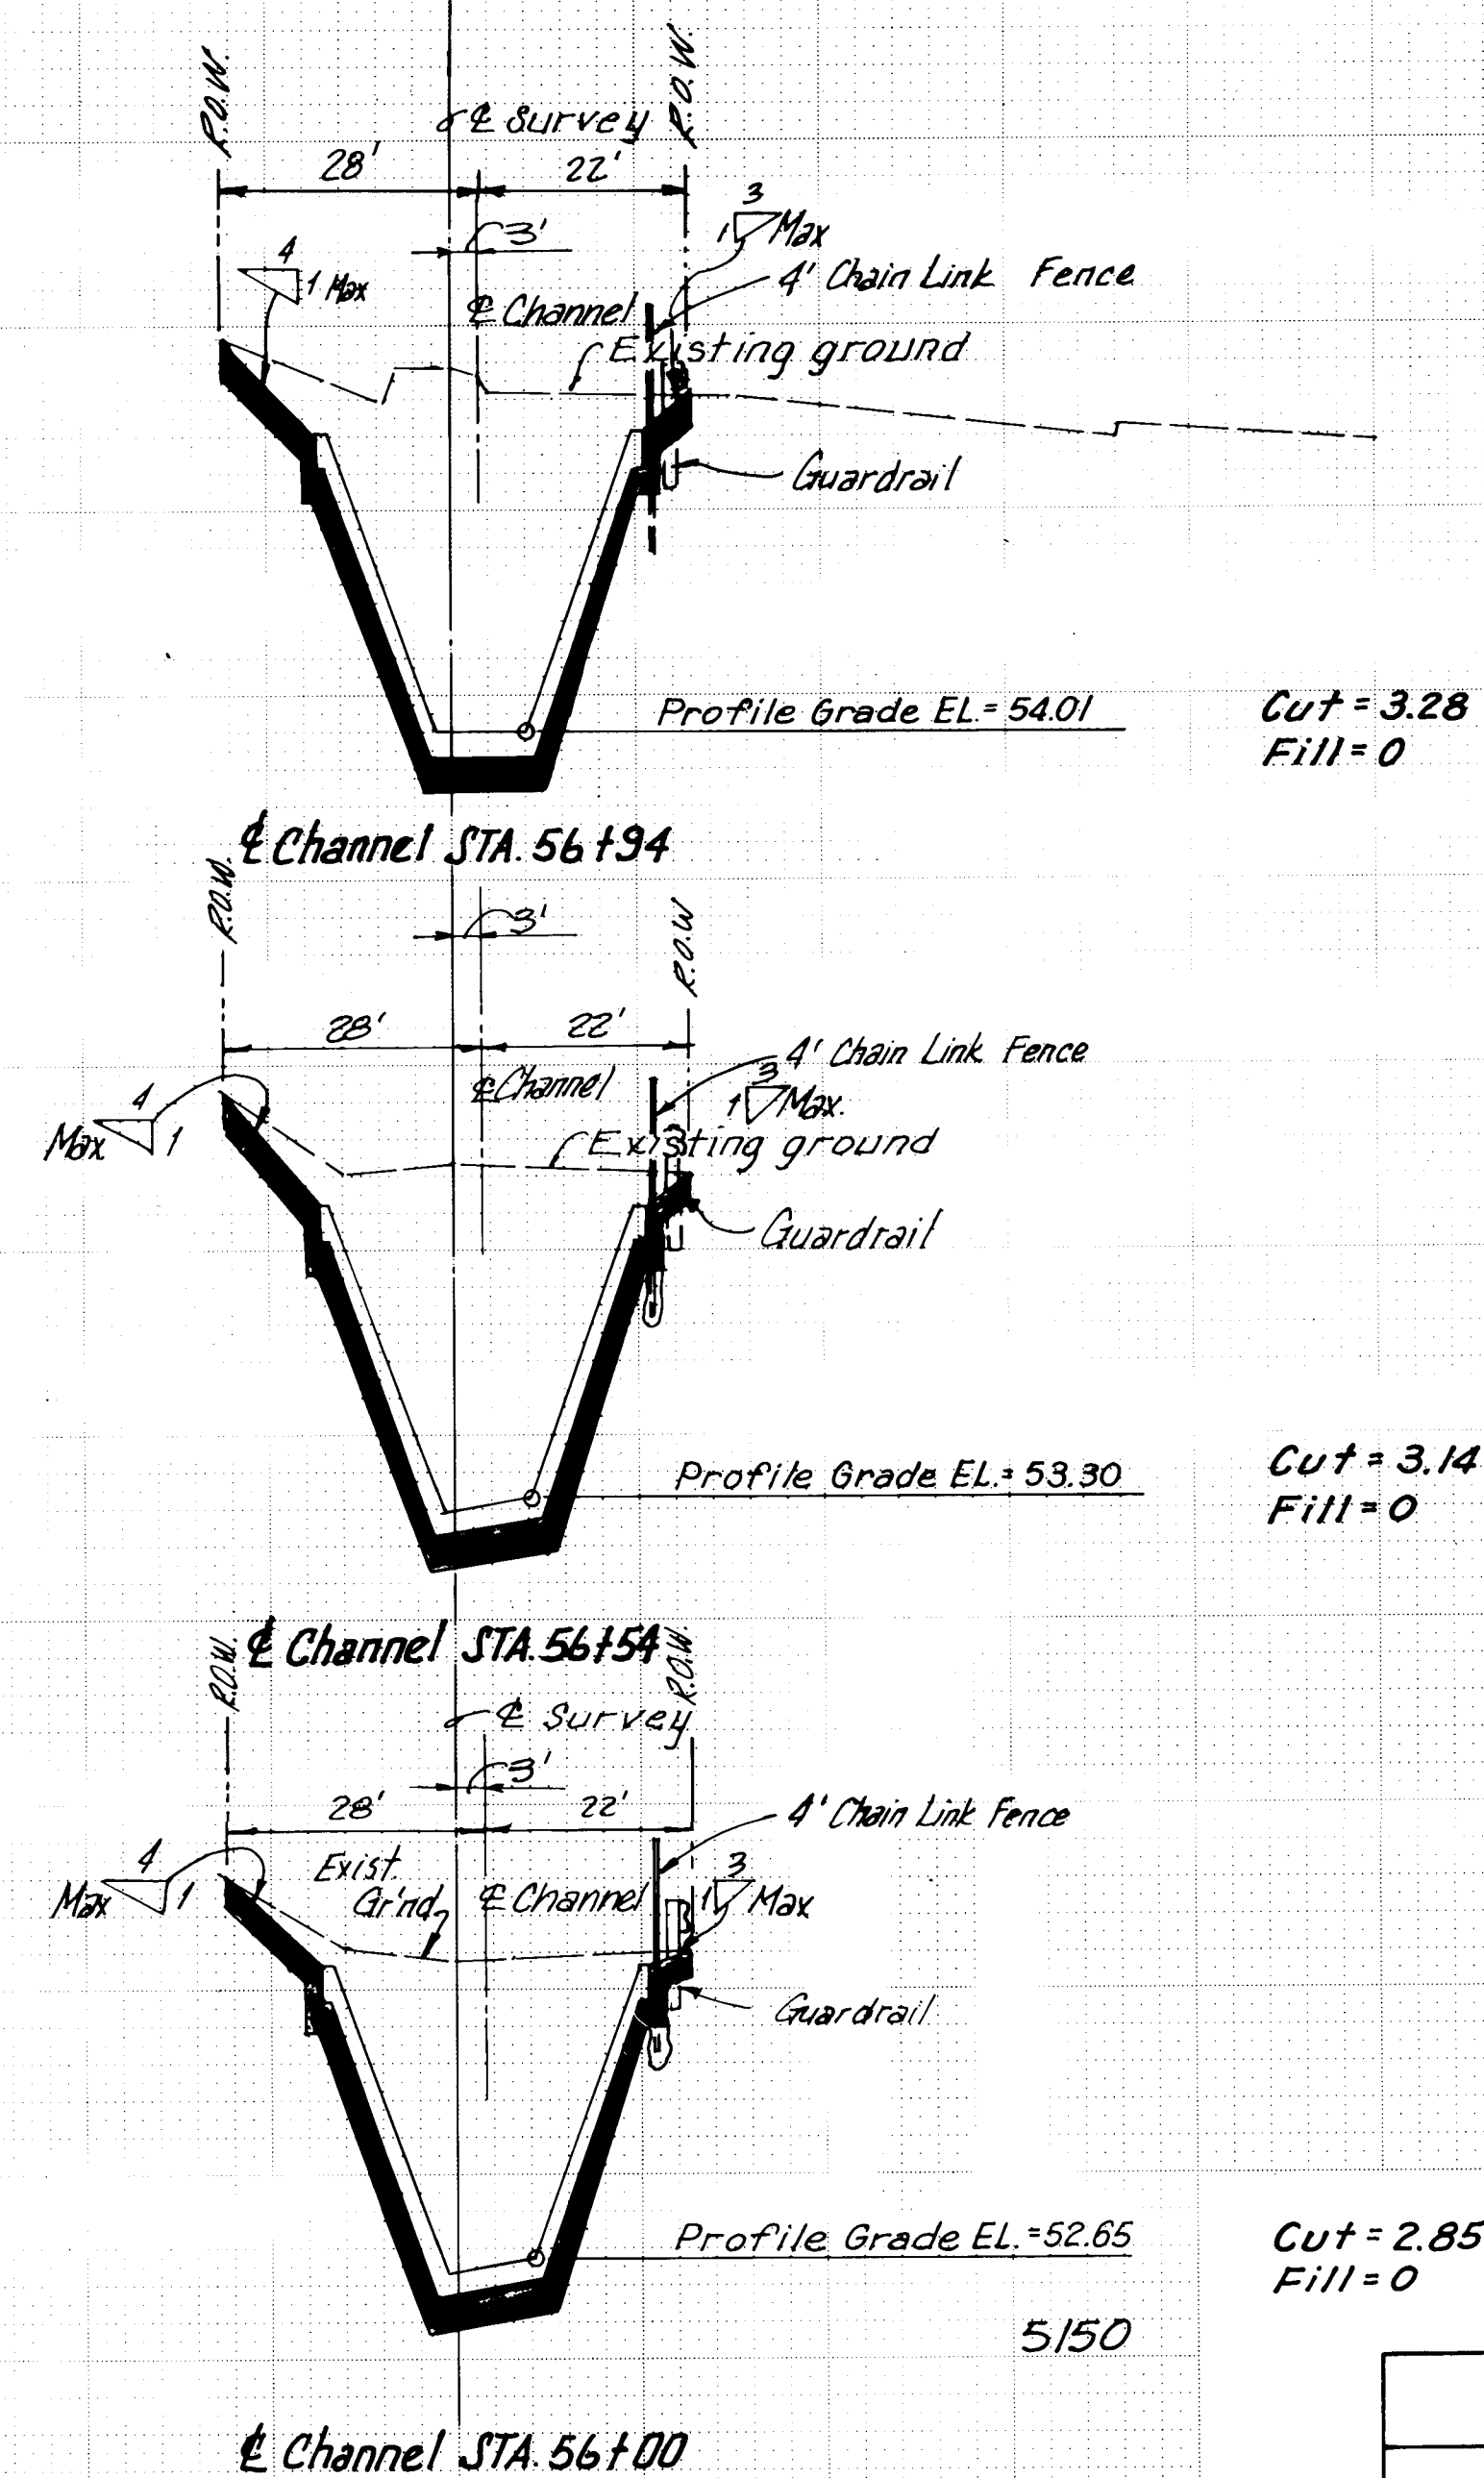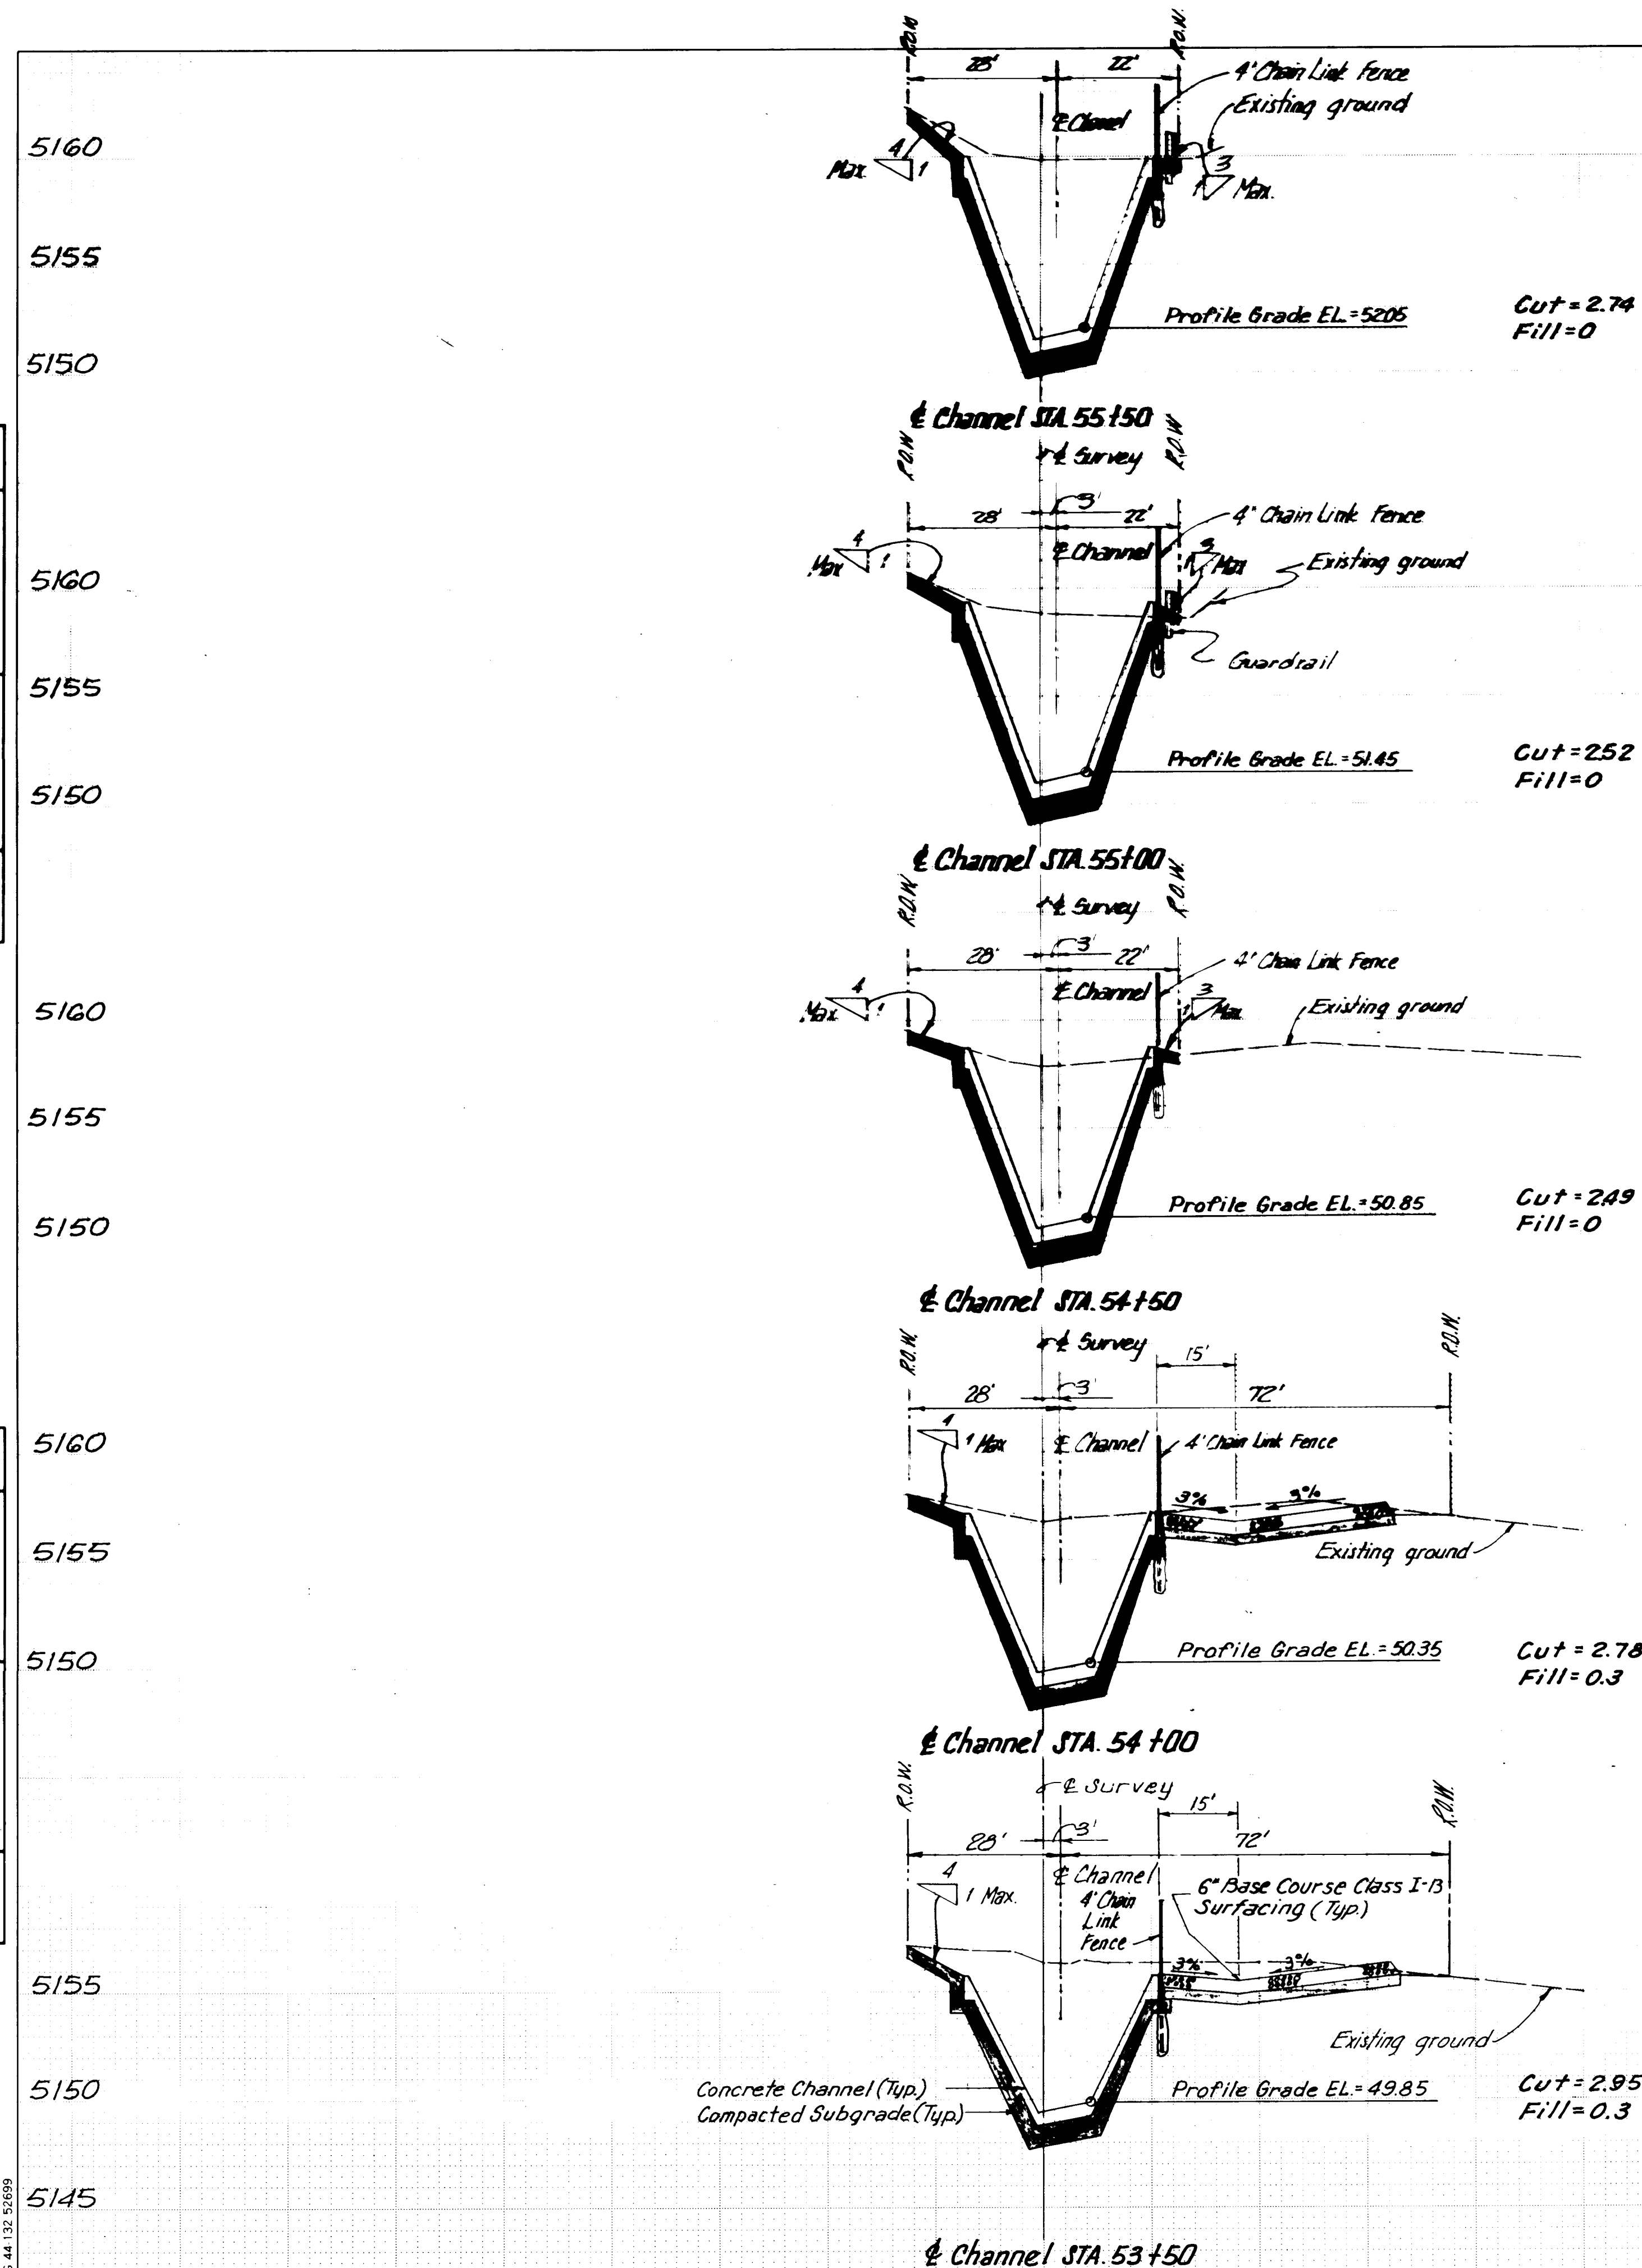


SCALE:
Horiz. $1'' = 20'$
Vert. $1'' = 5'$

RECORD DRAWING
Date JUL 10 1987

These drawings have been revised based on field data and every reasonable attempt has been made to depict construction as actually performed.

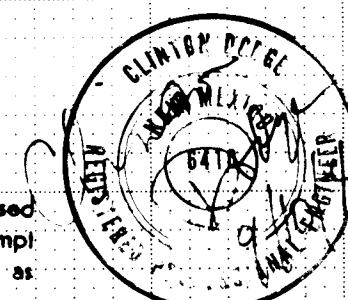

AMAFCA	
WESTGATE DIVERSION CHANNELS	
	SNOW VISTA CHANNEL PHASE II
	DRAWN BY G.C.
	DATE SEPT. 1986
	SCALE AS SHOWN
CROSS SECTIONS	
STA. 53 +50 TO STA. 56 +94	
GORDON HERKENHOFF & ASSOCIATES, INC.	
ALBUQUERQUE	ENGINEERS ARCHITECTS PLANNERS
SANTA FE	

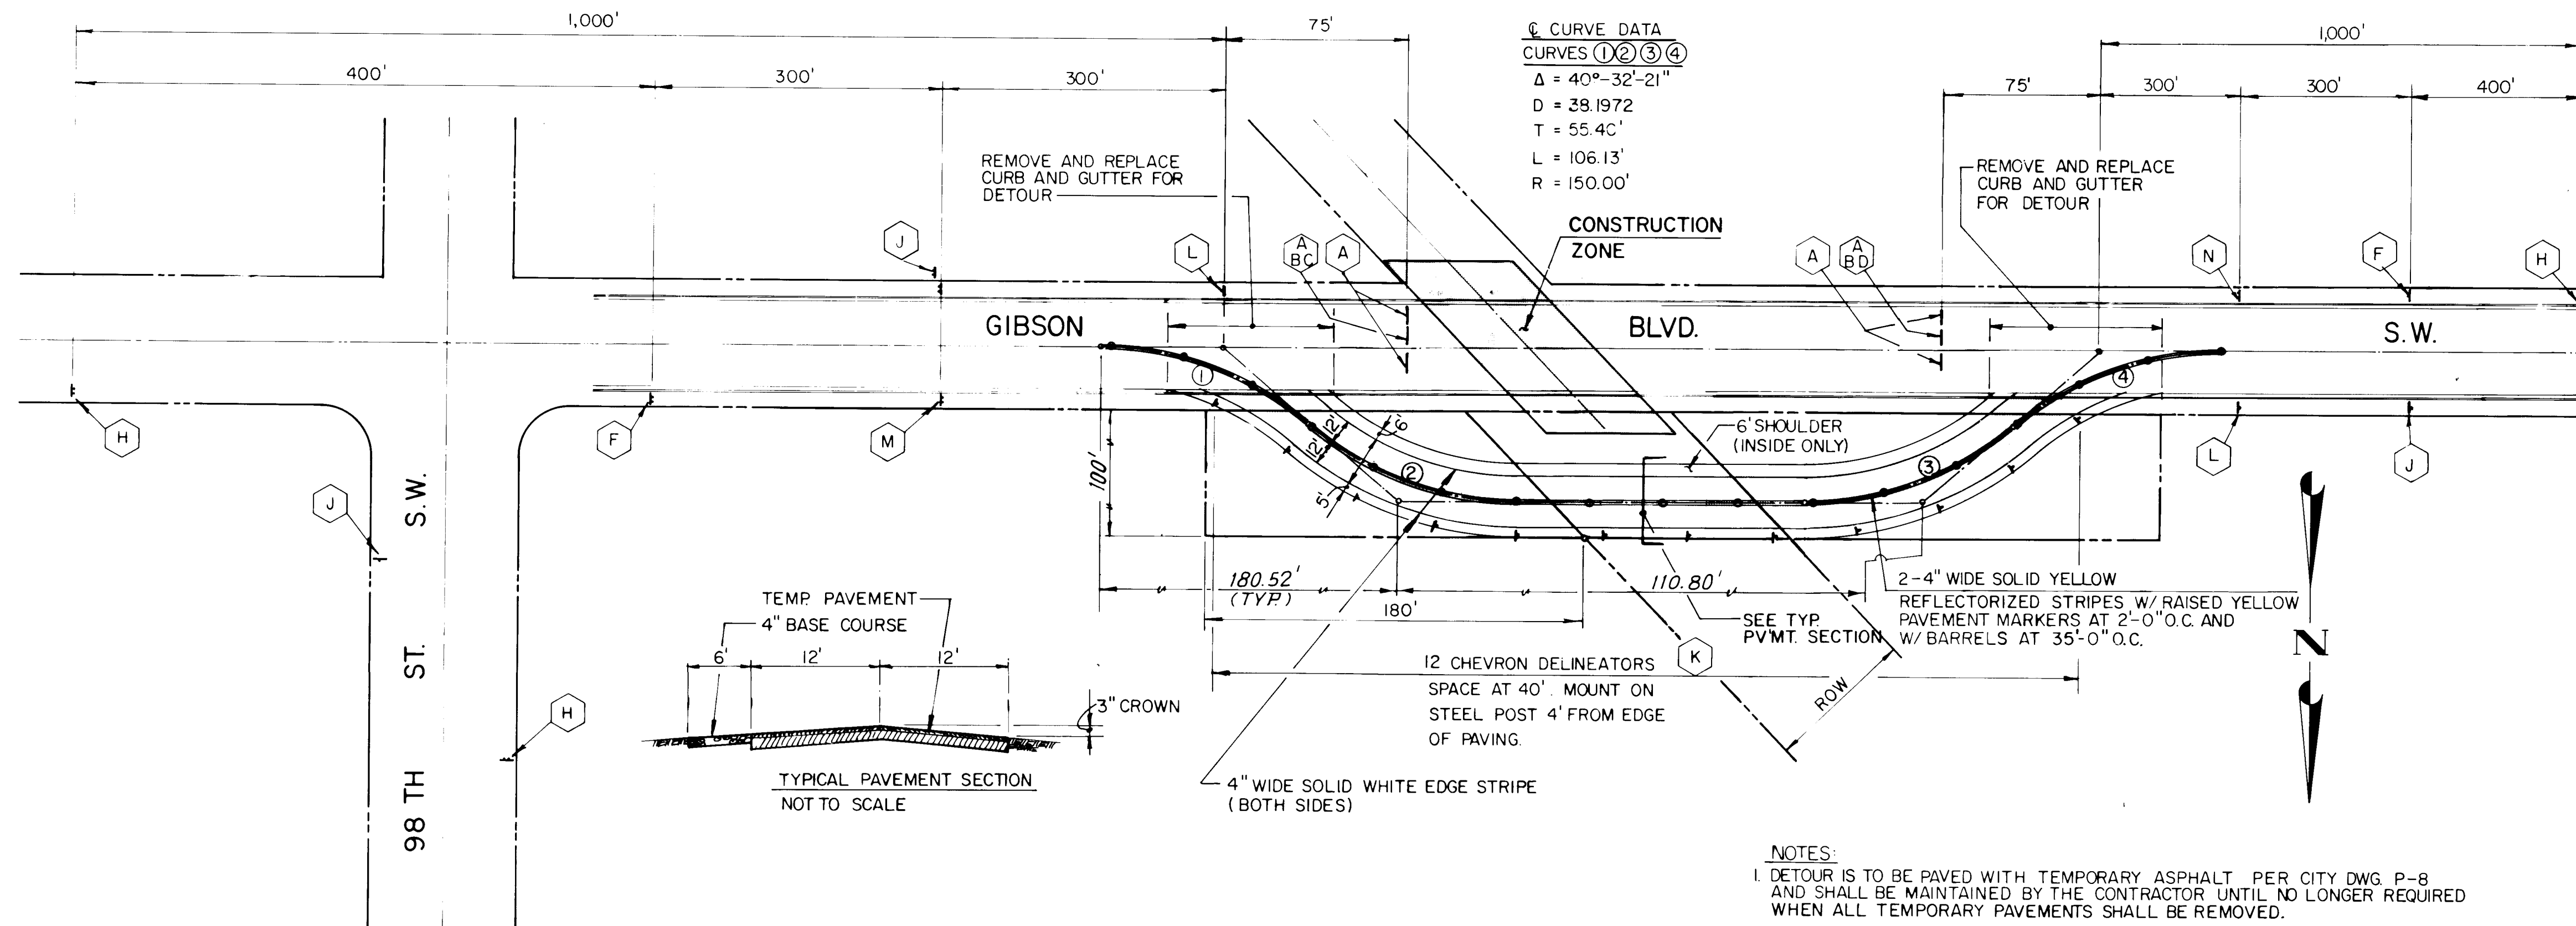

GENERAL NOTES:

1. All traffic control devices shall comply with Chapter VI of the 1978 edition Manual for Uniform Traffic Control Devices, with latest revisions.
2. The Contractor shall prepare and submit to the Project Engineer a detailed detour plan which must be approved by the City Traffic Engineer 3 working days in advance of any lane closures other than those shown on these plans.
3. All signs shall be mounted so that the bottom of the sign is 7 feet above ground or top of curb level and be in place before construction begins.
4. Sign locations will be selected in the field and approved by the Project Engineer. Distances between signs may be adjusted for local conditions.
5. All signs will be ground mounted on single or double posts. Existing posts may be used at some locations, with the approval of the Project Engineer. Portable sign supports are an acceptable alternate.
6. The Contractor shall maintain access to businesses and residences adjacent to the construction area at all times.
7. When barriers are required after dark, all advance warning signs and all barricades shall be equipped with flashing warning lights (Type A), except that all channelizing devices shall have steady burning lights (Type C).
8. Any existing regulatory signs that need to be removed, relocated or reinstalled shall be done by City of Albuquerque Traffic Engineering Division. The Contractor shall notify the Traffic Engineering Division 3 working days in advance of any required work.
9. The Contractor shall provide and maintain a safe and adequate means of channeling pedestrian traffic around all construction areas.

TRAFFIC CONTROL

GIBSON BLVD. will be closed from the west edge of the Circle K parking apron for the next 200' West. Traffic on Gibson will be routed onto a detour on the north side of Gibson.








MEMBRES ST. will be closed between Jenaro St. and Gibson.

TRAFFIC DETOUR PLAN

NOT TO SCALE

NOTES:





1. DETOUR IS TO BE PAVED WITH TEMPORARY ASPHALT PER CITY DWG P-8 AND SHALL BE MAINTAINED BY THE CONTRACTOR UNTIL NO LONGER REQUIRED WHEN ALL TEMPORARY PAVEMENTS SHALL BE REMOVED.
2. VERTICAL ALIGNMENT OF DETOUR IS TO MATCH SLOPE AND ELEVATIONS OF GIBSON BLVD.

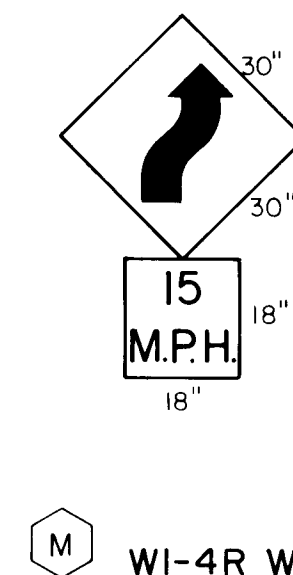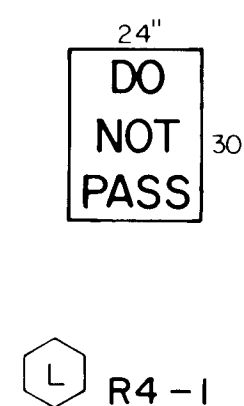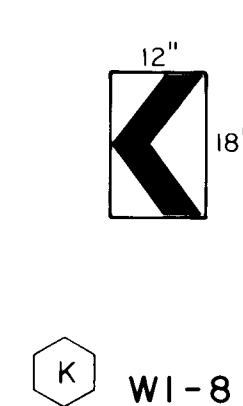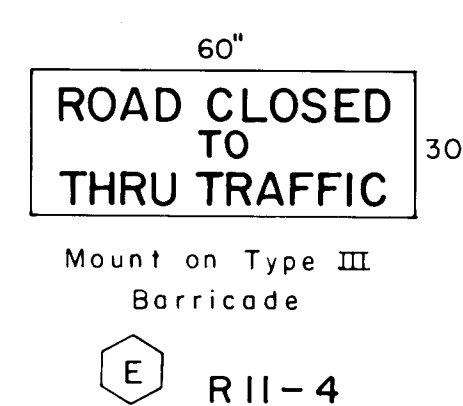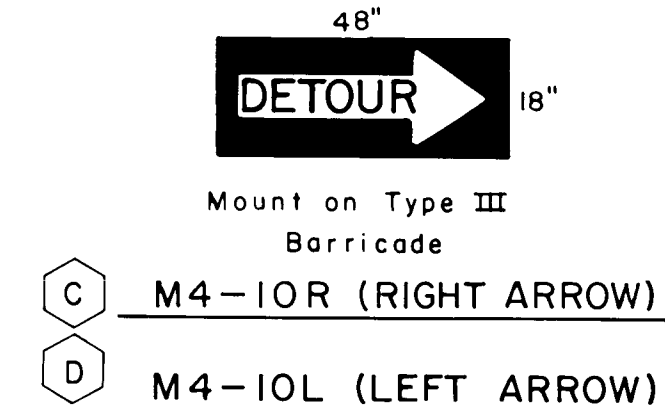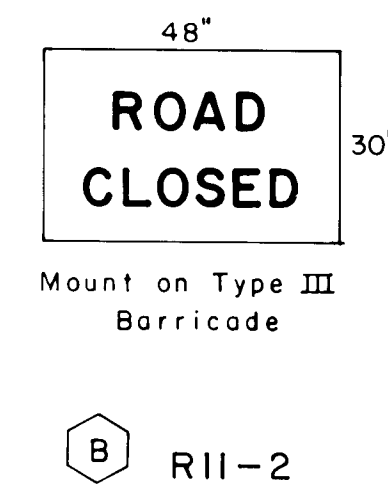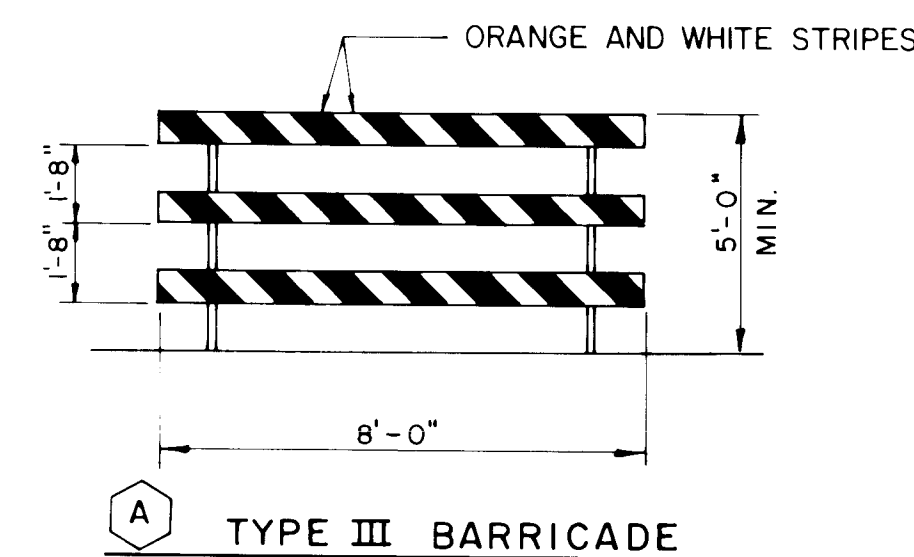

PERMANENT BARRICADES:

Type III Barricades with Road Closed (R11-2) signs shall be permanently installed at the following locations or as directed by the Engineer in accordance with the detail shown on this sheet.

Dedicated Street	Approximate Channel # STA	Approximate Location
DeAnza Dr. S.W.	13+60 13+90	50' Rt. 50' Lt.
Redondo Rd. S.W.	30+50	65' Lt.
98th Street Extension	45+15 46+00	55' Lt. 55' Rt.
Eucariz Road SW	96+91 97+08	25' Lt. 35' Rt.
Camino San Martin (Unplatted)	27+00	50' Lt.

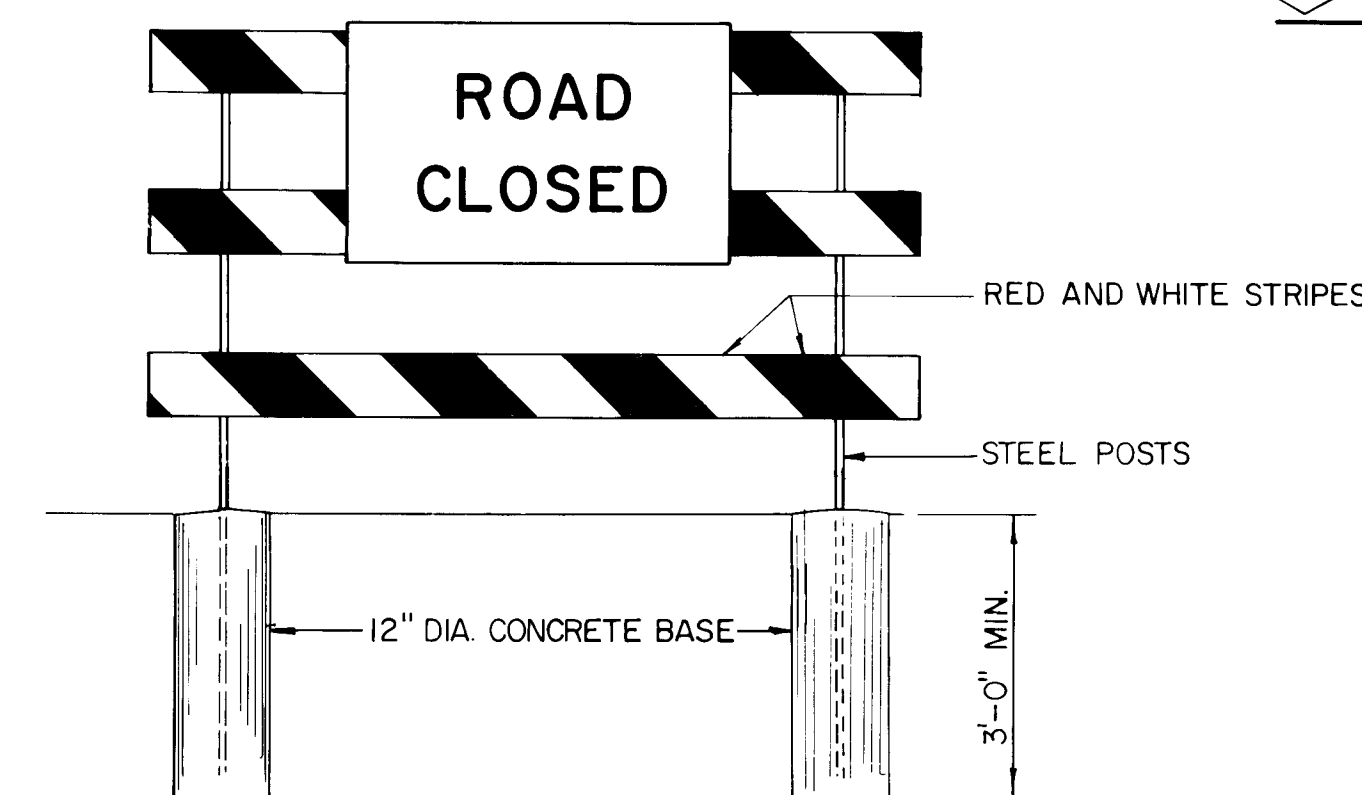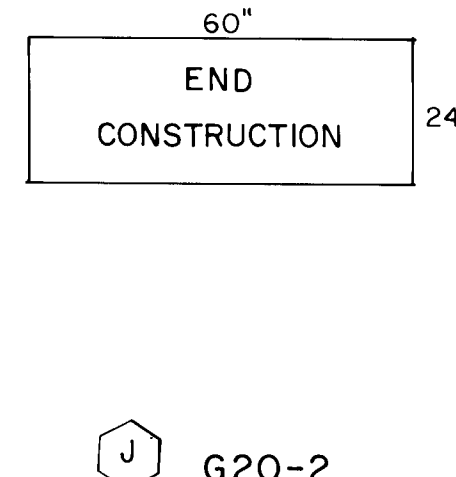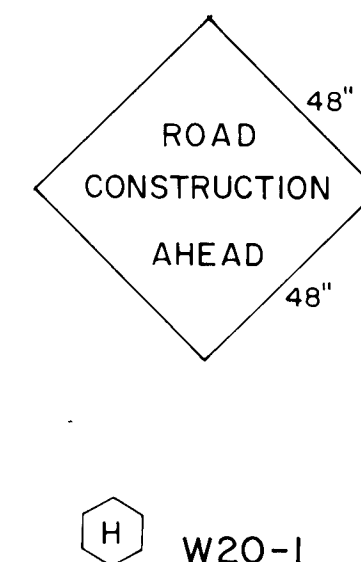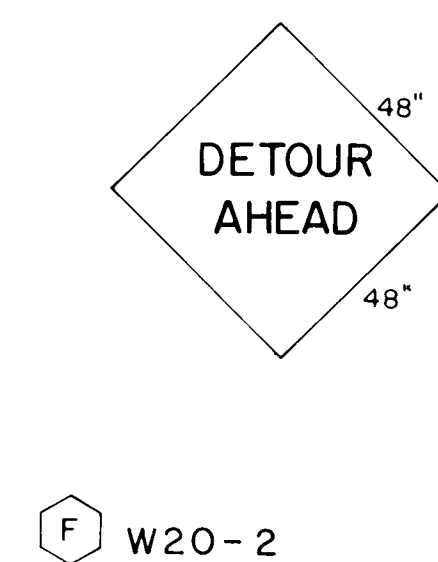


PERMANENT MOUNTING-
TYPE III BARRICADE
W/ R11-2

RECORD DRAWING


Date: 11/11/1987
These drawings have been revised based on field data and every reasonable attempt has been made to depict construction as actually performed.



AMAFCA	
WESTGATE DIVERSION CHANNELS	
	SNOW VISTA CHANNEL PHASE II
	TRAFFIC DETOUR PLAN AND SIGN DETAILS
	GORDON HERKENHOFF & ASSOCIATES, INC.
	ENGINEERS ARCHITECTS PLANNERS
ALBUQUERQUE	SANTA FE

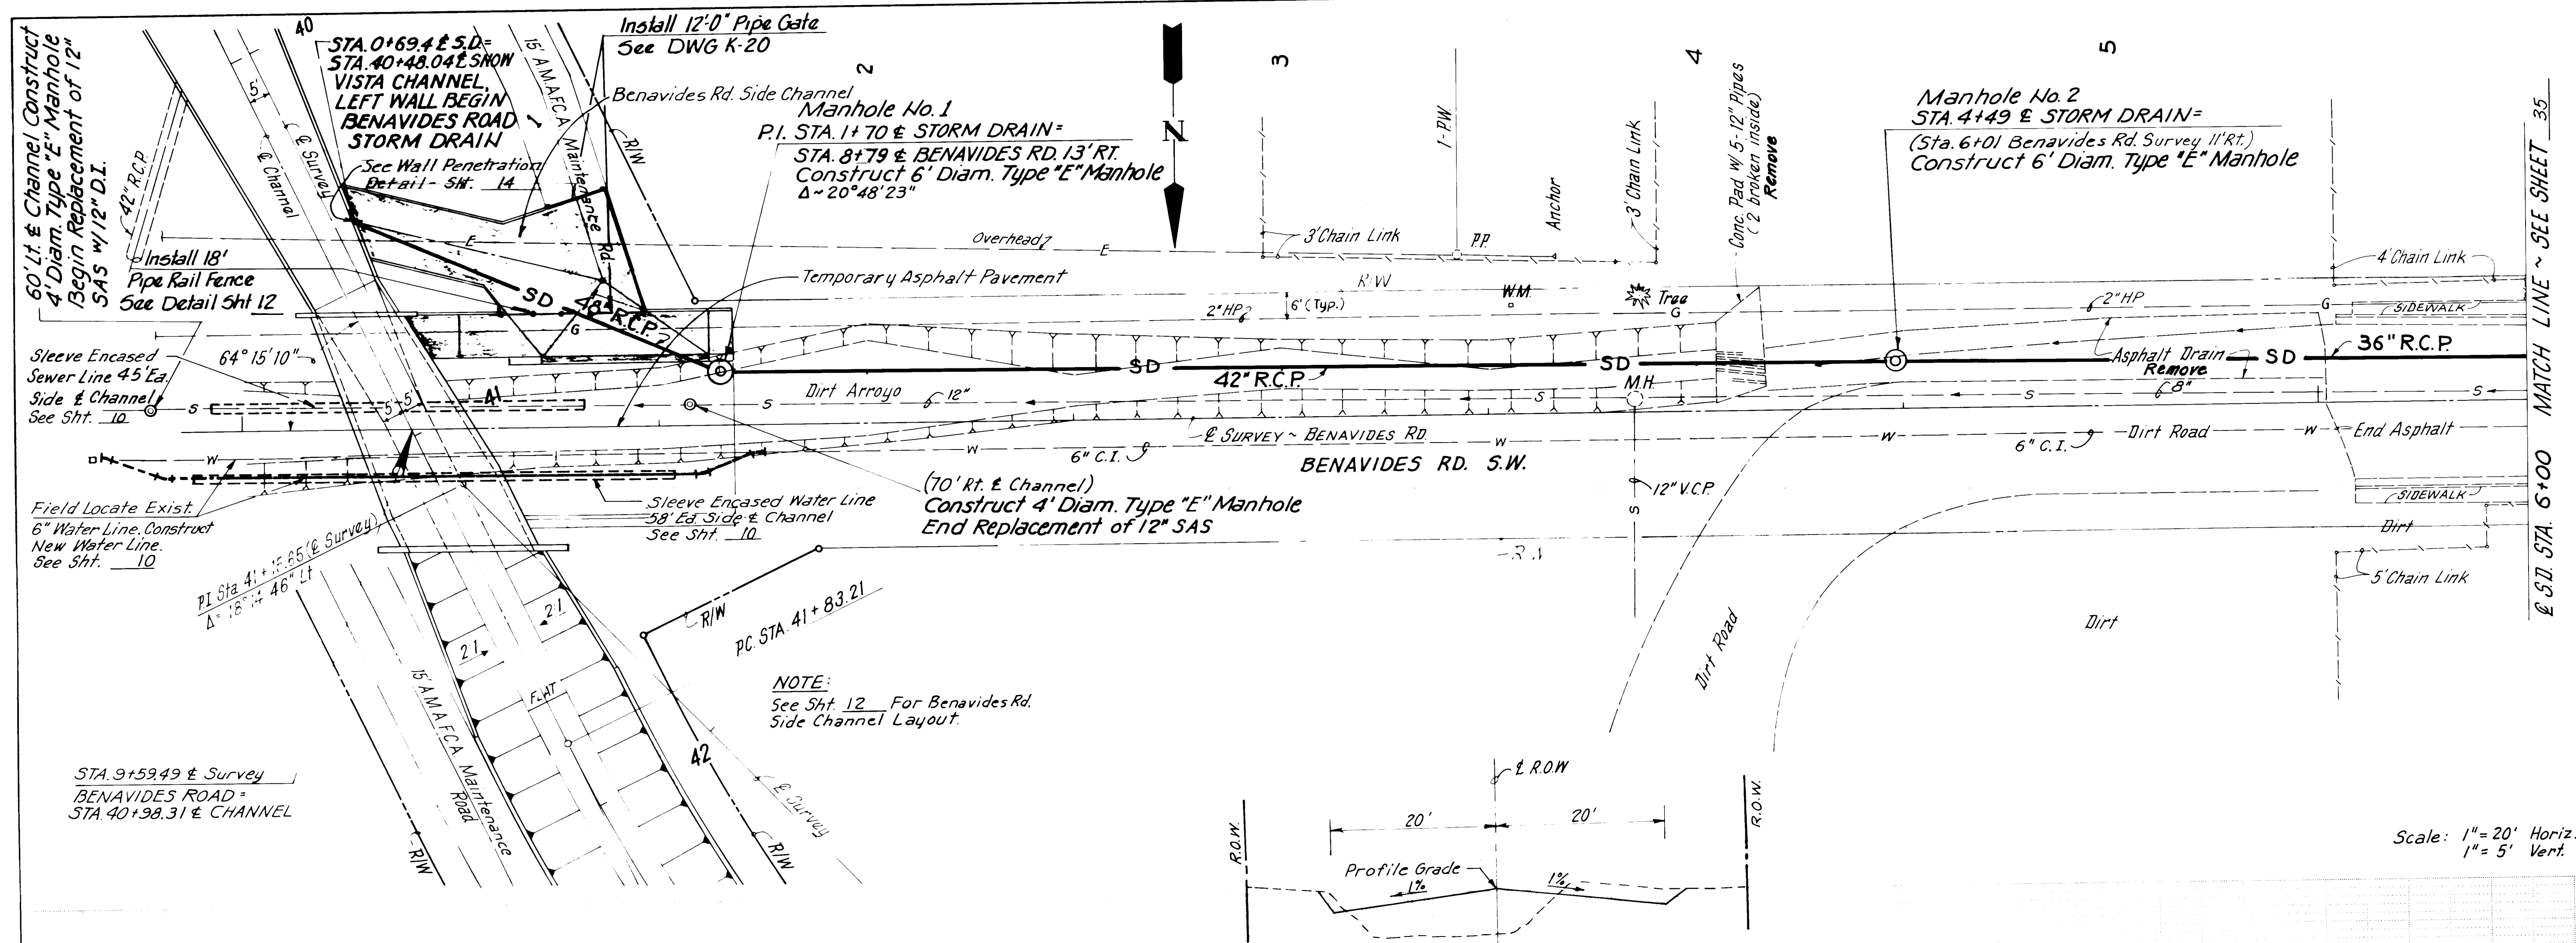

TYPICAL BLADED RD. SECTION-BENAVIDES

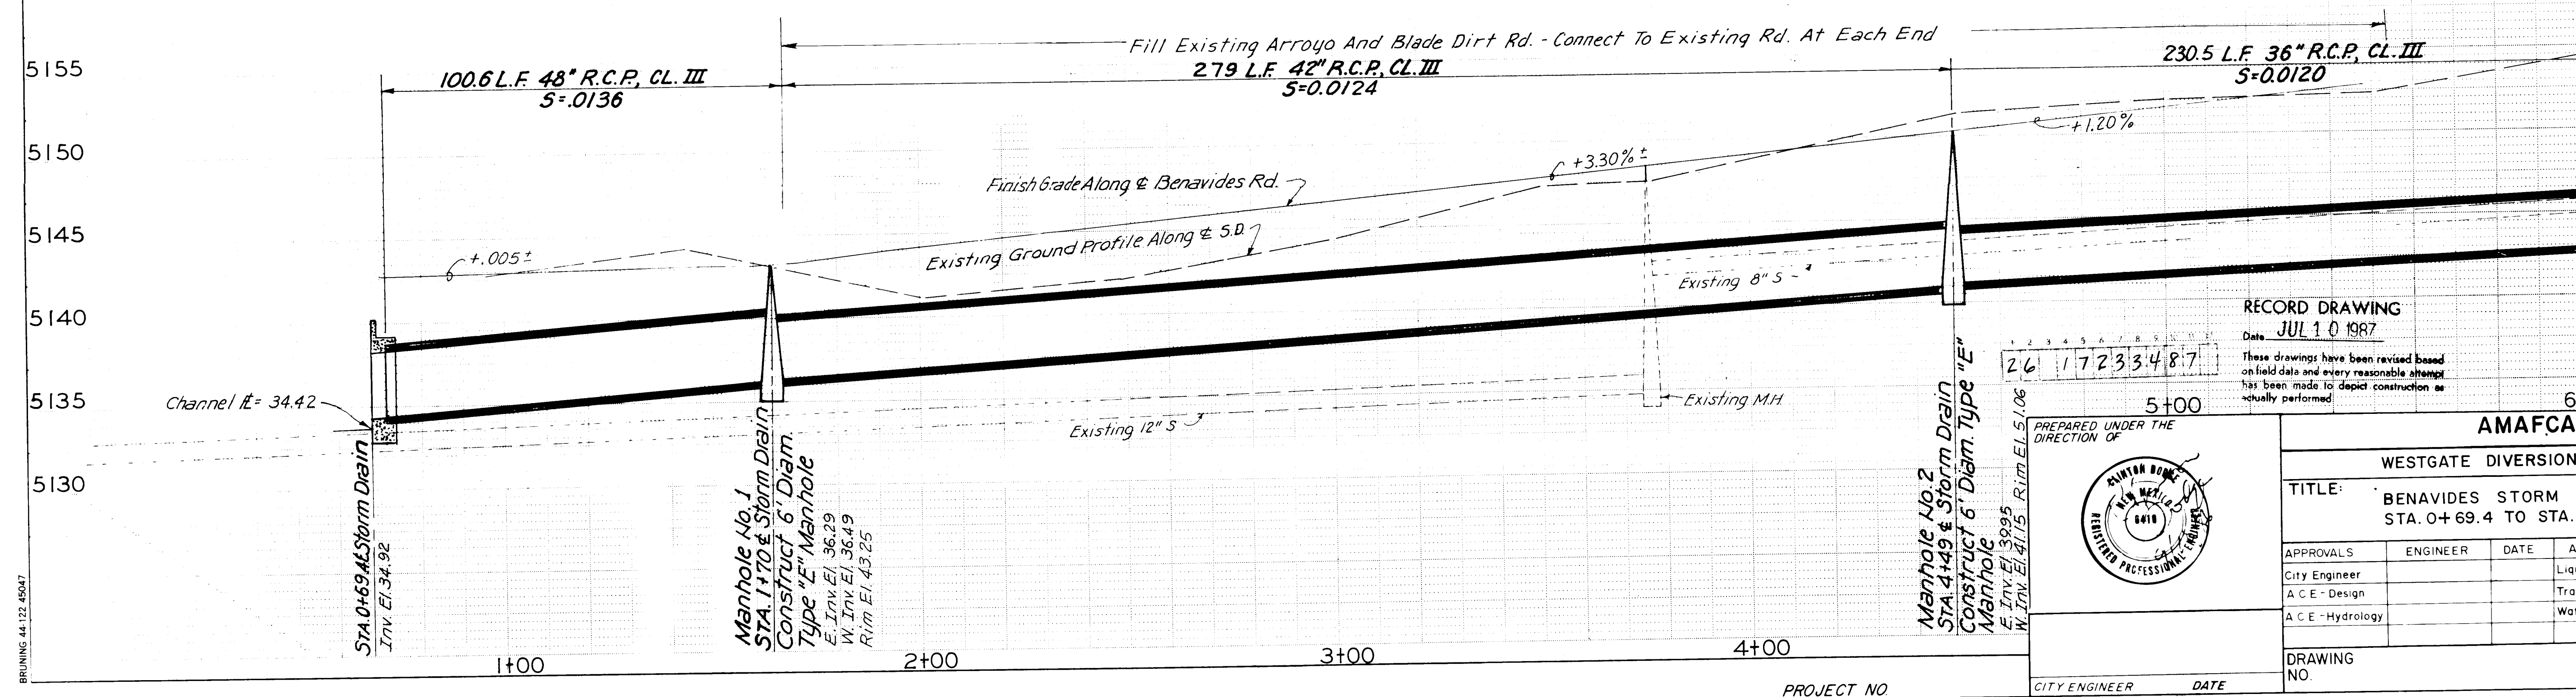

RECORD DRAWING

Date JUL 10 1987

These drawings have been said

on field data and every reasonable

has been made to depict const
actually performed

..... actually performed

[illegible]

	W
--	---

TITLE: .

	B
	C

3

APPROVALS	
-----------	--

City Engineer	
---------------	--

City Engineer	
A.C.E. - Design	

A C E - Hydrology

D.C.E. Hydrology	

DRAWING

DRAWING
NO.

E	NO.
---	-----

AMAFCA



WESTGATE DIVERSION CHANNELS

TITLE: BENAVIDES STORM DRAIN
STA 0+69.4 TO STA 6+00


APPROVALS	ENGINEER	DATE	APPROVALS	ENGINEER	DATE
City Engineer			Liquid Waste		
A C E - Design			Traffic		
A C E - Hydrology			Water		

DRAWING NO.	SHEET OF
	34 49

NO.	51	10
-----	----	----

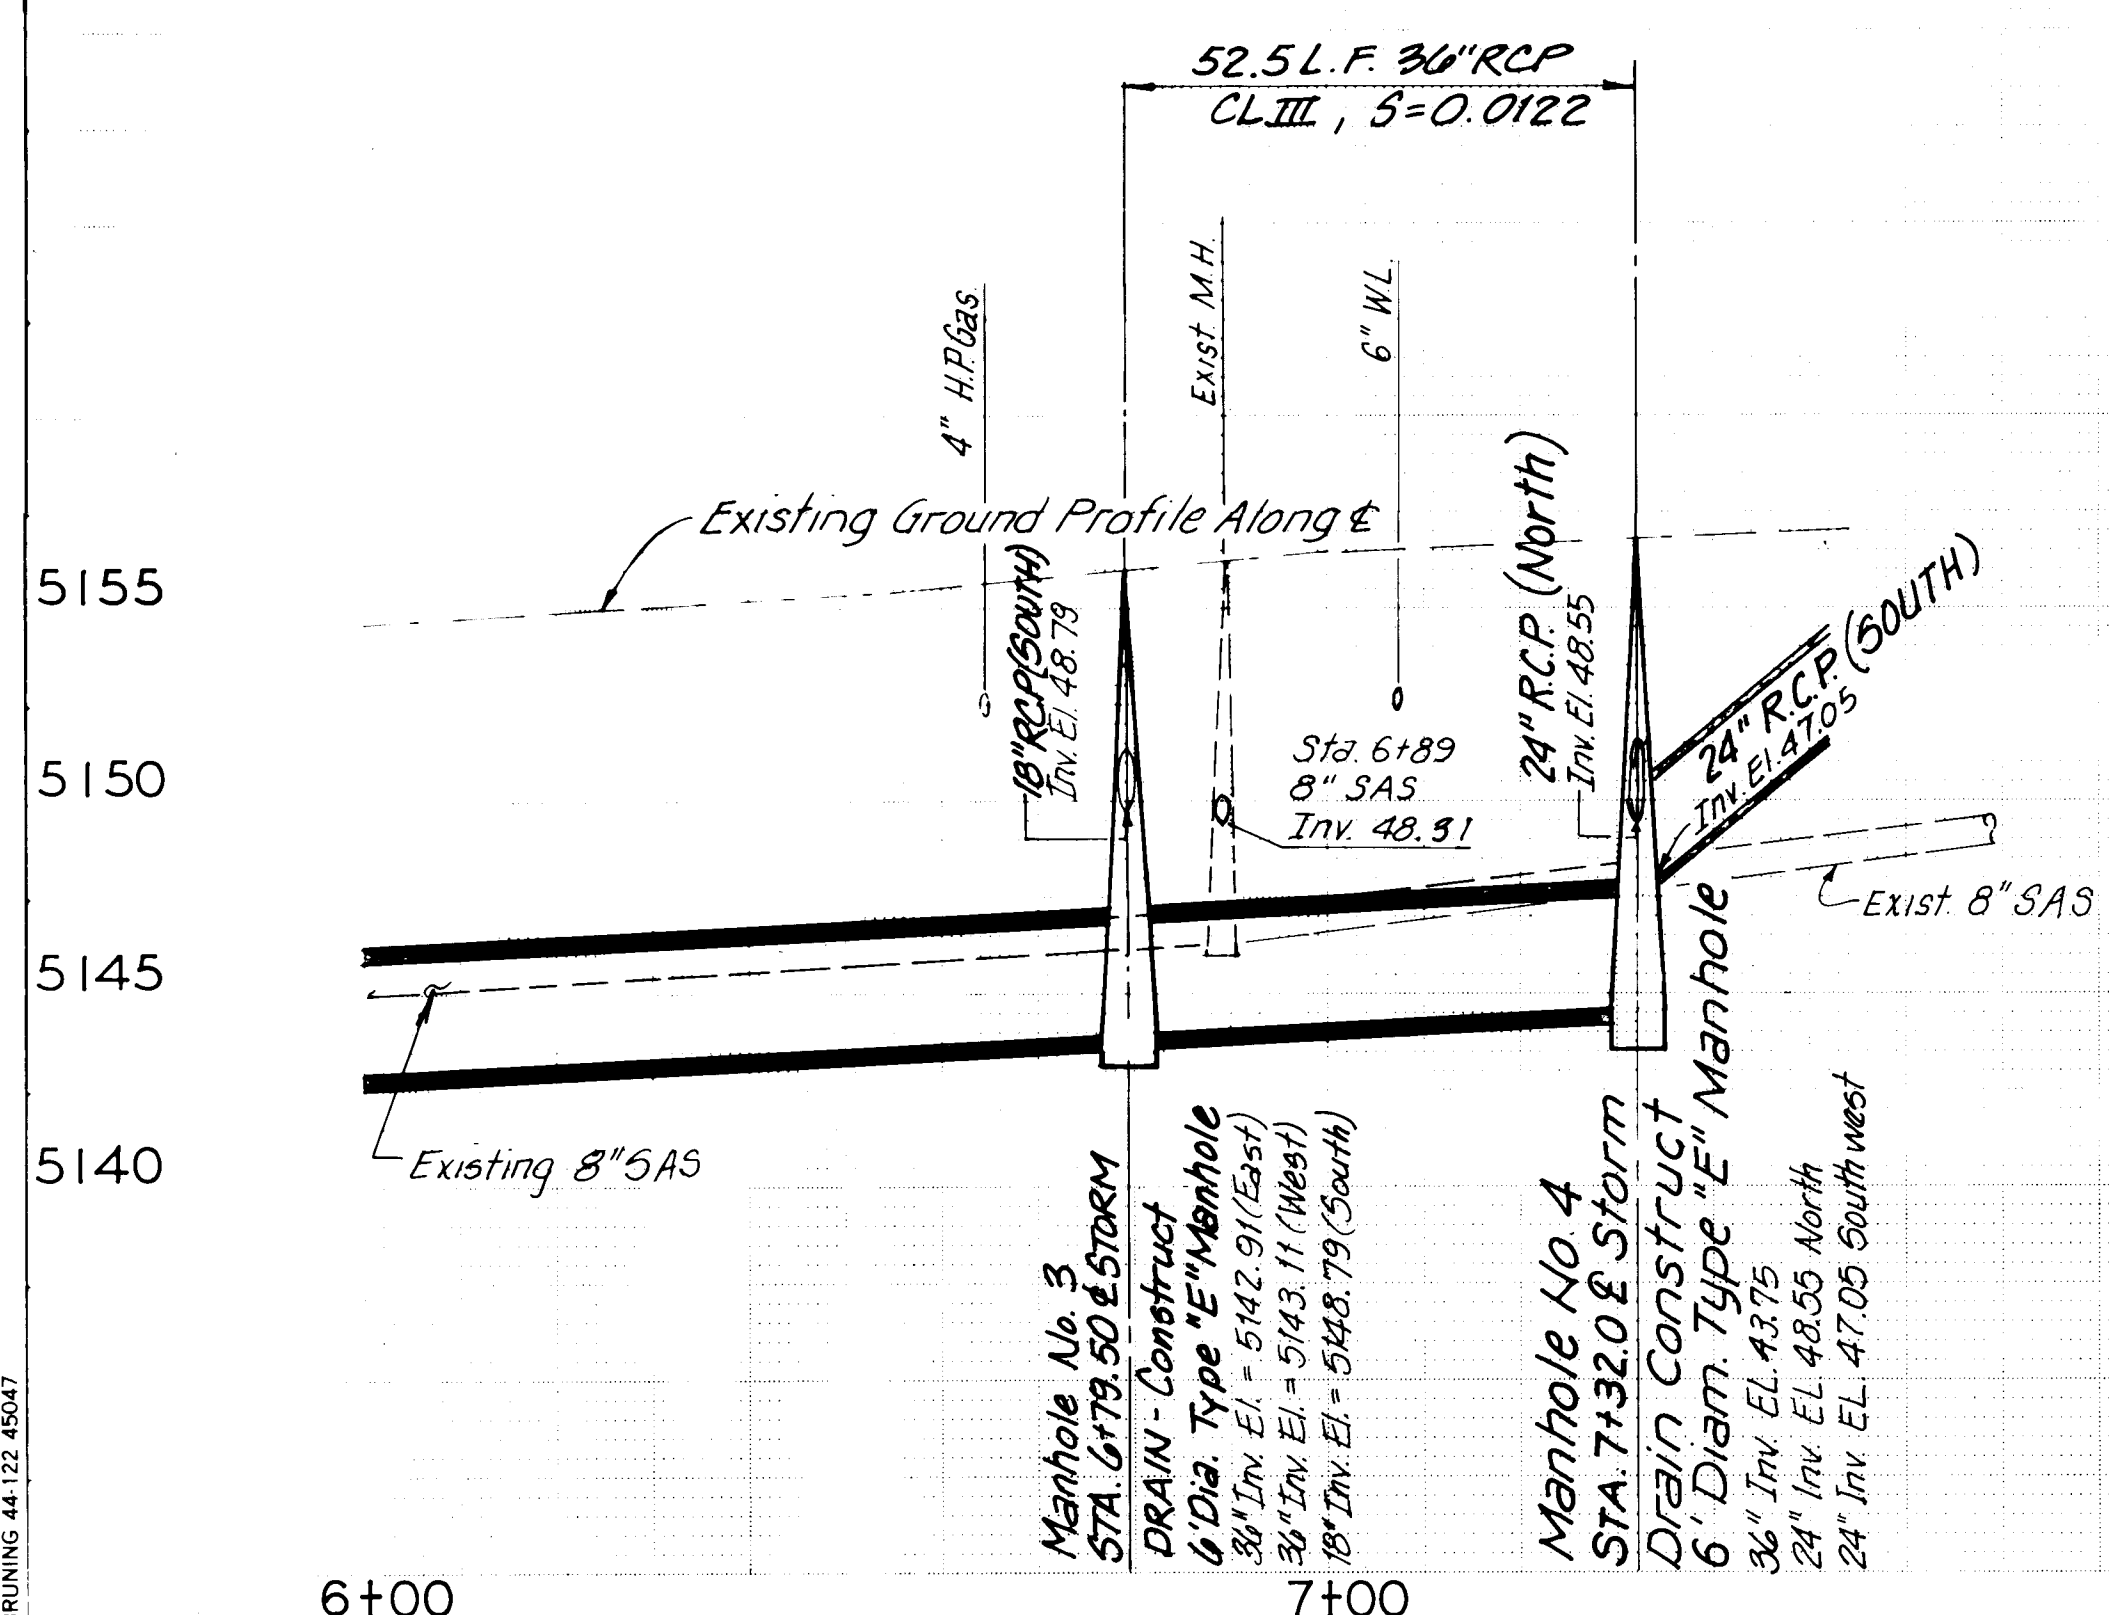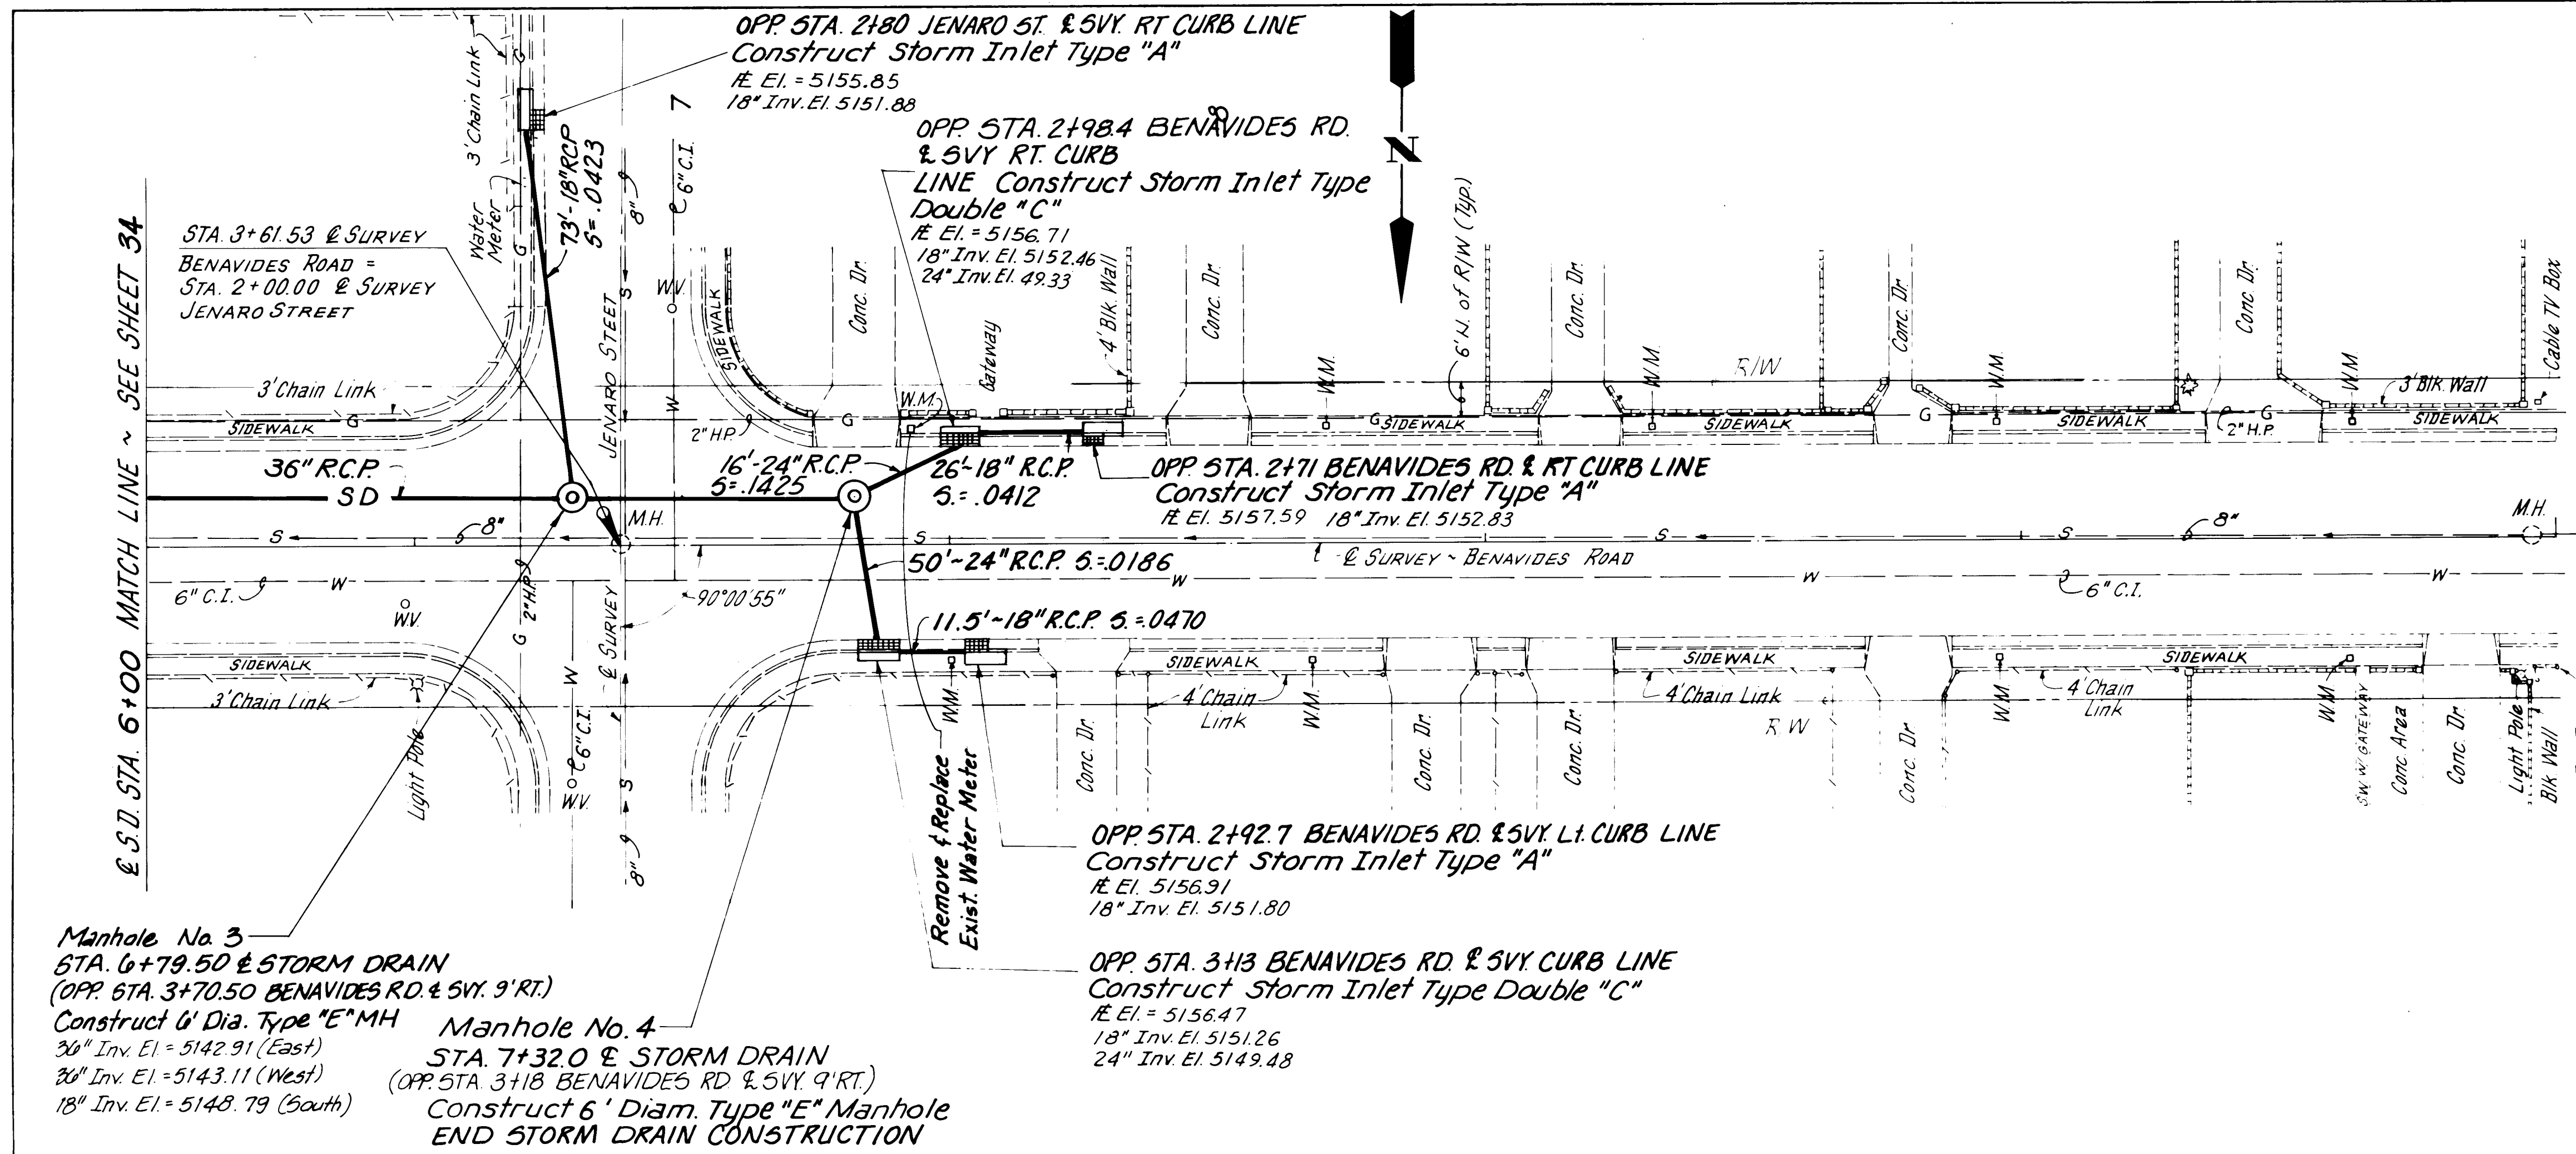

RECORD DRAWING
Date JUL 10 1987
These drawings have been revised based on field data and every reasonable attempt has been made to depict construction as actually performed.

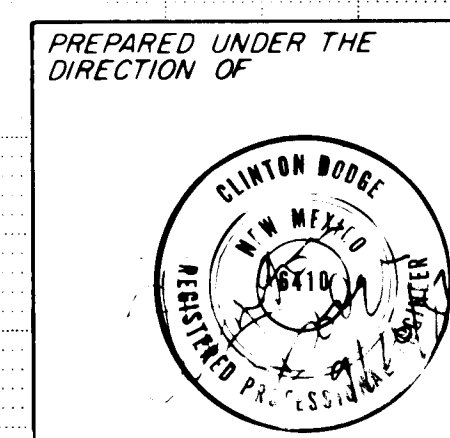

APPROVED FOR CONSTRUCTION

CITY ENGINEER DATE

AMAFCA					
WESTGATE DIVERSION CHANNELS					
TITLE: BENAVIDES STORM DRAIN STA. 6+00 TO STA. 7+32					
APPROVALS	ENGINEER	DATE	APPROVALS	ENGINEER	DATE
City Engineer			Liquid Waste		
A C E - Design			Traffic		
A C E - Hydrology			Water		
DRAWING NO.			SHEET OF		
			35 49		

Scale: 1" = 20' Horiz.
1" = 5' Vert.

				REFERENCES		SURVEY INFORMATION		BENCH MARKS		AS BUILT INFORMATION	
				MAP NO.		FIELD NOTES					
				EST. NO.		W.O. NO.	NO.	BY	DATE		

L

M

N

P

SEE PLAN & PROFILE SHEETS

39

38

37

SNOW VISTA PHASE III
PROJECT LOCATIONSEE SHEETS 2 THROUGH 35
PHASE IILOCATION MAP
SCALE: 1"=1000'

CONCRETE NOTES

1. CONCRETE FOR CHANNEL LINING AND CHANNEL APPURTENANCES SHALL BE CLASS 'E' UNLESS OTHERWISE SPECIFICALLY SHOWN ON THE PLANS.
2. REINFORCING SHALL CONFORM TO THE REQUIREMENTS OF ASTM A615 GRADE 60.
3. UNLESS OTHERWISE NOTED, LAPS, SPLICES OR EMBEDMENT LENGTHS SHALL CONFORM TO TABLE 20.1 ACI MANUAL SP-17 CLASS B SPLICE.
4. UNLESS OTHERWISE NOTED, CONCRETE COVER OVER STEEL SHALL BE 2" FOR FORMED CONCRETE AND 3" FOR CONCRETE CAST AGAINST EARTH.
5. REINFORCING SHALL BE CONTINUOUS AROUND ALL CORNERS UNLESS SHOWN OTHERWISE.
6. UNLESS OTHERWISE SHOWN, ALL EXPOSED CORNERS SHALL HAVE 3/4" CHAMFER OR TOOLED EDGE AS DIRECTED.
7. CHANNEL REBAR SHALL BE SUPPORTED ON 3 1/2" SAND CHAIRS AT A MAXIMUM SPACING OF 5' PERPENDICULAR TO THE CHANNEL CENTERLINE.

GENERAL NOTES


1. TWO (2) WORKING DAYS PRIOR TO ANY EXCAVATION, CONTRACTOR MUST CONTACT LINE LOCATING SERVICE, 765-1234, FOR LOCATION OF EXISTING UTILITIES.
2. PRIOR TO CONSTRUCTION, THE CONTRACTOR SHALL EXCAVATE AND VERIFY THE HORIZONTAL AND VERTICAL LOCATIONS OF ALL OBSTRUCTIONS. SHOULD A CONFLICT EXIST, THE CONTRACTOR SHALL NOTIFY THE ENGINEER SO THAT THE CONFLICT CAN BE RESOLVED WITH MINIMUM AMOUNT OF DELAY.
3. ALL NEW STREET PAVING, DRIVEWAYS, SIDEWALKS, AND CURB AND GUTTERS ABUTTING EXISTING AREAS SHALL MATCH THE ELEVATION OF THOSE AREAS.
4. THE CONTRACTOR SHALL ASSUME RESPONSIBILITY FOR ANY DAMAGE TO EXISTING PAVING OR CURB AND GUTTER DURING CONSTRUCTION, APART FROM THOSE SECTIONS INDICATED FOR REMOVAL ON THE PLANS, AND SHALL REPAIR OR REPLACE SAME AT HIS OWN EXPENSE. HE SHALL SUITABLY PROTECT THE CURB AND GUTTER FROM INCIDENTAL SPLASHING DURING THE TACK COAT APPLICATION AND SHALL BE RESPONSIBLE FOR CLEANING SAME AT HIS OWN COST SHOULD SPLASHING OCCUR.
5. ALL UTILITY LINES WHICH ARE NOT SPECIFICALLY DESIGNATED TO BE REMOVED AND REPLACED ON THE PLANS SHALL BE MAINTAINED IN SERVICE. SHORING, SHEETING, AND OTHER MEANS OF SUPPORT SHALL BE EMPLOYED BY THE CONTRACTOR TO PREVENT DAMAGE OR LOSS OF THESE EXISTING UTILITIES. BEAM AND CABLE OR OTHER ADEQUATE SUPPORTS SHALL BE USED FOR TEMPORARY SUPPORT OF ALL UTILITY LINES WHICH CROSS TRENCHES. ANY DAMAGE TO EXISTING UTILITIES SHALL PROMPTLY BE REPAIRED AT THE CONTRACTOR'S EXPENSE. THE ENGINEER SHALL BE IMMEDIATELY NOTIFIED OF ANY SIGNIFICANT DEVIATION OF EXPOSED UTILITIES FROM THE LOCATIONS SHOWN ON THE PLANS SO THAT CONFLICTS CAN BE RESOLVED IN A TIMELY MANNER.
6. ALL CHANNEL STEPS SHALL BE 1/2" GRADE 60 STEEL REINFORCING ROD ENCAPSULATED IN A CO-POLYMER POLYPROPYLENE AS MANUFACTURED BY M.A. INDUSTRIES, INC. (MODEL #P-2-PFS). STEPS ARE NOT TO BE PRECAST IN PLACE BUT SHALL BE INSTALLED AS RECOMMENDED BY THE MANUFACTURER.
7. RIGHT-OF-WAY SHOWN IS APPARENT RIGHT-OF-WAY DETERMINED FROM PLAT MAPS AND LOCATED PROPERTY TIES.
8. THE CONTRACTOR IS TO COORDINATE UTILITY RELOCATIONS TO BE PERFORMED BY OTHERS DURING ALL PHASES OF CONSTRUCTION.
9. ALL DISTURBED AREAS WITH SLOPES EQUAL TO OR FLATTER THAN 4H:1V SHALL BE SEEDED WITH CLASS 'A' SEEDING, AND ALL DISTURBED AREAS WITH SLOPES STEEPER THAN 4H:1V AND ALL DISTURBED AREAS WEST OF THE CONCRETE CHANNEL WITHIN THE PERMANENT ROW SHALL BE SEEDED WITH CLASS 'B' SEEDING, UNLESS OTHERWISE DIRECTED BY THE ENGINEER.

BENCH MARKS

TOP N.W. BOLT F.H. GIBSON & DEL MASTRO
DR. SW. ELEV. 5176.96*5-M9 "X", N.E. BONNET BOLT F.H. ON
W. SIDE 98TH ST. S.W. 150' N. INTERSECTION
OF GIBSON BLVD. S.W. & 98TH ST. S.W. ELEV. 5150.917

RECORD DRAWING

Date: JUL 10 1987

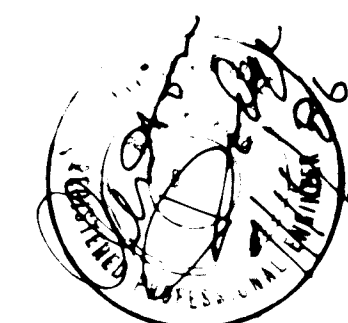These drawings have been revised based
on field data and every reasonable attempt
has been made to depict construction as
actually performed

HYDROLOGIC AND SYSTEM REFERENCE

WILLIAM MATOTAN & ASSOCIATES, "DRAINAGE MANAGEMENT PLAN, WESTERN ALBUQUERQUE METROPOLITAN AREA", 1975.

GORDON HERKENHOFF AND ASSOCIATES, "PRELIMINARY DESIGN ANALYSES, WESTGATE DIVERSION CHANNELS", APRIL 1980.

GORDON HERKENHOFF AND ASSOCIATES, "INTERIM DESIGN REPORT, WESTGATE DIVERSION CHANNELS", DECEMBER 1980.

GORDON HERKENHOFF AND ASSOCIATES, "FINAL DESIGN REPORT, SNOW VISTA CHANNEL PHASE III", JULY 1982.

DRAINAGE AREAS AND DESIGN DISCHARGES ARE SHOWN AT POINTS OF CONFLUENCE ON THESE CONSTRUCTION DRAWINGS. THE HYDRAULIC INFORMATION IS SHOWN FOR ULTIMATE DEVELOPMENT.

HYDRAULIC PROFILE LEGEND

Qp 100	100 YR. RETURN FREQUENCY DISCHARGE
Dn	NORMAL FLOW DEPTH
Vn	NORMAL FLOW VELOCITY
Dc	CRITICAL FLOW DEPTH
Fr	FROUDE NUMBER
n	MANNING'S FRICTION FACTOR

REACH	1A	1B	2A	3A
	STA. 58+07.01 TO STA. 58+68.77	STA. 58+68.77 TO STA. 65+50	STA. 65+50 TO STA. 65+91.26	STA. 65+91.26 TO STA. 76+00
PROFILE TYPE	SUPERCritical TRANSITION	SUPERCritical	SUPERCritical CONTRACTION	FOREWATER
GRADIENT	0.02428	0.02428	0.0225	0.01193 & 0.0126
Qp 100(CFS)	810	810	774	484
n	0.013	0.013	0.013	0.013
D or Dn(FT)	2.44	2.25	3.1	2.05
V or Vn(FPS)	24.36	24.8	15.24	16.79
Dc(FT)	4.64	4.39	4.39	3.32
Fr	3.11	3.33	1.82	2.35
S.E. 0.42'				


REACH	3B	3C	3D	4A SIDE CHANNEL
	STA. 76+00 TO STA. 81+00	STA. 81+00 TO STA. 86+00	STA. 86+00 TO STA. 97+50	STA. 1+16.74 TO STA. 4+64.94
PROFILE TYPE	FOREWATER	FOREWATER	FOREWATER	FOREWATER
GRADIENT	0.0040	0.0140	0.0109	0.0316
Qp 100(CFS)	484	484	290	484
n	0.013	0.013	0.013	0.013
D or Dn(FT)	3.01	2.24	2.36	1.20
V or Vn(FPS)	11.23	17.38	16.08	19.47
Dc(FT)	3.32	3.32	3.32	2.49
Fr	1.38	2.46	2.22	3.42
S.E. 0.87'				

26 17233687

REVISED 11/6/86

AMAFCA

WESTGATE DIVERSION CHANNELS

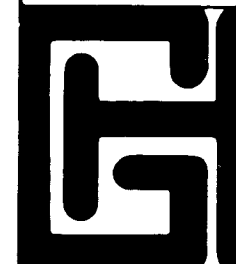

SNOW VISTA CHANNEL PHASE III

LOCATION MAP

AND


GENERAL NOTES

GORDON HERKENHOFF & ASSOCIATES, INC.

ALBUQUERQUE ENGINEERS ARCHITECTS PLANNERS FARMINGTON SANTA FE

PLAN	SURVEYED	DATE
	BY	
NOTE BOOK	ALIGNED	CHECKED
	BY	DATE

PROFILE	SURVEYED	DATE
	BY	
NOTE BOOK	ALIGNED	CHECKED
	BY	DATE

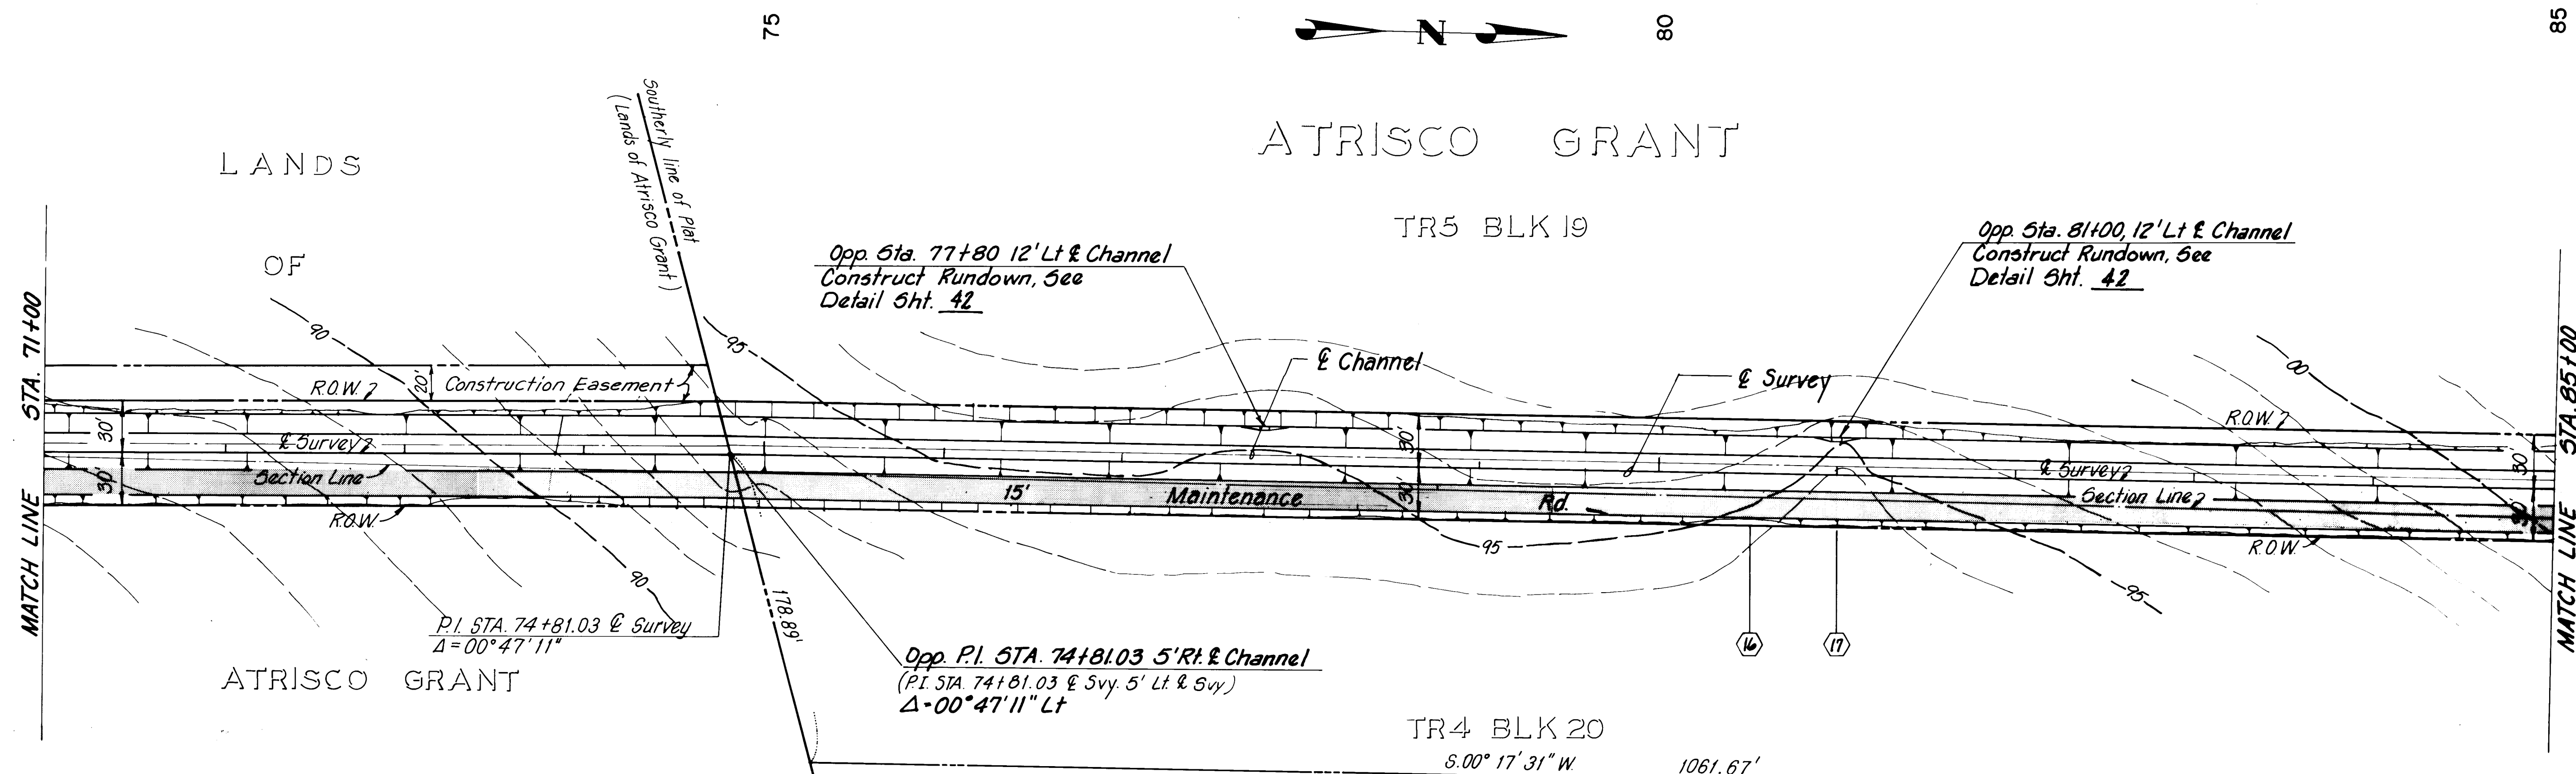


① STA. 58+29.60	CENTERLINE MAIN CHANNEL BEGIN TRANSITION FROM 3'-0" VERTICAL WALL TO 0'-0". SEE TYPICAL DETAIL SHEET 41.	⑦A STA. 66+93.50	CENTERLINE MAIN CHANNEL BEGIN SPLITTER WALL JUNCTION STRUCTURE. SEE SHEET 44.	⑭ STA. 69+50	CENTERLINE MAIN CHANNEL BEGIN TRANSITION FROM 5'-0" DEEP TO 5'-6" DEEP TRAPEZOIDAL CHANNEL. MAINTAIN 6" TRANSVERSE SLOPED BOTTOM. SEE TYPICAL SECTIONS SHEET 42.
② STA. 58+49.60	CENTERLINE MAIN CHANNEL END VERTICAL WALL TRANSITION AND BEGIN TRANSITION FROM 1:5:1 SIDE SLOPE TO 2:1 SIDE SLOPE (TRAPEZOIDAL CHANNEL).	⑧ STA. 1+24.66	CENTERLINE SIDE CHANNEL BEGIN TRANSITION FROM HORIZ. BOTTOM TRAPEZOIDAL TO 6" TRANSVERSE SLOPED BOTTOM. SEE TYPICAL SECTIONS SHEET 49.	⑮ STA. 70+00	CENTERLINE MAIN CHANNEL MAINTAIN 5'-6" DEEP TRAPEZOIDAL CHANNEL AND 6" TRANSVERSE SLOPED BOTTOM.
③ STA. 59+04.60	CENTERLINE MAIN CHANNEL END SIDE SLOPE TRANSITION AND BEGIN TRANSITION FROM HORIZ. BOTTOM TRAPEZOIDAL TO 6" TRANSVERSE SLOPED BOTTOM. SEE TYPICAL SECTION SHEET 41.	⑨ STA. 2+24.66	CENTERLINE SIDE CHANNEL END BOTTOM SLOPED TRANSITION, MAINTAIN TRAPEZOIDAL CHANNEL. SEE TYPICAL SECTIONS SHEET 49.	⑯ STA. 80+50	CENTERLINE MAIN CHANNEL END 5'-6" DEEP TRAPEZOIDAL CHANNEL AND BEGIN TRANSITION TO 5'-0" DEEP TRAPEZOIDAL CHANNEL. MAINTAIN 6" TRANSVERSE SLOPED BOTTOM.
④ STA. 59+54.60	CENTERLINE MAIN CHANNEL END OF BOTT. SLOPED TRANSITION AND BEGIN TRAPEZOIDAL CHANNEL. SEE TYPICAL SECTION SHEET 41.	⑩ STA. 4+02.86	CENTERLINE SIDE CHANNEL BEGIN TRANSITION FROM 6" TRANSVERSE SLOPED BOTTOM TO HORIZ. BOTTOM TRAPEZOIDAL CHANNEL.	⑰ STA. 81+00	CENTERLINE MAIN CHANNEL END DEPTH TRANSITION AND BEGIN 5'-0" DEEP TRAPEZOIDAL CHANNEL TO STA. 97+30 CENTERLINE MAIN CHANNEL, MAINTAIN 6" TRANSVERSE SLOPED BOTTOM.
⑤ STA. 65+00.00	CENTERLINE MAIN CHANNEL END TRAPEZOIDAL CHANNEL AND BEGIN TRANSITION FROM 6" TRANSVERSE SLOPED BOTTOM TO HORIZ. BOTTOM TRAPEZOIDAL CHANNEL.	⑪ STA. 4+52.86	CENTERLINE SIDE CHANNEL END BOTTOM SLOPED TRANSITION, MAINTAIN HORIZ. BOTTOM TO STA. 4+64.74.	⑱ STA. 97+30	CENTERLINE MAIN CHANNEL END 5'-0" DEEP TRAPEZOIDAL CHANNEL AND BEGIN TRANSITION TO 7'-6" DEEP TRAPEZOIDAL CHANNEL, MAINTAIN 6" TRANSVERSE SLOPED BOTTOM.
⑥ STA. 65+50	CENTERLINE MAIN CHANNEL END BOTTOM SLOPED TRANSITION, BEGIN TRANSITION FROM 10' WIDE BOTTOM TO 19.22' WIDE BOTTOM TRAPEZOIDAL CHANNEL - CHANNEL DEPTH ALSO DECREASES FROM 5'-6" TO 5'-0". SEE TYPICAL SECTION SHEET 41.	⑫ STA. 68+22.38	CENTERLINE MAIN CHANNEL BEGIN TRANSITION FROM 5'-0" DEEP HORIZ. BOTTOM TRAPEZOIDAL CHANNEL TO 6" TRANSVERSE SLOPED BOTTOM. SEE TYPICAL SECTION SHEET 41 & 42.	⑲ STA. 97+50	END CHANNEL CONSTRUCTION.
⑦ STA. 65+91.26	CENTERLINE MAIN CHANNEL END BOTTOM WIDTH AND DEPTH TRANSITION AND BEGIN 19.22' WIDE BOTTOM TRAPEZOIDAL CHANNEL. END AT STA. 66+93.50. SEE TYPICAL SECTIONS SHEET 41.	⑬ STA. 68+72.38	CENTERLINE MAIN CHANNEL END BOTTOM TRANSITION.		

Note: TR4-BLK 20 is AMAFCA Property. This site may be used as a spoil area for excess excavation at the contractors option. If used for excess excavation, the following procedure will be followed:

1. Strip area and stockpile strippings.
2. Stockpile excess excavation outside of the channel ROW limits. No debris will be allowed.
3. Place strippings on outside of spoil stockpile and seed and mulch per section 212 of the specifications.
4. Spoil stockpile will be the property of AMAFCA.
5. No extra payment will be made to the contractor for use of this tract for spoil.

NOTE: Profile Stationing is along & Channel


Scales:
Horz: 1" = 50'
Vert: 1" = 5'

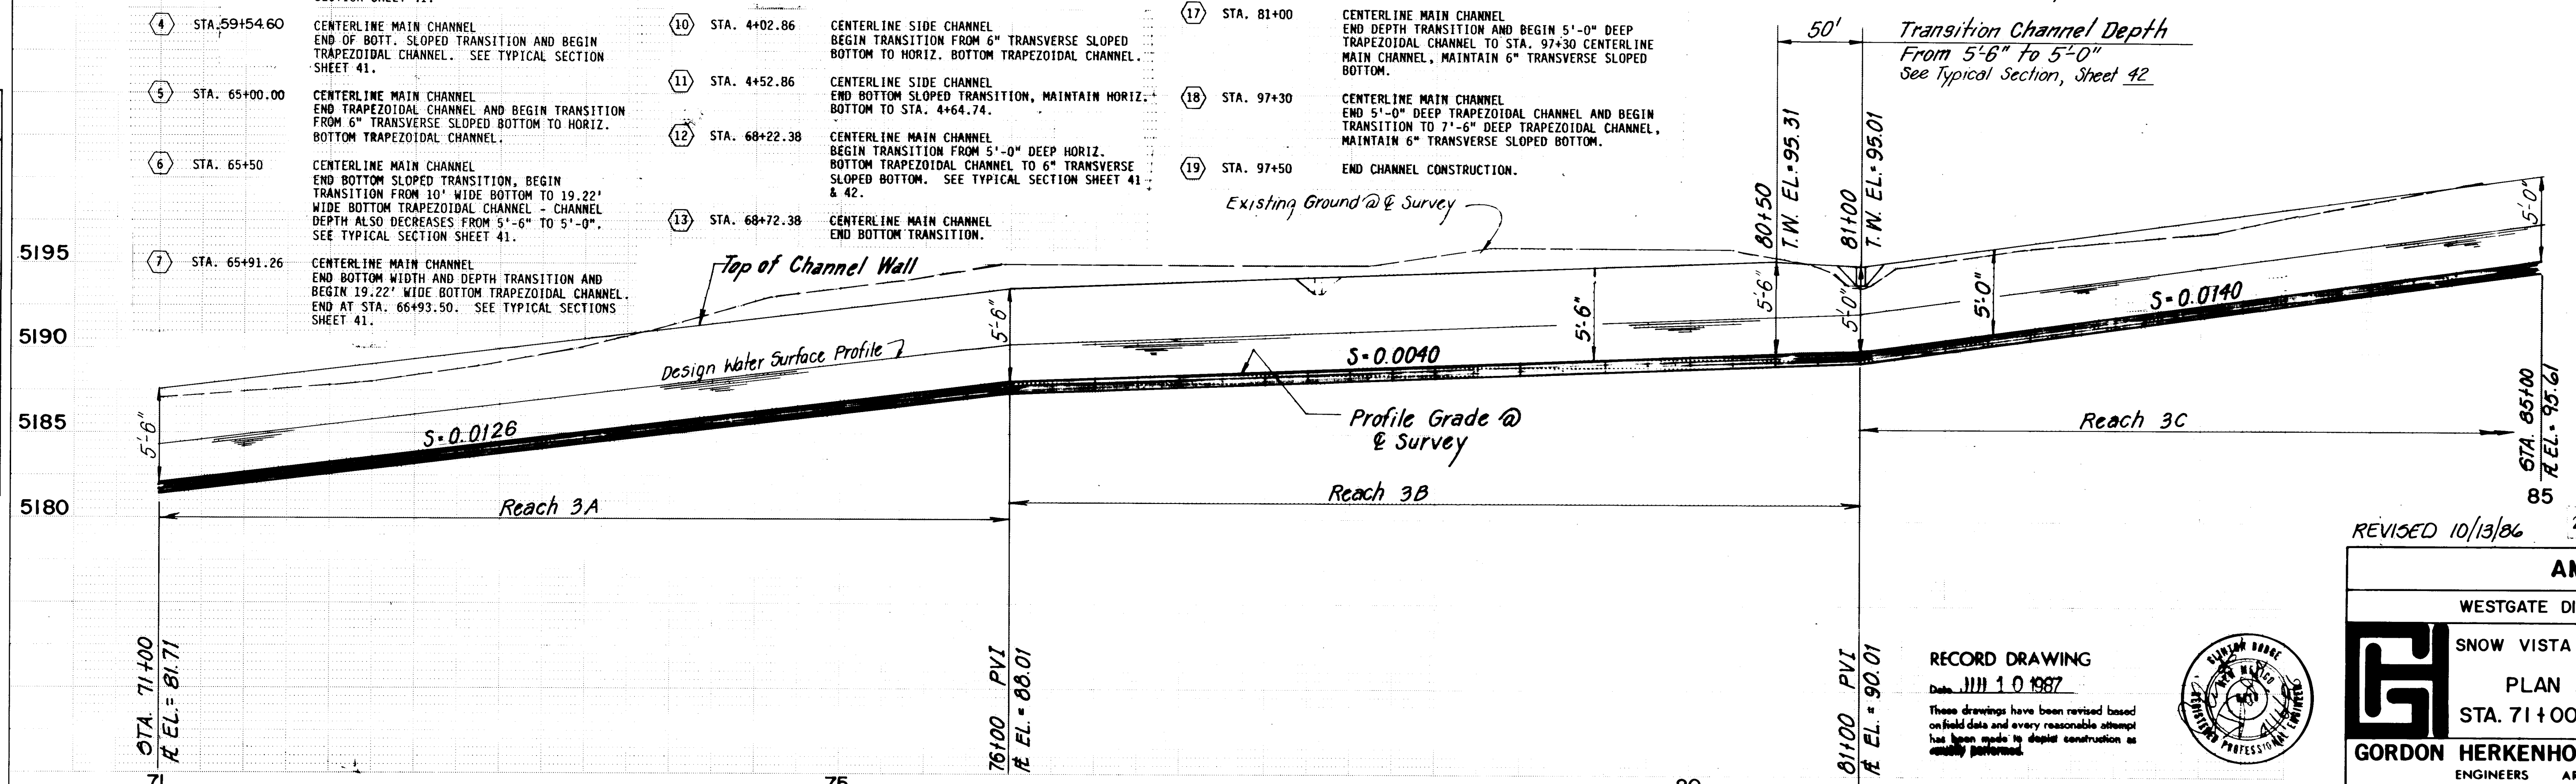

REVISED 10/13/86 26 17233887



AMAFCA	
WESTGATE DIVERSION CHANNELS	
SNOW VISTA CHANNEL PHASE III	
PLAN AND PROFILE	
STA. 71+00 TO STA. 85+00	
GORDON HERKENHOFF & ASSOCIATES, INC.	
ALBUQUERQUE ENGINEERS ARCHITECTS PLANNERS SANTA FE	

RECORD DRAWING
Date: 11/11/10 1987
These drawings have been revised based on field data and every reasonable attempt has been made to depict construction as actually performed.



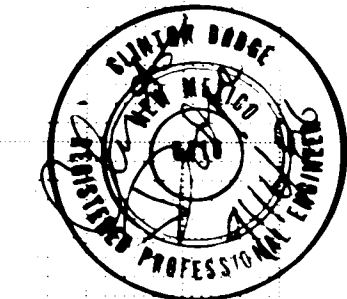


PROFILE NO. _____ NOTE BOOK _____	SURVEYED _____	BY _____ DATE _____
	PLOTTED _____	
	GRADES CHECKED _____	
	B. M.'S. NOTED _____	
	STRUCTURE NOTATIONS CHECKED _____	



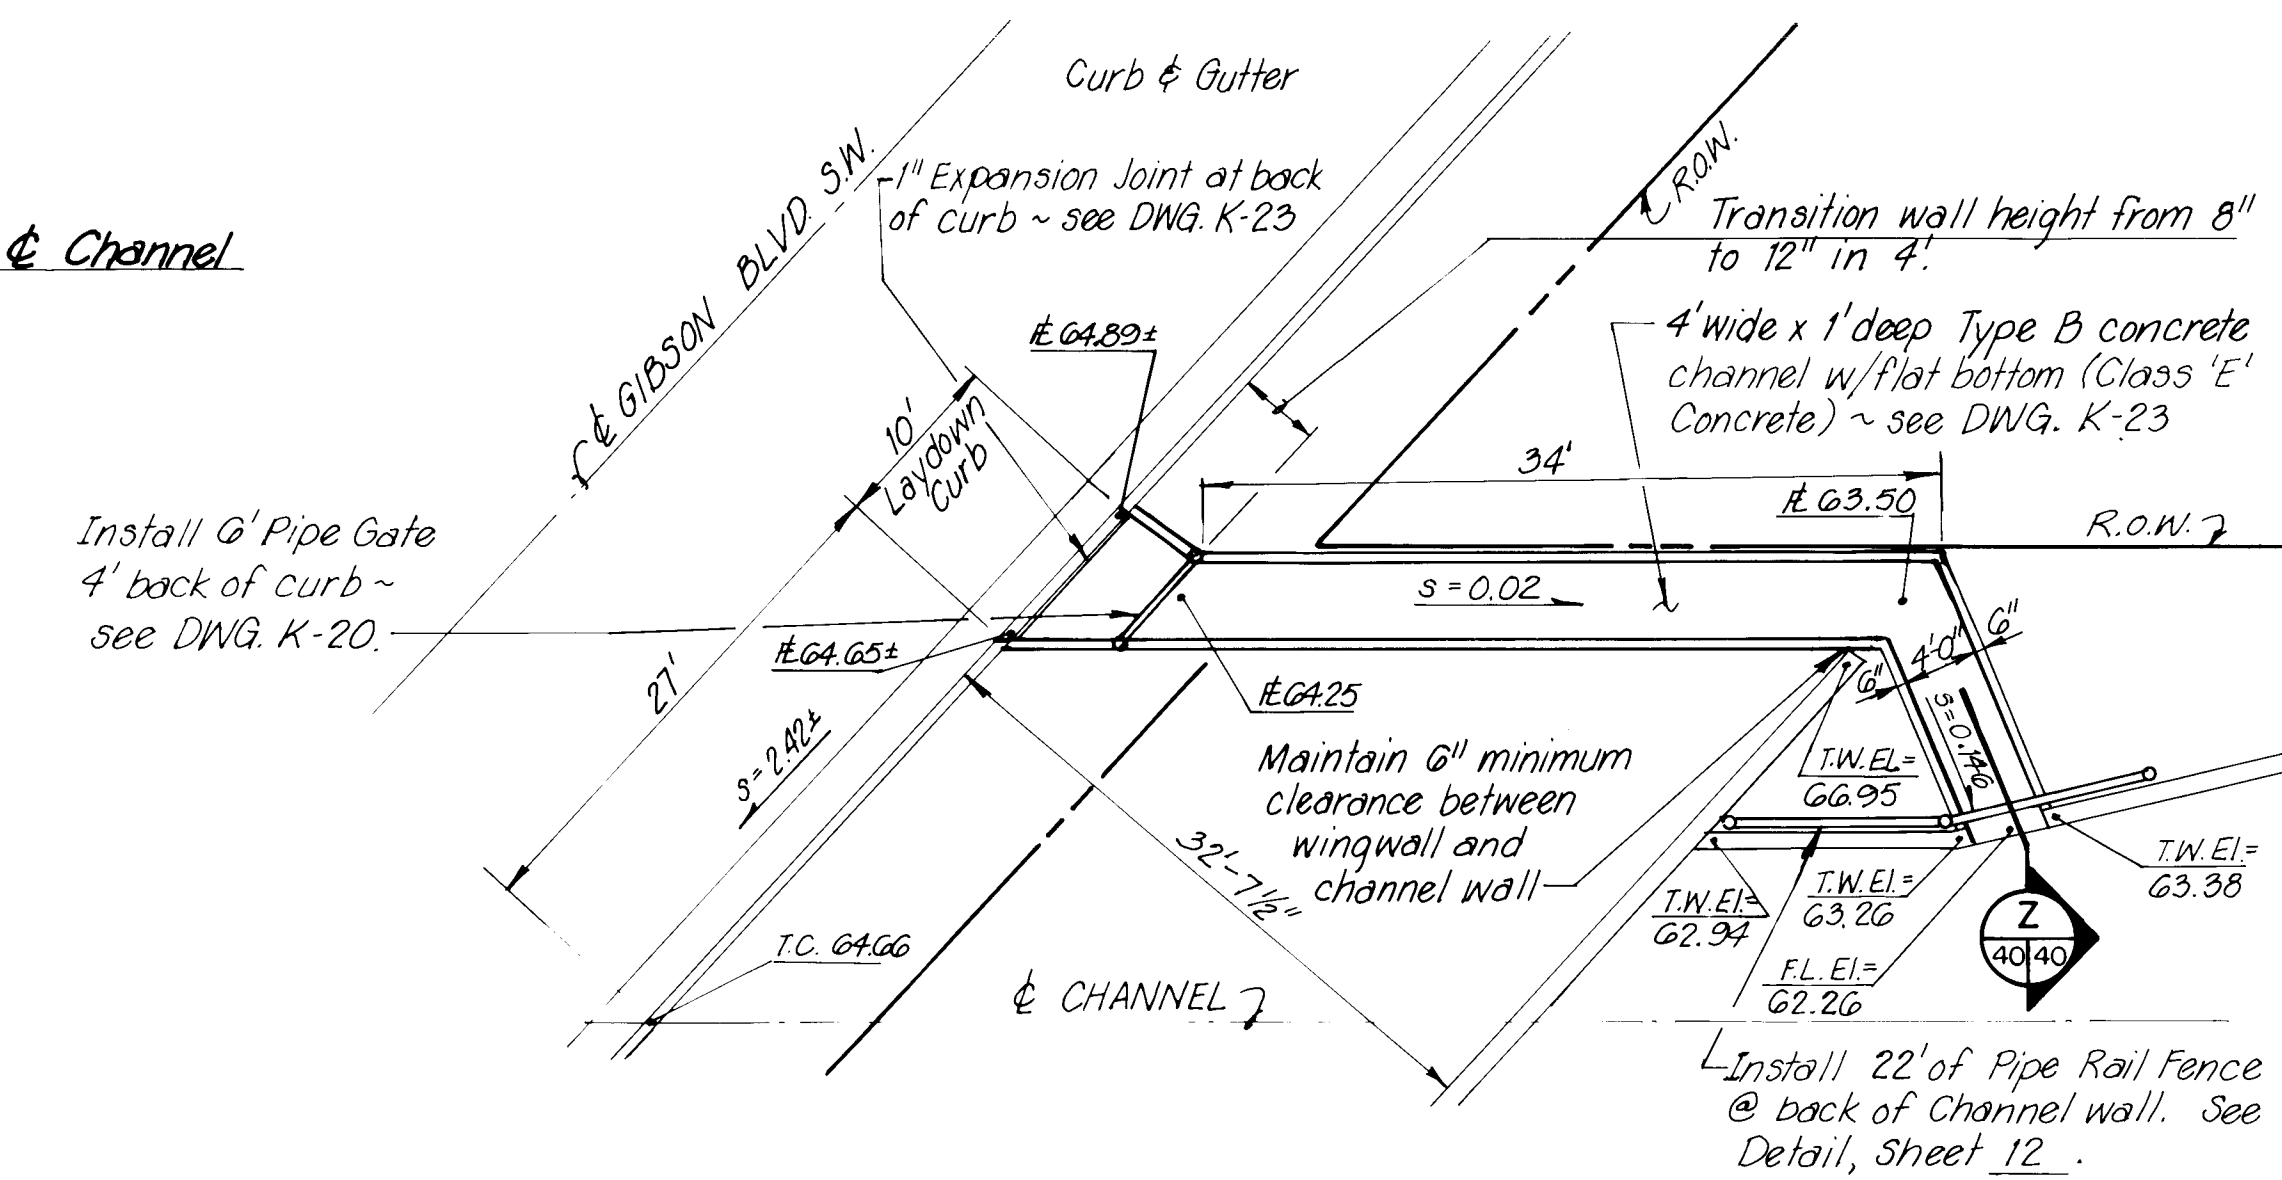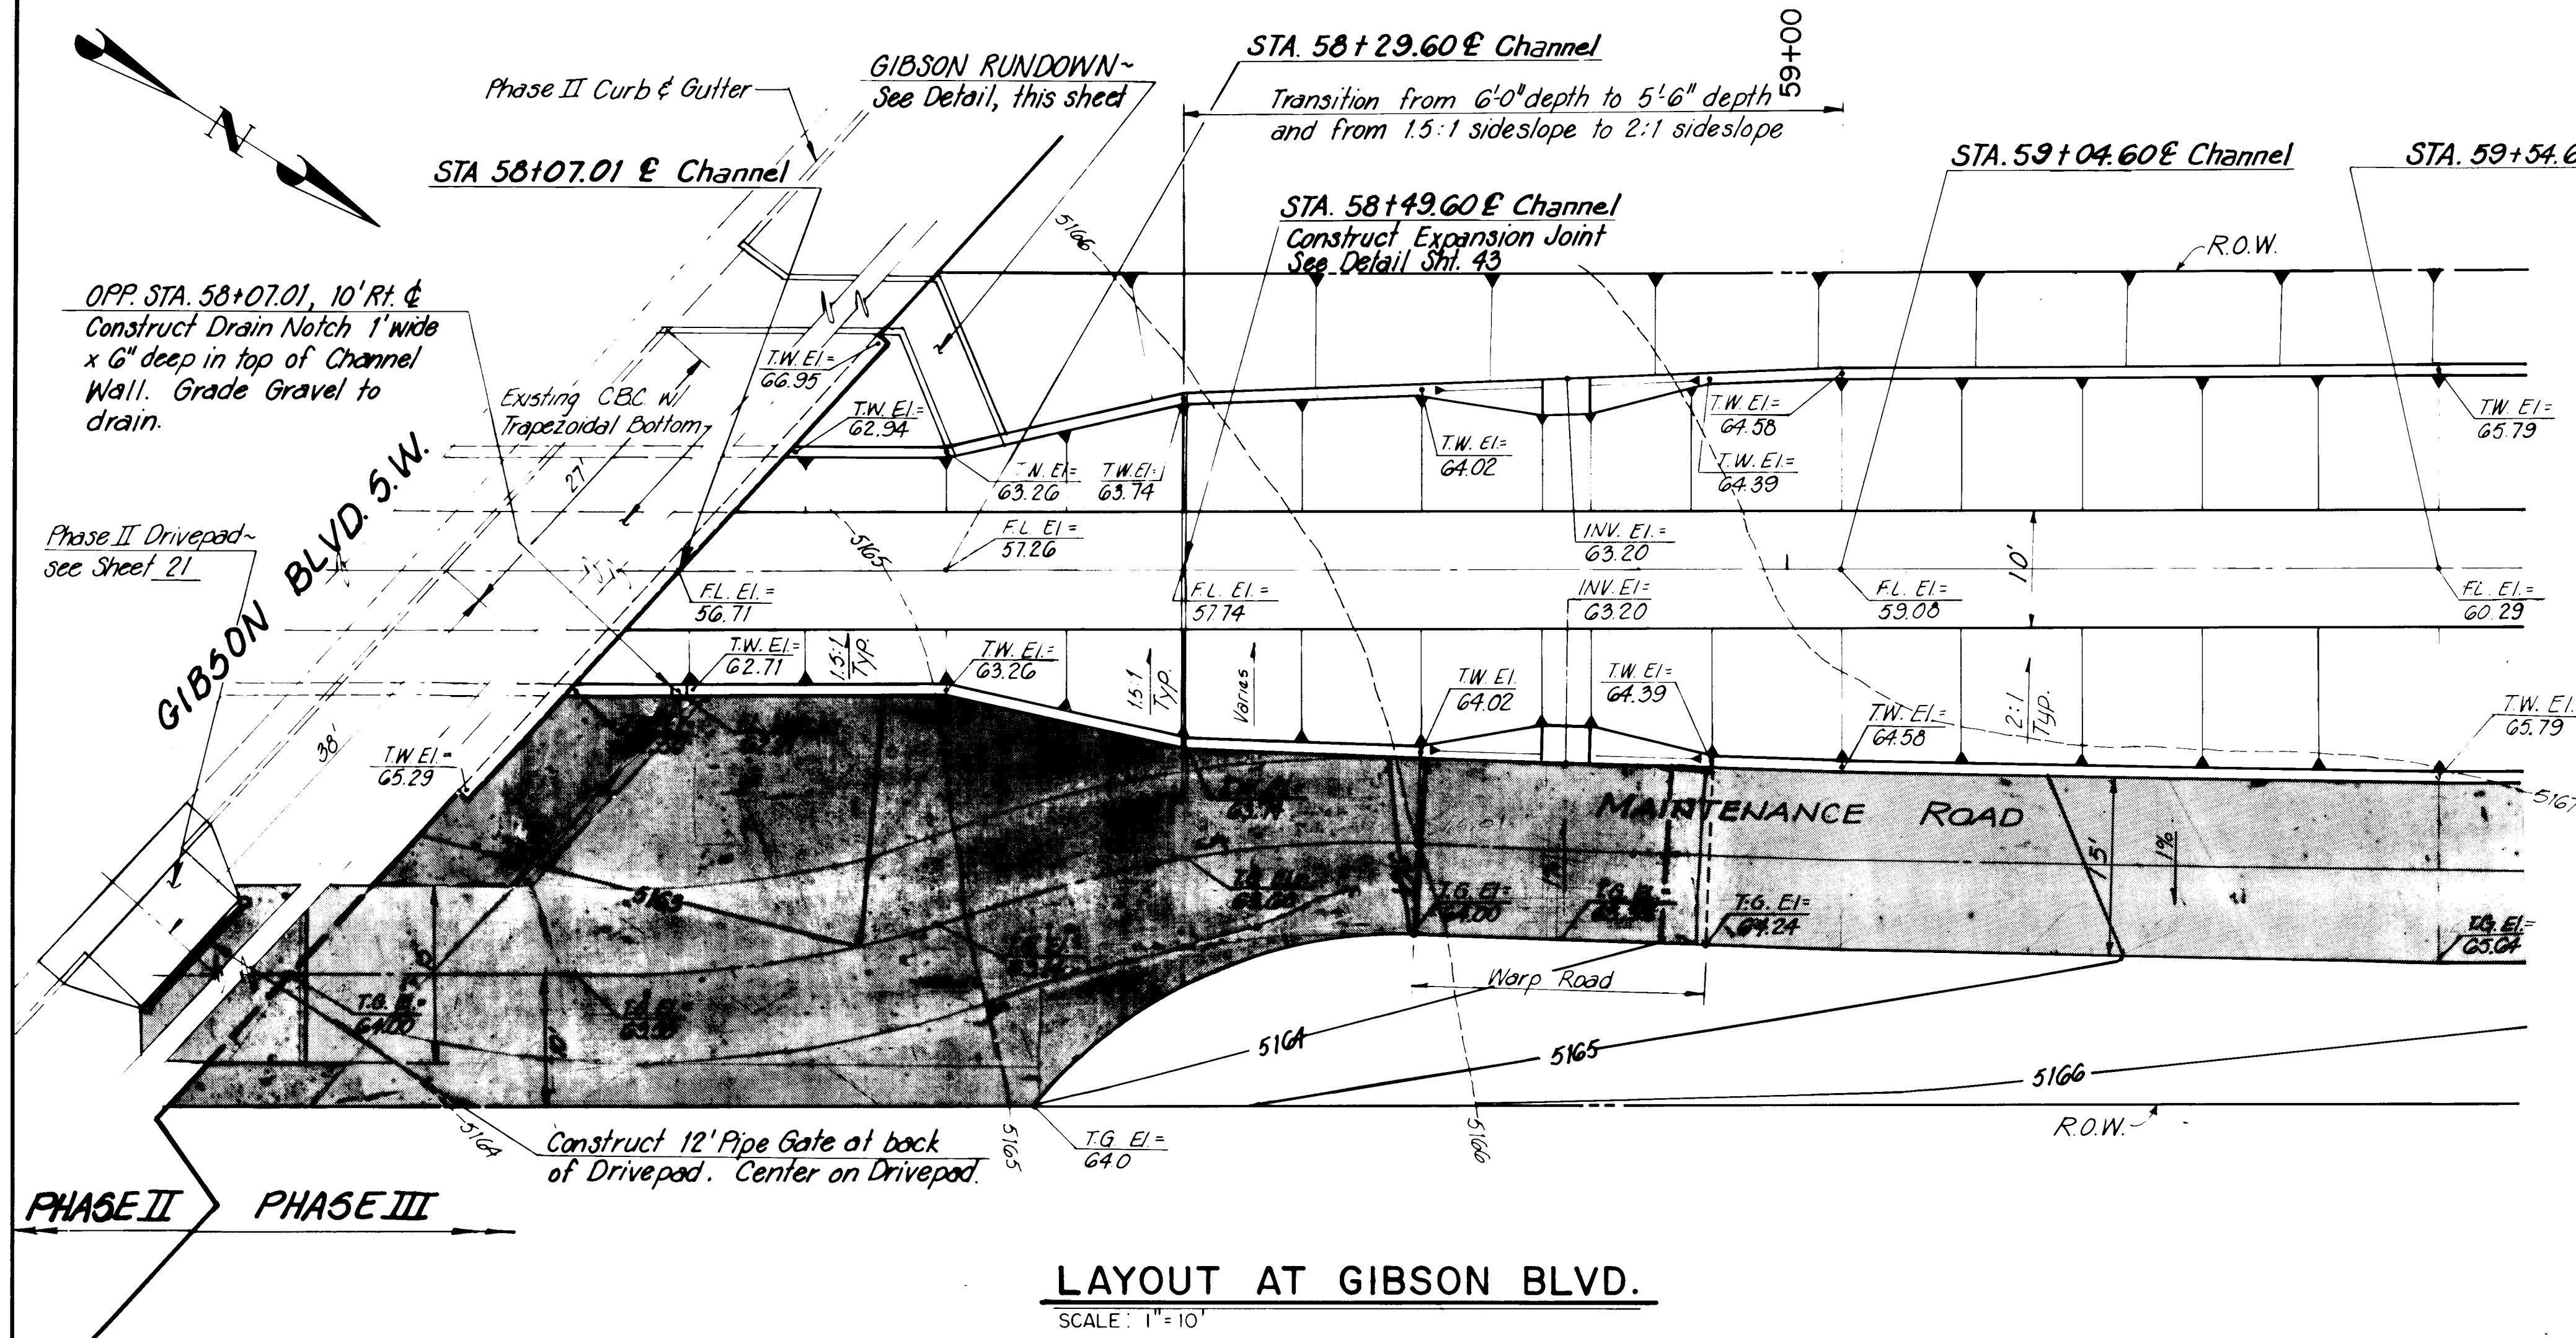

LEGEND
FL E.I. — Flow Line Elevation
TW E.I. — Top of Wall Elevation
T.S.W. E.I. — Top of Side Walk Elevation
T.G. E.I. — Top of Gravel Elevation

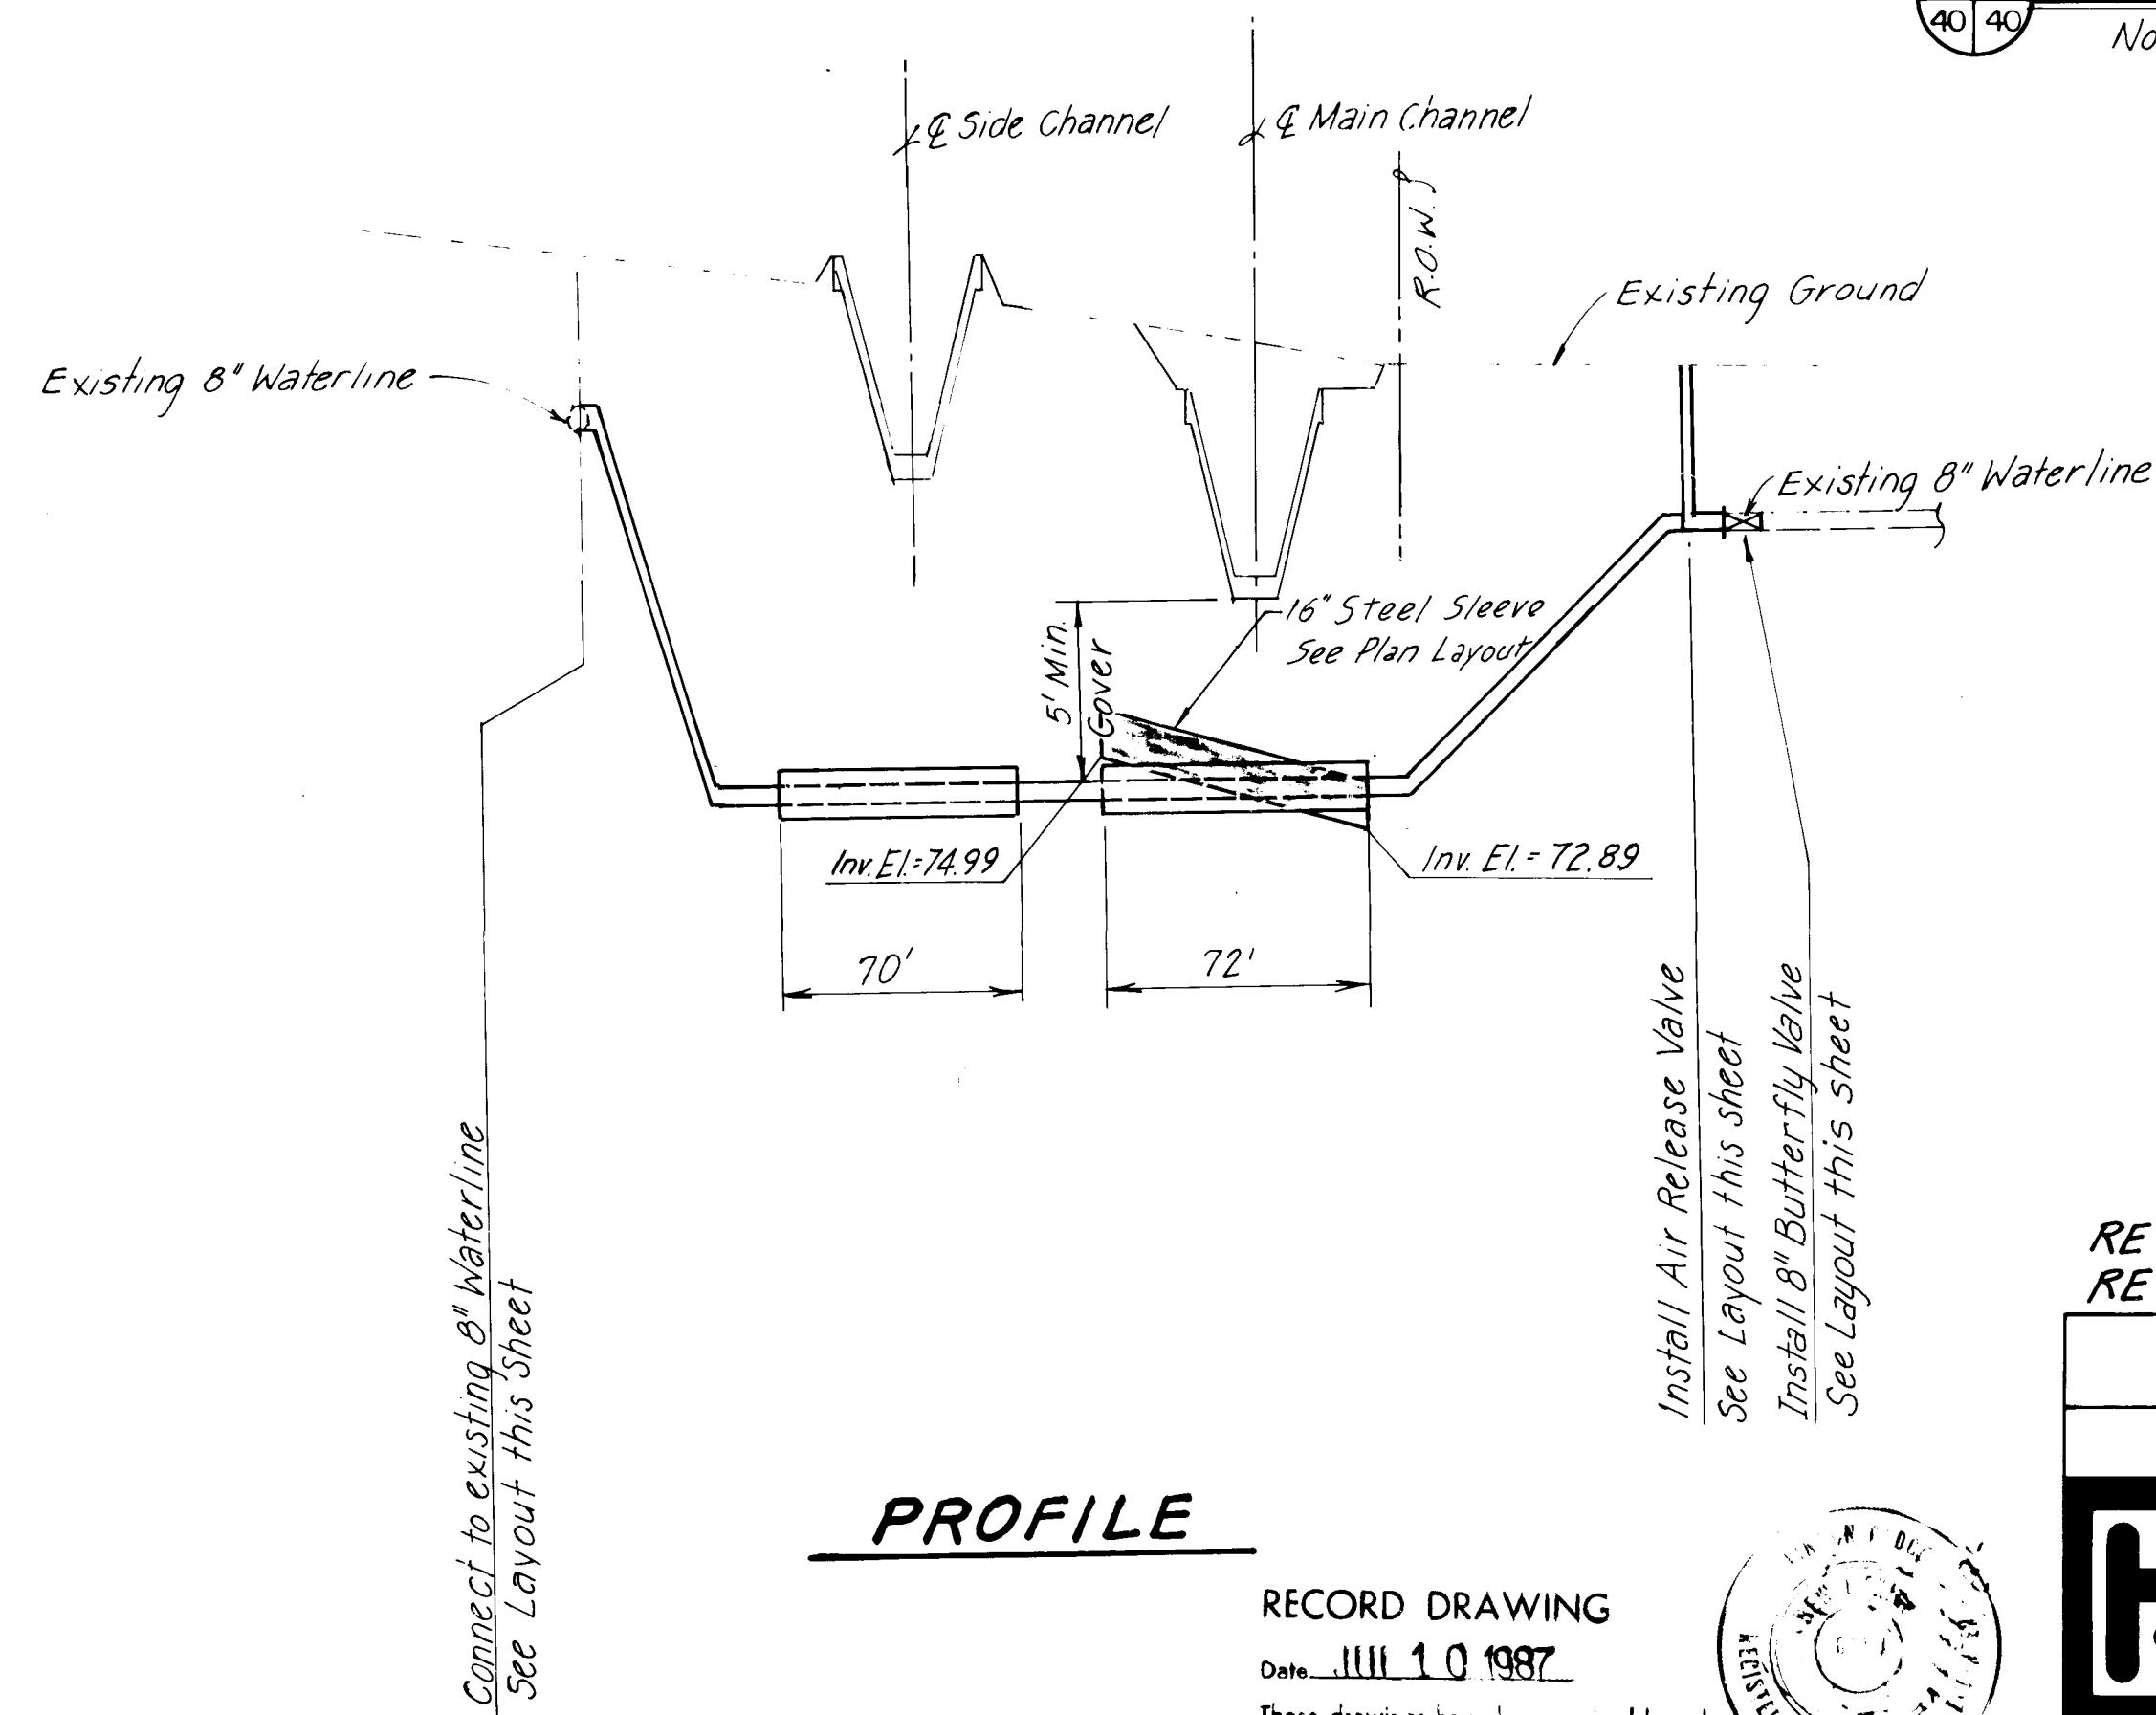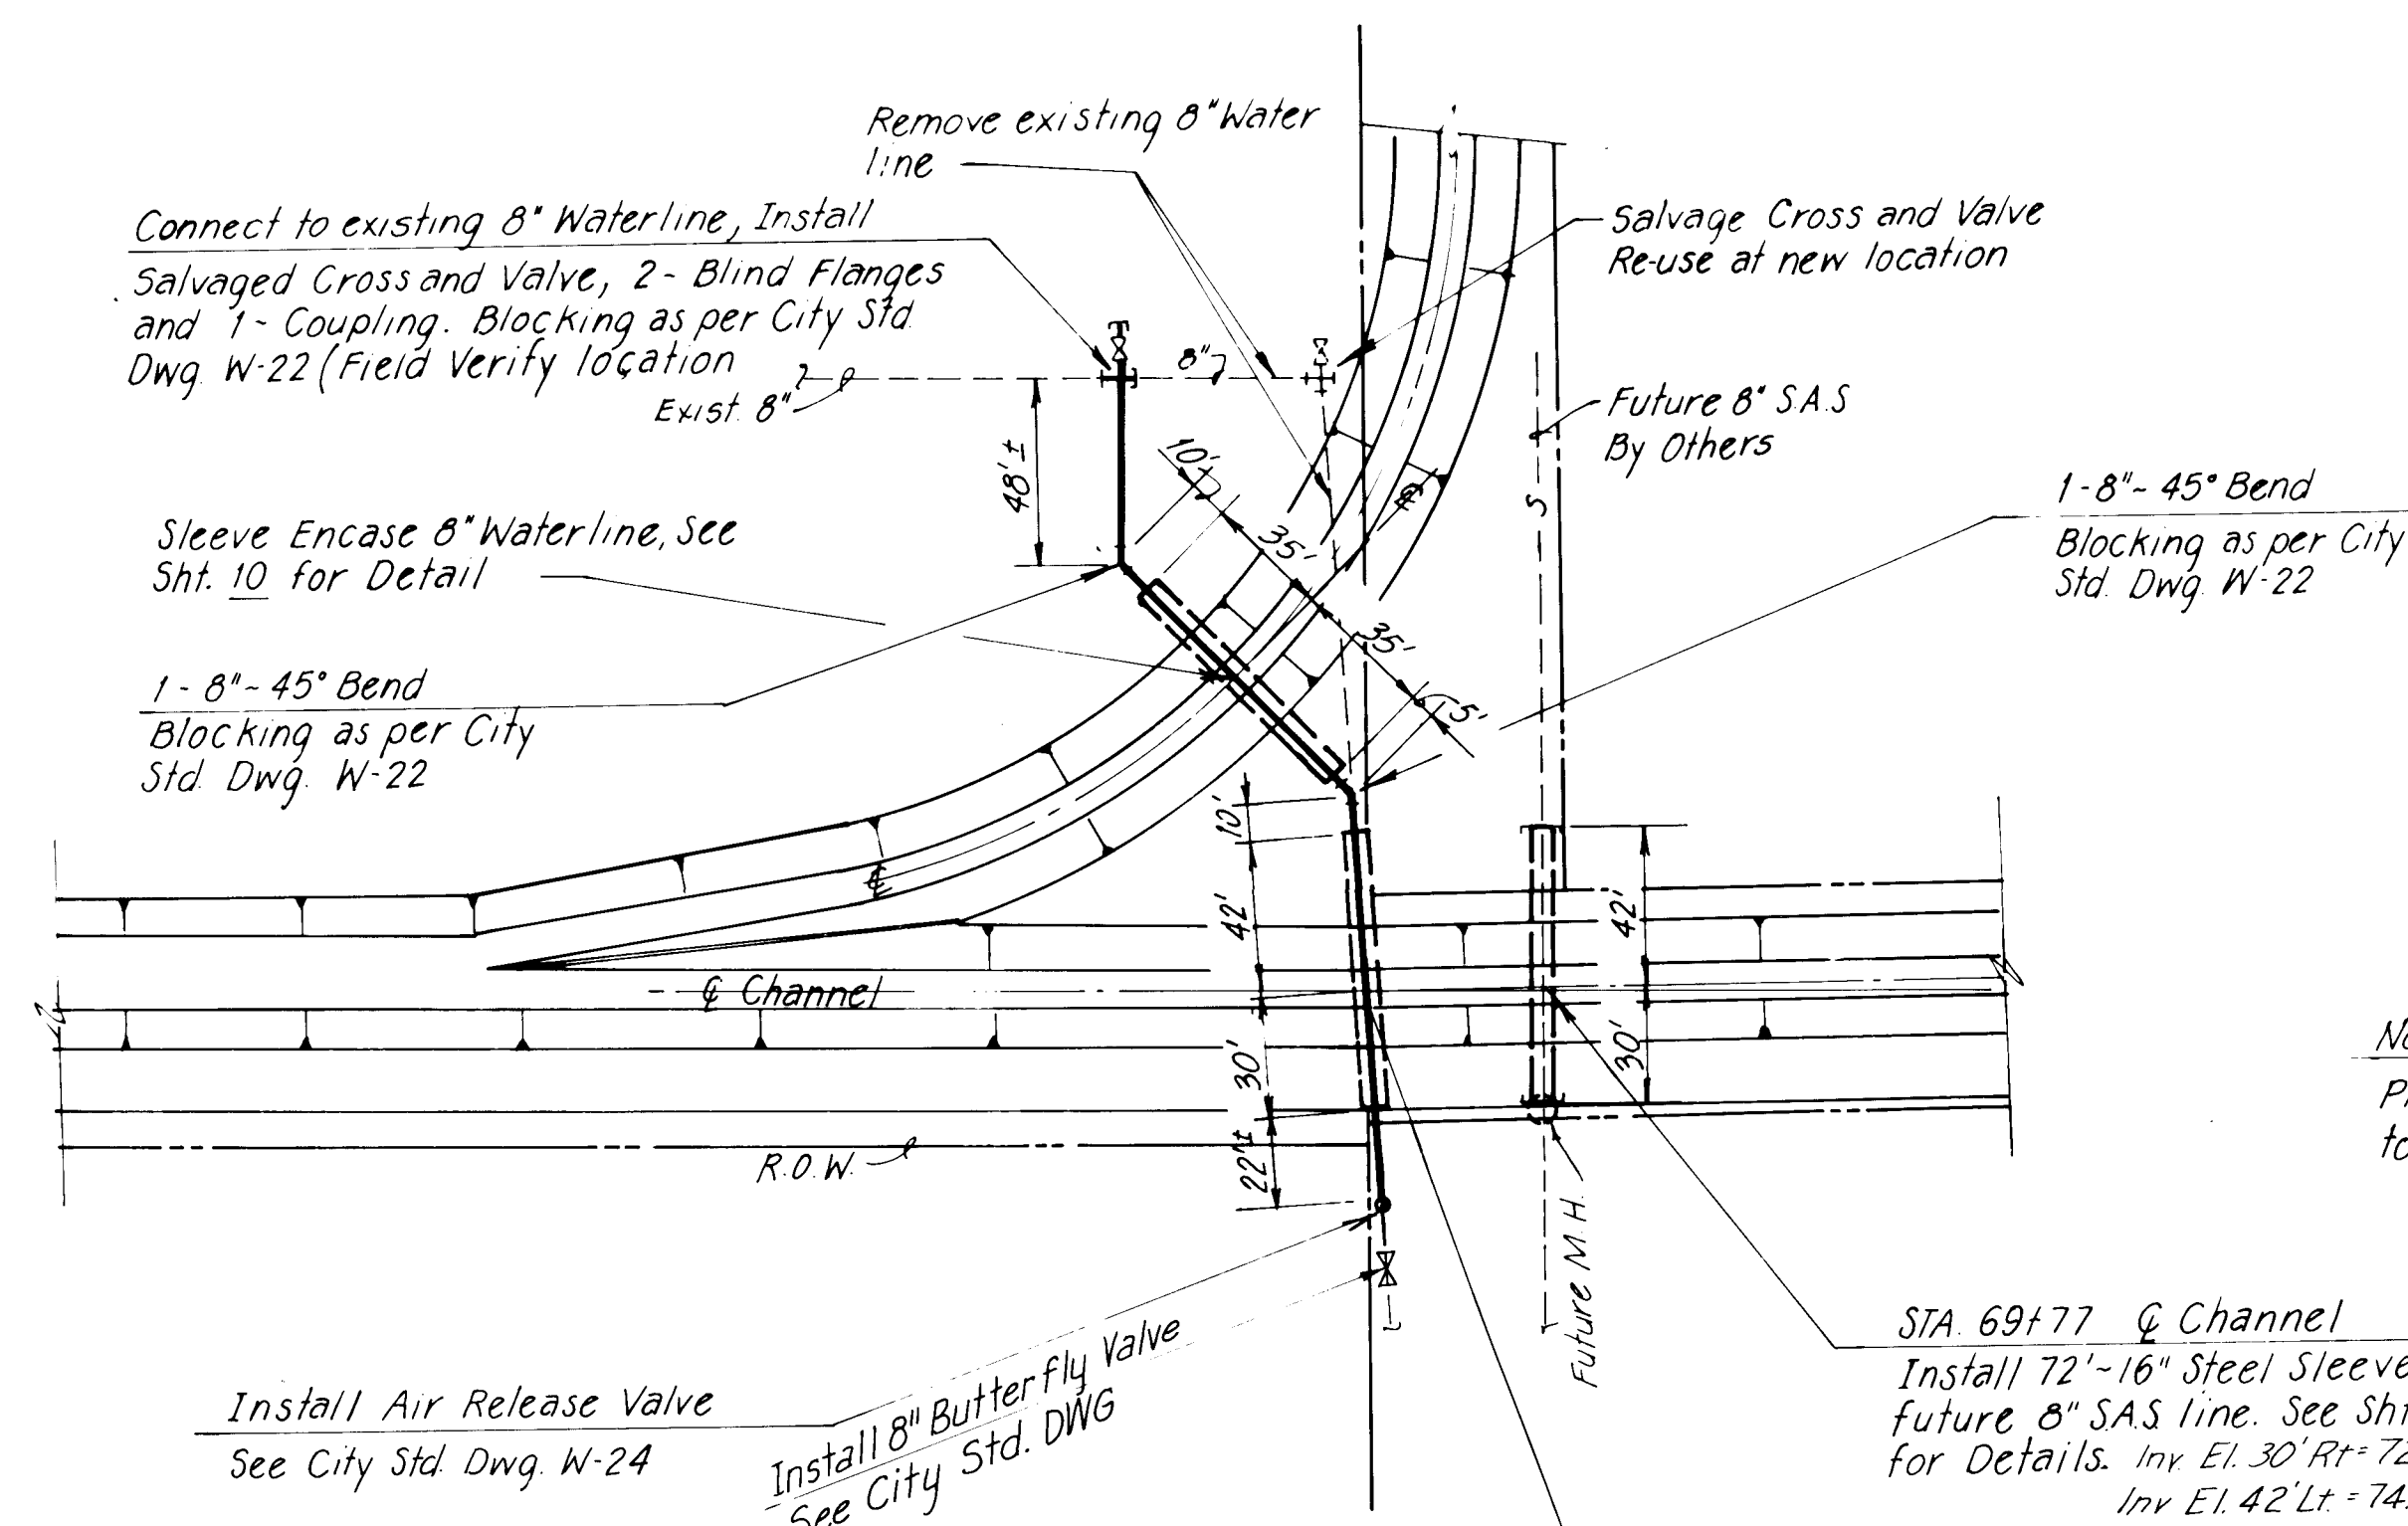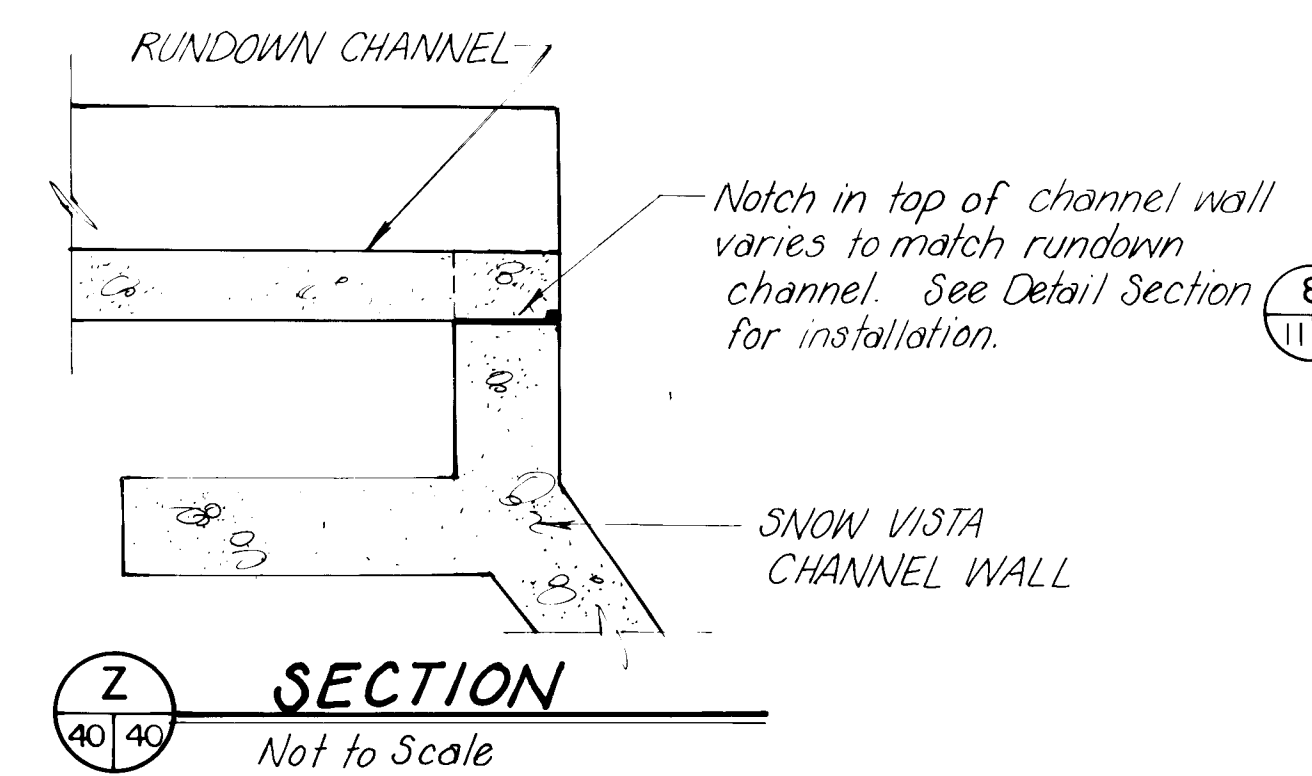

REVISED 11/6/86 26 17234087
REVISED 10/13/86

AMAFCA

WESTGATE DIVERSION CHANNELS


SNOW VISTA CHANNEL PHASE III

LAYOUT AT GIBSON BLVD.


GORDON HERKENHOFF & ASSOCIATES, INC.
ENGINEERS ARCHITECTS PLANNERS
ALBUQUERQUE SANTA FE

DRAWN BY
DATE
SCALE
AS SHOWN

WATERLINE RELOCATION~PLAN AND PROFILE

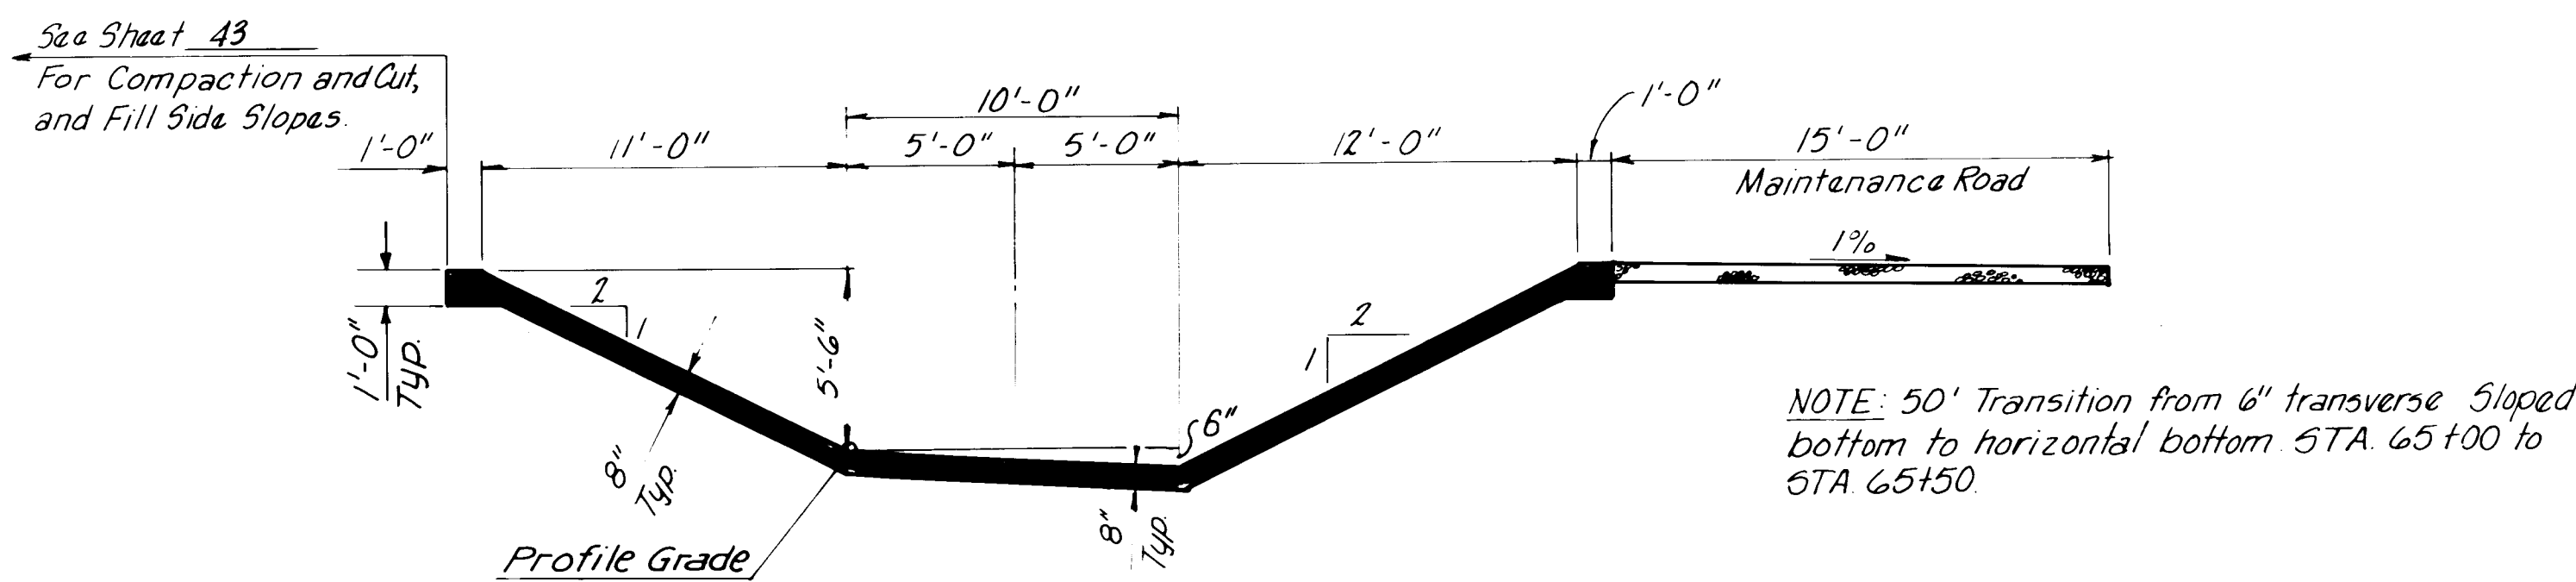


TYPICAL CHANNEL SECTION
MAIN CHANNEL STA. 59+54.60 TO STA. 65+00

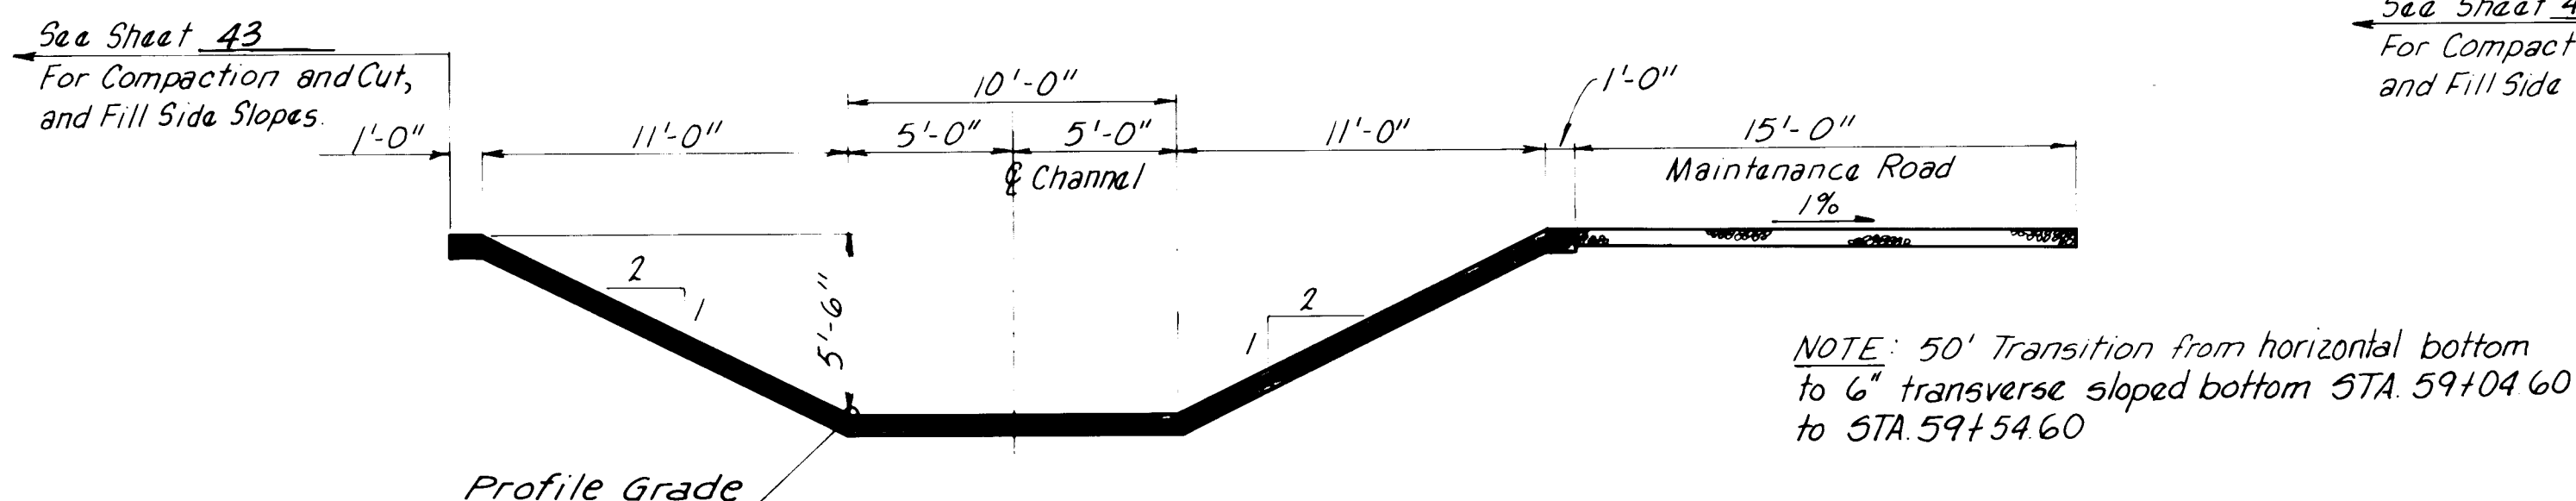


TYPICAL CHANNEL SECTION
MAIN CHANNEL STA. 59+04.60


NOTE: Transition Channel Side Slope from 15:1 to 2:1 and Channel depth from 6'-0" to 5'-6" from STA. 58+49.60 to STA. 59+04.60

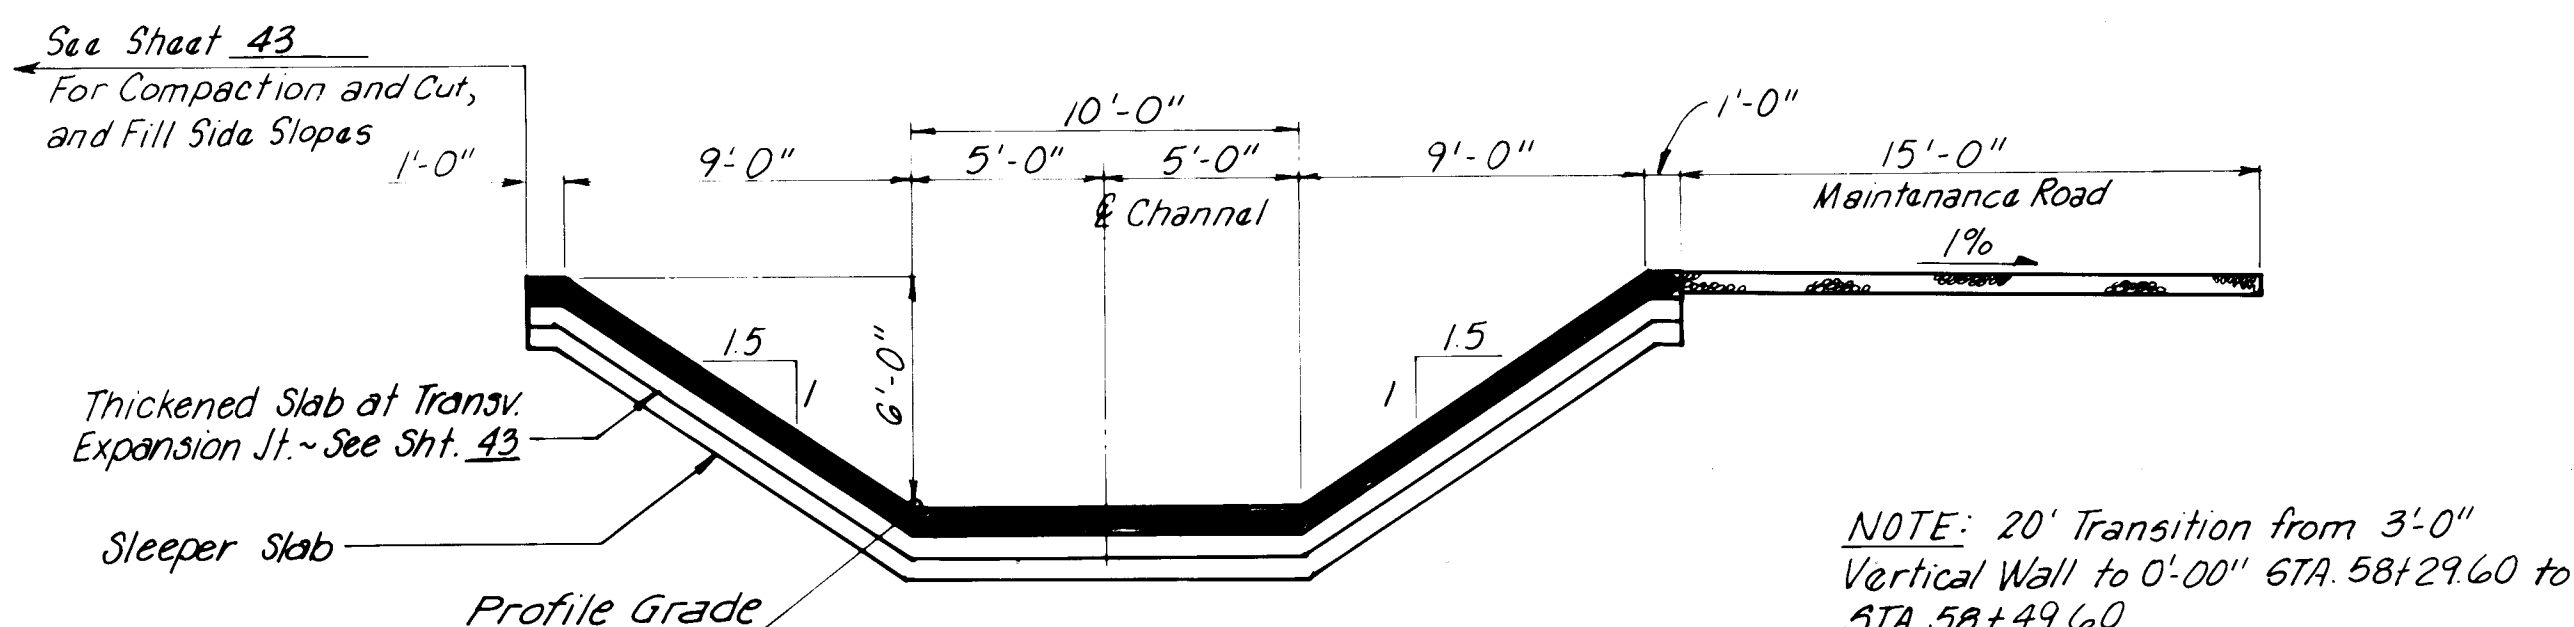

TYPICAL CHANNEL SECTION
MAIN CHANNEL STA. 58+49.60

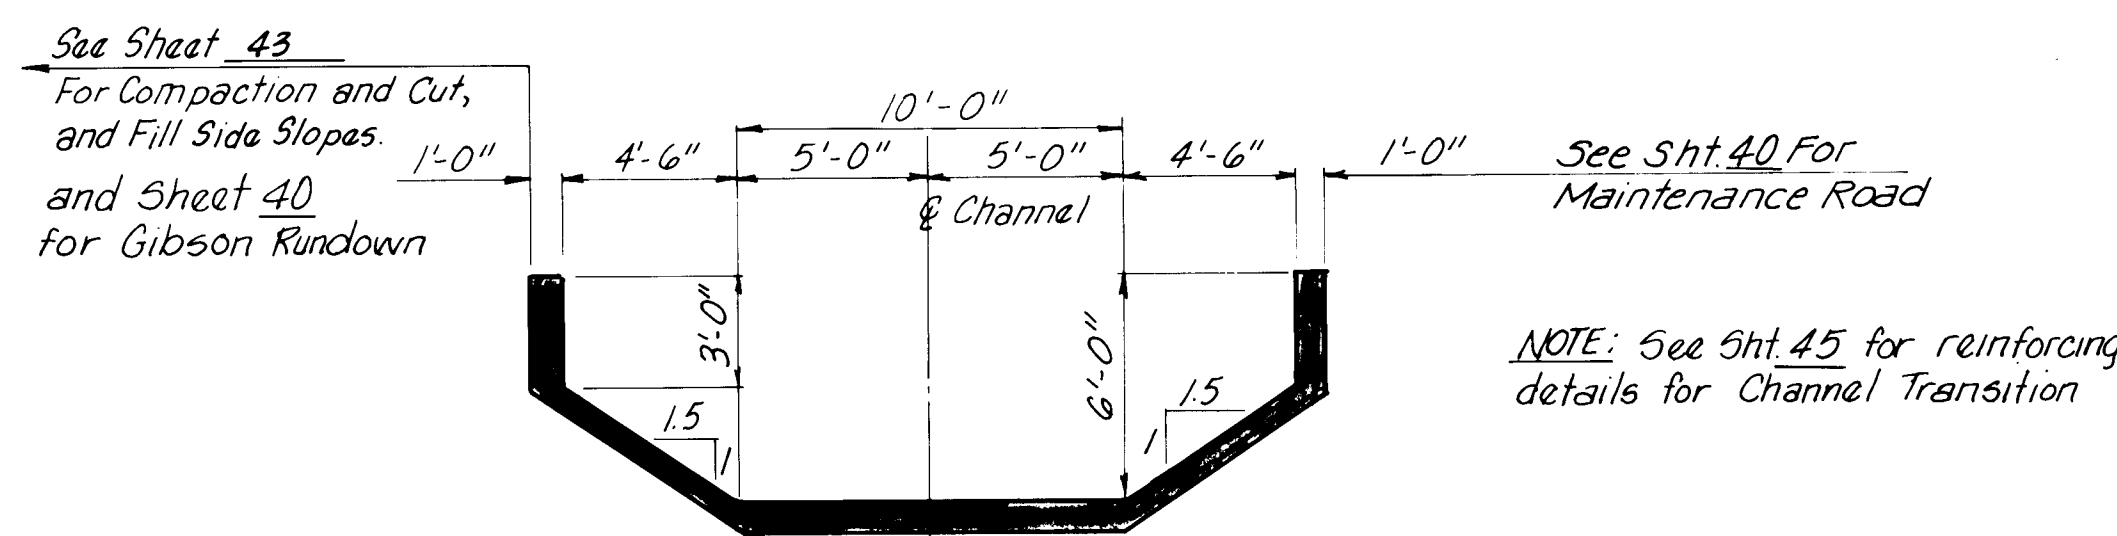


TYPICAL CHANNEL SECTION
MAIN CHANNEL STA. 58+07.01 TO STA. 58+29.60

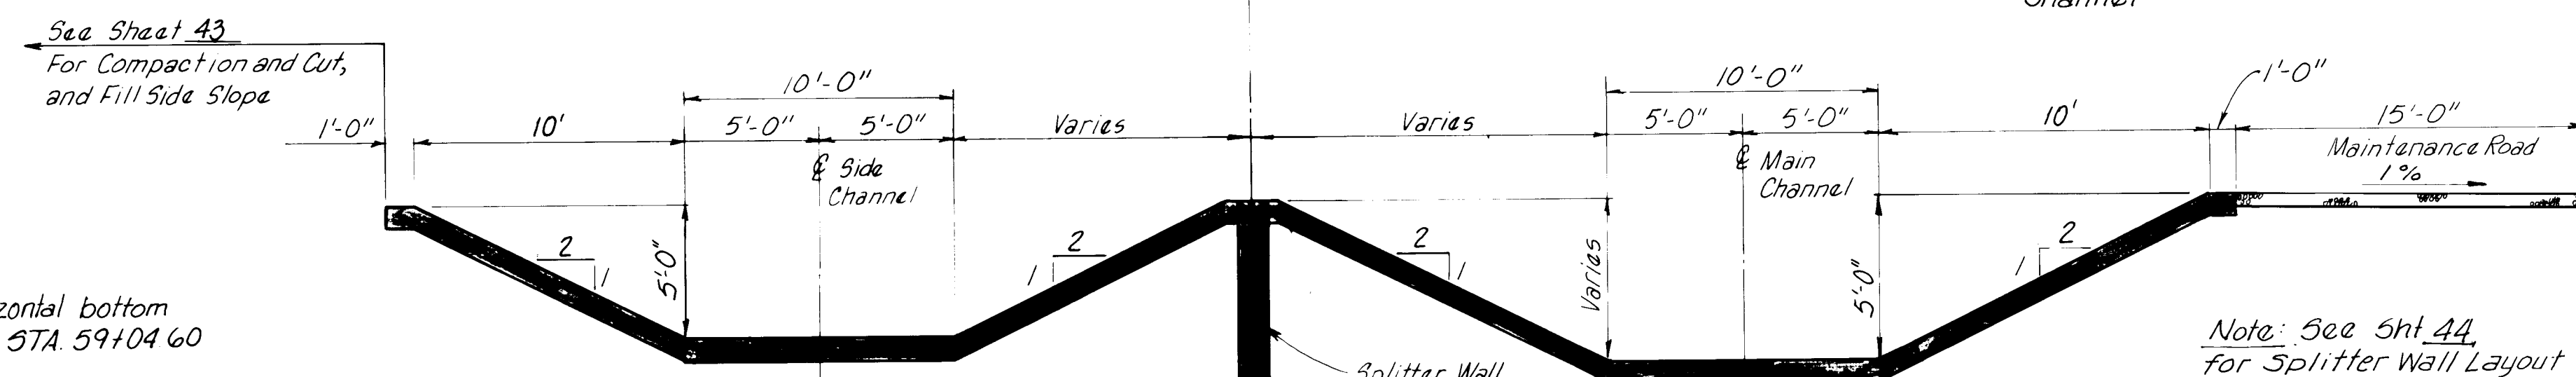


STA. 0+71.12 TO
STA. 1+97.50 SIDE CHANNEL

STA. 66+93.50
STA. 68+22.38 MAIN CHANNEL

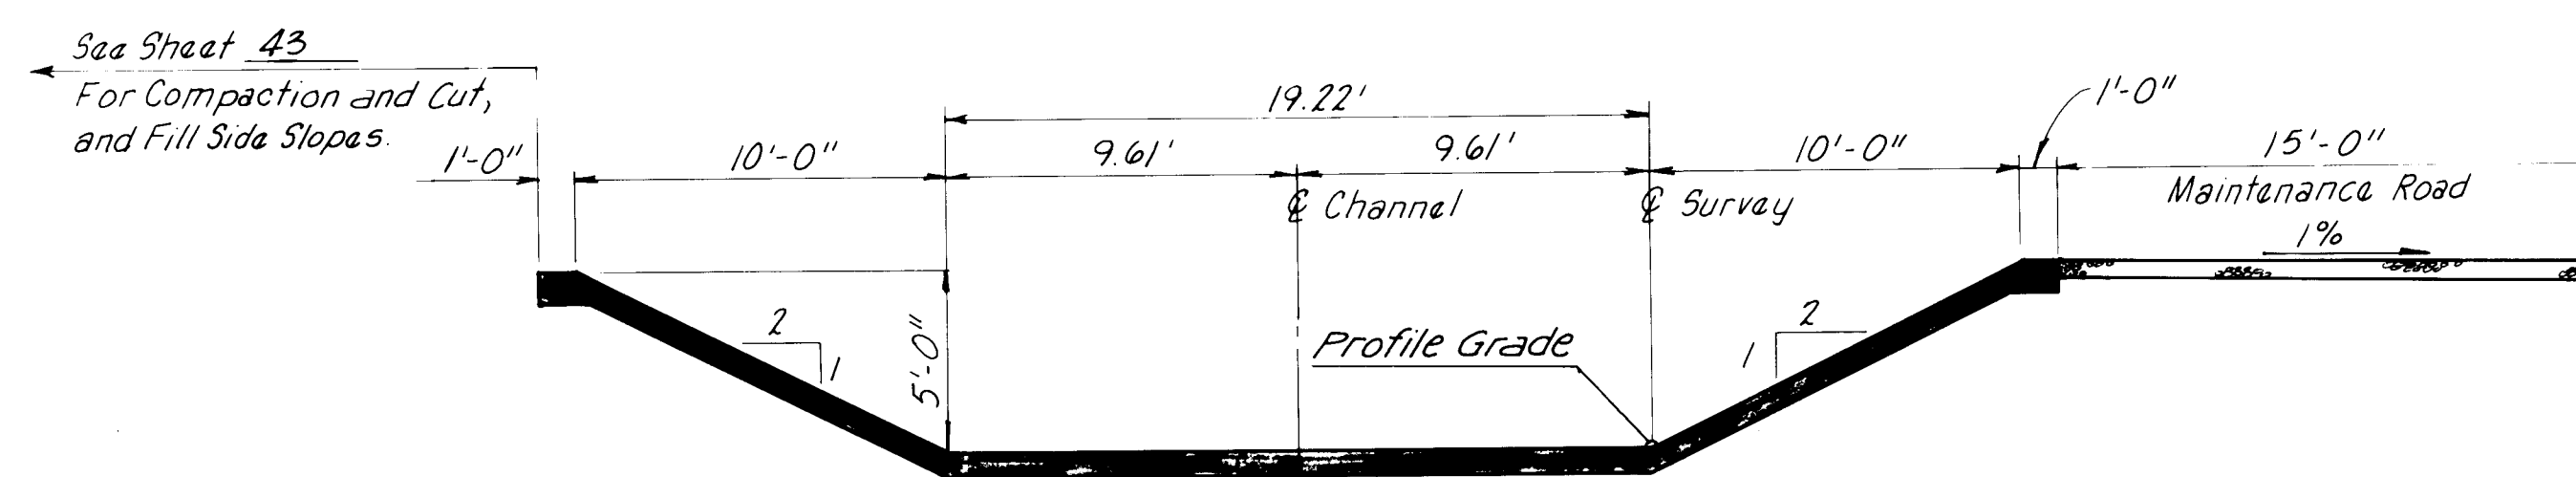

TYPICAL CHANNEL SECTION
MAIN CHANNEL STA. 65+91.26 TO STA. 66+93.50

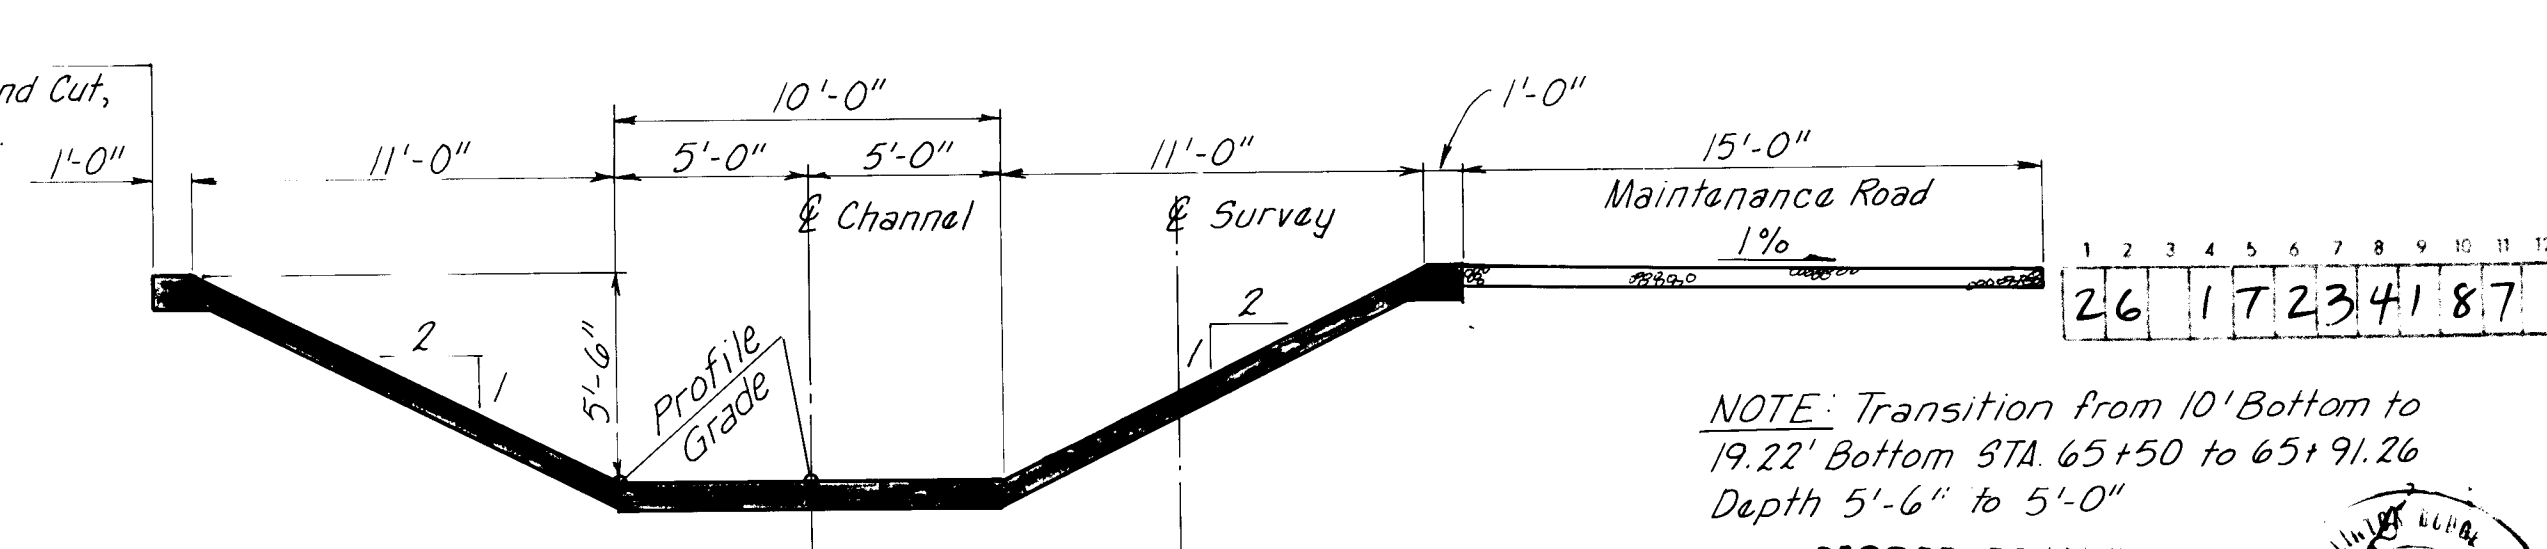

TYPICAL CHANNEL SECTION
MAIN CHANNEL STA. 65+50

NOTE: Transition from 10' Bottom to 19.22' Bottom STA. 65+50 to 65+91.26 Depth 5'-6" to 5'-0"

RECORD DRAWING

Date: 11/11/07

These drawings have been revised based on field data and every reasonable attempt has been made to depict construction as actually performed.

NOTES:
STA. 65+91.26 to STA. 97+40 Profile Grade @ Survey
STA. 65+50 to STA. 65+91.26 Profile Grade @ Channel
STA. 58+07.01 to STA. 65+50 Profile Grade @ 5' Lt. Channel.

REVISED 11/6/68
REVISED 10/13/86


AMAFCA

WESTGATE DIVERSION CHANNELS


SNOW VISTA CHANNEL PHASE III

TYPICAL CHANNEL SECTIONS


GORDON HERKENHOFF & ASSOCIATES, INC.
ENGINEERS ARCHITECTS PLANNERS
ALBUQUERQUE SANTA FE

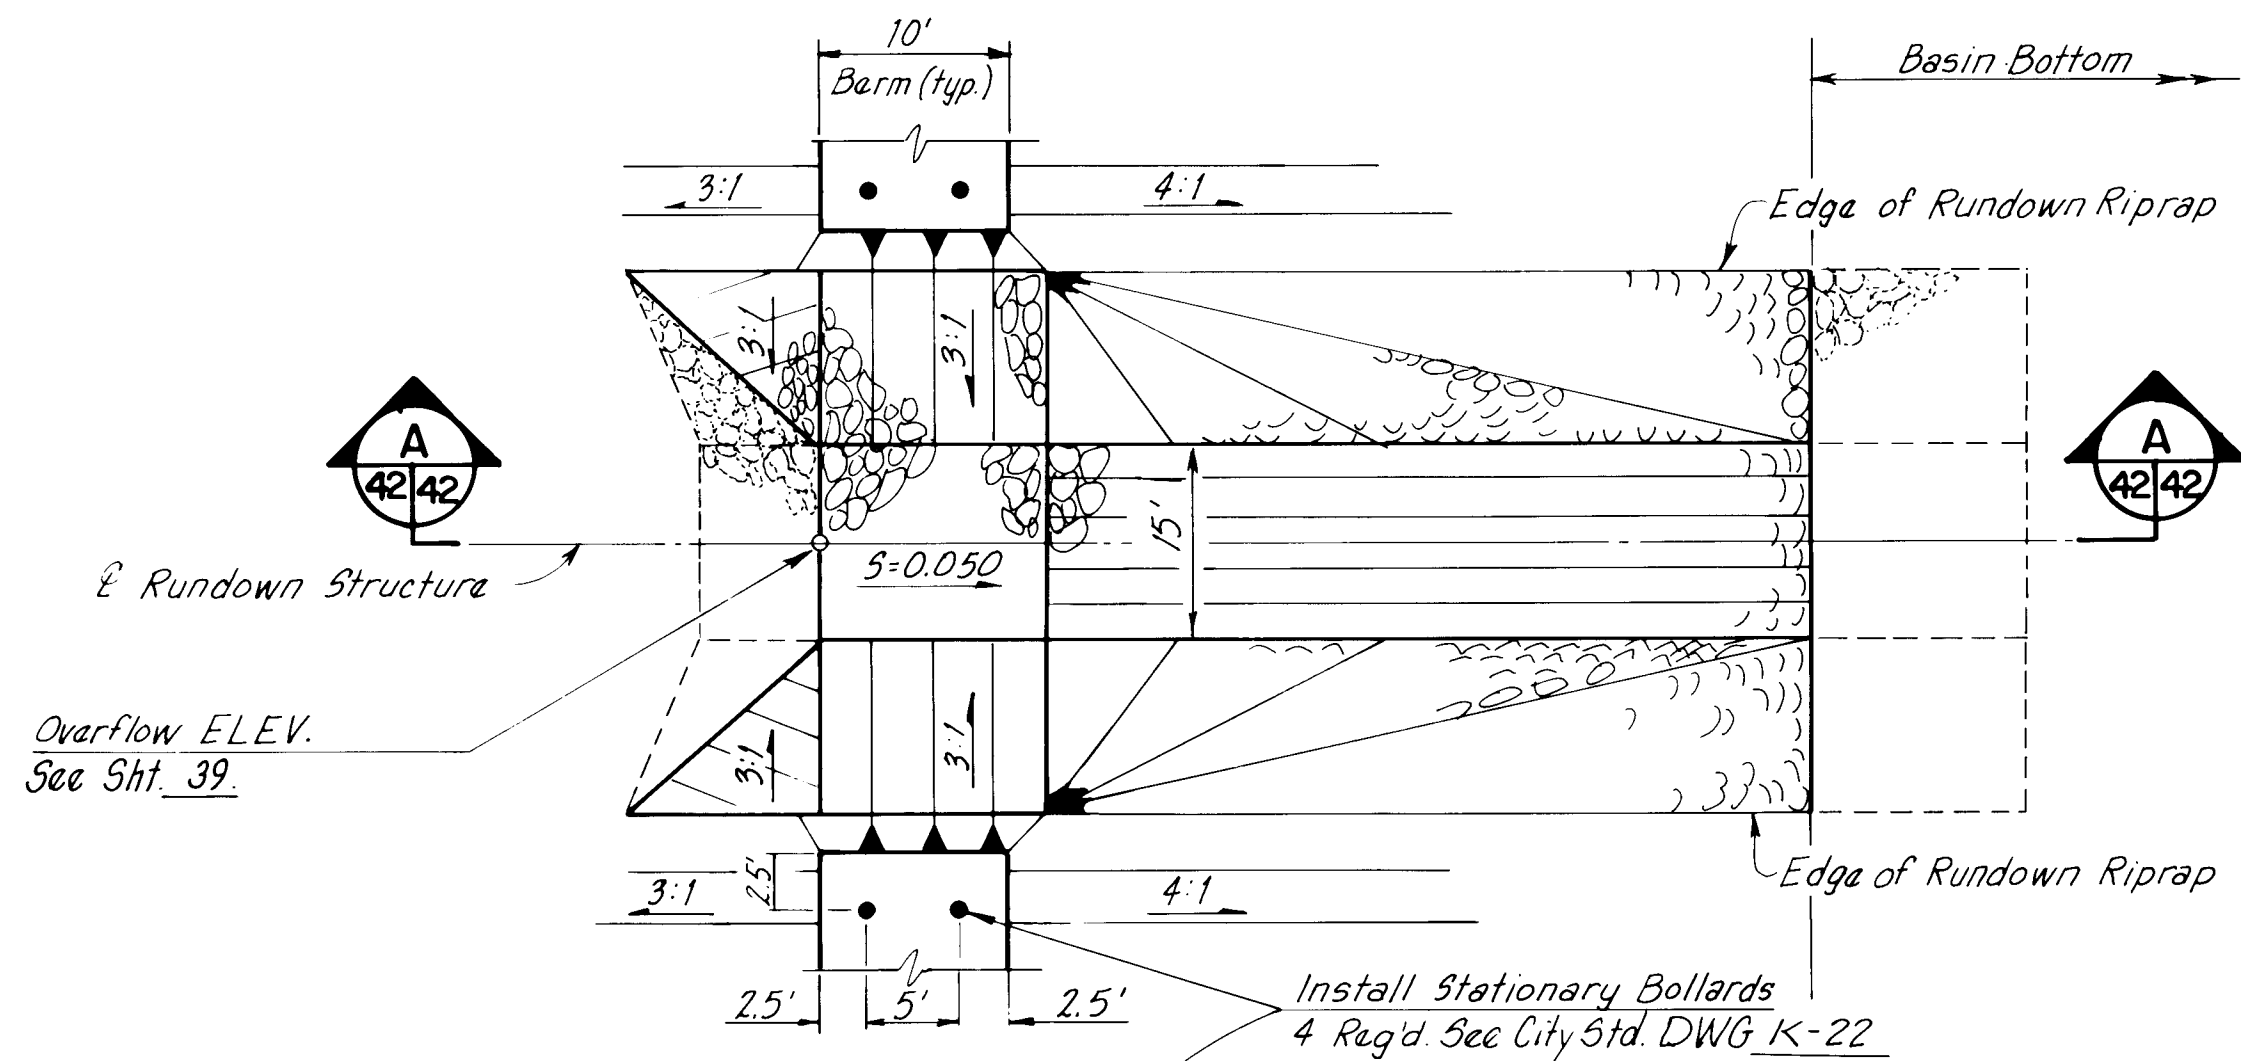

PLAN
Not to Scale

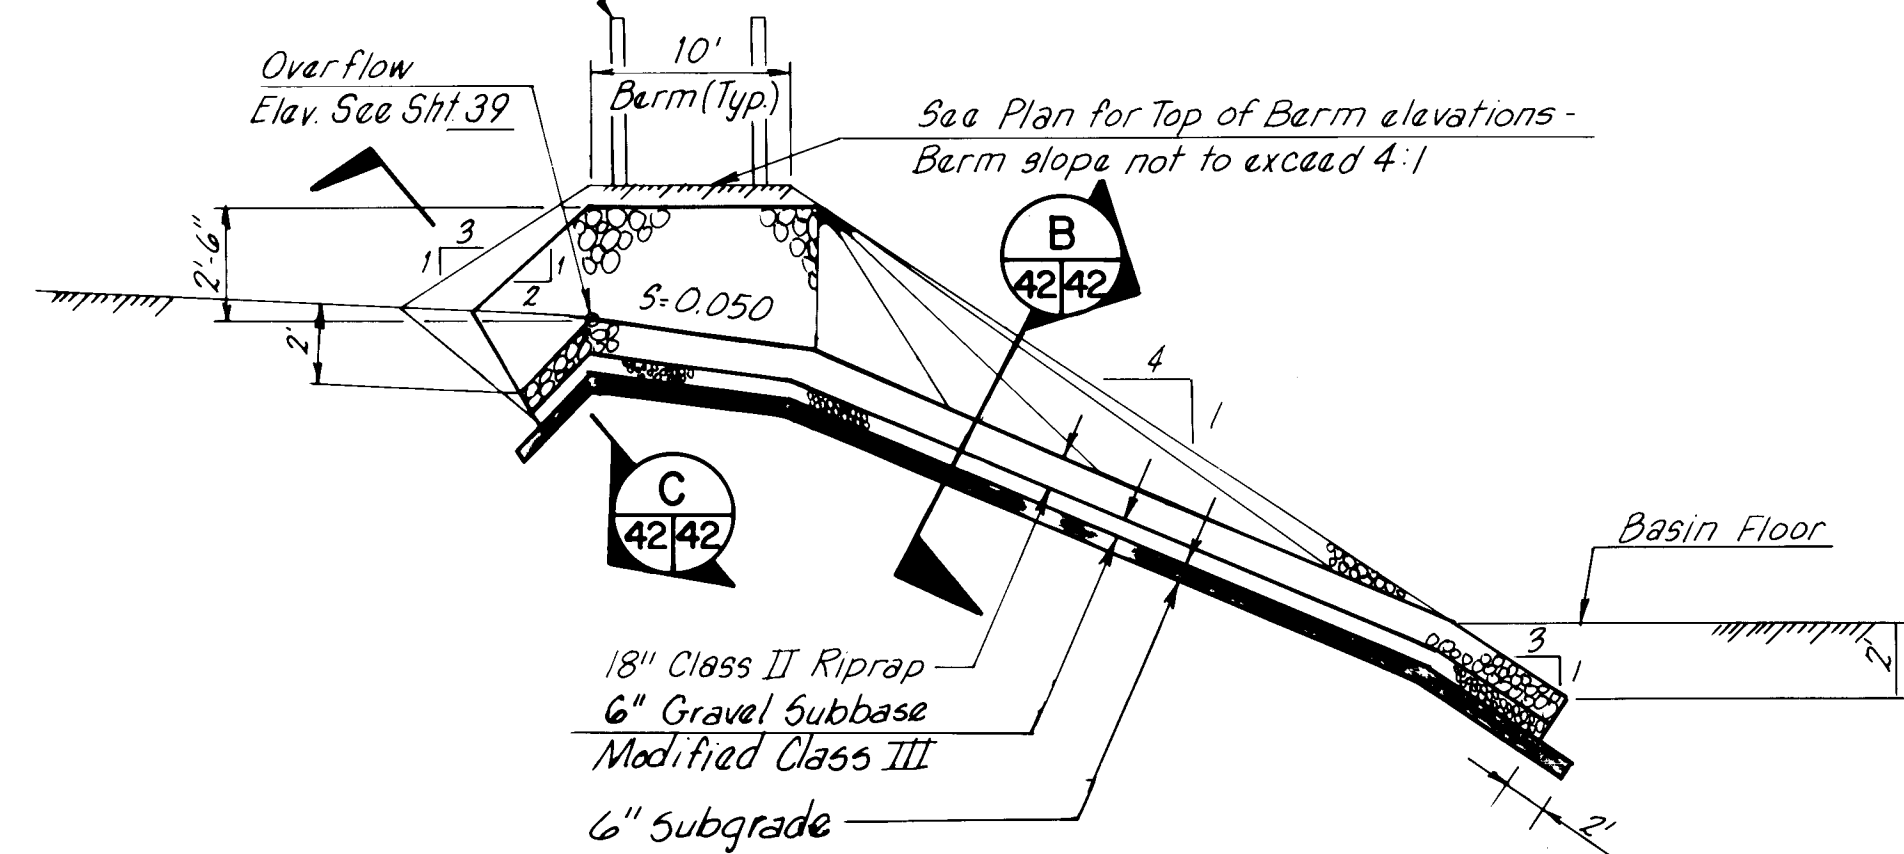


A SECTION
Not to Scale

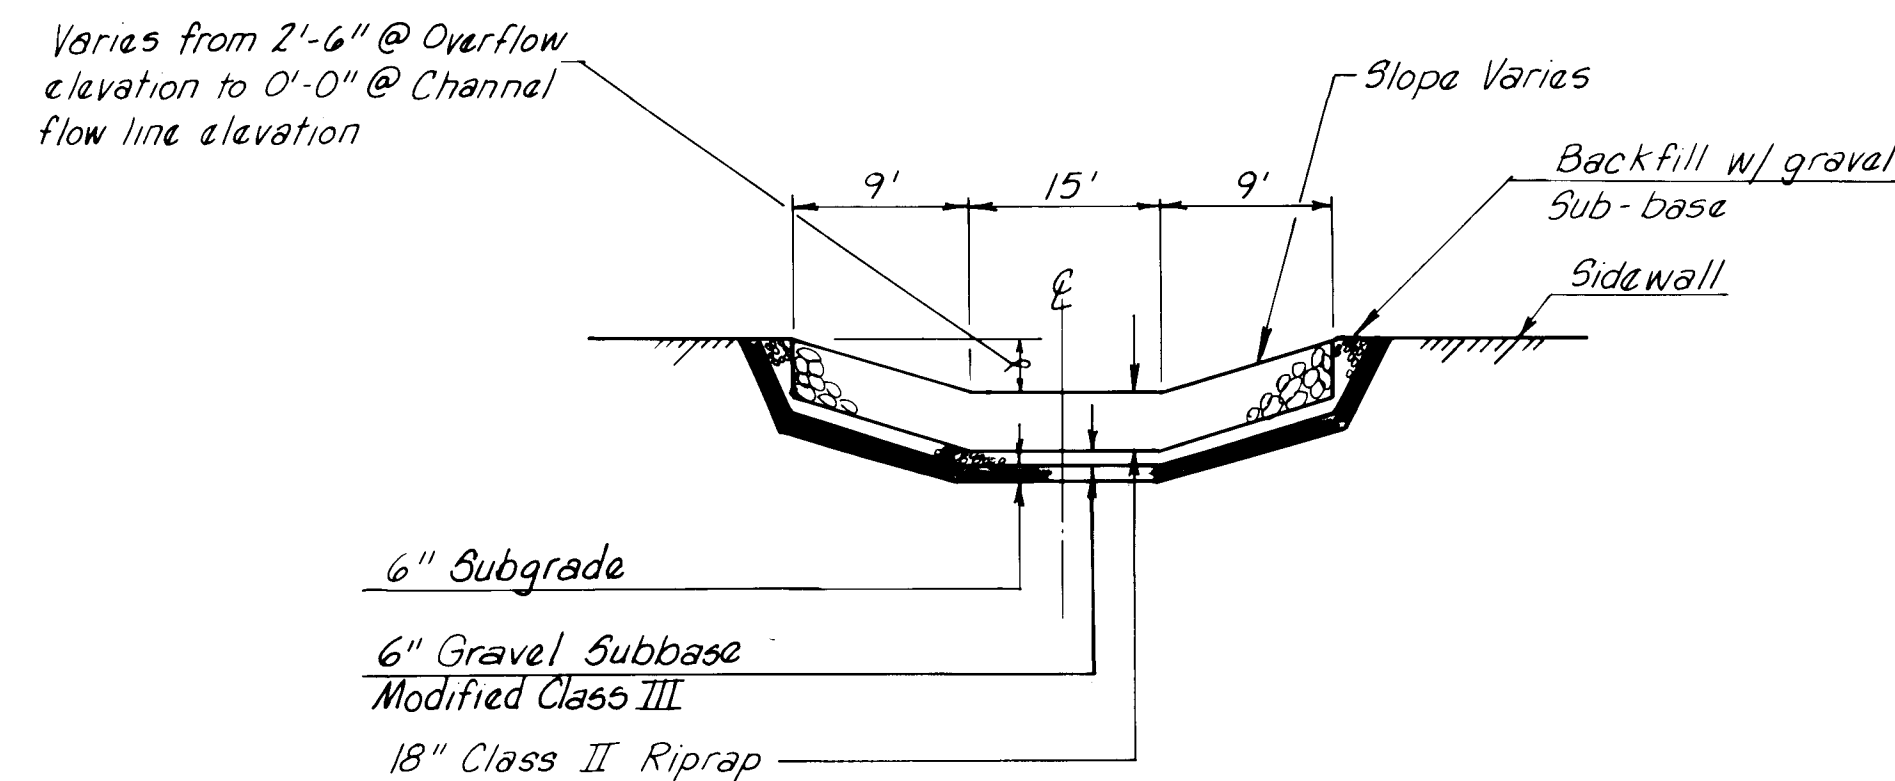


B SECTION
Not to Scale


RIPRAP RUNDOWN DETAIL (STA. 97+52 & STA. 100+12)

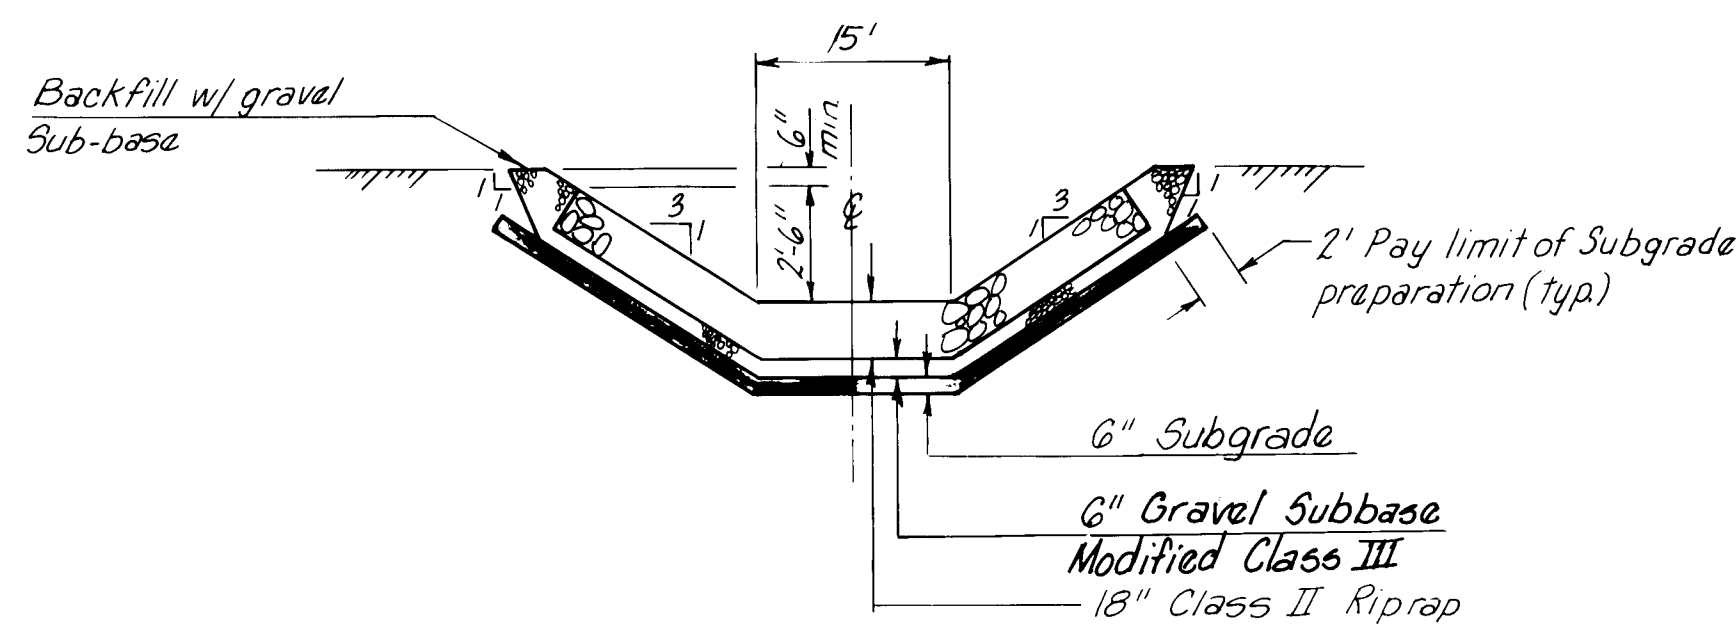


C SECTION
Not to Scale

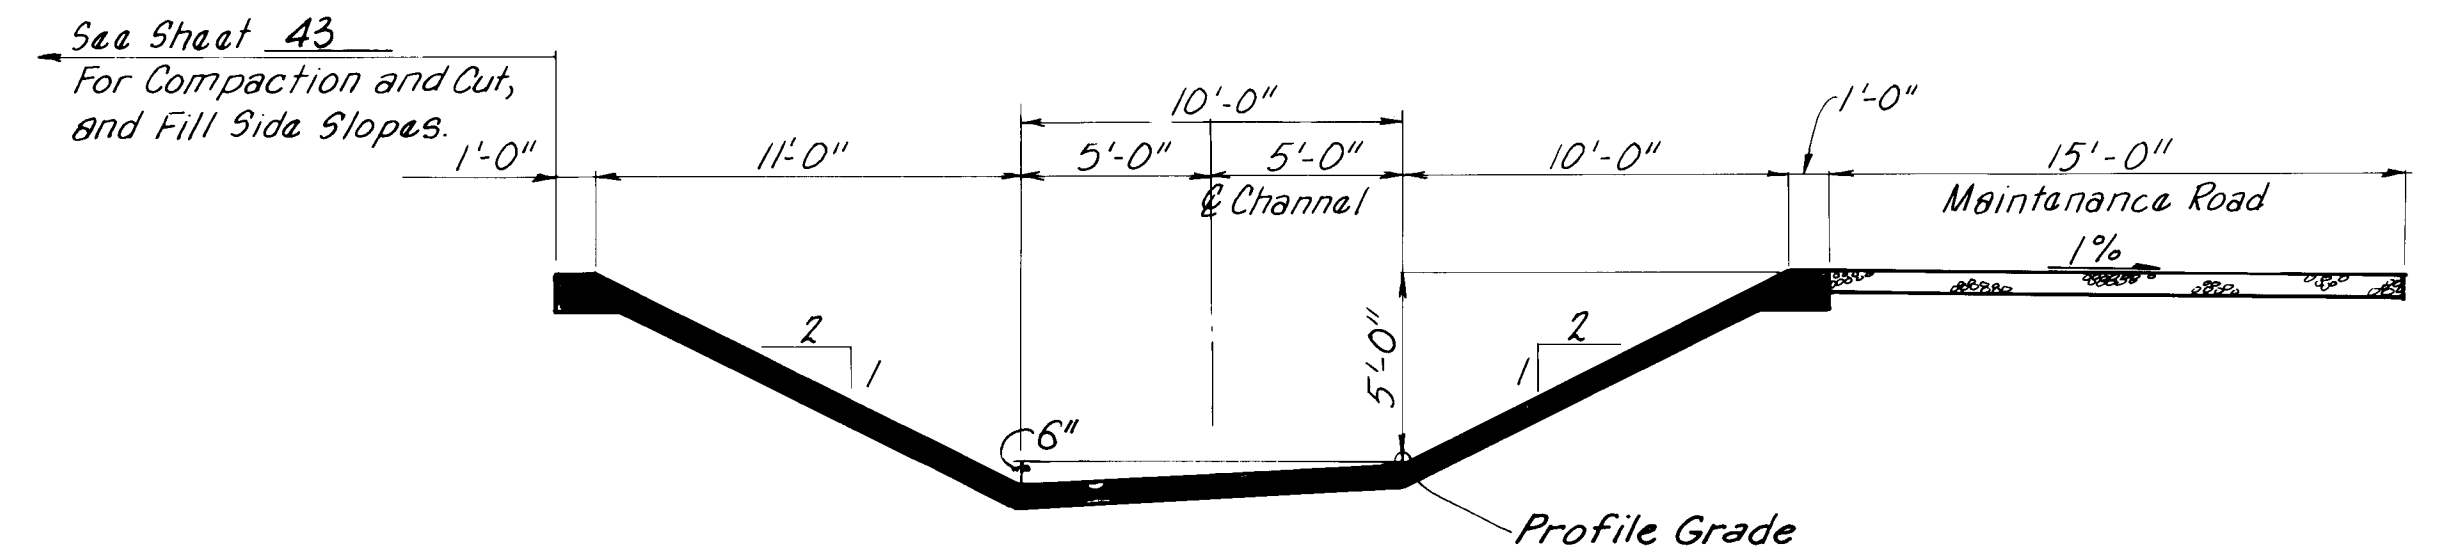

TYPICAL CHANNEL SECTION
MAIN CHANNEL STA. 81+00 TO STA. 85+33.67 &
STA. 85+98.04 TO STA. 97+30

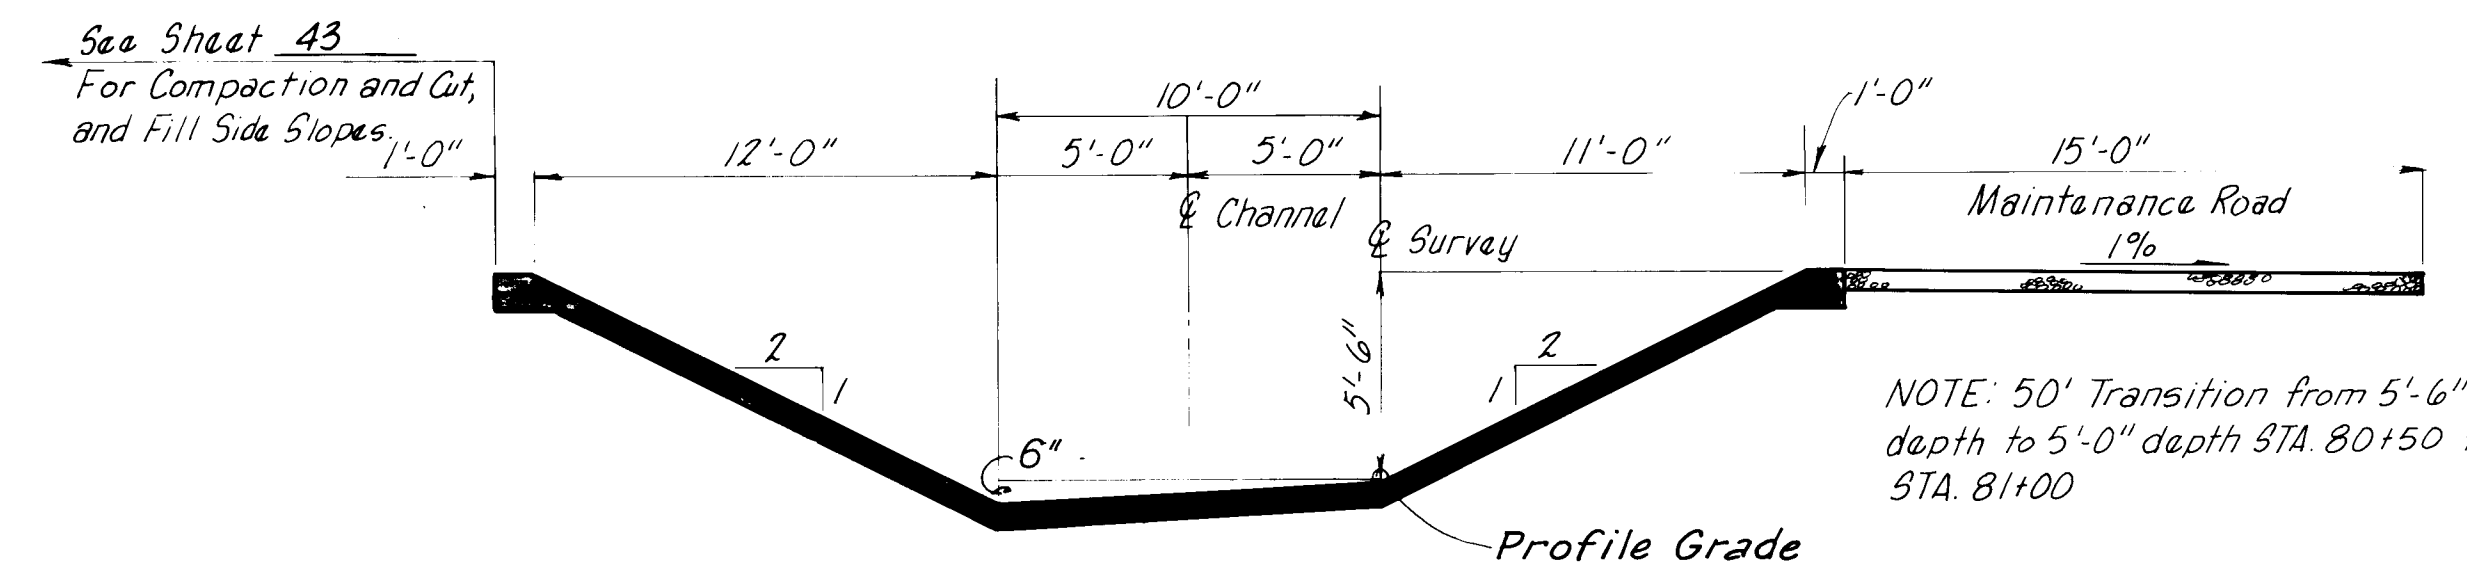

TYPICAL CHANNEL SECTION
MAIN CHANNEL STA. 70+00 TO STA. 80+50

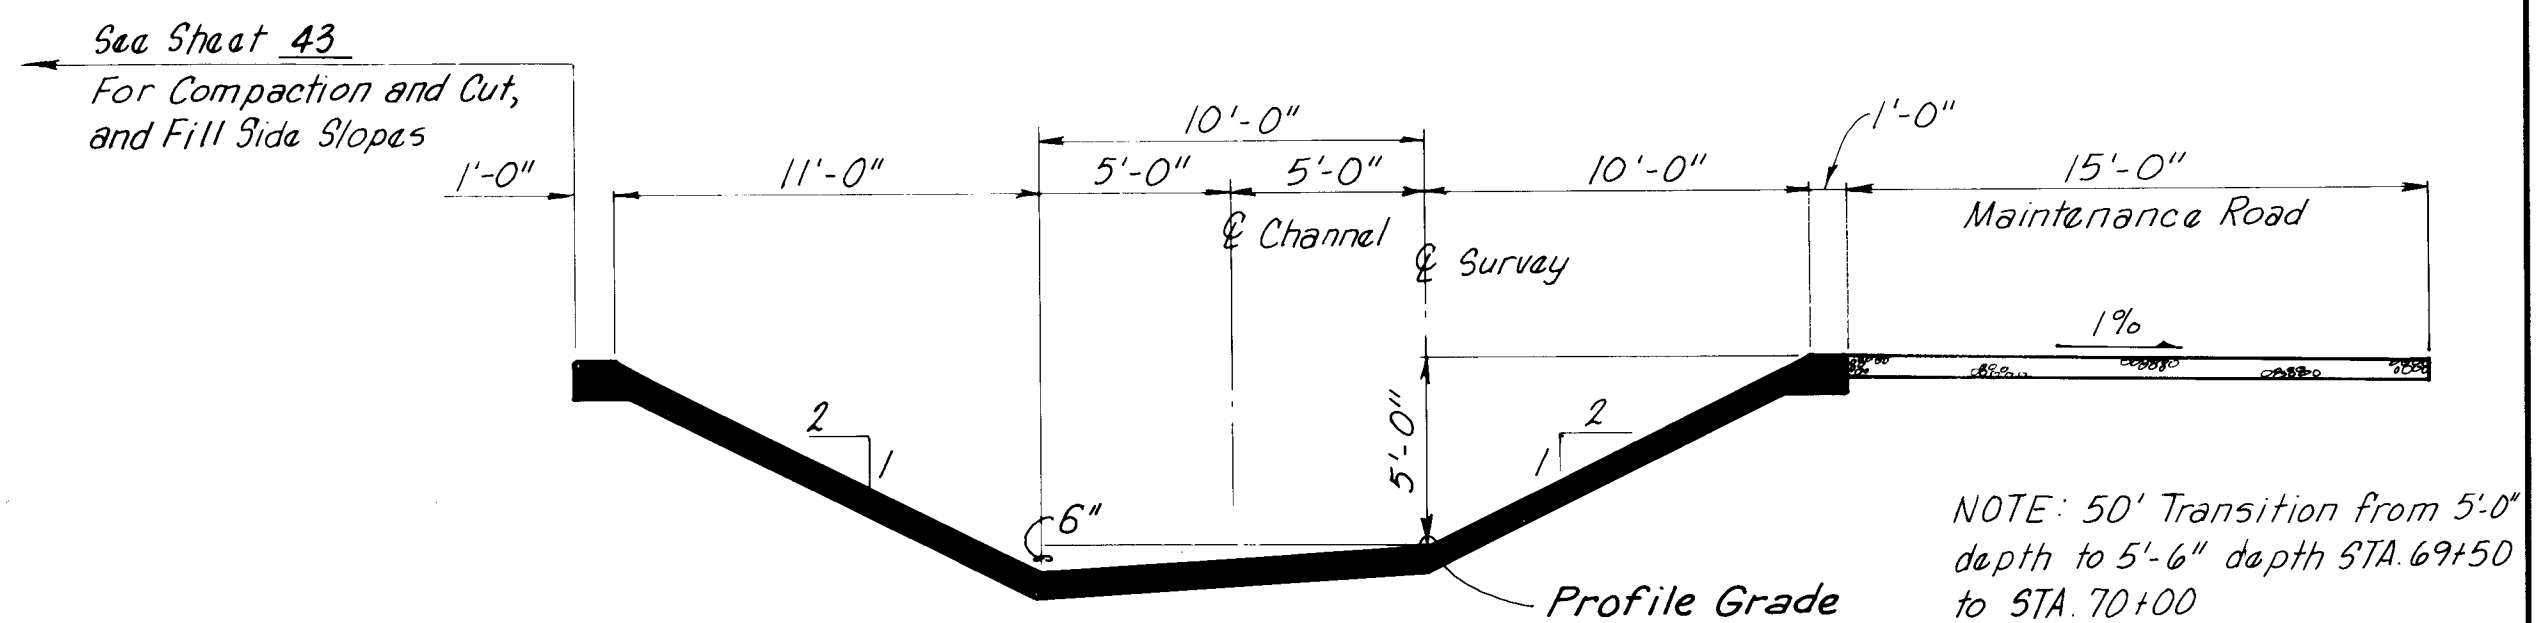

TYPICAL CHANNEL SECTION
MAIN CHANNEL STA. 68+50 TO STA. 69+50

NOTES:
STA. 65+91.26 to STA. 97+40 Profile Grade
@ E Survey.
STA. 65+90 to STA. 65+91.26 Profile Grade
@ E Channel.
STA. 57+83.10 to STA. 65+50 Profile Grade
@ 5' Lt. E Channel.

RECORD DRAWING

Date **JUL 10 1987**

These drawings have been revised based
on field data and every reasonable attempt
has been made to depict construction as
actually performed

26 17 23 4 2 8 7

AMAFCA

WESTGATE DIVERSION CHANNELS



SNOW VISTA CHANNEL PHASE III

TYPICAL SECTIONS AND




MISCELLANEOUS DETAILS

GORDON HERKENHOFF & ASSOCIATES, INC.

ENGINEERS ARCHITECTS PLANNERS



ALBUQUERQUE

SANTA FE

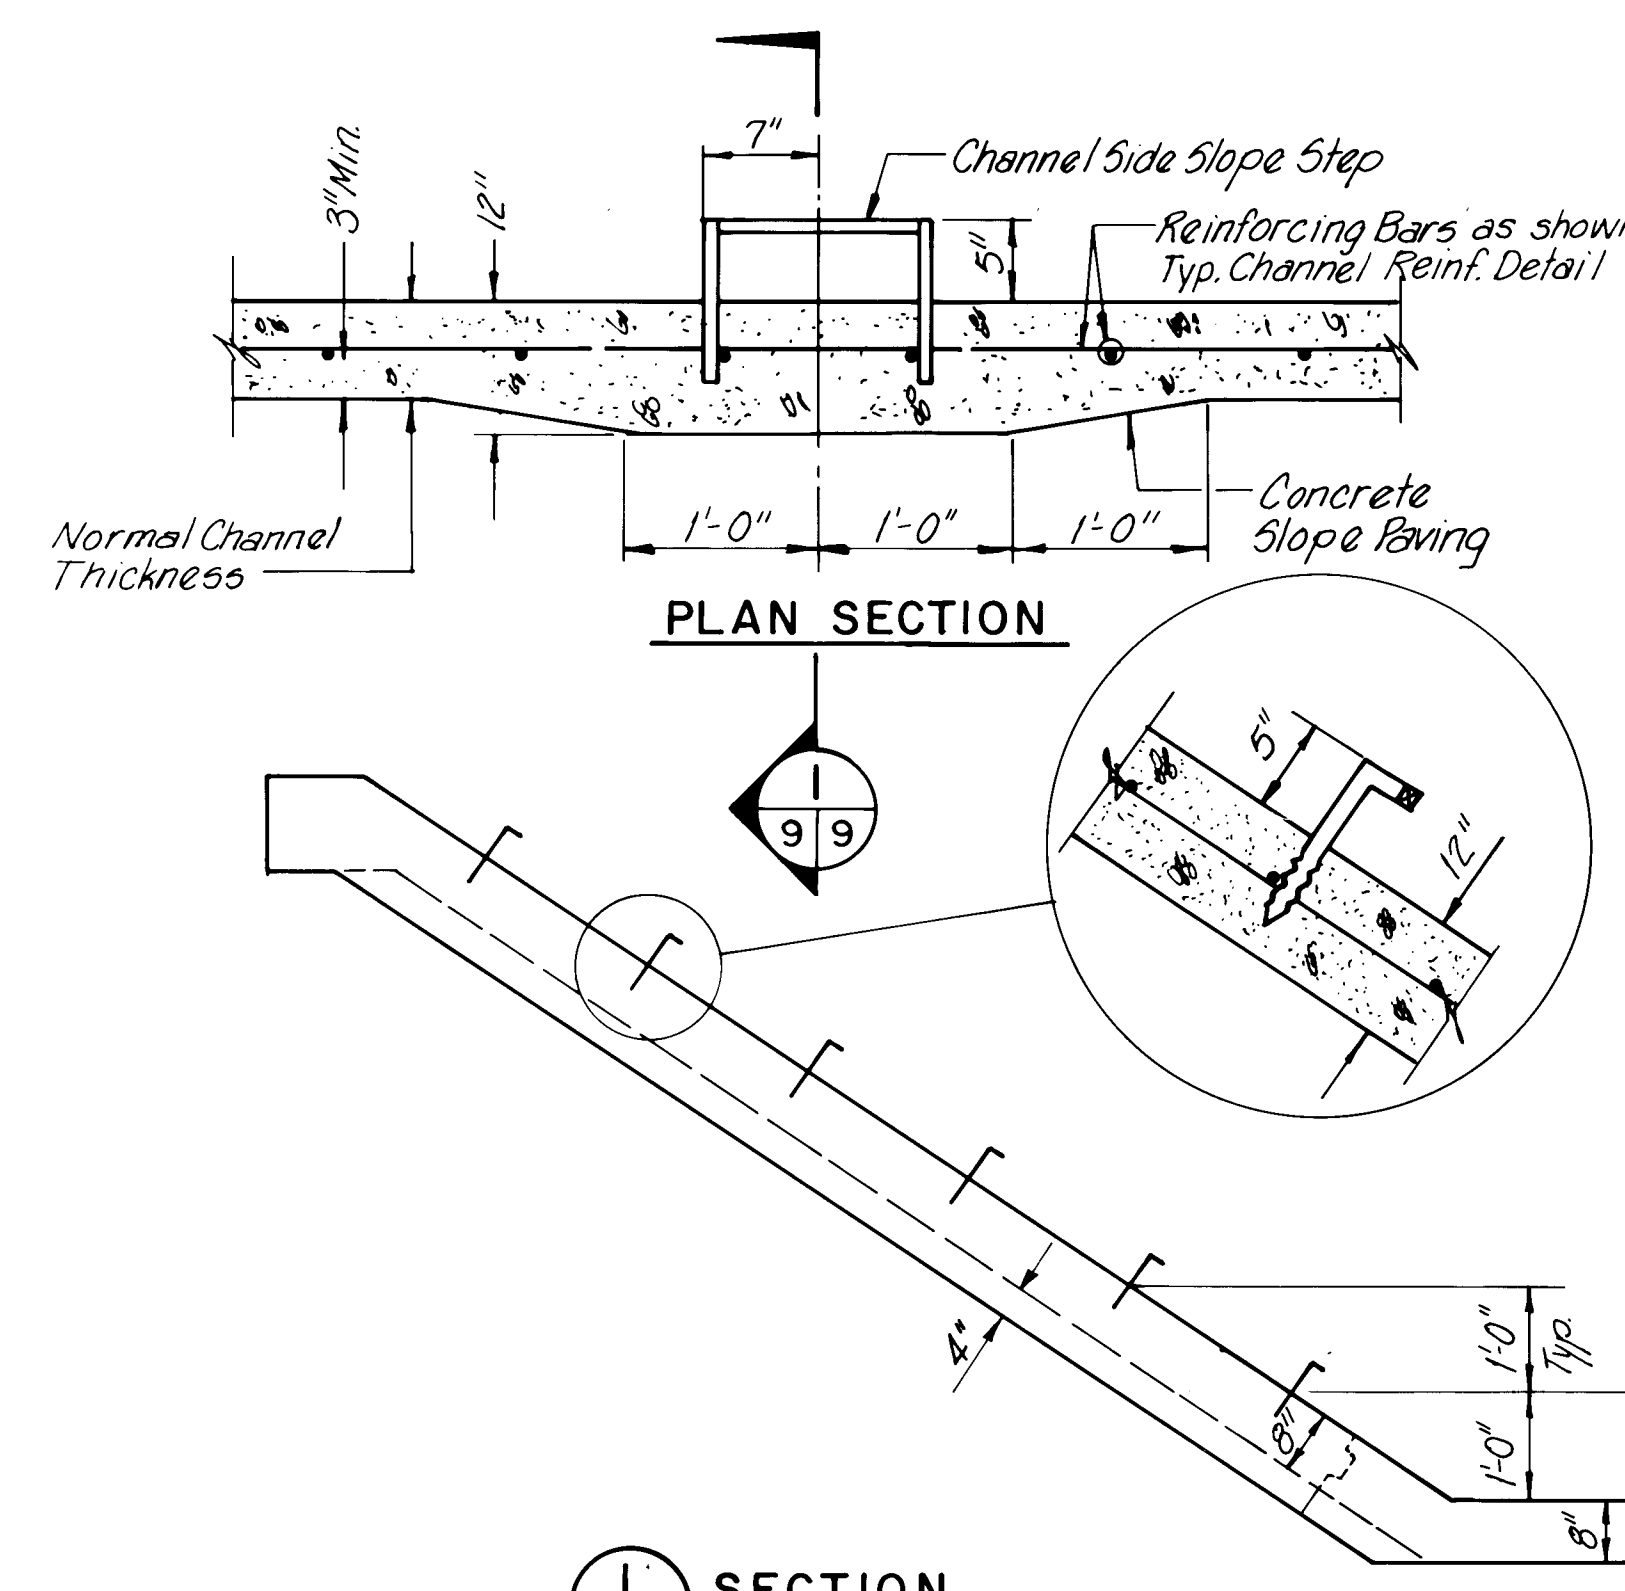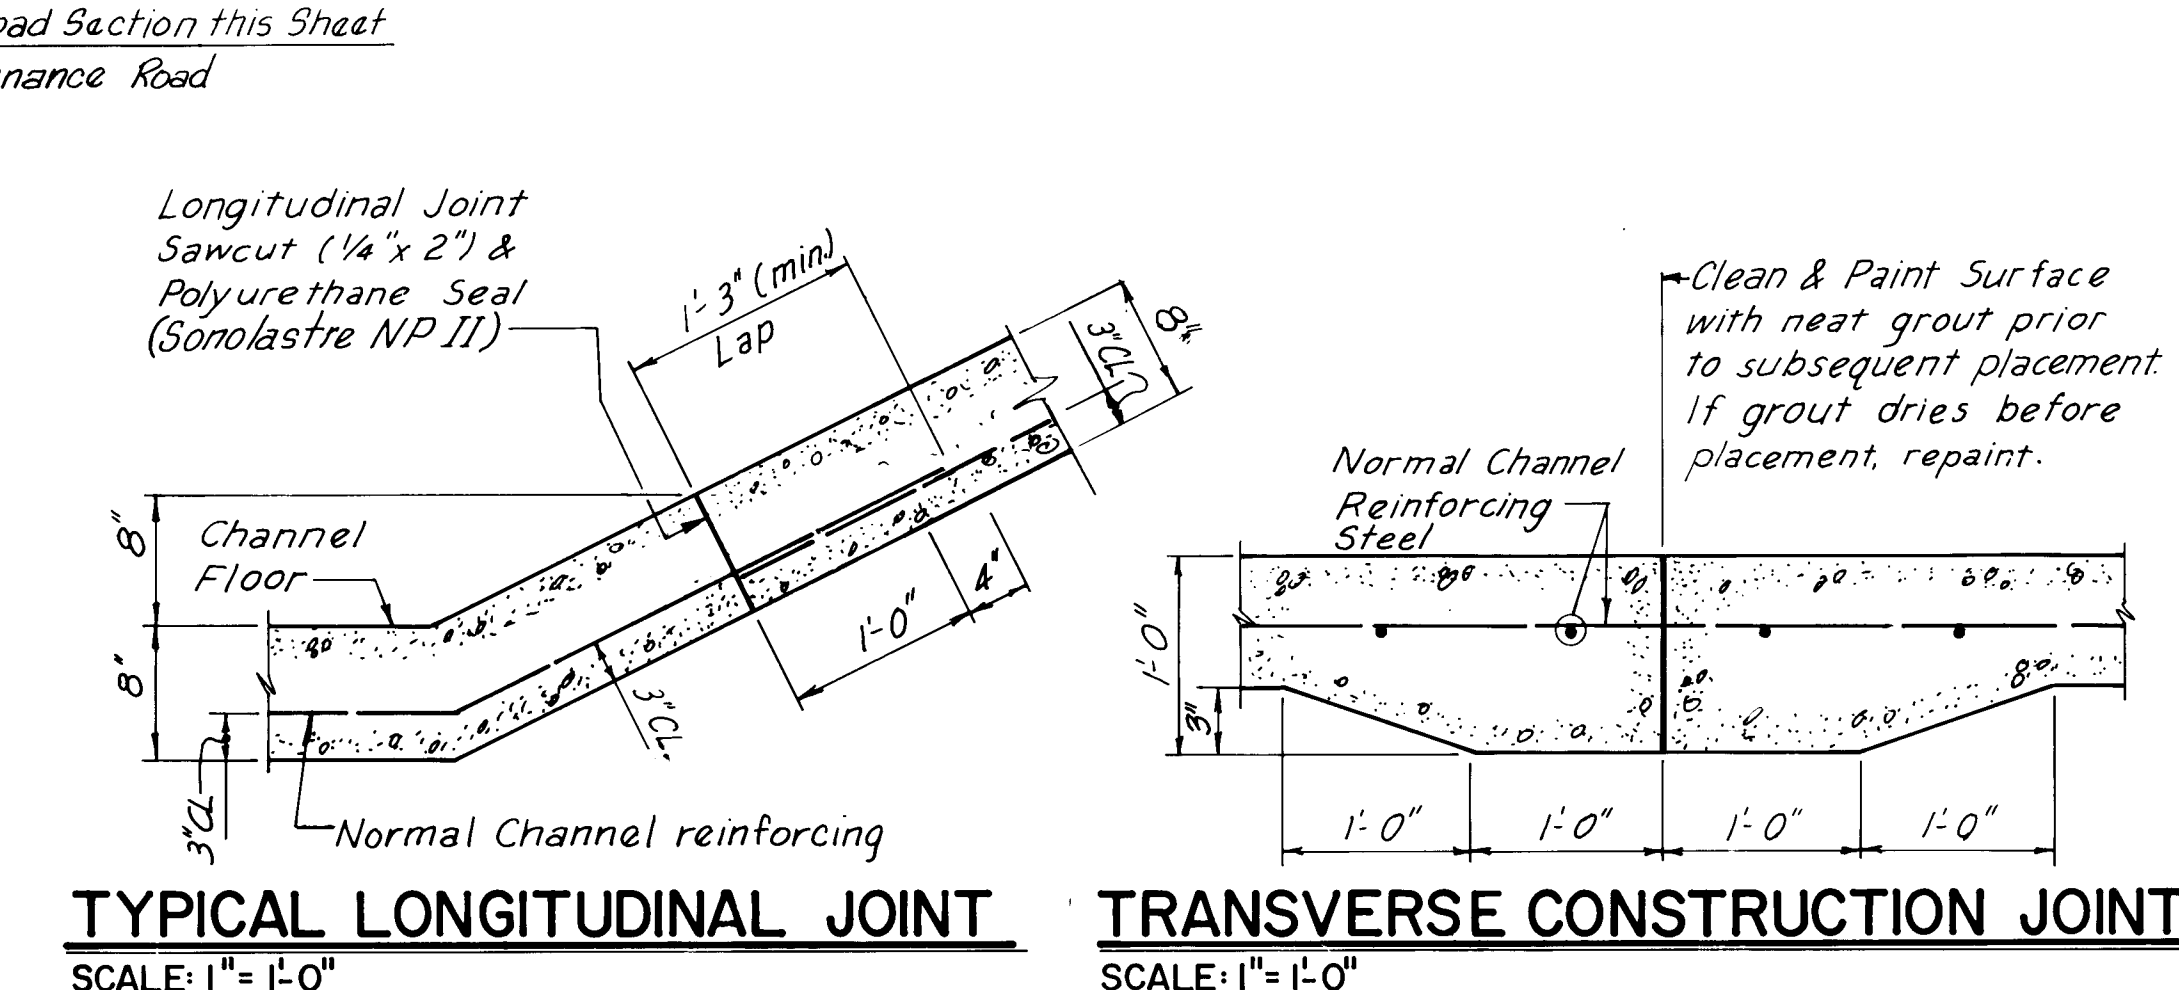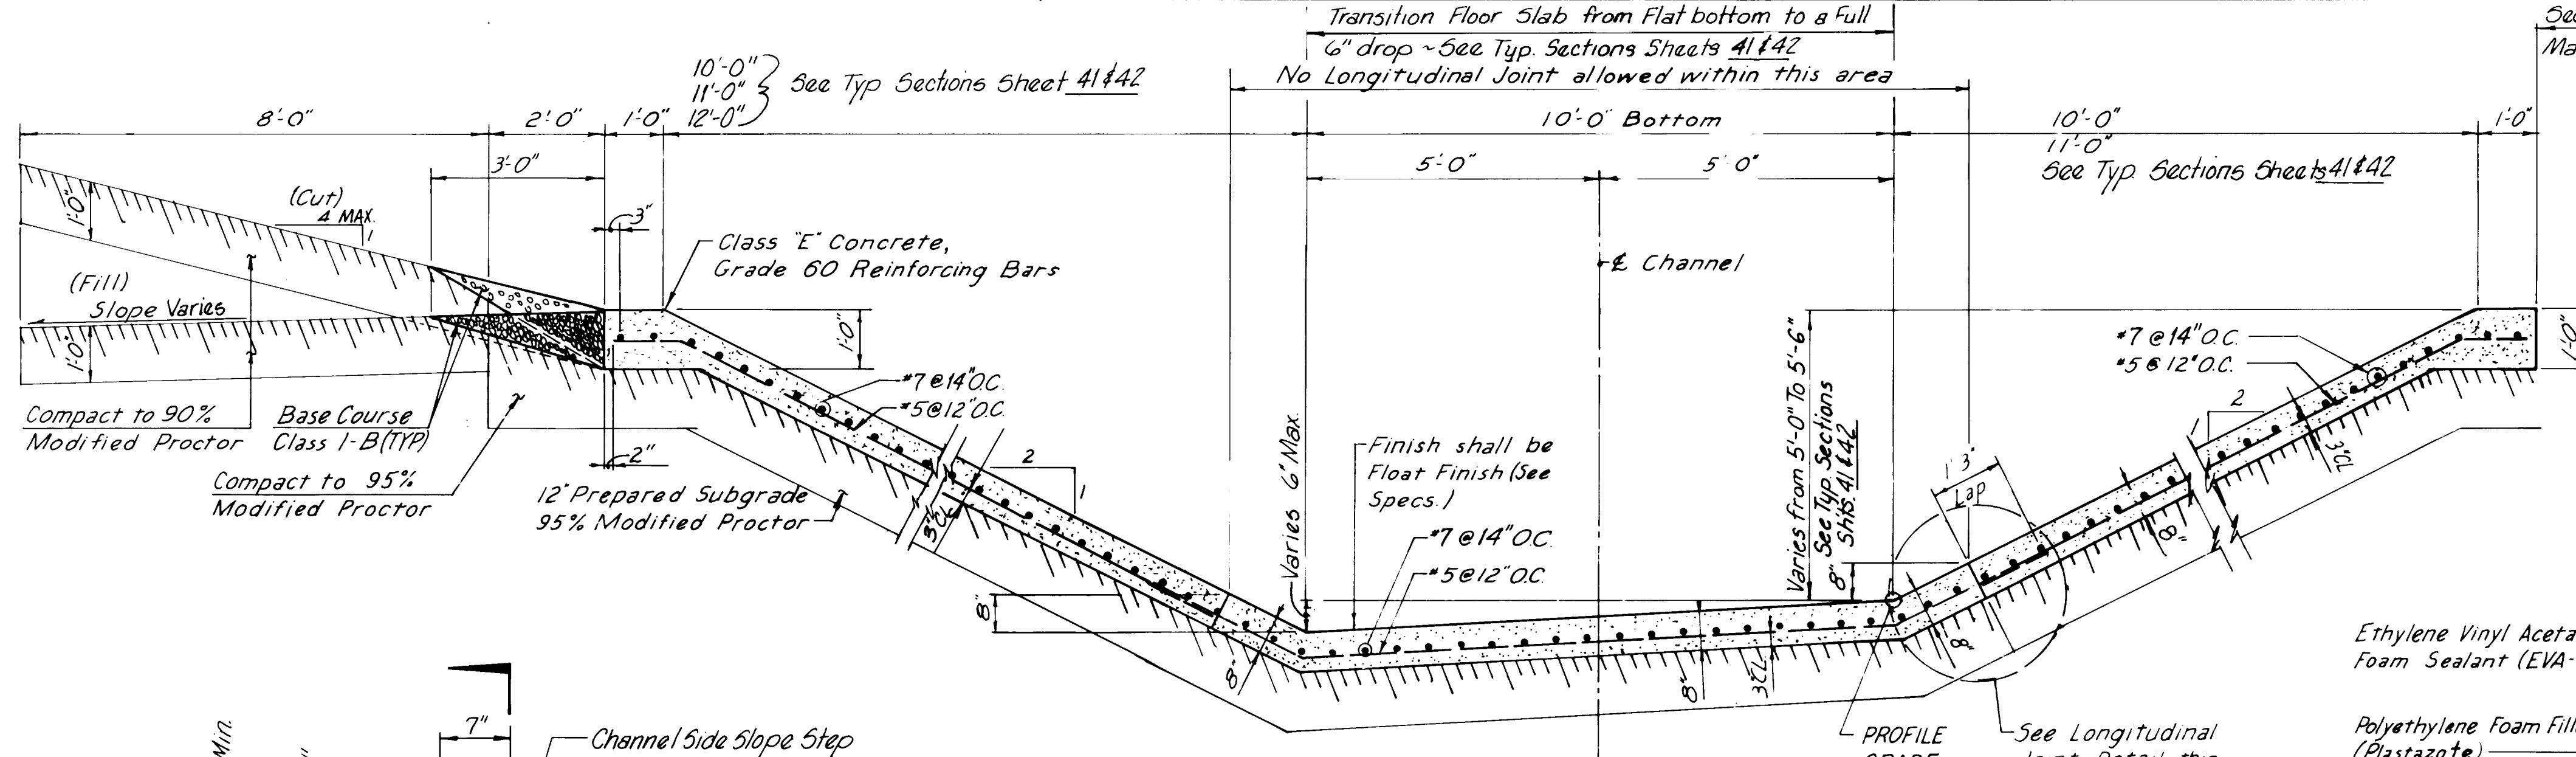

TYPICAL CHANNEL REINFORCING
NOT TO SCALE

CHANNEL STEP LOCATIONS		SAFETY POSTS REQD.
STATION	LOCATION	
58+55	RT & LT	Yes
65+40	RT & LT	NO
75+00	RT & LT	NO
86+30	RT & LT	Yes
96+00	RT & LT	NO

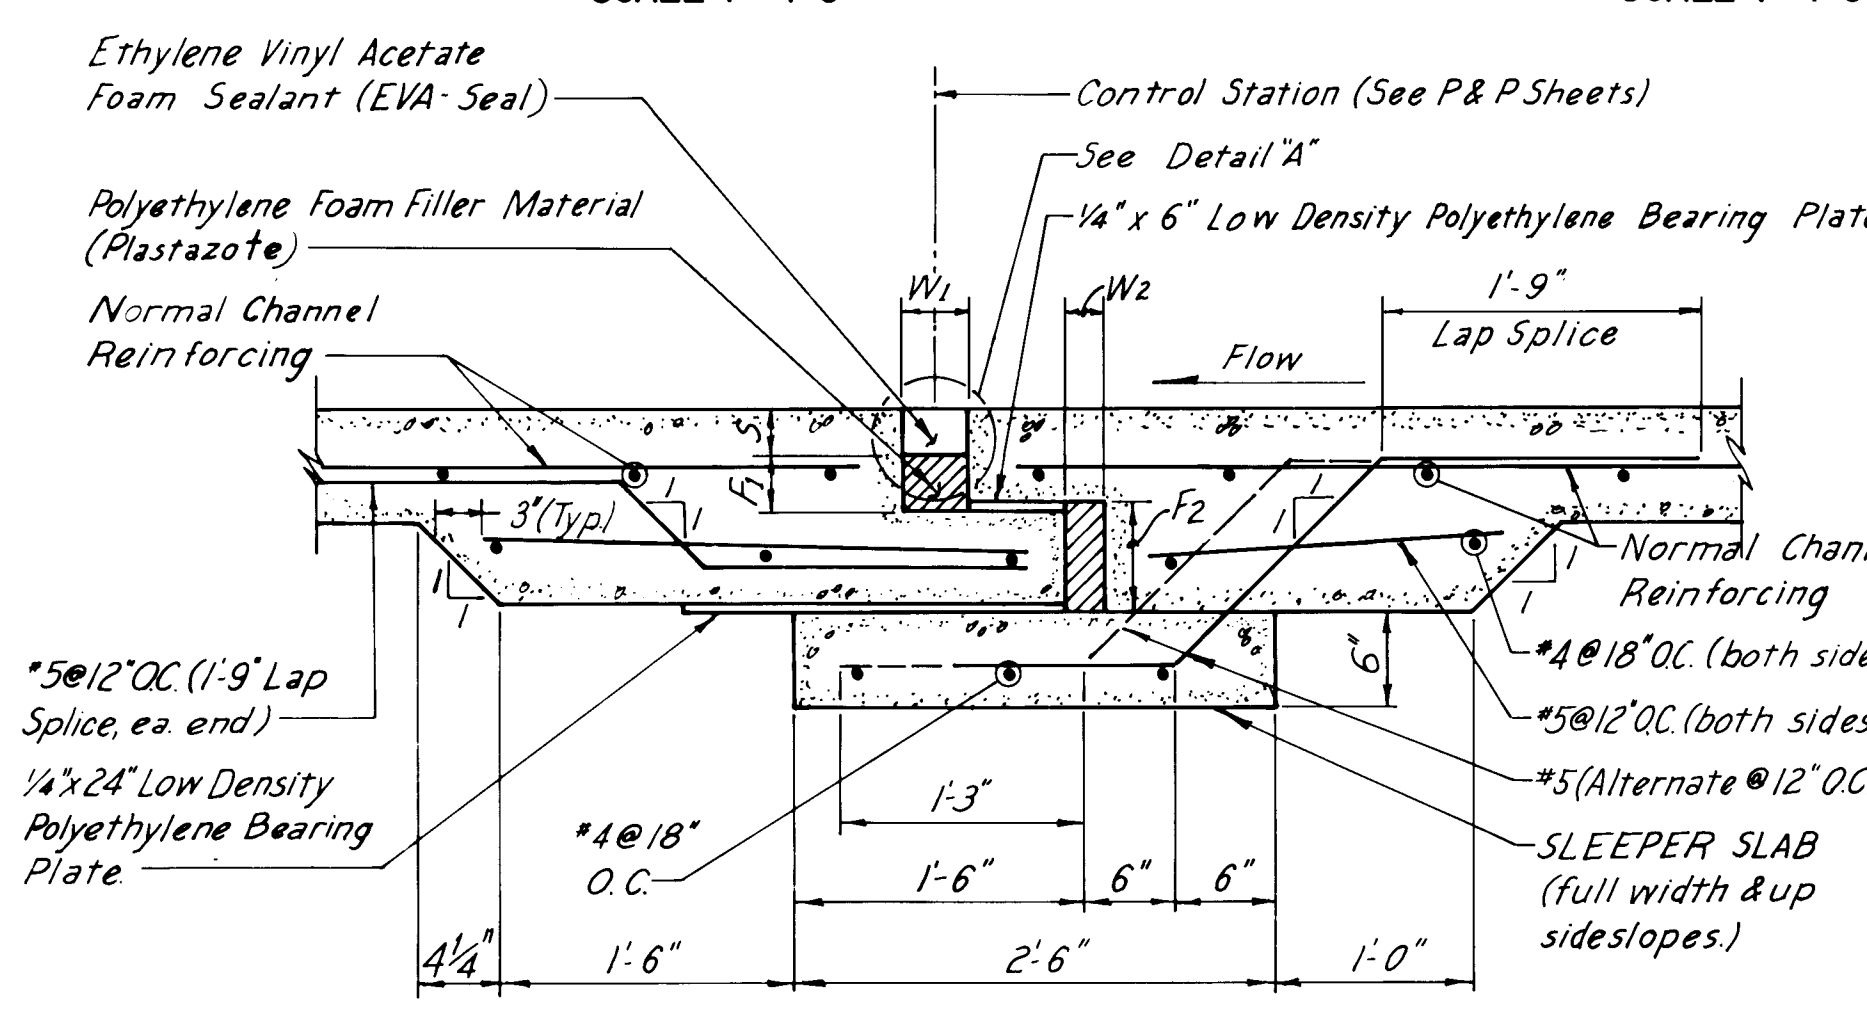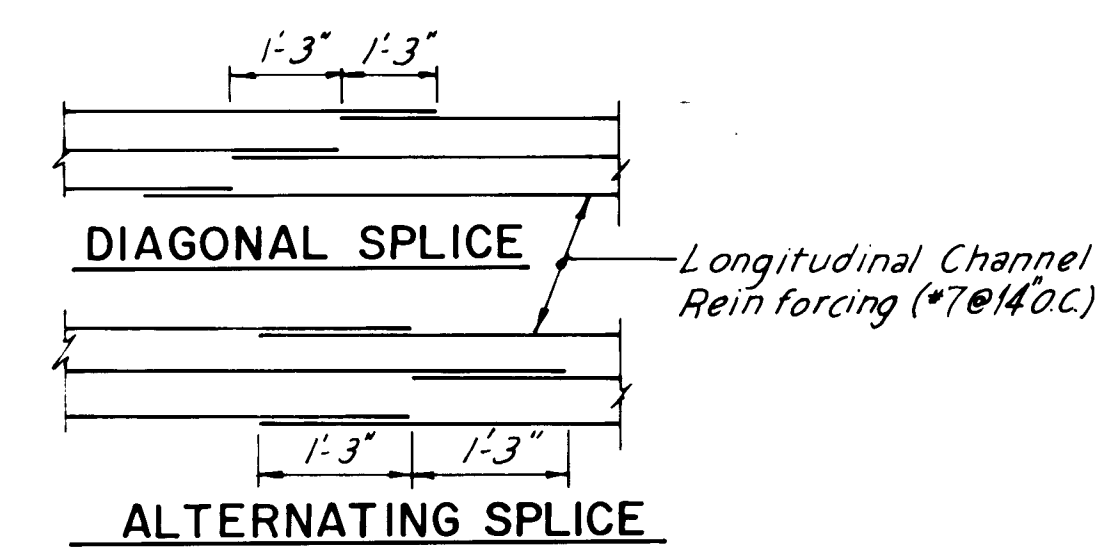






EXPANSION JOINT FILLERS & SEALANT DIMENSIONS

CONTROL STATION	W1	W2	S	F1	F2
58+49.60	4"	3"	3 1/2"	2 3/4"	6"
96+50	4"	3"	3 1/2"	2 3/4"	6"
2+23.72 Side Channel	4"	3"	3 1/2"	2 3/4"	6"

- EXPANSION JOINT CONSTRUCTION NOTES**
1. Compact sleeper subgrade to 95% per ASTM D 1557.
 2. Pour sleeper with Z-bar reinforcement extending above slab. Steel trowel bearing plate surface only.
 3. Compact subgrade and form downstream portion of joint. Construction joints may be installed a min. of 5 feet upstream and downstream of joint centerline. Place lower bearing plate and downstream reinforcement and make downstream pour. Steel trowel upper bearing plate surface.
 4. Compact subgrade and form upstream portion of joint. Place reinforcing steel, upper bearing plate, and upper and lower foam filler material. Upper bearing plate must be parallel to lower bearing plate. Do not anchor foam filler material with nails or bonding agent, but keep flush with poured downstream section. Block out foam sealant notch, clean exposed sleeper surface and make upstream pour.
 5. When upstream and downstream concrete has reached a min. of 80% design strength or after a minimum of seven days has elapsed since concrete was poured, remove sealant notch form, sand blast vertical surfaces and clean all debris from notch. Apply epoxy bonder to both vertical concrete faces and to both sides of foam sealant material. Immediately compress foam sealant into notch. Remove bonder from top surface of sealant material, but do not clean bonder bead along edges.
 6. If sealant material extends from 0" to 1/8" above channel flowline, apply ultraviolet paint as specified. If sealant material extends from 1/8" or more above channel flowline, power sand material flush with channel flowline under the direction of the Engineer prior to application of ultraviolet paint.

CHANNEL SIDESLOPE STEP DETAIL
NOT TO SCALE

NOTE: Channel steps shall be 1/2" Grade 60 reinforcing rod encapsulated in a co-polymer polypropylene as manufactured by M.A. Industries, Inc. (Model #P-2-PFS). Steps shall be installed as recommended by manufacturer after channel placement.

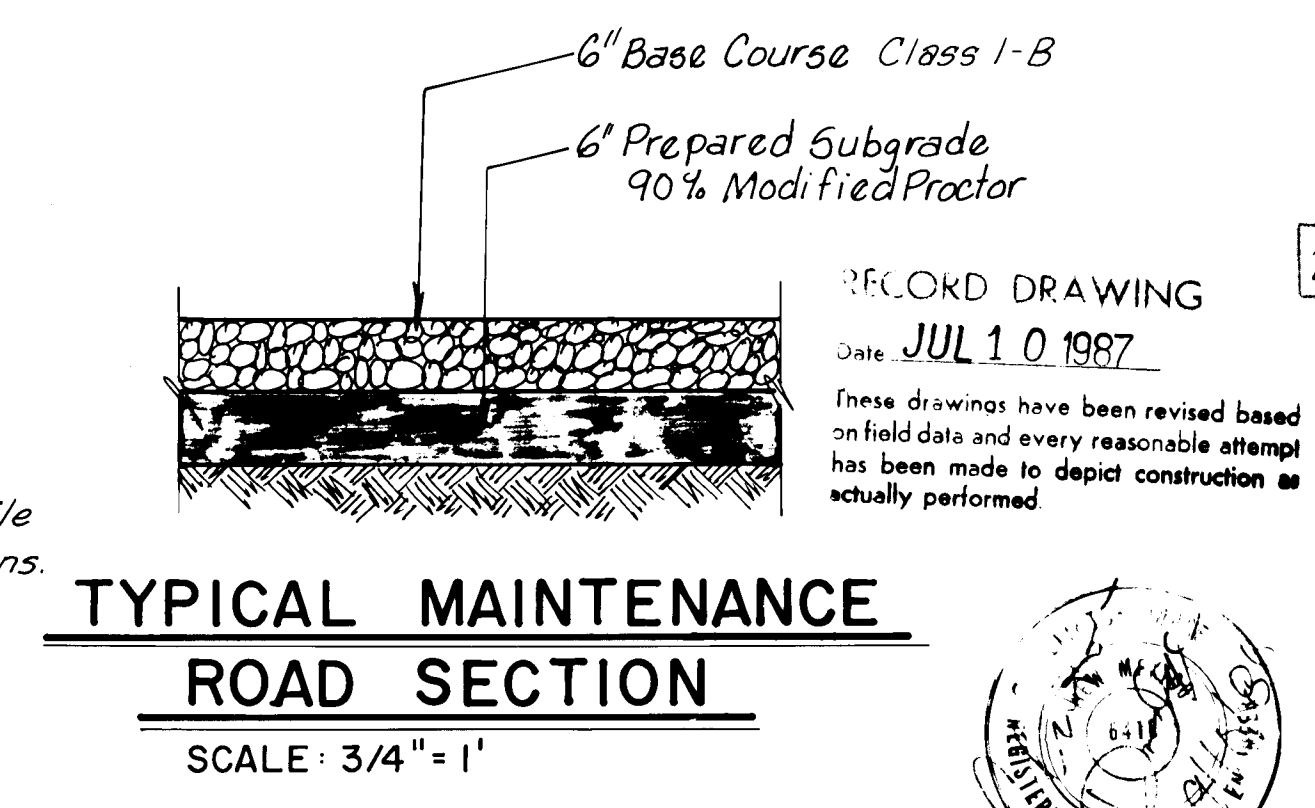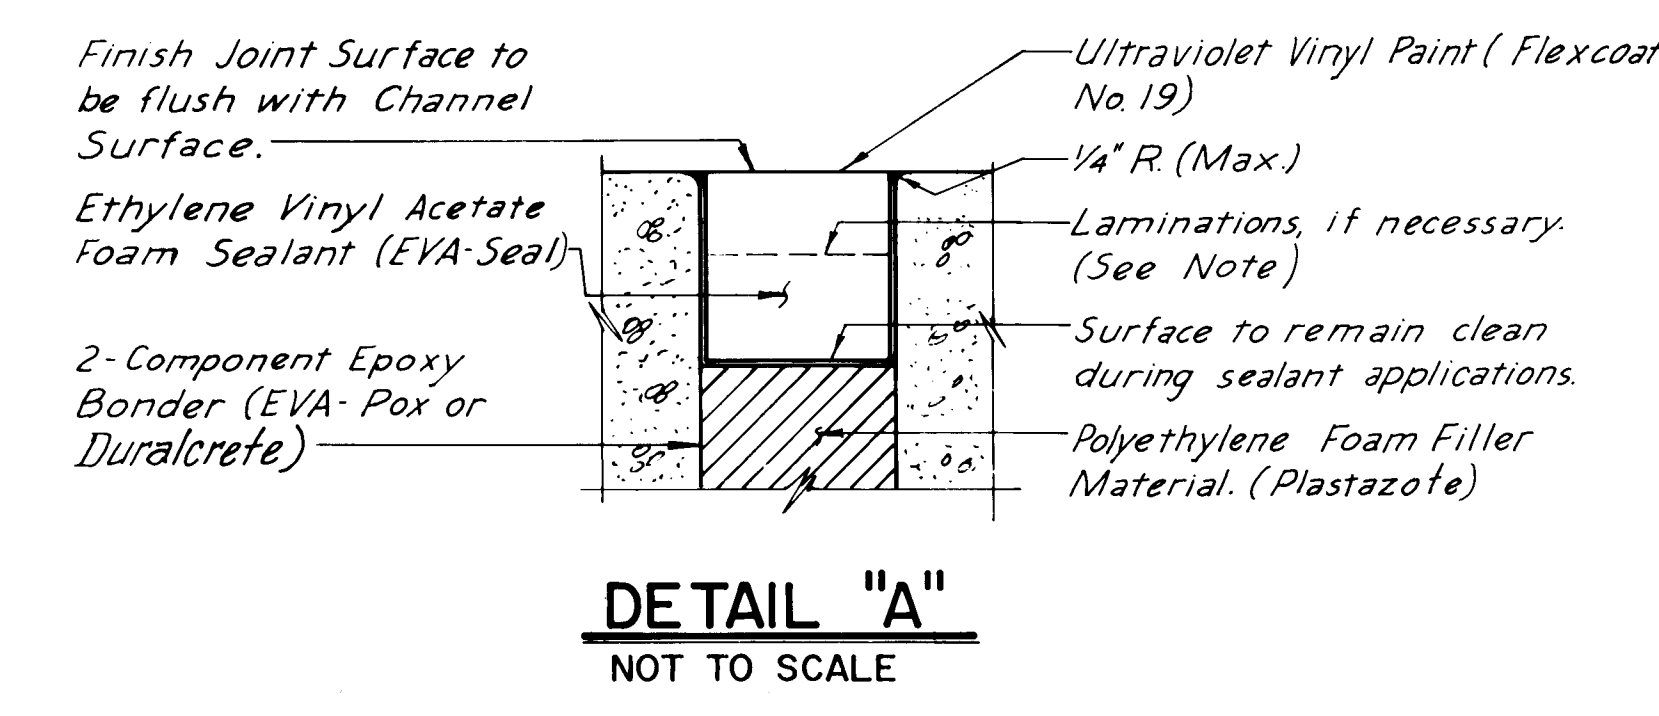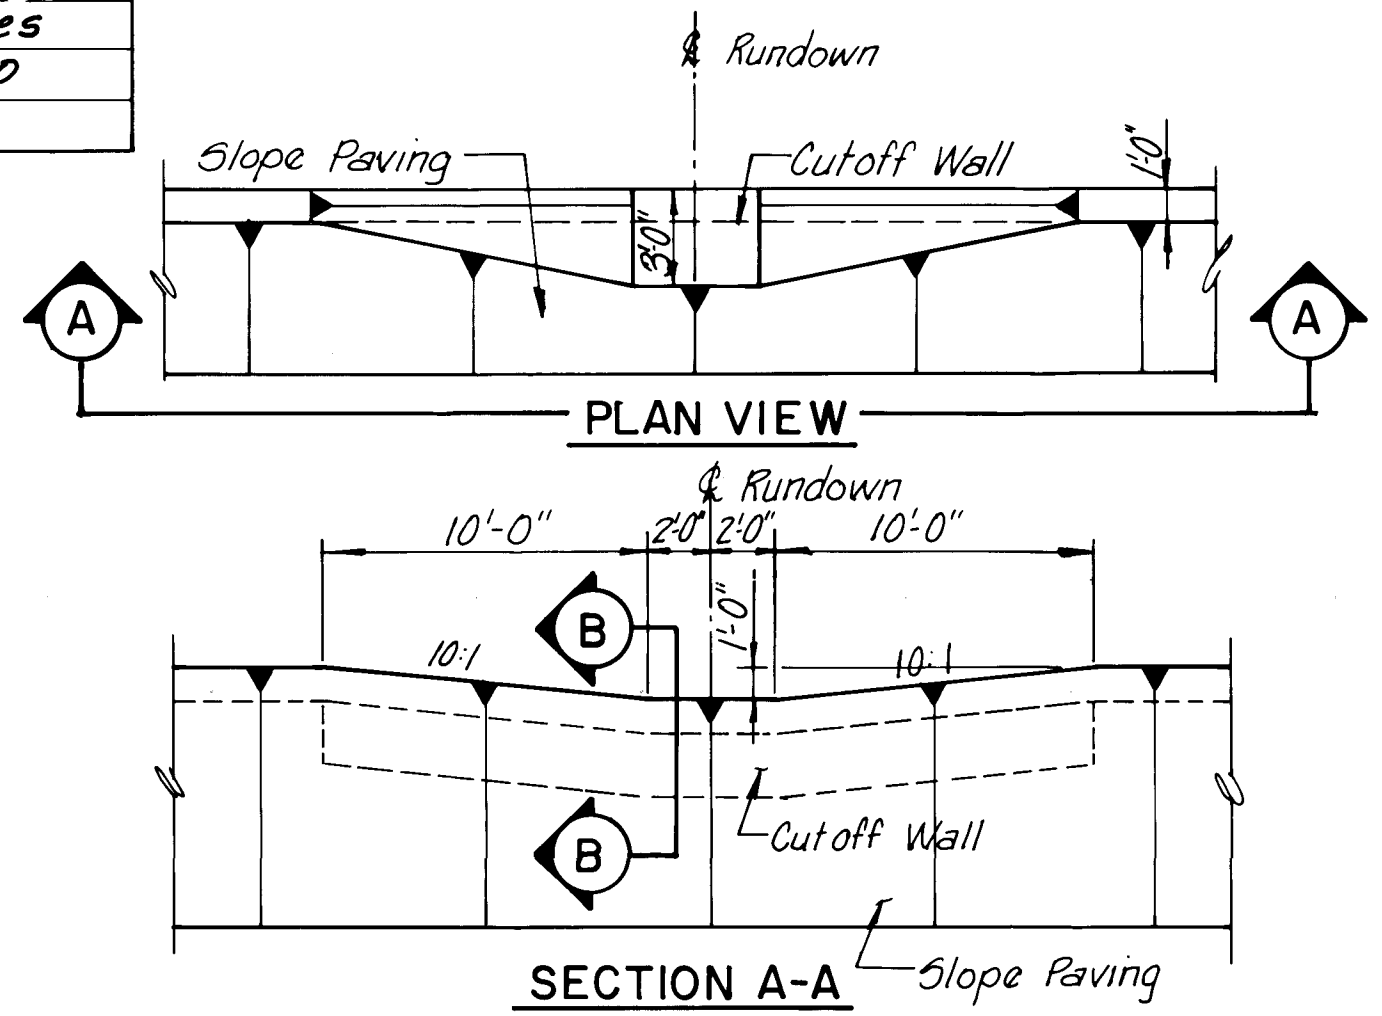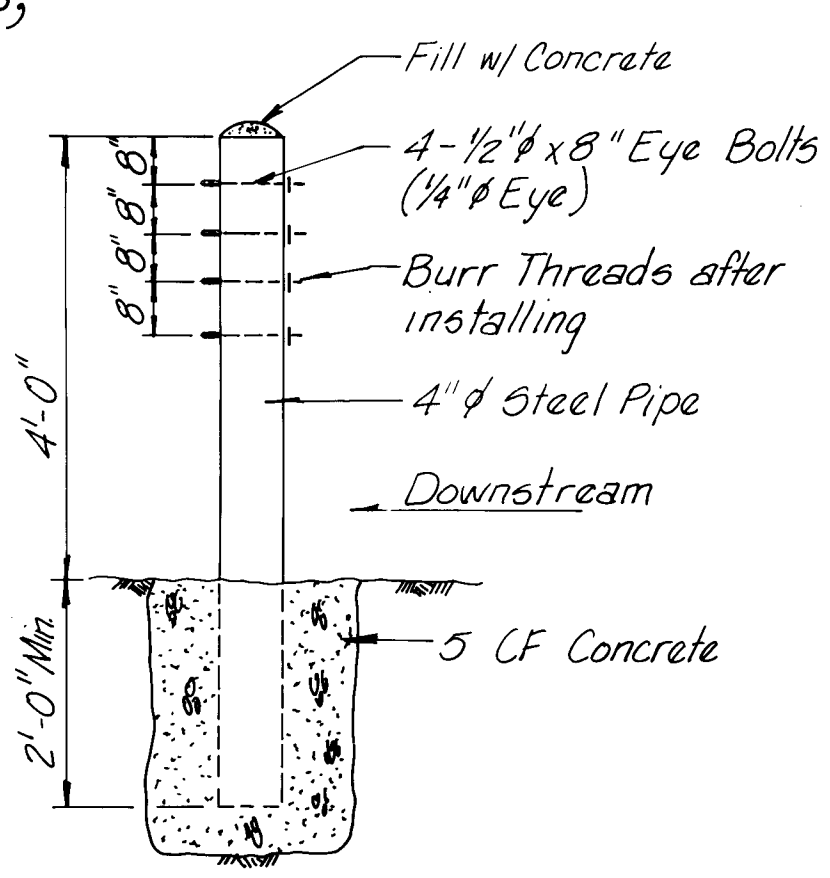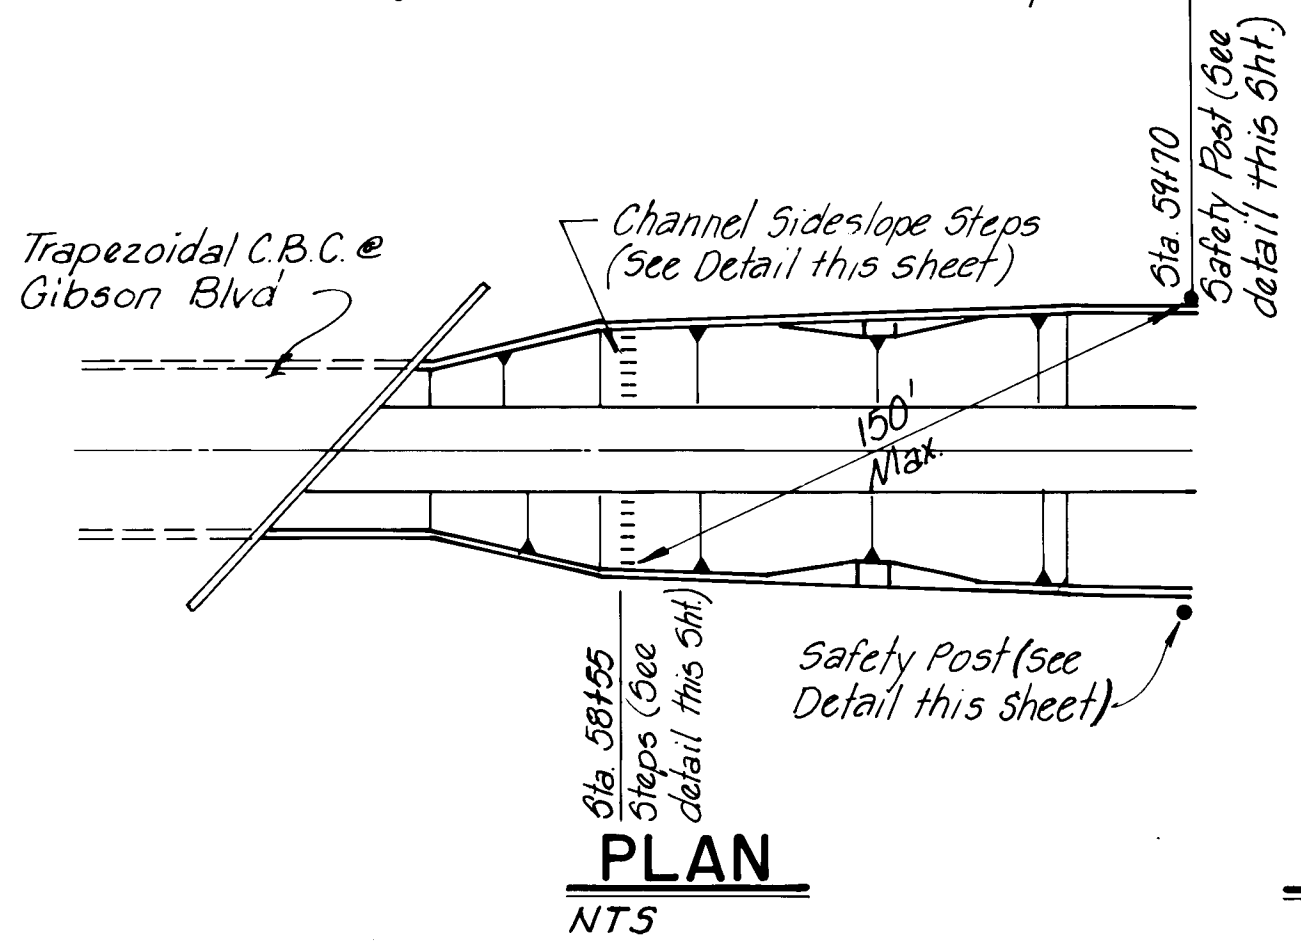

26 17 23 43 87
REVISED 11/6/86

AMAFCA

WESTGATE DIVERSION CHANNELS

SNOW VISTA CHANNEL PHASE III

REINFORCING STEEL AND MISC. DETAILS

GORDON HERKENHOFF & ASSOCIATES, INC.



ENGINEERS ARCHITECTS PLANNERS

ALBUQUERQUE FARMINGTON SANTA FE


DRAWN BY K.H.K.

DATE AUG 1986


SCALE AS SHOWN

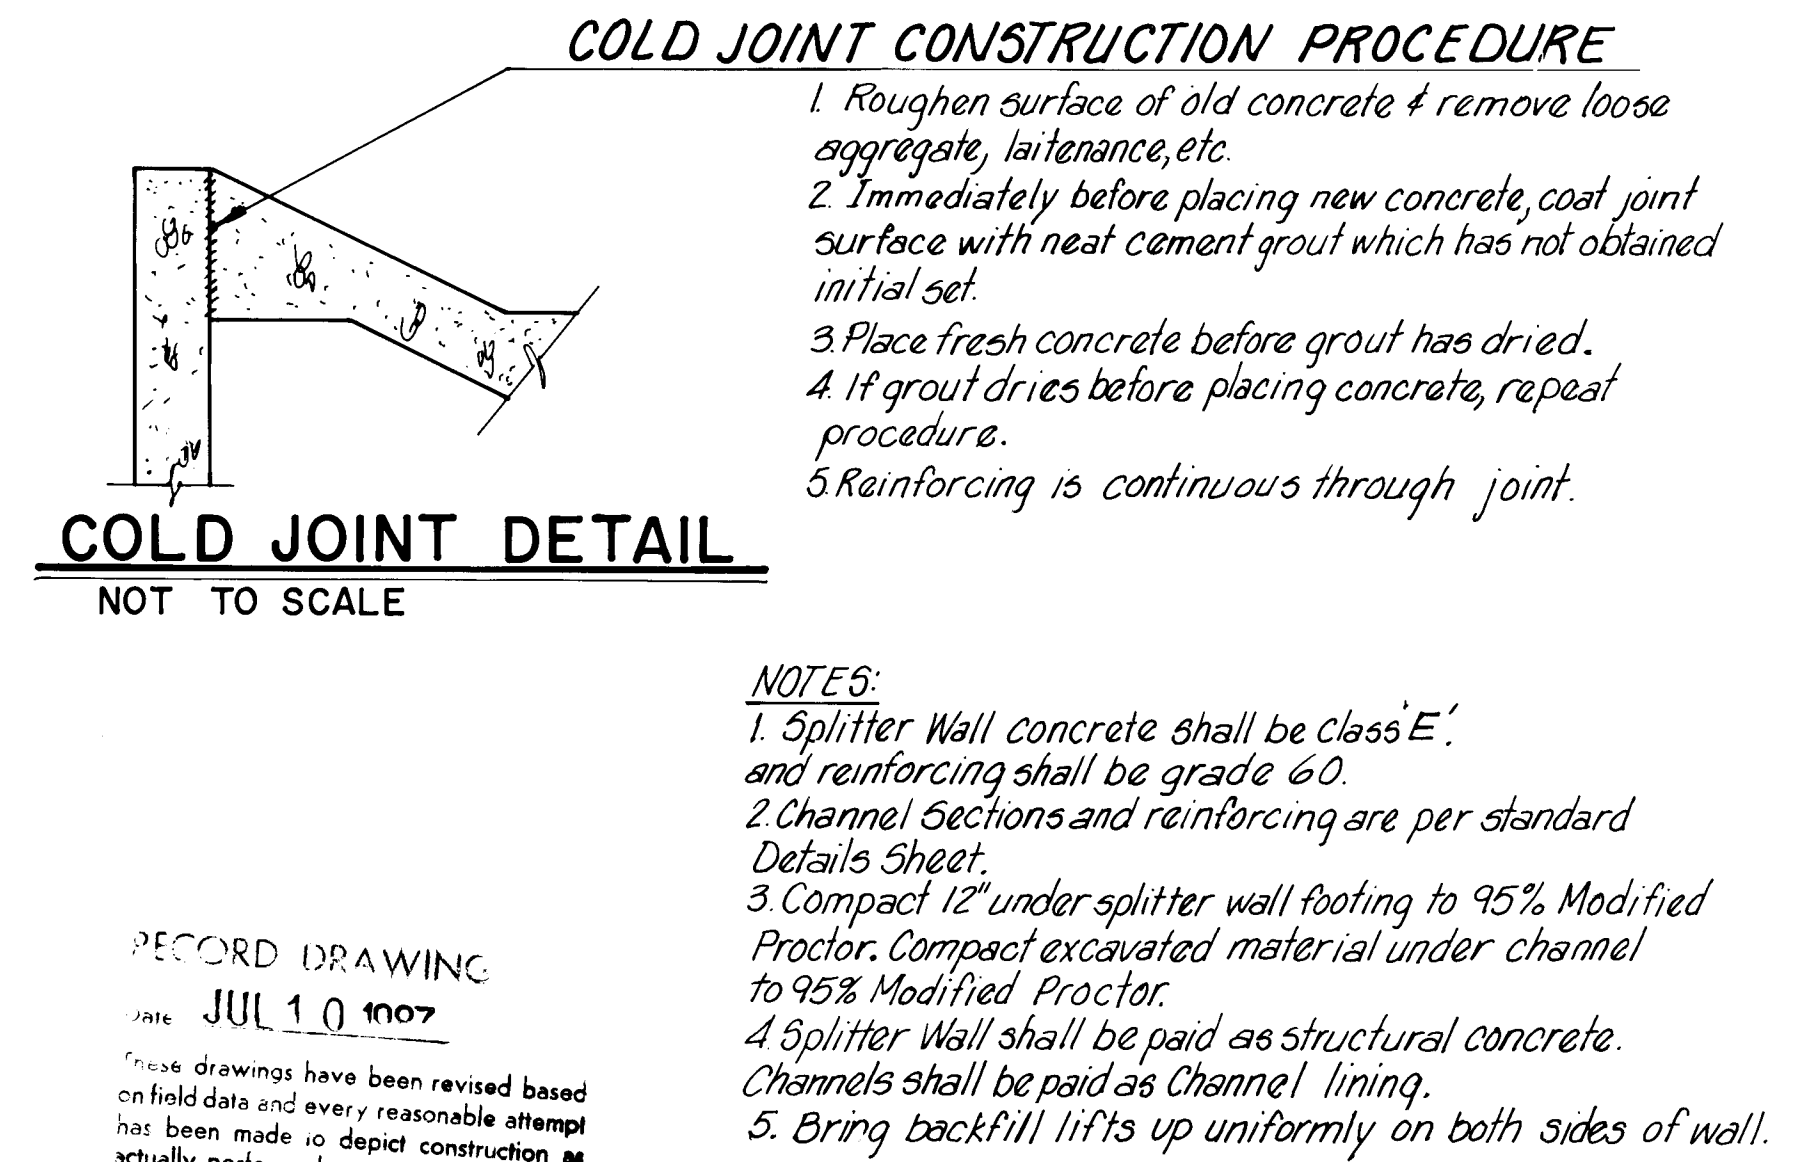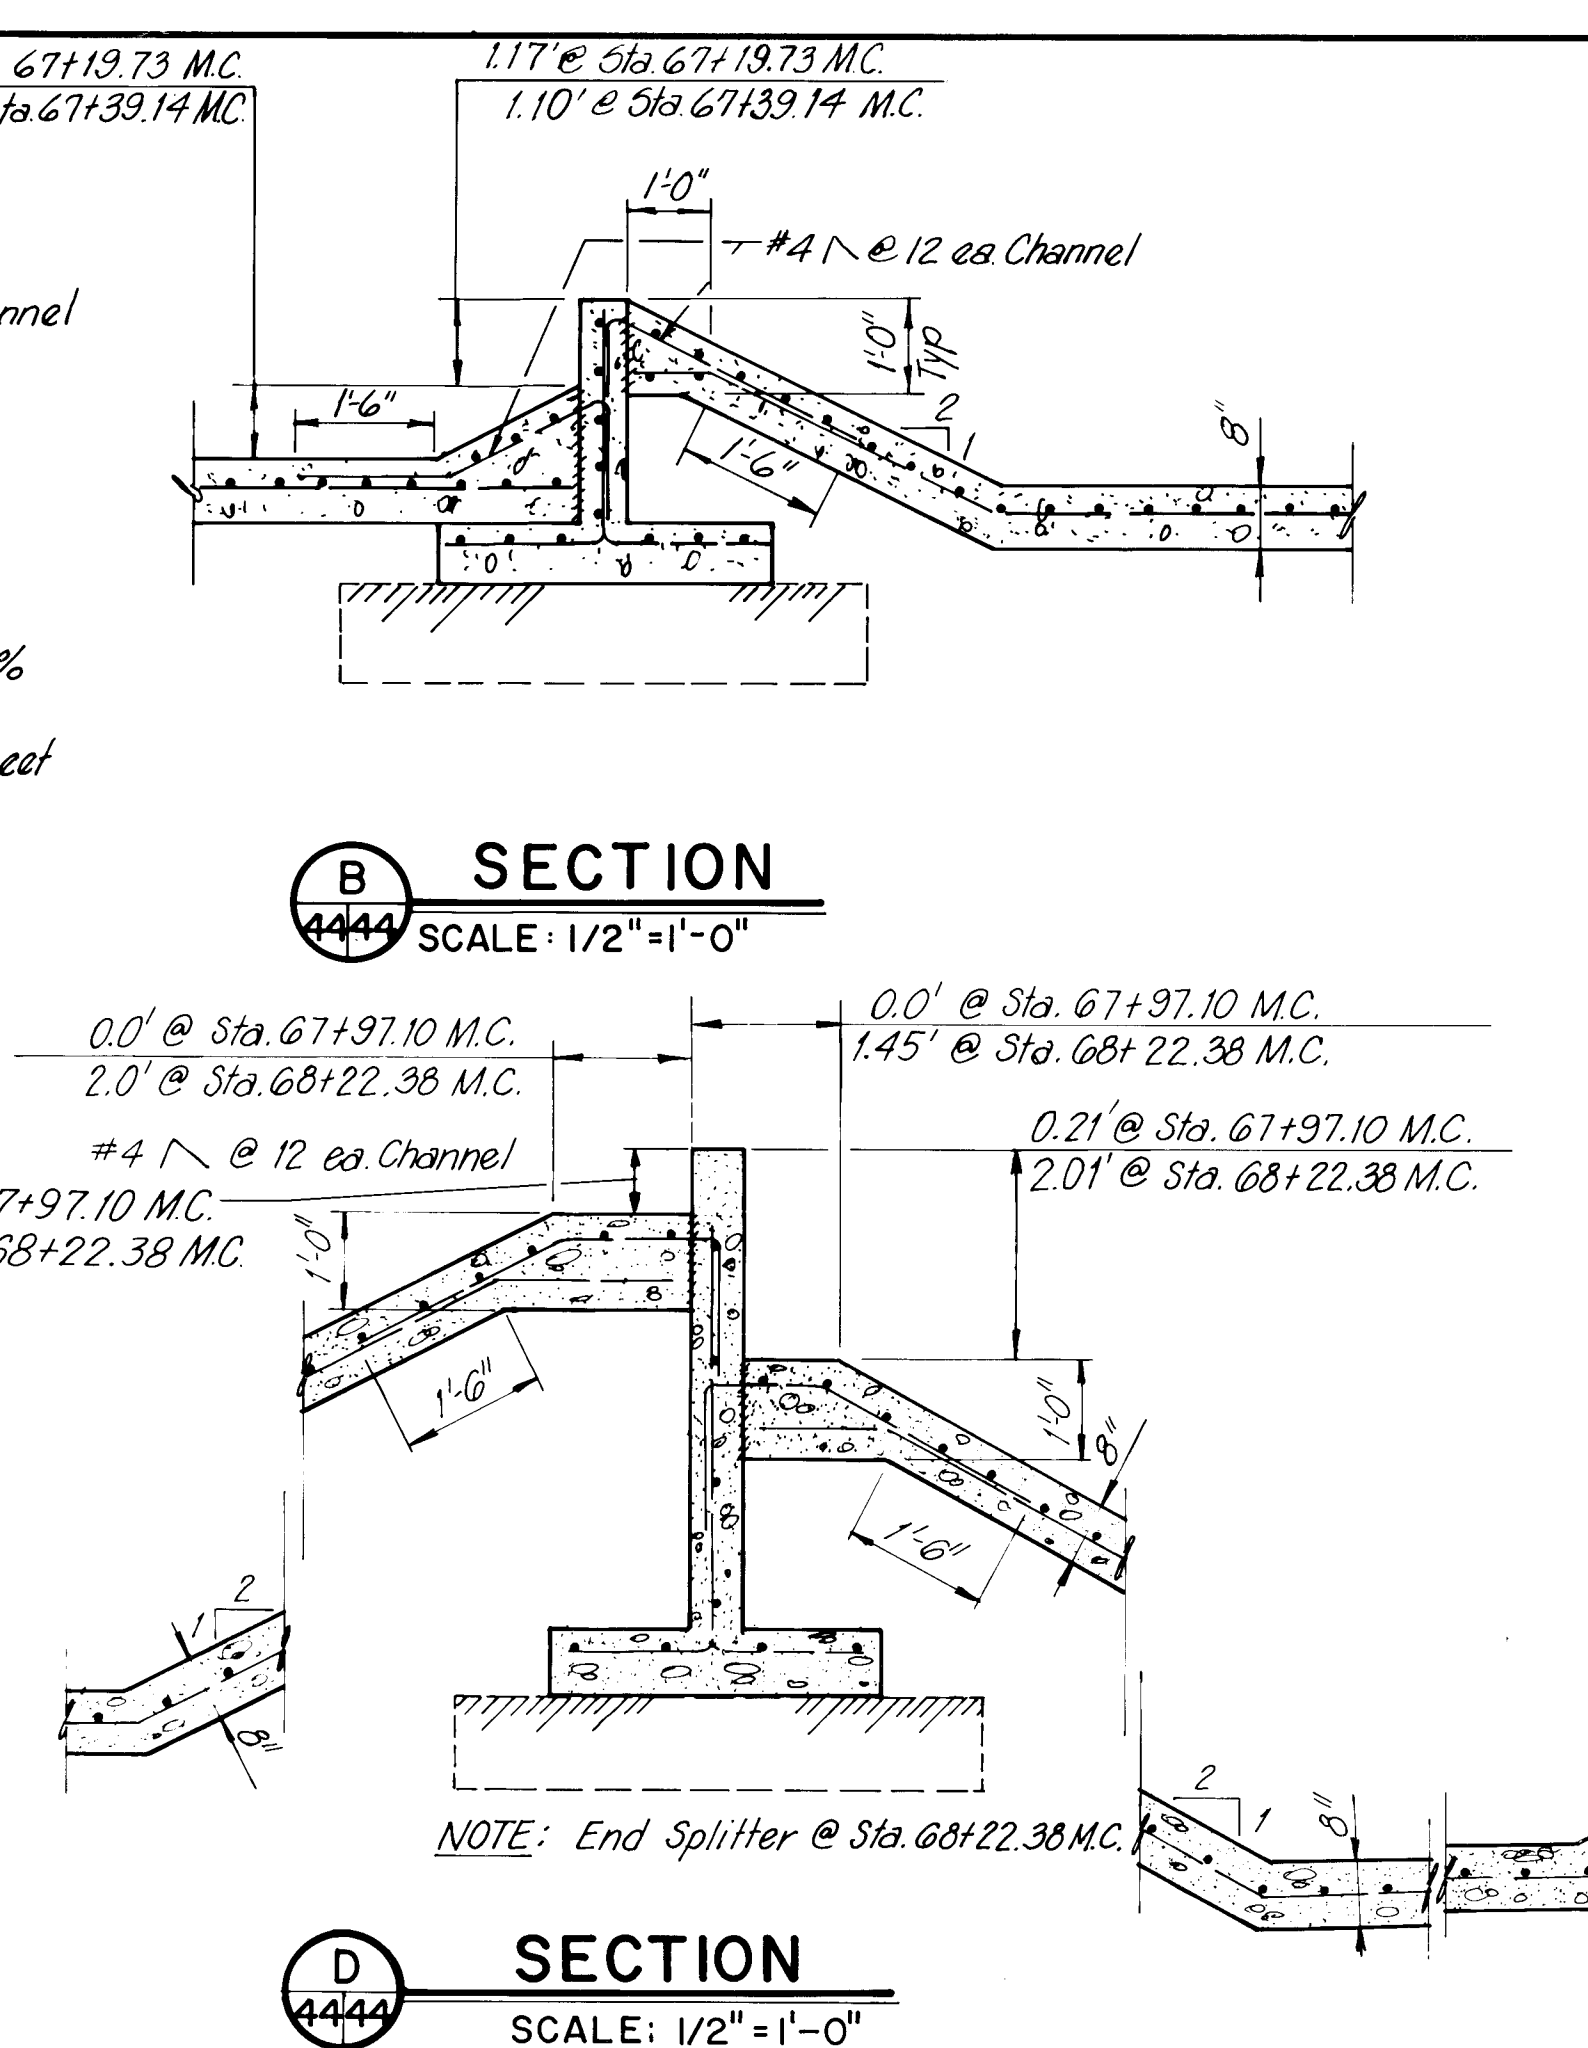


AMAFCA	
WESTGATE DIVERSION CHANNELS	
	SNOW VISTA CHANNEL PHASE III
	SPLITTER WALL LAYOUT AND DETAILS
	DRAWN J.L.B.
	DATE SEPT., 1968
GORDON HERKENHOFF & ASSOCIATES, INC.	
ALBUQUERQUE	ENGINEERS ARCHITECTS PLANNERS
SANTA FE	

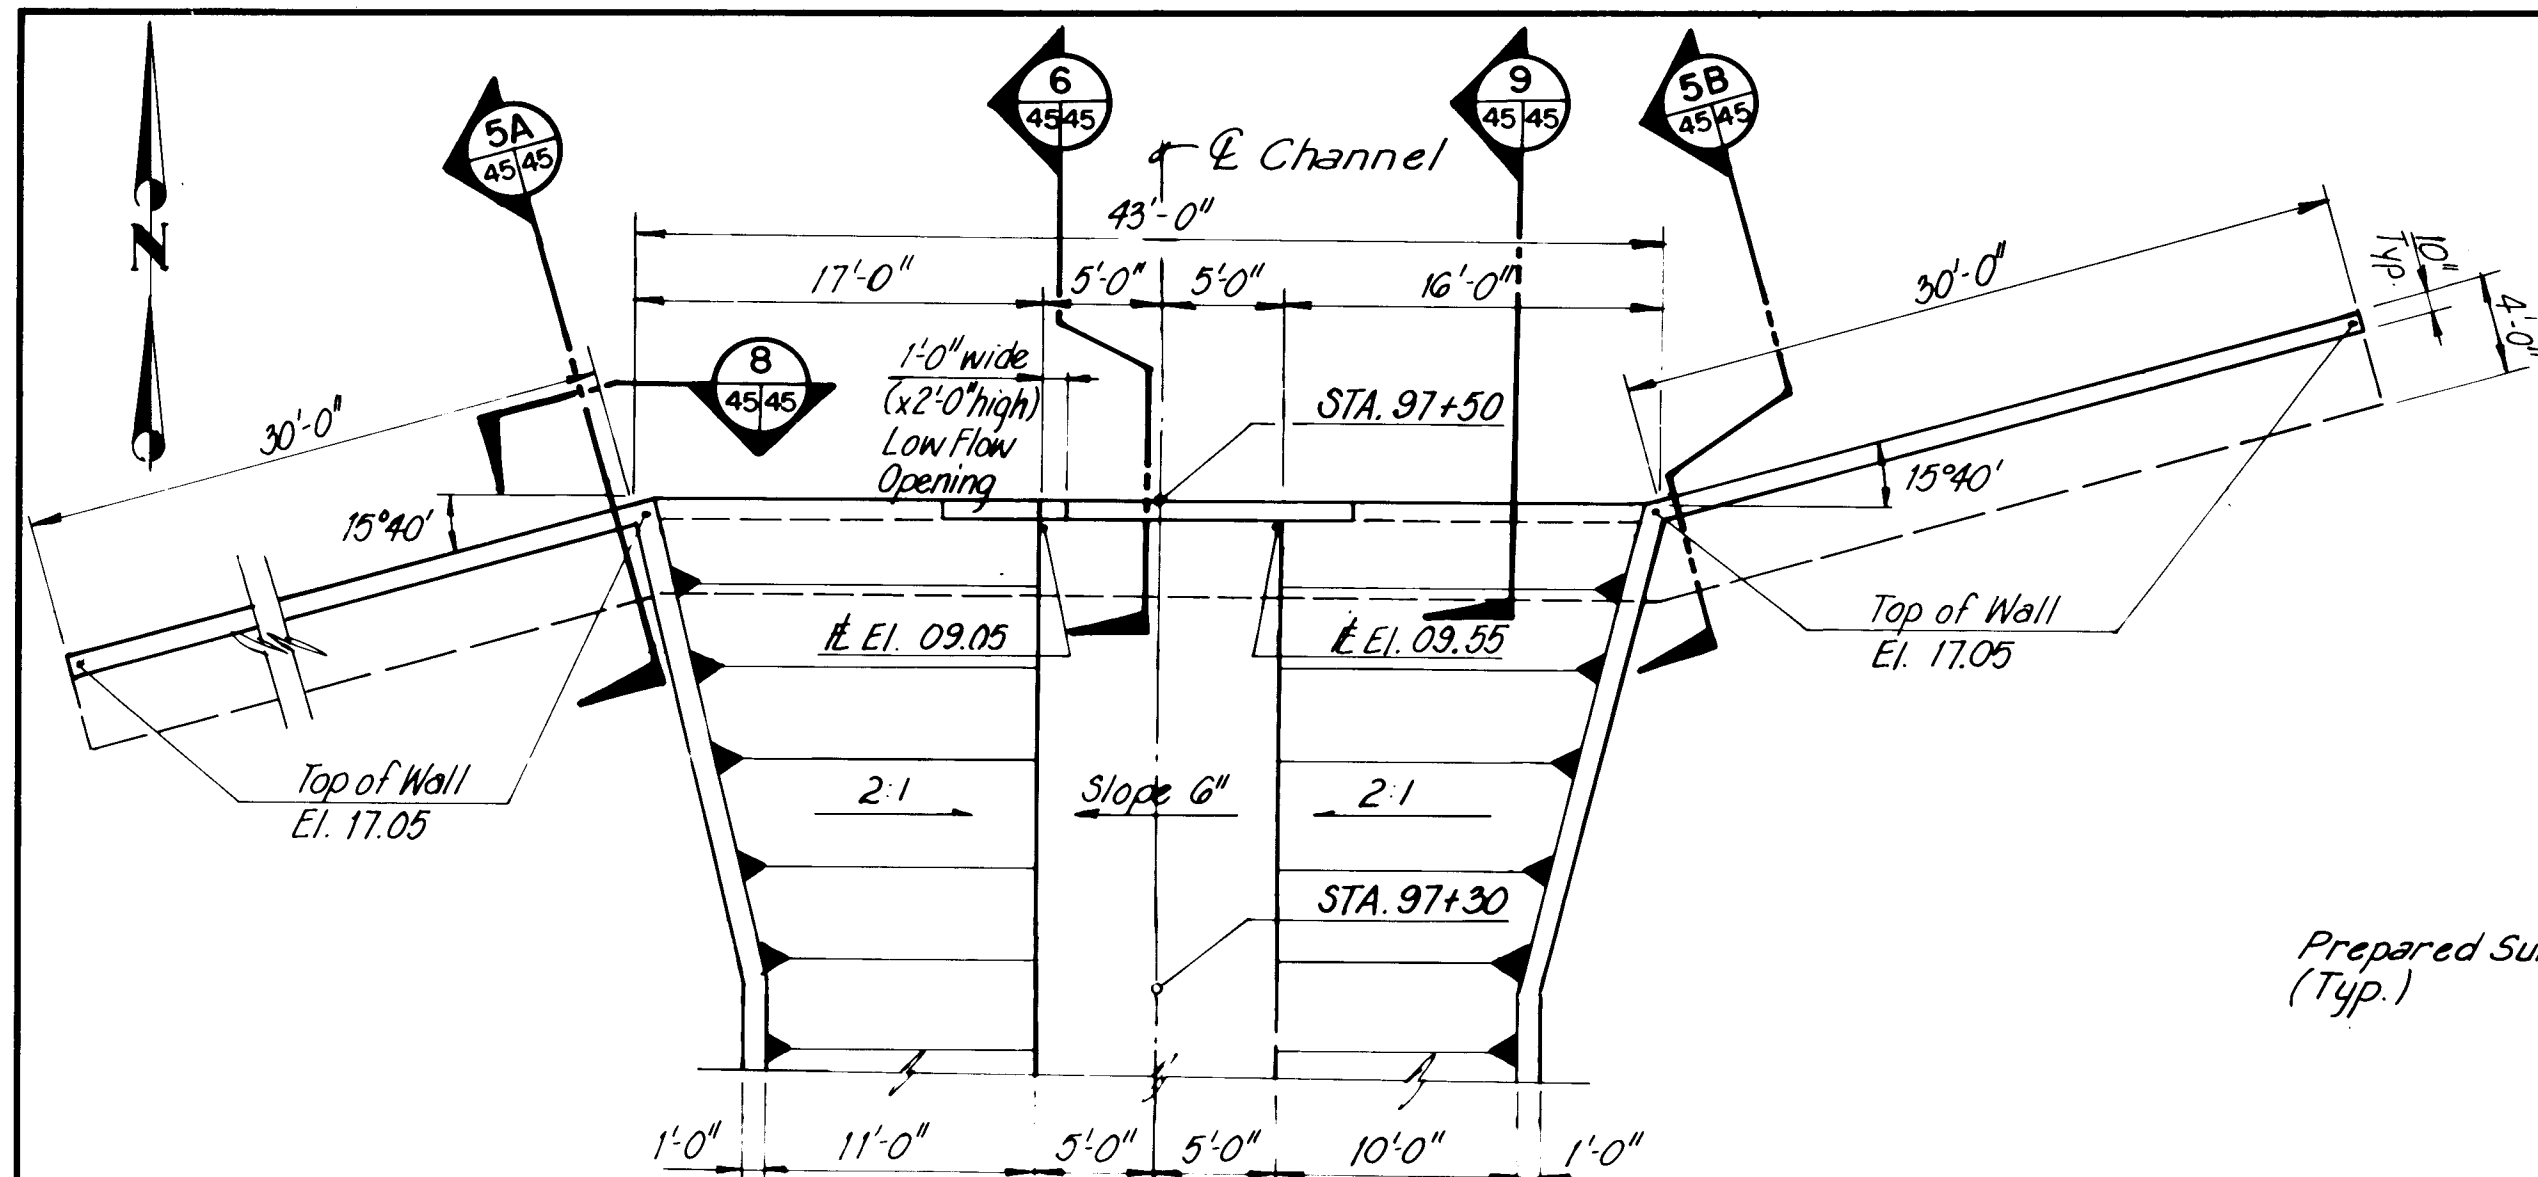


MAIN CHANNEL HEADWALL PLAN, STA. 97+50 & CHANNEL
SCALE: 1/8"=1'-0"

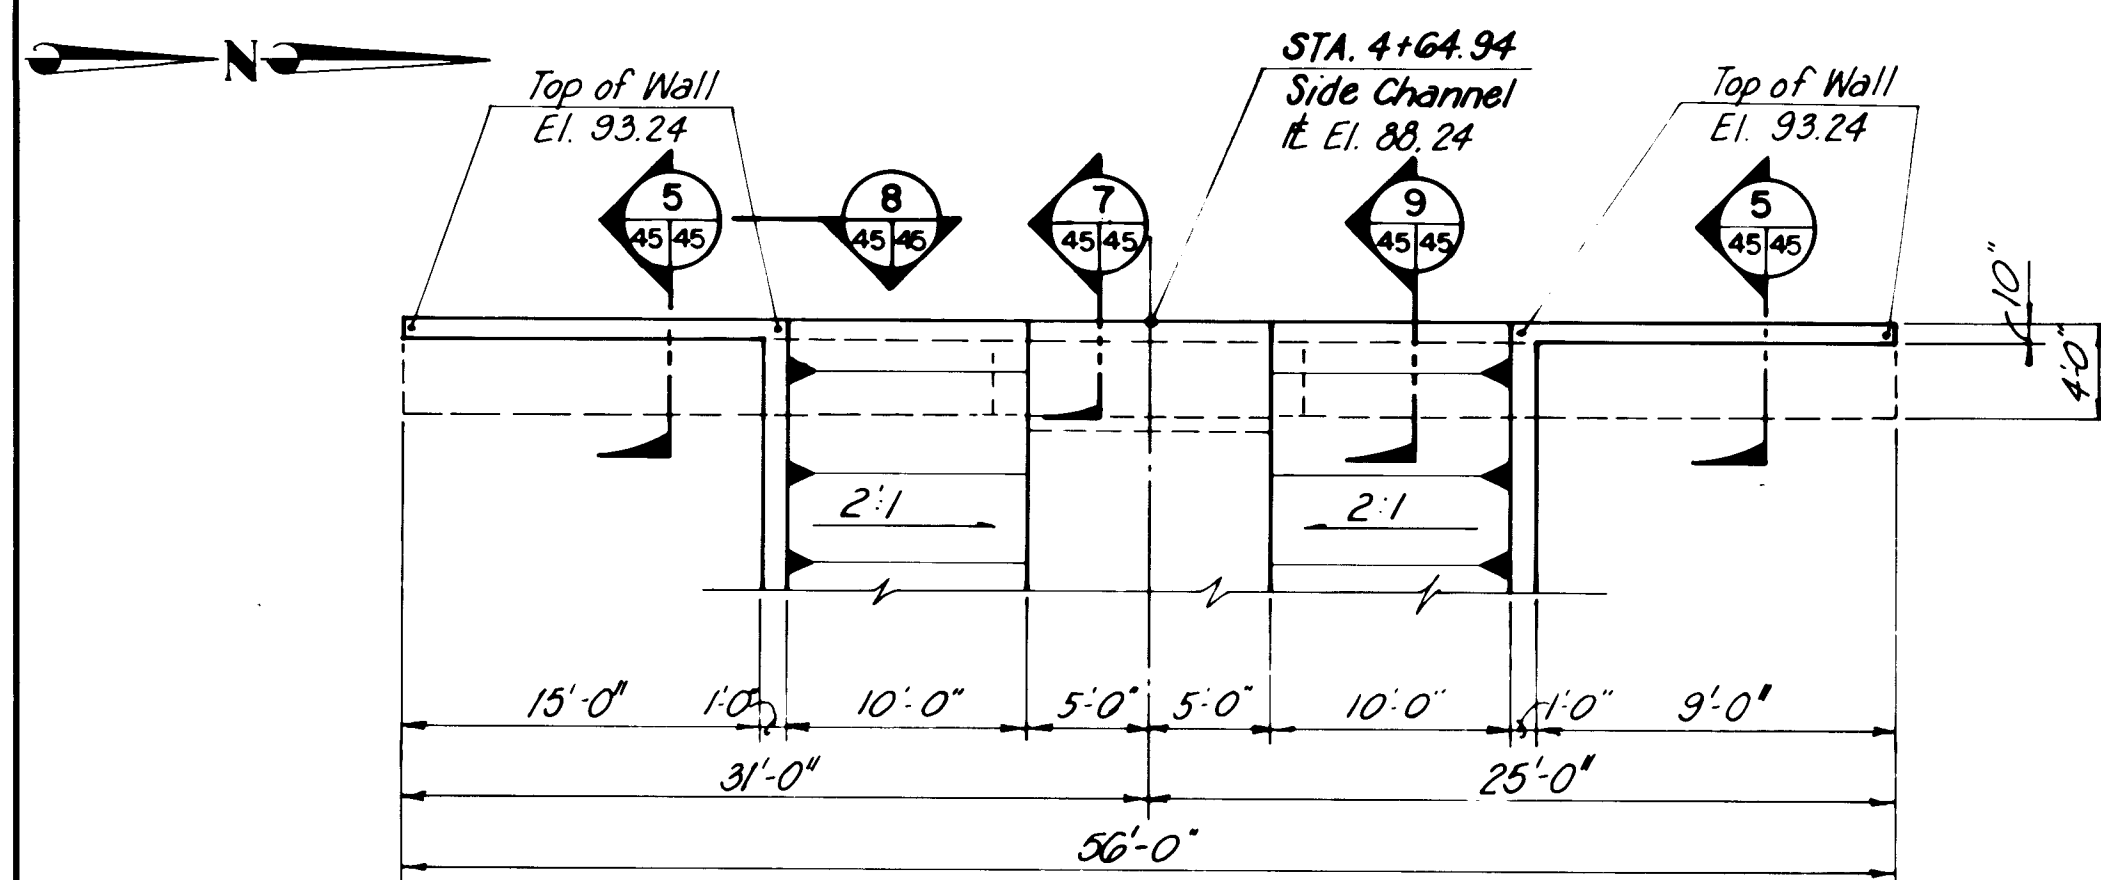


SIDE CHANNEL HEADWALL PLAN, STA. 4+64.94
SCALE: 1/8"=1'-0"

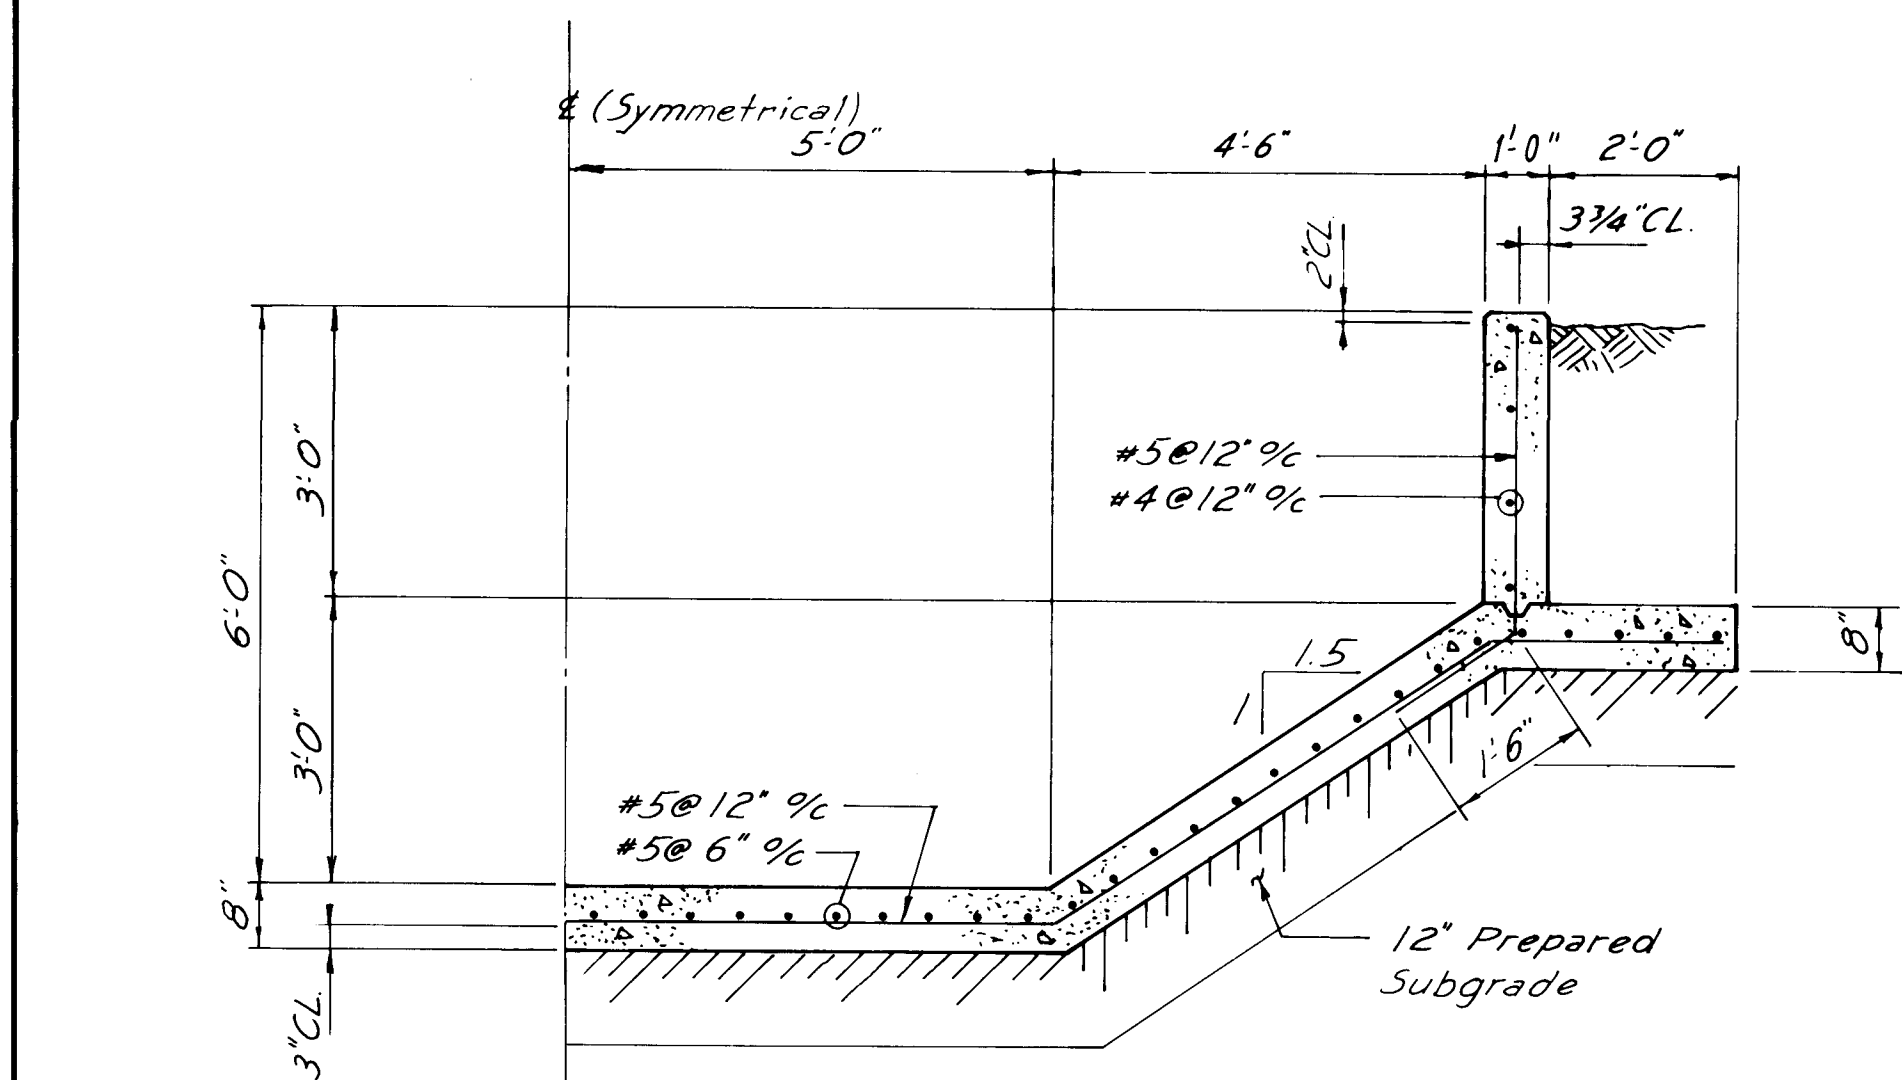


CHANNEL SECTION STA. 58+07.01 TO STA. 58+29.60
SCALE: 1/2"=1'-0"

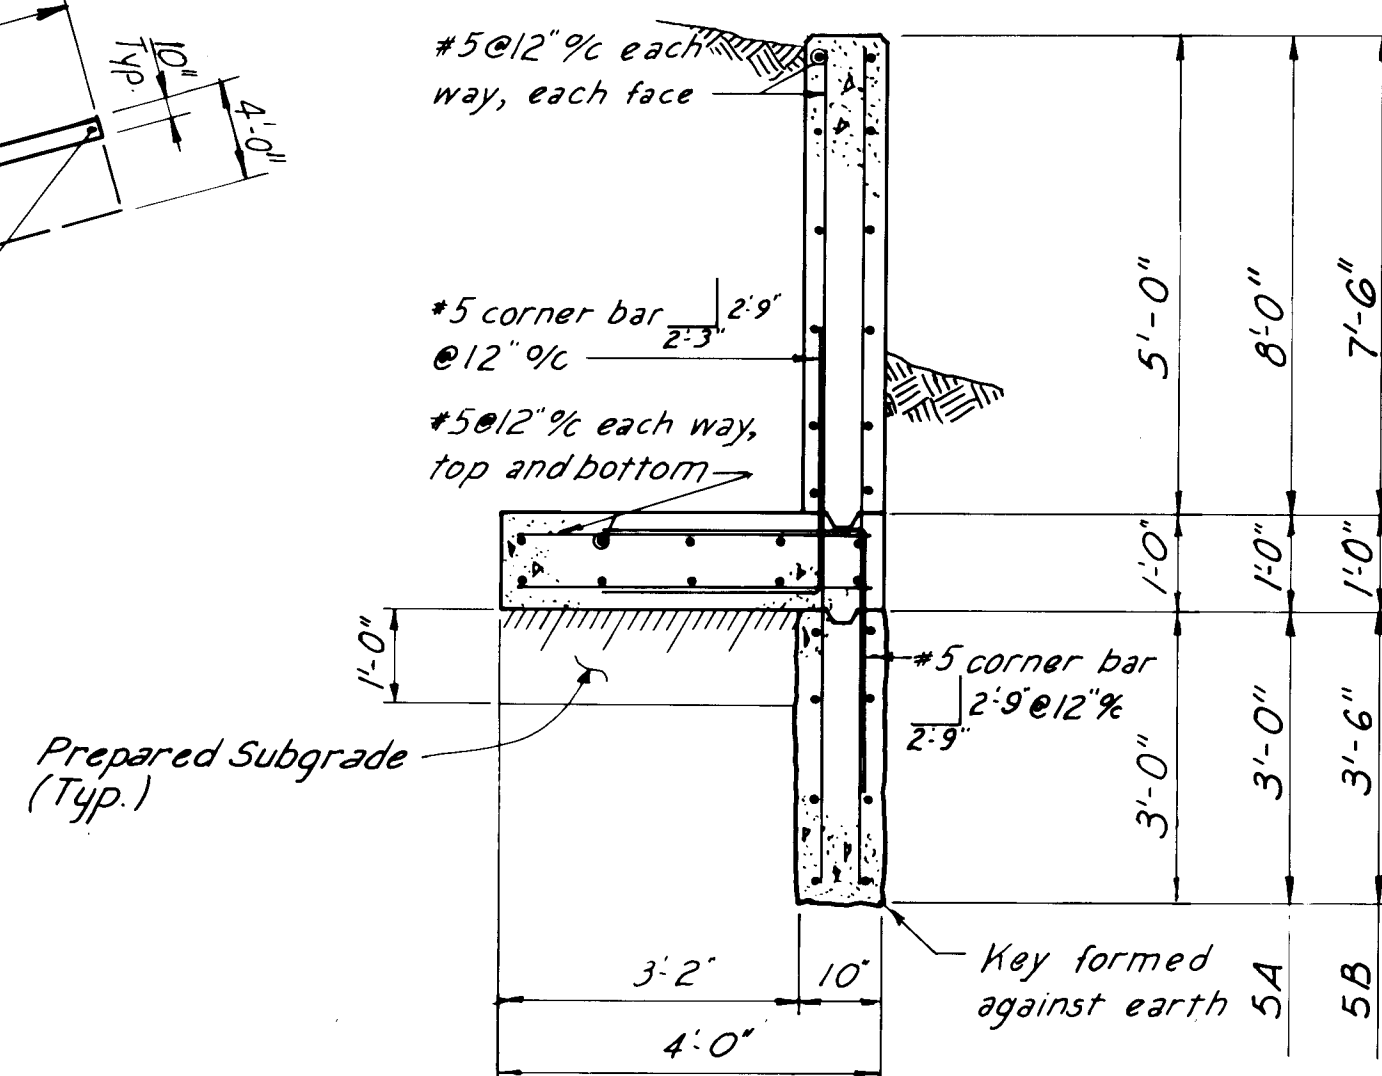


SECTION 5
SCALE: 1/2"=1'-0"

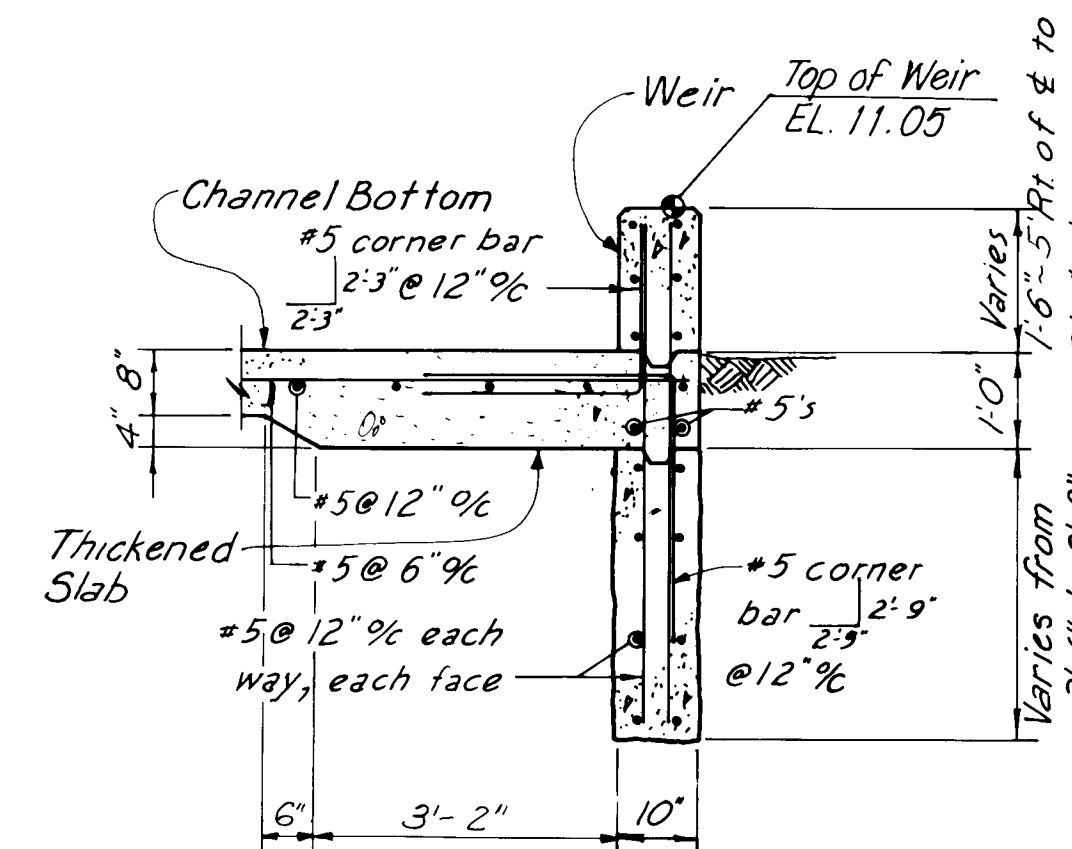


SECTION 6
SCALE: 1/2"=1'-0"

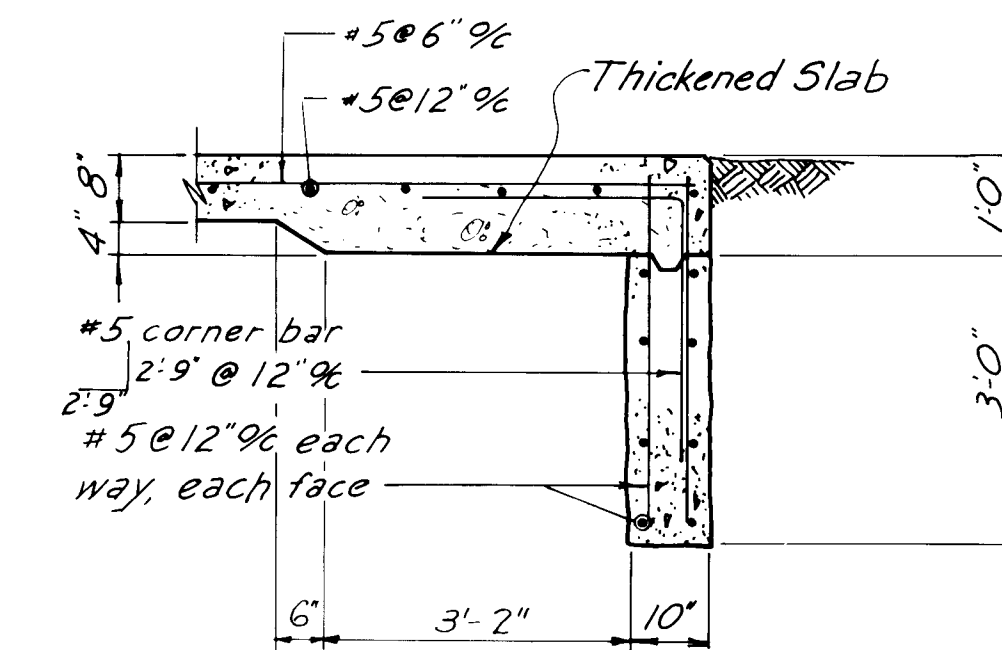


SECTION 7
SCALE: 1/2"=1'-0"

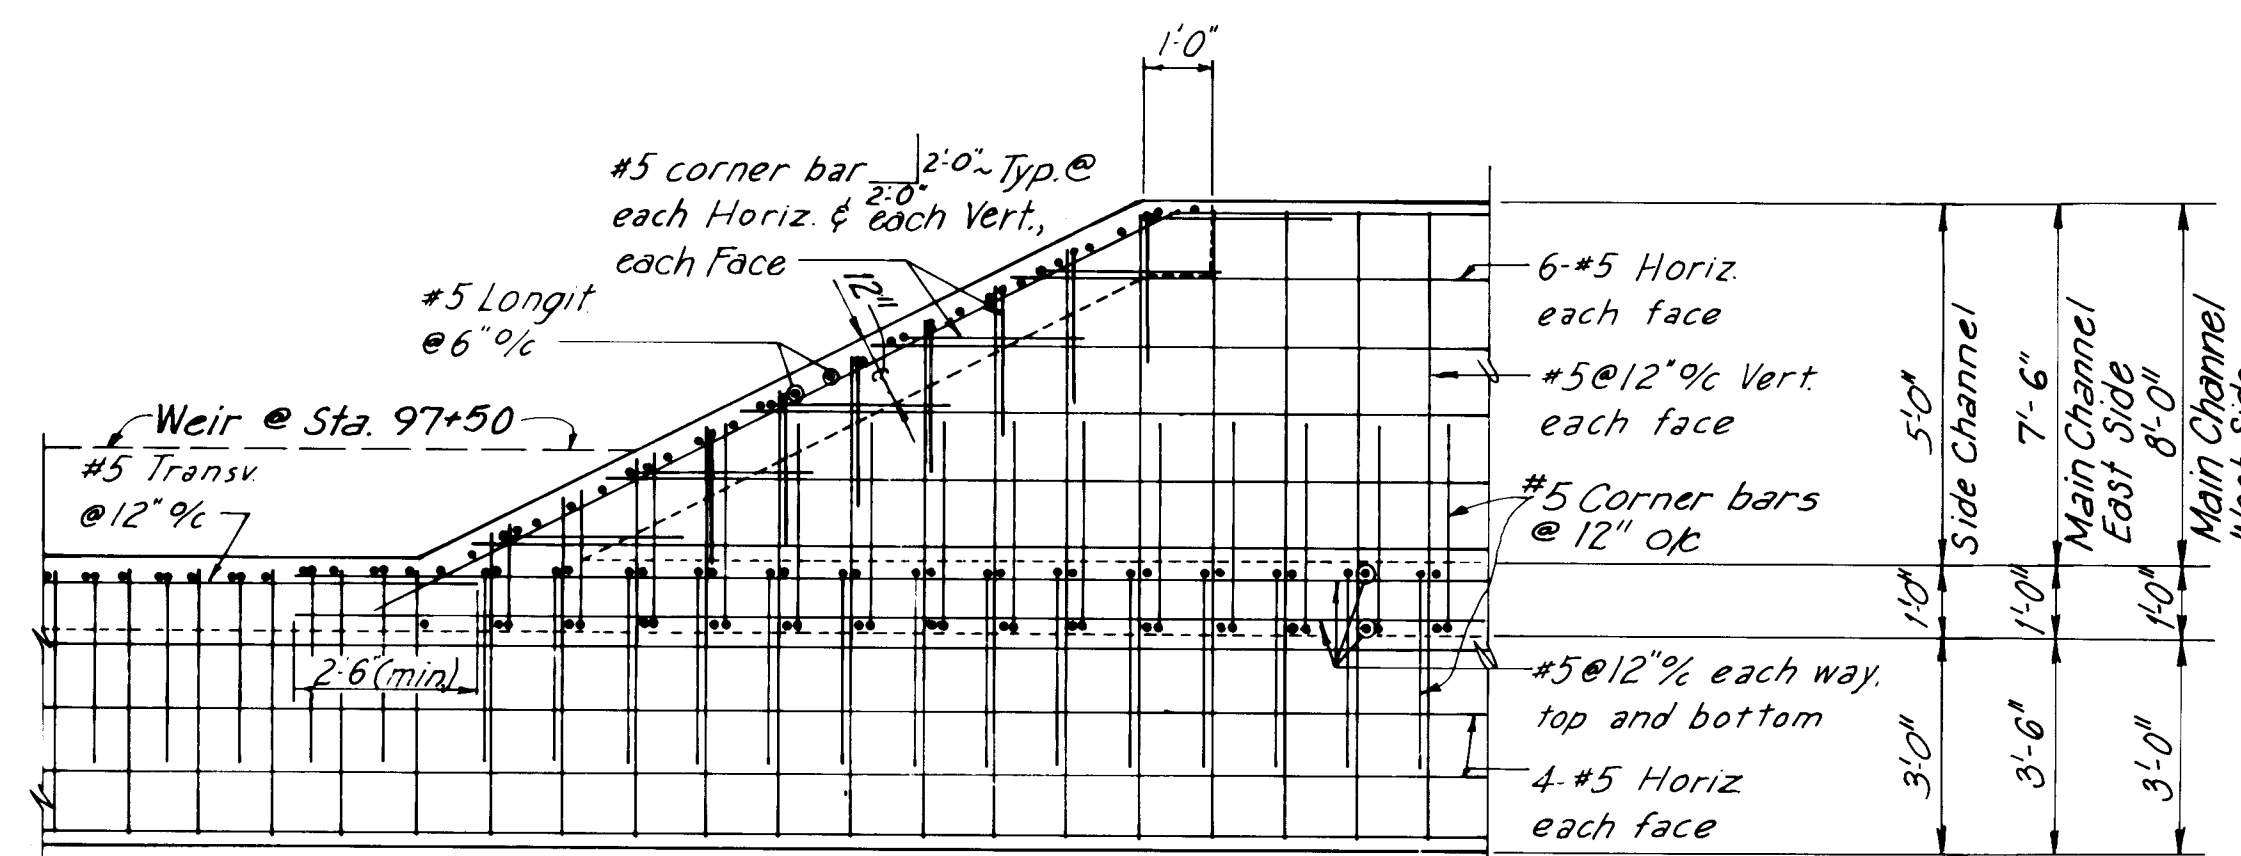

SECTION 8
SCALE: 3/8"=1'-0"

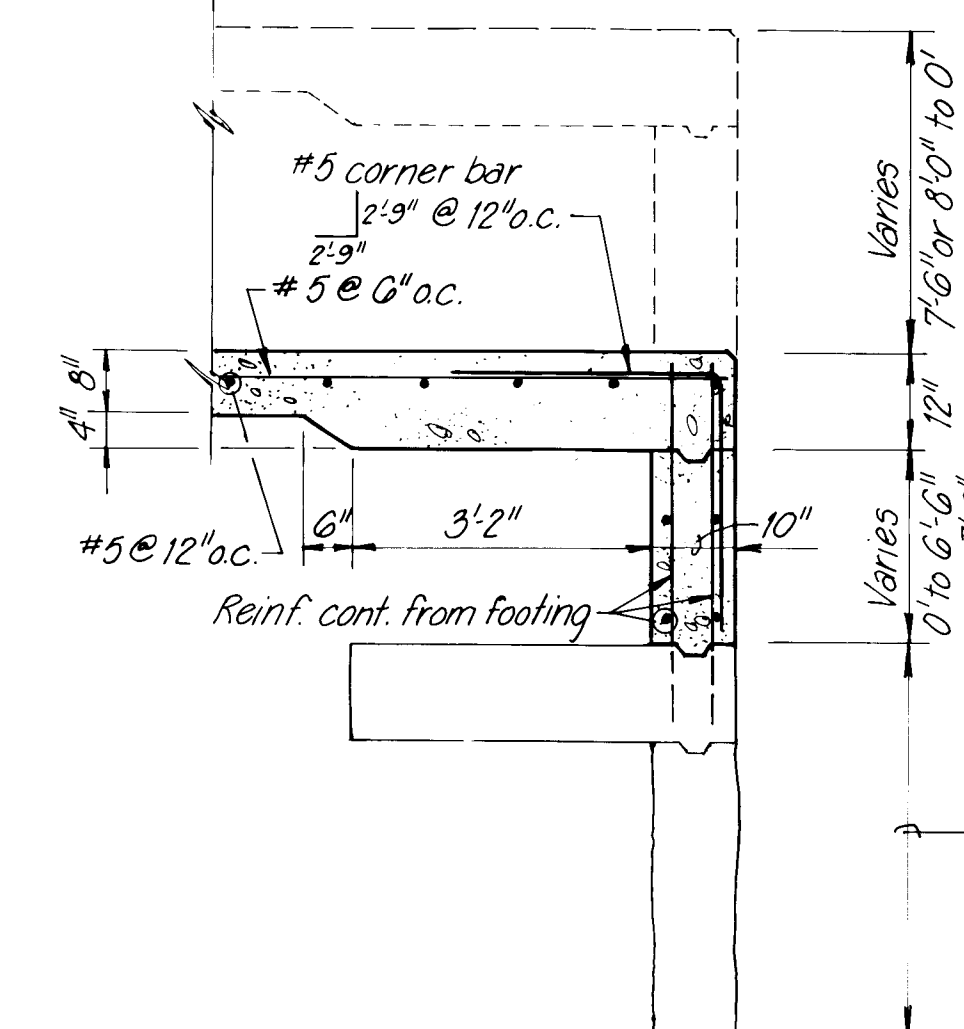

SECTION 9
SCALE: 1/2"=1'-0"

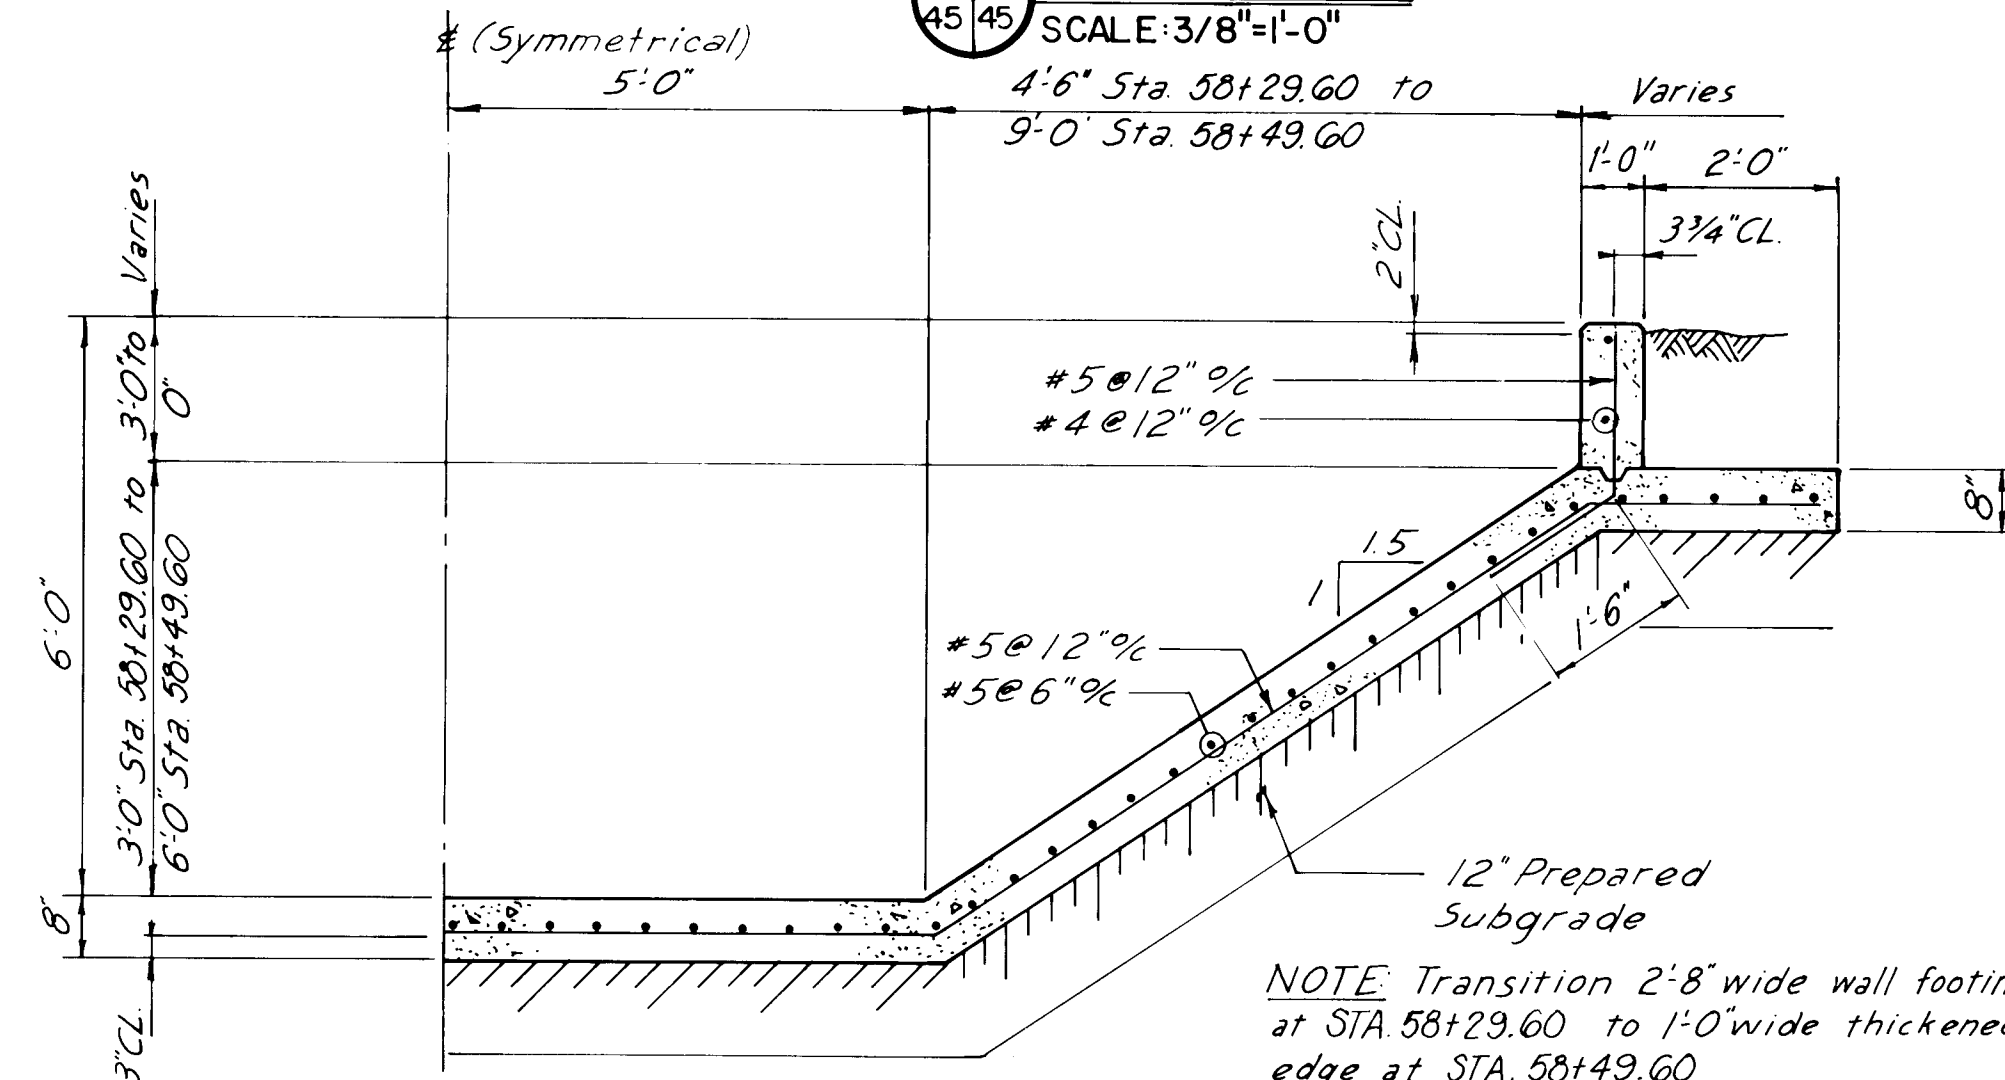


CHANNEL TRANSITION STA. 58+29.60 TO STA. 58+49.60
SCALE: 1/2"=1'-0"

NOTE:
Concrete for footings and headwalls shall be Class 'E'.
All other concrete shall be Class 'E'.

RECORD DRAWING

Date: JUL 10 1987

These drawings have been revised based on field data and every reasonable attempt has been made to depict construction as actually performed.

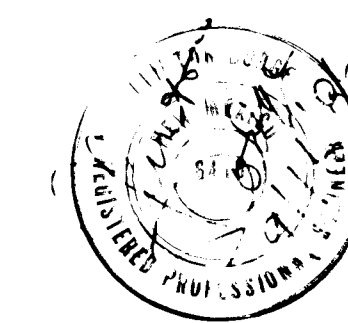


26 17234587

REVISED 11/6/86

AMAFCA	
WESTGATE DIVERSION CHANNELS	
	SNOW VISTA CHANNEL PHASE III
	STRUCTURAL TRANSITION
	AND
	HEADWALL DETAILS
GORDON HERKENHOFF & ASSOCIATES, INC.	
ALBUQUERQUE	ENGINEERS ARCHITECTS PLANNERS FARMINGTON SANTA FE

ORIGINAL	SURVEYED	BY	DATE
SURVEY	PLOTTED		
NOTE BOOK	TEMPLATE		
	AREAS		
NO. _____	AREAS CHECKED _____		

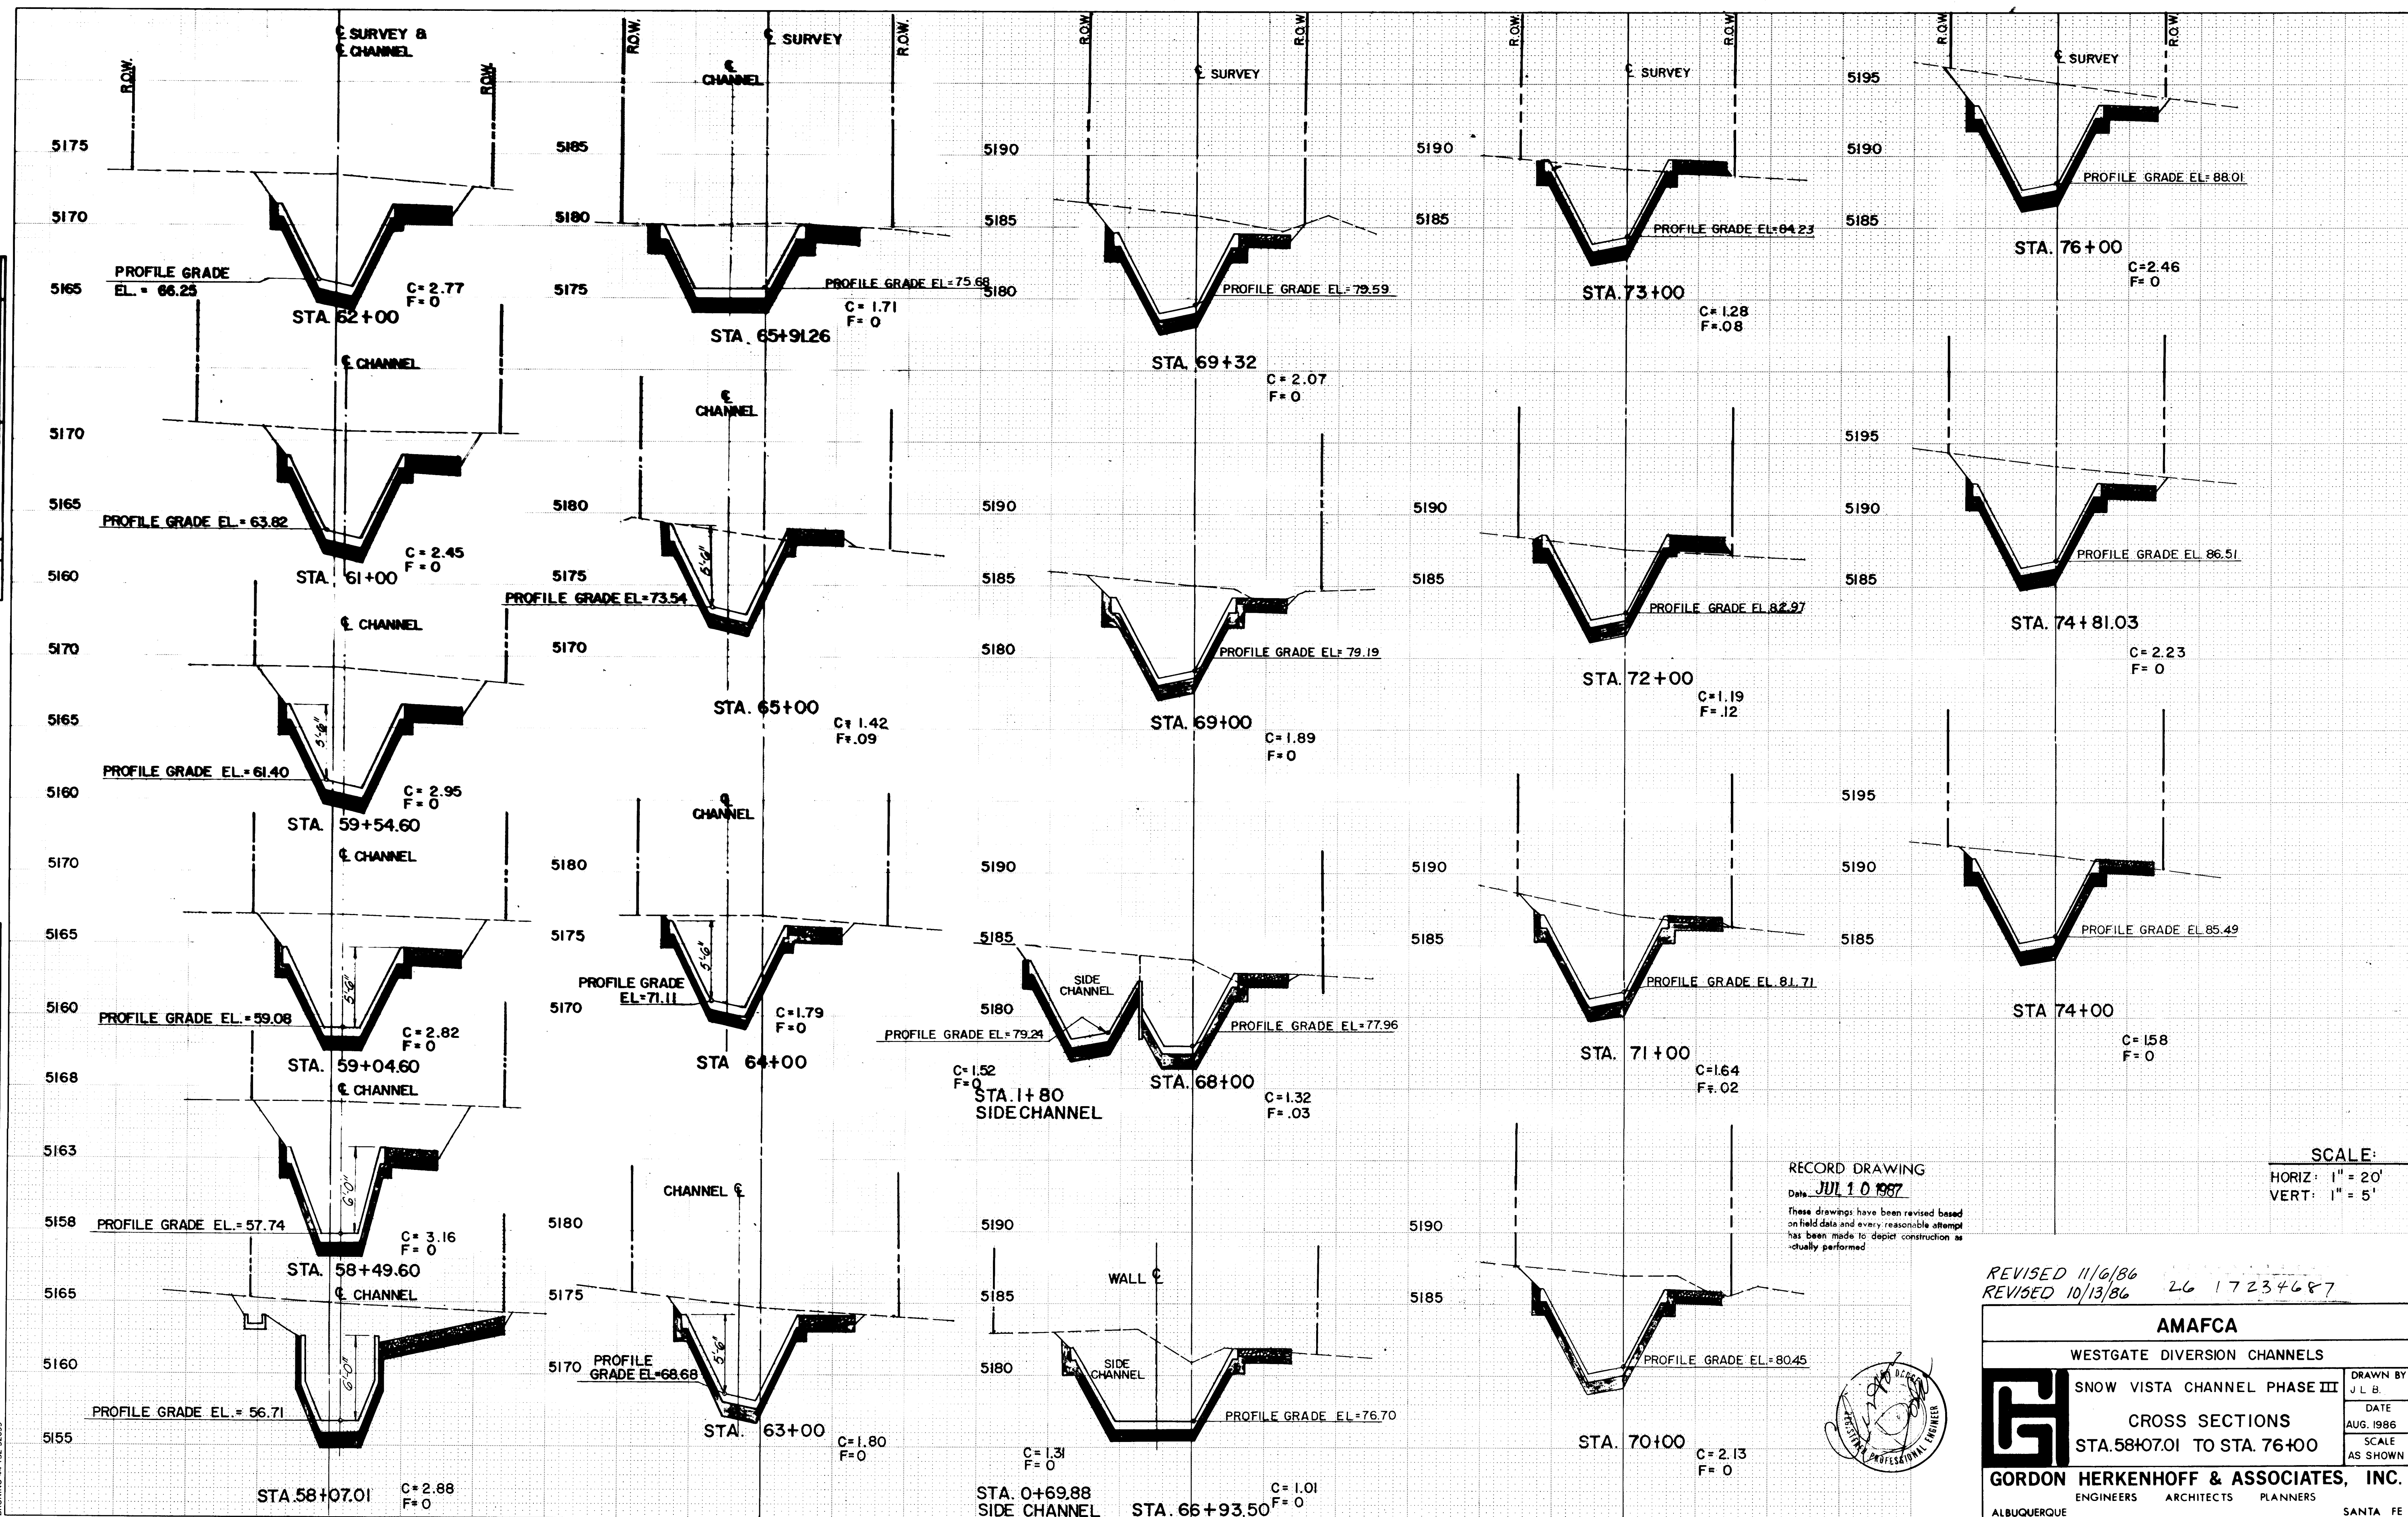

SCALE:

HORIZ: 1" = 20'

VERT: 1" = 5'

RECORD DRAWING

Date **JUL 10 1987**

These drawings have been revised based on field data and every reasonable attempt has been made to depict construction as actually performed.

REVISED 11/6/86
REVISED 10/13/86

AMAFCA

WESTGATE DIVERSION CHANNELS

SNOW VISTA CHANNEL PHASE 1

CROSS SECTIONS

STA 58+07.01 TO STA 76+00

GORDON HERKENHOFF & ASSOCIATES, INC.

ENGINEERS ARCHITECTS PLANNERS

DATE	11/11/2011
DRAWN BY	11/11/2011

III J L B.

DATE
AUG 1966


AUG. 1986
SCALE

AS SHOWN

ES. INC.


PLATE 3 CROSS SECTION - DOTTED
CHARLES BRUNING COMPANY
MADE IN U.S.A.

ORIGINAL SURVEY		SURVED BY _____	DATE _____
NOTE BOOK		PLOTTED _____	
NO. _____		TEMPLATE _____	
		AREAS _____	
		AREAS CHECKED _____	

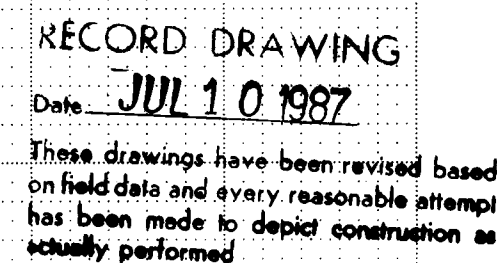


AMAFCA			
WESTGATE DIVERSION CHANNELS			
	SNOW VISTA CHANNEL PHASE III		DRAWN BY K.H.K./P.P.
	CROSS SECTIONS		DATE AUG. 1986
	STA. 96+00 TO STA. 100+73		SCALE AS SHOWN
GORDON HERKENHOFF & ASSOCIATES, INC.			
ENGINEERS		ARCHITECTS	PLANNERS
ALBUQUERQUE		SANTA FE	

ORIGINAL					
SURVEY					
NOTE BOOK					
NO					
	SURVEYED		BY		DATE
	PLOTTED				
	TEMPLATE				
	AREAS				
	AREAS CHECKED				

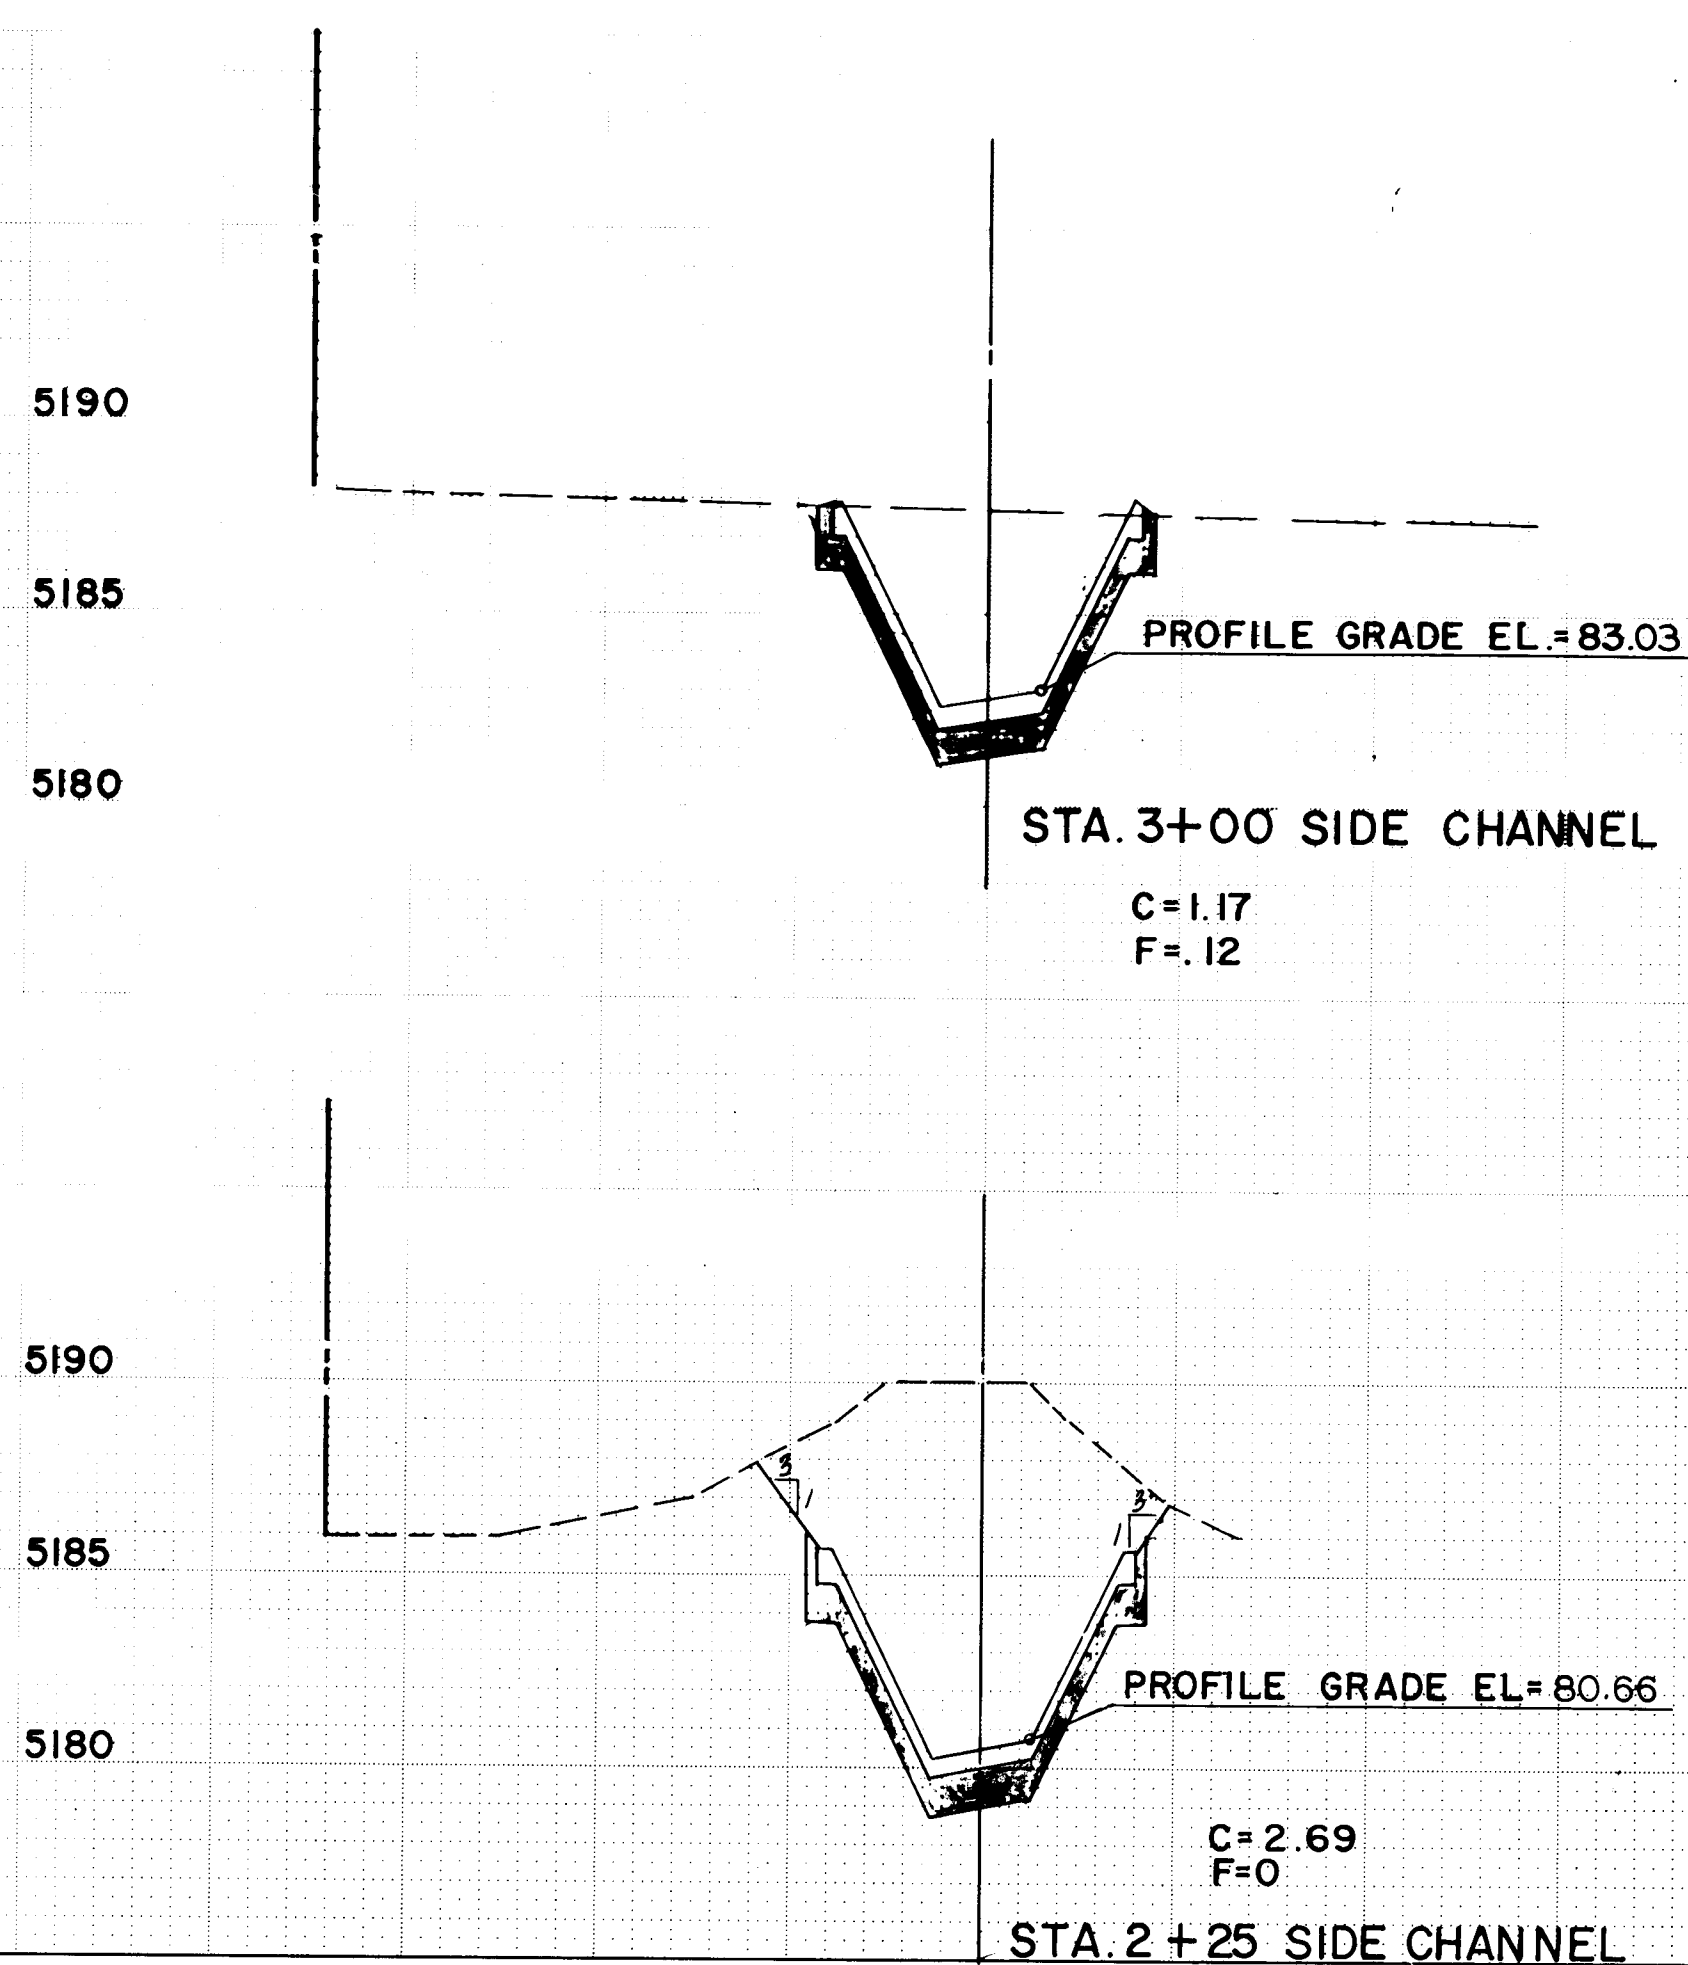

TYPICAL CHANNEL SECTION

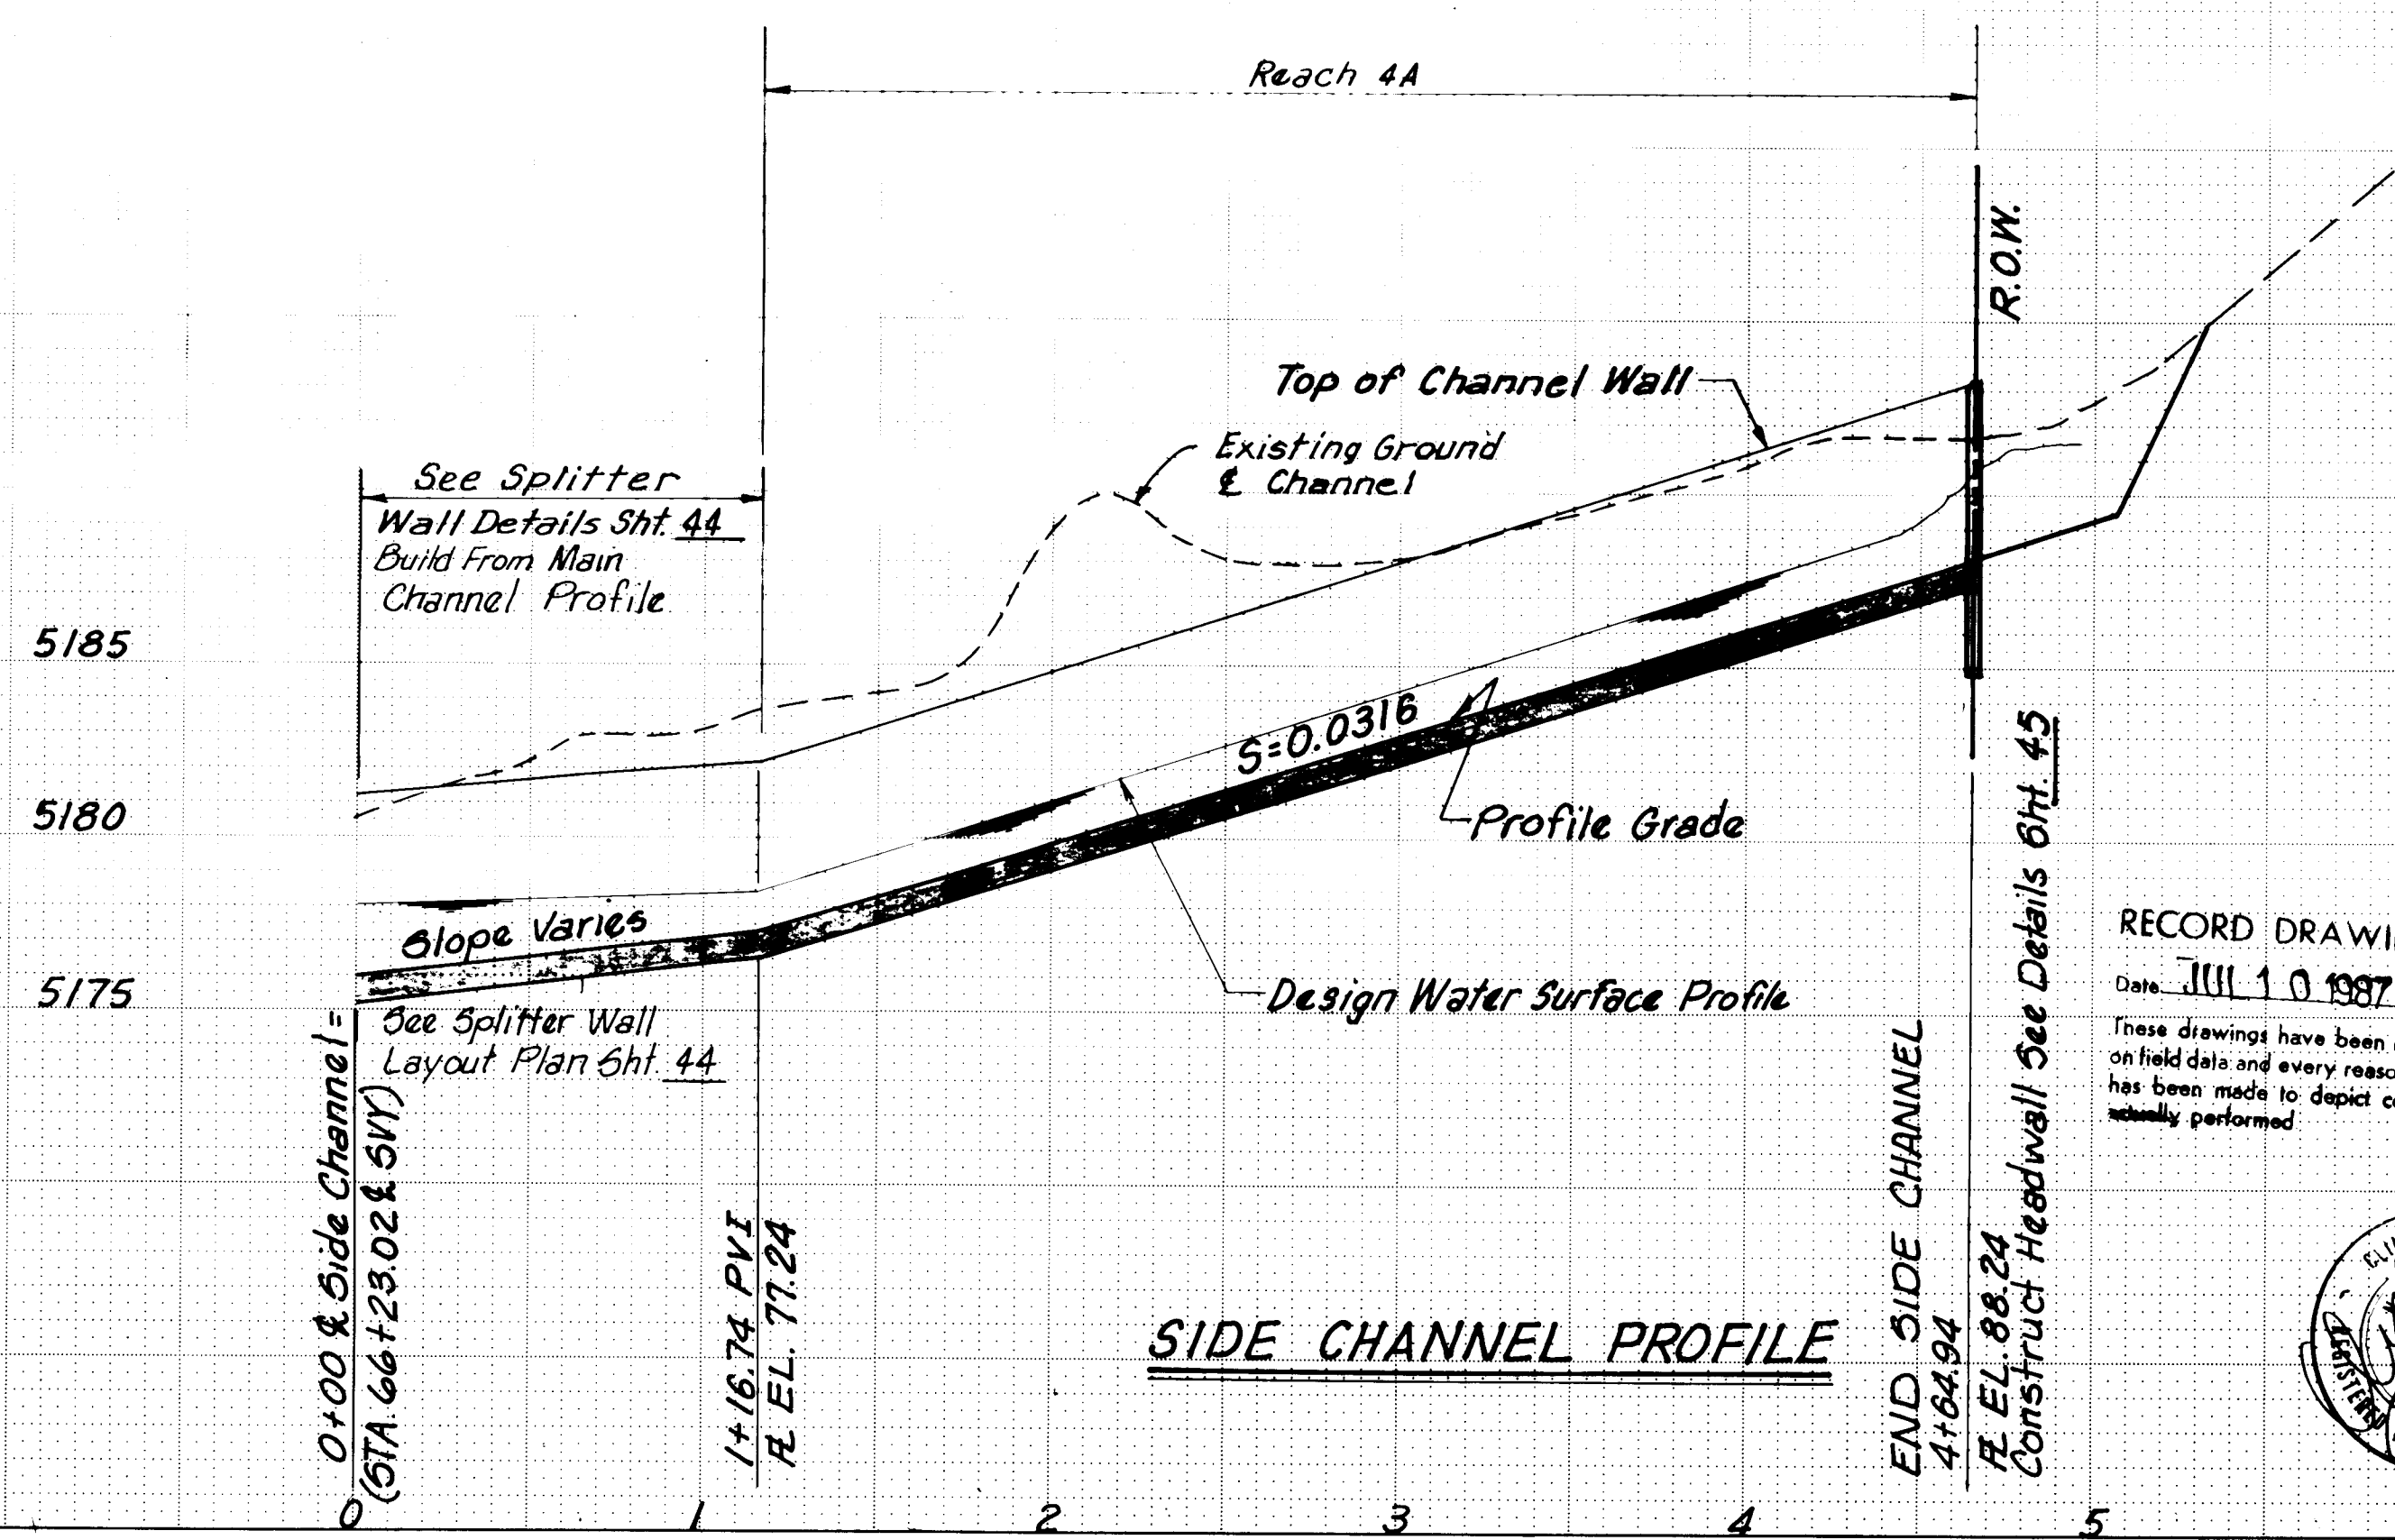

SCALE
HORIZ. = 1" = 50'
VERT. = 1" = 5'


NOTES:
Profile Stationing is Along $\pm$ Side Channel
Profile Grades @ 5' Rt. of $\pm$ Side Channel

RECORD DRAWING
Date JUL 10 1987


2	6	1	7	2	3	4	9	8	7
---	---	---	---	---	---	---	---	---	---

AMAFCA		
WESTGATE DIVERSION CHANNELS		
	SNOW VISTA CHANNEL PHASE III SIDE CHANNEL PROFILE AND CROSS SECTIONS STA. 2+25 TO STA. 4+64.94	DRAWN BY J.L.B.
		DATE AUG. 1986
		SCALE AS SHOWN
	GORDON HERKENHOFF & ASSOCIATES, INC. ENGINEERS ARCHITECTS PLANNERS	
ALBUQUERQUE		SANTA FE




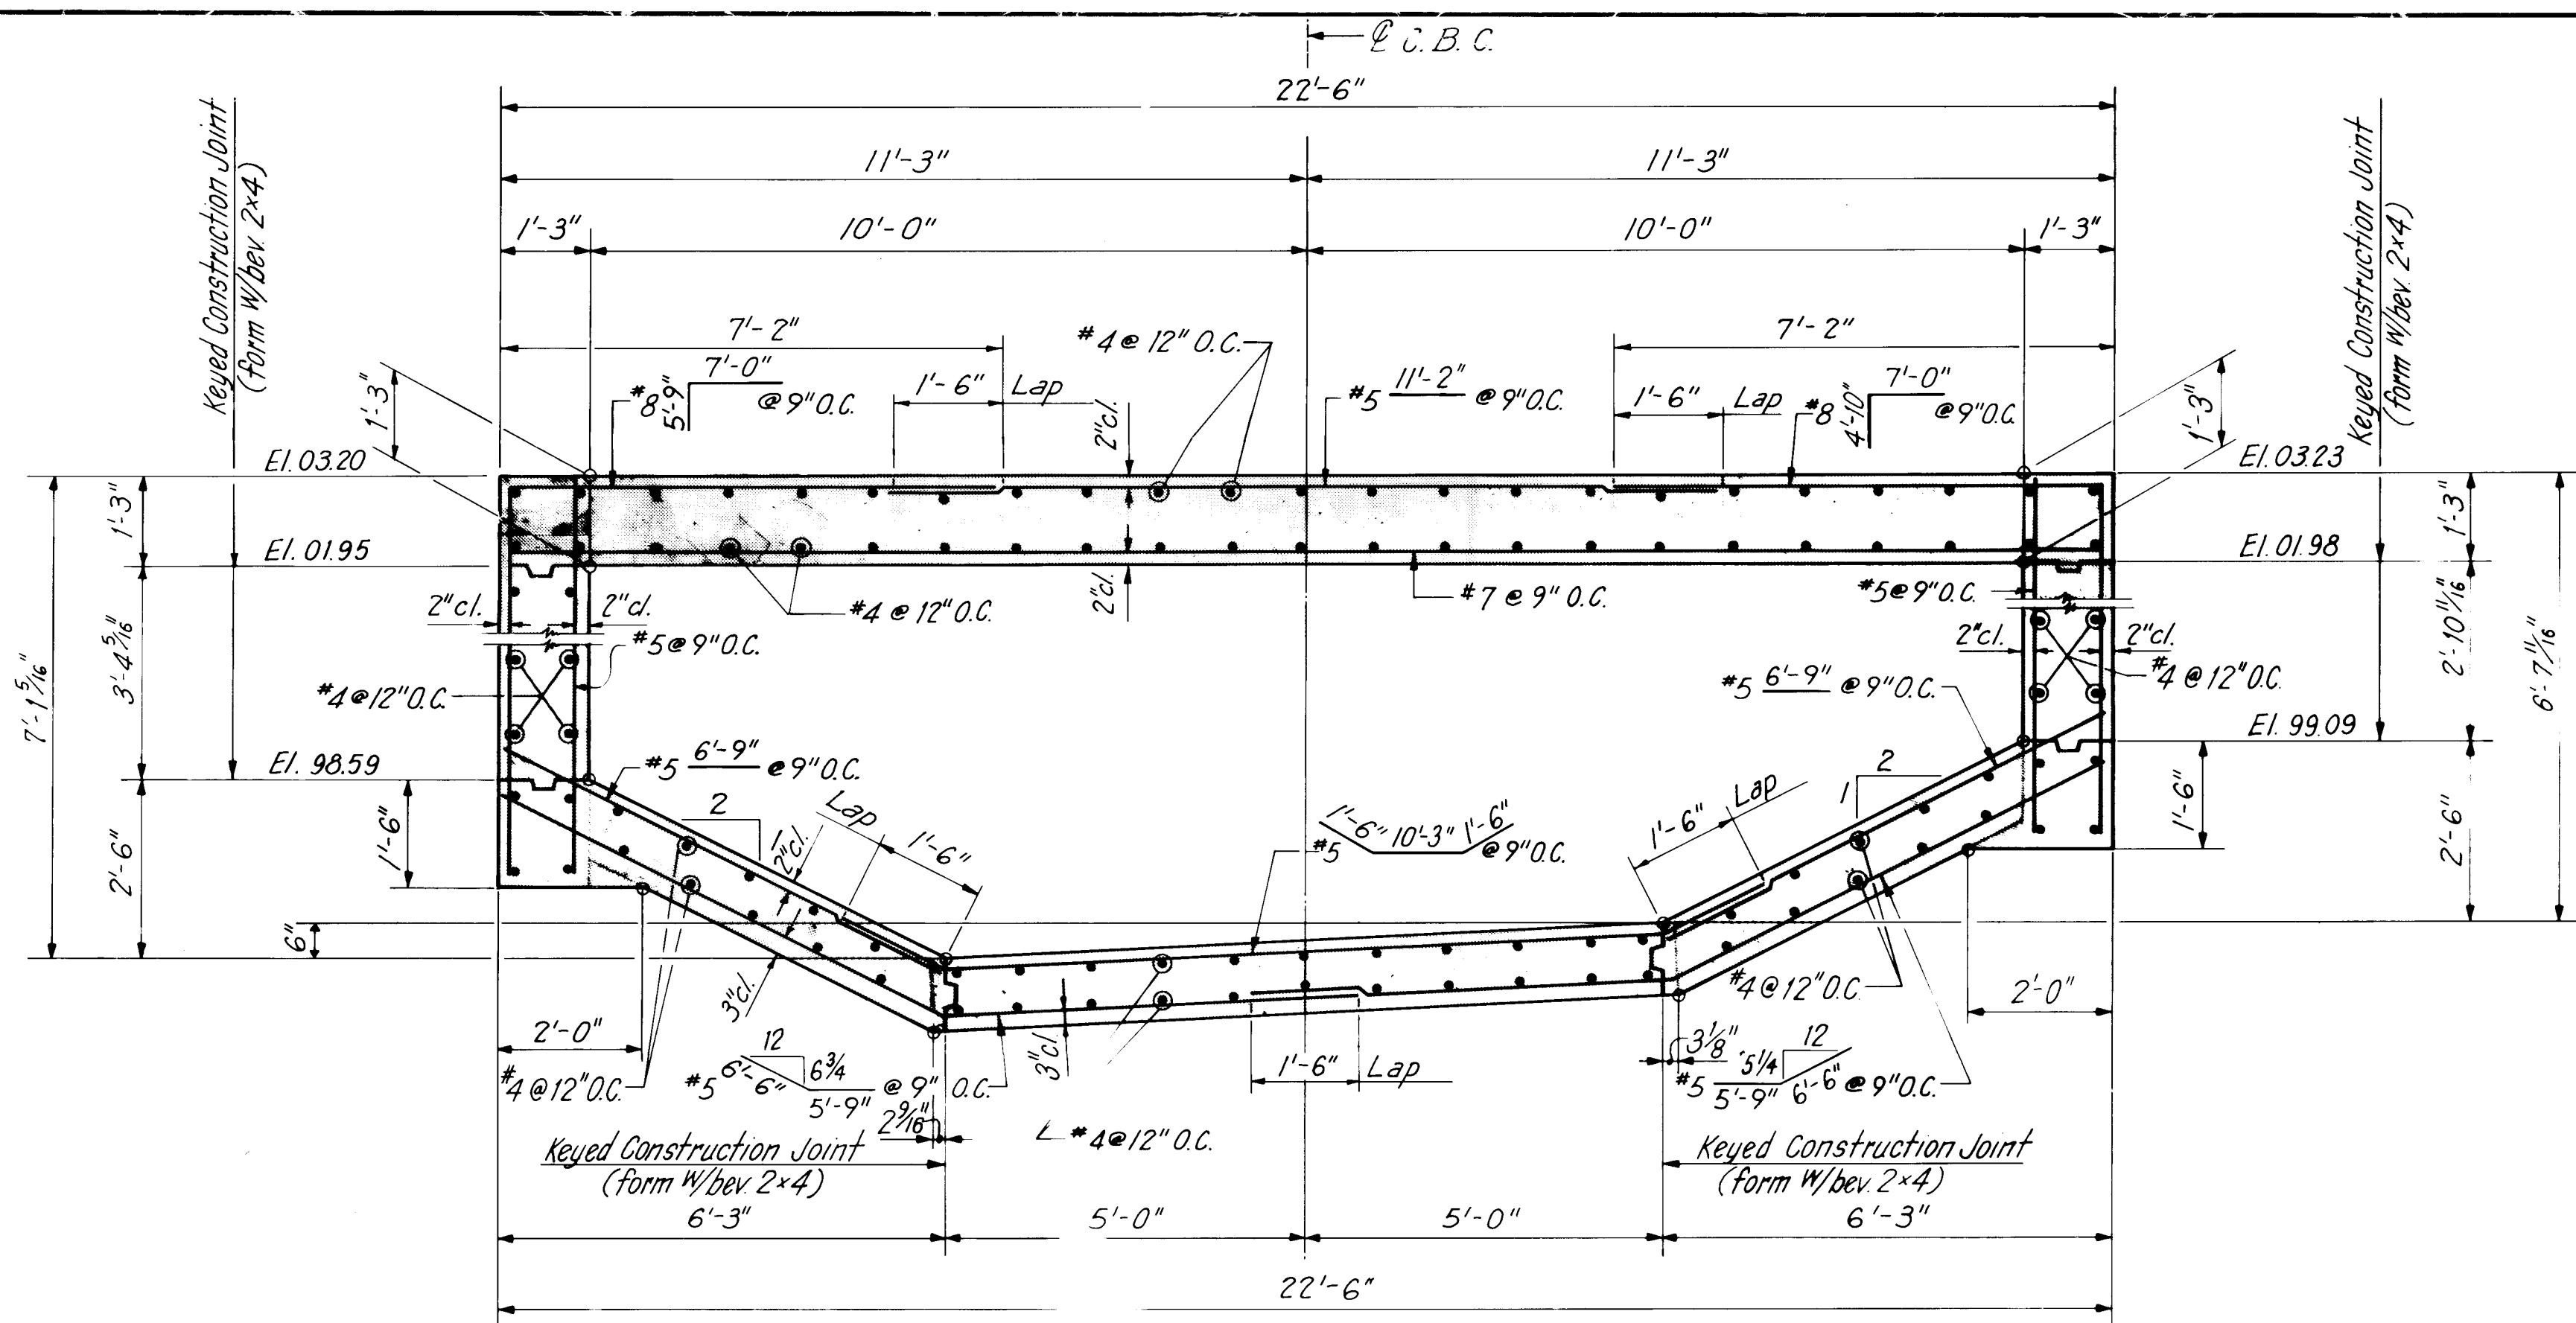

SECTION @ C
SCALE: 1/2"=1'-0"

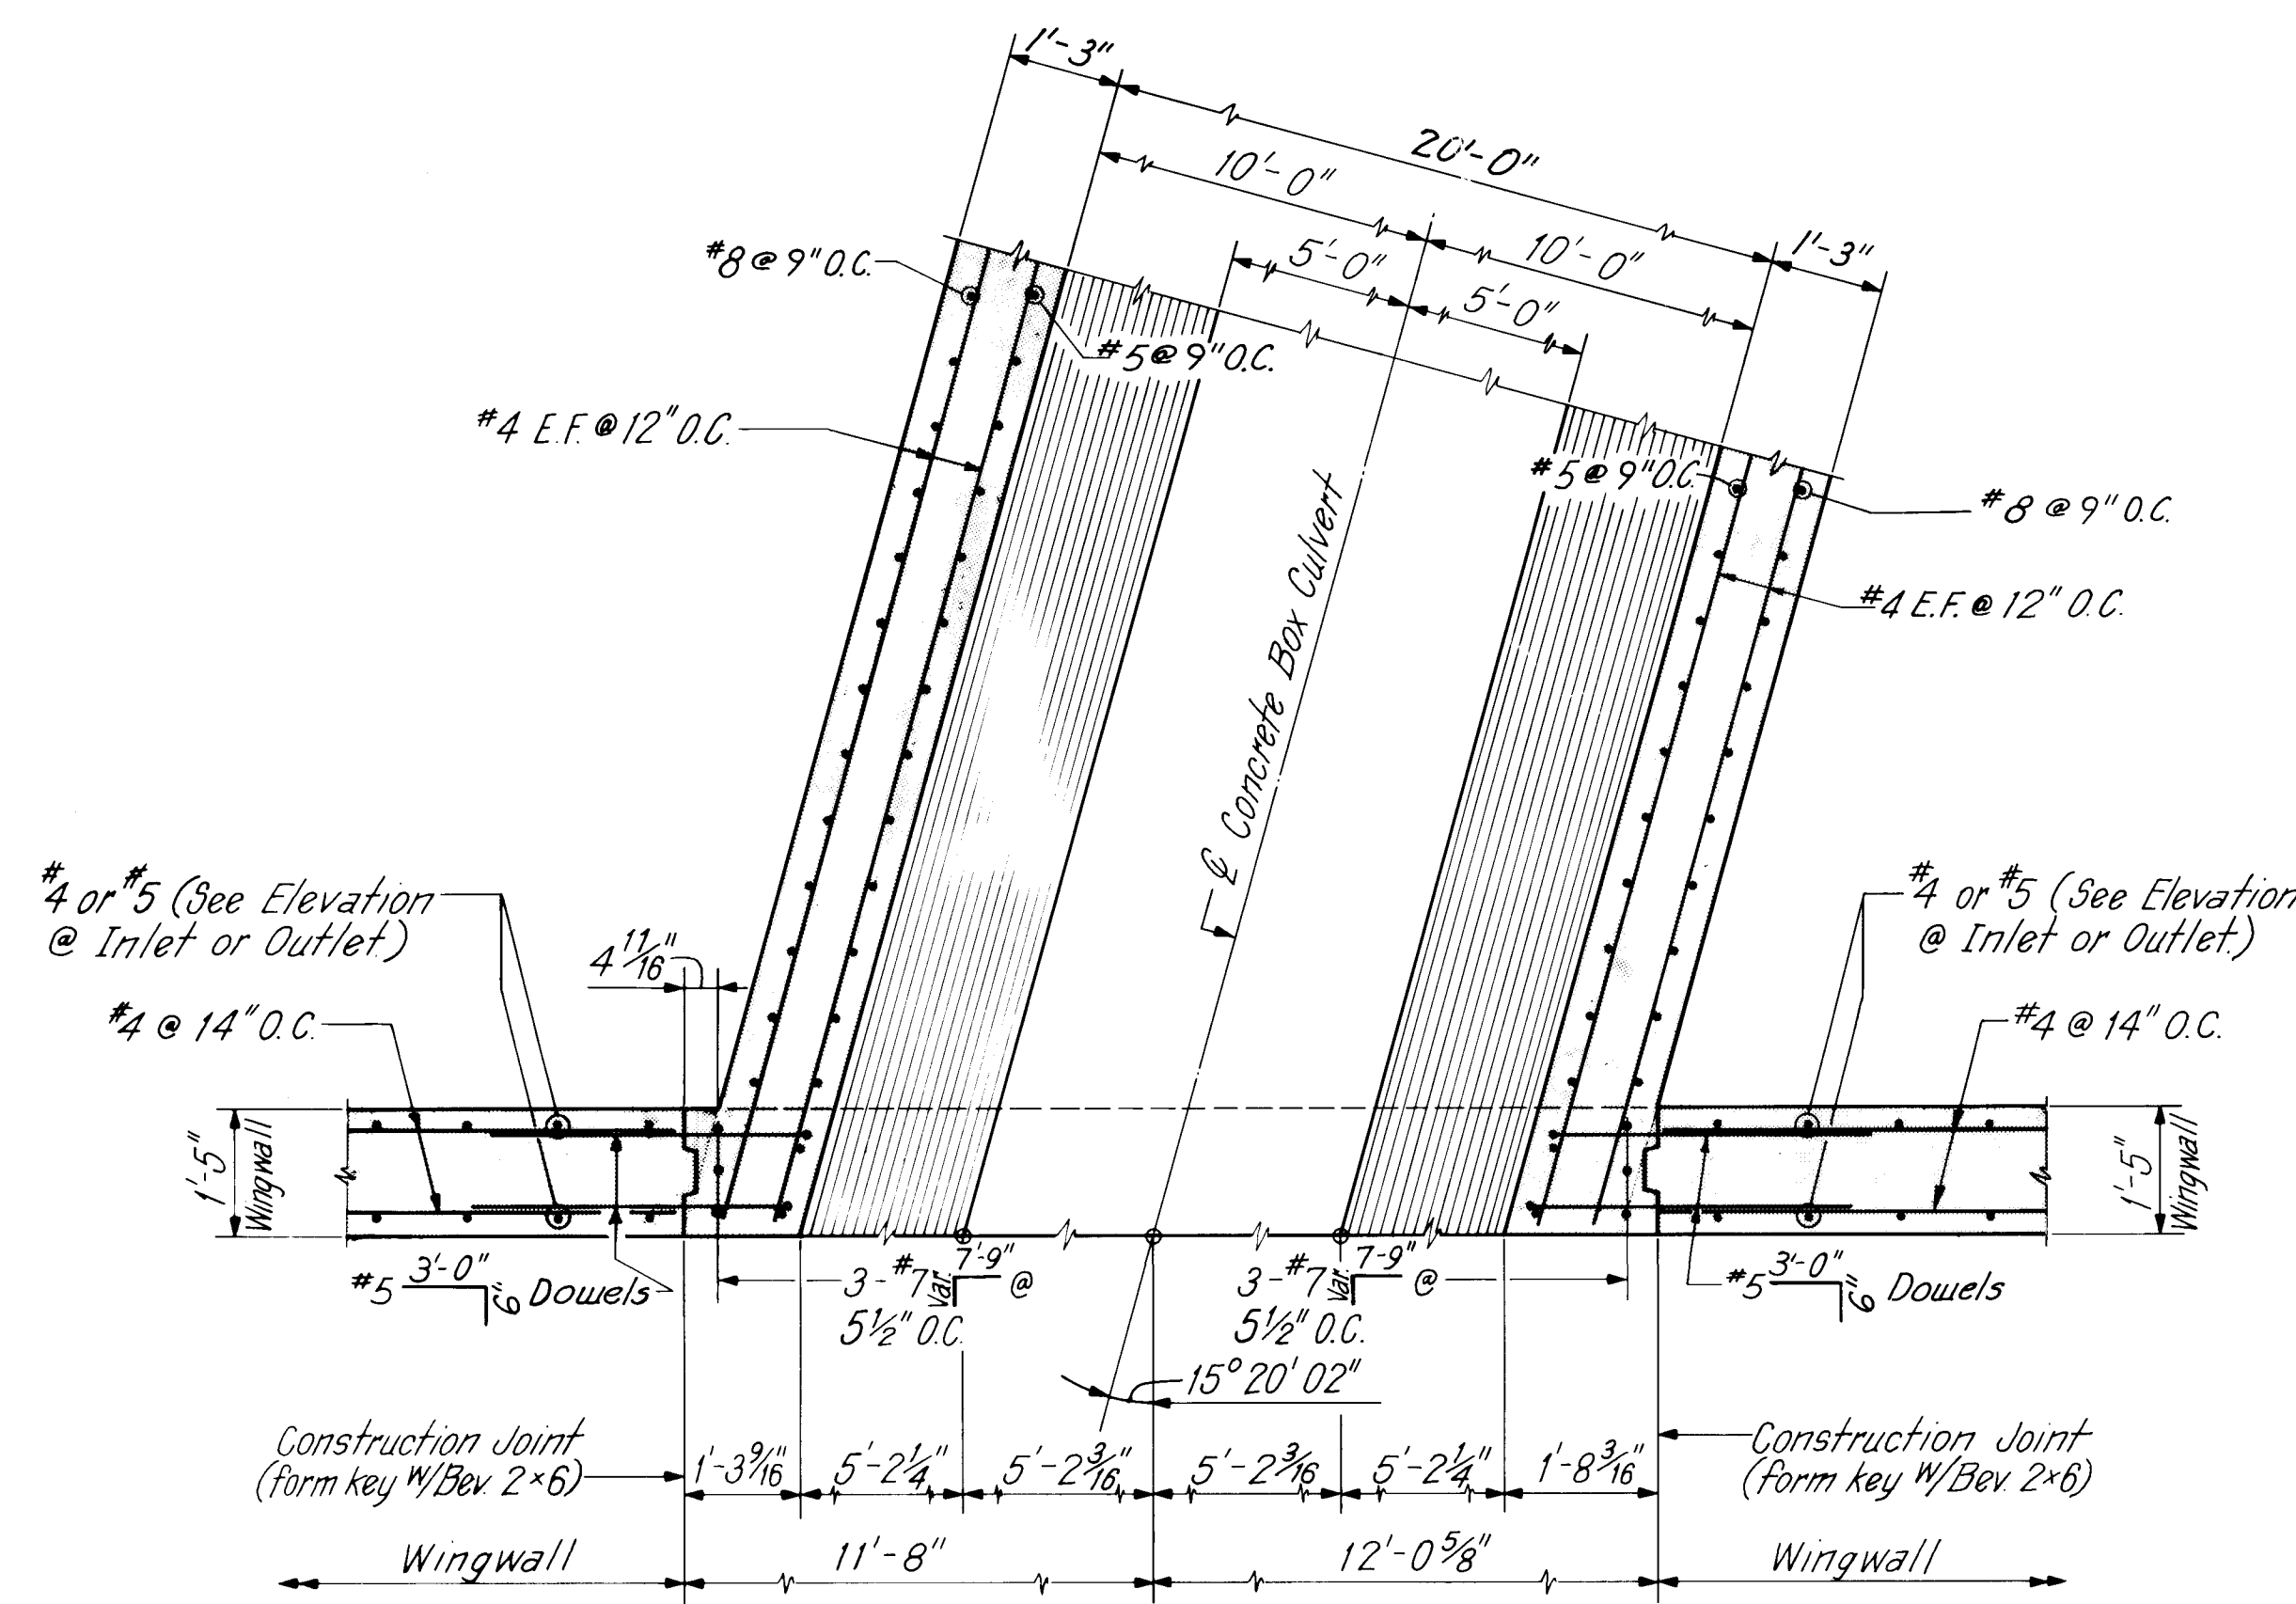


WINGWALL CONNECTION DETAILS AT INLET & OUTLET
SCALE: 1/2"=1'-0"

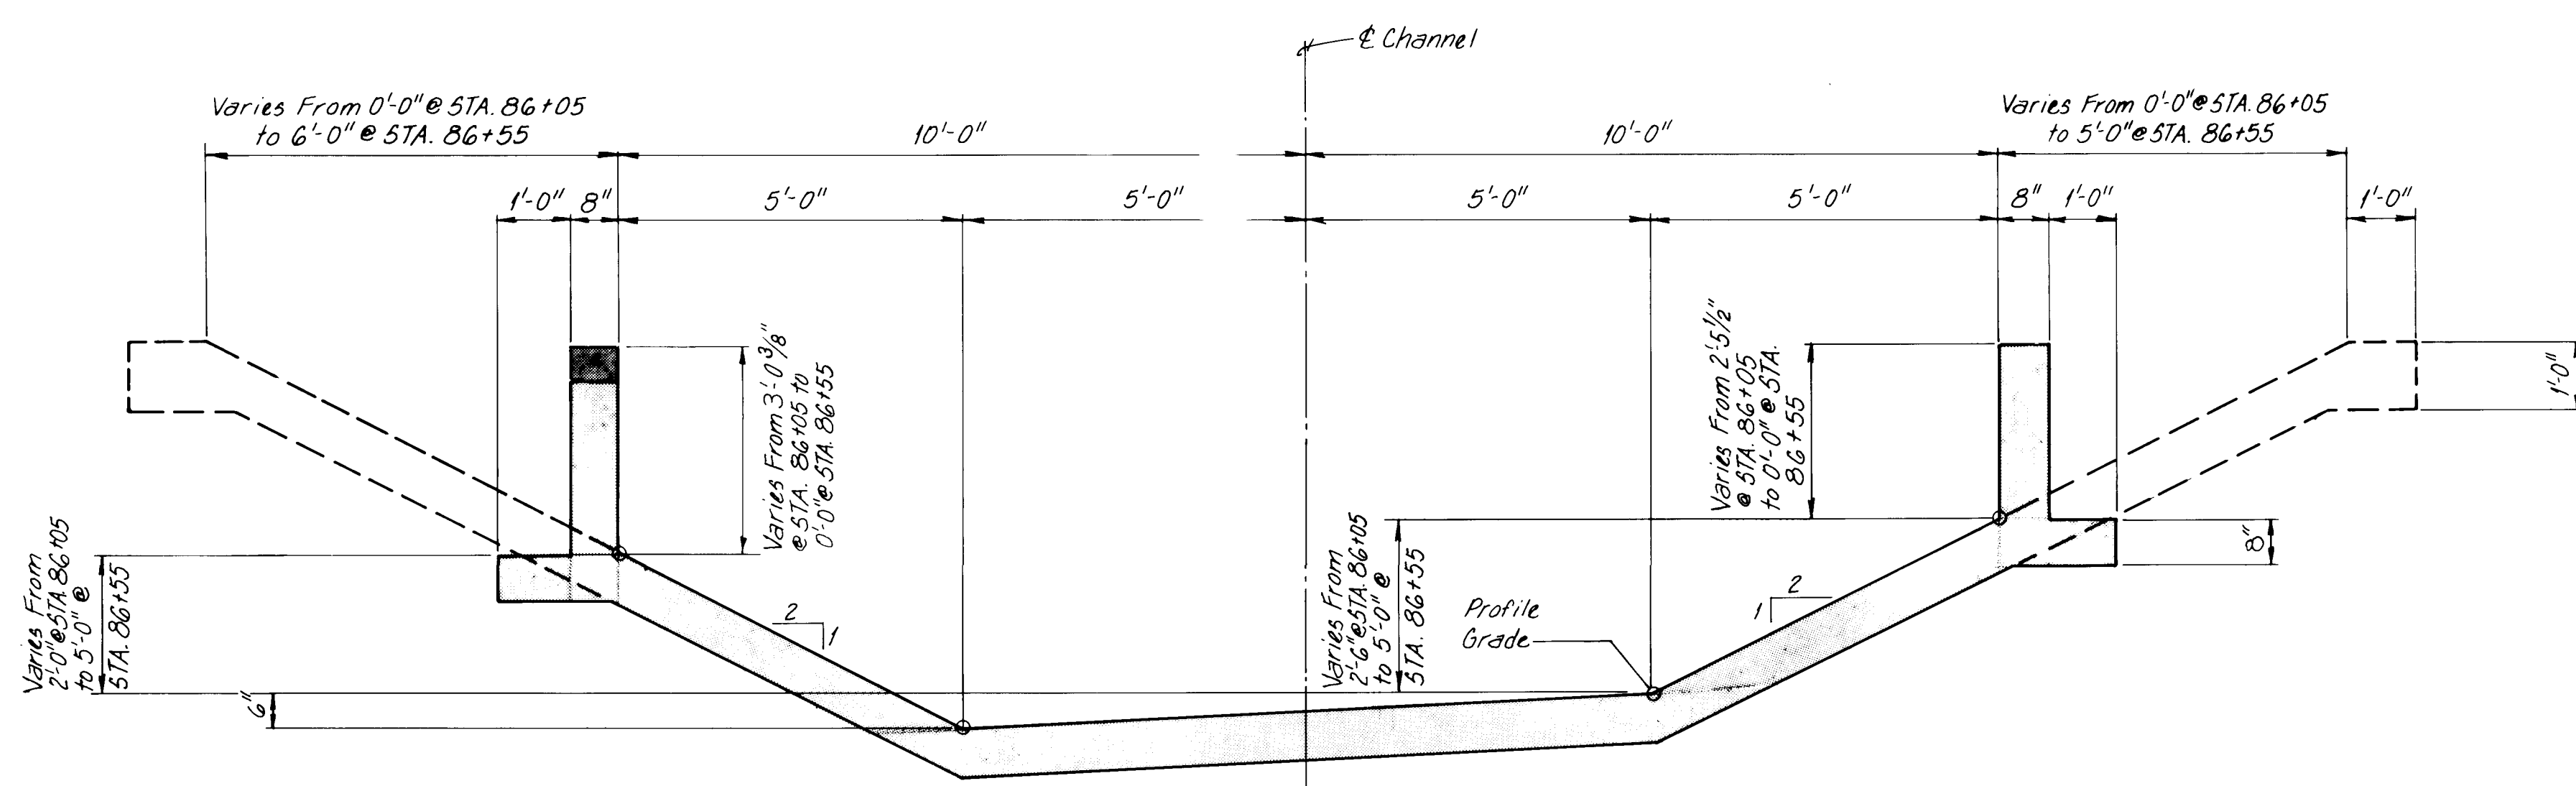

CHANNEL SECTION STA. 86+05 TO STA. 86+55
SCALE: 1/2"=1'-0"

- NOTES:
1. Transition 1'-8" Wide Wall Footing and Vertical Walls to 1'-0" Wide x 1'-0" Thickened Edge as Shown.
 2. Reinforcing in Channel Section Similar to Reinforcing Shown on Channel Section - STA. 58+07.01 to STA. 58+29.60 and Channel Transition STA. 58+29.60 to STA. 58+49.60 Sheet No. 45, Snow Vista Channel Phase III.

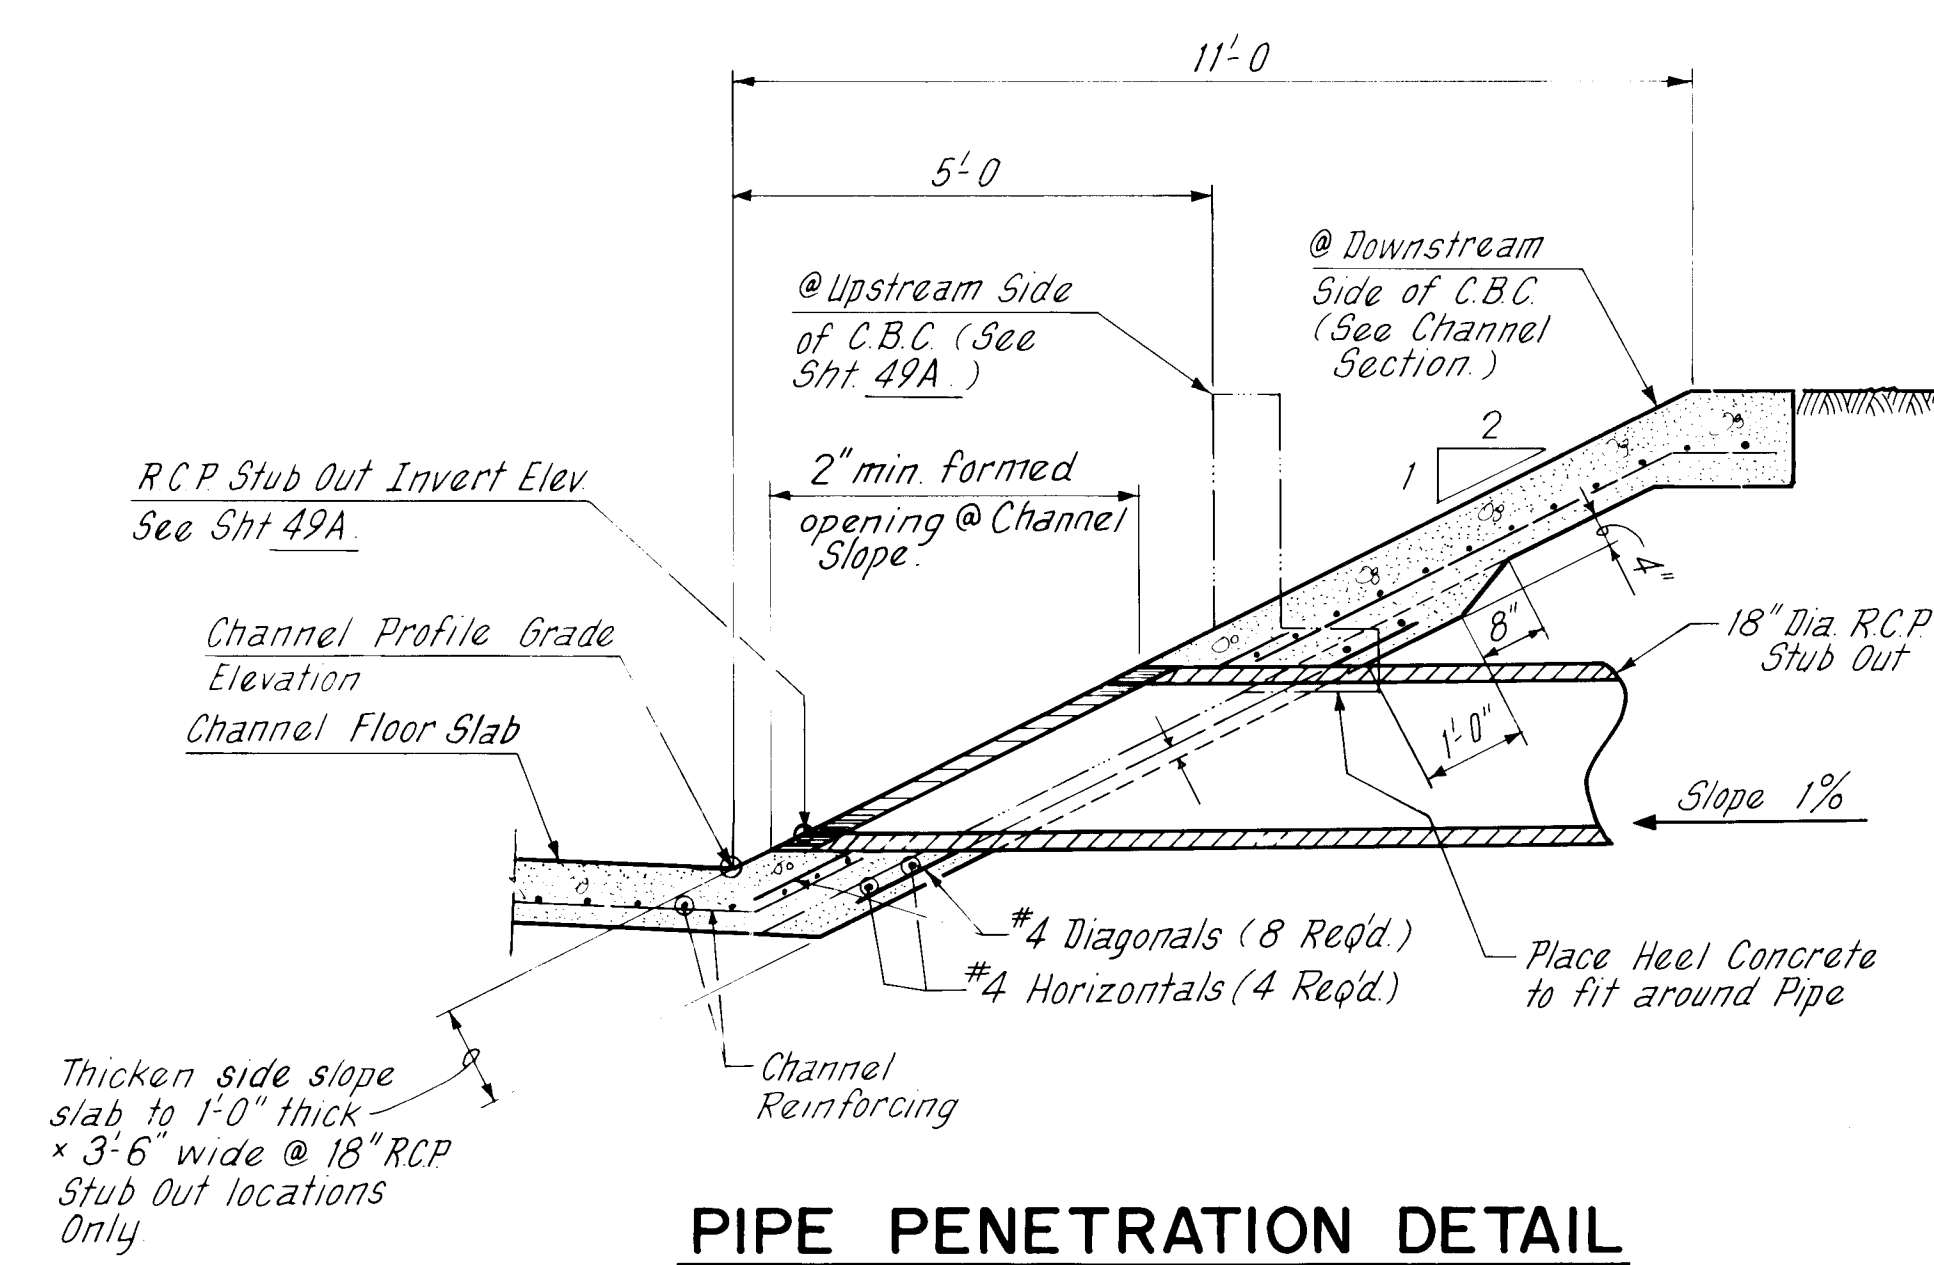

PIPE PENETRATION DETAIL
SCALE: 1/2"=1'-0"

NOTE: Field cut channel reinforcing to fit around beveled pipe.

RECORD DRAWING

Date: JUL 10 1987
These drawings have been revised based on field data and every reasonable attempt has been made to depict construction as actually performed.



AMAFCA	
WESTGATE DIVERSION CHANNELS	
SNOW VISTA CHANNEL PHASE III	
TOWER ROAD	
CONCRETE BOX CULVERT	
REINFORCEMENT DETAILS	
GORDON HERKENHOFF & ASSOCIATES, INC.	
ALBUQUERQUE ENGINEERS ARCHITECTS PLANNERS SANTA FE	

SHEET 49B OF 49

