


SMITH'S FOOD & DRUG STORE NO. 443
SITE WATERLINE IMPROVEMENTS
ALBUQUERQUE, NEW MEXICO

INDEX

SHEET NO.	DESCRIPTION
1.	COVER SHEET
2.	DOMESTIC WATERLINE PLAN & PROFILE
3.	FIRE LINE PLAN VIEW & DETAILS

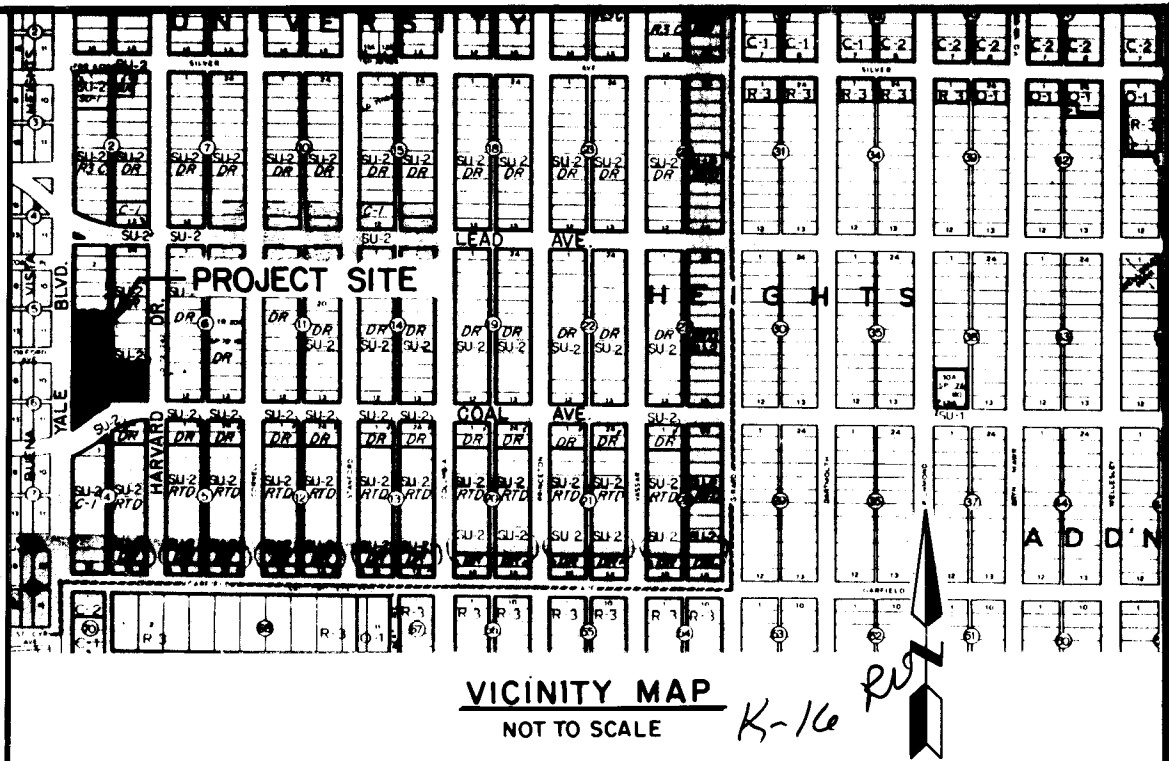


GENERAL NOTES

NOTICE TO CONTRACTORS

- NEW MEXICO STANDARD SPECIFICATIONS FOR PUBLIC WORKS CONSTRUCTION-1979 EDITION WILL BE REFERRED TO HEREON AS THE "STANDARD SPECIFICATION".
- ALL WORK DETAILED ON THESE PLANS TO BE PERFORMED UNDER CONTRACT SHALL, EXCEPT AS OTHERWISE STATED OR PROVIDED FOR HEREON, BE CONSTRUCTED IN ACCORDANCE WITH "CONTRACT DOCUMENTS FOR CITY-WIDE UTILITIES AND CASH PAVING NO. 31 AND THE STANDARD SPECIFICATION".
- TWO WORKING DAYS PRIOR TO ANY EXCAVATION, CONTRACTOR MUST CONTACT LINE LOCATING SERVICE, 765-1234, FOR LOCATION OF EXISTING UTILITIES.
- PRIOR TO CONSTRUCTION, THE CONTRACTOR SHALL EXCAVATE AND VERIFY THE HORIZONTAL AND VERTICAL LOCATIONS OF ALL OBSTRUCTIONS. SHOULD A CONFLICT EXIST, THE CONTRACTOR SHALL NOTIFY THE ENGINEER OR SURVEYOR SO THAT THE CONFLICT CAN BE RESOLVED WITH A MINIMUM AMOUNT OF DELAY.

THE FOLLOWING NOTES ALSO APPLY WHEN CHECKED



- ☐ ALL UTILITIES AND UTILITY SERVICE LINES SHALL BE INSTALLED PRIOR TO PAVING.
- ☒ BACKFILL COMPACTION SHALL BE ACCORDING TO SPECIFIED STREET USE.
- ☐ TACK COAT REQUIREMENTS SHALL BE DETERMINED BY THE CITY ENGINEER.
- ☐ SIDEWALKS AND WHEELCHAIR RAMPS WITHIN THE CURB RETURNS SHALL BE CONSTRUCTED WHEREVER A NEW CURB RETURN IS CONSTRUCTED.
- ☐ IF CURB IS DEPRESSED FOR A DRIVEPAD, THE DRIVEPAD SHALL BE CONSTRUCTED PRIOR TO ACCEPTANCE OF CURB AND GUTTER.
- ☐ ALL STORM DRAINAGE FACILITIES SHALL BE COMPLETED PRIOR TO FINAL ACCEPTANCE.
- ☒ THE CONTRACTOR SHALL SUBMIT A DETAILED BARRICADING AND/OR TRAFFIC DETOUR PLAN FOR SAFE CONTROL OF TRAFFIC DURING THE CONSTRUCTION OF YALE BOULEVARD WATERLINE IMPROVEMENTS. THE PLAN SHALL BE SUBMITTED TO THE CITY TRAFFIC ENGINEER FOR APPROVAL 7 DAYS PRIOR TO THE START OF CONSTRUCTION.

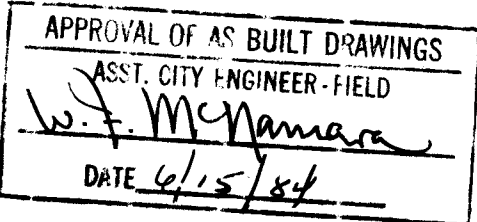


26 1748 0184


REV	SHEETS	CITY ENGINEER	DATE	USER	DEPT.	DATE	USER	DEPT.	DATE
APPROVAL OF REVISIONS									

		APPROVED FOR CONSTRUCTION
	PROJECT NUMBER 1748	CITY ENGINEER DATE
		SHEET 1 OF 3

 
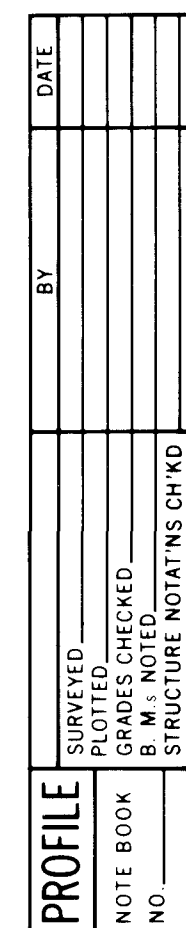


1-GxGxG C.I. Tee @ Sta. 4+44
1-G" G.V. & Box "A" @ Sta. 4+47
1-Gx4 C.I. Reducer @ Sta. 4+62
1-4" Trans. Coupl. @ Sta. 4+64
1-Non Press. Conn.
3'x3' F.H. Pad
Tied in straight.

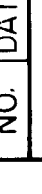ALBUQUERQUE CITY DEPARTMENT DIVISION																			
1000 STORE NO. 443 ALBUQUERQUE NM																			
PLAN & PROFILE																			
APPROVALS					ENGINEER					DATE									
Chief Engineer City Engineer Public Works Director					James Jaramila N. A. [Signature]					11/10/83 11/10/83									
SHEET 2										OF 3									

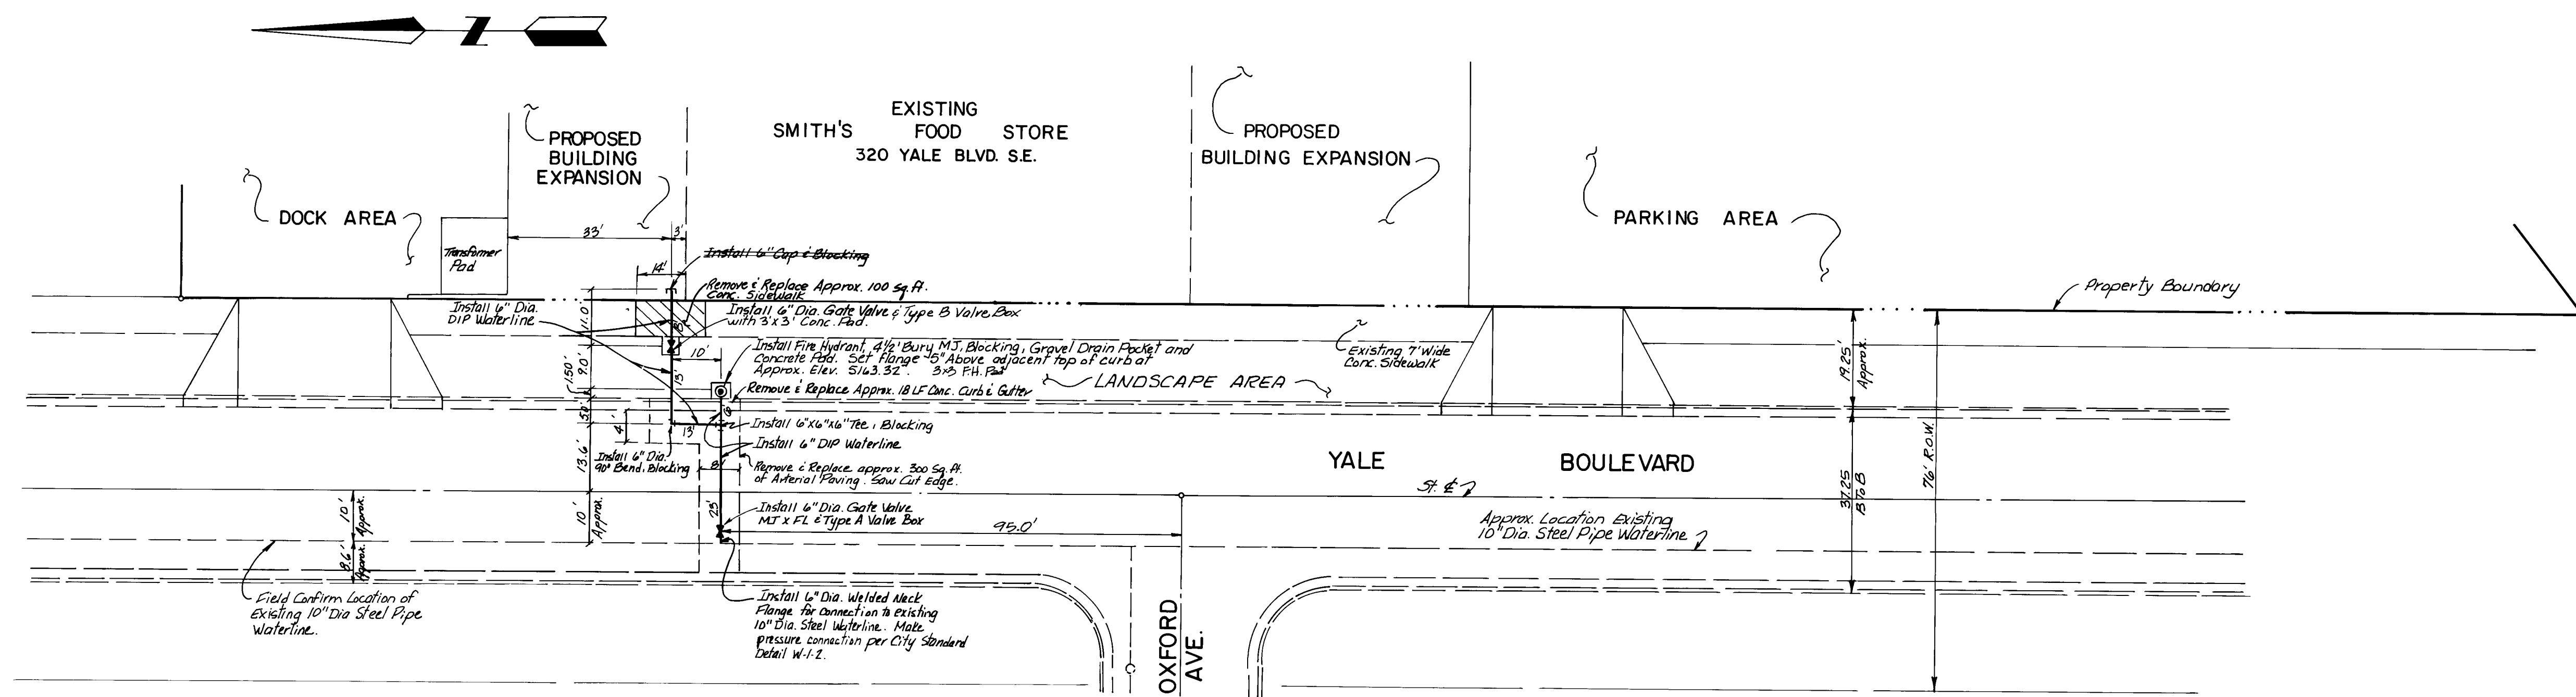

YALE FIRE LINE PLAN VIEW
SCALE: 1" = 20'

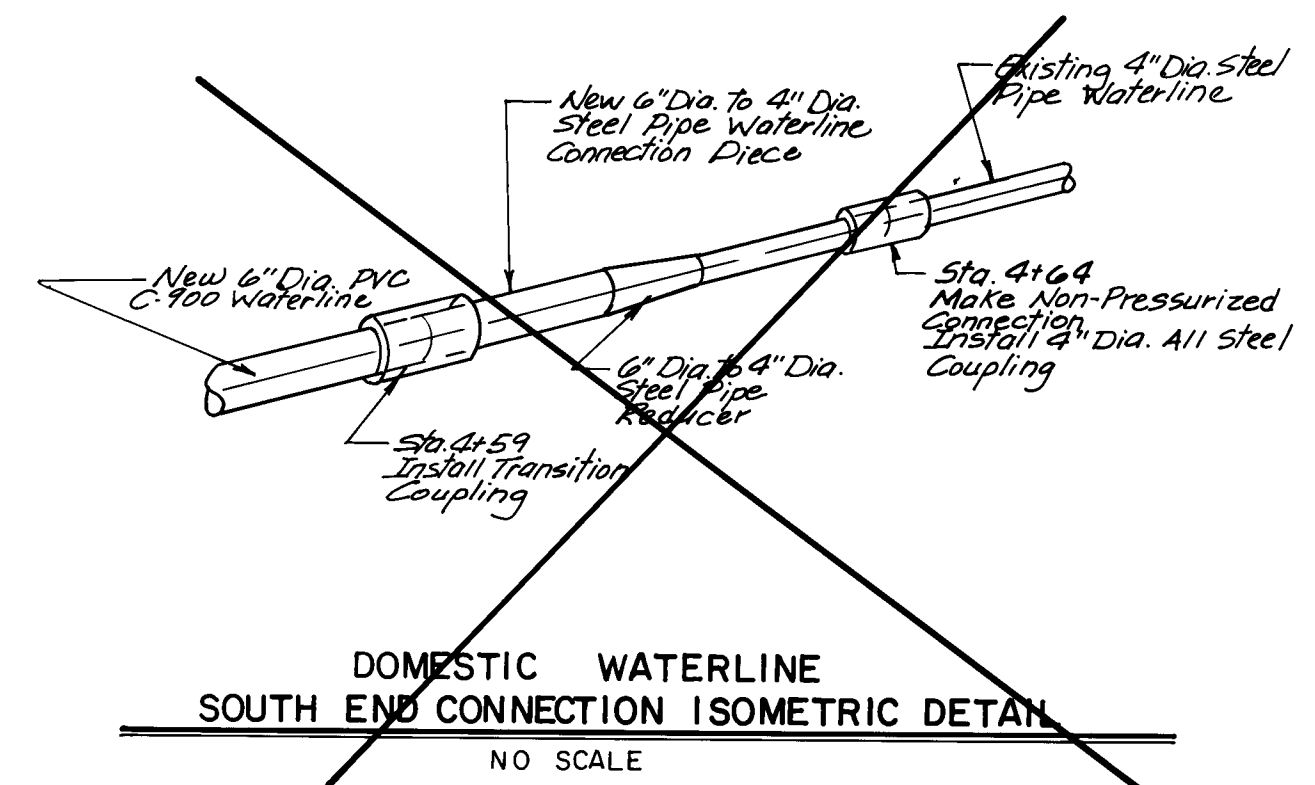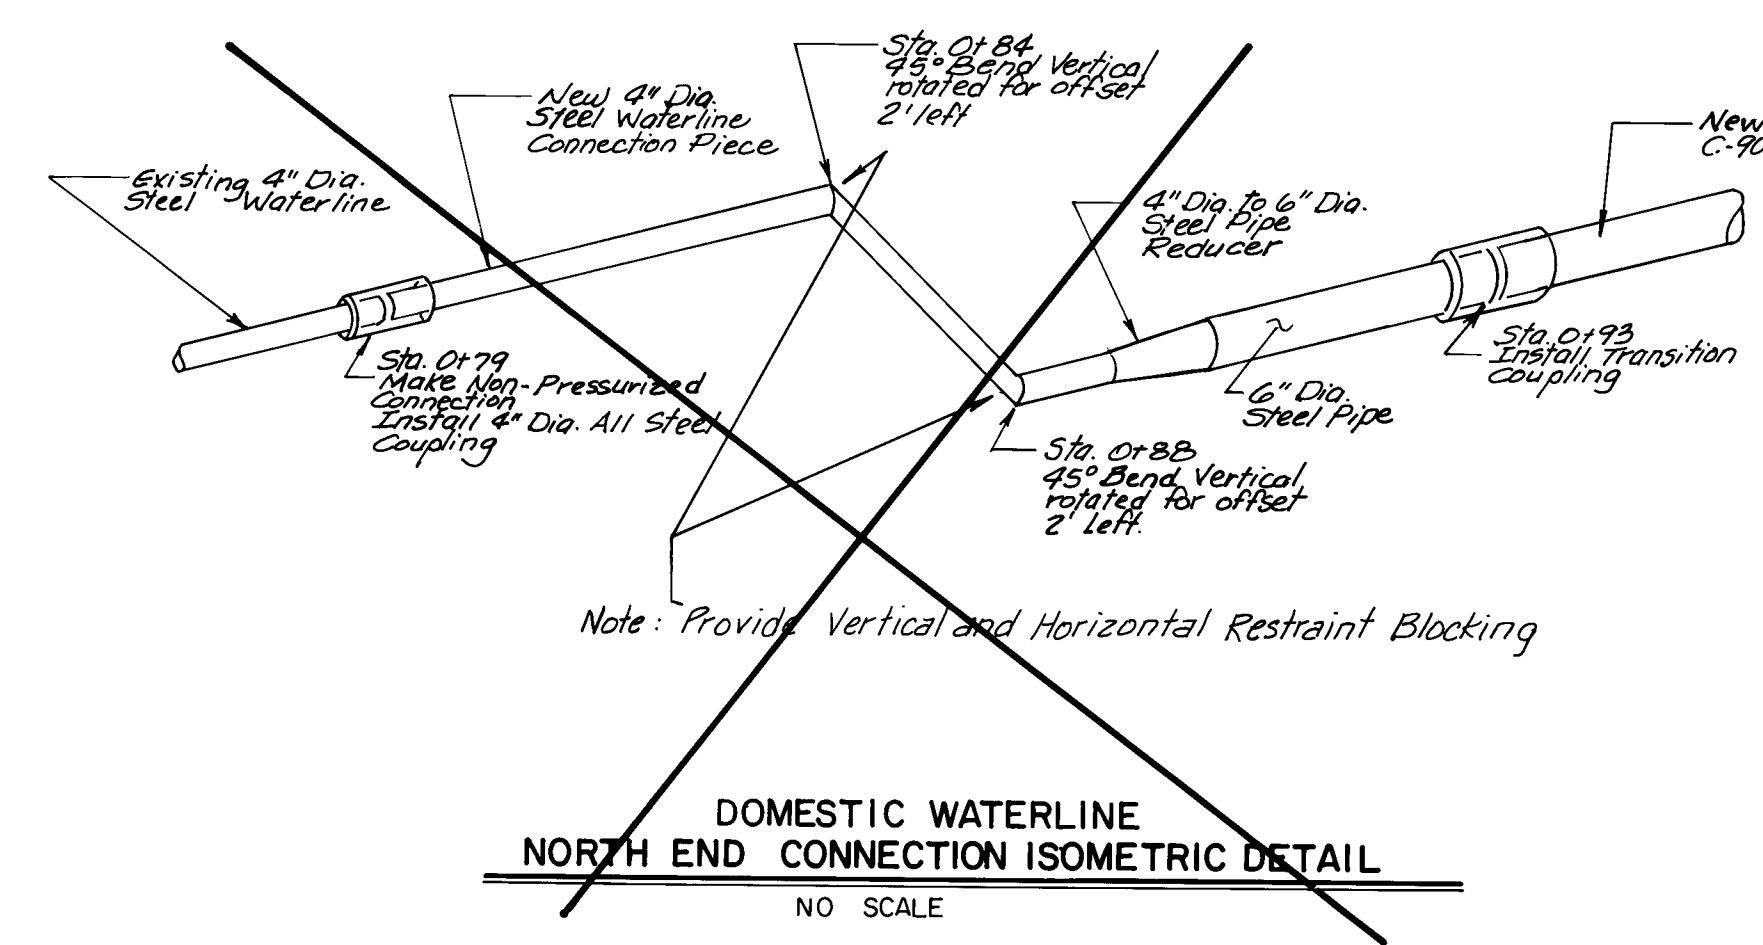

24 1748 0384

PREPARED UNDER THE DIRECTION OF <i>Michael M. Long</i> 6-23-83		CITY OF ALBUQUERQUE MUNICIPAL DEVELOPMENT DEPARTMENT ENGINEERING DIVISION	
TITLE: SMITH'S FOOD & DRUG STORE NO. 443 320 YALE S.E., ALBUQUERQUE NM FIRE LINE PLAN VIEW & DETAILS			
APPROVALS	ENGINEER	DATE	APPROVALS
City Engineer	<i>James J. Smith</i>	7/1/83	Liquid Waste
A.C.E. Design	<i>N.A. Smith</i>	6/28/83	Traffic
A.C.E. Hydrology	<i>N.A. Smith</i>	6/28/83	Water
APPROVED FOR CONSTRUCTION <i>C. H. Thompson</i> 9/1/83		DRAWING NO. 1748	
CITY ENGINEER		DATE	

AS-BUILT INFORMATION			
CONTRACTOR	ACADEMY	DATE	
STAKED BY		DATE	
ACCEPTANCE BY		DATE	
FIELD INSPECTION BY	M.E. CALVEZ	DATE	6-24
CORRECTION BY	C. CALVEZ	DATE	6-24
MICRO-FILM INFORMATION			
RECORDED BY		NO.	
DATE			