


STORM DRAINAGE IMPROVEMENTS
FOUR HILLS VILLAGE - FOURTH INSTALLMENT
BLOCK I LOTS 21/22

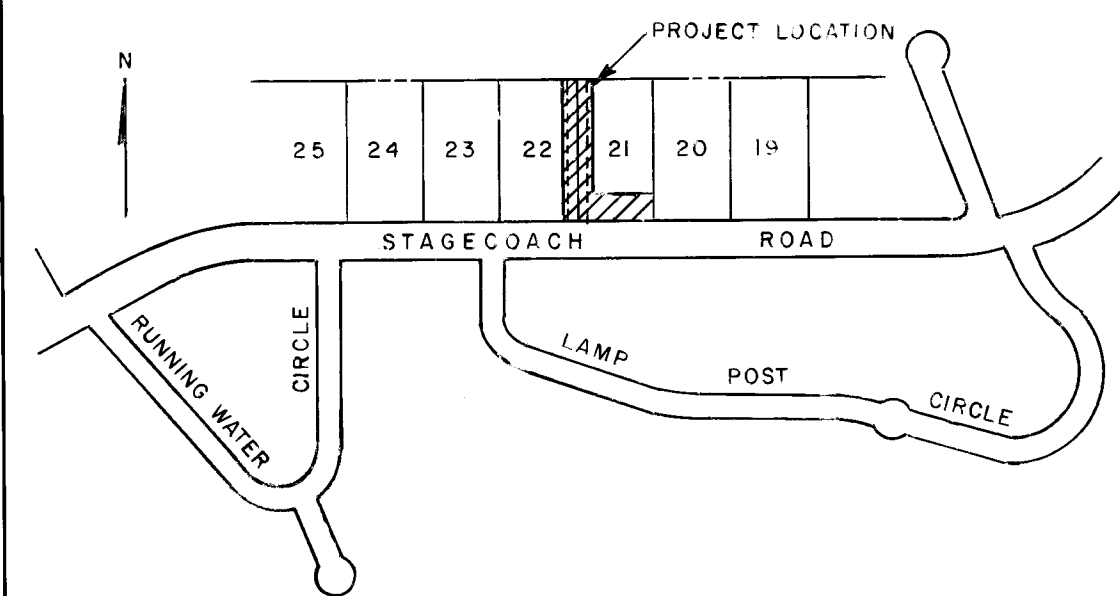

LOCATION MAP ZONE NO. M-22 *del*

NOTICE TO CONTRACTORS

1. All work detailed on these plans to be performed under contract shall, except as otherwise stated or provided for hereon, be constructed in accordance with the New Mexico Standard Specifications for Public Works Construction - (1979 Edition (referred to herein as the Standard Specifications)) and the Contract Documents for City Wide Utilities and Cash Paving No. 31.
2. Two (2) working days prior to any excavation, the contractor must contact Line Locating Service, 765-1234 for location of existing utilities.
3. Prior to construction, the contractor shall excavate and verify the horizontal and vertical locations of all obstructions. Should a conflict exist, the contractor shall notify the engineer or surveyor so that the conflict can be resolved with minimum amount of delay.

THE FOLLOWING NOTES ALSO APPLY
WHEN CHECKED


- ☐ All utilities and utility service lines shall be installed prior to paving.
- ☒ Backfill compaction shall be according to specified street use.
- ☒ Tack coat requirements shall be determined by the City Engineer.
- ☐ Sidewalks and wheelchair ramps within the curb returns shall be constructed wherever a new curb return is constructed.
- ☒ If curb is depressed for a driveway or a handicap ramp, the driveway or ramp shall be constructed prior to acceptance of the curb and gutter.
- ☒ All storm drainage facilities shall be completed prior to final acceptance.

INDEX

SHEET	TITLE
1	TITLE SHEET
2	SITE PLAN
3	DETAIL PLAN & PROFILE
4	MISCELLANEOUS DETAILS

26 1749 0184

REV.	SHEETS	CITY ENGR	DATE	USER	DEPT.	DATE	USER	DEPT.	DATE
APPROVAL OF REVISIONS									

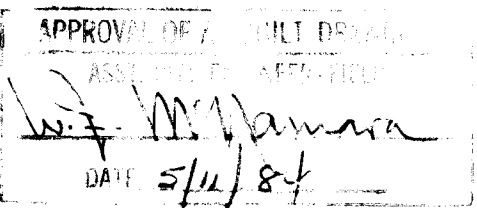

CITY OF ALBUQUERQUE	APPROVED FOR CONSTRUCTION <i>ed. Huppert 10/19/83</i> CITY ENGR. HCO 6-8-83
	SHEET OF 1 4

1749



SCALE: 1" = 20'

[illegible]



APPROVED FOR
CONSTRUCTION
E. W. Sheppard 10/19/81
CITY ENGINEER DATE

CITY OF ALBUQUERQUE
MUNICIPAL DEVELOPMENT DEPARTMENT
ENGINEERING DIVISION

TITLE:
STORM DRAINAGE IMPROVEMENTS - FOUR HILLS VILLAGE
FOURTH INSTALLMENT BLOCK I LOTS 21/22
SITE PLAN

DRAWING NO.	1749	MAP NO.	M-22	SHEET	2	OF	4
----------------	------	---------	------	-------	---	----	---

DRAWING NO.	1749	MAP NO.	M-22	SHEET	2	OF	4
----------------	------	---------	------	-------	---	----	---

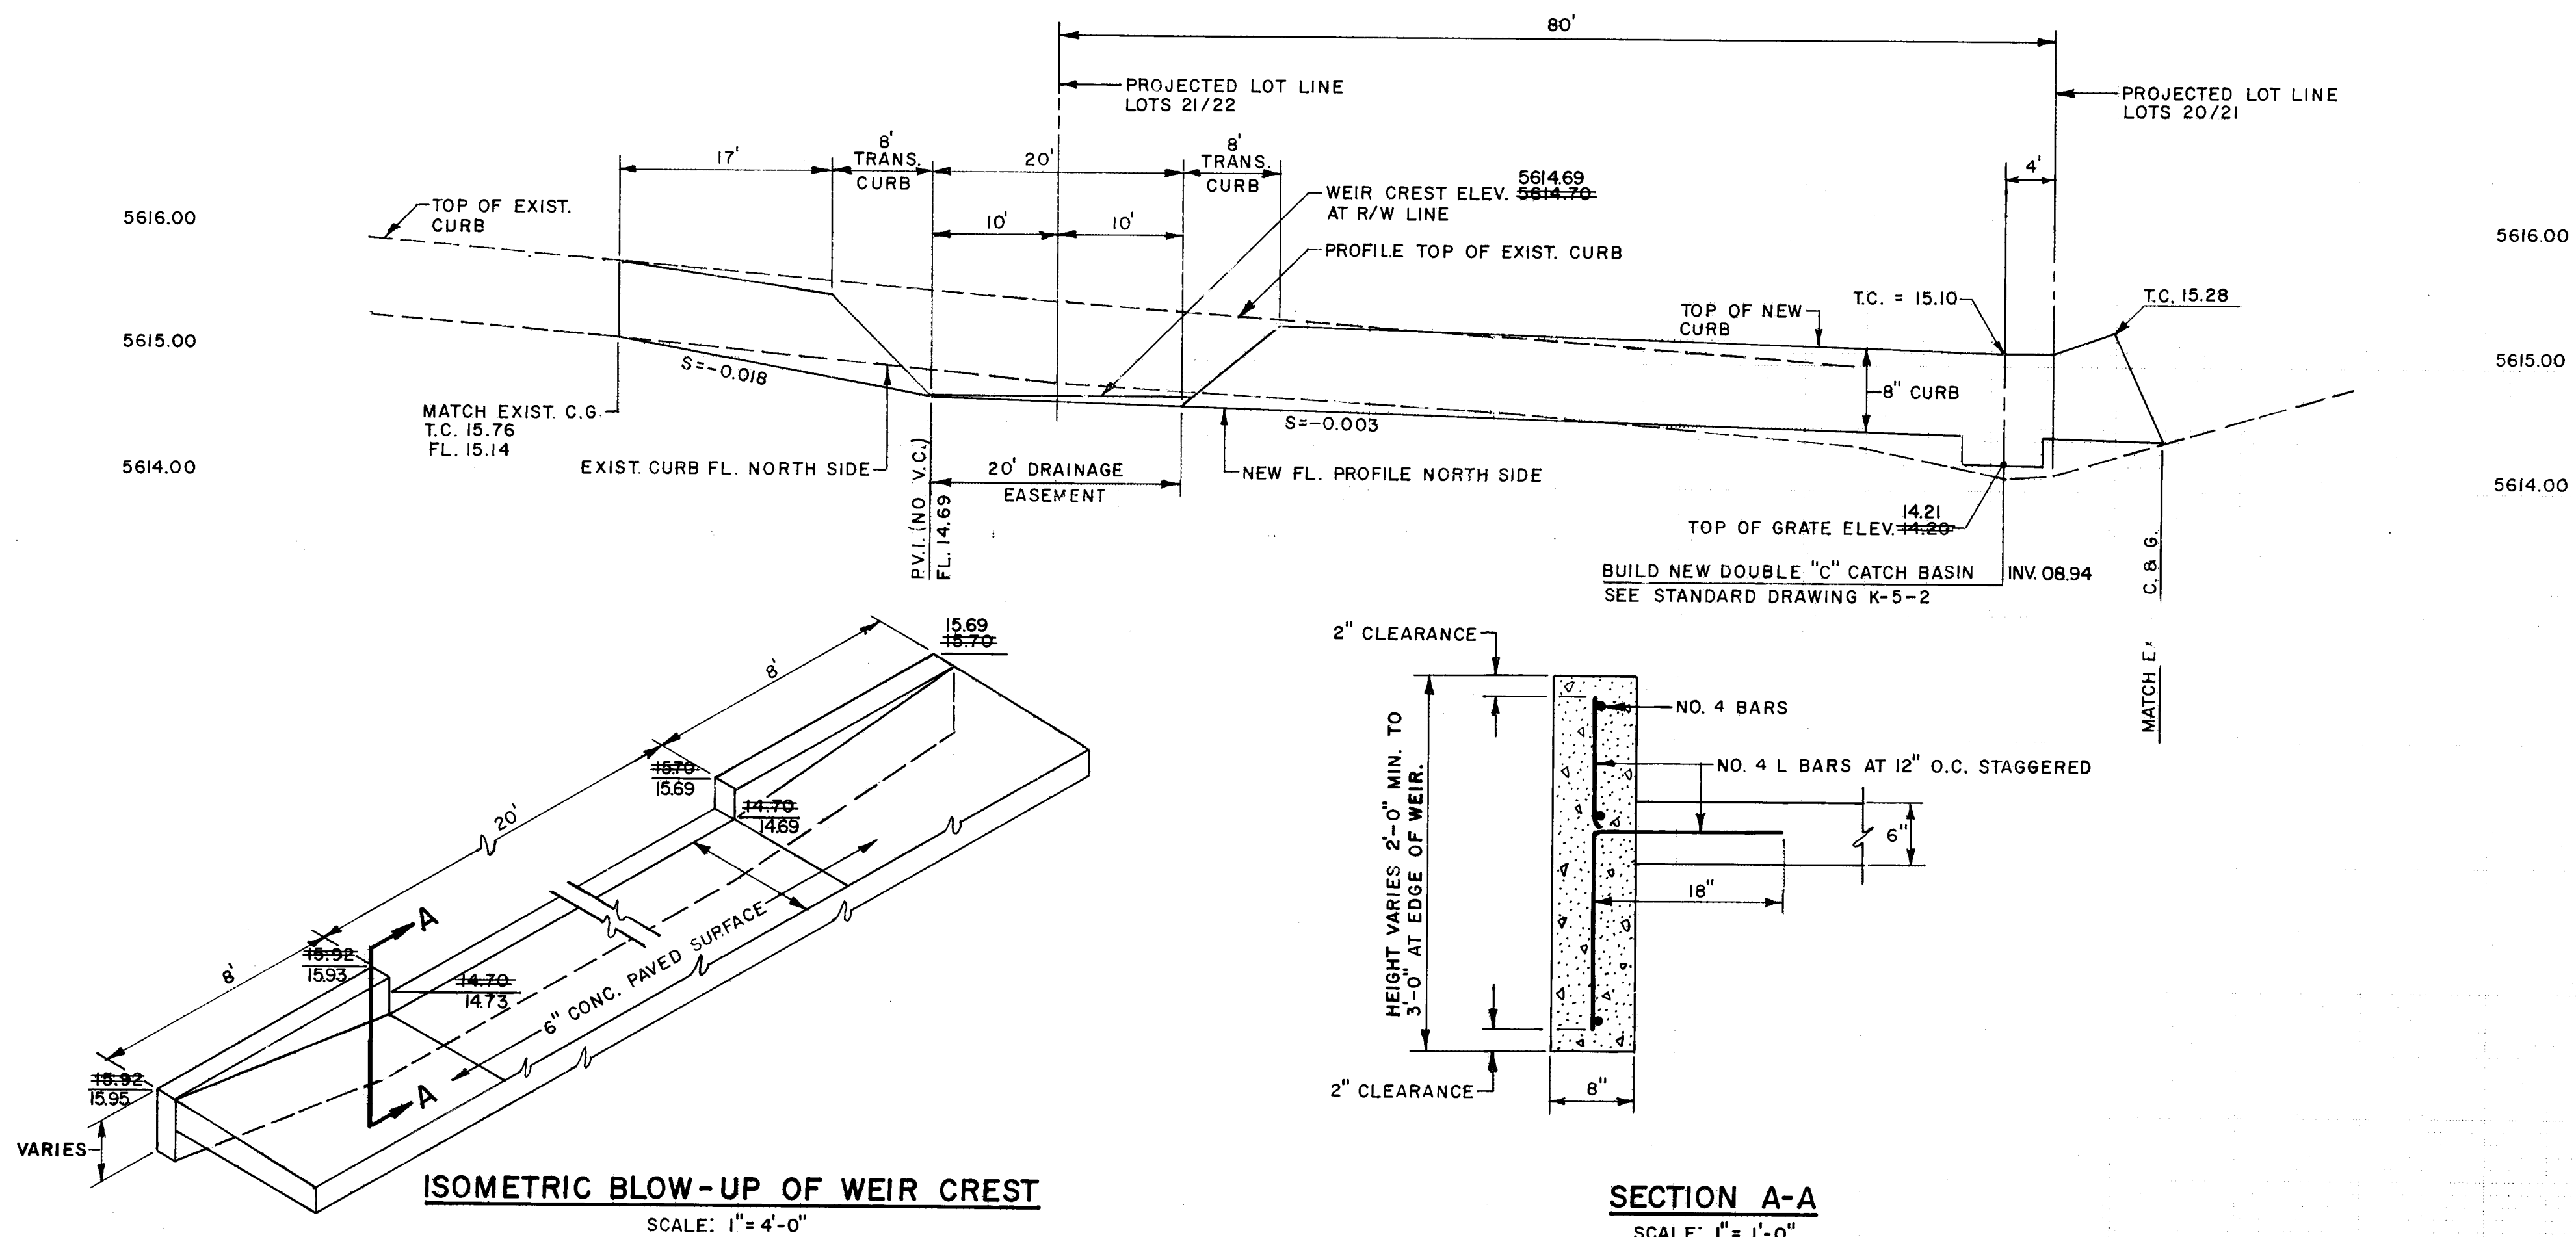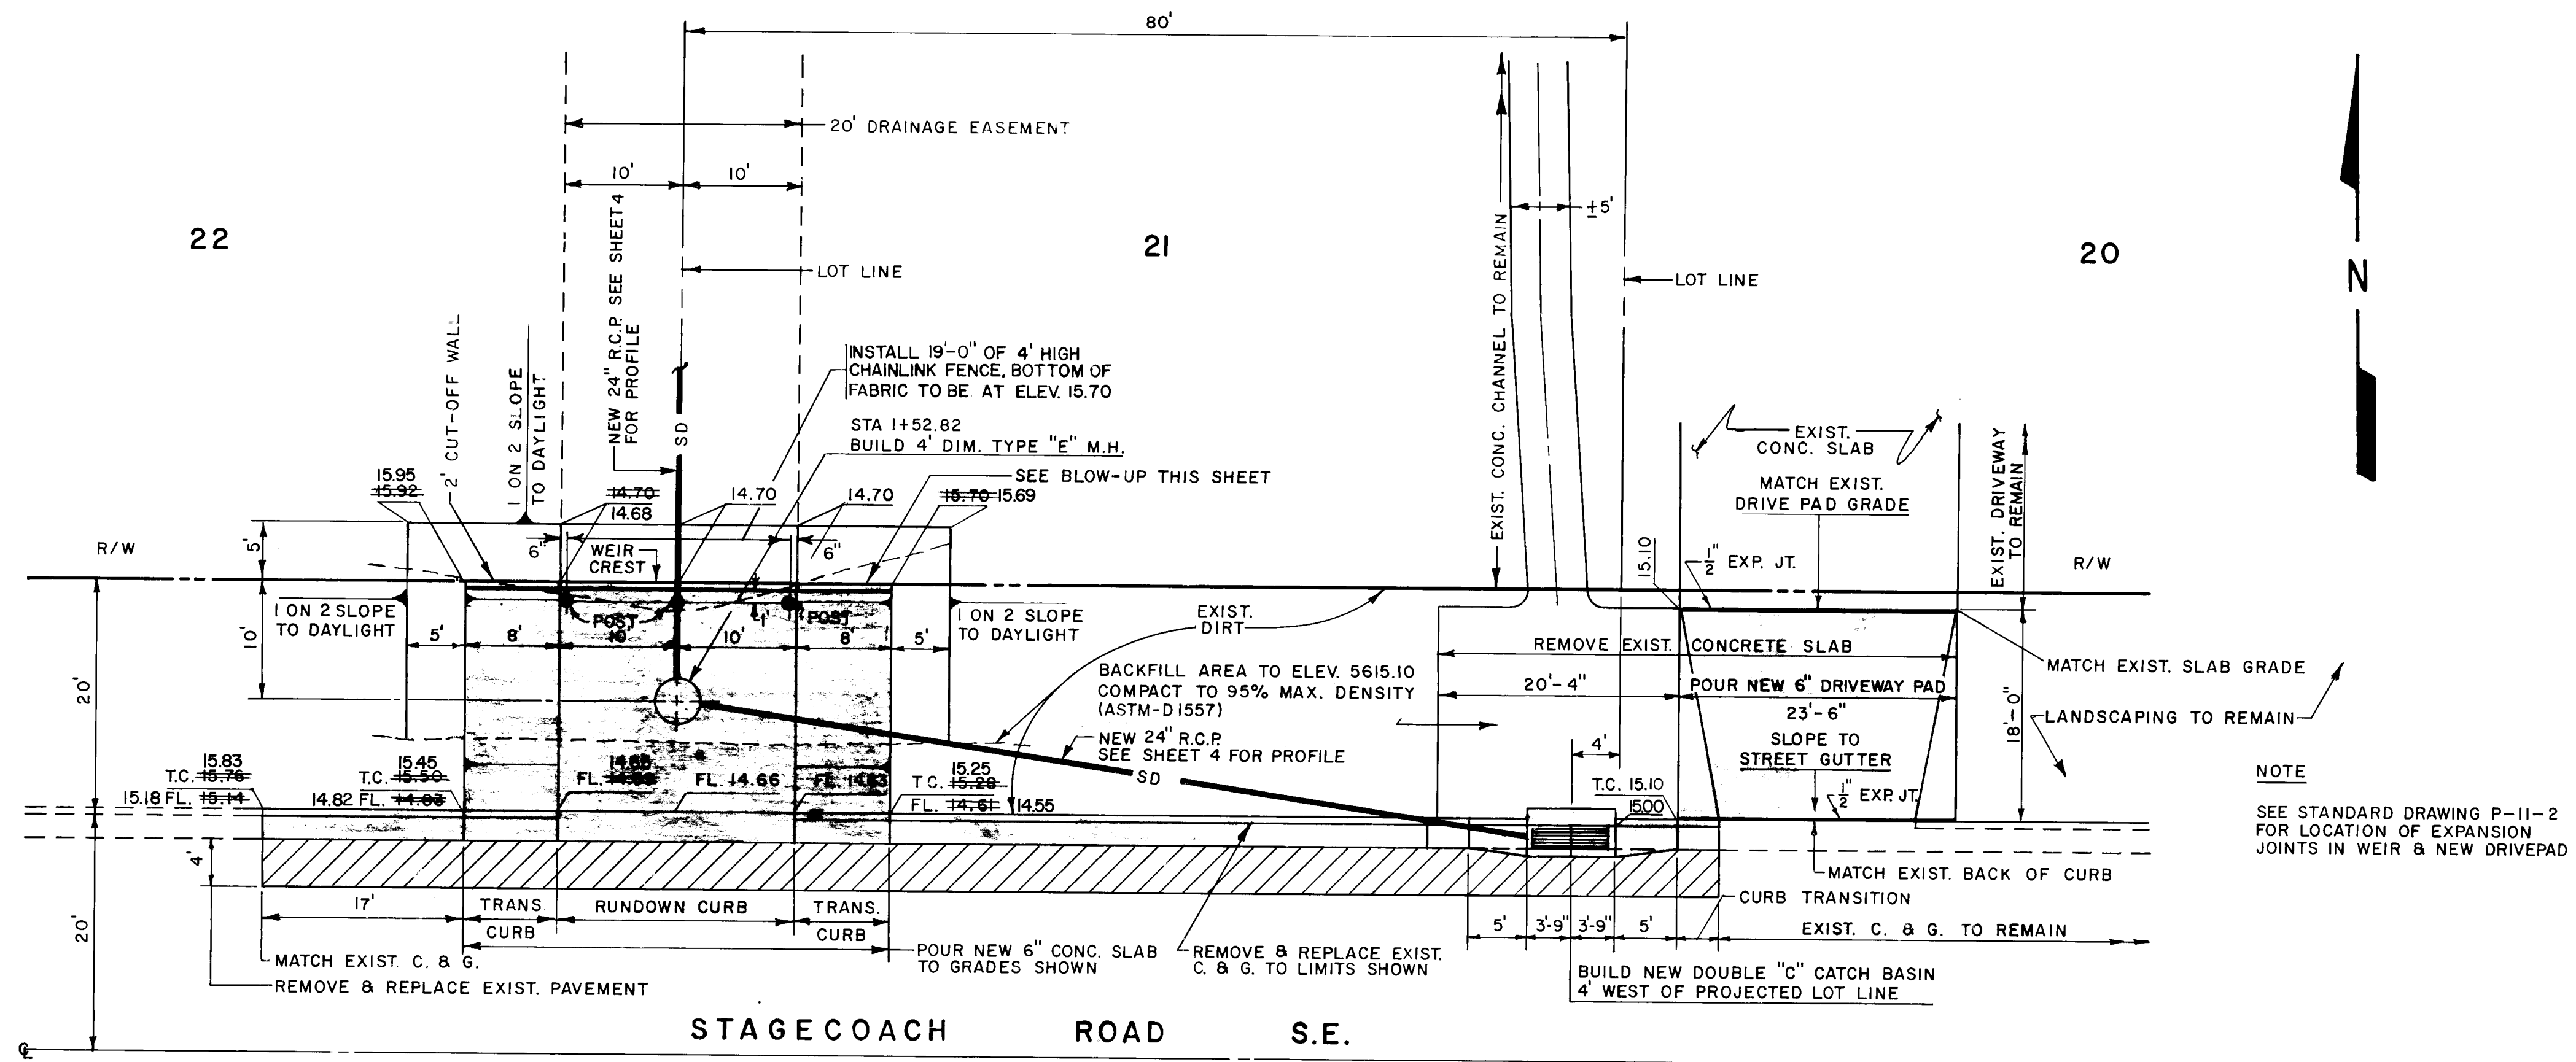

SCALE: HORIZ. 1" = 10'
VERT. 1" = 1'

AS BUILT INFORMATION		NEW CONCEPTS	
DATE	BY	DATE	BY
BENCH MARKS		SURVEY INFORMATION	
FIELD NOTES		NO. BY DATE	
ENGINEER'S SEAL		REVISIONS	
		NO. DATE	
		DESIGN	
		DATE 5-15-83	
		DRAWN BY ISAAC E. LARGE	
		CHECKED BY	
		DATE 5-19-83	

26-1749-0384

C. H. Shappert

CITY OF ALBUQUERQUE
MUNICIPAL DEVELOPMENT DEPARTMENT
ENGINEERING DIVISION

TITLE: STORM DRAINAGE IMPROVEMENTS-FOUR HILLS VILLAGE
FOURTH INSTALLMENT BLOCK 1 LOTS 21/22
DETAIL PLAN & PROFILE

APPROVALS	ENGINEER	DATE	APPROVALS	ENGINEER	DATE
CITY ENGINEER	C. H. Shappert	7/11/83	LIQUID WASTE	NA WBS	7-11-83
A.C.E. Design	7/24/83		TRAFFIC	NA DW4	7/24/83
A.C.E. Hydrology	7/24/83		WATER	NA WBS	7-11-83

DRAWING NO.	1749	MAP NO.	M-22	SHEET	3	OF	4
-------------	------	---------	------	-------	---	----	---

