

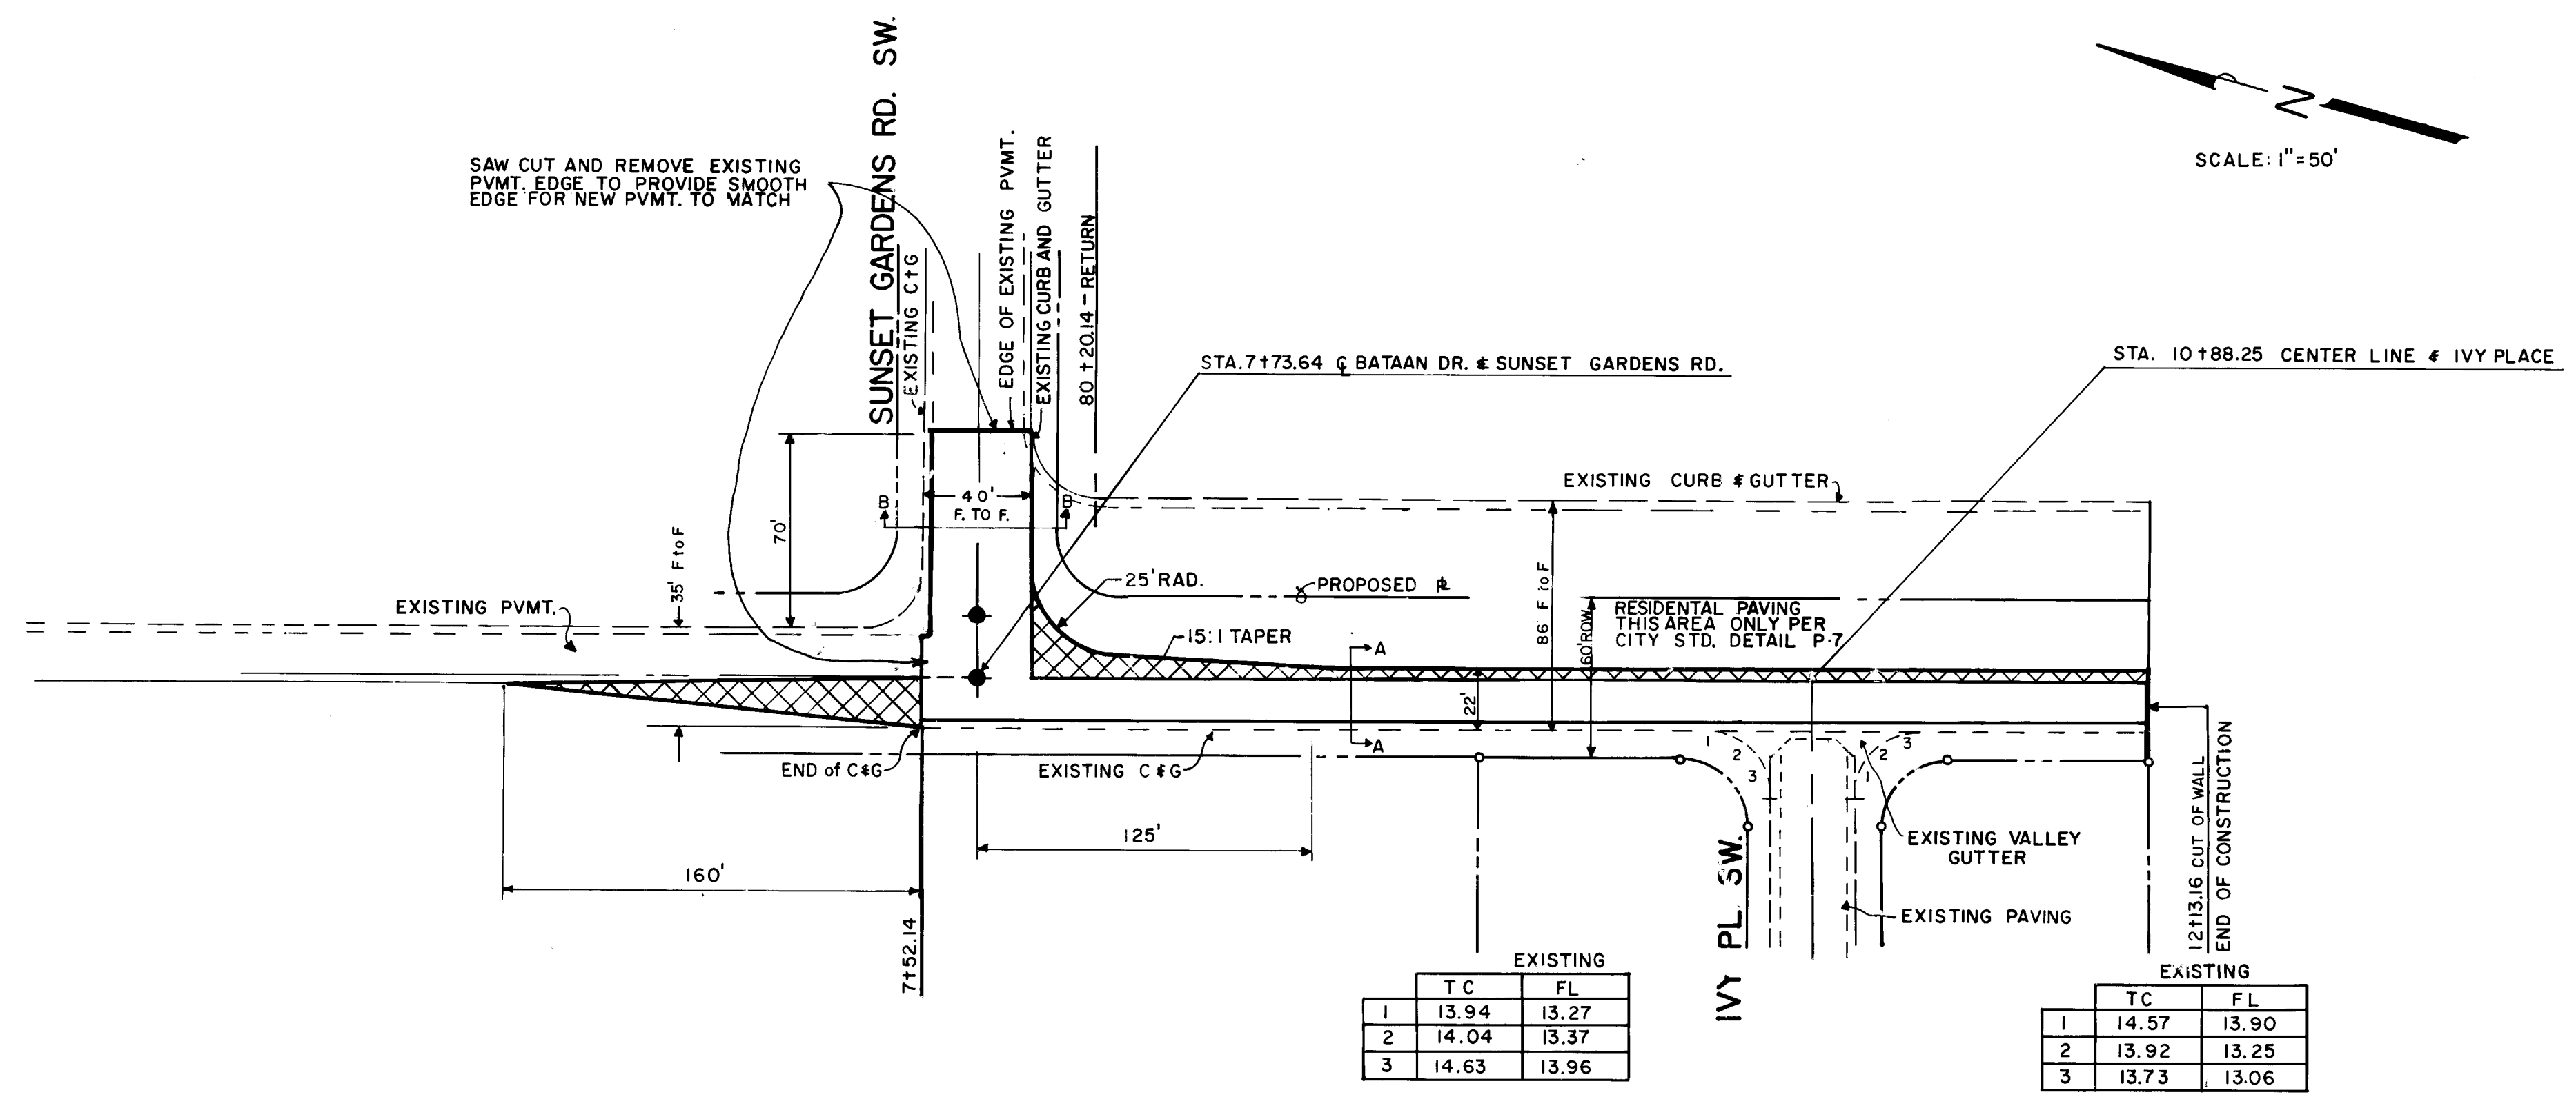
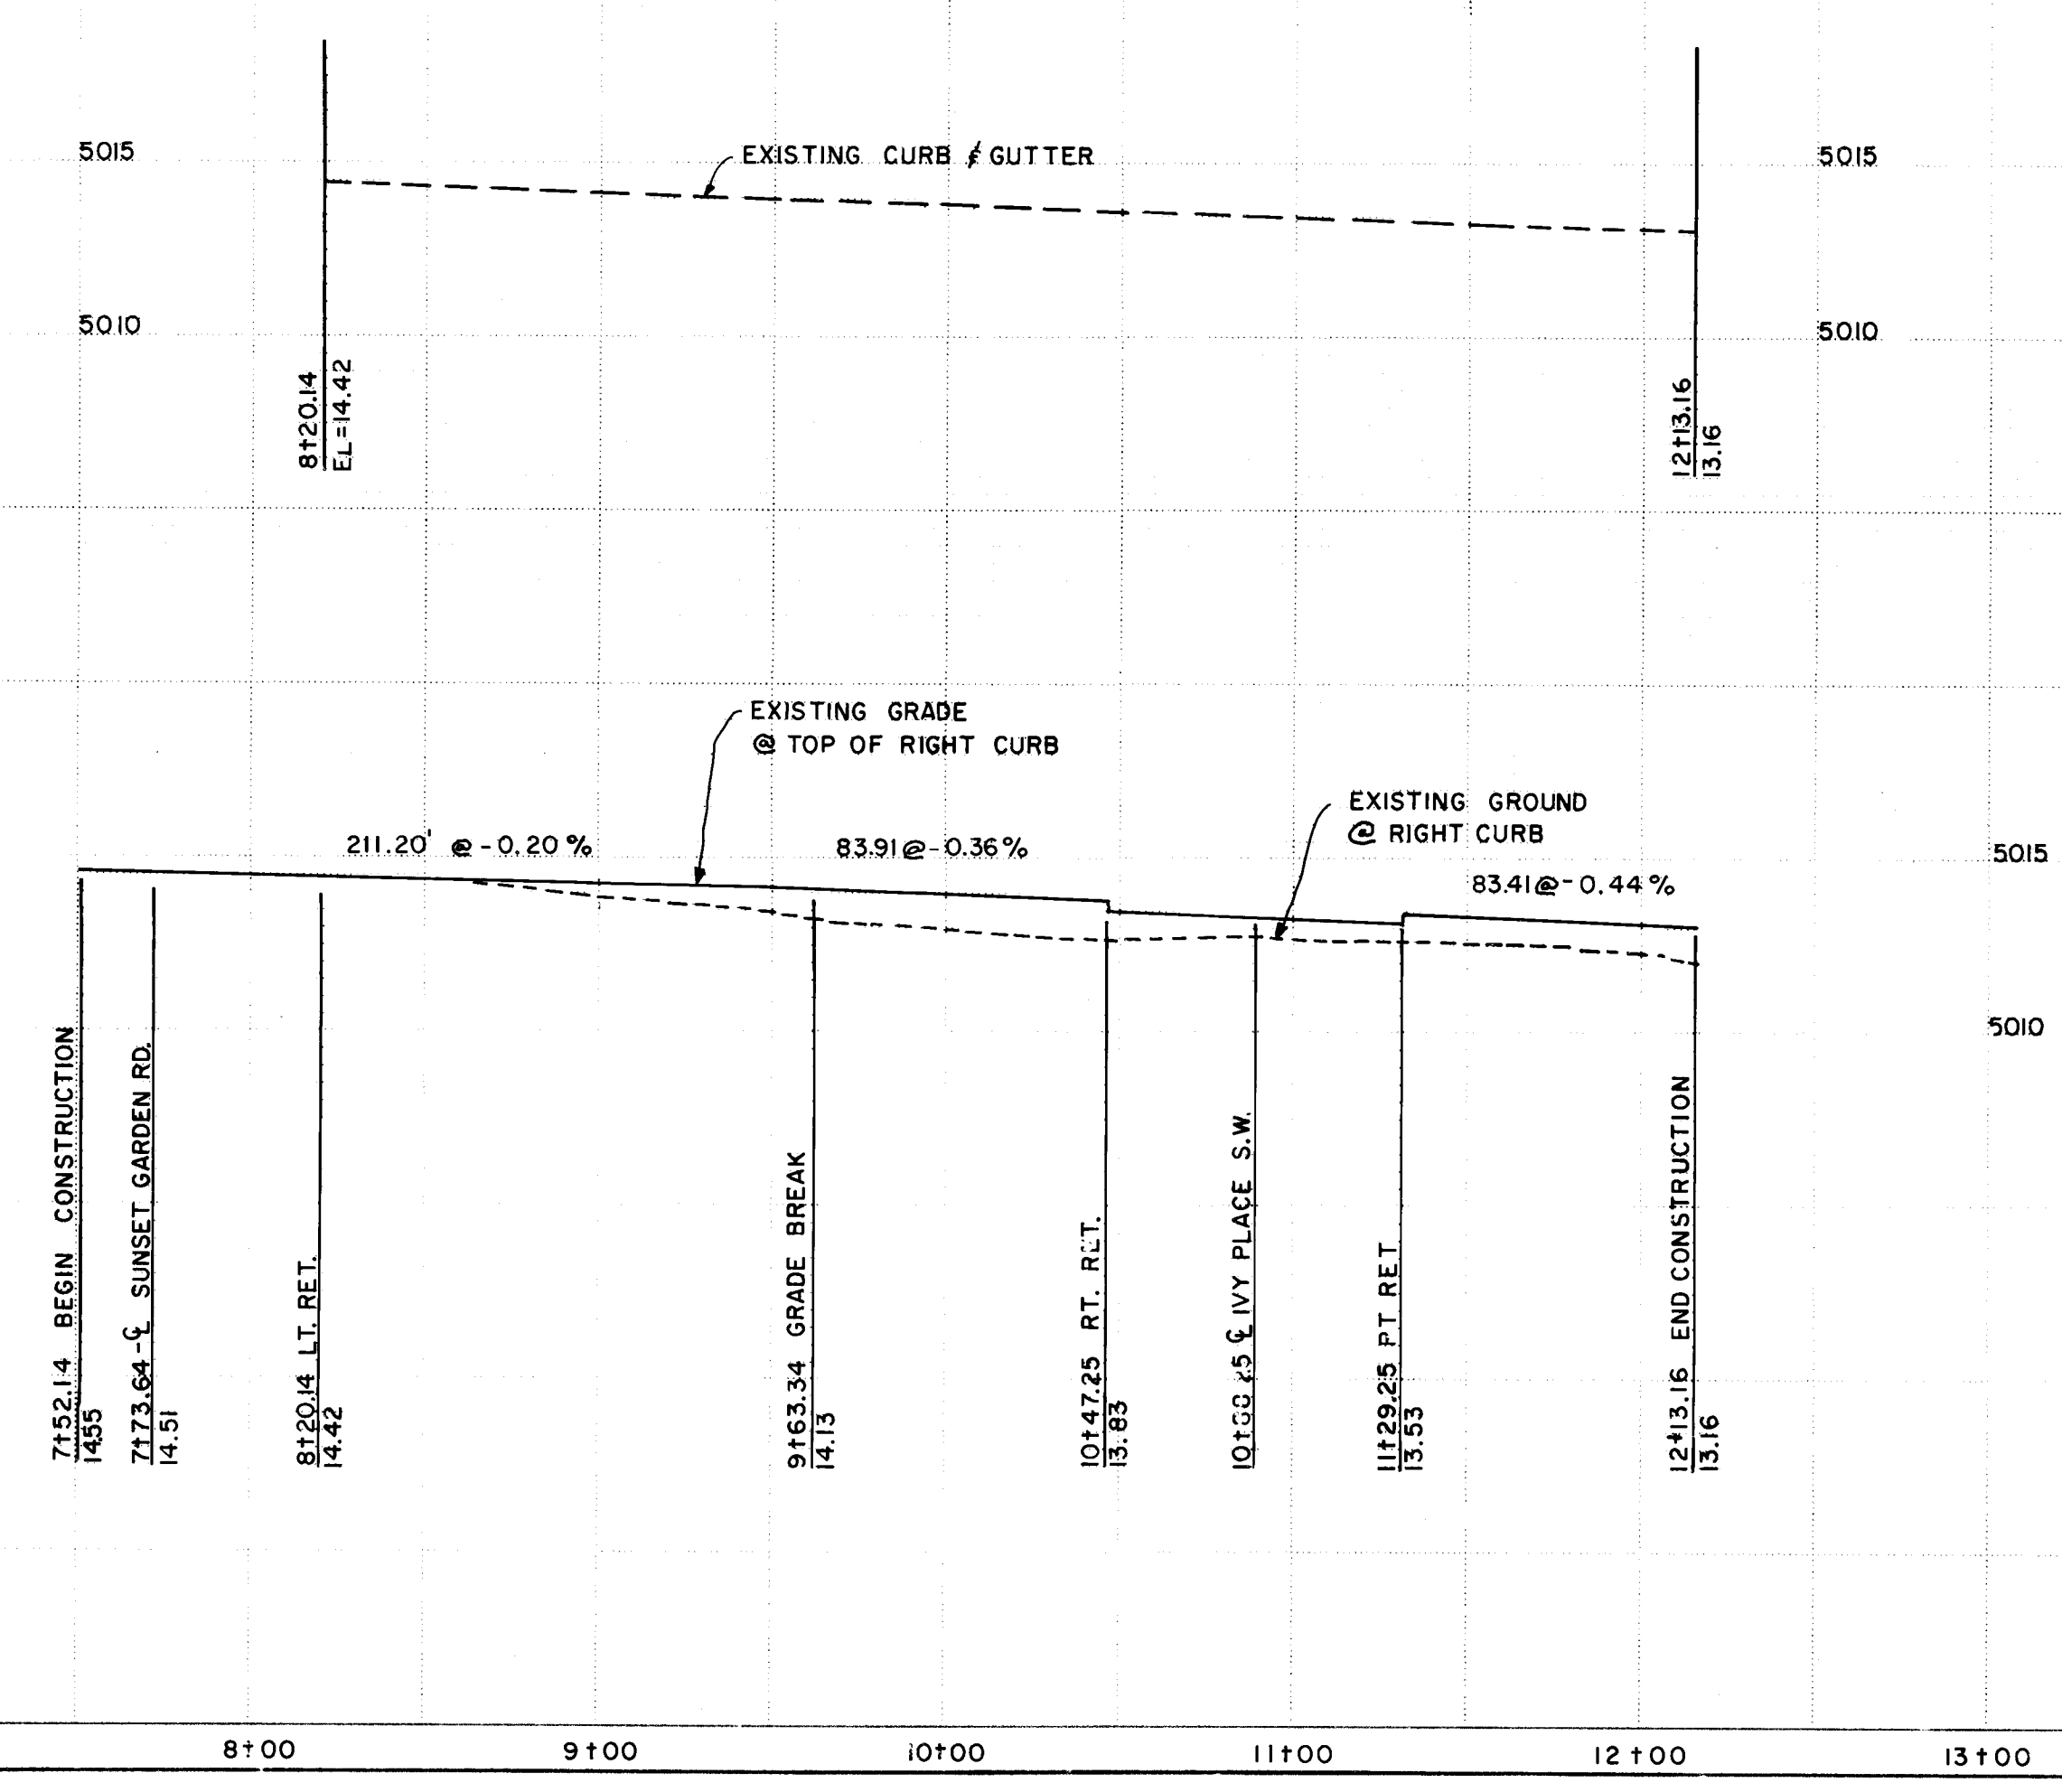


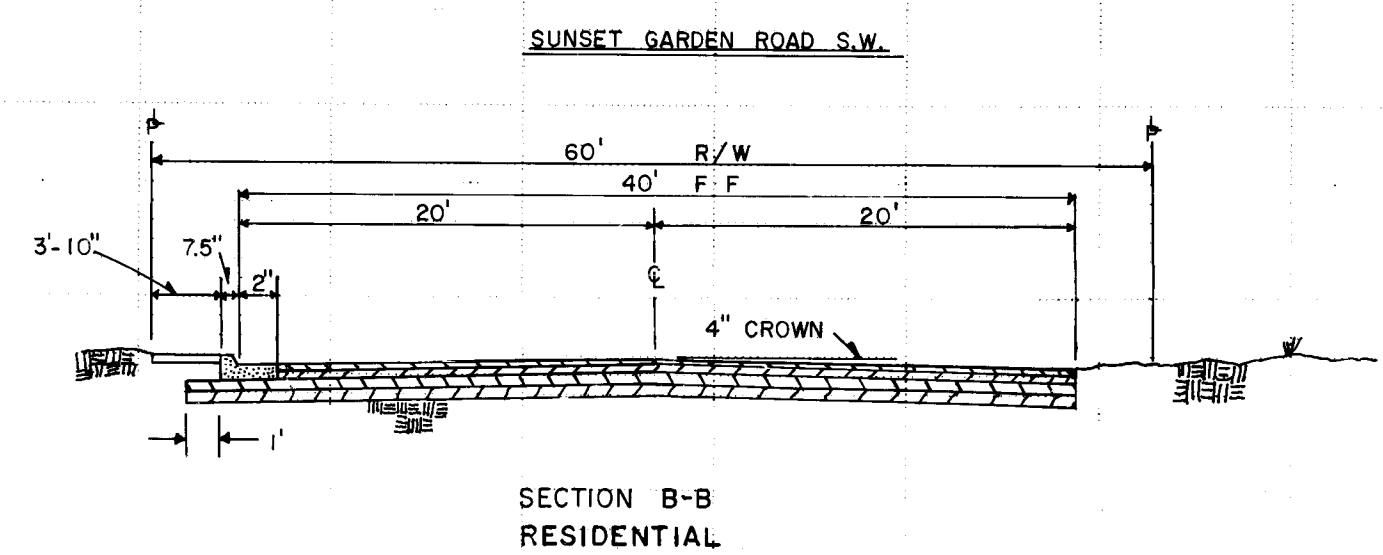

NOTE: CONSTRUCT PAVING PER
STANDARD DETAIL P-2 AND P-7

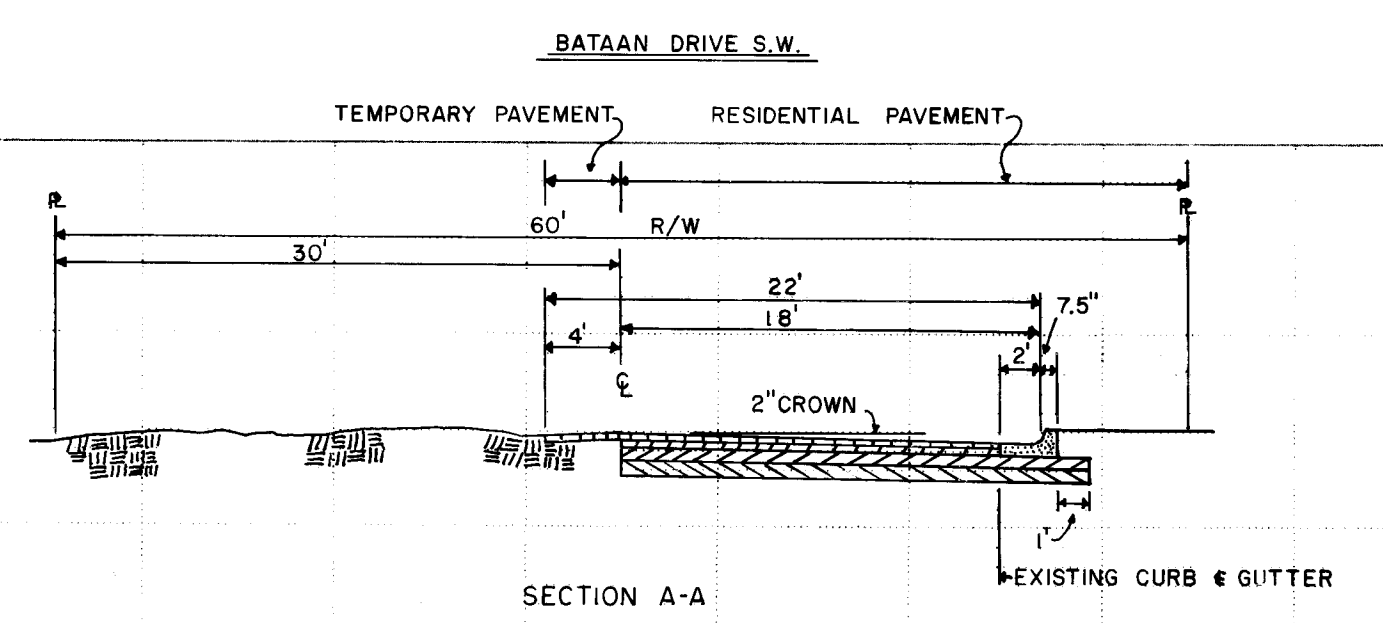

SCALE: 1"=50' HORIZ.
1"=5' VERT.

26 1754 0184

APPROVAL OF AS BUILT DRAWINGS
ASST. CITY ENGINEER-FIELD
W.F. M. GARCIA
DATE 1/23/84

C. H. Shepard 9/1/83
8-19-83

CITY OF ALBUQUERQUE MUNICIPAL DEVELOPMENT DEPARTMENT ENGINEERING DIVISION					
TITLE: BATAAN DRIVE S.W. - (IVY PLACE S.W. TO SUNSET GARDENS ROAD S.W.)					
APPROVALS	ENGINEER	DATE	APPROVALS	ENGINEER	DATE
City Engineer	C. H. Shepard	9/1/83	Liquid Waste	W. F. M. Garcia	8-1-83
A.C.E. - Design	W. F. M. Garcia	8/6/83	Traffic	W. F. M. Garcia	8-11-83
A.C.E. - Hydrology	W. F. M. Garcia	8/12/83	Water	W. F. M. Garcia	8-11-83
QA	A. R. B. B.	8-17-83			

DRAWING NO. 1754		MAP NO. L-11		SHEET 1 OF 1	
------------------	--	--------------	--	--------------	--

ENGINEER'S SEAL		SURVEY INFORMATION		BENCH MARKS		AS BUILT INFORMATION	
NO.	BY	FIELD NOTES	DATE	ACS BM #2-KID EL-5057.432	CHISELED IN THE TOP OF CURB AT THE WSW RETURN OF 68th ST. SW AND GWIN RD. SW	INSPECTED BY	DATE
						FIELD CHECK BY	DATE
						VERIFICATION BY	DATE
						CORRECTED BY	DATE
						RECORDED BY	DATE