

PHASE II


KATHERINE-NICHOLE ADDITION
CITY OF ALBUQUERQUE, NEW MEXICO

INDEX

TITLE SHEET	1
PLATS	2-3
KEY MAP	4
GRADING & DEVELOPMENT PLAN	5-7
STREET PLAN & PROFILE	8-12
WATER & SEWER PLAN & PROFILE	13-17
△ DRAINAGE MODIFICATION ON MILNE ROAD	18

(SHT. 18 ADDED 6-4-1984)

VICINITY MAP (F-10,G-10)

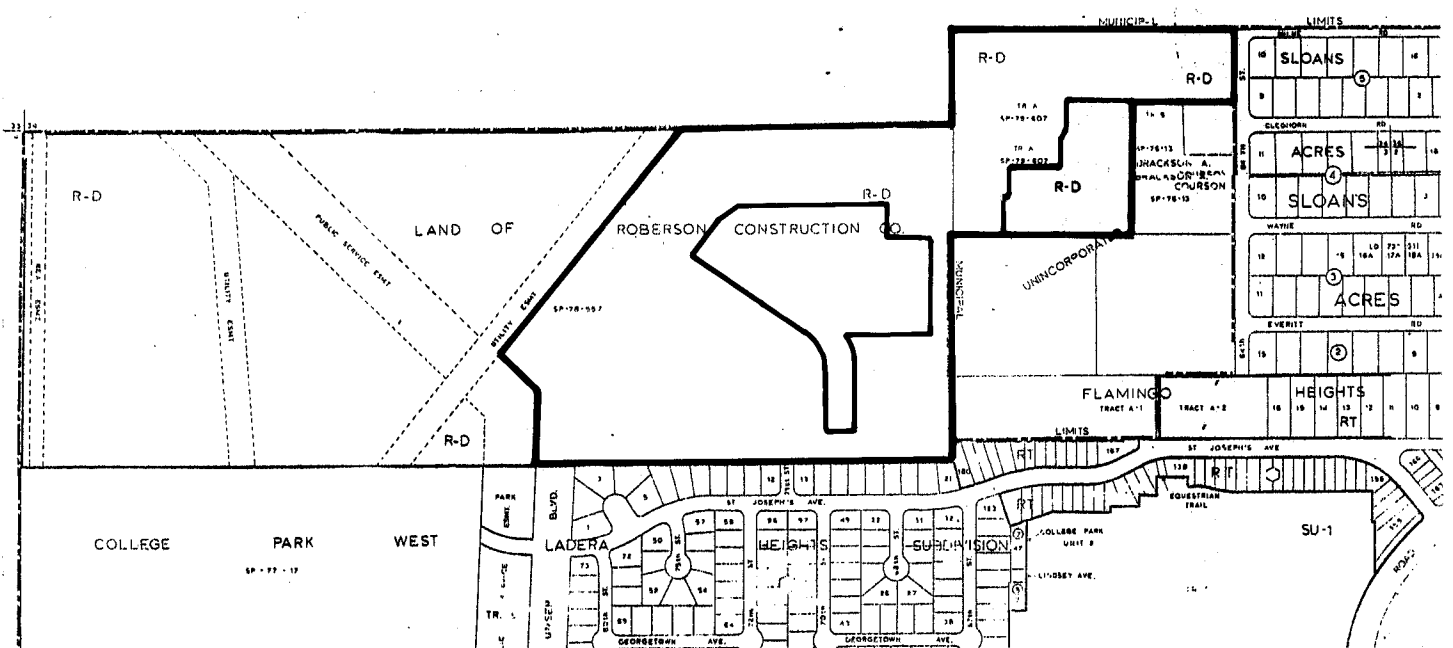


GENERAL NOTES

1. New Mexico Standard Specifications for Public Works Construction, 1979 Edition, will be referred to hereon as the "Standard Specification".
2. All work detailed on these plans to be performed under contract shall, except as otherwise stated or provided for hereon, be constructed in accordance with "Contract Documents for City-Wide Utilities and Cash Paving No. 31 and the Standard Specifications".
3. All utilities and utility service lines shall be installed prior to paving.
4. Where a water line passes beneath or less than 3' above an existing sewer line, the sewer line shall be encased in concrete 6" thick for at least 10' on each side of the water line, or the sewer line shall be replaced with ductile iron pipe with mechanical joints for 10' each side of the water line. This shall apply where a parallel water line is less than 10' horizontally and less than 2' above the sewer.
5. Backfill compaction shall be according to specified street use.
6. Tack coat requirements shall be determined by the City Engineer.
7. If curb is depressed for a driveway, the driveway shall be constructed prior to acceptance of the curb and gutter.
8. All storm drainage facilities shall be completed prior to final acceptance.
9. Two working days prior to any excavation, contractor must contact Line Locating Service, 765-1234, for location of existing utilities.
10. Prior to construction, the contractor shall excavate and verify the horizontal and vertical locations of all obstructions. Should a conflict exist, the contractor shall notify the engineer or surveyor so that the conflict can be resolved with a minimum amount of delay.
11. Location of Flatten Crown Sections as specified by the engineer.


RE-ENTRY

APPROVALS	ENGINEER	DATE	APPROVALS	ENGINEER	DATE
City Engineer	<i>[Signature]</i>	5/13/84	Liquid Waste	<i>[Signature]</i>	2-2-84
A.C.E.-Design	<i>[Signature]</i>	7/1/84	Traffic	<i>[Signature]</i>	2/2/84
A.C.E.-Hydrology	<i>[Signature]</i>	3/2/84	Water	<i>[Signature]</i>	2-2-84

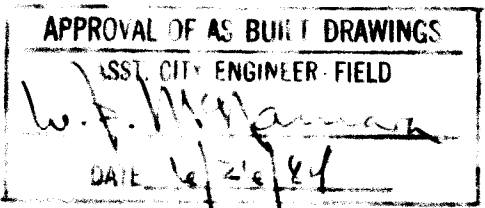

0.6 1790 0184

REV.	SHEET	DATE	USER	DEPT.	DATE	USER	DEPT.	DATE
1	THRU 18	6/13/84	ACC. DES.		6/13/84			
APPROVAL OF REVISIONS								

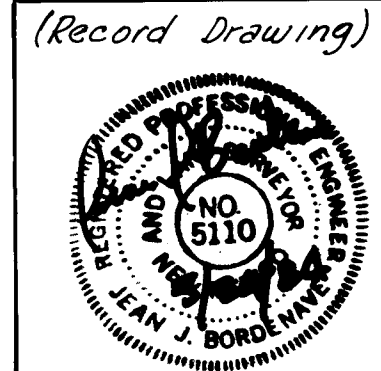

DMJM/
ADAM, HAMLYN, ANDERSON
consulting engineers inc.
4055 MONTGOMERY BOULEVARD N.E.
ALBUQUERQUE, NEW MEXICO 87109
505-881-1111

APPROVED FOR
CONSTRUCTION
[Signature]
C.E.

1790

SHEET 1 OF 17
18

0871

0871

APPROVED AND ACCEPTED BY:

V. Hernandez by R. Kelly
Richard S. Villanueva
4/24/81

Subdivision No. 5-79-54 81 2083

State of New Mexico
County of Bernalillo SS
This instrument was filed for record on
APR 7 1981
at _____ o'clock P.M., Recorded in Vol. _____
of pages of said County from _____
to _____ by Clerk & Recorder
Liquity Clerk

Unplatted Land

USGLO Brass Cap
S. Mile Marker

4-17-81
Date
1/16/81
Date
1/29/81
Date
4/18/81
Date
4/17/81
Date
4/20/81
Date
4/22/81
Date
4/20/81
Date

USGLO Brass Cap
Copper Chain
Sec. 34, T10N, R2E, NMPM &
Sec. 3, T10N, R2E, NMPM &
Grind to Grid Factor 0.999778
Grid = 2115.81
A CC - 0°16'05"

SURVEYOR'S CERTIFICATION
I am to certify that this Re-subdivision was prepared under my direct supervision and meets the minimum requirements for measurement, calculation and surveying of the proposed Subdivision Ordinance and true plat copy to the best of my knowledge and belief. All elements of record are shown.

R. J. C. Villanueva
DATE 4-20-81
J. L. C. Villanueva
J. L. C. Villanueva
No. 1074
New Mexico

EASEMENTS FOR UTILITIES
A seven foot (7') wide utility easement is hereby granted along the street line or lane within each lot shown herein.

RESUBDIVISION OF BLOCKS 6, 7, 8, 9 & 10
OF
KATHERINE · NICHOLE ADDITION
WITHIN SECTIONS 3, T10N, R2E & 34, T11N, R2E NMPM
AND THE TOWN OF ALBUQUERQUE GRANT,
ALBUQUERQUE, NEW MEXICO
ZONE ATLAS MAP NOS. F-10 & G-10

DEDICATION
The Re-Subdivision shown and described herein is for the purpose of altering the sizes of the lots shown on the plat of record and is with the free consent and in accordance with the desires of the undersigned owners thereof. The streets and public rights of way are shown hereon for reference only and have not been changed or altered in any way and remain the same as and identical to those shown on the plat of record. Easements for utilities are hereby granted and dedicated to the above herein together with the right of ingress and egress and the right to run interfering trees. Lot 11 in Block 8 is hereby dedicated to the City of Albuquerque, New Mexico for use as a water well site.

DESCRIPTIONS
Lot 44-51 Block 7, Lots 3-45 Block 2, Lots 1-16 Block 9 and Lots 1-34 Block 10 on the LAND OF CODA ROBERSON & SON, INC.
Lot 1-39 Block 6, Lots 1-43 Block 7, and Lots 1&2 Block 8, on the same LAND OF ROBERSON CONSTRUCTION COMPANY, INC.
and designated on the plat of KATHERINE · NICHOLE ADDITION, filed in the Office of the Clerk of Bernalillo County, New Mexico on January 6, 1981.

CODA ROBERSON & SON, INC.
By _____ Attorney
ROBERSON CONSTRUCTION COMPANY, INC.
By _____ Attorney
CODA C. ROBERSON
CODA C. ROBERSON, PRESIDENT

State of New Mexico
County of Bernalillo SS

The foregoing instrument was acknowledged before me this _____ day of _____ 1981, by Cody L. Roberson and Virgil H. Stewart on behalf of

APPROVED



Public Service Company of New Mexico Date
Approval of Grading According to
Sections "A-A" & "B-B" Within the
Public Service Company of New Mexico
Easement.

Sht. 4 of 21

Sht. 5 of 21

Sht. 6 of 21

Sht. 7 of 21

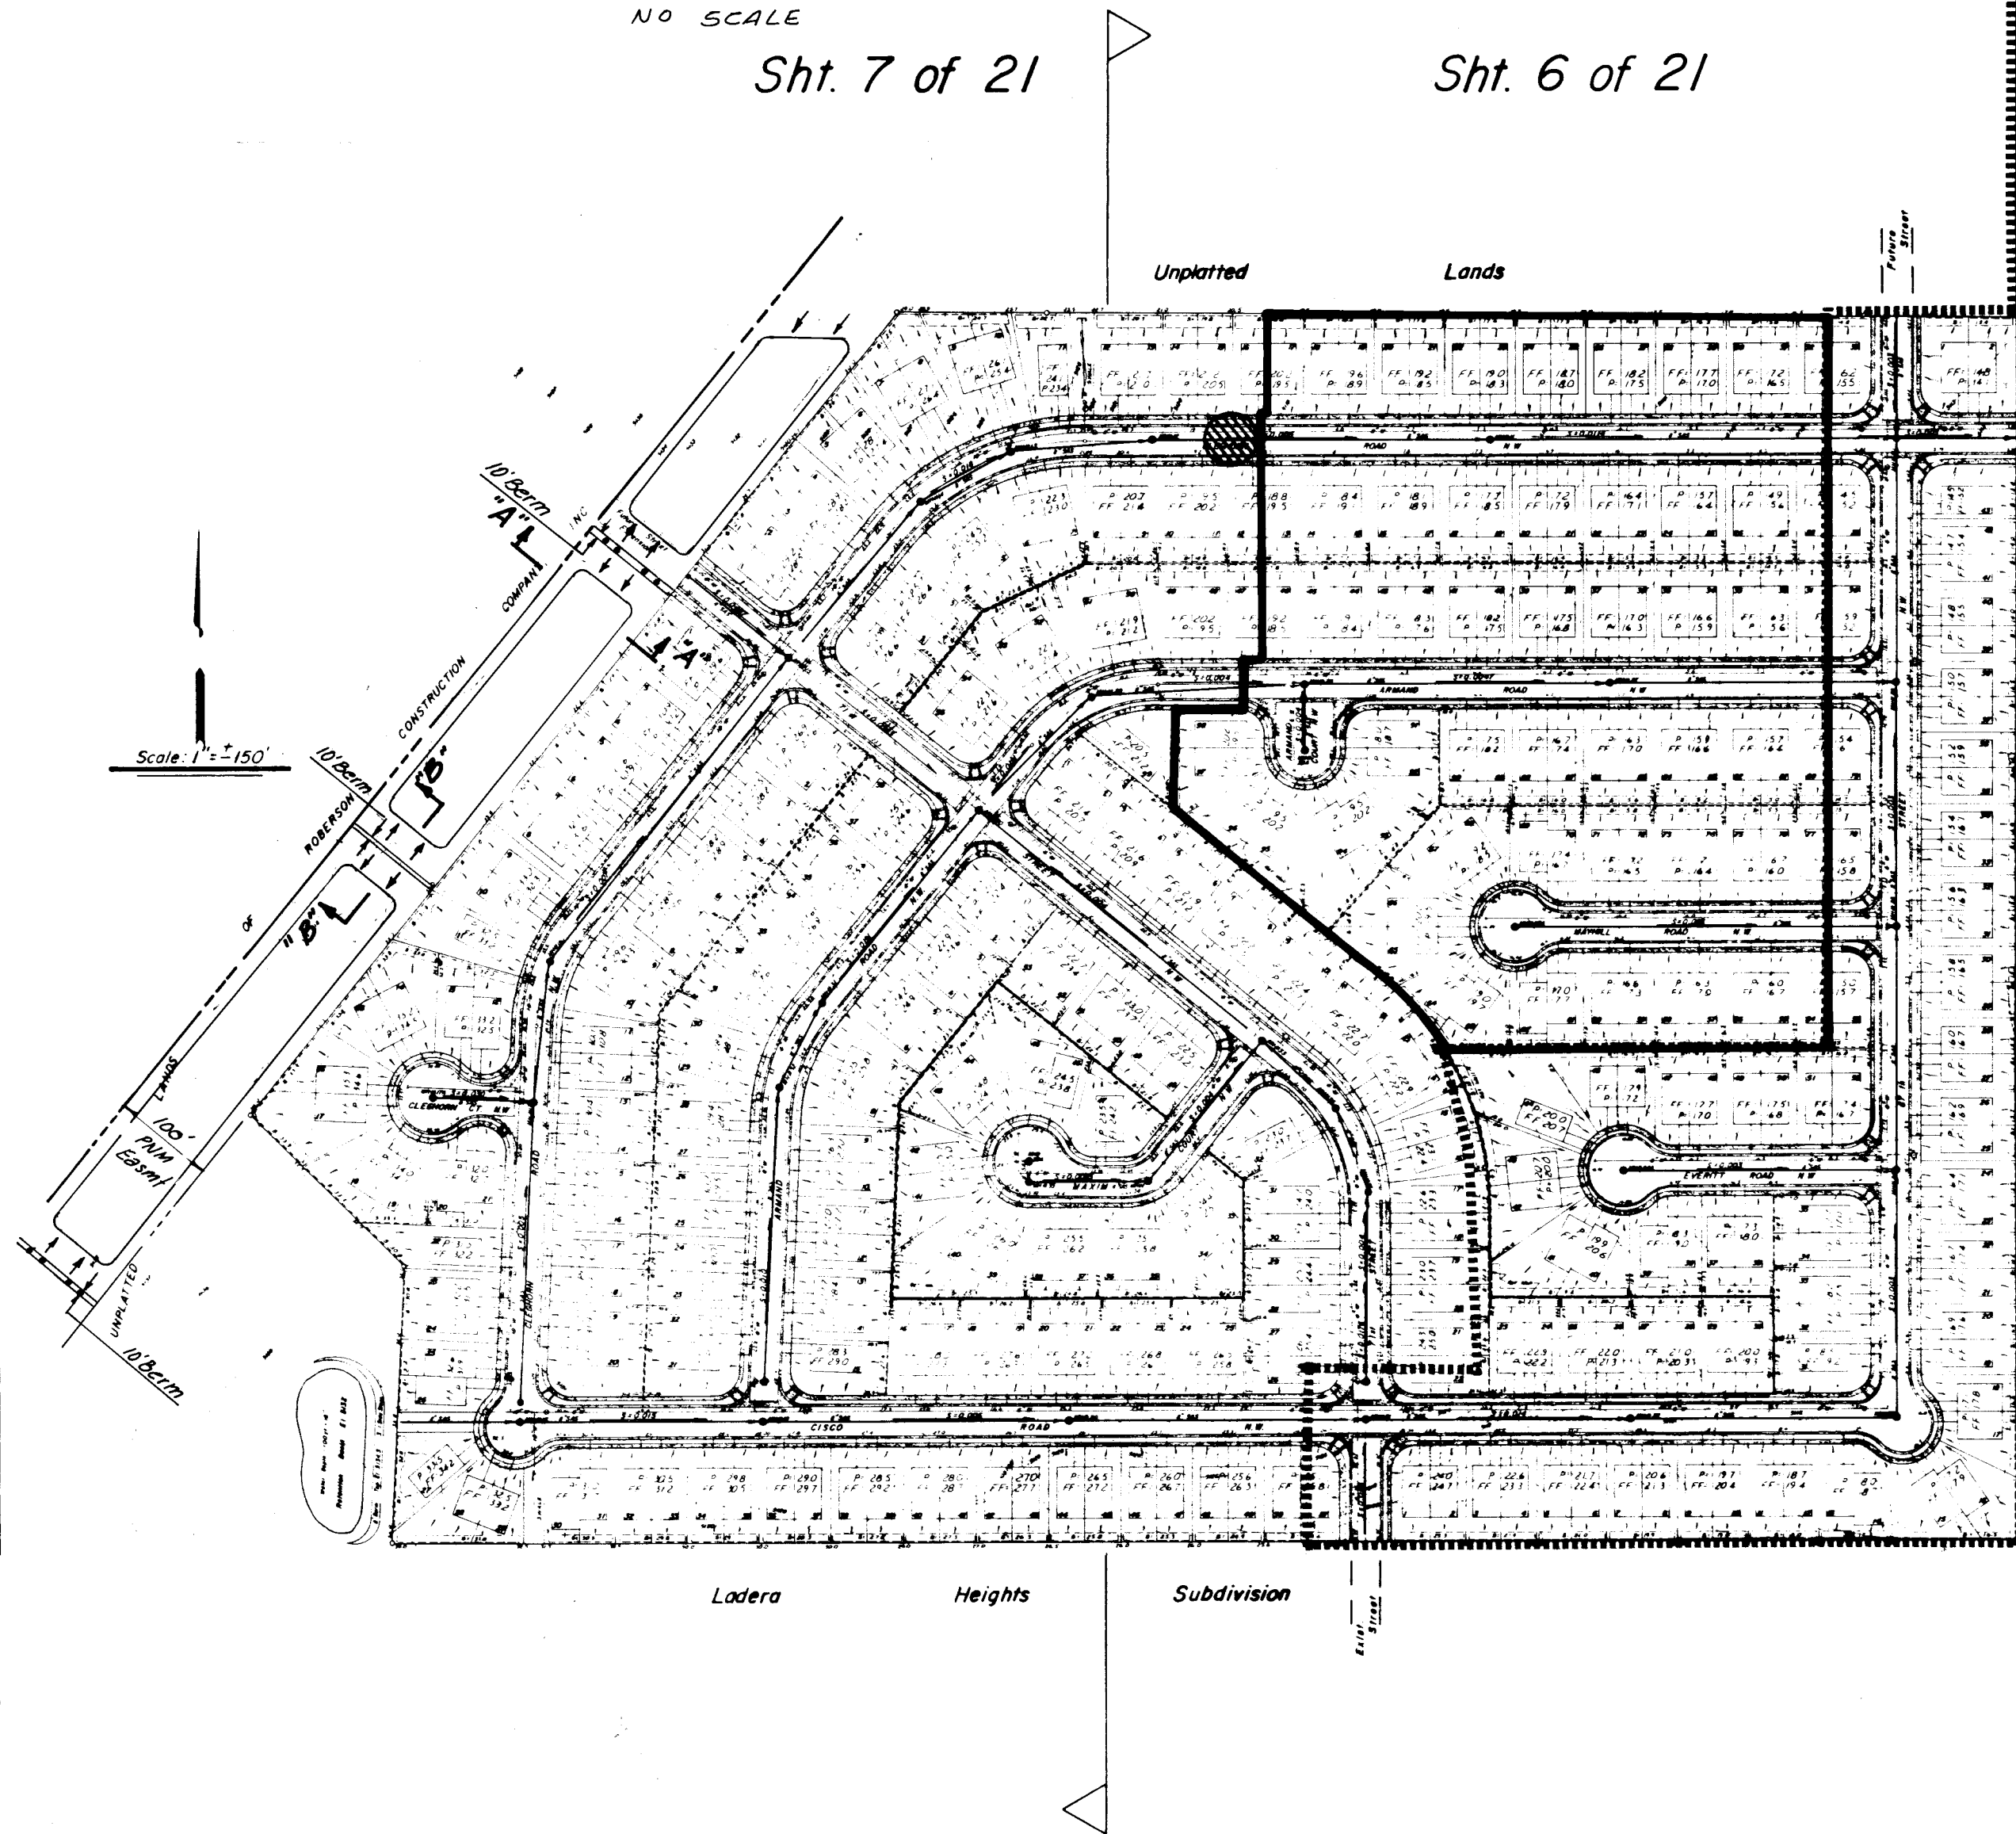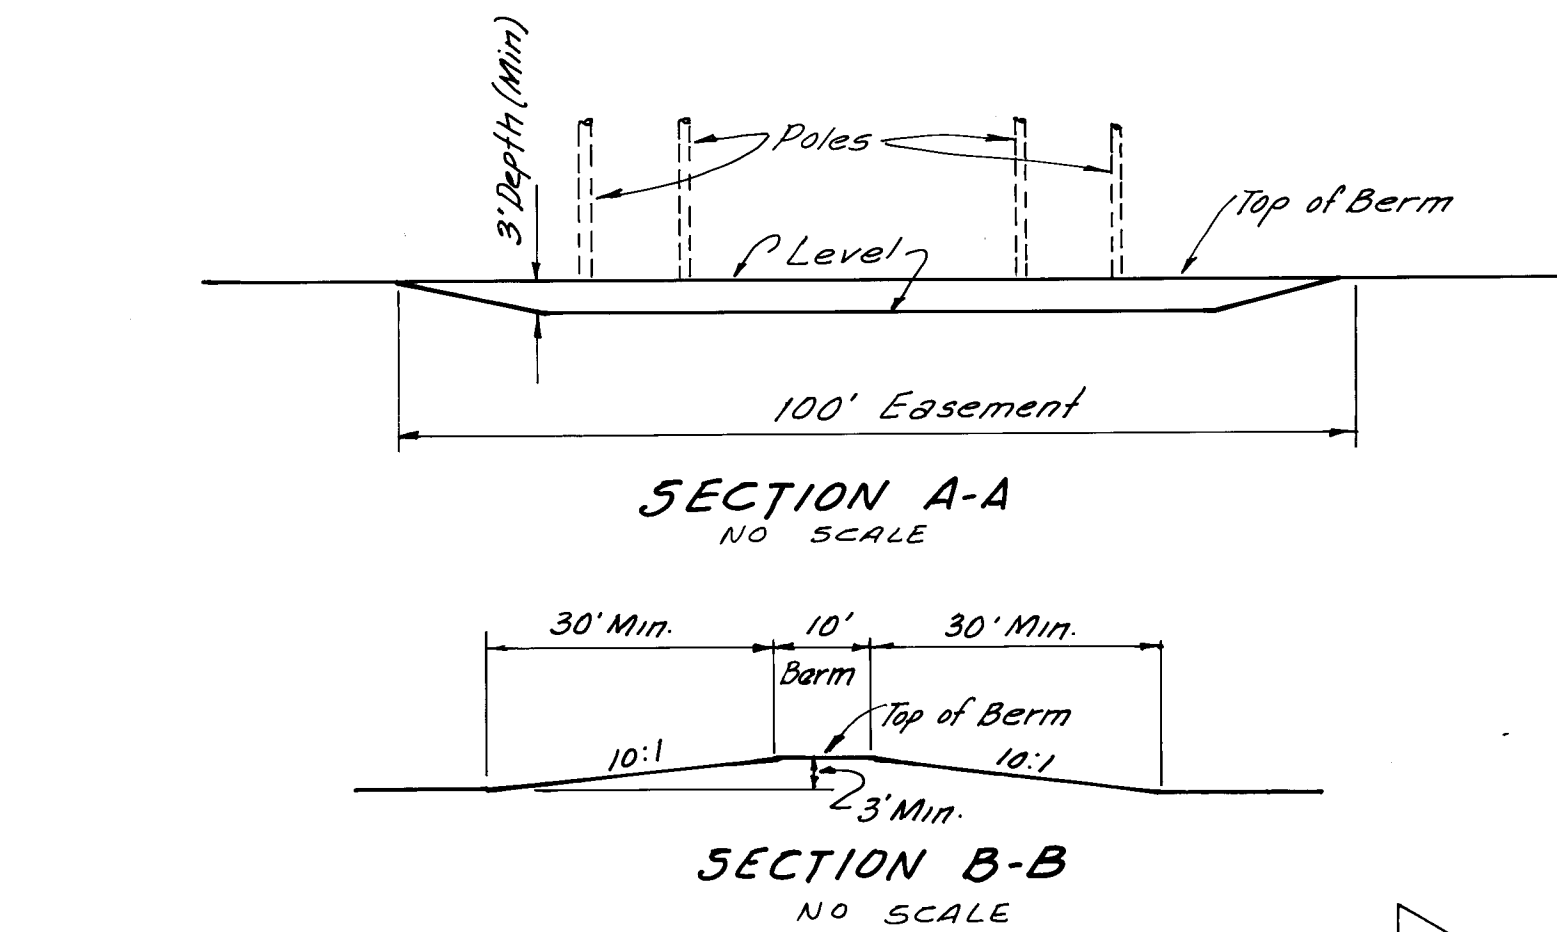

Flamingo
Heights
Subdivision


NOTE:

- Indicates Limits of Phase One Construction
- $S=0.004$ Refers to Street Grade Slopes and represents ft./ft.
- Indicates Limits of Phase Two Construction

NOTE
This drawing issued for reference only.
Not to be used for construction.

66 1790 0464


PHASE - II

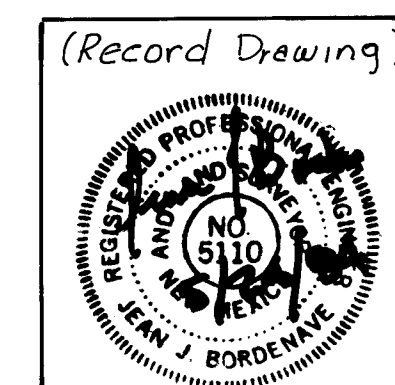

APPROVED FOR CONSTRUCTION
CITY ENGINEER
DATE

CITY OF ALBUQUERQUE MUNICIPAL DEVELOPMENT DEPARTMENT ENGINEERING DIVISION			
TITLE: KEY MAP - Grading & Development Plan KATHERINE - NICHOLE ADDITION			
APPROVALS	ENGINEER	DATE	APPROVALS
City Engineer	J. J. Borckware	5/21/81	Liquid Waste
A.C.E. - Design	J. J. Borckware	5/21/81	Traffic
A.C.E. - Hydrology	J. J. Borckware	5/21/81	Water
DRAWING NO. 1063-1790		SHEET 4 OF 17	

REFERENCES		SURVEY INFORMATION		BENCH MARKS		AS BUILT INFORMATION	
MAP NO.	EST. NO.	FIELD NOTES	BY	NO.	DATE	CONTRACTOR	NO.
F-70 & G-10		LEVINGTON ENGINEERING					
REVISIONS		REMARKS		DESIGN		MICRO-FILM INFORMATION	
NO.	DATE	BY	DATE	DESIGNED BY	DATE	RECORDED BY	DATE
1	6/4/84	RE-NUMBERED SHEETS		LEVINGTON ENGINEERING			
2							
3							
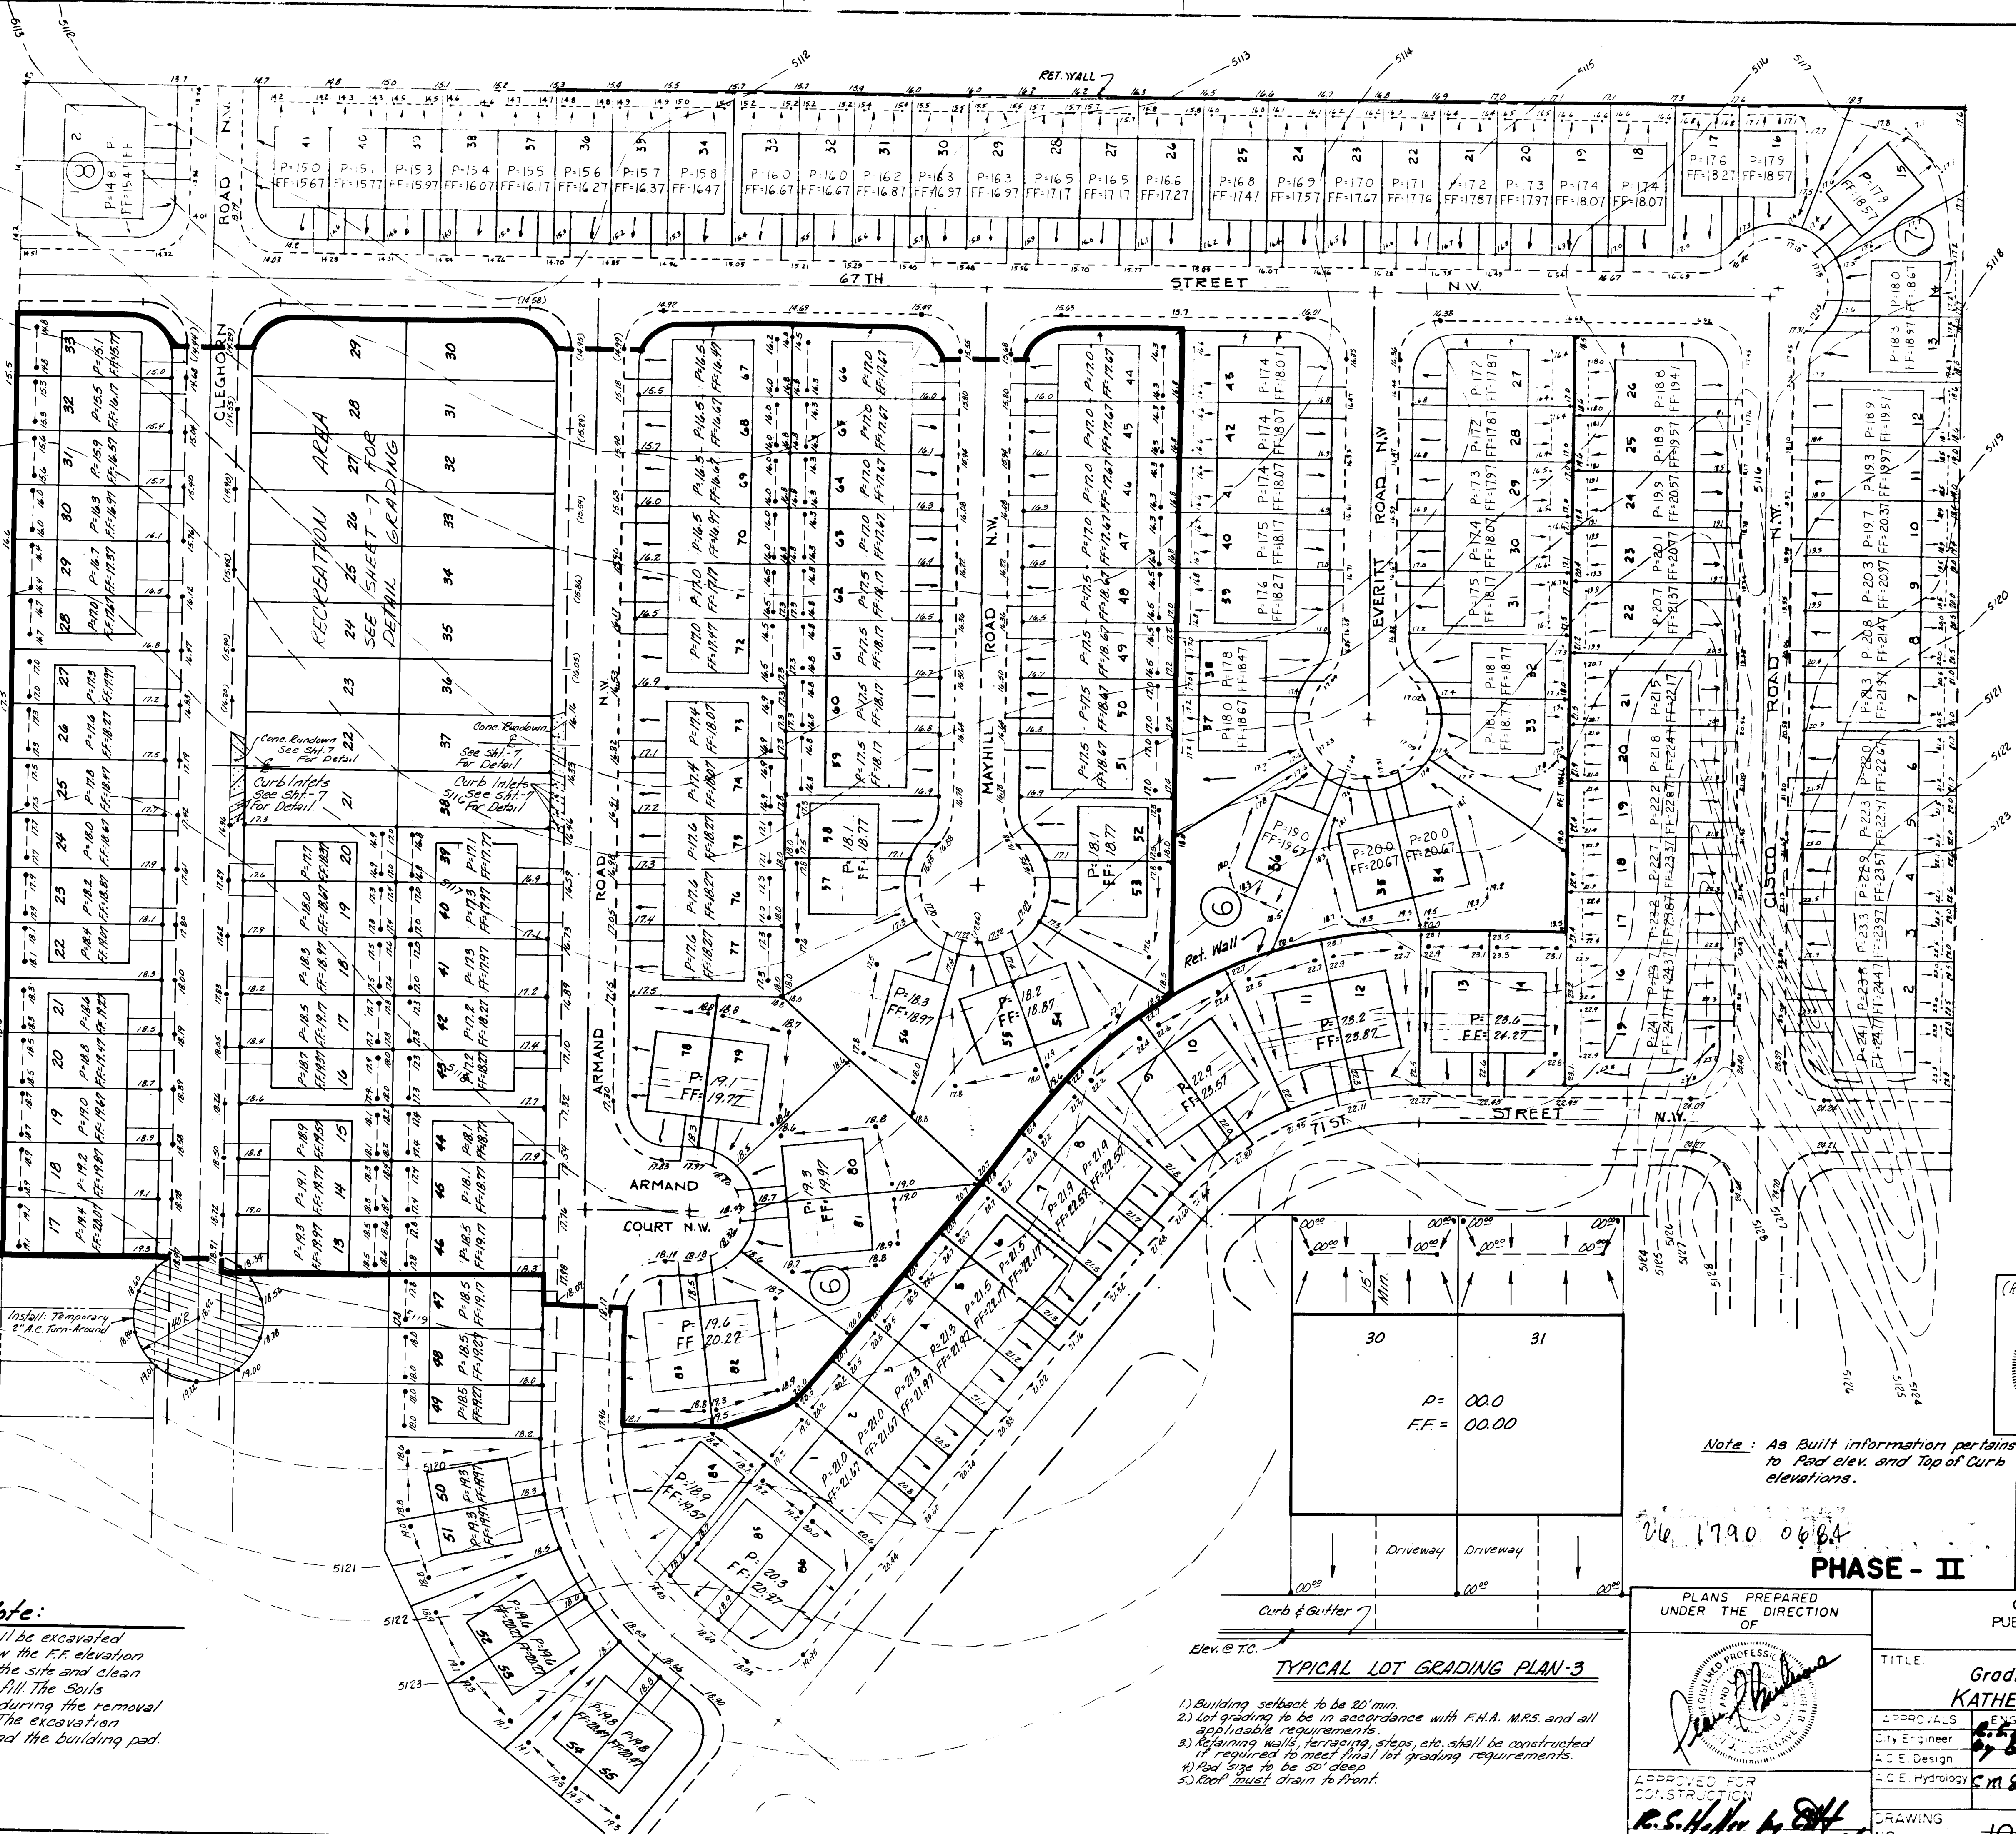


Excavation Note:
Lots 50, 52-55, 64 & 68 shall be excavated to a depth of 5.5 feet below the F.F. elevation shown, clay removed from the site and clean soil placed in a controlled fill. The Soils Engineer shall be onsite during the removal and replacement of soil. The excavation shall extend 5 feet beyond the building pad.

- TYPICAL LOT GRADING PLAN-3**
- 1) Building setback to be 20' min.
 - 2) Lot grading to be in accordance with F.H.A. M.R.S. and all applicable requirements.
 - 3) Retaining walls, terracing, steps, etc. shall be constructed if required to meet final lot grading requirements.
 - 4) Pad size to be 50' deep
 - 5) Roof must drain to front.

Note: As Built information pertains to Pad elev. and Top of Curb elevations.

26 1790 0664

PHASE - II

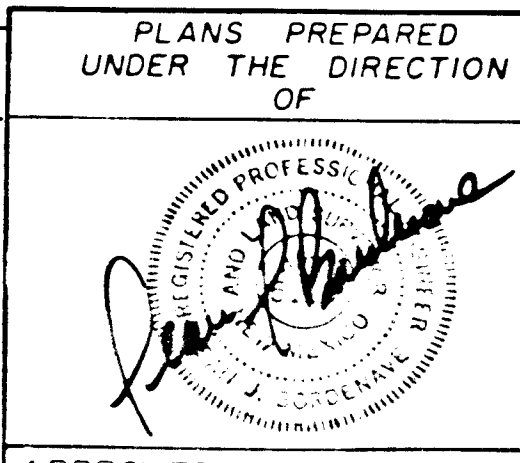

PLANS PREPARED UNDER THE DIRECTION OF		CITY OF ALBUQUERQUE PUBLIC WORKS DEPARTMENT ENGINEERING DIVISION	
TYPICAL LOT GRADING PLAN-3		TITLE Grading & Development Plan KATHERINE - NICHOLE ADDITION	
APPROVALS	DATE	APPROVALS	DATE
City Engineer	6/2/84	City Engineer	6/2/84
A.C.E. Design	6/2/84	A.C.E. Design	6/2/84
A.C.E. Hydrology	6/2/84	A.C.E. Hydrology	6/2/84
DRAWING NO. 1063 1790		SHEET 6 OF 17	

AS BUILT INFORMATION	
CONTRACTOR	Kent Mowlin Const. Co.
STAMPED BY	A.H.A.
DATE	11/81
INSPECTOR	
DATE	
FIELD	
DATE	
VERIFICATION BY	A.H.A.
DATE	1/82
CORRECTION BY	
DATE	
RECORDED BY	
DATE	

BENCH MARKS	
BRASS CAP - 34" TYP. REE AND SEC. 3, TION, REE - 210, 513.61	

SURVEY INFORMATION	
FIELD NOTES	
NO.	BY
NO.	LEVITON ENGINEERING





REFERENCES	
MAP NO. F-10 & B-10	
EST NO.	W.O. NO.

REVISIONS	
NO.	DATE
NO.	DATE

Adam Hamlyn, Anderson
Consulting Engineers Inc.
4055 Montgomery Blvd. N.E.
Albuquerque, New Mexico 87109 Ph. 881-1808





11/20/08

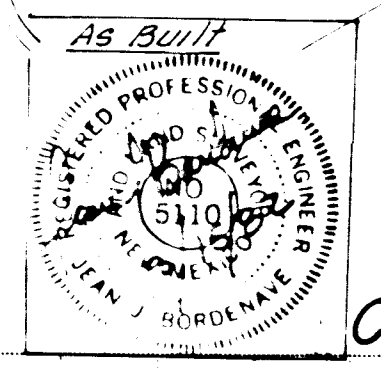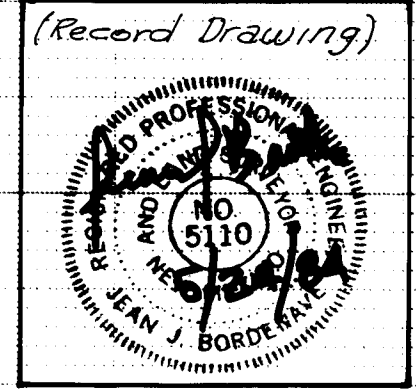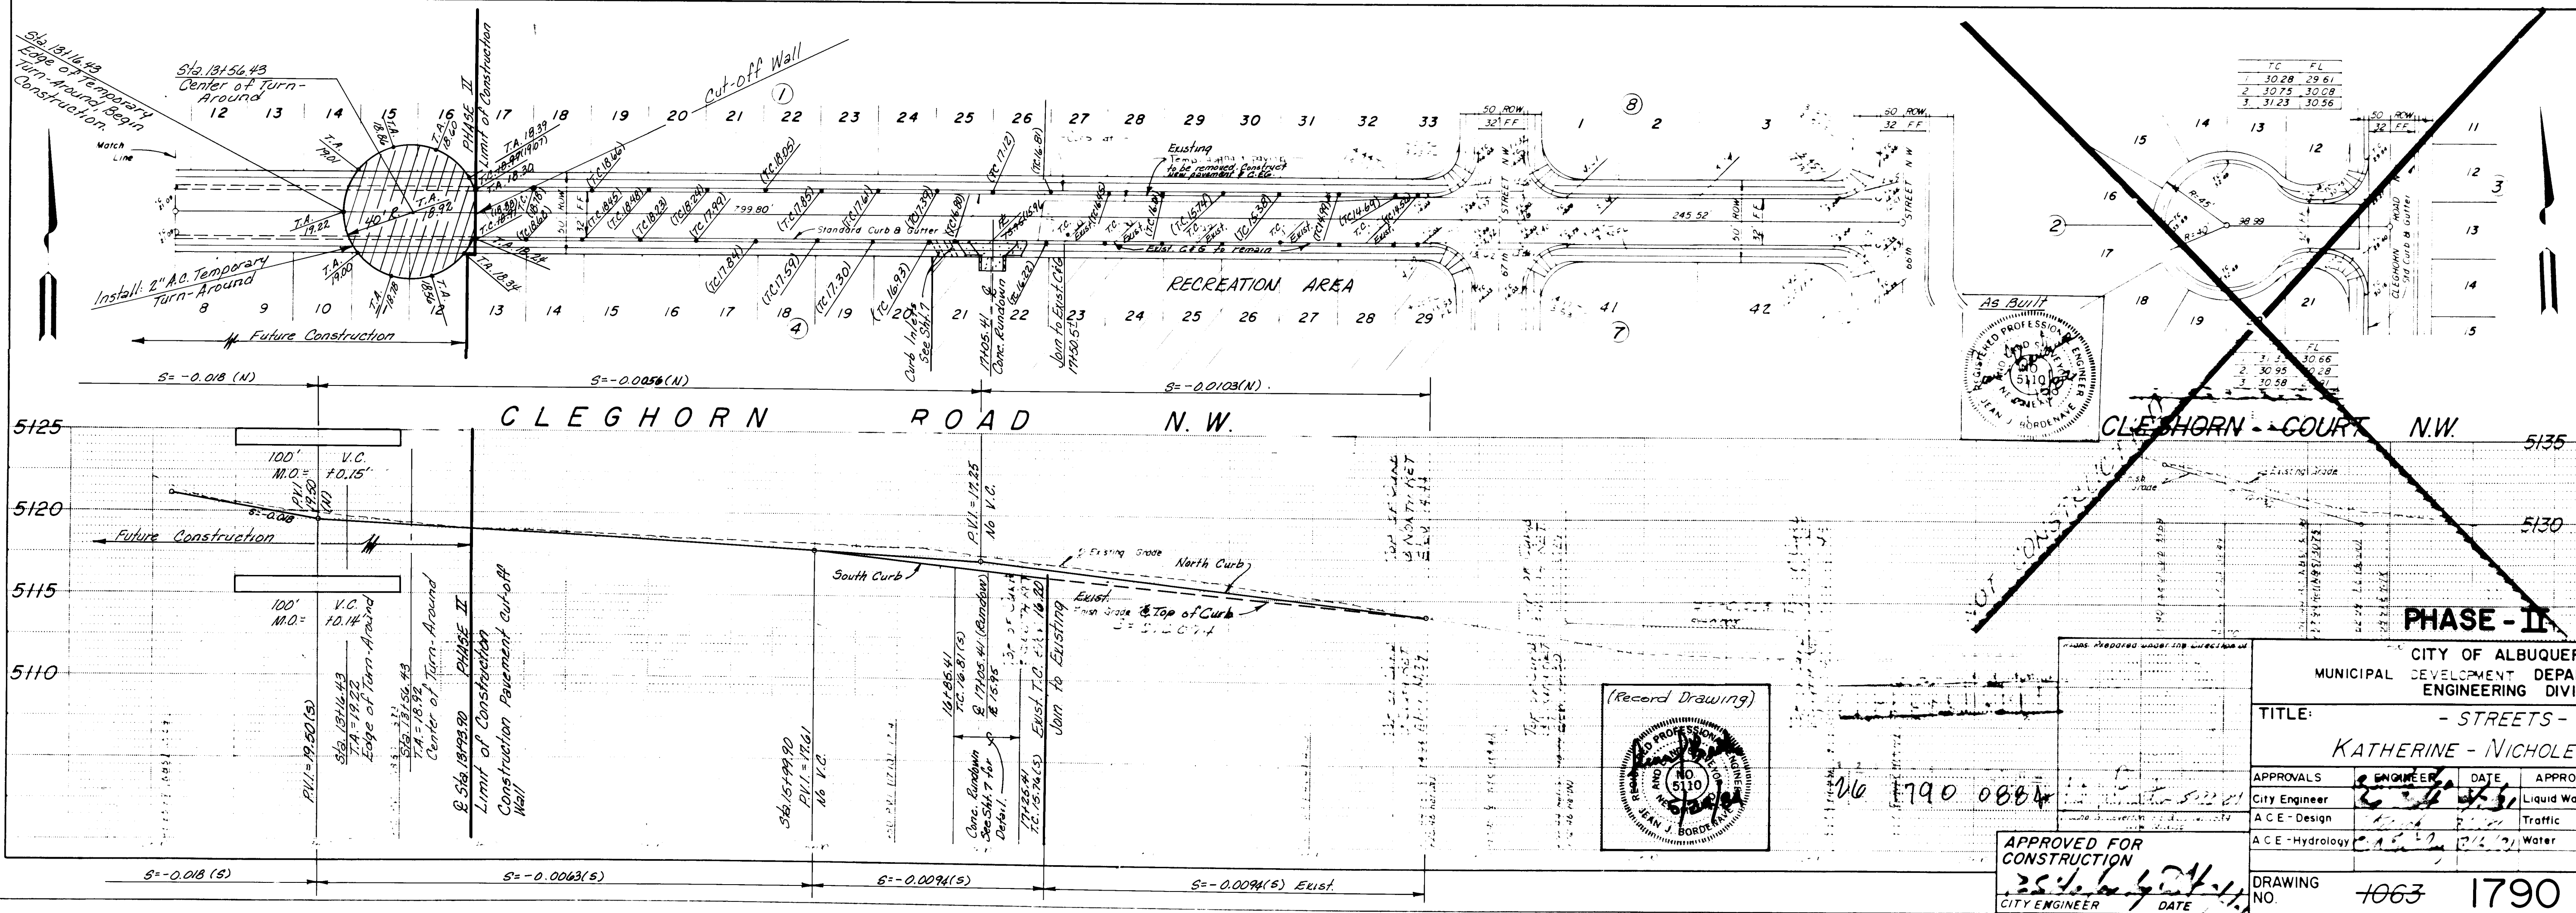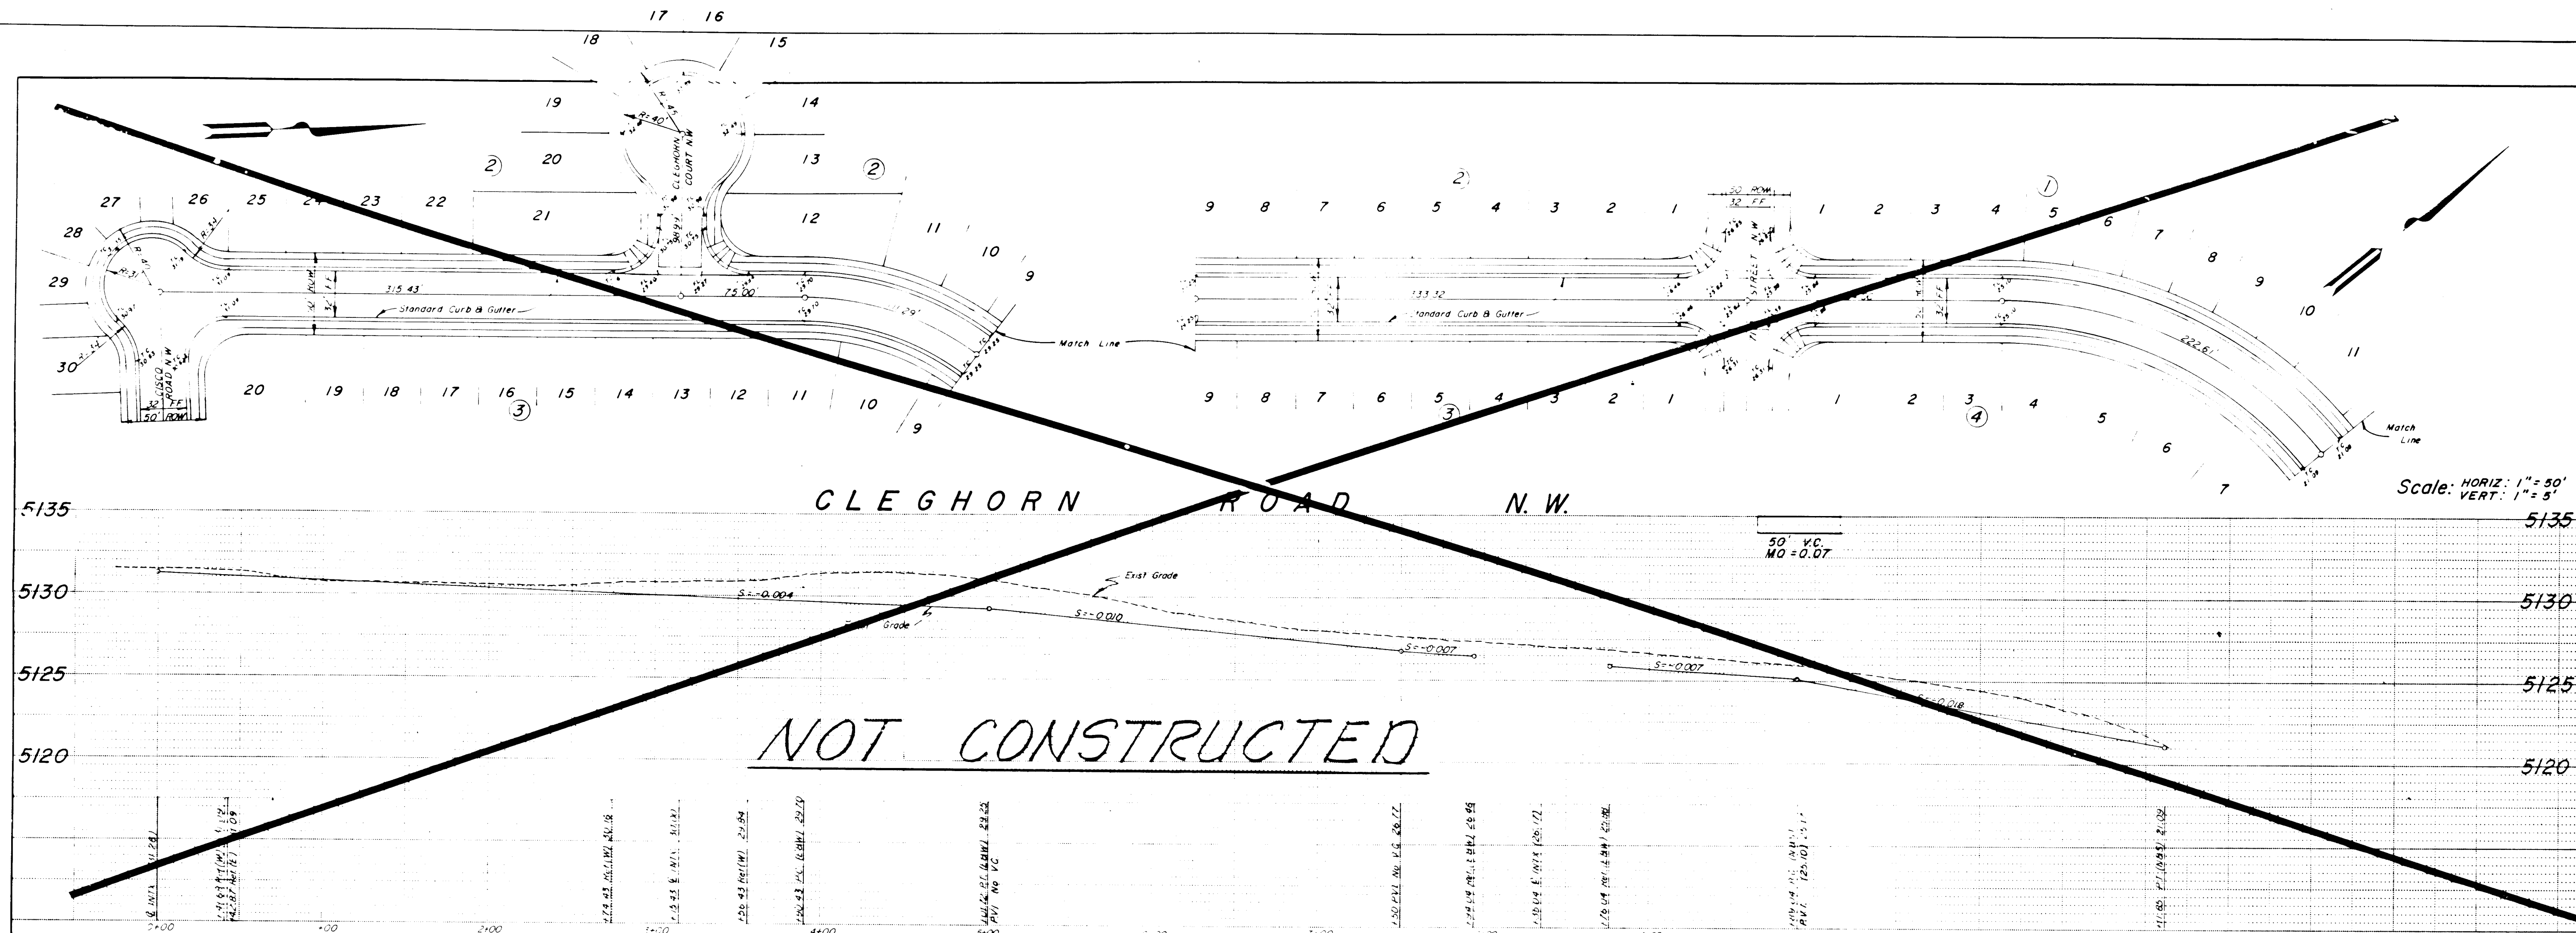

CITY OF ALBUQUERQUE MUNICIPAL DEVELOPMENT DEPARTMENT ENGINEERING DIVISION			
TITLE: - STREETS - KATHERINE - NICHOLE ADDITION			
APPROVALS	ENGINEER	DATE	APPROVALS
City Engineer	3/2/81	3/2/81	Liquid Waste
A.C.E.-Design			Traffic
A.C.E.-Hydrology			Water
DRAWING NO. 4063 1790		SHEET 8 OF 18	

AS BUILT INFORMATION		BENCH MARKS		SURVEY INFORMATION		REFERENCES	
CONTRACTOR	DATE	BRASS CAP	NO.	NO.	BY	MAP NO.	EST. NO.
INSPECTORS	DATE	NO.	DATE	NO.	DATE	NO.	DATE
FIELD	DATE	NO.	DATE	NO.	DATE	NO.	DATE
VERIFICATION BY	DATE	NO.	DATE	NO.	DATE	NO.	DATE
CORRECTED BY	DATE	NO.	DATE	NO.	DATE	NO.	DATE
MICRO-FILM INFORMATION		MICRO-FILM INFORMATION		MICRO-FILM INFORMATION		MICRO-FILM INFORMATION	
RECORDED BY	DATE	RECORDED BY	DATE	RECORDED BY	DATE	RECORDED BY	DATE

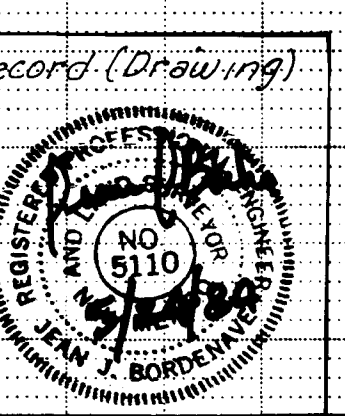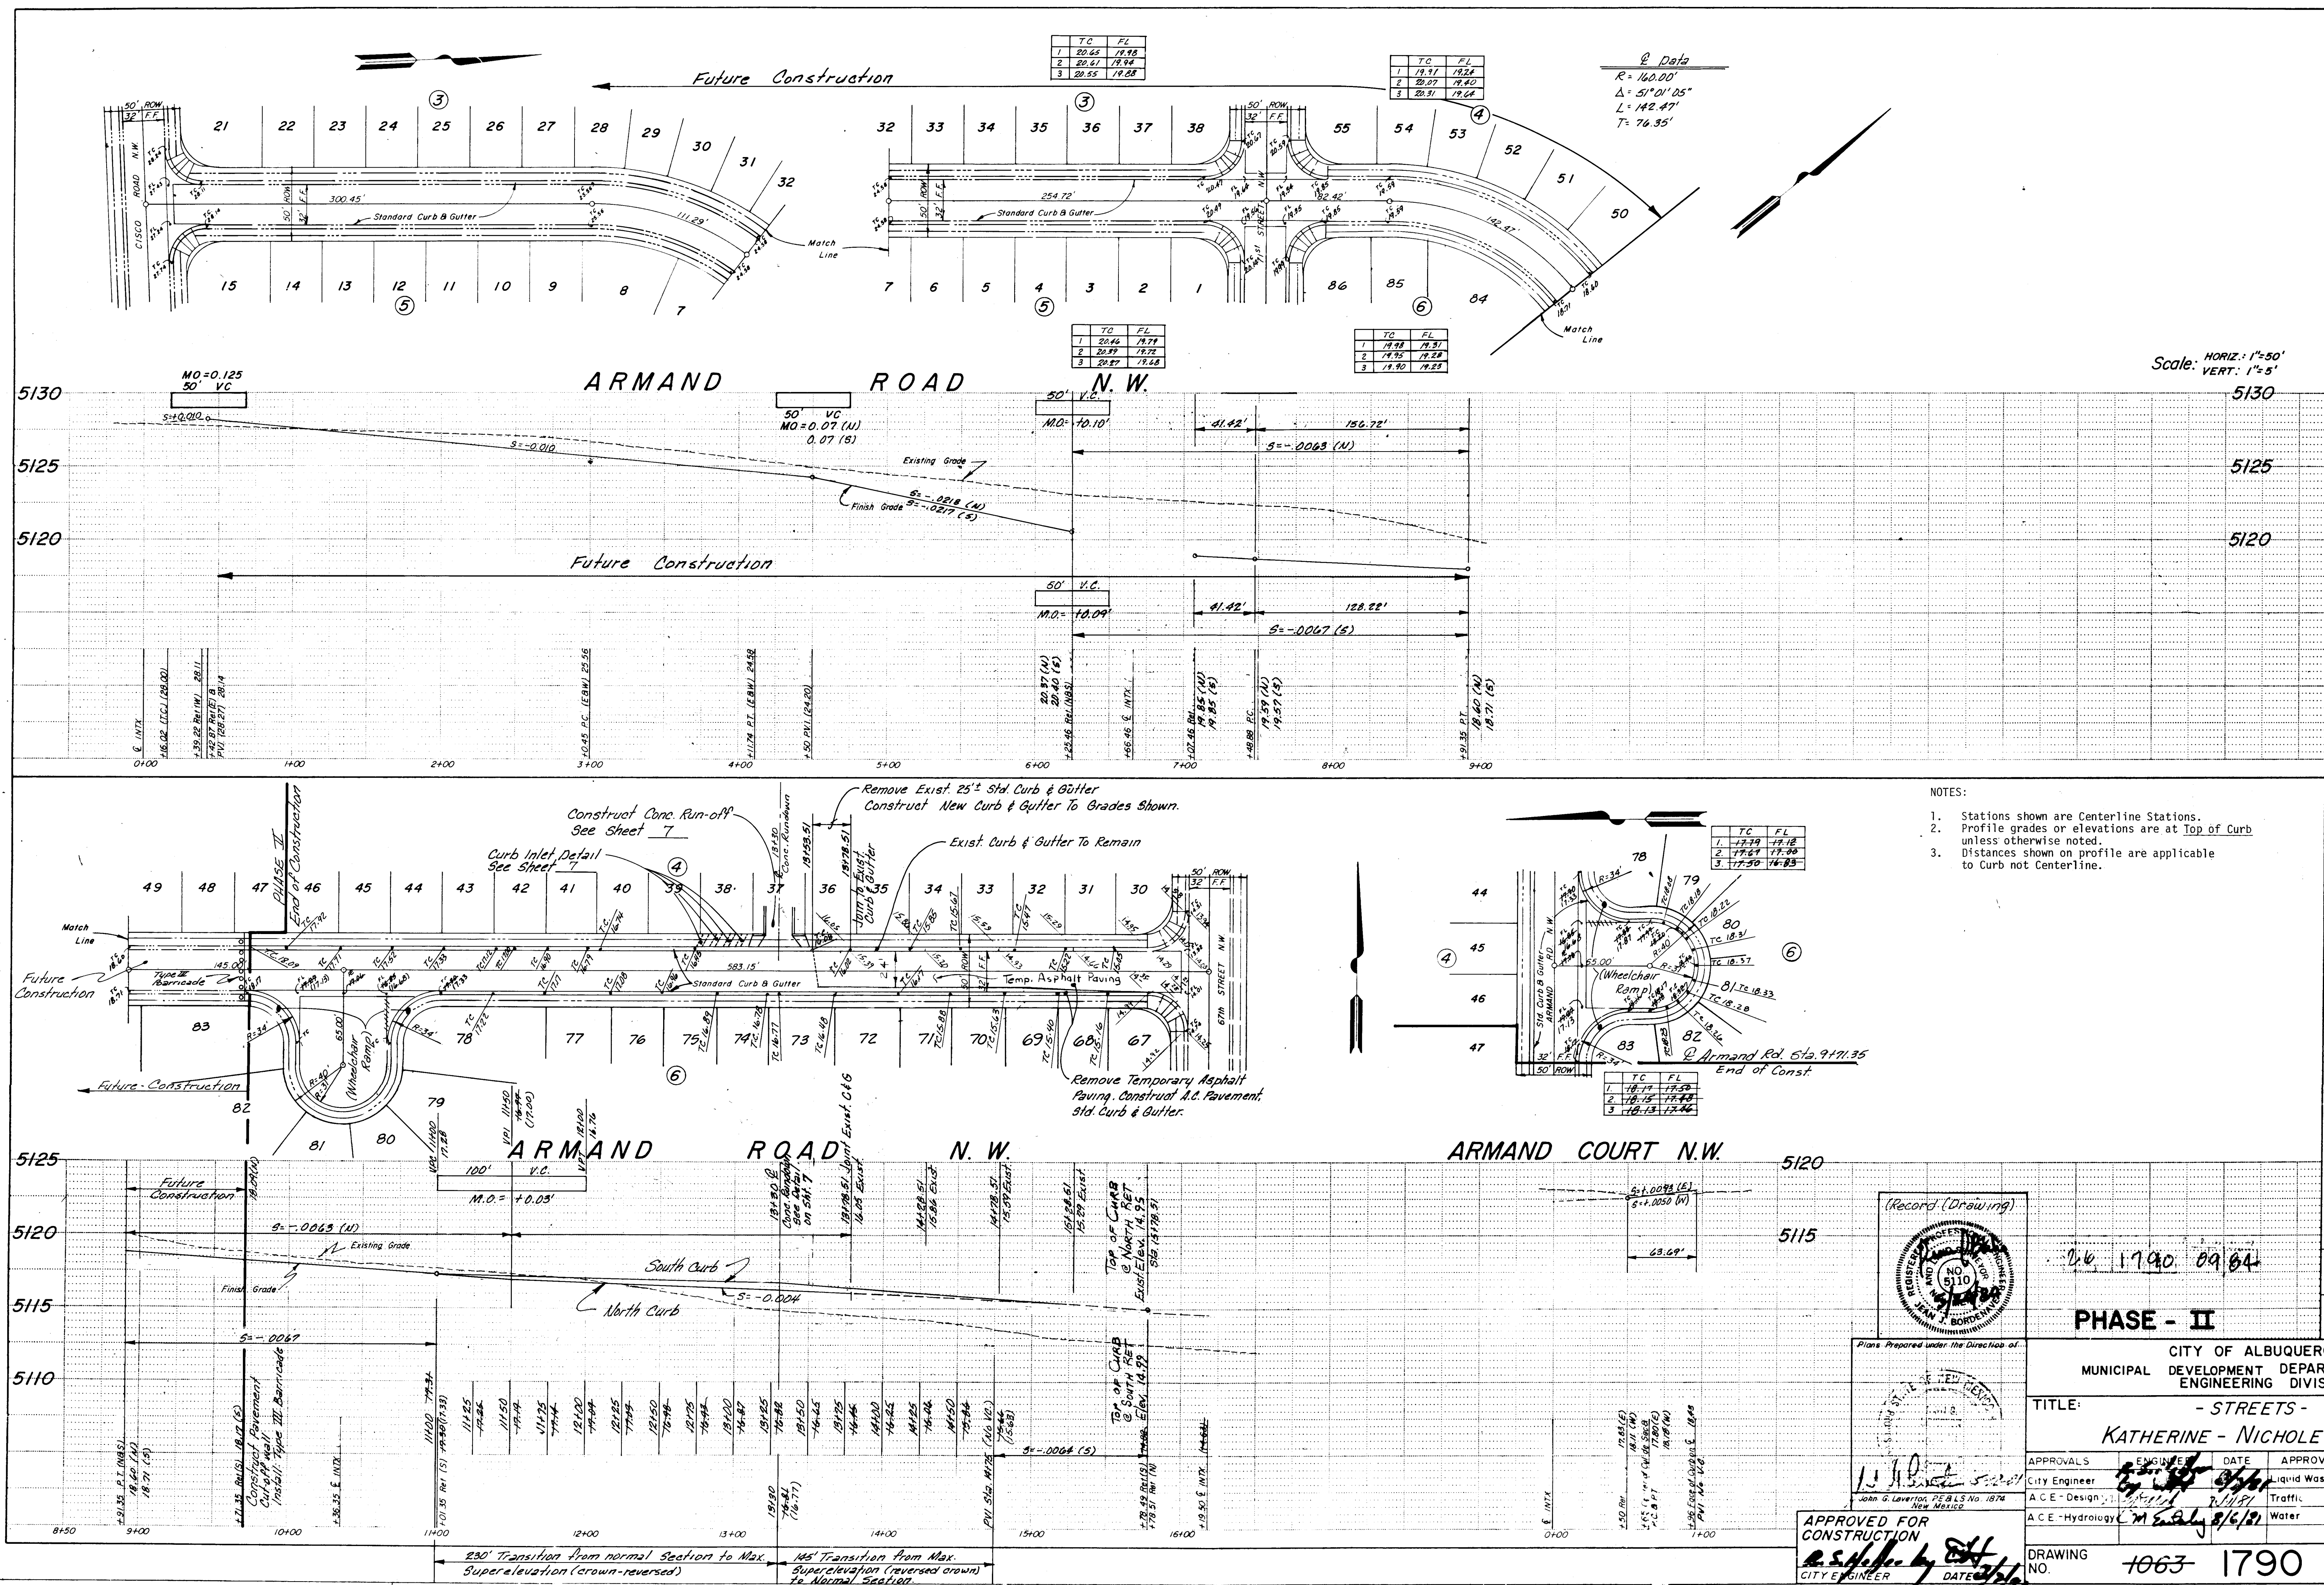

APPROVED FOR CONSTRUCTION
CITY ENGINEER
DATE 7/2/82

PHASE - II

26 1790 09 64

CITY OF ALBUQUERQUE
MUNICIPAL DEVELOPMENT DEPARTMENT
ENGINEERING DIVISION



TITLE: - STREETS -
KATHERINE - NICHOLE ADDITION

APPROVALS	ENGINEER	DATE	APPROVALS	ENGINEER	DATE
CITY ENGINEER	[Signature]	7/2/82	LIQUID WASTE	[Signature]	7/2/82
A.C.E. - Design	[Signature]	7/2/82	TRAFFIC	[Signature]	7/2/82
A.C.E. - Hydrology	[Signature]	7/2/82	WATER	[Signature]	7/2/82

DRAWING NO. 1063-1790 SHEET 9 OF 17

AS BUILT INFORMATION		BENCH MARKS		SURVEY INFORMATION		REFERENCES		REVISIONS	
CONTRACTOR	NO. 1063-1790	STATION	DATE	FIELD NOTES	DATE	MAP NO.	W.O. NO.	NO.	DATE
INSPECTOR	DATE 11/81	DATE	DATE	NO.	DATE	EST. NO.	BY	REMARKS	DATE
ACCEPTANCE BY	DATE 3/82	DATE	DATE	NO.	DATE	NO.	BY	DESIGN	DATE
VERIFICATION BY	DATE 3/82	DATE	DATE	NO.	DATE	NO.	BY	DESIGN	DATE
FORWARDED BY	DATE 1/82	DATE	DATE	NO.	DATE	NO.	BY	DESIGN	DATE
MICRO-FILM INFORMATION		RECORDED BY		DATE		DATE		DATE	

0571

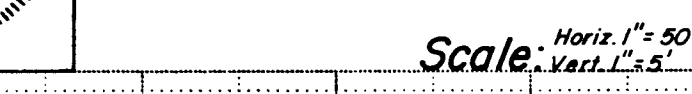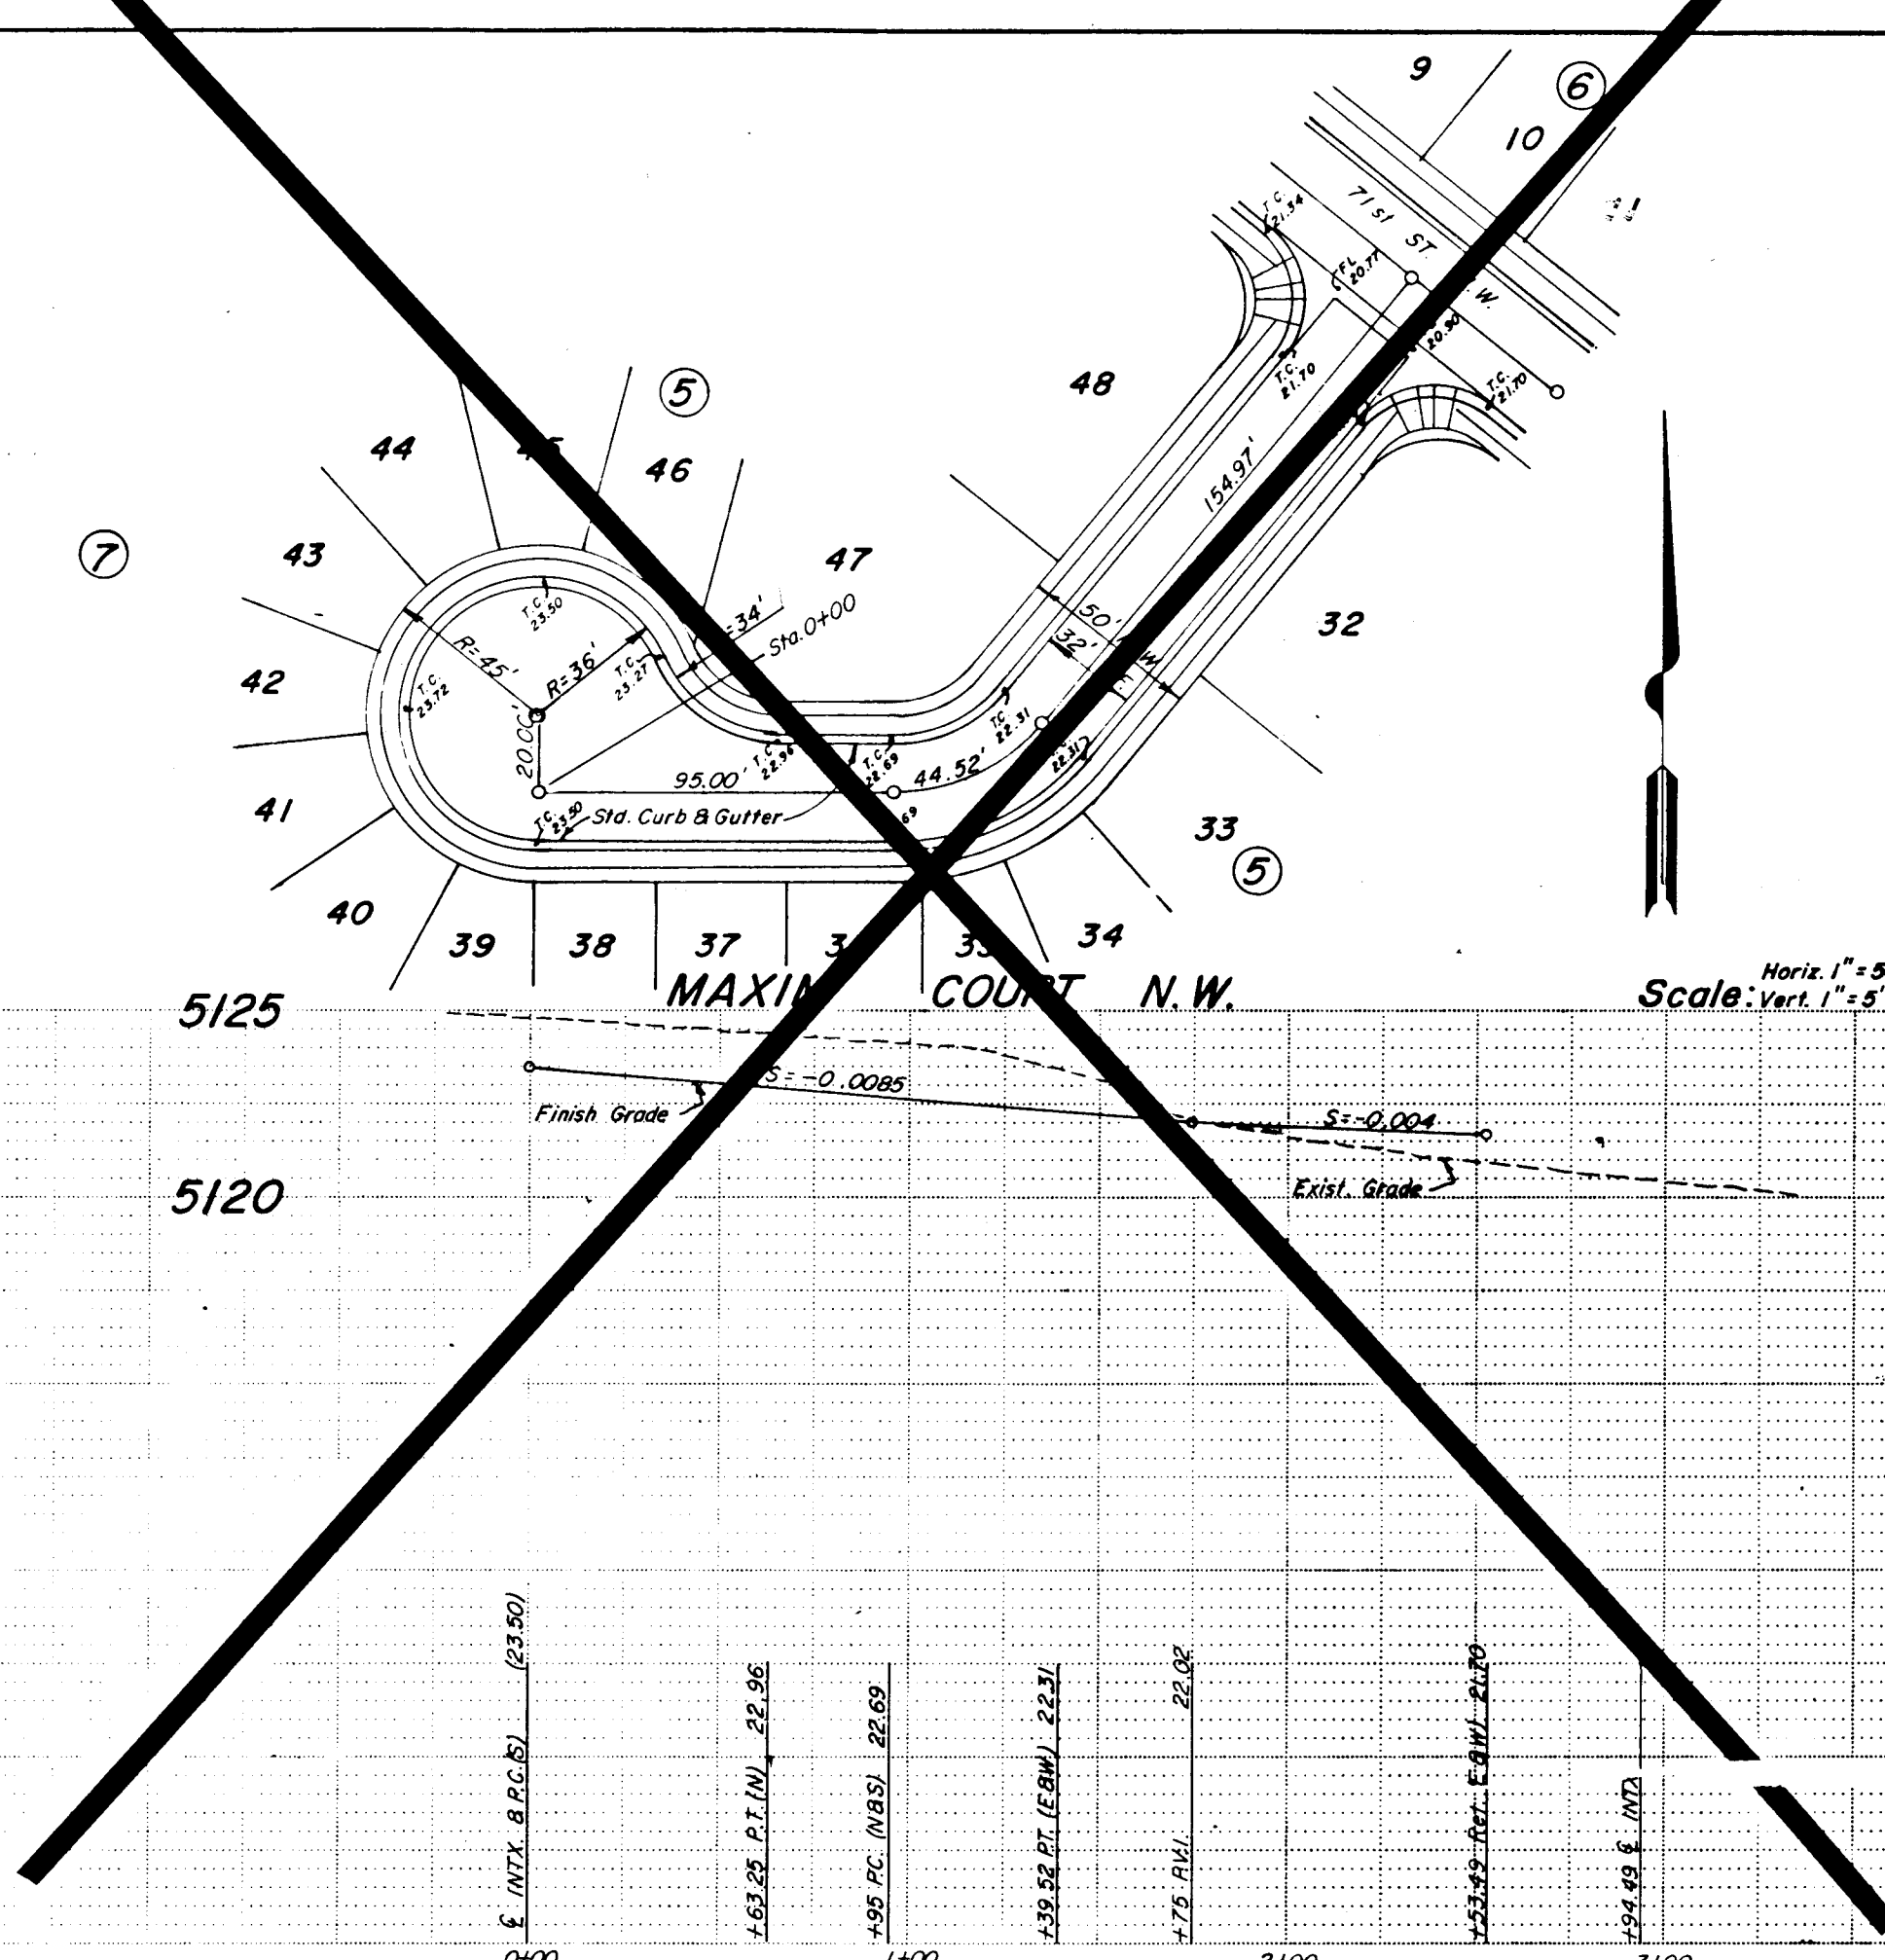

PHASE - II

TITLE: *Streets*
KATHERINE — NICHOLE ADDITION

APPROVALS	ENGINEER	DATE	APPROVALS	ENGINEER	DATE
City Engineer	<i>[Signature]</i>	3/6/81	Liquid Waste	<i>[Signature]</i>	6/30/81
A.C.E. - Design	<i>[Signature]</i>	7/5/81	Traffic	<i>[Signature]</i>	7/5/81
A.C.E. - Hydrology	<i>[Signature]</i>	8/6/81	Water	<i>[Signature]</i>	8/30/81

DRAWING NO. ~~1063~~ 1790 SHEET 10 OF 17


INFORMATION		BENCH MARKS		AS BUILT INFORMATION	
FIELD NOTES		Bench Cap - Sec. 34, T.11 N., R. 2 E. and Sec. 3, T. 10 N., R. 2 E. - Elev 5113.61		CONTRACTOR <i>Kent Nowlin Const Co.</i>	
DATE	BY	WORK STATED BY	DATE	WORK STATED BY	DATE
	ation Engineering	FIELD		ACCEPTANCE BY <i>A.H.A.</i>	DATE <i>3/82</i>
		VERIFICATION BY <i>A.H.A.</i>		DATE <i>3/82</i>	
		CORRECTED BY		DATE <i>1/82</i>	
		MICRO-FILM INFORMATION			
		RECORDED BY		DATE	
		NO.			

	REFERENCES	SURVE
MAP NO.	F-10 # G-10	
EST. NO.	WO. NO.	NO.
		Let



[illegible]

REQUEST PARTMENT ISON		
ADDITION		
NOVALS	ENGINEER	DATE
Waste	<i>[Signature]</i>	6/30
	<i>[Signature]</i>	7/2/81
	<i>[Signature]</i>	6/30
SHEET	10 OF	17

06/1

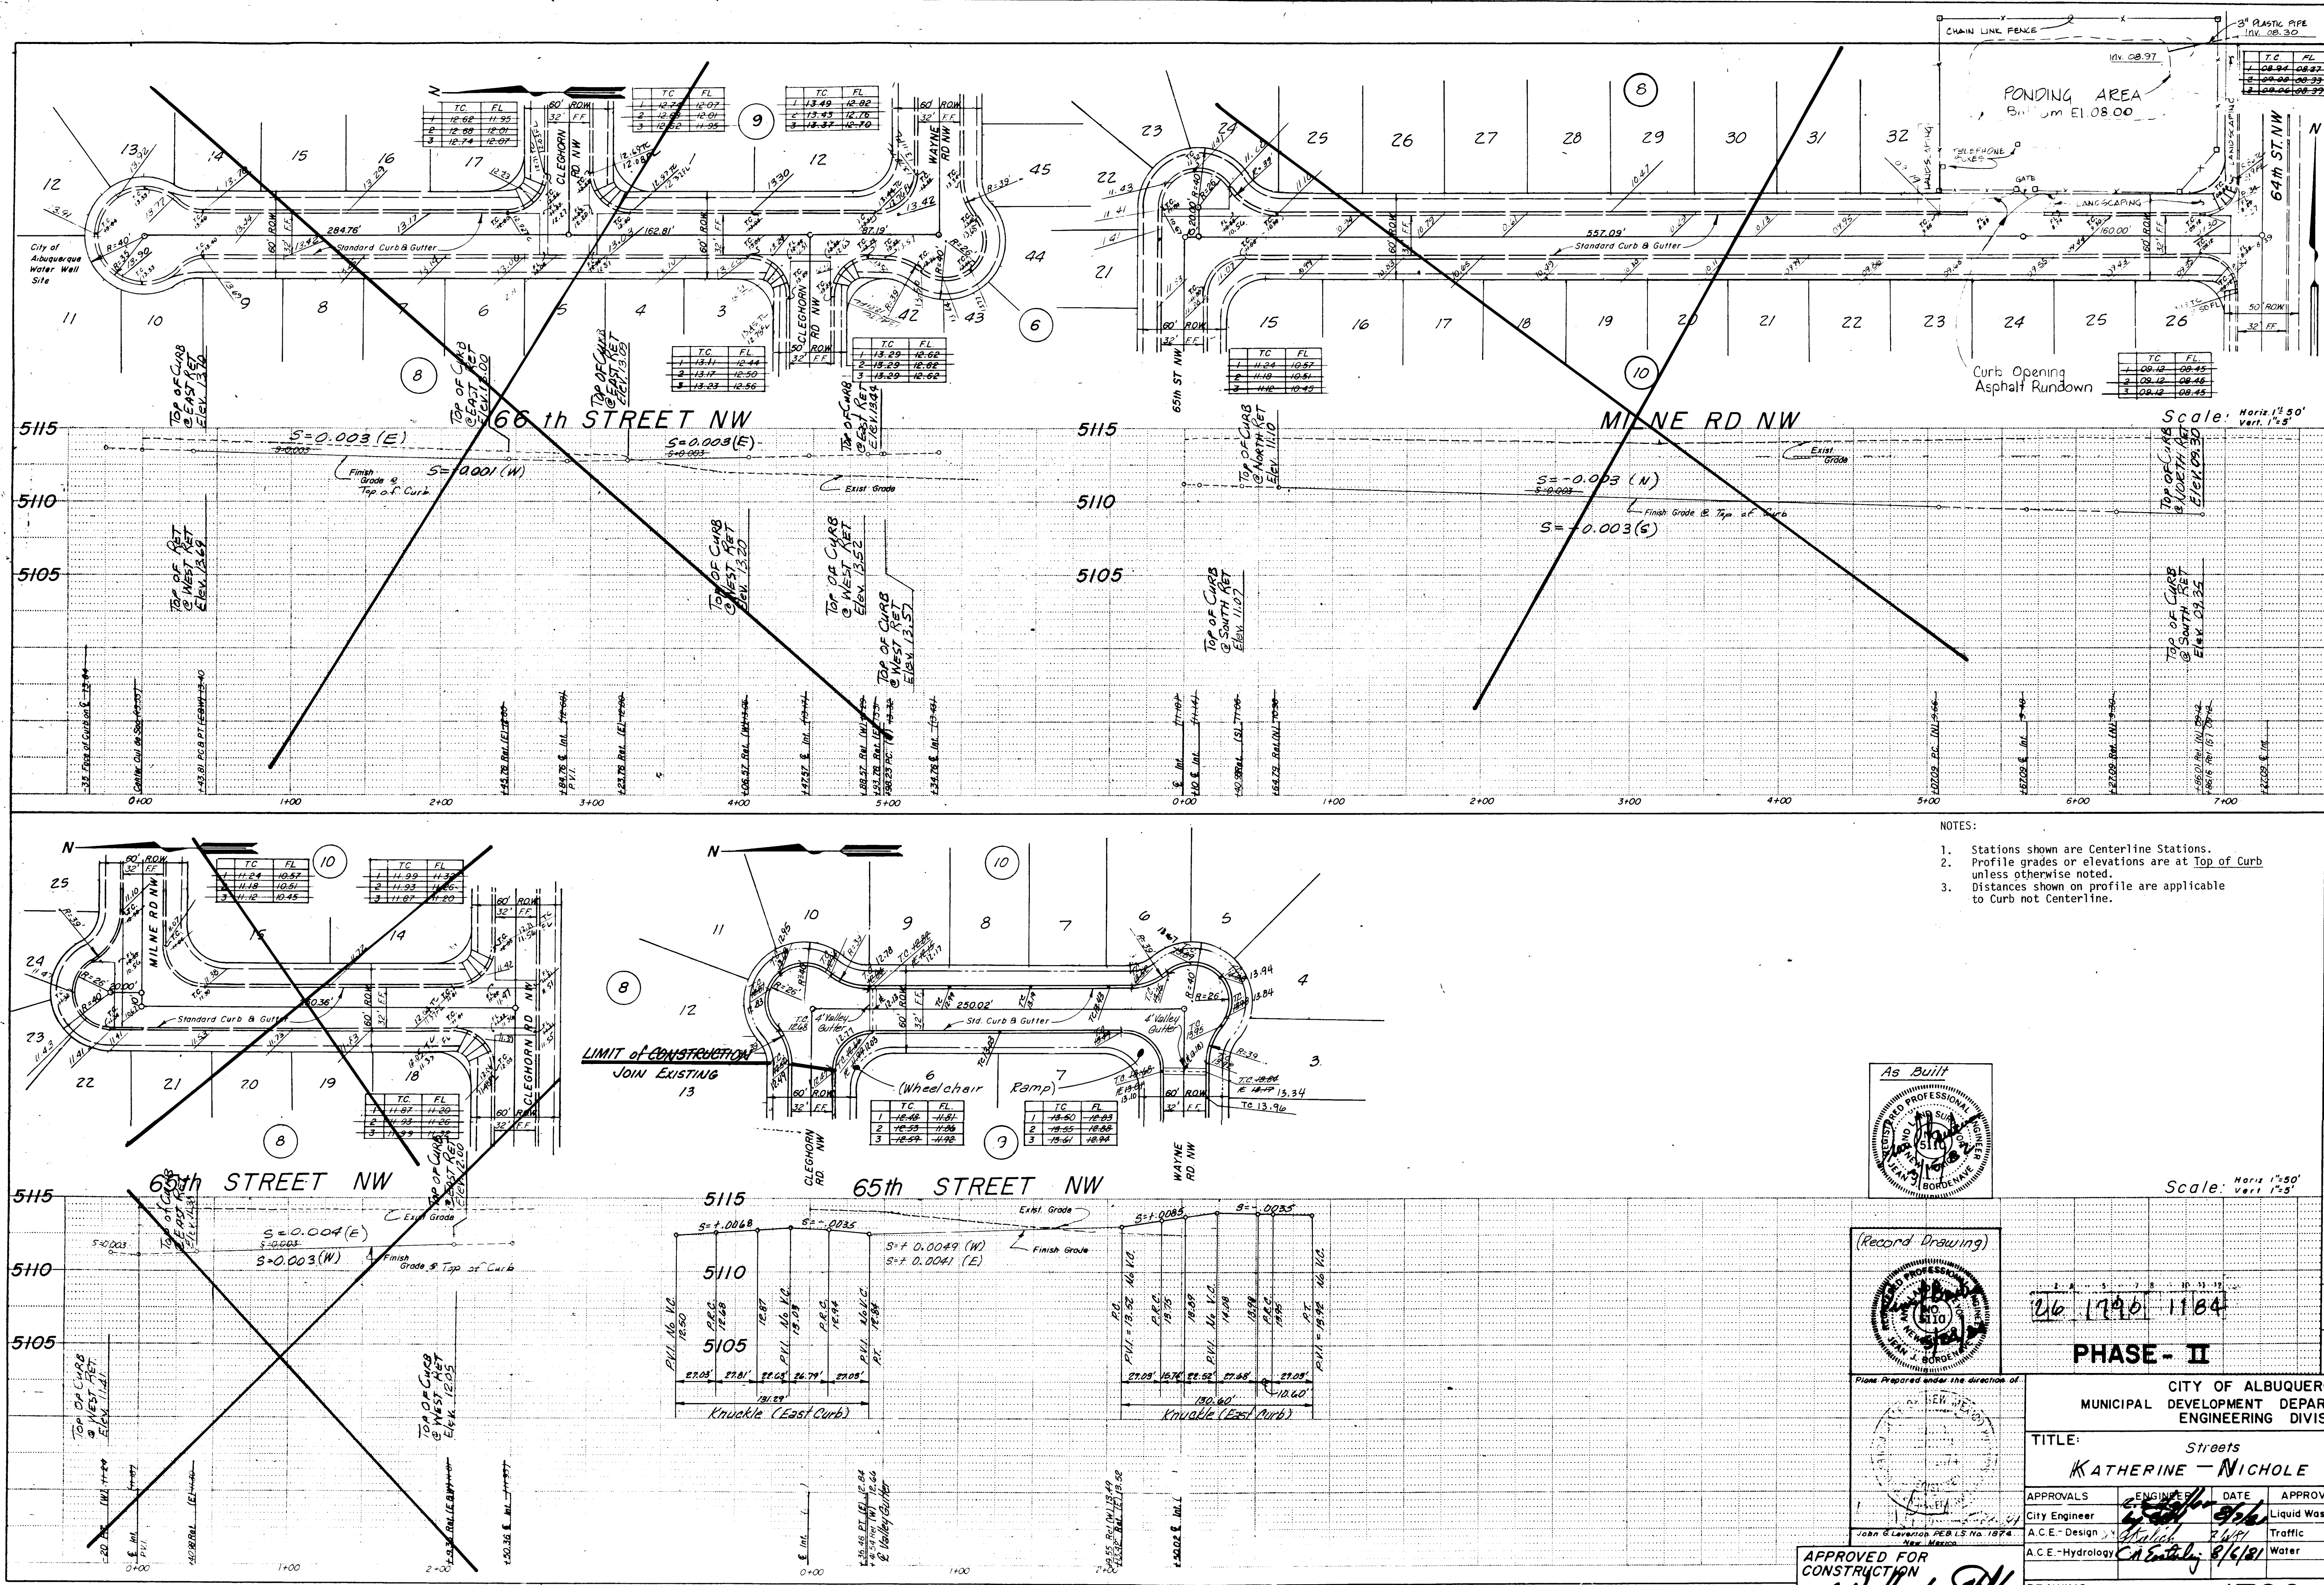

- NOTES:
1. Stations shown are Centerline Stations.
 2. Profile grades or elevations are at Top of Curb unless otherwise noted.
 3. Distances shown on profile are applicable to Curb not Centerline.

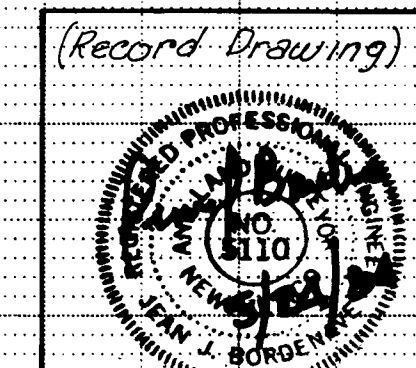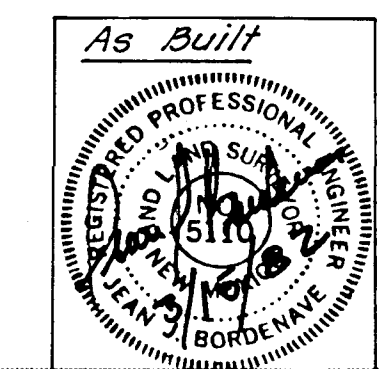

APPROVED FOR CONSTRUCTION
CITY ENGINEER
DATE 7/1/81

Scale: Horiz 1"=50' Vert 1"=5'

PHASE - II

26 1790 1184



CITY OF ALBUQUERQUE
MUNICIPAL DEVELOPMENT DEPARTMENT
ENGINEERING DIVISION

TITLE: Katherine - Nichole Addition


APPROVALS	ENGINEER	DATE	APPROVALS	ENGINEER	DATE
City Engineer	John A. Leaverton	7/1/81	Liquid Waste	John A. Leaverton	7/1/81
A.C.E. - Design	John A. Leaverton	7/1/81	Traffic	John A. Leaverton	7/1/81
A.C.E. - Hydrology	John A. Leaverton	7/1/81	Water	John A. Leaverton	7/1/81

DRAWING NO. 1063-1790 SHEET 11 OF 17

AS BUILT INFORMATION		BENCH MARKS		SURVEY INFORMATION		REFERENCES		REVISIONS		DESIGN	
CONTRACTOR	Kenner Construction Co.	STAKED BY	A.H.A.	DATE	11/81	MAP NO.	F-10 & G-10	NO.	DATE	DESIGNED BY	Leaverton Engineering
INSPECTORS	A.H.A.	ACCEPTANCE BY	A.H.A.	DATE	3/82	EST. NO.		BY	DATE	CHECKED BY	
VERIFICATION BY	A.H.A.	DATE	3/82								
FORWARDED BY	A.H.A.	DATE	1/82								
MICRO-FILM INFORMATION		RECORDED BY		DATE							

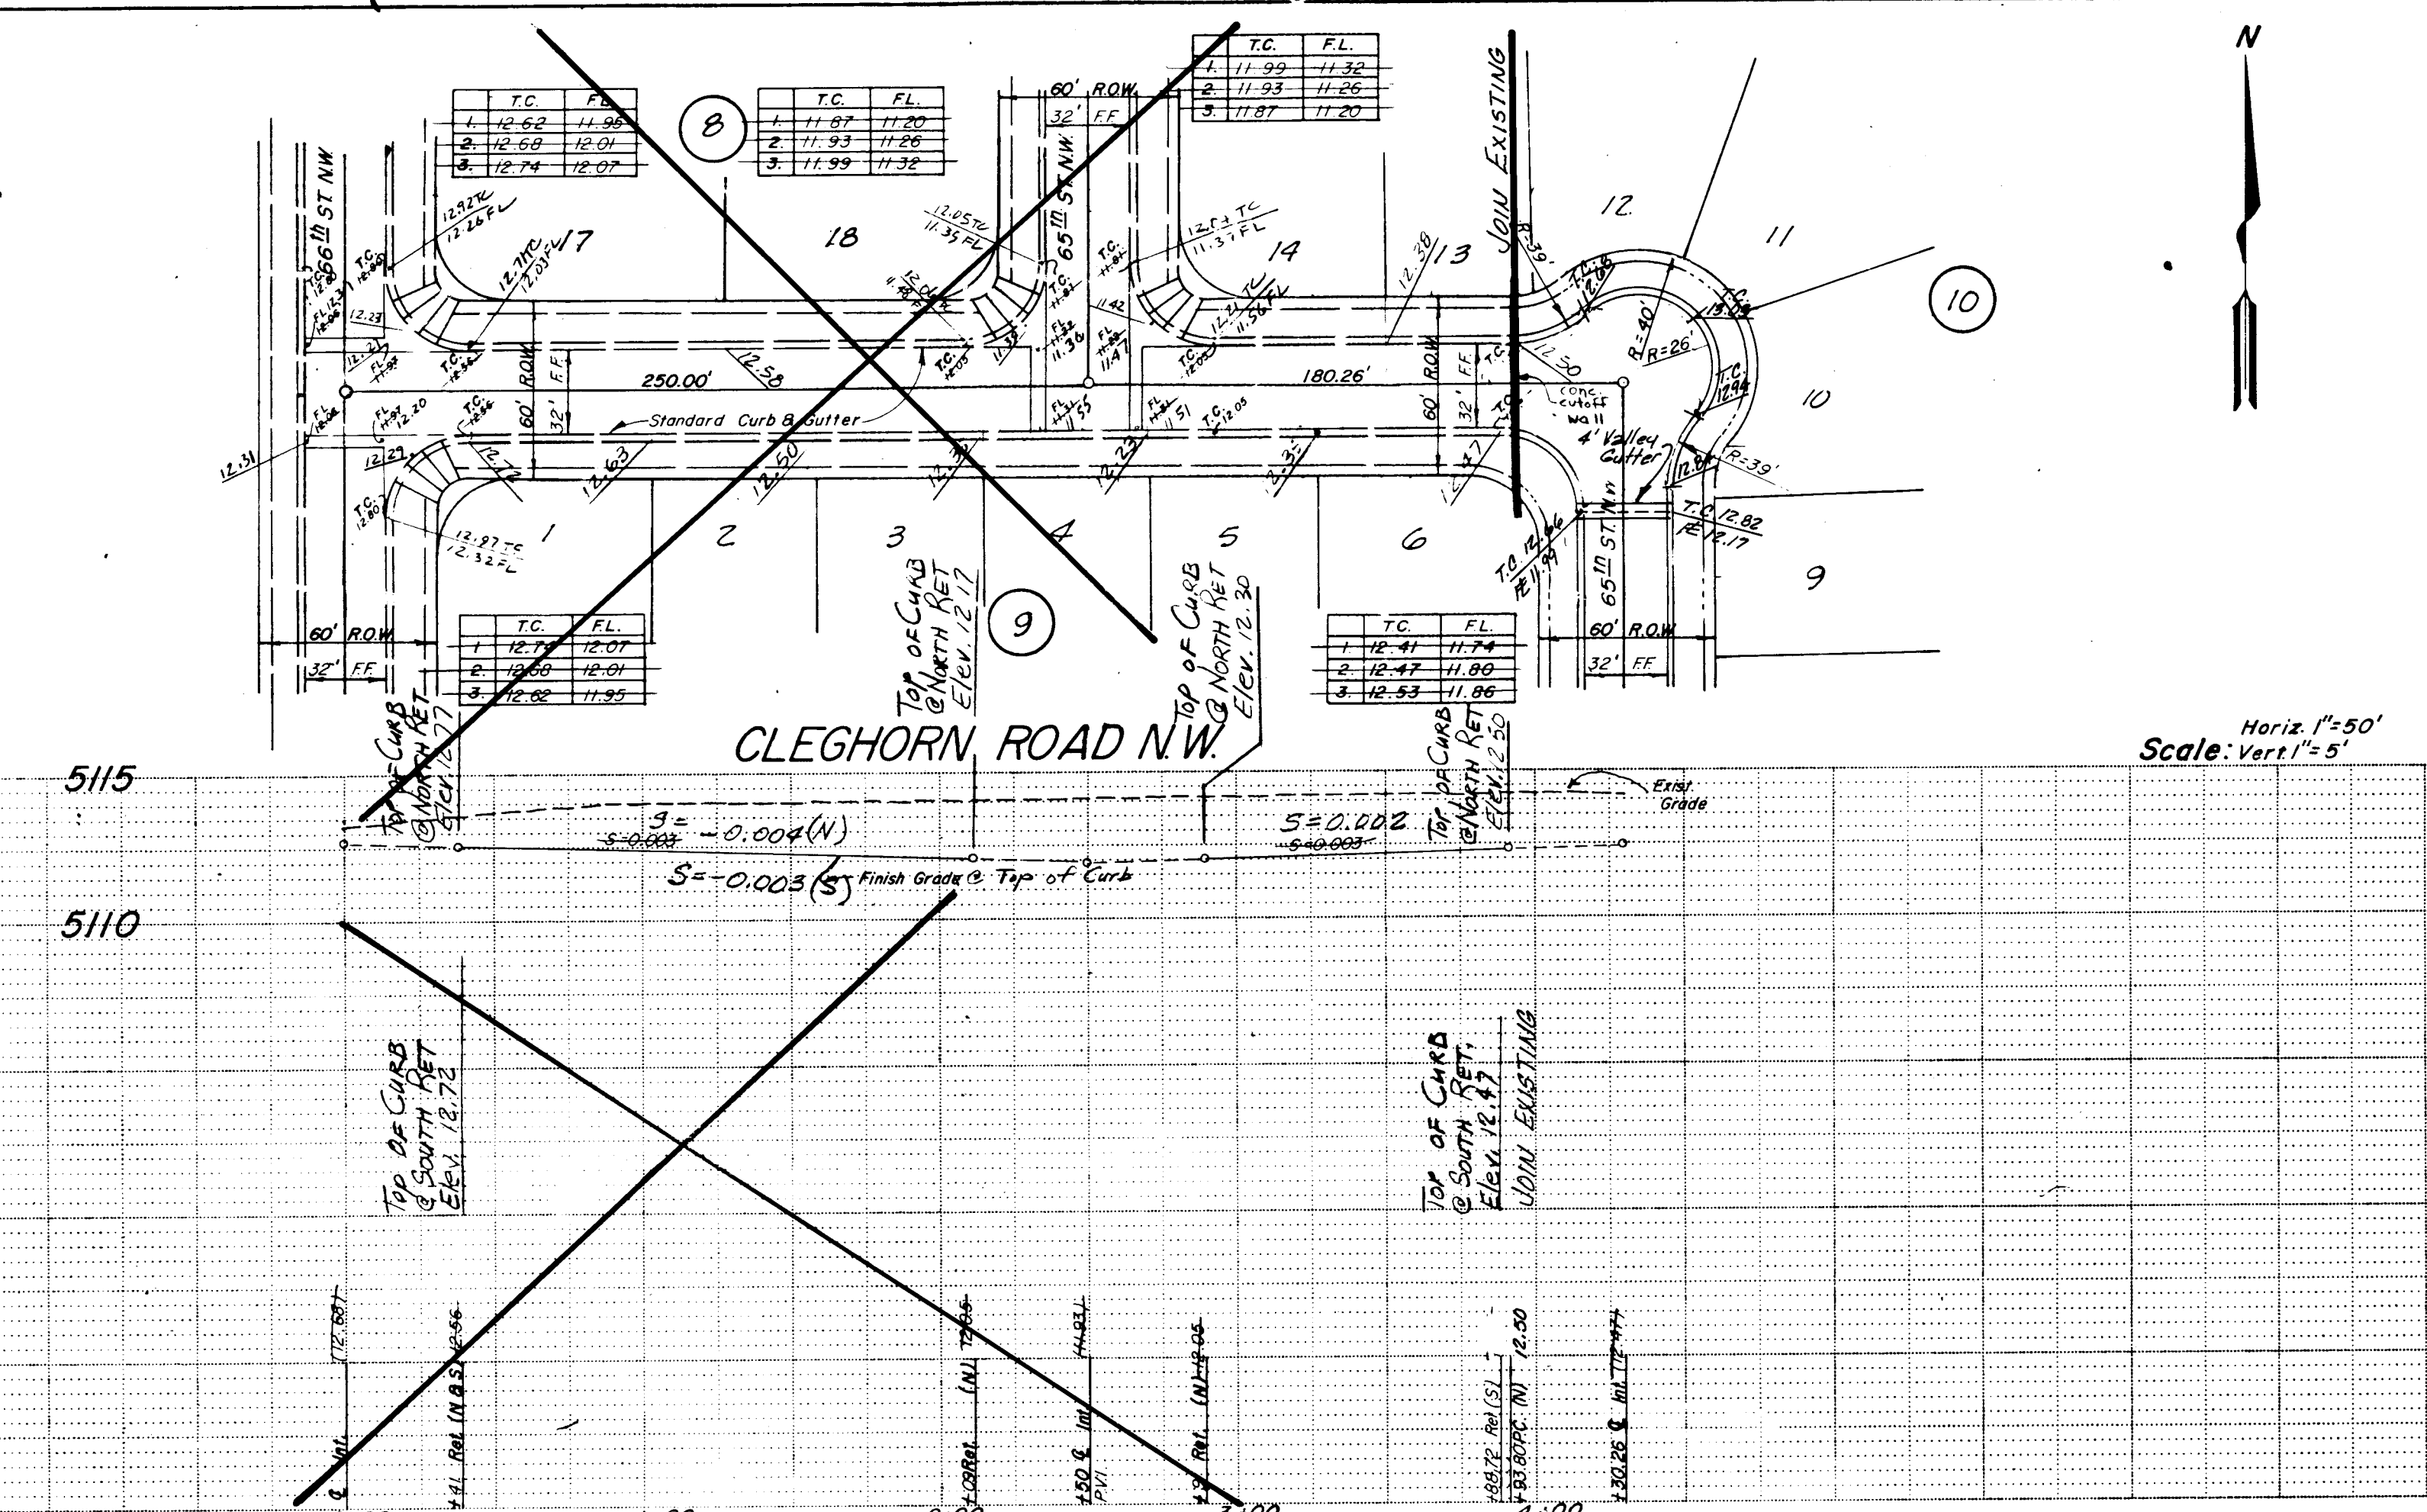
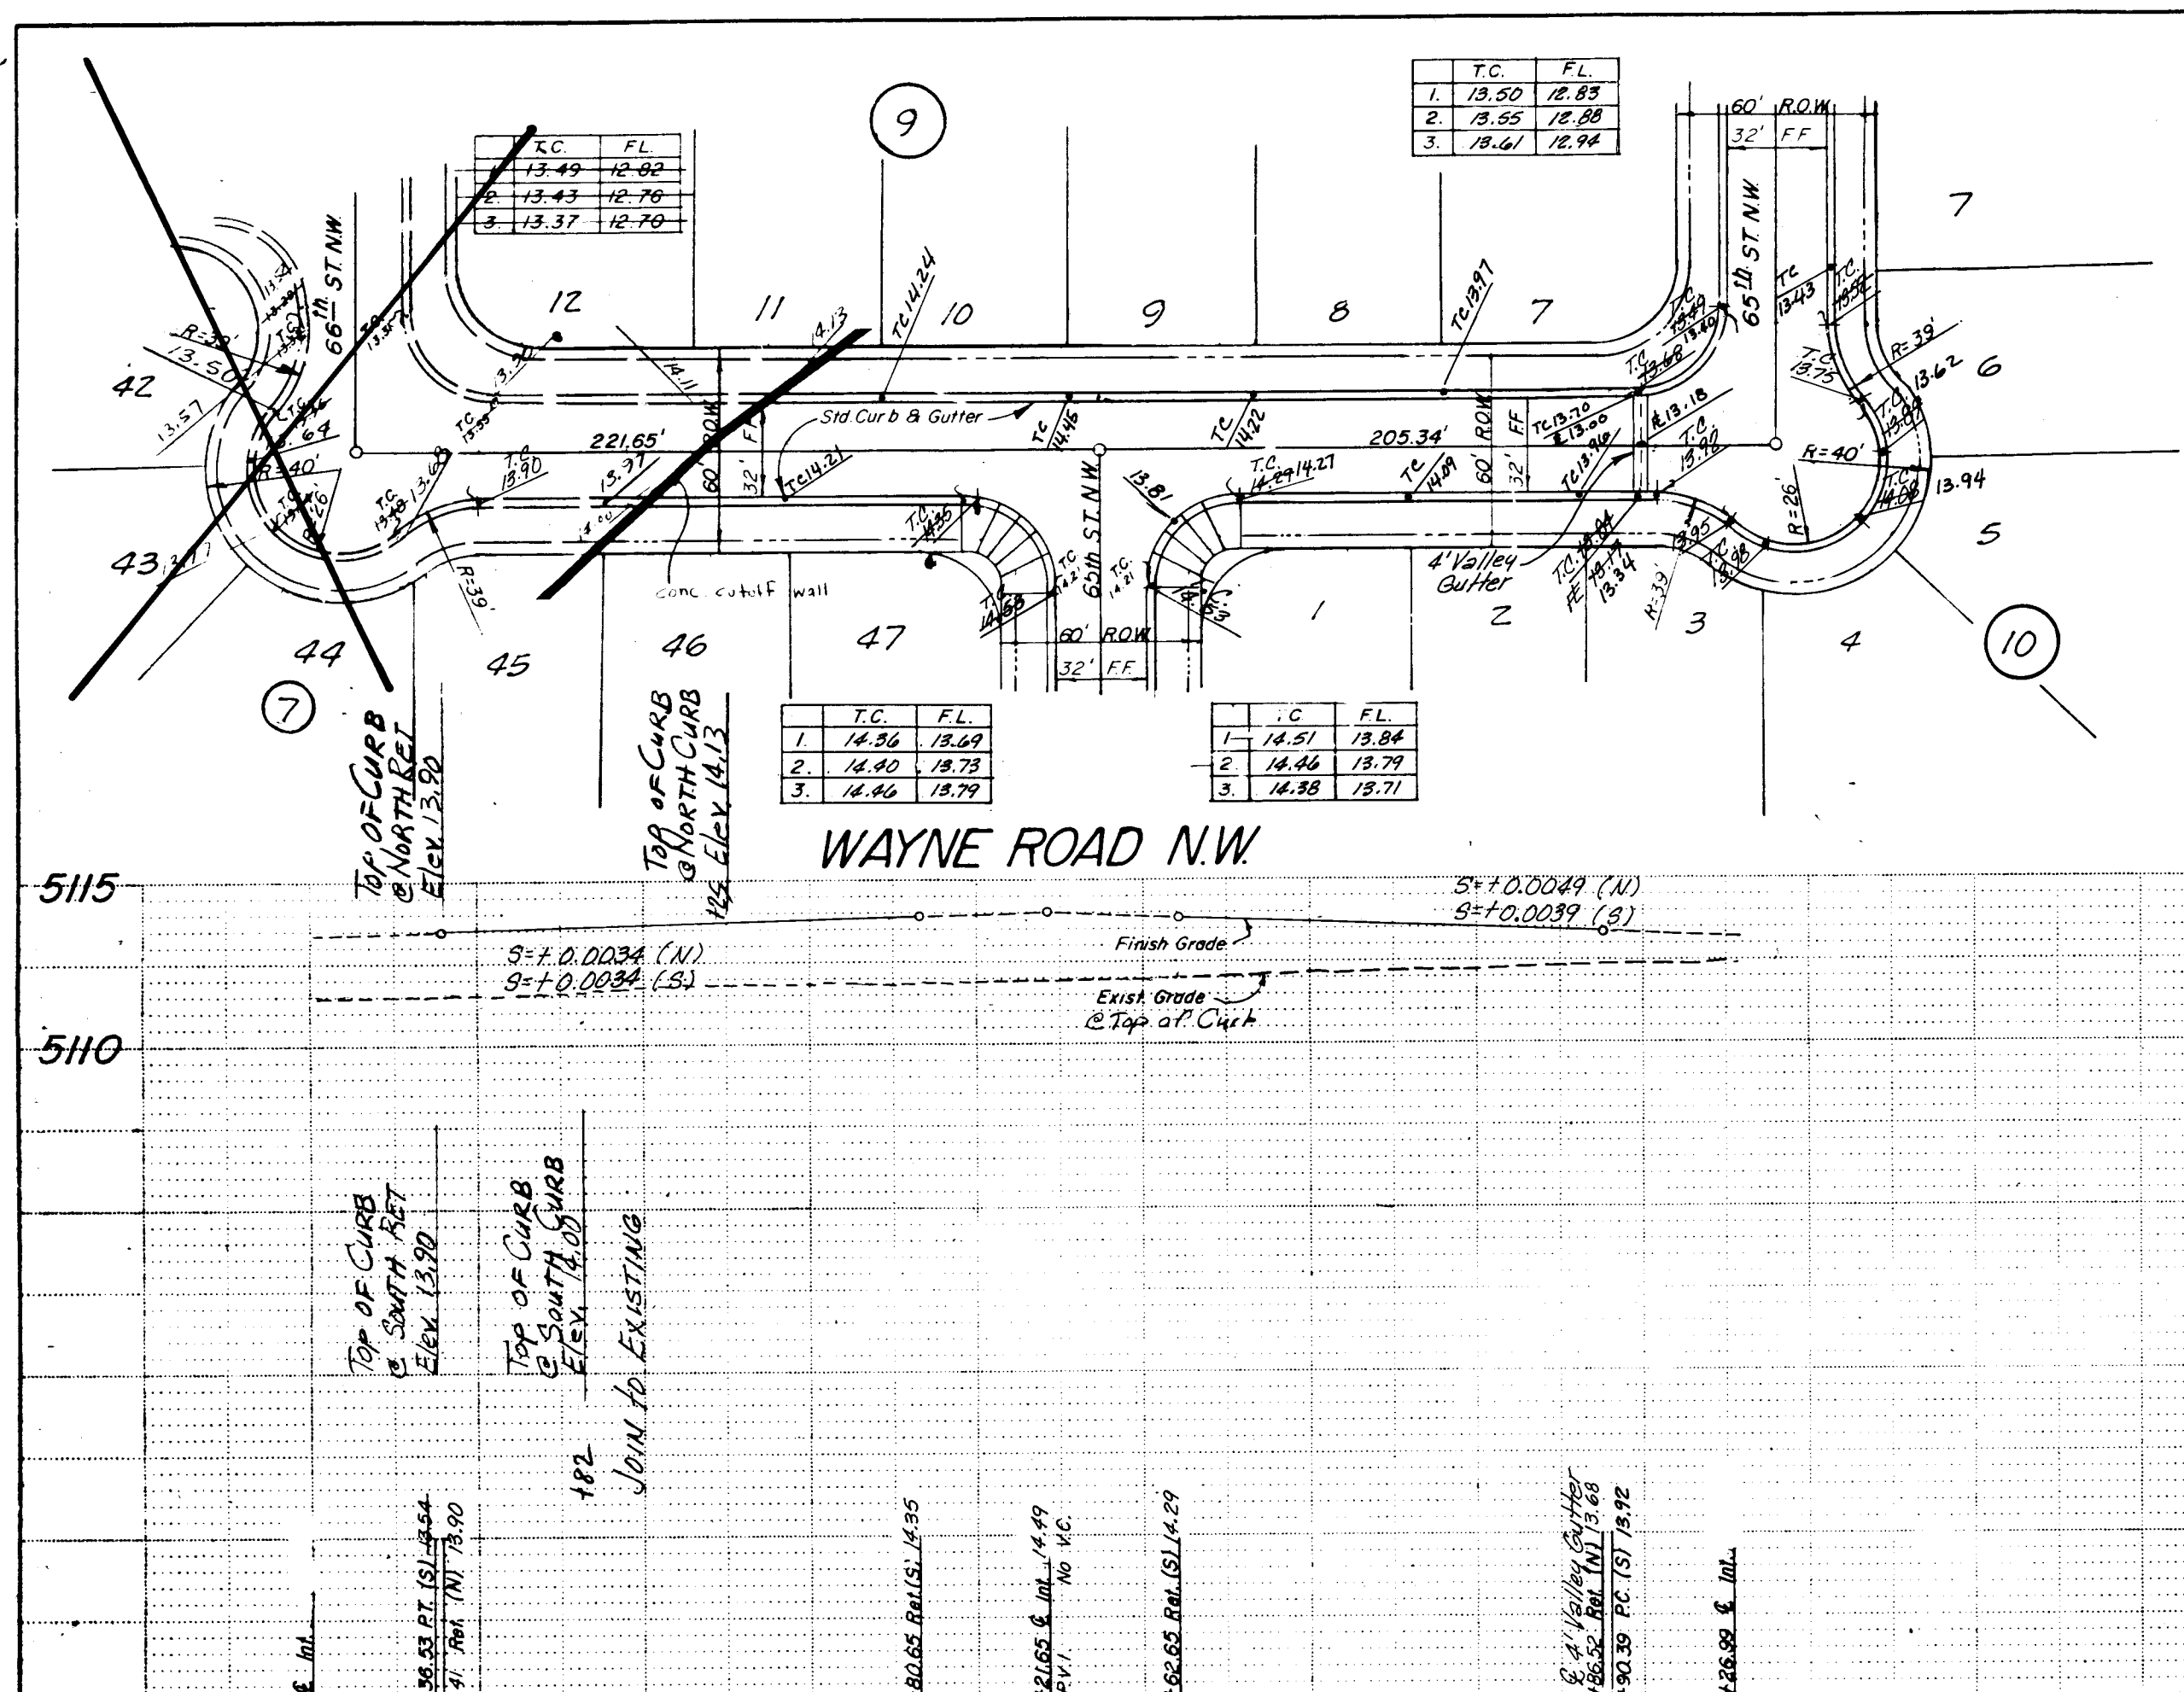


Scale: Horiz 1"=50'
Vert 1"=5'

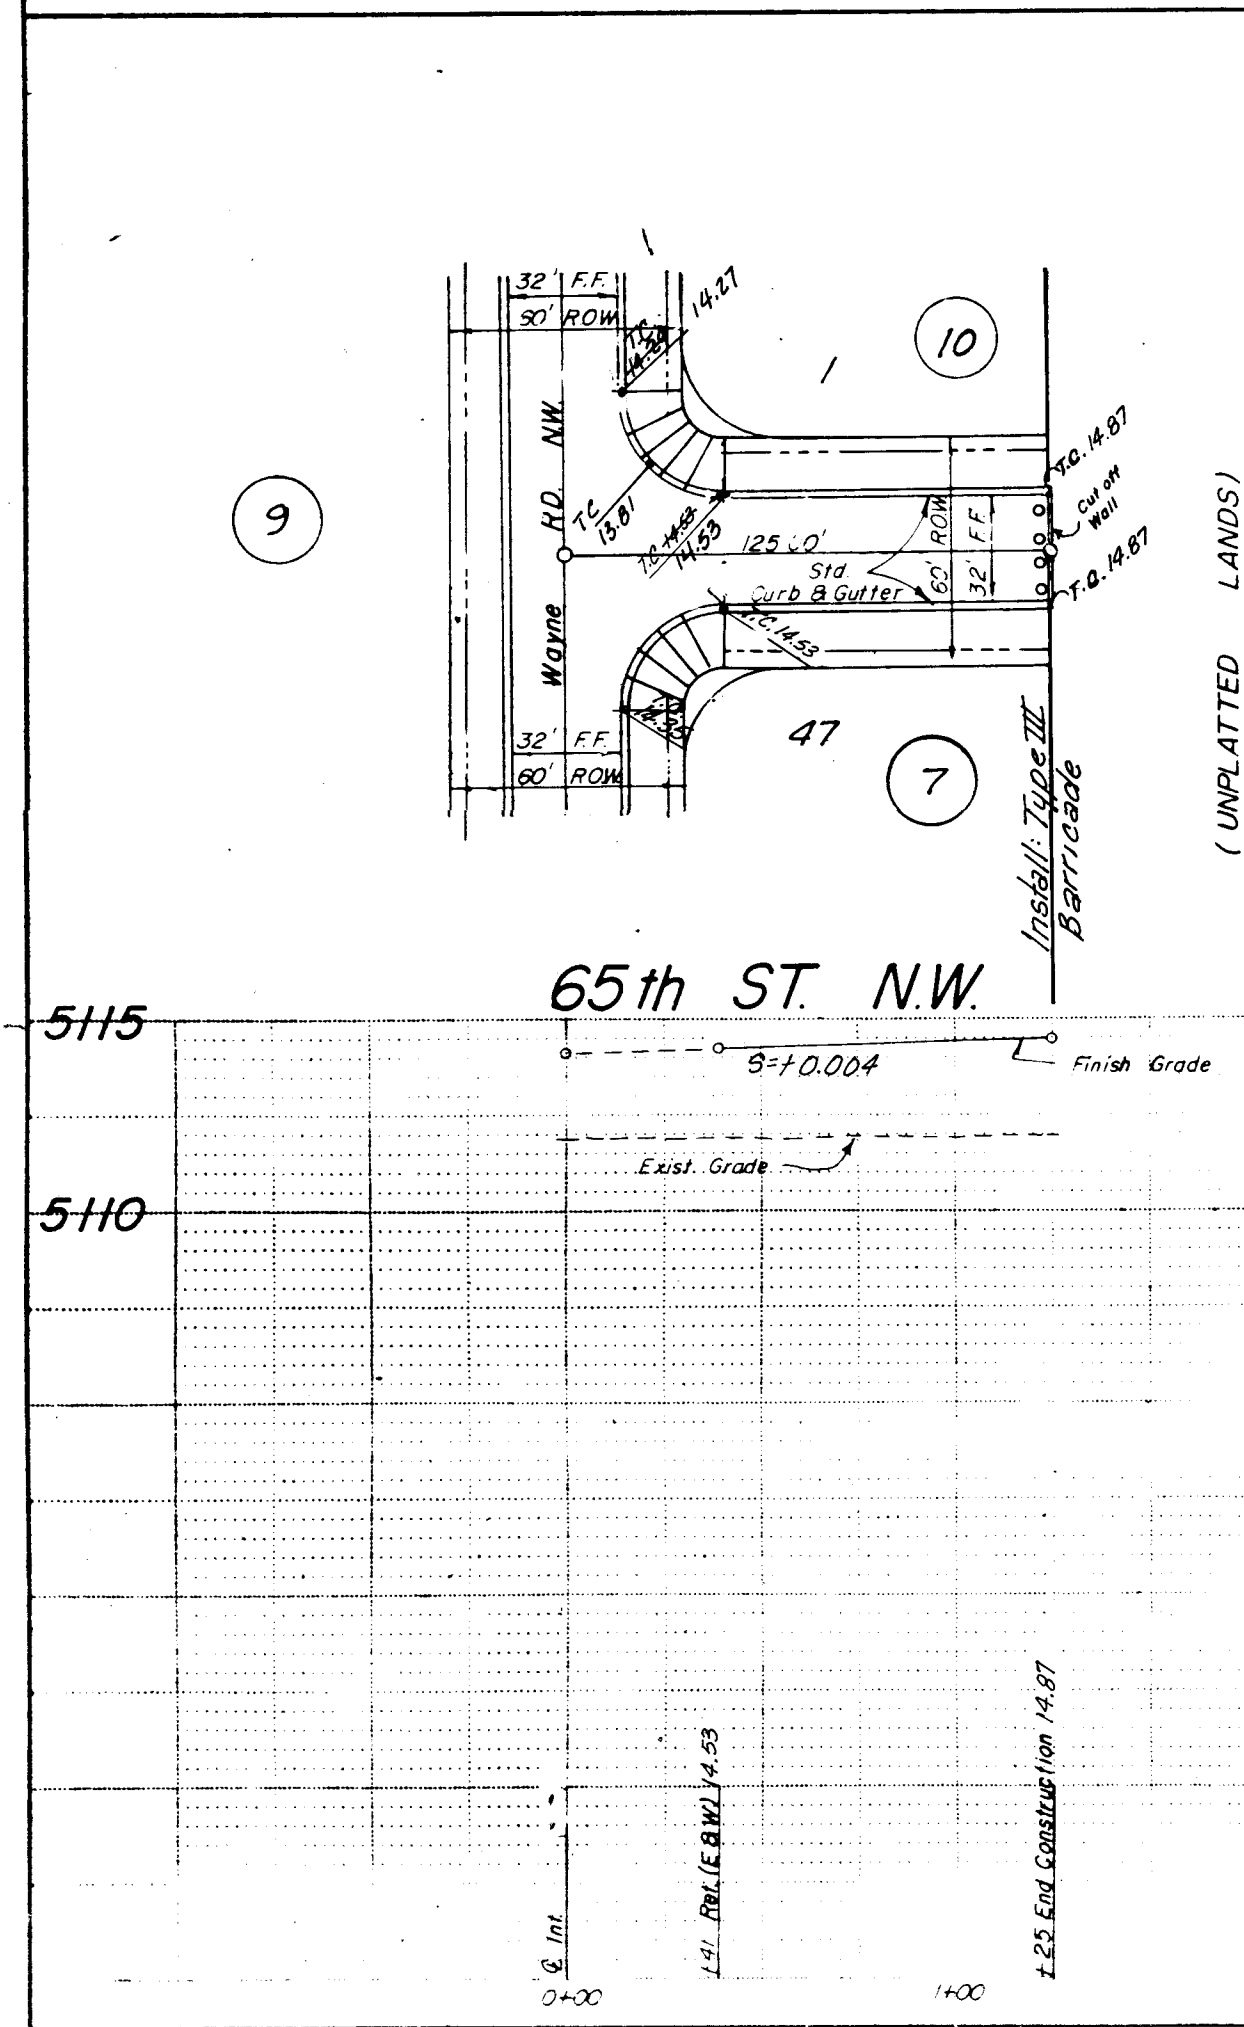

(UNPLATTED LANDS)

- NOTES:
- Stations shown are Centerline Stations.
 - Profile grades or elevations are at Top of Curb unless otherwise noted.
 - Distances shown on profile are applicable to Curb not Centerline.

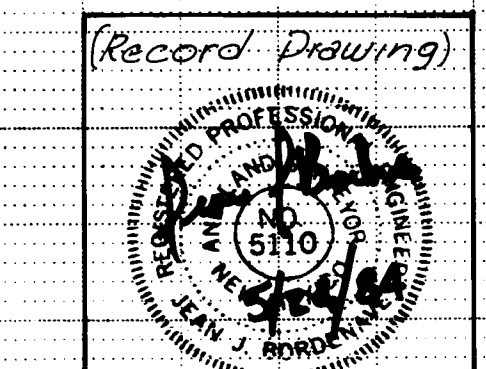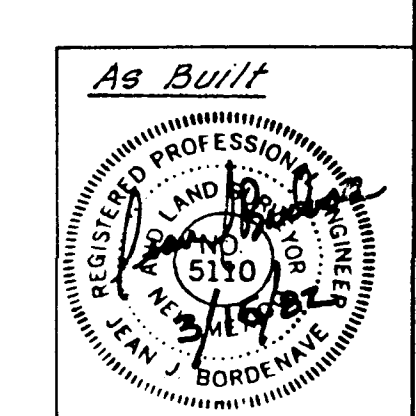

1790 12/28/11




PHASE - II

APPROVED FOR CONSTRUCTION
CITY ENGINEER
DATE 5/1/12

CITY OF ALBUQUERQUE MUNICIPAL DEVELOPMENT DEPARTMENT ENGINEERING DIVISION					
TITLE: Streets KATHERINE - NICHOLE ADDITION					
APPROVALS	ENGINEER	DATE	APPROVALS	ENGINEER	DATE
City Engineer	John J. Bordenave	5/1/12	Liquid Waste	John J. Bordenave	5/1/12
A.C.E. - Design	John J. Bordenave	5/1/12	Traffic	John J. Bordenave	5/1/12
A.C.E. - Hydrology	John J. Bordenave	5/1/12	Water	John J. Bordenave	5/1/12
DRAWING NO. 1063-1790			SHEET 12 OF 17		



SURVEY INFORMATION		BENCH MARKS		AS BUILT INFORMATION	
MAP NO.	EST. NO.	FIELD NOTES	DATE	CONTRACTOR	DATE
F-10 & B-10		NO.	BY	Kent Namur Corp. Co.	11/01
		NO.	BY	ACCEPTANCE BY	DATE
		NO.	BY	FIELD VERIFICATION BY	DATE
		NO.	BY	CORRECTED BY	DATE
		NO.	BY	MICRO-FILM INFORMATION	DATE
		NO.	BY	RECORDED BY	DATE
		NO.	BY		DATE

65th

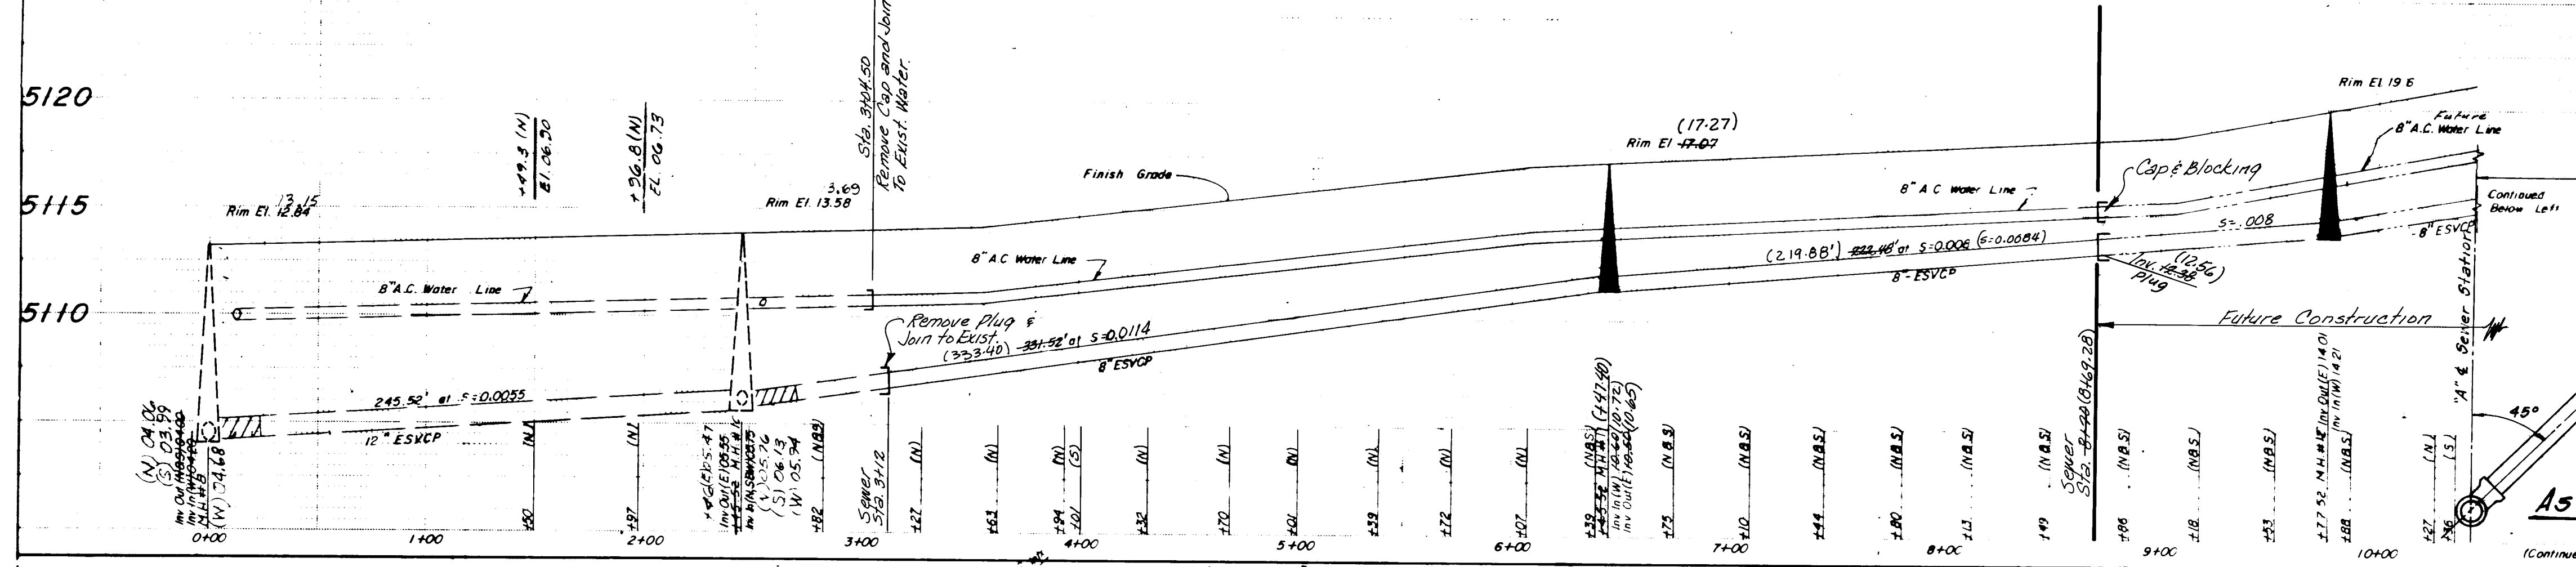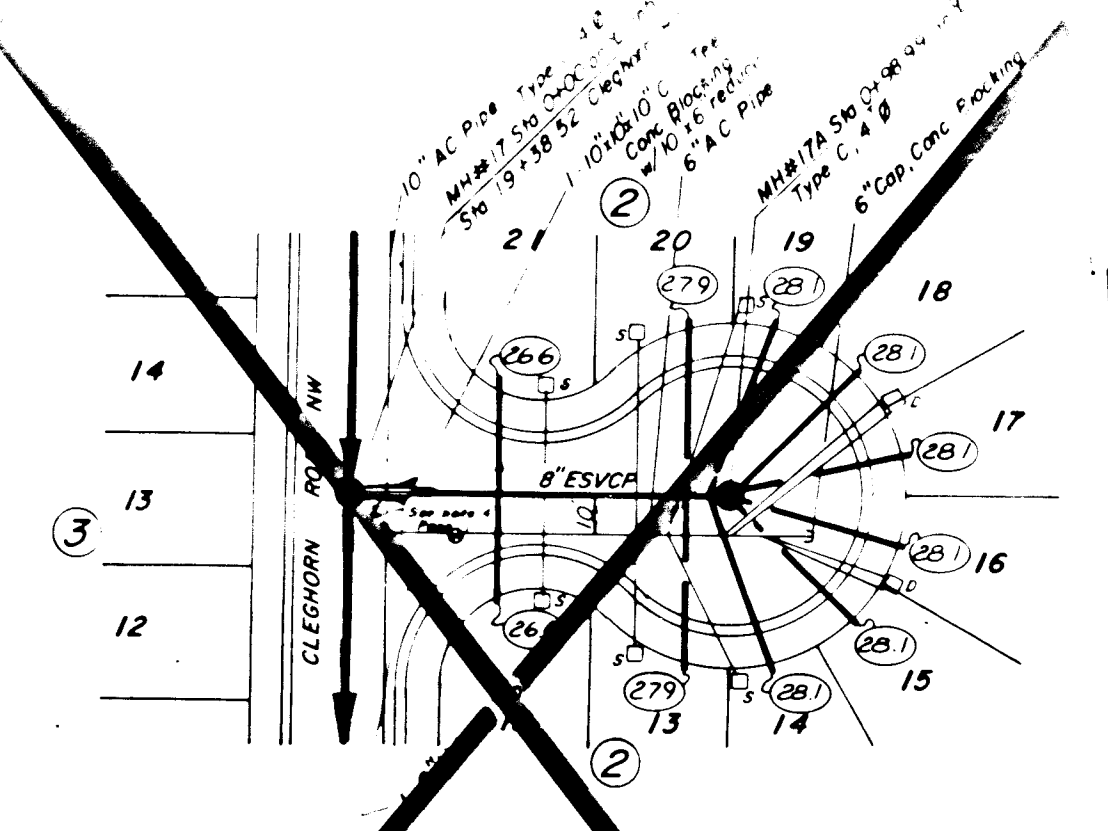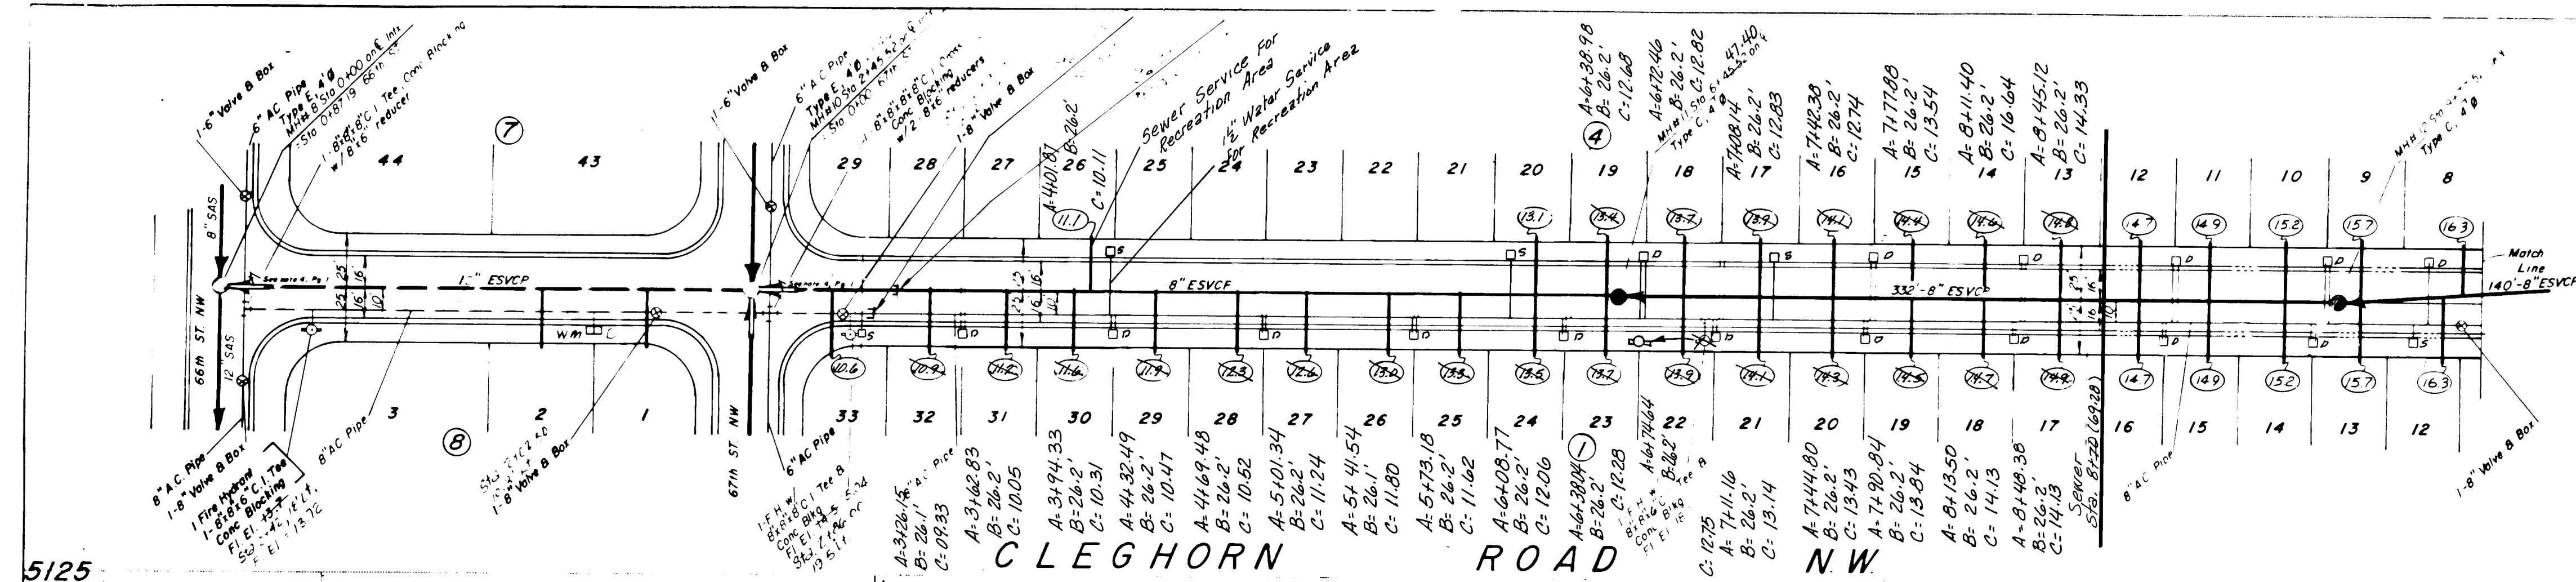


5135 CLEGHORN COURT N.W.

5130

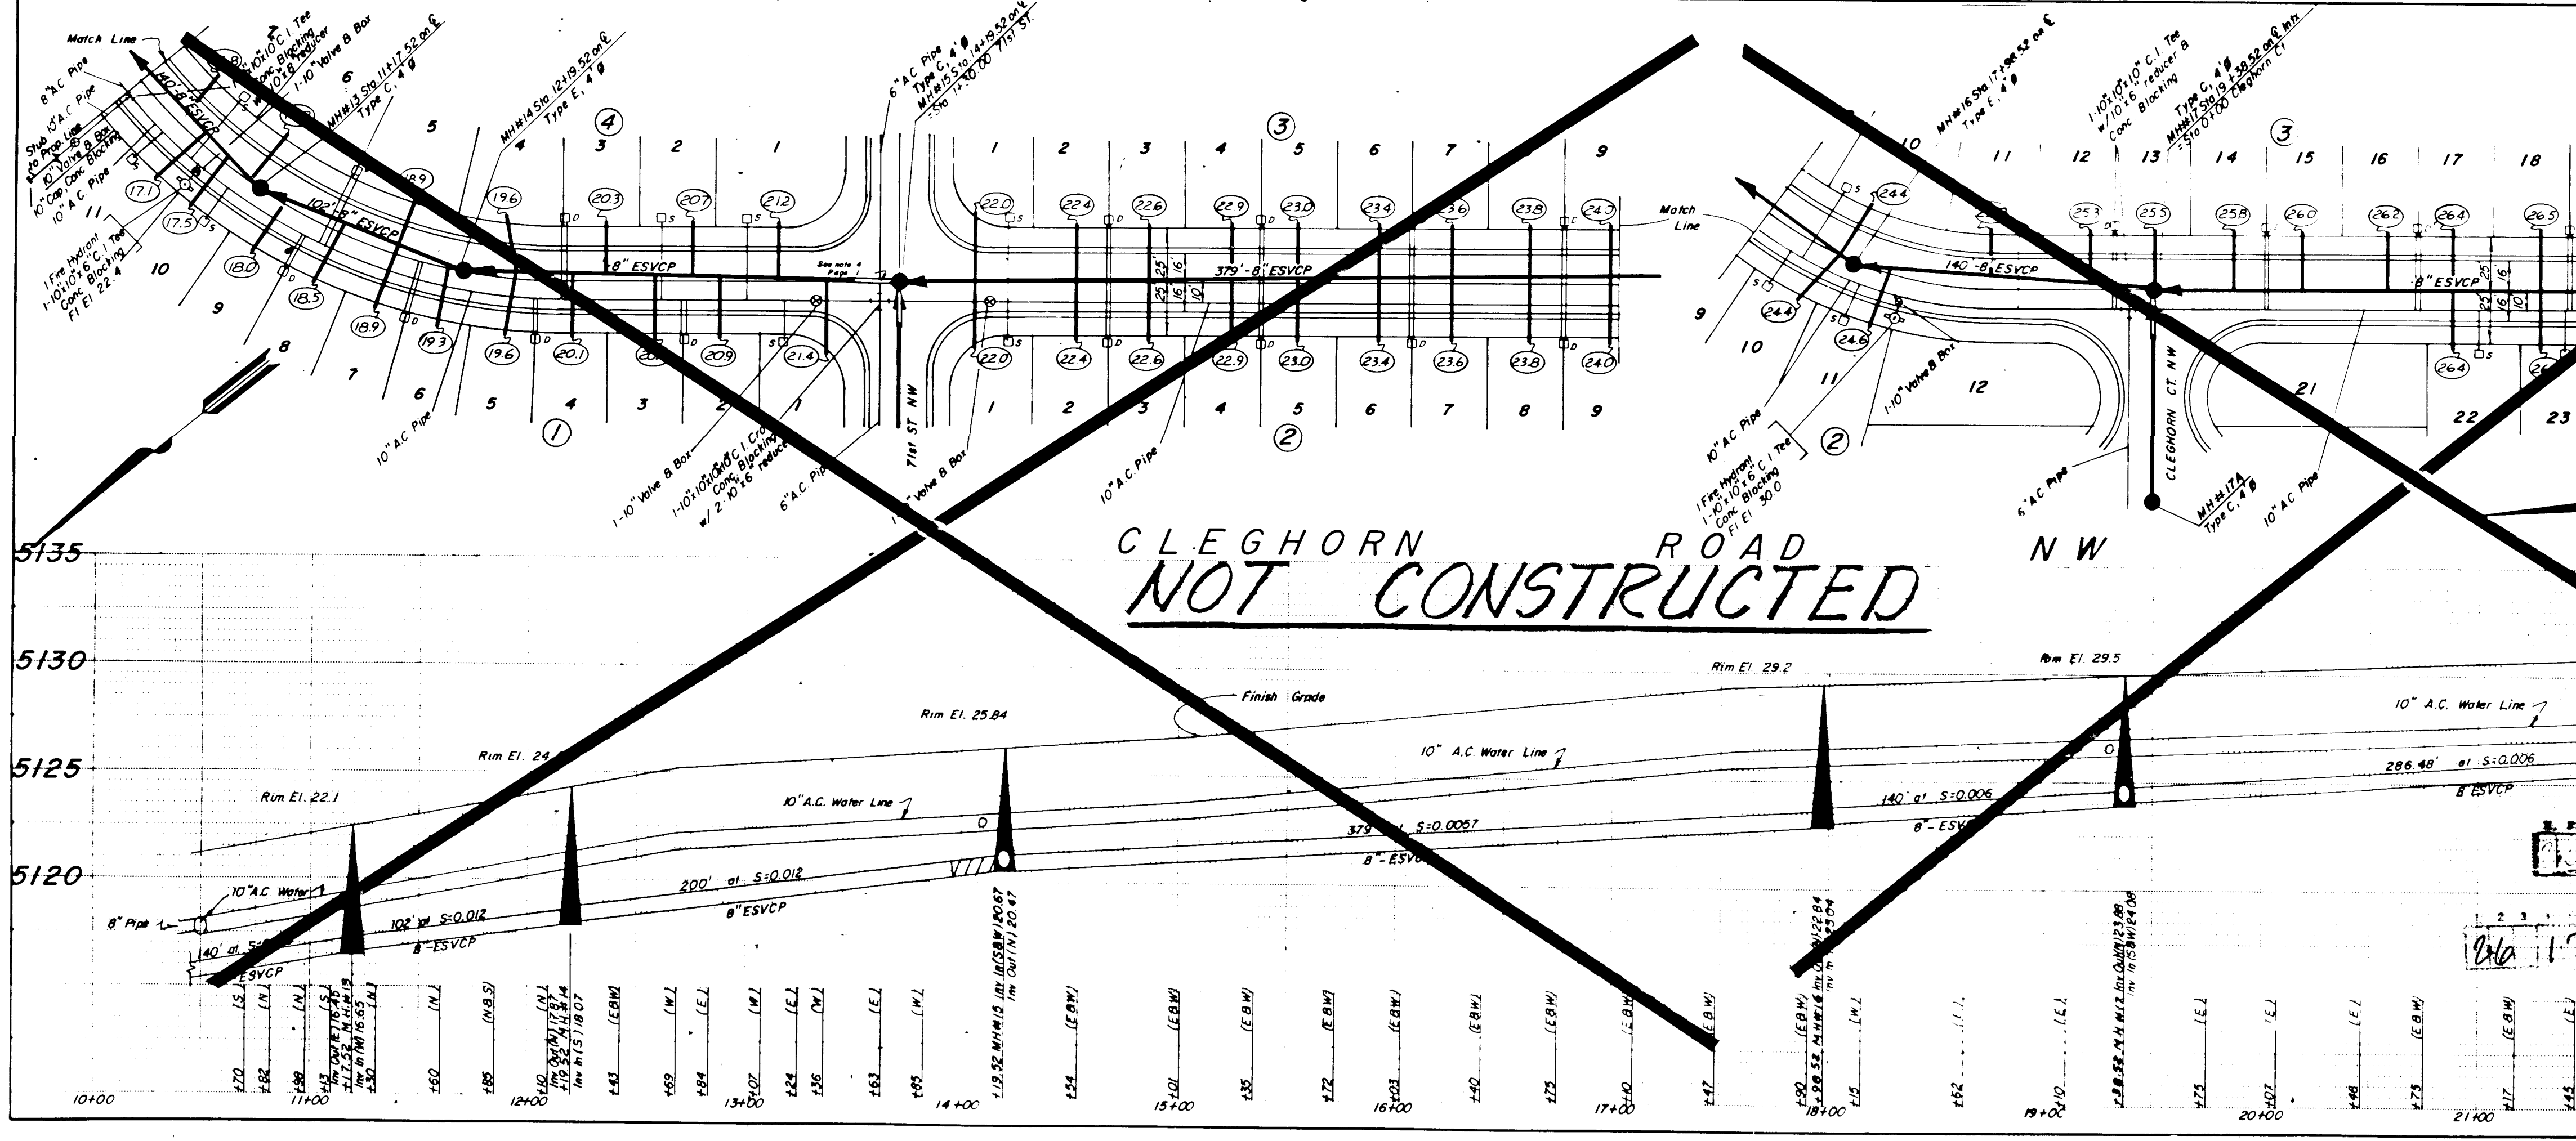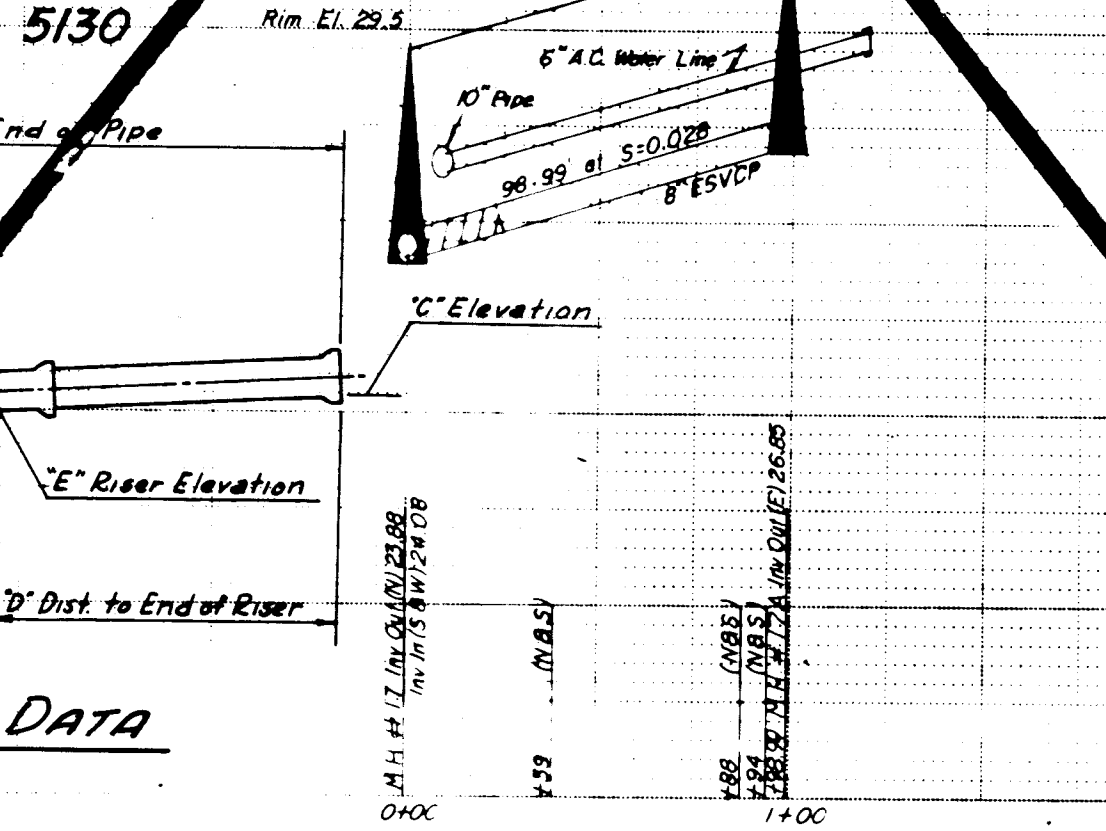

PHASE - II Scale: HORIZ. 1\"/>

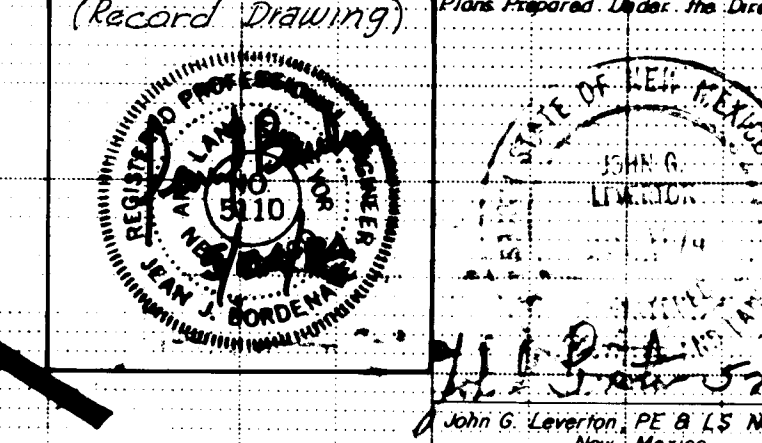


CITY OF ALBUQUERQUE MUNICIPAL DEVELOPMENT DEPARTMENT ENGINEERING DIVISION	
TITLE: - WATER & SAN. SEWER - KATHERINE - NICHOLE ADDIT'N	
APPROVALS	DATE
CITY ENGINEER	6/15/11
A.C.E. - Design	6/15/11
A.C.E. - Hydrology	6/15/11
DRAWING NO. 1063.1790	SHEET 13 OF 17


SURVEY INFORMATION		BENCH MARKS		AS BUILT INFORMATION	
NO.	DATE	NO.	DATE	NO.	DATE
1	6/15/11	1	6/15/11	1	6/15/11
2	6/15/11	2	6/15/11	2	6/15/11
3	6/15/11	3	6/15/11	3	6/15/11
100	6/15/11	100	6/15/11	100	6/15/11

0671


0671

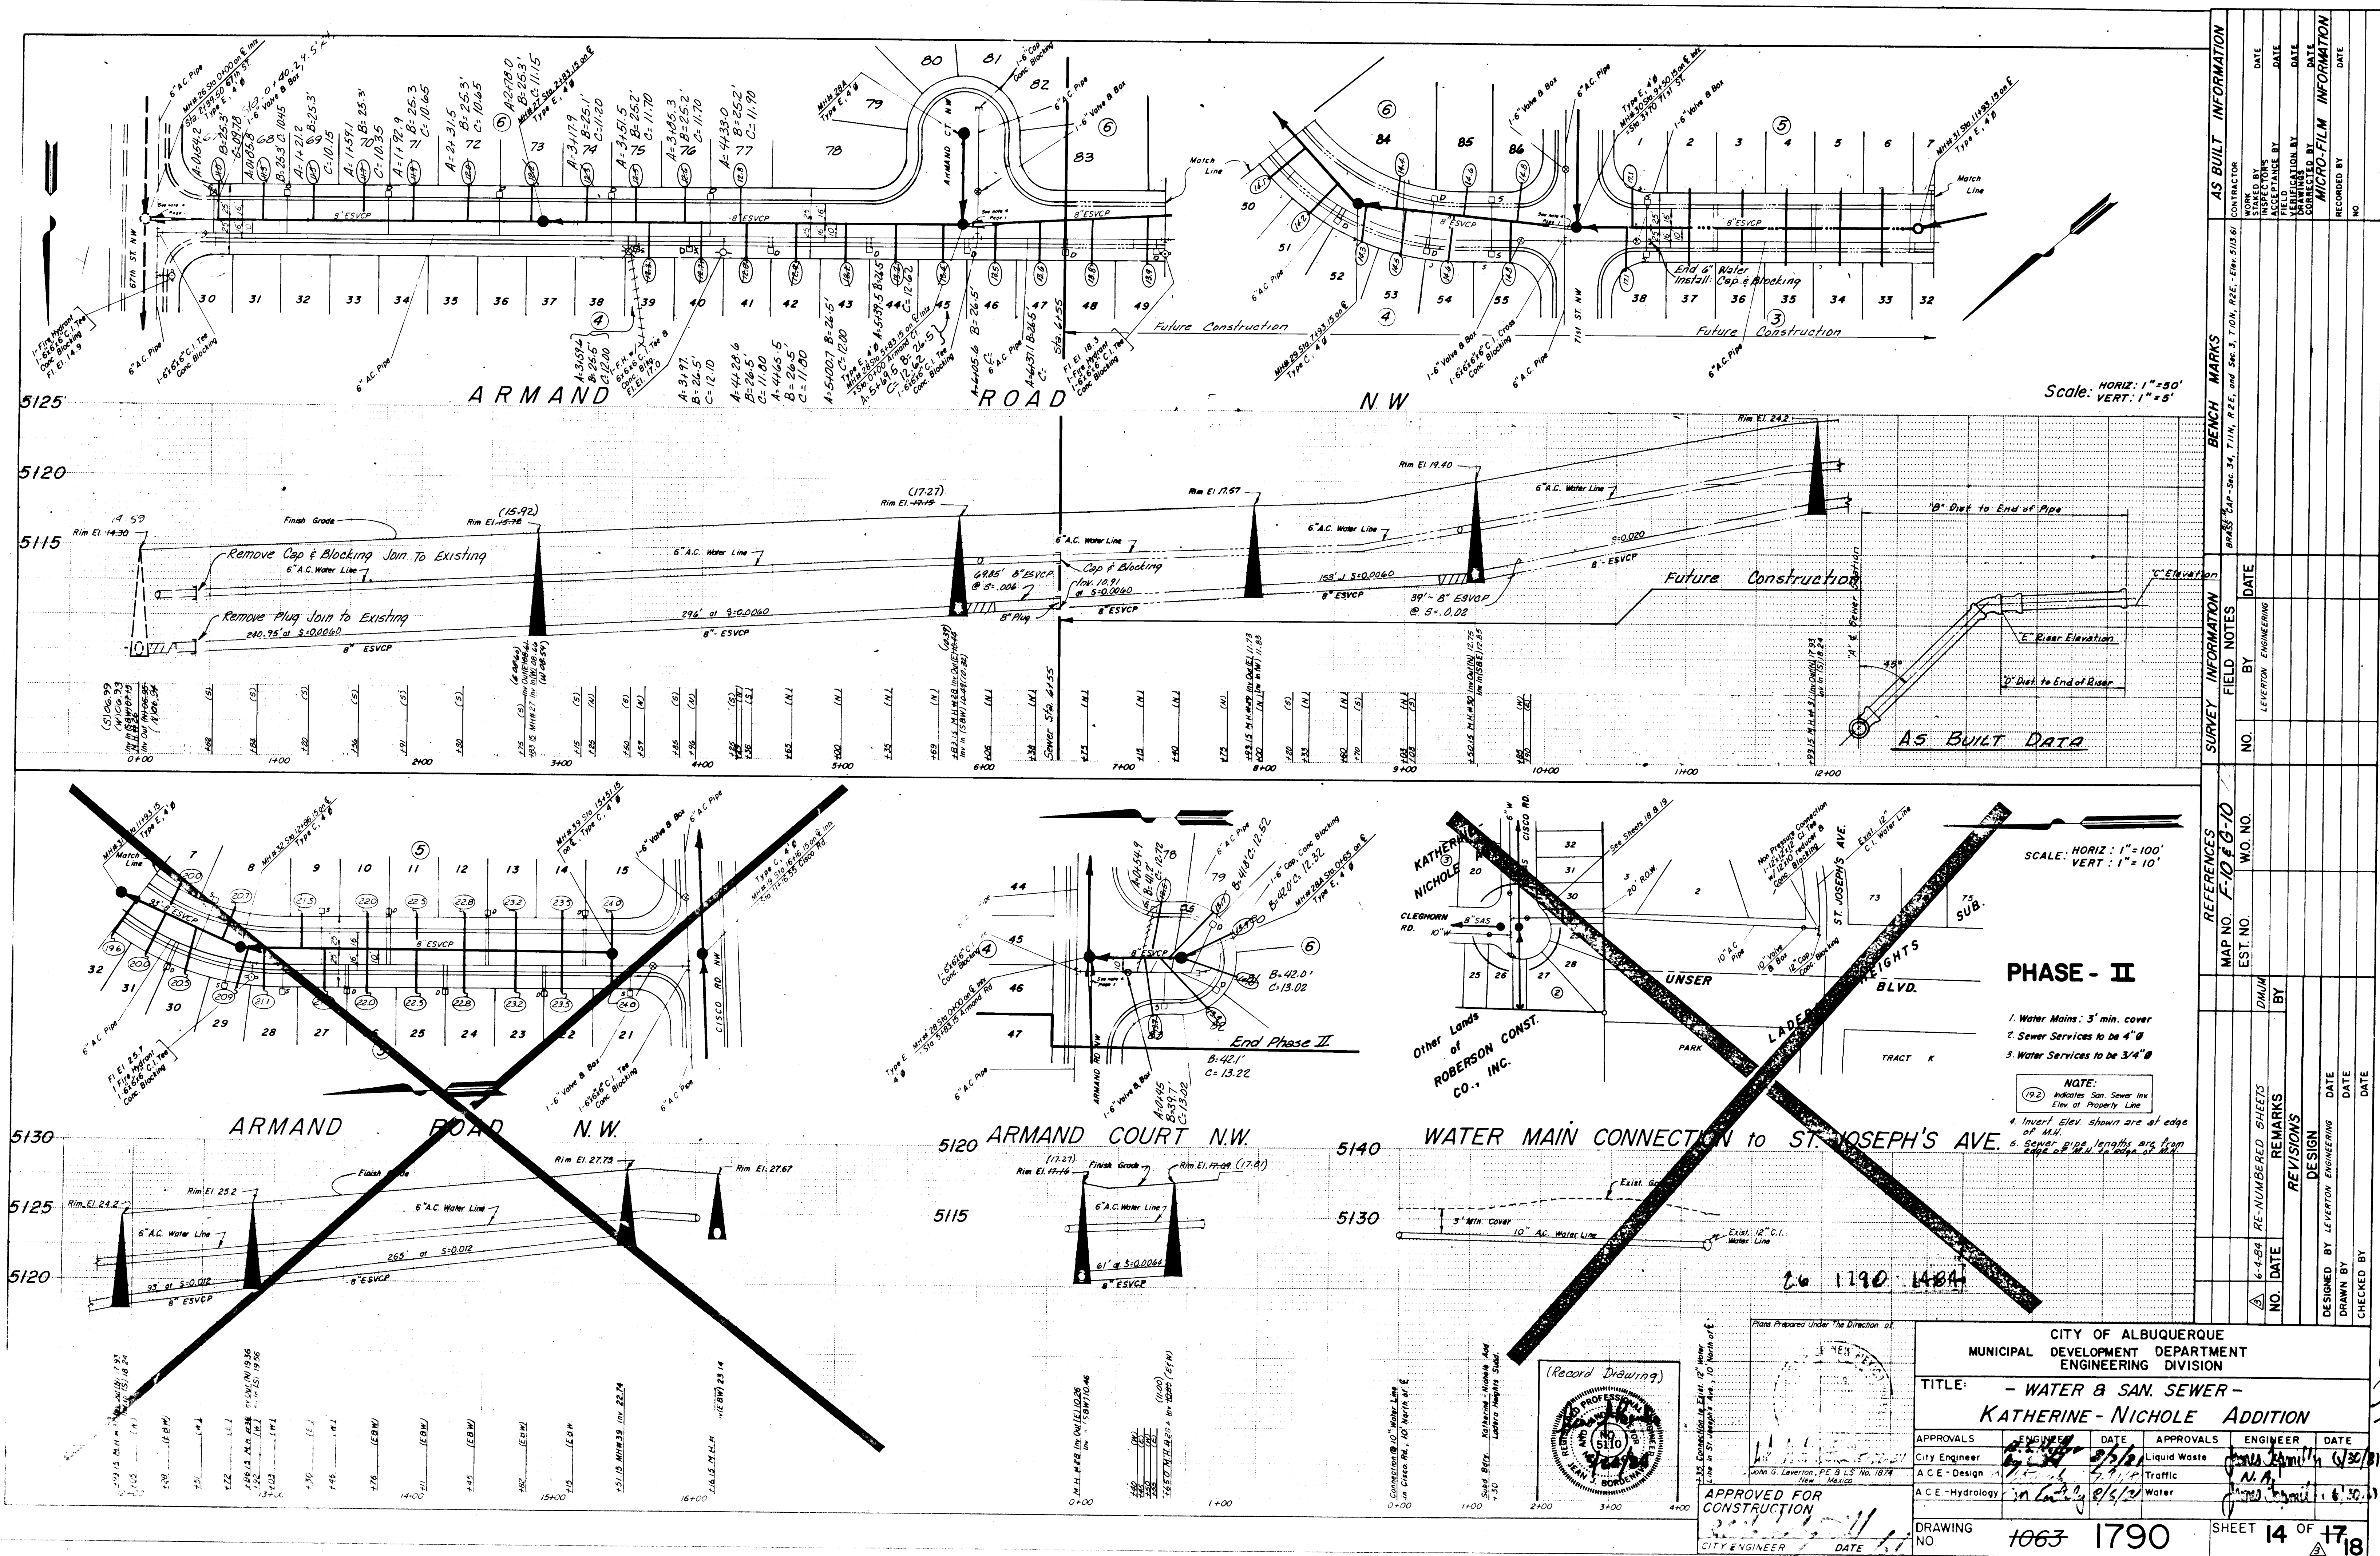


0271

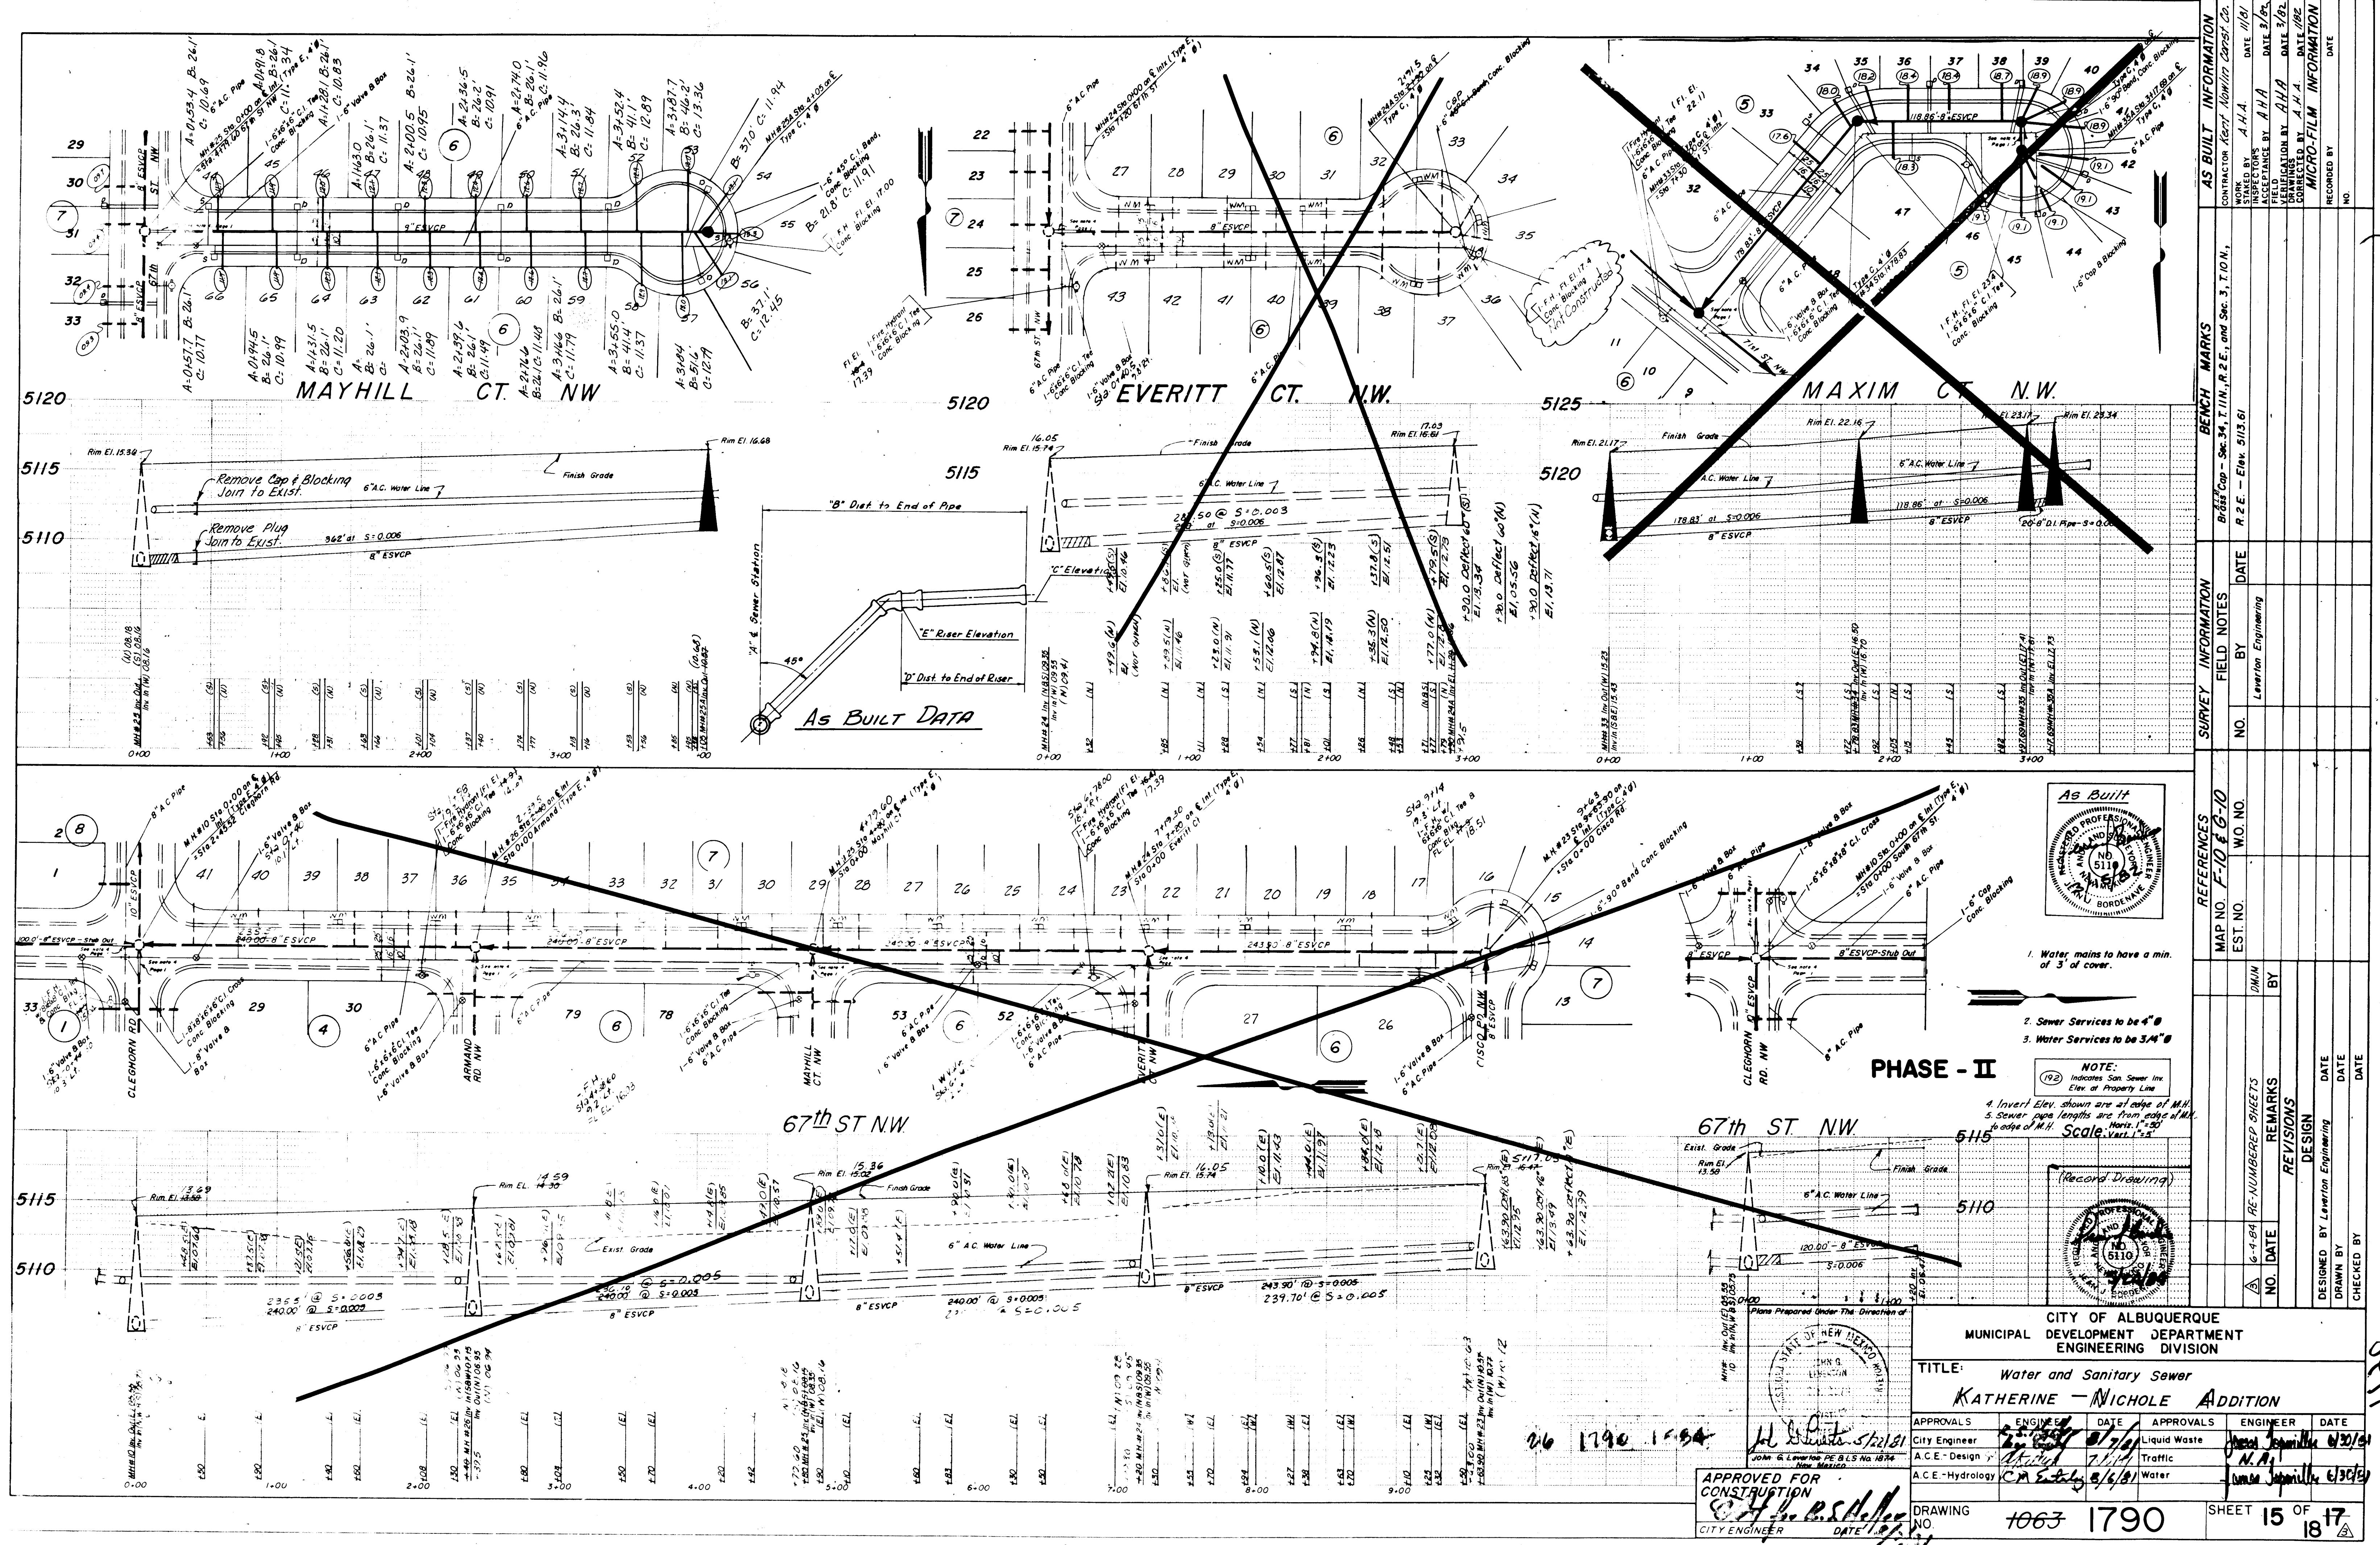


PHASE - II

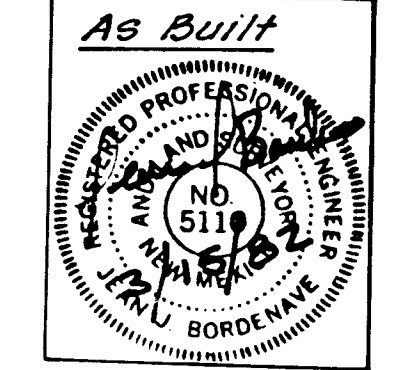

NOTE:
1. Water mains to have a min. of 3' of cover.
2. Sewer Services to be 4" Ø
3. Water Services to be 3/4" Ø

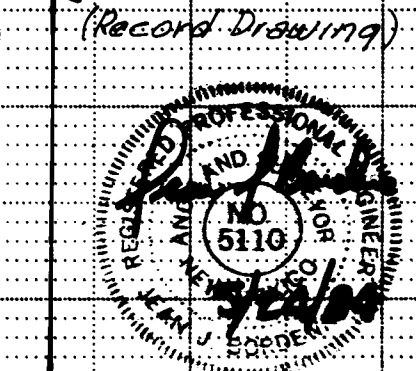


CITY OF ALBUQUERQUE MUNICIPAL DEVELOPMENT DEPARTMENT ENGINEERING DIVISION			
TITLE: Water and Sanitary Sewer KATHERINE - NICHOLE ADDITION			
APPROVALS	ENGINEER	DATE	APPROVALS
CITY ENGINEER	7/2/81	7/2/81	ENGINEER
A.C.E. - Design	7/1/81	7/1/81	Liquid Waste
A.C.E. - Hydrology	7/1/81	7/1/81	Traffic
			Water
DRAWING NO.	1063	1790	SHEET 15 OF 17

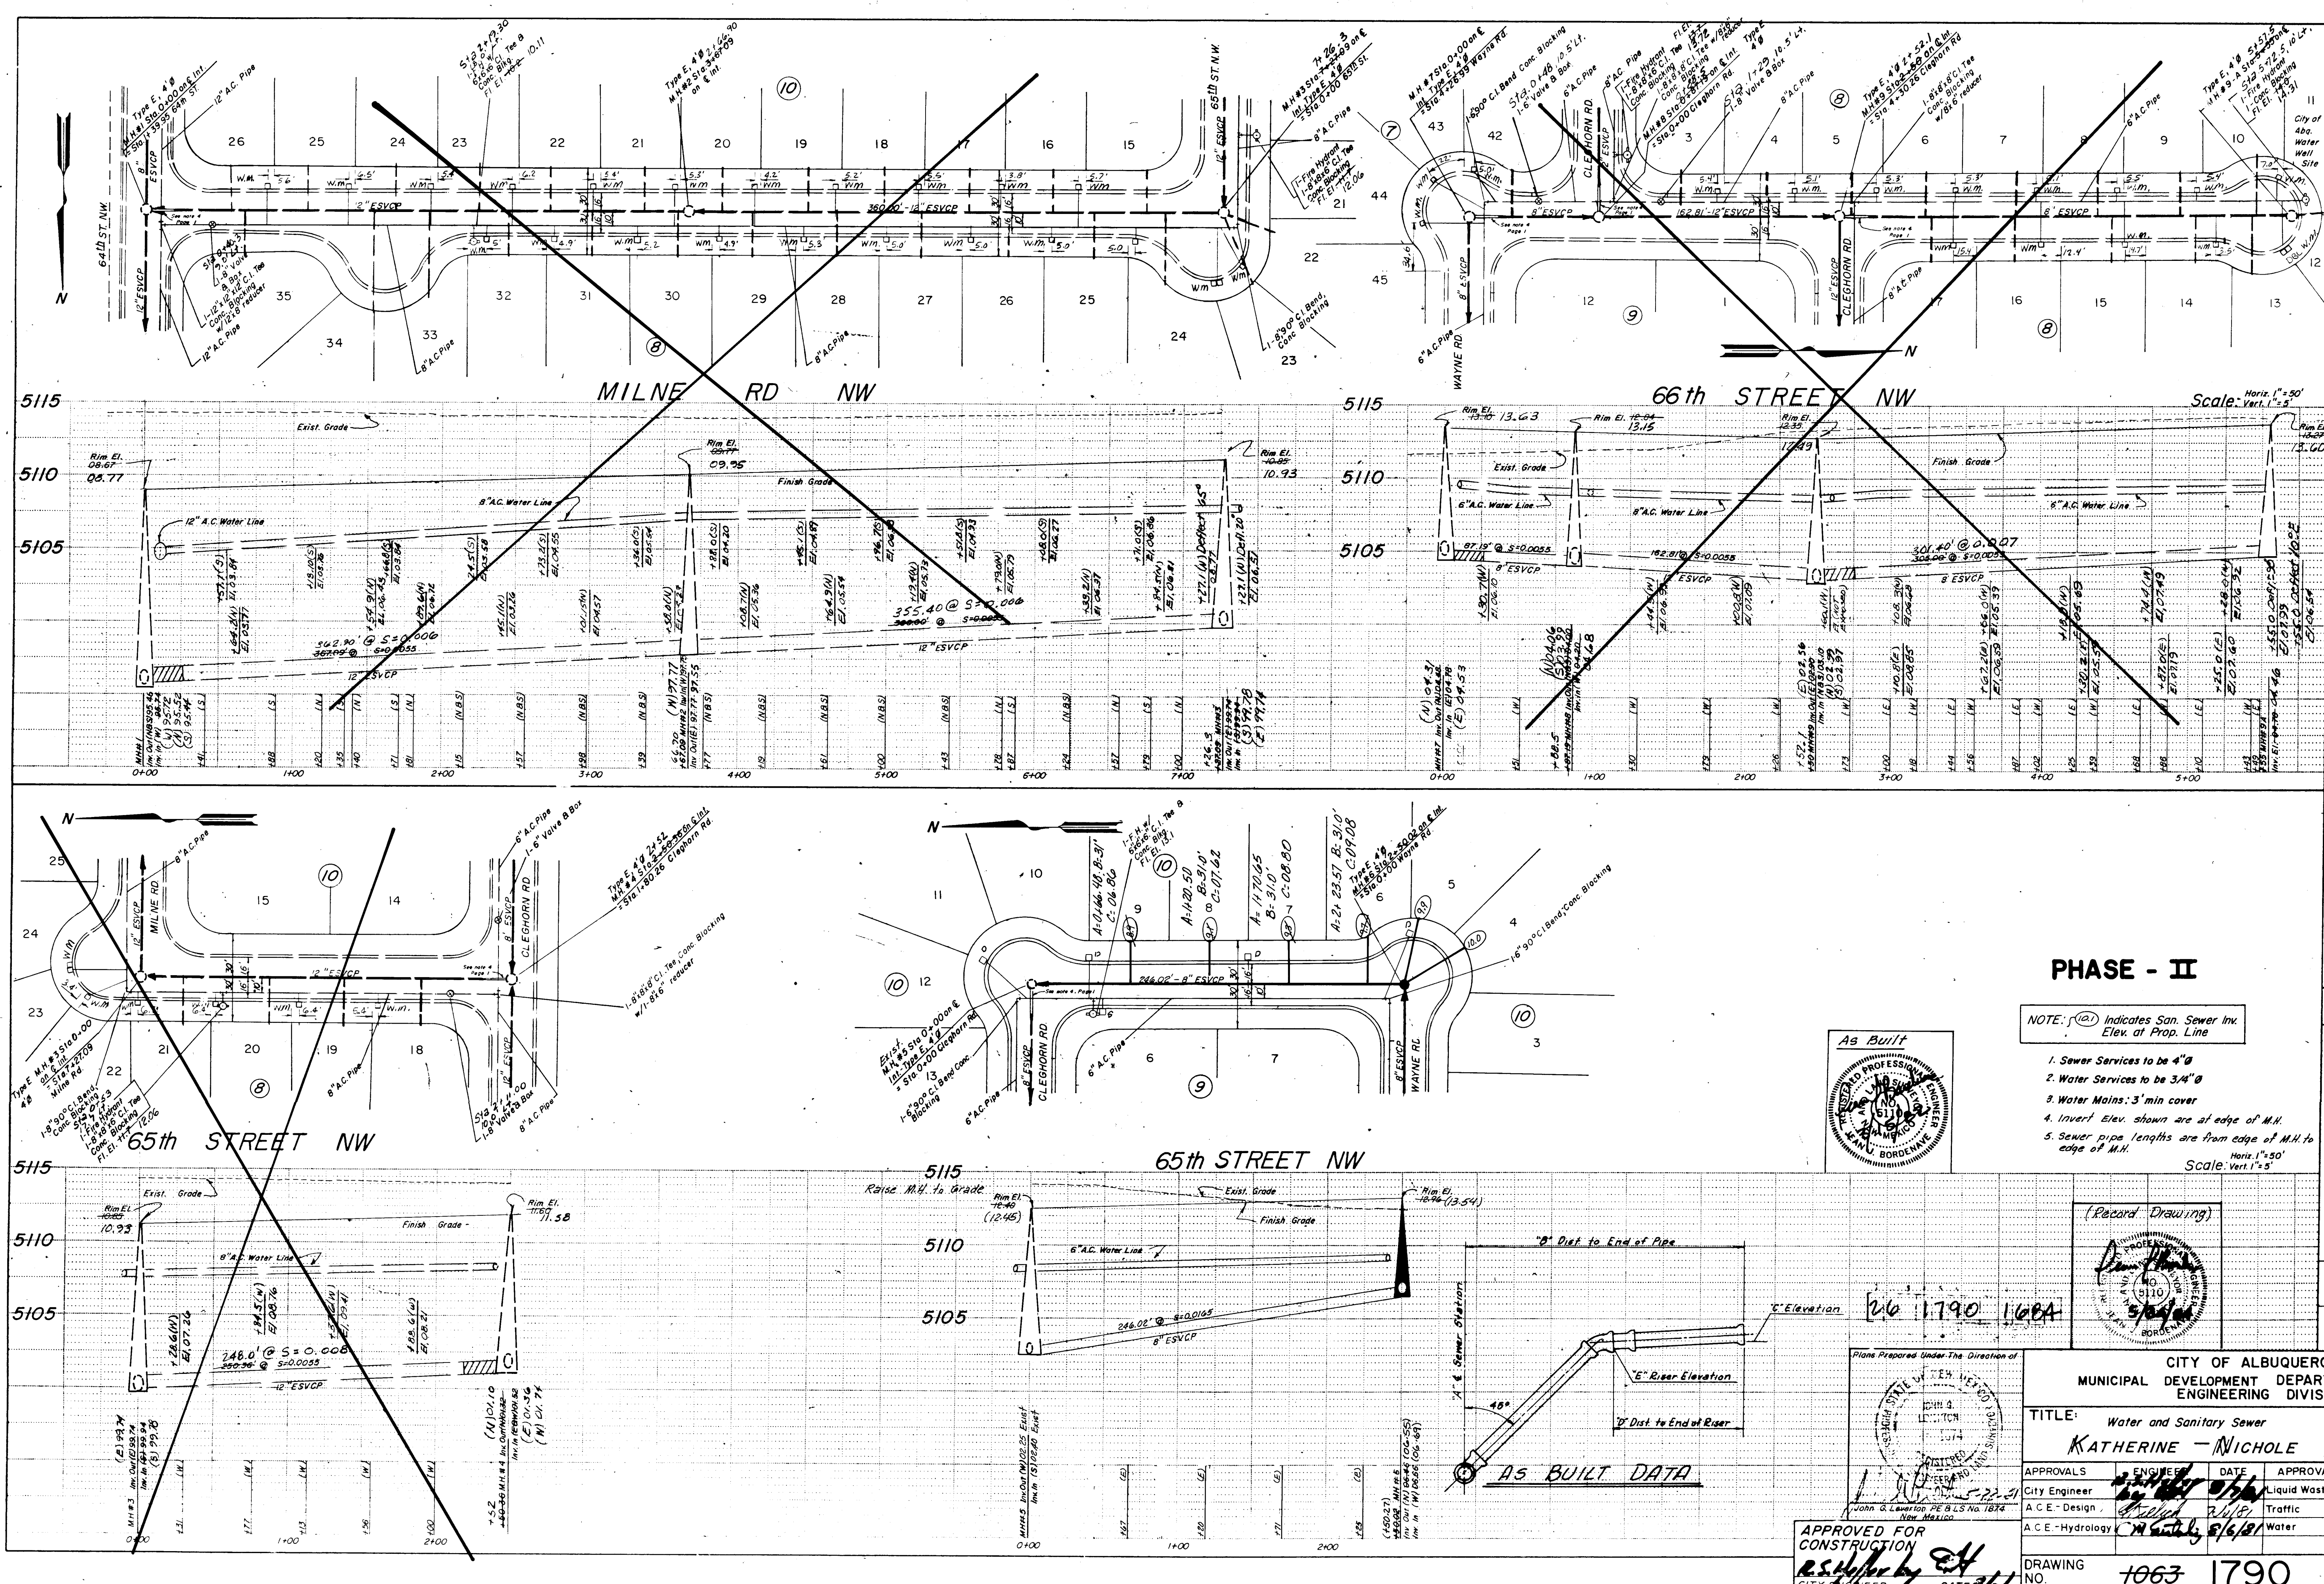

PHASE - II

- NOTE: (S) Indicates San. Sewer Inv. Elev. at Prop. Line
1. Sewer Services to be 4" Ø
 2. Water Services to be 3/4" Ø
 3. Water Mains: 3" min cover
 4. Invert Elev. shown are at edge of M.H.
 5. Sewer pipe lengths are from edge of M.H. to edge of M.H.
- Scale: Horiz. 1"=50'
Vert. 1"=5'



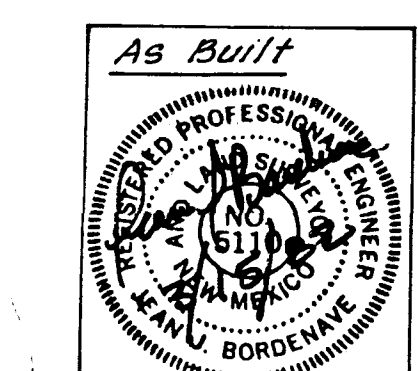


APPROVED FOR CONSTRUCTION
CITY ENGINEER
DATE 5/1/81

REVISIONS
NO. DATE BY
1 5/1/81 J.A. Smith


APPROVALS			ENGINEER			DATE		
City Engineer			Liquid Waste			J.A. Smith 5/1/81		
A.C.E. Design			Traffic			N.A. 5/1/81		
A.C.E. - Hydrology			Water			J.A. Smith 5/1/81		

AS BUILT INFORMATION		BENCH MARKS		SURVEY INFORMATION		REFERENCES		REVISIONS		DESIGN	
CONTRACTOR	RENTON CONSTRUCTION Co.	STATION	11/81	NO.	BY	MAP NO.	EST. NO.	NO.	DATE	NO.	DATE
INSPECTOR	AAA	DATE	11/81	NO.	BY	NO.	NO.	NO.	DATE	NO.	DATE
ACCEPTANCE BY	AAA	DATE	3/82	NO.	BY	NO.	NO.	NO.	DATE	NO.	DATE
VERIFICATION BY	AAA	DATE	3/82	NO.	BY	NO.	NO.	NO.	DATE	NO.	DATE
DESIGNED BY	AAA	DATE	1/82	NO.	BY	NO.	NO.	NO.	DATE	NO.	DATE
DRAWN BY	AAA	DATE	1/82	NO.	BY	NO.	NO.	NO.	DATE	NO.	DATE
RECORDED BY	AAA	DATE	1/82	NO.	BY	NO.	NO.	NO.	DATE	NO.	DATE

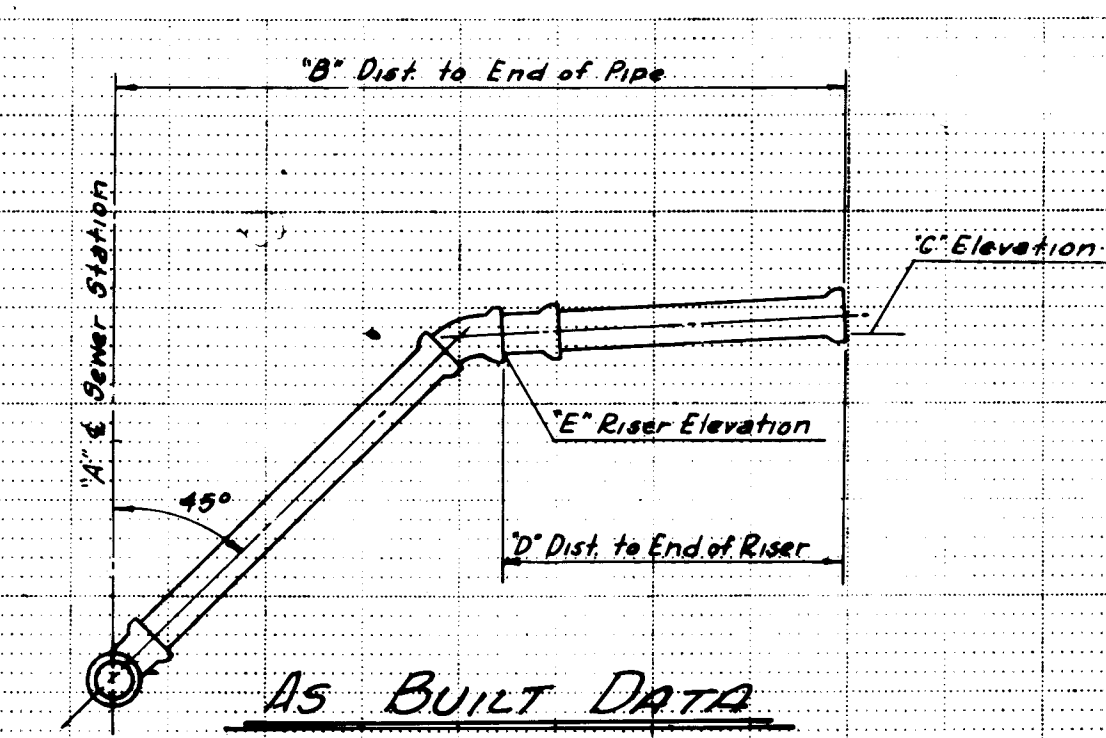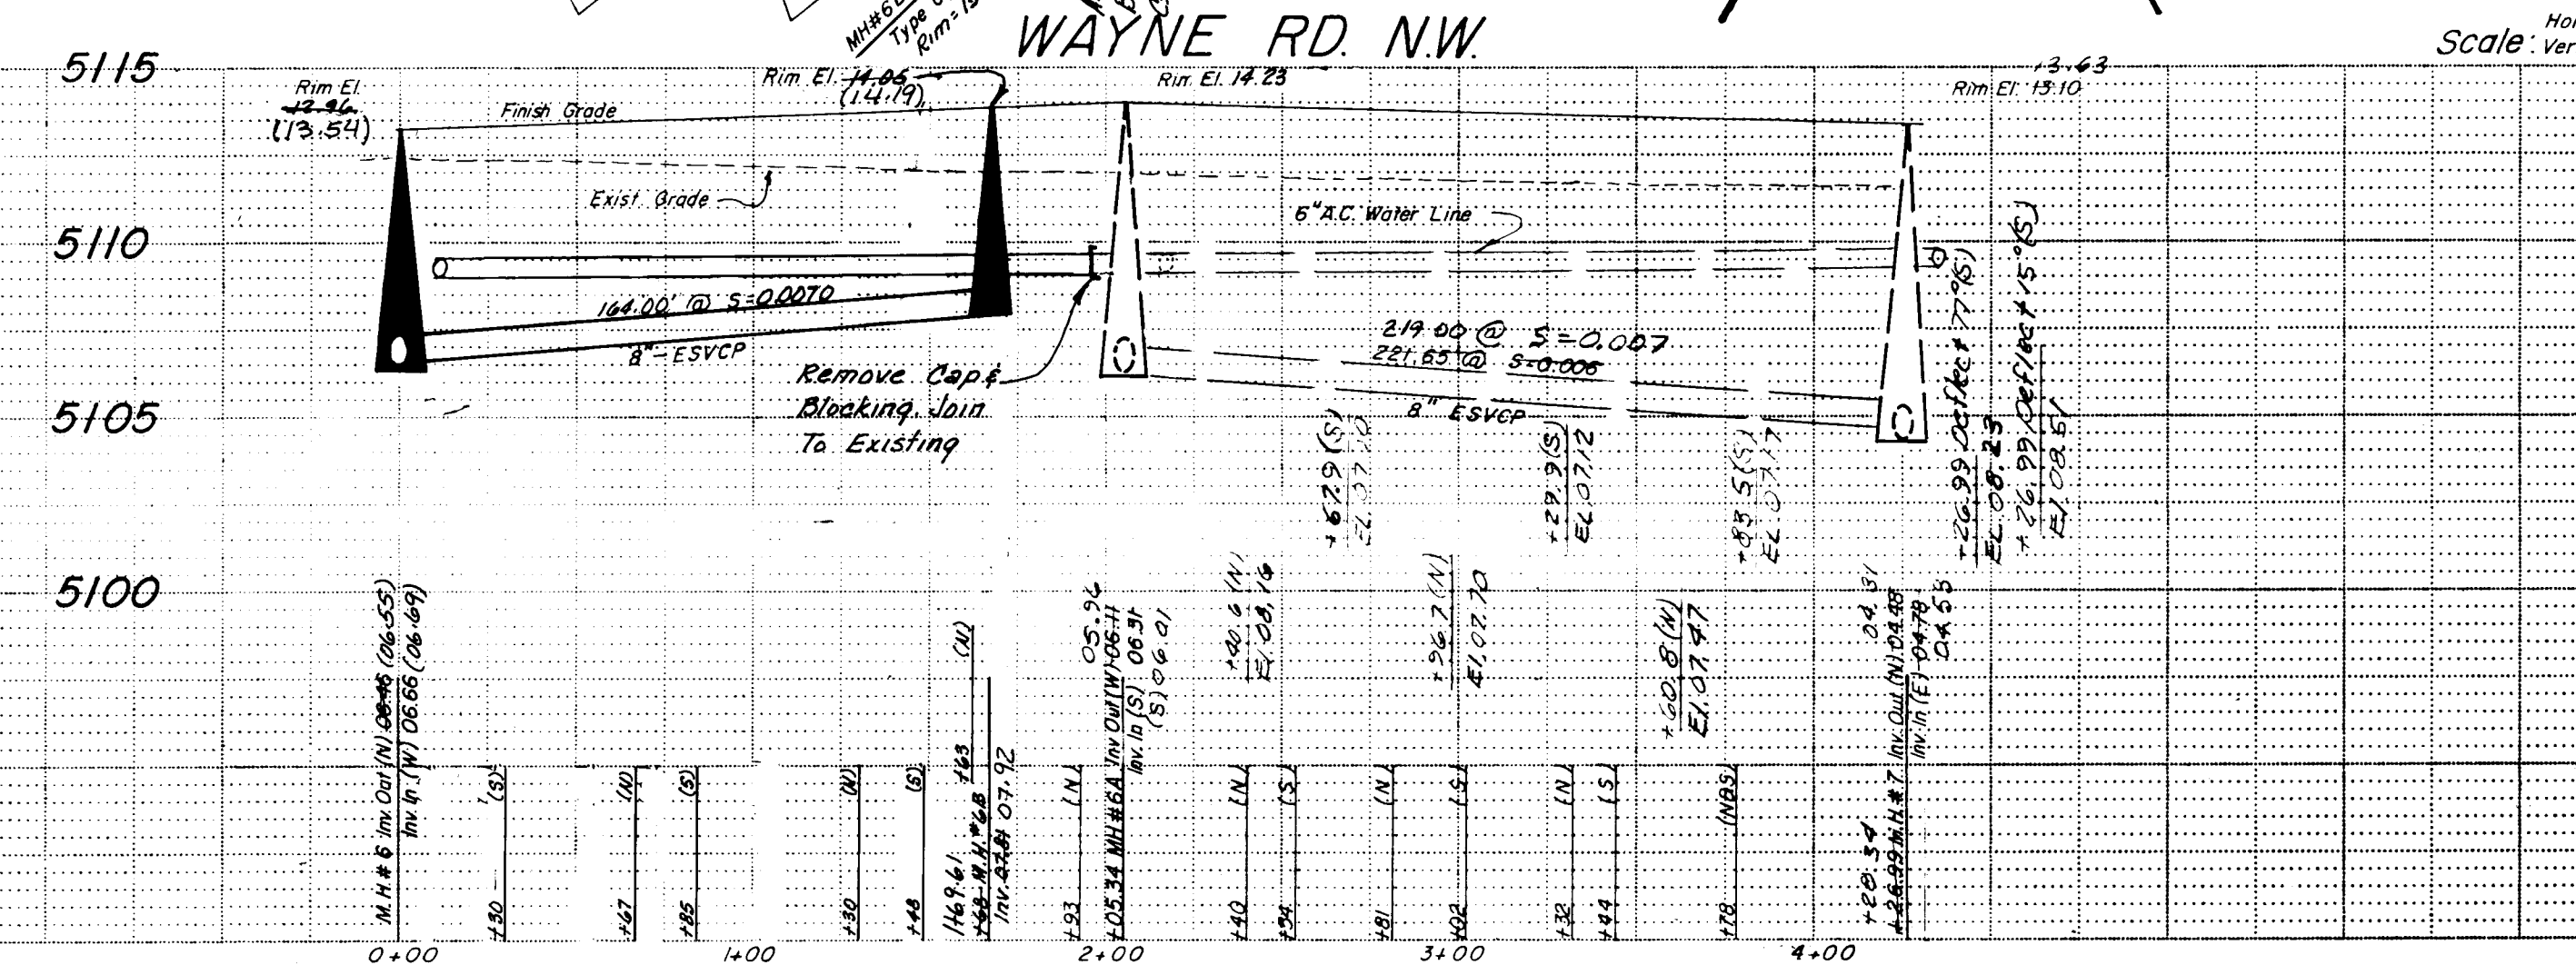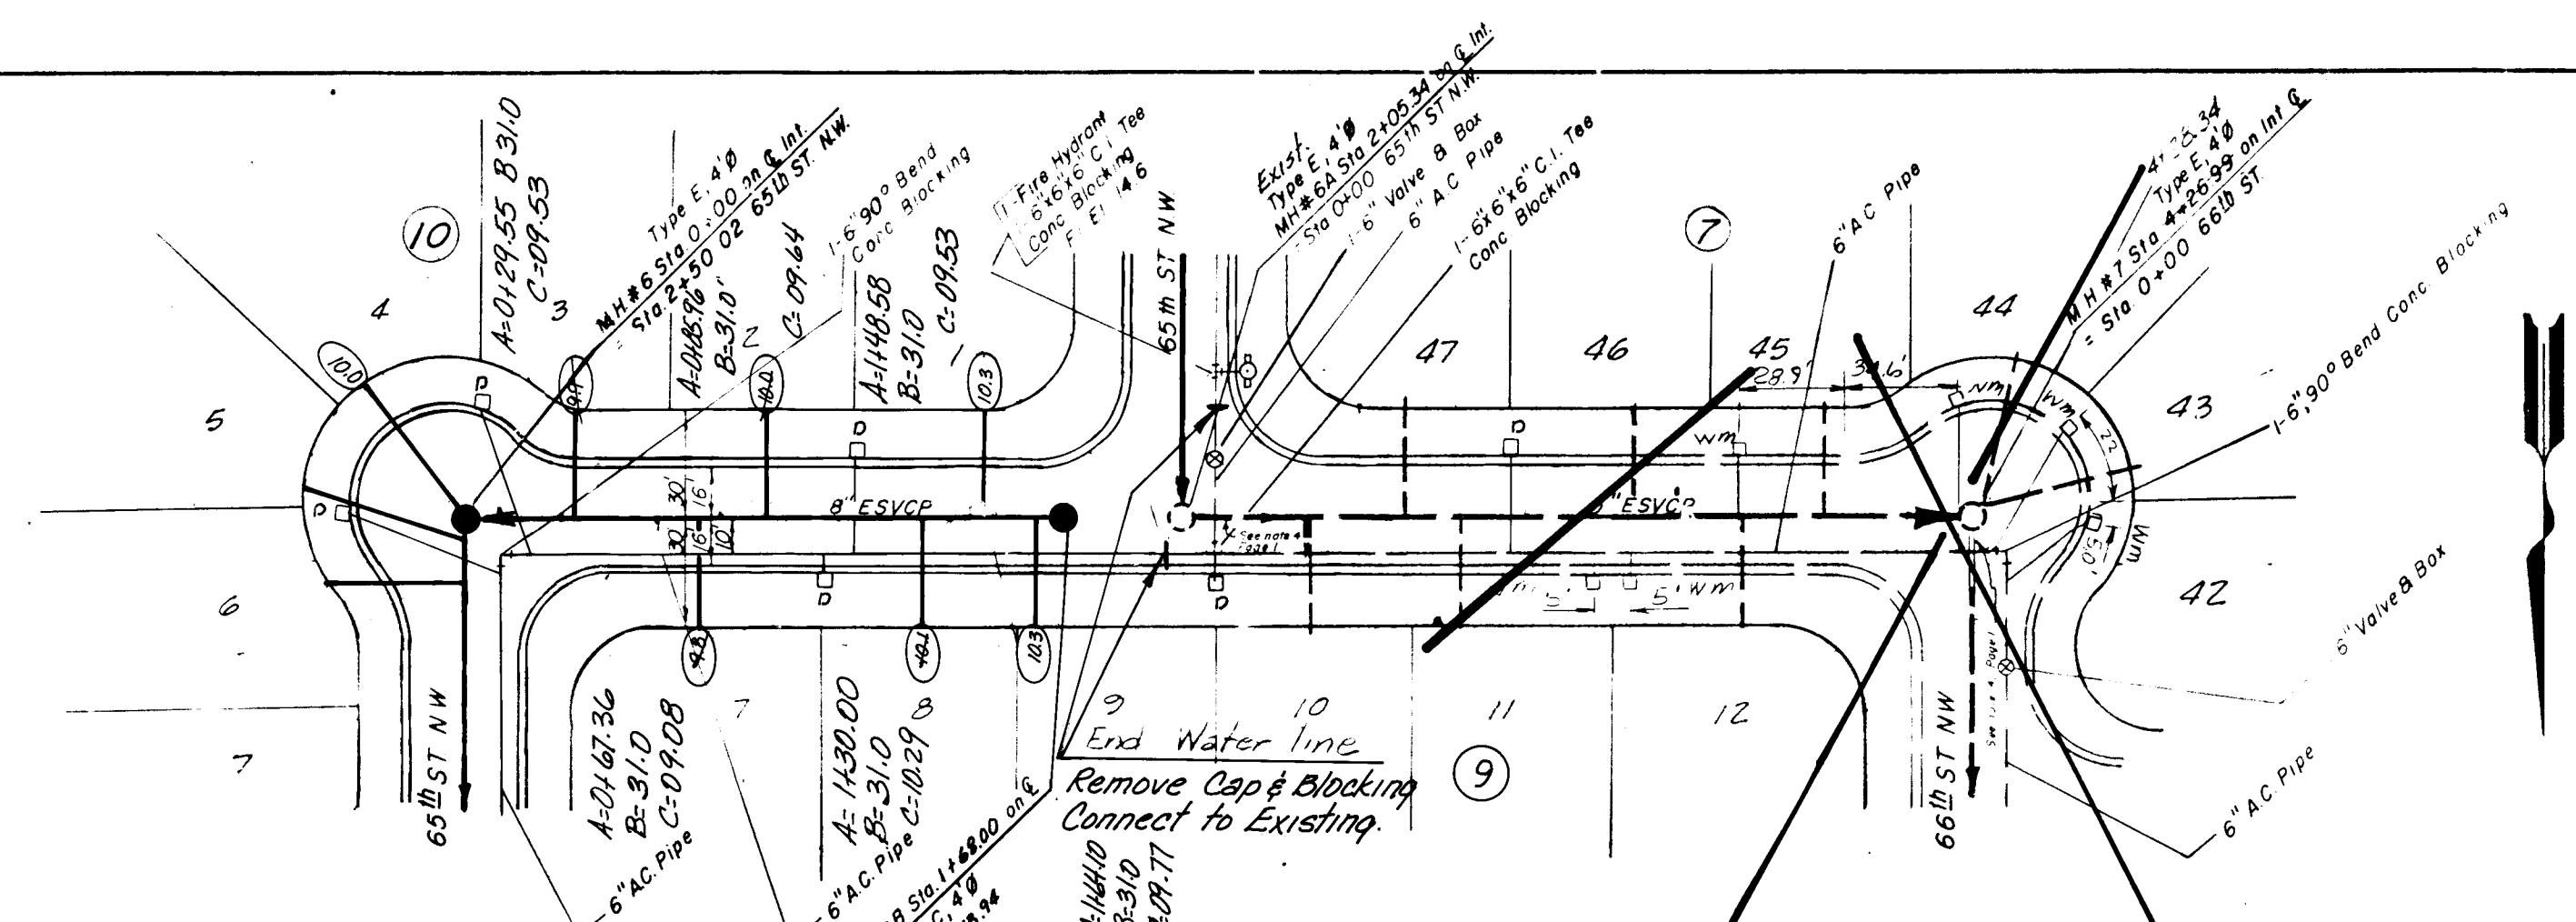

NOTE: (101) Indicates San. Sewer Inv.
Elev. at Prop. Line

1. Sewer Services to be 4" Ø
2. Water Services to be 3/4" Ø
3. Water Mains : 3' min. cover
4. Invert Elev. shown are at edge of M.H.
5. Sewer pipe lengths are from edge of M.H. to edge of M.H.

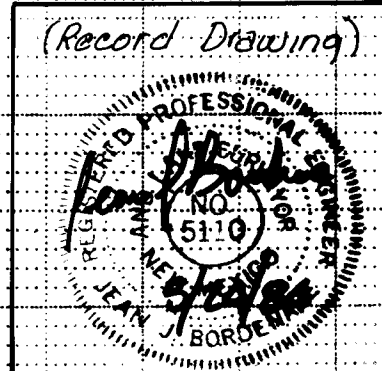

26 1790 1784

Plans Prepared Under The Direction of...

CITY OF ALBUQUERQUE
MUNICIPAL DEVELOPMENT DEPARTMENT
ENGINEERING DIVISION

TITLE: *Water and Sanitary Sewer*
KATHERINE - NICHOLE ADDITION

APPROVALS	ENGINEER	DATE	APPROVALS	ENGINEER	DATE
City Engineer	<i>[Signature]</i>	6/1/00	Liquid Waste	<i>[Signature]</i>	6/1/00

[illegible]

DRAWING NO	1063 1790	SHEET 17 OF 17 ^A 18
---------------	----------------------	-----------------------------------

APPROVED FOR
CONSTRUCTION
CITY ENGINEER
DATE

1998, 1999, 2000, 2679, 26

NOTES:

1. THIS DRAWING SUPERCEDES IN PART SHEETS 3,4 & 6 OF PLAN 1622.
2. STATIONING PER PLAN 1622.
3. GRADE GRADUALLY TO NEWLY PLACED RIP RAP TO DRAIN TOWARD BASIN INLET AS SHOWN ON SHT. 3 OF 6, PLAN 1622. SHOULD EROSION CONTROL BE DISTURBED (PER SHT. 3 OF 6 PLAN 1622) IT SHALL BE REPLACED PER THE DESIGN NOTES ON THE PLAN (1622).
4. BETWEEN STATION 15+82.40 & STATION 16+06.40 REMOVE 1' PAVEMENT-ALL CURB, GUTTER, SIDEWALK AND CONC. WALL.
BETWEEN STATION 16+06.40 & STATION 16+07.40 REMOVE SIDEWALK ONLY.
REPLACE IMPROVEMENTS PER SECTIONS C-C, D-D, E-E AND PAVEMENT SECTION SHOWN ON SHT. 6 OF 6, PLAN 1622 FOR DETAILS.
5. EXISTING CHAINLINK GATE BETWEEN STA. 15+62.40 AND 15+82.40 TO REMAIN. CONSTRUCT CHAINLINK FENCE TO MATCH GATE BETWEEN STA. 15+82.40 AND STA. 15+94.40, ALSO WHERE 2' OF WALL IS REMOVED
6. SAW CUT TO FULL DEPTH, INSTALL 1/2" EXP. JOINT W/ CITY APPROVED SEALANT.

Scale: $1'' = 5'$

LEGEND

TC	TOP OF CURB
TW	TOP OF WALL
TRR	TOP OF RIP RAP
5100	NEW ELEVATIONS
(5101)	EXISTING ELEVATIONS

PLAN


SECTION C-C

$$l'' = 5'$$

SECTION E-E


$$I'' = 5$$

SECTION D-D
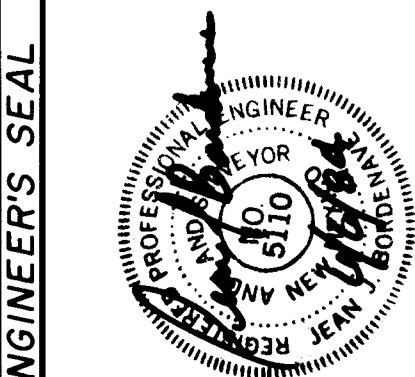
$$1'' = .5$$


ADAM, HAMLYN, ANDERSON
consulting engineers inc.
4055 MONTGOMERY BOULEVARD, N.E.
ALBUQUERQUE, NEW MEXICO 87109

(Record Drawing)

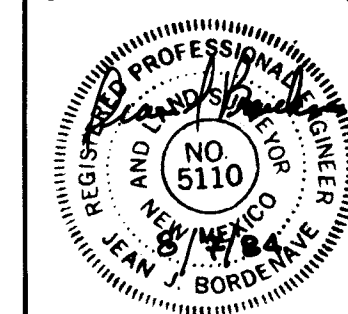

CITY OF ALBUQUERQUE
MUNICIPAL DEVELOPMENT DEPARTMENT
ENGINEERING DIVISION

TITLE: *Drainage Modification on Milne Road*

~~KATHERINE~~ - ~~NICHOLE~~ ~~ADDITION~~

APPROVALS	ENGINEER	DATE	APPROVALS	ENGINEER	DATE
City Engineer			Liquid Waste	NA. R. Peña	6/3/04
A.C.E.-Design	4200km	6/3/04	Traffic	R.A. DWH	6/6/04
A.C.E.-hydrology	Billy J. Smith	6/6/04	Water	NA. R. Peña	6/3/04

DRAWING NO.	1790	MAP NO.	F-10.G-10	SHEET	18-A	OF	18
-------------	------	---------	-----------	-------	------	----	----

26 177018134¹¹