


PAVEMENT FOR ACCESS ROAD
TO
NORTH VALLEY PARK

INDEX		
SHEET	NO.	DESCRIPTION
1	OF 5	TITLE SHEET
2	OF 5	PROJECT LAY-OUT
3	OF 5	ACCESS ROAD PLAN & PROFILE
4	OF 5	PARKING LOT PAVING PLAN
5	OF 5	DETAILS

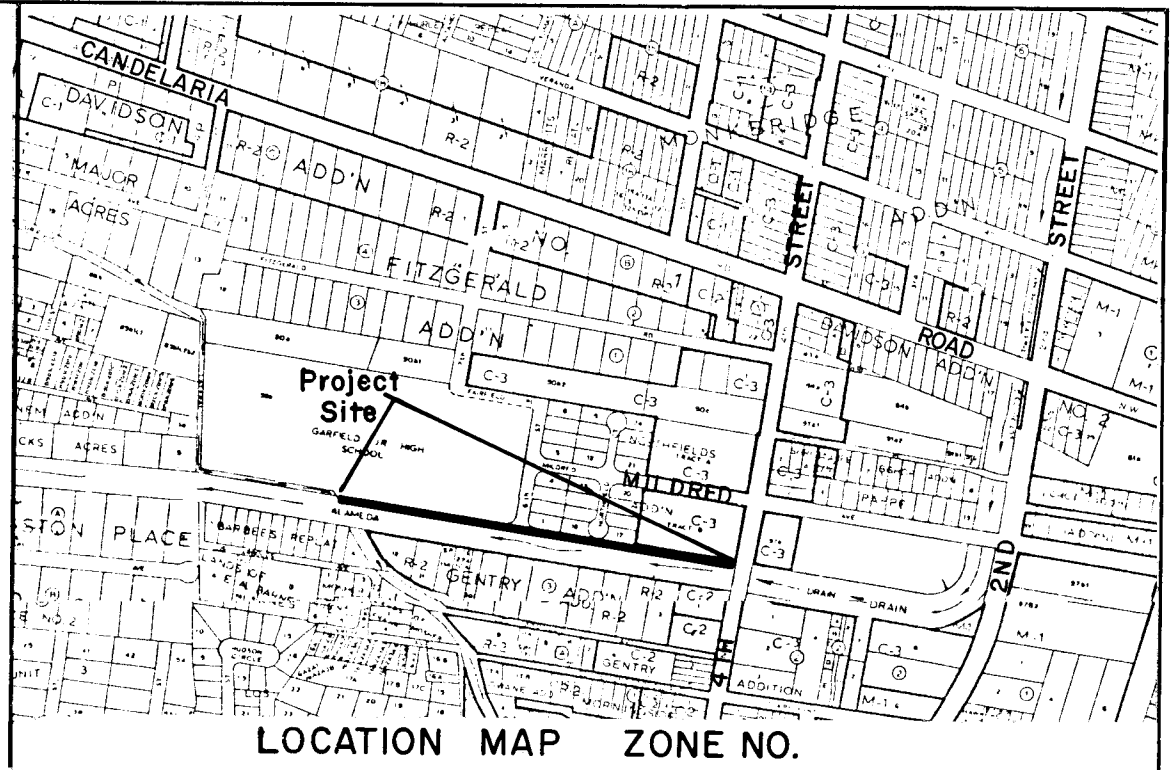

NOTICE TO CONTRACTORS

- All work detailed on these plans to be performed under contract shall, except as otherwise stated or provided for hereon, be constructed in accordance with the New Mexico Standard Specifications for Public Works Construction 1973-Edition (referred to herein as the Standard Specifications), and the Contract Documents for Public Works Contract 84-1.
- Two (2) working days prior to any excavation, the contractor must contact Line Locating Service, 765-1234, for location of existing utilities.
- Prior to construction, the contractor shall excavate and verify the horizontal and vertical locations of all obstructions. Should a conflict exist, the contractor shall notify the engineer or surveyor so that the conflict can be resolved with minimum amount of delay.

THE FOLLOWING NOTES ALSO APPLY
WHEN CHECKED

- ☒ All utilities and utility service lines shall be installed prior to paving.
- ☒ Backfill compaction shall be according to specified street use. (Residential)
- ☒ Tack coat requirements shall be determined by the City Engineer.
- ☐ Sidewalks and wheelchair ramps within the curb returns shall be constructed wherever a new curb return is constructed.
- ☐ If curb is depressed for a driveway or a handicap ramp, the driveway or ramp shall be constructed prior to acceptance of the curb and gutter.
- ☒ All storm drainage facilities shall be completed prior to final acceptance.
- ☒ The Block-to-Block Contractor Shall Build Only the Asphalt Concrete Pavement of the Access Road and the Parking Lot. All Other Work Shall Be By the Parks and Recreation Department.

W. F. Mylman
8/28/84


ADDENDUM
NO. 3

1/26/84	NOTICE TO CONTRACTORS	P. F.
2/2/84	Deleted "Block-to-Block"	C. T.
NO.	DATE	REMARKS
		BY

CITY OF ALBUQUERQUE	APPROVED FOR CONSTRUCTION
	CITY ENGR.
1806	SHEET OF 1 5

1806

1806

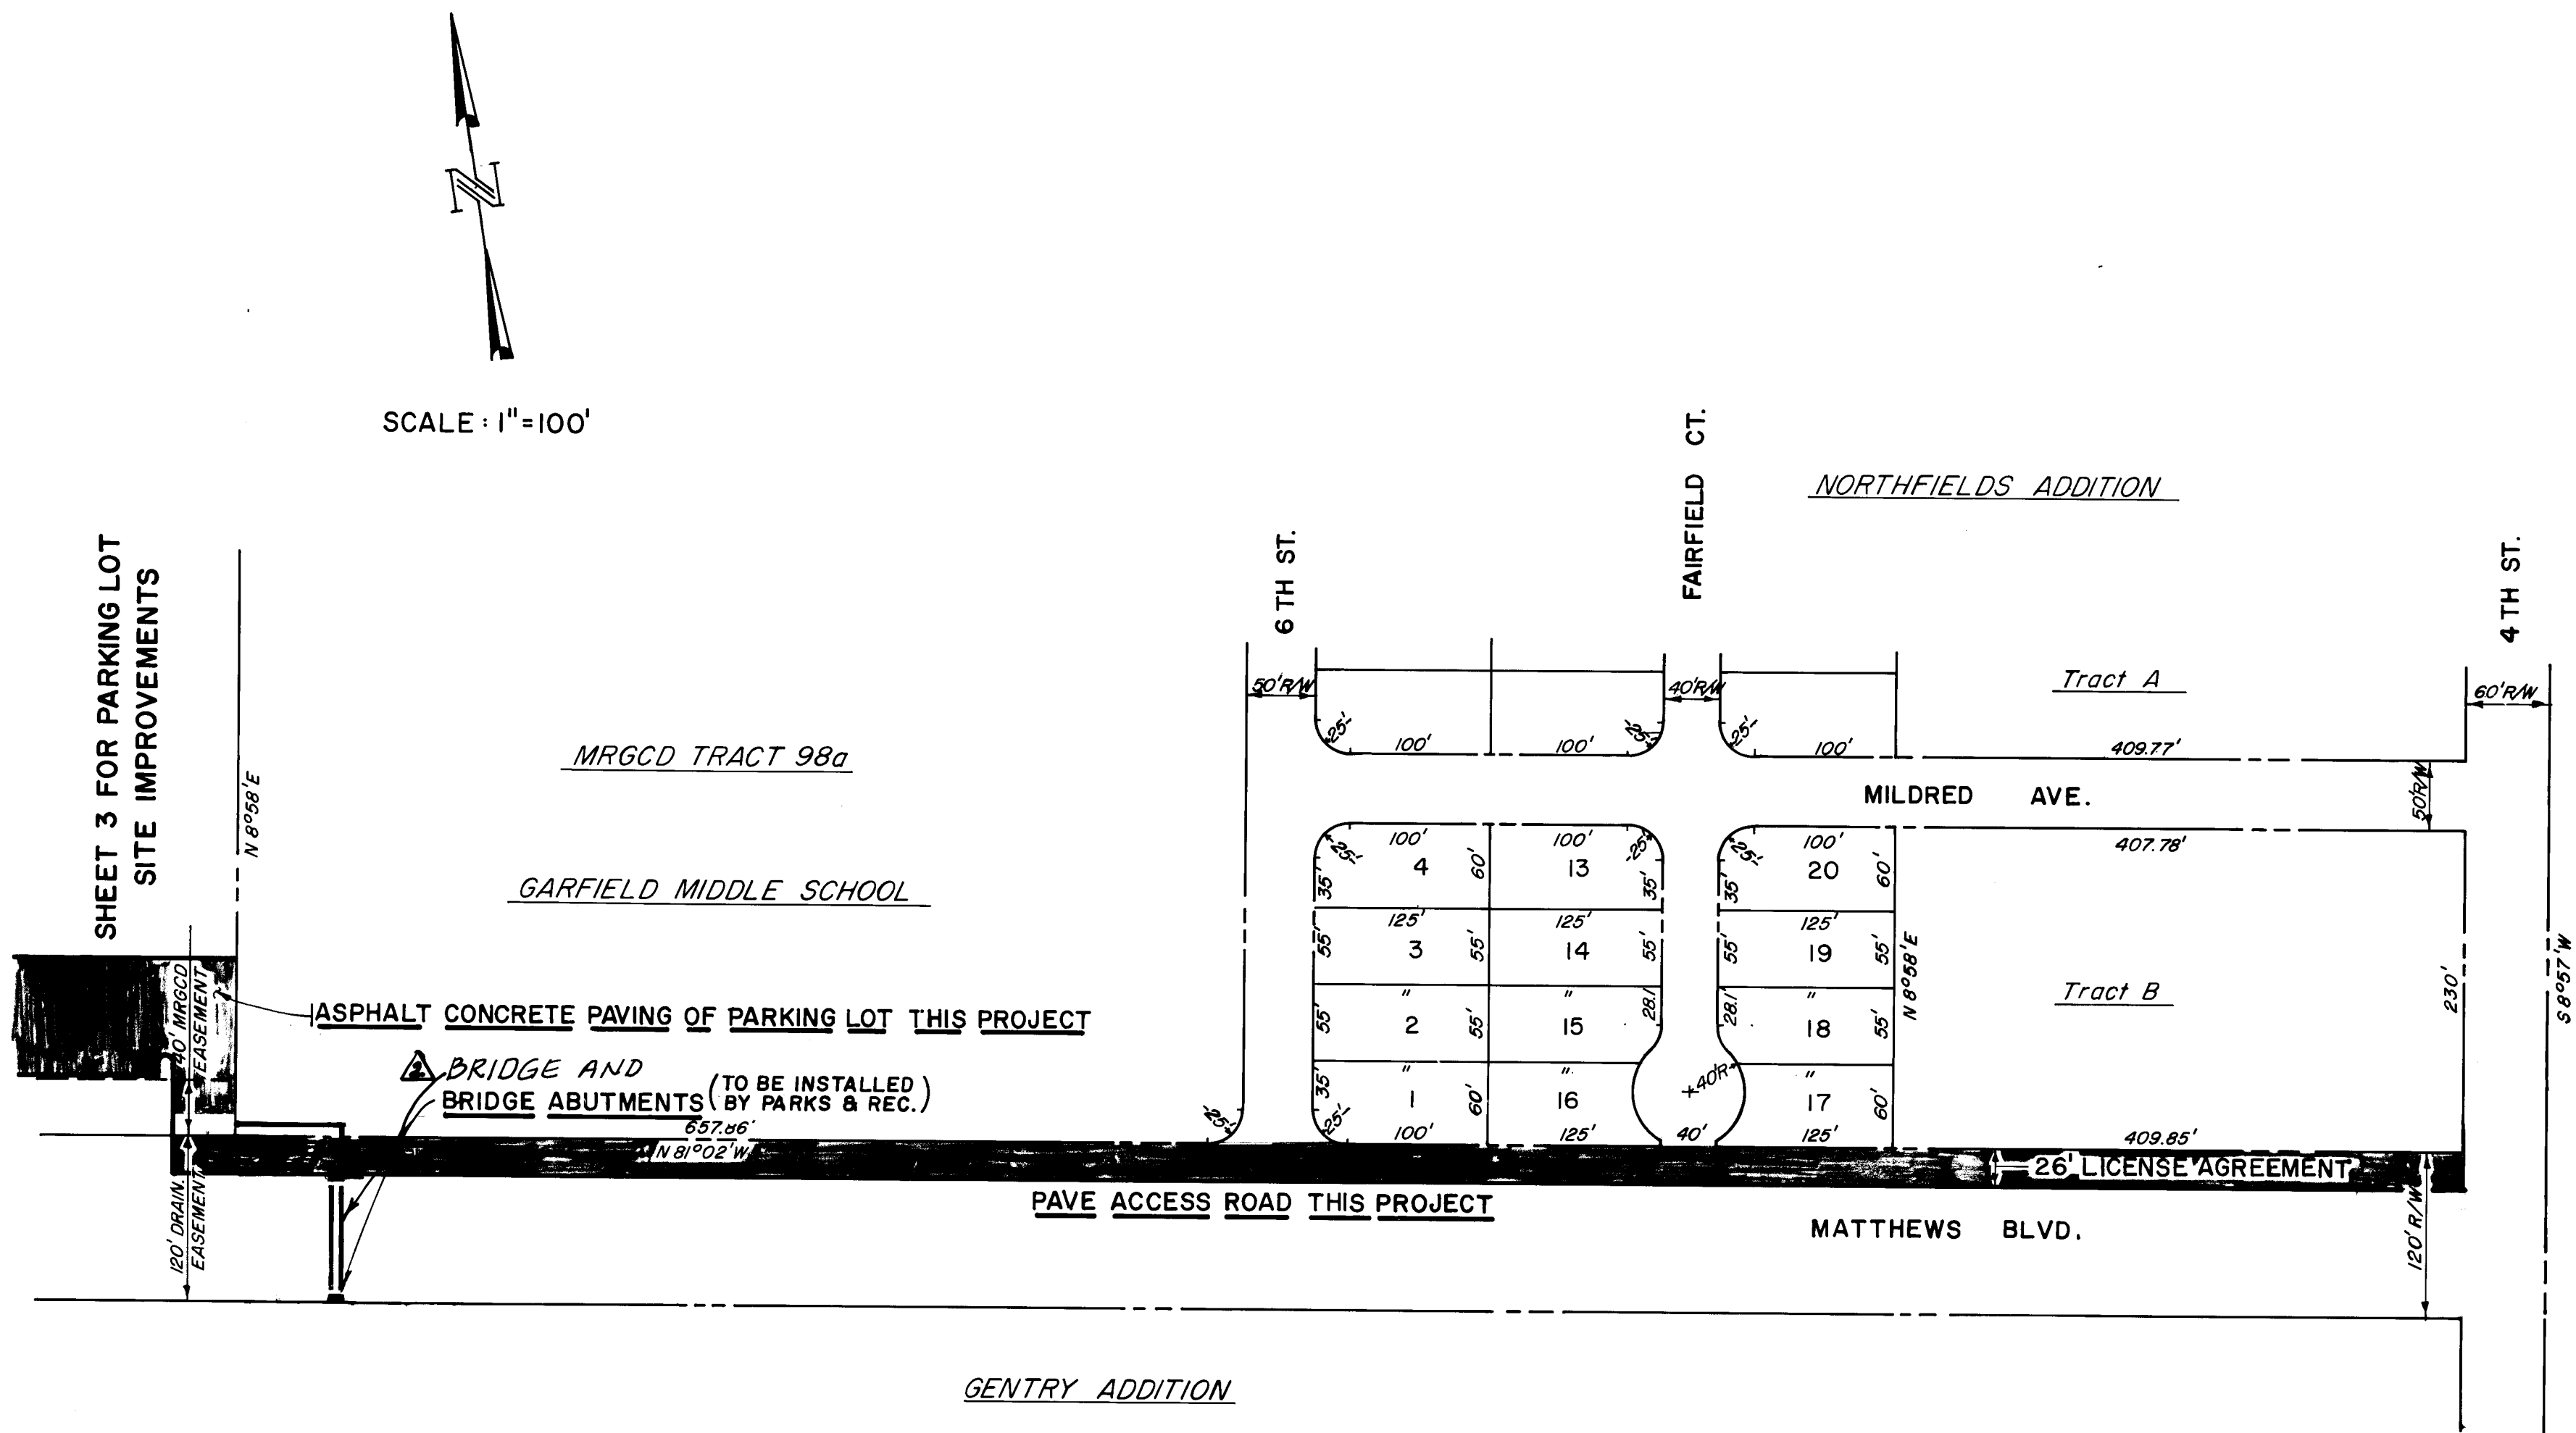


26 18.06 0284
ADDENDUM
NO. 3

CITY OF ALBUQUERQUE MUNICIPAL DEVELOPMENT DEPARTMENT ENGINEERING DIVISION					
TITLE: NORTH VALLEY PARK PROJECT LAY-OUT					
APPROVALS	ENGINEER	DATE	APPROVALS	ENGINEER	DATE
City Engineer	<i>[Signature]</i>	12/30/83	Liquid Waste	NA	11-4-83
A.C.E. - Design	<i>[Signature]</i>	12/30/83	Traffic	<i>[Signature]</i>	11/25/83
A.C.E. - Hydrology	<i>[Signature]</i>	11/14/83	Water	NA	11-4-83
DRAWING NO. 1806 MAP NO. 6-14 SHEET 2 OF 5					

ENGINEER'S SEAL		SURVEY INFORMATION		BENCH MARKS		AS BUILT INFORMATION	
NO. DATE P-33 6-20-83 BY AQUAR DATE 6-20-83 LOCATED AT THE INTERSECTION OF 4TH & CLAREMONT N.W. IN THE SOUTHEAST QUADRANT OF THE INTERSECTION.	C.K. BY NO. DATE 2/2/84 Added "Bridge and"	NO.	BY	B. M. 5-H14	CONTRACTOR	WORK	DATE
		NO.	BY	LOCATED AT THE INTERSECTION OF 4TH & CLAREMONT N.W. IN THE SOUTHEAST QUADRANT OF THE INTERSECTION.	INSPECTED BY	INSPECTION	DATE
		NO.	BY	REVISIONS	REVISIONS	REVISIONS	DATE
		NO.	BY	DESIGN	DESIGN	DESIGN	DATE
DESIGNED BY C. TOMLINSON DRAWN BY M. J. ZAMORA CHECKED BY		MICRO-FILM INFORMATION RECORDED BY NO.		MICRO-FILM INFORMATION RECORDED BY NO.		MICRO-FILM INFORMATION RECORDED BY NO.	

1806

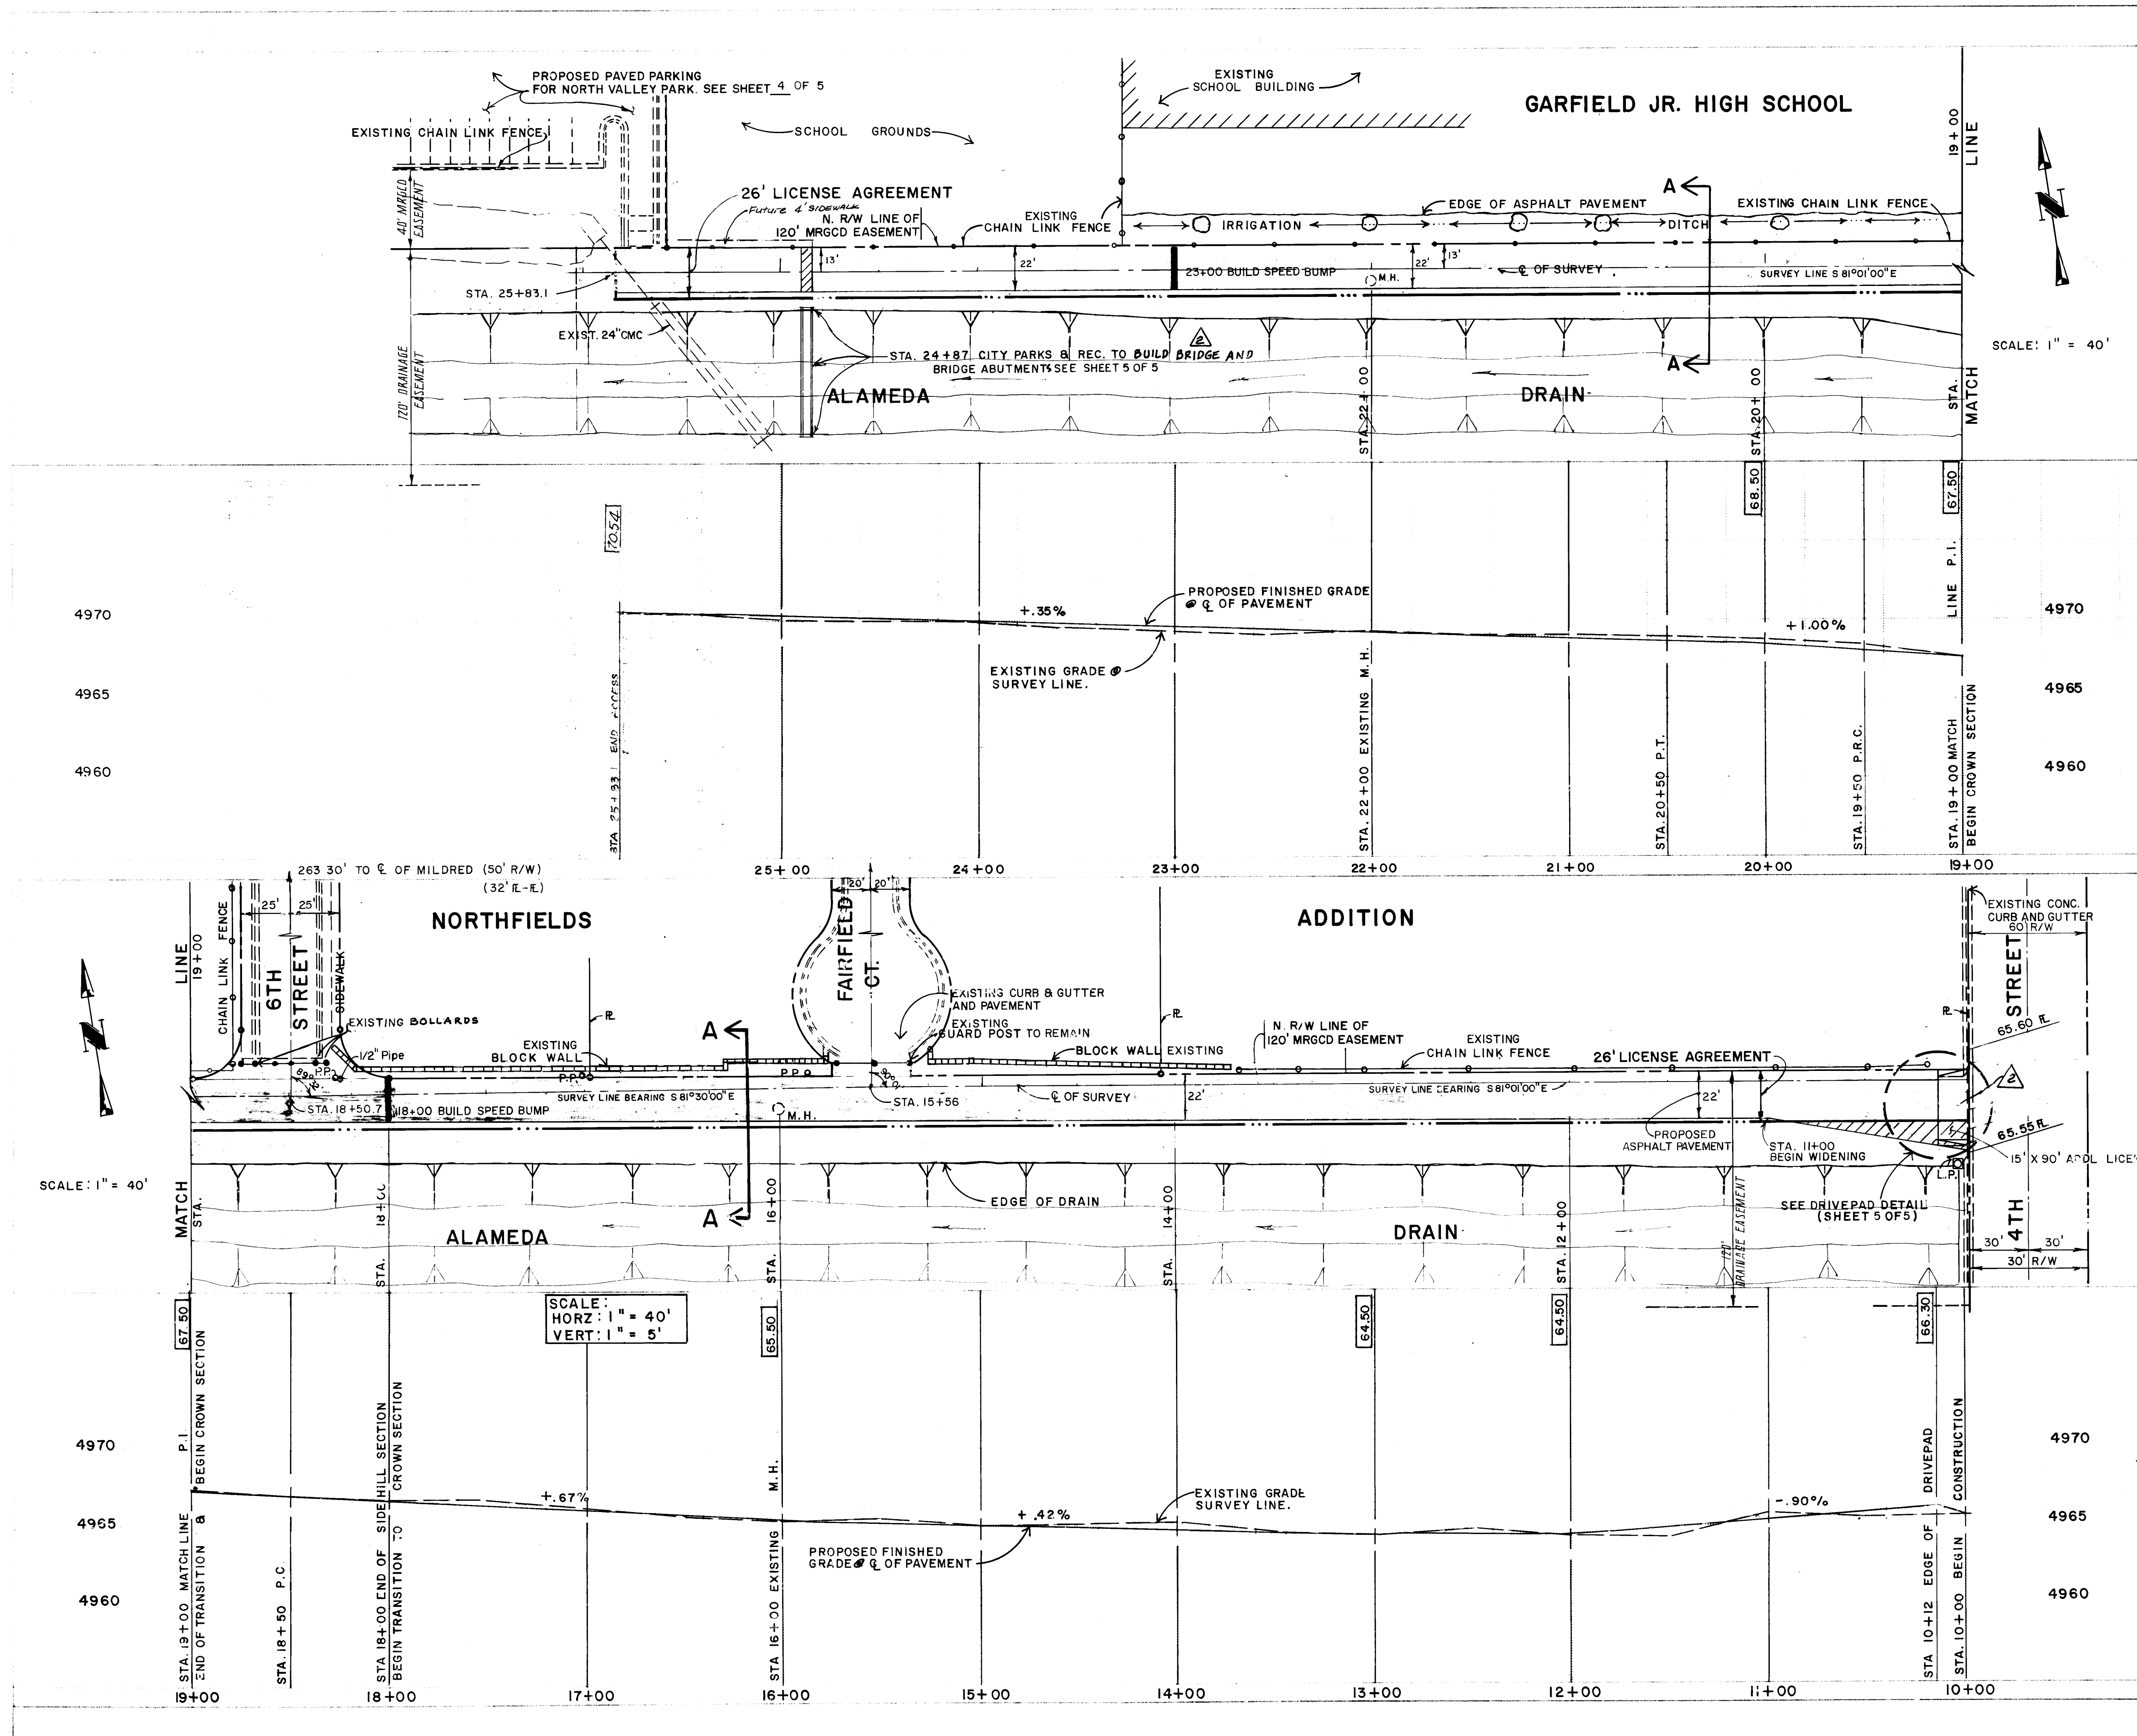

LEGEND-
65.60 E. - EXIST. FLOWLINE ELEVATION
67.50 - PROPOSED FINISHED GRADE ELEVATION @ C. OF P.V.M.T.

AS BUILT INFORMATION		BENCH MARKS		SURVEY INFORMATION		ENGINEER'S SEAL		REVISIONS		DESIGN	
DATE	DATE	B. M. 5-H14	LOCATED AT THE INTERSECTION OF 4TH & CLAREMONT N.W. IN THE SOUTHEAST QUADRANT OF THE INTERSECTION.	NO.	BY	DATE	DATE	NO.	DATE	DESIGNED BY	DATE
				PS-33	AQUIAR	6/20/83				C. TOMLINSON	7/83
										R. SALAZAR	7/83

ADDENDUM NO. 3

CITY OF ALBUQUERQUE
MUNICIPAL DEVELOPMENT DEPARTMENT
ENGINEERING DIVISION

TITLE
NORTH VALLEY PARK ACCESS ROAD PAVEMENT

APPROVALS	ENGINEER	DATE	APPROVALS	ENGINEER	DATE
City Engineer		12/30/83	Liquid Waste	NA	7-83
ACE Design		8/20/83	Traffic	NA	7-83
ACE Hydrology		12/28/83	Water	NA	7-83
PARKS		10-26-83			

DRAWING NO. 1806
MAP NO. 6-14
SHEET 3 OF 5

PROPOSED PAVEMENT SECTION
SCALE: 1"=1'

NOTE:  THE ~~BLOCK TO BLOCK~~ CONTRACTOR SHALL PAVE THE PARKING LOT ACCORDING TO THE PROPOSED PAVEMENT SECTION.

 THE CITY PARKS & RECREATION DEPARTMENT SHALL BUILD THE CONCRETE STANDARD CURB & GUTTER, SIDEWALKS AND DRIVEPAD, ~~BRIDGE~~ ^{NO ADJUSTMENTS}. INSTALLATION OF GATES FENCES AND BIKERACK, PAINTING AND STRIPING SHALL BE DONE BY PARKS DEPARTMENT ALSO.

LEGEND:

 - PROPOSED ASPHALT PAVING

 - SIDEWALK, CURB & GUTTER AND DRIVEPAD (By Parks & Recreation.)

ADDENDUM
NO. 3


CITY OF ALBUQUERQUE
MUNICIPAL DEVELOPMENT DEPARTMENT
ENGINEERING DIVISION

TITLE: **NORTH VALLEY PARK
PARKING LOT PAVEMENT PLAN**

APPROVALS		ENGINEER	DATE	APPROVALS		ENGINEER	DATE
City Engineer		<i>AD Becker</i>	12/24/83	Liquid Waste		<i>WJ WFS</i>	1-4-83
A.C.E. - Design		<i>John Becker</i>	25/24/83	Traffic		<i>WJ WFS</i>	1/28/83
A.C.E. - Hyarology		<i>John Becker</i>	12/26/83	Water		<i>WJ WFS</i>	1-4-83
<i>PARKS</i>		<i>Richard H. Heston</i>	10-26-83				
DRAWING NO. 1806			MAP NO. G-14		SHEET 4 OF 5		

ENGINEER'S SEAL				SURVEY INFORMATION		BENCH MARKS		AS BUILT INFORMATION	
NO.		DATE		BY		LOCATED AT THE INTERSECTION OF 4TH &		CONTRACTOR	
P-33		6-20-83		AQUAR				WORK STARTED BY DATE	
								FIELD ACCEPTANCE BY DATE	
								FIELD LOCATION BY DATE	
								DRAWINGS CORRECTED BY DATE	
								MICRO-FILM RECORDED BY DATE	
								NO.	

								DELETED NOTE FROM ANTHONY-SEE FILE C.I. DELETED "BLOCK-TO-BLOCK" PARTS TO BUILD BRIDGE & AUTHORITY C.T.	C.T.
NO.	DATE	REMARKS							BY
DESIGN									
DESIGNED BY	DATE								
DRAWN BY M. U. ZOMORA	DATE 8 / 83								
CHECKED BY	DATE								

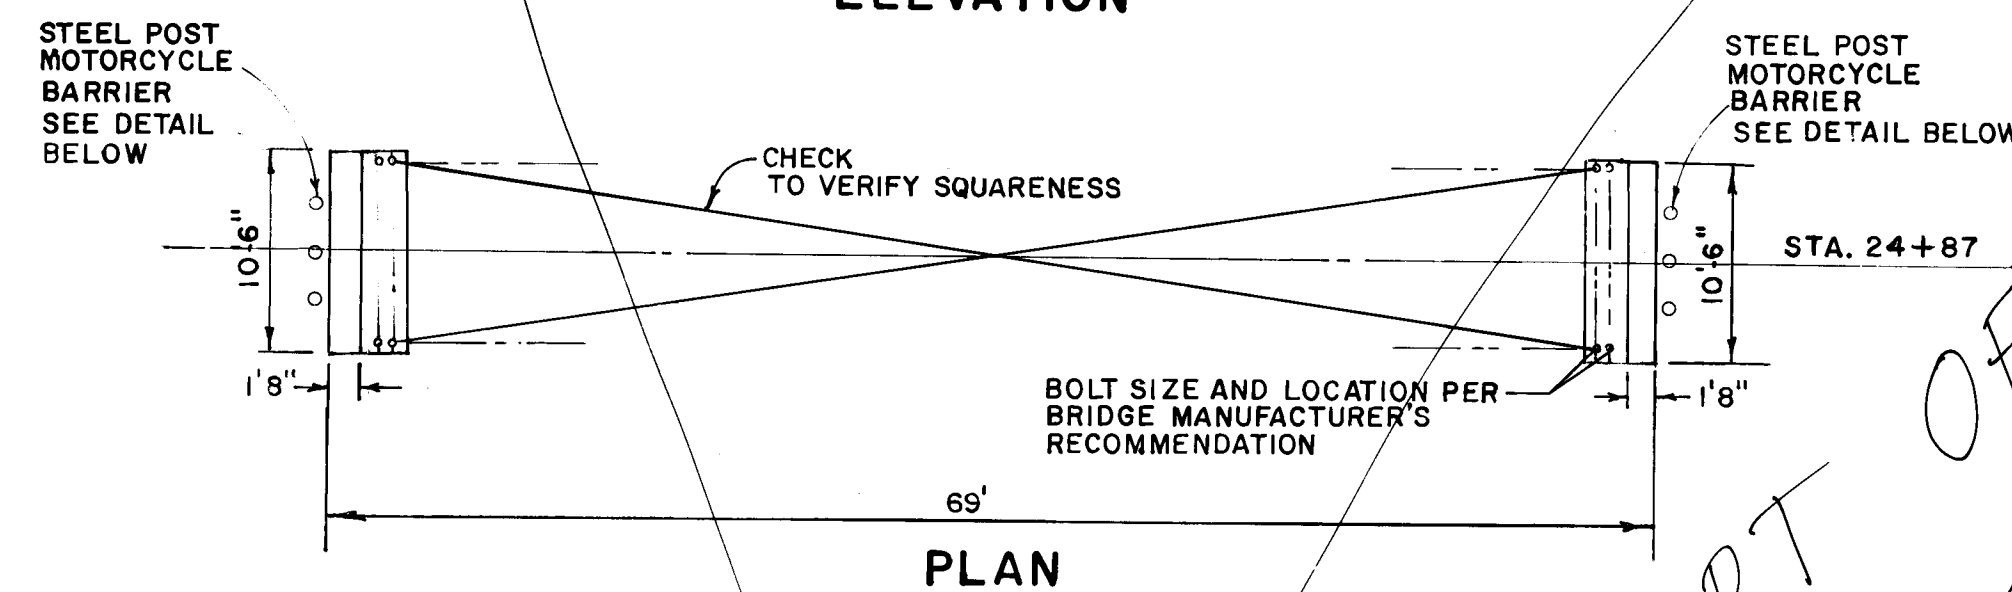

CRITERIA FOR BRIDGE


-

Diagram showing the elevation of a handrail section. The dimensions are indicated on the right side of the drawing:


- Top section: 1'-6"
- Middle section: 2'-6" O.C.
- Bottom section: 2'-6" O.C.
- Bottom section: 1'-6"

SCALE: 1" = 10'


SECTION B-B

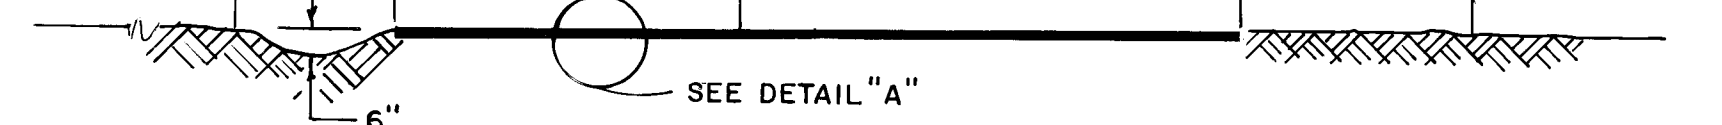

SCALE: 1" = 5'

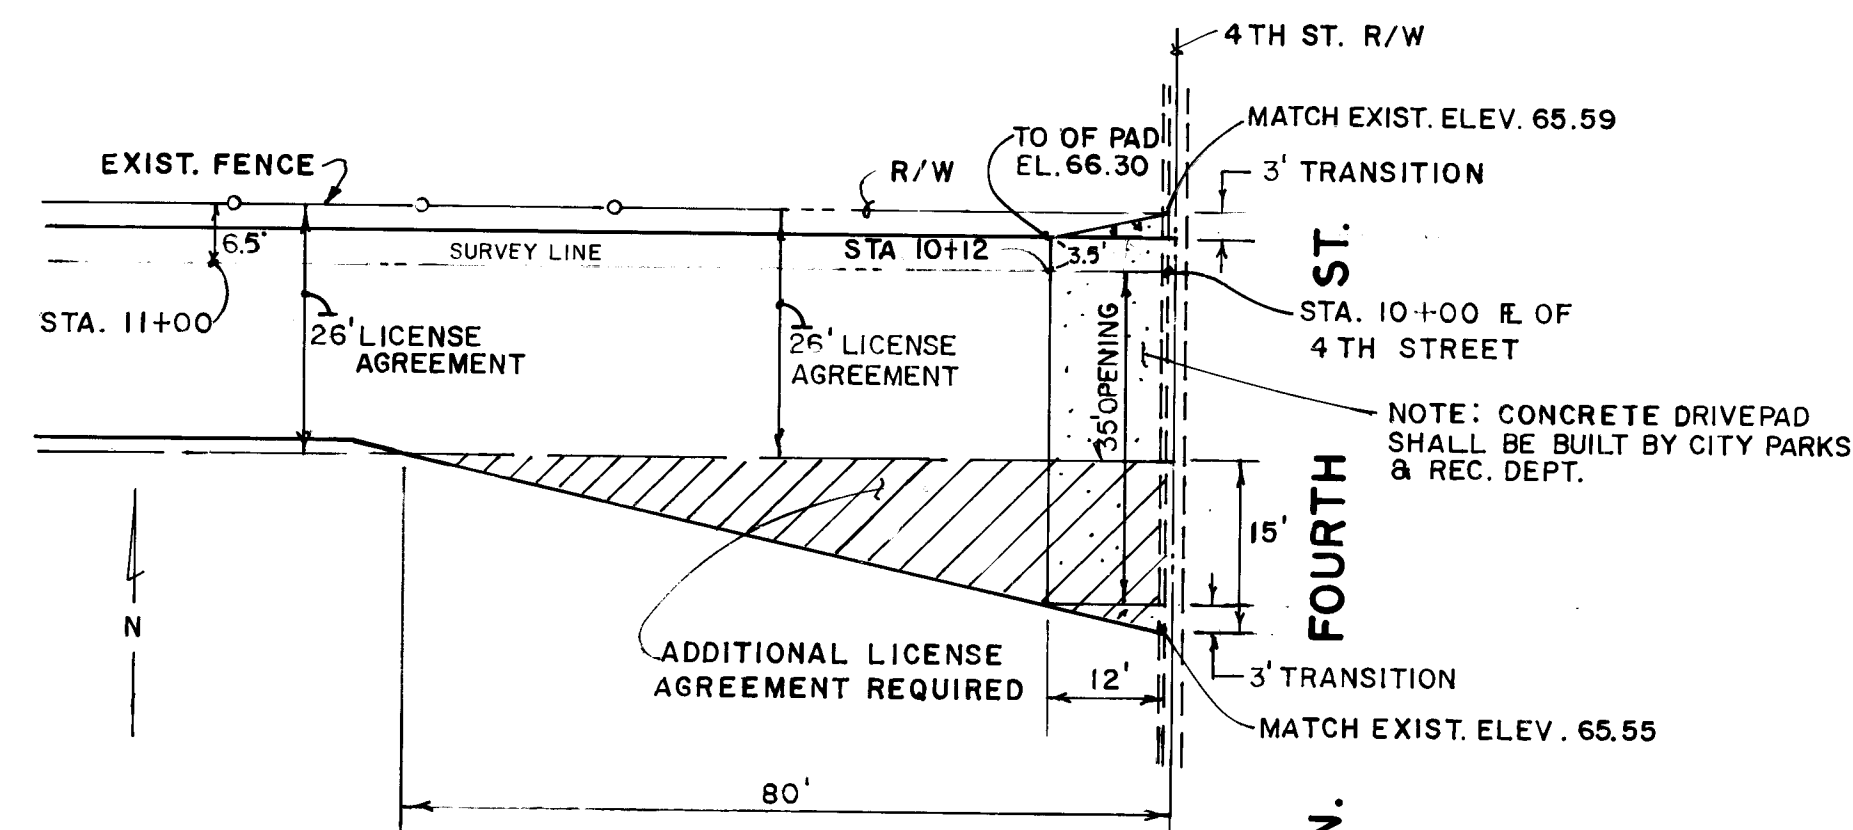

SCALE: 1"=20'

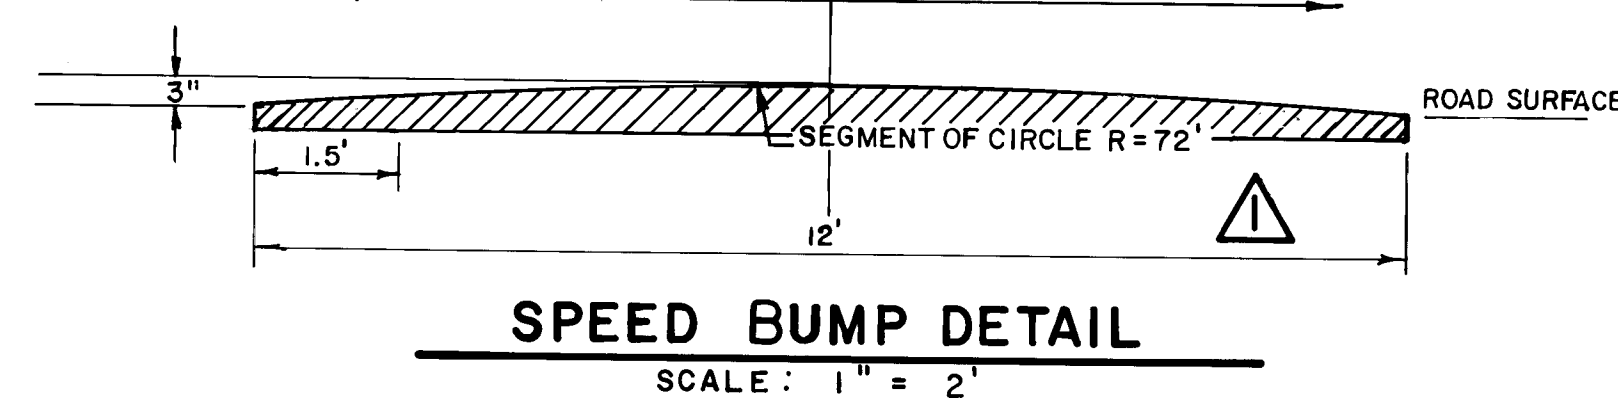

ADDENDUM
NO. 3

[illegible]

26 1806 0584

CITY OF ALBUQUERQUE MUNICIPAL DEVELOPMENT DEPARTMENT ENGINEERING DIVISION	
TITLE:	NORTH VALLEY PARK DETAILS

APPROVALS	ENGINEER	DATE	APPROVALS	ENGINEER	DATE
City Engineer	<i>[Signature]</i>	12/20/83	Liquid Waste	NA WFS	11-4-83
A C E - Design	<i>[Signature]</i>	8 Dec 83	Traffic	<i>[Signature]</i>	11/28/83
A C E - Hydrology	<i>[Signature]</i>	12/28/83	Water	NA WFS	11-4-83
PARKS	<i>[Signature]</i>	10-26-83			

DRAWING NO.	1806	MAP NO.	6-14	SHEET	5	OF	5
-------------	------	---------	------	-------	---	----	---