


HOME PLANNING DEVELOPMENT CO.

ALBUQUERQUE, NEW MEXICO

THOMAS VILLAGE PATIO HOMES



SITE IMPROVEMENTS

ANDREWS, ASBURY & ROBERT, INC.
CONSULTING ENGINEERS
ALBUQUERQUE NEW MEXICO

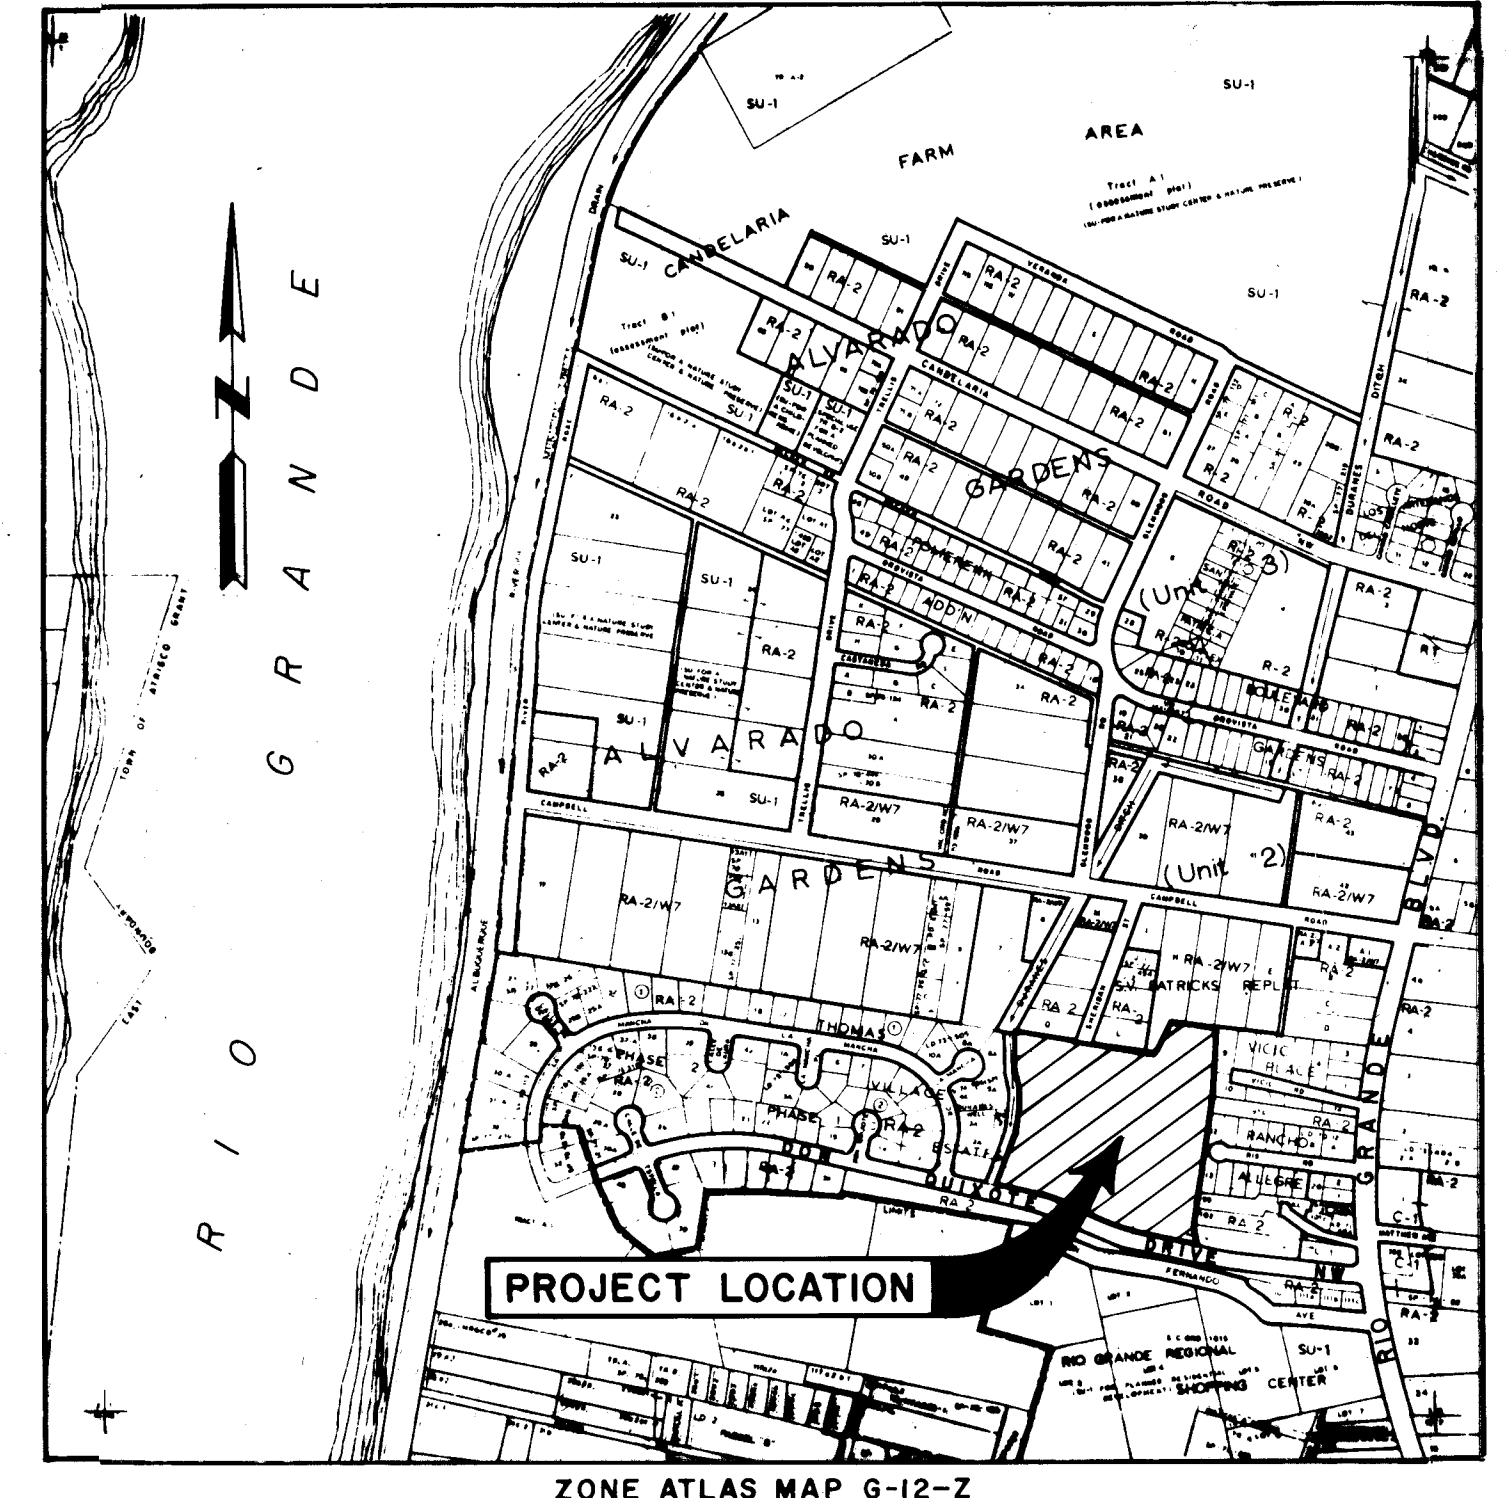


INDEX

DESCRIPTION	SHEET No.
TITLE SHEET & INDEX	1
SUBDIVISION PLAT (SHEET 1 OF 2) & NOTICE TO CONTRACTORS & GENERAL NOTES	2
SUBDIVISION PLAT (SHEET 2 OF 2)	3
GRADING PLAN	4
PAVING PLAN	5
WATER & SANITARY SEWER PLAN	6
STORM DRAIN PLAN	7
PAVING PLAN & PROFILE	8
DON JUAN NW	9
DON PABLO NW	10
DON PEDRO NW	11
DON PANCHITO ROAD NW	12
WATER & SANITARY SEWER PLAN & PROFILE	13
DON JUAN NW	14
DON PABLO NW	15
DON PEDRO NW	16
DON PANCHITO ROAD NW	17
STORM DRAIN PLAN & PROFILE	18
DON QUIXOTE ROAD NW	19
DON PEDRO NW	20
TYPICAL STREET SECTION & MISCELLANEOUS DETAILS	
MISCELLANEOUS DETAILS	
JUNCTION BOX & MISCELLANEOUS DETAILS	

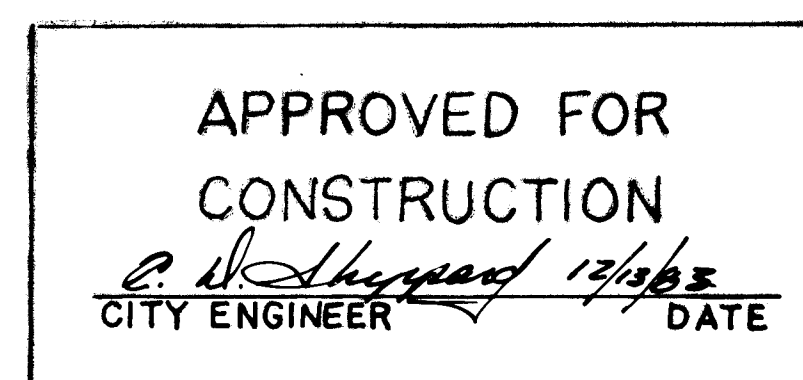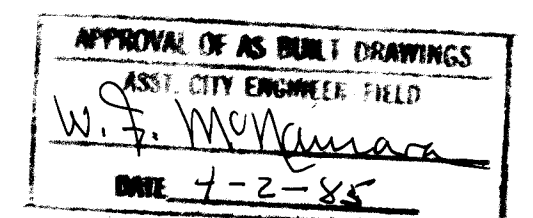

RECORD DRAWING

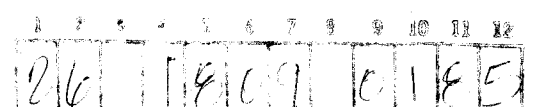

ENGR'S. FILE No. 82-319

SET No. _____

C22-94



LOCATION MAP
ZONE ATLAS MAP G-12

SUBDIVISION DATA

- SUBDIVISION CASE NO. Z-83-30-1
- ZONE ATLAS INDEX NO. G-12-2
- GROSS SUBDIVISION ACREAGE: 12.4269 ACRES
- TOTAL NUMBER OF LOTS CREATED: 70 LOTS
- TOTAL MILEAGE OF FULL WIDTH STREETS CREATED: 0.4257 MILES
- DATE OF SURVEY: JANUARY, 1983

NOTES

- BEARINGS ARE N.M. STATE PLANE GRID BEARINGS (CENTRAL ZONE).
- DISTANCES ARE GROUND DISTANCES.
- ALL BOUNDARY CORNERS MARKED THIS DATE WITH 5 REBARS WITH PLASTIC CAP STAMPED PE & LS 2455 UNLESS OTHERWISE NOTED ON THE PLAT.
- TRACTS A, B, C, D, E, AND F ARE COMMON AREAS OWNED IN FEE SIMPLE BY THE THOMAS VILLAGE PATIO HOMES HOMEOWNERS ASSOCIATION, AND WILL BE USED FOR RECREATIONAL, ACCESS, PRIVATE PARKING, AND DRAINAGE PURPOSES, AND WILL BE OPERATED AND MAINTAINED BY THOMAS VILLAGE PATIO HOMES HOMEOWNERS ASSOCIATION.

TRACT A TO BE USED FOR PRIVATE PARKING AND GRANTED TO THE CITY OF ALBUQUERQUE AS AN EASEMENT FOR ACCESS BY PUBLIC EMERGENCY VEHICLES AND AS A PUBLIC WATERLINE EASEMENT.

TRACT B TO BE USED AS AN ACCESS EASEMENT TO LOTS 14 THROUGH 17 AND IS GRANTED TO THE CITY OF ALBUQUERQUE AS A PUBLIC WATER AND SANITARY SEWER LINE EASEMENT.

TRACTS C, E, AND F ARE GRANTED TO THE CITY OF ALBUQUERQUE AS PUBLIC DRAINAGE EASEMENTS.

LEGAL DESCRIPTION

83 73686

A CERTAIN TRACT OF LAND SITUATE IN SECTION 1, T10N, R2E, N.M.P.M., BERNALILLO COUNTY, NEW MEXICO, AND BEING ALL OF TRACT "A" OF THOMAS VILLAGE PATIO HOMES, AS THE SAME IS SHOWN AND DESIGNATED ON THE PLAT FILED IN THE OFFICE OF THE COUNTY CLERK OF BERNALILLO COUNTY, NEW MEXICO, ON OCTOBER 12, 1982, AND BEING MORE PARTICULARLY DESCRIBED BY NEW MEXICO STATE PLANE GRID BEARINGS (CENTRAL ZONE) AND GROUND DISTANCES AS FOLLOWS:

BEGINNING AT THE NORTHWEST CORNER OF THE TRACT HEREIN DESCRIBED, SAID CORNER BEING THE NORTHWEST CORNER OF SAID TRACT "A", A POINT ON THE EASTERLY RIGHT OF WAY OF THE DURANES DITCH, WHENCE THE U.S.C.E. MONUMENT "R. 898 C-1" (NEW MEXICO STATE PLANE COORDINATES, CENTRAL ZONE, X = 372,705.78, Y = 1,499,372.05) BEARS:
S 80°04'23" E, 138.70 FEET AND FROM POINT OF BEGINNING RUNNING THENCE ALONG THE NORTHERLY BOUNDARY OF SAID TRACT "A",
S 80°52'31" E, 547.89 FEET TO A POINT; THENCE,
N 25°01'42" E, 145.24 FEET TO A POINT; THENCE,
S 80°27'52" E, 199.65 FEET TO THE NORTHEAST CORNER OF THE TRACT HEREIN DESCRIBED, BEING THE NORTHWEST CORNER OF VICIC PLACE, AS THE SAME IS SHOWN AND DESIGNATED ON THE PLAT FILED IN THE OFFICE OF THE COUNTY CLERK OF BERNALILLO COUNTY, NEW MEXICO, ON FEBRUARY 23, 1946; THENCE CONTINUING ALONG THE WESTERLY BOUNDARY OF SAID VICIC PLACE,
S 07°57'28" W, 254.14 FEET TO A POINT BEING THE SOUTHWEST CORNER OF SAID VICIC PLACE; THENCE,
S 08°23'37" W, 70.10 FEET TO A POINT BEING THE NORTHWEST CORNER OF RANCHO ALEGRE, AS THE SAME IS SHOWN AND DESIGNATED ON THE PLAT FILED IN THE OFFICE OF THE COUNTY CLERK OF BERNALILLO COUNTY, NEW MEXICO ON SEPTEMBER 29, 1945; THENCE CONTINUING ALONG THE WESTERLY BOUNDARY OF RANCHO ALEGRE, S07°28'17" W, 296.06 FEET TO THE SOUTHWEST CORNER OF SAID RANCHO ALEGRE; THENCE,
S 07°54'27" W, 239.97 FEET TO THE SOUTHEAST CORNER OF THE TRACT HEREIN DESCRIBED, SAID CORNER BEING A POINT ON THE NORTHERLY RIGHT OF WAY OF DON QUIXOTE DRIVE; THENCE CONTINUING ALONG SAID NORTHERLY RIGHT OF WAY,
N 77°19'31" W, 231.54 FEET TO A POINT OF CURVATURE; THENCE, 84.48 FEET ALONG THE ARC OF A CURVE TO THE RIGHT HAVING A RADIUS OF 450.00 FEET AND A CHORD BEARING N 71°56'50" W, 84.35 FEET TO A POINT OF TANGENCY; THENCE,
N 66°34'09" W, 251.81 FEET TO A POINT OF CURVATURE; THENCE, 104.45 FEET ALONG THE ARC OF A CURVE TO THE LEFT HAVING A RADIUS OF 593.87 FEET AND A CHORD BEARING OF N 71°36'29" W, 104.32 FEET TO A POINT OF TANGENCY; THENCE,
N 76°38'48" W, 133.91 FEET TO THE SOUTHWEST CORNER OF THE TRACT HEREIN DESCRIBED SAID CORNER BEING A POINT ON THE EASTERLY RIGHT OF WAY OF THE DURANES DITCH; THENCE LEAVING SAID RIGHT OF WAY OF DON QUIXOTE AND CONTINUING ALONG SAID EASTERLY RIGHT OF WAY OF THE DURANES DITCH,
N 21°05'28" E, 222.57 FEET TO A POINT; THENCE,
N 09°32'37" E, 79.37 FEET TO A POINT; THENCE,
N 04°25'22" E, 80.54 FEET TO A POINT; THENCE,
N 10°52'07" W, 76.44 FEET TO A POINT; THENCE,
N 00°21'43" W, 158.43 FEET TO THE POINT AND PLACE OF BEGINNING.

TRACT CONTAINS 12.4269 ACRES, MORE OR LESS.

FREE CONSENT AND DEDICATION

THE SUBDIVISION HEREON DESCRIBED IS WITH THE FREE CONSENT AND IN ACCORDANCE WITH THE DESIRES OF THE UNDERSIGNED OWNER AND/OR PROPRIETOR(S) THEREOF AND SAID OWNER AND/OR PROPRIETOR(S) DO HEREBY DEDICATE ALL STREETS AND PUBLIC RIGHT-OF-WAY SHOWN HEREON TO THE CITY OF ALBUQUERQUE IN FEE SIMPLE AND DO HEREBY GRANT ALL UTILITY EASEMENTS SHOWN HEREON TO THE PUBLIC USE FOREVER INCLUDING THE RIGHTS OF INGRESS AND EGRESS (BOTH SURFACE AND SUBSURFACE). THE UNDERSIGNED OWNER AND/OR PROPRIETOR(S) ALSO GRANT TO THE CITY OF ALBUQUERQUE IN PERPETUITY ALL SANITARY SEWER, WATER LINE, AND DRAINAGE FACILITIES THEREIN. UNLESS SPECIFICALLY LIMITED ELSEWHERE ON THIS PLAT, ALL EASEMENTS GRANTED TO THE CITY OF ALBUQUERQUE MAY BE USED FOR ANY OR ALL OF THE PURPOSES OF SANITARY SEWER, WATER LINE, OR DRAINAGE FACILITY EVEN THOUGH ONLY ONE OF THESE PURPOSES IS STATED ON THE EASEMENT AS DRAWN ON THE PLAT.

LESLIE CORPORATION
BY: *John J. Leslie*
JOHN J. LESLIE, PRESIDENT

ATTEST:
BY: *Betty Leslie*
BETTY LESLIE

STATE OF NEW MEXICO }
COUNTY OF BERNALILLO } ss.

THE FOREGOING INSTRUMENT WAS ACKNOWLEDGED BEFORE ME THIS 22ND DAY OF February, 1983, BY JOHN J. LESLIE, PRESIDENT OF LESLIE CORPORATION ON BEHALF OF SAID CORPORATION.

MY COMMISSION EXPIRES: 12/31/83
Harold C. Roberts
NOTARY PUBLIC



12/31/83

SUBDIVISION PLAT FOR
THOMAS VILLAGE
PATIO HOMES

WITHIN SECTION 1, T10N, R2E, N.M.P.M.
BERNALILLO COUNTY
ALBUQUERQUE, NEW MEXICO

FEBRUARY, 1983

APPROVALS

Robert A. Zumbach 9-13-83
CITY ENGINEER, TRANSPORTATION DEPARTMENT
Charles J. DeLoe 9/29/83
PARKS AND RECREATION DEPARTMENT
Dorey L. Hinkley 3-21-83
PUBLIC SERVICE COMPANY
Carin B. Santana 3/17/83
MOUNTAIN BELL TELEPHONE
Gay H. Hume 3-19-83
GAS COMPANY
John B. Robert 4/5/83
CHIEF CITY SURVEYOR, ENGINEERING DIVISION
O. Val Veldner 3-21-83
PROPERTY MANAGEMENT
D. J. Thompson 9/13/83
WATER RESOURCES
396 NA 10/25/83
ALBUQUERQUE METROPOLITAN ARROYO FLOOD CONTROL AUTHORITY
7/1 Aguirre 10/25/83
CITY ENGINEER, ENGINEERING DIVISION

APPROVAL AND CONDITIONAL ACCEPTANCE AS SPECIFIED BY THE ALBUQUERQUE SUBDIVISION ORDINANCE, ARTICLE XI OF CHAPTER 7 OF THE REVISED ORDINANCES OF ALBUQUERQUE, NM.

J. L. Lamm SP-83-309 10-25-83
CITY PLANNER, ALBUQUERQUE/BERNALILLO COUNTY PLANNING DIVISION

SURVEYOR'S CERTIFICATE

I, JOHN B. ROBERT, DO HEREBY CERTIFY THAT I AM A REGISTERED LAND SURVEYOR UNDER THE LAWS OF THE STATE OF NEW MEXICO, AND THAT THIS PLAT WAS PREPARED BY ME OR UNDER MY SUPERVISION, SHOWS ALL EASEMENTS OF RECORD, MEETS THE MINIMUM REQUIREMENTS FOR MONUMENTATION AND SURVEYS OF THE ALBUQUERQUE SUBDIVISION ORDINANCE, AND IS TRUE AND CORRECT TO THE BEST OF MY KNOWLEDGE AND BELIEF.

John B. Robert Feb 22, 1983
JOHN B. ROBERT, P.E. & L.S. No. 1817 DATE



ANDREWS, ASBURY & ROBERT, INC.
CONSULTING ENGINEERS
ALBUQUERQUE 82-319 NEW MEXICO

GENERAL NOTES

- CONTRACTOR SHALL BE RESPONSIBLE FOR OBTAINING ALL OR ANY BORROW MATERIAL. ALL BORROW MATERIAL SHALL BE APPROVED BY THE ENGINEER PRIOR TO INCORPORATION OF ANY MATERIAL IN THE PROJECT.
- CONTRACTOR SHALL PROVIDE 6" SUBGRADE PREPARATION UNDER ALL NEW CONCRETE STRUCTURES, FOOTINGS, SLABS, AND CONCRETE LINING. NO SEPARATE PAYMENT WILL BE MADE FOR SUBGRADE PREPARATION AND SHALL BE CONSIDERED INCIDENTAL TO THE ITEM TO WHICH THE SUBGRADE PREPARATION PERTAINS.
- CONTRACTOR SHALL REMOVE AND DISPOSE OF ALL OBJECTIONABLE MATERIAL FROM THE CONSTRUCTION AREA. ALL COSTS FOR SUCH REMOVAL SHALL BE INCLUDED UNDER BID ITEM NO. 1-1, SITE PREPARATION.
- RADII SHOWN FOR CURB RETURNS ARE TO FACE OF CURB (FLOWLINE) UNLESS OTHERWISE INDICATED.
- FINISH GRADE ELEVATIONS SHOWN ON PLANS AND PROFILES ARE FLOWLINE OF CURB & GUTTER UNLESS OTHERWISE DESIGNATED.
- SIDEWALKS TO BE CONSTRUCTED UNDER THIS CONTRACT SHALL BE FROM P.C. TO P.T. OF CURB RETURNS WITH WHEELCHAIR RAMPS ONLY. OTHER SIDEWALKS SHOWN ON THE PLANS ARE SHOWN FOR INFORMATION ONLY.
- REINFORCED CONCRETE STRUCTURES SHALL HAVE REINFORCING STEEL CONTINUOUS AT ALL CORNERS.
- DOWELS SHALL BE PROVIDED AT ALL CONNECTIONS OF REINFORCED CONCRETE CONSTRUCTION UNLESS OTHERWISE SHOWN.
- ALL EXPOSED CONCRETE STRUCTURE SURFACES, TO A MINIMUM OF 6 INCHES BELOW FINISH GRADE SHALL BE FINISHED WITH "THOROSEAL" AS PER MMSD SPECIFICATIONS FOR ROAD AND BRIDGE CONSTRUCTION, PARAGRAPH 509.037, TYPE I.
- 2" TO 4" DIAMETER ROCK FOR EROSION PROTECTION DOWNSTREAM OF RUNDOWNS SHALL BE SMOOTH NATURAL STONES, BROKEN CONCRETE IS NOT ACCEPTABLE.
- MEASUREMENT AND PAYMENT FOR ADJUSTING MANHOLE FRAMES AND COVERS AND WATER VALVE BOXES WILL BE MADE FOR MANHOLES CONSTRUCTED IN NEW STREETS CONSTRUCTED UNDER THIS PROJECT ONLY. NO MEASUREMENT OR PAYMENT WILL BE MADE FOR ADJUSTMENTS OF MANHOLE FRAMES AND COVERS AND VALVE BOXES CONSTRUCTED IN EXISTING STREETS OR BEHIND CURBS AND ANY COSTS FOR ADJUSTMENT REQUIRED SHALL BE CONSIDERED INCIDENTAL TO CONSTRUCTION OF THE MANHOLE OR VALVE BOX.

AS BUILT INFORMATION		BENCH MARKS		SURVEY INFORMATION		FIELD NOTES		ENGINEER'S SEAL		REVISIONS		DESIGN		DATE		DATE		DATE	
CONTRACTOR	UNIVERSAL CONSULTING ENGINEERS	NO.	DATE	NO.	DATE	NO.	DATE	NO.	DATE	NO.	DATE	NO.	DATE	NO.	DATE	NO.	DATE	NO.	DATE

RECORD DRAWING

1 2 3 4 5 6 7 8 9 10 11 12
26 1609 0283

CITY OF ALBUQUERQUE MUNICIPAL DEVELOPMENT DEPARTMENT ENGINEERING DIVISION									
THOMAS VILLAGE PATIO HOMES-SITE IMPROVEMENTS SUBDIVISION PLAT (SHEET 1 OF 2) & NOTICE TO CONTRACTORS & GENERAL NOTES									
APPROVALS	ENGINEER	DATE	APPROVALS	ENGINEER	DATE				
City Engineer	<i>C. H. Lamm</i>	10/15/83	Liquid Waste	<i>W. J. Roberts</i>	10-18-83				
A.C.E.-Design	<i>W. J. Roberts</i>	10/15/83	Traffic	<i>W. J. Roberts</i>	10/15/83				
A.C.E.-Hydrology	<i>W. J. Roberts</i>	10/15/83	Water	<i>W. J. Roberts</i>	10-10-83				
DRAWING NO.	1809	MAP NO.	G-12-Z	SHEET	2 OF 20				

C 22-94

NOTICE TO CONTRACTORS

- NEW MEXICO STANDARD SPECIFICATIONS FOR PUBLIC WORKS CONSTRUCTION - 1979 EDITION WILL BE REFERRED TO HEREON AS THE "STANDARD SPECIFICATION".
- ALL WORK DETAILED ON THESE PLANS TO BE PERFORMED UNDER CONTRACT SHALL, EXCEPT AS OTHERWISE STATED OR PROVIDED FOR HEREON, BE CONSTRUCTED IN ACCORDANCE WITH "CONTRACT DOCUMENTS FOR CITY-WIDE UTILITIES AND CASH PAVING NO. 31 AND THE STANDARD SPECIFICATION".
- TWO WORKING DAYS PRIOR TO ANY EXCAVATION, CONTRACTOR MUST CONTACT LINE LOCATING SERVICE, 765-1234, FOR LOCATION OF EXISTING UTILITIES.
- PRIOR TO CONSTRUCTION, THE CONTRACTOR SHALL EXCAVATE AND VERIFY THE HORIZONTAL AND VERTICAL LOCATIONS OF ALL OBSTRUCTIONS. SHOULD A CONFLICT EXIST, THE CONTRACTOR SHALL NOTIFY THE ENGINEER OR SURVEYOR SO THAT THE CONFLICT CAN BE RESOLVED WITH A MINIMUM AMOUNT OF DELAY.
- ALL UTILITIES AND UTILITY SERVICE LINES SHALL BE INSTALLED PRIOR TO PAVING.
- BACKFILL COMPACTION SHALL BE ACCORDING TO SPECIFIED STREET USE.
- IF CURB IS DEPRESSED FOR A DRIVEPAD, THE DRIVEPAD SHALL BE CONSTRUCTED PRIOR TO ACCEPTANCE OF CURB AND GUTTER.
- ALL STORM DRAINAGE FACILITIES SHALL BE COMPLETED PRIOR TO FINAL ACCEPTANCE.
- THE REQUESTOR OR DEVELOPER SHALL BE RESPONSIBLE FOR REPAIR AND REPLACEMENT OF ALL CURB AND GUTTER OR SIDEWALK DAMAGED AFTER APPROVAL BY CITY ENGINEER OR WORK COMPLETED BY CONTRACT.

SEE GENERAL NOTES, THIS SHEET.

SUBDIVISION PLAT FOR THOMAS VILLAGE PATIO HOMES


BERNALILLO COUNTY
ALBUQUERQUE, NEW MEXICO

FEBRUARY, 1983

SURVEYOR'S CERTIFICATE

I, JOHN B. ROBERT, DO HEREBY CERTIFY THAT I AM A REGISTERED LAND SURVEYOR UNDER THE LAWS OF THE STATE OF NEW MEXICO, AND THAT THIS PLAT WAS PREPARED BY ME OR UNDER MY SUPERVISION, SHOWS ALL EASEMENTS OF RECORD, MEETS THE MINIMUM REQUIREMENTS FOR MONUMENTATION AND SURVEYS OF THE ALBUQUERQUE SUBDIVISION ORDINANCE, AND IS TRUE AND CORRECT TO THE BEST OF MY KNOWLEDGE AND BELIEF.

JOHN B. ROBERT, P.E. & L.S. NO. 1817 DATE 2/21/83

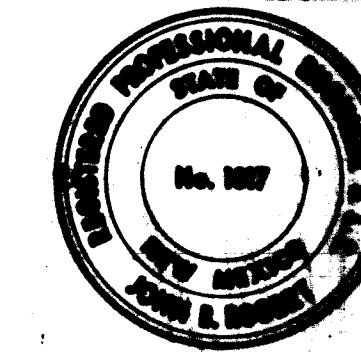

CURVE DATA

NUMBER	RADIUS	ARC	DELTA	NUMBER	RADIUS	ARC	DELTA
1	25.00'	37.46'	85°51'12"	14	583.87'	31.69'	03°03'27"
2	259.00'	36.66'	06°06'35"	15	1417.06'	128.69'	05°12'12"
3	241.00'	34.11'	08°06'35"	16	406.92'	84.13'	11°50'44"
4	486.55'	113.58'	13°22'31"	17	25.00'	22.07'	50°34'12"
5	25.00'	37.09'	85°00'00"	18	49.00'	240.43'	281°08'24"
6	25.00'	41.45'	95°00'00"	19	25.00'	22.07'	50°34'12"
7	530.55'	123.85'	13°22'31"	20	24.00'	44.91'	103°29'56"
8	25.00'	39.27'	90°00'00"	21	25.00'	38.55'	88°20'48"
9	991.45'	102.63'	05°55'51"	22	25.00'	38.55'	88°20'48"
10	569.03'	106.82'	10°45'22"	23	25.00'	38.55'	88°20'48"
11	613.03'	115.08'	10°45'22"	24	25.00'	38.55'	88°20'48"
12	947.45'	98.07'	05°55'51"	25	25.00'	38.55'	88°20'48"
13	25.00'	38.55'	87°07'36"	26	25.00'	38.55'	87°07'36"

AREA SCHEDULE

LOT #	ACRES	LOT #	ACRES	LOT #	ACRES	LOT #	ACRES
1	0.1414	19	0.1083	37	0.1083	55	0.1083
2	0.1157	20	0.1083	38	0.1083	56	0.1083
3	0.1157	21	0.1083	39	0.1083	57	0.1083
4	0.1157	22	0.1083	40	0.1083	58	0.1083
5	0.1157	23	0.1083	41	0.1083	59	0.1083
6	0.1157	24	0.1083	42	0.1083	60	0.1083
7	0.1157	25	0.1083	43	0.1083	61	0.1083
8	0.1157	26	0.1083	44	0.1083	62	0.1083
9	0.1157	27	0.1083	45	0.1083	63	0.1083
10	0.1157	28	0.1083	46	0.1083	64	0.1083
11	0.1157	29	0.1083	47	0.1083	65	0.1083
12	0.1718	30	0.1083	48	0.1083	66	0.1083
13	0.1718	31	0.1083	49	0.1083	67	0.1083
14	0.1083	32	0.1083	50	0.1083	68	0.1083
15	0.1083	33	0.1083	51	0.1083	69	0.1083
16	0.1083	34	0.1083	52	0.1083	70	0.1083
17	0.1154	35	0.1083	53	0.1083		
18	0.1083	36	0.1083	54	0.1083		

TRACT A = 0.1083 AC TRACT B = 0.1083 AC TRACT C = 1.0447 AC
TRACT D = 0.6658 AC TRACT E = 0.1083 AC TRACT F = 0.0675 AC

ANDREWS, ASBURY & ROBERT, INC.

CONSULTING ENGINEERS

ALBUQUERQUE, NEW MEXICO

Sheet 2 of 2

caa-94



RECORD DRAWING

CITY OF ALBUQUERQUE
MUNICIPAL DEVELOPMENT DEPARTMENT
ENGINEERING DIVISION



THOMAS VILLAGE PATIO HOMES-SITE IMPROVEMENTS
SUBDIVISION PLAT (SHEET 2 OF 2)

APPROVALS	ENGINEER	DATE	APPROVALS	ENGINEER	DATE
City Engineer	<i>[Signature]</i>	11/15/83	Liquid Waste	NA	
A.C.E.-Design	<i>[Signature]</i>	11/15/83	Traffic	NA	
A.C.E.-Hydrology	<i>[Signature]</i>	11/15/83	Water	NA	

DRAWING NO.	1809	MAP NO.	G-12-Z	SHEET	3 OF 20
-------------	------	---------	--------	-------	---------

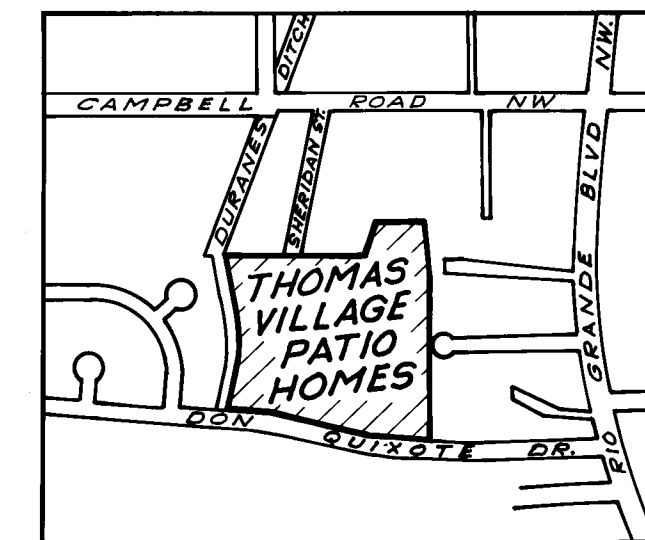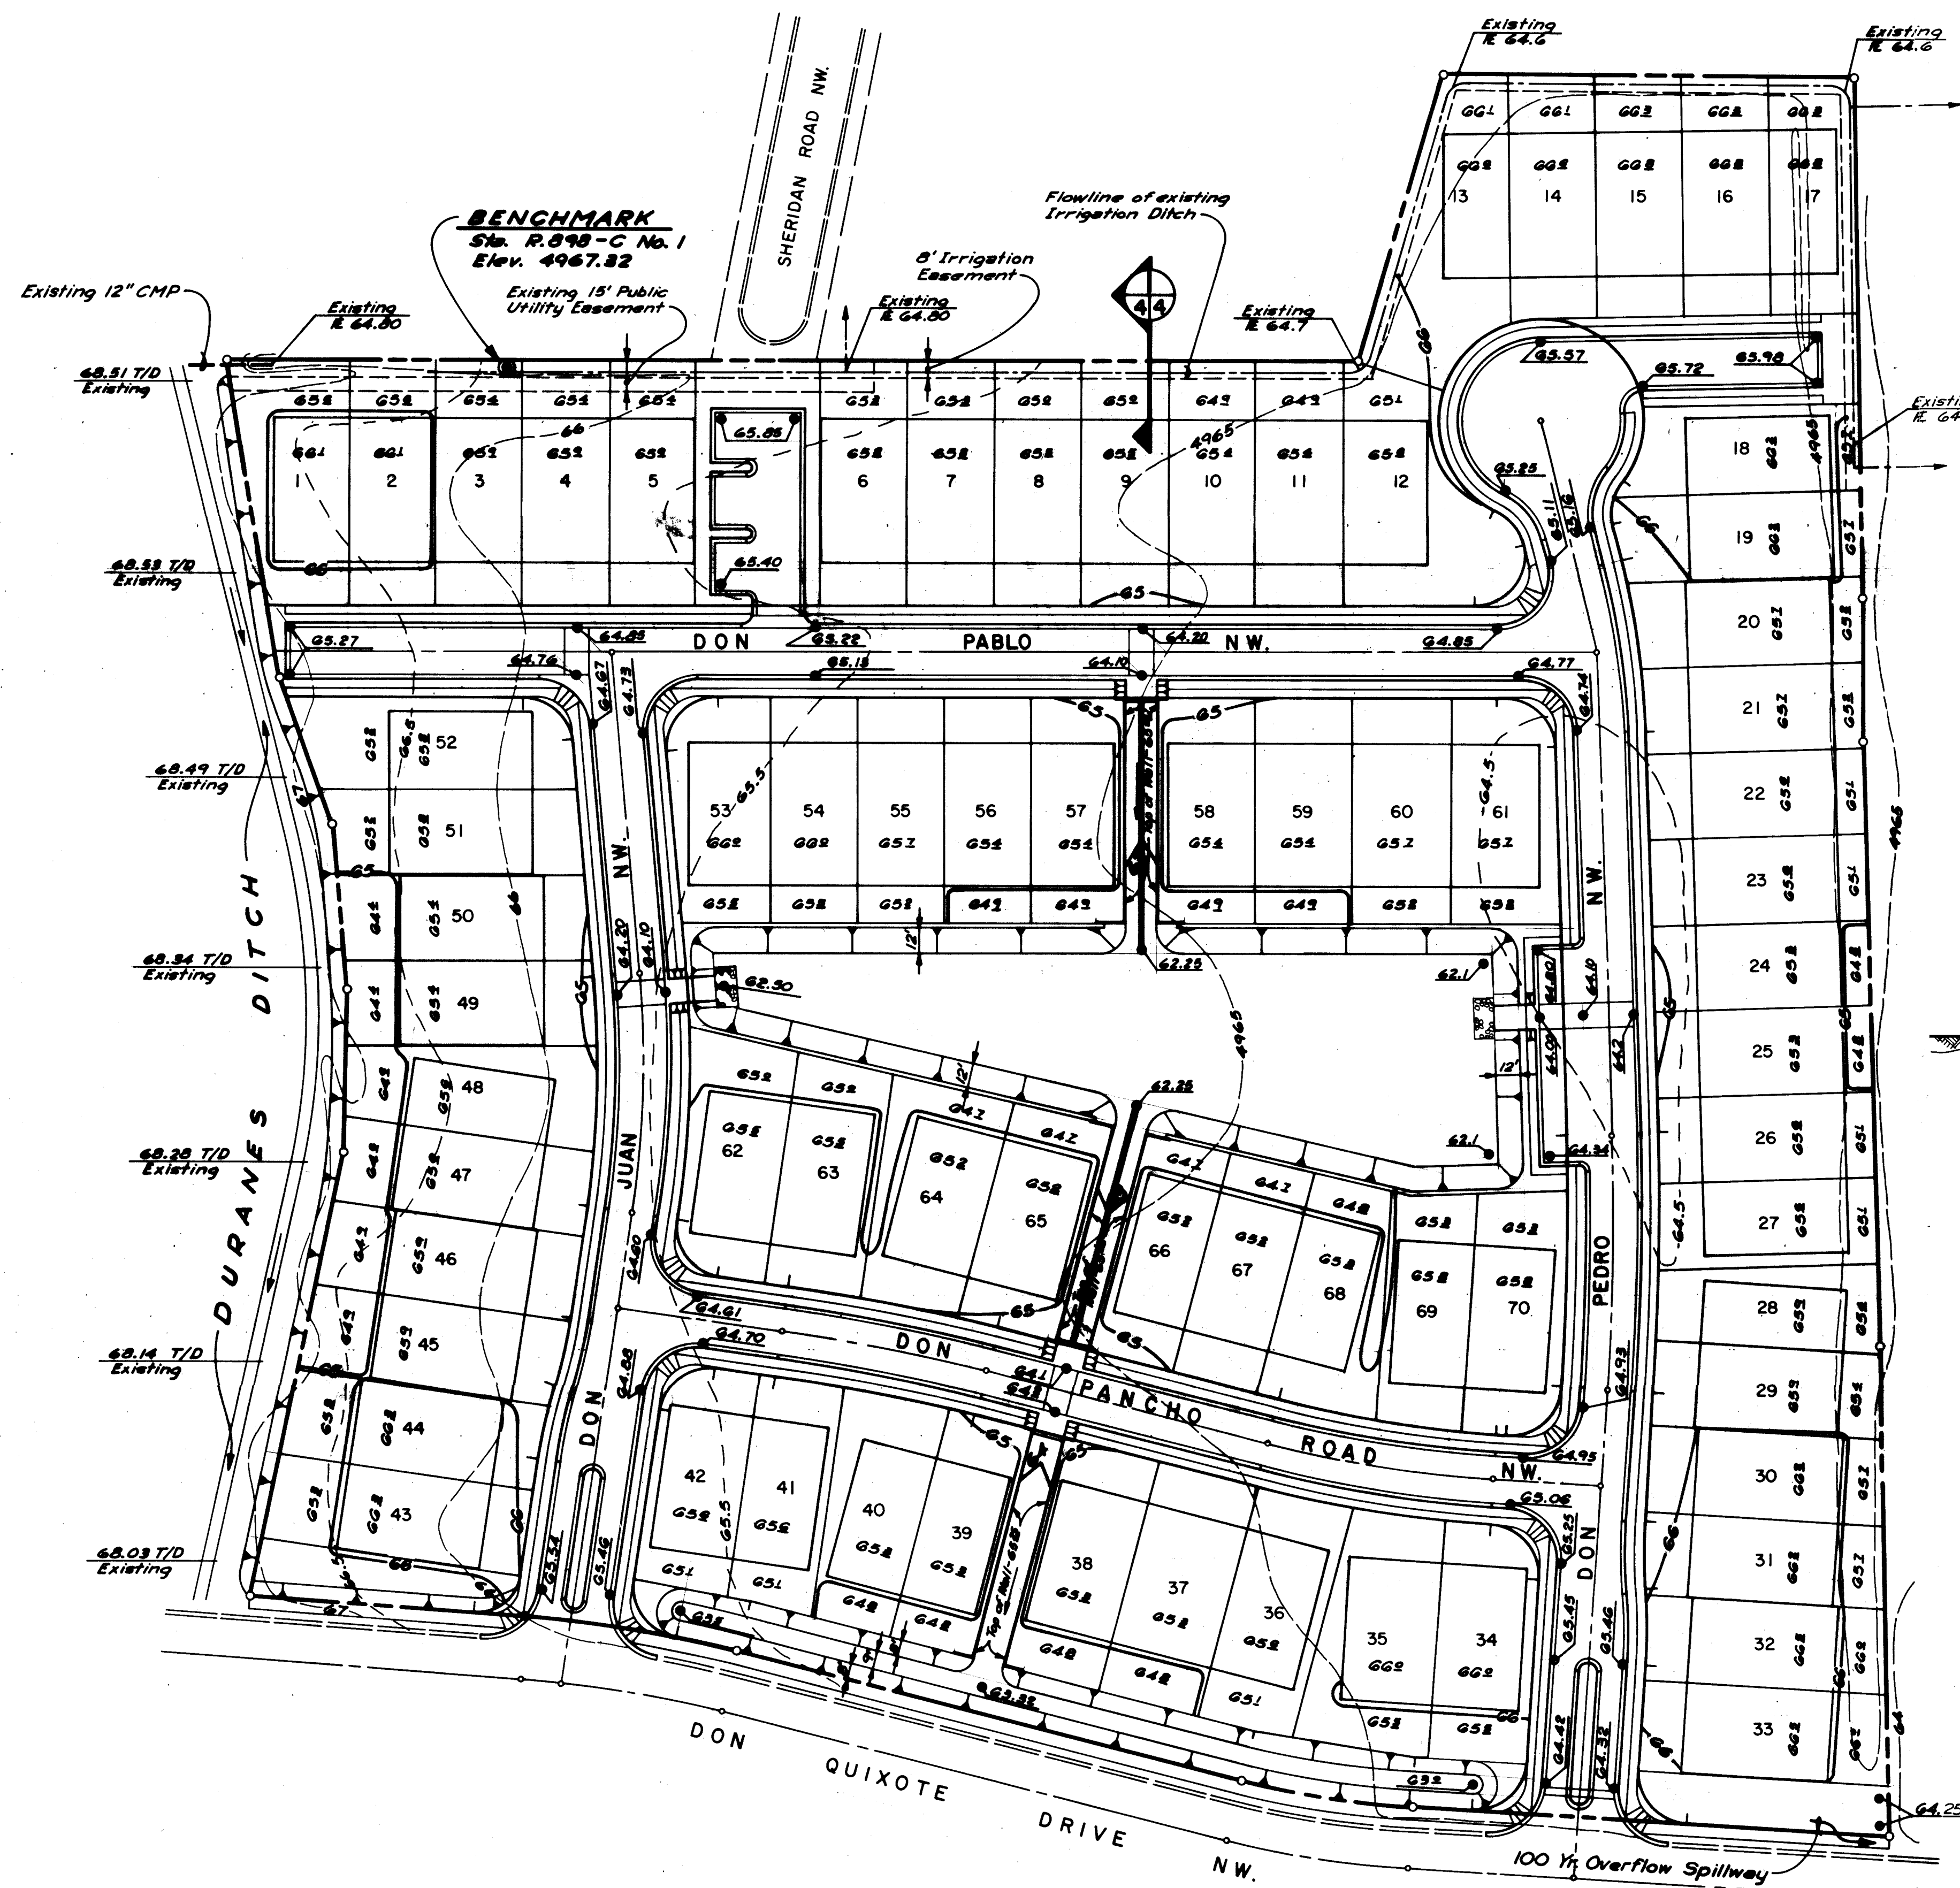

SCALE: 1"=50'

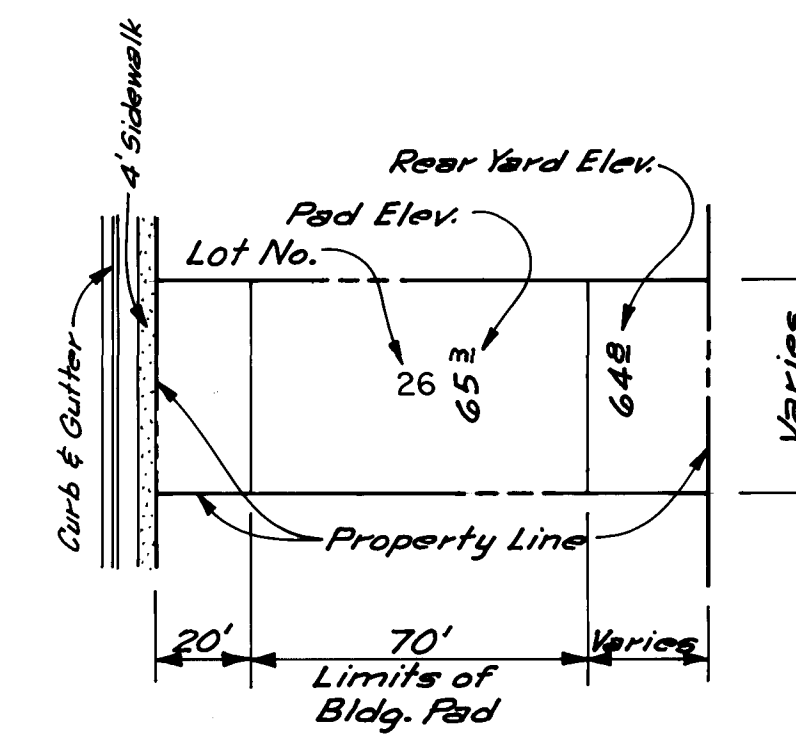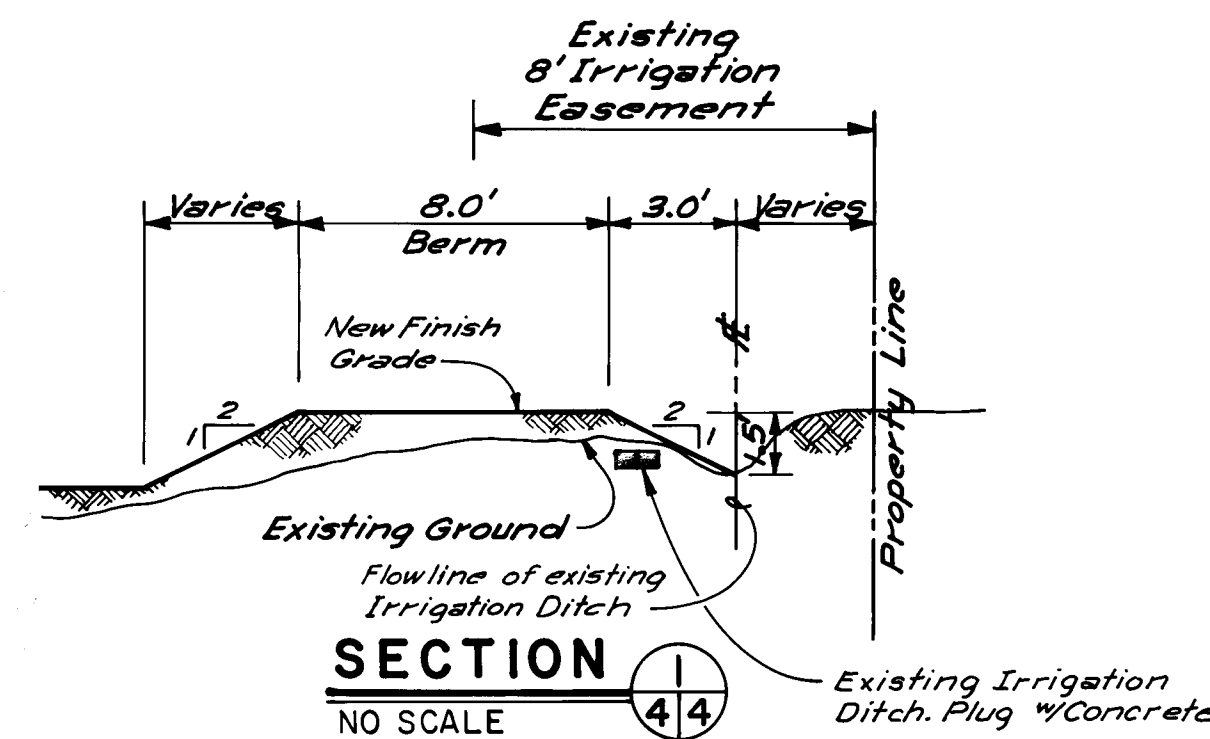

- LEGEND**
- 67 Existing Contour Line
 - 64 Finish Contour Line
 - 64.3 Finish Spot Elevation
 - Top of Berm
 - Toe of Slope

NOTES


- Embankment material to be compacted to 90% of modified proctor. ASTM D-1557
- Contractor will be Responsible for Insuring that Sediment Migration During Construction is Controlled.

2618090485

RECORD DRAWING

AS BUILT INFORMATION				SURVEY INFORMATION				ENGINEER'S SEAL			
CONTRACTOR	Universal Constr. Inc.	DATE	1/84	FIELD NOTES	DATE	BY	NO.				
STANDARD	USC & S Brass Cap	DATE	12/01								
ACCEPTANCE BY	DATE	DATE	DATE					ANDREWS, ASBURY & ROBERT, INC. ALBUQUERQUE, N.M. 87102			
FIELD	DATE	DATE	DATE								
REVISIONS	DATE	DATE	DATE					DESIGNED BY: JF DRAWN BY: JV CHECKED BY: JA			
								DATE: June 83 DATE: June 83			

CITY OF ALBUQUERQUE MUNICIPAL DEVELOPMENT DEPARTMENT ENGINEERING DIVISION					
THOMAS VILLAGE PATIO HOMES-SITE IMPROVEMENTS GRADING PLAN					
APPROVALS	ENGINEER	DATE	APPROVALS	ENGINEER	DATE
City Engineer	<i>[Signature]</i>	12/83	Liquid Waste	NA	
A.C.E.-Design	<i>[Signature]</i>	12/83	Traffic	NA	
A.C.E.-Hydrology	<i>[Signature]</i>	12/83	Water	NA	
DRAWING NO.	1809	MAP NO.	G-12-Z	SHEET	4 OF 20

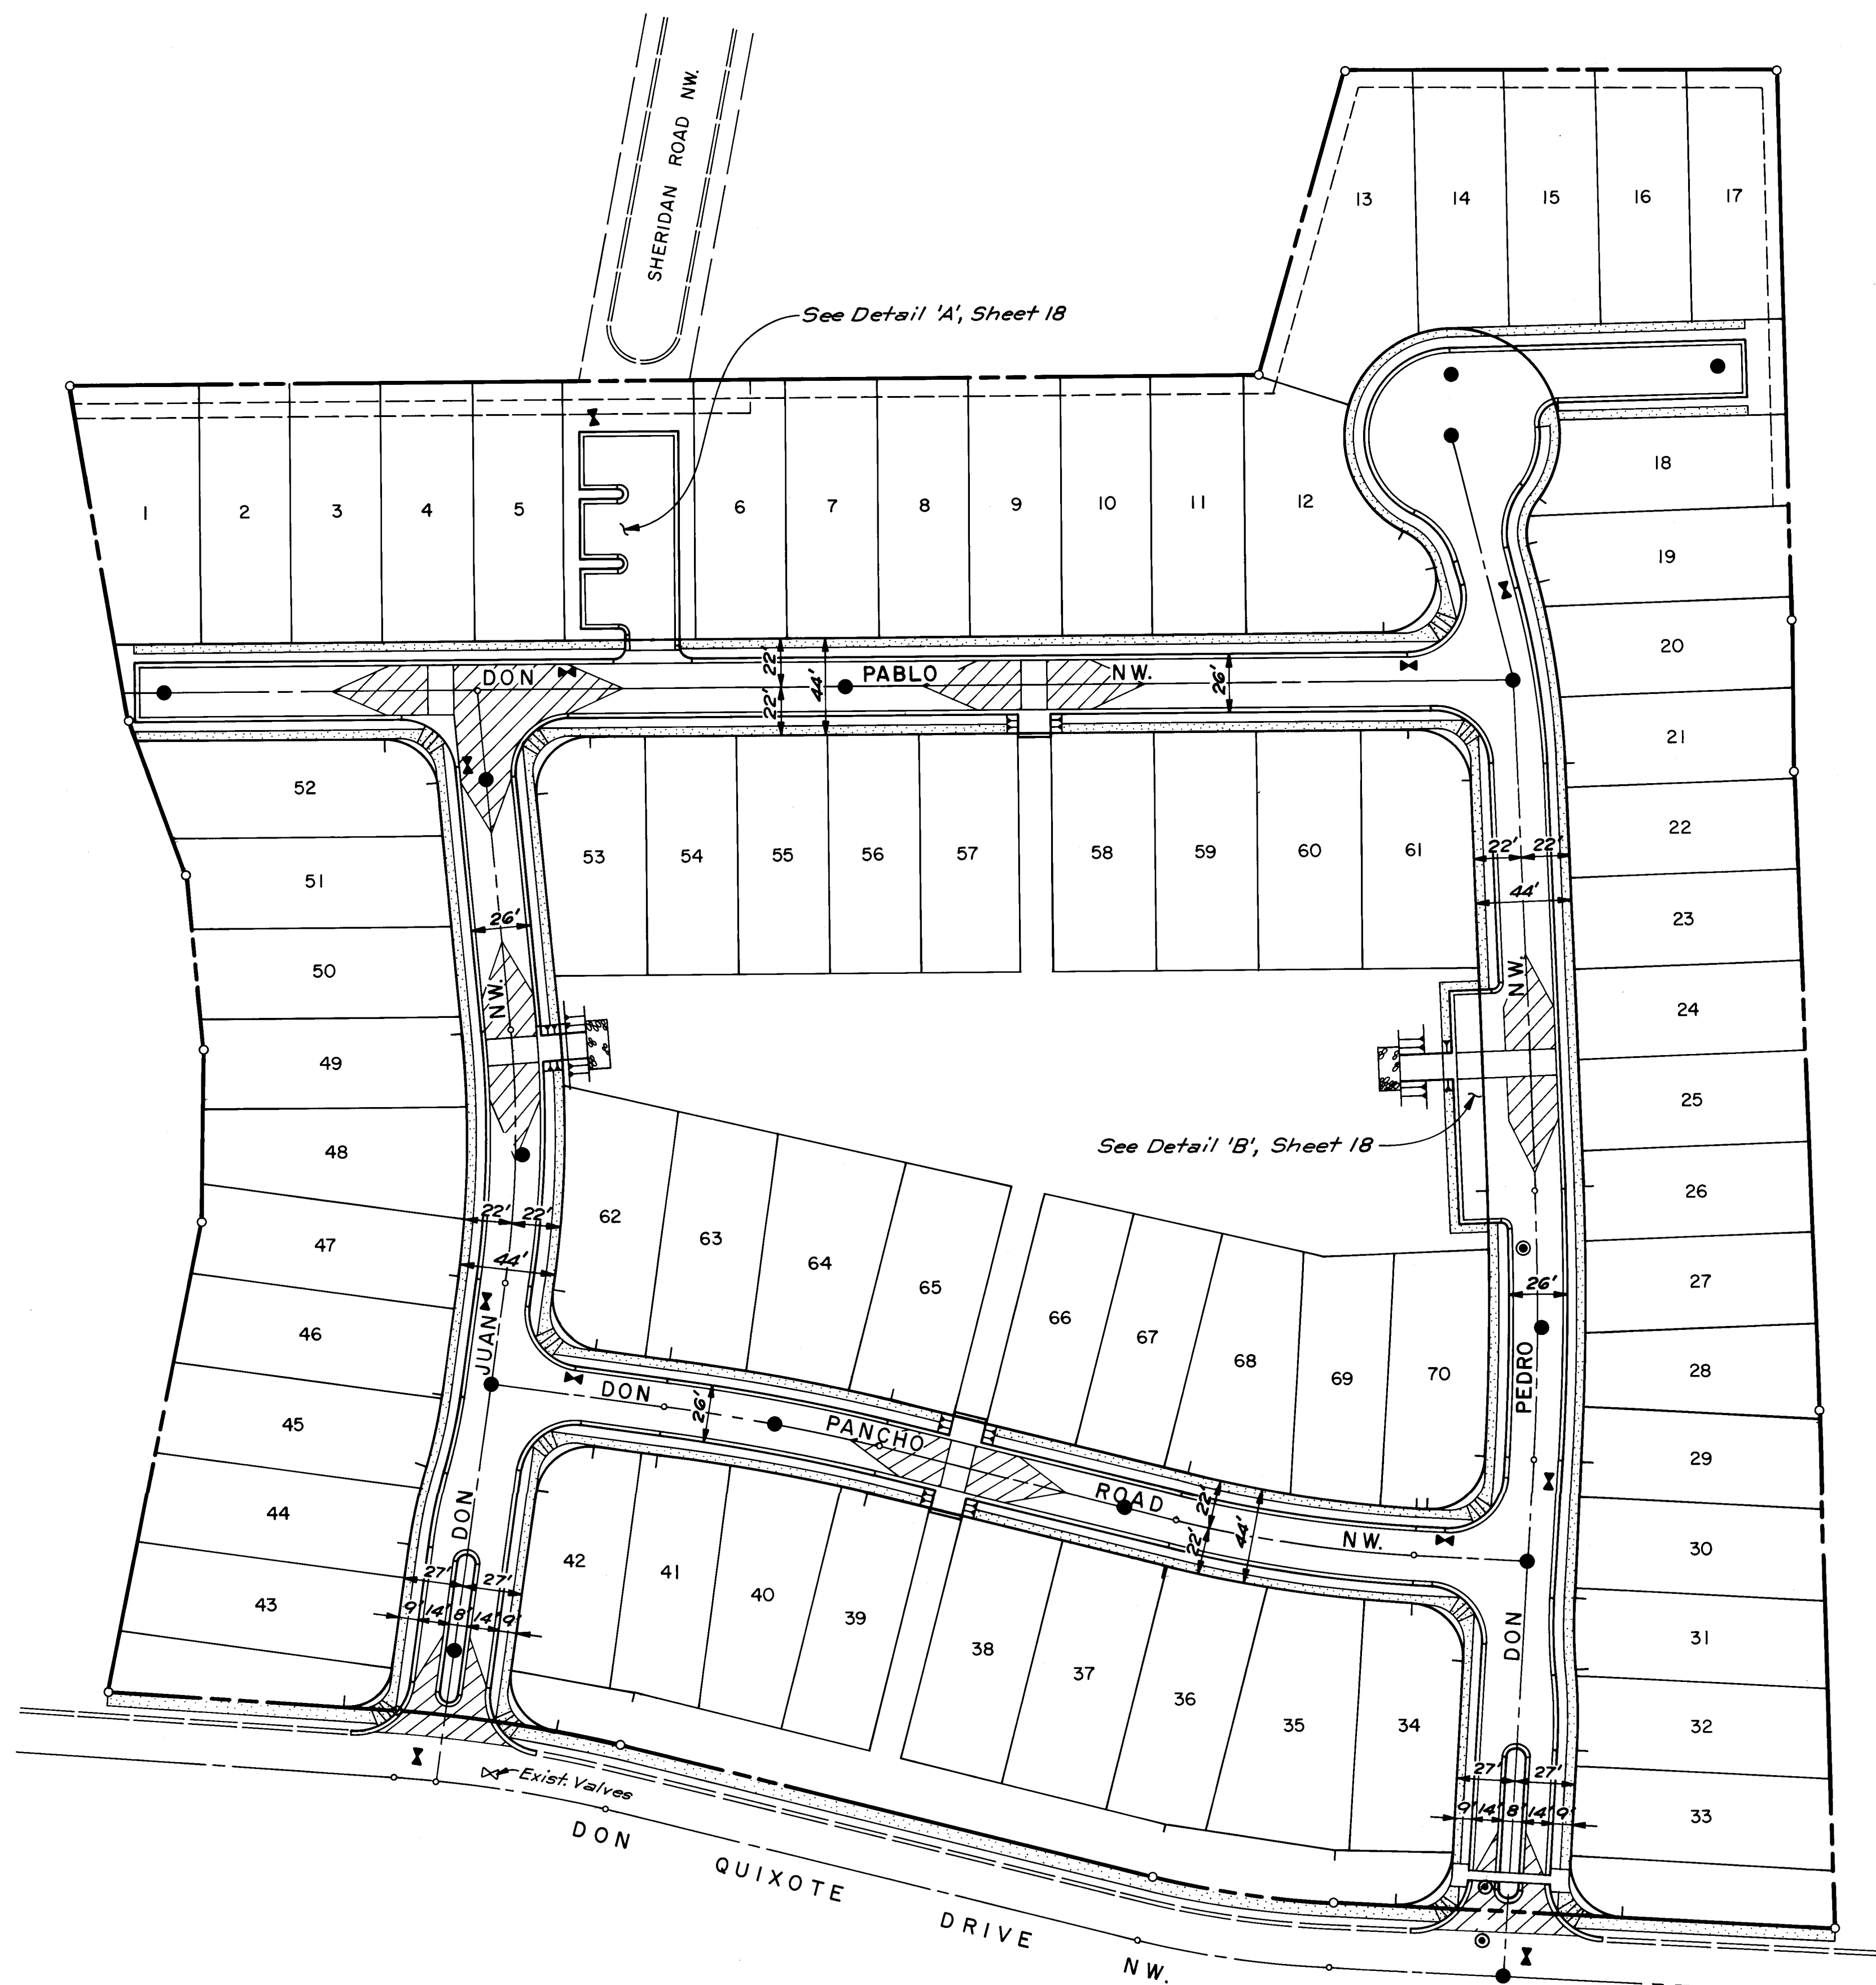

SCALE: 1" = 50'

Plan & Profile Sheet Reference

Street	Sheet No.
Don Juan NW	8
Don Pablo NW	9
Don Pedro NW	10
Don Pancho Road	11

Don Juan NW 8
 Don Pablo NW 9
 Don Pedro NW 10
 Don Pancho Road 11

LEGEND

- ==== Exist. Curb & Gutter
- ⊠ Exist. Water Valve w/Box
- ==== New Curb & Gutter
- ===== New Sidewalk
- New Crown Transition Area
- New Sanitary Sewer Manhole
- ⊙ New Storm Drain Manhole
- ⊠ New Water Valve w/Box

AS BUILT INFORMATION		BENCH MARKS		SURVEY INFORMATION		ENGINEER'S SEAL		REVISIONS		DESIGN		REMARKS	
CONTRACTOR	UNIVERSAL CONSTR. INC.	DATE	NO.	BY	DATE	DATE	DATE	NO.	DATE	DATE	DATE	DATE	DATE
WORK	STAKED BY	DATE	NO.	BY	DATE	DATE	DATE	NO.	DATE	DATE	DATE	DATE	DATE
FIELD	ACCEPTANCE BY	DATE	NO.	BY	DATE	DATE	DATE	NO.	DATE	DATE	DATE	DATE	DATE
FIELD	ADJUSTED BY	DATE	NO.	BY	DATE	DATE	DATE	NO.	DATE	DATE	DATE	DATE	DATE
REVISIONS	DATE	DATE	DATE	DATE	DATE	DATE	DATE	DATE	DATE	DATE	DATE	DATE	DATE
CORRECTED BY	DATE	DATE	DATE	DATE	DATE	DATE	DATE	DATE	DATE	DATE	DATE	DATE	DATE
MICRO-FILM	INFORMATION	DATE	NO.	DATE	DATE	DATE	DATE	DATE	DATE	DATE	DATE	DATE	DATE
RECORDED BY	DATE	DATE	DATE	DATE	DATE	DATE	DATE	DATE	DATE	DATE	DATE	DATE	DATE

2618090585

RECORD DRAWING

CITY OF ALBUQUERQUE
 MUNICIPAL DEVELOPMENT DEPARTMENT
 ENGINEERING DIVISION

**THOMAS VILLAGE PATIO HOMES-SITE IMPROVEMENTS
 PAVING PLAN**

APPROVALS	ENGINEER	DATE	APPROVALS	ENGINEER	DATE
City Engineer	C.A. [Signature]	12/1/83	Liquid Waste	N.A.	
A.C.E. - Design	[Signature]	12/1/83	Traffic	row Kennedy	12/1/83
A.C.E. - Hydrology	[Signature]	11/15/83	Water	N.A.	

DRAWING NO.	MAP NO.	SHEET	OF
1809	G-12-Z	5	20

-W- Existing Waterline & Valve Box
 -W- New Waterline & Valve Box
 A New Fire Hydrant
 -SAS- Exist. Sanitary Sewer & Manhole
 -SAS- New Sanitary Sewer & Manhole
 -SD- New Storm Drain & Manhole
 New Inlet & Junction Box

NOTE:
All New Waterlines & Sanitary
Sewer Lines to be PVC.

Don Juan NW 12
Don Pablo NW 13
Don Pedro NW 14
Don Pancho Road . . 15

2618090/84

1	2	3	4	5	6	7	8	9	10	11
26			1	8	0	9		0	6	8

RECORD DRAWING

CITY OF ALBUQUERQUE
MUNICIPAL DEVELOPMENT DEPARTMENT
ENGINEERING DIVISION

THOMAS VILLAGE PATIO HOMES-SITE IMPROVEMENTS
WATER & SANITARY SEWER PLAN

APPROVALS	ENGINEER	DATE	APPROVALS	ENGINEER	DATE
City Engineer	<i>C. S. Chappell</i>	<i>12/10/57</i>	Liquid Waste	<i>W. B. J.</i>	<i>10-10-57</i>
A.C.E. - Design	<i>J. H. Smith</i>	<i>10/20/57</i>	Traffic	<i>R. A. [unclear]</i>	<i>10/14/57</i>
A.C.E. - Hydrology	<i>J. H. Smith</i>	<i>11/15/57</i>	Water	<i>W. B. J.</i>	<i>10-10-57</i>


DRAWING NO.	1809	MAP NO.	G-12-Z	SHEET	6	OF	20
-------------	------	---------	--------	-------	---	----	----

SURVEY INFORMATION		BENCH MARKS		AS BUILT INFORMATION	
FIELD NOTES				CONTRACTOR <i>Universal Const. Inc.</i>	
NO.	BY	DATE		WORK STARTED BY	DATE
				STAKED BY <td></td>	
				ACCEPTANCE BY <td></td>	
				FIELD <td></td>	
				VERIFICATION BY <td></td>	
				CORRECTED BY <td></td>	
				MICRO-FILM INFORMATION	
				RECORDED BY	DATE
				NO.	

[illegible]

CHECKED

18081

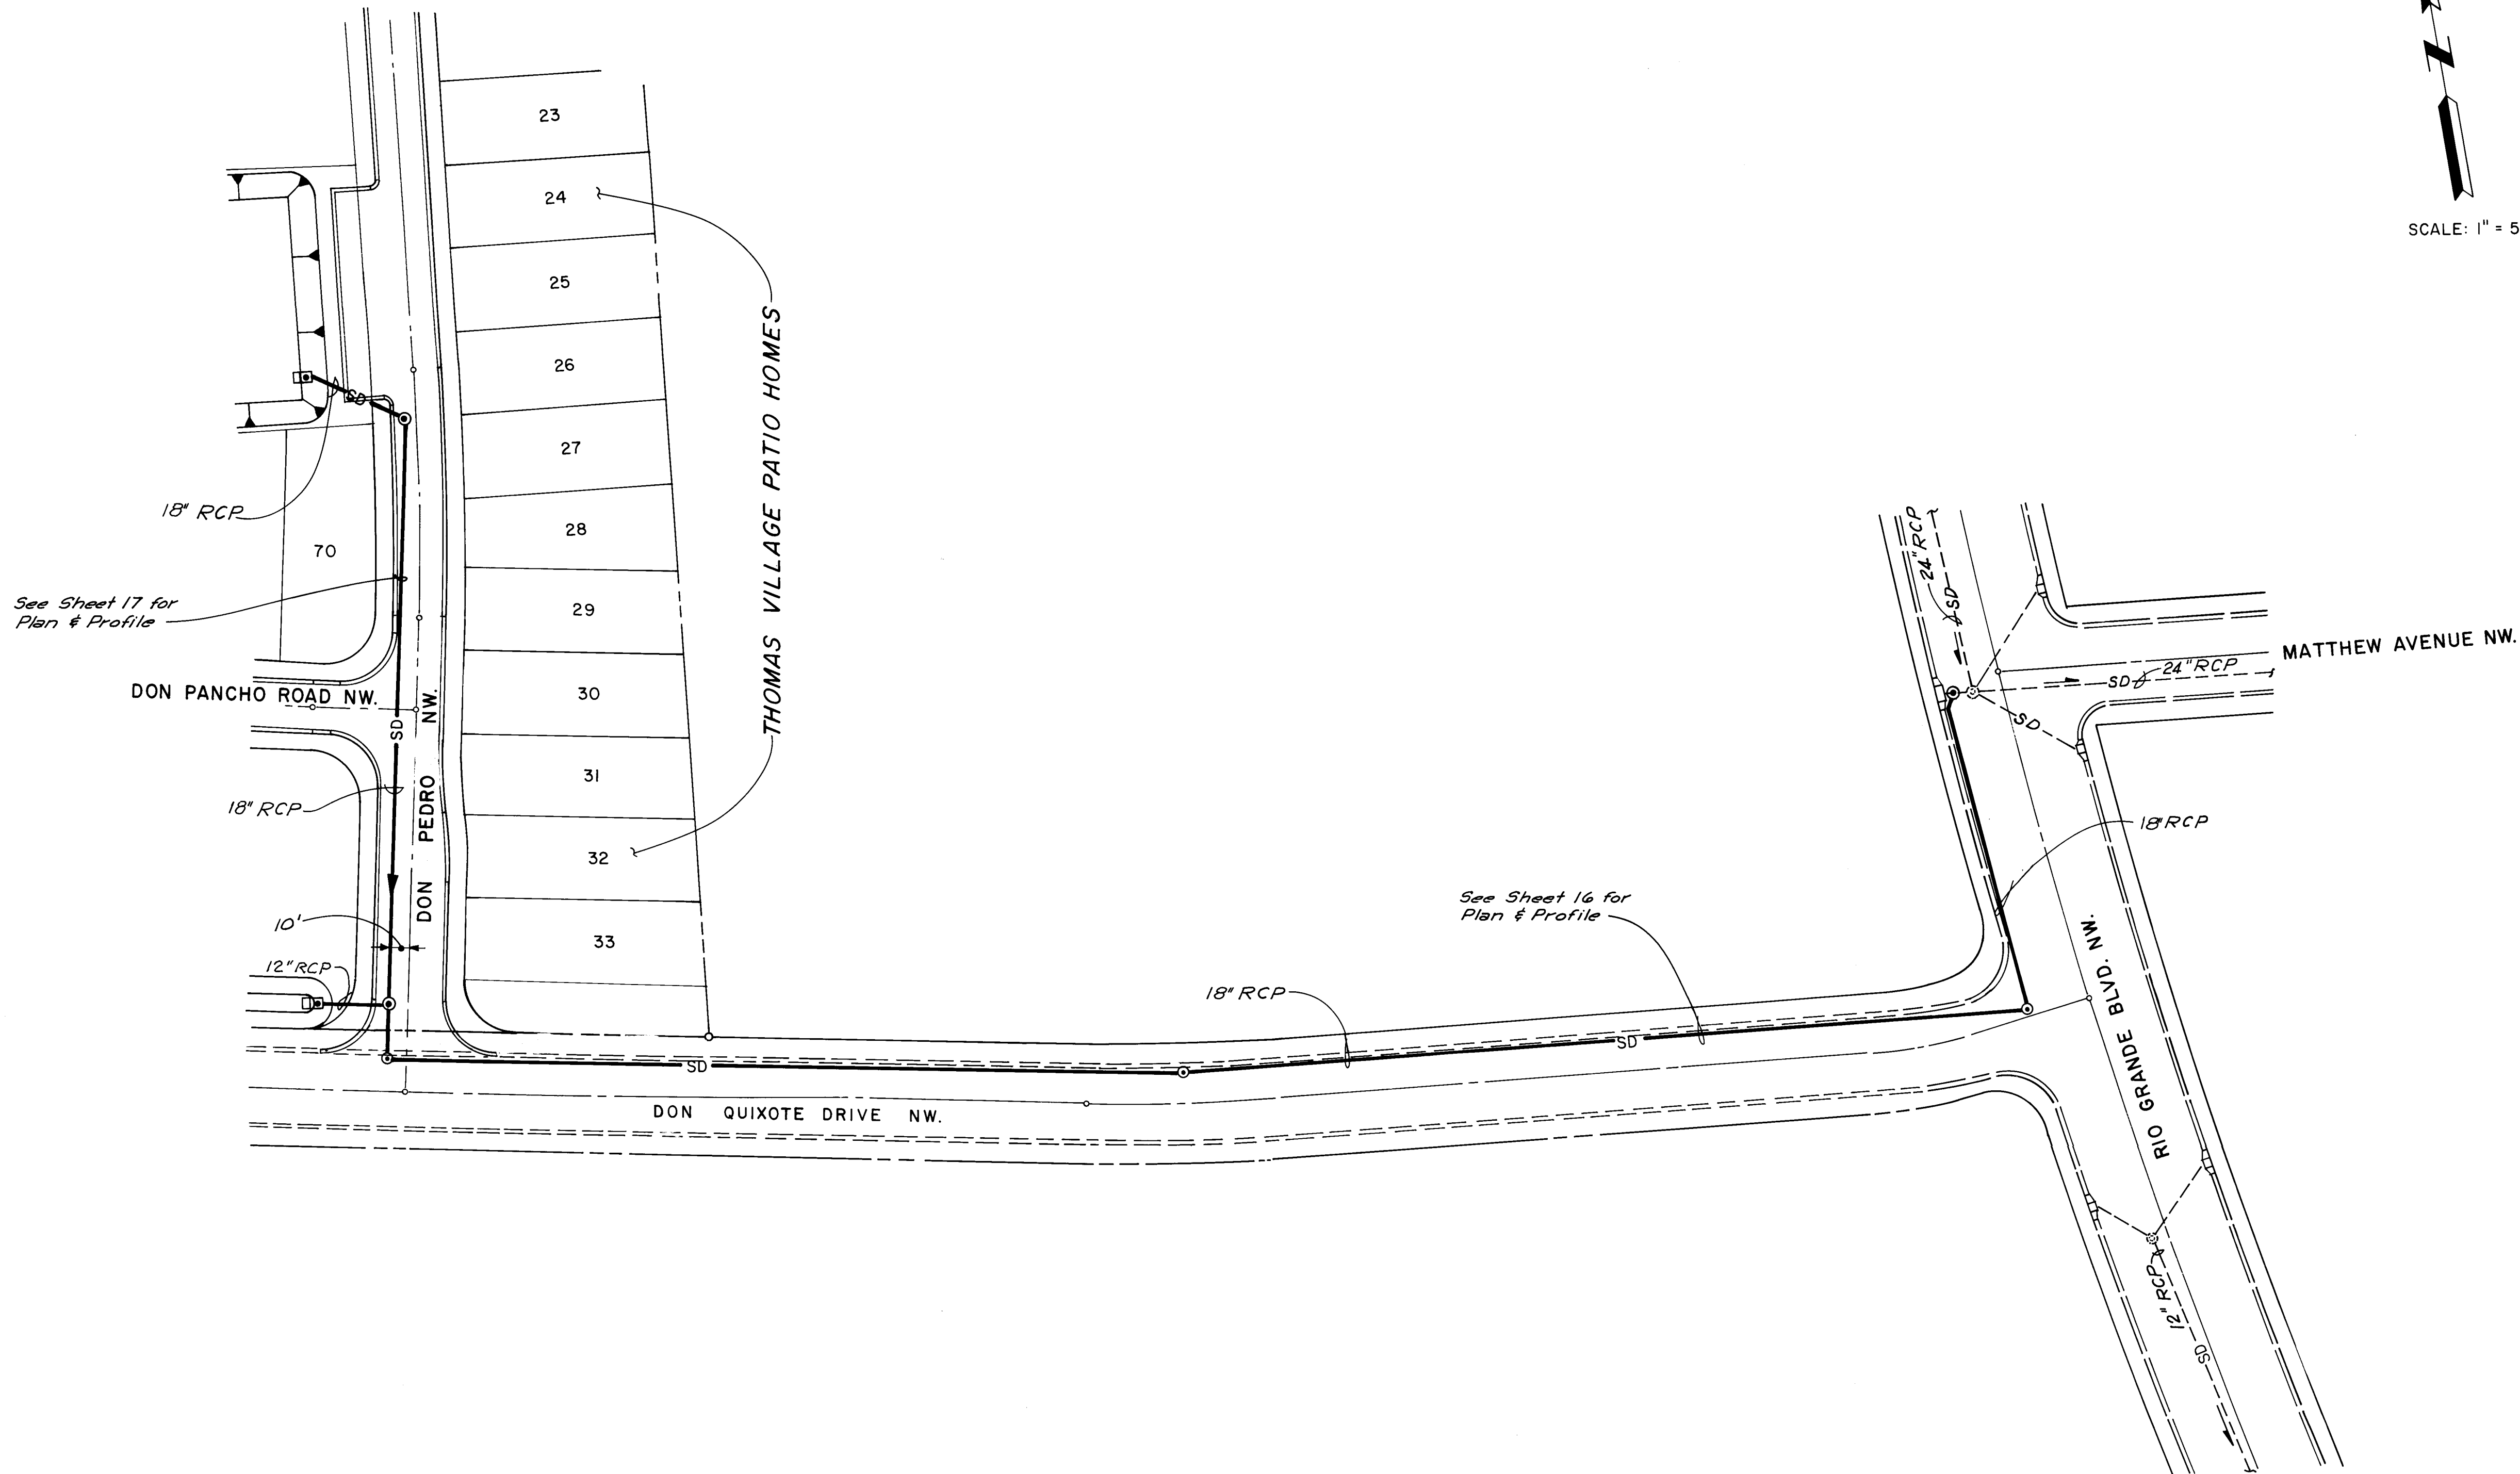

LEGEND


- SD--○-- Exist. Storm Drain & Manhole
- SD--●-- New Storm Drain & Manhole
- Junction Box
- ==== Existing Curb & Gutter
- ===== New Curb & Gutter

AS BUILT INFORMATION				BENCH MARKS		SURVEY INFORMATION		ENGINEER'S SEAL		REVISIONS		DESIGN		DATE	
CONTRACTOR	Universal Const. Inc.	DATE	1/84	NO.	DATE	NO.	BY	REGISTERED PROFESSIONAL ENGINEER	STATE OF NEW MEXICO	NO.	DATE	BY	DATE	NO.	DATE
STATED BY	A.A.R.	DATE						ANDREWS, ASBURY & ROBERT, INC.	CONSULTING ENGINEERS - NEW MEXICO						
FIELD		DATE													
VERIFICATION BY	A.A.R.	DATE	10/84												
CORRECTED BY	A.A.R.	DATE	2/85												
MICRO-FILM INFORMATION				RECORDED BY		NO.		DATE							

26 18090785

RECORD DRAWING



CITY OF ALBUQUERQUE MUNICIPAL DEVELOPMENT DEPARTMENT ENGINEERING DIVISION					
THOMAS VILLAGE PATIO HOMES-SITE IMPROVEMENTS STORM DRAIN PLAN					
APPROVALS	ENGINEER	DATE	APPROVALS	ENGINEER	DATE
City Engineer	<i>[Signature]</i>	12/1/83	Liquid Waste	NA	
A.C.E.-Design	<i>[Signature]</i>	10/24/83	Traffic	<i>[Signature]</i>	10/4/83
A.C.E.-Hydrology	<i>[Signature]</i>	11/15/83	Water	NA	
DRAWING NO.	1809	MAP NO.	6-12-Z	SHEET	7 OF 20

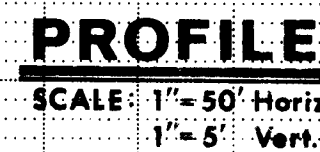

RECORD DRAWING

✓
✓
✓
✓

DRAWING NO.	1809	MAP NO.	G-12-Z	SHEET	8	OF	20
-------------	------	---------	--------	-------	---	----	----

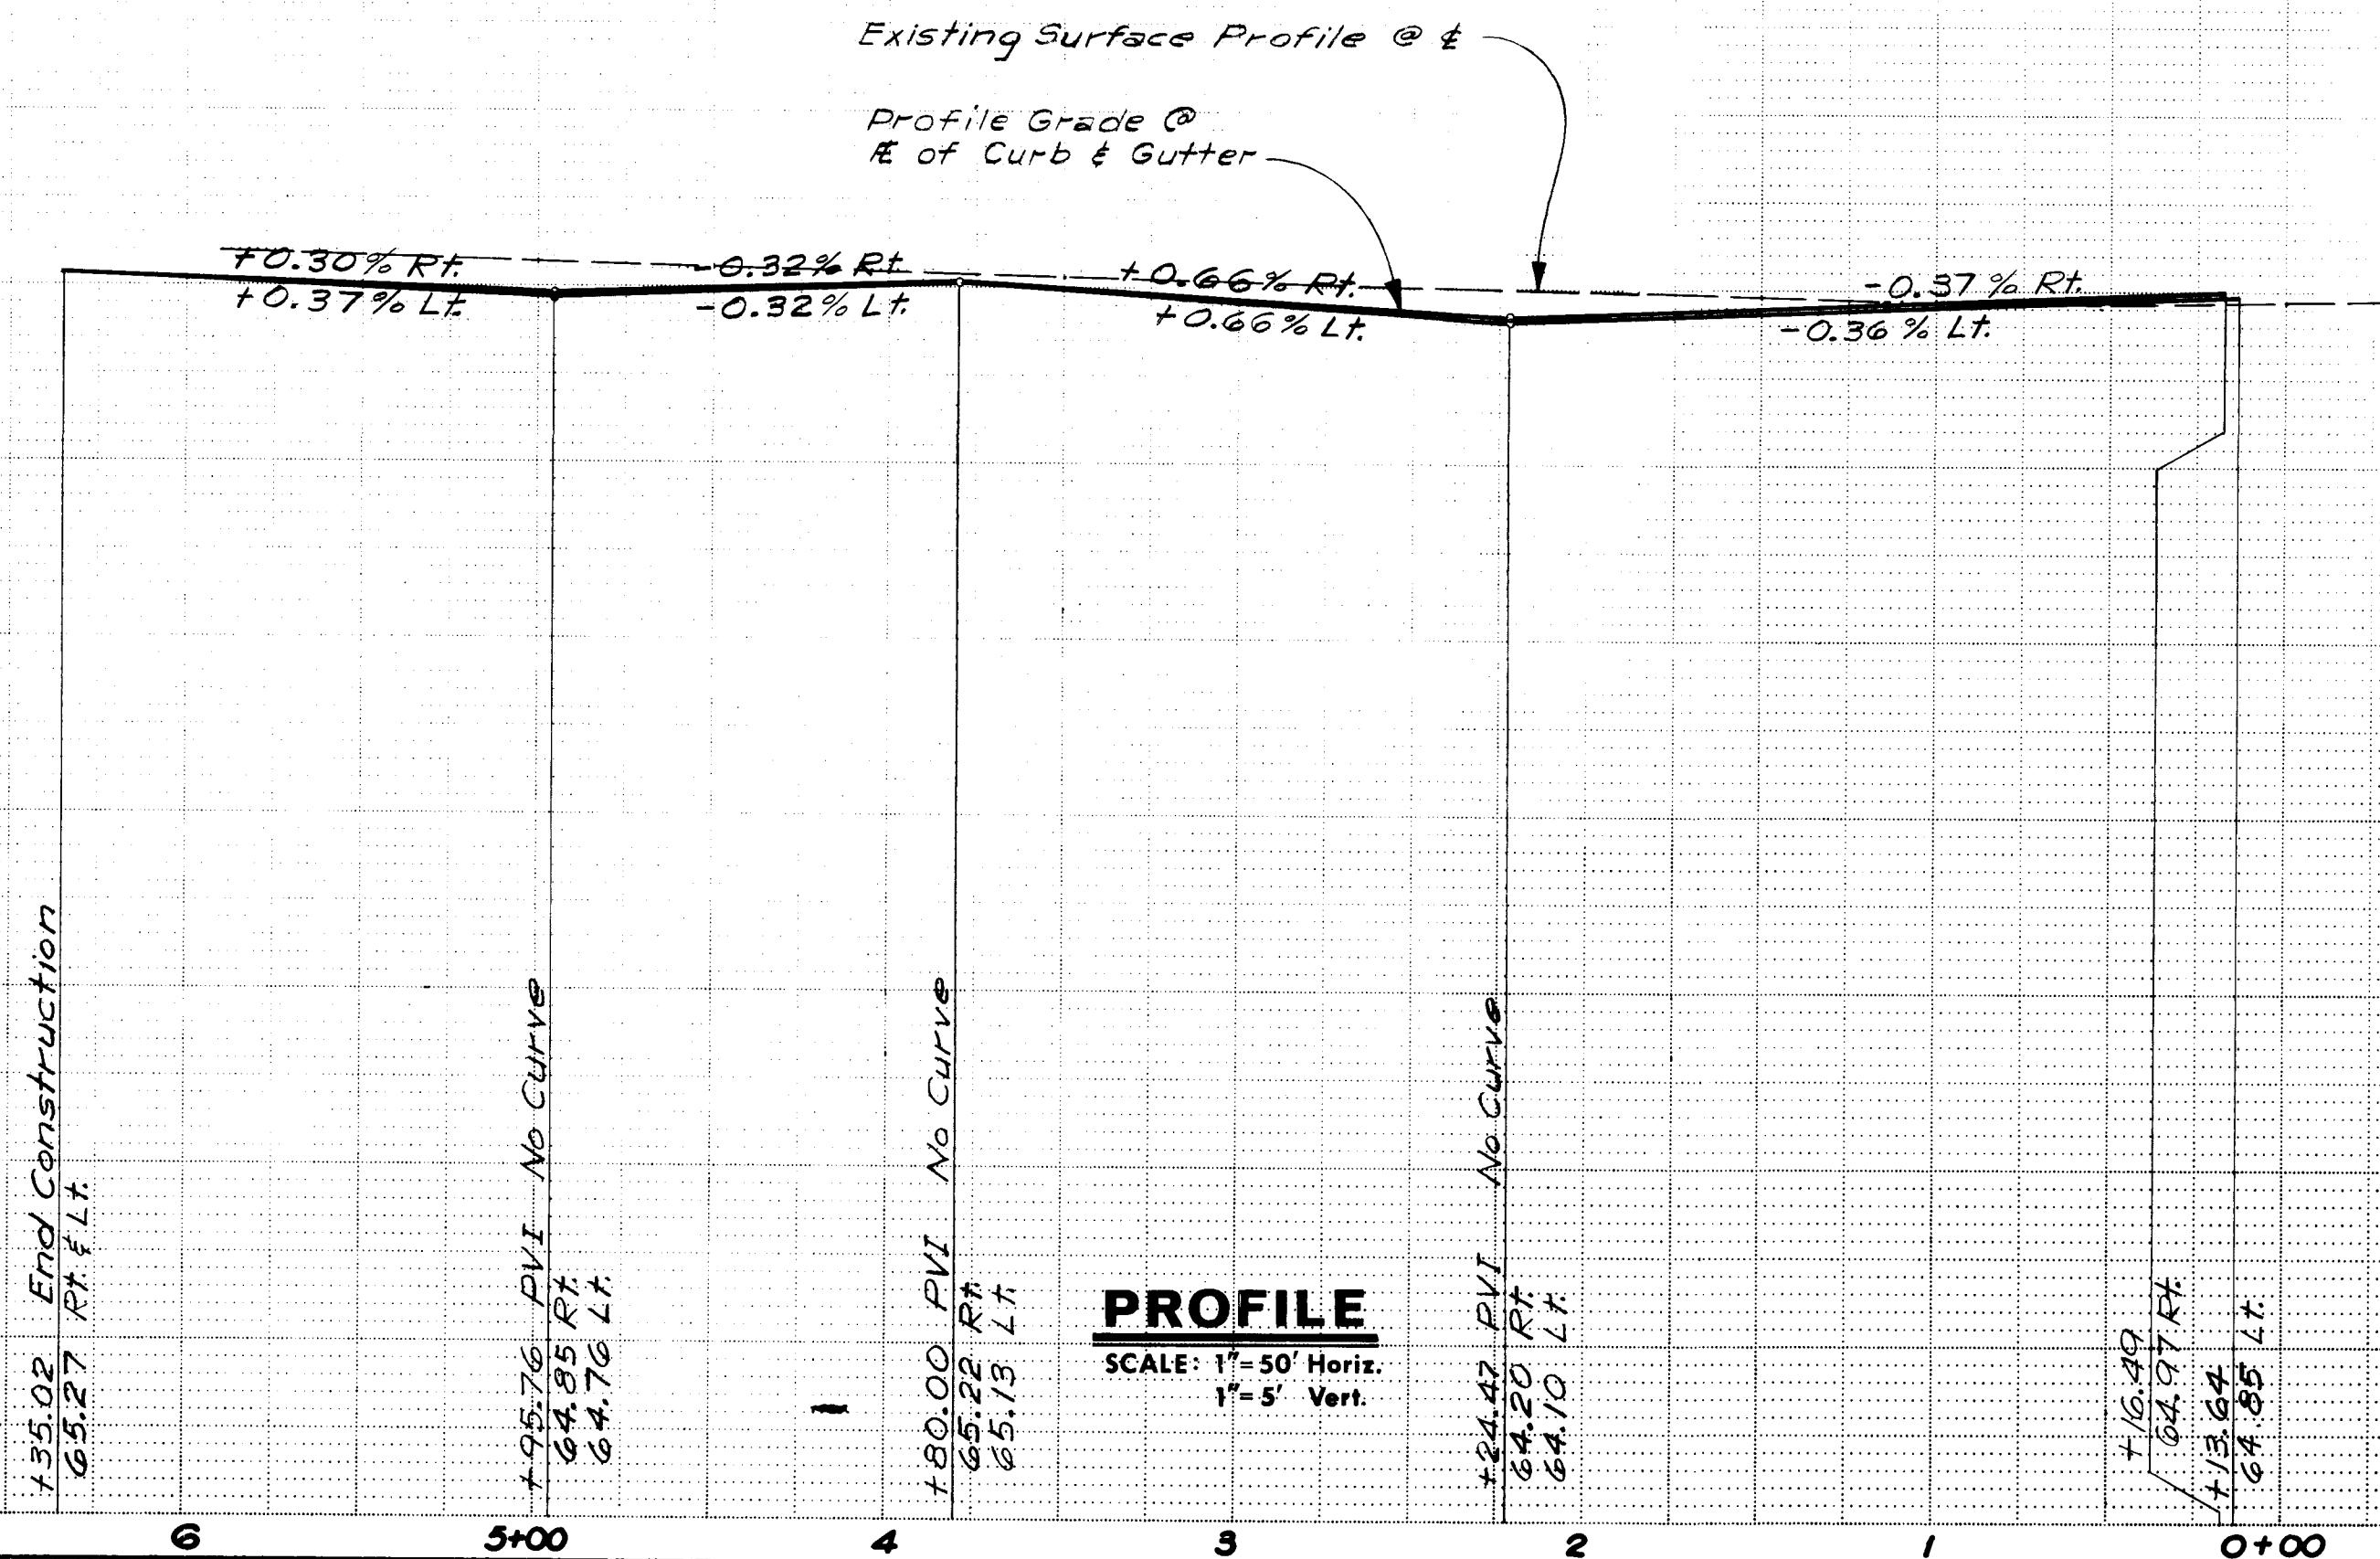
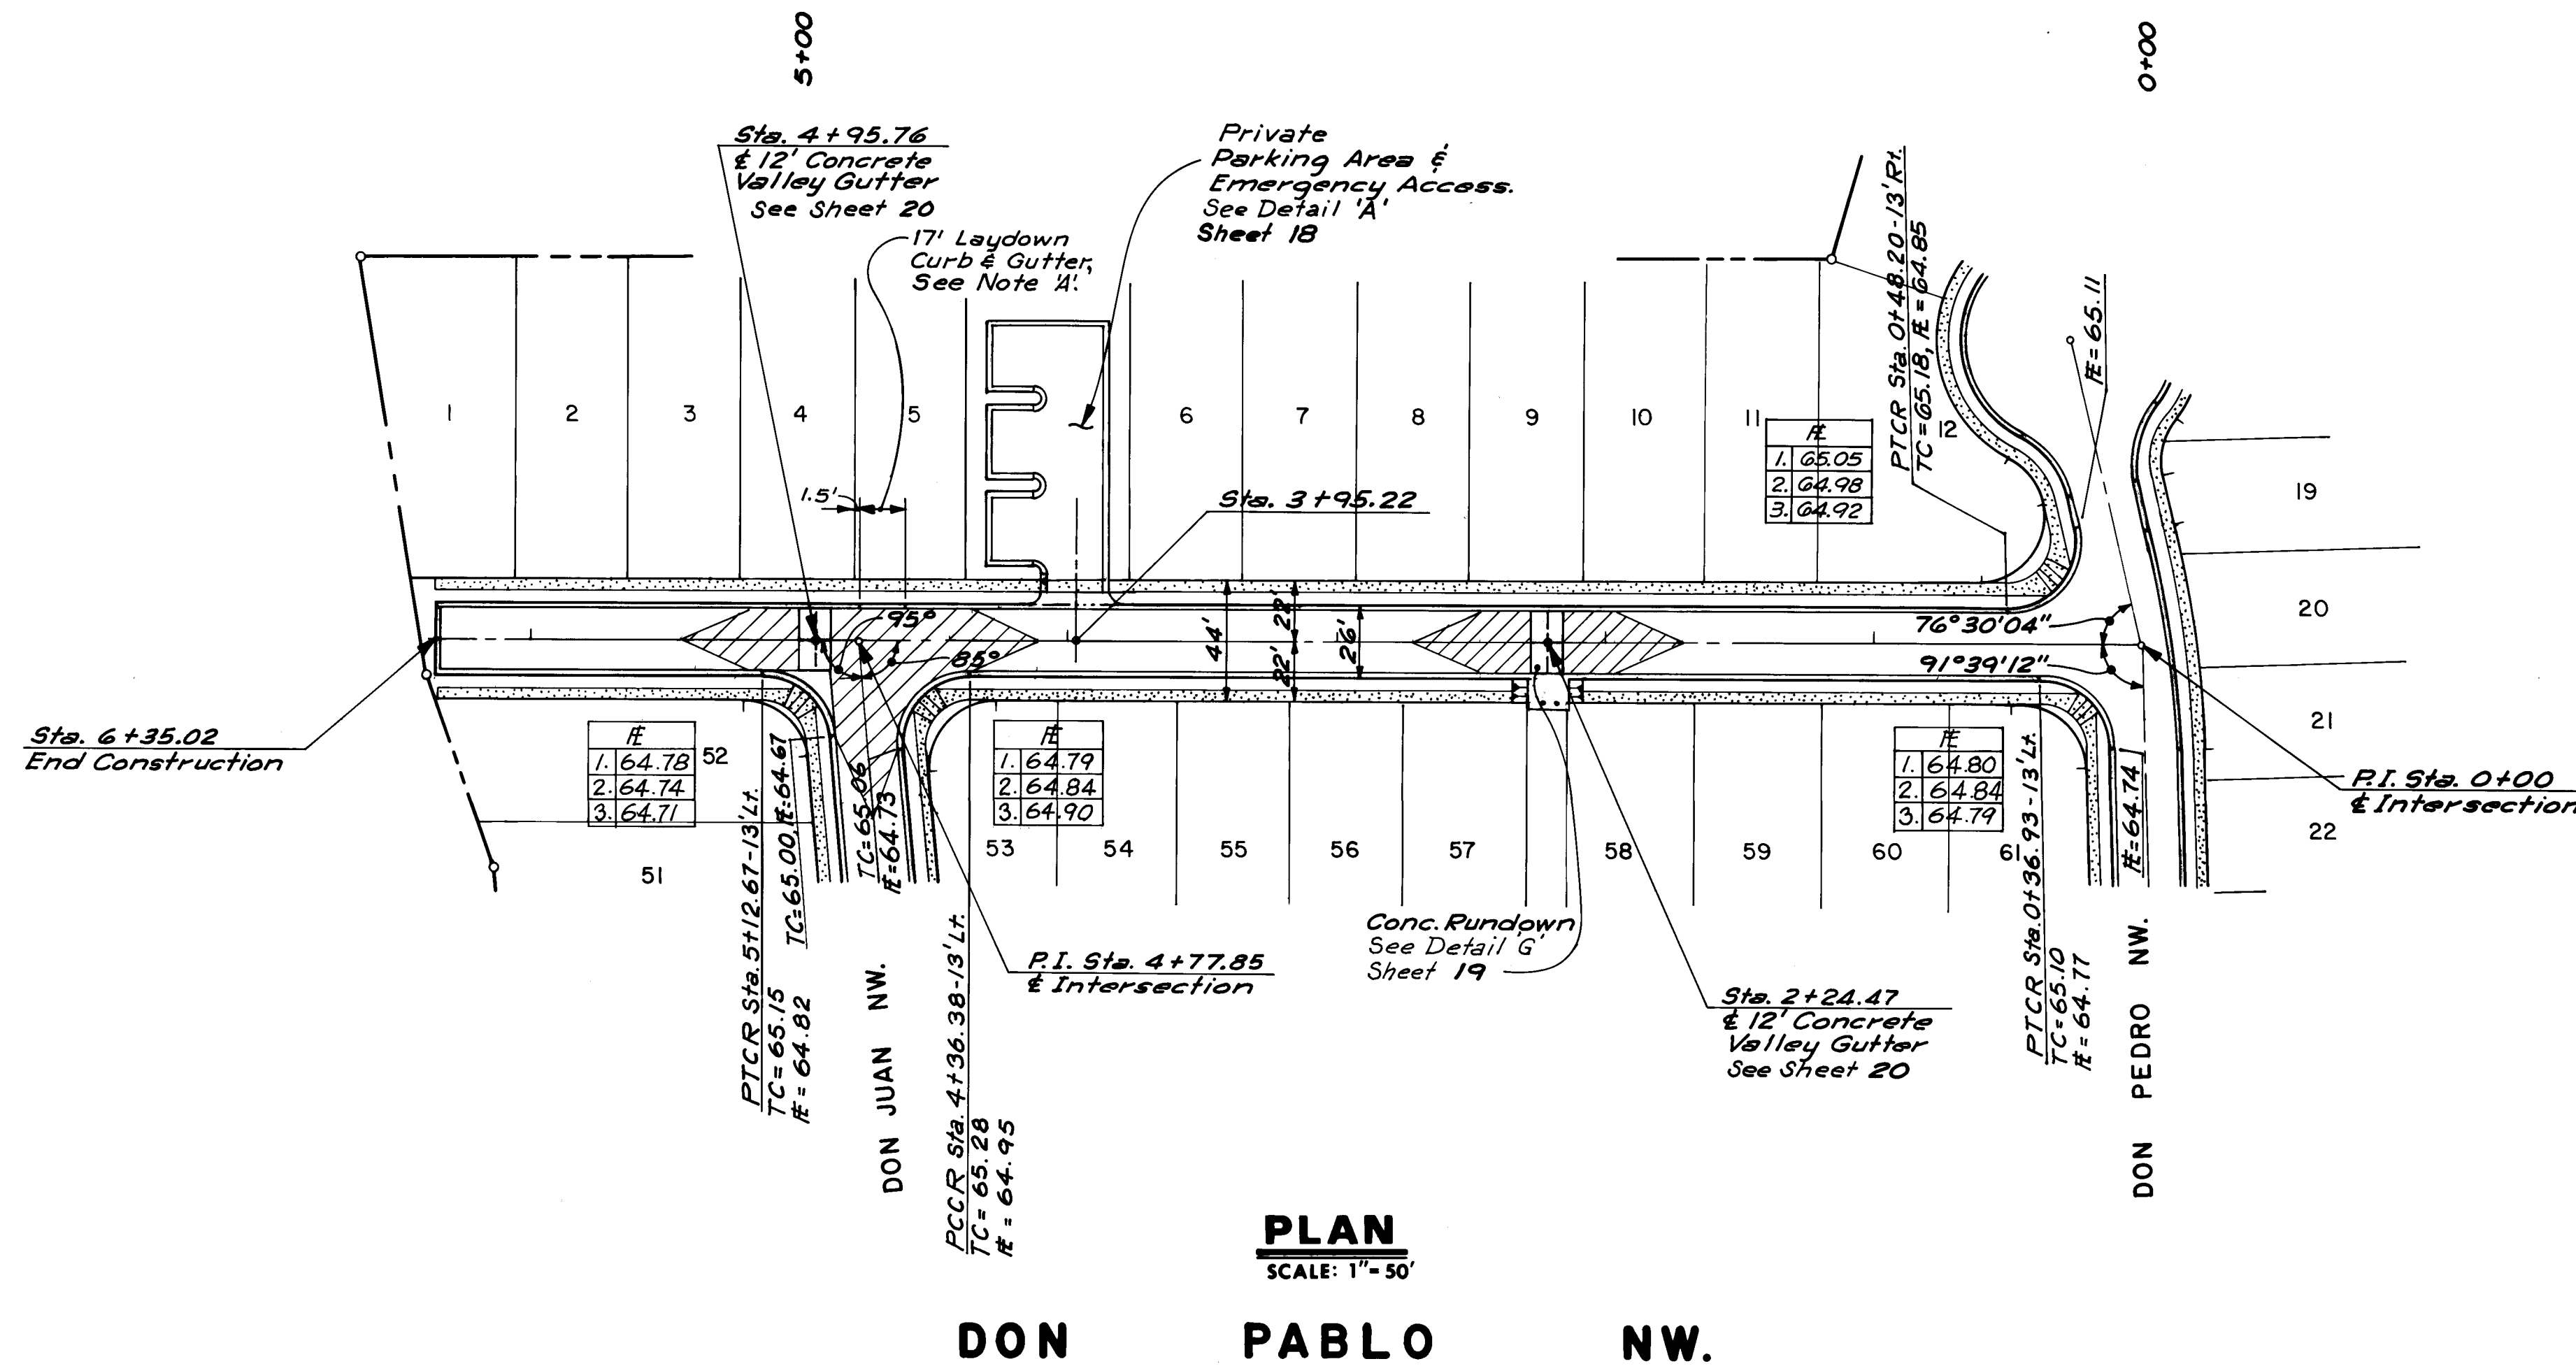


LEGEND

- Crown Transition Area
- New Curb & Gutter
- New Sidewalk

Note 'A'
Use 1'-6" Transition between Mountable Curb & Gutter - Roll Type and Laydown Curb & Gutter.

AS BUILT INFORMATION			BENCH MARKS			SURVEY INFORMATION			ENGINEER'S SEAL																										
CONTRACTOR	UNIVERSAL CONSTRUCTION, INC.	DATE	DATE	DATE	DATE	NO.	BY	DATE	NO.	BY	DATE																								
INSPECTOR	DATE	DATE	DATE	DATE	DATE	DATE	DATE	DATE	DATE	DATE	DATE																								
VERIFICATION BY	DATE	DATE	DATE	DATE	DATE	DATE	DATE	DATE	DATE	DATE	DATE																								
CORRECTED BY	DATE	DATE	DATE	DATE	DATE	DATE	DATE	DATE	DATE	DATE	DATE																								
MICRO-FILM INFORMATION			REVISIONS			DESIGN			REVISIONS																										
NO.	DATE	DATE	NO.	DATE	DATE	NO.	DATE	DATE	NO.	DATE	DATE																								
NO.	DATE	DATE	NO.	DATE	DATE	NO.	DATE	DATE	NO.	DATE	DATE																								
RECORD DRAWING CITY OF ALBUQUERQUE MUNICIPAL DEVELOPMENT DEPARTMENT ENGINEERING DIVISION THOMAS VILLAGE PATIO HOMES-SITE IMPROVEMENTS PAVING PLAN & PROFILE DON PABLO NW. <table border="1"> <tr> <th>APPROVALS</th> <th>ENGINEER</th> <th>DATE</th> <th>APPROVALS</th> <th>ENGINEER</th> <th>DATE</th> </tr> <tr> <td>City Engineer</td> <td><i>[Signature]</i></td> <td>12/1/83</td> <td>Liquid Waste</td> <td>NA</td> <td></td> </tr> <tr> <td>A.C.E. - Design</td> <td><i>[Signature]</i></td> <td>12/1/83</td> <td>Traffic</td> <td><i>[Signature]</i></td> <td>10/1/83</td> </tr> <tr> <td>A.C.E. - Hydrology</td> <td><i>[Signature]</i></td> <td>12/1/83</td> <td>Water</td> <td>NA</td> <td></td> </tr> </table> DRAWING NO. 1809 MAP NO. 6-12-2 SHEET 9 OF 20												APPROVALS	ENGINEER	DATE	APPROVALS	ENGINEER	DATE	City Engineer	<i>[Signature]</i>	12/1/83	Liquid Waste	NA		A.C.E. - Design	<i>[Signature]</i>	12/1/83	Traffic	<i>[Signature]</i>	10/1/83	A.C.E. - Hydrology	<i>[Signature]</i>	12/1/83	Water	NA	
APPROVALS	ENGINEER	DATE	APPROVALS	ENGINEER	DATE																														
City Engineer	<i>[Signature]</i>	12/1/83	Liquid Waste	NA																															
A.C.E. - Design	<i>[Signature]</i>	12/1/83	Traffic	<i>[Signature]</i>	10/1/83																														
A.C.E. - Hydrology	<i>[Signature]</i>	12/1/83	Water	NA																															

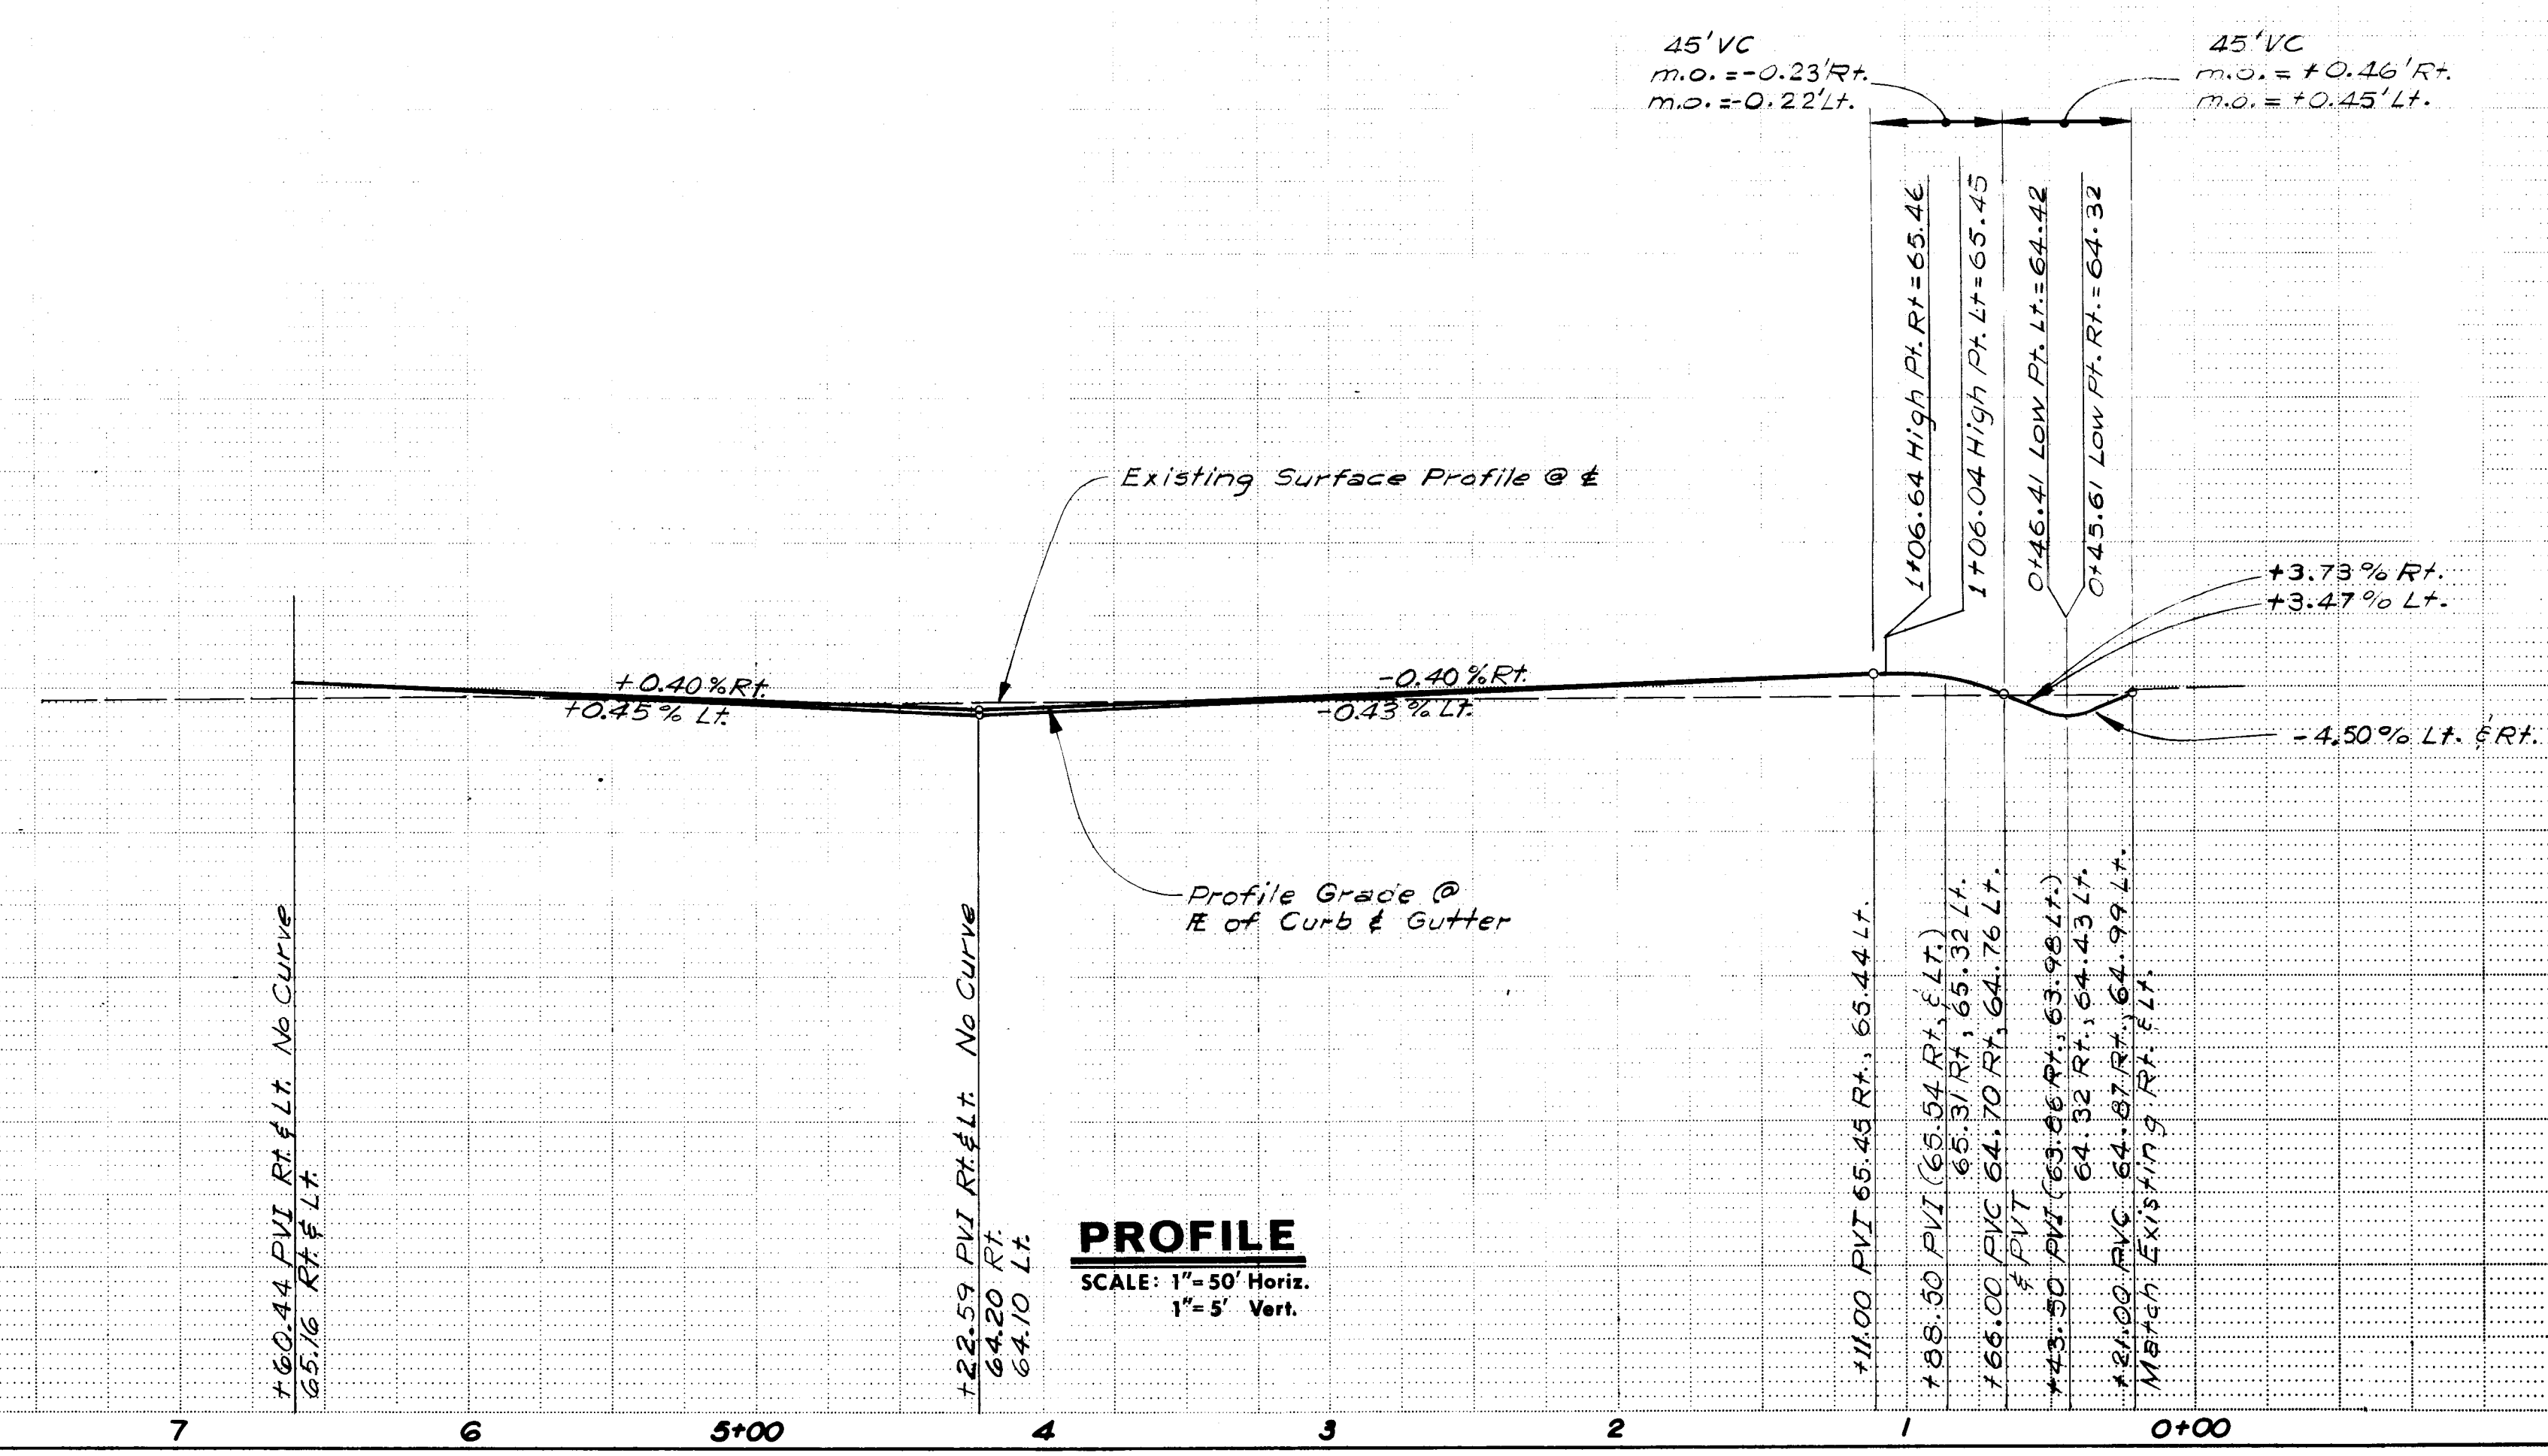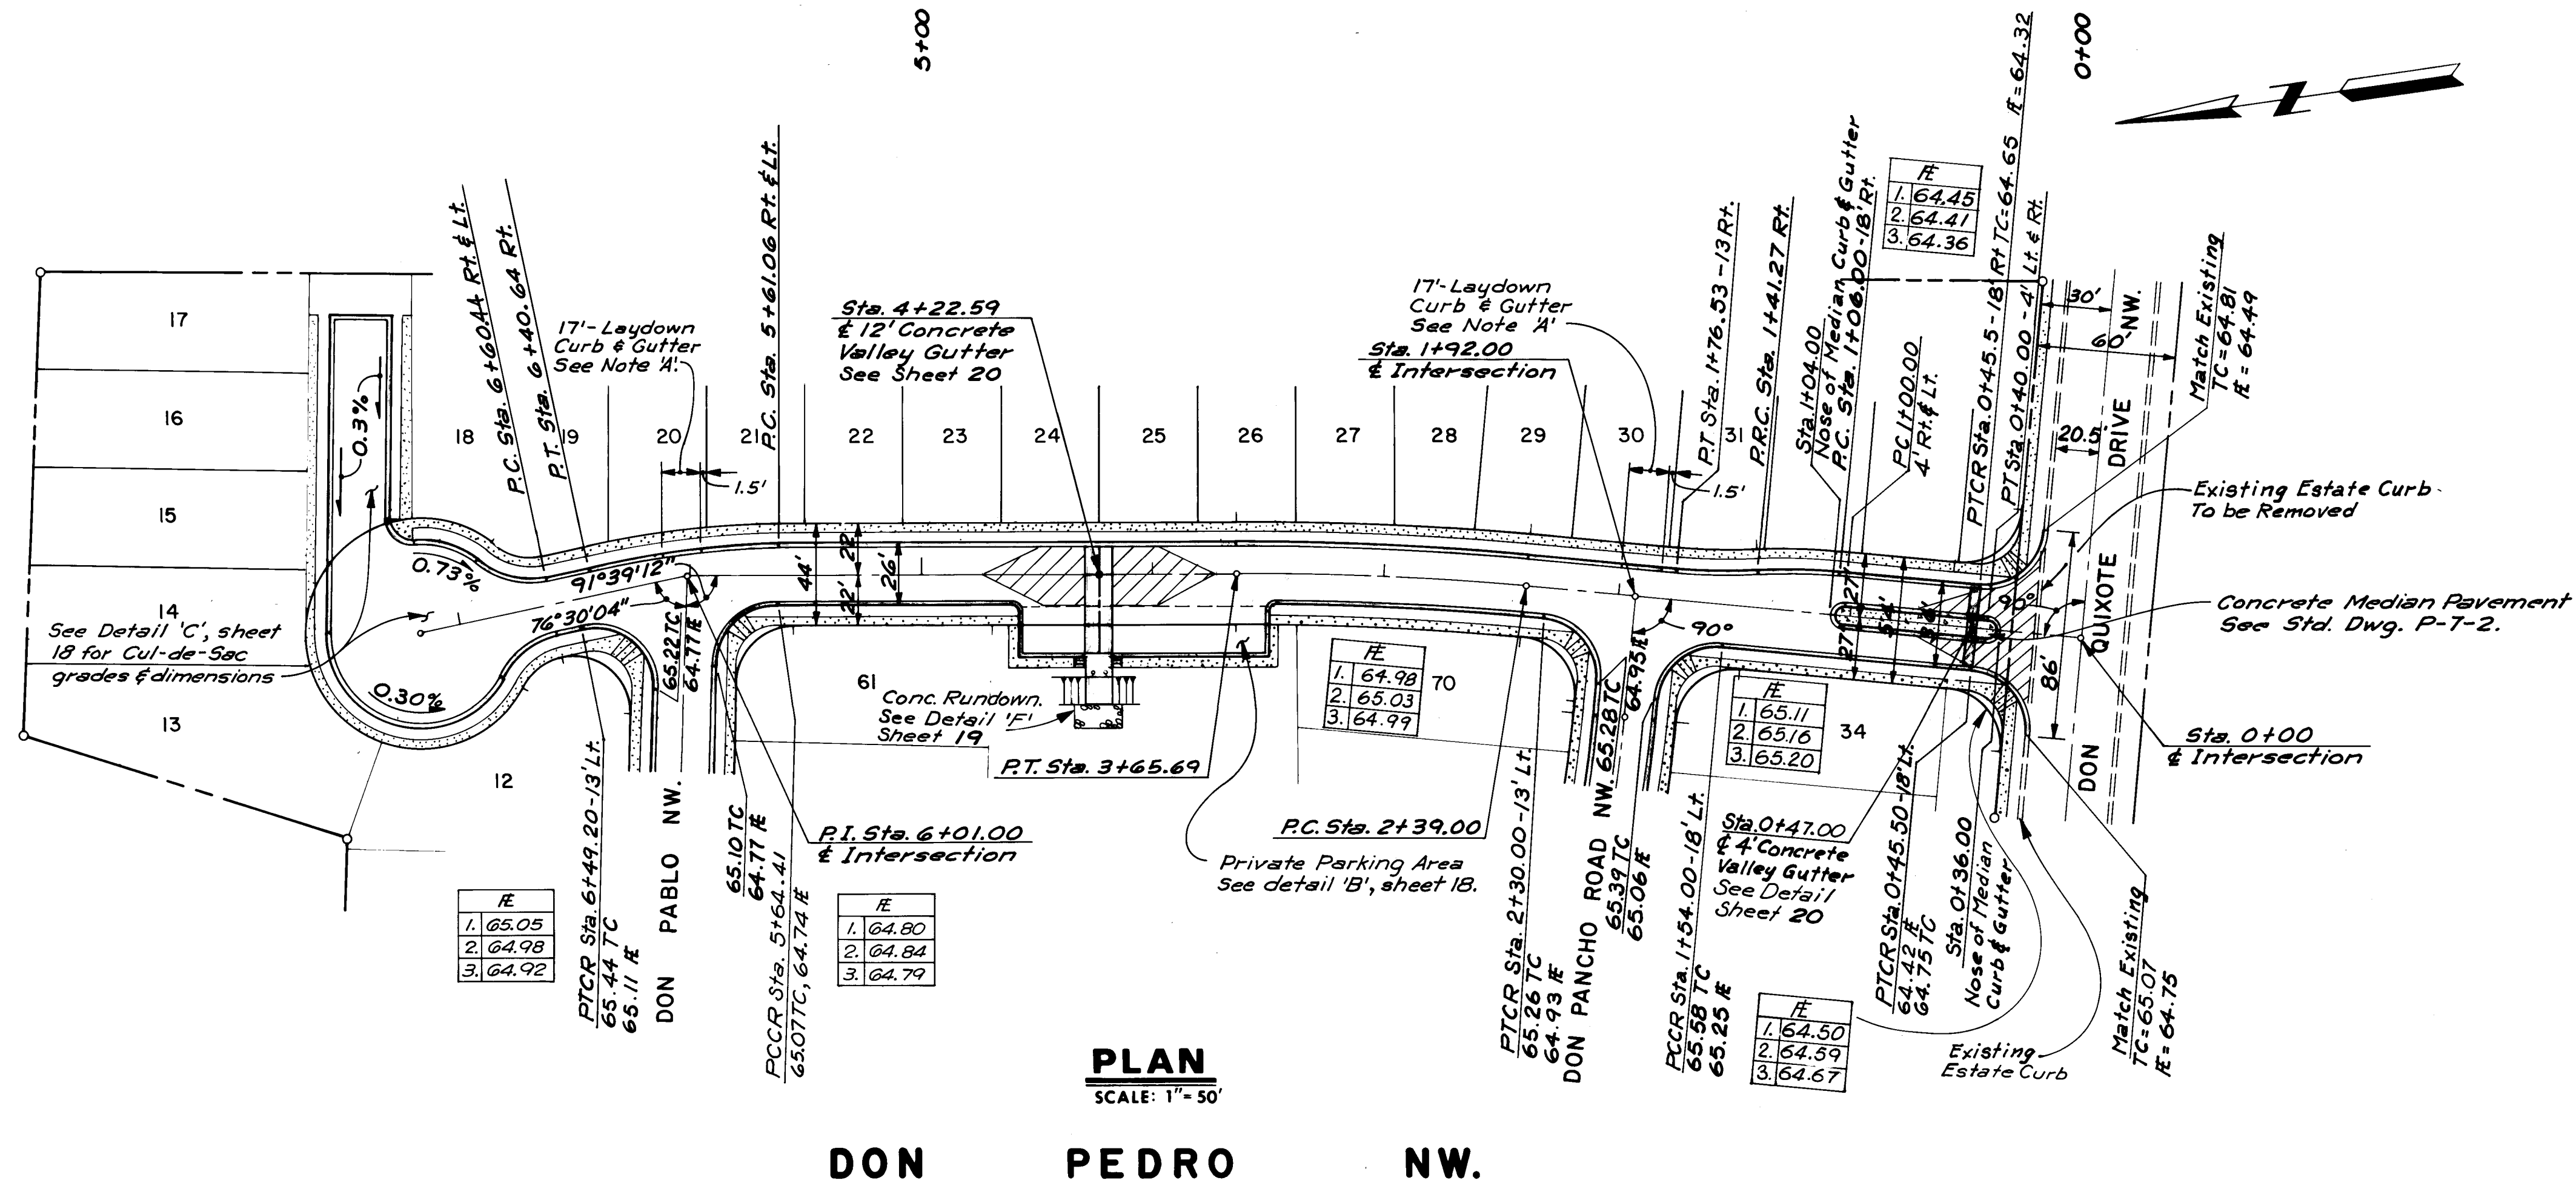

- LEGEND**
- Crown Transition Area
 - New Curb & Gutter
 - Existing Curb & Gutter
 - New Sidewalk

Note 'A'
Use 1'-6" Transition between Mountable Curb & Gutter - Roll Type and Laydown Curb & Gutter

2618091085

RECORD DRAWING

CITY OF ALBUQUERQUE
MUNICIPAL DEVELOPMENT DEPARTMENT
ENGINEERING DIVISION

THOMAS VILLAGE PATIO HOMES-SITE IMPROVEMENTS
PAVING PLAN & PROFILE
DON PEDRO NW.

APPROVALS	ENGINEER	DATE	APPROVALS	ENGINEER	DATE
City Engineer	<i>[Signature]</i>	12/1/83	Liquid Waste	NA	
A.C.E. - Design	<i>[Signature]</i>	10/1/83	Traffic	<i>[Signature]</i>	10/1/83
A.C.E. - Hydrology	<i>[Signature]</i>	10/1/83	Water	NA	

DRAWING NO. **1809** MAP NO. **G-12-Z** SHEET **10** OF **20**

ENGINEER'S SEAL		SURVEY INFORMATION		BENCH MARKS		AS BUILT INFORMATION	
NO.	DATE	NO.	DATE	STATION	ELEVATION	CONTRACTOR	DATE
				Sta. R.898-CNo.1	Elevation 4967.32	Universal Const. Inc.	1984
				Standard USC&GS Brass Cap. 1210'			
				West of extended centerline on Sheridan St. NW. and 46' south of fence line behind house No. 2715			

REVISIONS

NO.	DATE	REMARKS
DESIGNED BY	RF	DATE June 83
DRAWN BY	JJ	DATE June 83
CHECKED BY	JA	DATE June 83

ENGINEER'S SEAL
REGISTERED PROFESSIONAL ENGINEER
ALBUQUERQUE, N.M.
ANDREWS, ASBURY & ROBERT, INC.
ALBUQUERQUE, N.M.

Existing Surface Profile @ 2

Profile Grade @ R of Curb & Gutter

+0.29% Lt
+0.28% Rt

-0.38% Lt
-0.37% Rt

+72.05
+64.65 Rt
+67.05
+64.75 Lt

+66.09 PVI No Curve
+64.20 Lt, +64.10 Rt

+13.00
+65.15 Lt
+13.00
+65.04 Rt

PROFILE
SCALE: 1" = 50' Horiz.
1" = 5' Vert.

5+00 4 3 2 1 0+00

	Crown Transition Area
	New Curb & Gutter
	Existing Curb & Gutter
	New Sidewalk






PROFILE AD NW.			SHEET 11 OF 20		
SITE IMPROVEMENTS			REVISIONS		
NO.	DATE	REMARKS	BY		
DESIGN					
DESIGNED BY	R/F	DATE	June 83		
DRAWN BY	JJ JCS	DATE	June 83		
CHECKED BY	JA	DATE	June 83		
ENGINEER'S SEAL			ANDREWS, ASBURY & ROBERT, INC. CONSULTING ENGINEERS ALBUQUERQUE, NEW MEXICO		
SURVEY INFORMATION			BENCH MARKS		
NO.	BY	DATE	Sta. R898-C No. 1, Elevation 4907.92		
FIELD NOTES			Standard USC & GS Brass Cap, 121.01'		
NO. DATE			west of extended center-line on Sheridan		
NO. DATE			St. NW and 4.6' south of fence line		
NO. DATE			behind house No. 2715		
NO. DATE			MICRO-FILM INFORMATION		
NO. DATE			RECORDED BY DATE		
NO. DATE			NO. DATE		
AS BUILT INFORMATION			AS BUILT INFORMATION		
CONTRACTOR Universal Const. Inc.			CONTRACTOR Universal Const. Inc.		
WORK ORDER BY A.A.# R. DATE 10/84			WORK ORDER BY A.A.# R. DATE 10/84		
INSPECTION BY DATE			INSPECTION BY DATE		
ACCEPTANCE BY DATE			ACCEPTANCE BY DATE		
FIELD ACTION BY A.A.# R. DATE 10/84			FIELD ACTION BY A.A.# R. DATE 10/84		
DRAWINGS CORRECTED BY A.A.# R. DATE 2/85			DRAWINGS CORRECTED BY A.A.# R. DATE 2/85		

RECORD DRAWING

CITY OF ALBUQUERQUE									
MUNICIPAL DEVELOPMENT DEPARTMENT									
ENGINEERING DIVISION									
THOMAS VILLAGE PATIO HOMES - SITE IMPROVEMENTS									
PAVING PLAN & PROFILE									
DON PANCHO ROAD NW.									

DON TARRANT ROAD NW.					
APPROVALS	ENGINEER	DATE	APPROVALS	ENGINEER	DATE
City Engineer	<i>C. L. Lippert</i>	12/1/03	Liquid Waste	NA	
A.C.E.-Design	<i>J. L. Lippert</i>	10/2/03	Traffic	<i>T. W. Lippert</i>	10/14/03
A.C.E.-Hydrology	<i>J. L. Lippert</i>	11/1/03	Water	NA	






DRAWING NO.	1809	MAP NO. G-12-Z	SHEET 11 OF 20
-------------	------	-------------------	----------------

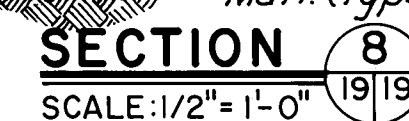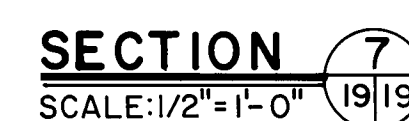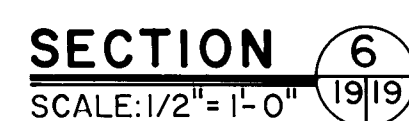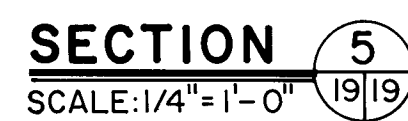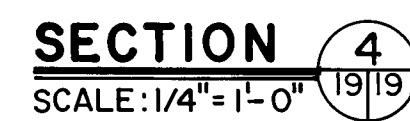

NOTES:

1. All Wood Posts to be 8" dia. and Treated in conformance with AASHTO M-133
2. All Reinforcing shall be continuous at corners.





SHEET 18 OF 20			SITE IMPROVEMENTS DETAILS			DIVISION DEPARTMENT			REQUIRE		
NO.	DATE	REMARKS	BY								
				DESIGN		DATE		June 83			
				DRAWN BY		DATE		June 83			
				CHECKED BY		DATE		June 83			
				DESIGNED BY		DATE		June 83			
				REVISIONS							
				REGISTERED PROFESSIONAL ENGINEER		STATE OF		NEW MEXICO			
				NO. 10000		DATE		June 83			
				NAME		DATE		June 83			
				FIRM		DATE		June 83			
				ADDRESS		DATE		June 83			
				CITY		DATE		June 83			
				STATE		DATE		June 83			
				COUNTRY		DATE		June 83			
				DESIGNED BY		DATE		June 83			
				DRAWN BY		DATE		June 83			
				CHECKED BY		DATE		June 83			
				DESIGNED BY		DATE		June 83			
				DRAWN BY		DATE		June 83			
				CHECKED BY		DATE		June 83			
				DESIGNED BY		DATE		June 83			
				DRAWN BY</							

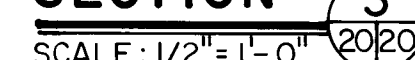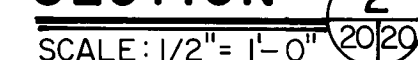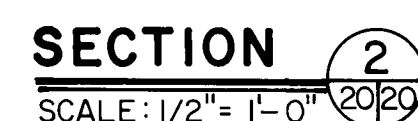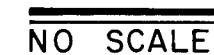
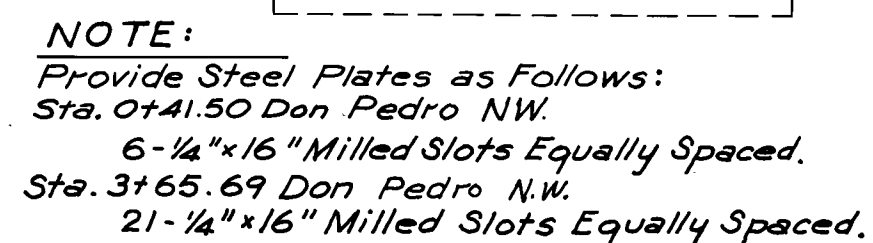


26 18092065

RECORD DRAWING

DRAWING NO.	1809	MAP NO.	G-12-Z	SHEET	20	OF	20
-------------	------	---------	--------	-------	----	----	----

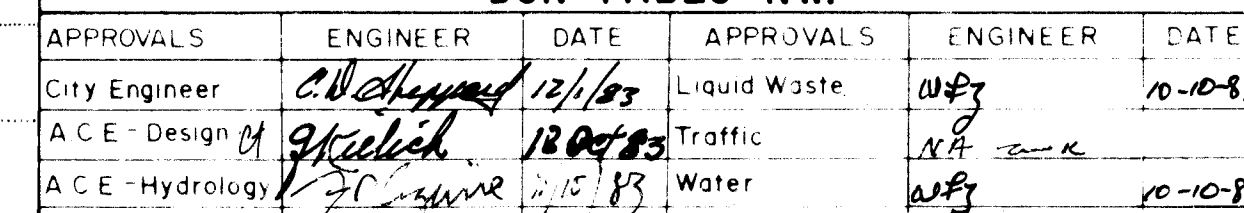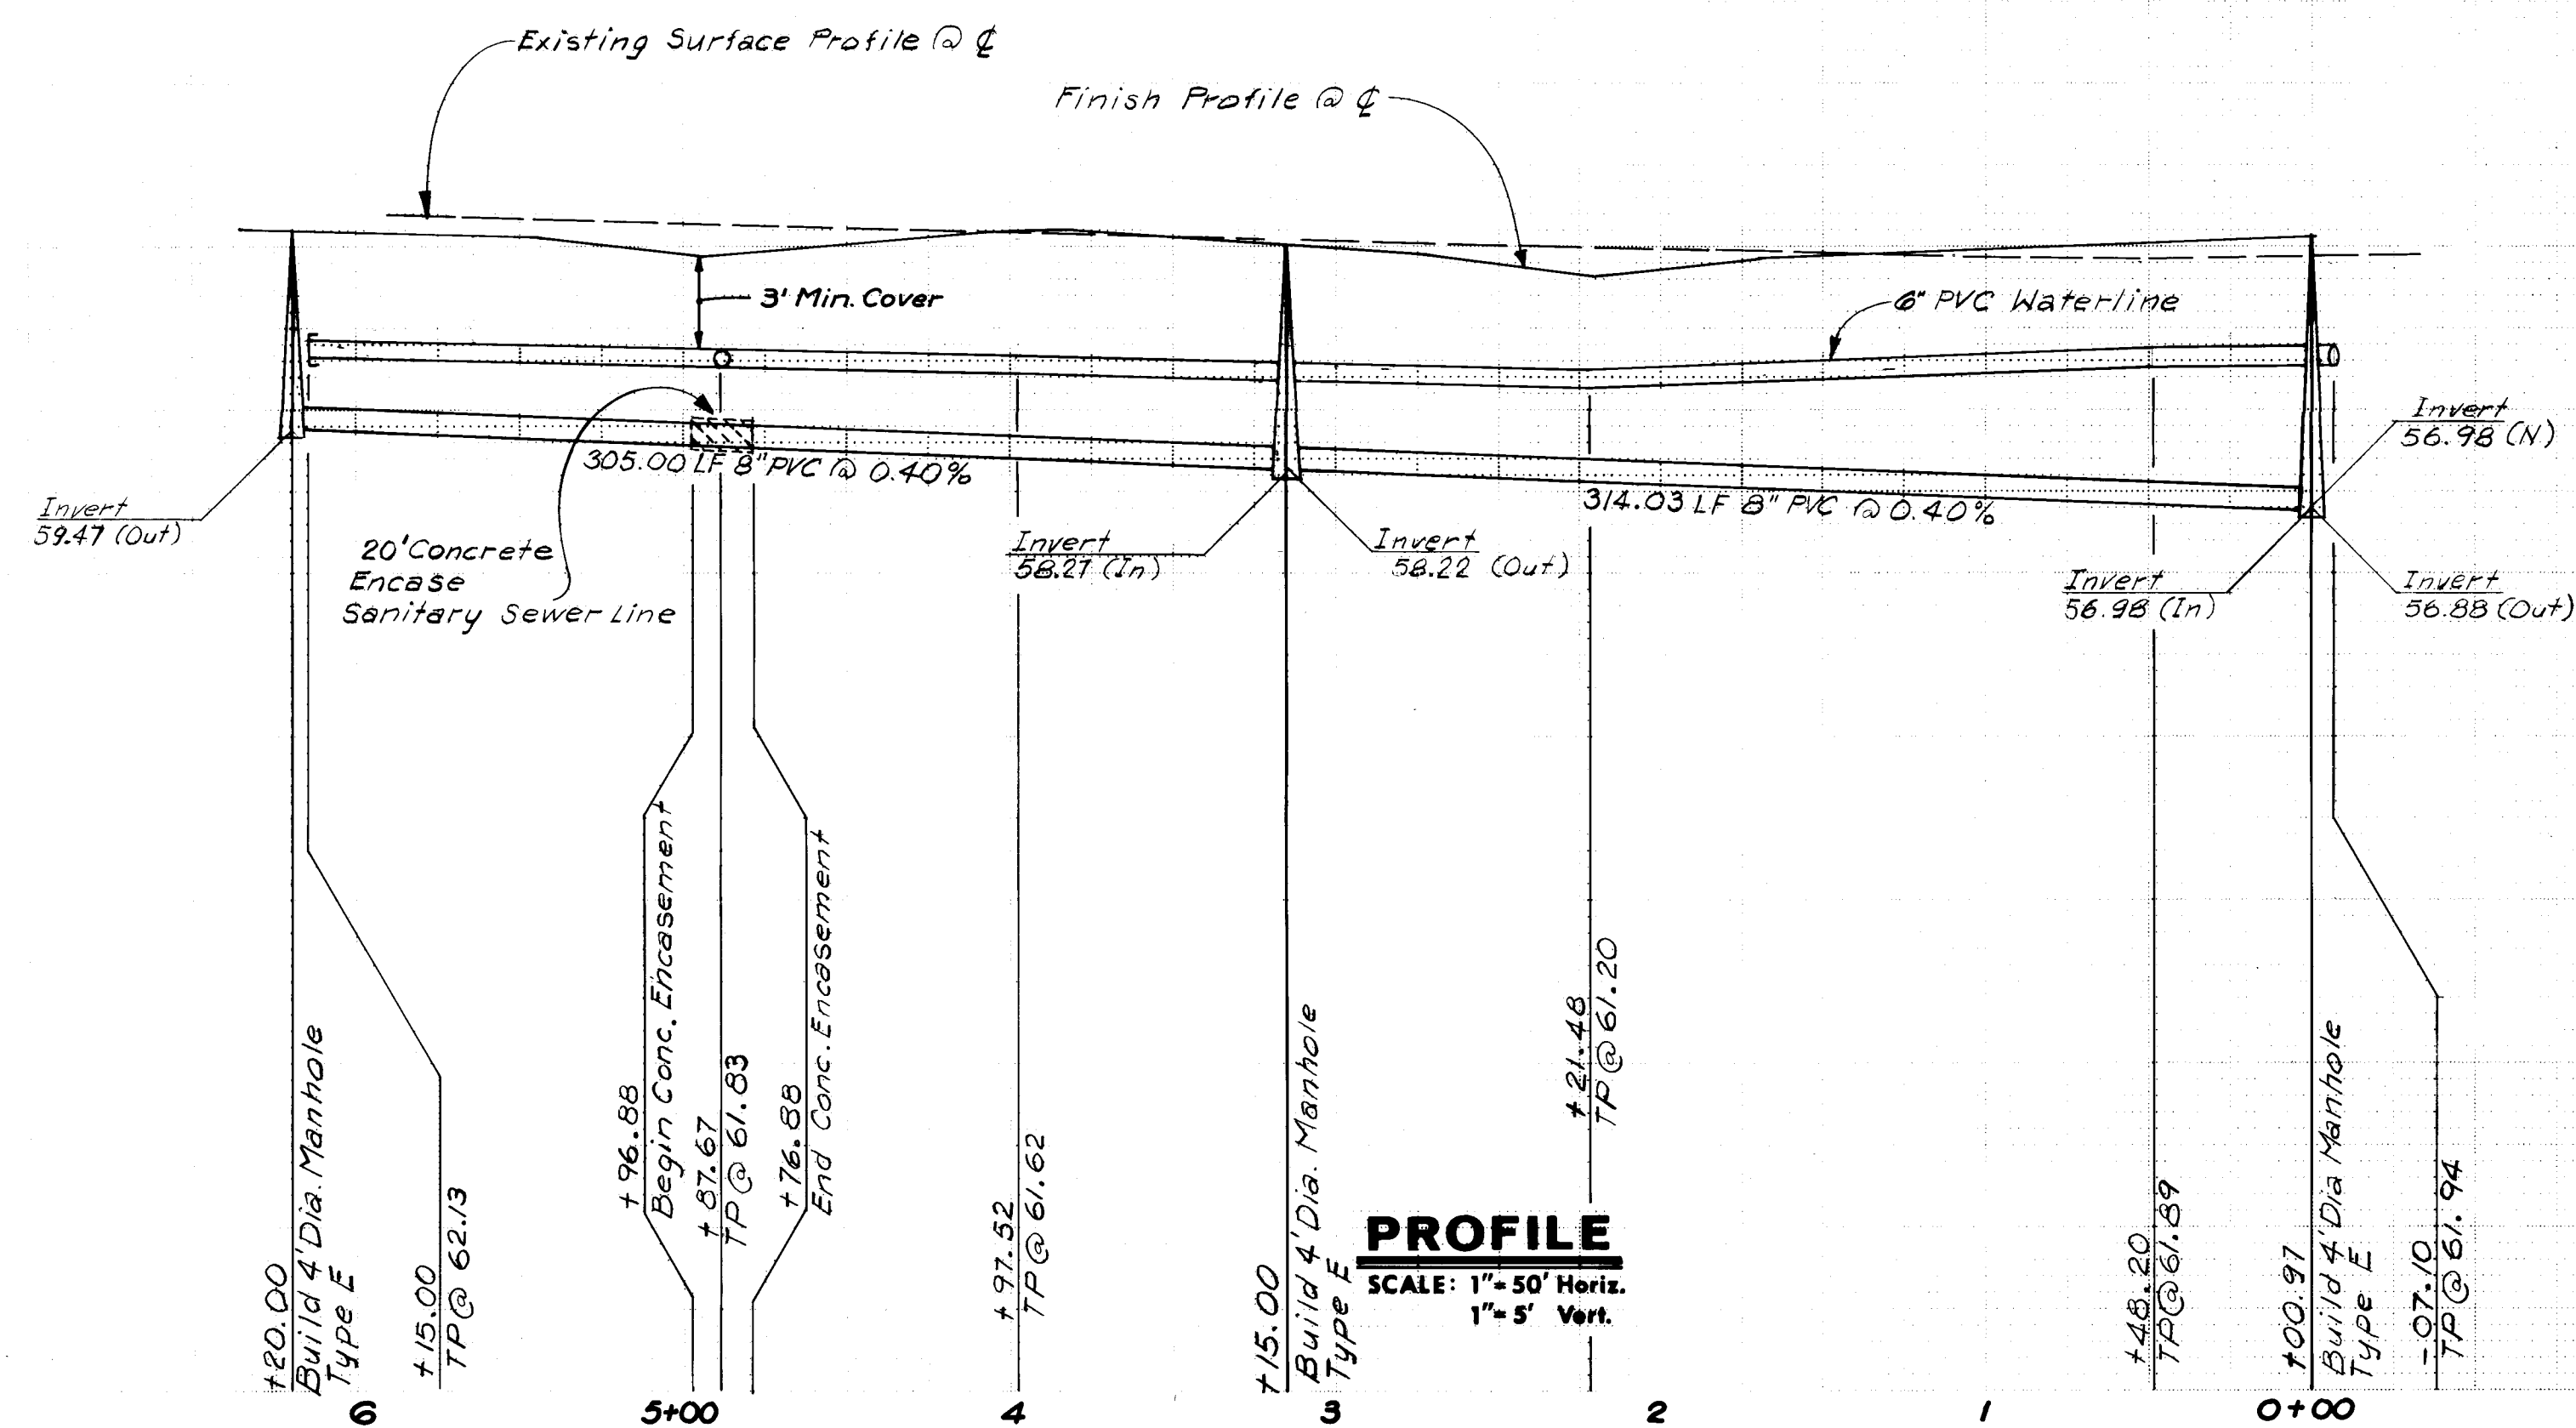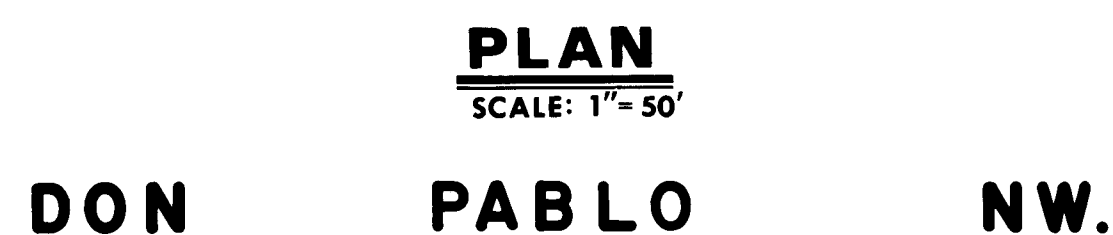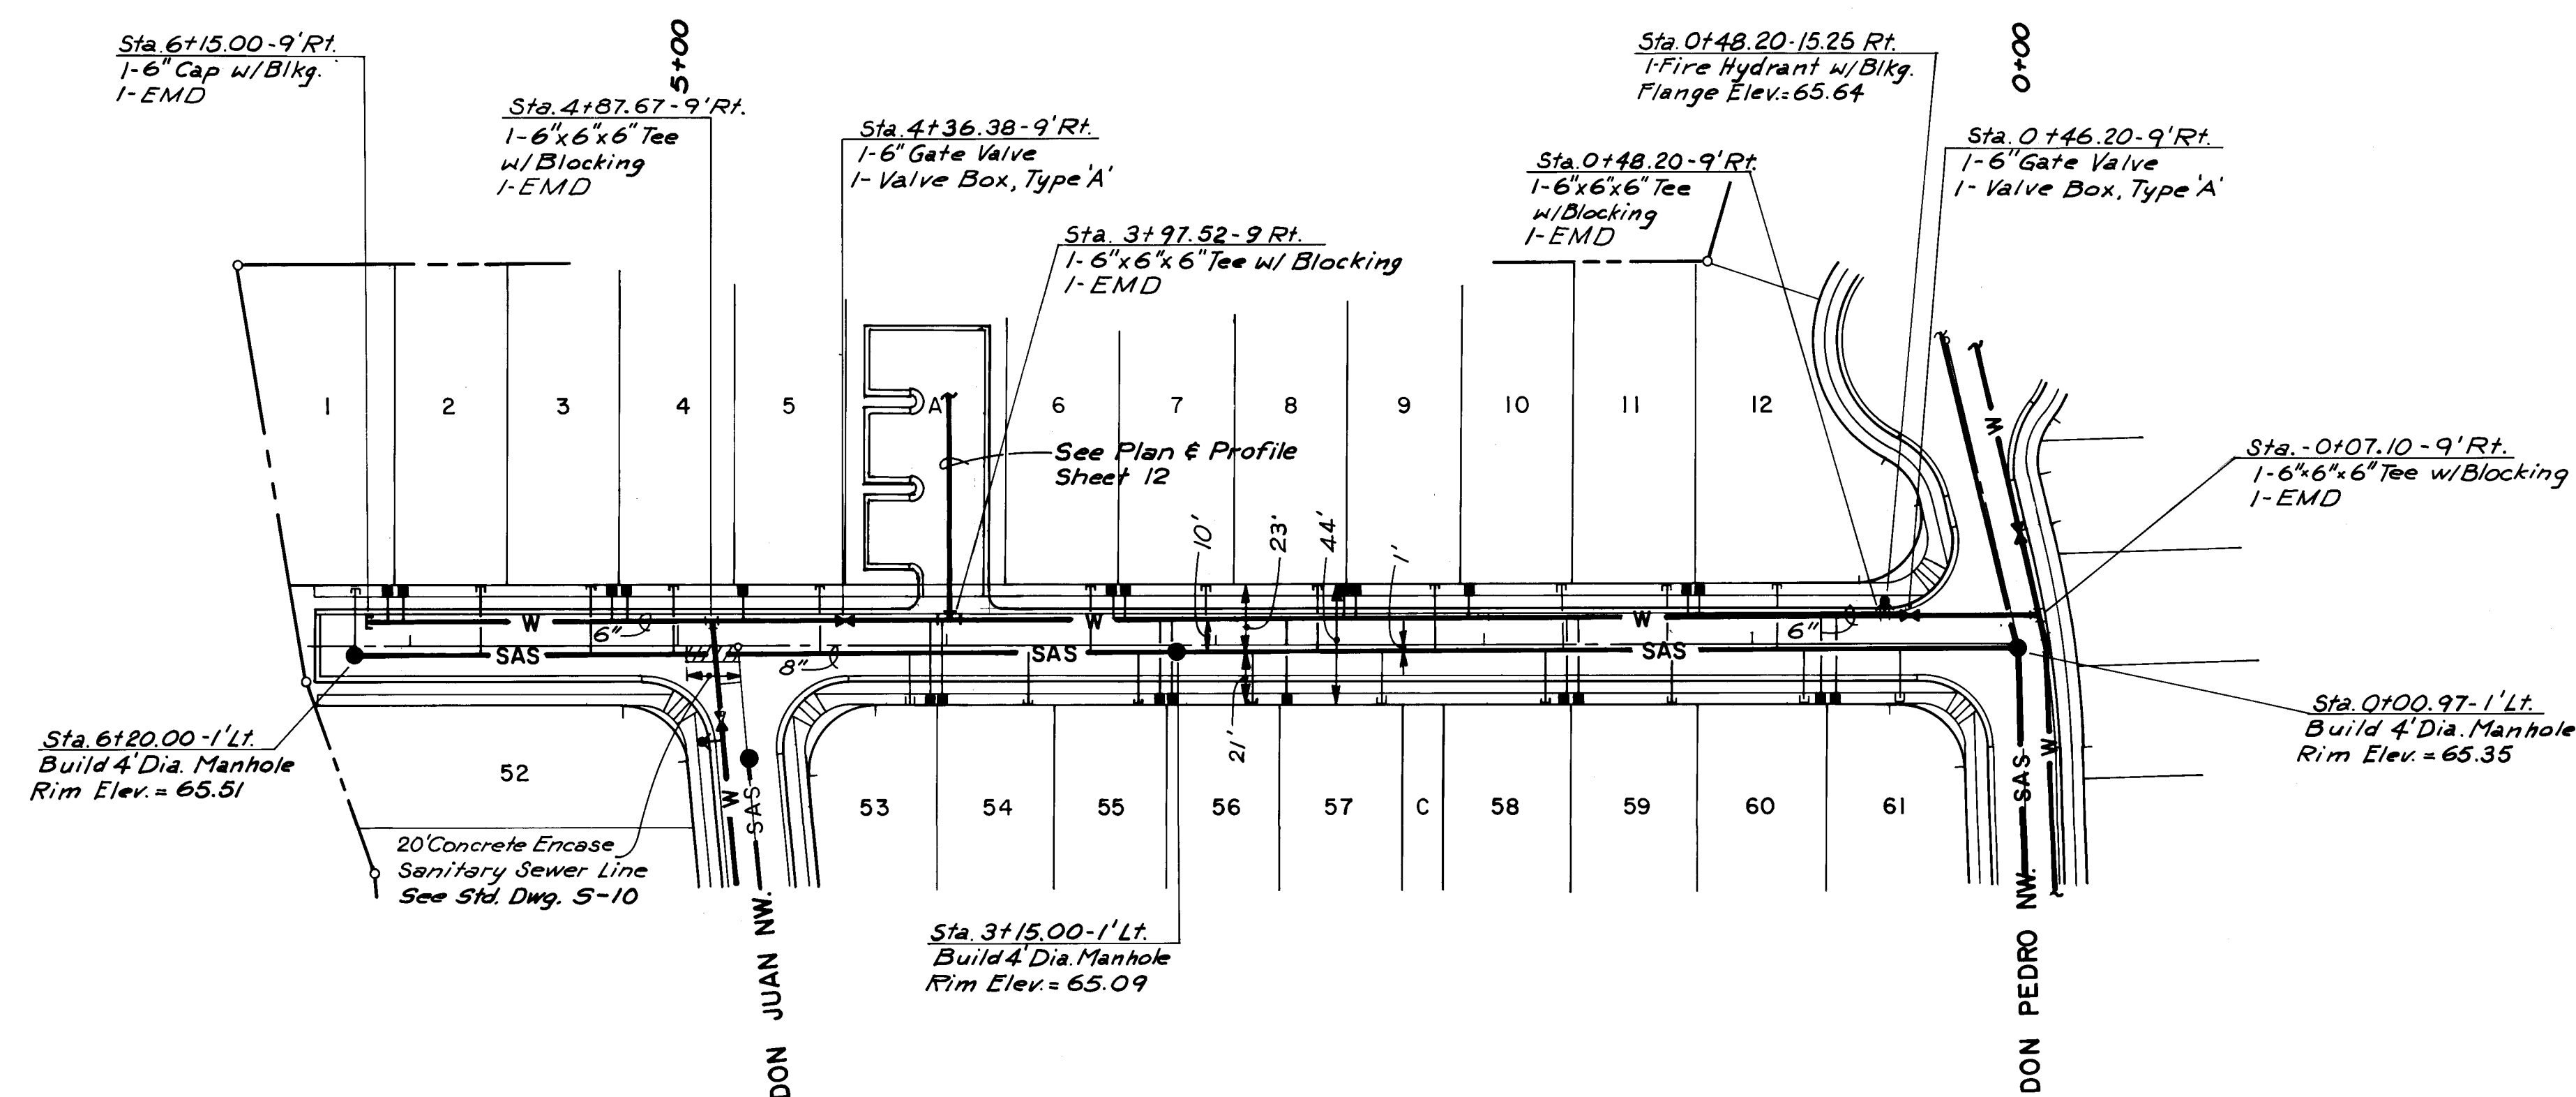

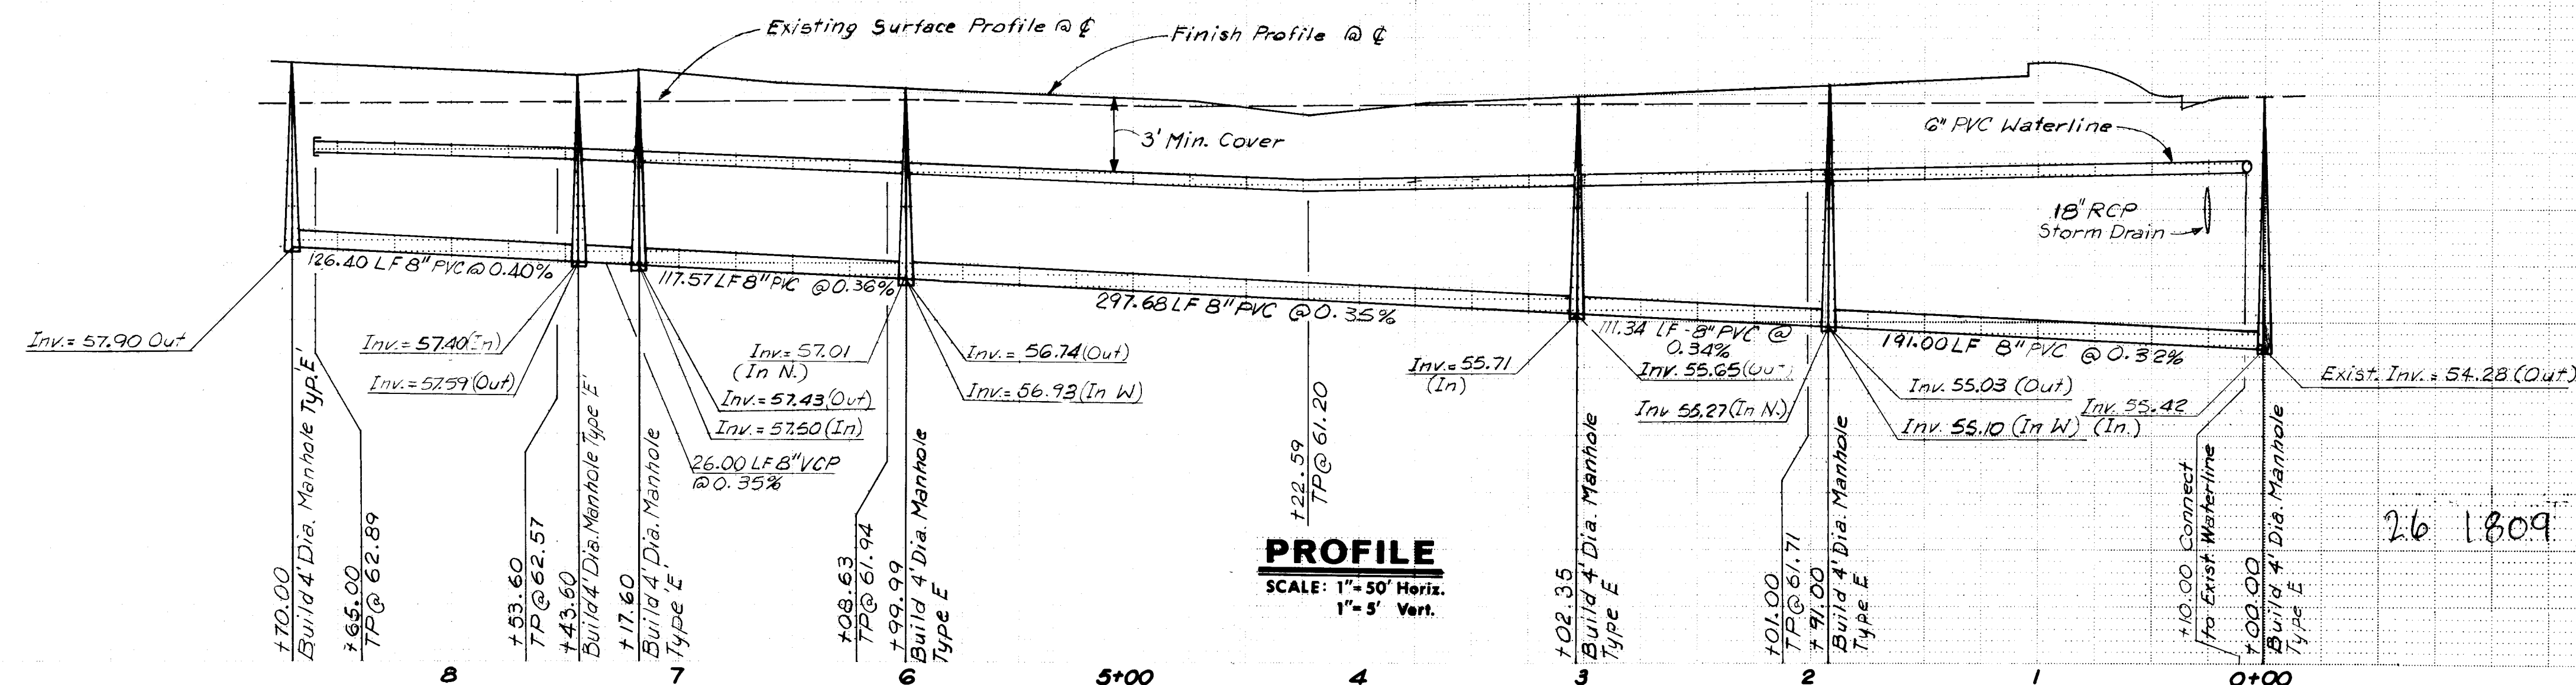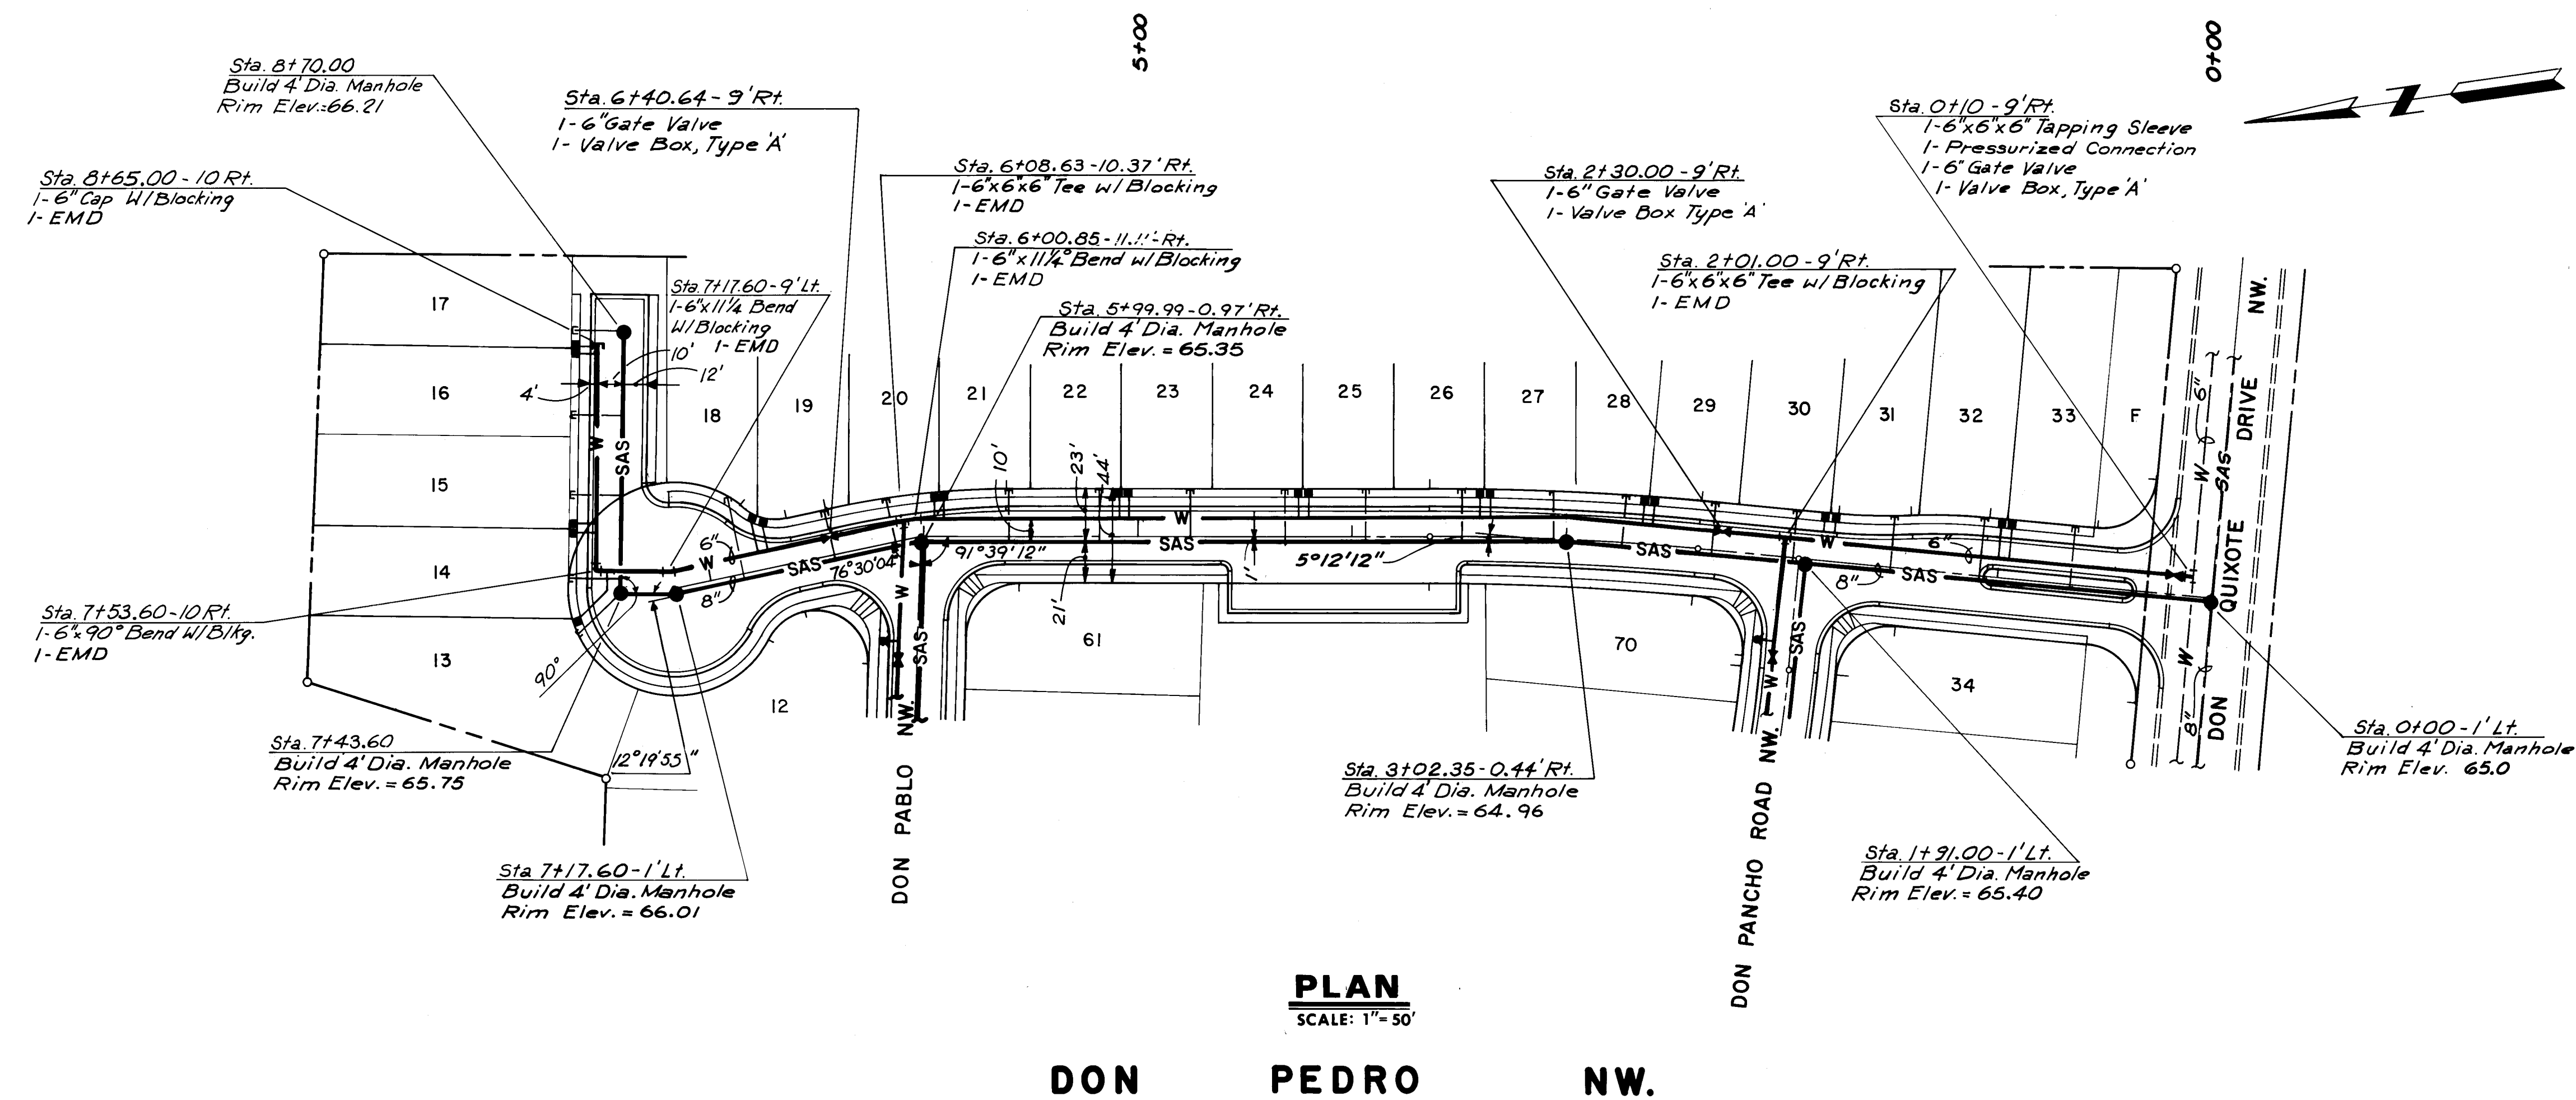

SEWER SERVICE INVERT DATA		
LOT NO.	℄ STATION	INVERT OF SEWER SERVICE ℄
33	0+66.00-27.00*RT	59.00
32	1+08.50-26.95*RT	59.11
31	1+50.00-23.10*RT	59.21
30	1+95.50-22.00*RT	59.32
29	2+32.50-22.00*RT	59.41
28	2+75.50-22.00*RT	59.52
27	3+08.00-22.00*RT	59.60
26	3+48.50-22.00*RT	59.70
25	3+92.25-22.00*RT	59.81
24	4+30.00-22.00*RT	59.91
23	4+74.00-22.00*RT	60.01
22	5+17.00-22.00*RT	60.12
21	5+39.00-22.00*RT	60.23
20	6+13.50-22.00*RT	60.36
19	6+42.50-22.00*RT	60.43
18	6+85.50-38.00*RT	60.58
17	7+43.60-28.00*LT	60.72
16	7+51.60-23.00*LT	60.74
15	7+94.00-23.00*LT	60.85
14	8+31.00-23.00*LT	60.94
13	8+70.00-23.00*LT	61.00

BENCH MARKS	AS BUILT INFORMATION
a. R 890-C/A-1, Elevation 4967.32 Standard USC & GS Brass Cap, 121.0' west of extended center-line on Sheridan St. NW, and 4.6' south of fence line behind house No. 2715	UNIVERSAL - Universal Constr. Inc. A. A. & R. A. A. & R. DATE: '84 NORTH BY DATE FIELD BY DESCRIPTION BY A. A. & R. DATE 10/84 CORRECTED BY A. A. & R. DATE 2/85 MICRO-FILM INFORMATION RECORDED BY DATE NO

[illegible]



ENGINEER'S SEAL



ANDREWS ASBURY & ROBERT, INC.
CONSULTING ENGINEERS
ALBUQUERQUE 82-519 NEW MEXICO

NO. DATE		REMARKS	BY
		<i>REVIEWS</i>	
<i>DESIGN</i>			
DESIGNED BY	<i>RF</i>	DATE	<i>June 83</i>
DRAWN BY	<i>JJ</i>	DATE	<i>June 83</i>
CHECKED BY	<i>JA</i>	DATE	<i>June 83</i>


CITY OF ALBUQUERQUE MUNICIPAL DEVELOPMENT DEPARTMENT ENGINEERING DIVISION					
THOMAS VILLAGE PATIO HOMES-SITE IMPROVEMENTS WATER & SANITARY SEWER PLAN & PROFILE DON PEDRO NW.					
APPROVALS	ENGINEER	DATE	APPROVALS	ENGINEER	DATE
City Engineer	<i>C. J. [Signature]</i>	12/1/83	Liquid Waste	<i>W. [Signature]</i>	10-10-83
A.C.E. - Design	<i>[Signature]</i>	10-10-83	Traffic	<i>N. [Signature]</i>	
A.C.E. - Hydrology	<i>[Signature]</i>	10-10-83	Water	<i>W. [Signature]</i>	10-10-83
DRAWING NO.	1809		MAP NO.	G-12-Z	
			SHEET	OF	
			14		20

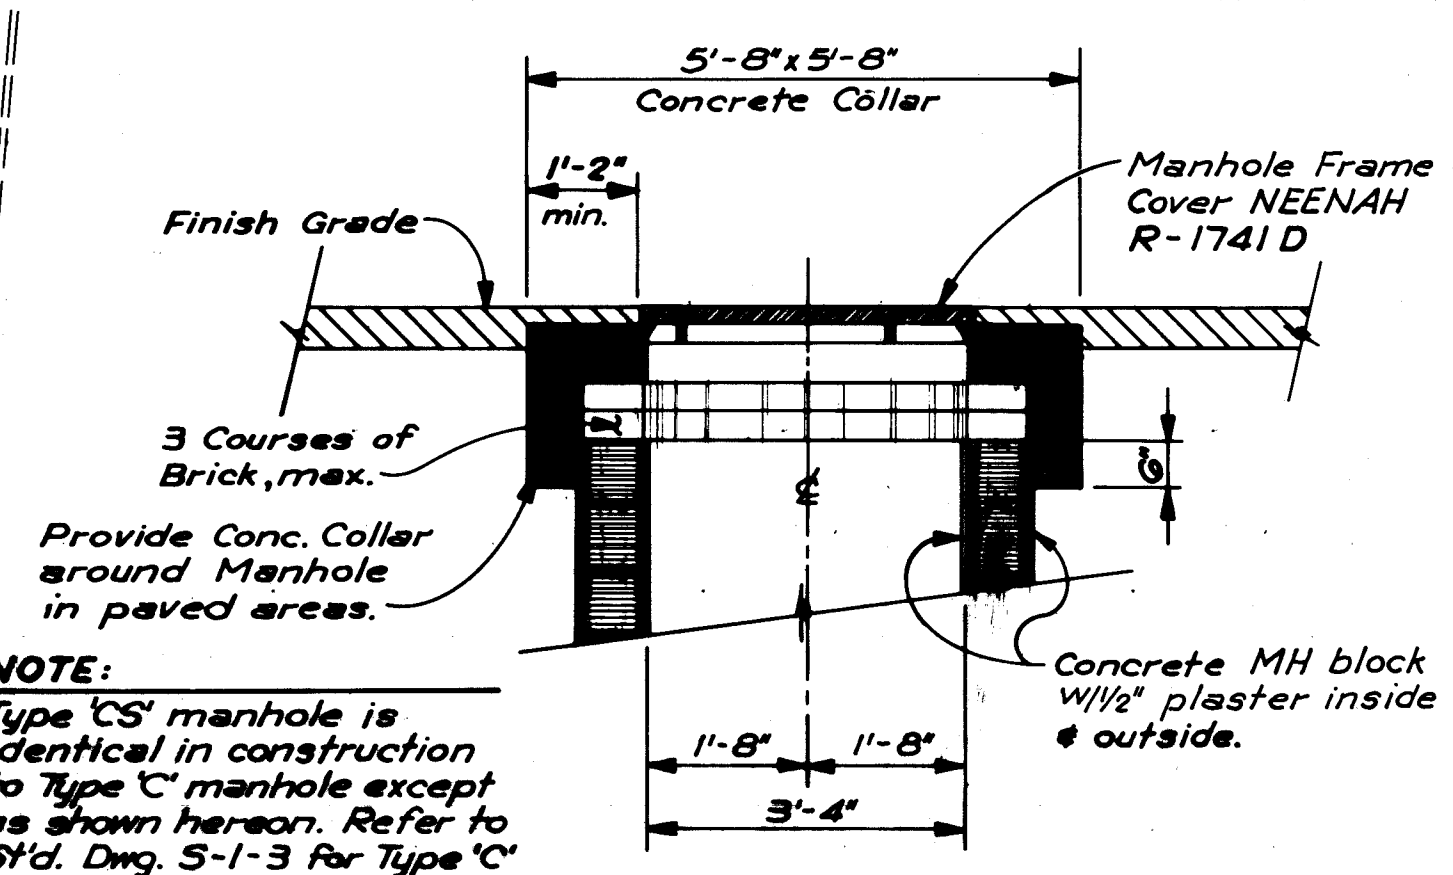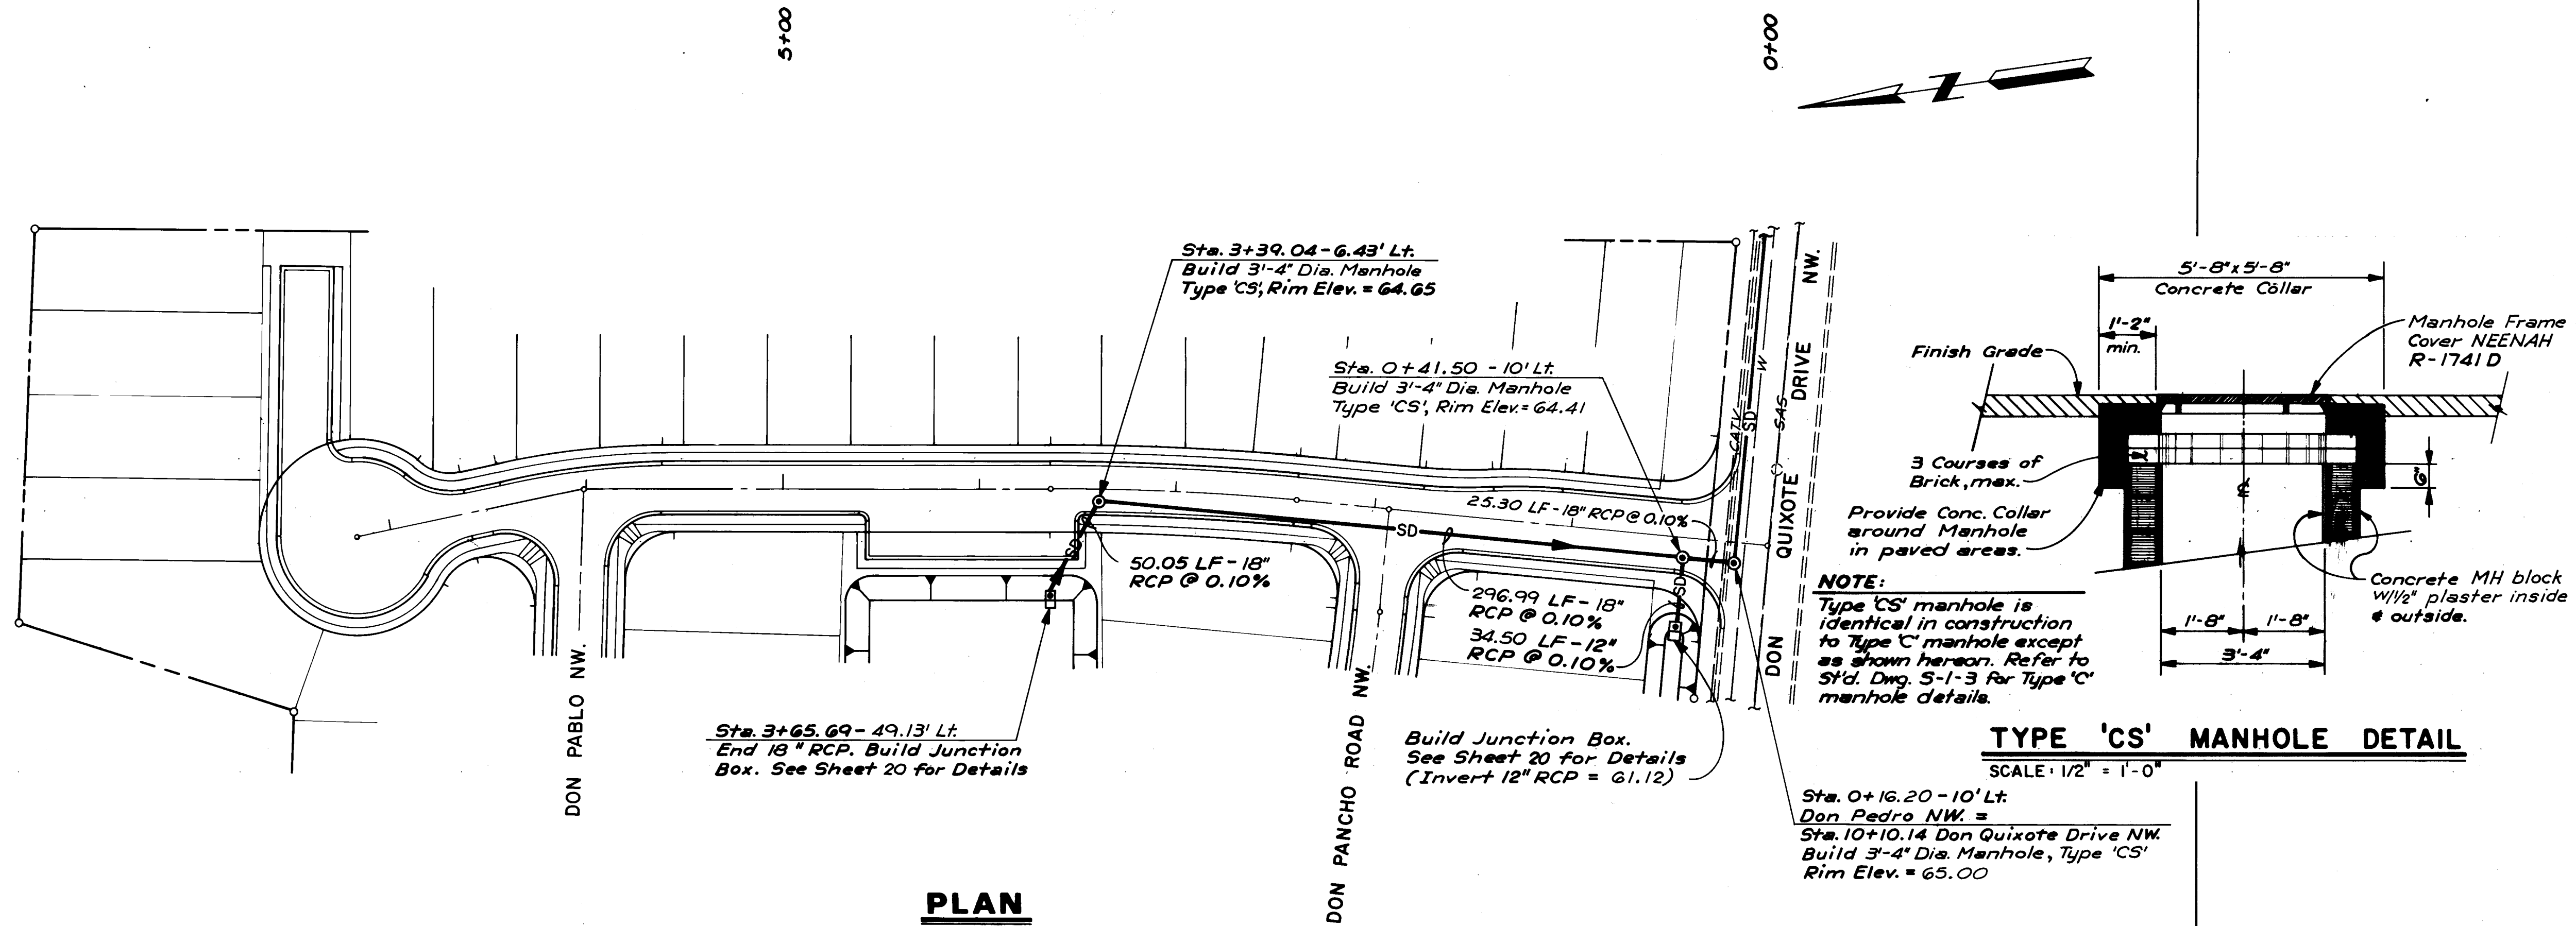

PLAN
SCALE: 1" = 50'

TYPE 'CS' MANHOLE DETAIL
SCALE: 1/2" = 1'-0"

PROFILE
SCALE: 1" = 50' Horiz.
1" = 5' Vert.

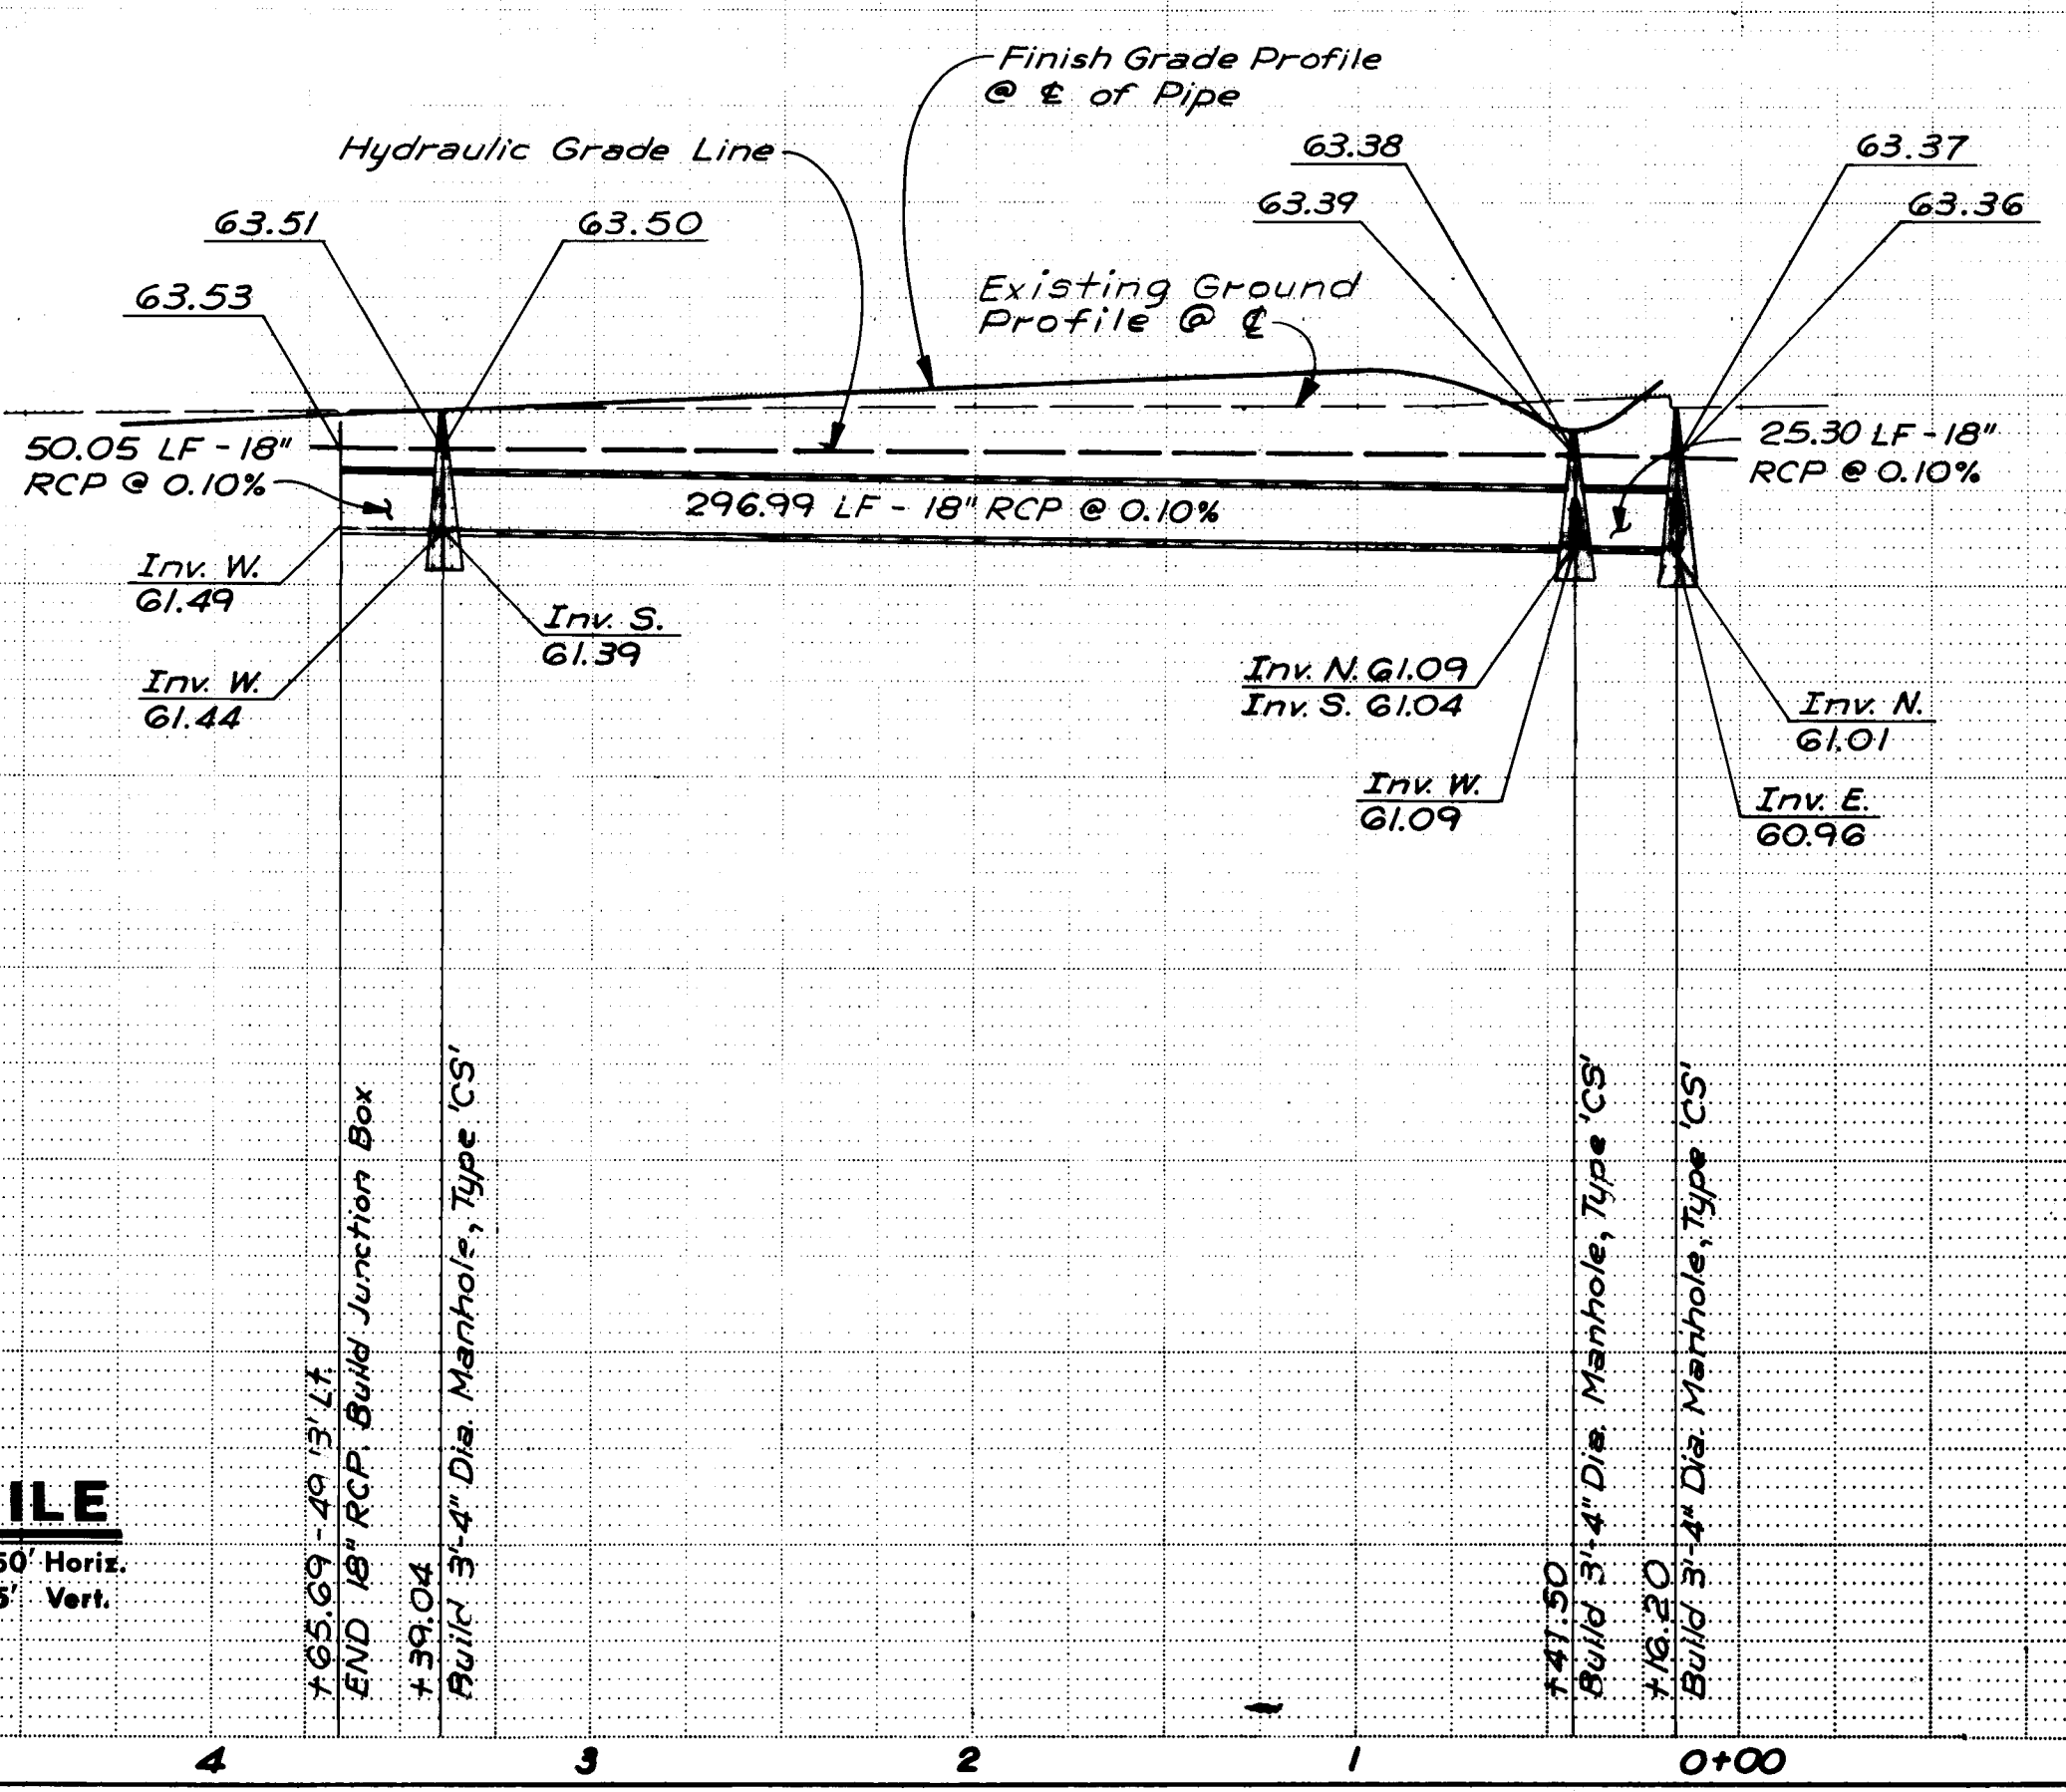

LEGEND


- SD — New Storm Drain Line & Manhole
- JB — Junction Box

2618091785

RECORD DRAWING

CITY OF ALBUQUERQUE MUNICIPAL DEVELOPMENT DEPARTMENT ENGINEERING DIVISION					
THOMAS VILLAGE PATIO HOMES-SITE IMPROVEMENTS STORM DRAIN PLAN & PROFILE DON PEDRO NW.					
APPROVALS	ENGINEER	DATE	APPROVALS	ENGINEER	DATE
City Engineer	C. N. Hughes	12/1/83	Liquid Waste	NA	
A.C.E. - Design	C. N. Hughes	10/24/83	Traffic	NA	
A.C.E. - Hydrology	C. N. Hughes	10/24/83	Water	NA	
DESIGNED BY		RF	DATE		June 83
DRAWN BY		JJ	DATE		June 83
CHECKED BY		JJA	DATE		June 83
DRAWING NO.		1809	MAP NO.		G-12-Z
			SHEET		17 OF 20


AS BUILT INFORMATION		BENCH MARKS		SURVEY INFORMATION		ENGINEER'S SEAL	
CONTRACTOR	Universal Const. Inc.	Sta. R. 898 - C.M. 1, Elevation 4967.32	Standard USC & GS Brass Cap, 1210'	NO.	BY	DATE	Professional Engineer Seal
WORK STARTED BY	A.A. & R.	INSPECTOR'S FIELD	west of extended centerline on Sheridan St. NW, and 46' south of fence line behind house No. 2715				
VERIFICATION BY	A.A. & R.	DATE	10/83				
CORRECTED BY	A.A. & R.	DATE	2/85				
MICRO-FILM INFORMATION							
RECORDED BY	NO						
DATE							

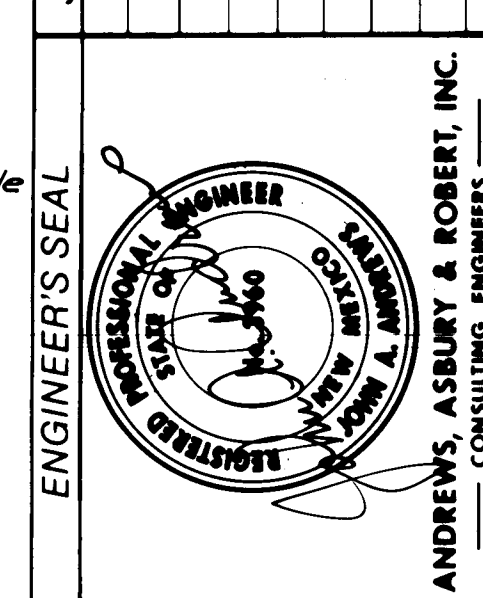


1	2-84	Revised Storm Drain	ARC	BY	DATE
NO.	DATE	REVISIONS	DESIGN	DATE	DATE
				June 83	June 83
				June 83	June 83

18091


18091

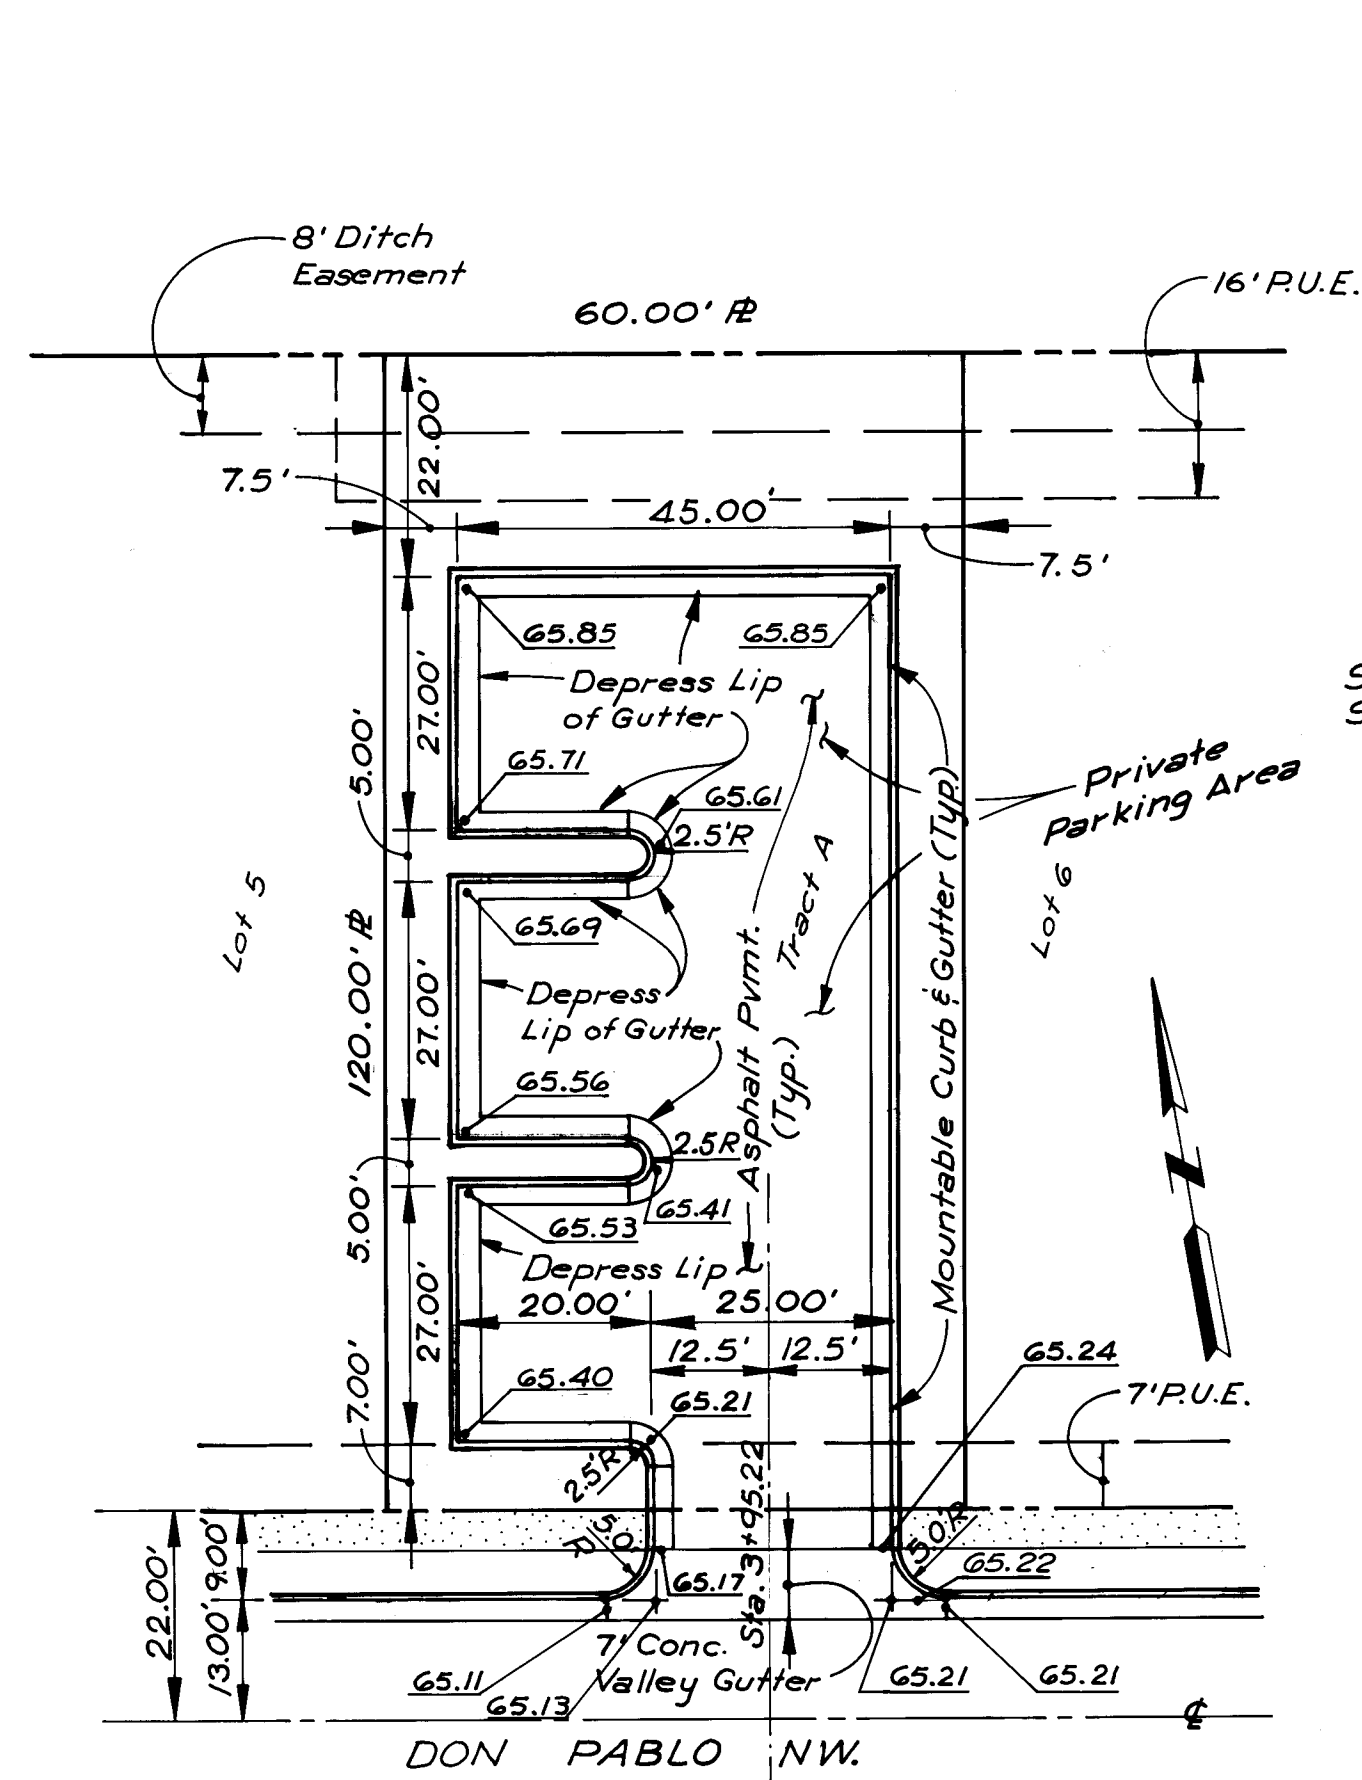


DETAIL 'A'
SCALE: 1" = 20'

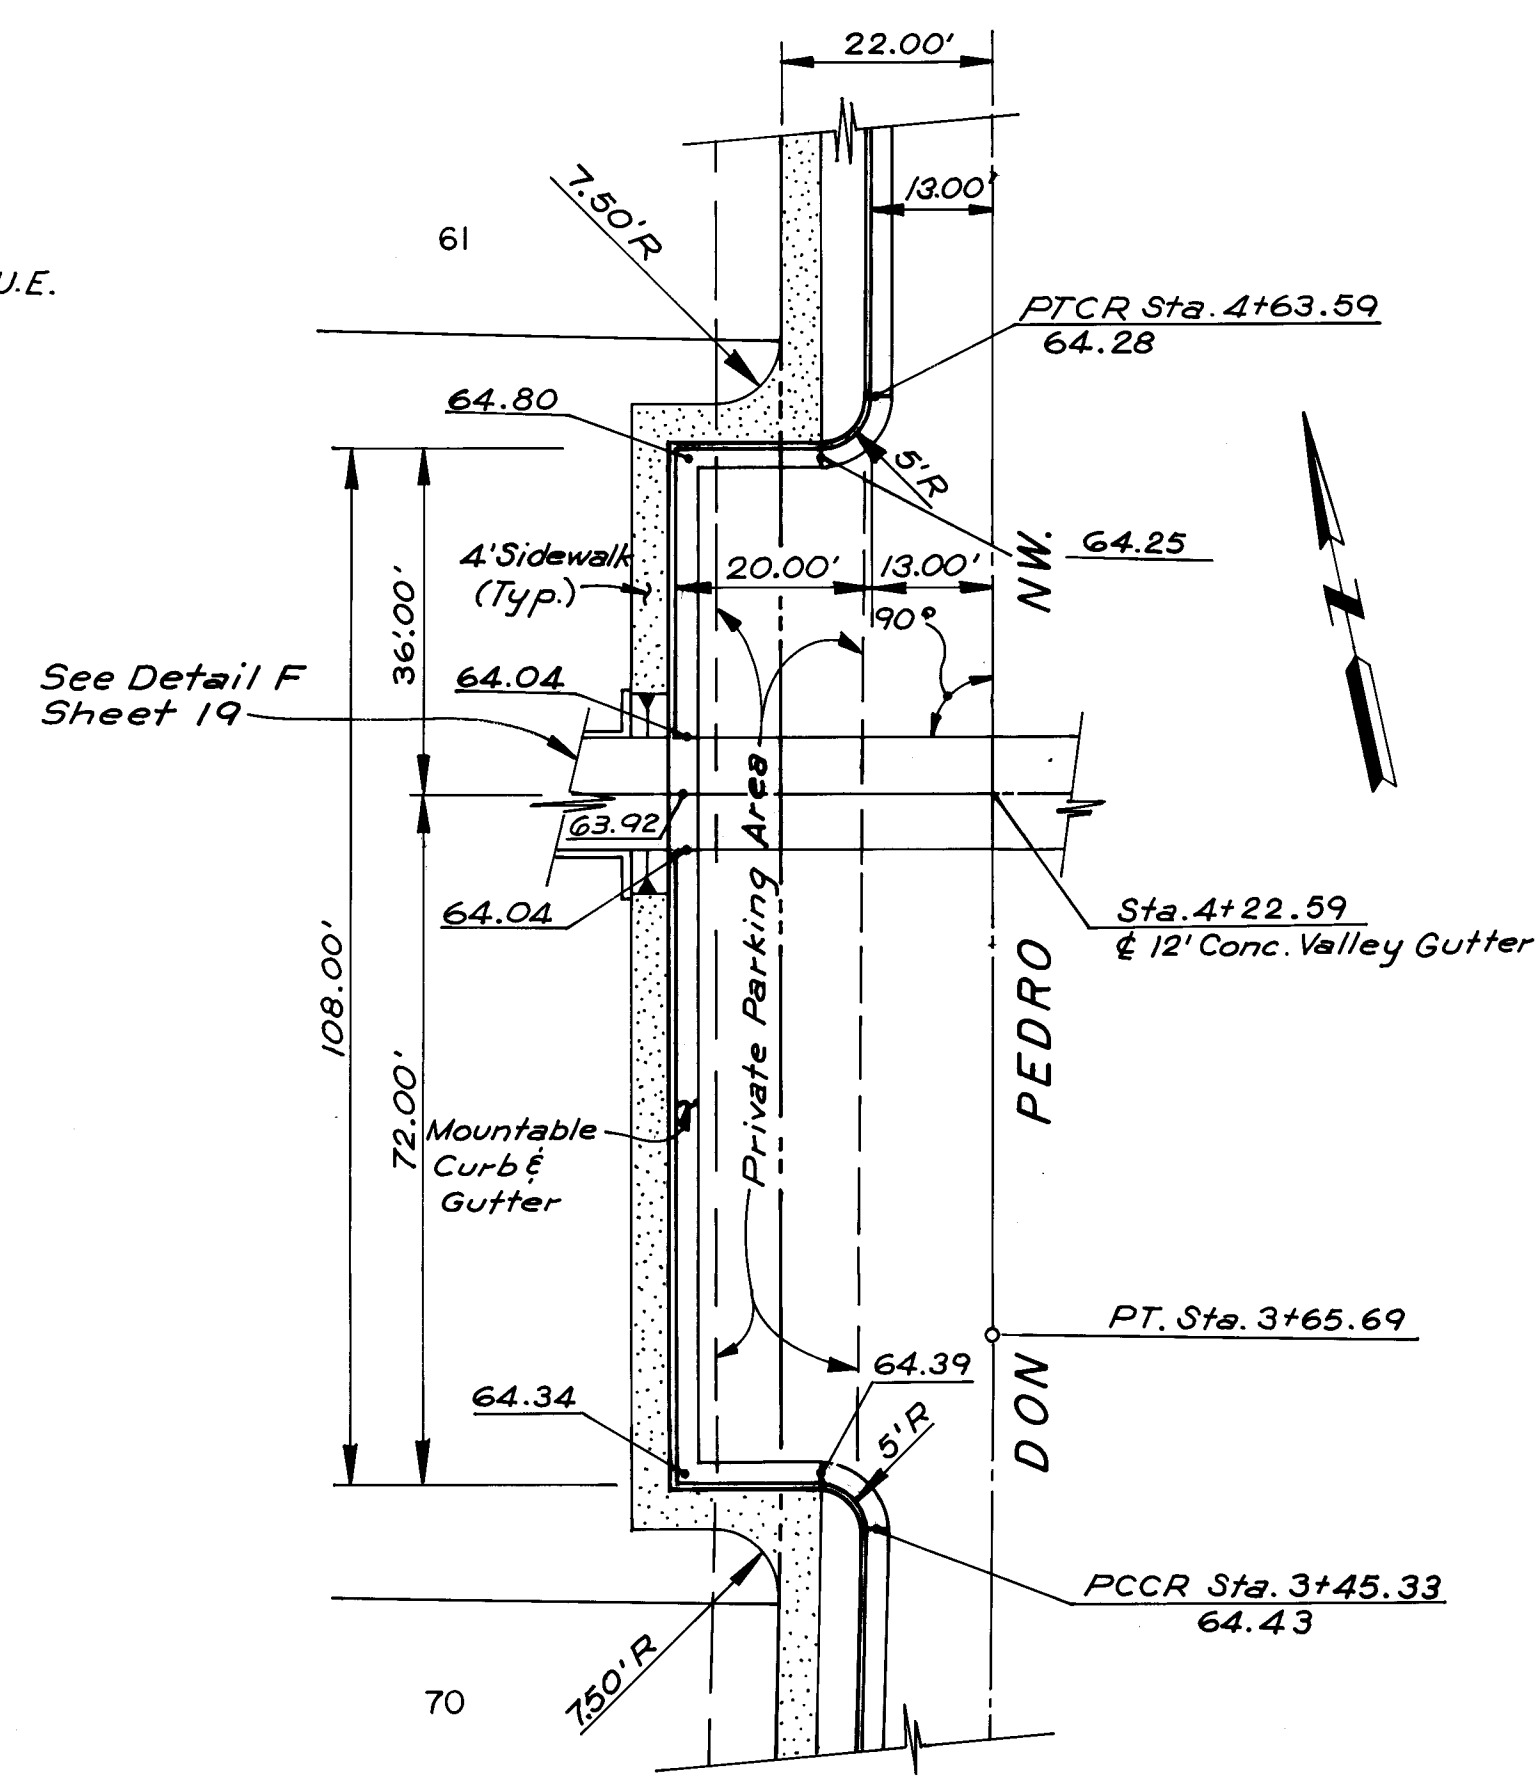

DETAIL 'B'
SCALE: 1" = 20'

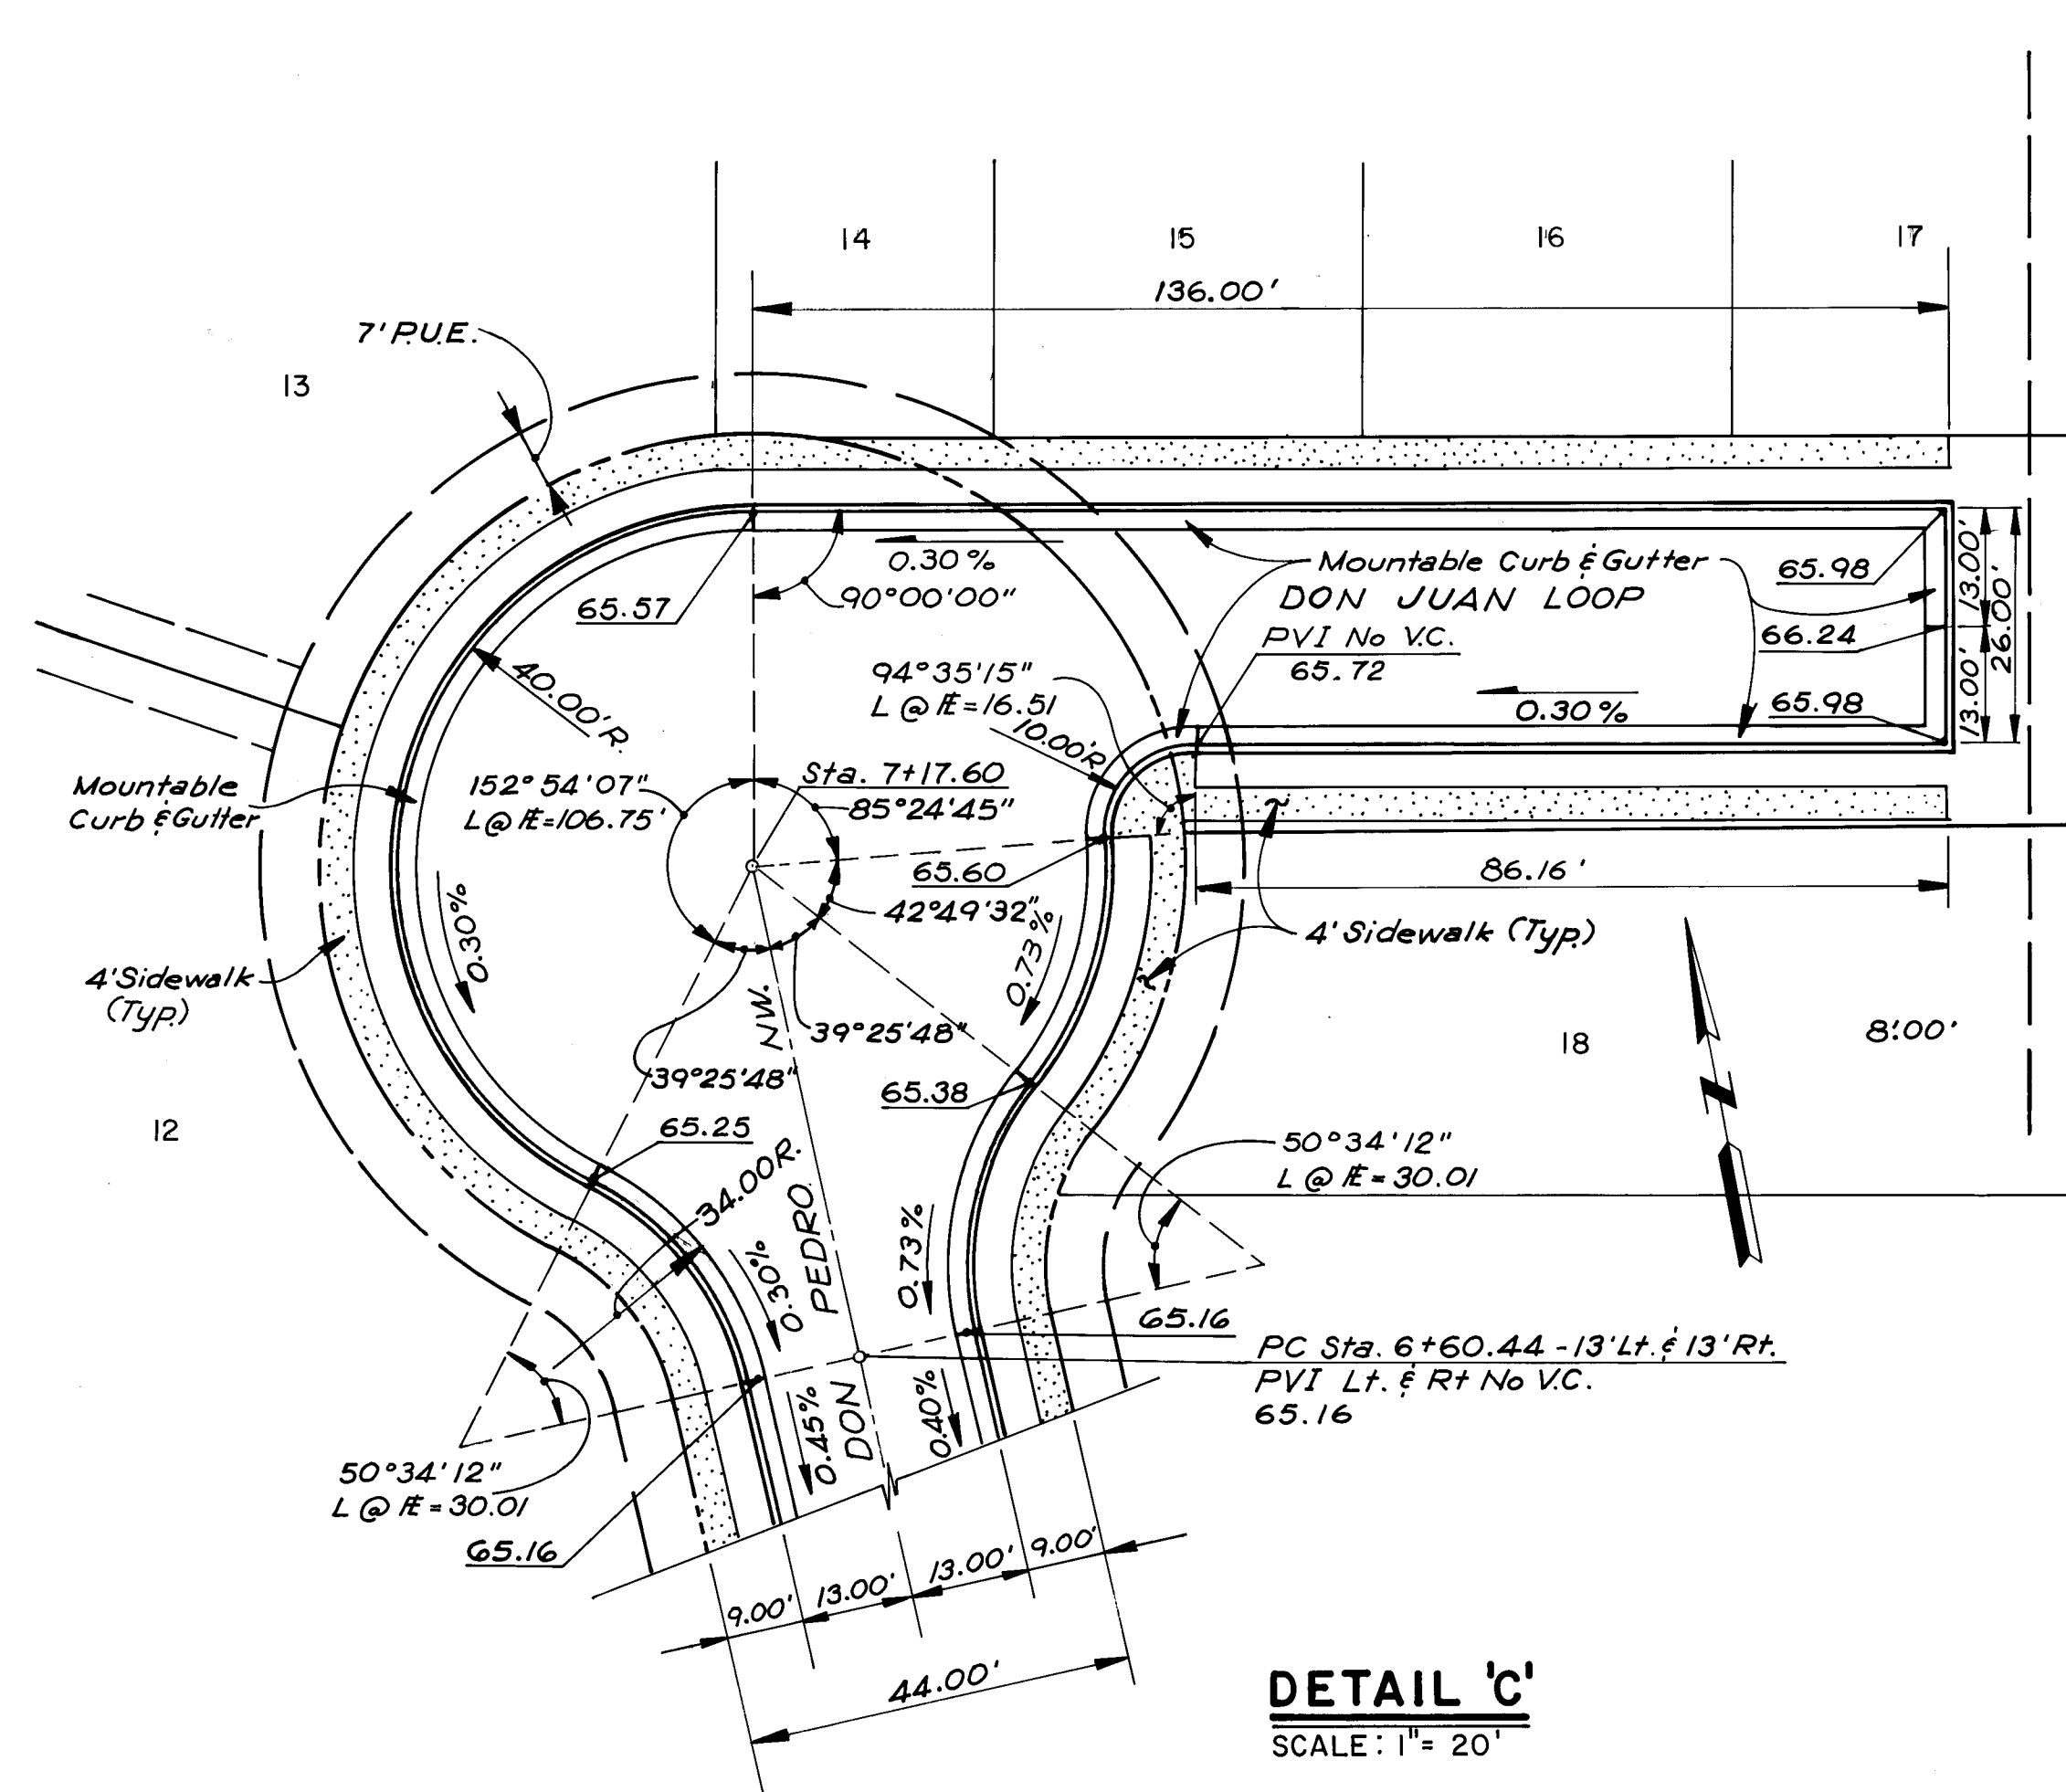


DETAIL 'C'
SCALE: 1" = 20'

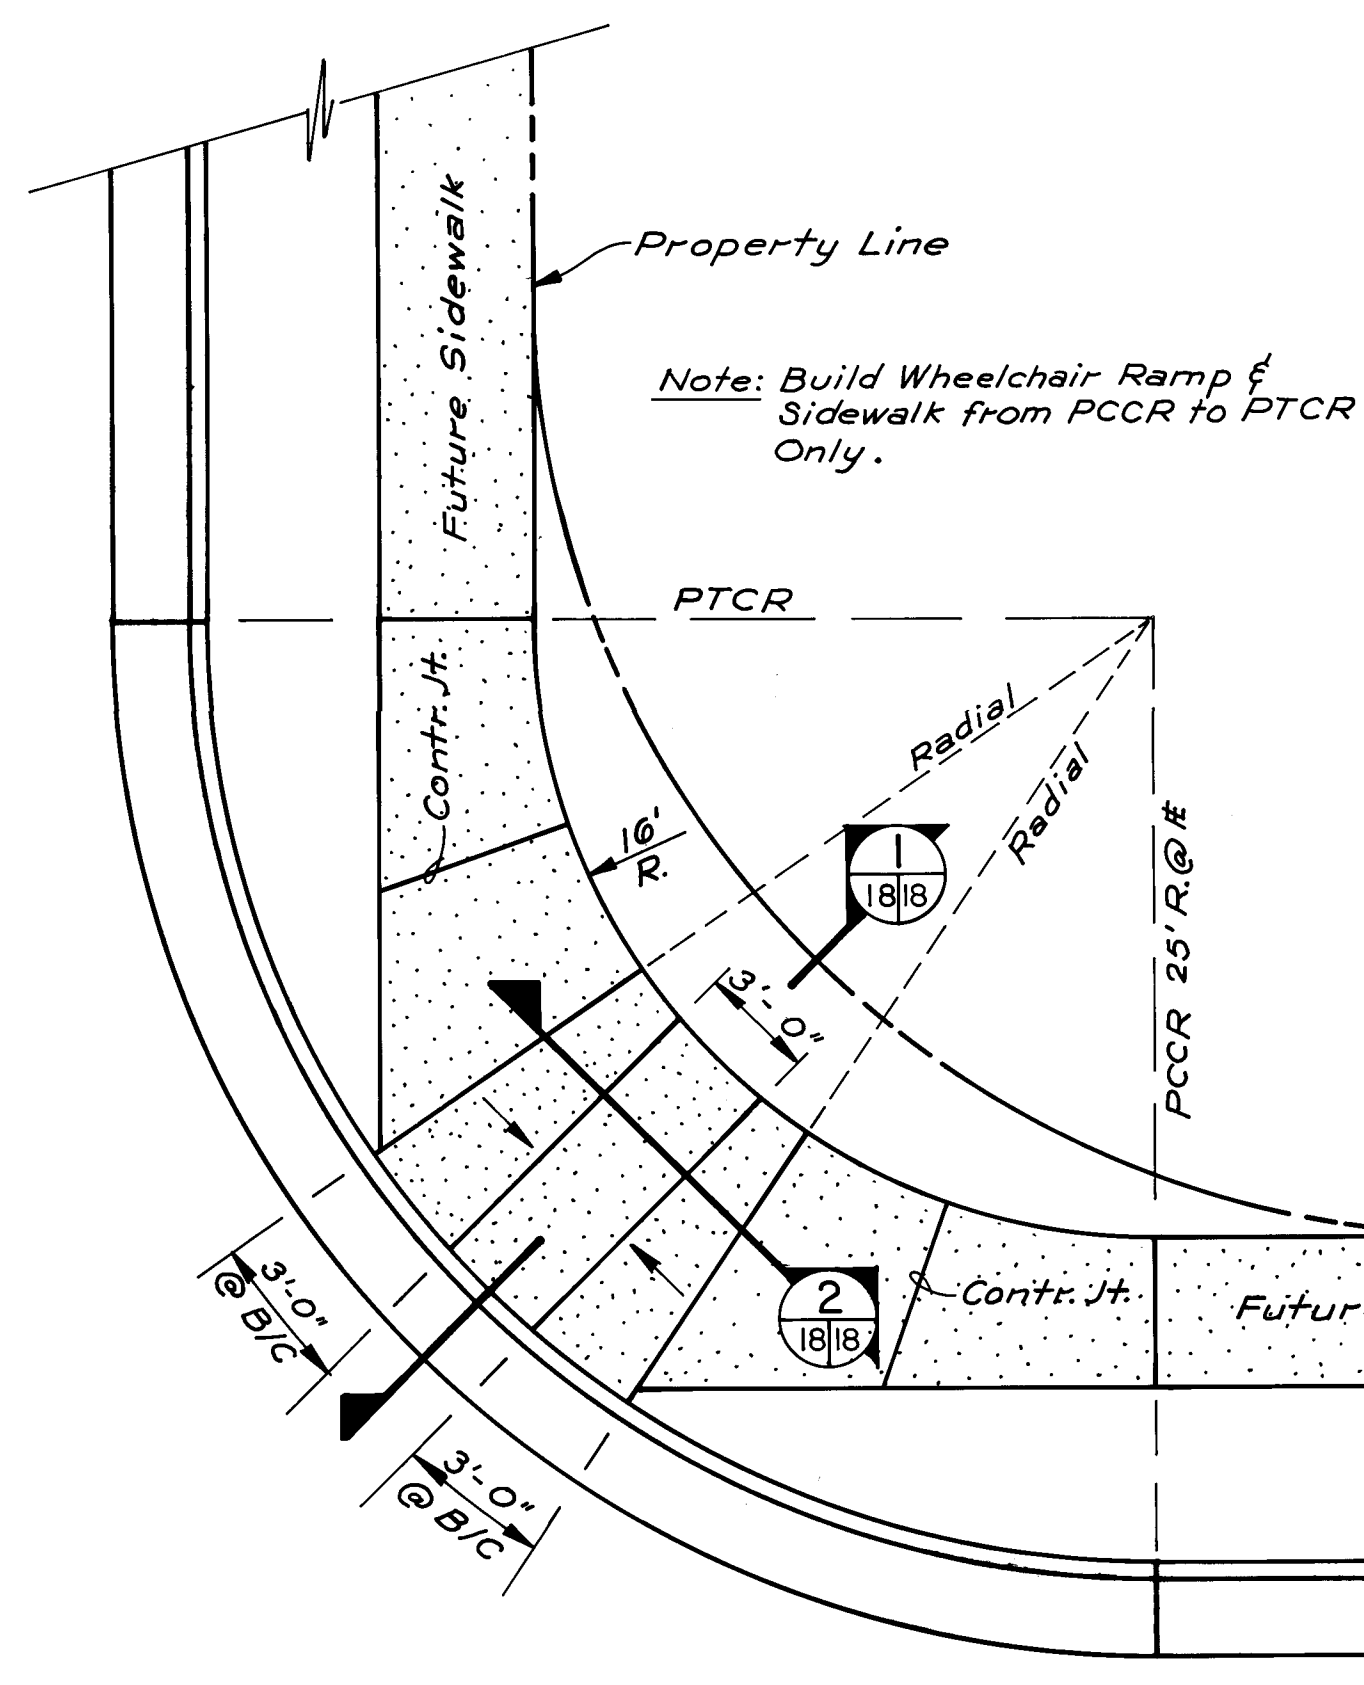


WHEELCHAIR RAMP


SCALE: 1" = 5'

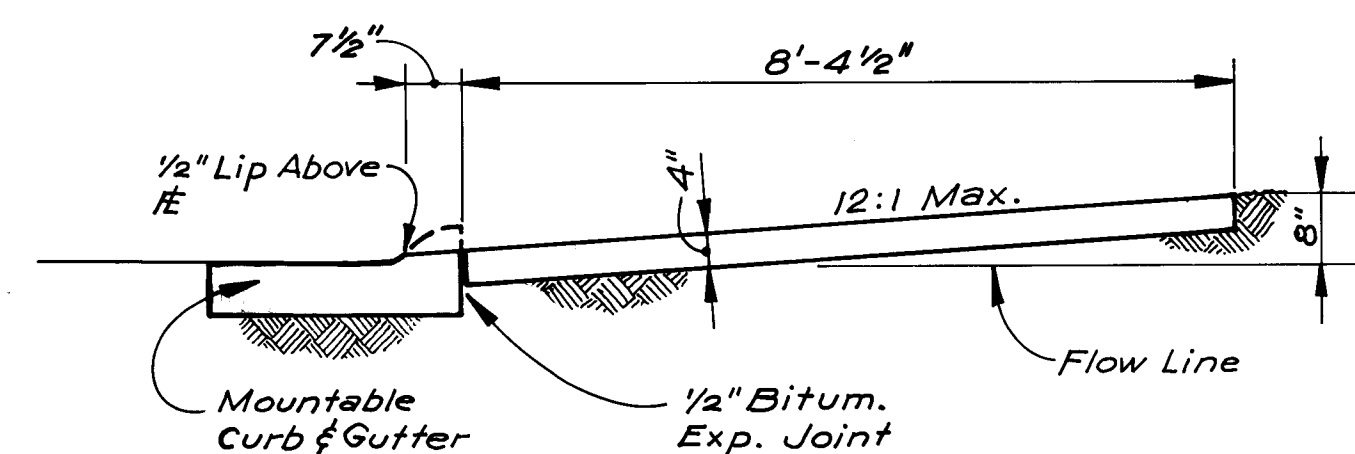

SECTION
SCALE: 1/2" = 1'-0"

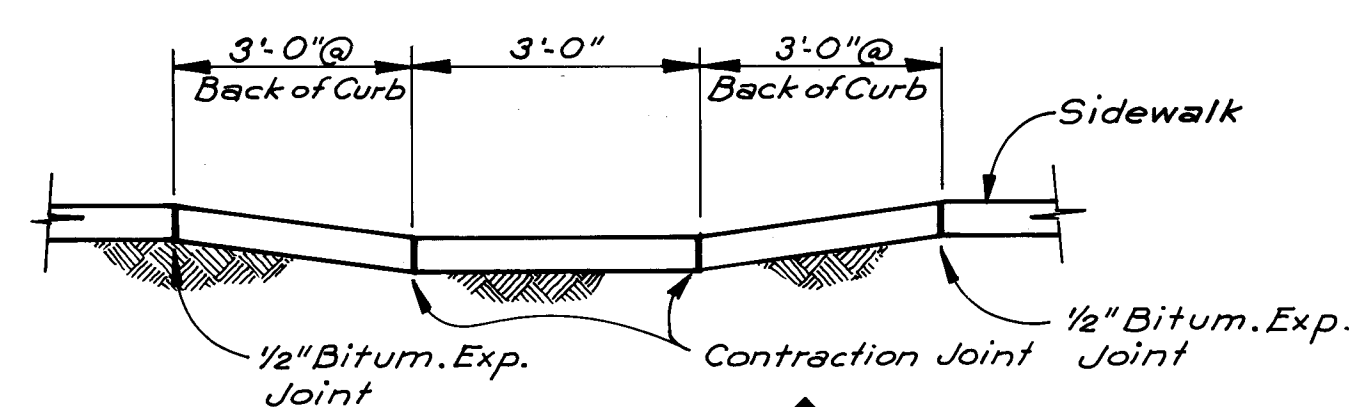

SECTION
SCALE: 1/2" = 1'-0"

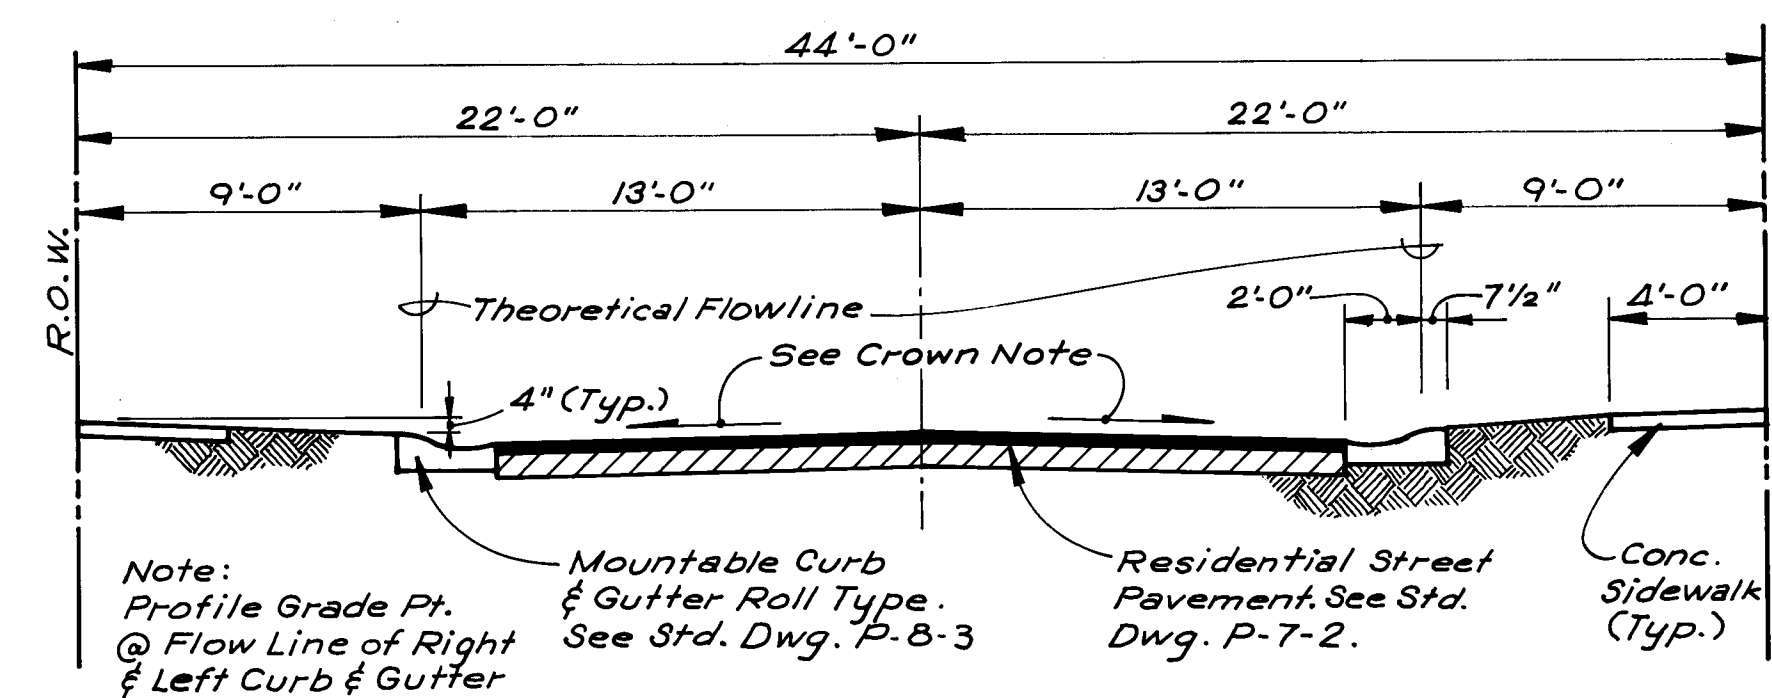

TYPICAL STREET SECTION
SCALE: 1" = 20'

Crown Note:
Crown @ centerline shall
be 0.26 feet above a straight
line between lips of gutters

2618091885

RECORD DRAWING

CITY OF ALBUQUERQUE MUNICIPAL DEVELOPMENT DEPARTMENT ENGINEERING DIVISION					
THOMAS VILLAGE PATIO HOMES-SITE IMPROVEMENTS TYPICAL STREET SECTION 8 MISCELLANEOUS DETAILS					
APPROVALS	ENGINEER	DATE	APPROVALS	ENGINEER	DATE
City Engineer	<i>E.H. [Signature]</i>	<i>1/2/83</i>	Liquid Waste	<i>NA</i>	
A.C.E.-Design	<i>[Signature]</i>	<i>10/27/83</i>	Traffic	<i>T.W. [Signature]</i>	<i>10/14/83</i>
A.C.E.-Hydrology	<i>[Signature]</i>	<i>11/15/83</i>	Water	<i>NA</i>	
DRAWING NO.	1809		MAP NO.	SHEET 18 OF 20	
			G-12-Z		