
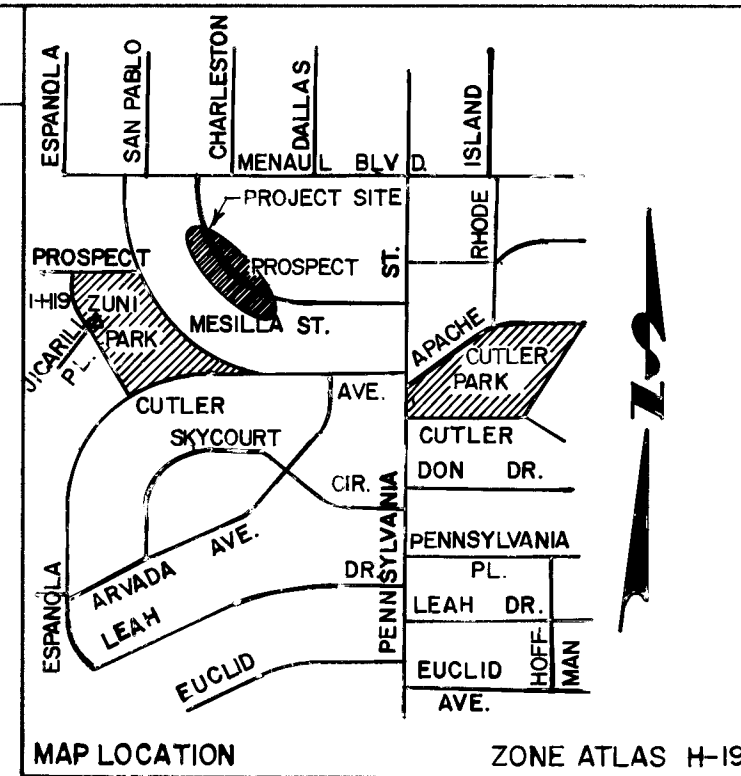
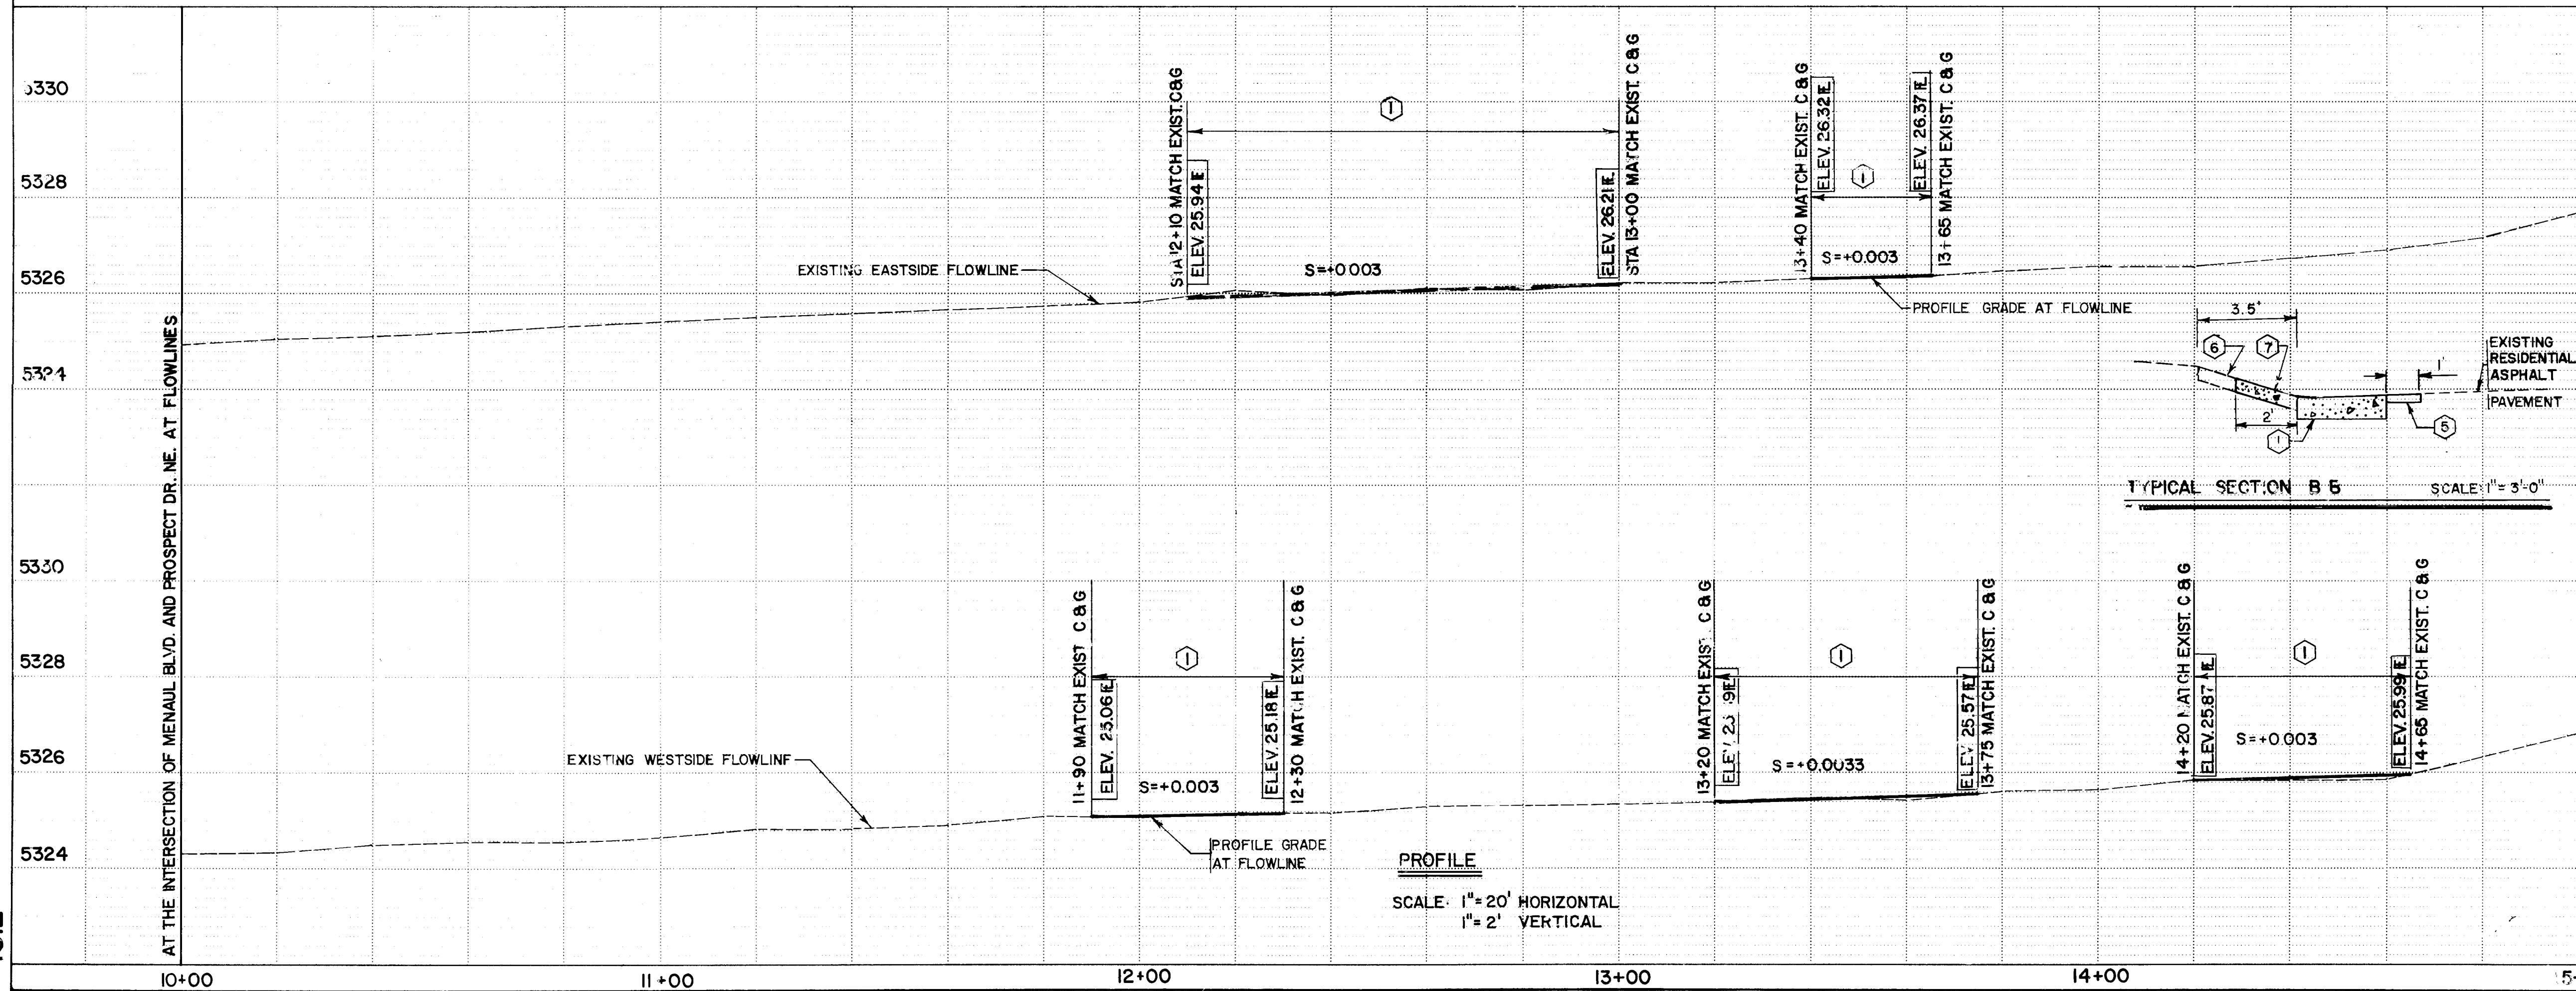


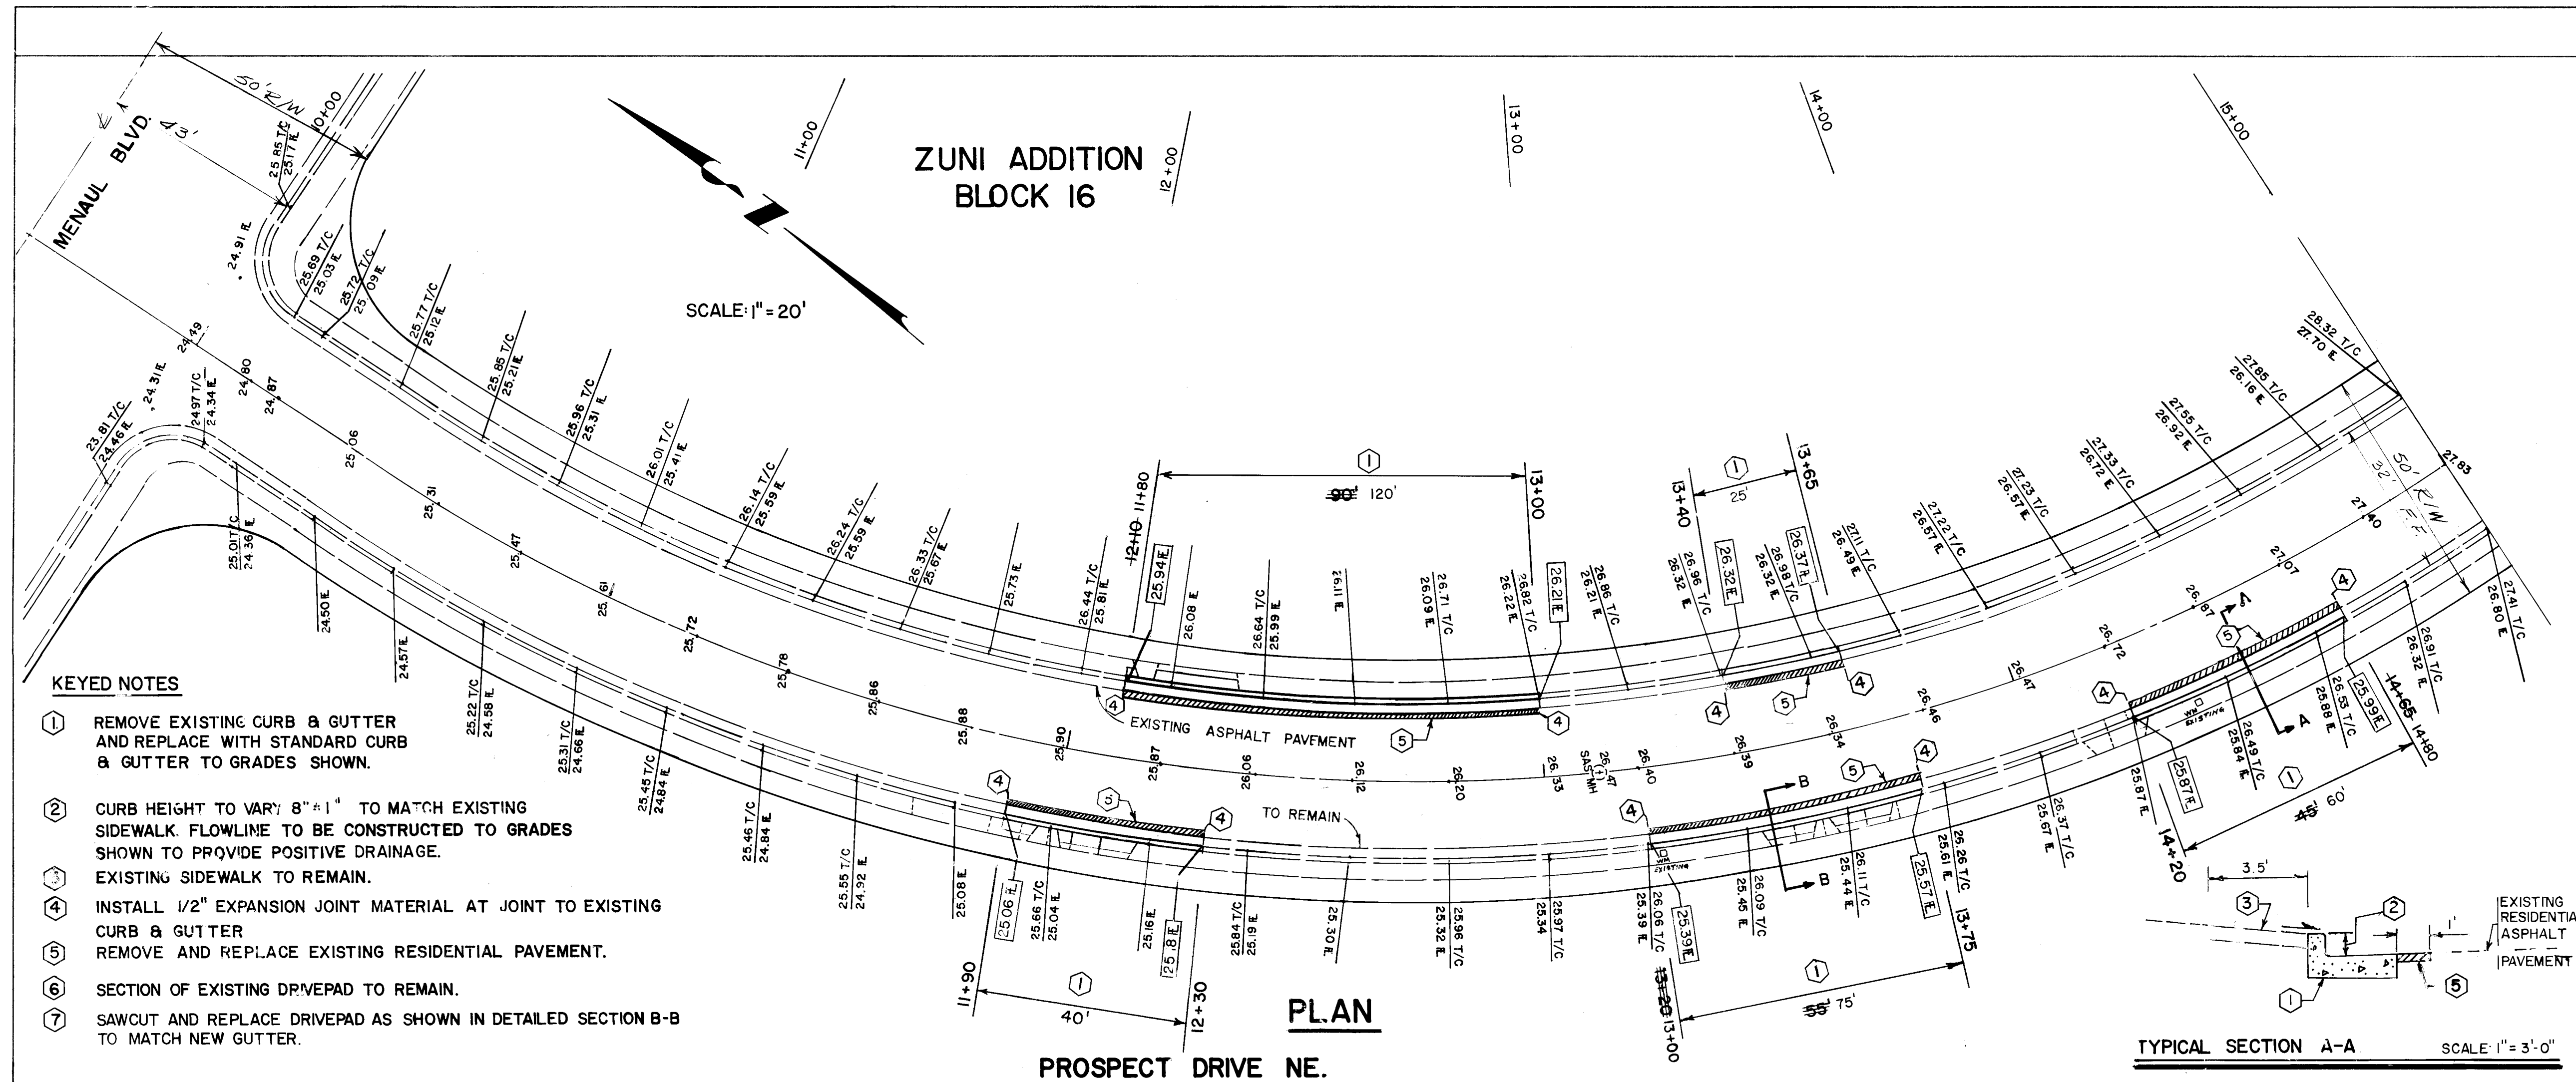

NOTICE TO CONTRACTORS

- All work detailed on these plans to be performed under contract shall, except as otherwise stated or provided for herein, be constructed in accordance with the New Mexico Standard Specifications for Public Works Construction-1978 Edition (referred to herein as the Standard Specifications) and the Contract Documents for City-Wide Utilities and Cash Paving No. 31.
- Two (2) working days prior to any excavation, the contractor must contact Line Locating Service, 765-1234, for location of existing utilities.
- Prior to construction, the contractor shall excavate and verify the horizontal and vertical locations of all obstructions. Should a conflict exist, the contractor shall notify the engineer or surveyor so that the conflict can be resolved with minimum amount of delay.

THE FOLLOWING NOTES ALSO APPLY WHEN CHECKED

- ☐ All utilities and utility service lines shall be installed prior to paving.
- ☒ Backfill compaction shall be according to specified street use. Residential
- ☒ Tack coat requirements shall be determined by the City Engineer.
- ☐ Sidewalks and wheelchair ramps within the curb returns shall be constructed wherever a new curb return is constructed.
- ☐ If curb is depressed for a driveway or a handicap ramp, the driveway or ramp shall be constructed prior to acceptance of the curb and gutter.
- ☐ All storm drainage facilities shall be completed prior to final acceptance.

LEGEND

25.91 T/C EXIST. TOP OF CURB ELEV.
25.87 E EXIST. FLOWLINE ELEVATION
25.57 E NEW FLOWLINE ELEVATION

--- EXIST. C & G
--- NEW C & G
--- REM. & REPL. EXIST. RES. PAVE

○ EXIST. SAS MANHOLE

26 1813 0184

APPROVAL OF AS BUILT DATA
AS BUILT DATA
1/25/84

APPROVED FOR CONSTRUCTION
CITY ENGINEER
DATE 1/25/84

CITY OF ALBUQUERQUE
MUNICIPAL DEVELOPMENT DEPARTMENT
ENGINEERING DIVISION

TITLE: DRAINAGE ON PROSPECT DR. NE. BETWEEN MENAUL BLVD. AND PENNSYLVANIA DR.

APPROVALS	ENGINEER	DATE	APPROVALS	ENGINEER	DATE
City Engineer	C. J. Thompson	1/25/84	Liquid Waste	W. J. W. J.	10-10-83
A.C.E. - Design	R. J. J. J.	1/25/83	Traffic	T. J. J. J.	11/12/83
A.C.E. - Hydrology	R. J. J. J.	1/25/83	Water	W. J. W. J.	10-10-83

DESIGNED BY: RICHARD LOVATO
DATE: JUNE, 1983
DRAWN BY: A. J. OLIVAS SR.
DATE: JUNE, 1983
CHECKED BY: RICHARD LOVATO
DATE: JUNE, 1983

DRAWING NO. 1813
MAP NO. H-19
SHEET 1 OF 1