


1851

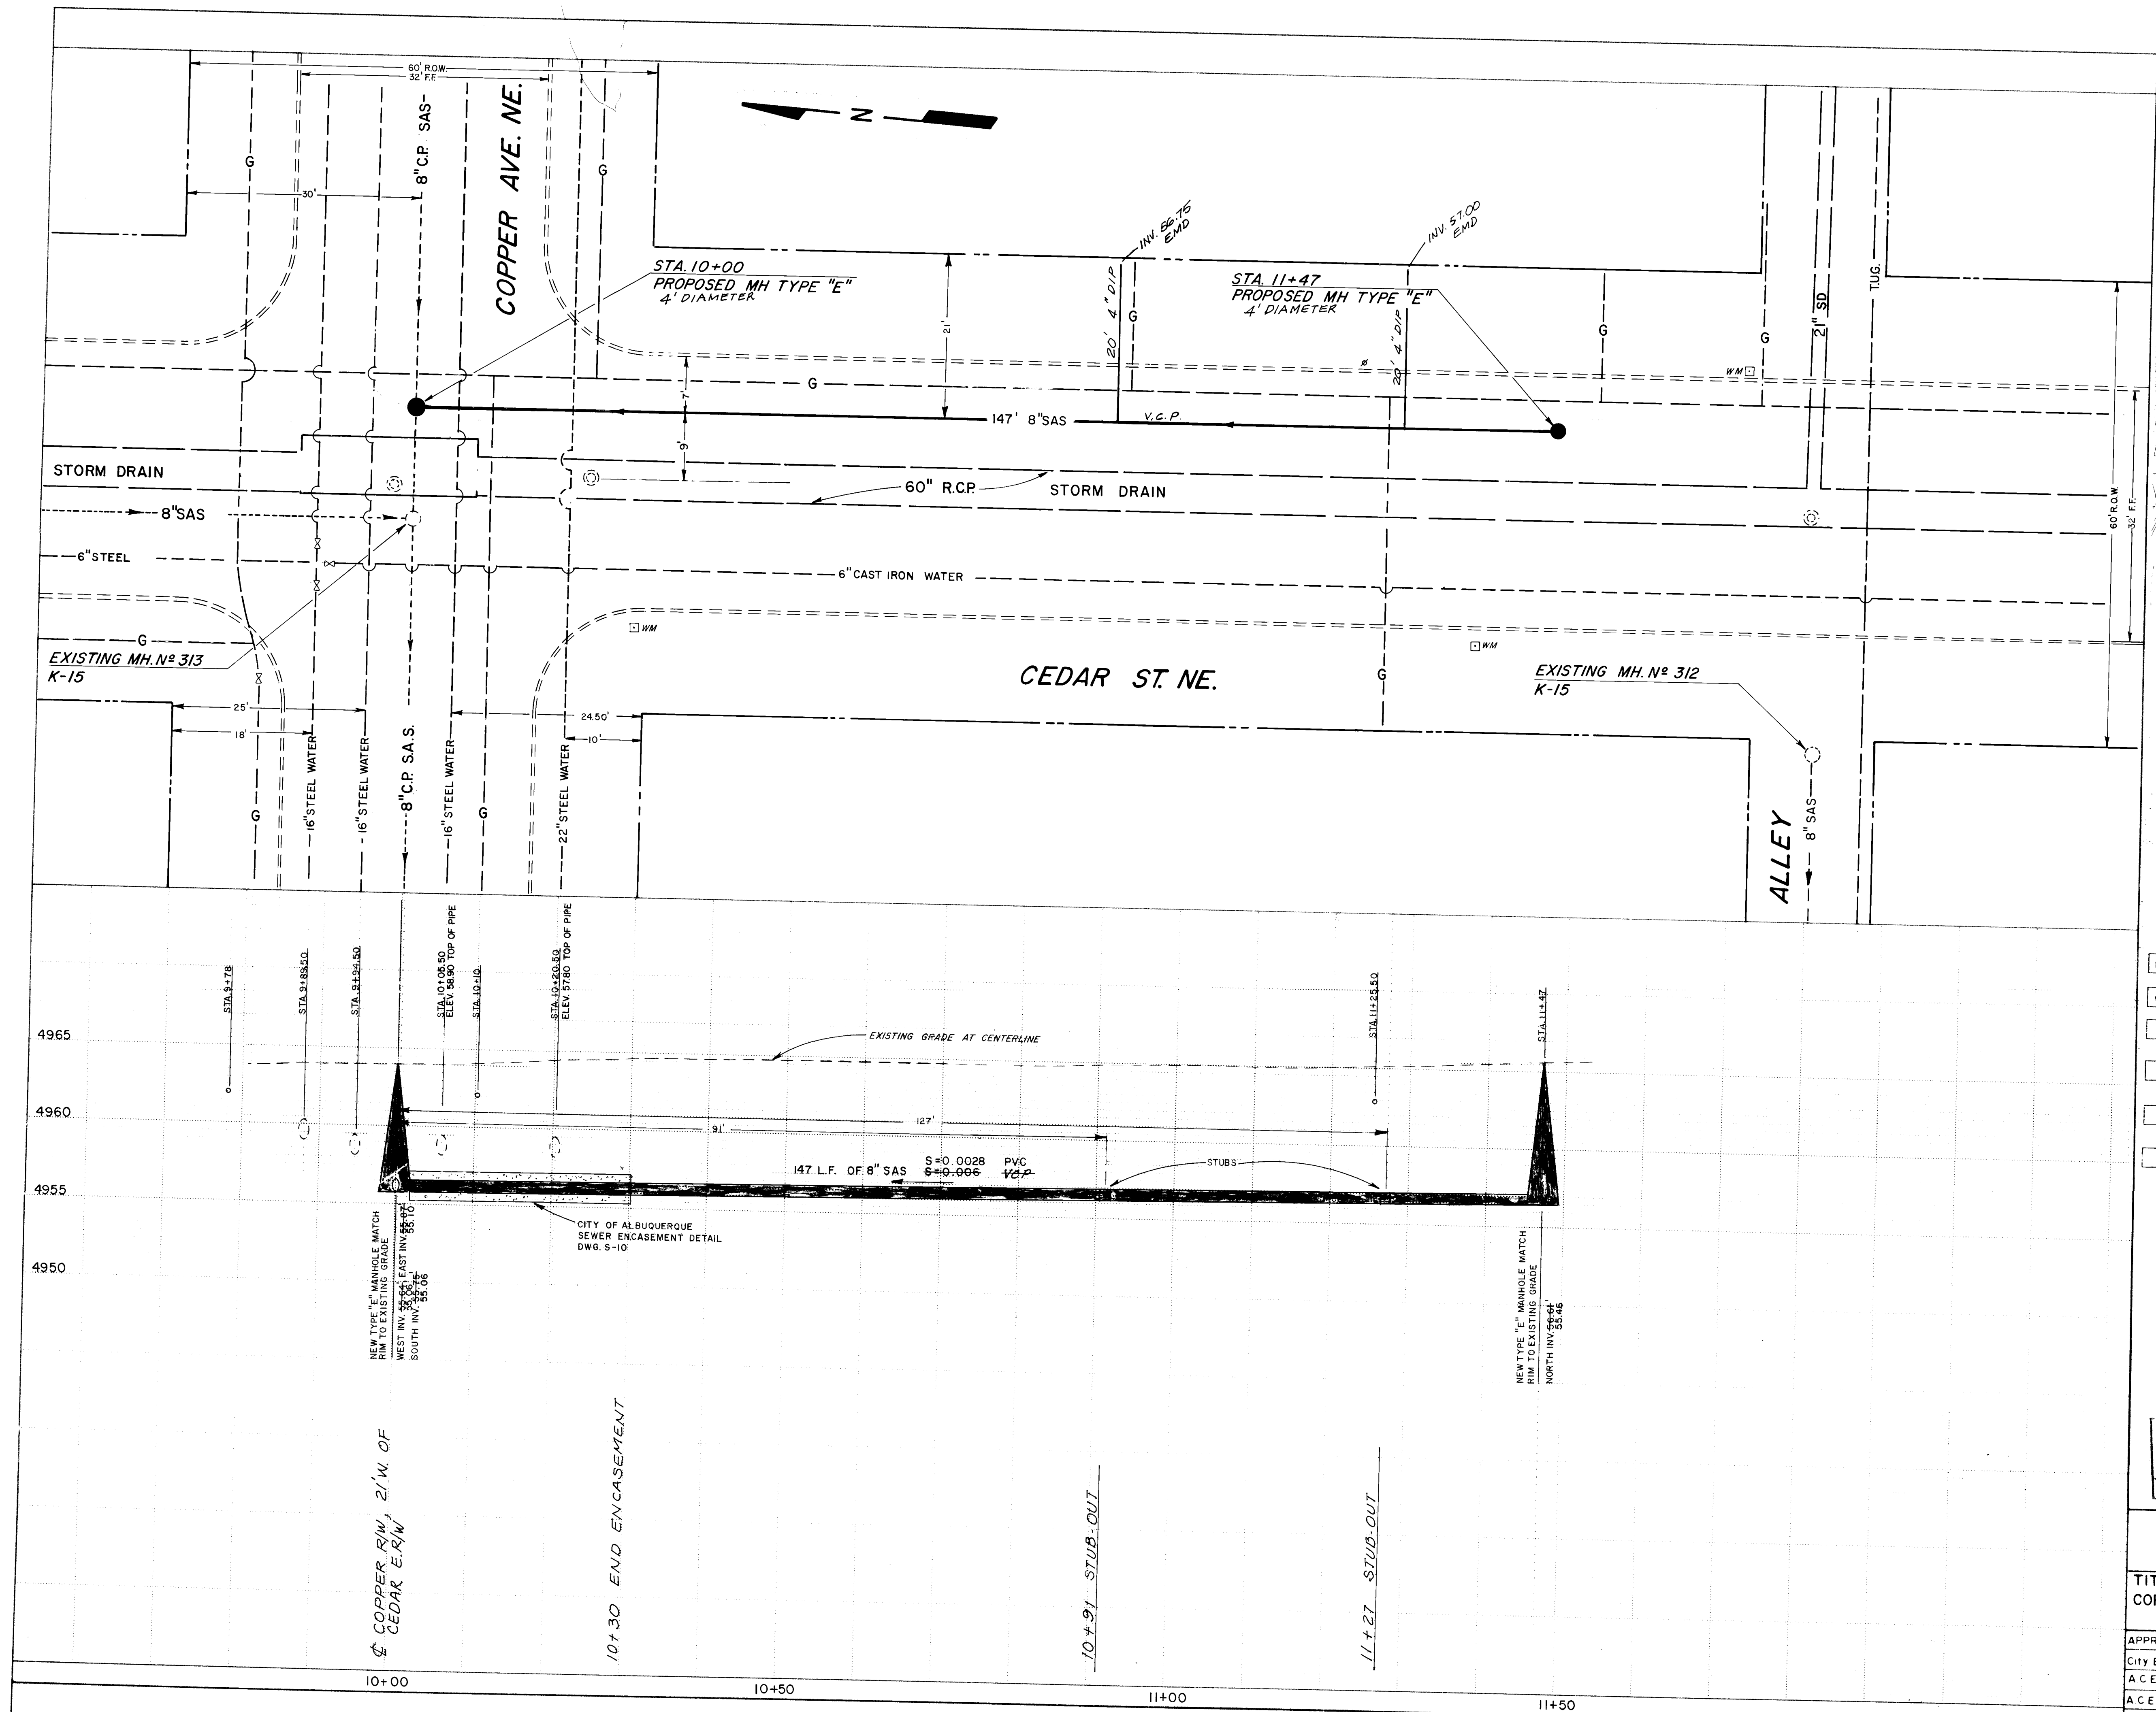

"NOTICE TO CONTRACTORS"

1) New Mexico Standard Specifications for Public Works Construction-1979 Edition will be referred to hereon as the "Standard Specification."

2) All work detailed on these plans to be performed under contract shall, except as otherwise stated or provided for herein, be constructed in accordance with "Contract Documents for City-Wide Utilities and Cash Paving No. 31" and the Standard Specification."

3) Two working days prior to any excavation, contractor must contact Line Locating Service, 765-1234, for location of existing utilities.

4) Prior to construction, the contractor shall excavate and verify the horizontal and vertical locations of all obstructions. Should a conflict exist, the contractor shall notify the engineer or surveyor so that the conflict can be resolved with minimum amount of delay.

- THE FOLLOWING NOTES APPLY WHEN CHECKED
- ☒ All utilities and utility service lines shall be installed prior to paving.
 - ☒ Backfill compaction shall be according to specified street use. *Residential*
 - ☐ Task tool requirements shall be determined by the City Engineer.
 - ☐ Sidewalks and wheelchair ramps within the curb returns shall be constructed wherever a new curb return is constructed.
 - ☐ If curb is depressed for a driveway, the driveway shall be constructed prior to acceptance of the curb and gutter.
 - ☐ All storm drainage facilities shall be completed prior to final acceptance.

APPROVAL OF AS BUILT DRAWINGS
ASST. CITY ENGINEER - FIELD
Charles R. Rode
DATE 10/19/83

APPROVED FOR CONSTRUCTION
C. J. [Signature]
CITY ENGINEER
DATE 9/6/83

CITY OF ALBUQUERQUE
WATER RESOURCES DEPARTMENT
ENGINEERING DIVISION

TITLE: 8" SANITARY SEWER LINE IN CEDAR ST. N.E. FROM COPPER AVE. N.E. SOUTH 147.00 FT.

APPROVALS	ENGINEER	DATE	APPROVALS	ENGINEER	DATE
City Engineer	<i>C. J. [Signature]</i>	9/6/83	Liquid Waste	<i>W. F. [Signature]</i>	7/26/83
ACE - Design	<i>[Signature]</i>	12/6/83	Traffic	<i>N. B. [Signature]</i>	7/26/83
ACE - Hydrology	<i>[Signature]</i>	7/26/83	Water	<i>W. F. [Signature]</i>	7/26/83
QA	<i>[Signature]</i>	9/6/83			

DRAWING NO. 1821 MAP NO. K-15 SHEET 1 OF 1

AS BUILT INFORMATION	
BRASS CAP AT CENTERLINE OF CENTRAL AVE & ARNO ST. ELEVATION 4977.88 - KNOWN AS 17-K14	
DATE	
BY	
NO	
SURVEY INFORMATION	
FIELD NOTES	
DATE	
BY	
NO	
ENGINEER'S SEAL	
BY	
REVISIONS	
DESIGN	
DESIGNED BY A.T. OSTAPACK	
DRAWN BY A.T. OSTAPACK	
CHECKED BY M. TENORIO	
DATE JUNE 83	
DATE JUNE 83	
DATE JULY 83	

1851