

KEYED NOTES

1. EXTEND CURB & GUTTER AND SIDEWALK NORTH.
2. MATCH EXISTING PAVEMENT.
3. INSTALL 25' OF STANDARD GUARDRAIL WITH STANDARD TERMINAL SECTIONS. LOCATE GUARDRAIL 2' BACK OF SIDEWALK.
4. CONSTRUCT 14' WIDE ASPHALT SURFACE COURSE PAVEMENT TO LIMITS SHOWN. LINE AND GRADE TO BE ESTABLISHED BY CITY OF ALBUQUERQUE SURVEY CREW. PAVEMENT TO BE IN TRAVELED WAY AND STAY BETWEEN EXISTING FENCES AT ALL LOCATIONS.
5. INSTALL 25' OF STANDARD GUARDRAIL WITH STANDARD TERMINAL SECTION TO BE LOCATED IN FIELD TO PREVENT VEHICULAR TRAFFIC BETWEEN SAWMILL ROAD AND 11TH STREET.
6. EXISTING SANITARY SEWER TO REMAIN IN PLACE.
7. REGRADE EXISTING MANHOLES AS REQUIRED.
8. REGRADE EXISTING VALVE BOX.
9. REMOVE AND REPLACE EXISTING WATER SERVICE TO RESIDENCES ON KINLEY AVENUE. WATER SERVICES TO BE FIELD LOCATED AND NOTED ON AS-BUILTS.
10. INSTALL NEW FIRE HYDRANT WITHIN EXISTING R/W 2' BACK OF NEW PAVEMENT LIMITS.
11. REMOVE AND REPLACE EXISTING SANITARY SEWER SERVICE TO RESIDENCE ON KINLEY AVE. WITHIN LIMITS OF SANITARY SEWER SERVICES CONSTRUCTION. SANITARY SEWER SERVICES TO BE FIELD LOCATED AND NOTED ON AS-BUILTS.

KINLEY AVENUE J-13, J-14


14' CROWN SECTION. TEMPORARY 2" ASPHALT CONCRETE SURFACE COURSE

PLAN

SCALE: 1"=40'

LEGEND

- NEW PAVEMENT
- PAVEMENT LIMITS
- NEW GUARDRAIL
- NEW CURB & GUTTER & SIDEWALK
- NEW 6" WATERLINE
- NEW 8" SAS LINE

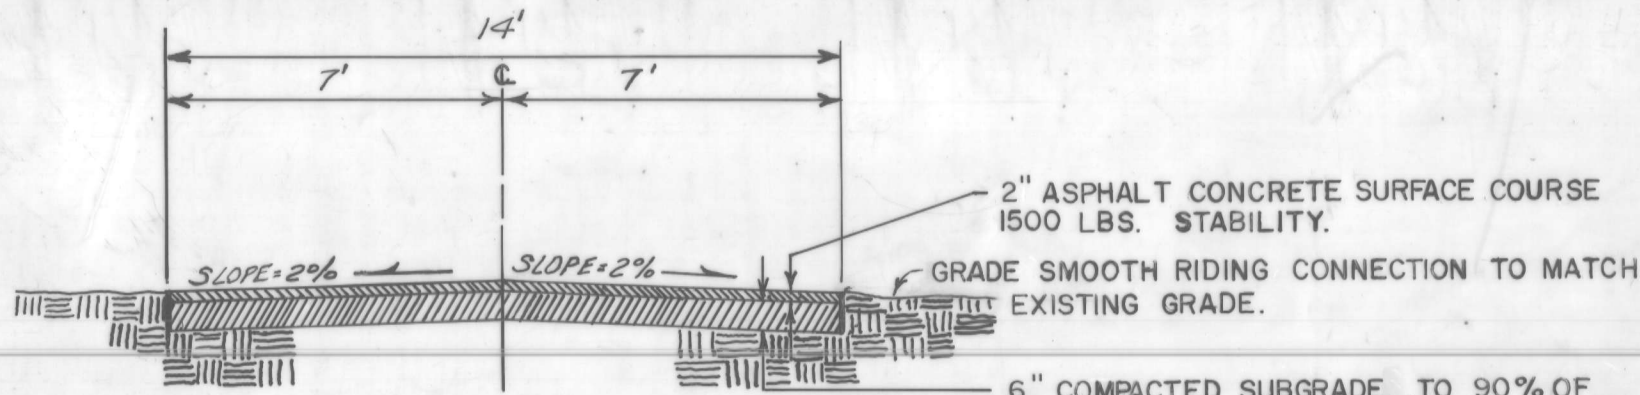

PAVING SECTION

SCALE: NONE

NOTICE TO CONTRACTORS

1. All work detailed on these plans to be performed under contract shall, except as otherwise stated or provided for hereon, be constructed in accordance with the New Mexico Standard Specifications for Public Works Construction-1979 Edition (referred to herein as the Standard Specifications) and the Contract Documents for City-Wide Utilities and Cosh Paving No. 31.
2. Two (2) working days prior to any excavation, the contractor must contact Life Locating Service, 765-1234, for location of existing utilities.
3. Prior to construction, the contractor shall excavate and verify the horizontal and vertical locations of all obstructions. Should a conflict exist, the contractor shall notify the engineer or surveyor so that the conflict can be resolved with minimum amount of delay.

THE FOLLOWING NOTES ALSO APPLY WHEN CHECKED

- ☒ All utilities and utility service lines shall be installed prior to paving.
- ☒ Backfill compaction shall be according to specified street use. TEMPORARY PAVEMENT
- ☐ Tack coat requirements shall be determined by the City Engineer.
- ☐ Sidewalks and wheelchair ramps within the curb returns shall be constructed wherever a new curb return is constructed.
- ☐ If curb is depressed for a driveway or a handicap ramp, the driveway or ramp shall be constructed prior to acceptance of the curb and gutter.
- ☐ All storm drainage facilities shall be completed prior to final acceptance.

CITY OF ALBUQUERQUE  
MUNICIPAL DEVELOPMENT DEPARTMENT  
ENGINEERING DIVISION

TITLE: PAVING ON KINLEY AVE. EAST OF SAWMILL AND WATERLINE REPLACEMENT.

APPROVALS	ENGINEER	DATE	APPROVALS	DATE
City Engineer	<i>C. W. [Signature]</i>	10/2/03	Liquid Waste	10/2/03
A.C.E. Design	<i>R. [Signature]</i>	24 Aug 03	Traffic	24 Aug 03
A.C.E. Hydrology	<i>[Signature]</i>	9/15/03	Water	9/15/03

DRAWING NO. 1822

MAP NO. J-13&14

APPROVAL OF AS BUILT DRAWINGS  
ASST. CITY ENGINEER - FIELD  
*[Signature]*  
DATE 5-1-04

26 1822 0184

APPROVED FOR CONSTRUCTION  
*C. W. [Signature]* 10/2/03  
CITY ENGINEER  
DATE 10/2/03