

PINO ARROYO IMPROVEMENTS


JEFFERSON STREET TO INTERSTATE 25

INDEX

SHEET NO.	DESCRIPTION
1	TITLE SHEET
2	STA. 99+75.00 TO STA. 104+14.22 PINO ARROYO - PLAN AND PROFILE STA. 0+00.00 TO STA. 2+57.92 BETA ARROYO - PLAN AND PROFILE
3	STA. 104+14.22 TO STA. 115+30.47 PINO ARROYO - PLAN AND PROFILE
4	CONFLUENCE DETAIL - PINO AND BETA ARROYOS
5	TYPICAL CHANNEL SECTIONS
6	EXPANSION JOINT DETAILS
7-8	MISCELLANEOUS CONSTRUCTION DETAILS
9	MAINTENANCE VEHICLE RAMP DETAILS
10-11	BOX CULVERT EXTENSION DETAILS
12	TYPICAL RETAINING WALL DETAILS
13	SURVEY RIGHT-OF-WAY MAP
14-15	CROSS SECTIONS FOR PINO ARROYO
16	CROSS SECTIONS FOR BETA ARROYO

LEGEND

	New Fence
	Existing Fence
	Overhead Power Lines
	Utility Pole
	Side Slopes
	Easement Lines
	Right-Of-Way
	Existing Water Line

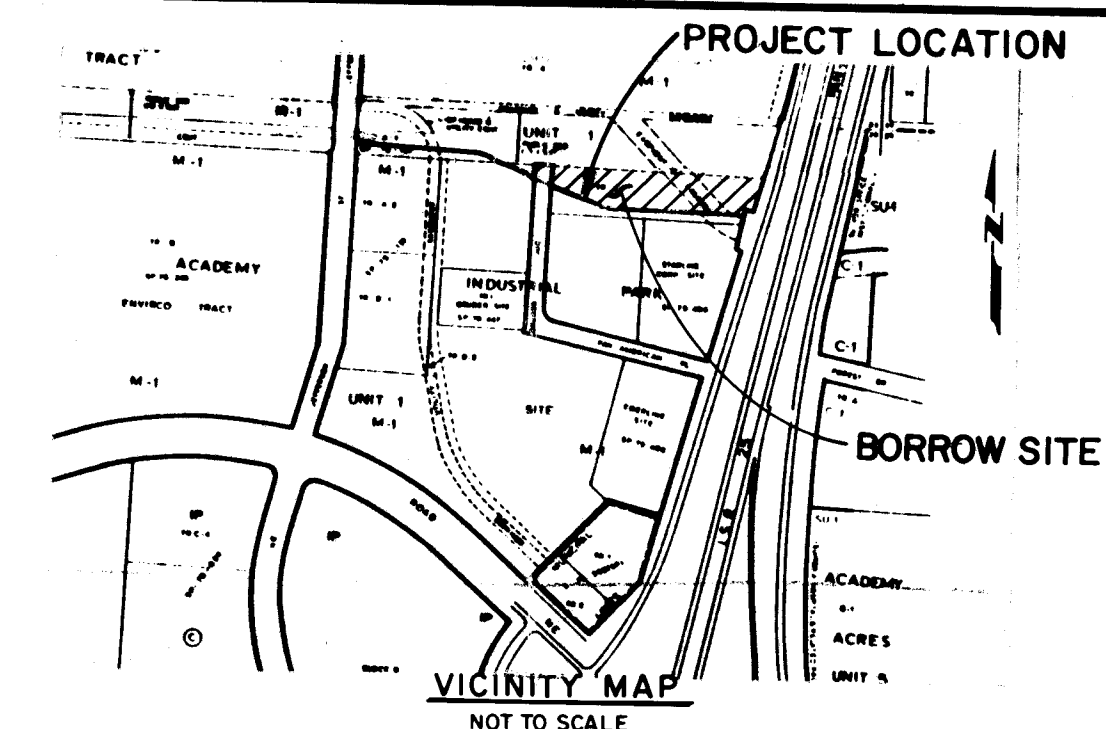


GENERAL NOTES

NOTICE TO CONTRACTORS

- NEW MEXICO STANDARD SPECIFICATIONS FOR PUBLIC WORKS CONSTRUCTION-1979 EDITION WILL BE REFERRED TO HEREON AS THE "STANDARD SPECIFICATION."
- NO CONSTRUCTION WILL BE ALLOWED IN THE PINO ARROYO DURING THE MONTHS OF JULY, AUGUST, OR SEPTEMBER UNLESS THE CONTRACTOR PROVIDES AND OBTAINS APPROVAL OF AN EROSION CONTROL PLAN AND A PLAN FOR THE SAFE PASSAGE OF THE 10 YEAR DESIGN STORM RUNOFF.
- TWO WORKING DAYS PRIOR TO ANY EXCAVATION, CONTRACTOR MUST CONTACT LINE LOCATING SERVICE, 765-1234, FOR LOCATION OF EXISTING UTILITIES.
- PRIOR TO CONSTRUCTION, THE CONTRACTOR SHALL EXCAVATE AND VERIFY THE HORIZONTAL AND VERTICAL LOCATIONS OF ALL OBSTRUCTIONS. SHOULD A CONFLICT EXIST, THE CONTRACTOR SHALL NOTIFY THE ENGINEER OR SURVEYOR SO THAT THE CONFLICT CAN BE RESOLVED WITH A MINIMUM AMOUNT OF DELAY.
- THE CONTRACTOR SHALL COORDINATE THE EARTHWORK SCHEDULING WITH THE ENGINEER IN ORDER TO FACILITATE THE RELOCATION OF PNM. POWER POLES.
- THE BORROW SITE FOR EXCAVATION SHALL BE AS SHOWN IN THE VICINITY MAP.

THE FOLLOWING NOTES ALSO APPLY WHEN CHECKED

- ☐ ALL UTILITIES AND UTILITY SERVICE LINES SHALL BE INSTALLED PRIOR TO PAVING.
- ☐ BACKFILL COMPACTION SHALL BE ACCORDING TO SPECIFIED STREET USE.
- ☐ TACK COAT REQUIREMENTS SHALL BE DETERMINED BY THE CITY ENGINEER.
- ☐ SIDEWALKS AND WHEELCHAIR RAMPS WITHIN THE CURB RETURNS SHALL BE CONSTRUCTED WHEREVER A NEW CURB RETURN IS CONSTRUCTED.
- ☐ IF CURB IS DEPRESSED FOR A DRIVEPAD, THE DRIVEPAD SHALL BE CONSTRUCTED PRIOR TO ACCEPTANCE OF CURB AND GUTTER.
- ☒ ALL STORM DRAINAGE FACILITIES SHALL BE COMPLETED PRIOR TO FINAL ACCEPTANCE.
- ☐ THE REQUESTOR OR DEVELOPER SHALL BE RESPONSIBLE FOR REPAIR OR REPLACEMENT OF ALL CURB AND GUTTER OR SIDEWALK DAMAGED AFTER APPROVAL BY THE CITY ENGINEER OF WORK COMPLETED BY THE CONTRACTOR.

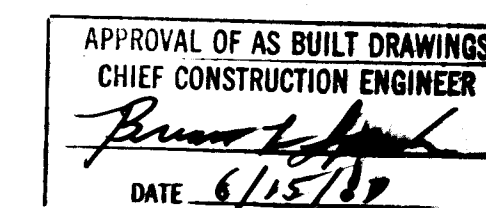

1 2 3 4 5 6 7 8 9 10 11 12
26 18 53 01 87

REV	SHEETS	CITY ENGINEER	DATE	USER	DEPT.	DATE	USER	DEPT.	DATE


APPROVAL OF REVISIONS



RECORD DRAWINGS
DATE 2-26-86

 BOHANNON - HUSTON INC. ALBUQUERQUE - SANTA FE - EL PASO ENGINEERS PLANNERS PHOTOGRAMMETRISTS	APPROVED FOR CONSTRUCTION C.E.
	PROJECT NUMBER 1853
SHEET 1 OF 16	


PROFILE NO. _____ NOTE BOOK _____ B. M. : NOTED _____ GRADES CHECKED _____ PLOTTED _____ SURVEYED _____	BY	DATE

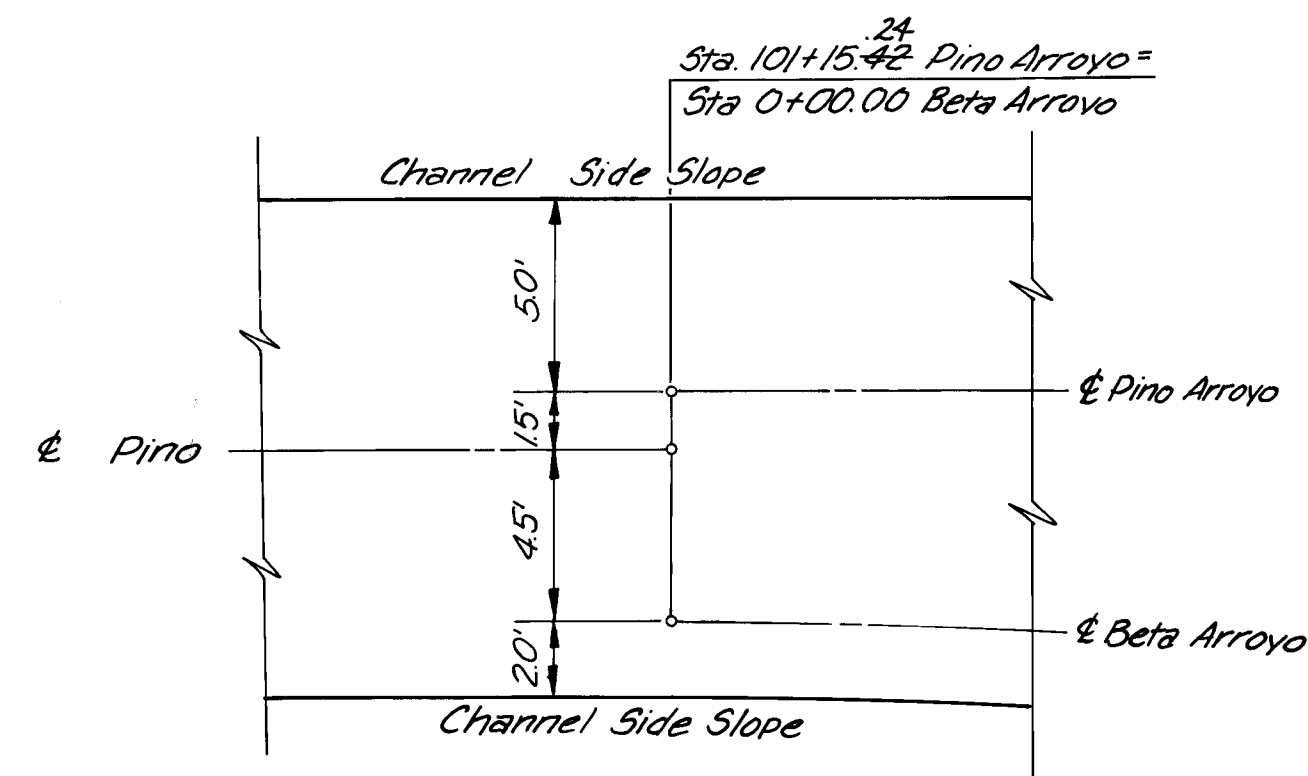

*E Curve Data
Beta Arroyo*

<i>PI Sta. 0+54.56</i>	<i>PI Sta. 2+12.18</i>
<i>R=199.91'</i>	<i>R= 98.93'</i>
<i>T=54.56'</i>	<i>T= 55.65'</i>
<i>Δ=30°31'53"</i>	<i>Δ=58°43'00"</i>
<i>D=28°39'39"</i>	<i>D=57°54'56"</i>
<i>L=106.53'</i>	<i>L=101.39'</i>

- NOTES:**
1. For Retaining Wall Schedule, See Sheet 8.
 2. For Rectangular to Trapezoidal Transition, See Sheet 4.
 3. For Pino-Beta Confluence Details, See Sheet 4.
 4. For Temporary End Plug Details, See Sheet 4.
 5. For All Right-of-Way Survey Information, See Sheet 13.
 6. For Typical Trapezoidal Channel Cross-Section, See Sheet 5.
 7. For 30" RCP Connection to CBC, See Sheet 9.

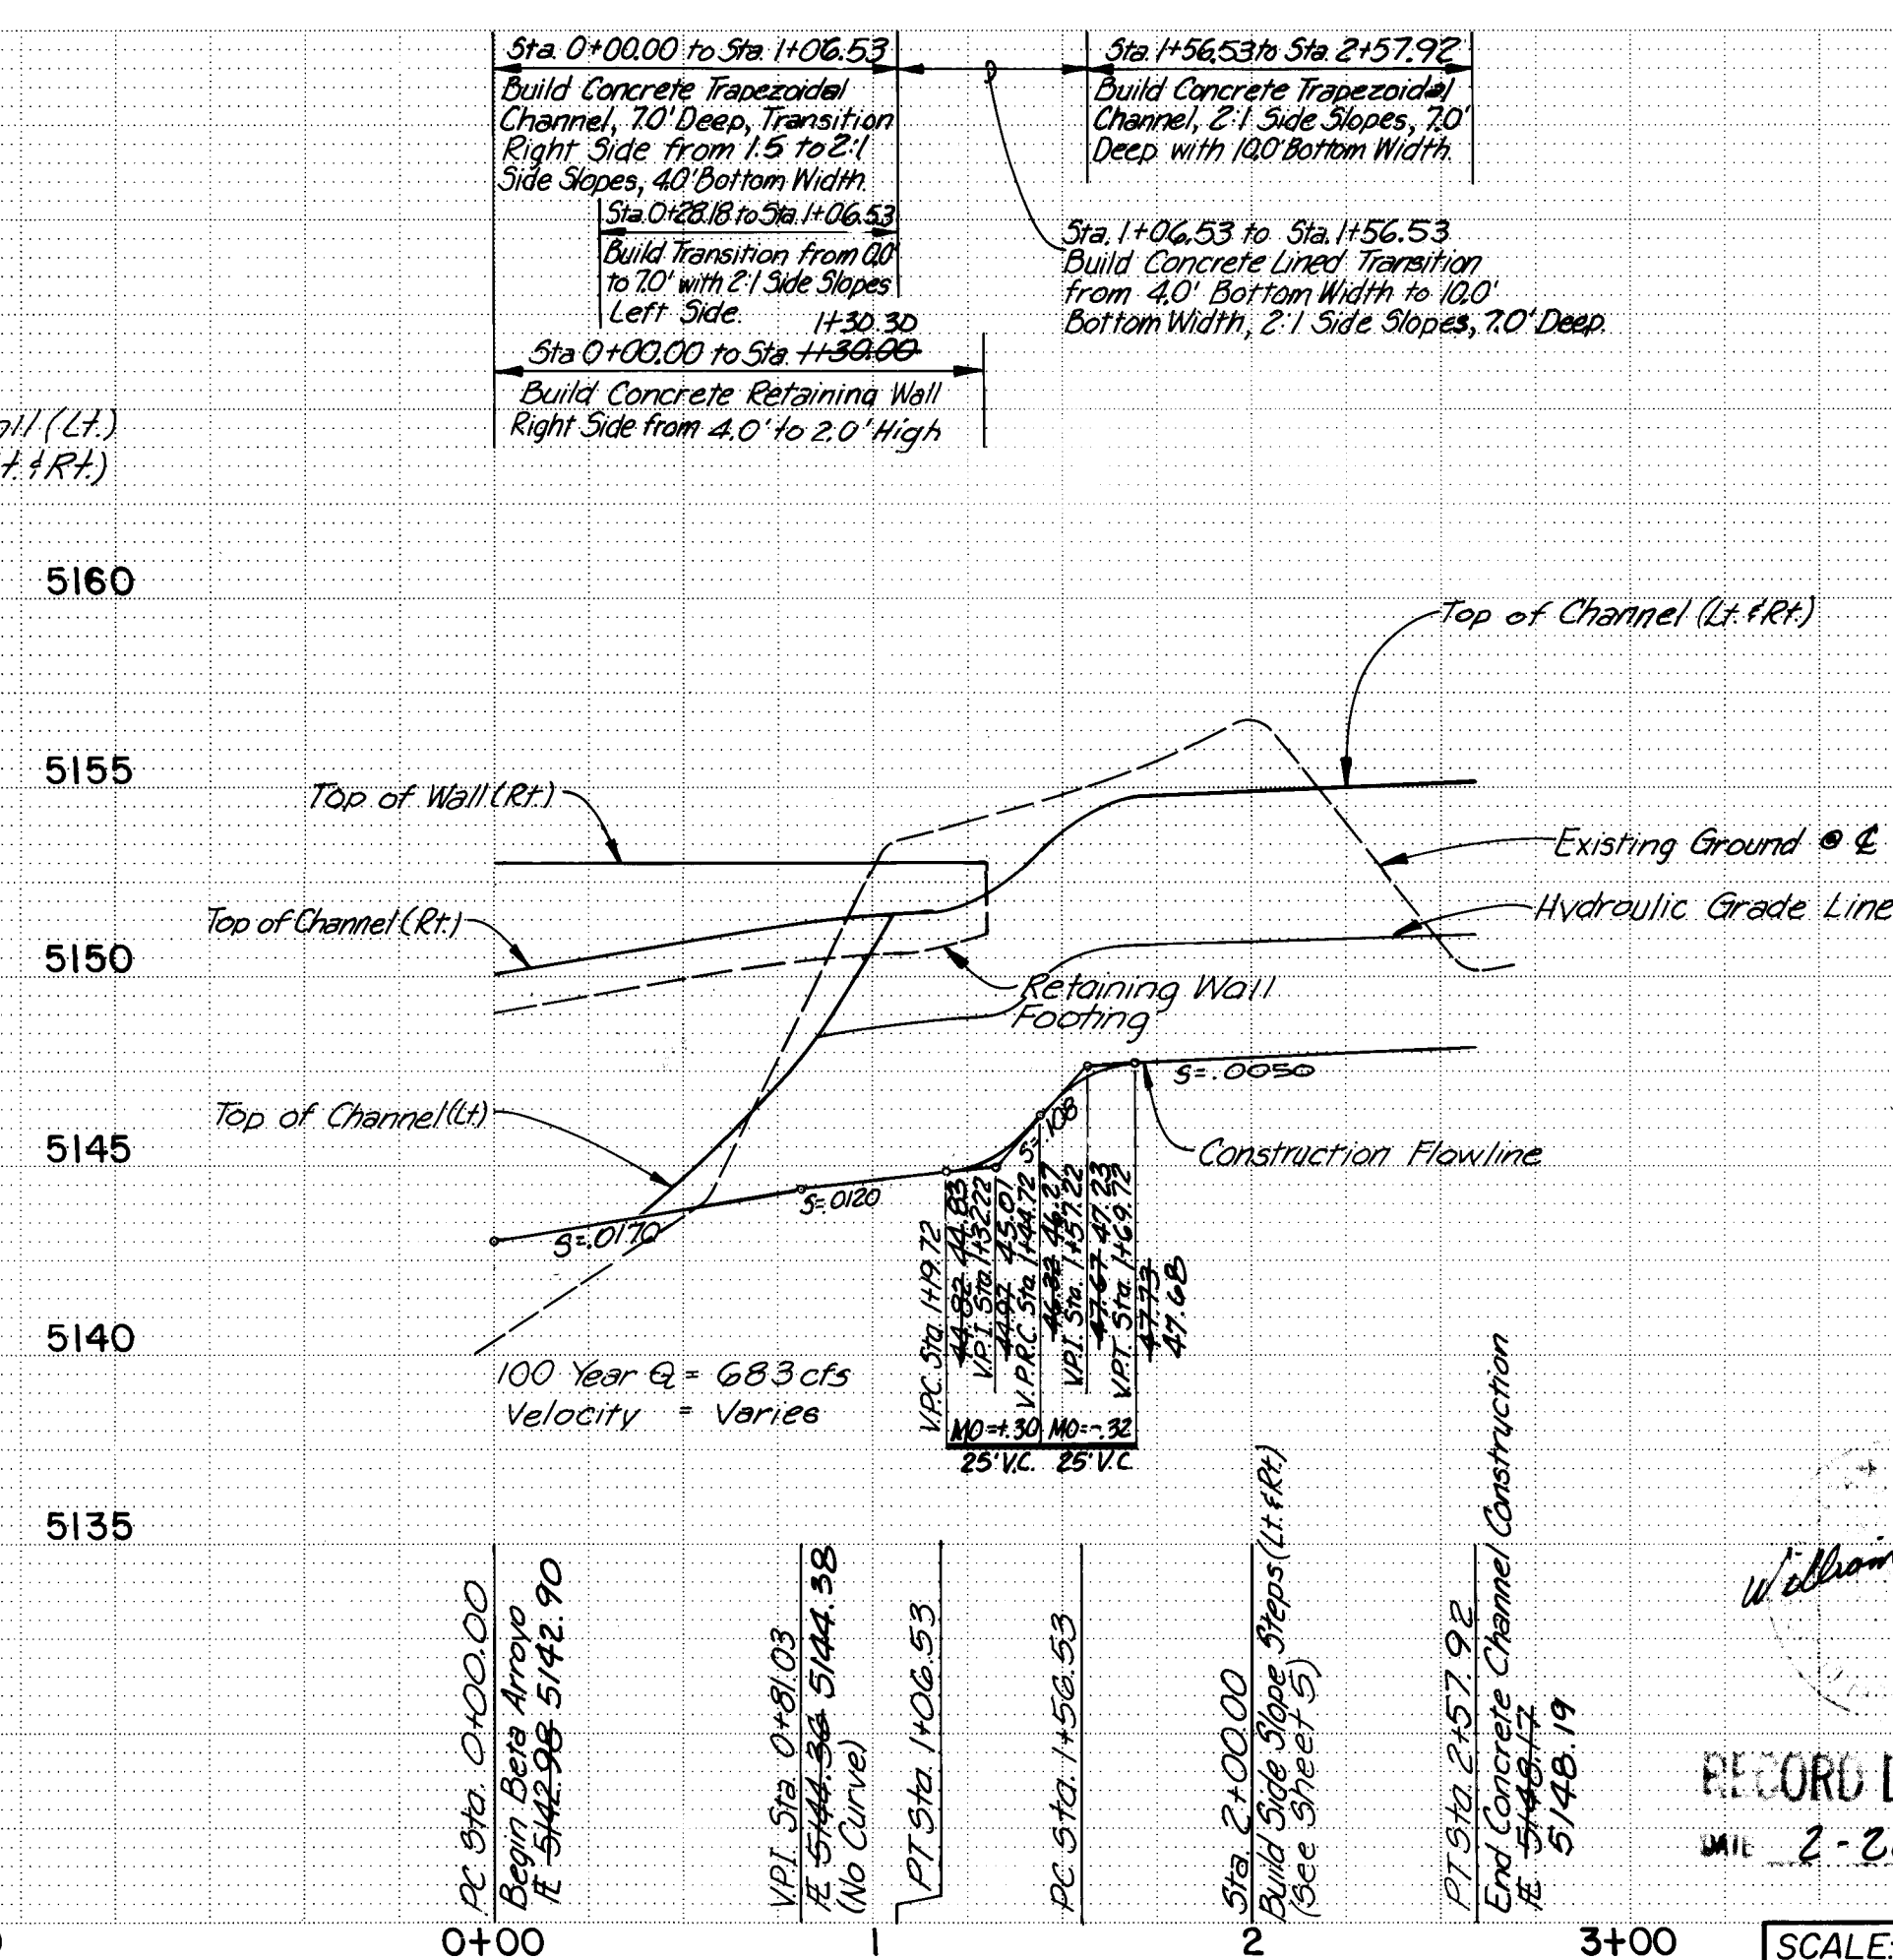


JOB NO. 20596


SCALE:
1" = 50' HORIZ.
1" = 5' VERT.

PREPARED UNDER THE DIRECTION OF  <i>Howard C. Starn</i> 10-18-84	 CITY OF ALBUQUERQUE MUNICIPAL DEVELOPMENT DEPARTMENT ENGINEERING DIVISION  TITLE: STA. 99+75.00 to STA. 104+14.22 PINO ARROYO STA. 0+00.00 to STA. 2+57.92 BETA ARROYO PINO ARROYO IMPROVEMENTS <table border="1" style="width: 100%; border-collapse: collapse; margin-top: 10px;"> <thead> <tr> <th style="width: 16.6%;">APPROVALS</th> <th style="width: 16.6%;">ENGINEER</th> <th style="width: 16.6%;">DATE</th> <th style="width: 16.6%;">APPROVALS</th> <th style="width: 16.6%;">ENGINEER</th> <th style="width: 16.6%;">DATE</th> </tr> </thead> <tbody> <tr> <td>City Engineer</td> <td><i>William Baker</i></td> <td><i>12/2/84</i></td> <td>Liquid Waste</td> <td><i>William Baker</i></td> <td><i>12/2/84</i></td> </tr> <tr> <td>A.C.E. - Design</td> <td><i>W.C. Starn</i></td> <td><i>12/2/84</i></td> <td>Traffic</td> <td><i>N.A. Dorr</i></td> <td><i>12/2/84</i></td> </tr> <tr> <td>A.C.E. - Hydrology</td> <td><i>W.C. Starn</i></td> <td><i>12/2/84</i></td> <td>Water</td> <td><i>William Baker</i></td> <td><i>12/2/84</i></td> </tr> <tr> <td colspan="3">Q.A.</td> <td colspan="3"></td> </tr> </tbody> </table>	APPROVALS	ENGINEER	DATE	APPROVALS	ENGINEER	DATE	City Engineer	<i>William Baker</i>	<i>12/2/84</i>	Liquid Waste	<i>William Baker</i>	<i>12/2/84</i>	A.C.E. - Design	<i>W.C. Starn</i>	<i>12/2/84</i>	Traffic	<i>N.A. Dorr</i>	<i>12/2/84</i>	A.C.E. - Hydrology	<i>W.C. Starn</i>	<i>12/2/84</i>	Water	<i>William Baker</i>	<i>12/2/84</i>	Q.A.					
APPROVALS	ENGINEER	DATE	APPROVALS	ENGINEER	DATE																										
City Engineer	<i>William Baker</i>	<i>12/2/84</i>	Liquid Waste	<i>William Baker</i>	<i>12/2/84</i>																										
A.C.E. - Design	<i>W.C. Starn</i>	<i>12/2/84</i>	Traffic	<i>N.A. Dorr</i>	<i>12/2/84</i>																										
A.C.E. - Hydrology	<i>W.C. Starn</i>	<i>12/2/84</i>	Water	<i>William Baker</i>	<i>12/2/84</i>																										
Q.A.																															
APPROVED FOR CONSTRUCTION CITY ENGINEER _____ DATE _____	DRAWING NO. 1853																														
	SHEET 2 OF 16																														

PROFILE	SURVEYED _____	BY _____	DATE _____
NOTE BOOK _____	PLOTTED _____		
	GRADES CHECKED _____		
NO _____	B.M.'S NOTED _____		
	STRUCTURE NOTATIONS CH'KD _____		

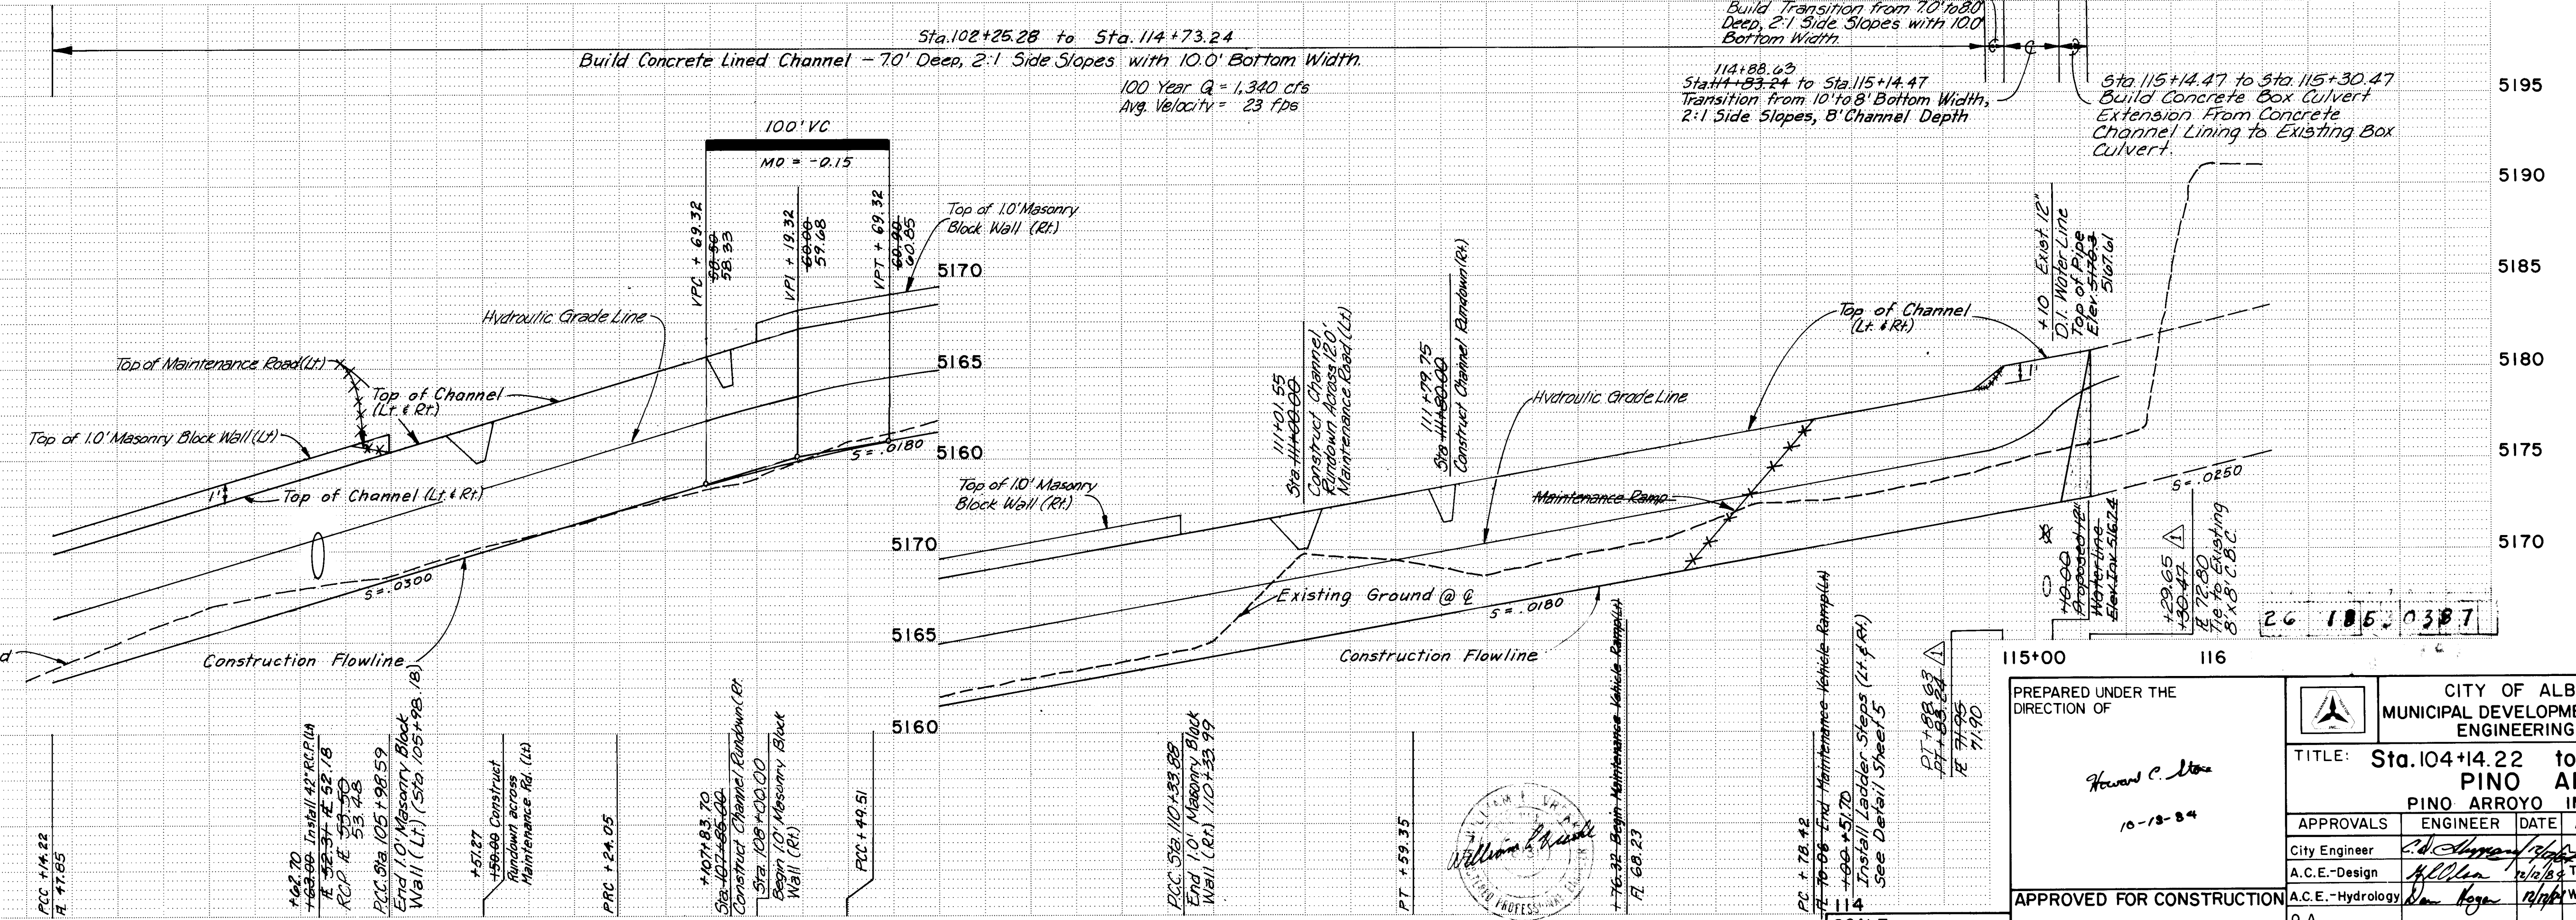[illegible]

PREPARED UNDER THE DIRECTION OF 	CITY OF ALBUQUERQUE MUNICIPAL DEVELOPMENT DEPARTMENT ENGINEERING DIVISION																																																		
Howard C. Moore 10-18-84	<table border="1" style="width: 100%; border-collapse: collapse;"> <tr> <td colspan="5">TITLE: Sta. 104+14.22 to Sta. 115+30.47</td> </tr> <tr> <td colspan="5" style="text-align: center;">PINO ARROYO</td> </tr> <tr> <td colspan="5" style="text-align: center;">PINO ARROYO IMPROVEMENTS</td> </tr> <tr> <td style="width: 15%;">APPROVALS</td> <td style="width: 25%;">ENGINEER</td> <td style="width: 15%;">DATE</td> <td style="width: 25%;">APPROVALS</td> <td style="width: 20%;">ENGINEER</td> </tr> <tr> <td>City Engineer</td> <td><i>C. D. Thompson</i></td> <td><i>12/1/84</i></td> <td>Liquid Waste</td> <td><i>William B. Belsky</i></td> </tr> <tr> <td>A.C.E.-Design</td> <td><i>William B. Belsky</i></td> <td><i>12/1/84</i></td> <td>Traffic</td> <td><i>N.H. D.W.H.</i></td> </tr> <tr> <td>APPROVED FOR CONSTRUCTION</td> <td>A.C.E.-Hydrology</td> <td><i>Ken Hoge</i></td> <td>Water</td> <td><i>William B. Belsky</i></td> </tr> <tr> <td colspan="5">Q.A.</td> </tr> <tr> <td colspan="3">DRAWING NO. 1853</td> <td colspan="2">SHEET 3 OF 16</td> </tr> <tr> <td colspan="3">CITY ENGINEER DATE</td> <td colspan="2"></td> </tr> </table>	TITLE: Sta. 104+14.22 to Sta. 115+30.47					PINO ARROYO					PINO ARROYO IMPROVEMENTS					APPROVALS	ENGINEER	DATE	APPROVALS	ENGINEER	City Engineer	<i>C. D. Thompson</i>	<i>12/1/84</i>	Liquid Waste	<i>William B. Belsky</i>	A.C.E.-Design	<i>William B. Belsky</i>	<i>12/1/84</i>	Traffic	<i>N.H. D.W.H.</i>	APPROVED FOR CONSTRUCTION	A.C.E.-Hydrology	<i>Ken Hoge</i>	Water	<i>William B. Belsky</i>	Q.A.					DRAWING NO. 1853			SHEET 3 OF 16		CITY ENGINEER DATE				
TITLE: Sta. 104+14.22 to Sta. 115+30.47																																																			
PINO ARROYO																																																			
PINO ARROYO IMPROVEMENTS																																																			
APPROVALS	ENGINEER	DATE	APPROVALS	ENGINEER																																															
City Engineer	<i>C. D. Thompson</i>	<i>12/1/84</i>	Liquid Waste	<i>William B. Belsky</i>																																															
A.C.E.-Design	<i>William B. Belsky</i>	<i>12/1/84</i>	Traffic	<i>N.H. D.W.H.</i>																																															
APPROVED FOR CONSTRUCTION	A.C.E.-Hydrology	<i>Ken Hoge</i>	Water	<i>William B. Belsky</i>																																															
Q.A.																																																			
DRAWING NO. 1853			SHEET 3 OF 16																																																
CITY ENGINEER DATE																																																			

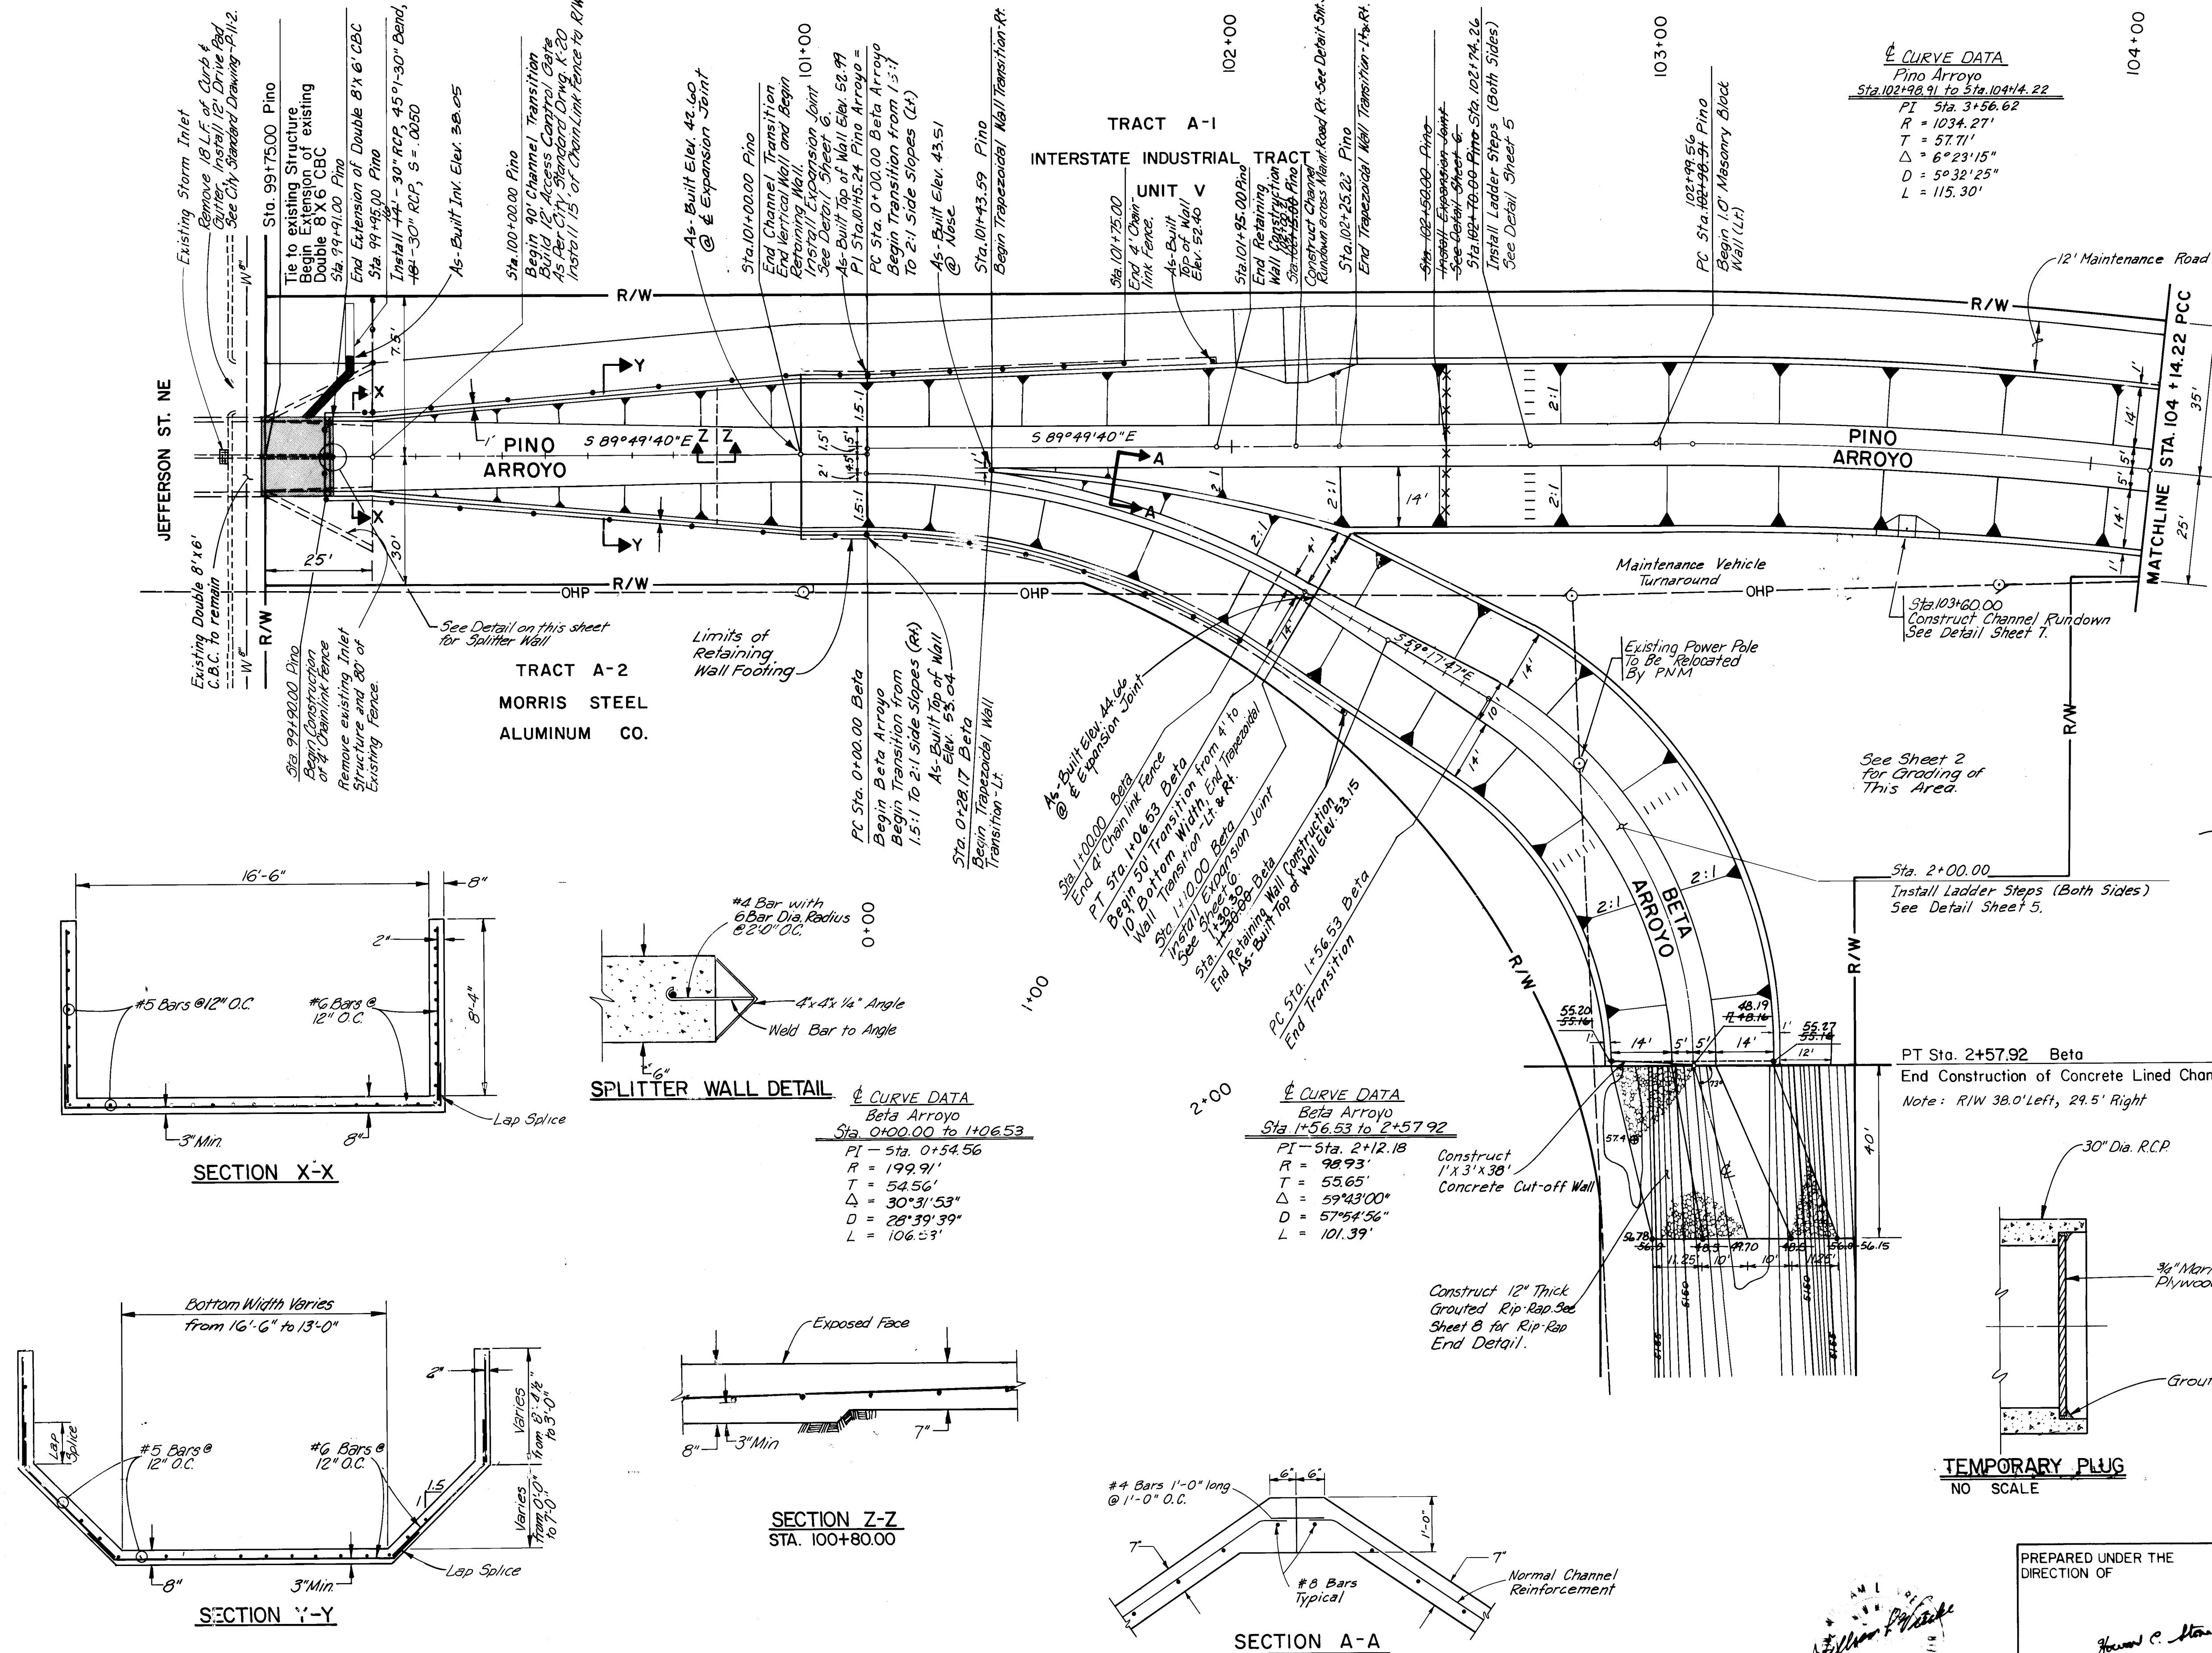

CURVE DATA

Pino Arroyo
Sta. 102+98.91 to Sta. 104+14.22
PI Sta. 103+56.62
R = 1034.27'
T = 57.71'
Δ = 6°23'15"
D = 5°32'25"
L = 115.30'

PT Sta. 2+57.92 Beta
End Construction of Concrete Lined Channel
Note: R/W 38.0' Left, 29.5' Right

26 18530487

PREPARED UNDER THE
DIRECTION OF

10-18-89

JOB NO. 20596

SCALE:
1" = 20'

RECORD DRAWINGS
DATE 2-26-86

APPROVED FOR CONSTRUCTION

CITY ENGINEER DATE

CITY OF ALBUQUERQUE
MUNICIPAL DEVELOPMENT DEPARTMENT
ENGINEERING DIVISION


TITLE:
CONFLUENCE - PINO AND BETA ARROYOS
PINO ARROYO IMPROVEMENTS

APPROVALS	ENGINEER	DATE	APPROVALS	ENGINEER	DATE
City Engineer	<i>C. H. Hays</i>	12/1/89	Liquid Waste	<i>William B. Bledsoe</i>	12/1/89
A.C.E. Design	<i>Alisa</i>	12/1/89	Traffic	<i>DA Durr</i>	12/1/89
A.C.E. Hydrology	<i>Don Hays</i>	12/1/89	Water	<i>William B. Bledsoe</i>	12/1/89

DRAWING
NO. **1853**

SHEET **4** OF **16**


REFERENCES			SURVEY INFORMATION			BENCH MARKS		AS-BUILT INFORMATION	
MAP NO. E-17-Z			DATE			STATION IS A STANDARD ACS BRASS TABLET		CONTRACTOR K.V.C. Inc.	
EST NO.			BY			STAMPED "8-DIT", SET IN TOP OF A CONCRETE		STAKED BY <i>Robertson-Hughes Inc.</i> DATE <i>8/86</i>	
						POST PROJECTING 0.2 FEET ABOVE STATION IS		INSPECTOR'S FIELD VERIFICATION BY <i>Silvas Guizzo</i> DATE <i>9/86</i>	
						LOCATED APPROXIMATELY 300 FEET SOUTH		FIELD VERIFICATION BY <i>Robertson-Hughes Inc.</i> DATE <i>1/86</i>	
						OF ELLISON ST. CENTERLINE AND APPROXIMATELY		CORRECTED BY <i>Robertson-Hughes Inc.</i> DATE <i>2/86</i>	
						45 FEET WEST OF JEFFERSON ST. CENTERLINE.		MICRO-FILM INFORMATION	
						ELEV. 5145.55		RECORDED BY DATE	
								NO.	

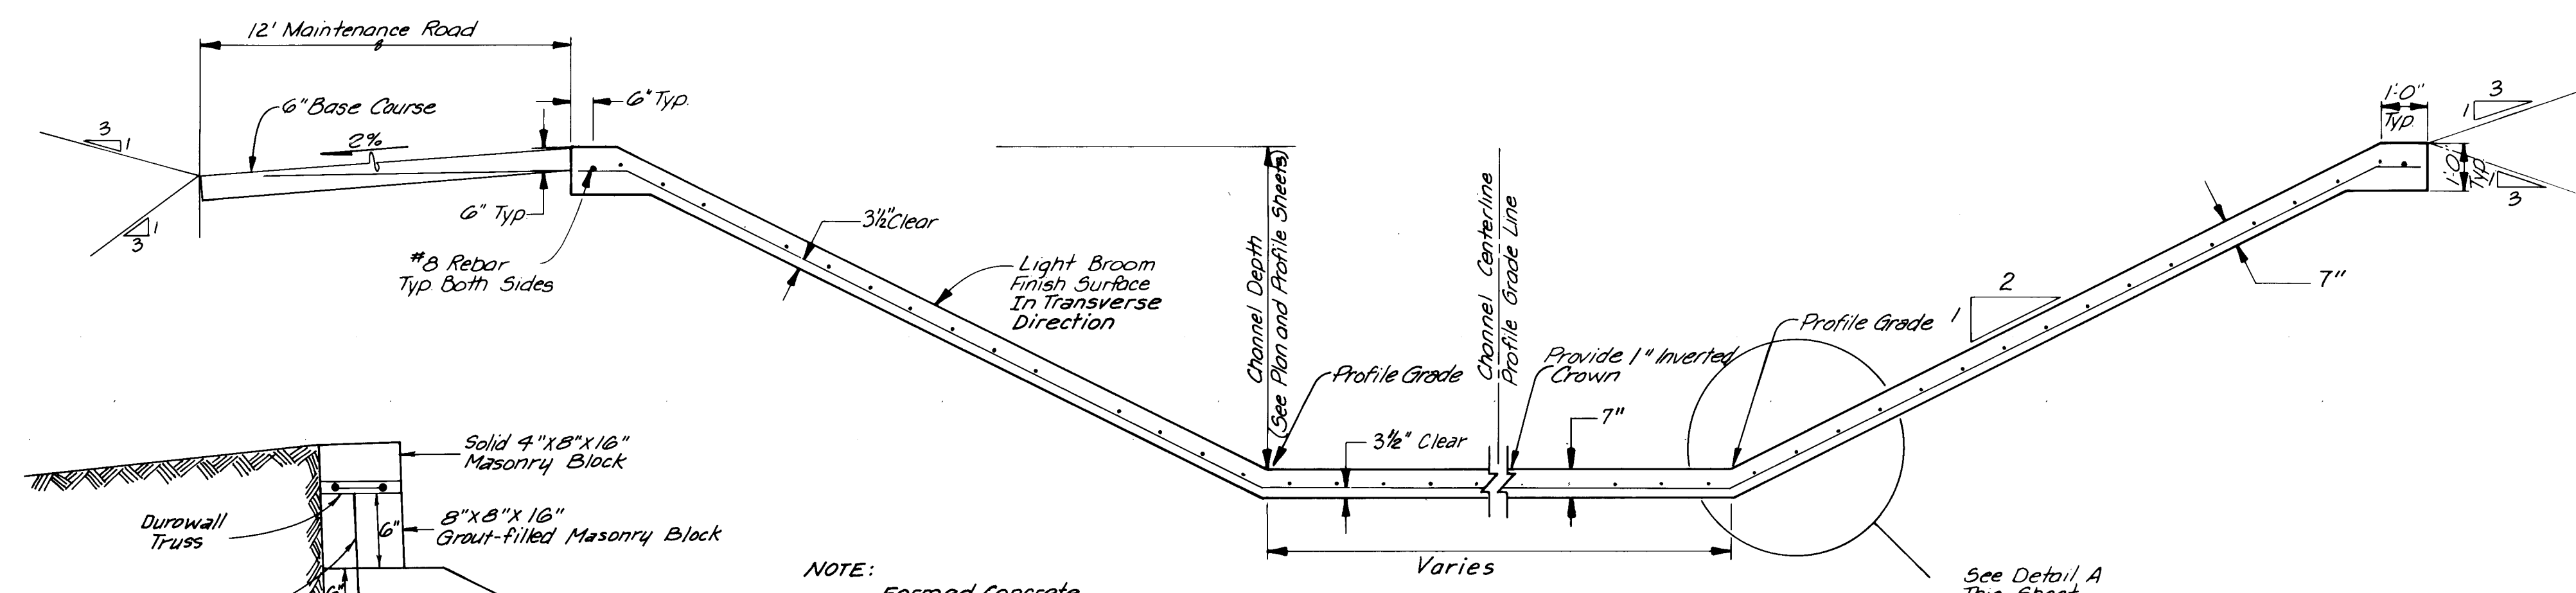


TYPICAL CHANNEL CROSS SECTION

Note: Reinforce with No. 5 bars @ 1'-0" O.C. transverse and No. 6 bars @ 1'-0" O.C. longitudinal.


GROUT-FILLED MASONRY BLOCK RETAINING WALL DETAIL

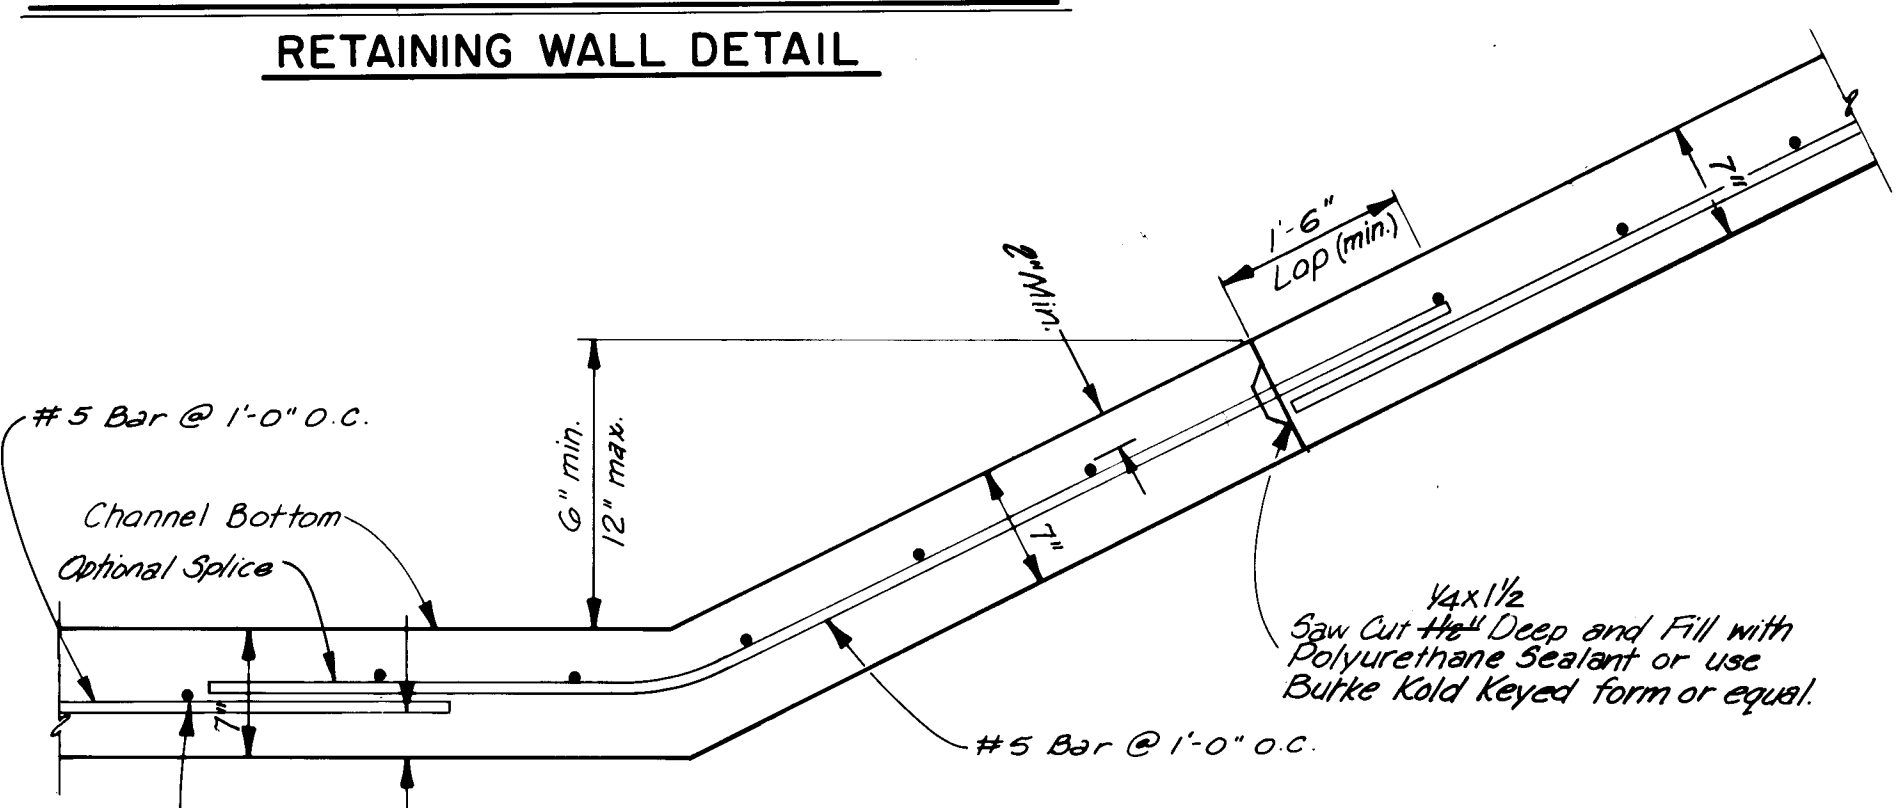


DETAIL A

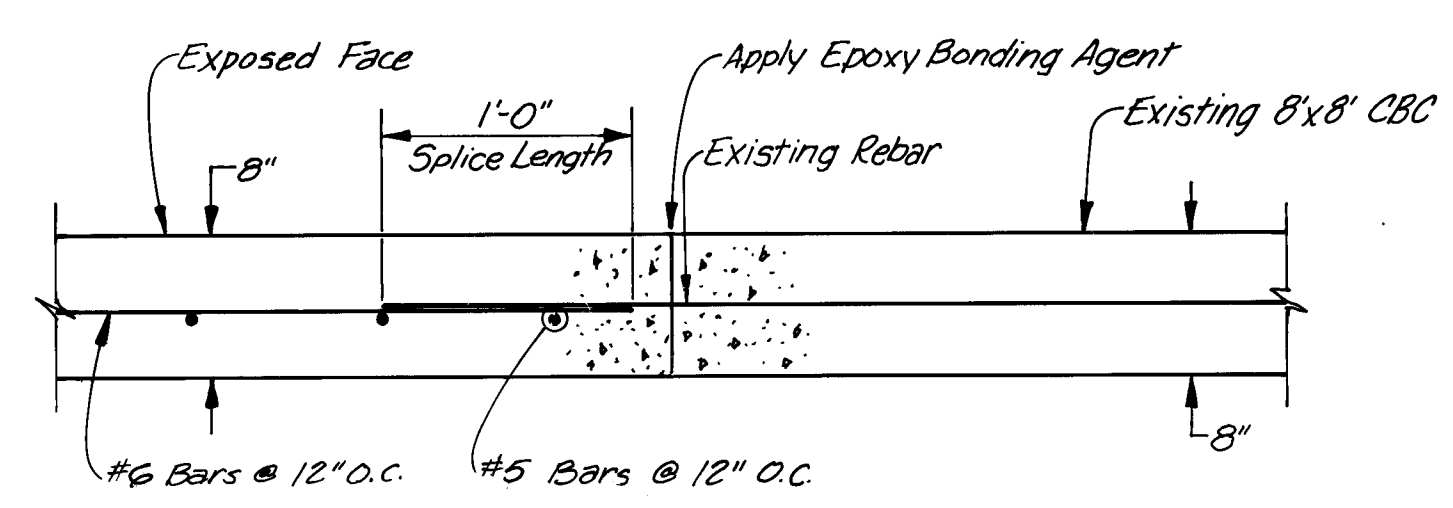

TIE TO EXISTING C.B.C. STRUCTURE
STA. 115+30.47

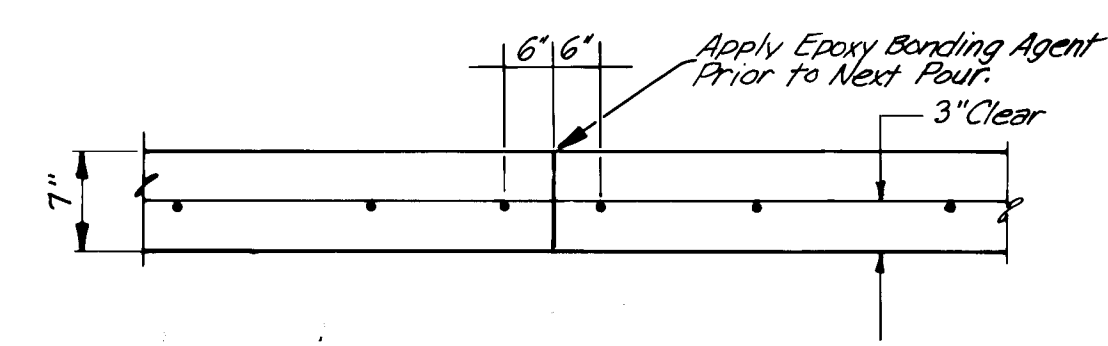


CONSTRUCTION JOINT DETAIL
AS REQUIRED BY CHANNEL CONSTRUCTION

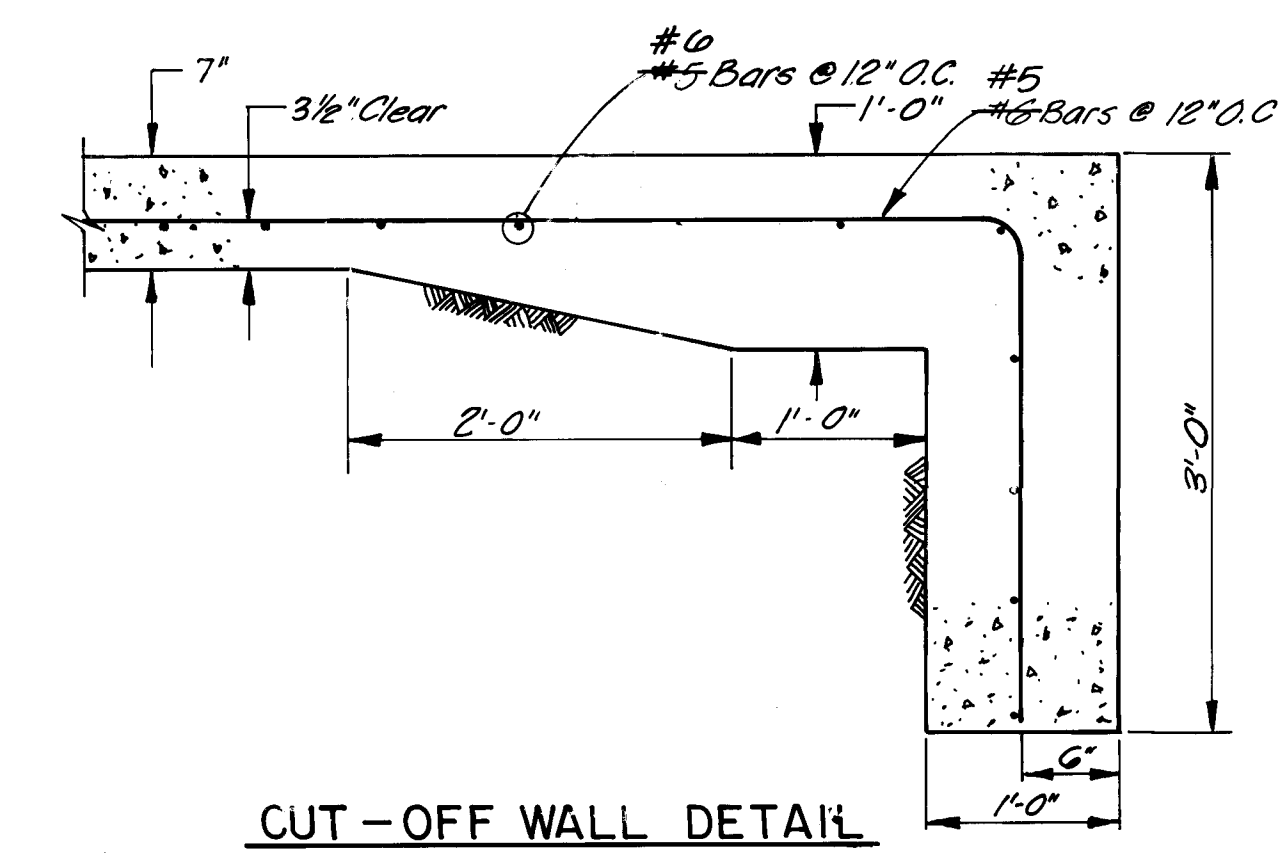

CUT-OFF WALL DETAIL


- NOTES:
- Concrete shall be 3000 p.s.i. 28 day strength with maximum aggregate size as stated in the specifications.
 - All steel shall be Grade 60 deformed bars unless noted otherwise.
 - Splices in rebar in typical channel section shall be 1'-0" or greater for No. 3 and No. 4 bars, 1'-3" for No. 5 bars and 1'-8" for No. 6 Bars, and 2'-10" for No. 8 Bars.
 - All steel spacings are given to the centerline of the bar.
 - All exposed edges shall have a 3/4" chamfer, except as noted.
 - All rebar shall be supported on 3/4" sand chairs at a maximum spacing of 5' perpendicular to the channel centerline.
 - Place ladder steps as shown on plan and profile sheets on both sides of channel.
 - Subgrade minimum compaction 90% per ASTM D-1557
 - Maintenance road shall be surfaced with 6" Class I Crushed Gravel Base as stated in the Specifications.

RECORD DRAWINGS
DATE 2-26-86
JOB NO. 20596

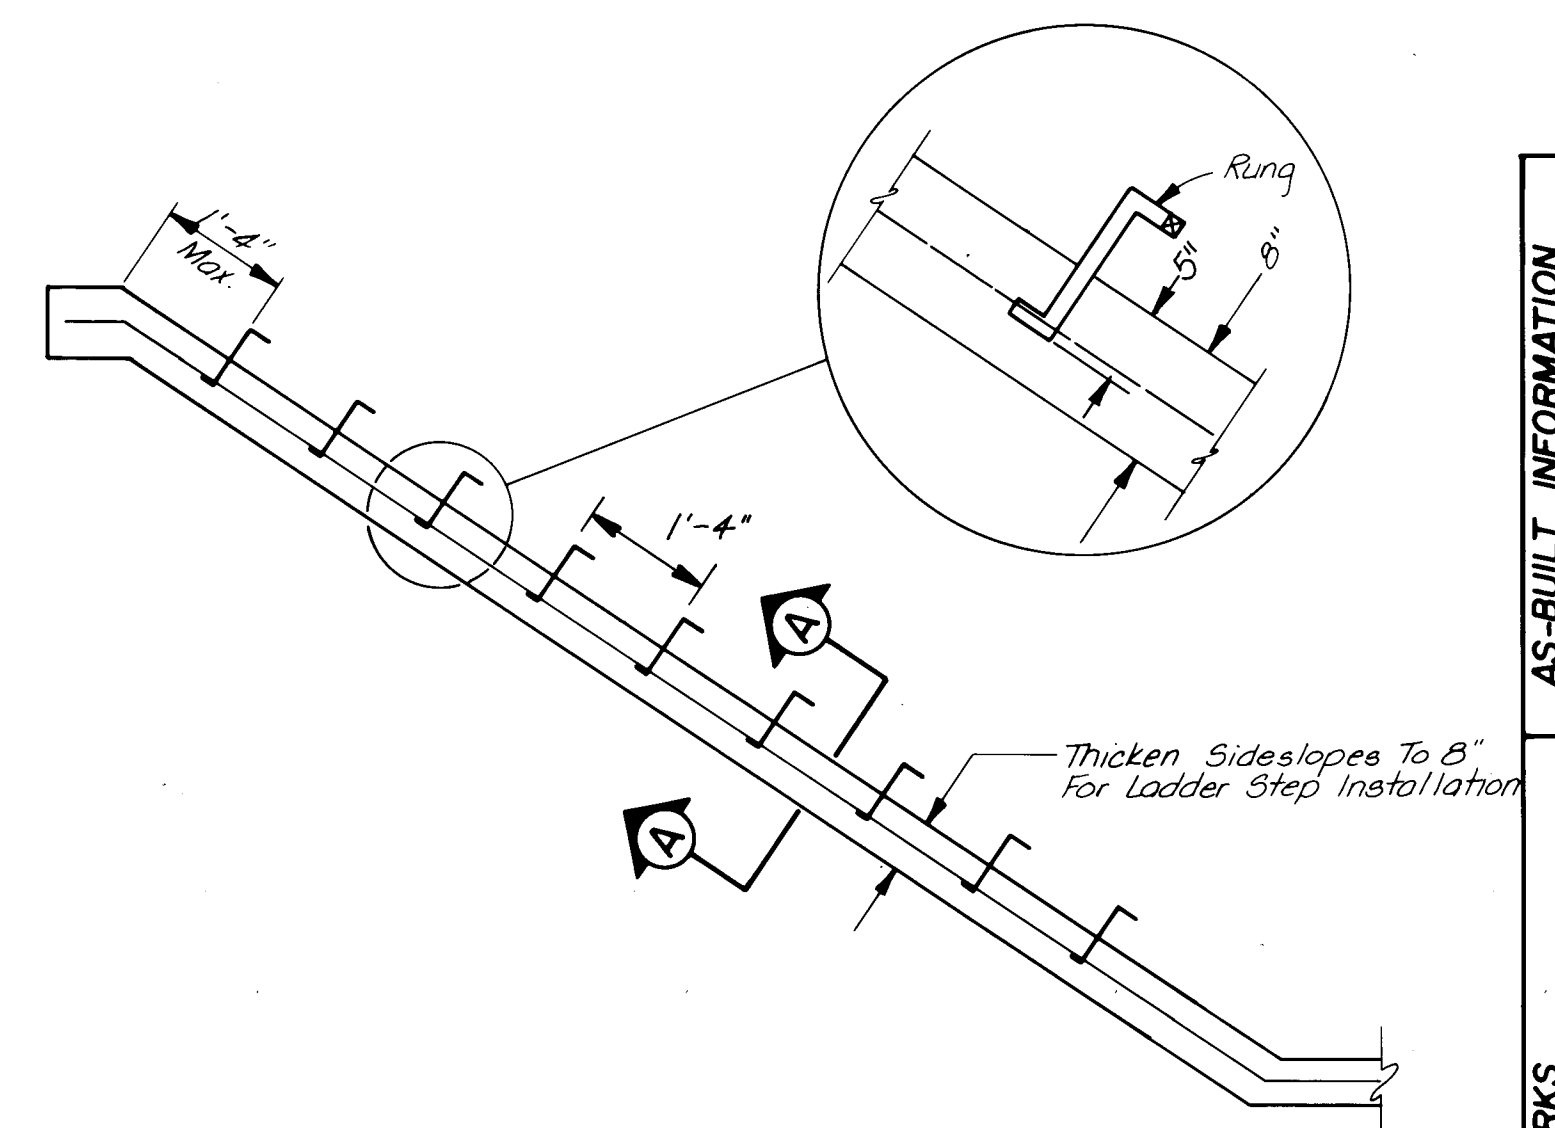


CHANNEL SIDESLOPE LADDER DETAILS

Sta. 2+00.00 Beta Arroyo
Sta. 102+70.00, 114+00.00 Pino Arroyo

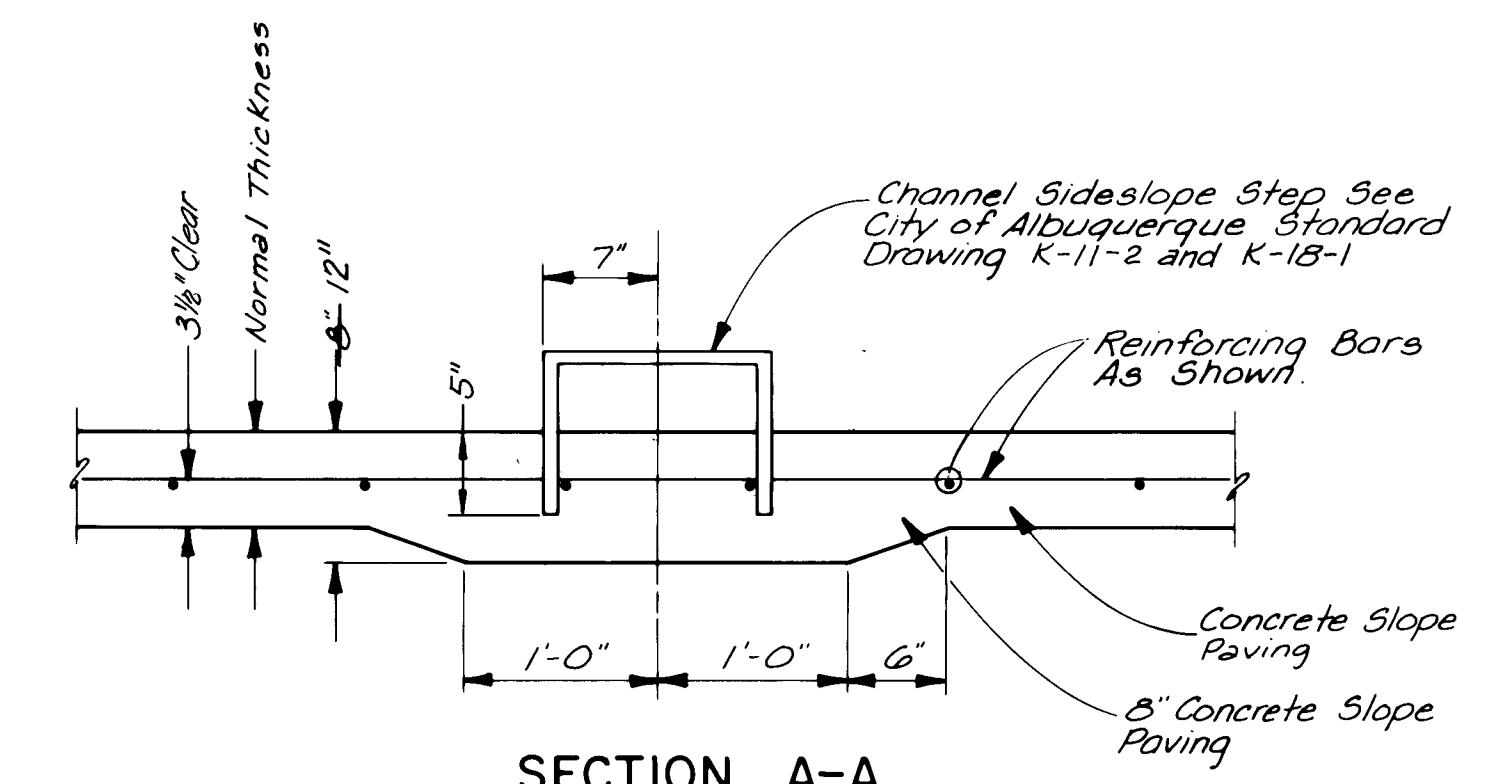




SECTION A-A

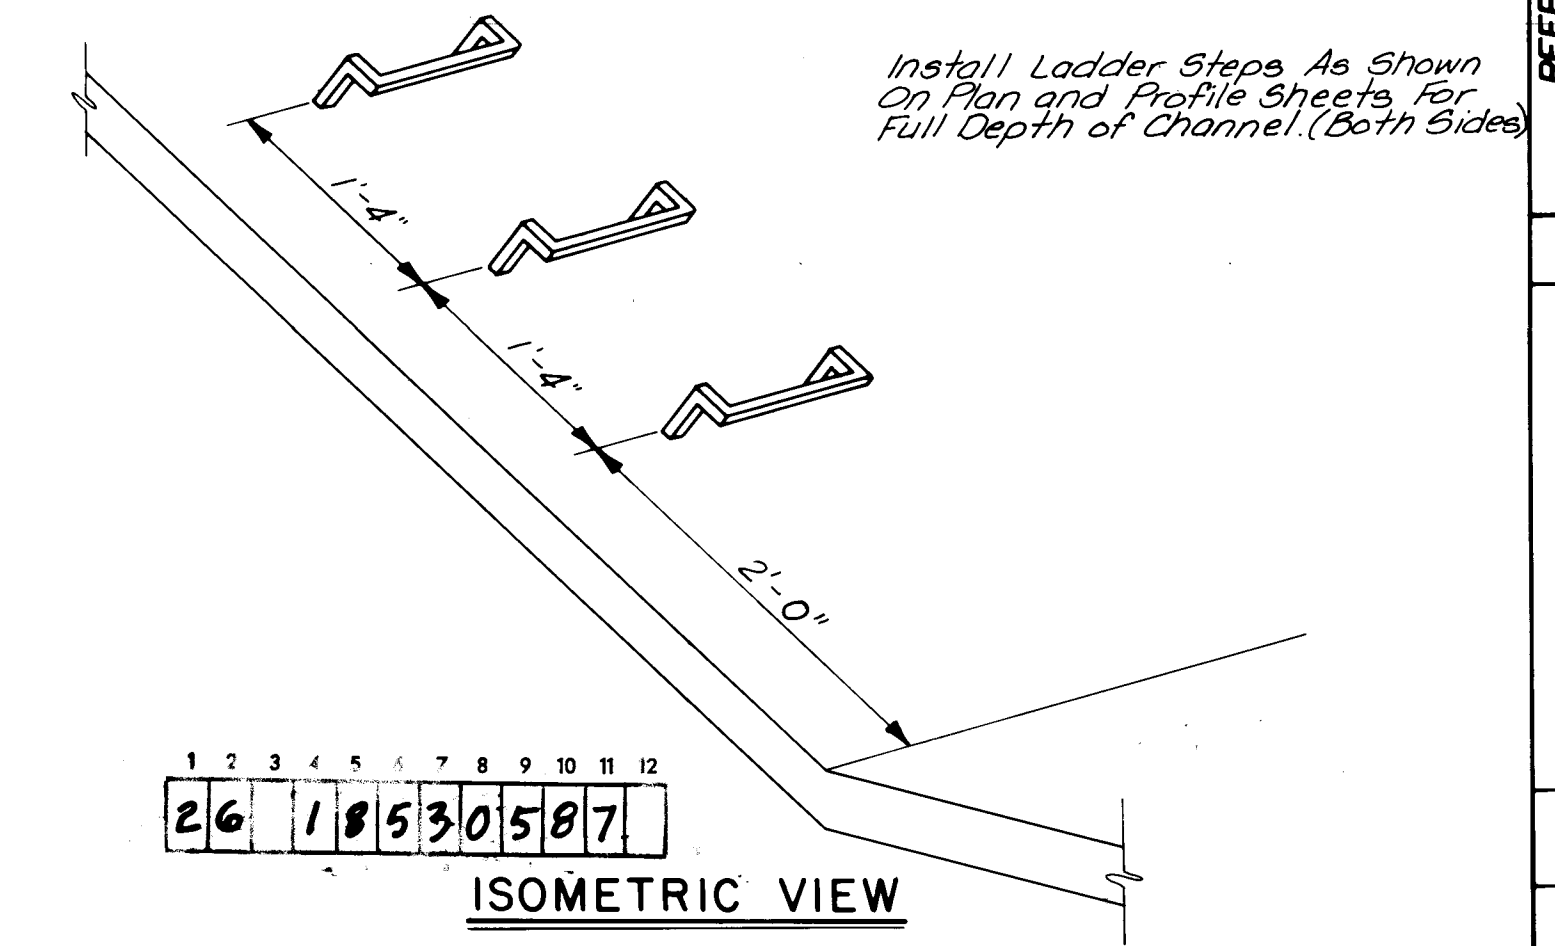

ISOMETRIC VIEW



PREPARED UNDER THE DIRECTION OF <i>Howard C. Stan</i> 10-18-89		CITY OF ALBUQUERQUE MUNICIPAL DEVELOPMENT DEPARTMENT ENGINEERING DIVISION	
TITLE: TYPICAL CHANNEL SECTIONS PINO ARROYO IMPROVEMENTS			
APPROVALS	ENGINEER	DATE	APPROVALS
City Engineer	<i>William L. Vreeland</i>	12/1/89	Liquid Waste
A.C.E.-Design	<i>William L. Vreeland</i>	12/1/89	Traffic
A.C.E.-Hydrology	<i>William L. Vreeland</i>	12/1/89	Water
Q.A.	<i>William L. Vreeland</i>	12/1/89	
DRAWING NO. 1853		SHEET 5 OF 16	

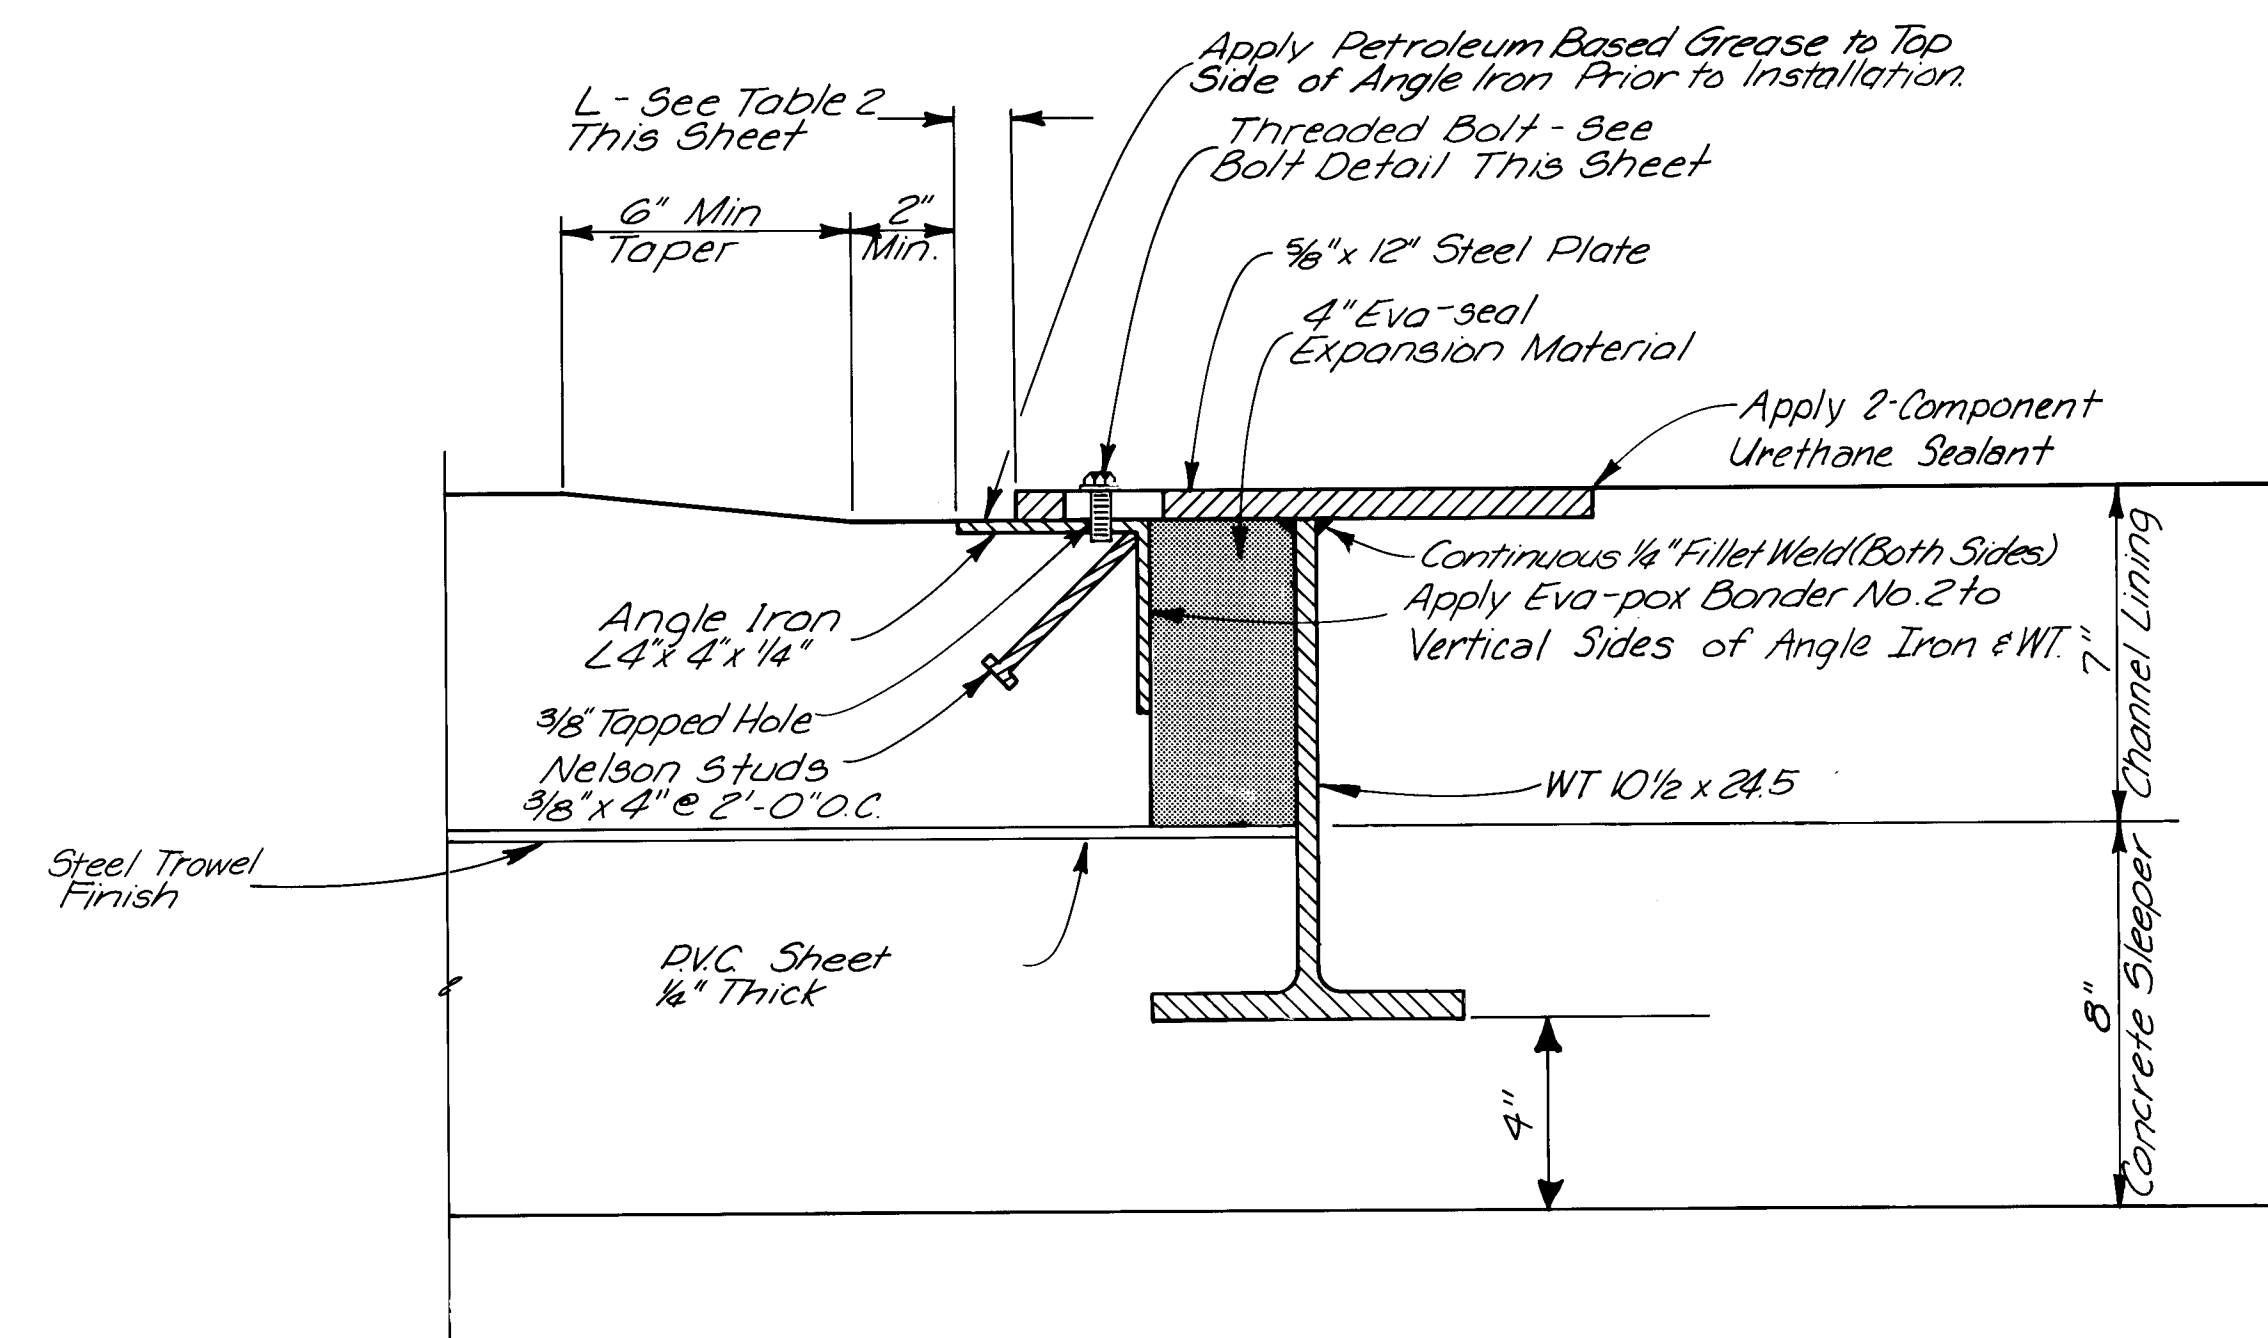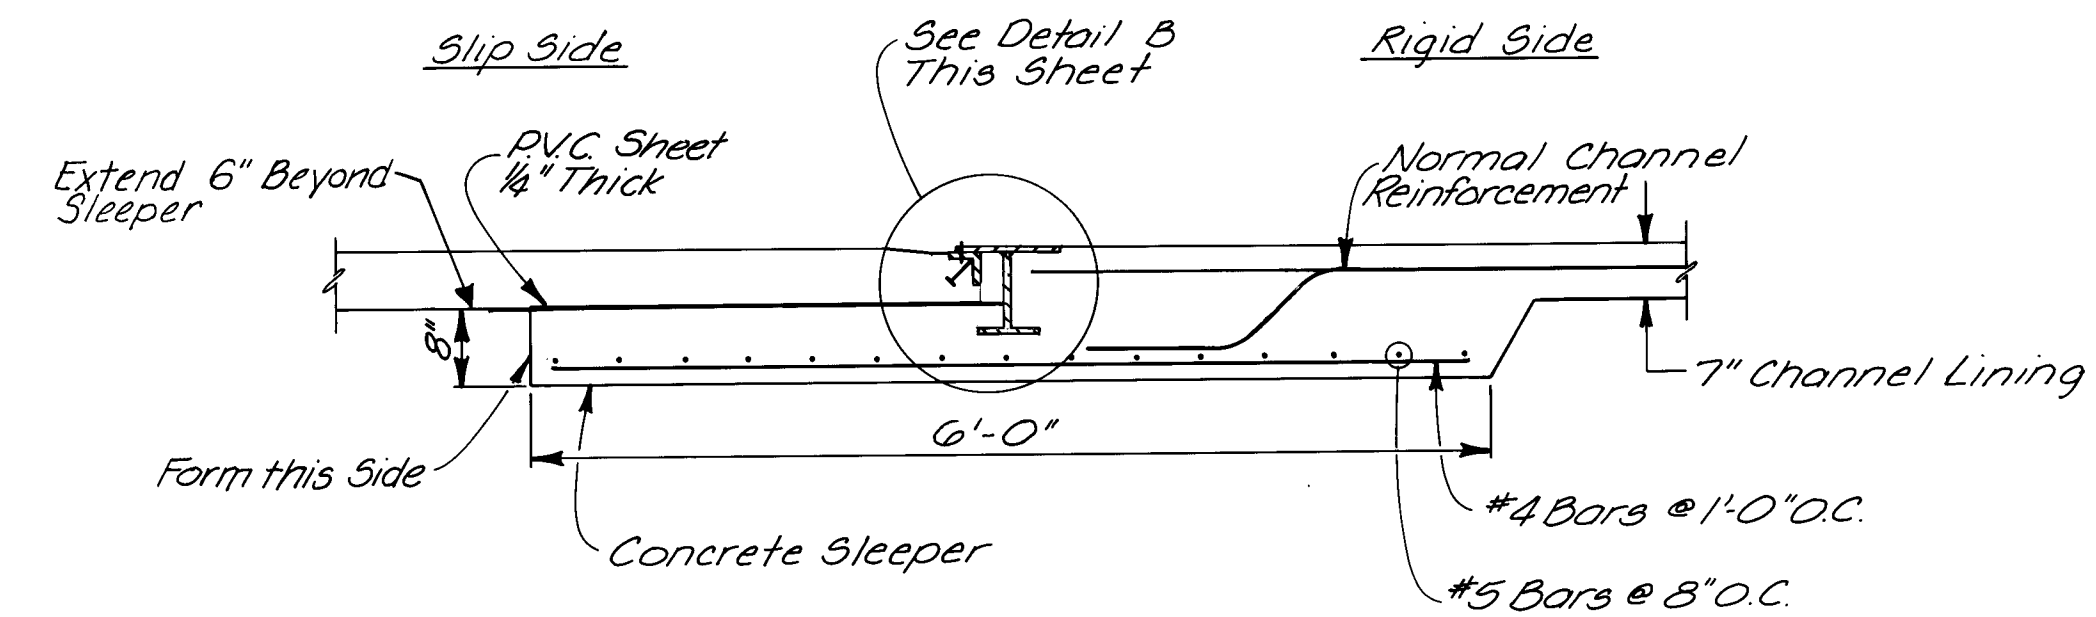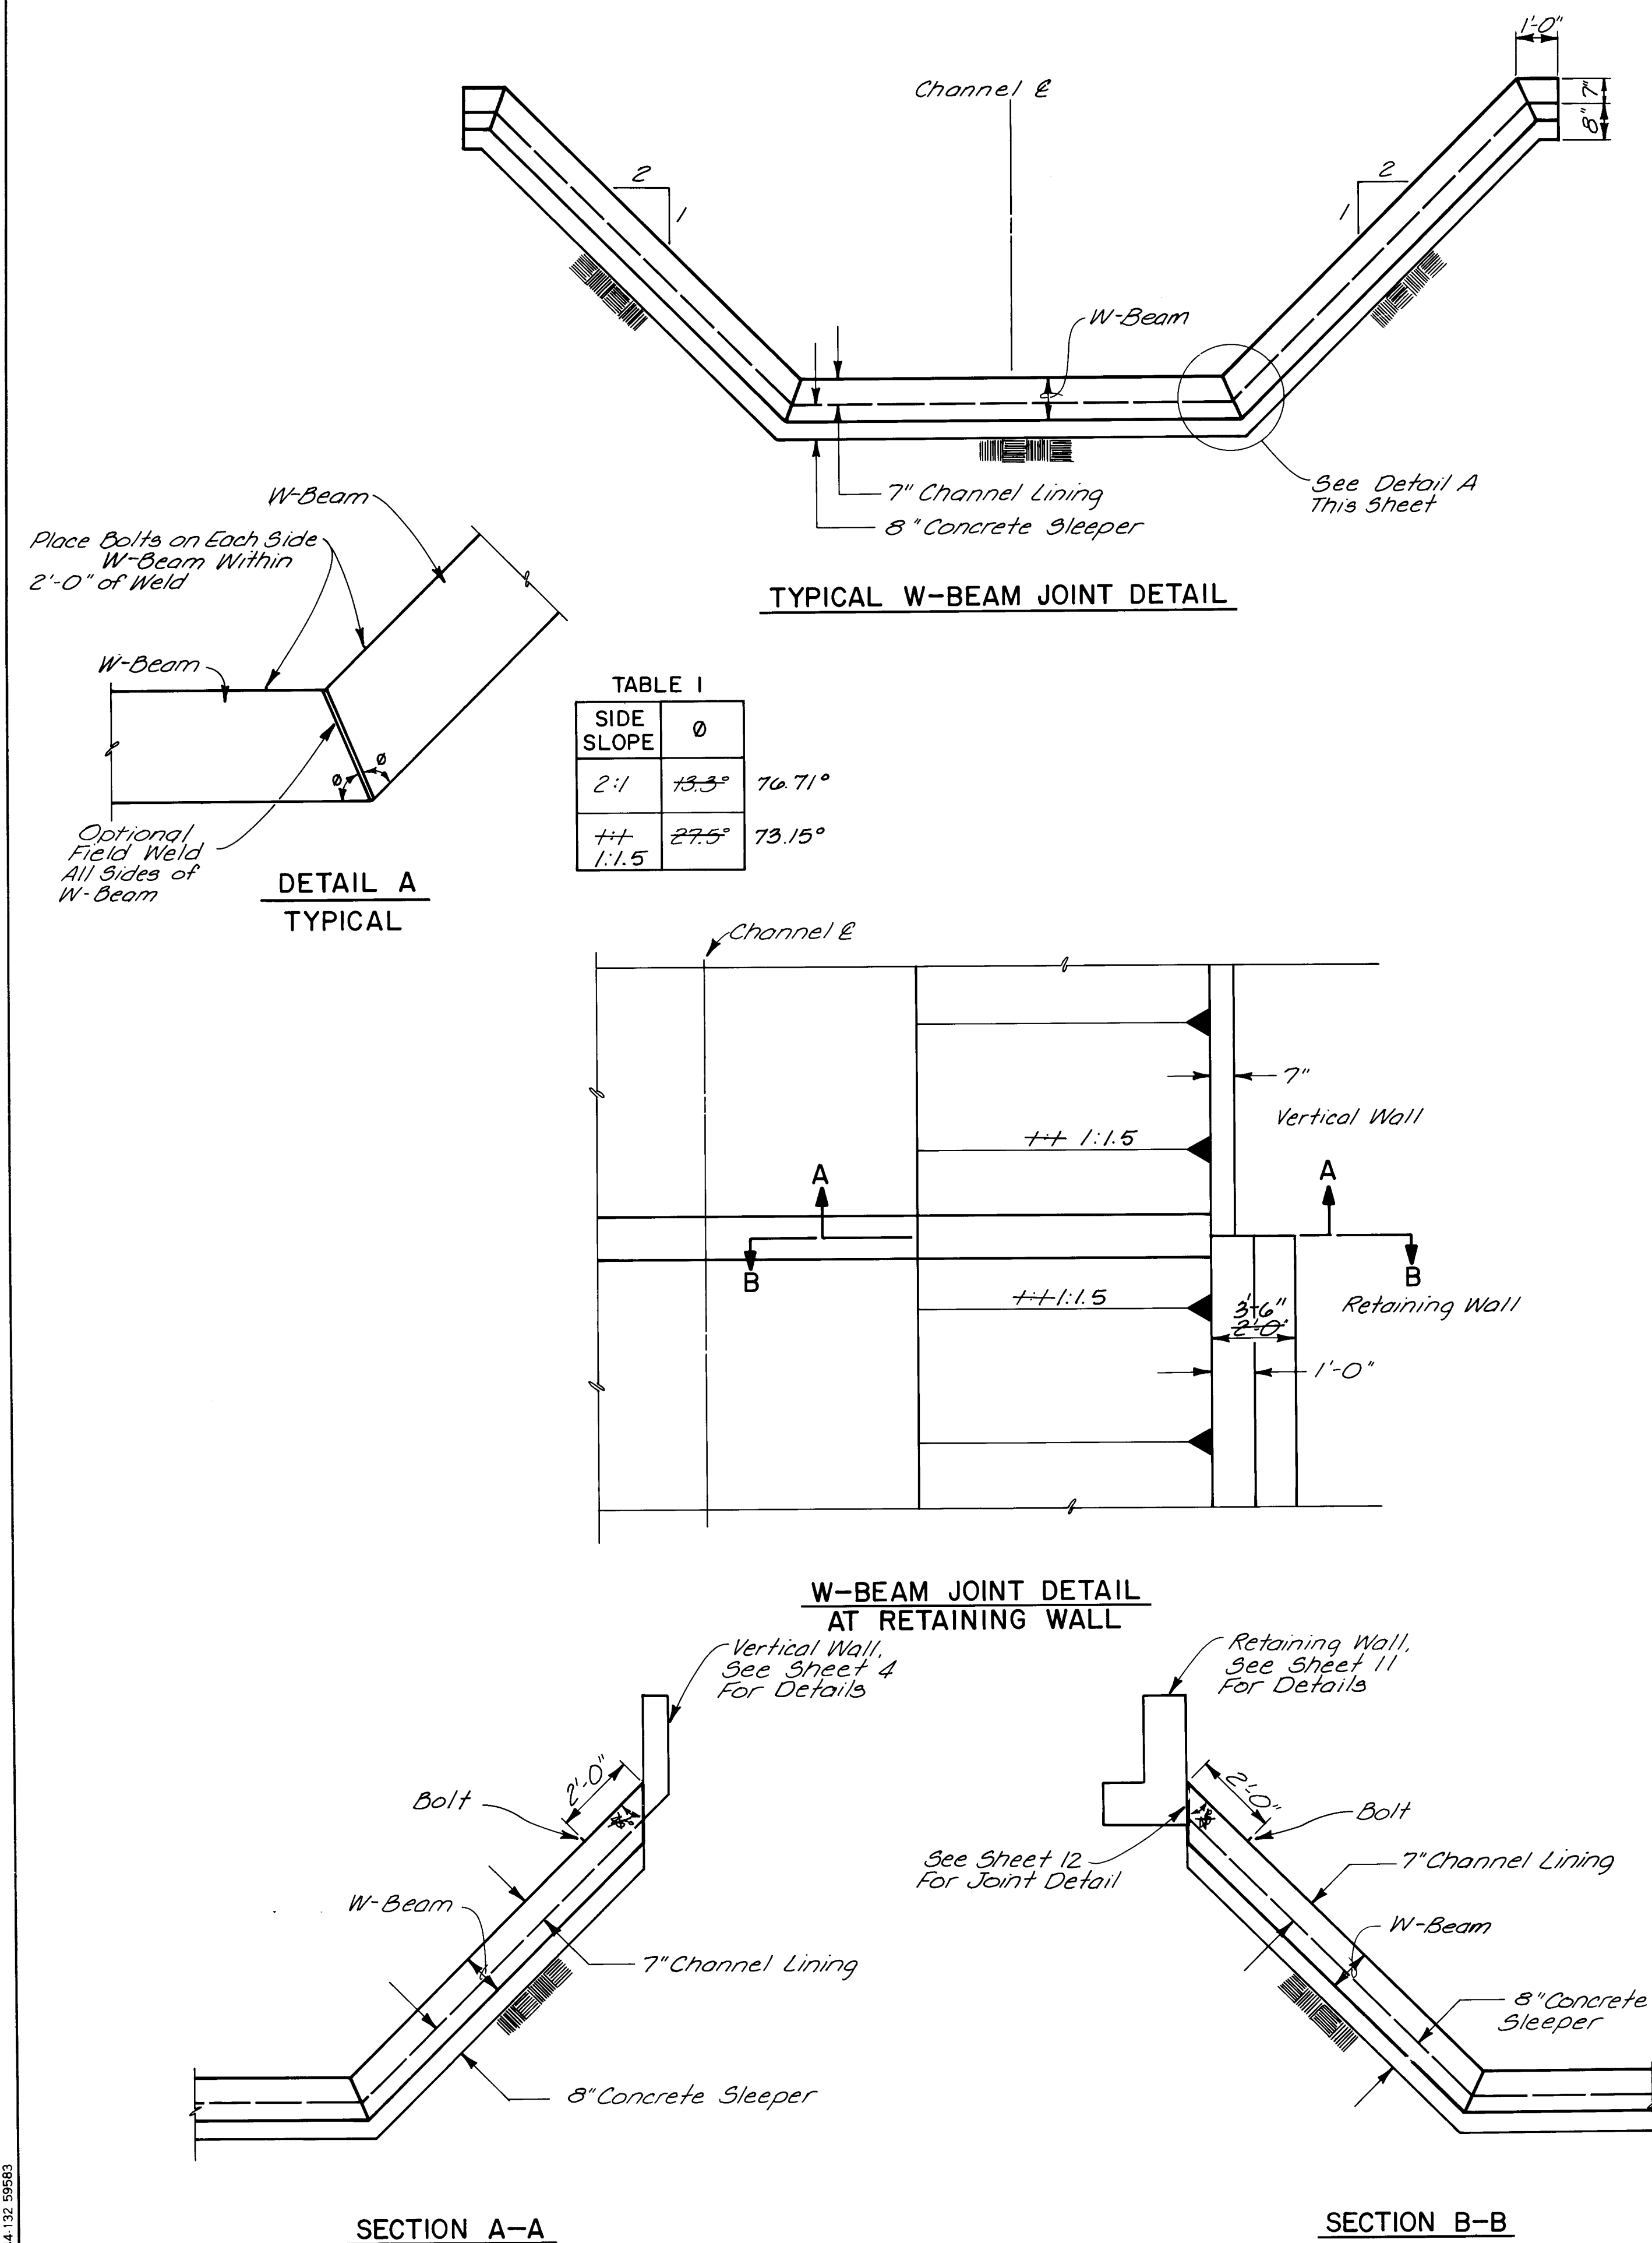


ORIENTATION OF W-BEAM EXPANSION JOINT	
Station	Location of Rigid Side
114+73.24 (Pino)	Upstream
101+00.00 (Pino)	Downstream
1+10.00 (Beta)	Downstream

TABLE 2	
Average Daily Maximum Temperature (°F)	L (Inches)
90°	0.9
70°	1.3
50°	1.5

Note: On same day as concrete pour, Bond No. 2 shall be applied to angle iron and Eva-seal. And angle iron shall be installed as directed on Table 2.

Bolt Requirements
2 on Bottom
2 on Each Side Slope
1 on Top Bill

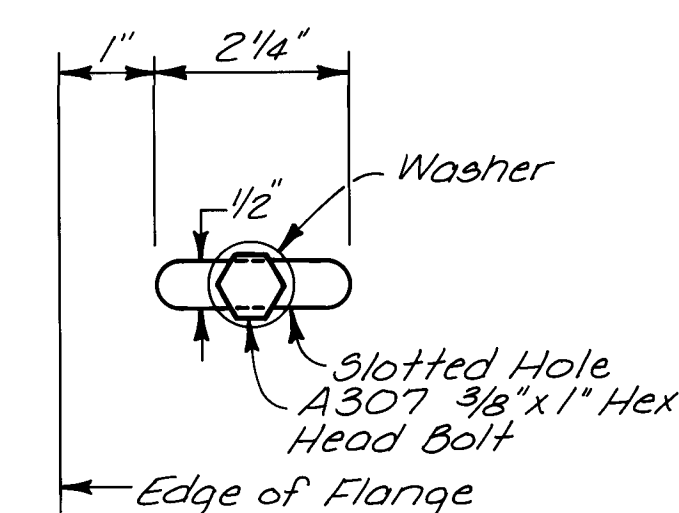

BOLT DETAIL PLAN

NOTE:

- EVA-POX BOND NO. 2 AND EVA-SEAL MANUFACTURED BY E-POXY INDUSTRIES MAY BE SUBSTITUTED WITH ENGINEER APPROVED EQUAL.
- ANGLE IRON BOLTS MUST BE REMOVED BETWEEN 24-36 HOURS AFTER CONCRETE POUR.
- AFTER REMOVAL OF ANGLE IRON BOLTS, COVER SLOTTED HOLE WITH 1/8" METAL PLATE AND WELD.
- INSTALLATION OF E-POXY MATERIALS MUST BE PER MANUFACTURER'S INSTRUCTIONS.



JOB NO. 20596
SCALE:
NO SCALE

26 18530687


PREPARED UNDER THE DIRECTION OF

Howard P. Stee
10-18-89

CITY OF ALBUQUERQUE MUNICIPAL DEVELOPMENT DEPARTMENT ENGINEERING DIVISION			
TITLE: EXPANSION JOINT DETAILS W-BEAM TRANSVERSE JOINT PINO ARROYO IMPROVEMENTS			
APPROVALS	ENGINEER	DATE	APPROVALS
City Engineer	William P. Stee	10/18/89	Liquid Waste
A.C.E.-Design	William P. Stee	12/1/89	Traffic
A.C.E.-Hydrology	William P. Stee	12/1/89	Water
Q.A.			
DRAWING NO.	1853		SHEET 6 OF 16
CITY ENGINEER	DATE		

AS-BUILT INFORMATION				BENCH MARKS				SURVEY INFORMATION				REFERENCES				REVISIONS			
CONTRACTOR	K.M.C. Inc.	DATE	9/86	STATION	114+73.24	DATE	9/86	MAP NO.	1853	EST. NO.	0687	W.O. NO.		BY		NO.			
INSPECTOR	William P. Stee	DATE	9/86	FIELD CHIEF	William P. Stee	DATE	9/86												
VERIFICATION BY	William P. Stee	DATE	9/86	CORRECTED BY	William P. Stee	DATE	9/86												
MICRO-FILM INFORMATION				RECORDED BY				NO.				DATE							

BRUNING 44 32 52793

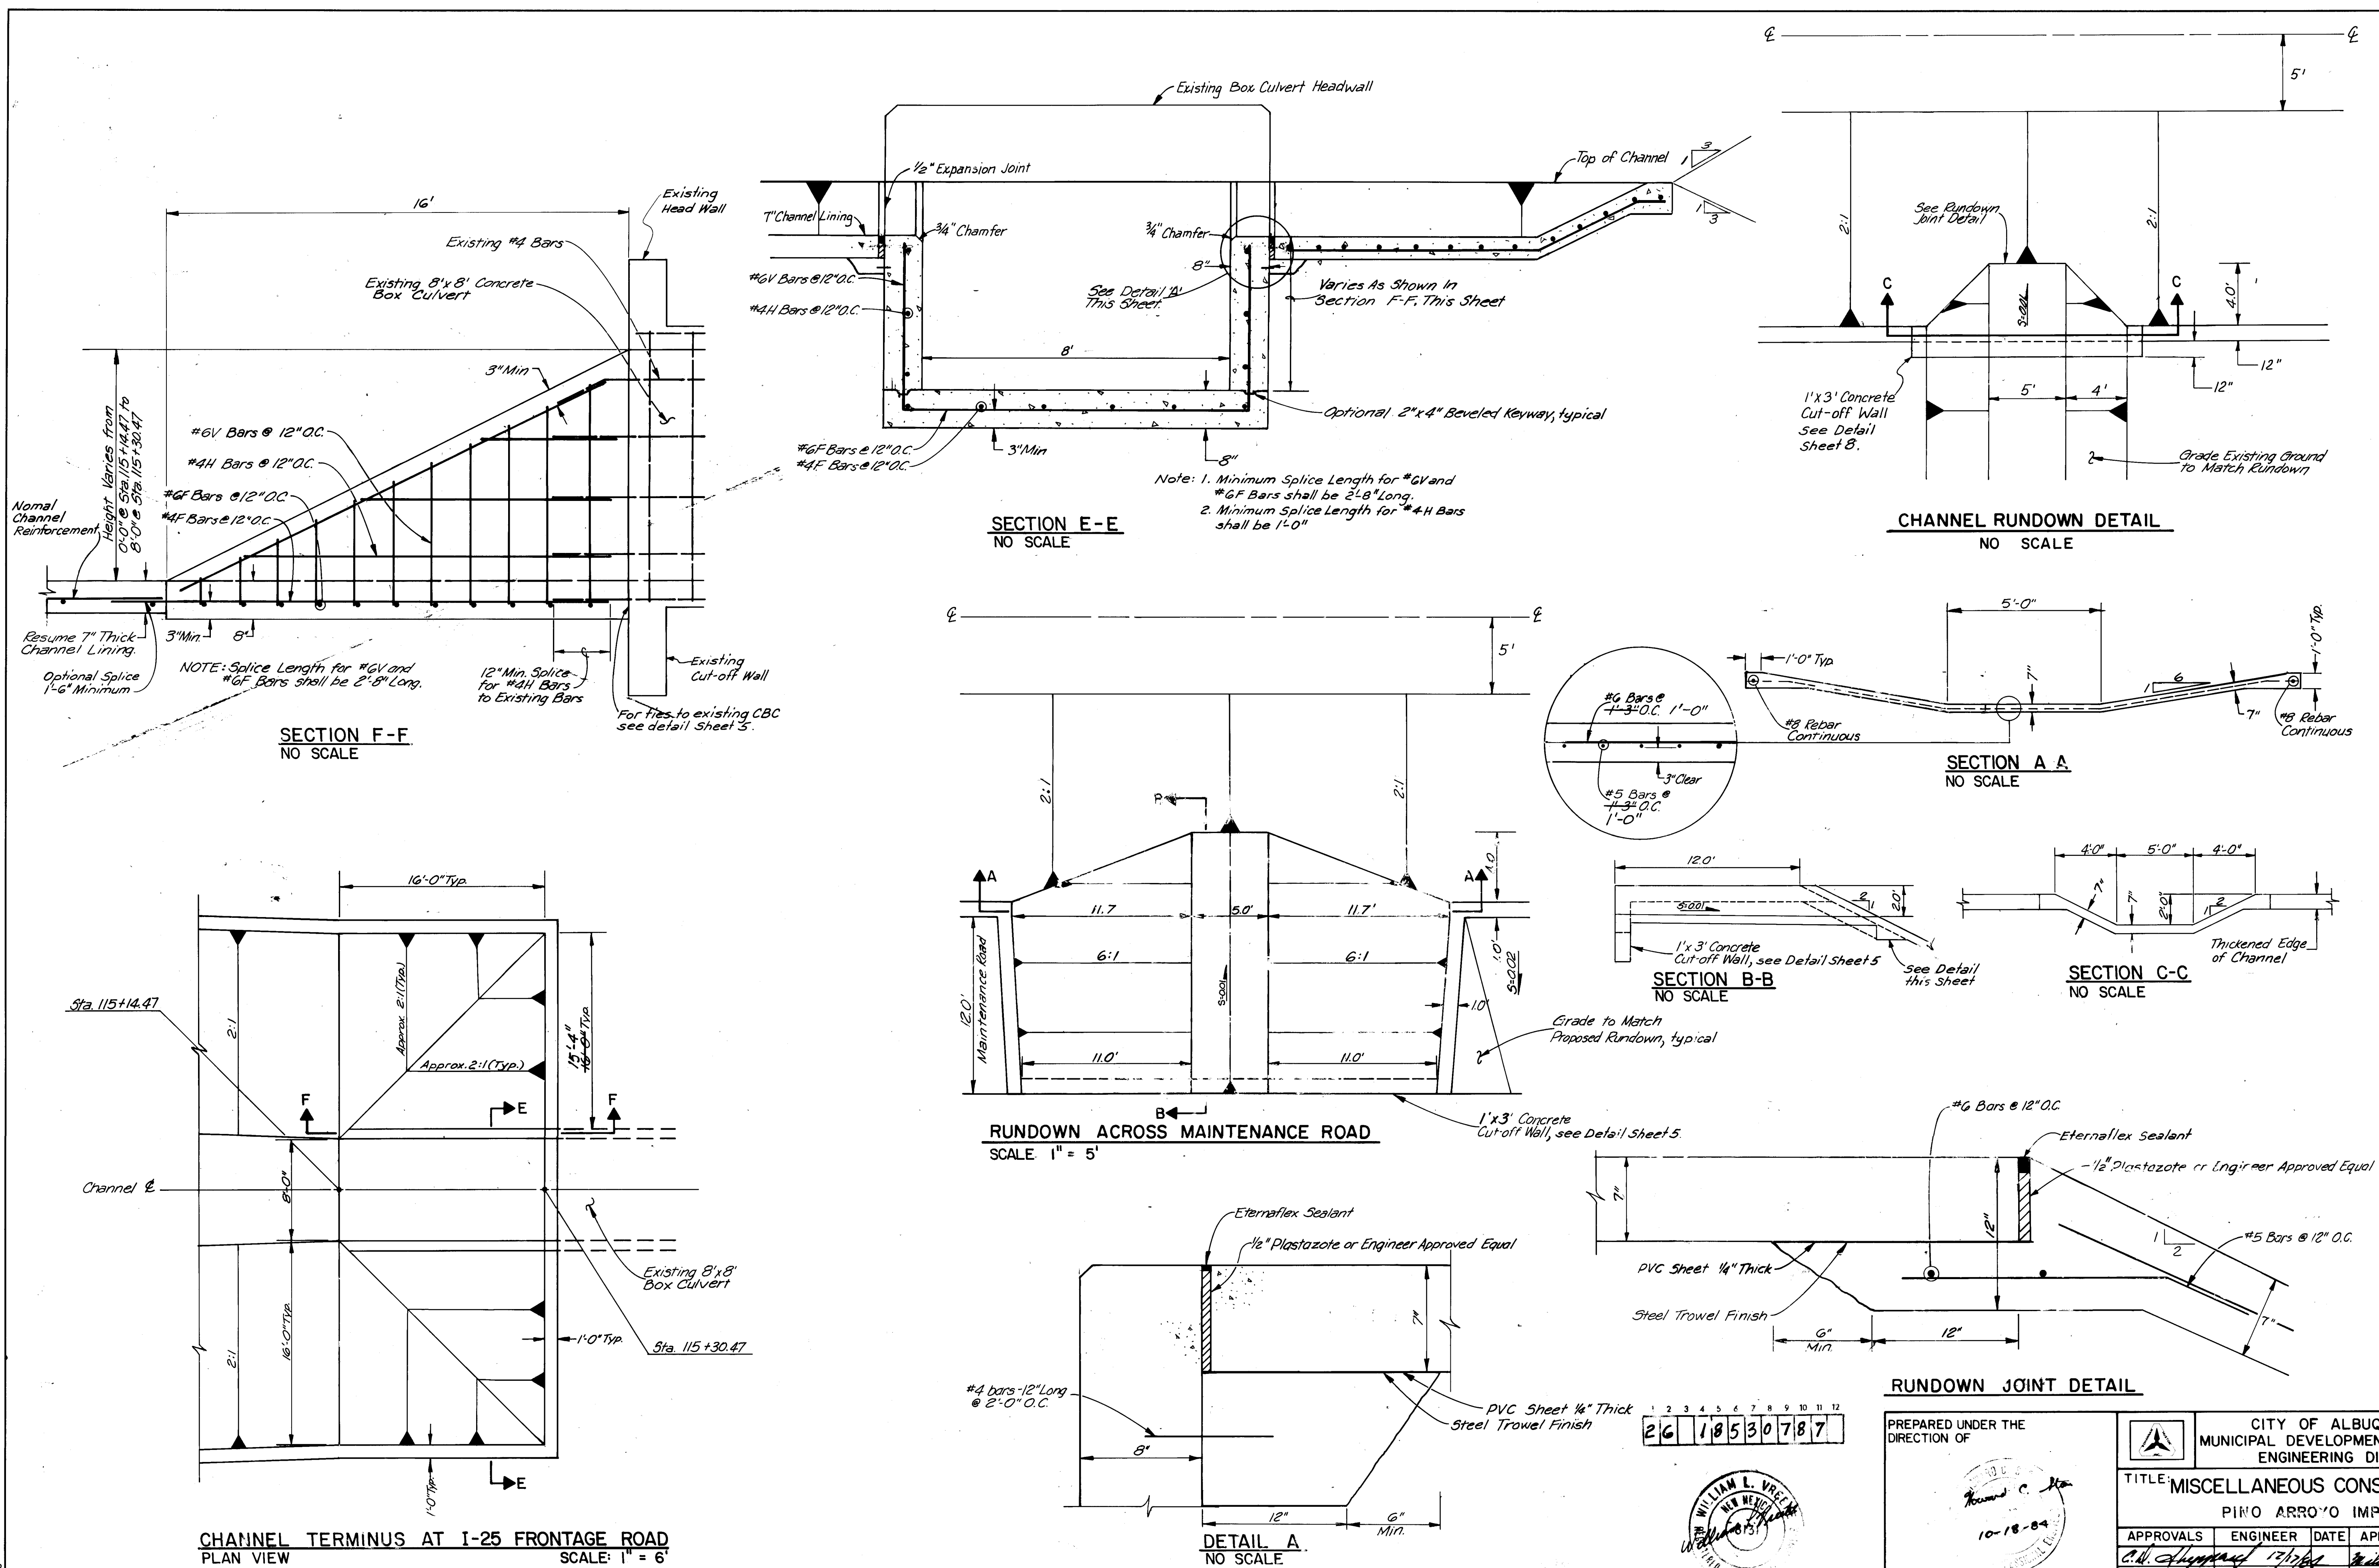

AS-BUILT INFORMATION				BENCH MARKS				SURVEY INFORMATION				REFERENCES				REVISIONS			
CONTRACTOR	K.A.C. Inc.	WORK	BY	DATE	DATE	DATE	DATE	MAP NO.	E-17-Z	EST. NO.	W.O. NO.	MAP NO.	E-17-Z	EST. NO.	W.O. NO.	NO.	DATE	DESIGN	DATE
INSPECTOR	By	DATE	DATE	DATE	DATE	DATE	DATE											DESIGNED BY	DATE
ACCEPTANCE	By	DATE	DATE	DATE	DATE	DATE	DATE											DRAWN BY	DATE
VERIFICATION	By	DATE	DATE	DATE	DATE	DATE	DATE											CHECKED BY	DATE
MICRO-FILM INFORMATION				RECORDED BY				NO.				DATE				NO.			

RECORD DRAWINGS

DATE 2-26-86

JOB No. 20596

SCALE: AS SHOWN

WILLIAM L. VREEL

26 18530787

PREPARED UNDER THE DIRECTION OF

CITY OF ALBUQUERQUE
MUNICIPAL DEVELOPMENT DEPARTMENT
ENGINEERING DIVISION

TITLE: MISCELLANEOUS CONSTRUCTION DETAILS
PINO ARROYO IMPROVEMENTS

APPROVALS	ENGINEER	DATE	APPROVALS	ENGINEER	DATE

APPROVED FOR CONSTRUCTION

DRAWING NO. 1853

CITY ENGINEER

DATE

DESIGNED BY KRU:HCS DATE 6/83

DRAWN BY PE DATE 6/83

CHECKED BY HCS DATE 10/84

SHEET 7 OF 16

[illegible]

1. Distances Lt. & Rt. from C are to inside face of vertical wall.
2. All wall height transitions are linear with respect to channel C Profile Elevations.
3. For Retaining Wall Details, See Sheet 12.



CONSTRUCTION DETAILS									
MOVEMENTS									
APPROVALS			ENGINEER			DATE			
<i>for Resources</i> <i>for Resources</i>			<i>William Babel</i> <i>SA Du H</i>			<i>12/12/10</i> <i>12/16/10</i> <i>12/21/10</i>			
SHEET			8			OF			16

26 18530887

PREPARED UNDER THE
DIRECTION OF

Howard C. Stott
10-18-84

	CITY OF ALBUQUERQUE MUNICIPAL DEVELOPMENT DEPARTMENT ENGINEERING DIVISION	
---	---	---

TITLE: MISCELLANEOUS CONSTRUCTION DETAILS
PINO ARROYO IMPROVEMENTS

APPROVALS	ENGINEER	DATE	APPROVALS	ENGINEER	DATE
<i>C. J. Shaffer</i>	<i>12/17/84</i>		Water Resources	<i>William Rabel</i>	<i>12/18/84</i>
ACE-D	<i>H. J. Olson</i>	<i>12/18/84</i>	Traffic	<i>J. A. Dowd</i>	<i>12/18/84</i>

THE Hydrology	Na Hagen	12/19/04	Water Resources	William Bahl	12/12/04
DRAWING NO. 1853			SHEET 8 OF 16		

JOB No. 20596
SCALE:
AS SHOWN

APPROVED FOR CONSTRUCTION

CITY ENGINEER _____ DATE _____

DRAWING NO.	1853	SHEET	8	OF	16
-------------	------	-------	---	----	----



1	2	3	4	5	6	7	8	9	10	11	1
26		1	8	5	3	0	9	8	7		



REC'D DRAWING
DATE 2-26-86

PREPARED UNDER THE DIRECTION OF	 CITY OF ALBUQUERQUE MUNICIPAL DEVELOPMENT DEPARTMENT ENGINEERING DIVISION																									
<i>Howard C. Stone</i> <i>10-18-89</i>																										
TITLE: MAINTENANCE VEHICLE RAMP DETAILS PINO ARROYO IMPROVEMENTS																										
<table border="1" style="width: 100%; border-collapse: collapse;"> <tr> <th style="width: 20%;">APPROVALS</th> <th style="width: 20%;">ENGINEER</th> <th style="width: 20%;">DATE</th> <th style="width: 20%;">APPROVALS</th> <th style="width: 20%;">ENGINEER</th> <th style="width: 20%;">DATE</th> </tr> <tr> <td>City Engineer</td> <td><i>Bill Chapman</i></td> <td><i>9/2/89</i></td> <td>liquid Waste</td> <td><i>William Baker</i></td> <td><i>12/1/89</i></td> </tr> <tr> <td>A.C.E.-Design</td> <td><i>Bill Chapman</i></td> <td><i>11/2/89</i></td> <td>Traffic</td> <td><i>ADP/WH</i></td> <td><i>12/1/89</i></td> </tr> <tr> <td>A.C.E.-Hydrology</td> <td><i>Don Hays</i></td> <td><i>11/2/89</i></td> <td>Water</td> <td><i>William Baker</i></td> <td><i>12/1/89</i></td> </tr> </table>			APPROVALS	ENGINEER	DATE	APPROVALS	ENGINEER	DATE	City Engineer	<i>Bill Chapman</i>	<i>9/2/89</i>	liquid Waste	<i>William Baker</i>	<i>12/1/89</i>	A.C.E.-Design	<i>Bill Chapman</i>	<i>11/2/89</i>	Traffic	<i>ADP/WH</i>	<i>12/1/89</i>	A.C.E.-Hydrology	<i>Don Hays</i>	<i>11/2/89</i>	Water	<i>William Baker</i>	<i>12/1/89</i>
APPROVALS	ENGINEER	DATE	APPROVALS	ENGINEER	DATE																					
City Engineer	<i>Bill Chapman</i>	<i>9/2/89</i>	liquid Waste	<i>William Baker</i>	<i>12/1/89</i>																					
A.C.E.-Design	<i>Bill Chapman</i>	<i>11/2/89</i>	Traffic	<i>ADP/WH</i>	<i>12/1/89</i>																					
A.C.E.-Hydrology	<i>Don Hays</i>	<i>11/2/89</i>	Water	<i>William Baker</i>	<i>12/1/89</i>																					
APPROVED FOR CONSTRUCTION																										
<table style="width: 100%;"> <tr> <td style="width: 40%;">DRAWING NO.</td> <td style="width: 40%; text-align: center; font-size: 1.5em;">1853</td> <td style="width: 20%; text-align: right;">SHEET 9 OF 16</td> </tr> <tr> <td>CITY ENGINEER</td> <td>DATE</td> <td></td> </tr> </table>			DRAWING NO.	1853	SHEET 9 OF 16	CITY ENGINEER	DATE																			
DRAWING NO.	1853	SHEET 9 OF 16																								
CITY ENGINEER	DATE																									

[illegible]

BAR DETAILS

j-bars same size as d bars.
 k-bars " " " e bars.
 R Place this end in sidewall.

j H + 1'-9" H+4'-0" Long
 k 4'-6" 6'-9" Long
 l Place this end in sidewall. R = 3/4 bar dia. for
 3/8 to 7/8
 R = 4/8 bar dia. for
 8# to 11#

X

Diagram showing a 12" Rad. pipe section. The top dimension is 12" Rad. The bottom dimension is 12" dia. The side dimension is 6'-3" Long. The pipe is labeled c3&c4 bars.

4# h 2'-1 1/2" 6'-3" Long
 4# g 2'-8 1/2" 7'-6" "

c3&c4 bars

Place this end in center wall.
 R = 3 bar dia.

12" bar dia.

NUMBER OF BARS REQUIRED

a2, b2, c2, d & e bars : $24L \div \text{Spacing}$.

a1, b1, m & n bars : $12L \div \text{Spacing}$


p bars : 12 for cutoff & parapet at each end

c1, c3 & c4 bars : $(24L \div \text{Spa})$ plus 2 at each end

j & k bars : 4 of each for cutoff and parapet at each end.

Other bars : see table.

L = Length of Barrel in feet.

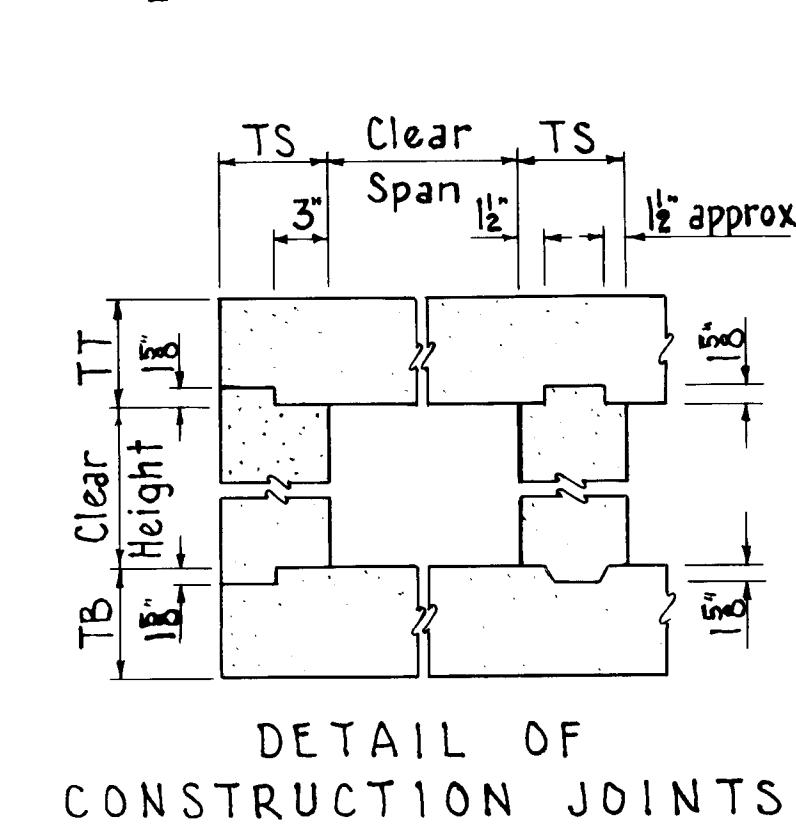

- G E N E R A L N O T E S**

 1. Workmanship and materials shall conform to New Mexico State Highway Commission Specifications.
 2. All concrete to be Class "A". Chamfer all exposed edges $\frac{3}{4}$ inch except as noted.
 3. All reinforcing bars shall conform to ASTM Specifications A615, Grade 40.
All dimensions refer to $\pm$ of bar.
 4. T-bars may be spliced, when necessary, by lapping at least 20 bar diameters. Pay weight for reinforcing steel does not include splices. Cost of splice material to be included in unit price bid for reinforcing steel.
 5. Volume of concrete = (L) x (concrete quantity per lin. ft.) plus concrete at ends.
 6. Weight of reinforcing steel = (L) x (wt. of reinf. steel/lin. ft.) plus weight at ends.
 7. Place T_a-bars on a-bars and T_b-bars under b-bars, spaced as shown in the table. The remaining T_a- and T_b-bars are to be placed adjacent to d-, e-, m- and n-bars, as indicated in Section A-A.
 8. Place T_c-bars next to cl bars, spaced as shown in the table. The remaining T_c-bars to be placed in sidewall next to c2, d- & e- bars. When cl bars are not required place all T_s bars next to c2, d- and e- bars.
 9. "Cover" is height of fill from top of box to finished grade.
 10. Extend T_s bars in sidewalls and T_b bars in bottom a minimum of 1'-8" into vertical wall channel.

D E S I G N D A T A

Design according to A.A.S.H.O. Specifications, 1957.

Live Load: H20-S16-44 & Interstate Alternate Loading

Weight of fill on top of box: 84 #/cu. ft.

Horizontal Earth Pressure = 30 #/cu. ft., 2' surcharge.

Design Stresses: f_c = 3000 p.s.i., f_t = 1200 psi.
f_s = 20000 p.s.i., n = 10.


26 18531087

NEW MEXICO






D E S I G N D A T A

Design according to A.A.S.H.O. Specifications, 1957.
Live Load: H20-S16-44 & Interstate Alternate Loading
Weight of fill on top of box: 84#/cu. ft.
Horizontal Earth Pressure = 30#/cu. ft, 2' surcharge.
Design Stresses: $f_c = 3000$ p.s.i., $f_t = 1200$ psi.
 $f_s = 20,000$ p.s.i., $n = 10$.


NEW MEXICO
STATE HIGHWAY DEPARTMENT
CONCRETE BOX CULVERT BARRELS
DOUBLE OPENING ~ NORMAL
DESIGN NO. 1
0 TO 5' COVER
Sheet 1 of 4
1853 SERIAL CB-35

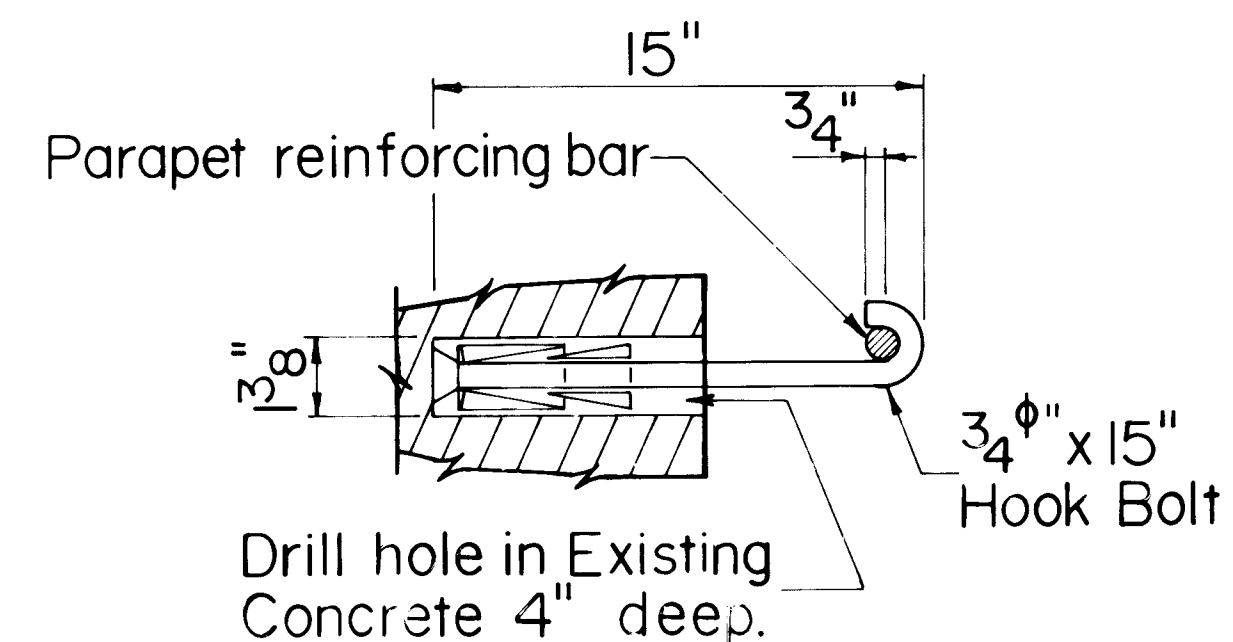

DETAIL OF EXPANSION HOOK BOLT

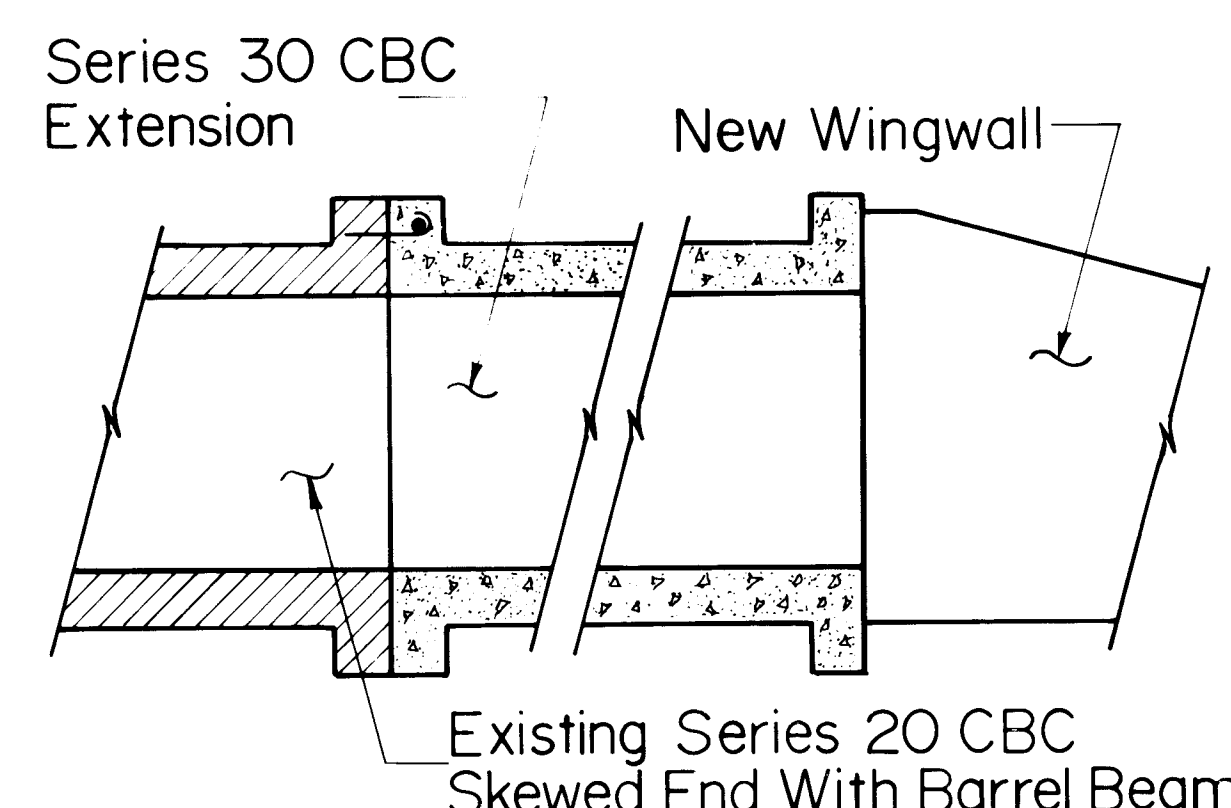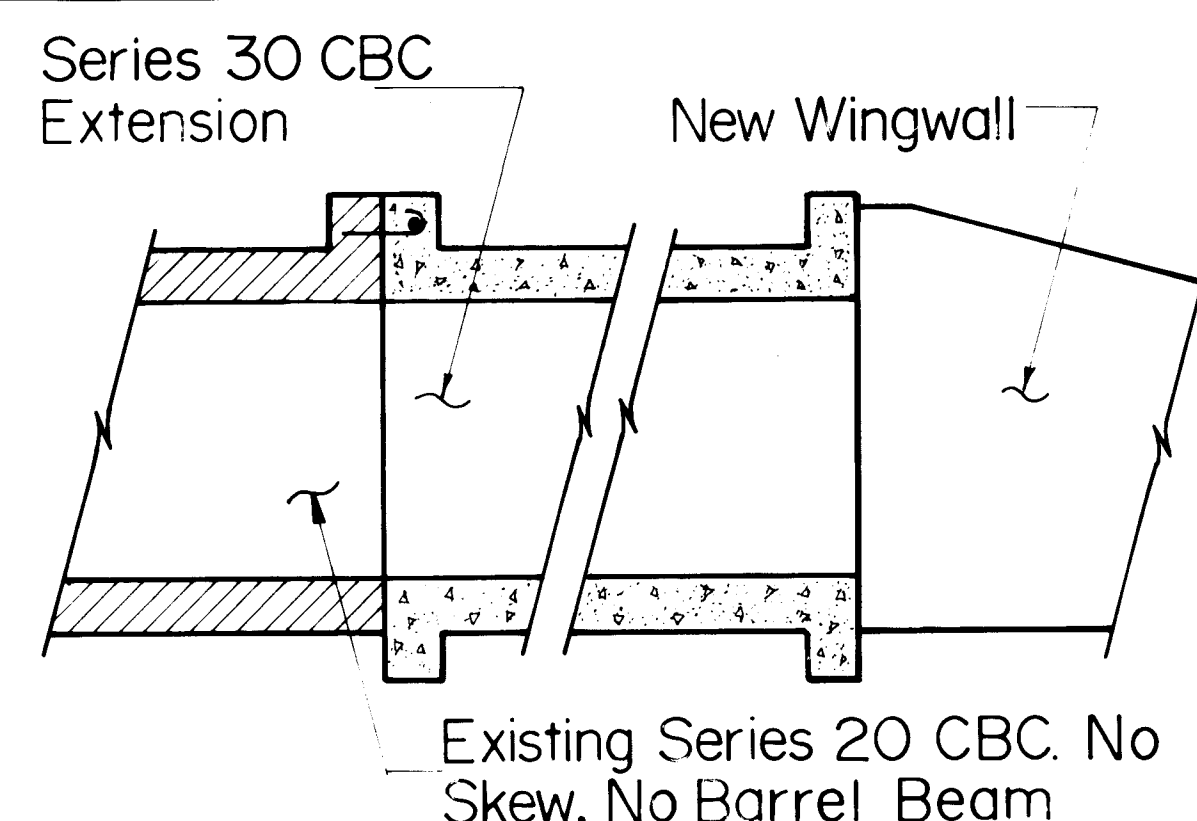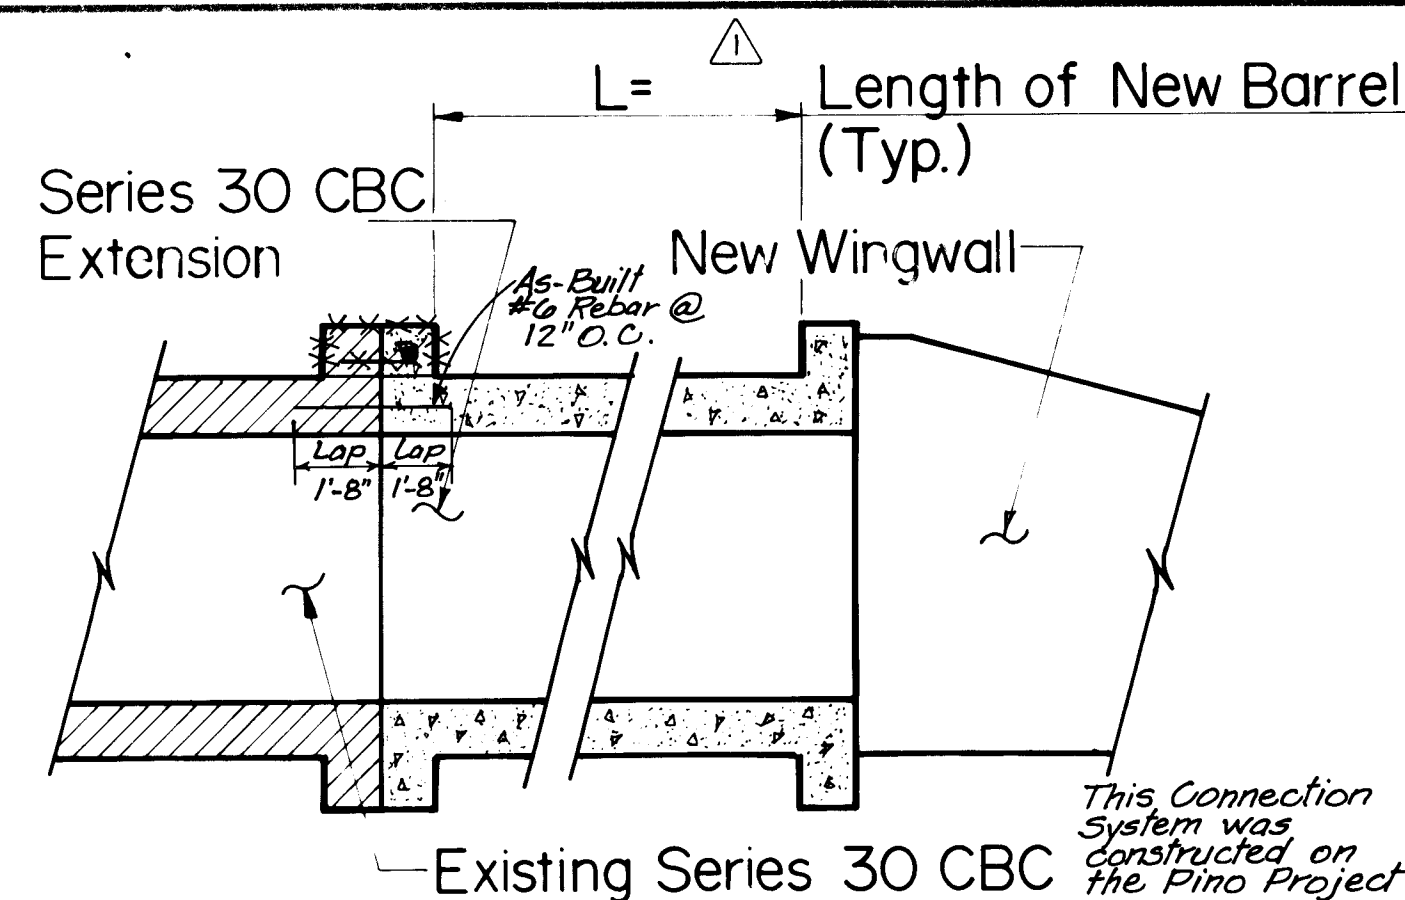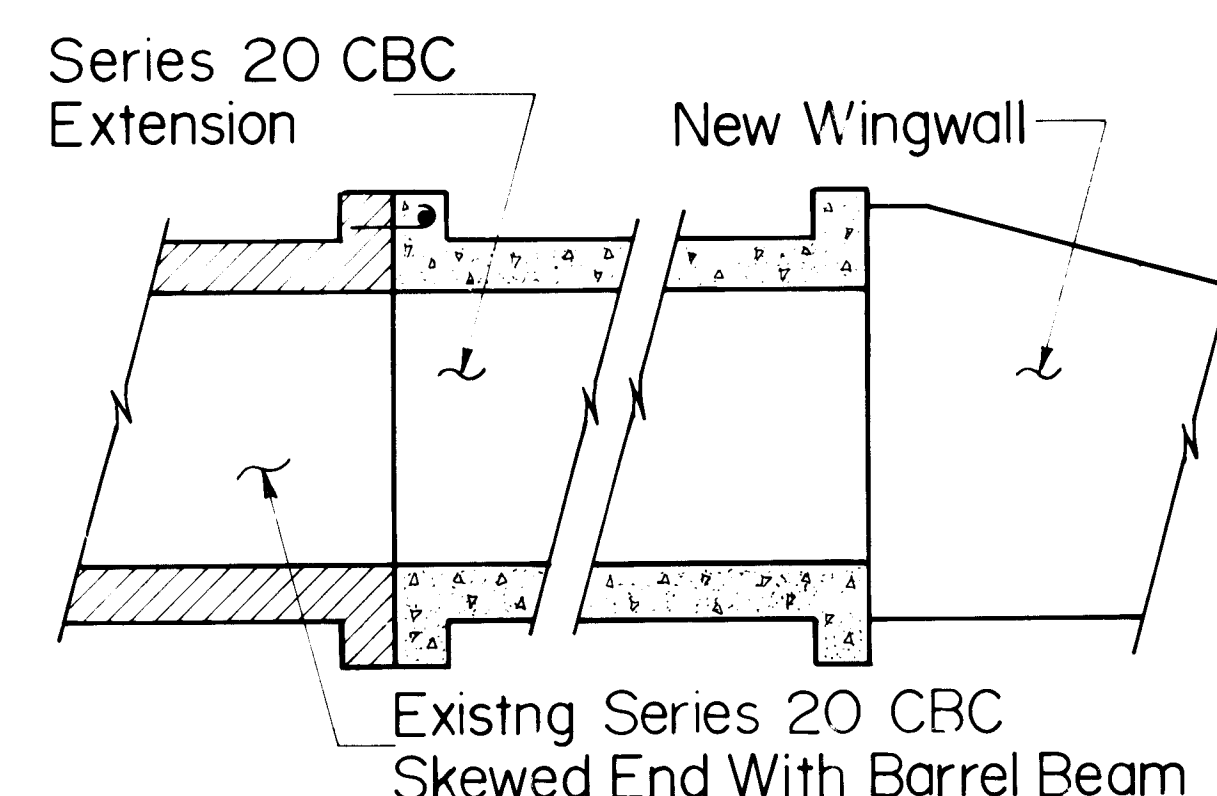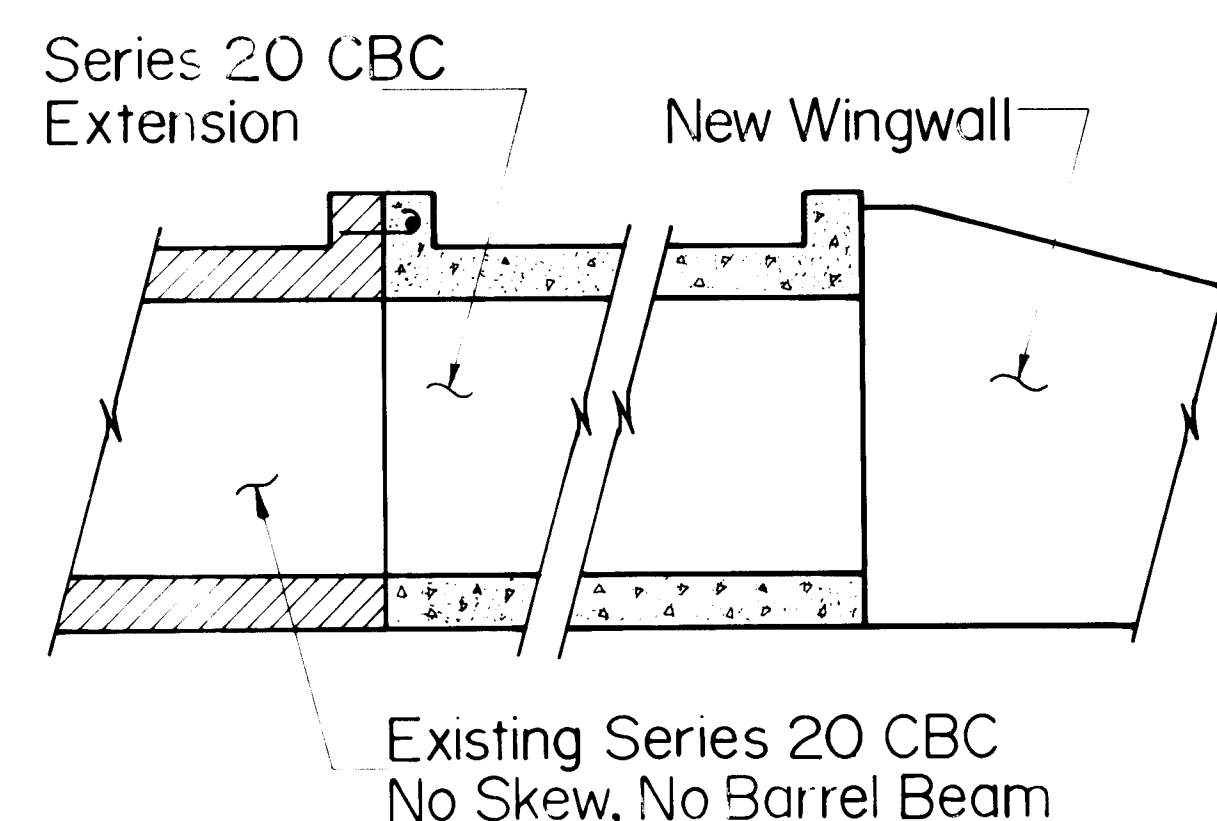


TYPE I CBC EXTENSIONS

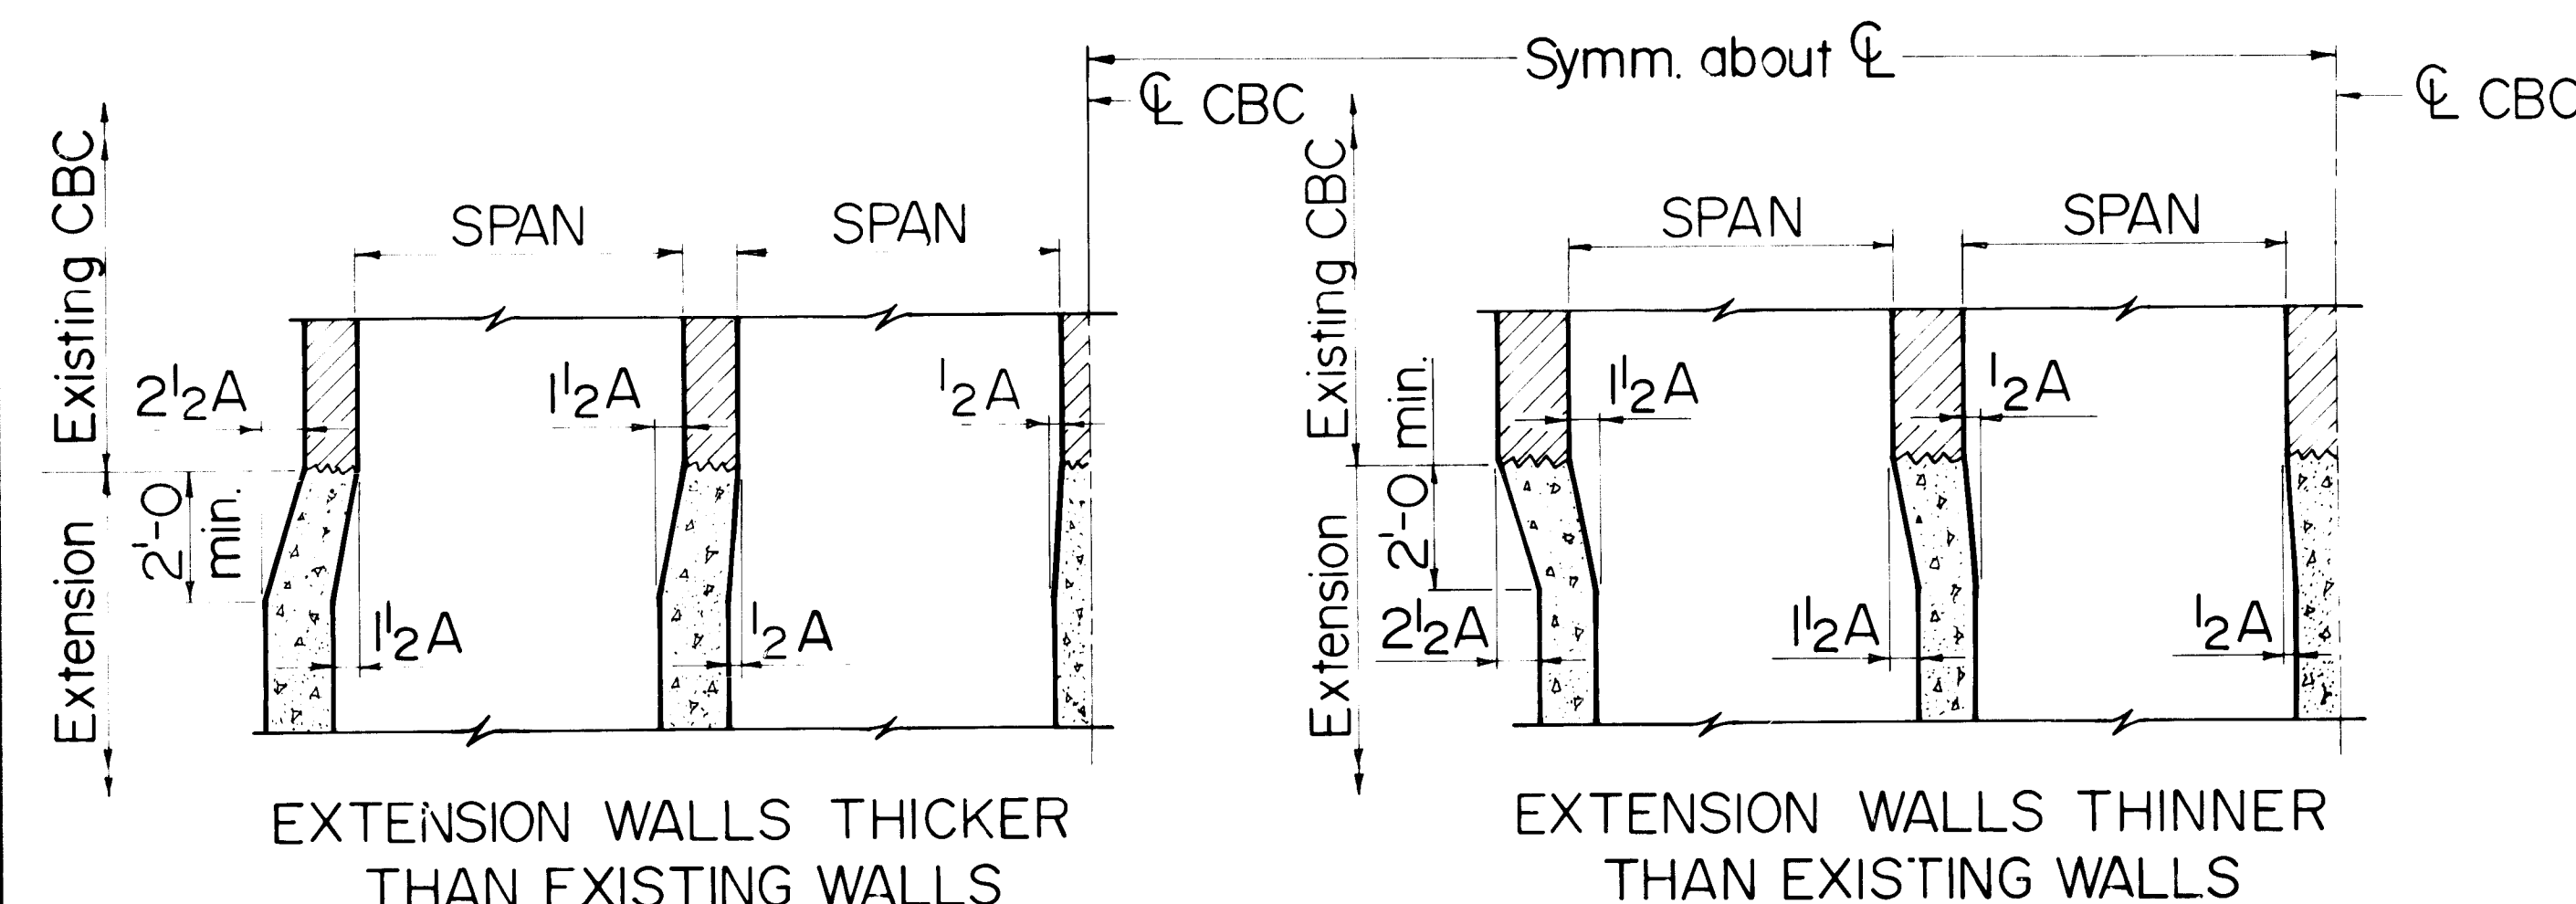


CBC WITH EVEN NUMBER OF OPENINGS

CBC WITH ODD NUMBER OF OPENINGS

WALL TRANSITION DETAILS

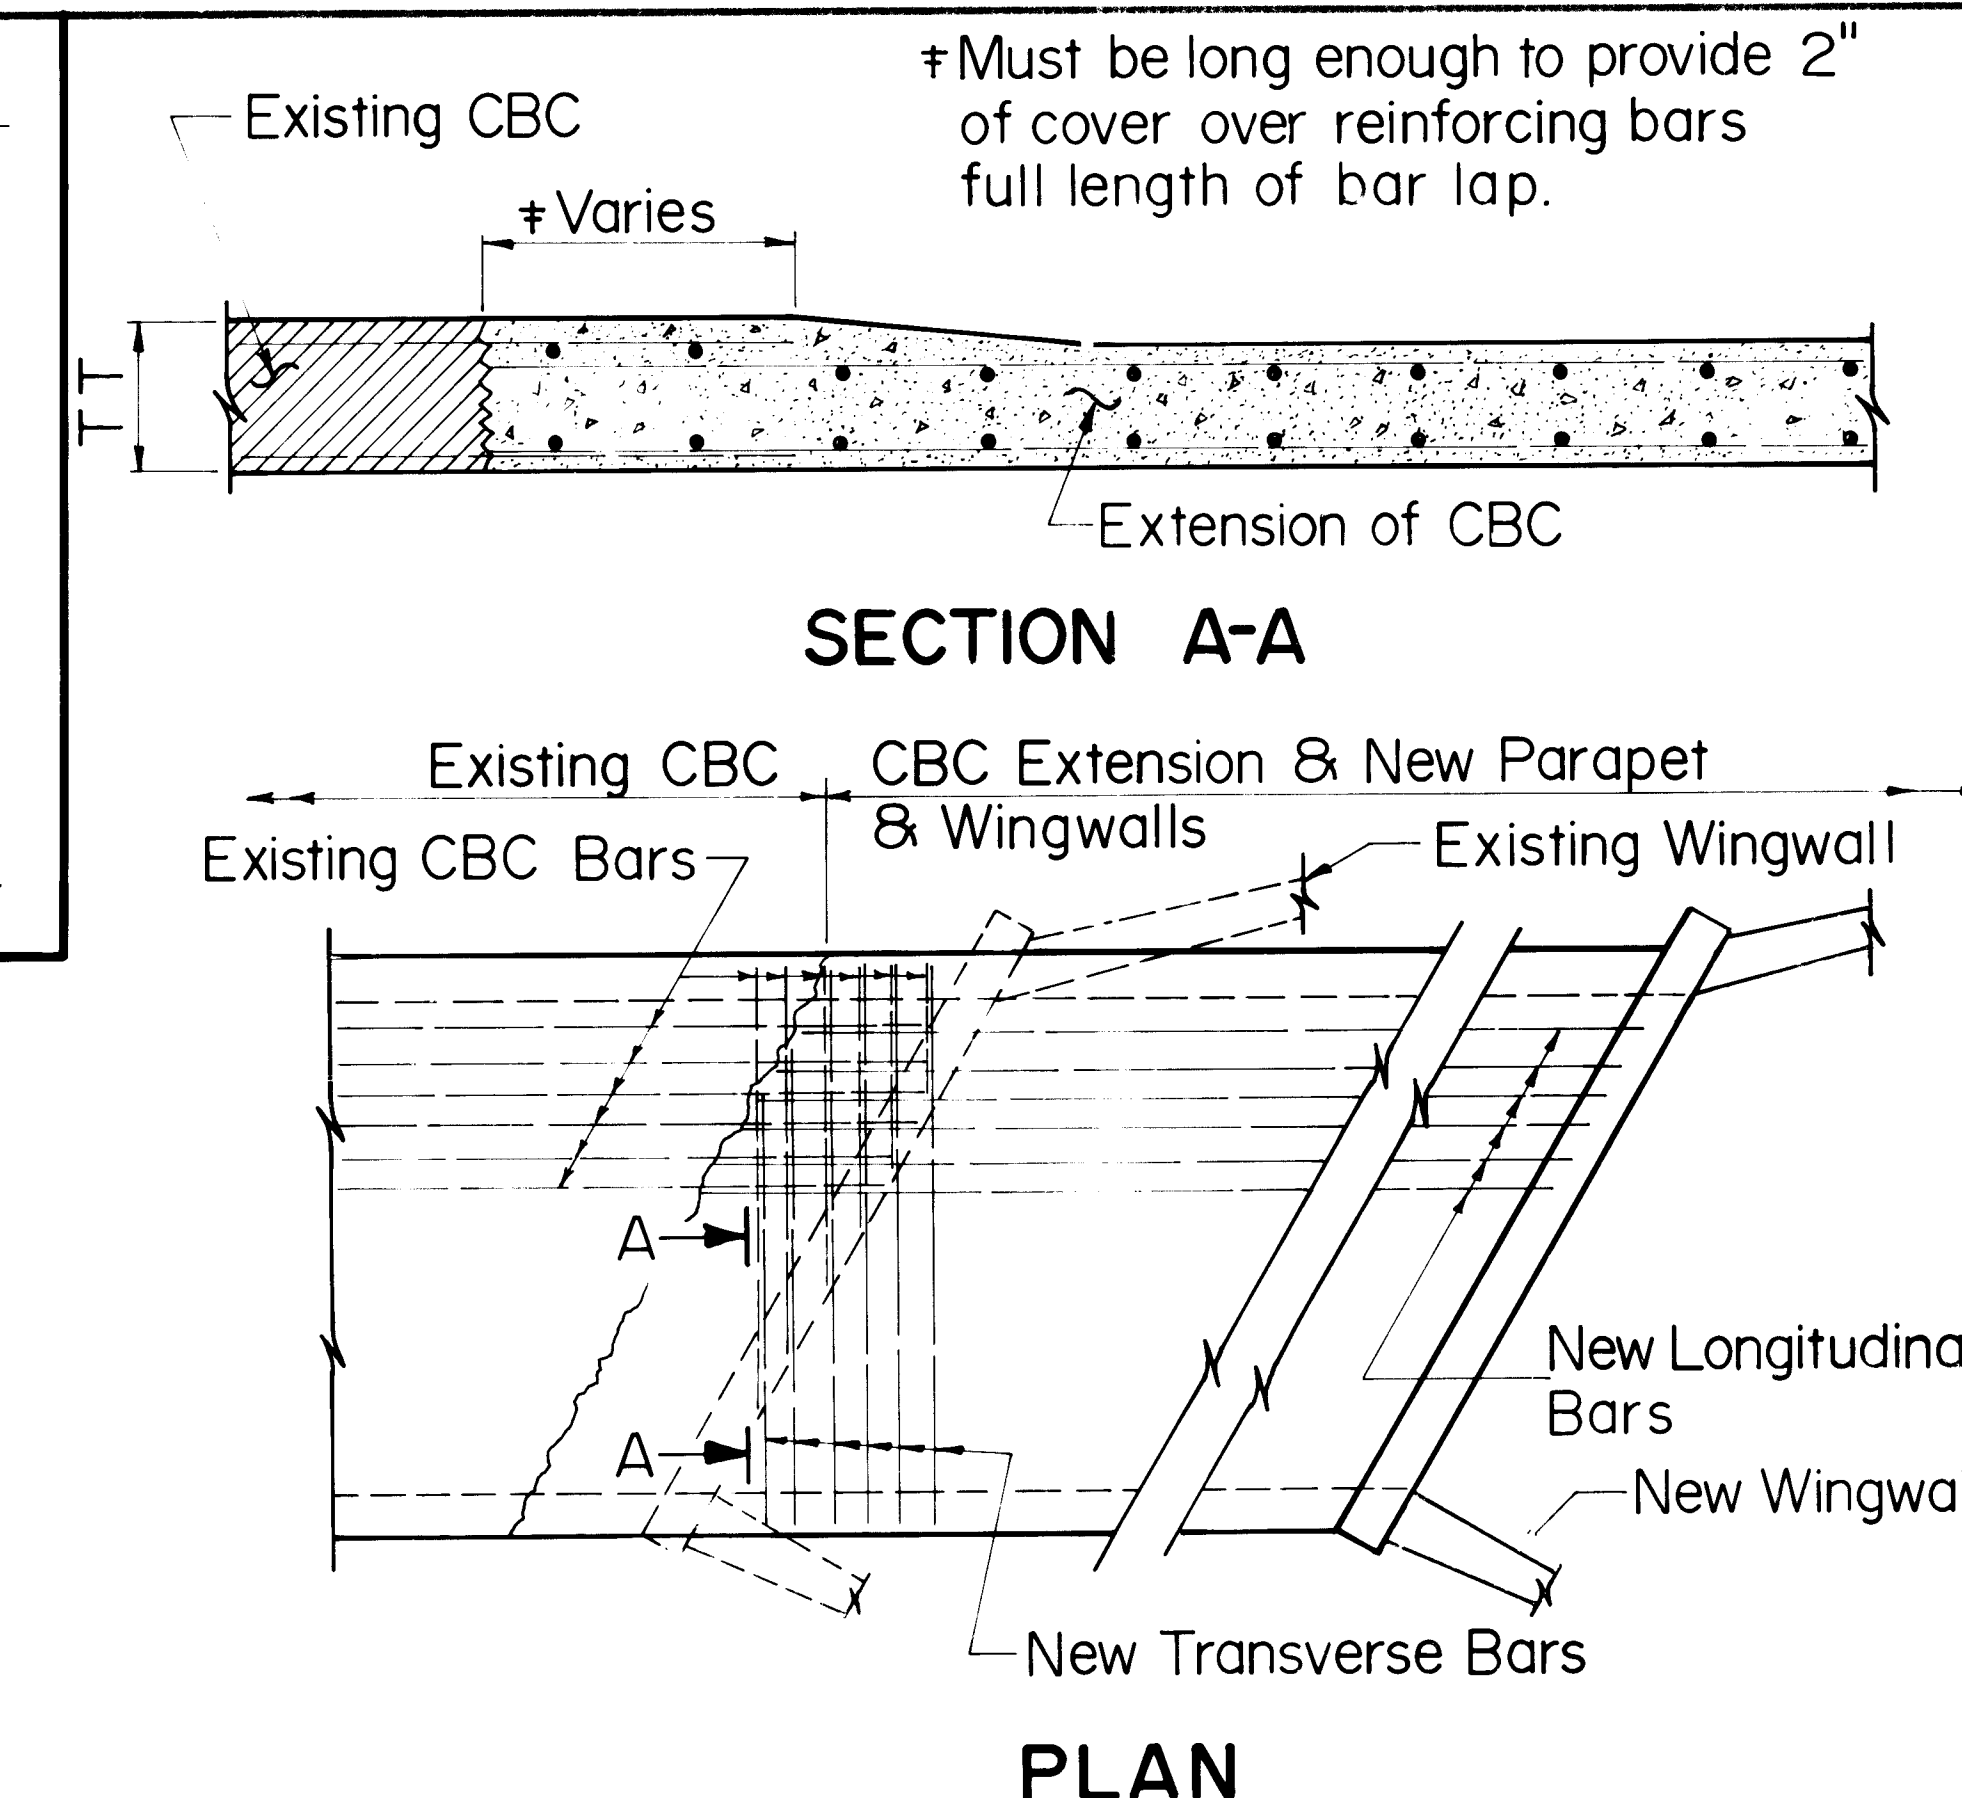


SECTION A-A

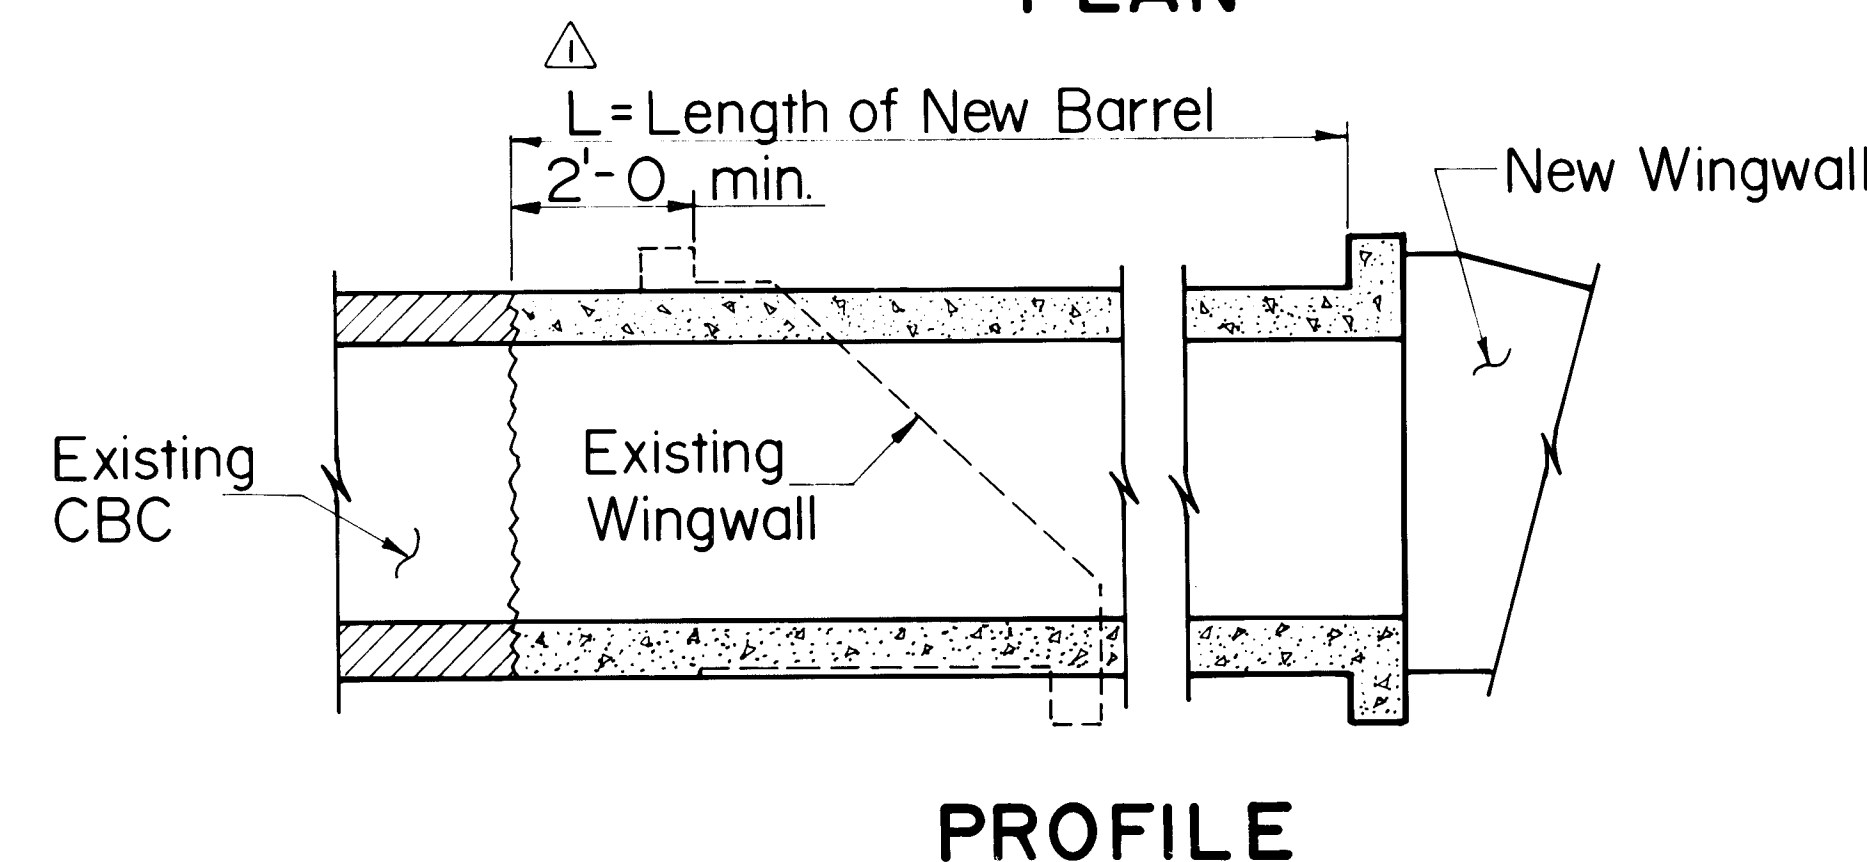

PROFILE

TYPE II CBC EXTENSIONS


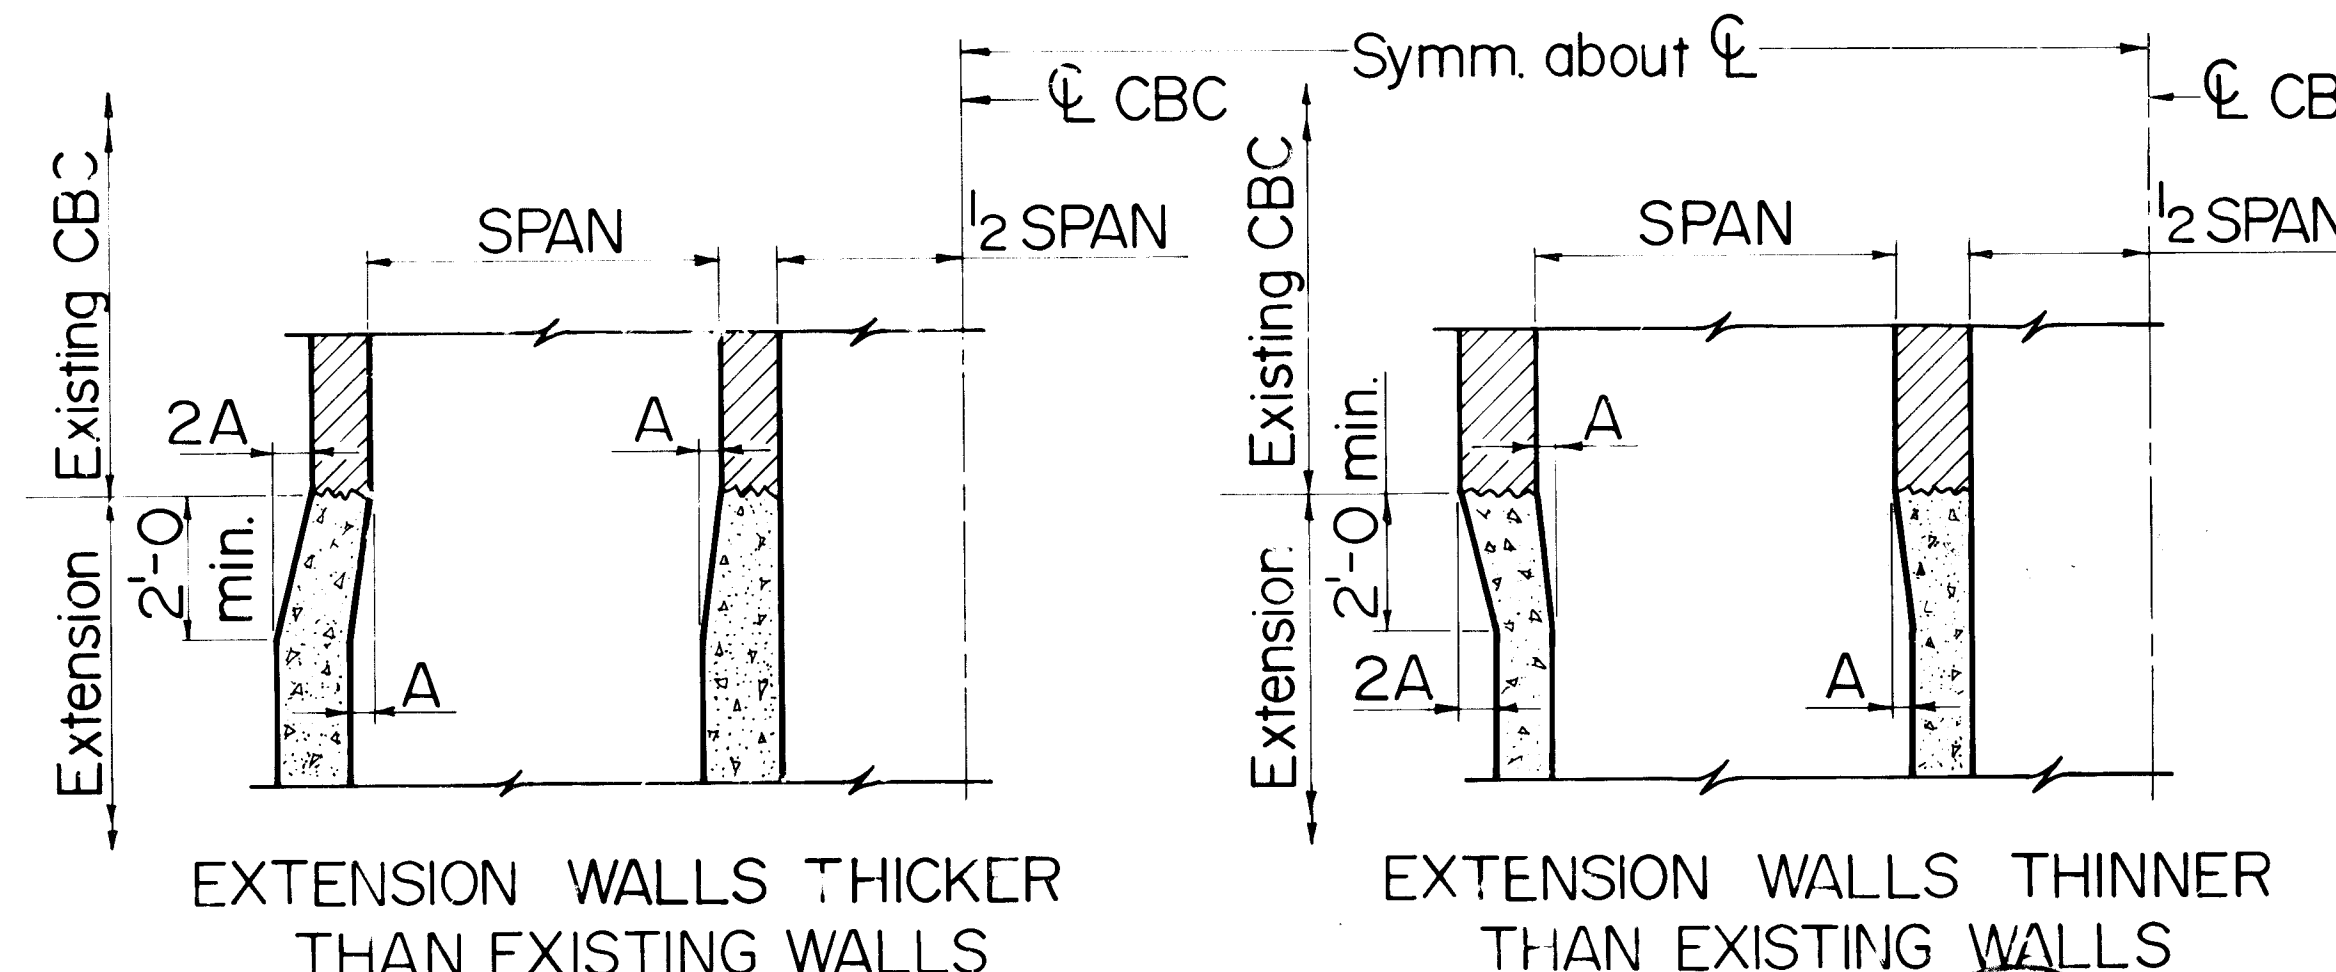


GENERAL NOTES

1. Series 20 Type I CBC Extension is to be used when the span and rise of the Existing Series 20 CBC does not match any Series 30 CBC shown in the standards.
2. Remove wings and aprons (where present) from the existing CBC. Longitudinal bars exposed by removal of existing concrete are to be cleaned and straightened and bonded into CBC extension.
3. Hook bolts to be installed in existing parapet only of Type I CBC extensions (not in vertical walls or bottom slab) spaced at 1'-0" centers.
4. For Type II CBC Extension remove enough of existing CBC concrete to expose the larger of 2'-0" of longitudinal steel or a minimum length of transverse reinforcing near mid-span equal to the following:
 - #4 bars ~ 12"
 - #5 bars ~ 14"
 - #6 bars ~ 19"
 - #7 bars ~ 26"
 - #8 bars ~ 33"
 - #9 bars ~ 41"
5. There will not be a parapet or a cut off wall at the connection of the existing and the extended Type II CBC; the reinforcing for a parapet and cutoff wall can be omitted at the connection end of CBC. For estimated quantities the extended barrel length will be based on removing a minimum 2'-0" of existing CBC. Pay quantities will be based on the actual removal.
6. Cost of Expansion Bolts is incidental to the completion of the work and no measurement or payment will be made therefor.

FHWA	STATE	SHEET	TOTAL
Region No.	6	NO.	SHEETS

ADDED "L" DIMENSION		2-12-80 E.R.D.
REVISIONS		DATE
NEW MEXICO		
STATE HIGHWAY DEPARTMENT		
CONCRETE BOX		
CULVERT EXTENSION		
DESIGNED BY J.D.G.	APPROVAL	DATE
DRAWN BY A.J.S.	RECOMMENDED	BRIDGE ENGINEER
CHECKED BY E.R.D.	APPROVED	DIRECTOR PROJ. DEVELOPMENT DIVISION
SERIAL RCE-001-01		1853

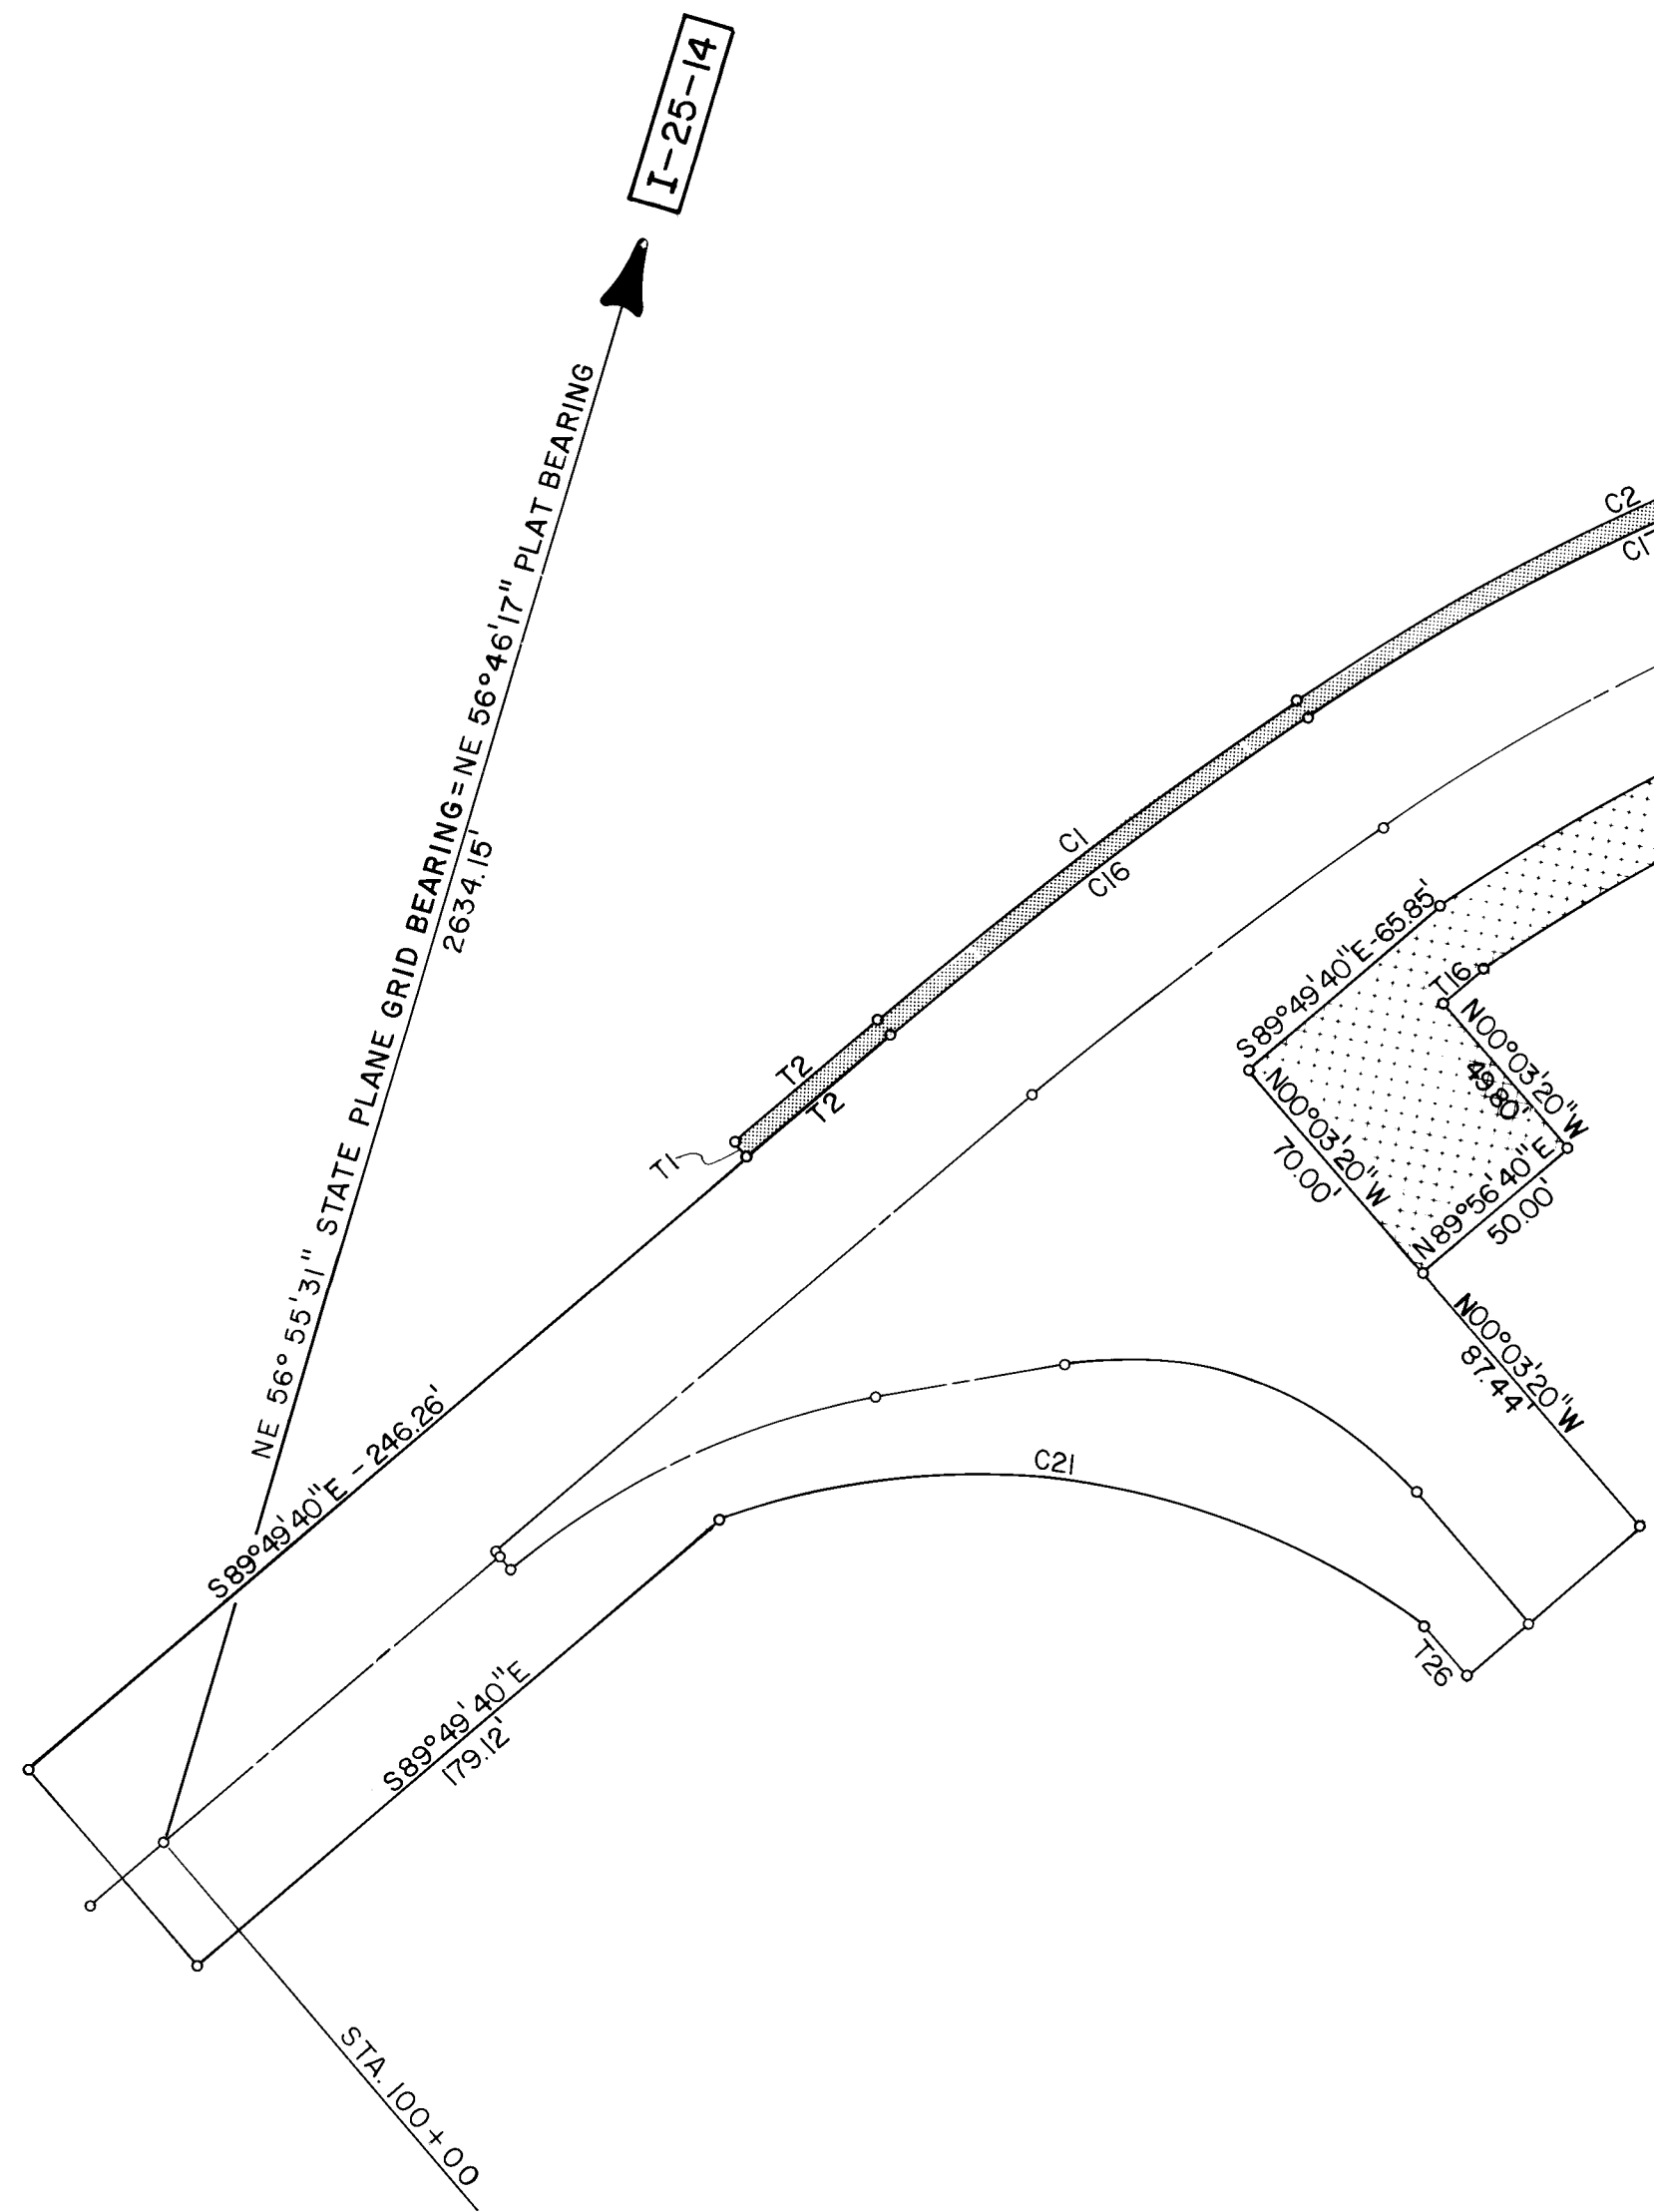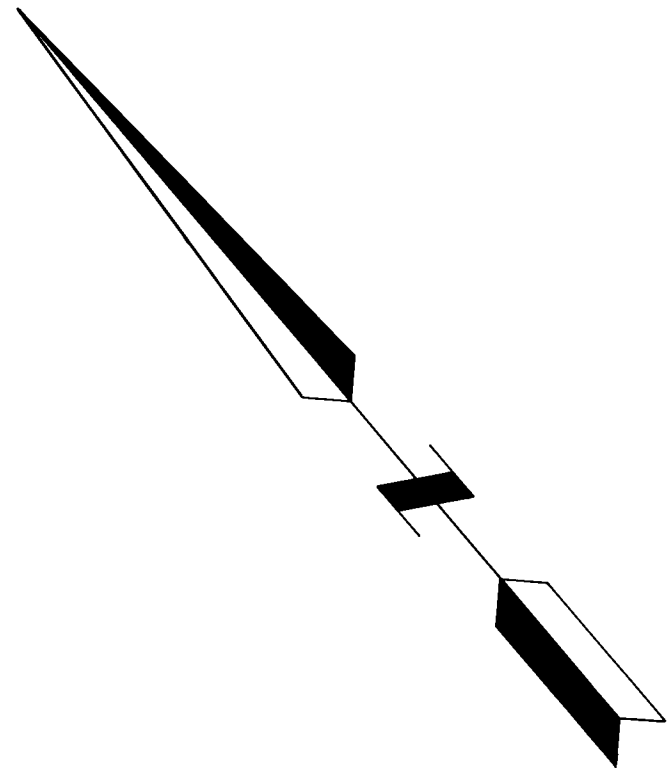

TANGENT DATA		
NR.	DISTANCE	BEARING
T1	5.00'	N00°10'20"E
T2	48.91'	S89°49'40"E
T3	25.88'	S85°14'09"E
T4	4.96'	N00°34'10"E
T5	10.16'	N09°31'34"W
T6	10.65'	N09°31'34"W
T7	30.67'	S79°25'16"E
T8	5.00'	N02°37'49"E
T9	5.00'	N00°34'10"E
T10	25.00'	N00°34'10"E
T11	35.00'	S89°25'50"E
T12	30.00'	N00°34'10"E
T13	5.66'	S89°25'24"E
T14	23.16'	N00°03'26"W
T15	5.71'	S00°03'57"E
T16	14.14'	N89°56'40"E
T17	36.14'	N78°08'57"E
T18	67.07'	S89°25'50"E
T19	38.16'	S75°47'20"E
T20	10.00'	N00°34'10"E
T21	10.02'	N03°54'42"E
T22	27.01'	S79°25'16"E
T23	63.35'	S89°49'40"E
T24	2.91'	S27°40'23"W
T25	4.64'	S59°57'24"E
T26	17.26'	S00°03'20"E

CURVE DATA				
NR.	RADIUS	ARC	CHORD	DELTA
C1	1235.35'	137.72'	137.65'	06°23'15"
C2	640.00'	196.67'	195.89'	17°36'24"
C3	1160.00'	94.47'	94.44'	04°39'58"
C4	560.00'	172.08'	171.41'	17°36'24"
C5	1160.00'	111.93'	111.88'	05°31'42"
C6	565.00'	78.38'	78.32'	07°56'55"
C7	570.00'	20.50'	20.50'	02°03'39"
C8	1225.00'	128.07'	128.02'	05°59'25"
C9	625.00'	112.30'	112.15'	10°17'41"
C10	1225.00'	64.18'	64.17'	03°00'07"
C11	625.00'	79.76'	79.71'	07°18'42"
C12	1225.00'	63.89'	63.89'	02°59'18"
C13	1155.00'	127.77'	127.70'	06°20'17"
C14	555.00'	169.21'	168.55'	17°28'05"
C15	575.00'	175.95'	175.26'	17°31'57"
C16	1230.35'	137.16'	137.09'	06°23'15"
C17	635.00'	195.13'	194.36'	17°36'24"
C18	1165.00'	121.80'	121.75'	05°59'25"
C19	565.00'	173.62'	172.94'	17°36'24"
C20	575.00'	100.45'	100.32'	10°00'34"
C21	192.00'	193.77'	185.65'	57°49'21"

KEY

- Permanent Drainage Easement
- Temporary Drainage Easement
- Permanent Access Easement
- Temporary Construction & Slope Easement

26 18531387

PREPARED UNDER THE
DIRECTION OF

Howard C. Stos
10-13-84

William L. Neale

JOB NO. 20596

SCALE: 1" = 50'

2-26-86

CITY OF ALBUQUERQUE
MUNICIPAL DEVELOPMENT DEPARTMENT
ENGINEERING DIVISION

TITLE
SURVEY
RIGHT OF WAY MAP
PINO ARROYO IMPROVEMENTS

APPROVALS	ENGINEER	DATE	APPROVALS	ENGINEER	DATE
<i>Ch. Chapman</i>	<i>10/13/84</i>	<i>Water Resources</i>	<i>William Neale</i>	<i>10/13/84</i>	
<i>CC-0</i>	<i>10/13/84</i>	<i>Water Resources</i>	<i>NR DWH</i>	<i>10/13/84</i>	











APPROVED FOR CONSTRUCTION

CITY ENGINEER DATE

DRAWING NO. 1853

SHEET 13 OF 16

REFERENCES			SURVEY INFORMATION			BENCH MARKS			AS-BUILT INFORMATION		
MAP NO.	EST NO.	W/O NO.	NO.	BY	DATE	I-25-14 - Brass Cap is located N.E. of intersection of the I-25 East Frontage Road and the NMHD District No. 3 Offices driveway. Elev. 5196.899	CONTRACTOR	K.N.C. Inc.	INSPECTOR	5/1/85	DATE
NO.	DATE	REMARKS	NO.	DATE	REVISIONS	DESIGN	NO.	DATE	NO.	DATE	DATE
DESIGNED BY	DATE	10-84	DRAWN BY	DATE	10-84	CHECKED BY	DATE	10-84	RECORDED BY	DATE	DATE

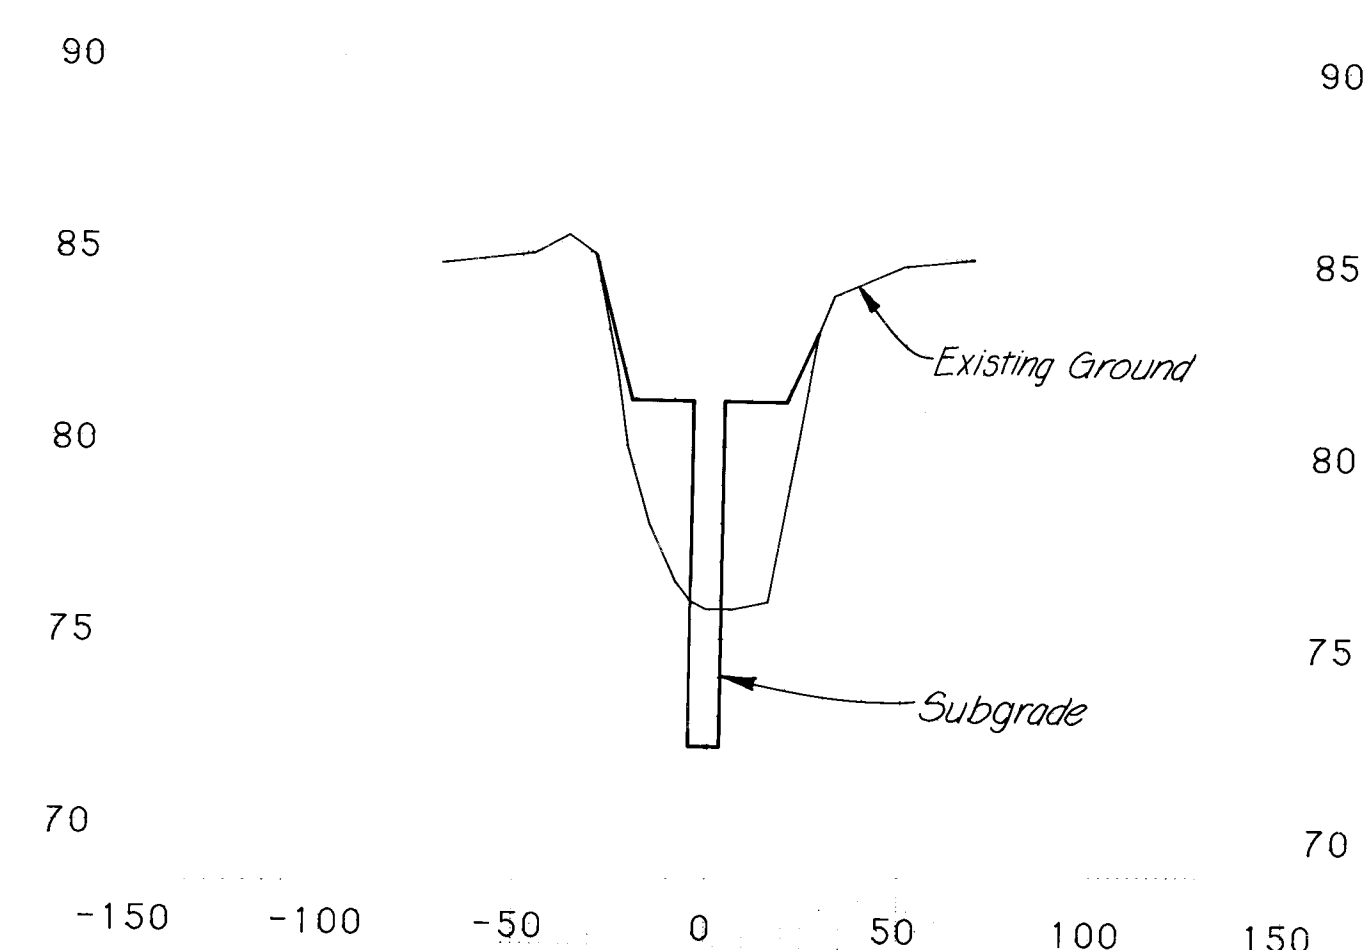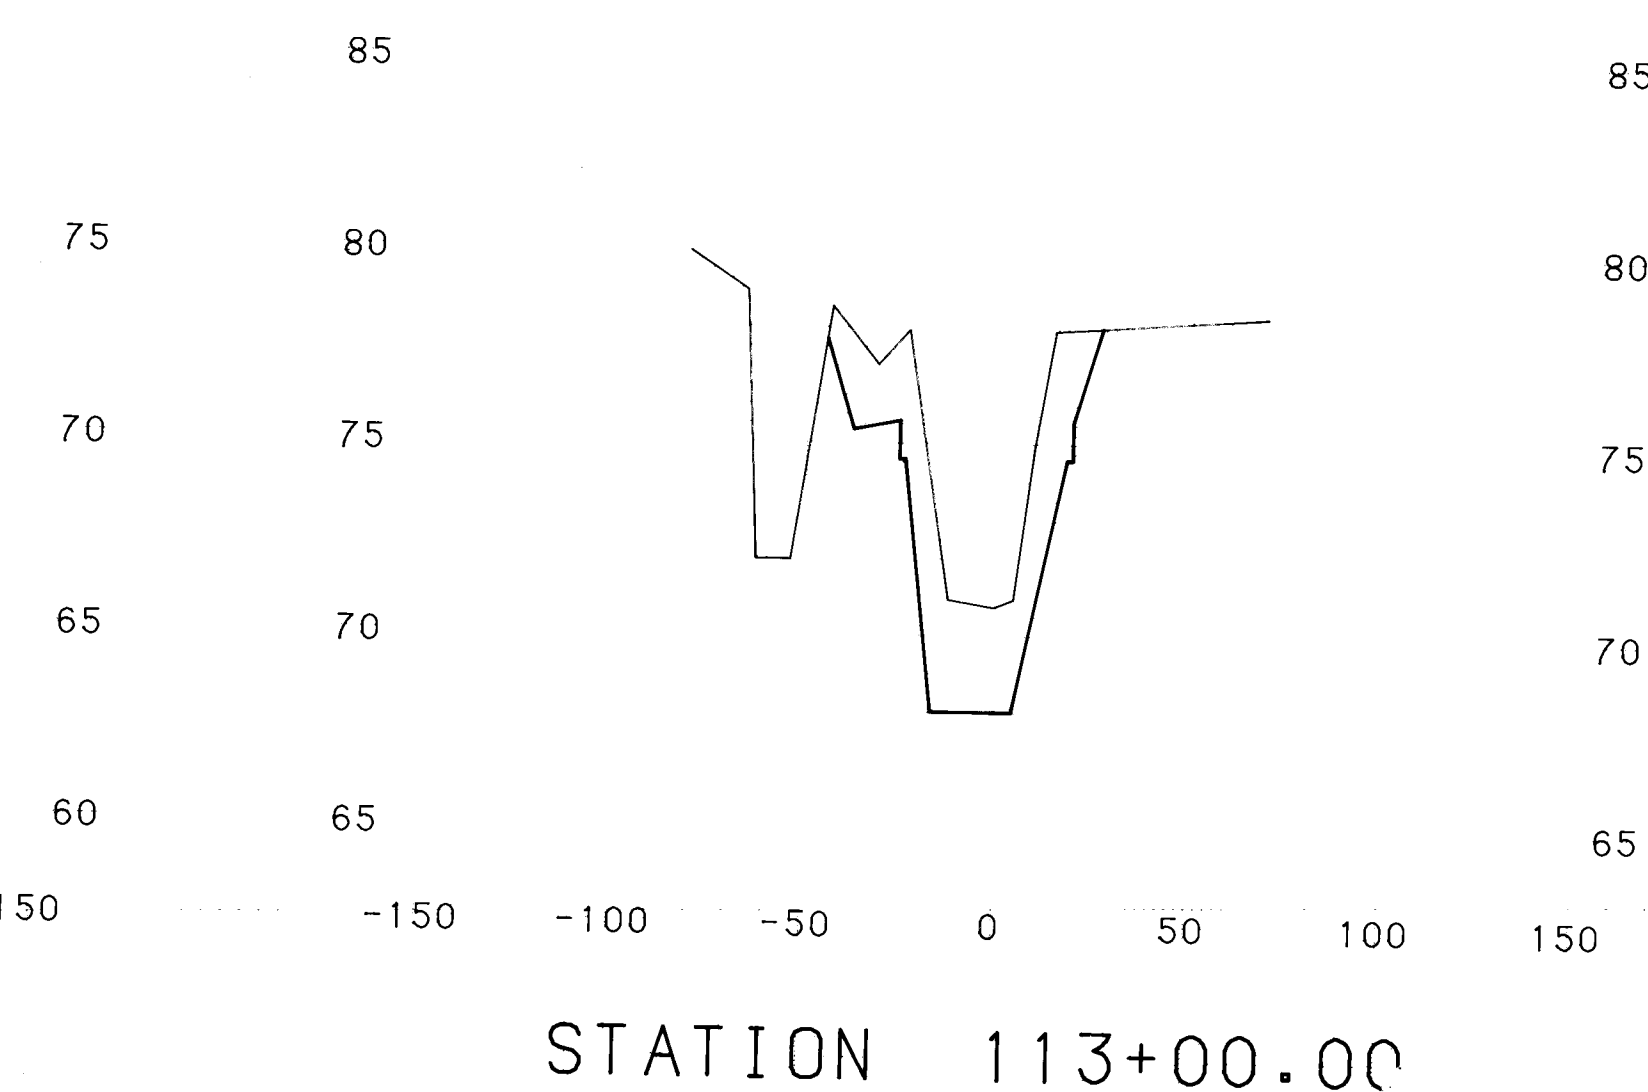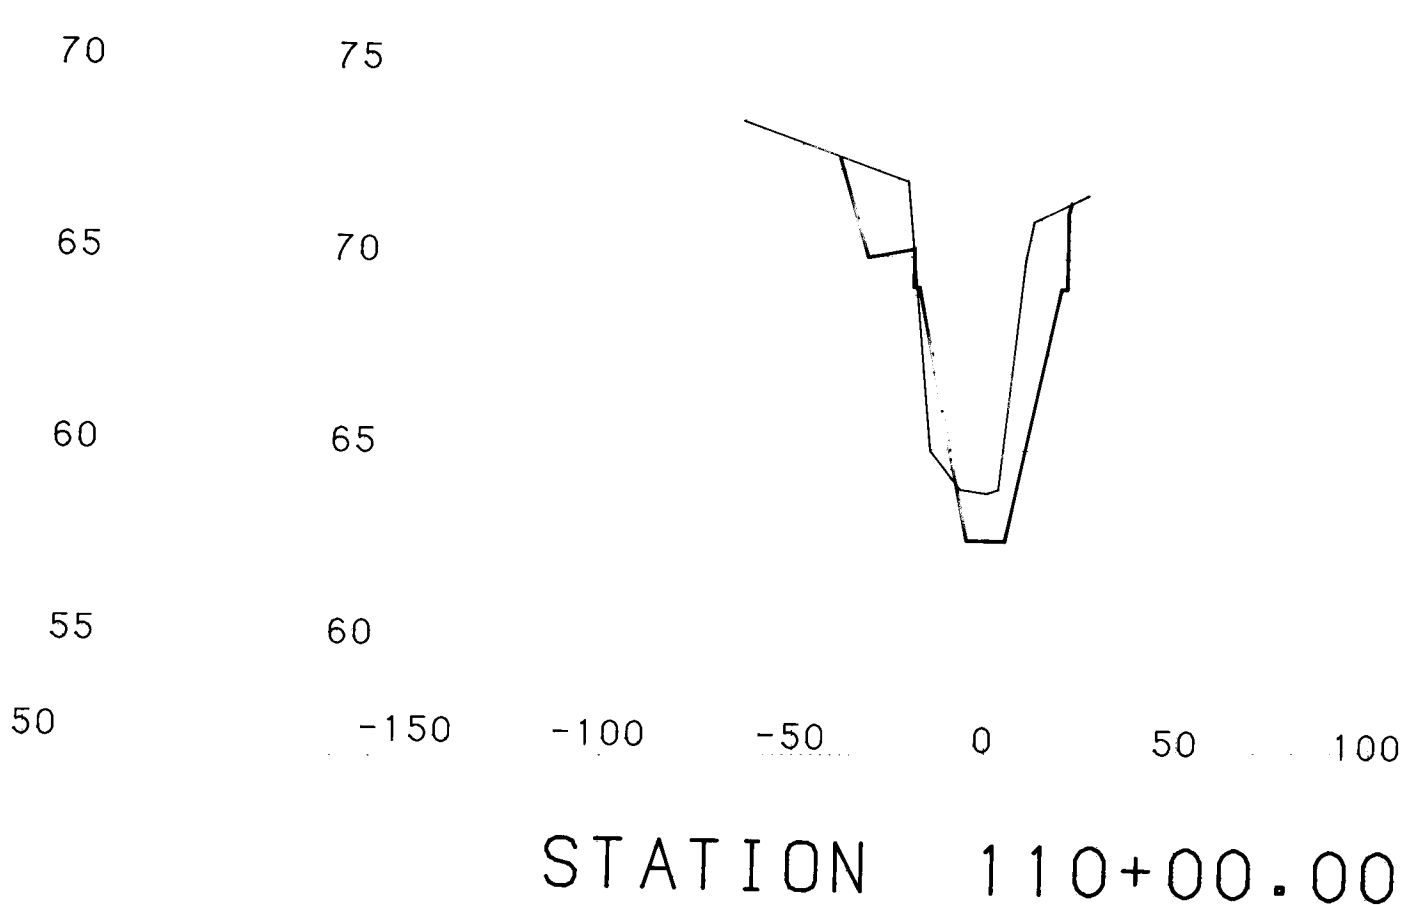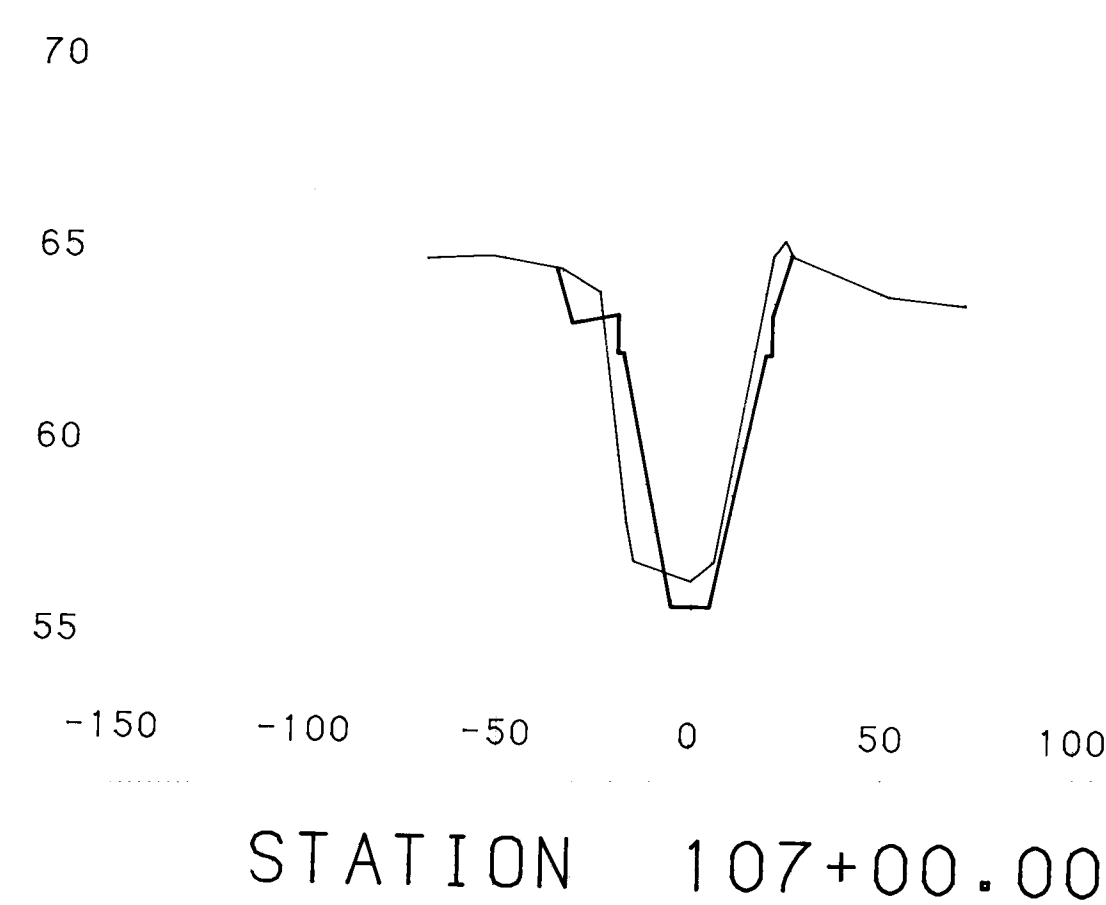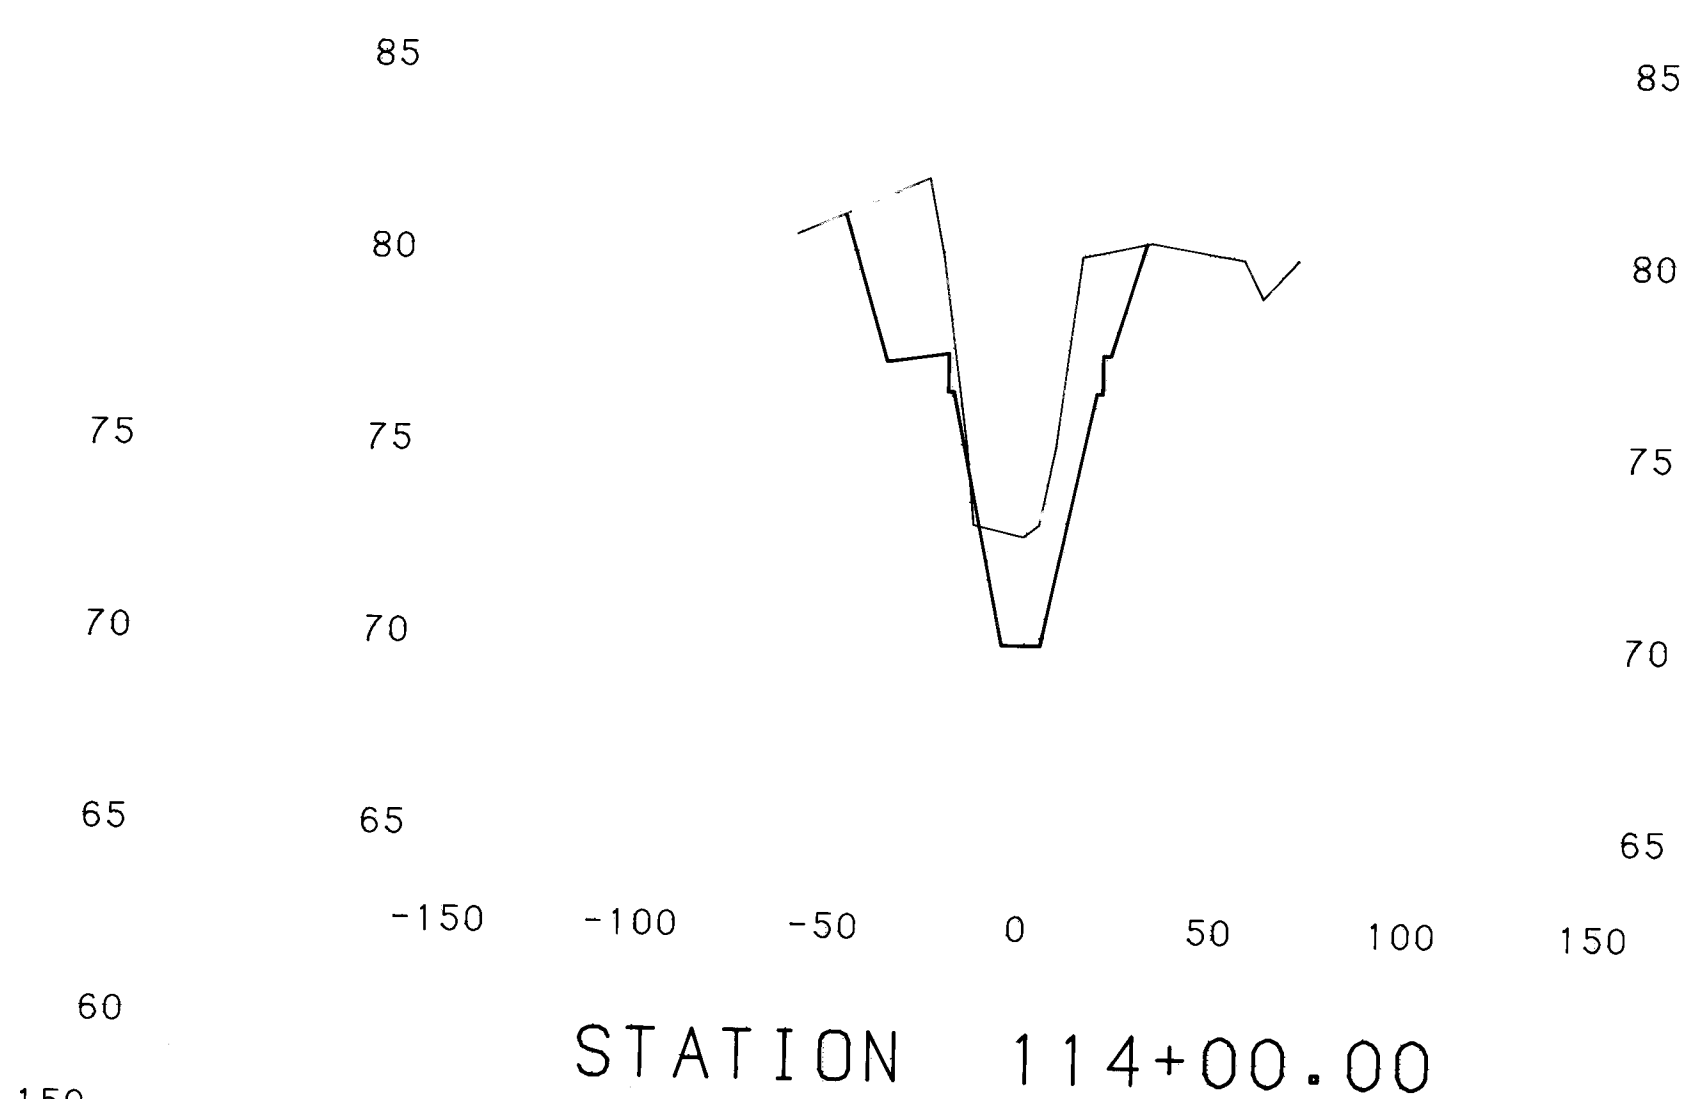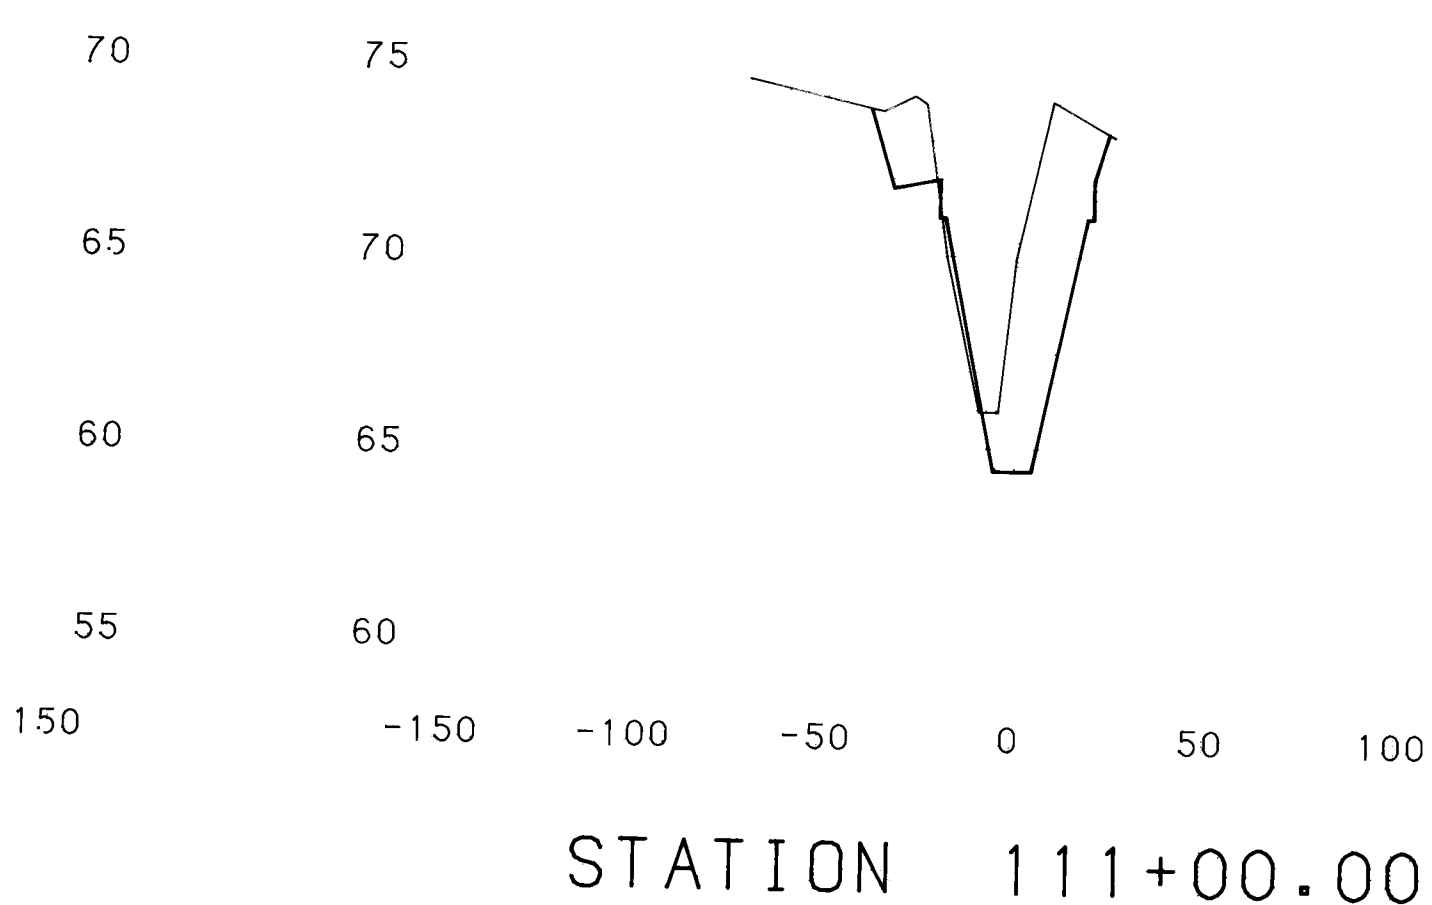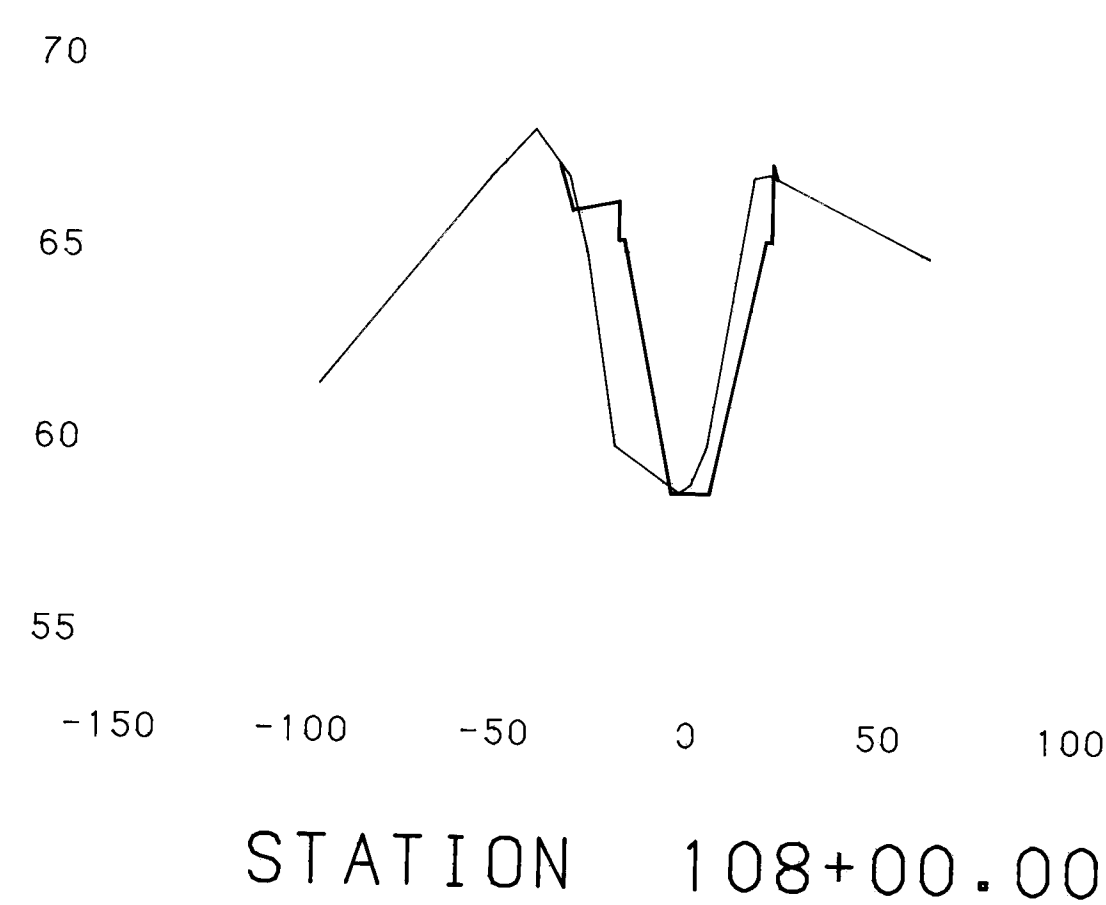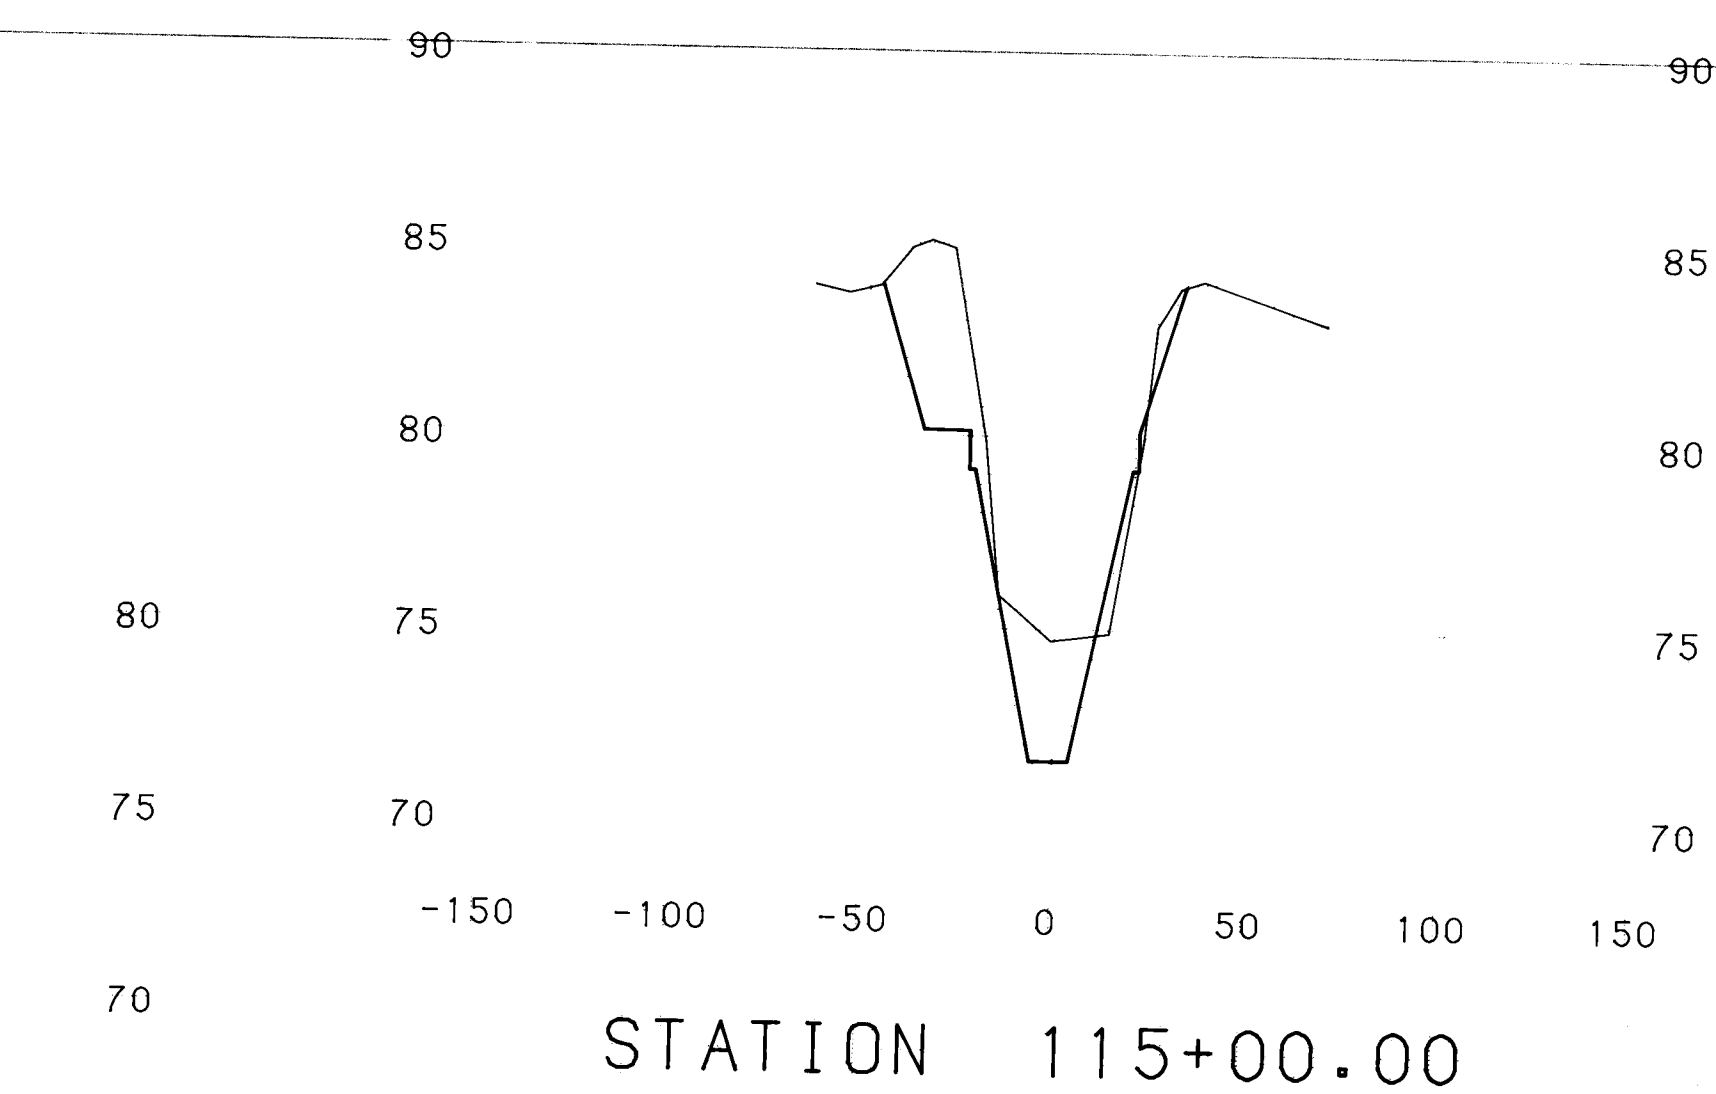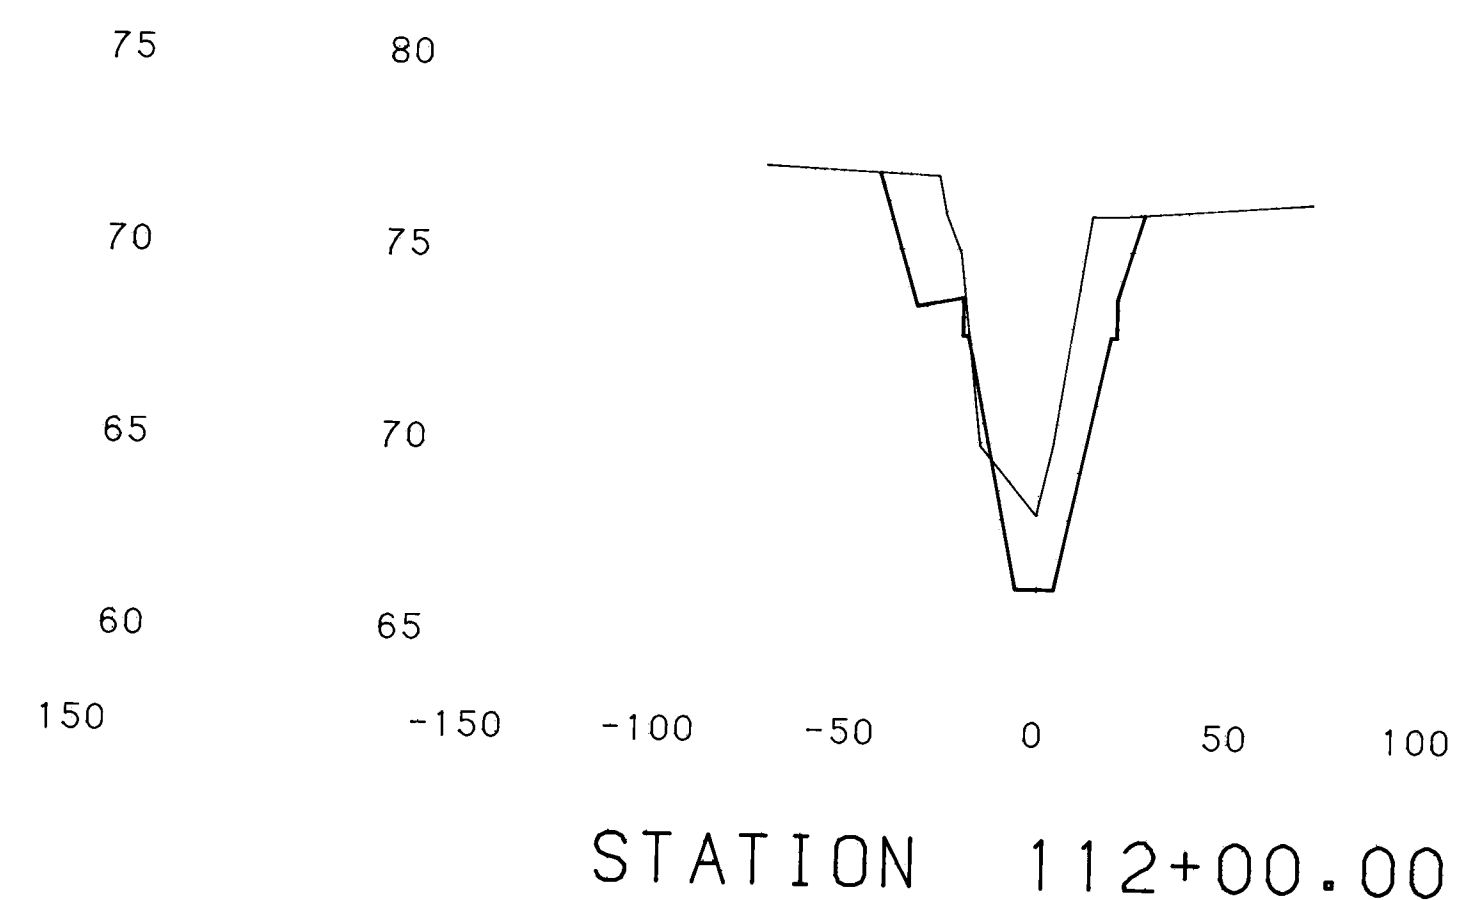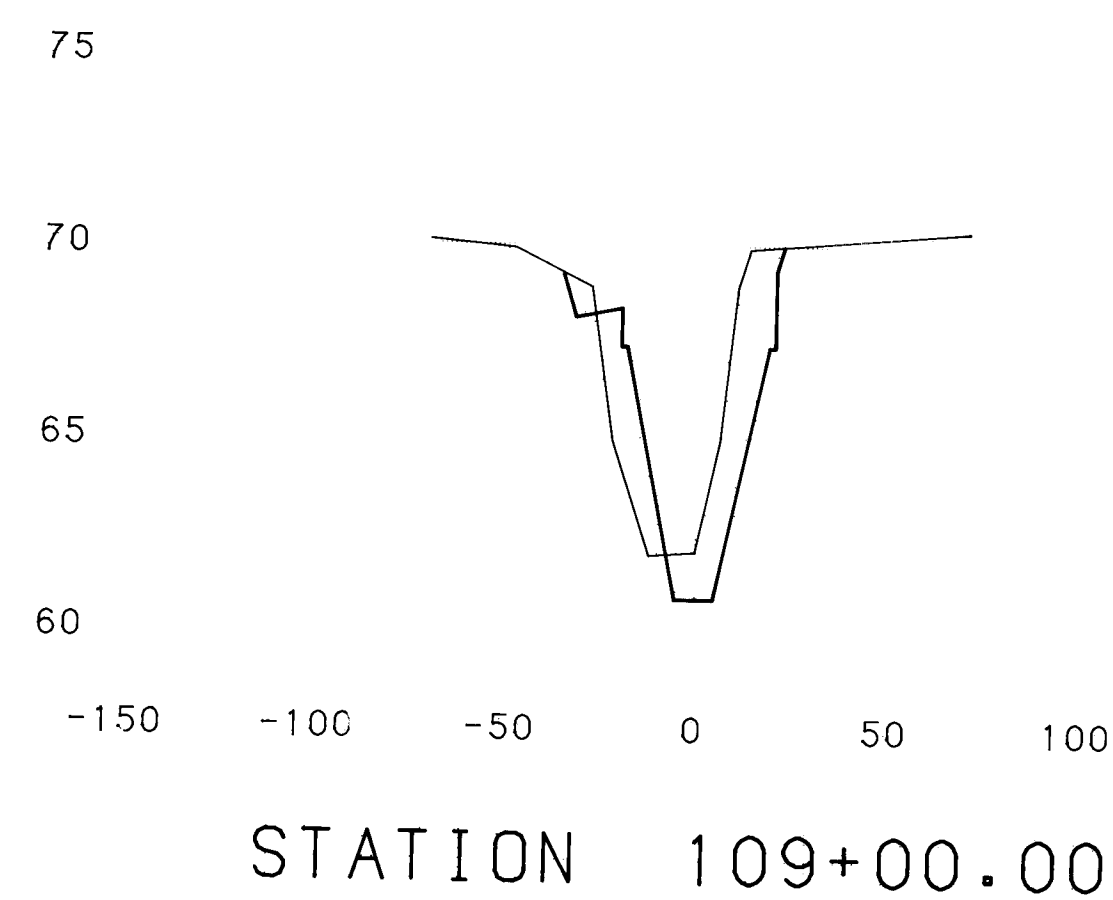[illegible]


STATION 115+30.47

Howard C. Sta. 21 18581567
10-18-89 STA. 107+00.00 to STA. 115+30.47

PINO ARROYO
PINO ARROYO IMPROVEMENTS

JOB NO. 20596

1853




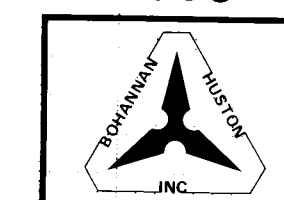


Sheet 15 of 16

PLATE 3 CROSS SECTION - DOTTED
CHARLES BRUNING COMPANY
MADE IN U.S.A.

FINAL	SURVEY	DATE
NO.	NOTED	BY
	AREAS	
	CHECKED	

ORIGINAL	SURVEY	DATE
NO.	NOTED	BY
	AREAS	
	CHECKED	

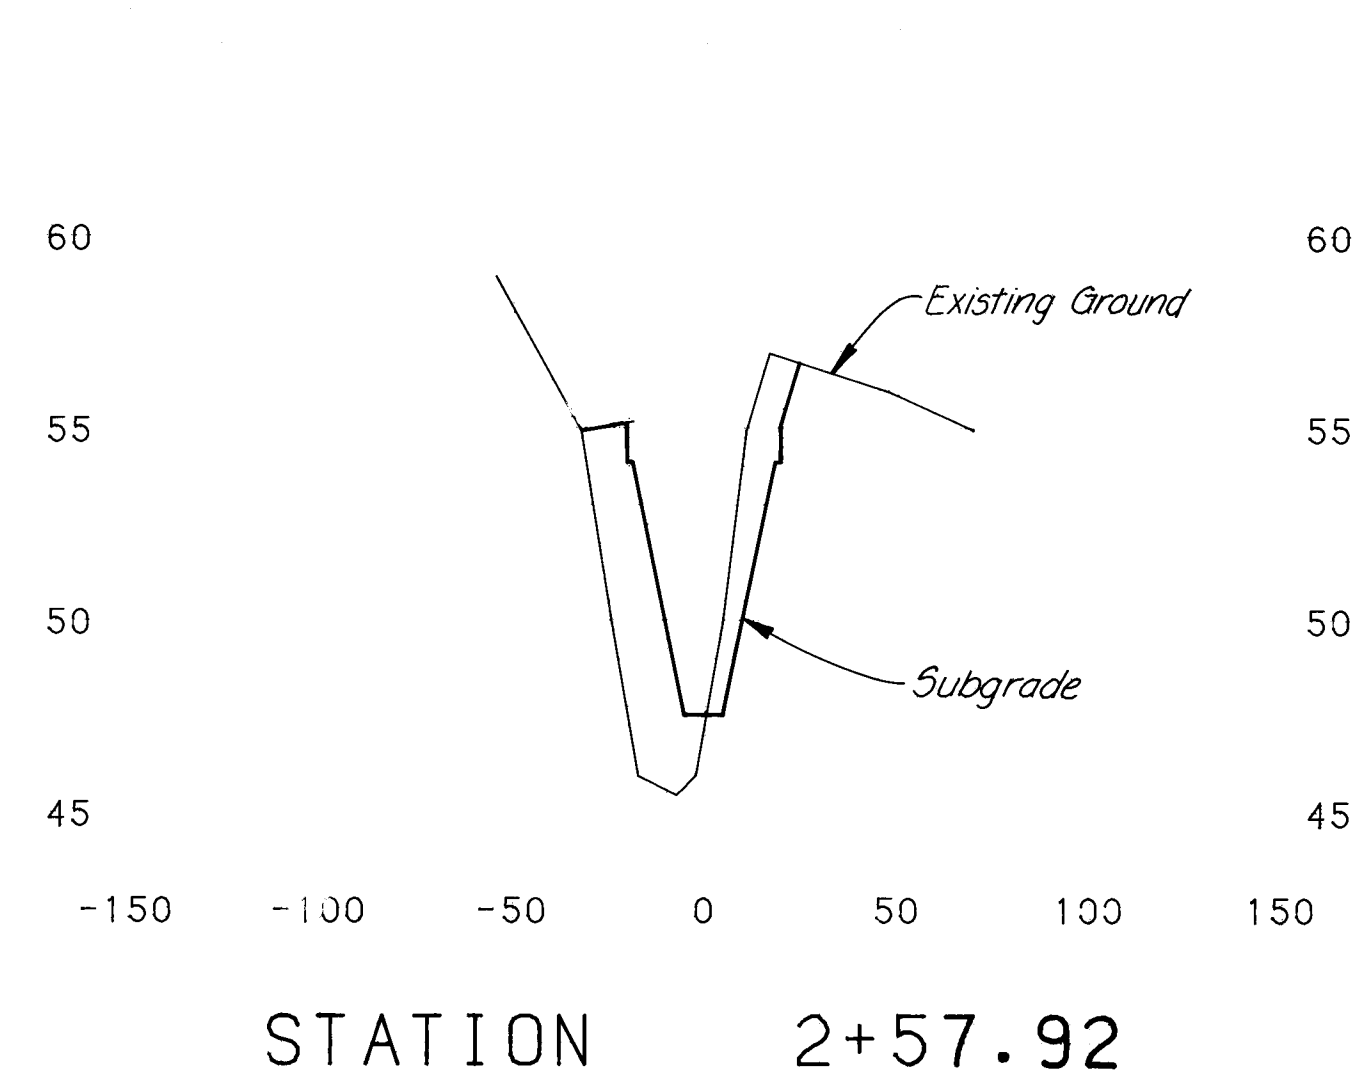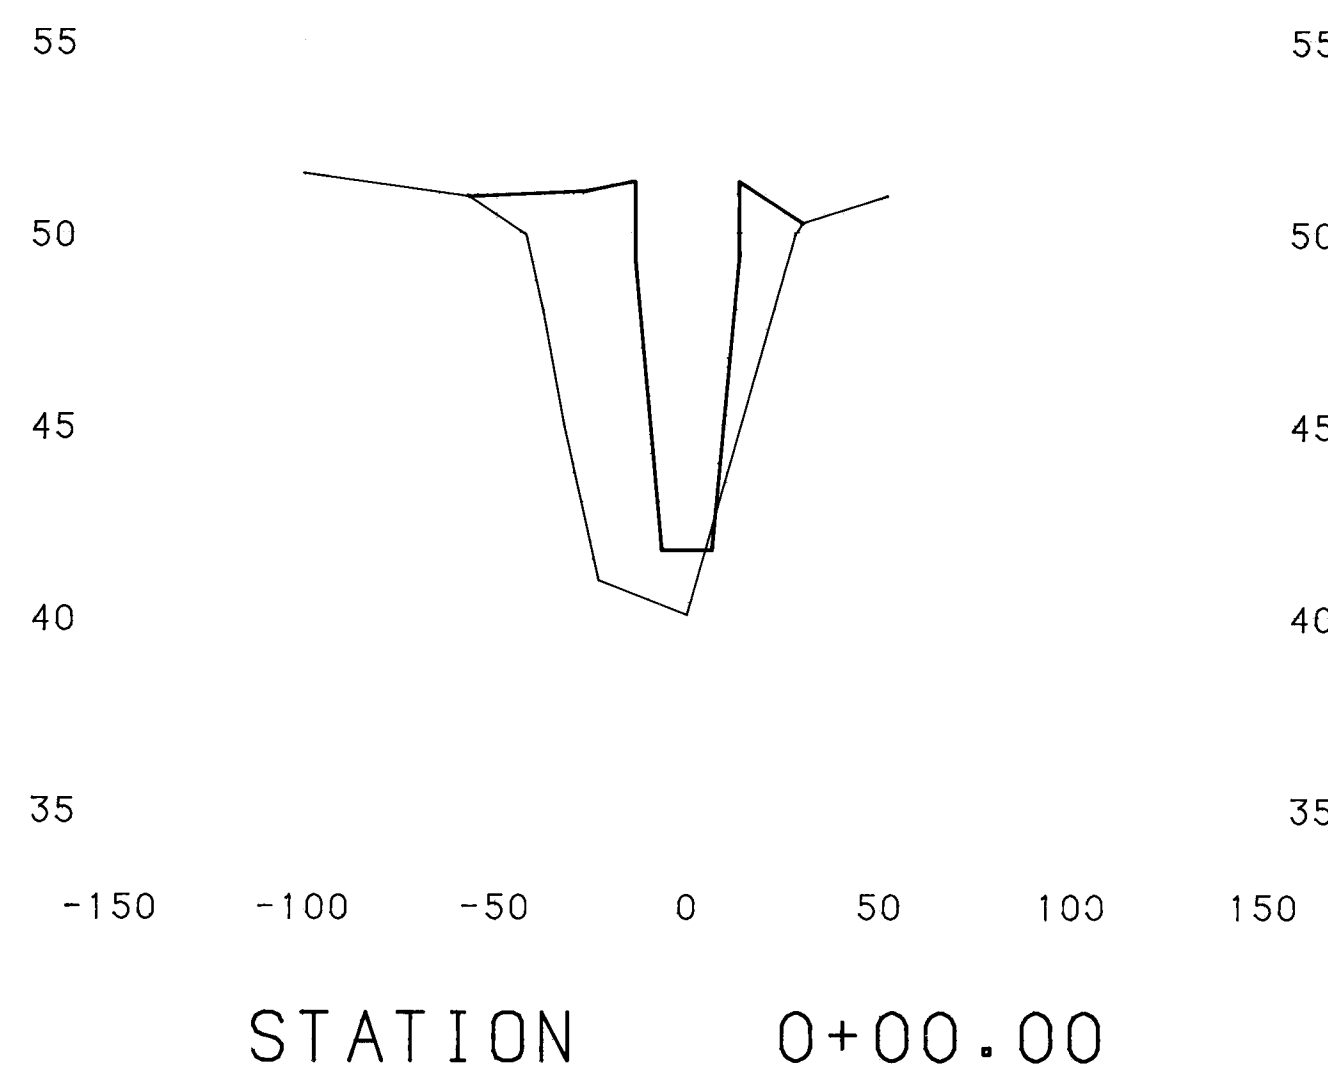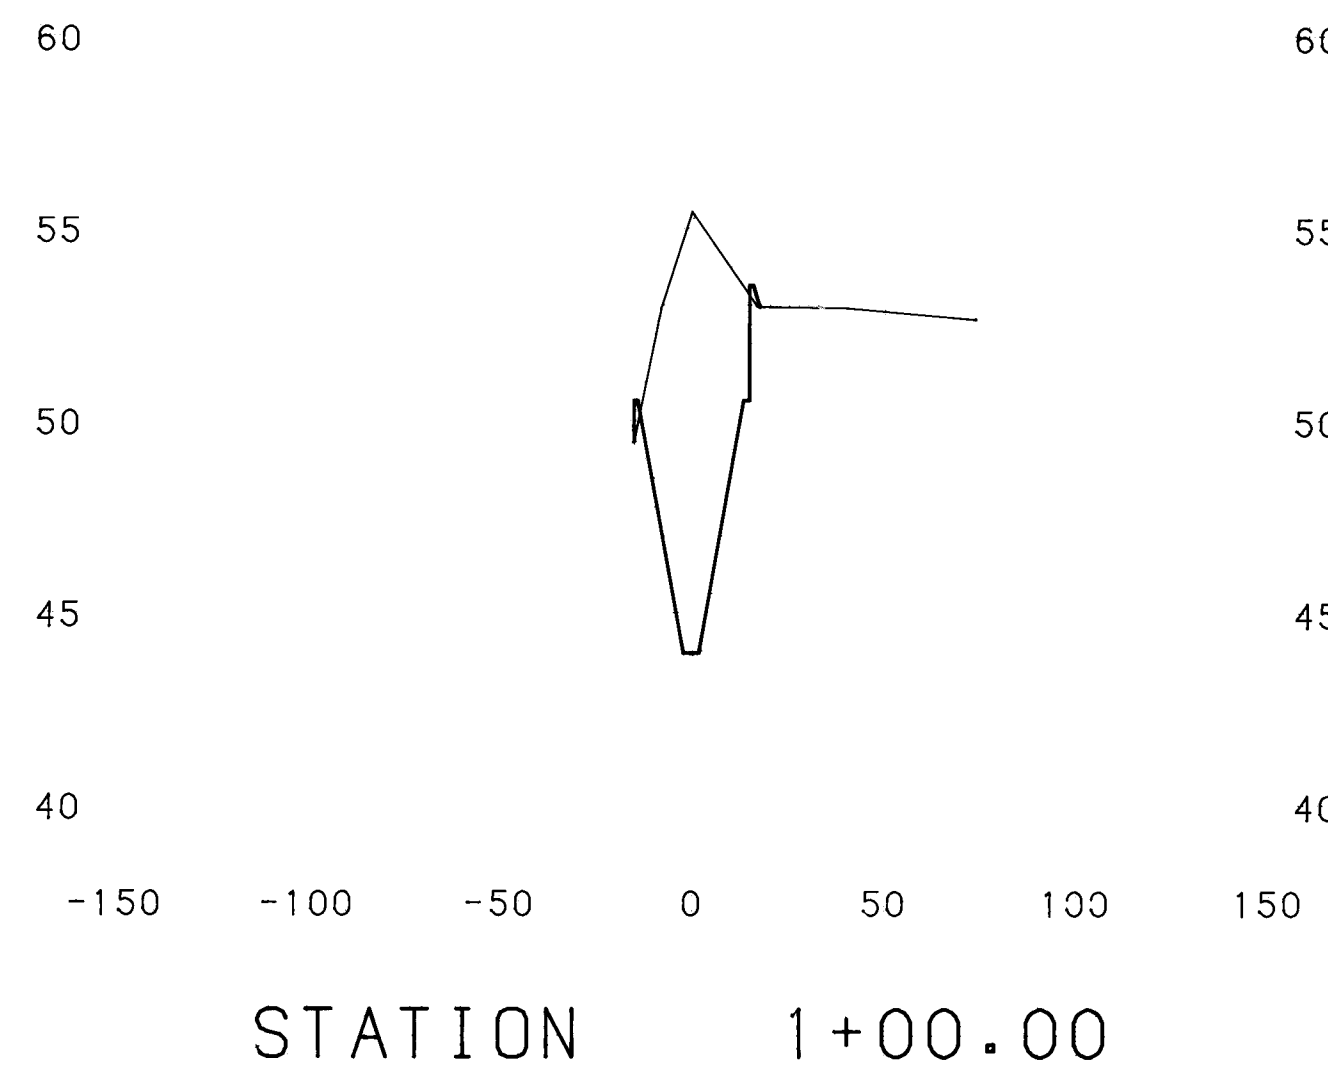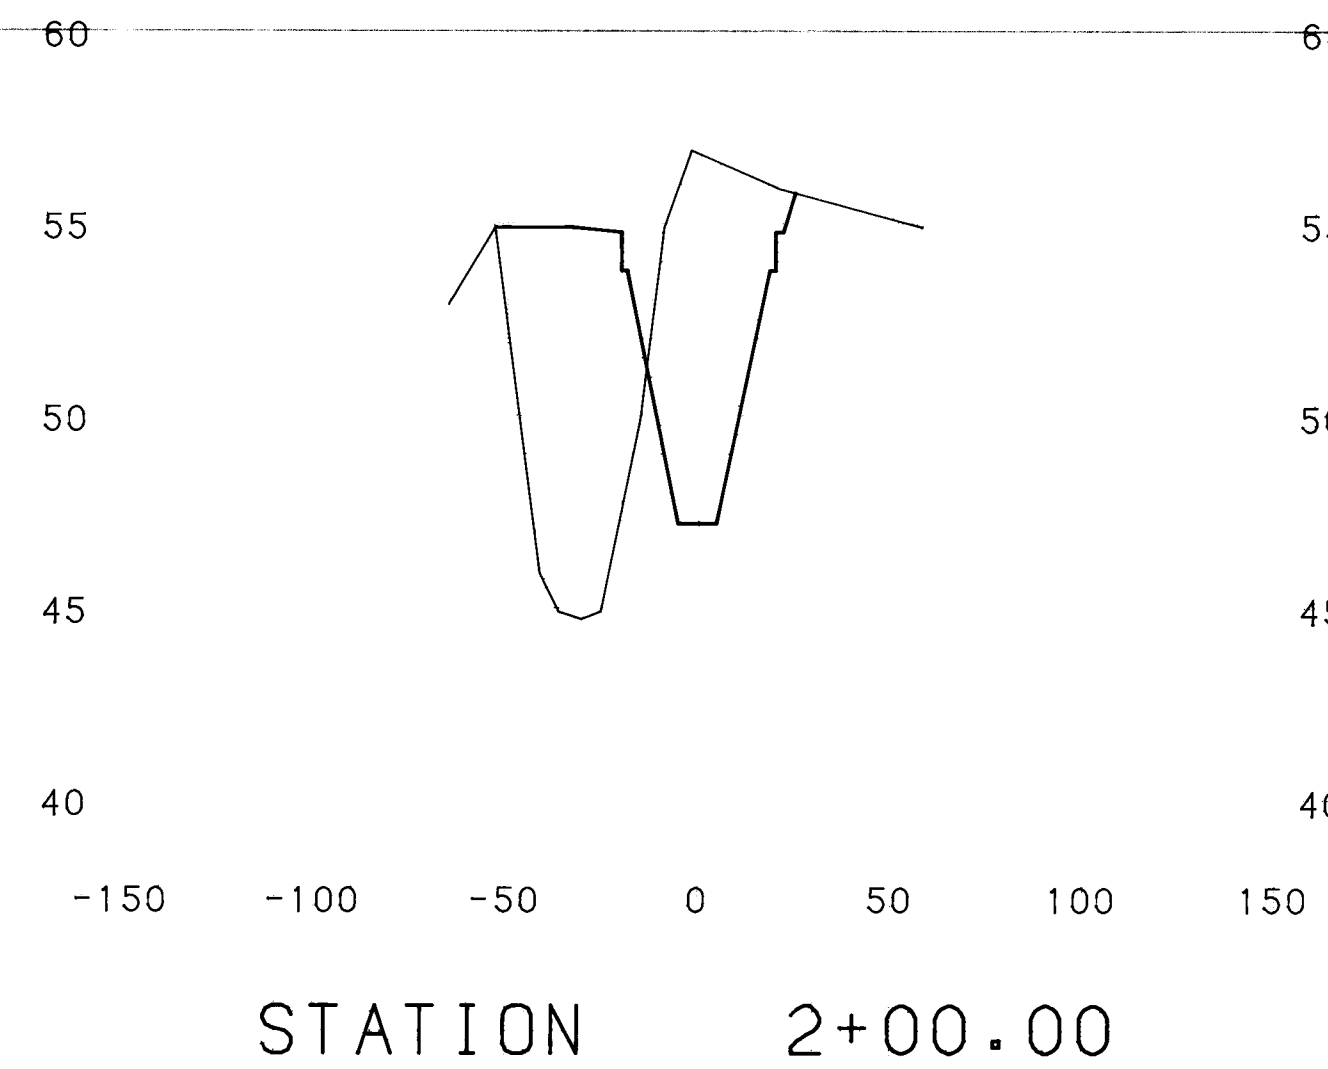

DATE 2-26-86

Howan C. Sten
10-18-89

26-18531687

STA. 0+00.00 to STA. 2+57.92
BETA ARROYO
PINO ARROYO IMPROVEMENTS
JOB NO. 20596

