

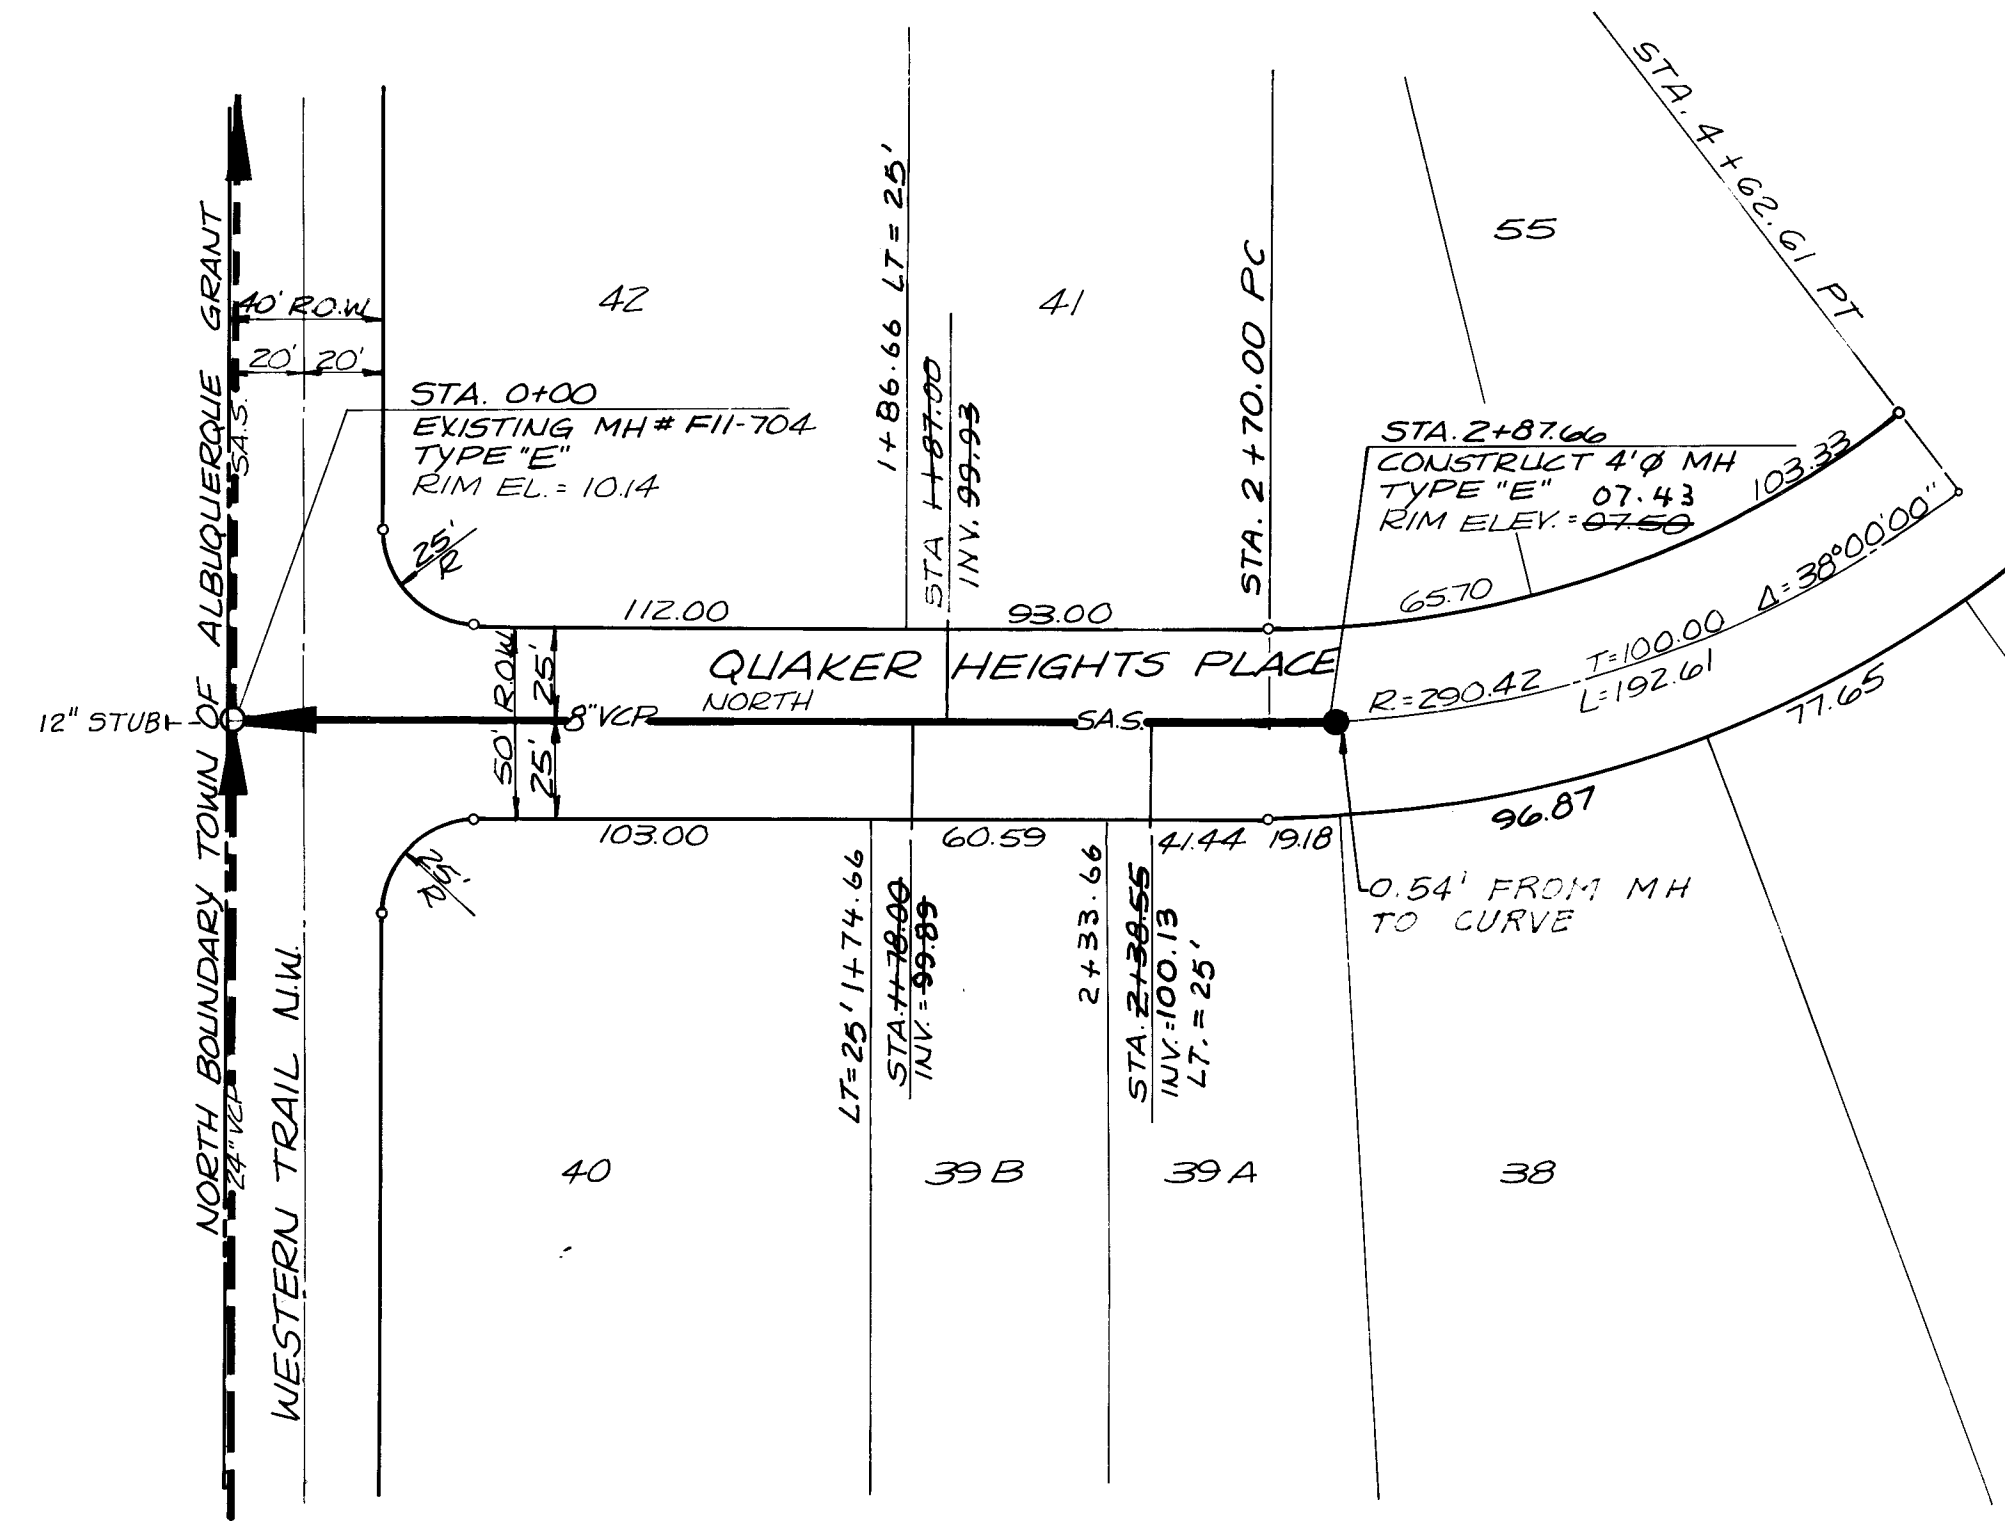


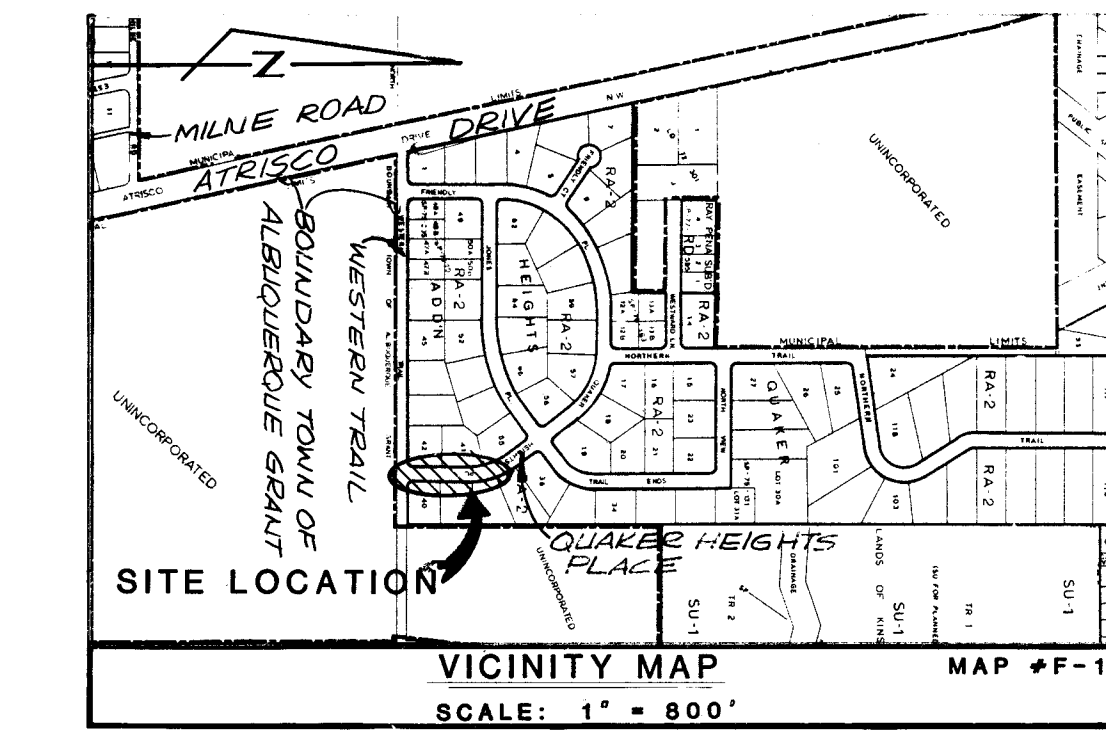

QUAKER HEIGHTS PLACE

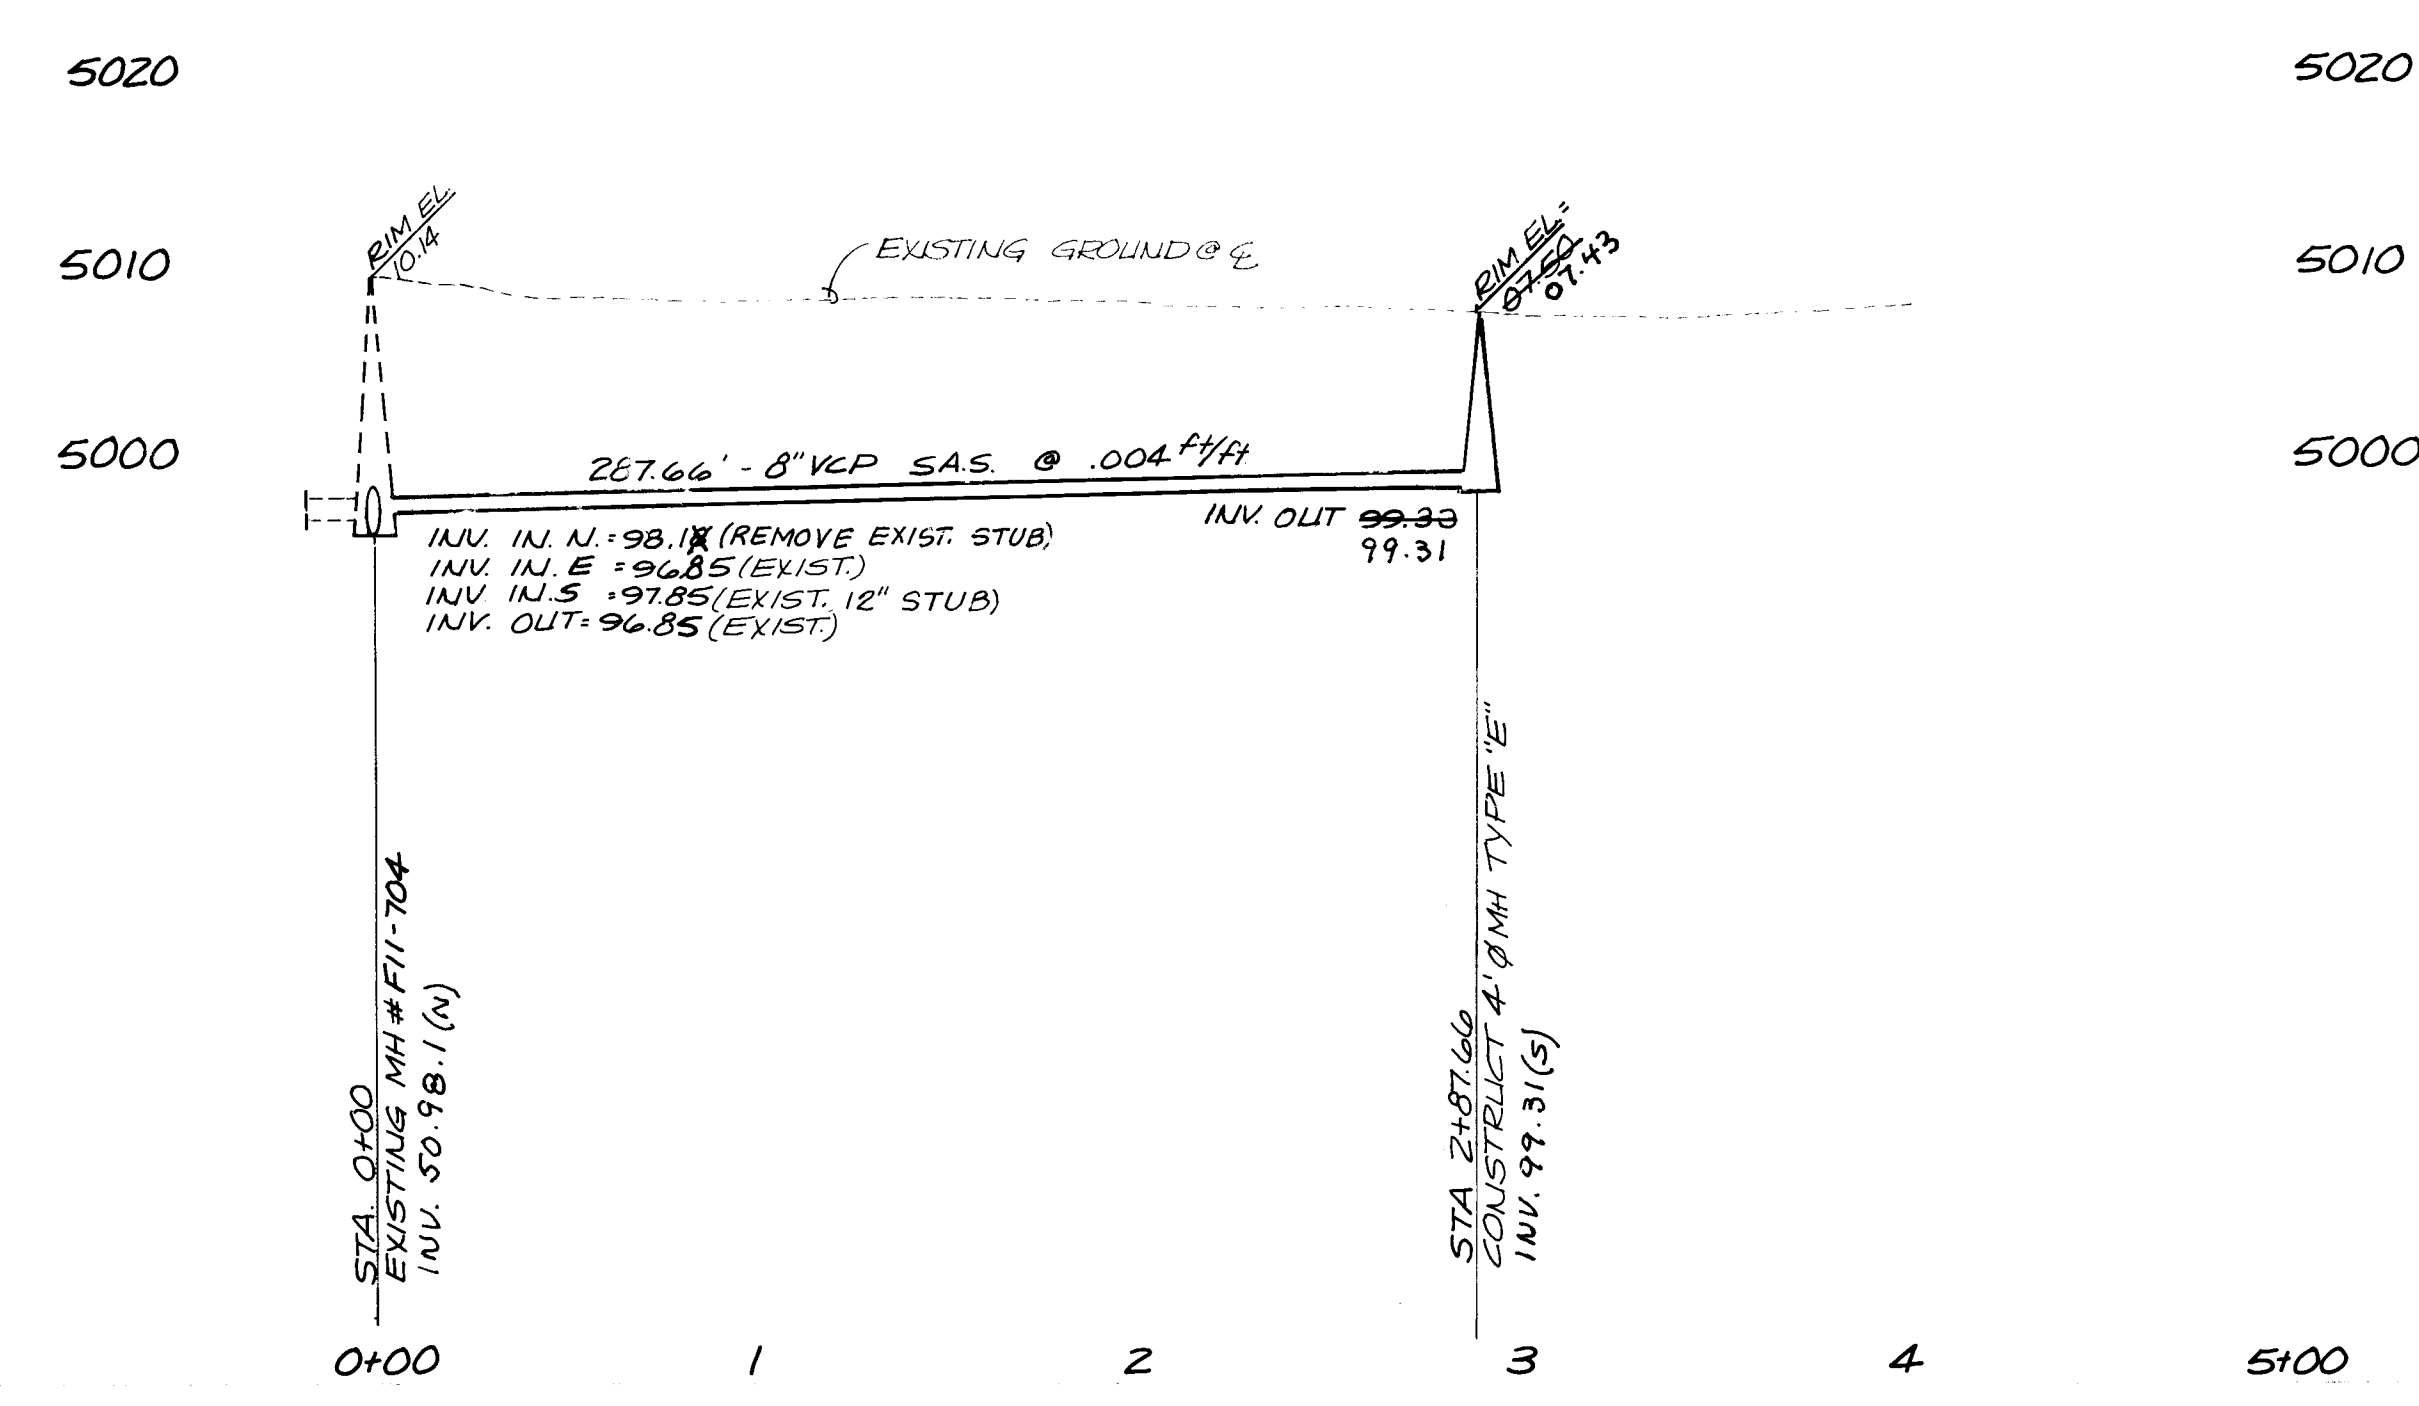

- GENERAL NOTES:
- 1) All work detailed on these plans to be performed under contract shall, except as otherwise stated or provided hereon, be constructed in accordance with the New Mexico Standard Specifications for Public Works Construction - 1979 Edition (referred to herein as the Standard Specifications) and the Contract Documents for City-Wide Utilities and Cash Paving No. 31.
 - 2) Two (2) working days prior to any excavation, contractor must contact Line Locating Service, 765-1234, for location of existing utilities.
 - 3) Prior to construction, the contractor shall excavate and verify the horizontal and vertical locations of all obstructions. Should a conflict exist, the contractor shall notify the engineer or surveyor so that the conflict can be resolved with minimum amount of delay.
 - 4) Backfill compaction shall be according to residential street use.
 - 5) This plan for sewer only. No paving this contract.

APPROVED FOR AS BUILT DRAWING
 DATE 11/4/83

Academy Engineering, Inc.
 5353 Wyoming Blvd. N.E., Suite 3
 Albuquerque, New Mexico 87109
 (505) 421-8008

CITY OF ALBUQUERQUE
 MUNICIPAL DEVELOPMENT DEPARTMENT
 ENGINEERING DIVISION

SEWER MAIN EXTENSION
 QUAKER HEIGHTS PLACE

APPROVED FOR CONSTRUCTION
 C. J. Shupard 9/22/83
 CITY ENGINEER

REVISIONS
 1. BLOCK 8-30-83
 2. SLOPE 8-30-83
 3. BLACKWELL 8-30-83

DRAWING NO. 1857
 MAP NO. F-11
 SHEET 1 OF 1