



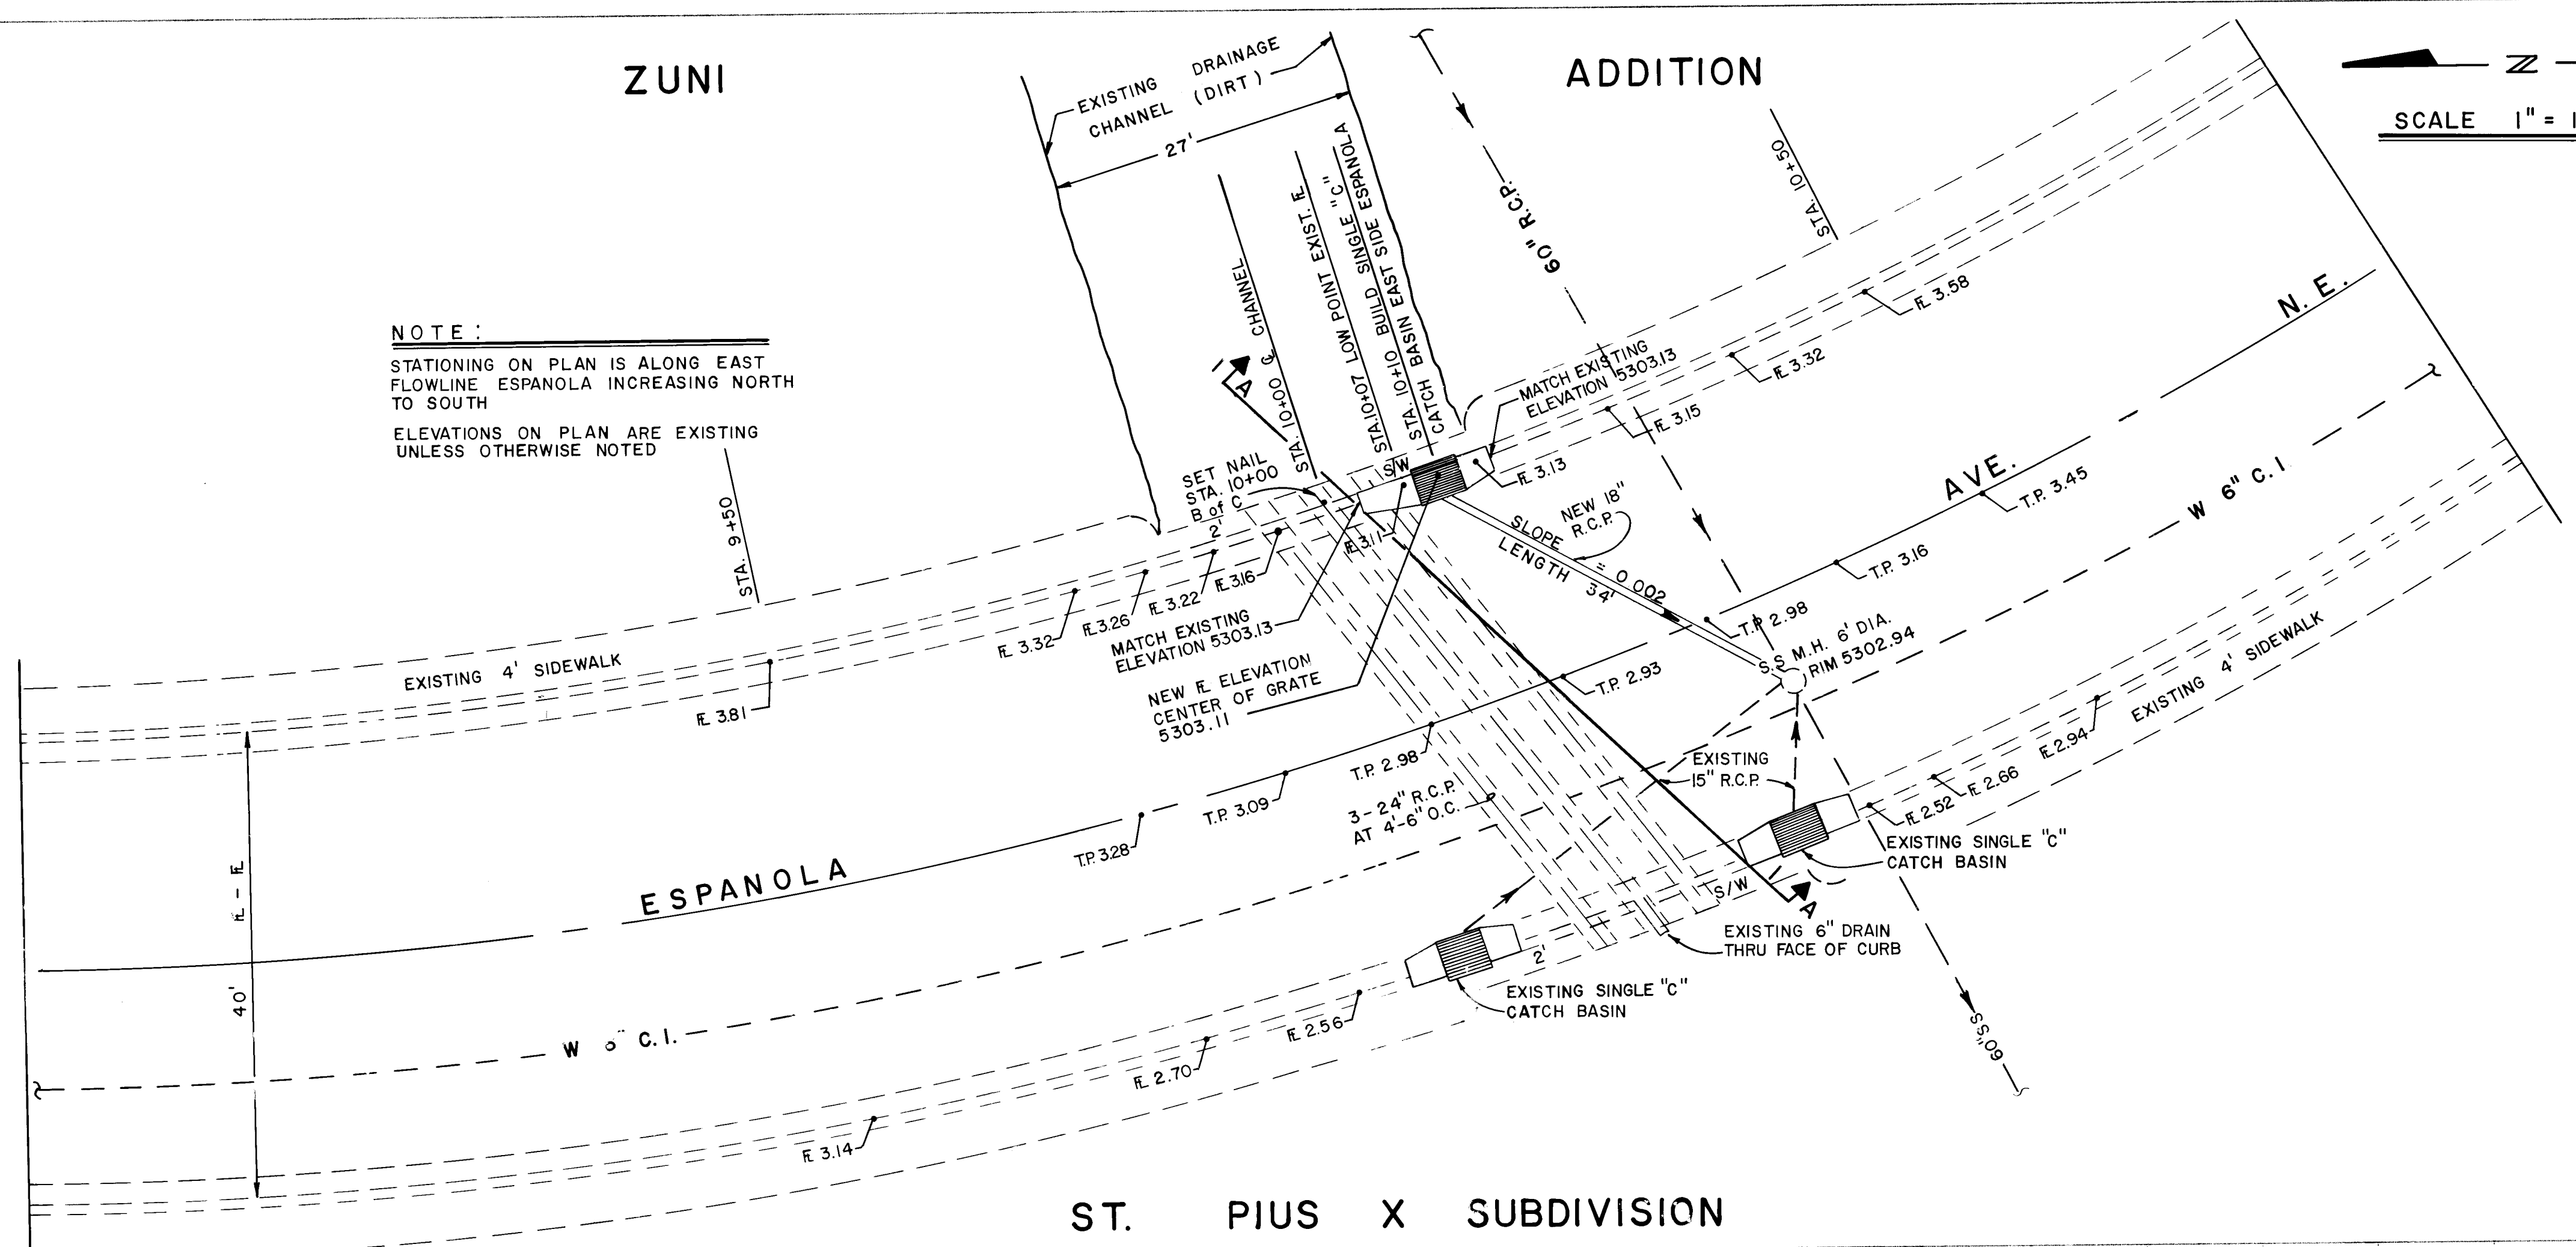

NOTE:
STATIONING ON PLAN IS ALONG EAST
FLOWLINE ESPANOLA INCREASING NORTH
TO SOUTH
ELEVATIONS ON PLAN ARE EXISTING
UNLESS OTHERWISE NOTED

SCALE 1" = 10'

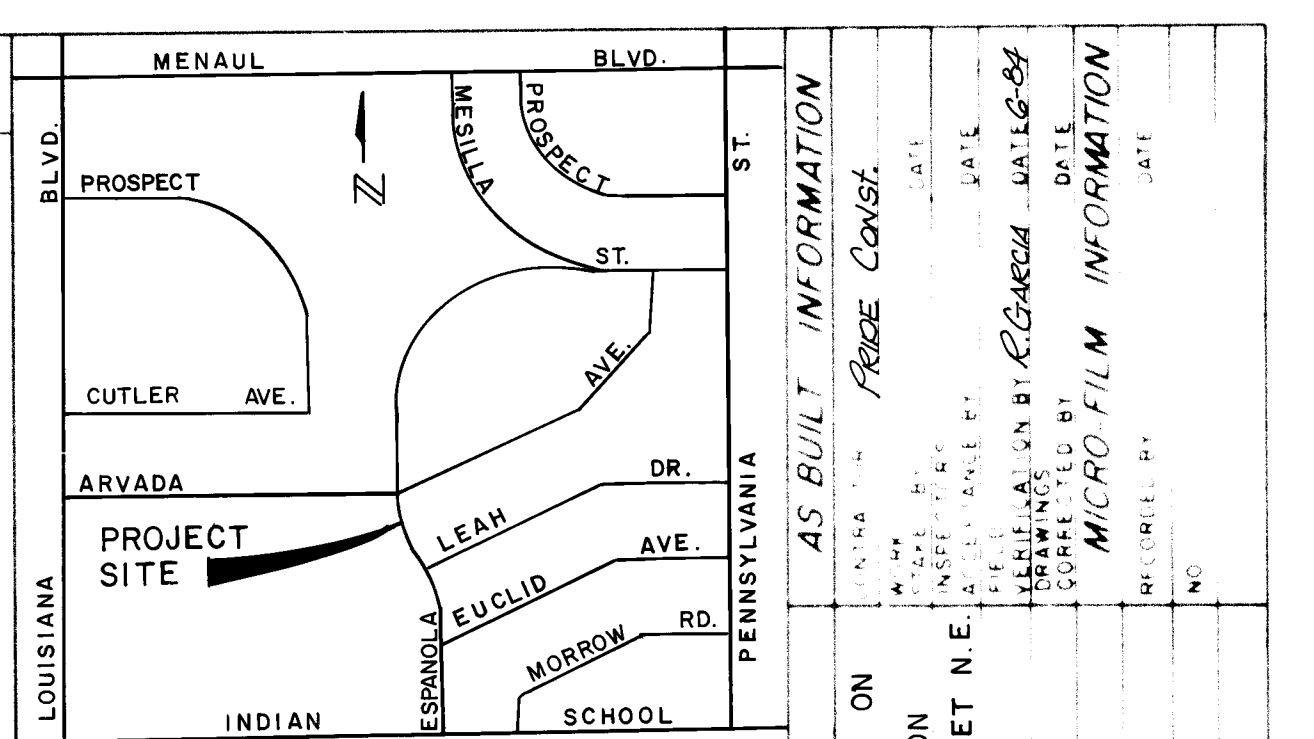

LOCATION MAP H-19

NOTICE TO CONTRACTORS

- All work detailed on these plans to be performed under contract shall, except as otherwise stated or provided for hereon, be constructed in accordance with the New Mexico Standard Specifications for Public Works Construction-1979 Edition (referred to herein as the Standard Specifications) and the Contract Documents for Public Works Contract 184-1.
- Two (2) working days prior to any excavation, the contractor must contact Line Locating Service, 765-1234, for location of existing utilities.
- Prior to construction, the contractor shall excavate and verify the horizontal and vertical locations of all obstructions. Should a conflict exist, the contractor shall notify the engineer or surveyor so that the conflict can be resolved with minimum amount of delay.

THE FOLLOWING NOTES ALSO APPLY WHEN CHECKED

- ☐ All utilities and utility service lines shall be installed prior to paving.
- ☒ Backfill compaction shall be according to specified street use. **Residential**
- ☒ Tack coat requirements shall be determined by the City Engineer.
- ☐ Sidewalks and wheelchair ramps within the curb returns shall be constructed wherever a new curb return is constructed.
- ☐ If curb is depressed for a driveway or a handicap ramp, the driveway or ramp shall be constructed prior to acceptance of the curb and gutter.
- ☒ All storm drainage facilities shall be completed prior to final acceptance.

ENGINEER'S SEAL

BENCH MARKS

3 H-19 CHISLED ON TOP OF CONCRETE CURB ON THE WNW CURB RETURN AT THE INTERSECTION OF INDIAN SCHOOL ROAD AND ESPANOLA STREET N.E.

DATE 7/83

BY H. MEACER

NO PS/40

FIELD NOTES

DATE 7/83

BY H. MEACER

NO PS/40

AS BUILT INFORMATION	REVISIONS	DATE	BY
FILED IN BUREAU OF PUBLIC WORKS	DESIGN	DATE 10/83	BY STEVE BOBERG
RECORDED BY	DESIGN	DATE 10/83	BY STEVE BOBERG
NO	REMARKS	DATE	BY

26 1860 0184

[Signature]

CITY OF ALBUQUERQUE
MUNICIPAL DEVELOPMENT DEPARTMENT
ENGINEERING DIVISION

TITLE CATCH BASIN INSTALLATION EAST SIDE
ESPANOLA AVE. 750± NORTH OF INDIAN
SCHOOL RD.

APPROVALS	ENGINEER	DATE	APPROVALS	ENGINEER	DATE
City Engineer	<i>[Signature]</i>	12/19/83	Liquid Waste	AM WBF	12/19/83
ACE - Design	<i>[Signature]</i>	12/19/83	Traffic	AM WBF	12/19/83
ACE - Hydrology	<i>[Signature]</i>	12/19/83	Water	AM WBF	12/19/83

DRAWING NO. 1860	MAP NO. H-19	SHEET 1 OF 1
------------------	--------------	--------------