




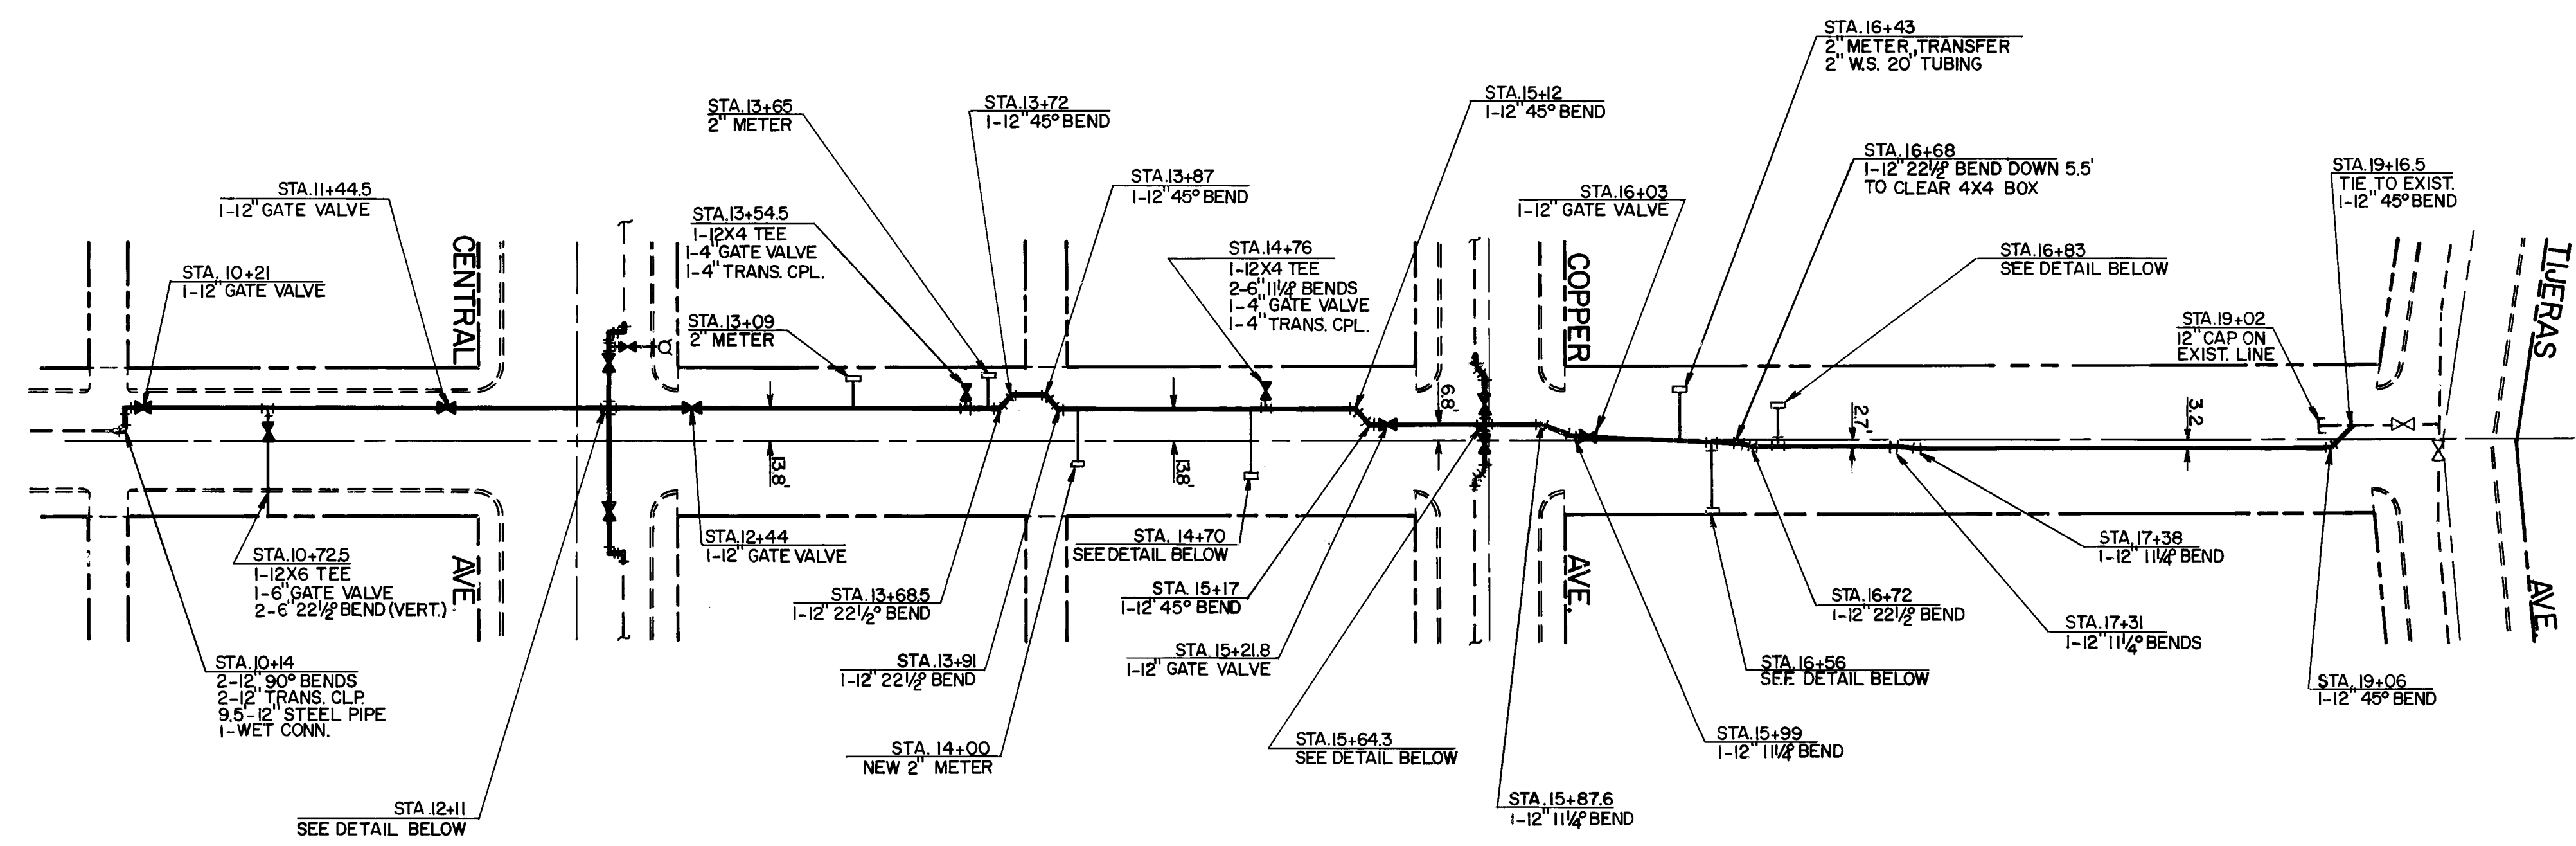


4TH STREET

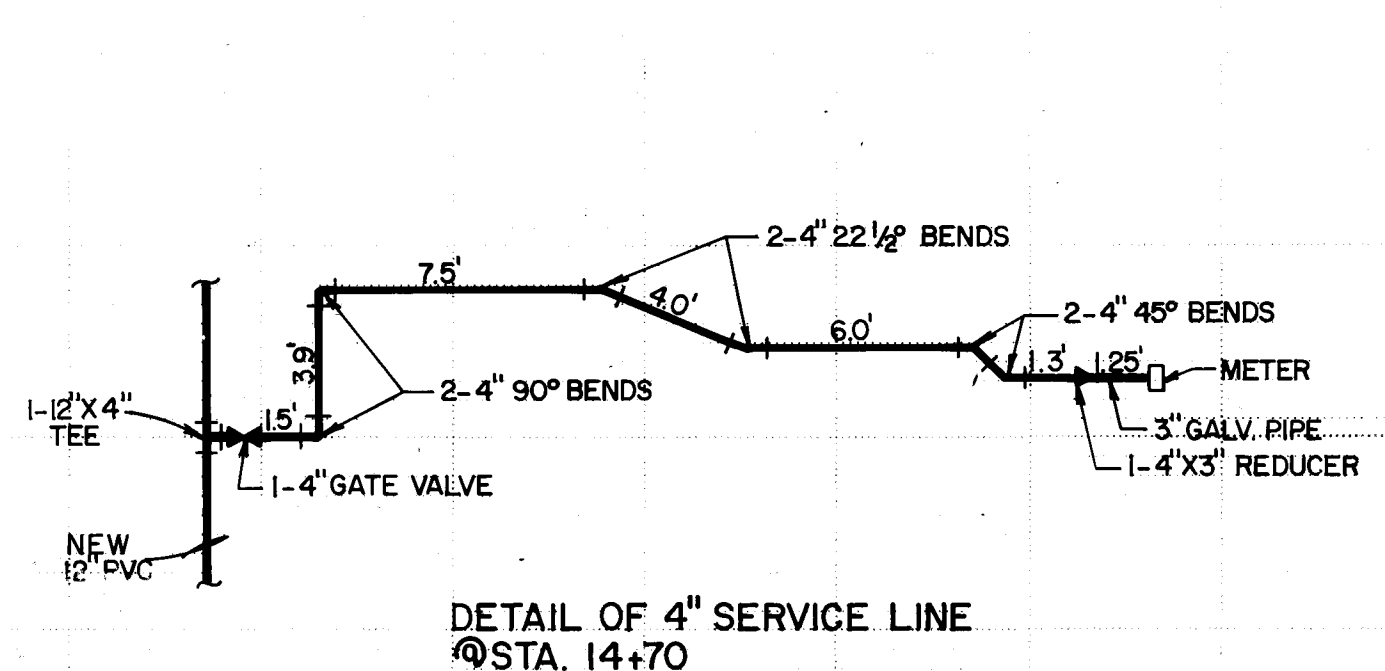


DETAIL OF 4" SERVICE LINE
@ STA. 14+70

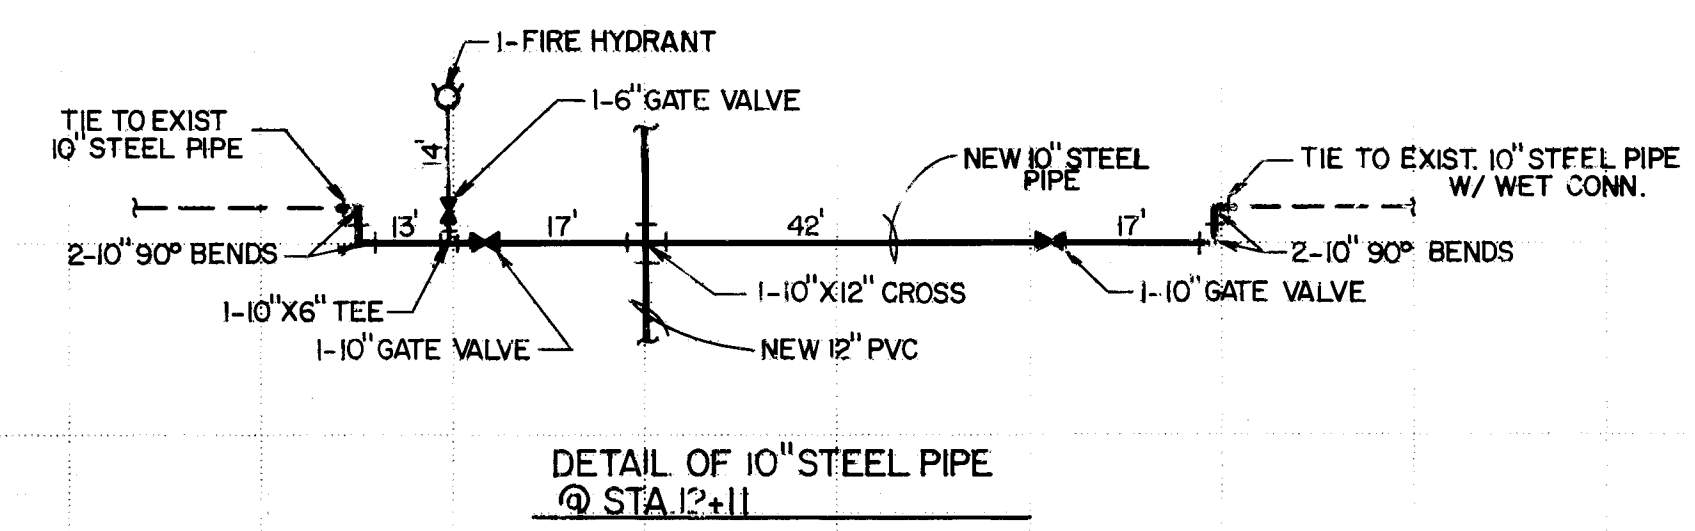


DETAIL OF 10" STEEL PIPE
@ STA. 12+11

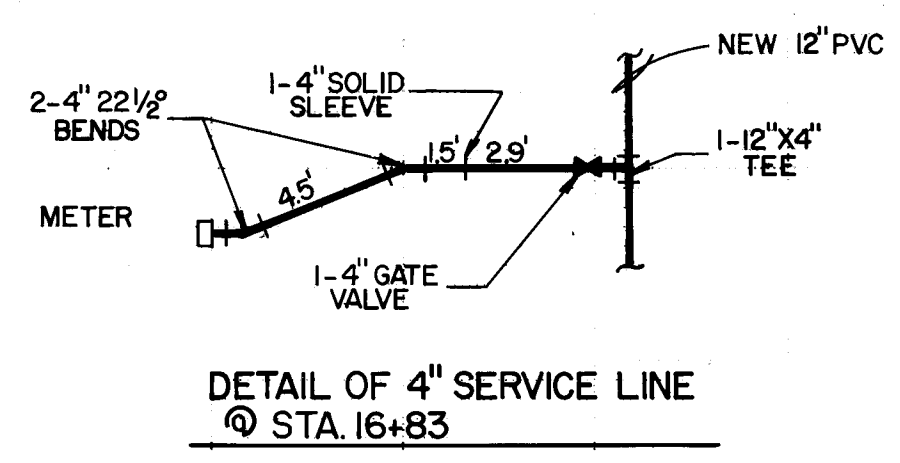

DETAIL OF 4" SERVICE LINE
@ STA. 16+83

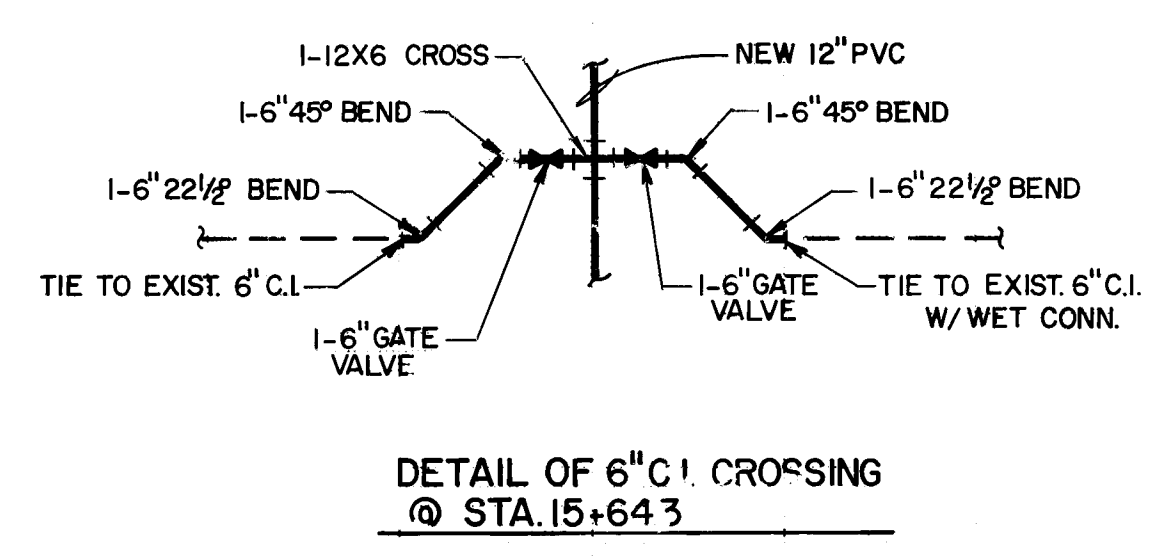

DETAIL OF 6" C.I. CROSSING
@ STA. 15+64.3

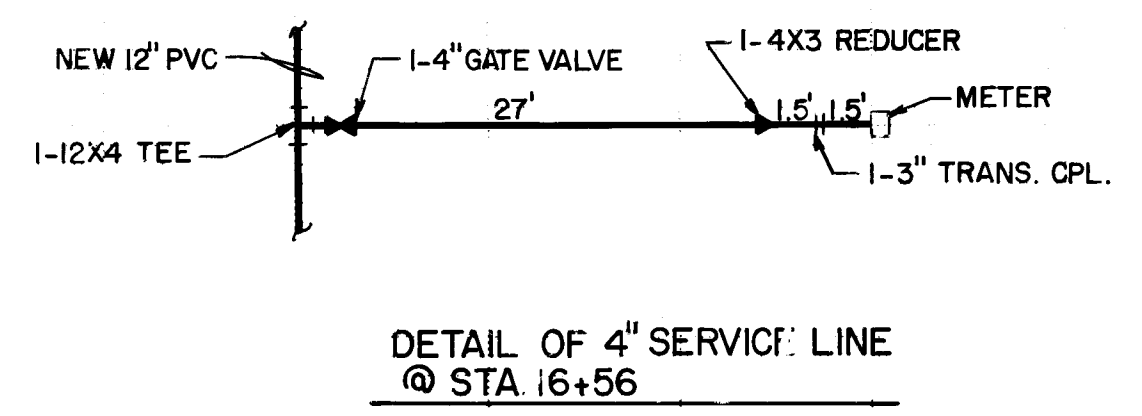

DETAIL OF 4" SERVICE LINE
@ STA. 16+56

STA.	TOP OF PIPE ELEV.
12+42	47.54
13+51	48.09
13+66	48.37
13+73	48.78

APPROVAL OF AS-BUILT DRAWINGS
ASST. CITY ENGINEER - FIELD
[Signature]
DATE 4-10-84

NO
THIS AS-BUILT COMPILED FROM FIELD NOTES
AND FIELD ENGINEERS INSTRUCTIONS AND IS
FOR RECORD PURPOSES.

26 1862 0184

CITY OF ALBUQUERQUE
MUNICIPAL DEVELOPMENT DEPARTMENT
ENGINEERING DIVISION

TITLE WATER LINE REPLACEMENT
4th St. FROM TIJERAS TO THE
ALLEY SOUTH OF CENTRAL.

APPROVAL	ENGINEER	DATE	APPROVAL	ENGINEER	DATE
City Engineer			Liquid Waste		
ACE Design			Traffic		
ACE Hydrology			Water		

DRAWING NO 862 MAP NO K-4 SHEET 1 OF 1

NEW CONCEPTS
BILL MONTANA 1-17-84

REVISIONS
DATE MAR 28, 1984
BY
R. DURAN
H. BENNINGHOFF