
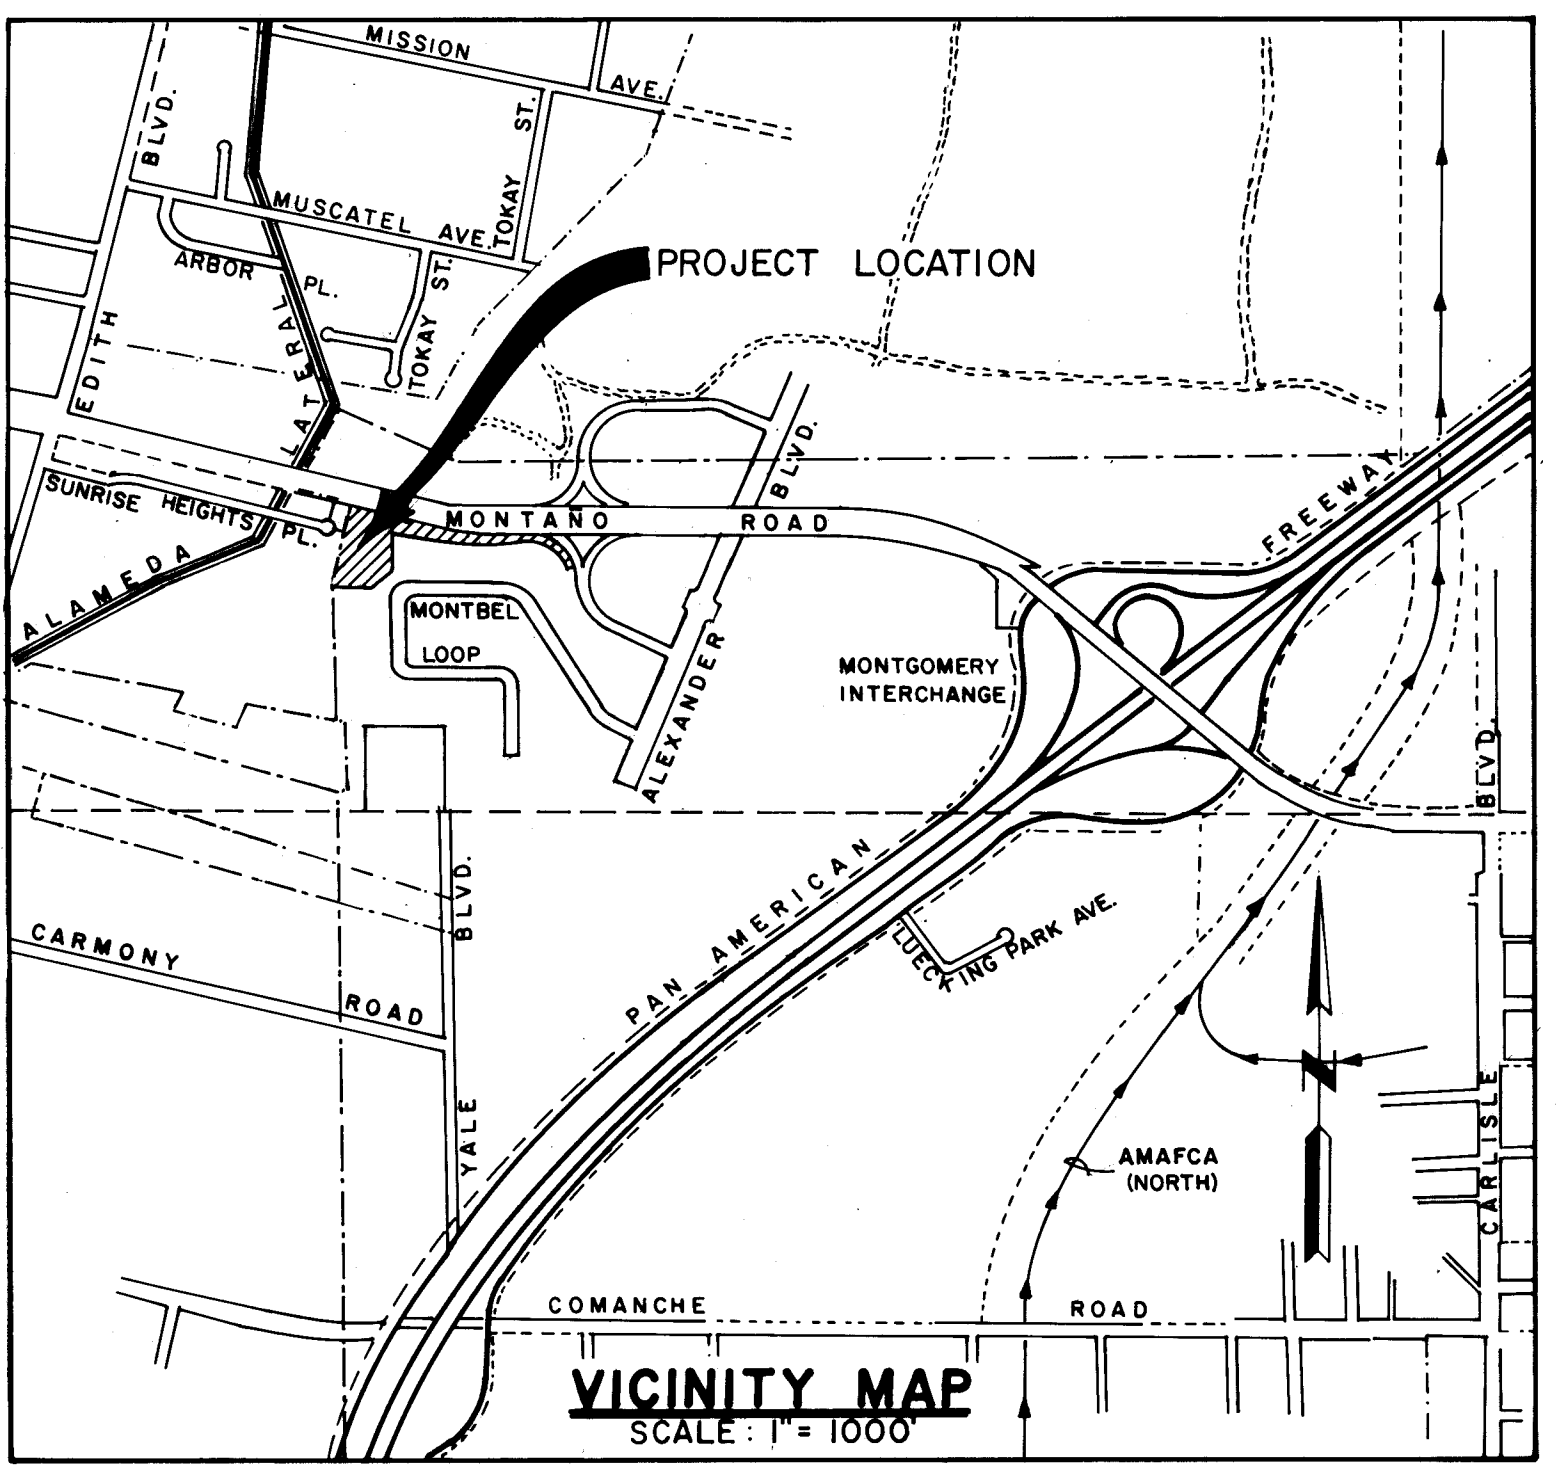


ALBUQUERQUE GRAVEL PRODUCTS COMPANY

AGP - MONTBEL
DETENTION BASIN

ANDREWS, ASBURY & ROBERT, INC.
CONSULTING ENGINEERS
ALBUQUERQUE NEW MEXICO

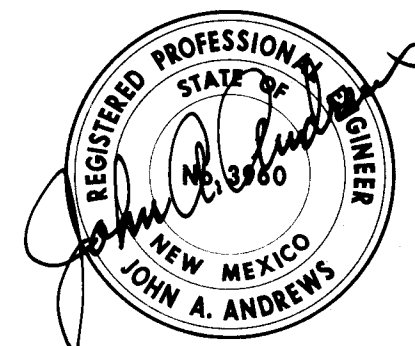

INDEX


DESCRIPTION	SHEET No.
TITLE SHEET	1
SUBDIVISION PLAT	2
SUBDIVISION PLAT	3
LOCATION & GRADING PLAN & GENERAL NOTES	4
GRADING PLAN, SECTIONS & DETAILS	5
INLET PLAN & SECTIONS	6
SPILLWAY & OUTLET WORKS	7
SECTIONS & DETAILS	8
SECTIONS & DETAILS	9
STORM DRAIN PLAN & PROFILE	10

26 1865 0184

APPROVAL OF AS BUILT DRAWINGS
ASST. CITY ENGINEER - FIELD
W. F. McPherson
DATE 7/5/84

RECORD DRAWING

APPROVED FOR
CONSTRUCTION
W. F. McPherson 7/5/84
CITY ENGINEER DATE

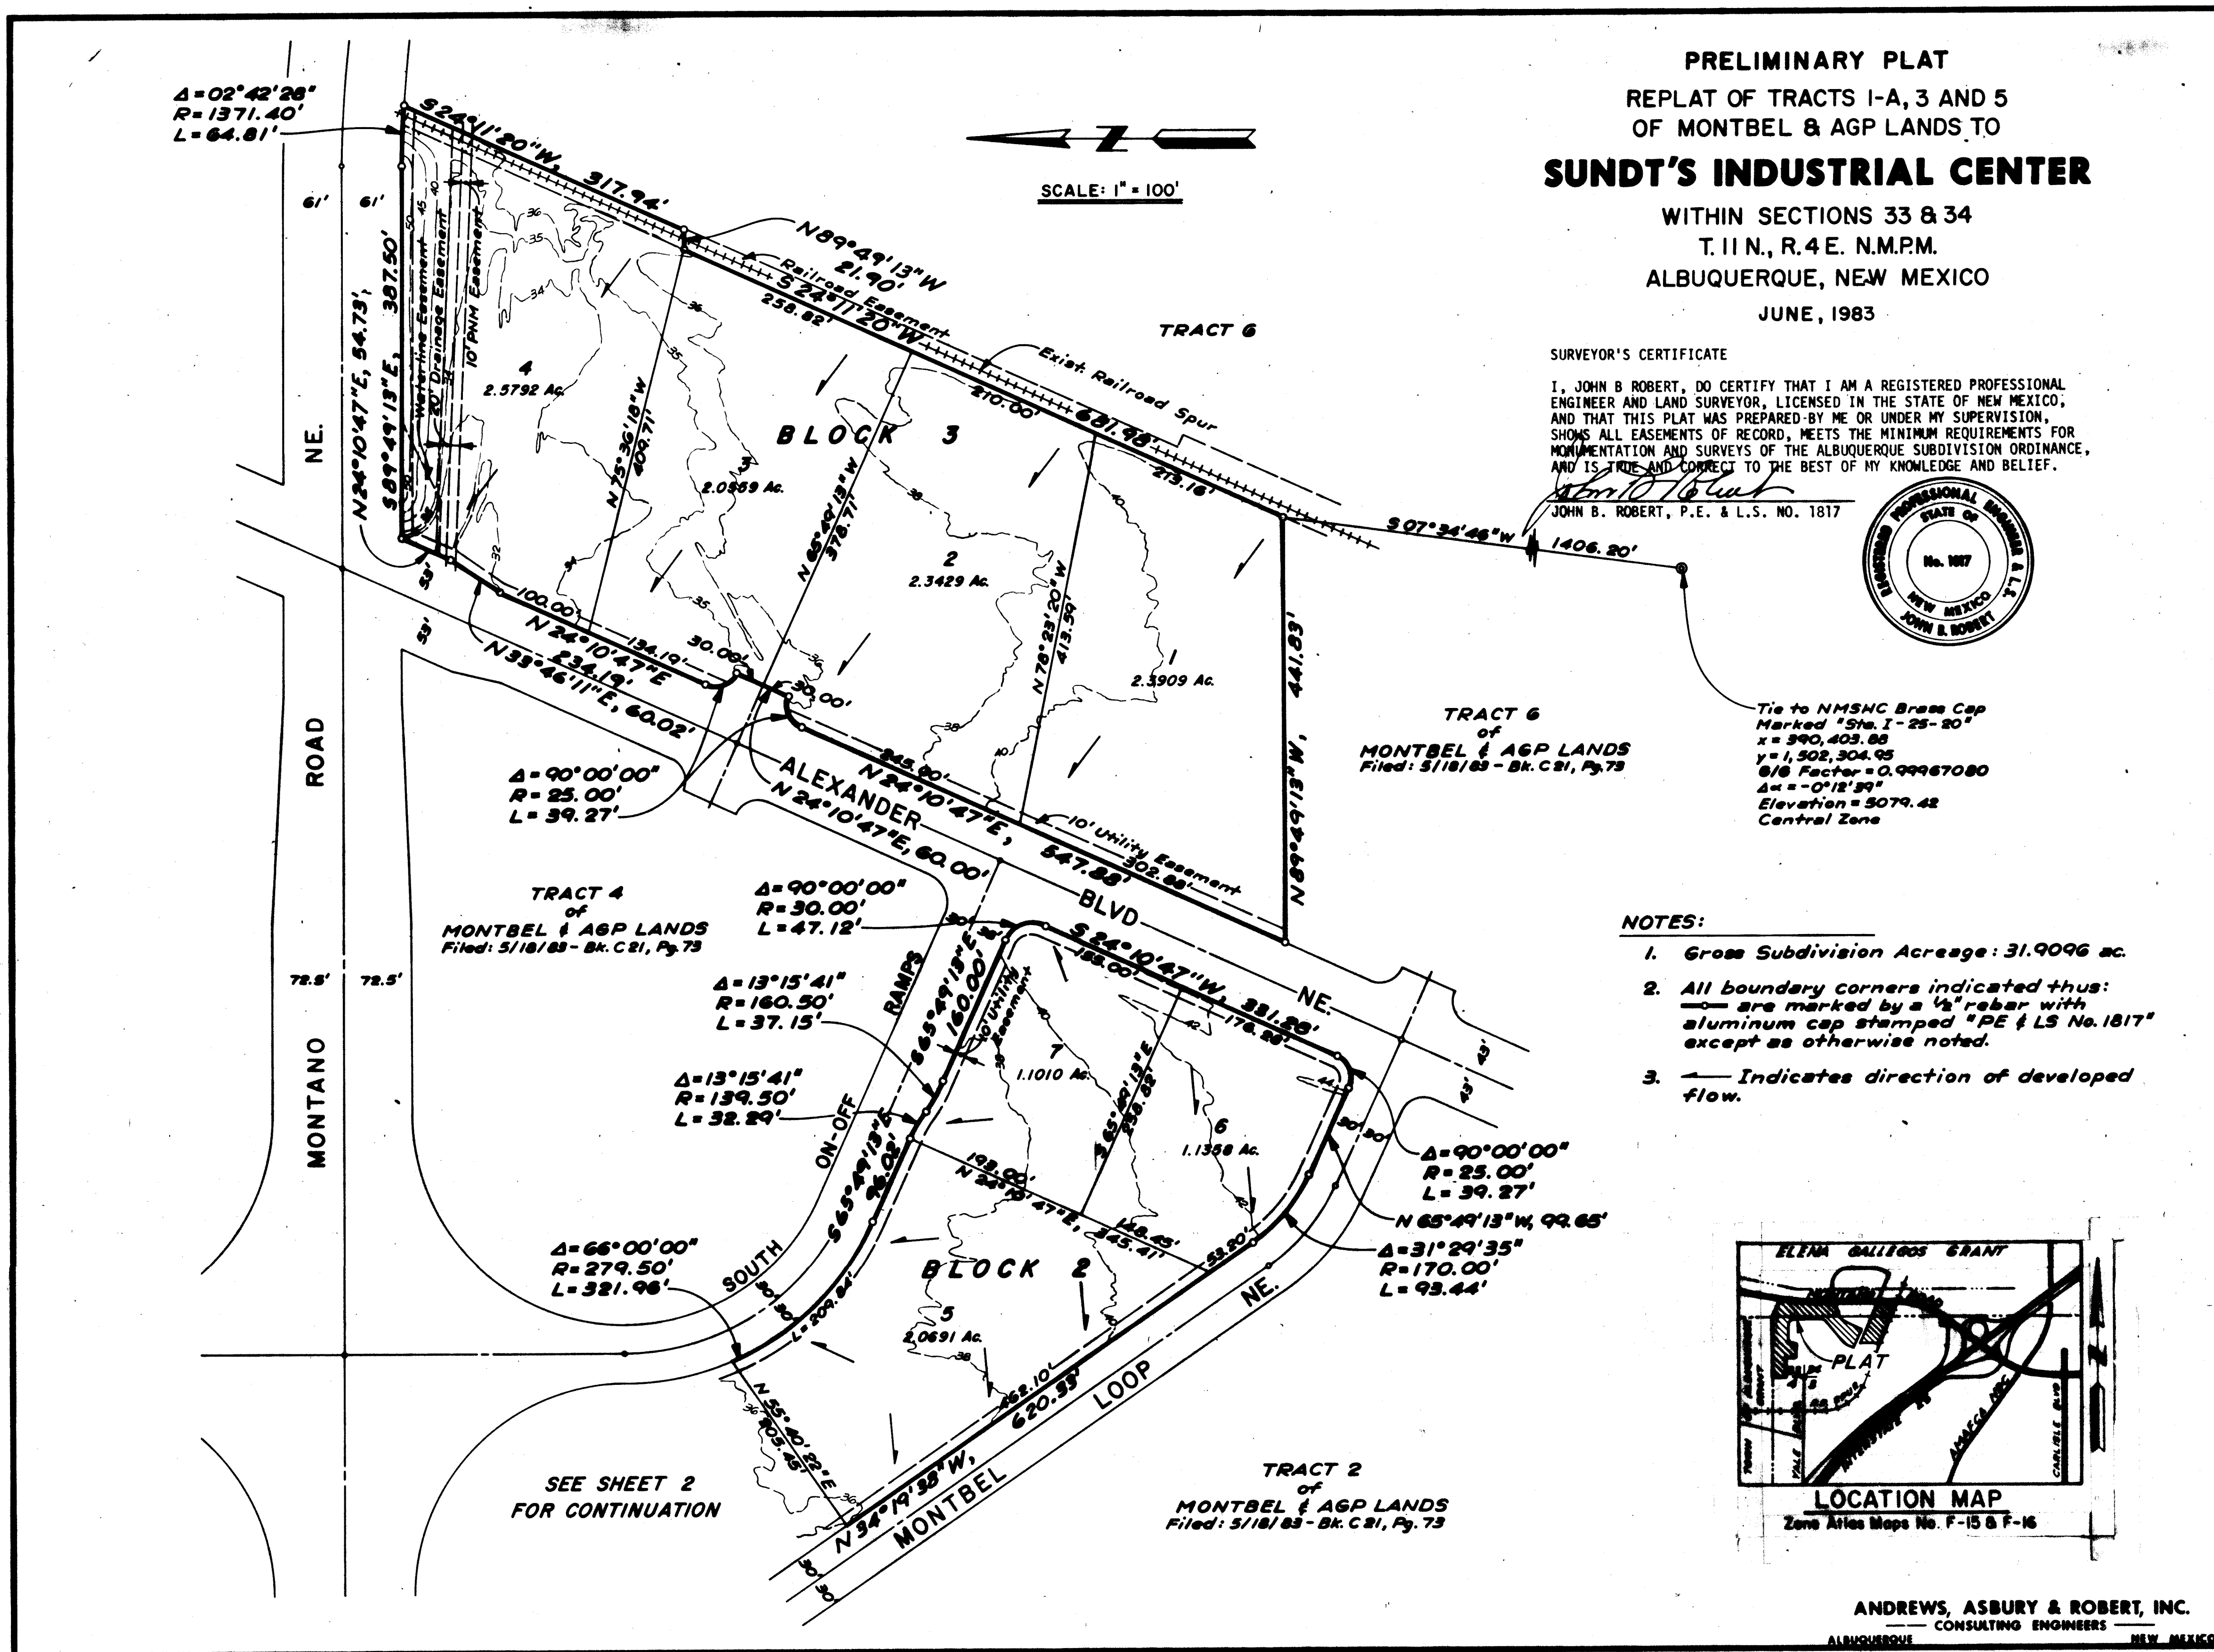

RECORD DRAWING


AS BUILT INFORMATION		BENCH MARKS		SURVEY INFORMATION		ENGINEER'S SEAL		REVISIONS		DESIGN	
CONTRACTOR	DATE	NO.	BY	NO.	BY	NO.	DATE	NO.	DATE	NO.	DATE
KNC Inc.	7-25-83										
WORK BY	DATE										
INSPECTION	DATE										
ACCEPTANCE BY	DATE										
FIELD LOCATION BY	DATE										
DRAWINGS BY	DATE										
CORRECTED BY	DATE										
MICRO-FILM INFORMATION	DATE										
RECORDED BY	DATE										
NO.											

APPROVED FOR CONSTRUCTION
CITY ENGINEER
DATE 9/16/83
MHC-CRO

CITY OF ALBUQUERQUE
MUNICIPAL DEVELOPMENT DEPARTMENT
ENGINEERING DIVISION
AGP/MONTBEL DETENTION BASIN
SUBDIVISION PLAT

APPROVALS	ENGINEER	DATE	APPROVALS	ENGINEER	DATE
City Engineer	C. D. Higgins	9/16/83	Liquid Waste	W. J. W. J.	9-1-83
A.C.E.-Design	P. J. W. J.	9/16/83	Traffic	N.A.	
A.C.E.-Hydrology	P. J. W. J.	9/16/83	Water	N.A.	9-1-83


DRAWING NO. 1865
MAP NO. F-15 & F-16
SHEET 2 OF 10

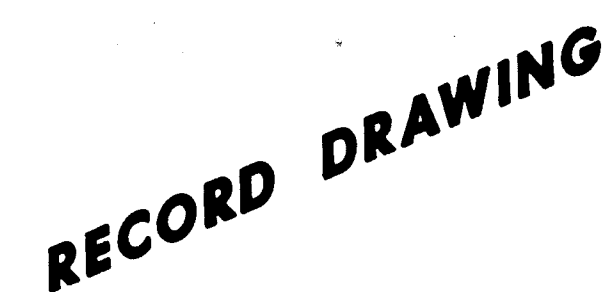

APPROVALS			ENGINEER	DATE
Waste	NA	WJ		9-1-83
c	NA	NA		
	NA	WJ		9-1-83

SHEET 3 OF 10

F-16

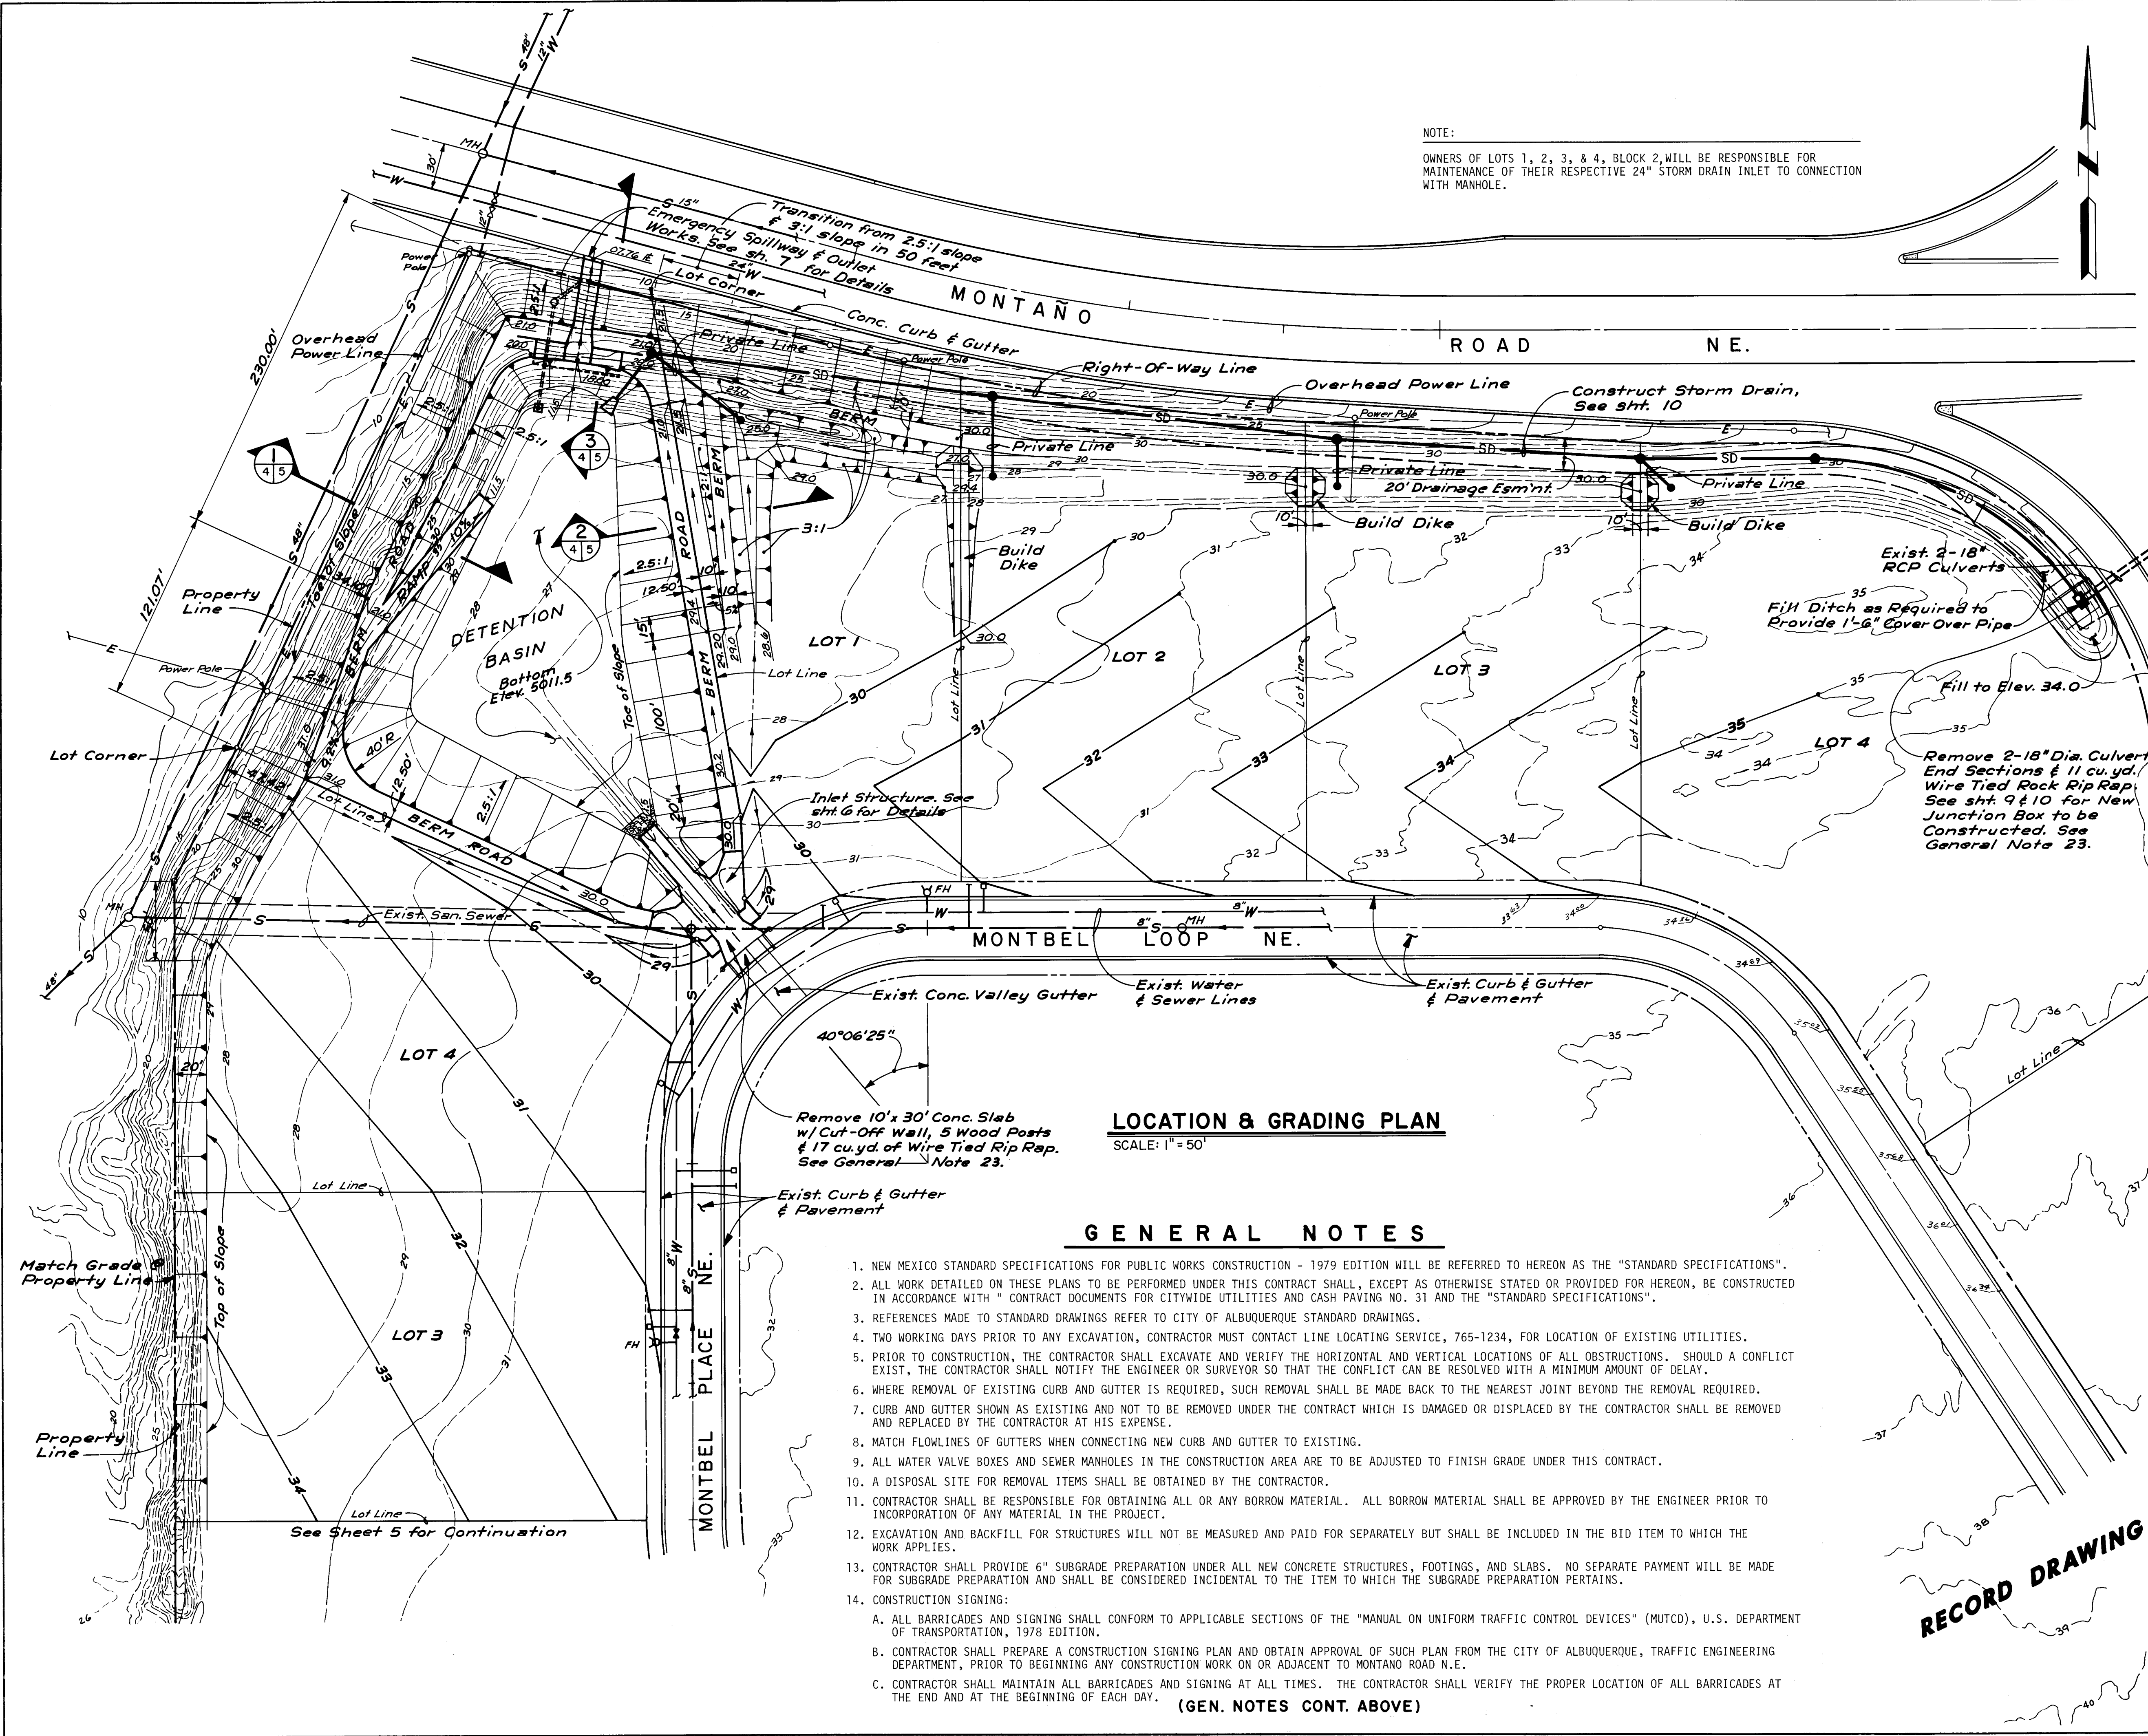

**GENERAL NOTES
(CONTINUED)**

- CONTRACTOR SHALL REMOVE AND DISPOSE OF ALL OBJECTIONABLE MATERIAL FROM THE CONSTRUCTION AREA. PAYMENT FOR SUCH REMOVAL SHALL BE MADE UNDER THE BID ITEM - REMOVAL OF STRUCTURES & OBSTRUCTIONS.
- EXCAVATION WITHIN THE CONSTRUCTION AREA WILL BE PAID FOR UNDER THE BID ITEM - UNCLASSIFIED EXCAVATION, AND SUCH PAYMENT SHALL INCLUDE THE PLACEMENT AND COMPACTION OF EXCAVATED MATERIAL IN EMBANKMENTS IN CONFORMANCE WITH SECTION 203 - FILL CONSTRUCTION.
- ITEMS OF CONSTRUCTION INCLUDED IN THE BID PROPOSAL THAT ARE BID PER EACH OR LUMP SUM WILL NOT BE MEASURED AND PAID FOR PER CUBIC YARD. SUCH BID ITEMS THAT ARE BID PER EACH OR LUMP SUM SHALL INCLUDE ALL CONCRETE, REINFORCING STEEL, EXCAVATION AND BACKFILL, AND ALL OTHER WORK FOR A COMPLETE INSTALLATION.
- REINFORCED CONCRETE STRUCTURES SHALL HAVE REINFORCING STEEL CONTINUOUS AT ALL CORNERS.
- DOWELS SHALL BE PROVIDED AT ALL CONNECTIONS OF REINFORCED CONCRETE CONSTRUCTION.
- ALL EXPOSED CONCRETE SURFACES, TO A MINIMUM OF 6 INCHES BELOW FINISHED GRADE, SHALL BE FINISHED WITH "THOROSEAL" AS PER MNSHD SPECIFICATIONS FOR ROAD AND BRIDGE CONSTRUCTION, PARAGRAPH 509.037, TYPE 1.
- 24" RCP FOR STORM DRAIN INLETS WILL BE MEASURED PER LINEAR FT. ALONG THE CENTERLINE OF THE PIPE FROM CENTERLINE OF MANHOLE, THROUGH THE 90° ELL FITTING AND VERTICAL TO THE TOP OF THE PIPE. BID ITEM FOR 90° ELL FITTING SHALL INCLUDE THE COST FOR SPECIAL FABRICATION ONLY.
- TRENCHING AND BACKFILLING FOR STORM DRAIN INLETS WILL BE MEASURED HORIZONTAL ONLY FROM CENTERLINE OF MANHOLE TO CENTERLINE OF VERTICAL 24" RCP INLET.
- CONTRACTOR SHALL CALL CITY STREET DIVISION TELE: 766-7755 FOR PICK UP AND COLLECTION OF RIPRAP MATERIAL.

LEGEND

- Existing Contours
- New Finish Grade Contours
- New Finish Grade Spot Elevation

26. 1865. 0484

[Signature]
MH for GRO 9/14/83


**CITY OF ALBUQUERQUE
MUNICIPAL DEVELOPMENT DEPARTMENT
ENGINEERING DIVISION**

**AGP/MONTBEL DETENTION BASIN
LOCATION & GRADING PLAN & GENERAL NOTES**


APPROVALS	ENGINEER	DATE	APPROVALS	ENGINEER	DATE
City Engineer	<i>[Signature]</i>	9/14/83	Liquid Waste	NA	9-1-83
A.C.E.-Design	<i>[Signature]</i>	9/14/83	Traffic	NA	9-1-83
A.C.E.-Hydrology	<i>[Signature]</i>	9/14/83	Water	NA	9-1-83

DRAWING NO.	1865	MAP NO.	F-15 & F-16	SHEET	4 OF 10
-------------	------	---------	-------------	-------	---------


AS BUILT INFORMATION		BENCH MARKS		SURVEY INFORMATION		FIELD NOTES		ENGINEER'S SEAL		REVISIONS		DESIGN		DATE	
CONTRACTOR	KVC Inc.	DATE	9-25-84	NO.	DATE	NO.	DATE	REGISTERED PROFESSIONAL ENGINEER	STATE OF NEW MEXICO	NO.	DATE	DESIGNED BY	JA	DATE	Aug. 1983
INSPECTOR	A.A. & R.	DATE	9-25-84	BY	DATE	BY	DATE	SEAL	DATE	NO.	DATE	DRAWN BY	JCS, PMO	DATE	Aug. 1983
ACCEPTANCE BY	A.A. & R.	DATE	9-25-84	NO.	DATE	NO.	DATE	REGISTERED PROFESSIONAL ENGINEER	STATE OF NEW MEXICO	NO.	DATE	CHECKED BY	JA	DATE	Aug. 1983
VERIFICATION BY	A.A. & R.	DATE	9-25-84	NO.	DATE	NO.	DATE	REGISTERED PROFESSIONAL ENGINEER	STATE OF NEW MEXICO	NO.	DATE	DESIGNED BY	JA	DATE	Aug. 1983
CORRECTED BY	A.A. & R.	DATE	9-25-84	NO.	DATE	NO.	DATE	REGISTERED PROFESSIONAL ENGINEER	STATE OF NEW MEXICO	NO.	DATE	DRAWN BY	JCS, PMO	DATE	Aug. 1983
MICRO-FILM INFORMATION		DATE		NO.	DATE	NO.	DATE	REGISTERED PROFESSIONAL ENGINEER	STATE OF NEW MEXICO	NO.	DATE	CHECKED BY	JA	DATE	Aug. 1983

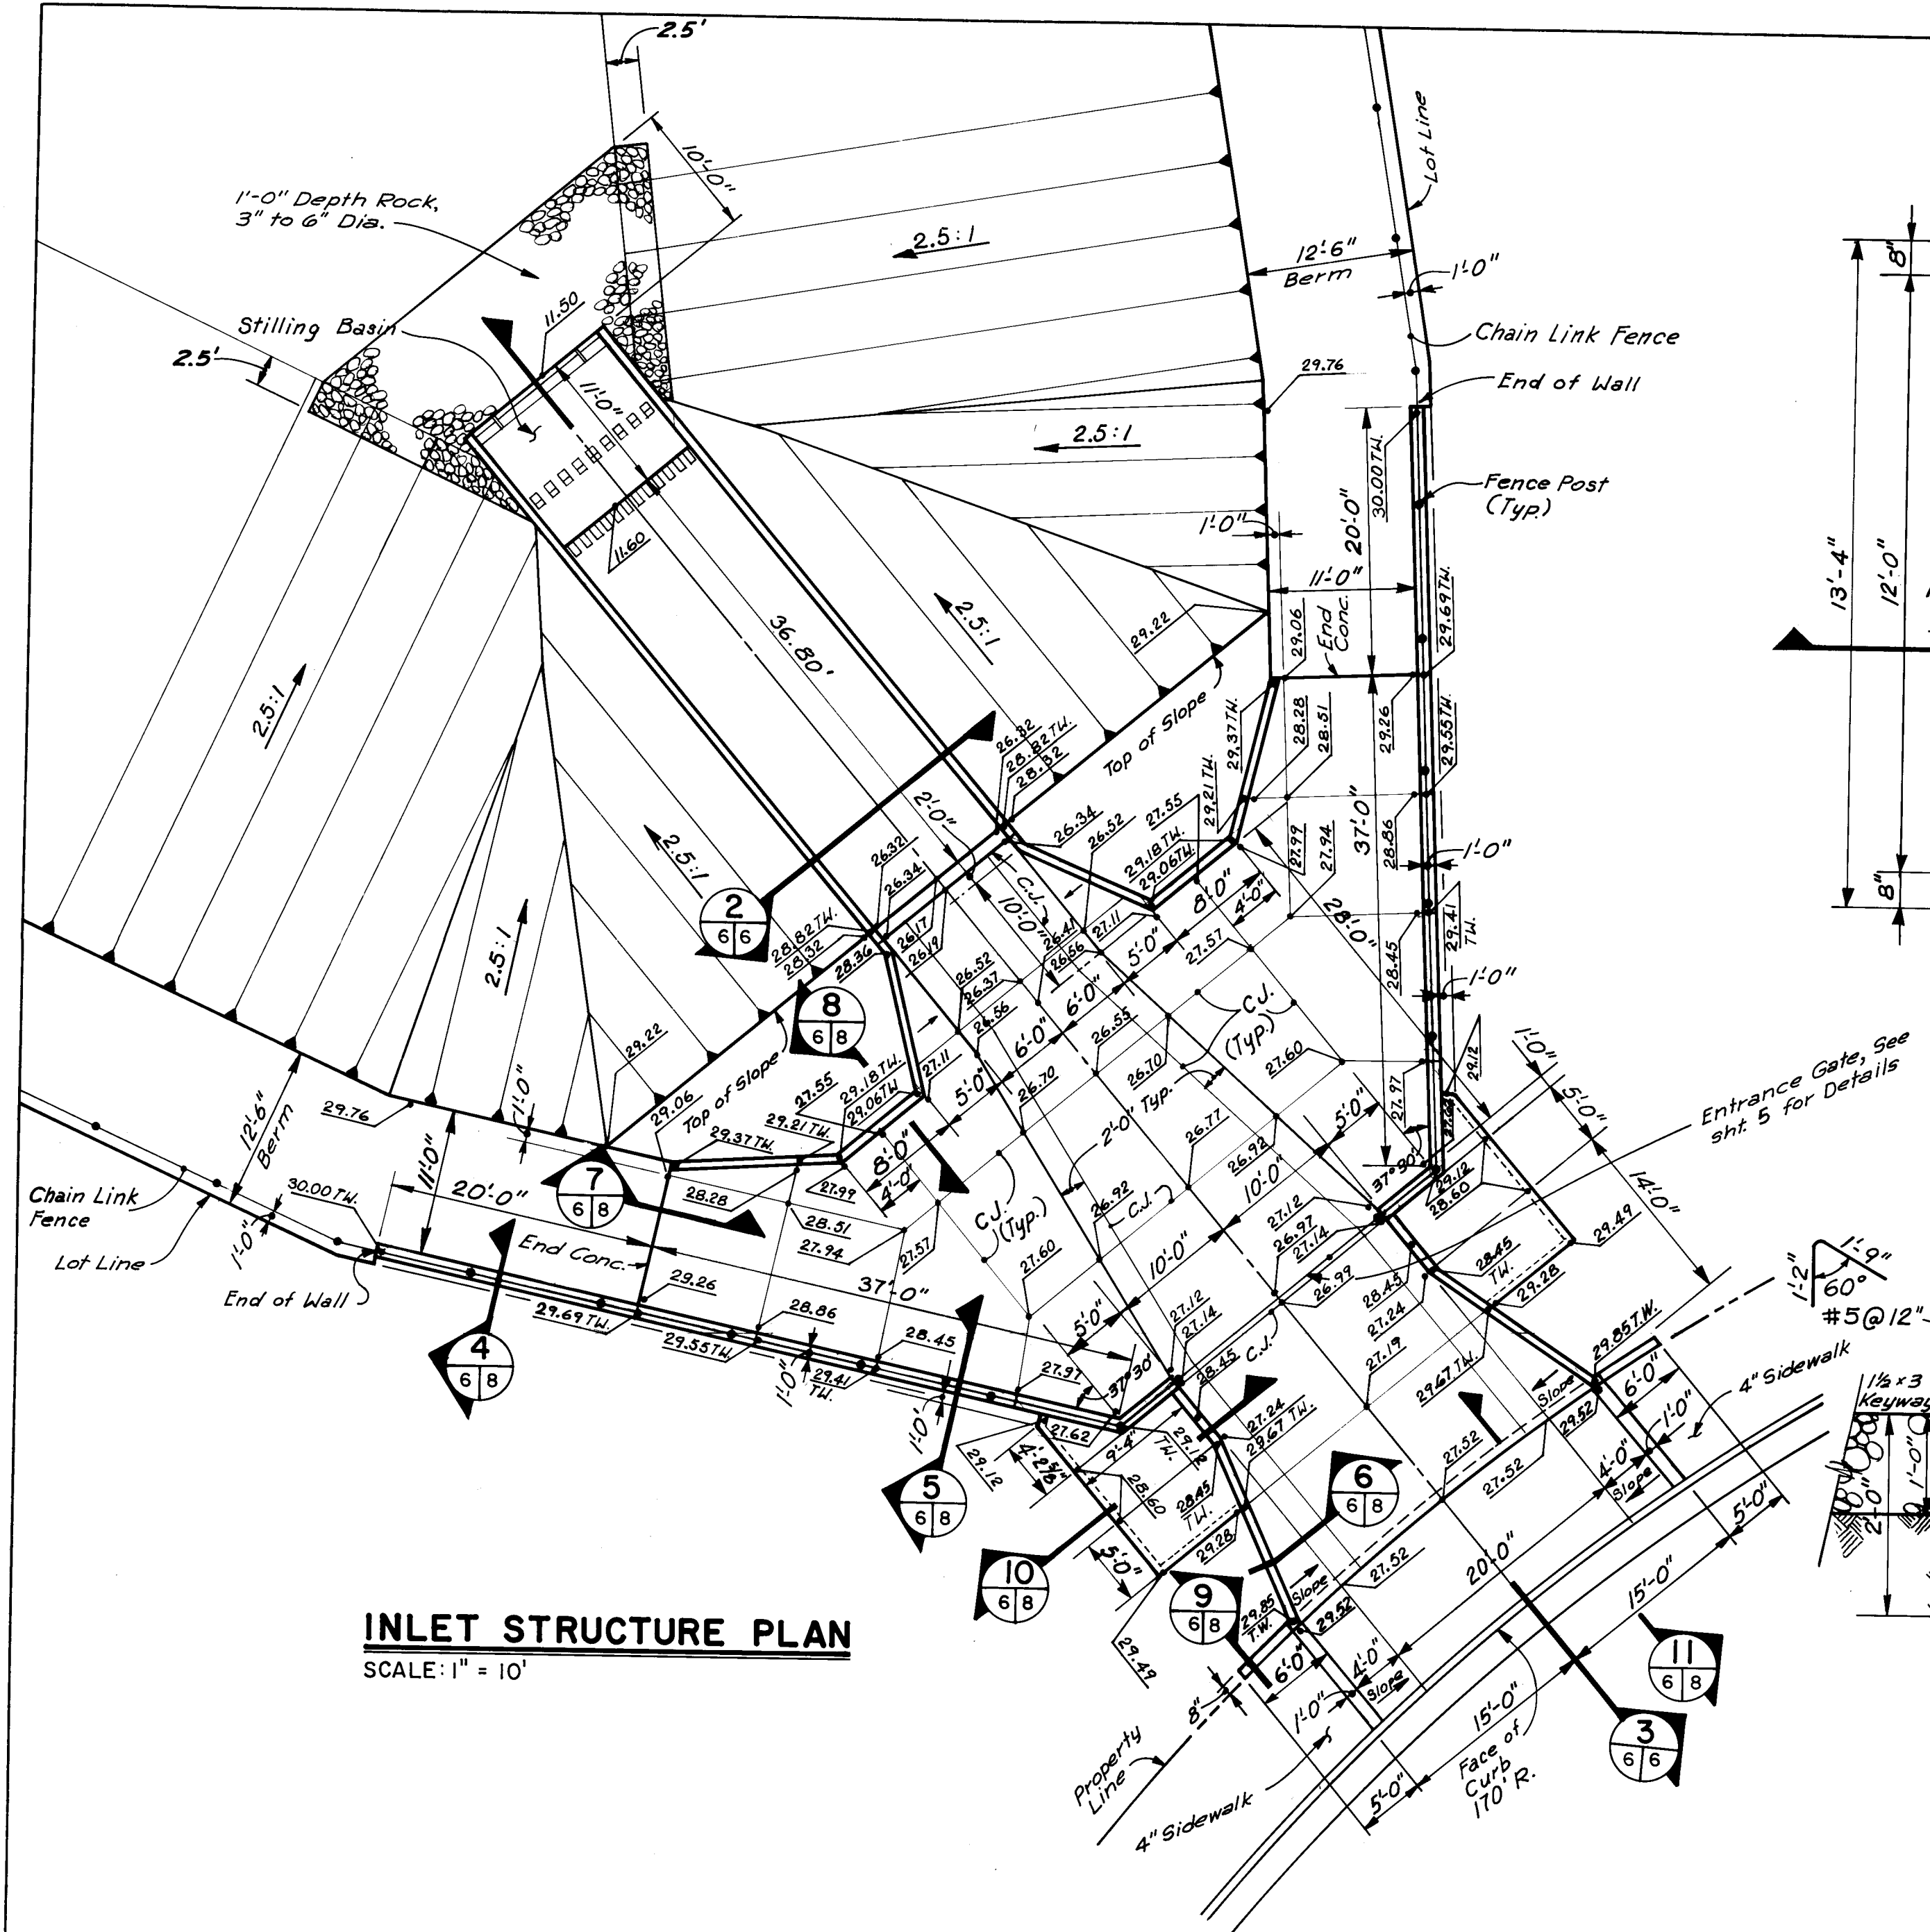


INLET STRUCTURE PLAN
SCALE: 1" = 10'

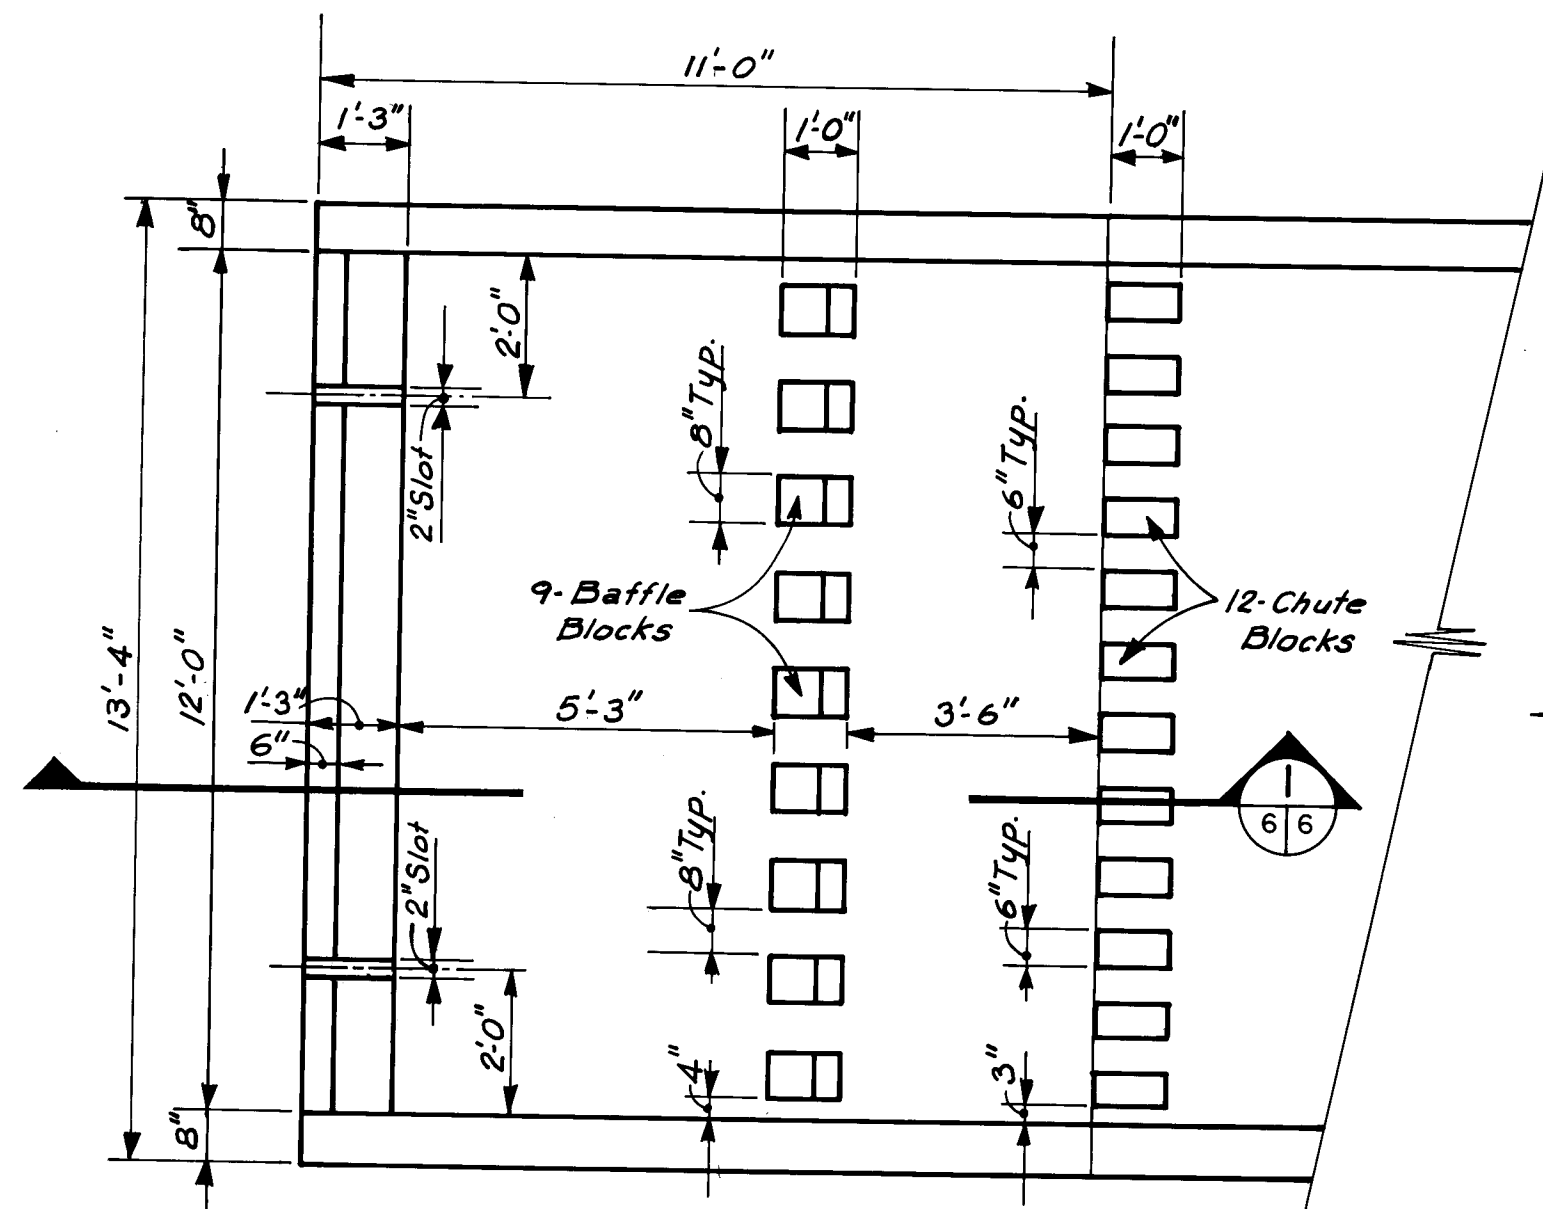


STILLING BASIN PLAN
SCALE: 3/8" = 1'-0"

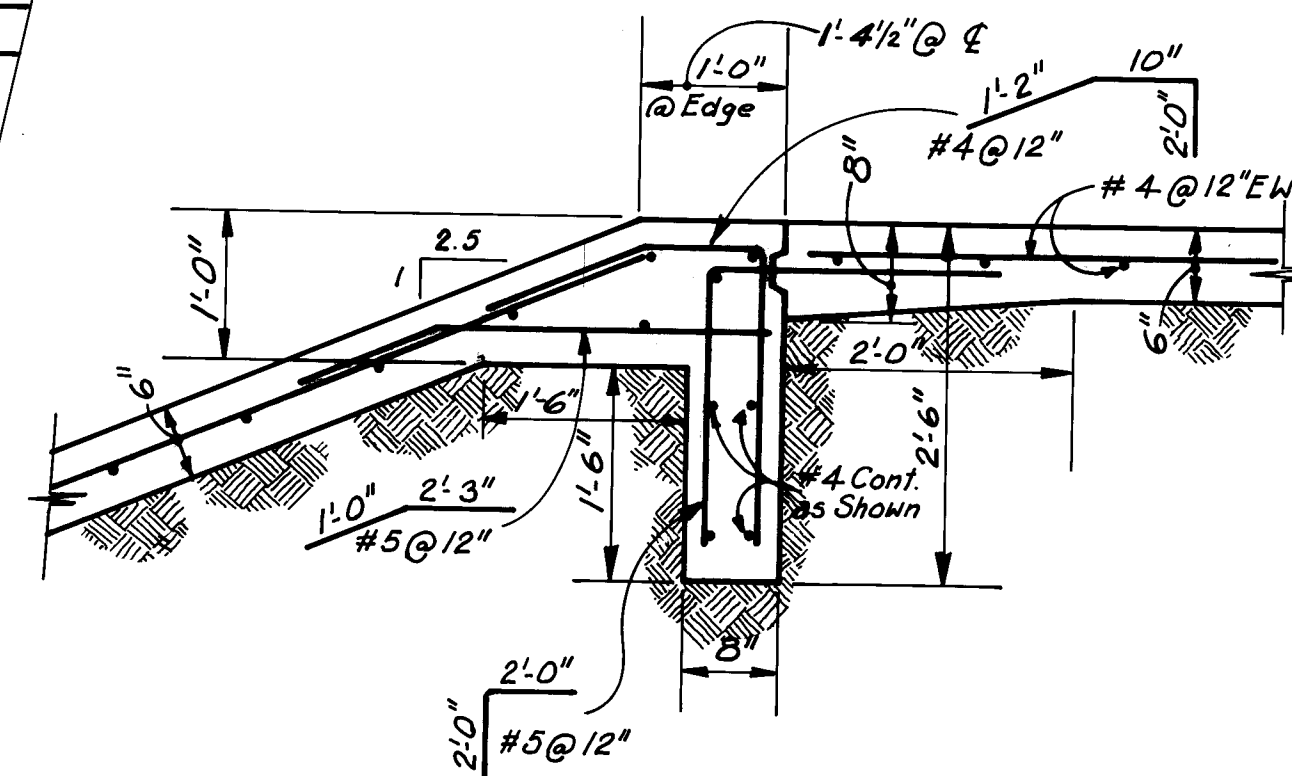


DETAIL A
SCALE: 3/4" = 1'-0"

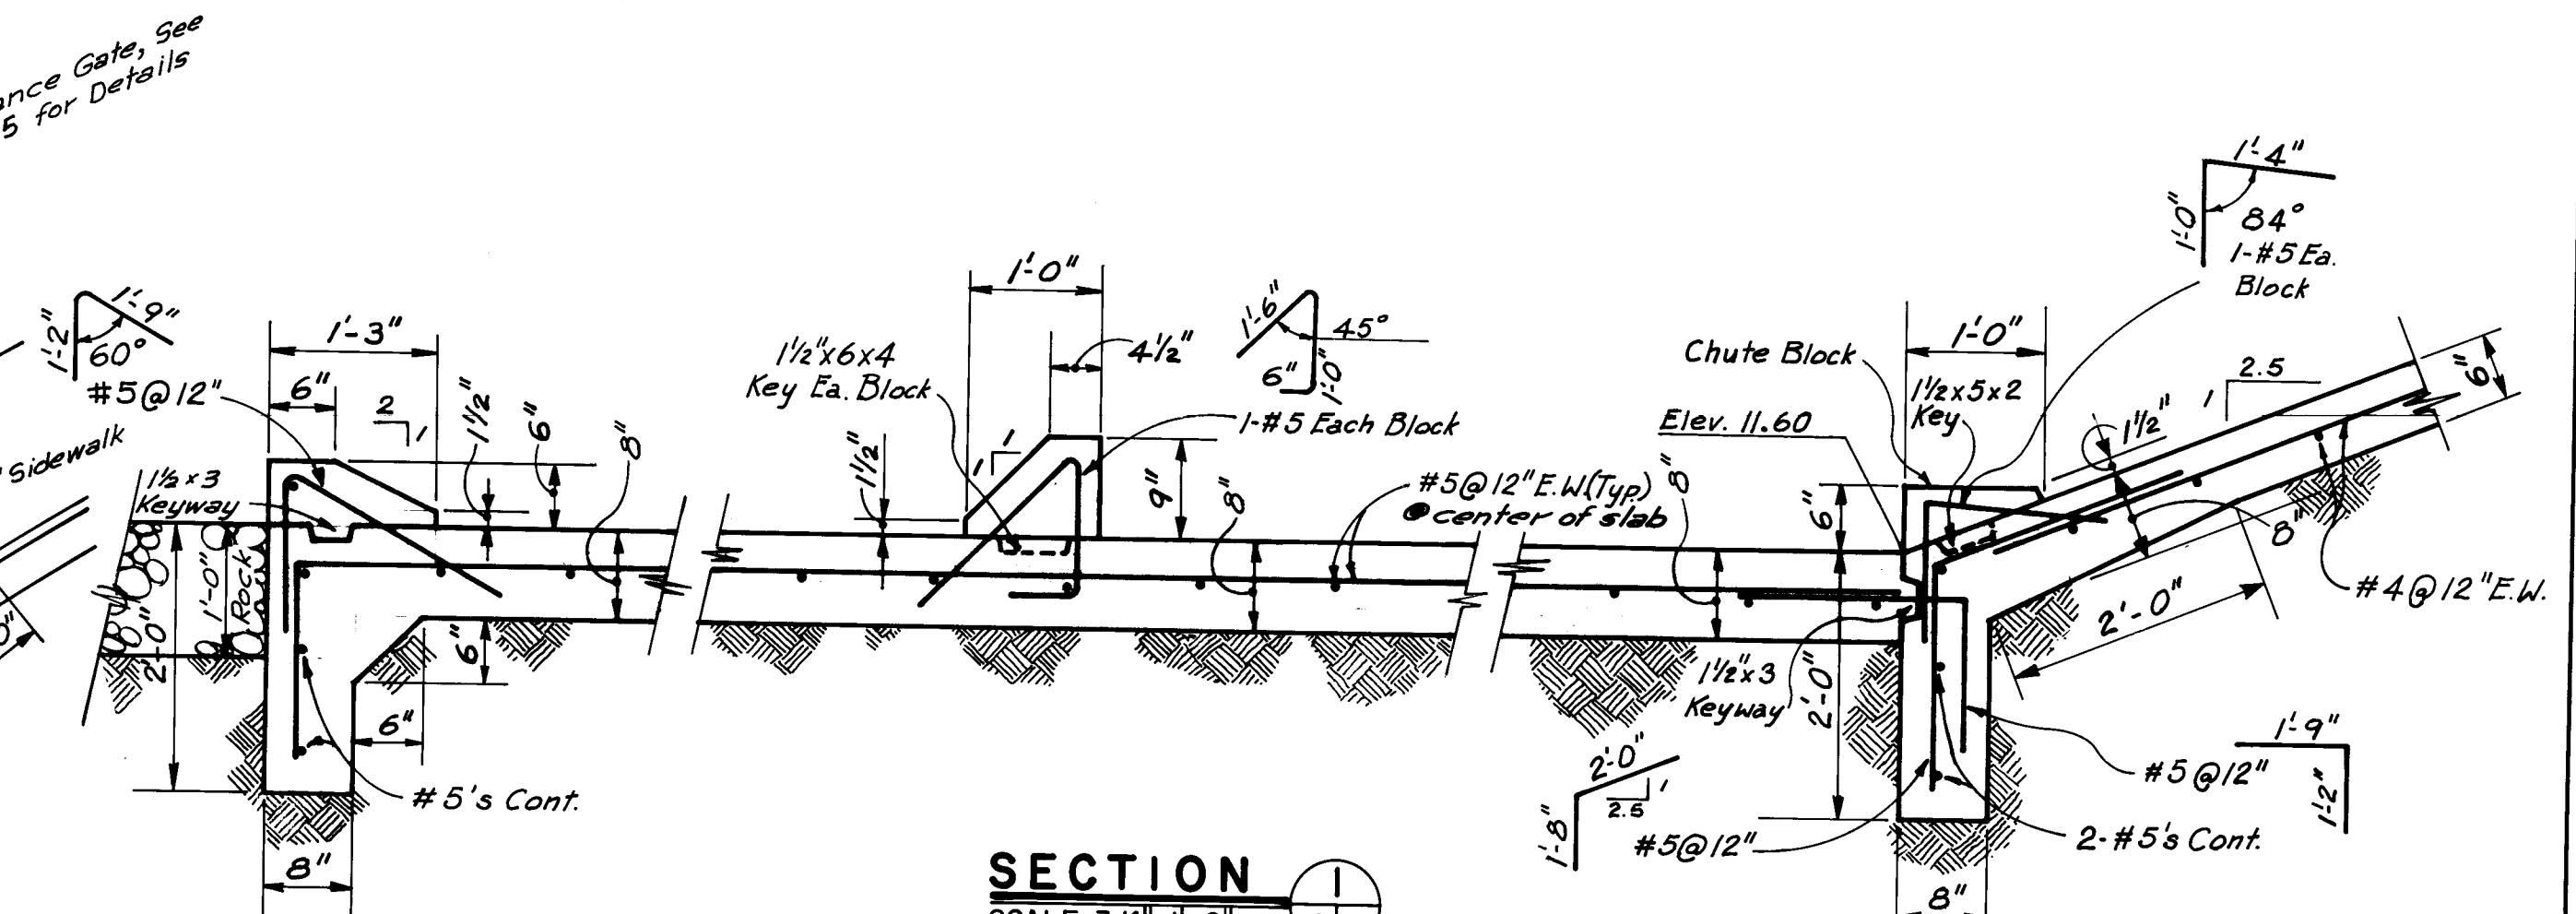

SECTION 1
SCALE: 3/4" = 1'-0"

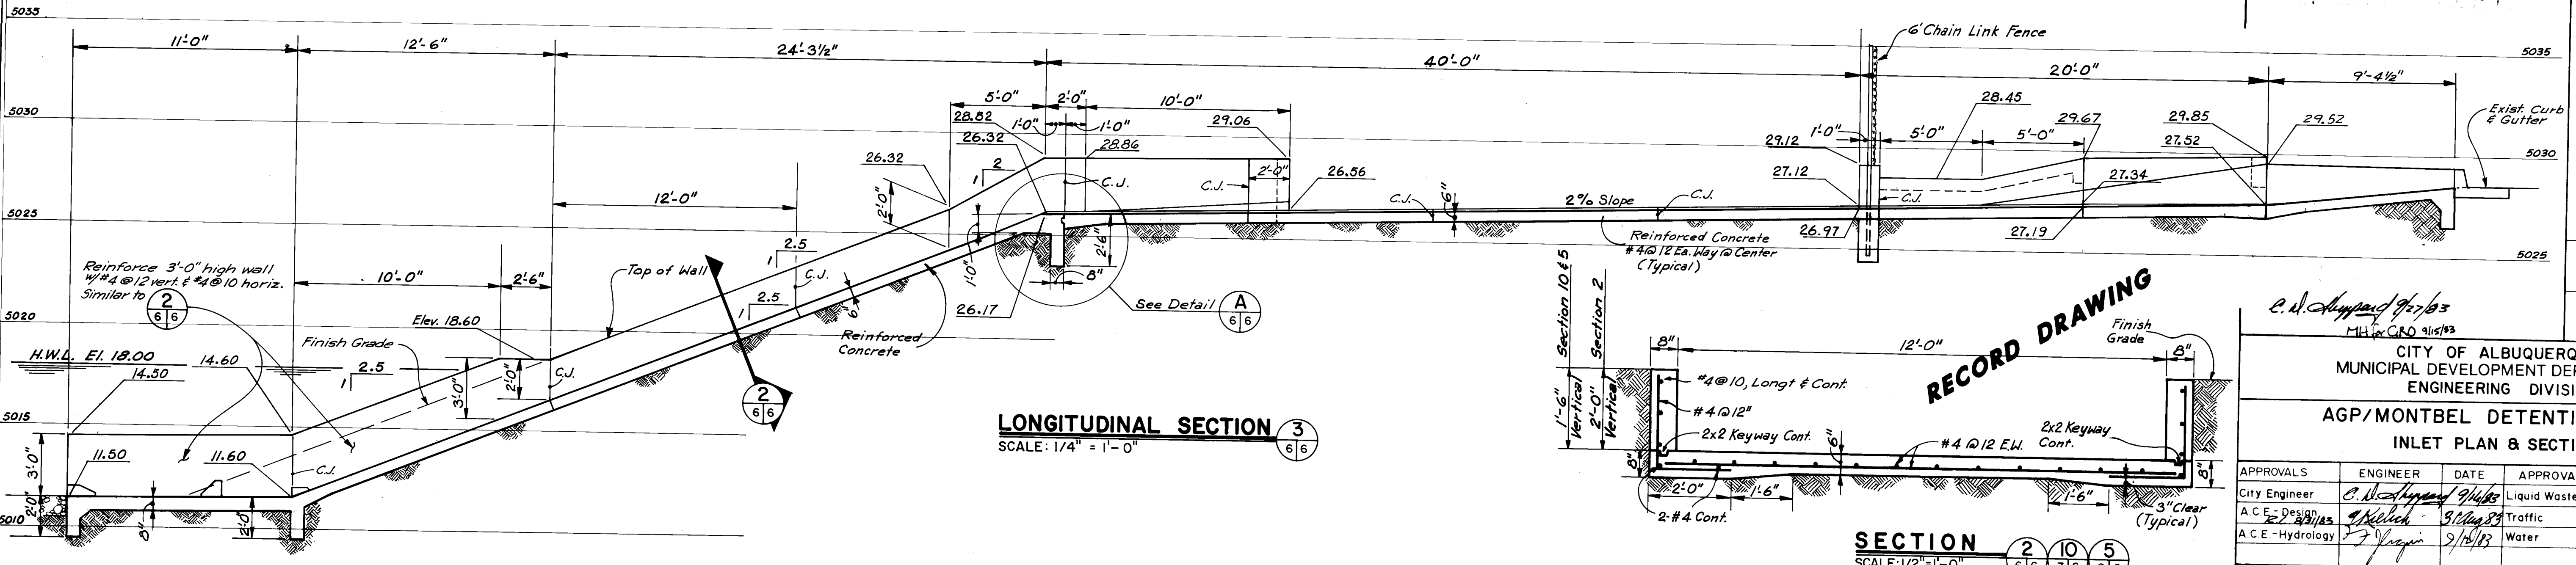


LONGITUDINAL SECTION 3
SCALE: 1/4" = 1'-0"

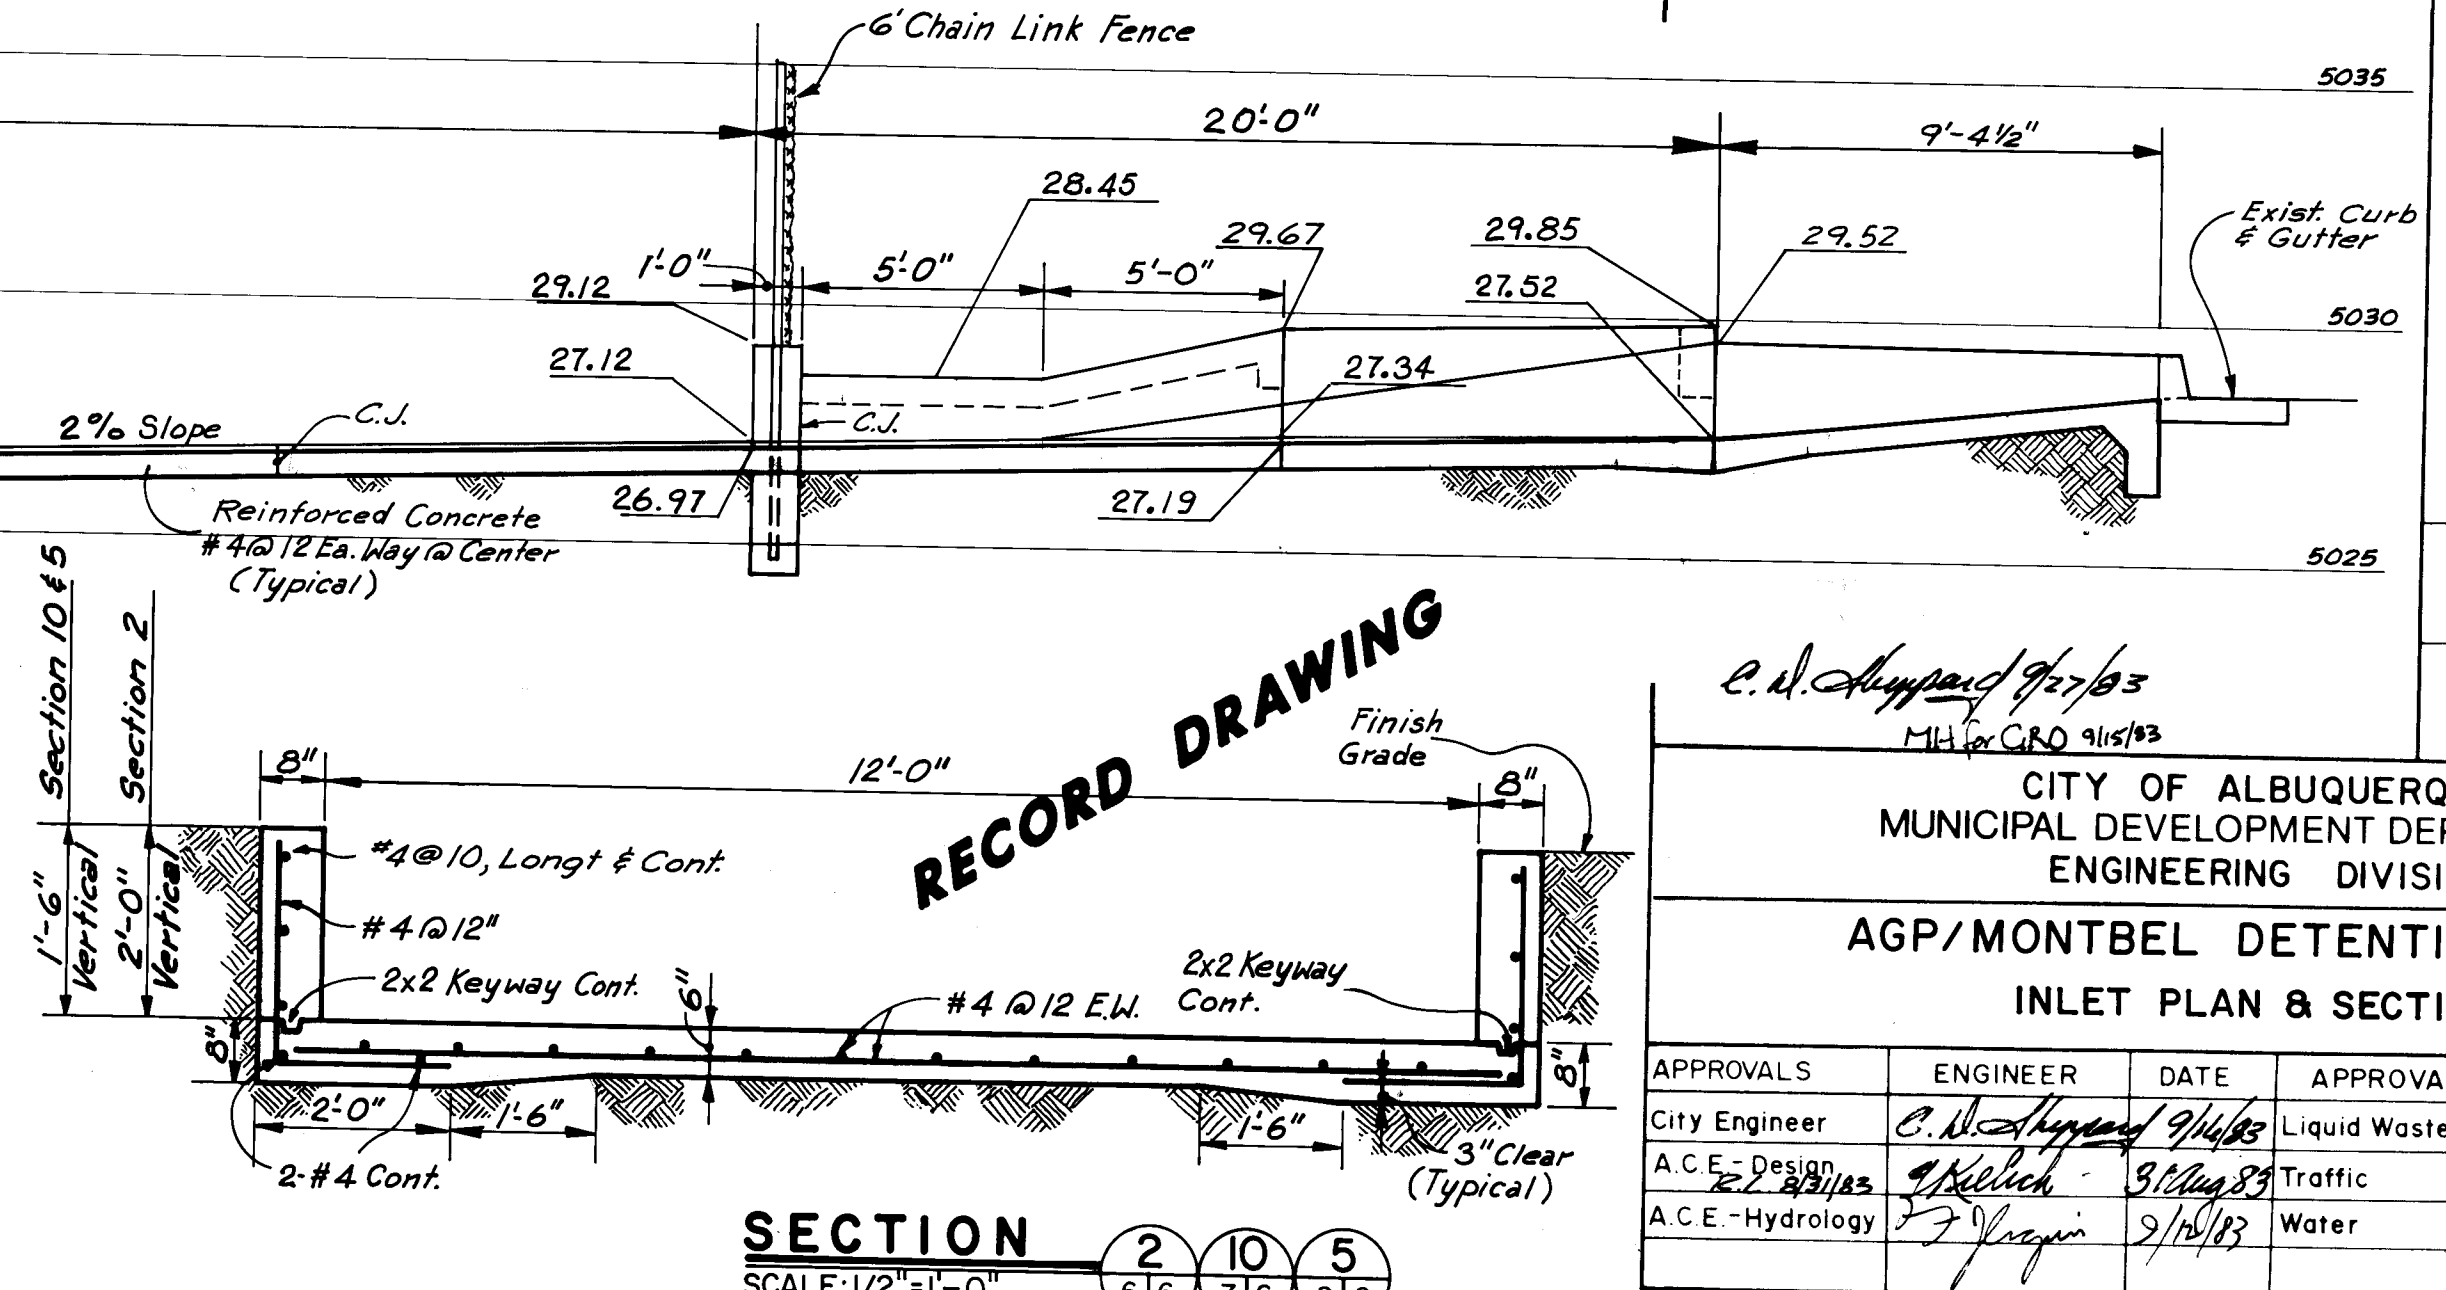


SECTION 2
SCALE: 1/2" = 1'-0"


NOTE:
3/4" Chamfer all exposed
Concrete Edges - Typical.

ENGINEER'S SEAL				SURVEY INFORMATION				BENCH MARKS				AS BUILT INFORMATION			
 ANDREWS ASBURY & ROBERT, INC. CONSULTING ENGINEERS ALBUQUERQUE, N.M. 87106				FIELD NOTES		DATE		ACS STA. 2+FT6 ELEVATION = 5062.08		CONTRACTOR KVC Inc.		DATE 8-23-84			
				NO.	BY	STANDARD ACS BRASS TABLET ON TOP OF CONCRETE POST PROJECTING 0.2 FT. ABOVE GROUND LOCATION 0.4 MILE WEST OF 1-25 IN THE MEDIAN ON MONTANO ROAD N.E.		INSPECTORS		WORK STAKED BY A.A. & R.		DATE 1-25-84			
				REVISIONS		DATE		CORRECTED BY A.A. & R.		DATE 8-28-84		VERIFICATION BY A.A. & R.		DATE 8-28-84	
				NO.	DATE	DESIGN		FIELD CHANGE BY		MICRO-FILM INFORMATION		RECORDED BY		DATE	
SHEET 6 OF 10				DESIGNED BY JA		DATE Aug. 1983		GROUND LOCATION 0.4 MILE WEST OF 1-25		NO		DATE			
				DRAWN BY JJ		DATE Aug. 1983		IN THE MEDIAN ON MONTANO ROAD N.E.							
				CHECKED BY JA		DATE Aug. 1983									

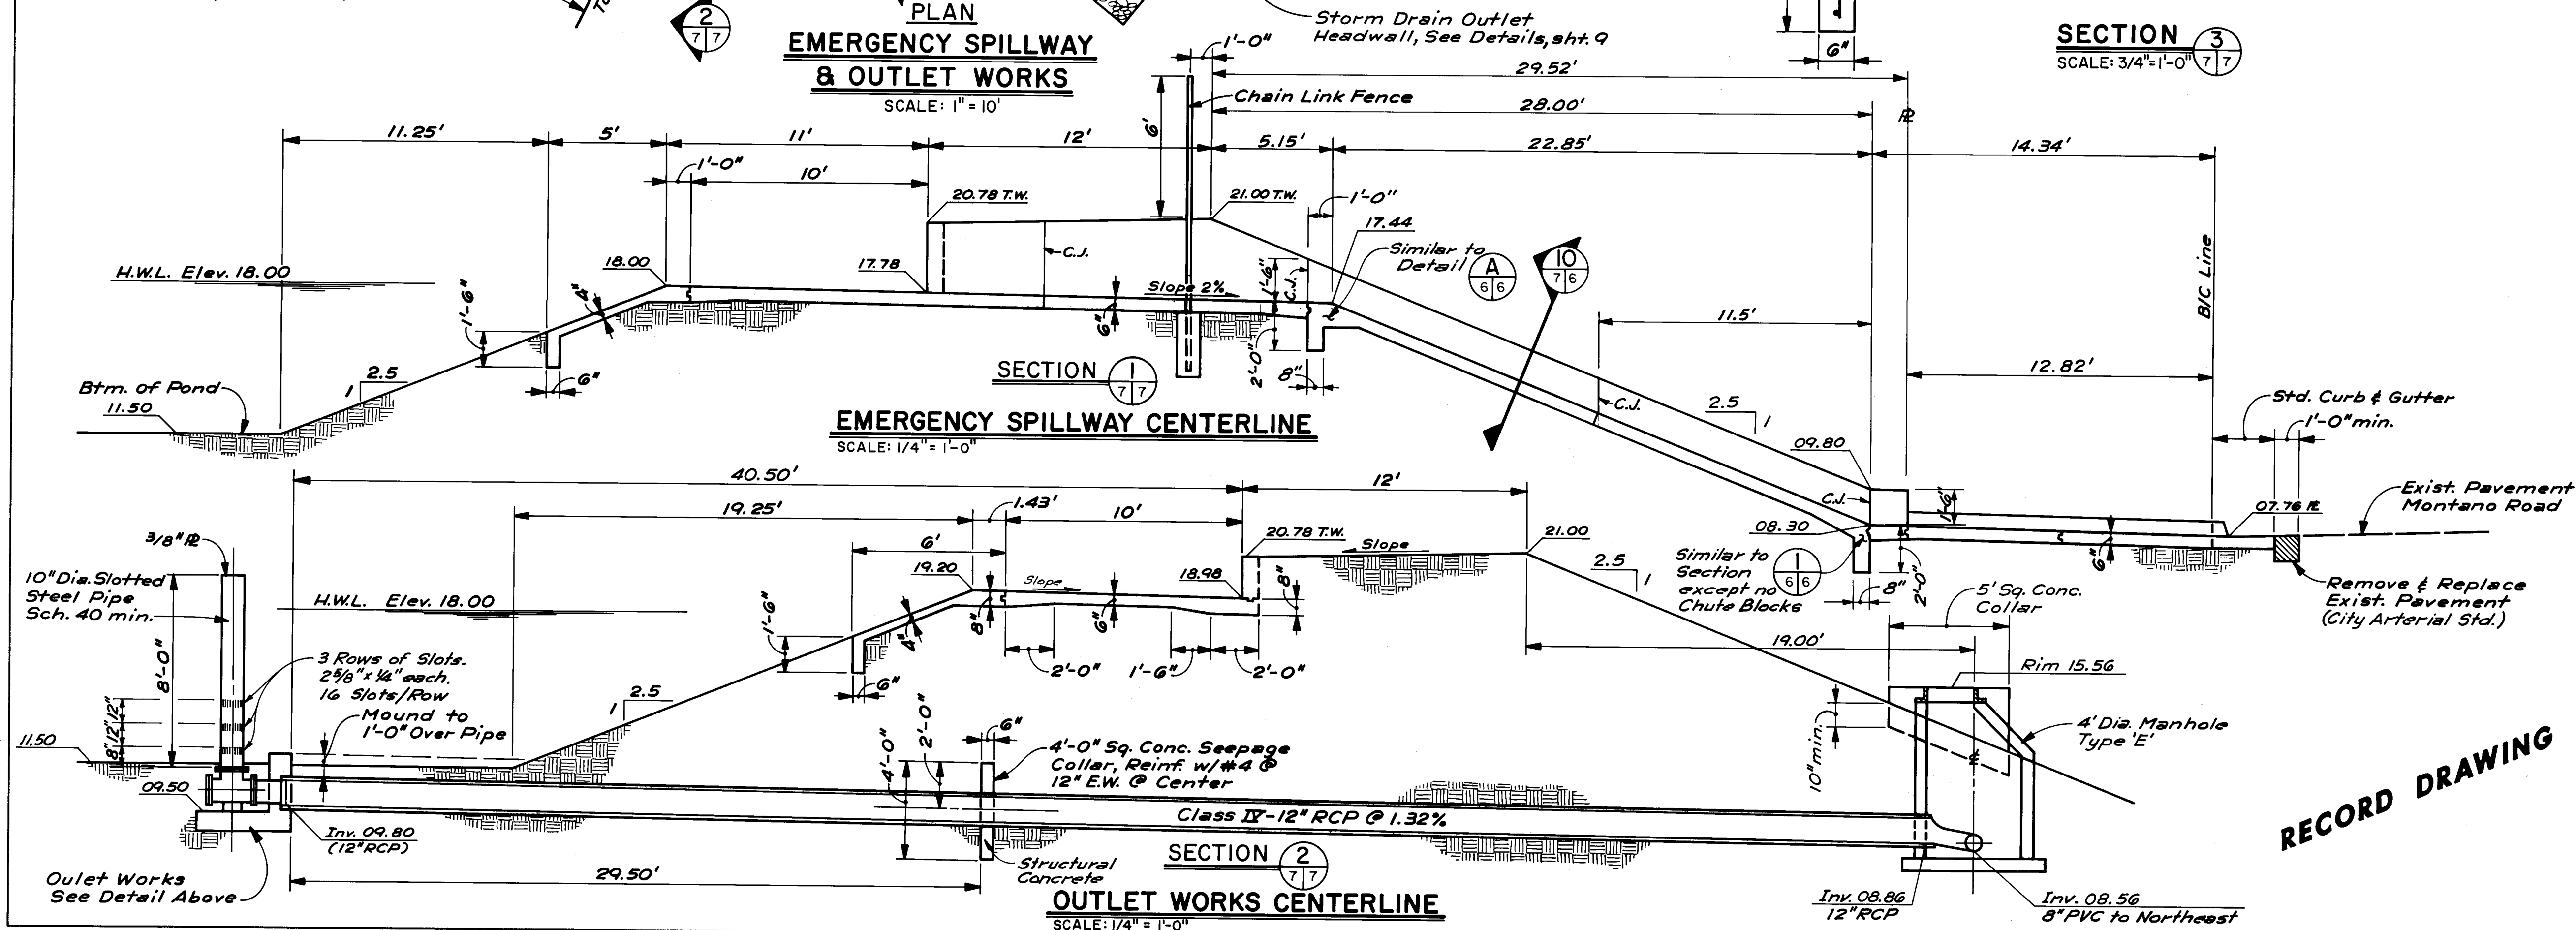


NOTE:
3/4" Chamfer all exposed
Concrete Edges - Typical.

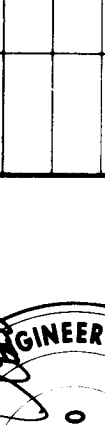
ENGINEER'S SEAL 			SURVEY INFORMATION FIELD NOTES		BENCH MARKS ACS STA. 2-F16 ELEVATION = 5062.03 STANDARD ACS BRASS TABLET ON TOP OF CONCRETE POST PROJECTING 0.2 FT. ABOVE GROUND LOCATED 0.4 MILE WEST OF 1-25 IN THE MEDIAN ON MONTANO ROAD N.E.		AS BUILT INFORMATION CONTRACTOR <i>KNC Inc</i> WORK ORDER BY <i>A.A. # R</i> INSPECTOR'S DATE <i>8-83</i> ACCEPTANCE BY DATE <i>1-25-84</i> VERIFICATION BY <i>A.A. # R</i> DATE <i>8-83</i> DRAWINGS BY <i>A.A. # R</i> DATE <i>8-7-84</i> MICRO-FILM INFORMATION RECORDED BY DATE NO	
DESIGNED BY <i>JA</i> DATE <i>Aug. 1983</i> DRAWN BY <i>PMO</i> DATE <i>Aug. 1983</i> CHECKED BY <i>JA</i> DATE <i>Aug. 1983</i>			REVISIONS NO. DATE REMARKS BY					
DESIGNED BY <i>JA</i> DATE <i>Aug. 1983</i> DRAWN BY <i>PMO</i> DATE <i>Aug. 1983</i> CHECKED BY <i>JA</i> DATE <i>Aug. 1983</i>			REVISIONS NO. DATE REMARKS BY					
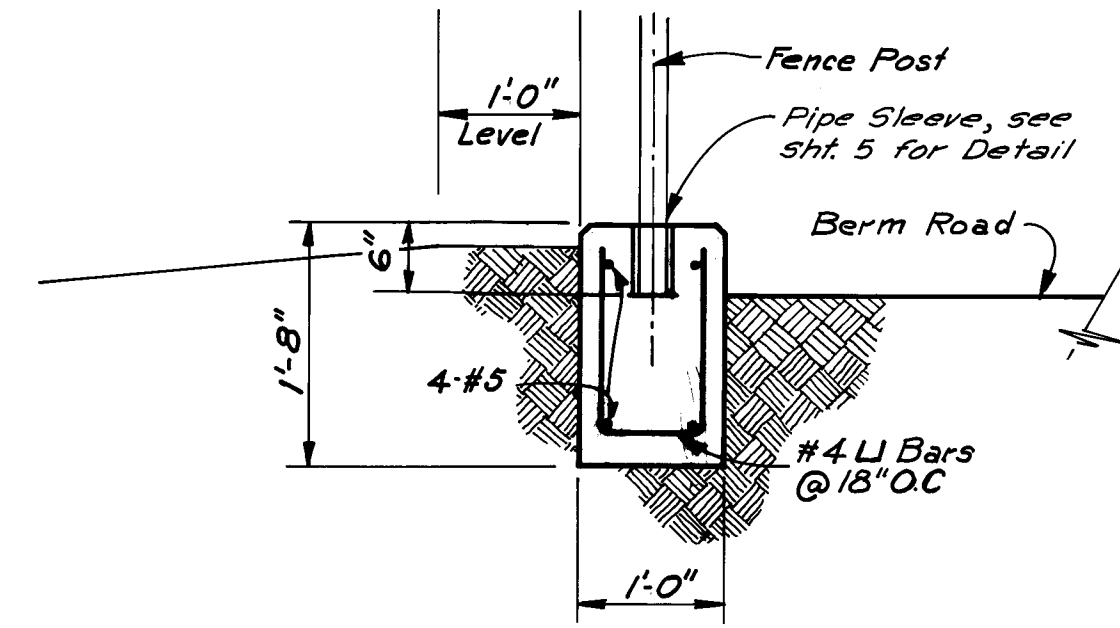


SECTION 4
SCALE: 3/4" = 1'-0"

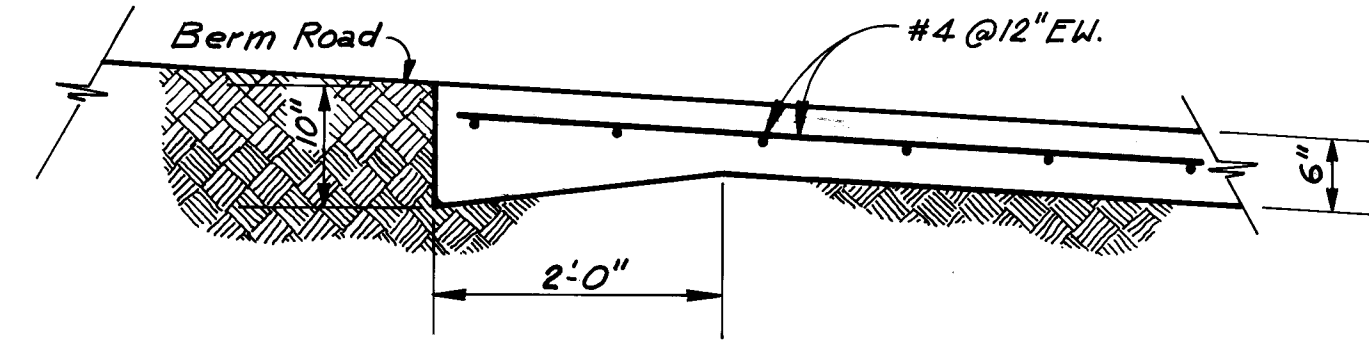


SECTION 7
SCALE: 3/4" = 1'-0"

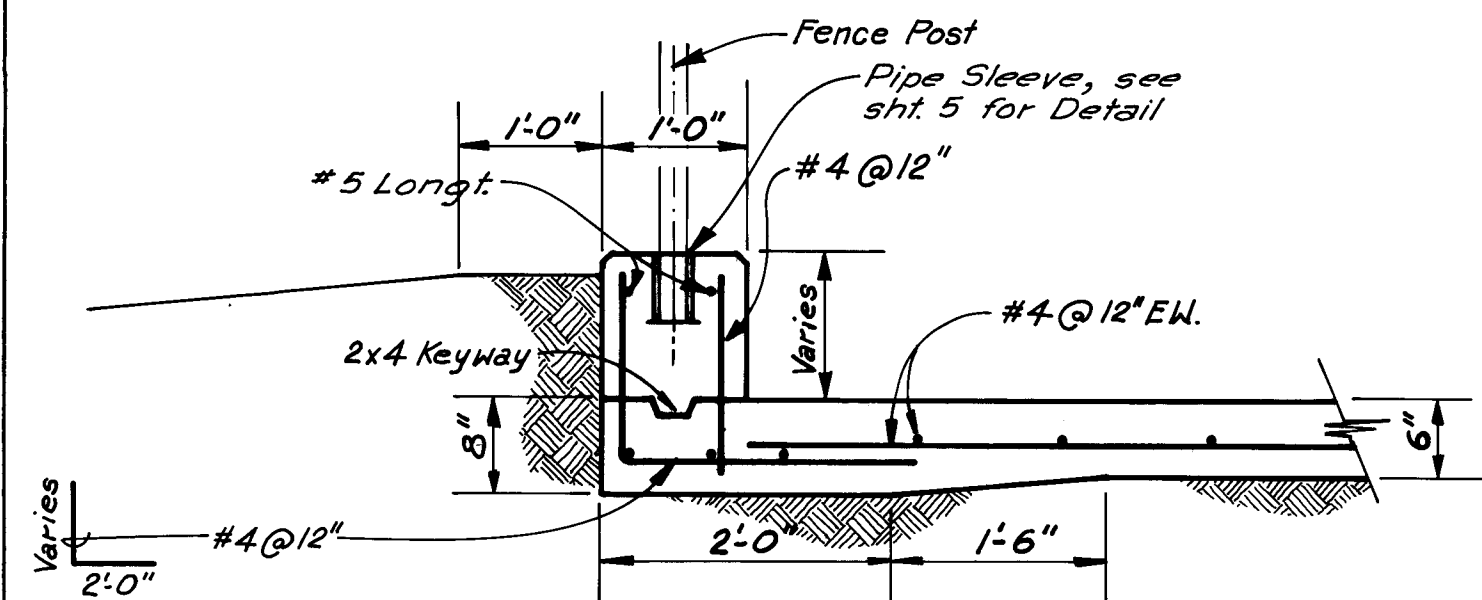


SECTION 5
SCALE: 3/4" = 1'-0"

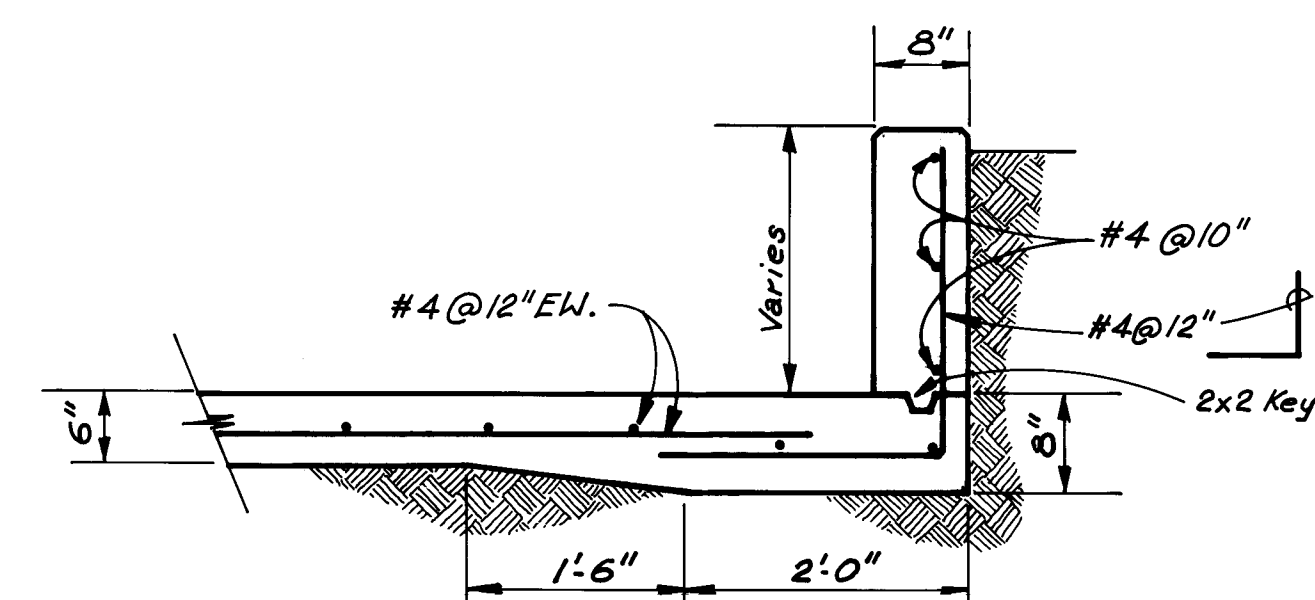


SECTION 8
SCALE: 3/4" = 1'-0"

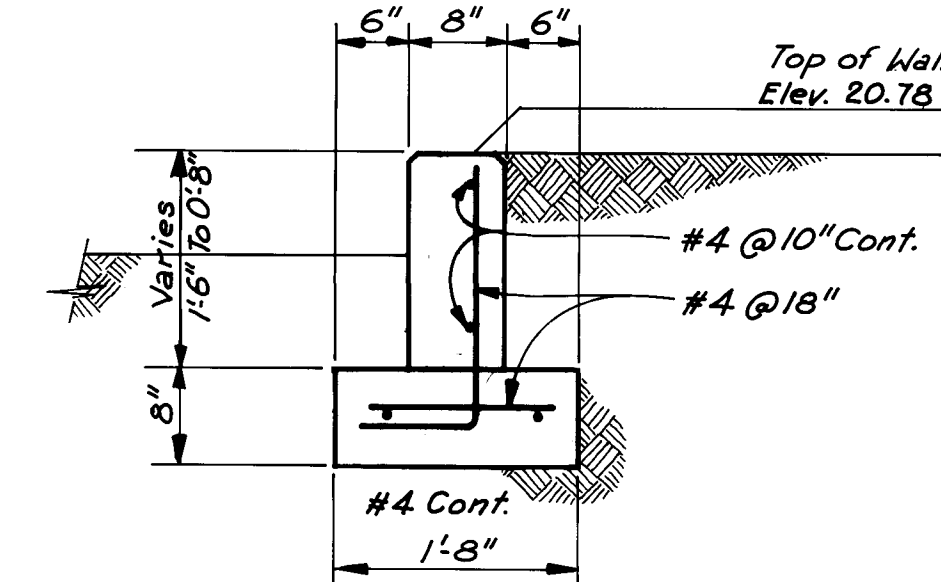


SECTION 6
SCALE: 3/4" = 1'-0"

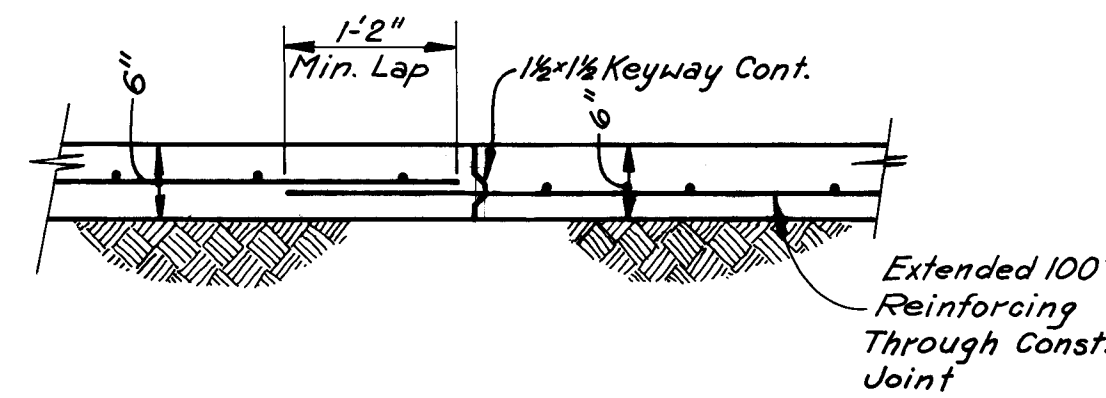


**SLAB ON GRADE
TYPICAL CONSTRUCTION JOINT**
SCALE: 3/4" = 1'-0"

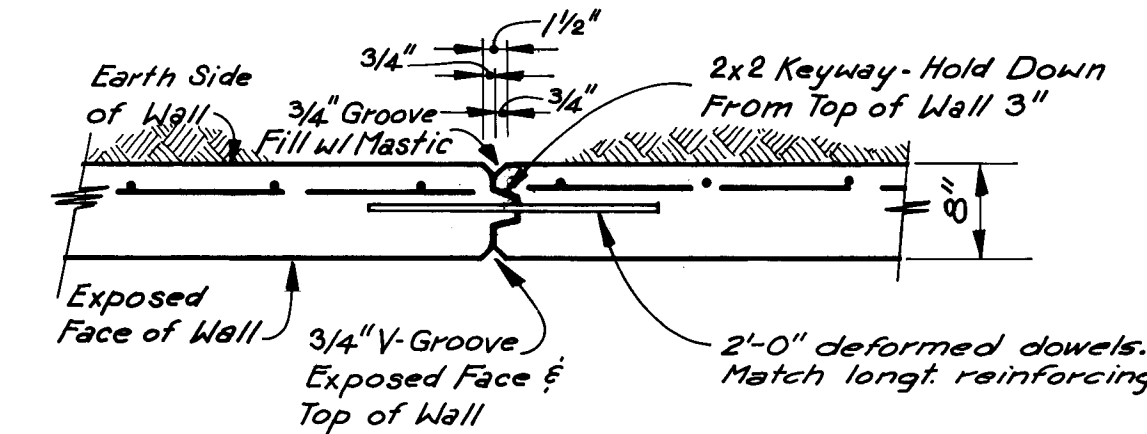


TYPICAL-WALL CONSTRUCTION JOINT
SCALE: 3/4" = 1'-0"

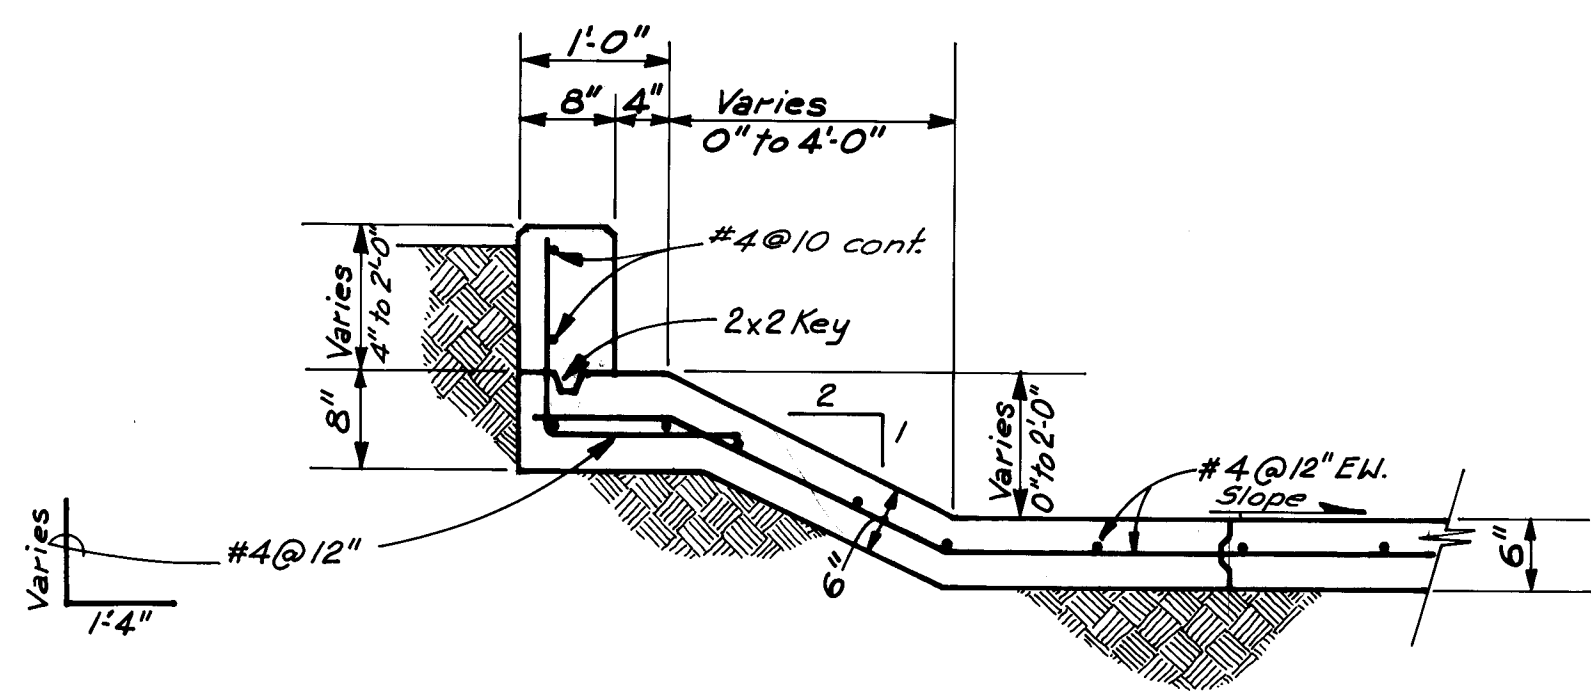


SECTION 6
SCALE: 3/4" = 1'-0"

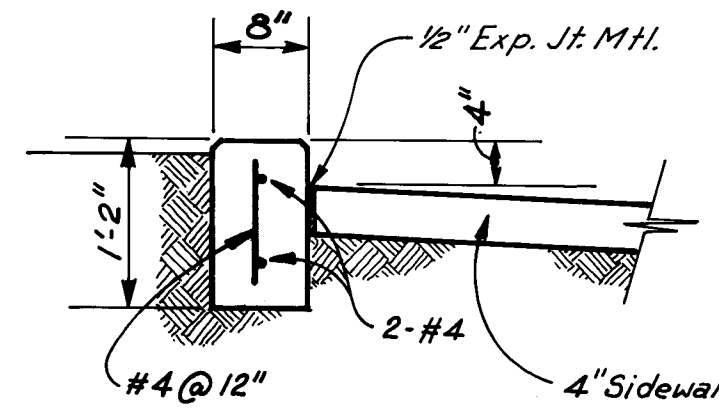

SECTION 9
SCALE: 3/4" = 1'-0"

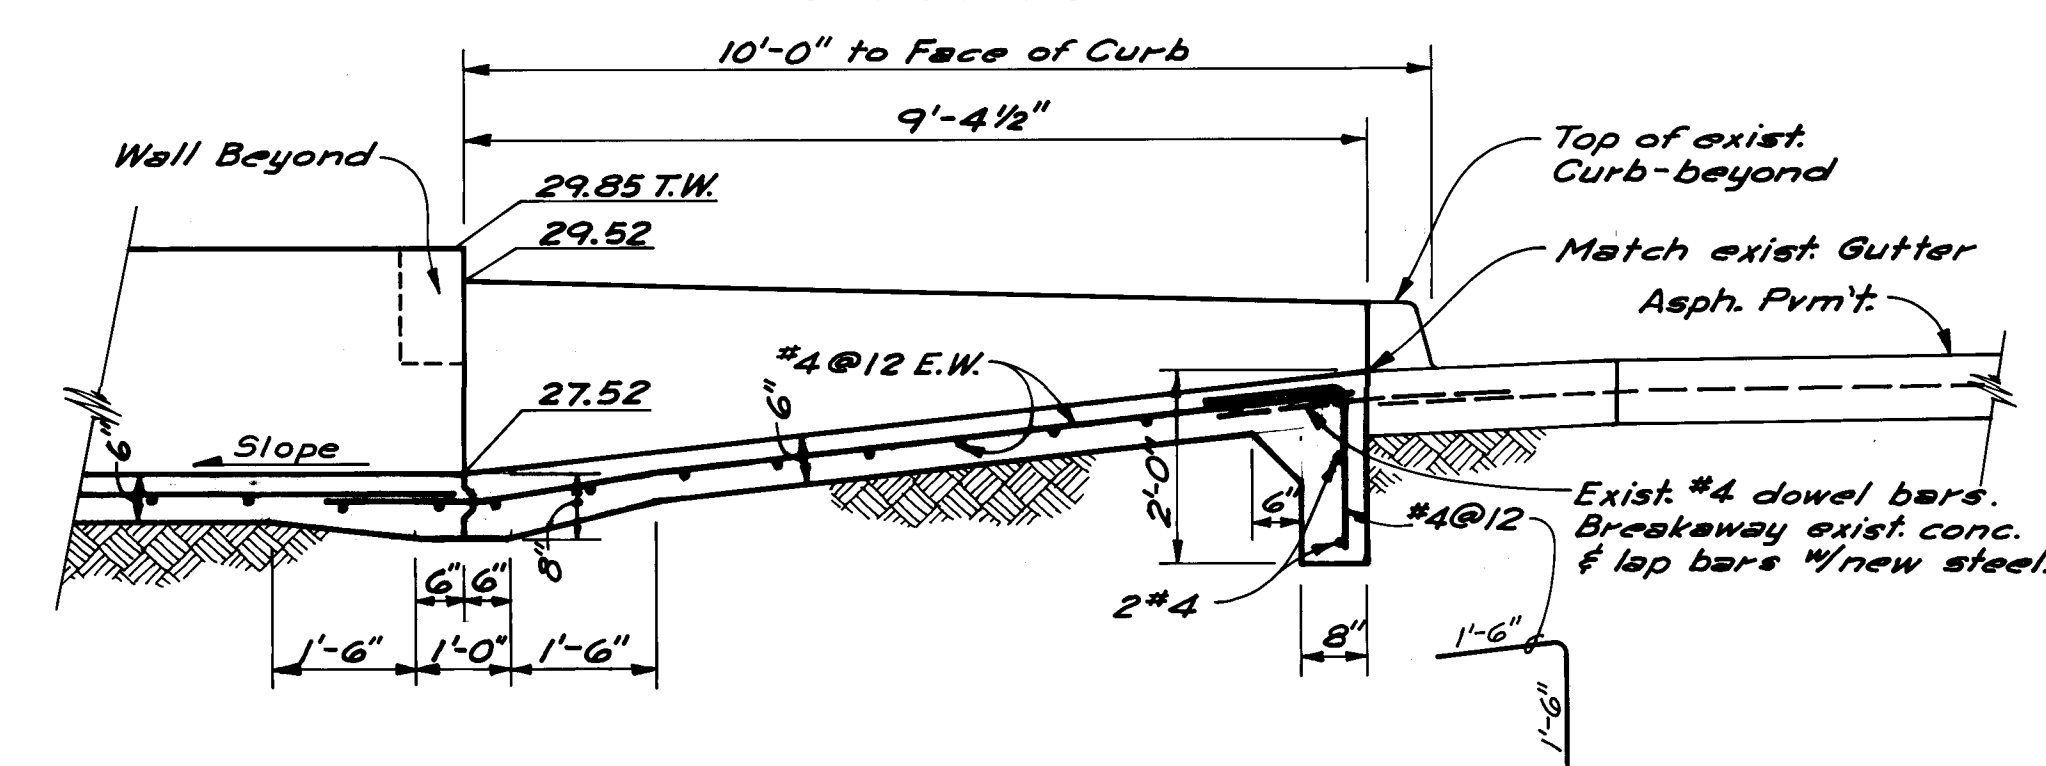

SECTION 11
SCALE: 1/2" = 1'-0"

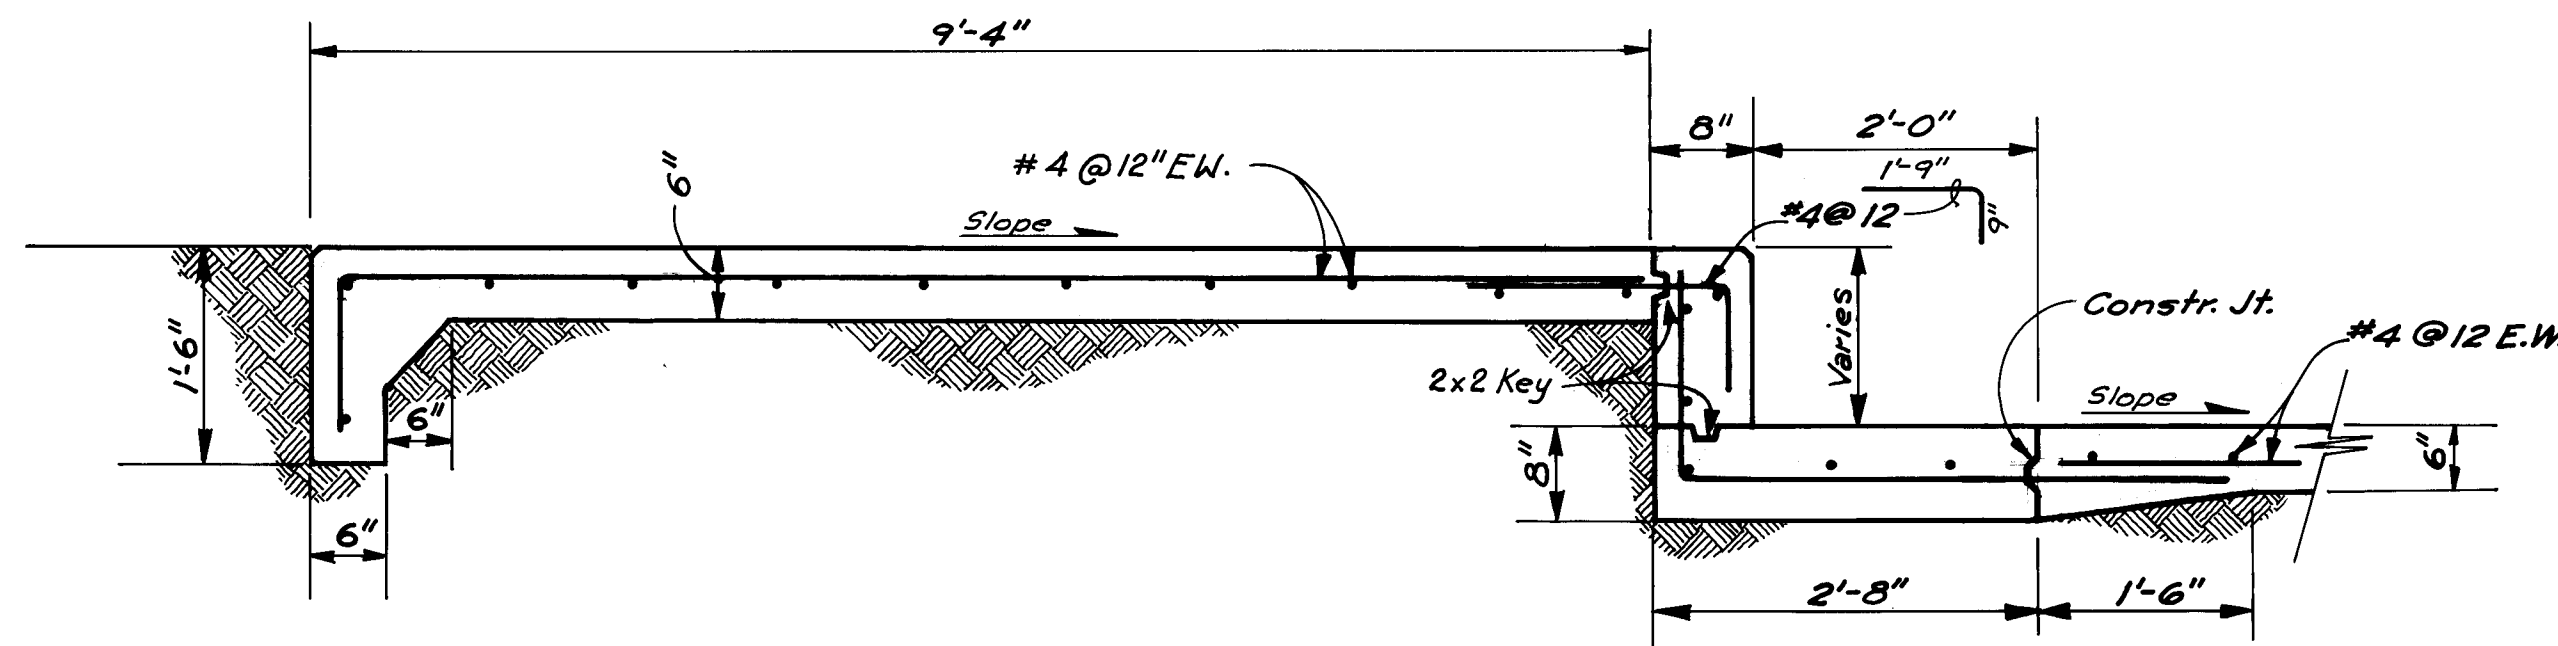



SECTION 10
SCALE: 3/4" = 1'-0"

NOTE:
3/4" Chamfer all exposed concrete edges - Typical.

AS BUILT INFORMATION			BENCH MARKS			SURVEY INFORMATION			ENGINEER'S SEAL		
CONTRACTOR	KNC Inc.	DATE	ACCS STA.	2-F16	ELEVATION = 5062.08	NO.	BY	DATE			
WORKED BY	A.A. #R	DATE	STANDARD ACS BRASS	TABLET ON TOP OF	CONCRETE POST PROJECTING 0.2 FT. ABOVE						
INSPECTED BY	A.A. #R	DATE	GROUND LOCATED 0.4 MILE WEST OF I-25		IN THE MEDIAN ON MONTANO ROAD N.E.						
VERIFIED BY	A.A. #R	DATE									
DRAWN BY	A.A. #R	DATE									
CHECKED BY	A.A. #R	DATE									
RECORDED BY	A.A. #R	DATE									
NO.											

CITY OF ALBUQUERQUE MUNICIPAL DEVELOPMENT DEPARTMENT ENGINEERING DIVISION					
AGP/MONTBET DETENTION BASIN SECTIONS & DETAILS					
APPROVALS	ENGINEER	DATE	APPROVALS	ENGINEER	DATE
City Engineer	C.M. Thompson	9/14/83	Liquid Waste	N.A. W.F.	9-1-83
A.C.E. - Design	W.F.	8/14/83	Traffic	N.A. W.F.	
A.C.E. - Hydrology	W.F.	9/14/83	Water	N.A. W.F.	9-1-83
DRAWING NO.	1865	MAP NO.	F-15 & F-16	SHEET	8 OF 10

RECORD DRAWING

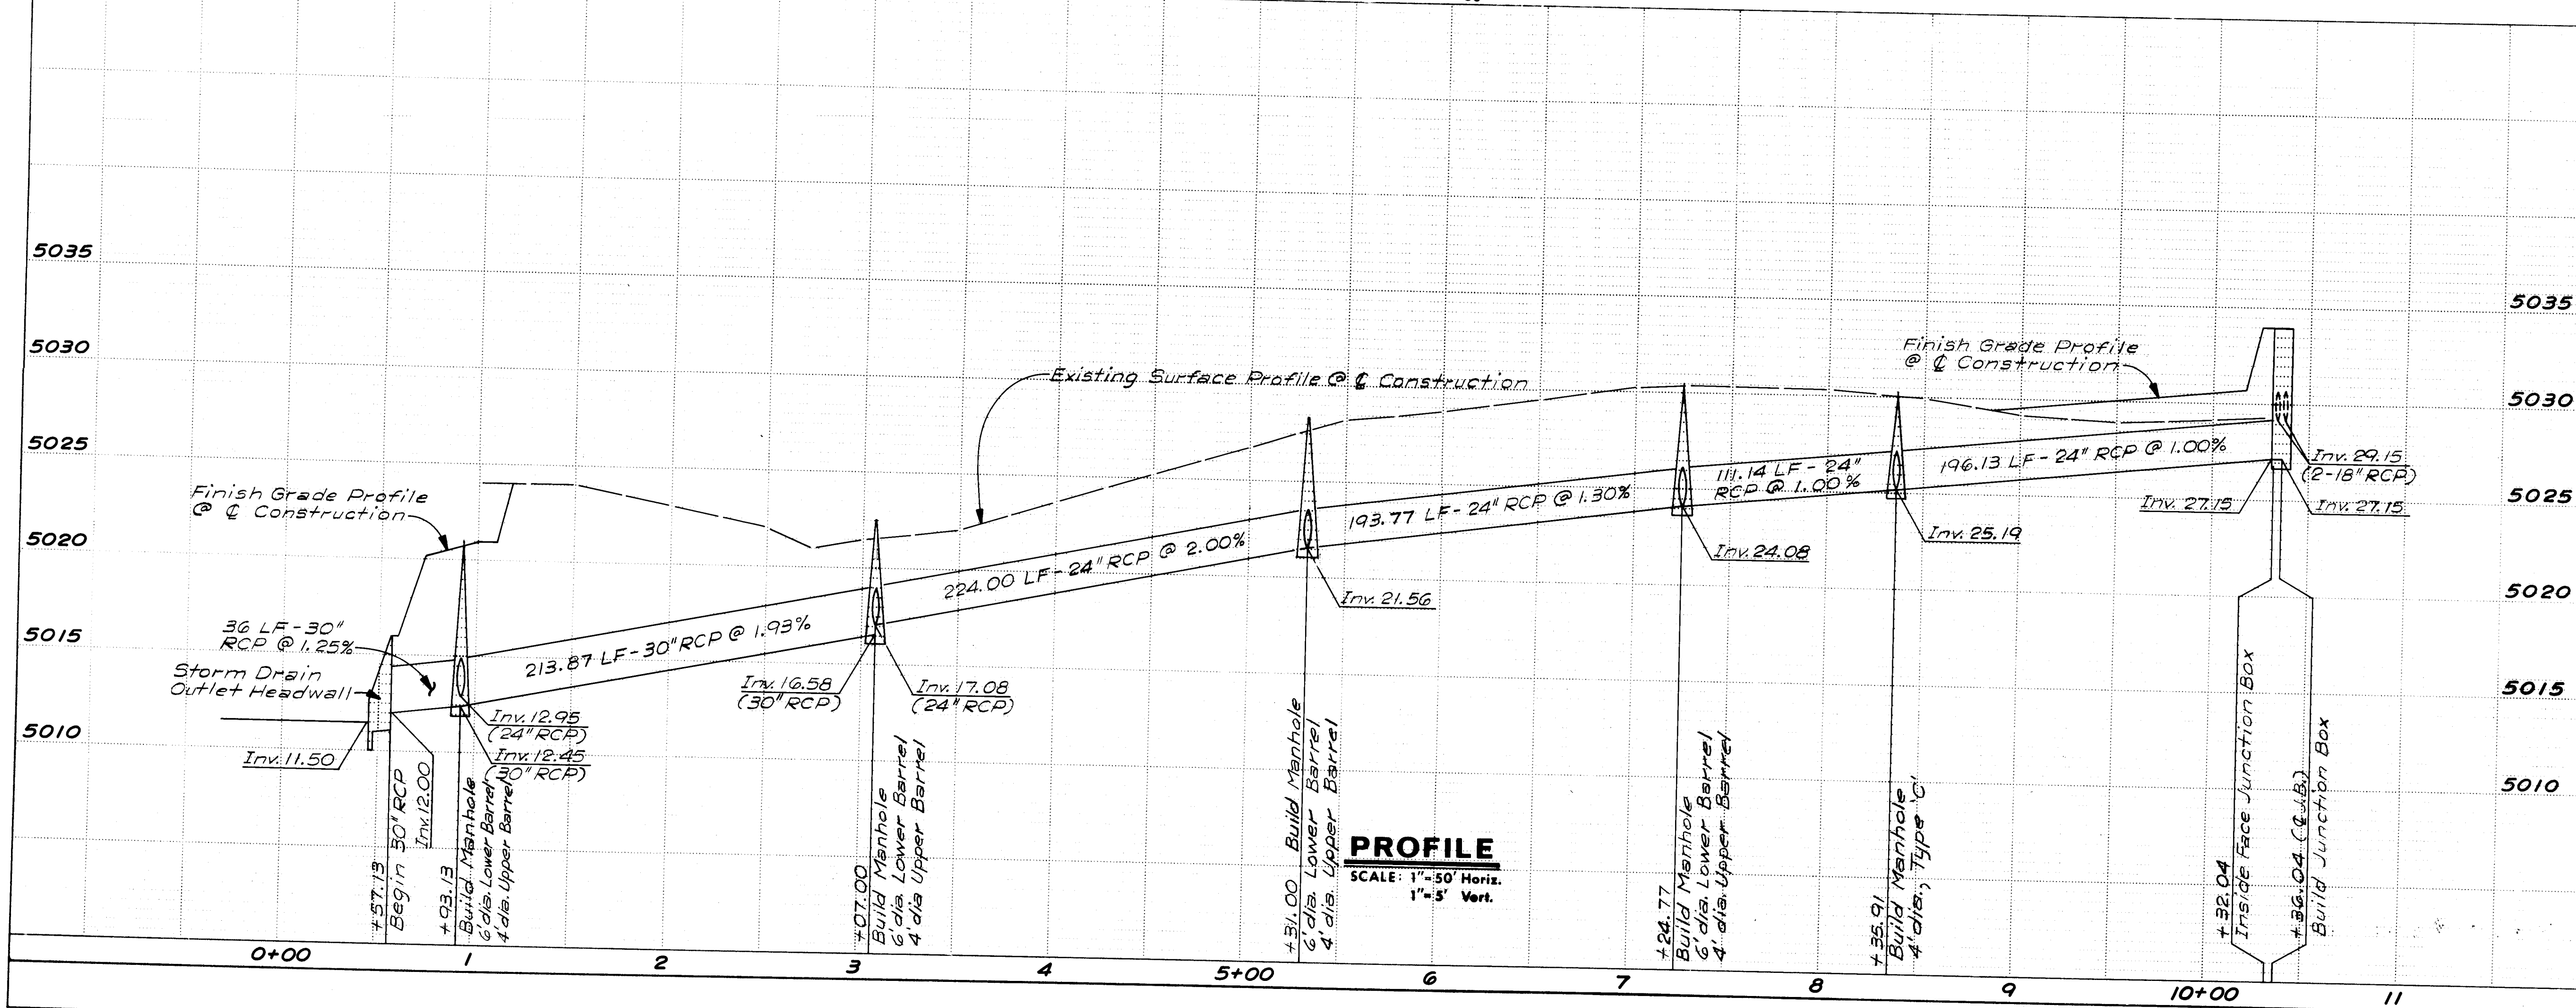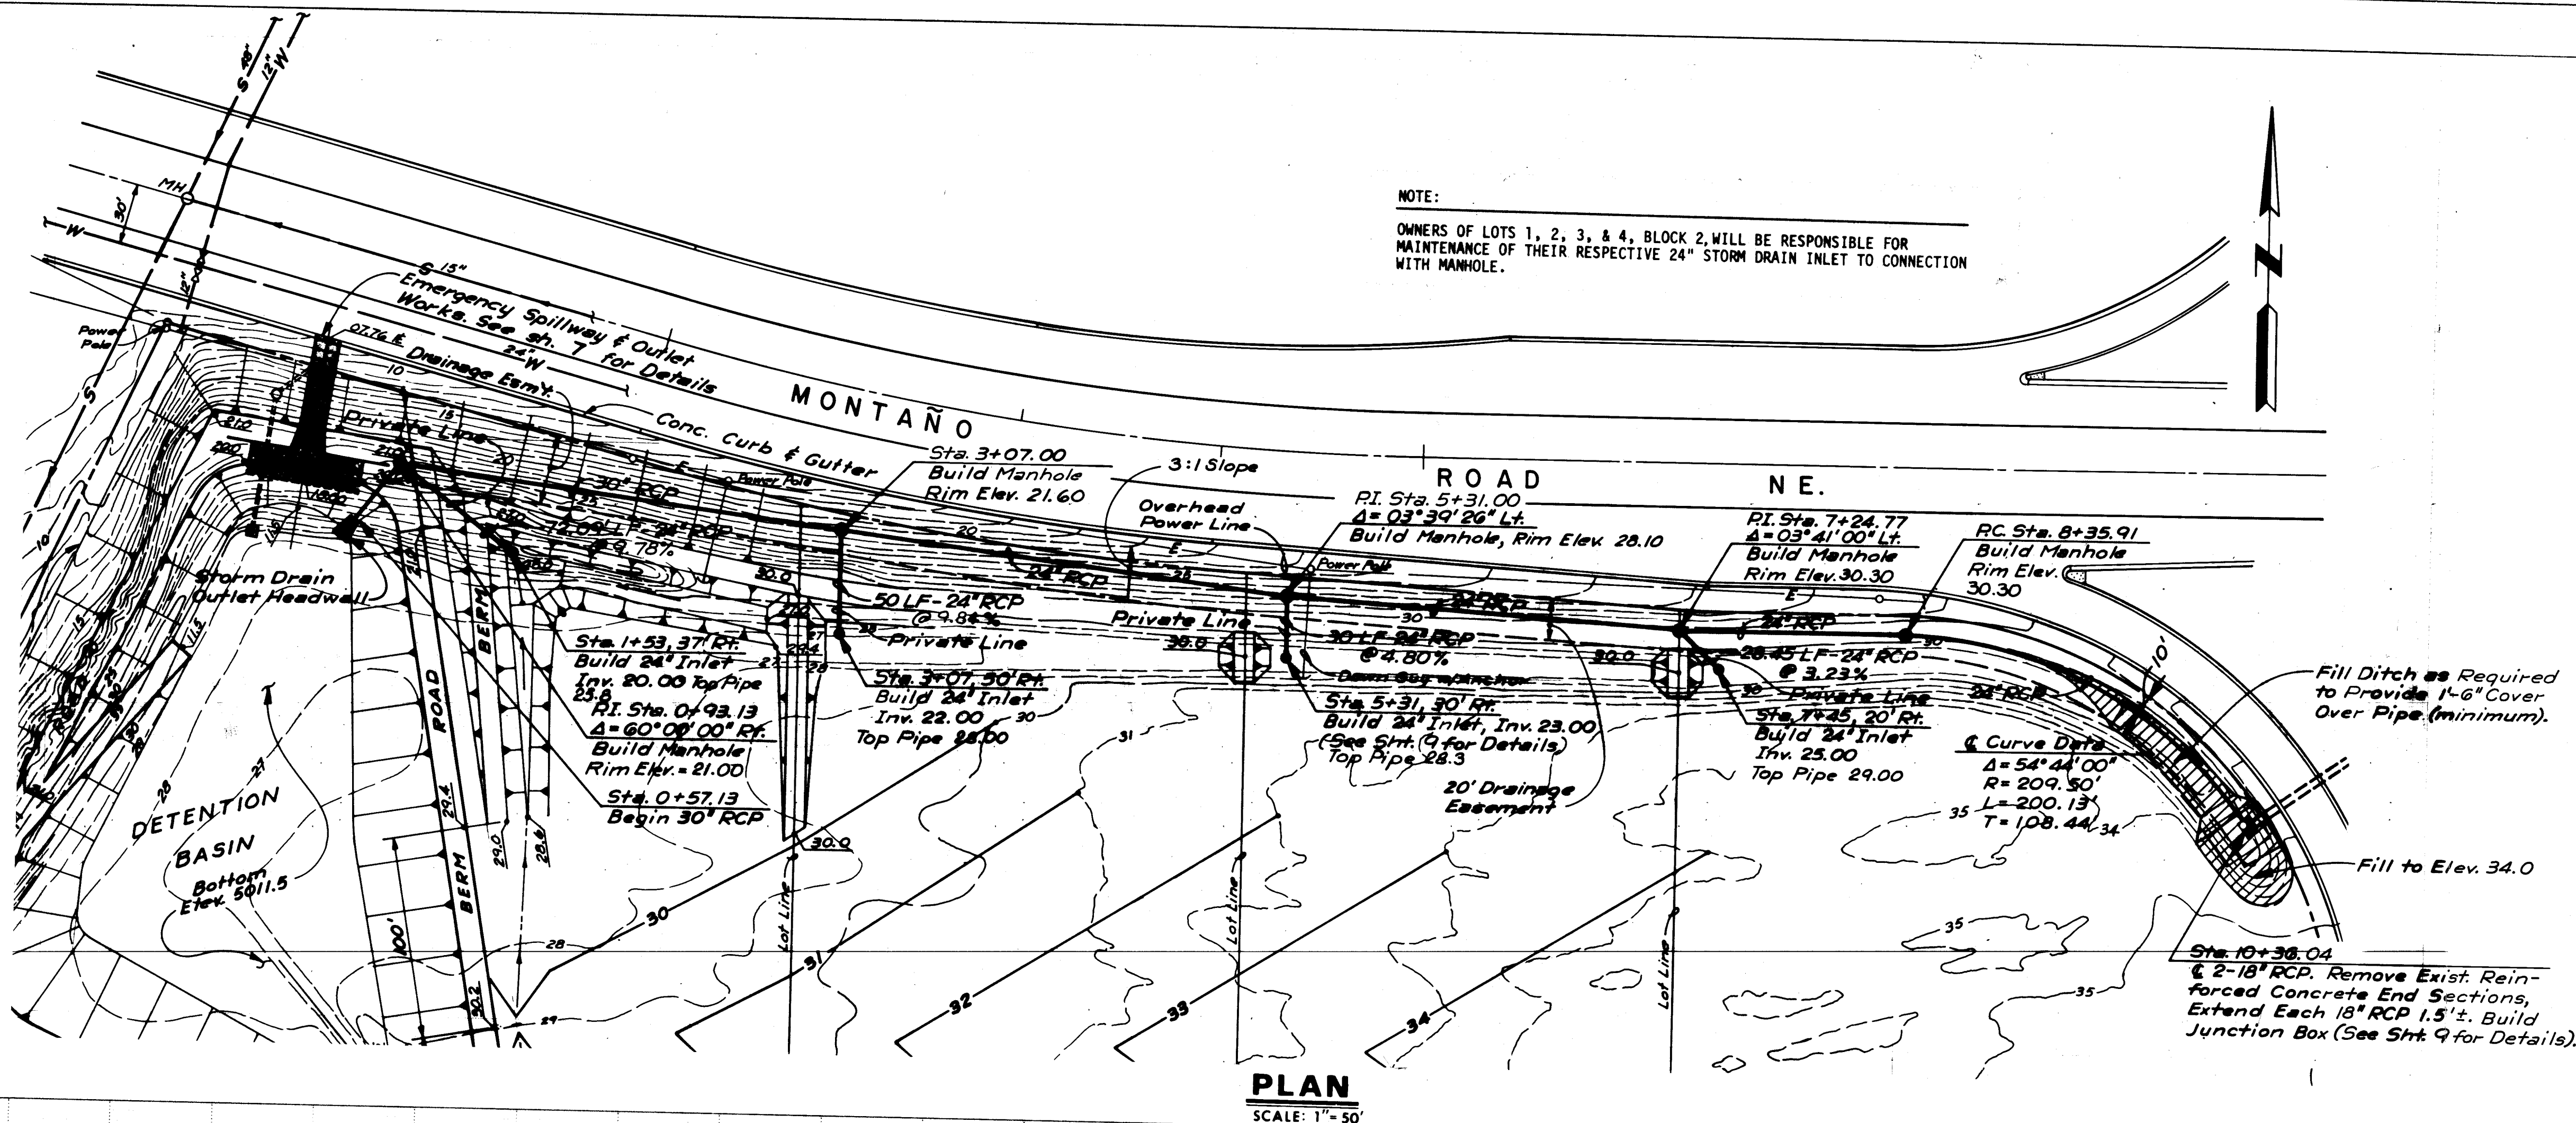

- NOTE:
1. All Manholes to have aluminum MH Steps @ 12" (Typical).
2. All Manhole Covers shall be marked "STORM".

RECORD DRAWING

C. H. Alford 9/1/83
M.A. for G.R.D. 9/1/83

CITY OF ALBUQUERQUE
MUNICIPAL DEVELOPMENT DEPARTMENT
ENGINEERING DIVISION
AGP/MONTBEL DETENTION BASIN
STORM DRAIN PLAN & PROFILE

APPROVALS	ENGINEER	DATE	APPROVALS	ENGINEER	DATE
City Engineer	C. H. Alford	9/1/83	Liquid Waste	N.A. W.B.	9-1-83
A.C.E. - Design	J. H. Alford	9/1/83	Traffic	N.A. W.B.	9-1-83
A.C.E. - Hydrology	J. H. Alford	9/1/83	Water	N.A. W.B.	9-1-83

DRAWING NO. 1865 MAP NO. F-15 & F-16 SHEET 10 OF 10

ENGINEER'S SEAL		SURVEY INFORMATION		BENCH MARKS		AS BUILT INFORMATION				
	NO.	BY	DATE	ACS STA. 2+16 ELEVATION = 5062.08 STANDARD ACS BRASS TABLET ON TOP OF CONCRETE POST PROJECTING 0.2 FT. ABOVE GROUND LOCATED 0.4 MILE WEST OF 1-25 IN THE MEDIAN ON MONTANO ROAD N.E.	CONTRACTOR	KNC Inc.	DATE			
ANDREWS, ASBURY & ROBERT, INC. CONSULTING ENGINEERS BIOGRAPHIC 83-326 NEW MEXICO						MICRO-FILM INFORMATION RECORDED BY DATE				