


SCALE: 1" = 50' HORIZ.
1" = 2' VERT.

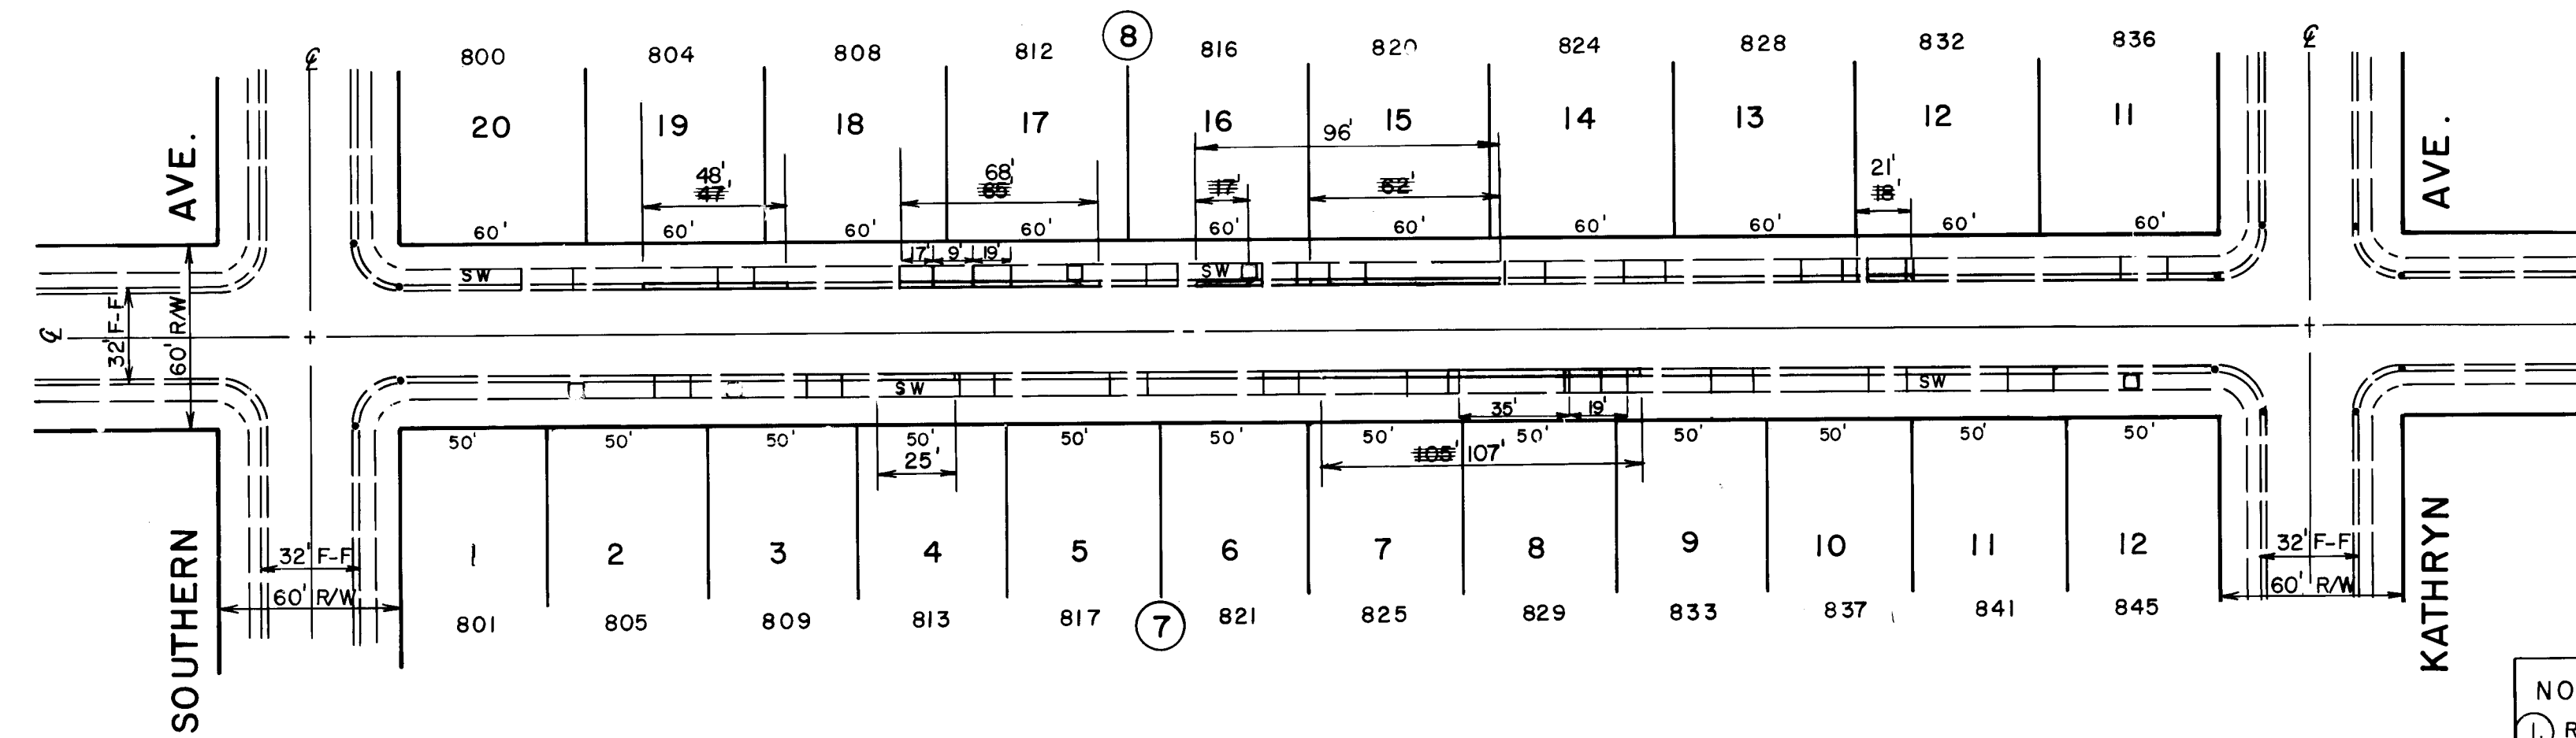

CAGUA DRIVE S.E.

- NOTES:

1. REMOVE AND REPLACE CURB AND GUTTER TO THE NEAREST JOINT AT THE STATIONS SHOWN OR AS DIRECTED BY ENGINEER.
2. REMOVE AND REPLACE SIDEWALK AND DRIVEPADS ONLY IF DIRECTED TO DO SO BY ENGINEER.
3. REMOVE AND REPLACE 1' WIDE STRIP OF RESIDENTIAL ASPHALT PAVEMENT ALONG NEW CURB AND GUTTER.
4. GRADES ON NEW GUTTER TO BE ESTABLISHED BY STRAIGHT LINE BETWEEN EXISTING CURB AND GUTTER THAT REMAINS.
5. REPLACE EXISTING DRIVEPAD WIDTHS UNLESS A PERMITTING AGENCY OR TRAFFIC ENGINEERING TO WIDEN. CONSTRUCT DRIVEPADS WITH 3 FT TRANSITIONS AS PER CITY STD. DWG P-11.

NOTICE TO CONTRACTORS

1. All work detailed on these plans to be performed under contract shall, except as otherwise stated or provided for herein, be constructed in accordance with the New Mexico Standard Specifications for Public Works Construction-1979 Edition (referred to herein as the Standard Specifications) and the Contract Documents for **Public Works Contract 84-1**.

2. Two (2) working days prior to any excavation, the contractor must contact Line Locating Service, 755-1234, for location of existing utilities.
3. Prior to construction, the contractor shall excavate and verify the horizontal and vertical locations of all obstructions. Should a conflict exist, the contractor shall notify the engineer or surveyor so that the conflict can be resolved with minimum amount of delay.

THE FOLLOWING NOTES ALSO APPLY
WHEN CHECKED

- | | |
|-------------------------------------|---|
| ☐ | All utilities and utility service lines shall be installed prior to paving. |
| ☒ | Backfill compaction shall be according to specified street use. |
| ☒ | Tack coat requirements shall be determined by the City Engineer. |
| ☐ | Sidewalks and wheelchair ramps within the curb return shall be constructed wherever a new curb return is constructed. |
| ☐ | If curb is depressed for a driveway or a handicap ramp, the driveway or ramp shall be constructed prior to acceptance of the curb and gutter. |
| ☐ | Any storm drainage facilities shall be completed prior to final acceptance. |

LEGEND

- EXISTING CURB & GUTTER
AND SIDEWALK
- NEW CURB & GUTTER
- EXISTING DRIVEPADS
- DOUBLE HEADED ARROW
ON PROFILE INDICATES
REMOVAL AND REPLACEMENT
OF CURB AND GUTTER
- EXISTING WATER METER

ADDENDUM
NO. 1

C. H. Shepard 1/14/84

CITY OF ALBUQUERQUE
MUNICIPAL DEVELOPMENT DEPARTMENT
ENGINEERING DIVISION

TITLE: CAGUA BETWEEN SOUTHERN AND KATHRYN
S.E. DRAINAGE PROBLEM.

APPROVALS	ENGINEER	DATE	APPROVALS	ENGINEER	DATE
City Engineer	<i>C.W. Hagan</i>	<i>1/10/84</i>	Liquid Waste	<i>N.A. Wetz</i>	<i>10-20-83</i>
A C E - Design	<i>Stefel</i>	<i>9/10/83</i>	Traffic	<i>T.W. Bennett</i>	<i>10/10/83</i>
A C E - Hydrology	<i>Stefel</i>	<i>11/2/83</i>	Water	<i>N.A. Wetz</i>	<i>10-20-83</i>


DRAWING NO.	1867	MAP NO.	L-18	SHEET	1	OF	1
-------------	------	---------	------	-------	---	----	---

[illegible]

ANDERSON	ALVARO	VALEN	CARBELL	SAN	ARTIZO	GALILEI	DANIO
ZONE MAP L-18							
NOTICE TO CONTRACTORS							
1. All work detailed on these plans to be performed under contract shall, except as otherwise stated or provided for hereon, be constructed in accordance with the New Mexico Standard Specifications for Public Works Construction-1979 Edition (referred to herein as the Standard Specifications) and the Contract Documents for Public Works Contract 84-1. 2. Two (2) working days prior to any excavation, the contractor must contact Line Locating Service, 765-1234, for location of existing utilities. 3. Prior to construction, the contractor shall excavate and verify the horizontal and vertical locations of all excavations. Should a conflict exist, the contractor shall notify the engineer or surveyor so that the conflict can be resolved with minimum amount of delay.							
THE FOLLOWING NOTES ALSO APPLY WHEN CHECKED							
☐ All utilities and utility service lines shall be installed prior to paving. ☒ Backfill compaction shall be according to specified street use. ☒ Tack coat requirements shall be determined by the City Engineer. ☐ Sidewalks and wheelchair ramps within the curb							

SURVEY INFORMATION	FIELD NOTES	BENCH MARKS	
NO 05-44	BY D. KRAEMER A. GONZALES G. BARTEAU	BM ☐ CUT N N E RET. SAN PEDRO & KATHRYN SE ELEV. = 5302.49	DATE 8/9/83

LEGEND EXISTING CURB & GUTTER AND SIDEWALK NEW CURB & GUTTER EXISTING DRIVEPADS DOUBLE HEADED ARROW ON PROFILE INDICATES REMOVAL AND REPLACEMENT OF CURB AND GUTTER <input style="width: 20px; height: 20px; margin-right: 10px;" type="checkbox"/> EXISTING WATER METER		ENGINEER'S SEAL		
NOTICE TO CONTRACTORS 1/26/84	PF	BY	REVISIONS	
ADDENDUM NO. 1	DESIGN			
	DESIGNED BY	PHILIP FISCHER	DATE	8/783
	DRAWN BY	D ZAMORA	DATE	8/783
	CHECKED BY		DATE	

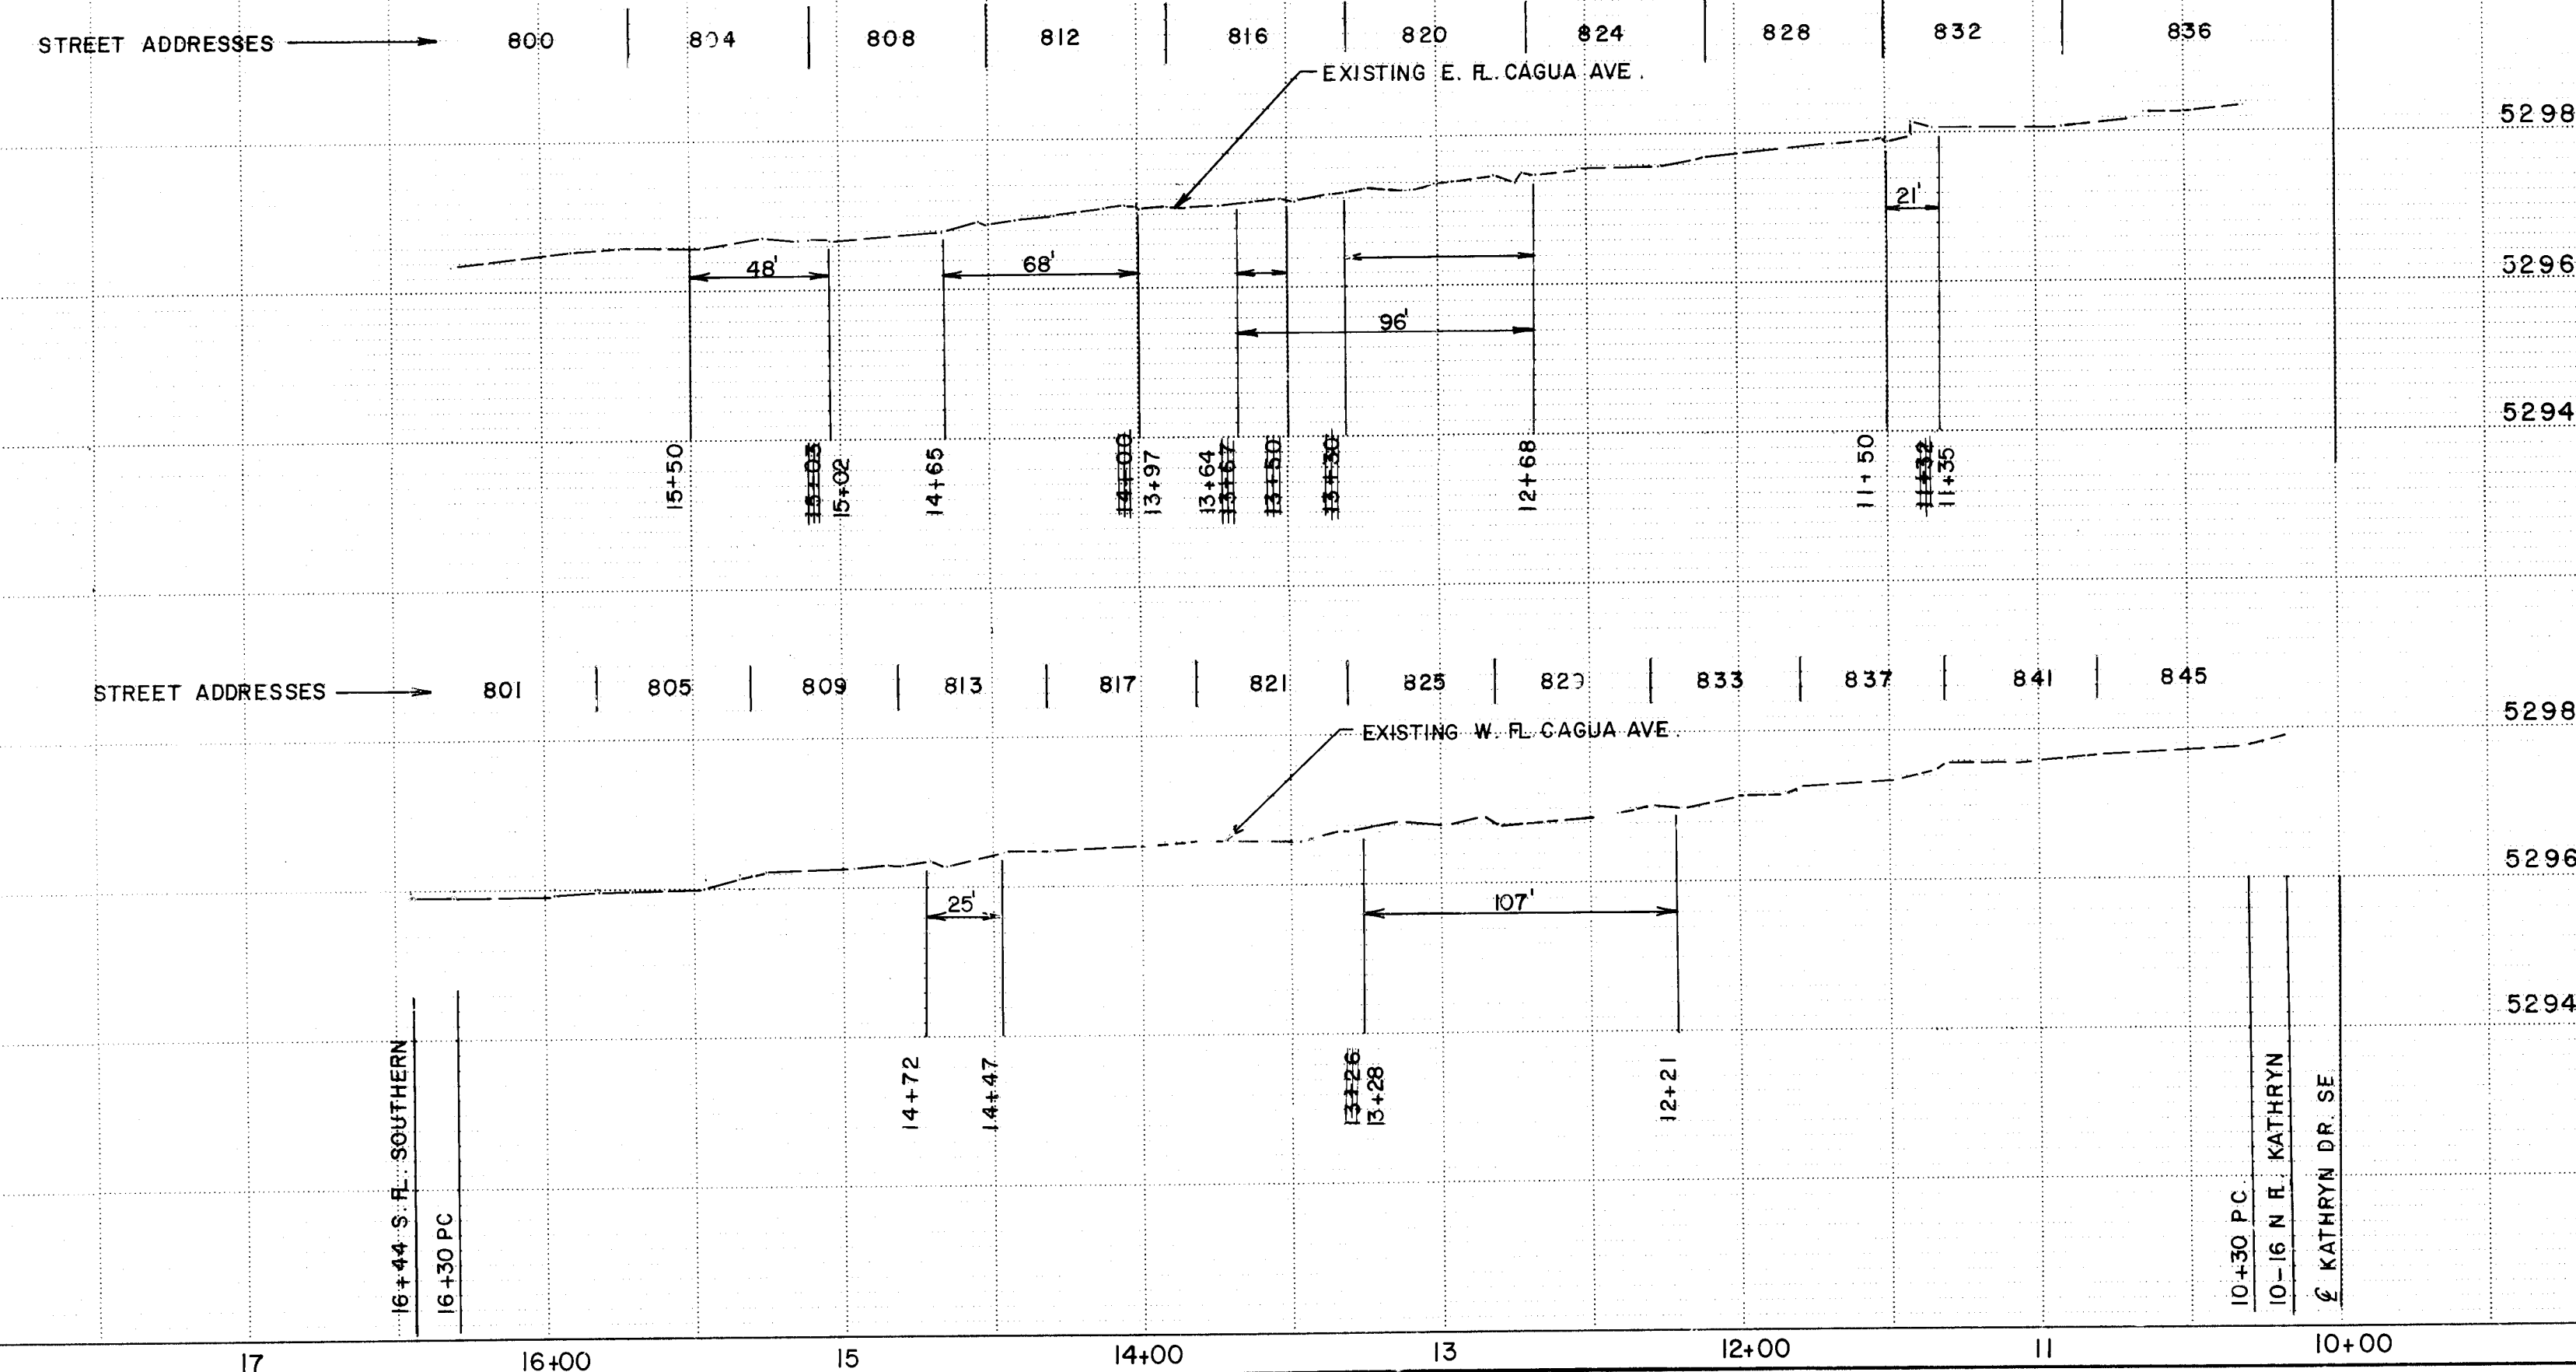

APPROVA BY PHIL HAWKINS
ASSISTANT ENGINEER
W. J. Williams
DATE 7/18/84