


UNITS ONE & TWO

SALIDA DEL SOL

AT SEVEN BAR RANCH

ALBUQUERQUE, NEW MEXICO

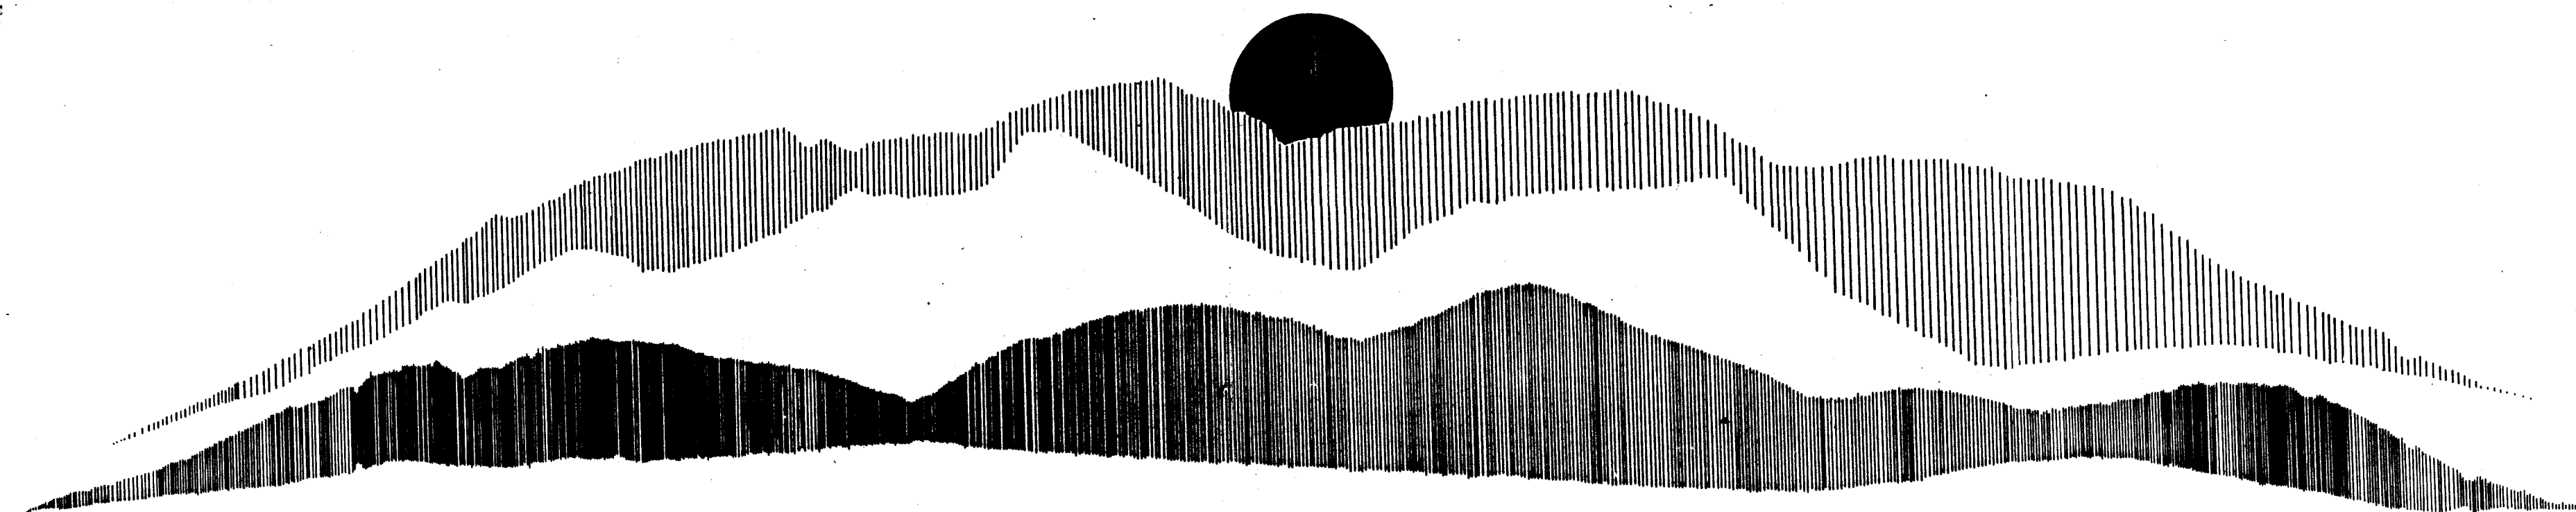

CONSTRUCTION PLANS FOR GRADING, PAVING, & UTILITIES


INDEX TO DRAWINGS

1	COVER SHEET AND INDEX TO DRAWINGS
2-3	PLATS OF GEOMETRY
4-8	GRADING PLANS
9	EROSION CONTROL PLAN
10	COMPOSITE STREET PAVING PLAN
11-21	STREET PLAN & PROFILES
22	COMPOSITE SANITARY SEWER & WATER PLAN
23-33	SANITARY SEWER AND WATER PLAN AND PROFILES
34	DRAINAGE FACILITIES PLAN AND PROFILES
35-36	BLACK ARROYO CHANNEL PLAN AND PROFILES
37-38	BLACK ARROYO CHANNEL DETAILS
39-40	CROSS-SECTIONS AND DETAILS

REVISIONS	
SHT. NO.	DATE
30	7-84

W.F. McManis
1-28-86

26 18690186

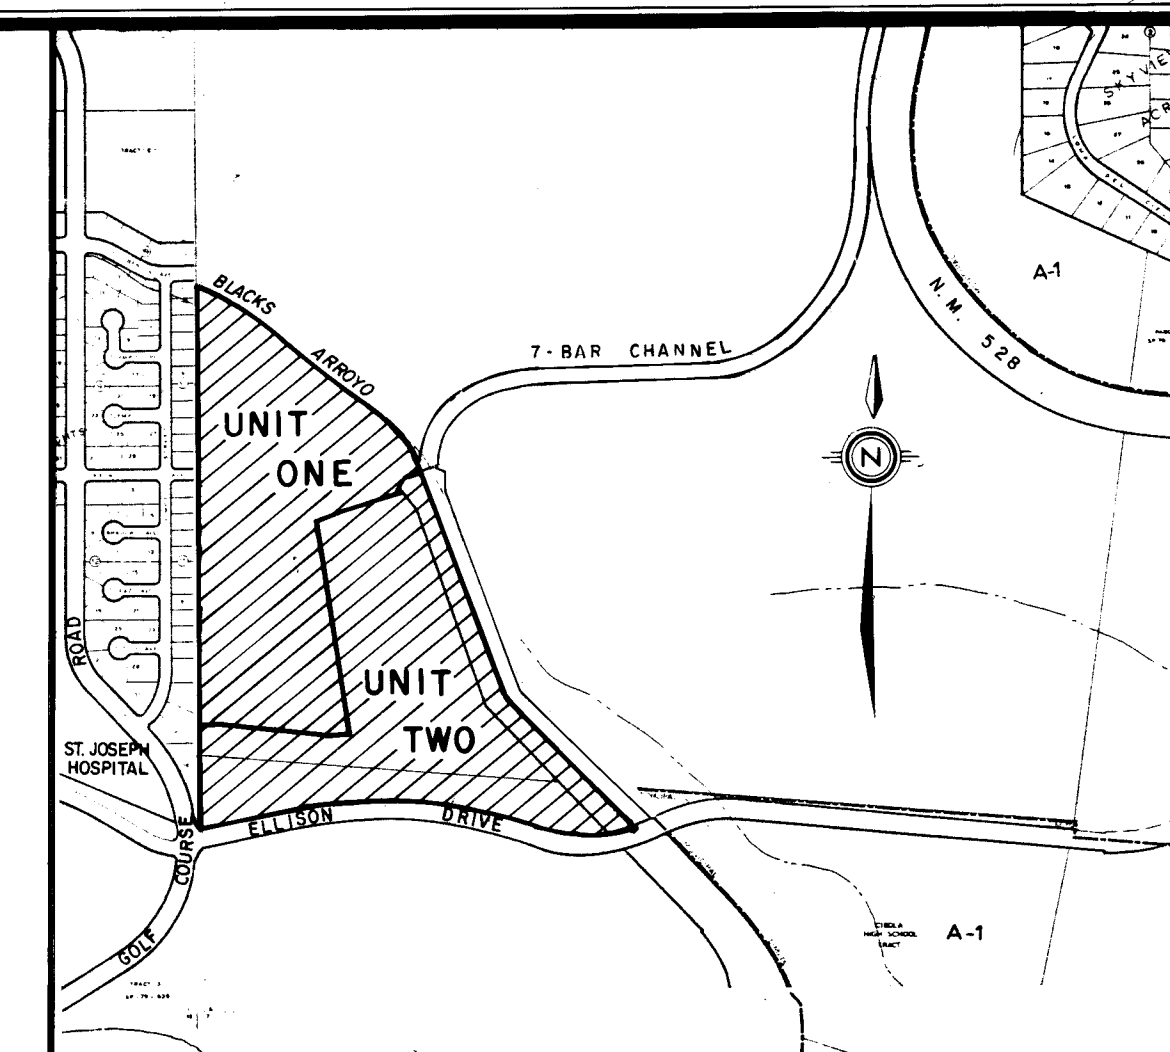


VICINITY MAP
(Scale: 1" = 800' approx.)

ZONE ATLAS
A-13

GENERAL NOTES

- All work detailed on these plans to be performed under contract shall except as otherwise stated or provided for hereon, be constructed in accordance with the New Mexico Standard Specifications for Public Works Construction - 1979 Edition (referred to herein as the Standard Specifications) and the Contract Documents for Public Works Contract #84-1.
- Two (2) working days prior to any excavation, contractor must contact Line Locating Service, 765-1234, for location of existing utilities.
- Prior to construction, the contractor shall excavate and verify the horizontal and vertical locations of all obstructions. Should a conflict exist, the contractor shall notify the engineer or surveyor so that the conflict can be resolved with minimum amount of delay.
- All utilities and utility service lines shall be installed prior to paving.
- Backfill compaction shall be according to specified street use.
- Tack coat requirements shall be determined by the City Engineer.
- Sidewalks and wheelchair ramps within the curb returns shall be constructed wherever a new curb return is constructed.
- If curb is depressed for a driveway or a handicap ramp, the driveway or ramp shall be constructed prior to acceptance of the curb and gutter.
- All storm drainage facilities shall be completed prior to final acceptance.
- The water line and sanitary sewer line are to belong to New Mexico Utility Company. The City will not stake, inspect or accept them.

AS BUILT

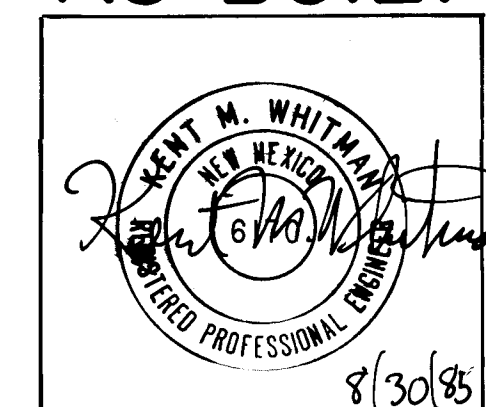

NOTE: THIS CERTIFICATION IS INTENDED TO INDICATE THAT IN THE ENGINEER'S OPINION THIS CONSTRUCTION IS IN SUBSTANTIAL COMPLIANCE WITH THE DESIGN AS SHOWN FOR AS ANNOTATED WITH UPDATED FIELD NOTES WHERE INDICATED. IT IS NOT A VERIFICATION OF CONTRACT COMPLIANCE IN THE LEVEL OF DETAIL ASSOCIATED WITH FULL CONSTRUCTION INSPECTION OF THE PROJECT.

AS BUILT LEGEND

19.57


FIELD CHECKED
SPOT ELEVATION

NOT
CONSTRUCTED

AS BUILT NOTE

REV.	SHEETS	CITY ENGINEER	DATE	USER	DEPARTMENT	DATE	USER	DEPARTMENT	DATE
APPROVAL OF REVISIONS									

ENGINEER'S SEAL 	DATE: JAN. 1984	COMMUNITY SERVICES CORPORATION	APPROVED FOR CONSTRUCTION
	SCALE: NONE DESIGNED: K.M.W. DRAWN: J.W.B. JOB NO: 23-01-PRE		
PROJECT NO. 1869		SHEET 1 OF 40	

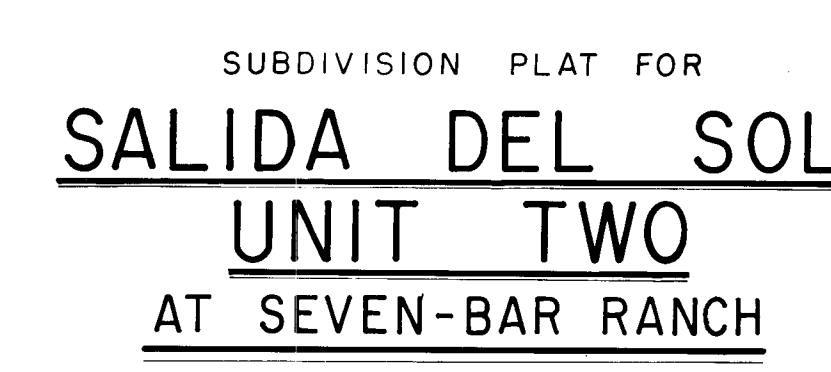




DATE	SEPT. 1983
SCALE	1" = 100'
DESIGNED	C. S. C.
DRAWN	J. W. B.
JOB NO.	23-01-025

community sciences corporation


LONGFORD, MASS. LONGFORD, MASS. LONGFORD, MASS.

P.O. Box 1125 P.O. Box 1125 P.O. Box 1125

Longford, New Mass. Longford, New Mass. Longford, New Mass.

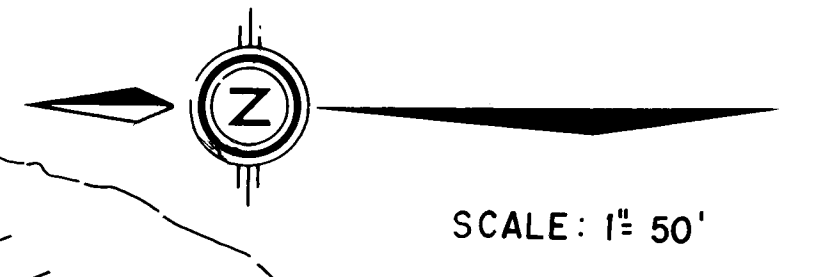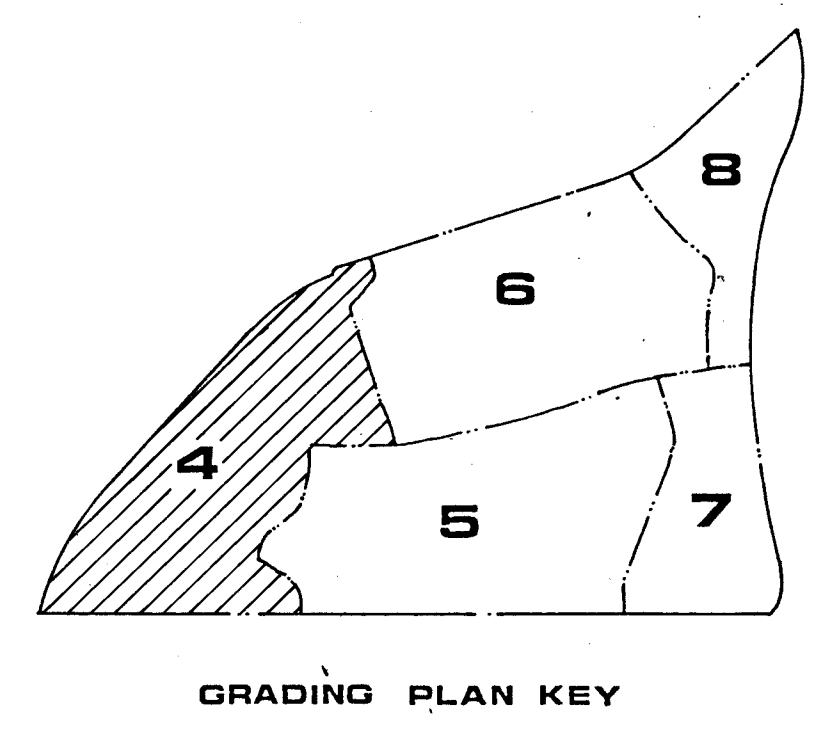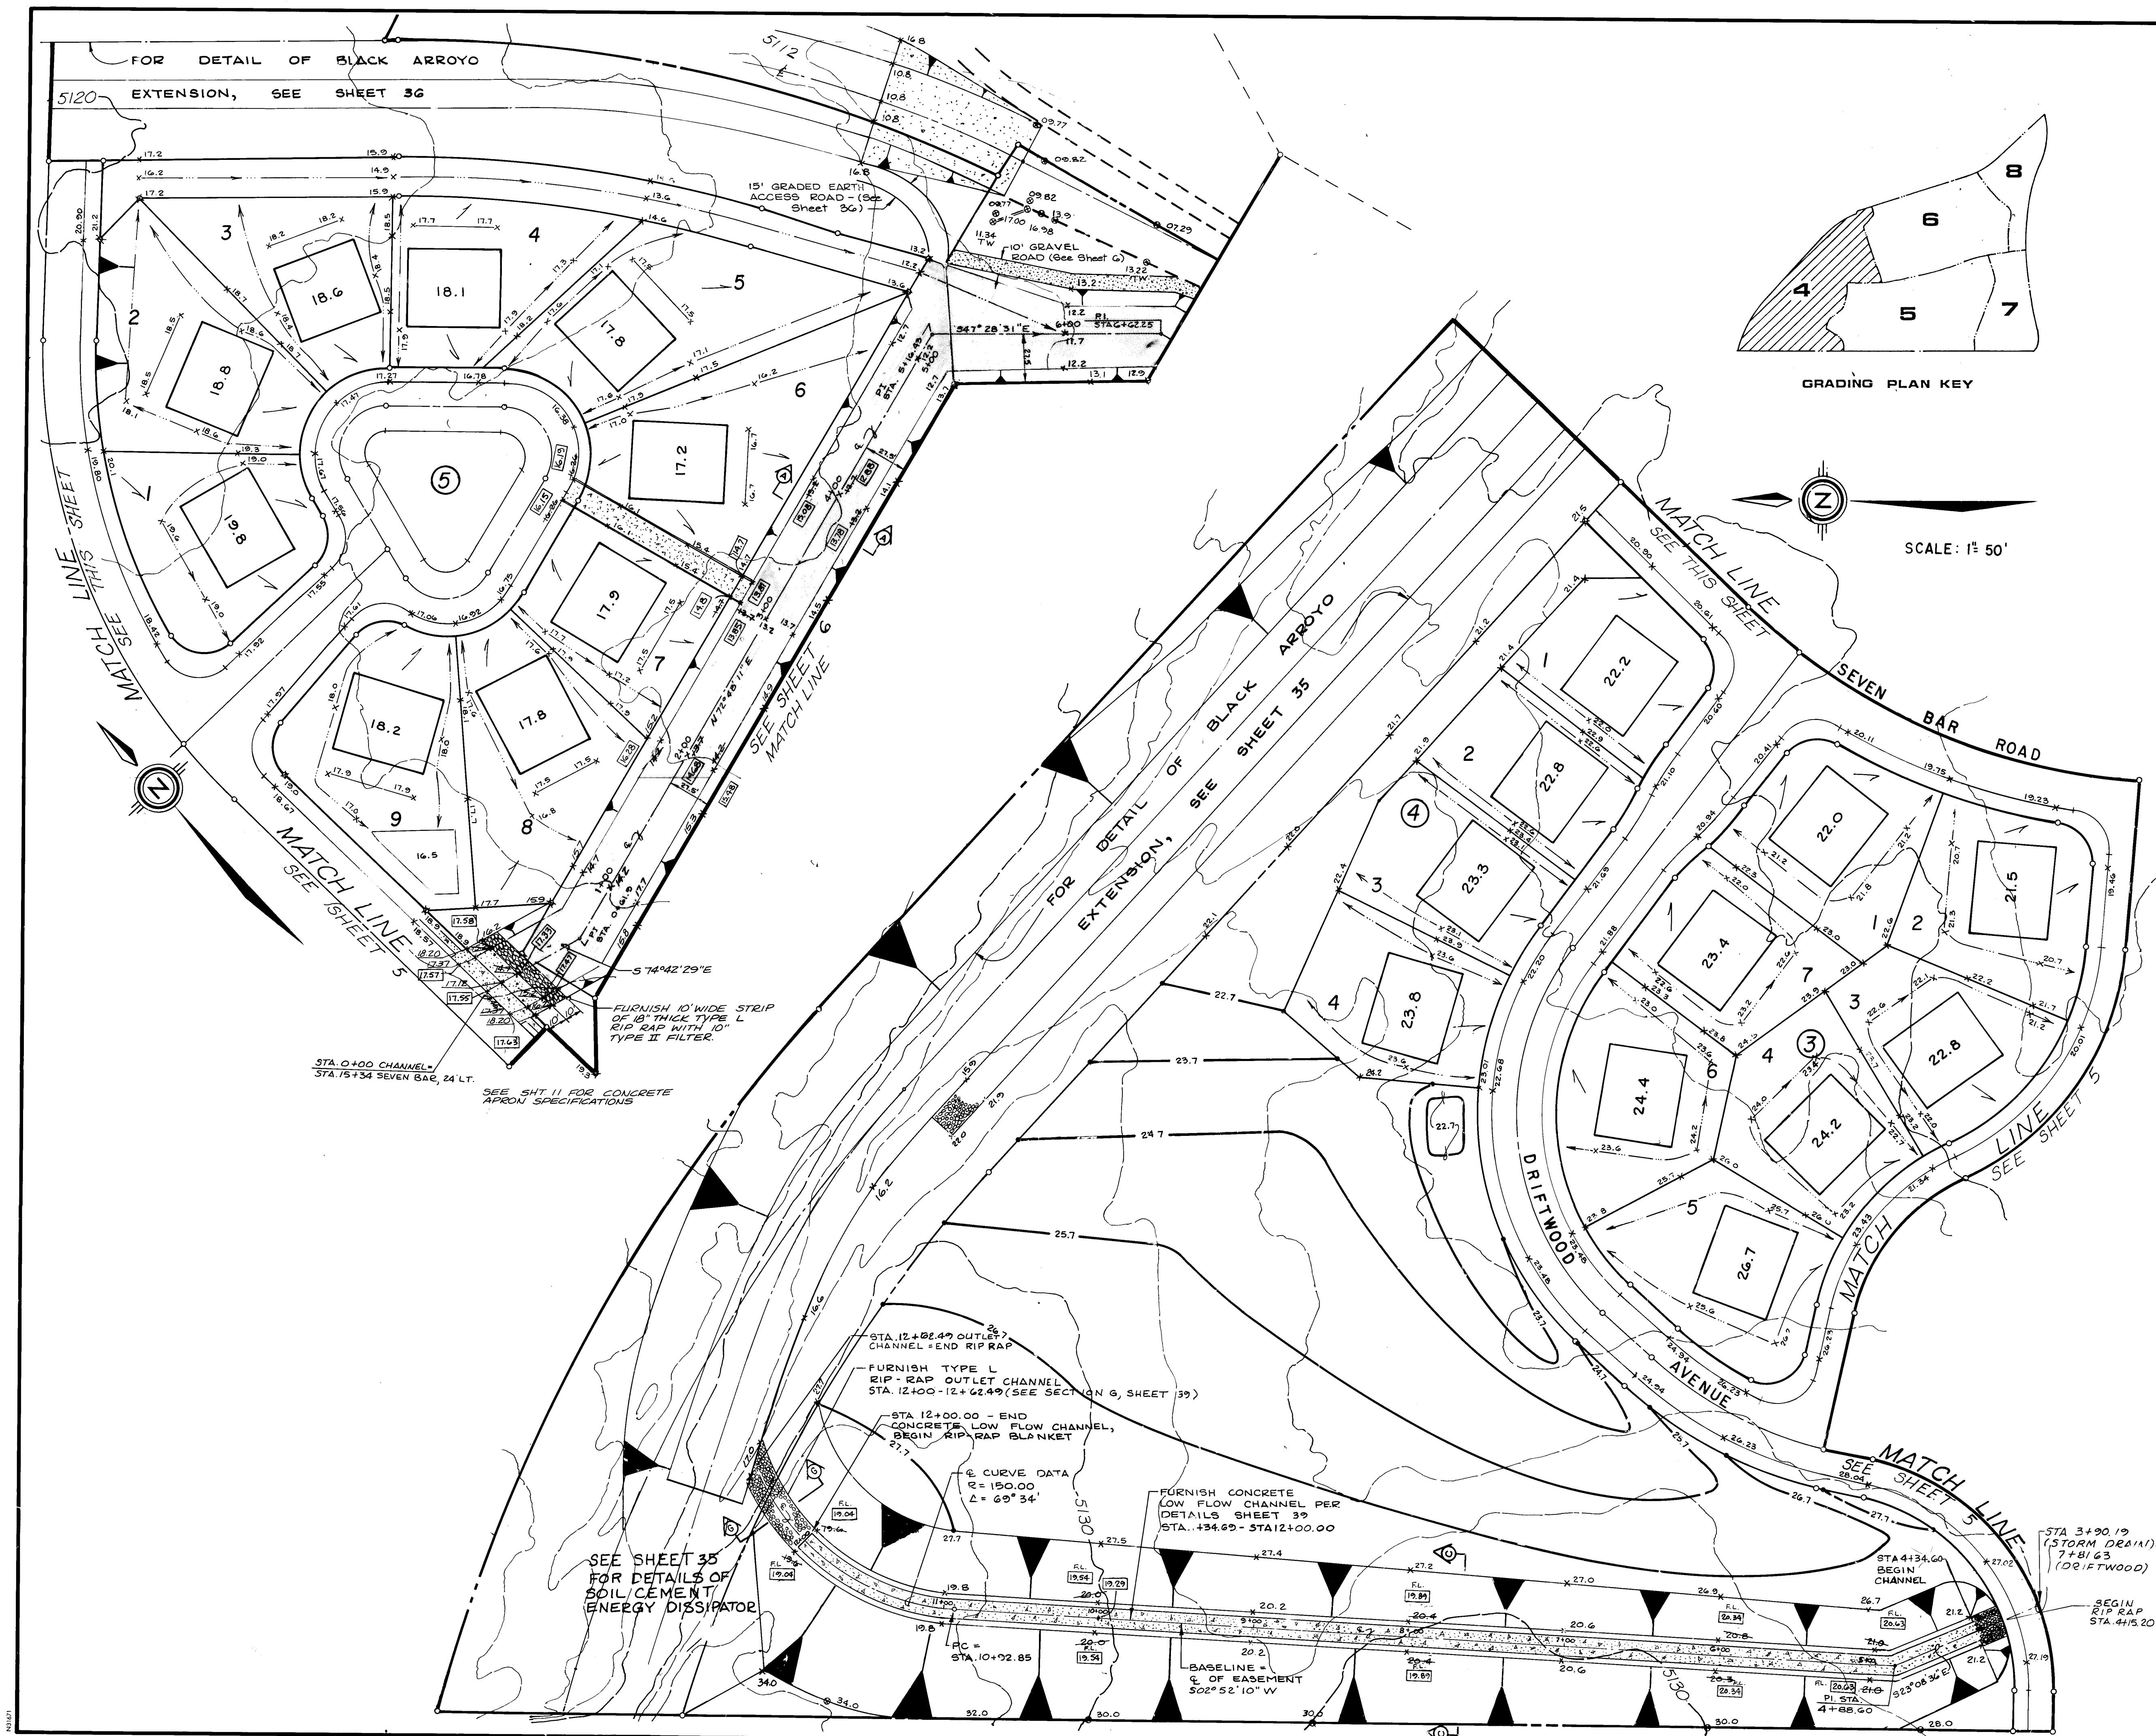

AS BUILT

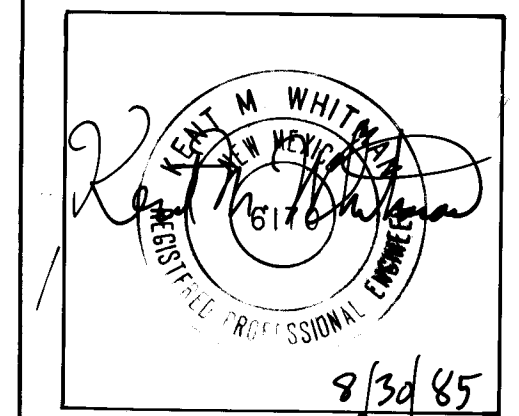


NOTE: THIS CERTIFICATION IS INTENDED TO INDICATE THAT IN THE ENGINEER'S OPINION THIS CONSTRUCTION IS IN SUBSTANTIAL COMPLIANCE WITH THE DESIGN AS SHOWN (OR AS ANNOTATED WITH UPDATED FIELD CHANGES WHERE INDICATED). IT IS NOT A VERIFICATION OF CONTRACT COMPLIANCE IN THE LEVEL OF DETAIL ASSOCIATED WITH FULL CONSTRUCTION INSPECTION OF THE PROJECT.

2 1 4 5 6 7 8 9 10 11 12
1 2 3 4 5 6 7 8 9 10 11 12

CITY OF ALBUQUERQUE MUNICIPAL DEVELOPMENT DEPARTMENT ENGINEERING DIVISION					
TITLE: SALIDA DEL SOL - UNIT ONE GRADING PLAN					
APPROVALS	ENGINEER	DATE	APPROVALS	ENGINEER	DATE
City Engineer	<i>C. M. Whitman</i>	9/30/85	Liquid Waste		
ACE - Design	<i>John D. Hester</i>	8/6/84	Traffic	<i>T. M. Kennedy</i>	2/20/84
ACE - Hydrology	<i>John D. Hester</i>	2/20/84	Water Res.	<i>N. M. W.</i>	2-1-84
DRAWING NO.	1869	MAP NO.	A-13	SHEET	4 OF 40



AS BUILT INFORMATION	
DATE	9/30/85
BY	K. M. W.
DATE	11/83
BY	M. A. S.
DATE	11/83
BY	K. M. W.
DATE	11/83

SURVEY INFORMATION	
NO.	127184
BY	K. M. W.
DATE	11/83
BY	M. A. S.
DATE	11/83
BY	K. M. W.
DATE	11/83

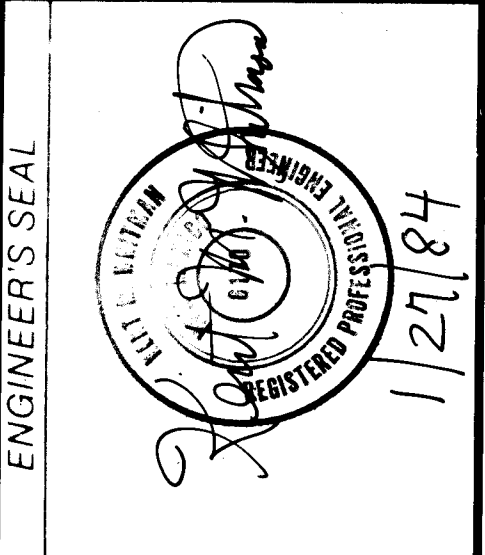


ENGINEER'S SEAL	
NO.	127184
BY	K. M. W.
DATE	11/83
BY	M. A. S.
DATE	11/83
BY	K. M. W.
DATE	11/83

REVISIONS	
NO.	DATE
1	8/6/84
2	2/20/84
3	2-1-84

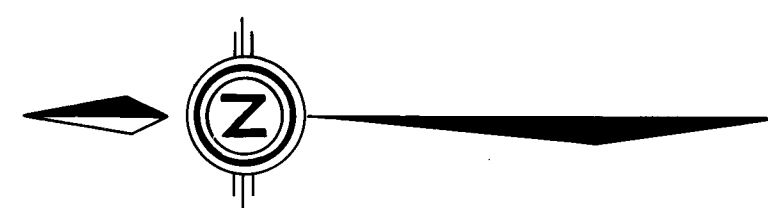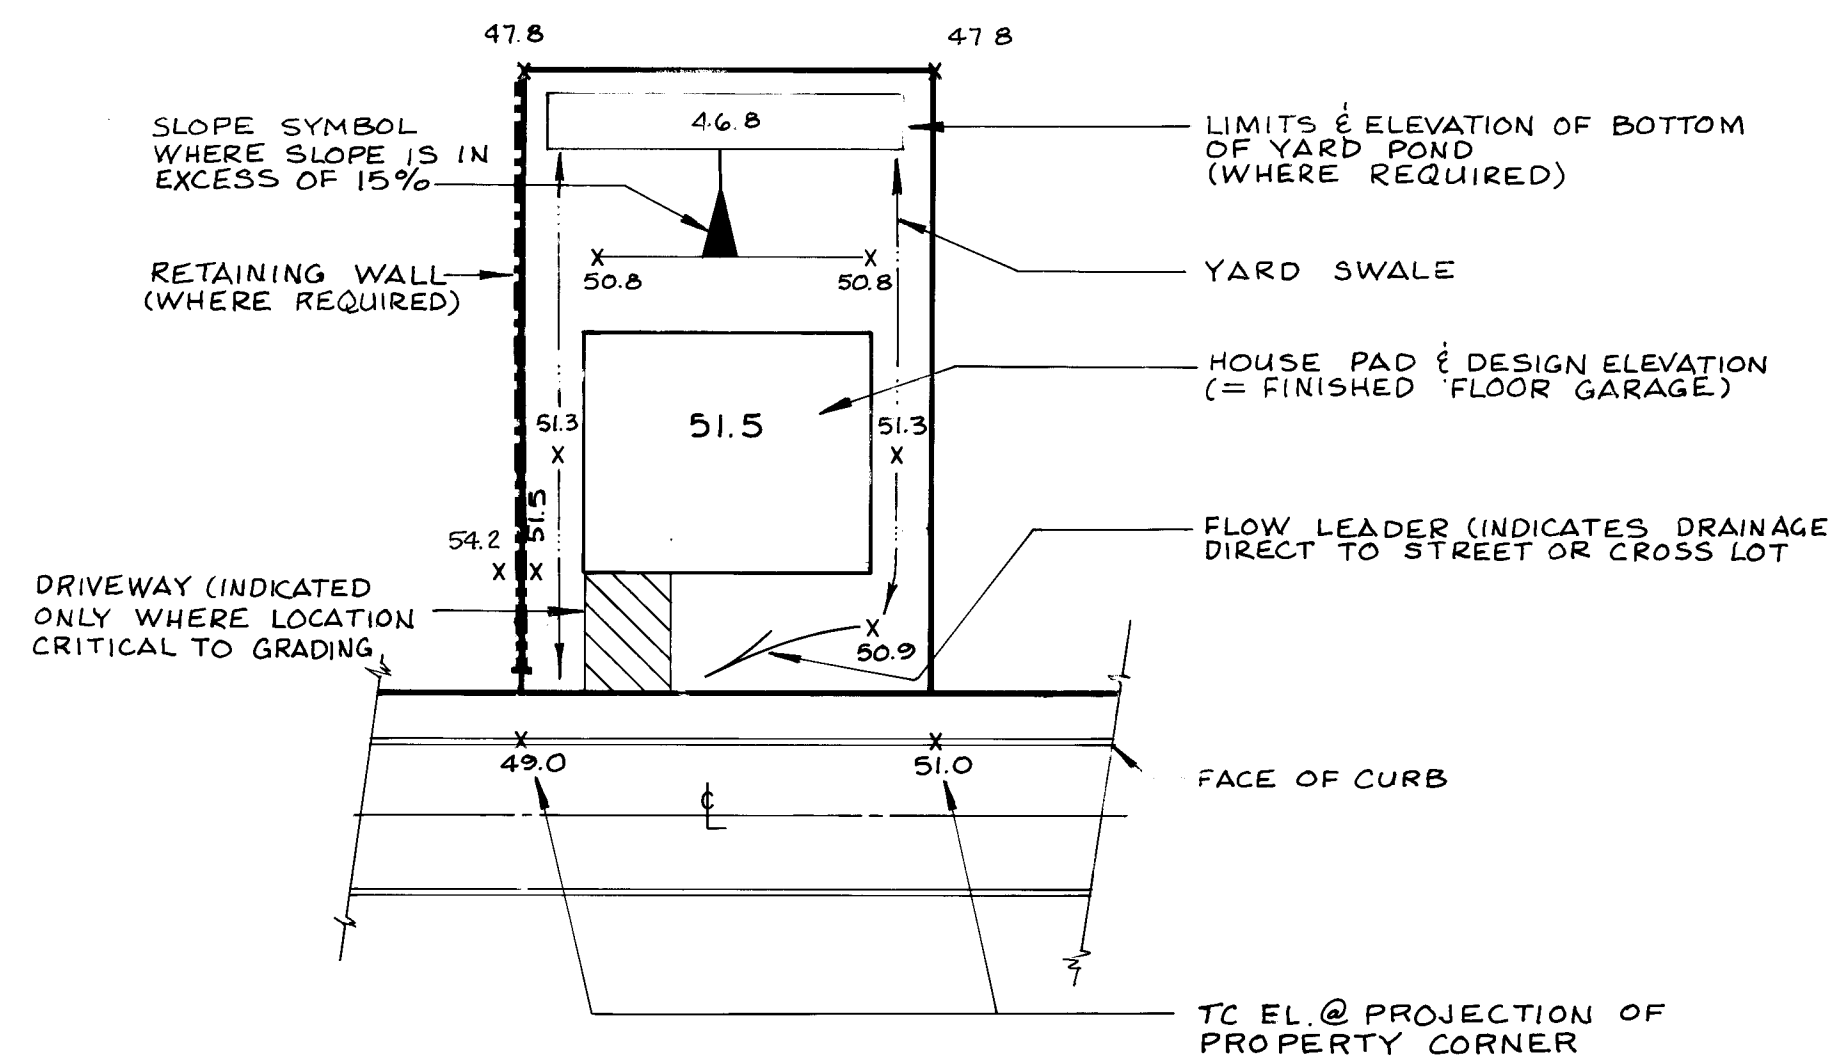

SCALE: 1" = 50'

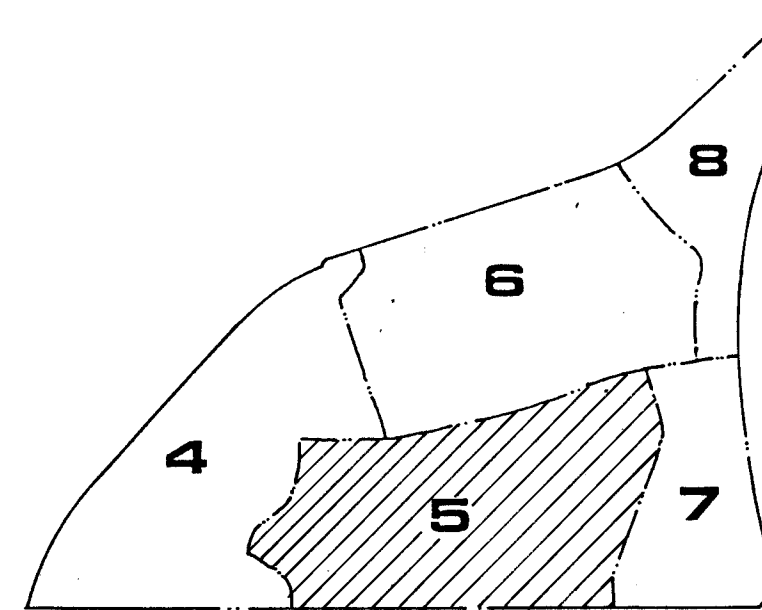


LEGEND (ALL GRADING NOTE ON SPOT ELEVATIONS: N.T.S.)

- EXISTING
- x DESIGN (FINISHED)



AS BUILT

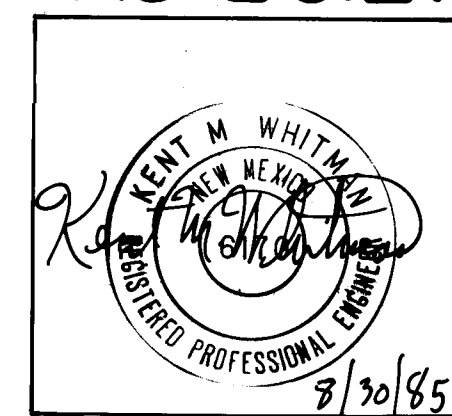

NOTE: THIS CERTIFICATION IS INTENDED TO INDICATE THAT IN THE ENGINEER'S OPINION THIS CONSTRUCTION IS IN SUBSTANTIAL COMPLIANCE WITH THE DESIGN AS SHOWN (OR AS ANNOTATED WITH UPDATED FIELD NOTES WHERE INDICATED). IT IS NOT A VERIFICATION OF CONTRACT COMPLIANCE IN THE LEVEL OF DETAIL ASSOCIATED WITH FULL CONSTRUCTION INSPECTION OF THE PROJECT.

CITY OF ALBUQUERQUE MUNICIPAL DEVELOPMENT DEPARTMENT ENGINEERING DIVISION					
TITLE: SALIDA DEL SOL - UNIT ONE					
GRADING PLAN					
APPROVALS	ENGINEER	DATE	APPROVALS	ENGINEER	DATE
City Engineer	<i>[Signature]</i>	5/1/84	Liquid Waste		
A.C.E. - Design	<i>[Signature]</i>	8/26/84	Traffic	<i>[Signature]</i>	2/28/84
A.C.E. - Hydrology	<i>[Signature]</i>	2/28/84	Water Res.	NA	2/28/84
DRAWING NO. 1869		MAP NO. A-13		SHEET 5 OF 40	

AS BUILT INFORMATION	
DATE	DATE
BY	BY
NO.	NO.

BENCH MARKS	
DATE	DATE
BY	BY
NO.	NO.

SURVEY INFORMATION	
DATE	DATE
BY	BY
NO.	NO.

ENGINEER'S SEAL	
DATE	DATE
BY	BY
NO.	NO.

REVISIONS	
NO.	DATE
1	11-83
2	11-83
3	11-83

REMARKS	
DESIGNED BY	DATE
DRAWN BY	DATE
CHECKED BY	DATE


GRAVEL	SPECS
SCREEN SIZE	% PASSING
2"	100
3/4"	80-100
NO. 4	40-70
NO. 10	30-55
NO. 200	4-12
R.I.	6 or less

NOTE: GRADE LEVEL FROM ELEVATIONS OF SECTION A CHANNEL TO WALL OF CONCRETE CHANNEL FURNISH 4" GRAVEL ROAD SURFACE AS SHOWN & TO SPECIFICATIONS THIS SHEET.
GRAVEL NOT FURNISHED



SECTION - H (Through match line with soil cement inlet.)
1" = 20' horiz.
1" = 5' vert.


AS BUILT

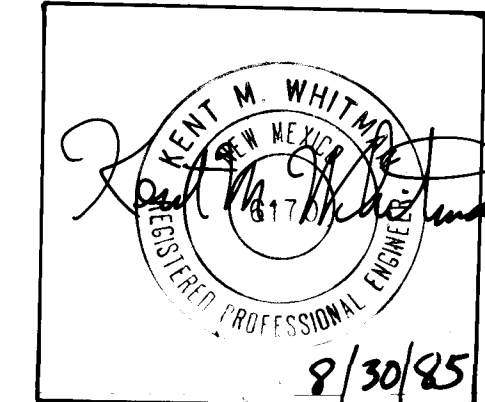

NOTE: THIS CERTIFICATION IS INTENDED TO INDICATE THAT IN THE ENGINEER'S OPINION, THIS CONSTRUCTION IS IN SUBSTANTIAL COMPLIANCE WITH THE DESIGN AS SHOWN (OR AS ANNOTATED WITH UPDATED FIELD GRADES WHERE INDICATED). IT IS NOT A VERIFICATION OF CONTRACT COMPLIANCE IN THE LEVEL OF DETAIL ASSOCIATED WITH FULL CONSTRUCTION INSPECTION OF THE PROJECT.

26 18690686




CITY OF ALBUQUERQUE MUNICIPAL DEVELOPMENT DEPARTMENT ENGINEERING DIVISION					
TITLE: SALIDA DEL SOL - UNIT TWO					
GRADING PLAN					
APPROVALS	ENGINEER	DATE	APPROVALS	ENGINEER	DATE
City Engineer	<i>[Signature]</i>	8/30/85	Liquid Waste		
A.C.E. - Design	<i>[Signature]</i>	8/30/85	Traffic	<i>[Signature]</i>	2/28/84
A.C.E. - Hydrology	<i>[Signature]</i>	2/28/84	Water Res.	<i>[Signature]</i>	2/28/84
DRAWING NO. 1869					
MAP NO. A-13					
SHEET 6 OF 40					

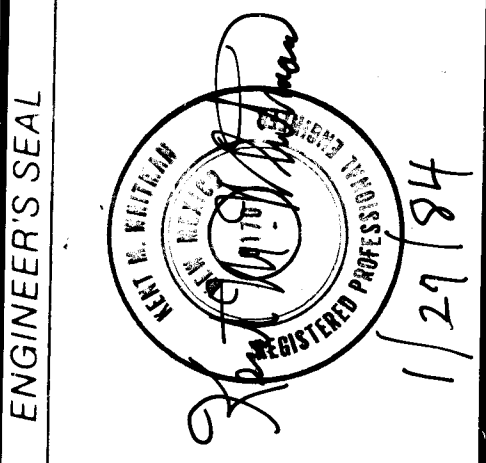


NO.	DATE	REMARKS	BY
1	11-83	DESIGN	K.M.W.
2	11-83	DESIGN	K.M.W.
3	11-83	DESIGN	K.M.W.

AS BUILT INFORMATION	BENCH MARKS	SURVEY INFORMATION	FIELD NOTES	DATE
A. SQUARE CHISEL IN THE TOP OF THE EASTERLY WALL OF THE A.M.A.F.C.A. FLOOD DIVERSION NO. 2 CHANNEL, APPROXIMATELY 180 FEET SOUTH OF THE POINT OF CONFLUENCE WITH THE SKYLINE DRAINAGE CHANNEL ESTABLISHED BY BOHANNAN-HUSTON AND MARKED "TBM 205". ELEVATION = 5110.55				

1861

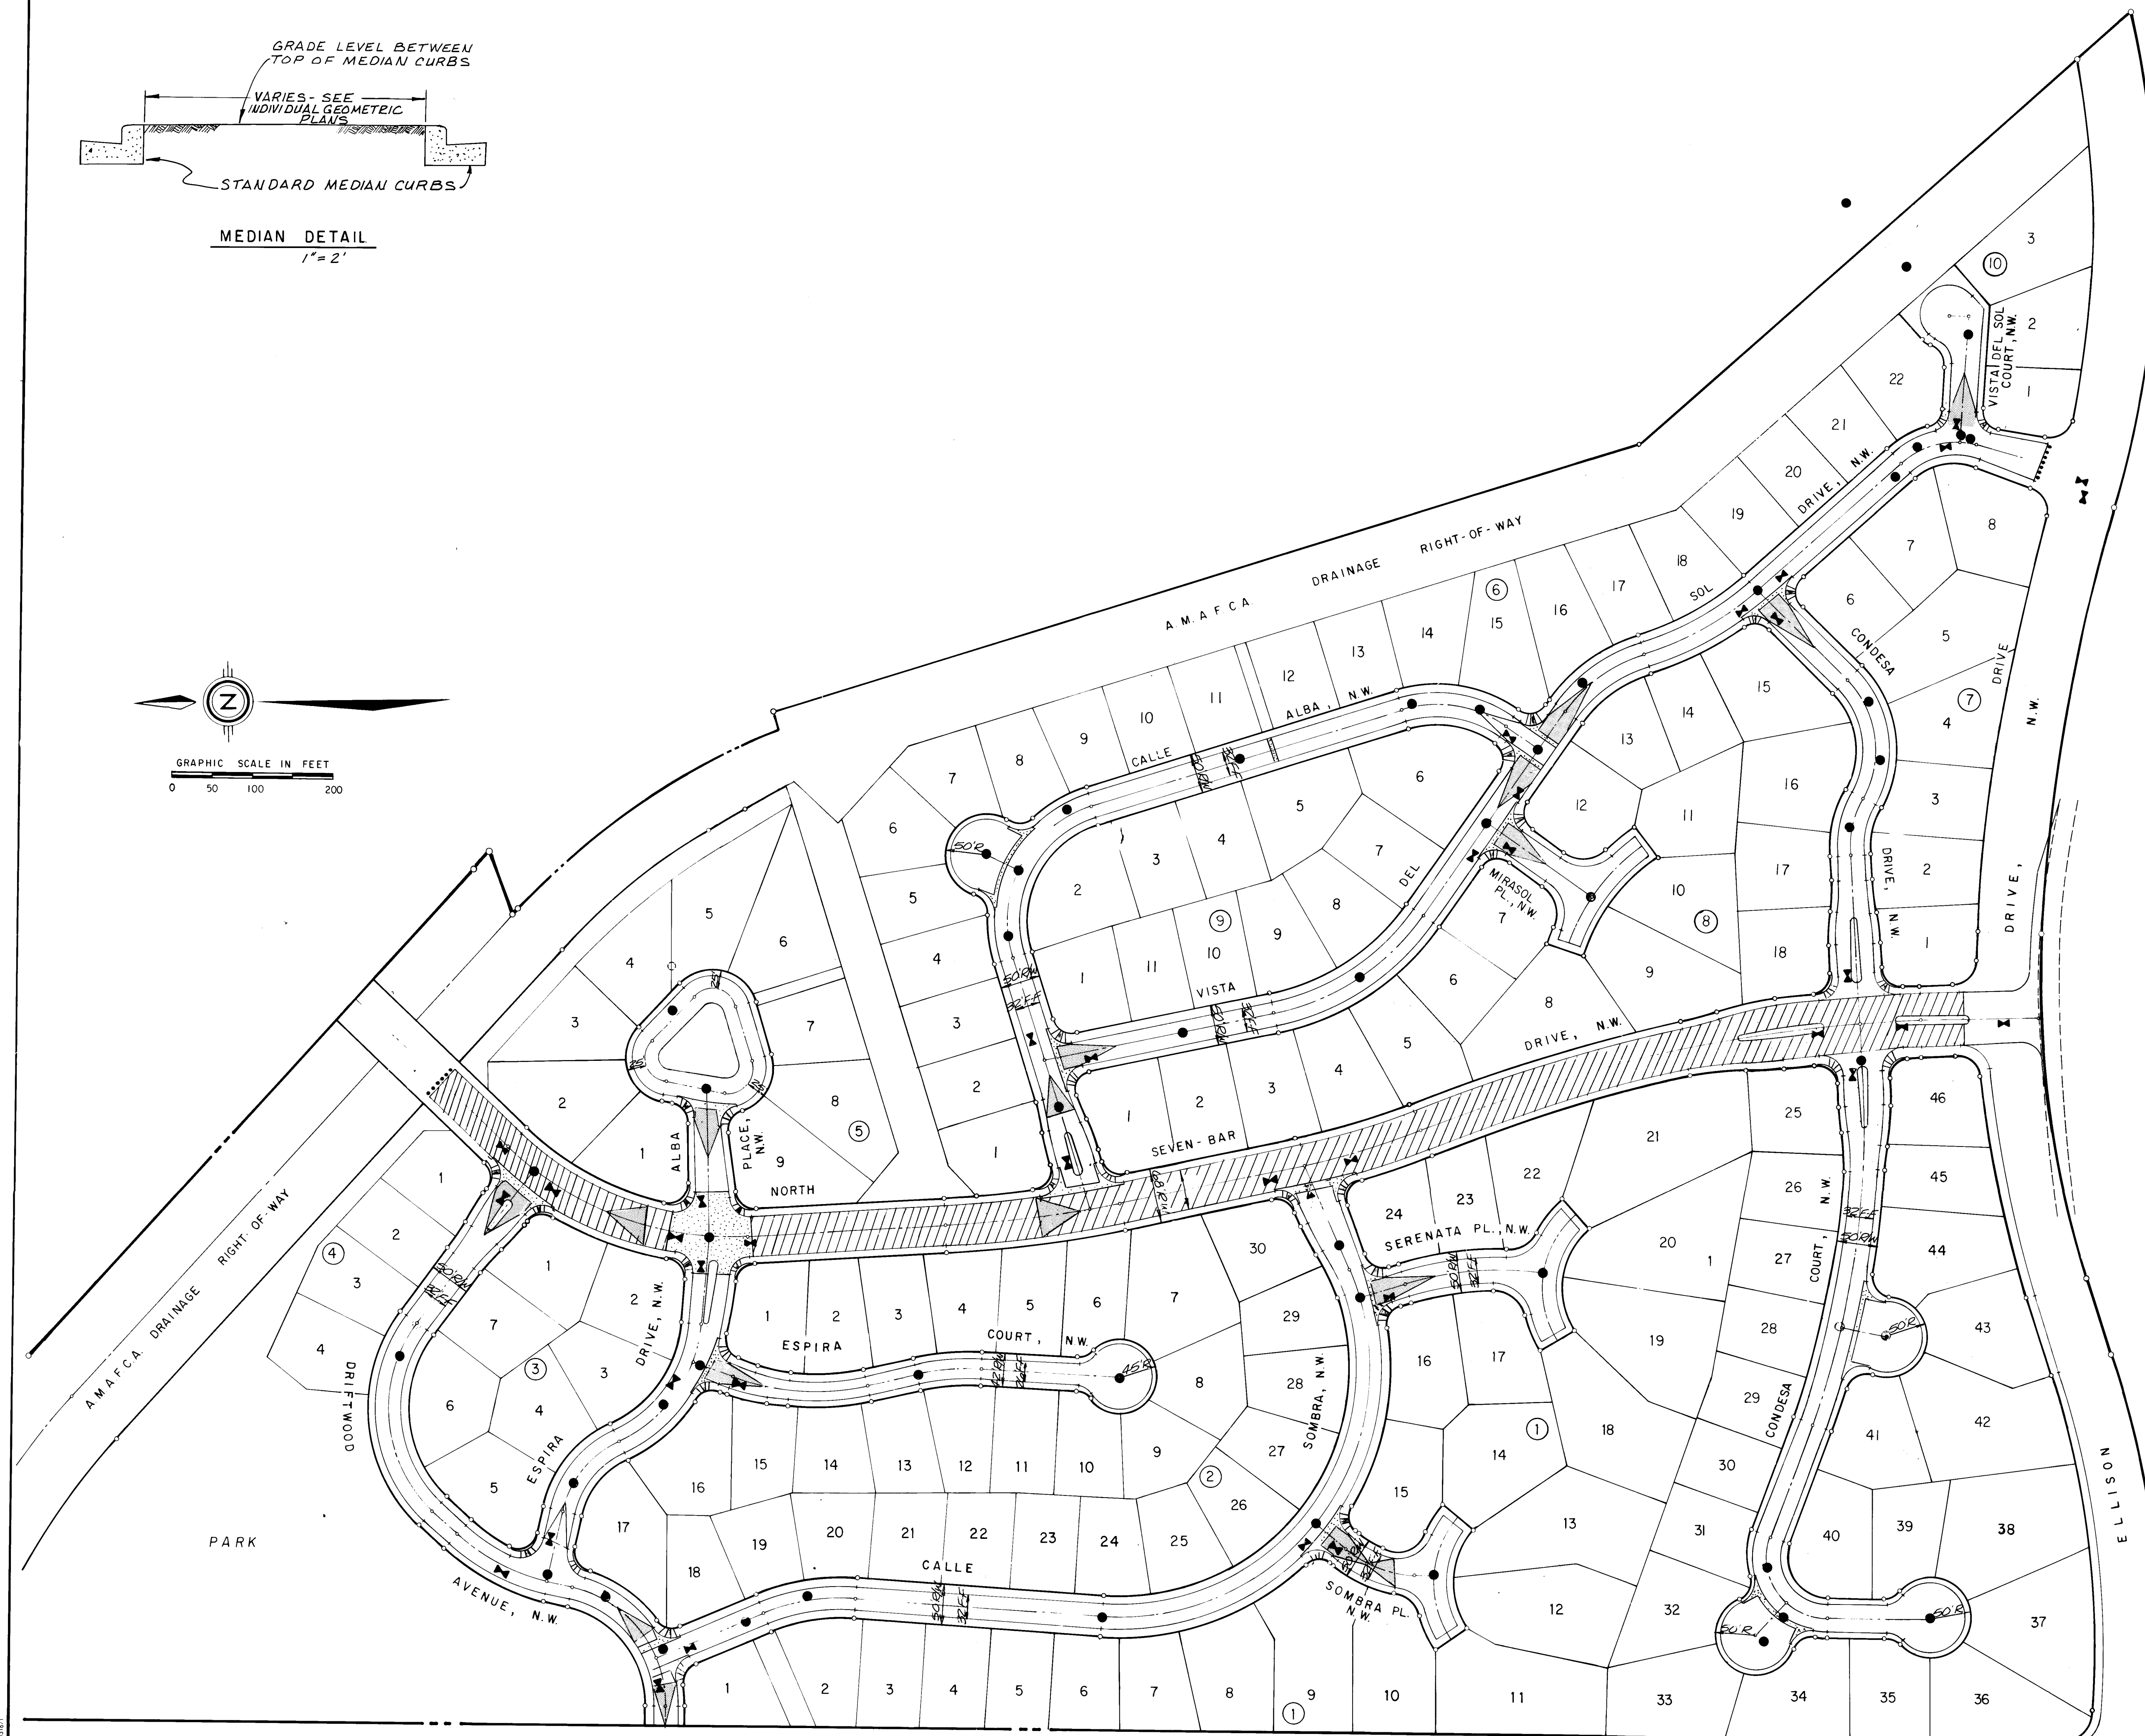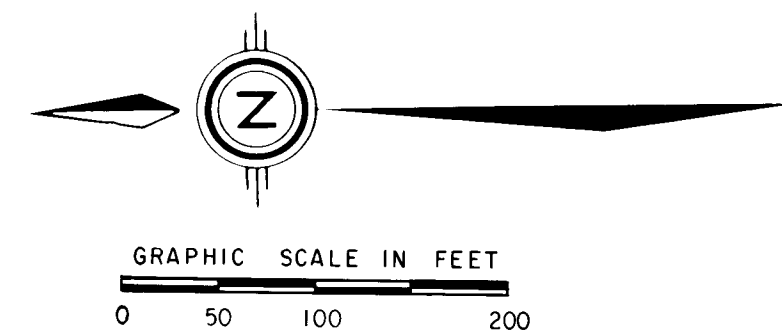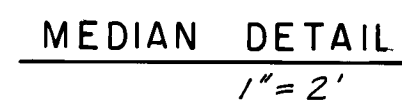

AS BUILT

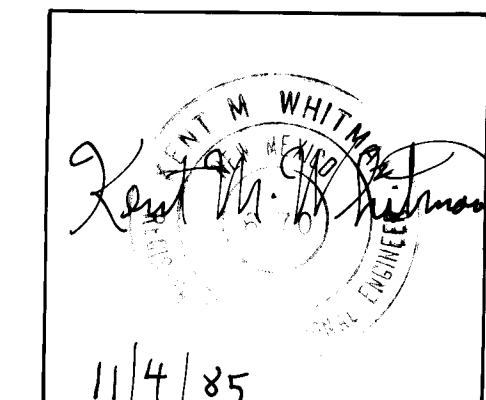

NOTE: THIS CERTIFICATION IS INTENDED TO INDICATE THAT IN THE ENGINEER'S OPINION THIS CONSTRUCTION IS IN SUBSTANTIAL COMPLIANCE WITH THE DESIGN AS SHOWN (OR AS ANNOTATED WITH UPDATED FIELD GRADES WHERE INDICATED). IT IS NOT A VERIFICATION OF CONTRACT COMPLIANCE IN THE LEVEL OF DETAIL ASSOCIATED WITH FULL CONSTRUCTION INSPECTION OF THE PROJECT.

LEGEND

-
-  SANITARY SEWER MH LOCATION
 WATERLINE VALVE BOX LOCATION
 CONCRETE VALLEY GUTTER W/
TRANSITION SECTION
 TRAFFIC BARRICADE
 ARTERIAL PAVEMENT
 WHEELCHAIR RAMP

26 1869 1086

CITY OF ALBUQUERQUE
MUNICIPAL DEVELOPMENT DEPARTMENT
ENGINEERING DIVISION


TITLE: SALIDA DEL SOL-UNITS ONE & TWO
COMPOSITE STREET PAVING PLAN

APPROVALS	ENGINEER	DATE	APPROVALS	ENGINEER	DATE
City Engineer	<i>C. K. Shyng</i>	7/1/84	Liquid WASTE		
A C E - Design	<i>W. K. Shyng</i>	8/15/84	Traffic	<i>T. W. Kennedy</i>	2/28/84
A C E - Hydrology	<i>W. K. Shyng</i>	2/22/84	Water R.O.	<i>W. K. Shyng</i>	2-8-84


DRAWING NO.	1869	MAP NO.	A-13	SHEET	10	OF	40
-------------	------	---------	------	-------	----	----	----

[illegible]


1828

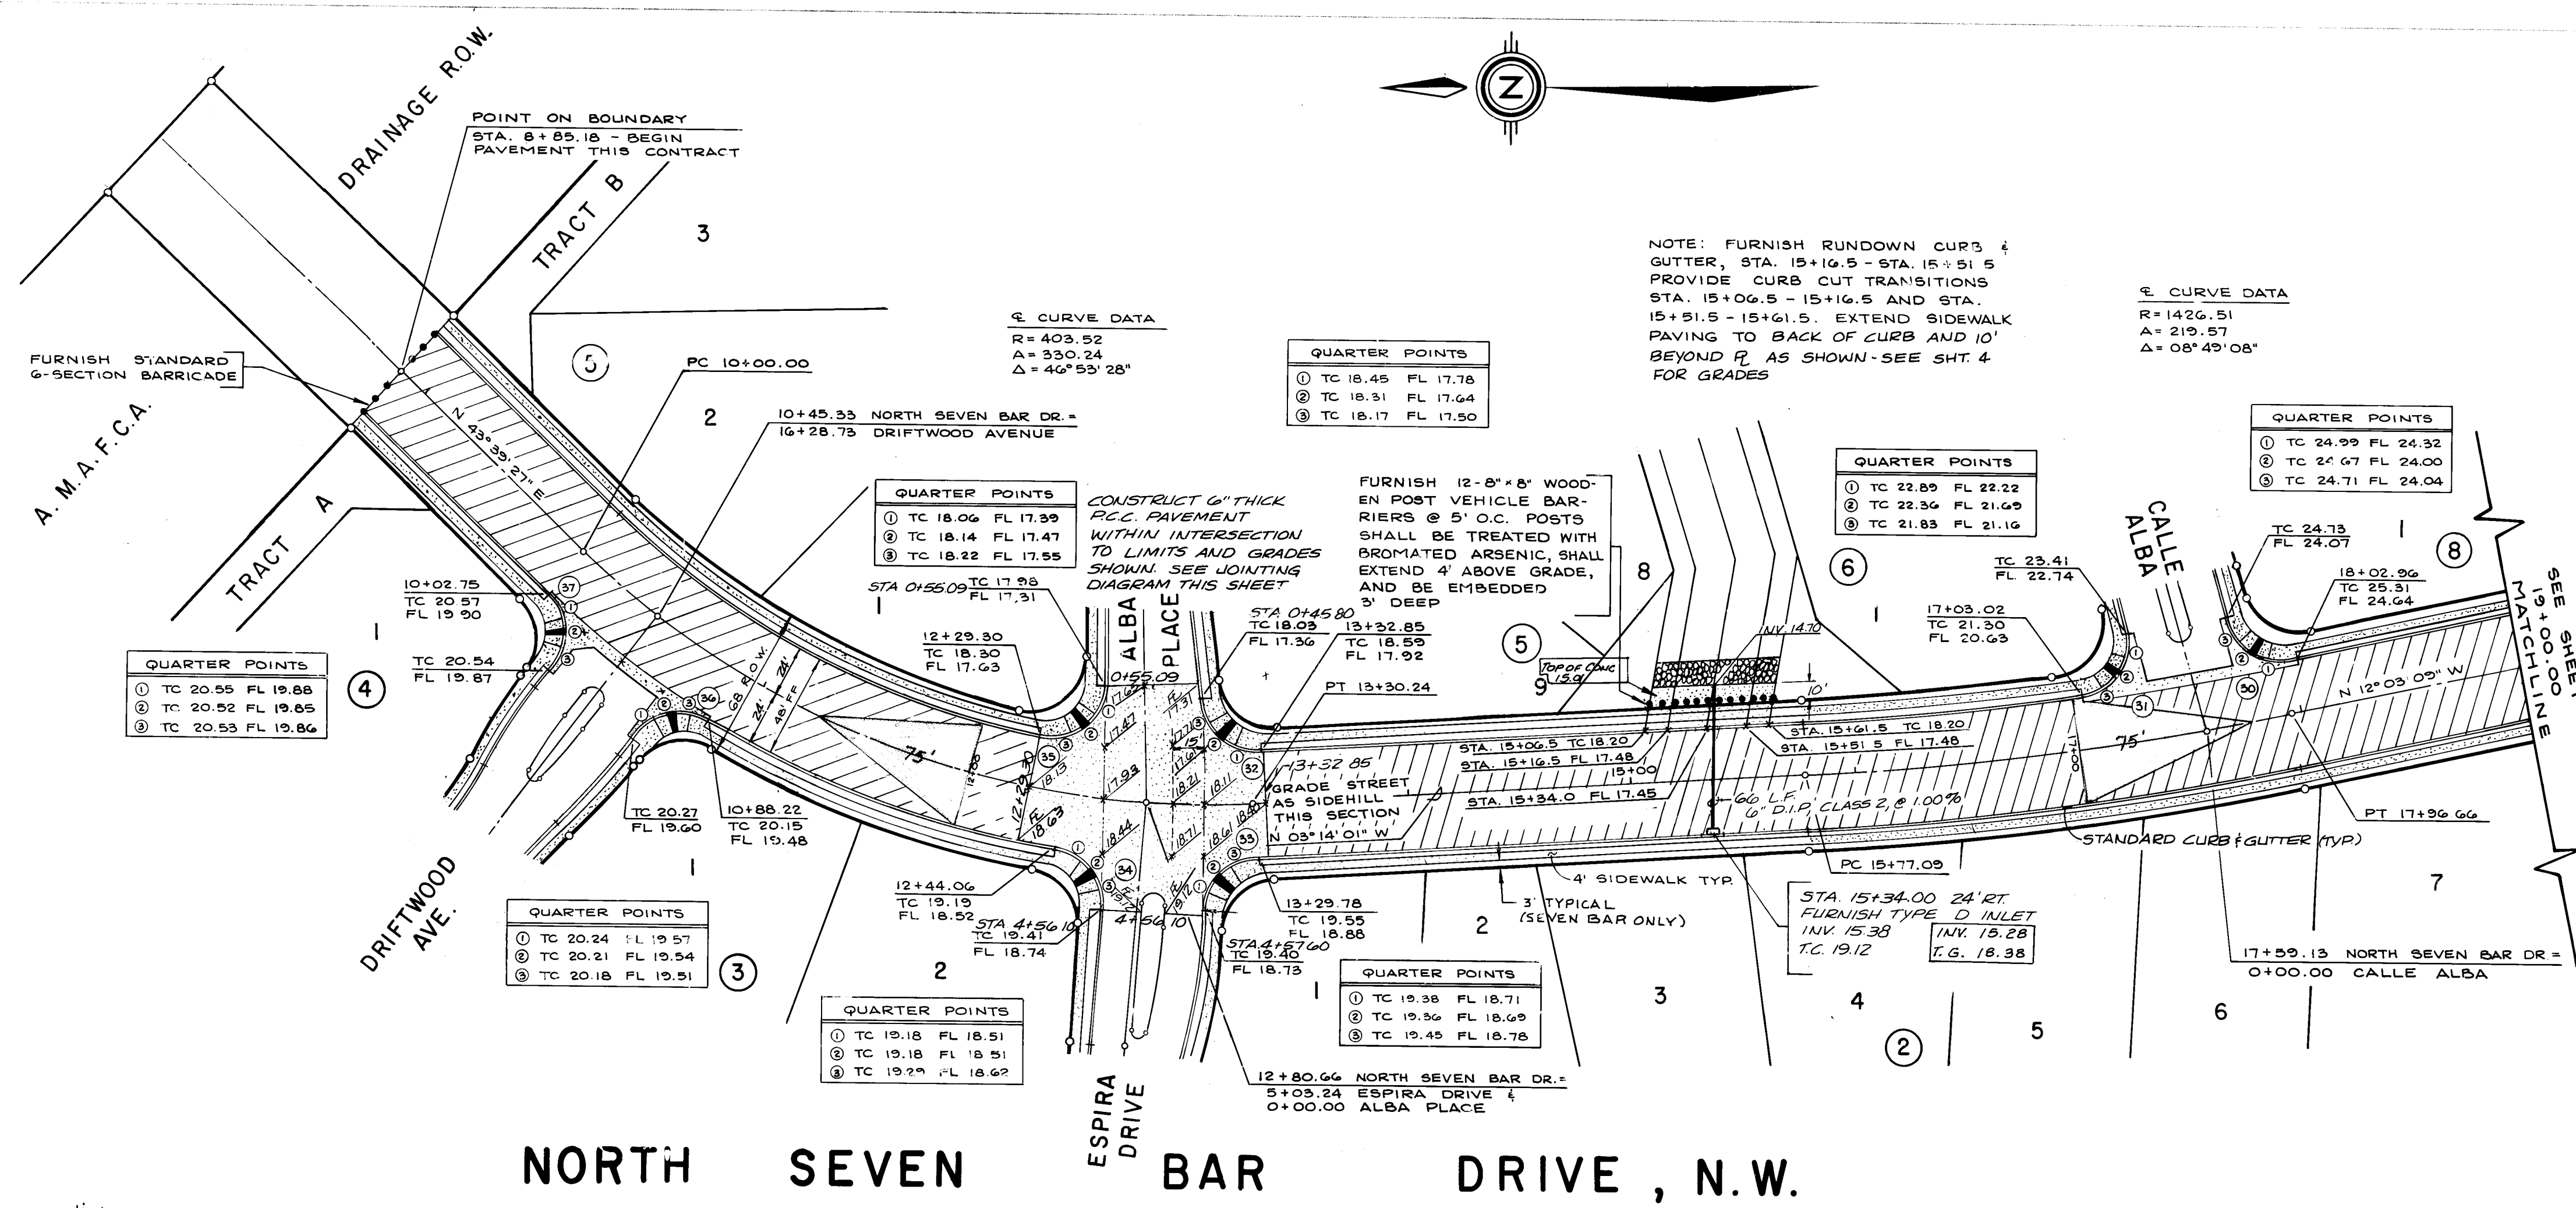


CURVE DATA			
CURVE	RADIUS	ARC	DELTA
(30)	25.00	37.03	84°51'20"
(31)	25.00	43.16	98°54'15"
(32)	25.00	37.86	86°45'35"
(33)	25.00	36.20	82°51'38"
(34)	25.00	37.00	84°48'06"
(35)	25.00	44.32	101°34'48"
(36)	25.00	36.61	83°54'40"
(37)	25.00	36.46	83°33'47"

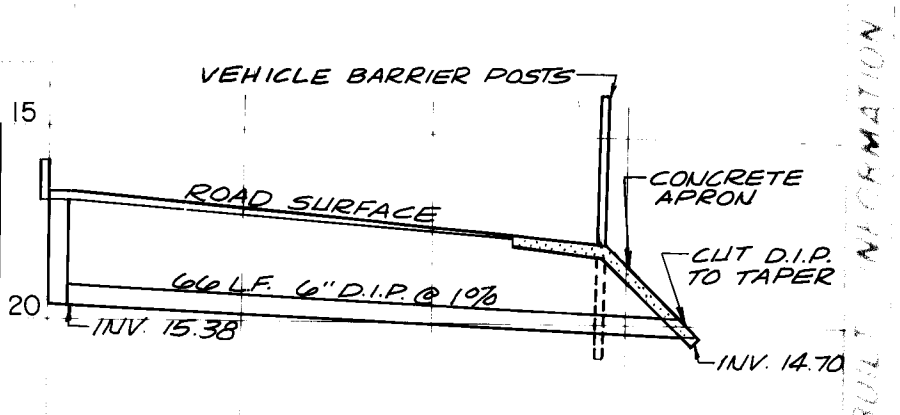

LOW FLOW DRAIN PROFILE
1" = 20' HORIZ.
1" = 5' VERT.

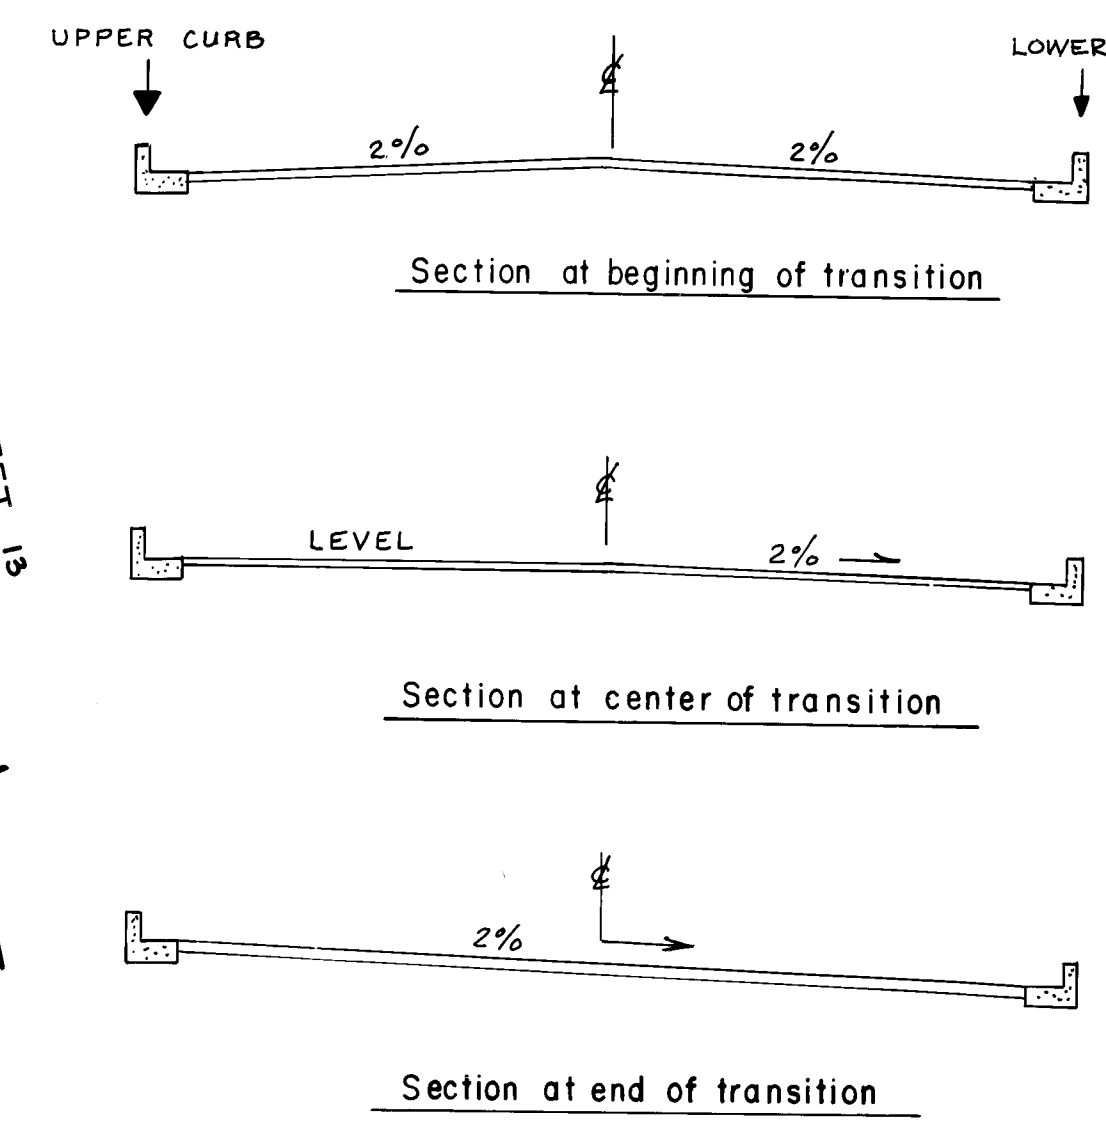


TRANSITION - CROWN TO SUPERELEVATION
N.T.S.

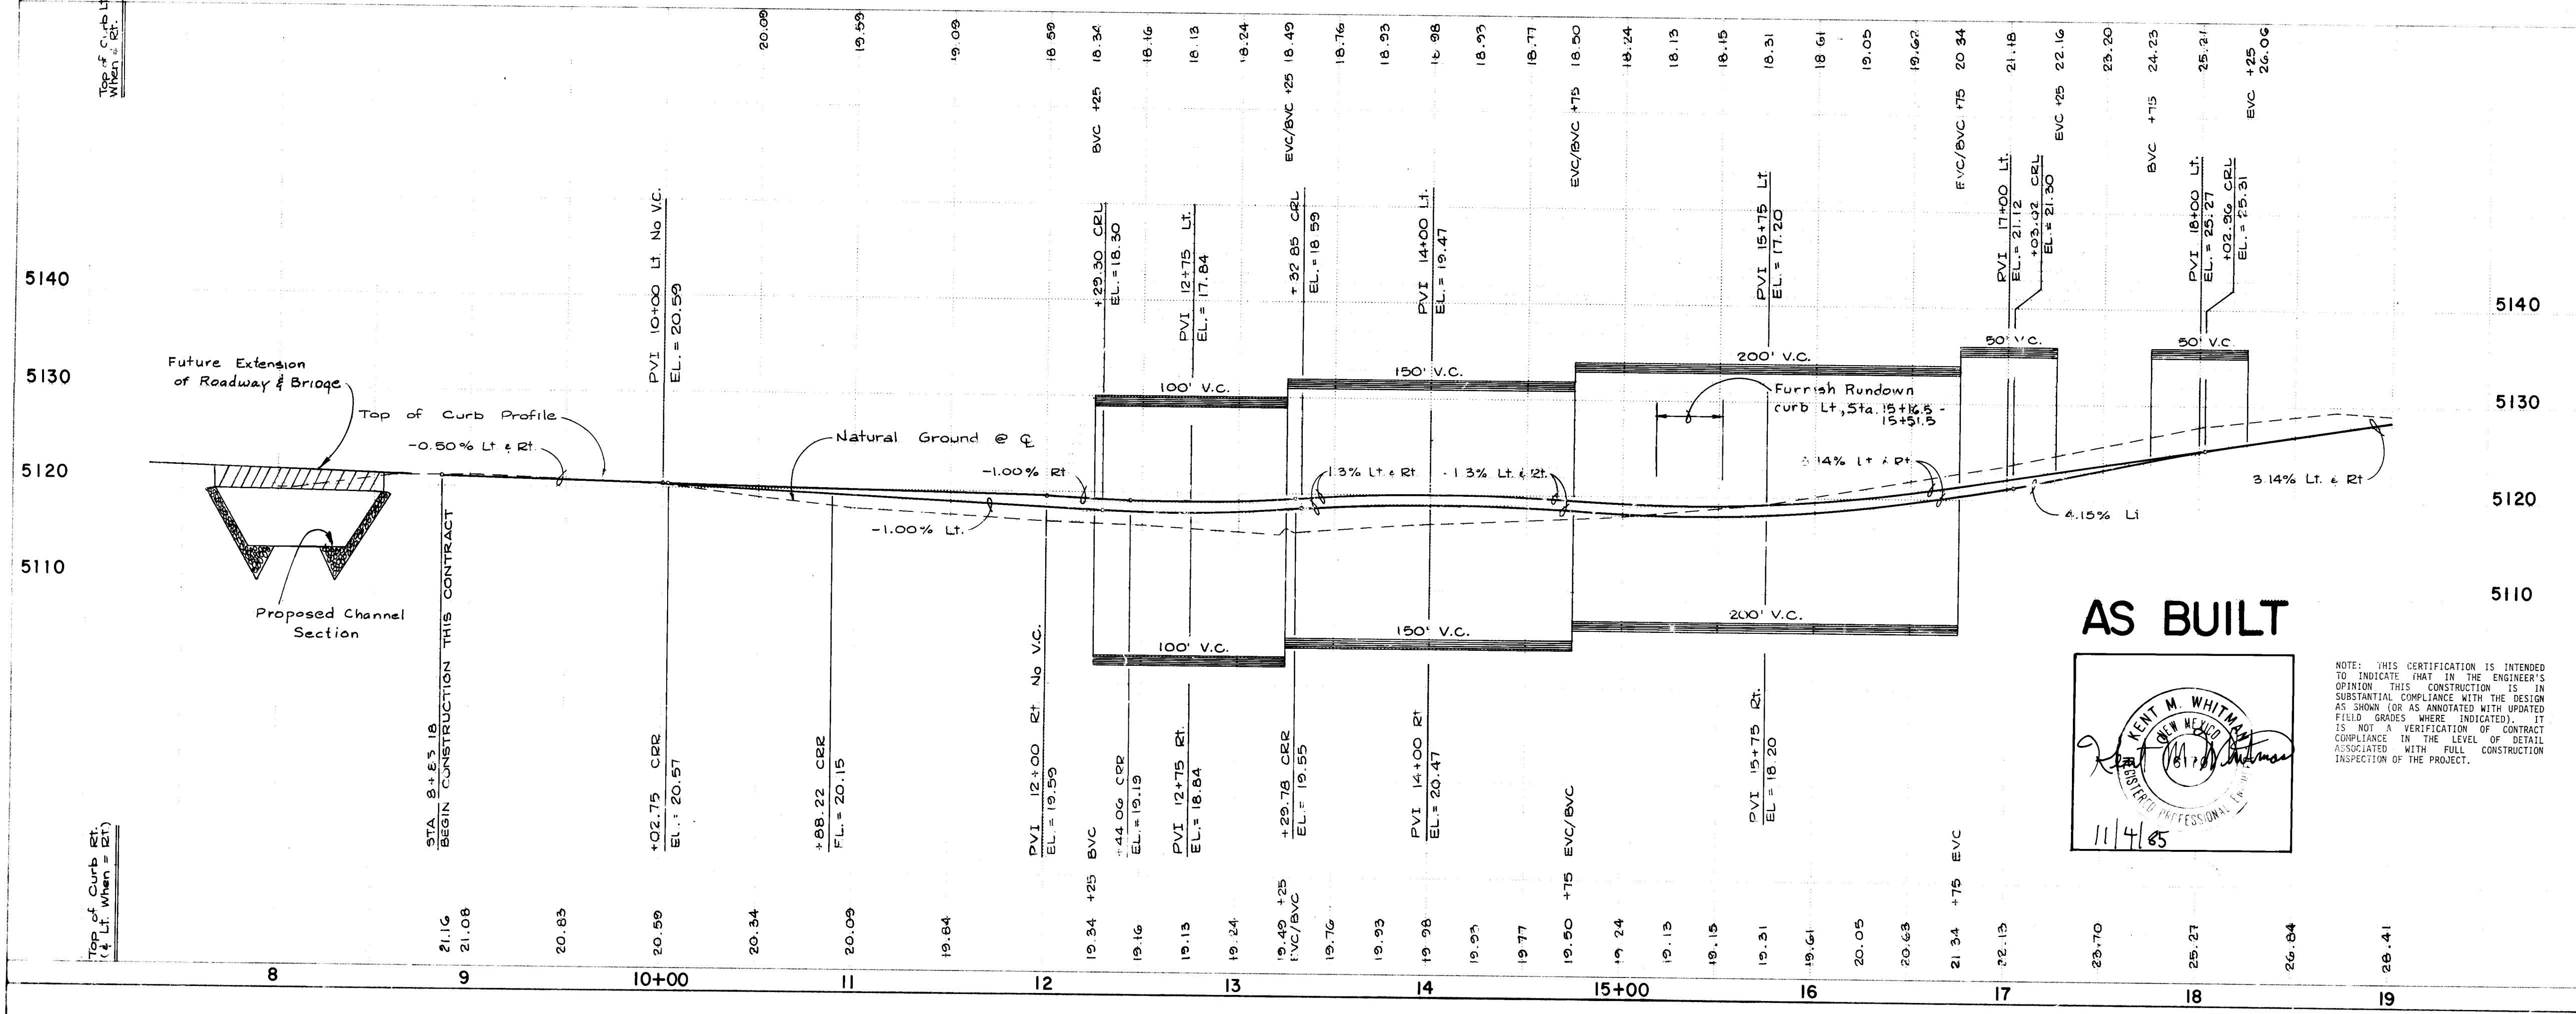

AS BUILT

KENT M. WHITMAN
REGISTERED PROFESSIONAL ENGINEER
11/4/85

NOTE: THIS CERTIFICATION IS INTENDED TO INDICATE THAT IN THE ENGINEER'S OPINION THIS CONSTRUCTION IS IN SUBSTANTIAL COMPLIANCE WITH THE DESIGN AS SHOWN (OR AS ASSOCIATED WITH UPDATED FIELD GRADES WHERE INDICATED). IT IS NOT A VERIFICATION OF CONTRACT COMPLIANCE IN THE LEVEL OF DETAIL ASSOCIATED WITH FULL CONSTRUCTION INSPECTION OF THE PROJECT.

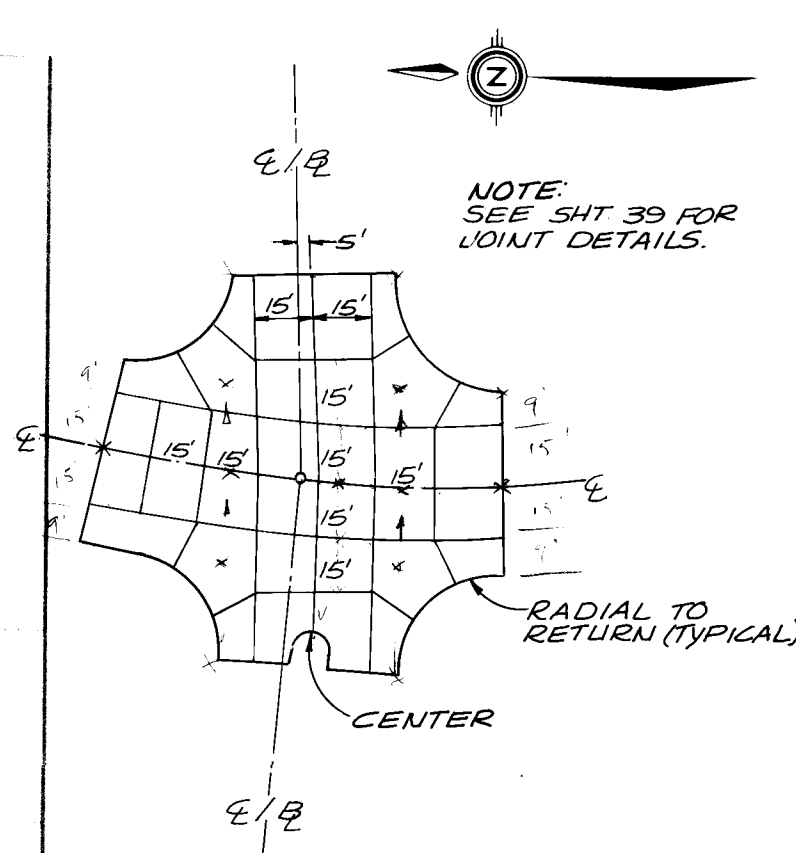

CONCRETE INTERSECTION
JOINTING DIAGRAM
N.T.S.



SCALE 1" = 50' Horizontal
1" = 10' Vertical

CITY OF ALBUQUERQUE
MUNICIPAL DEVELOPMENT DEPARTMENT
ENGINEERING DIVISION


TITLE SALIDA DEL SOL-UNIT ONE - PAVING PLAN & PROFILE
NORTH SEVEN BAR DRIVE, N.W.

APPROVALS	ENGINEER	DATE	APPROVALS	ENGINEER	DATE
City Engineer	<i>[Signature]</i>	8/4/89	City Engineer	<i>[Signature]</i>	8/4/89
A.C.E. Design	<i>[Signature]</i>	8/4/89	A.C.E. Design	<i>[Signature]</i>	8/4/89
A.C.E. Hydrology	<i>[Signature]</i>	8/4/89	A.C.E. Hydrology	<i>[Signature]</i>	8/4/89

DRAWING NO. 1869 MAP NO. A-13 SHEET 11 OF 40

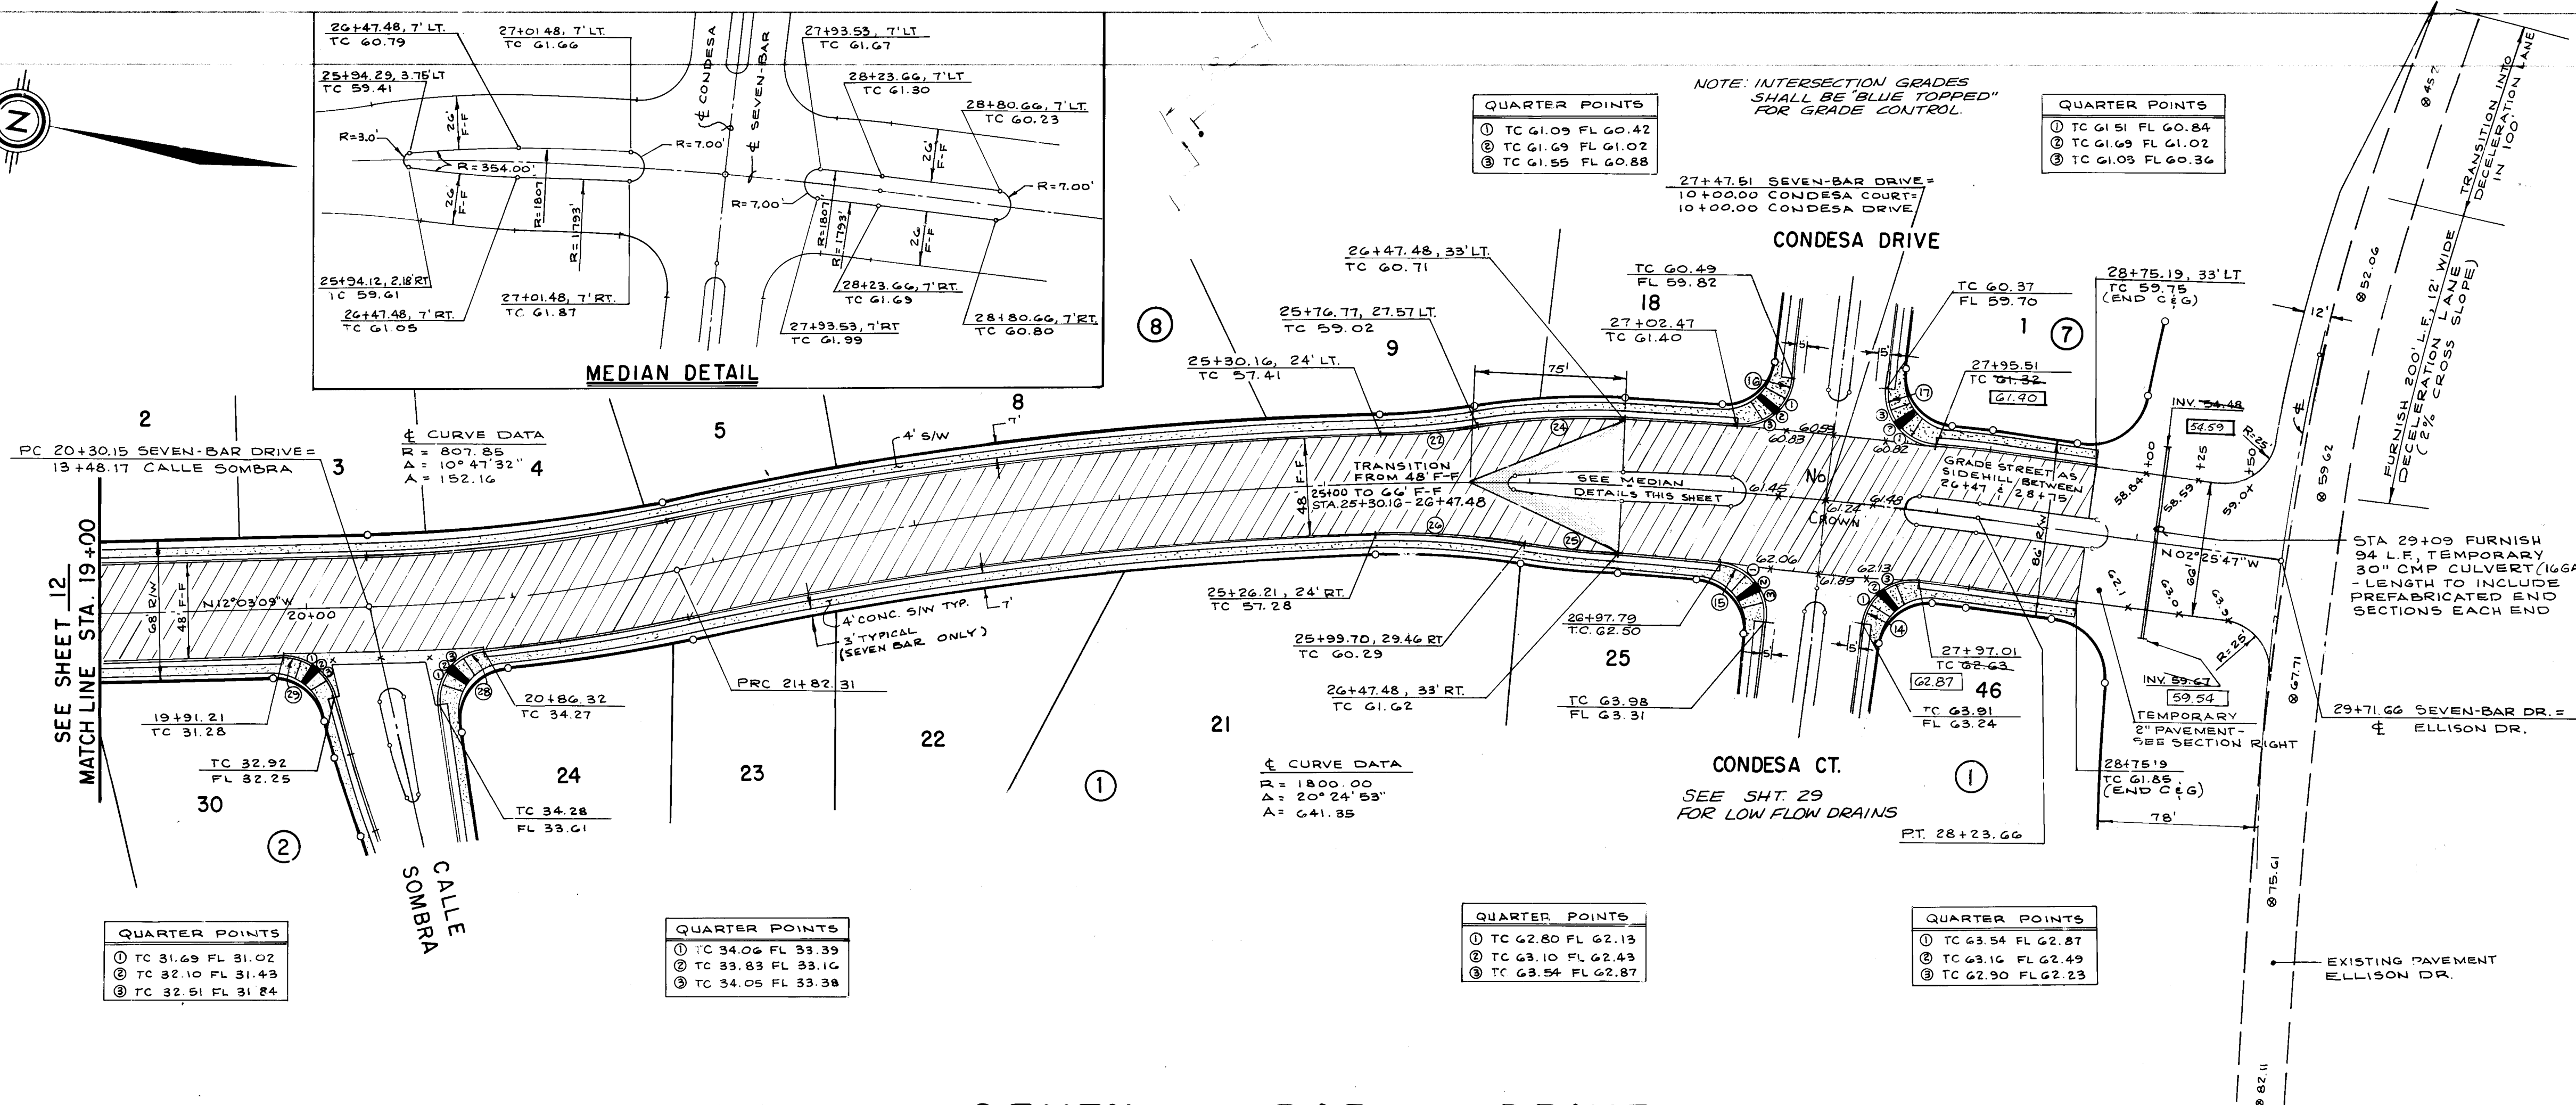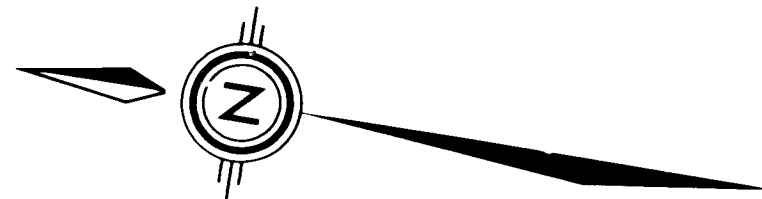


CURVE DATA			
CURVE	RADIUS	ARC	DELTA
(1)	25.00	39.61	90°46'31"
(2)	25.00	40.34	92°27'25"
(3)	25.00	37.98	87°02'59"
(4)	25.00	39.26	89°59'19"
(5)	30.00	45.47	87°13'05"
(6)	380.00	72.21	10°53'14"
(7)	380.00	47.11	07°06'12"
(8)	380.00	72.71	10°57'48"
(9)	25.00	40.57	92°58'45"
(10)	25.00	34.21	78°23'58"

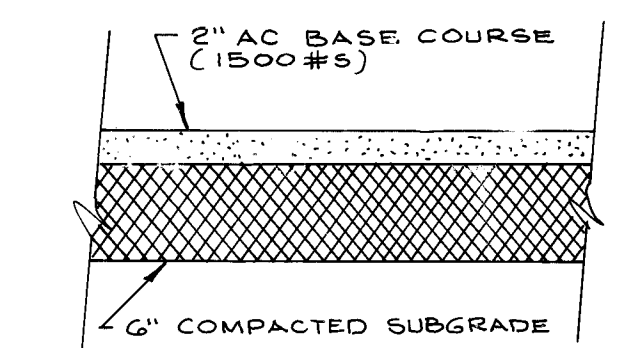


TEMPORARY PAVEMENT DETAILS
N.T.S.

NORTH SEVEN BAR DRIVE, N.W.

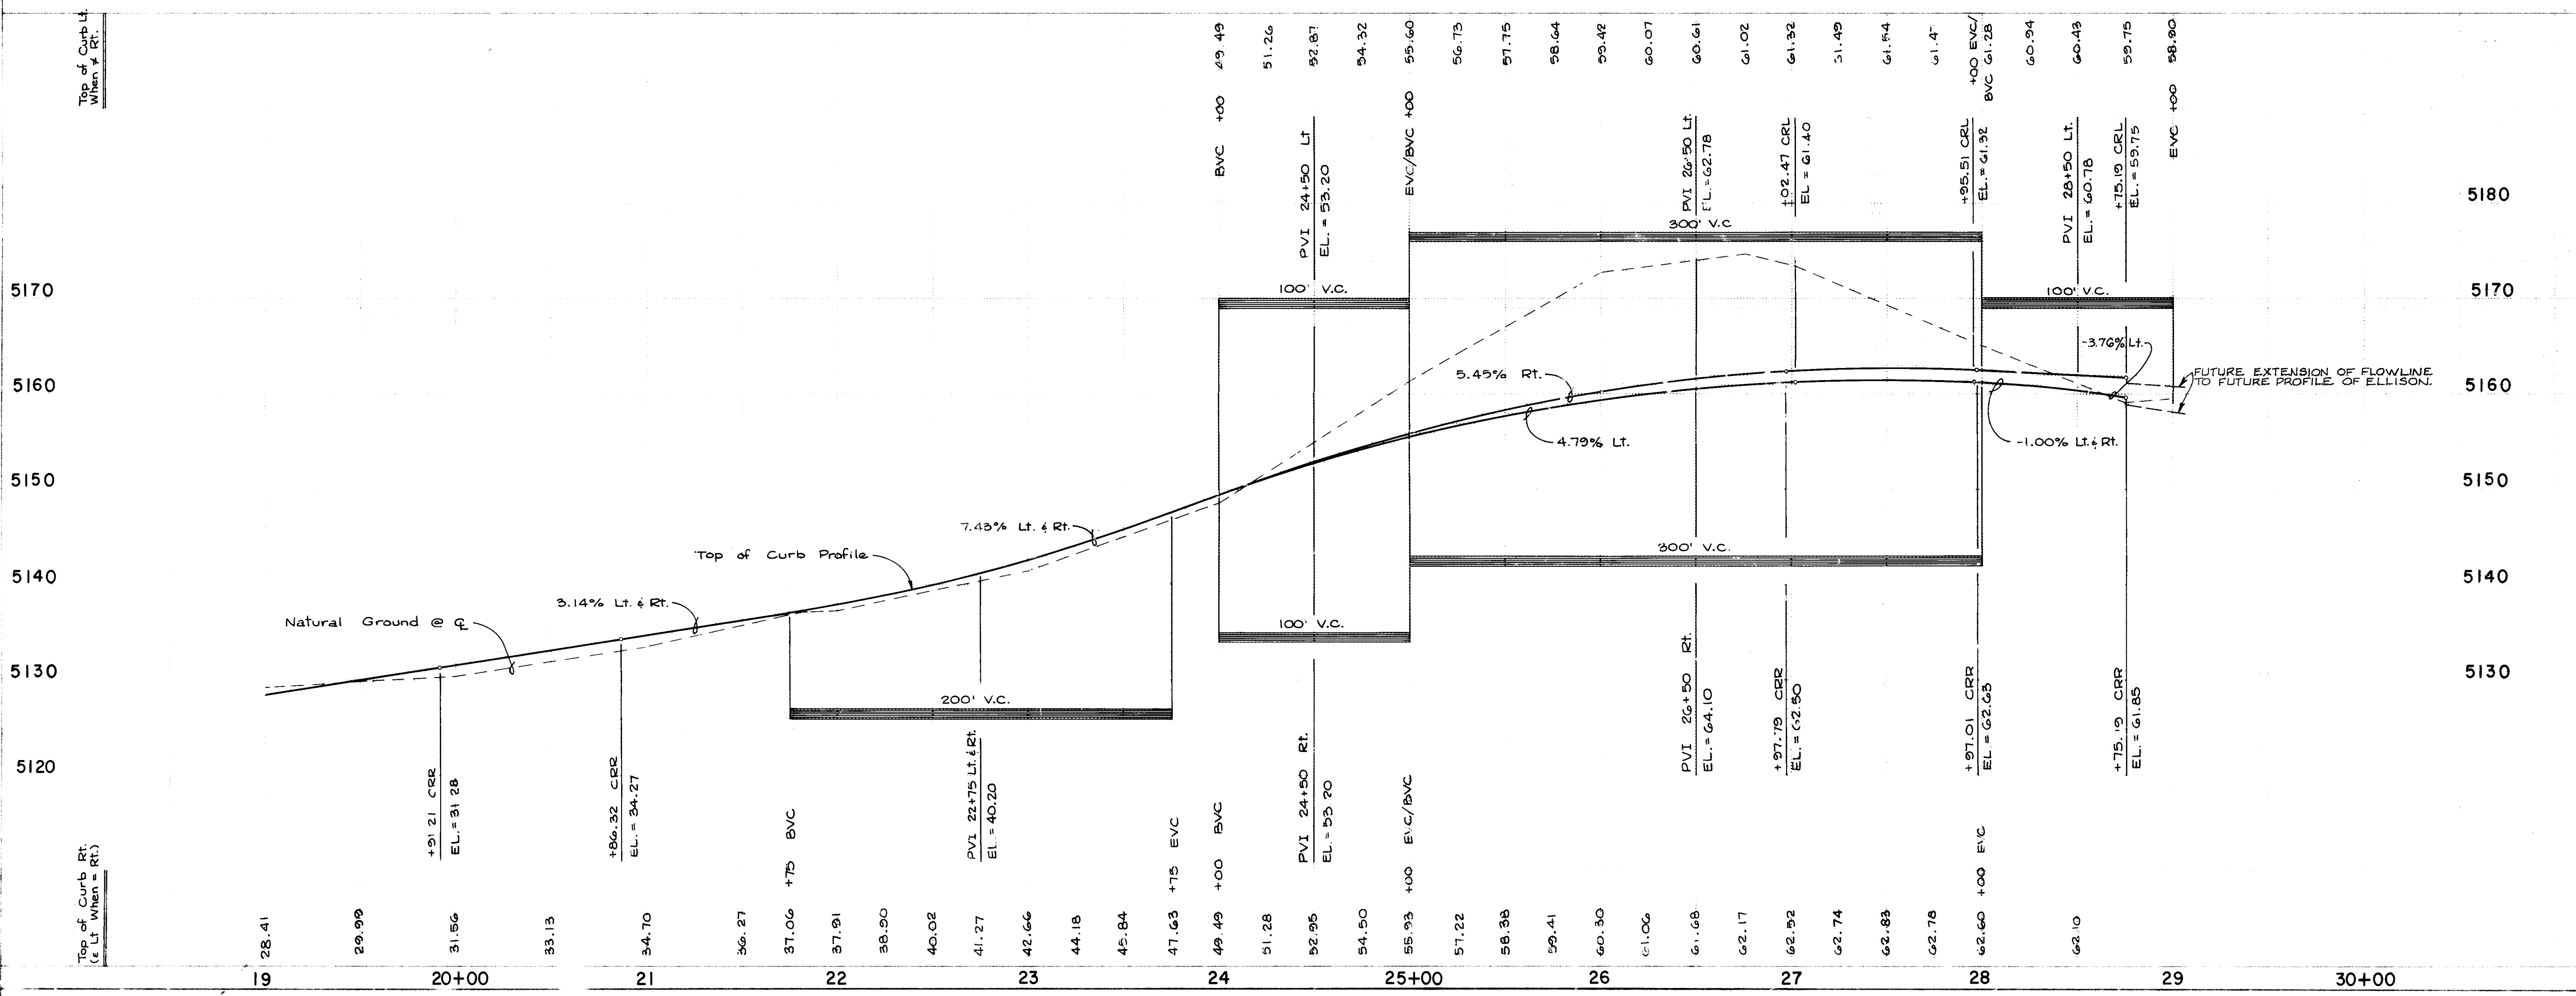

AS BUILT


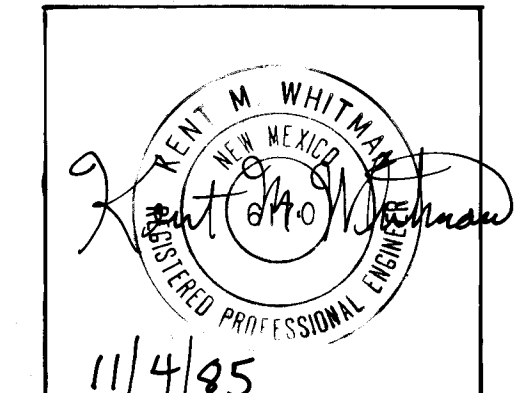


NOTE: THIS CERTIFICATION IS INTENDED TO INDICATE THAT IN THE ENGINEER'S OPINION THIS CONSTRUCTION IS IN SUBSTANTIAL COMPLIANCE WITH THE DESIGN AS SHOWN (OR AS ANNOTATED WITH UPDATED FIELD GRADES WHERE INDICATED). IT IS NOT A VERIFICATION OF CONTRACT COMPLIANCE IN THE LEVEL OF DETAIL ASSOCIATED WITH FULL CONSTRUCTION INSPECTION OF THE PROJECT.

20186191286

SCALE: 1" = 50' Horizontal
1" = 10' Vertical

CITY OF ALBUQUERQUE MUNICIPAL DEVELOPMENT DEPARTMENT ENGINEERING DIVISION			
TITLE: SALIDA DEL SOL-UNIT ONE - PAVING PLAN & PROFILE NORTH SEVEN BAR DRIVE, N.W.			
APPROVALS	ENGINEER	DATE	APPROVALS
City Engineer	<i>Ch. D. Lopez</i>	1/14/85	Water Res
ACE Design	<i>W. G. Smith</i>	1/14/85	Water Res
ACE Hydrology	<i>W. G. Smith</i>	1/14/85	Water Res
DRAWING NO. 1869		MAP NO. A-13 SHEET 12 OF 40	

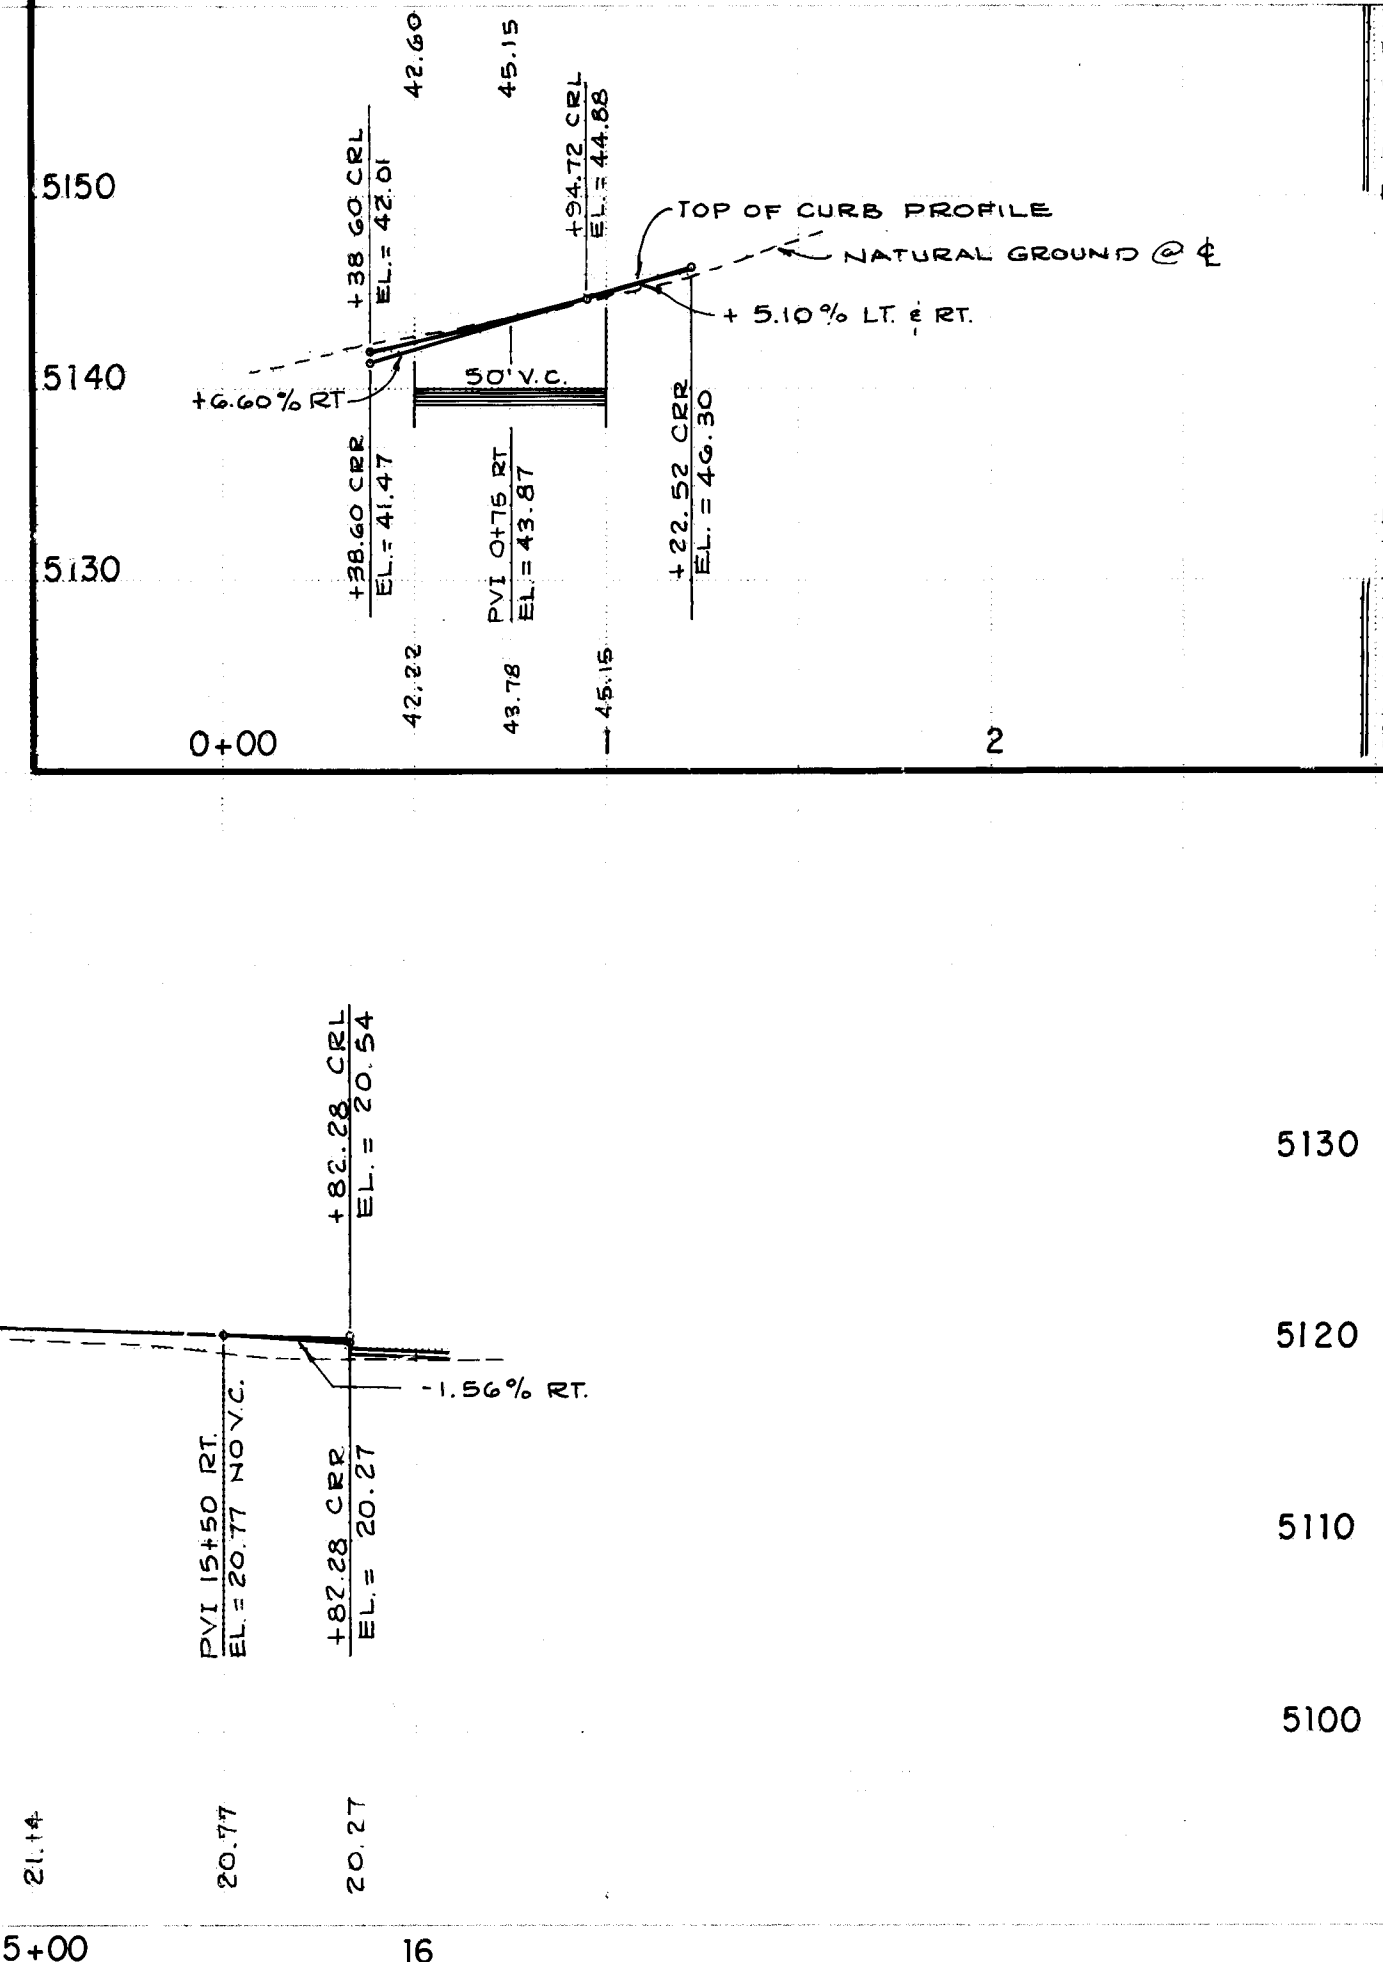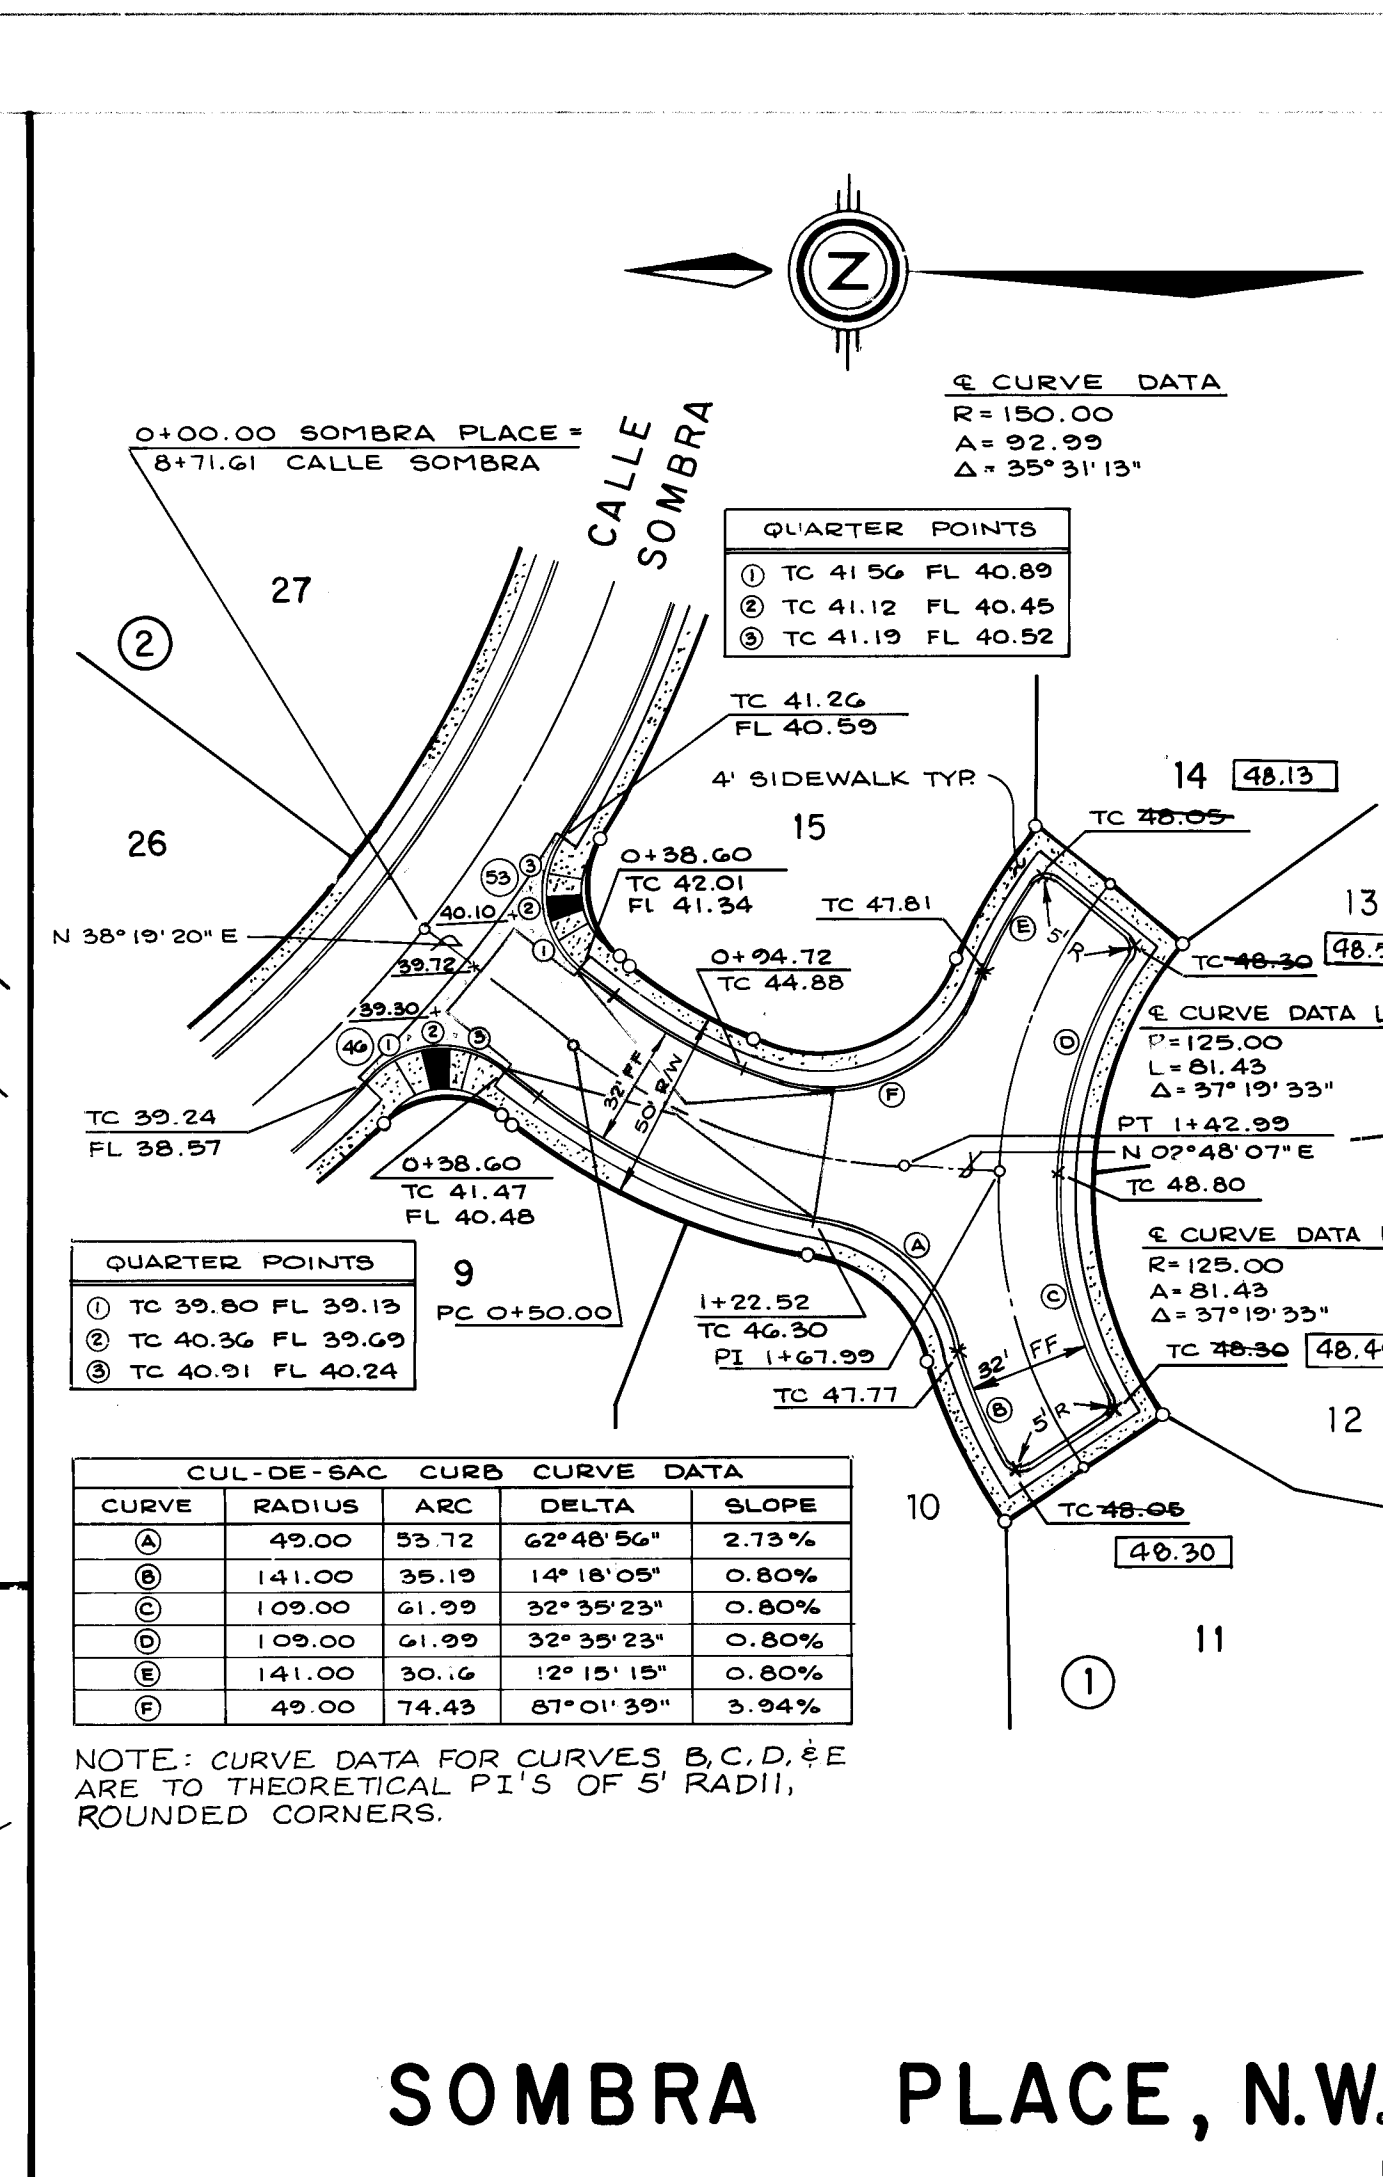





CUL-DE-SAC CURB CURVE DATA				
CURVE	RADIUS	ARC	DELTA	SLOPE
(A)	49.00	53.72	62°48'56"	2.73 %
(B)	141.00	35.19	14°18'05"	0.80 %
(C)	109.00	61.99	32°35'23"	0.80 %
(D)	109.00	61.99	32°35'23"	0.80 %
(E)	141.00	30.16	12°15'15"	0.80 %
(F)	49.00	74.43	81°01'39"	3.94 %

SCALE : 1" = 50' Horizontal
1" = 10' Vertical

CITY OF ALBUQUERQUE					
MUNICIPAL DEVELOPMENT DEPARTMENT					
ENGINEERING DIVISION					
TITLE SALIDA DEL SOL-UNIT ONE-PAVING PLAN & PROFILE					
DRIFTWOOD AVENUE, N.W.					
SOMBRA PLACE, N.W.					
APPROVALS	ENGINEER	DATE	SPRINTING	ENGINEER	DATE
City Engineer	<i>C. M. Shepard</i>	<i>4/2/64</i>	<i>John W. Hester</i>		
A.C.E. Design	<i>W. H. Hester</i>	<i>8/25/64</i>	Tratto	<i>W. H. Hester</i>	<i>4-2-64</i>
A.C.E. Hydrology	<i>Joe Cox</i>	<i>2/22/64</i>	water	Res.	<i>NA</i> <i>W. H. Hester</i> <i>2-2-64</i>
DRAWING NO	1869		MAP NO	A-13	
			SHEET	OF	
			13	40	


ENGINEER'S SEAL		
SURVEY INFORMATION	NO.	BY
FIELD NOTES	DATE	
A SQUARE CHISEL IN THE TOP OF THE EASTERLY WALL OF THE A.M.A.F.C.A. FLOOD DIVERSION NO. 2 CHANNEL, APPROXIMATELY 180 FEET SOUTH OF THE POINT OF CONFLUENCE WITH THE SKYVIEW DRAINAGE CHANNEL ESTABLISHED BY BOHANNAN-HUSTON AND MARKED "TBM 205". ELEVATION = 5110.55		
AS FOUND		ADDITIONAL INFORMATION

NO.	DATE	REMARKS	BY	REVISIONS			
				DESIGN	DATE	TIME	BY
		KPW		10:35			
		NKS, RDQ			11:05		

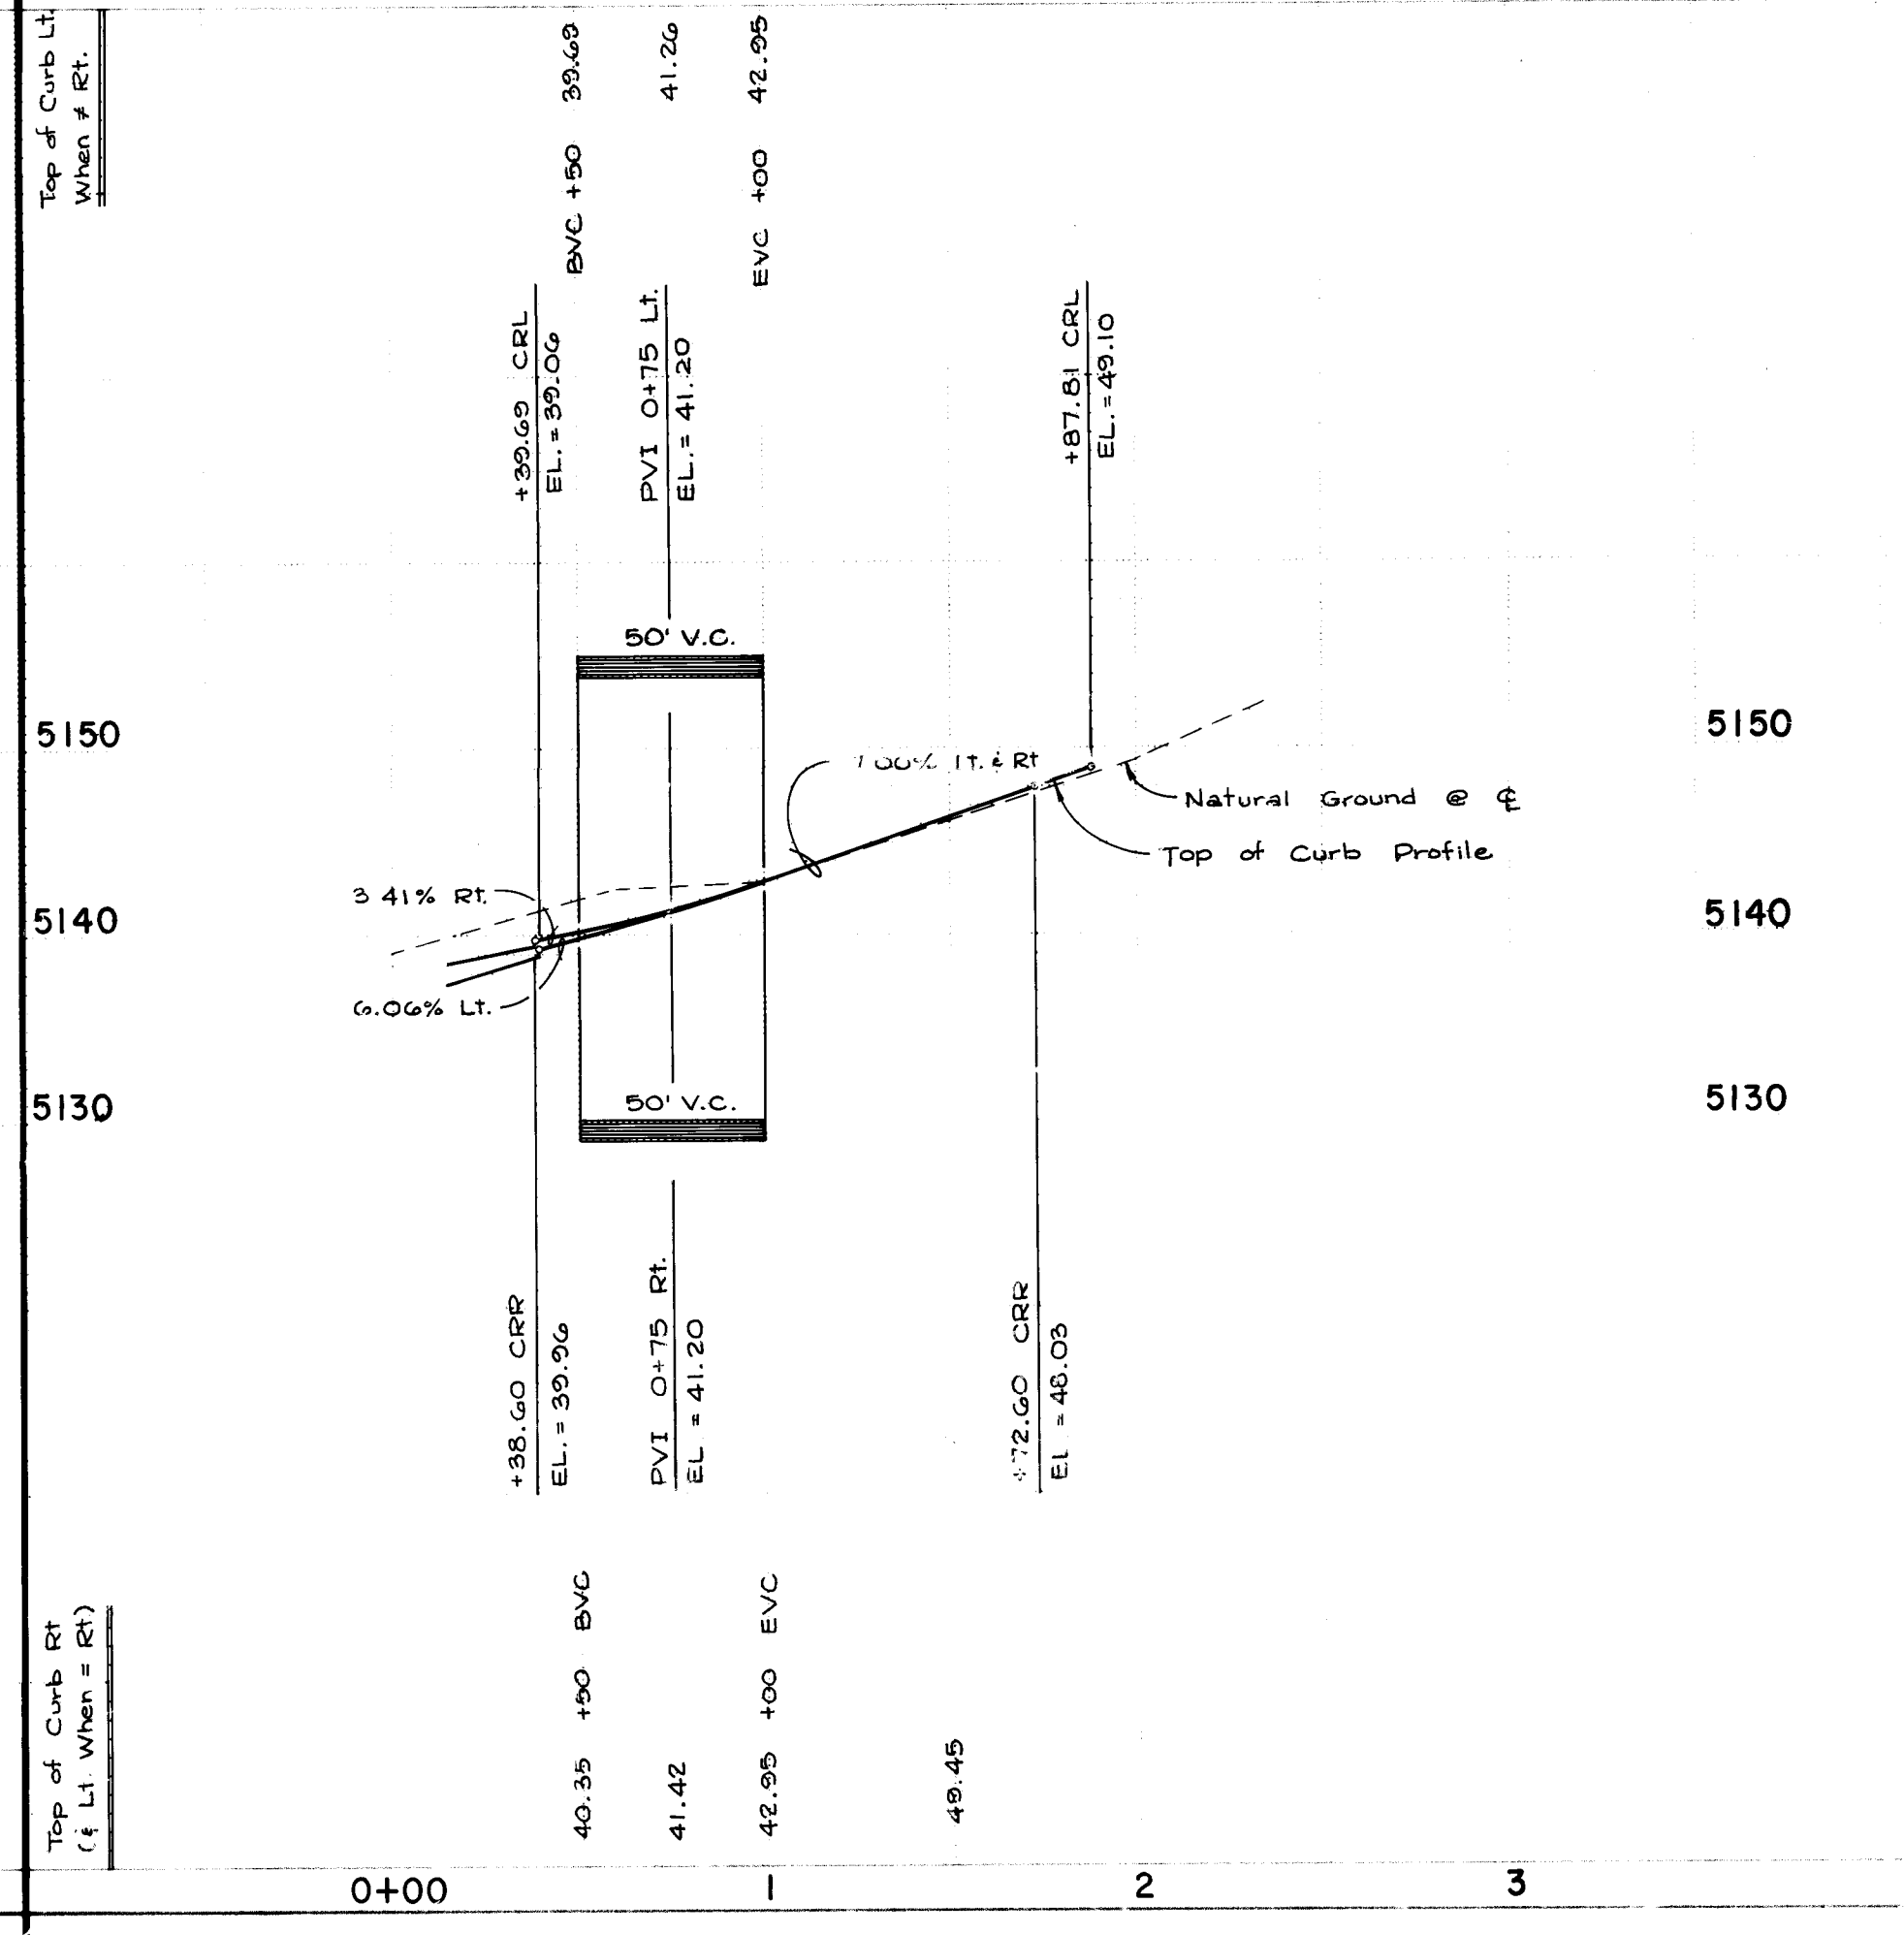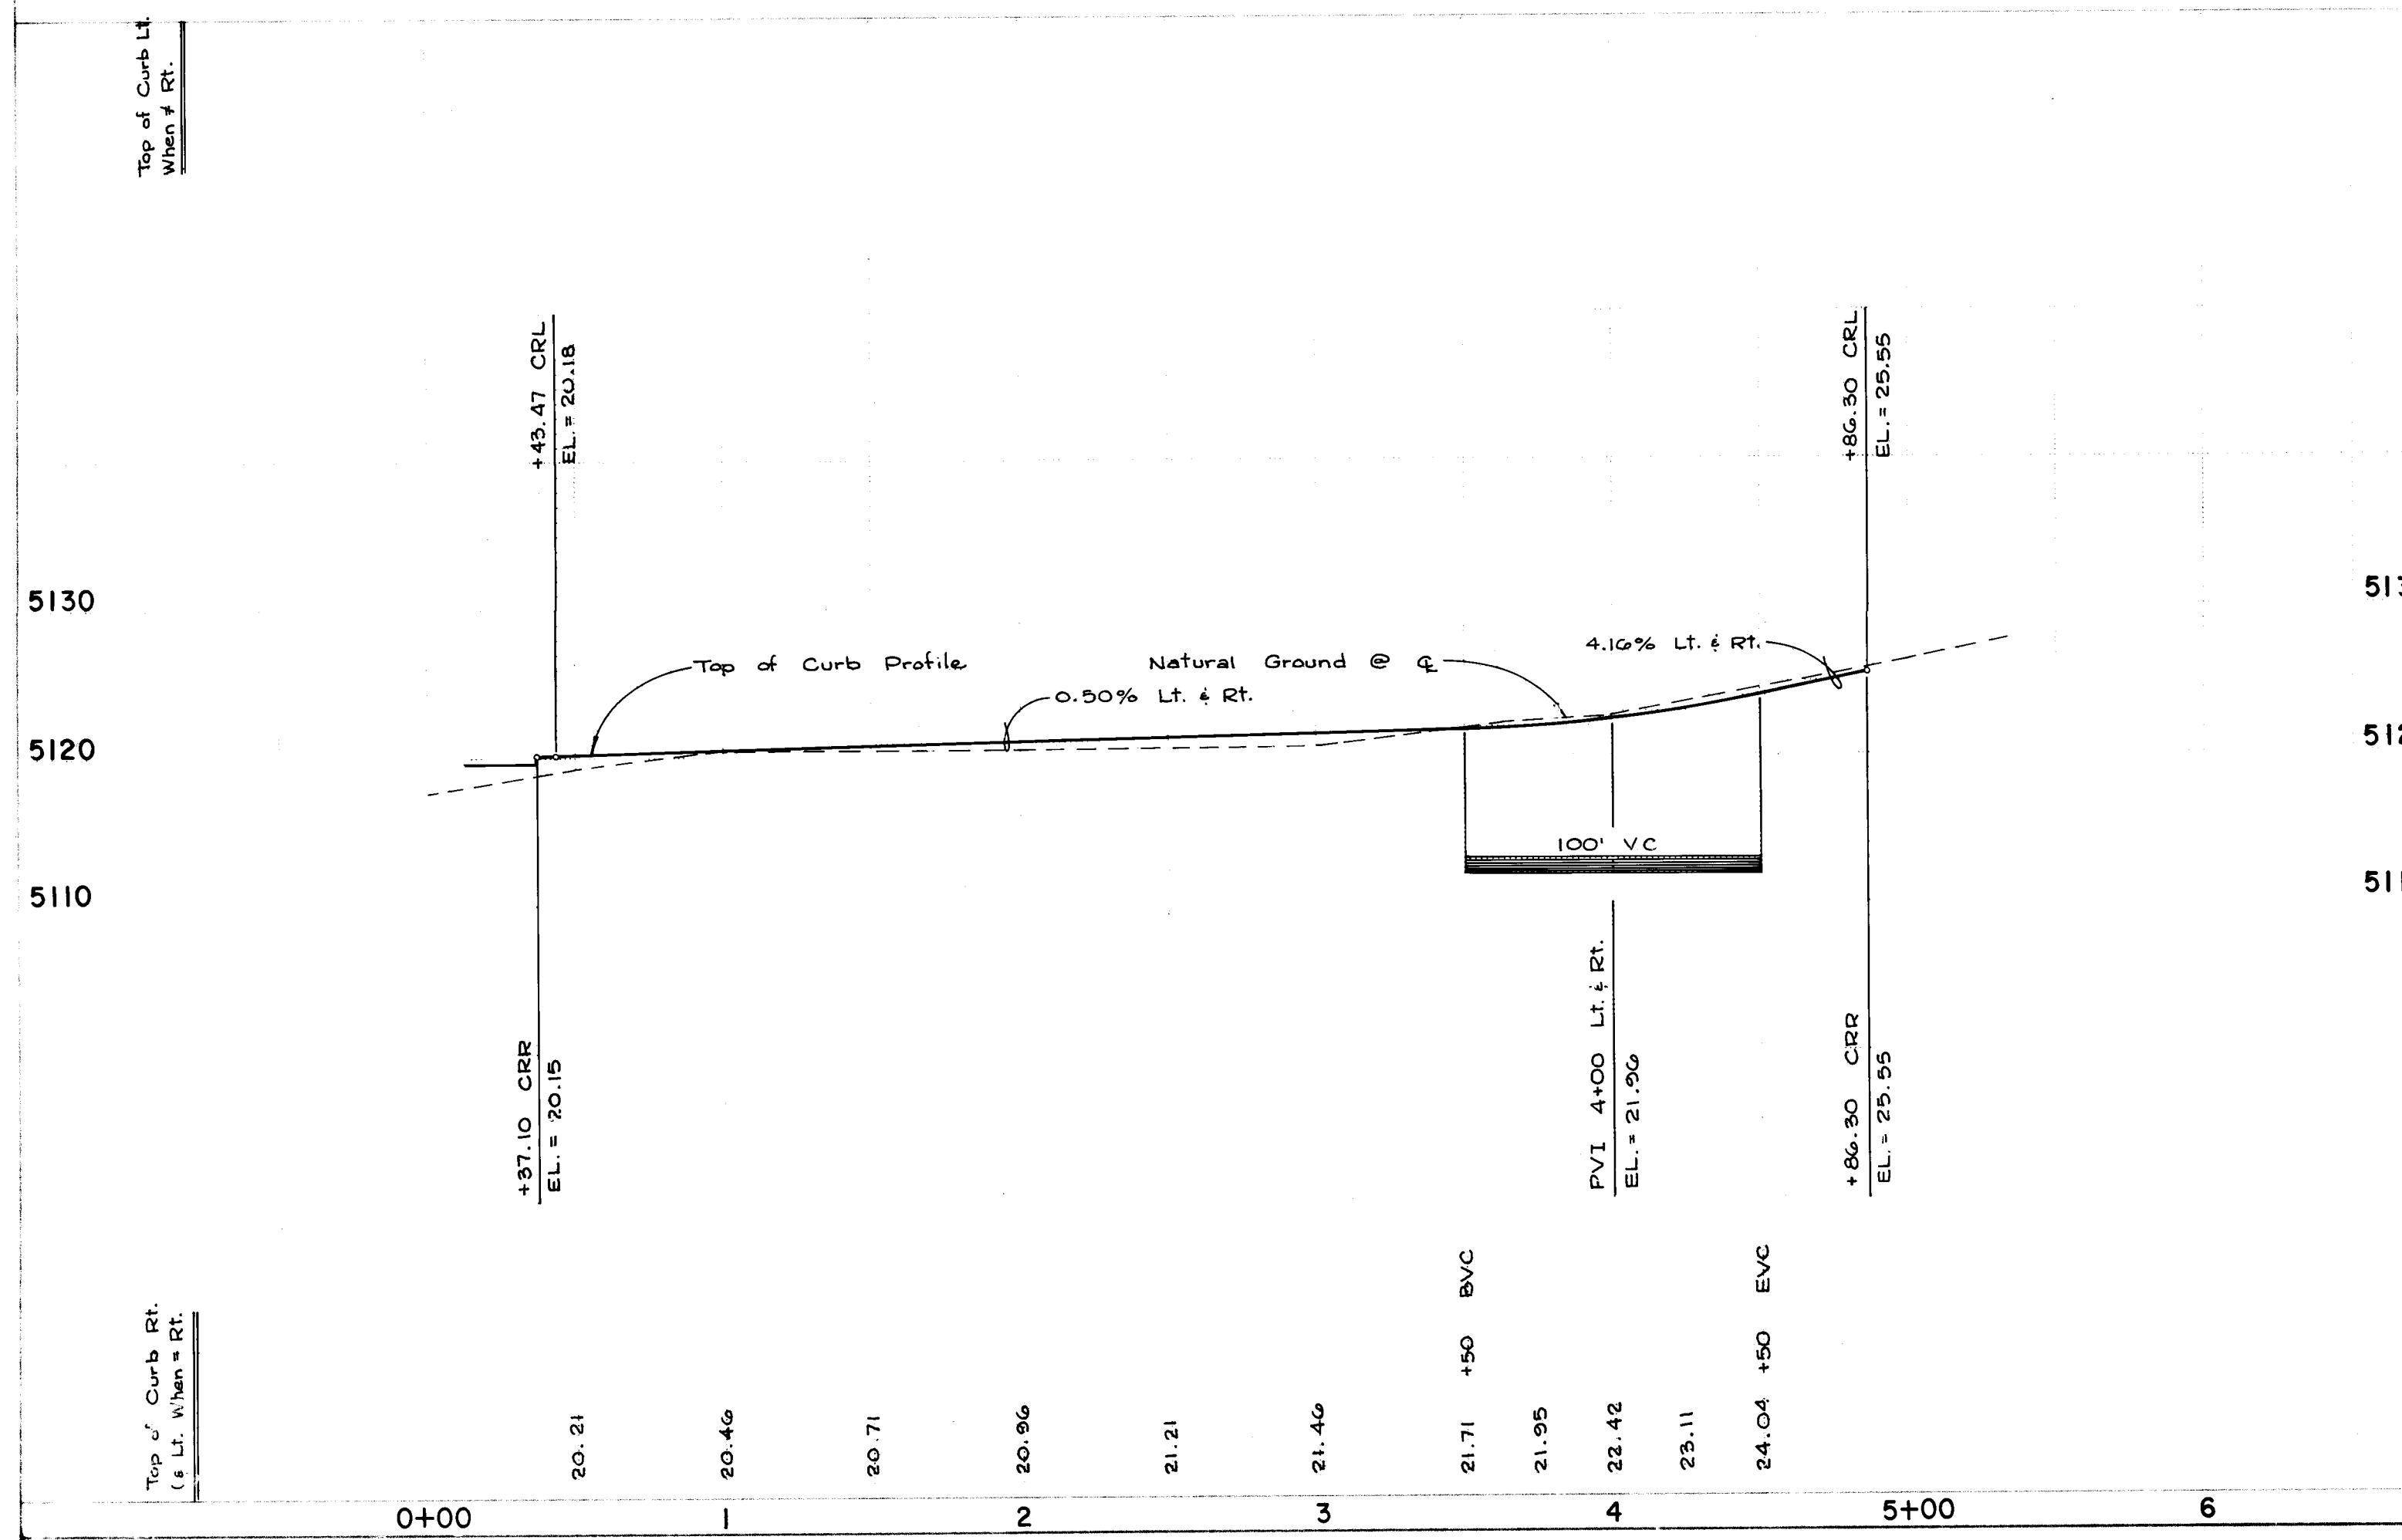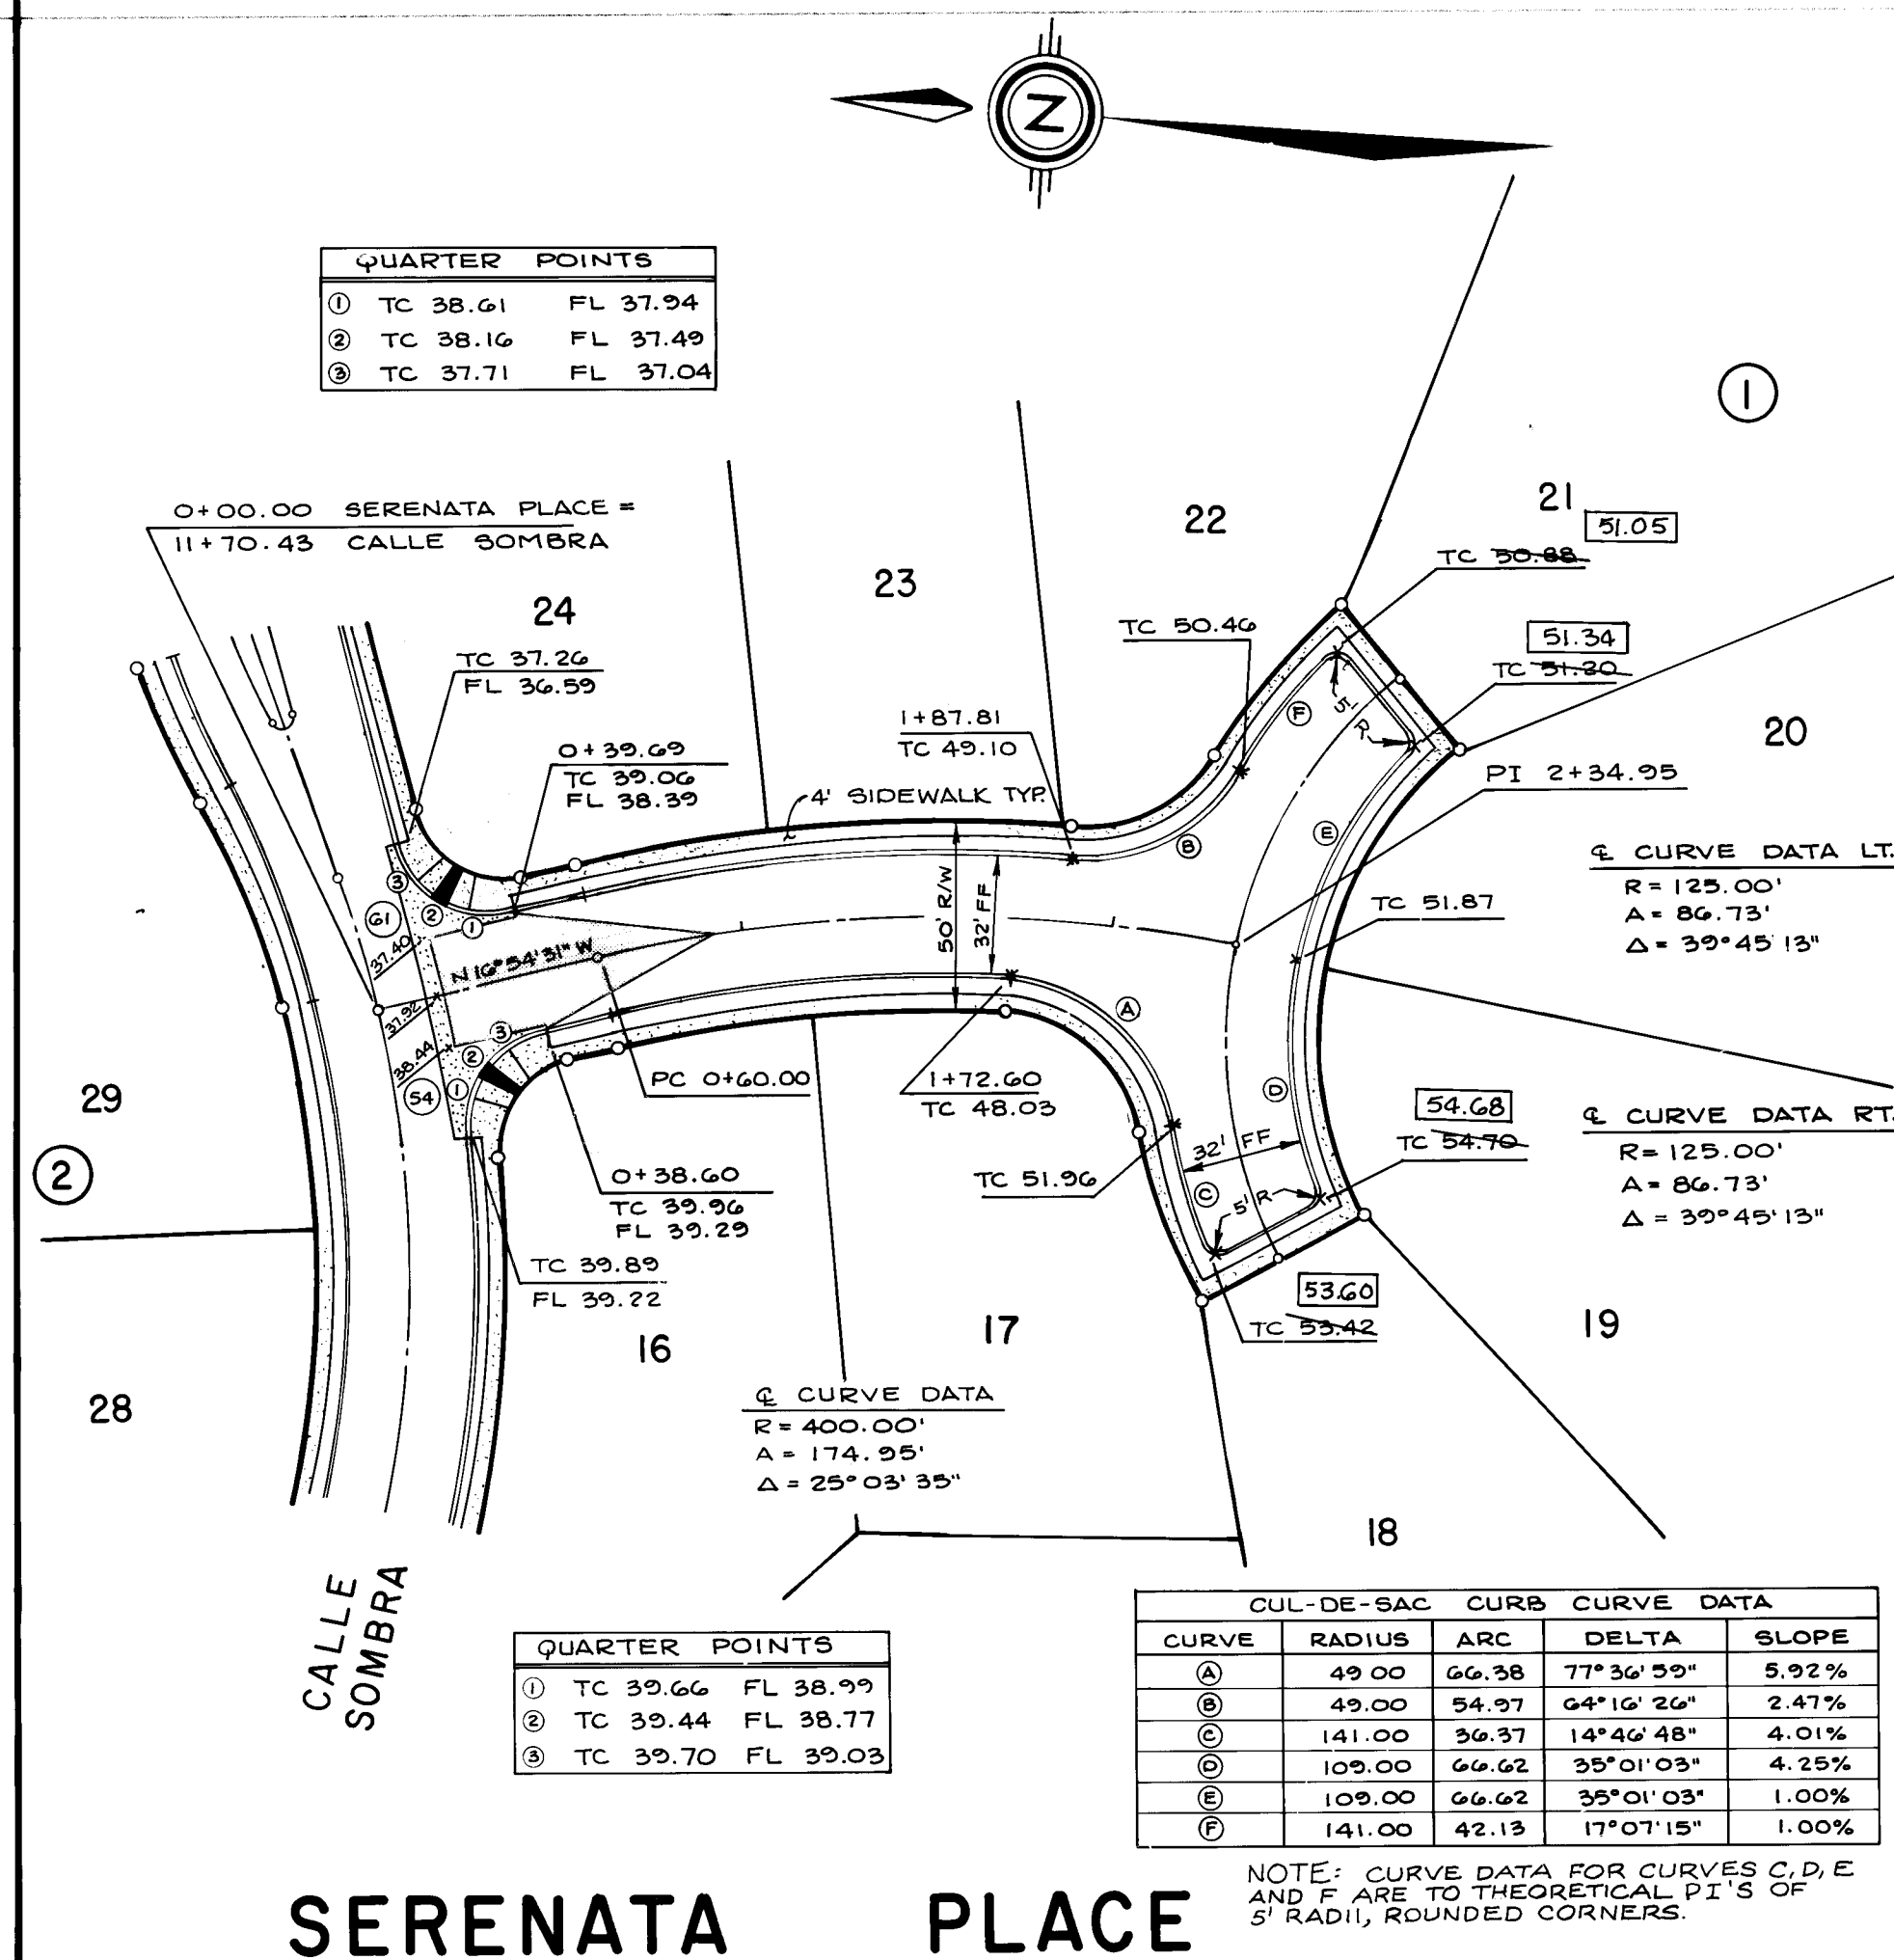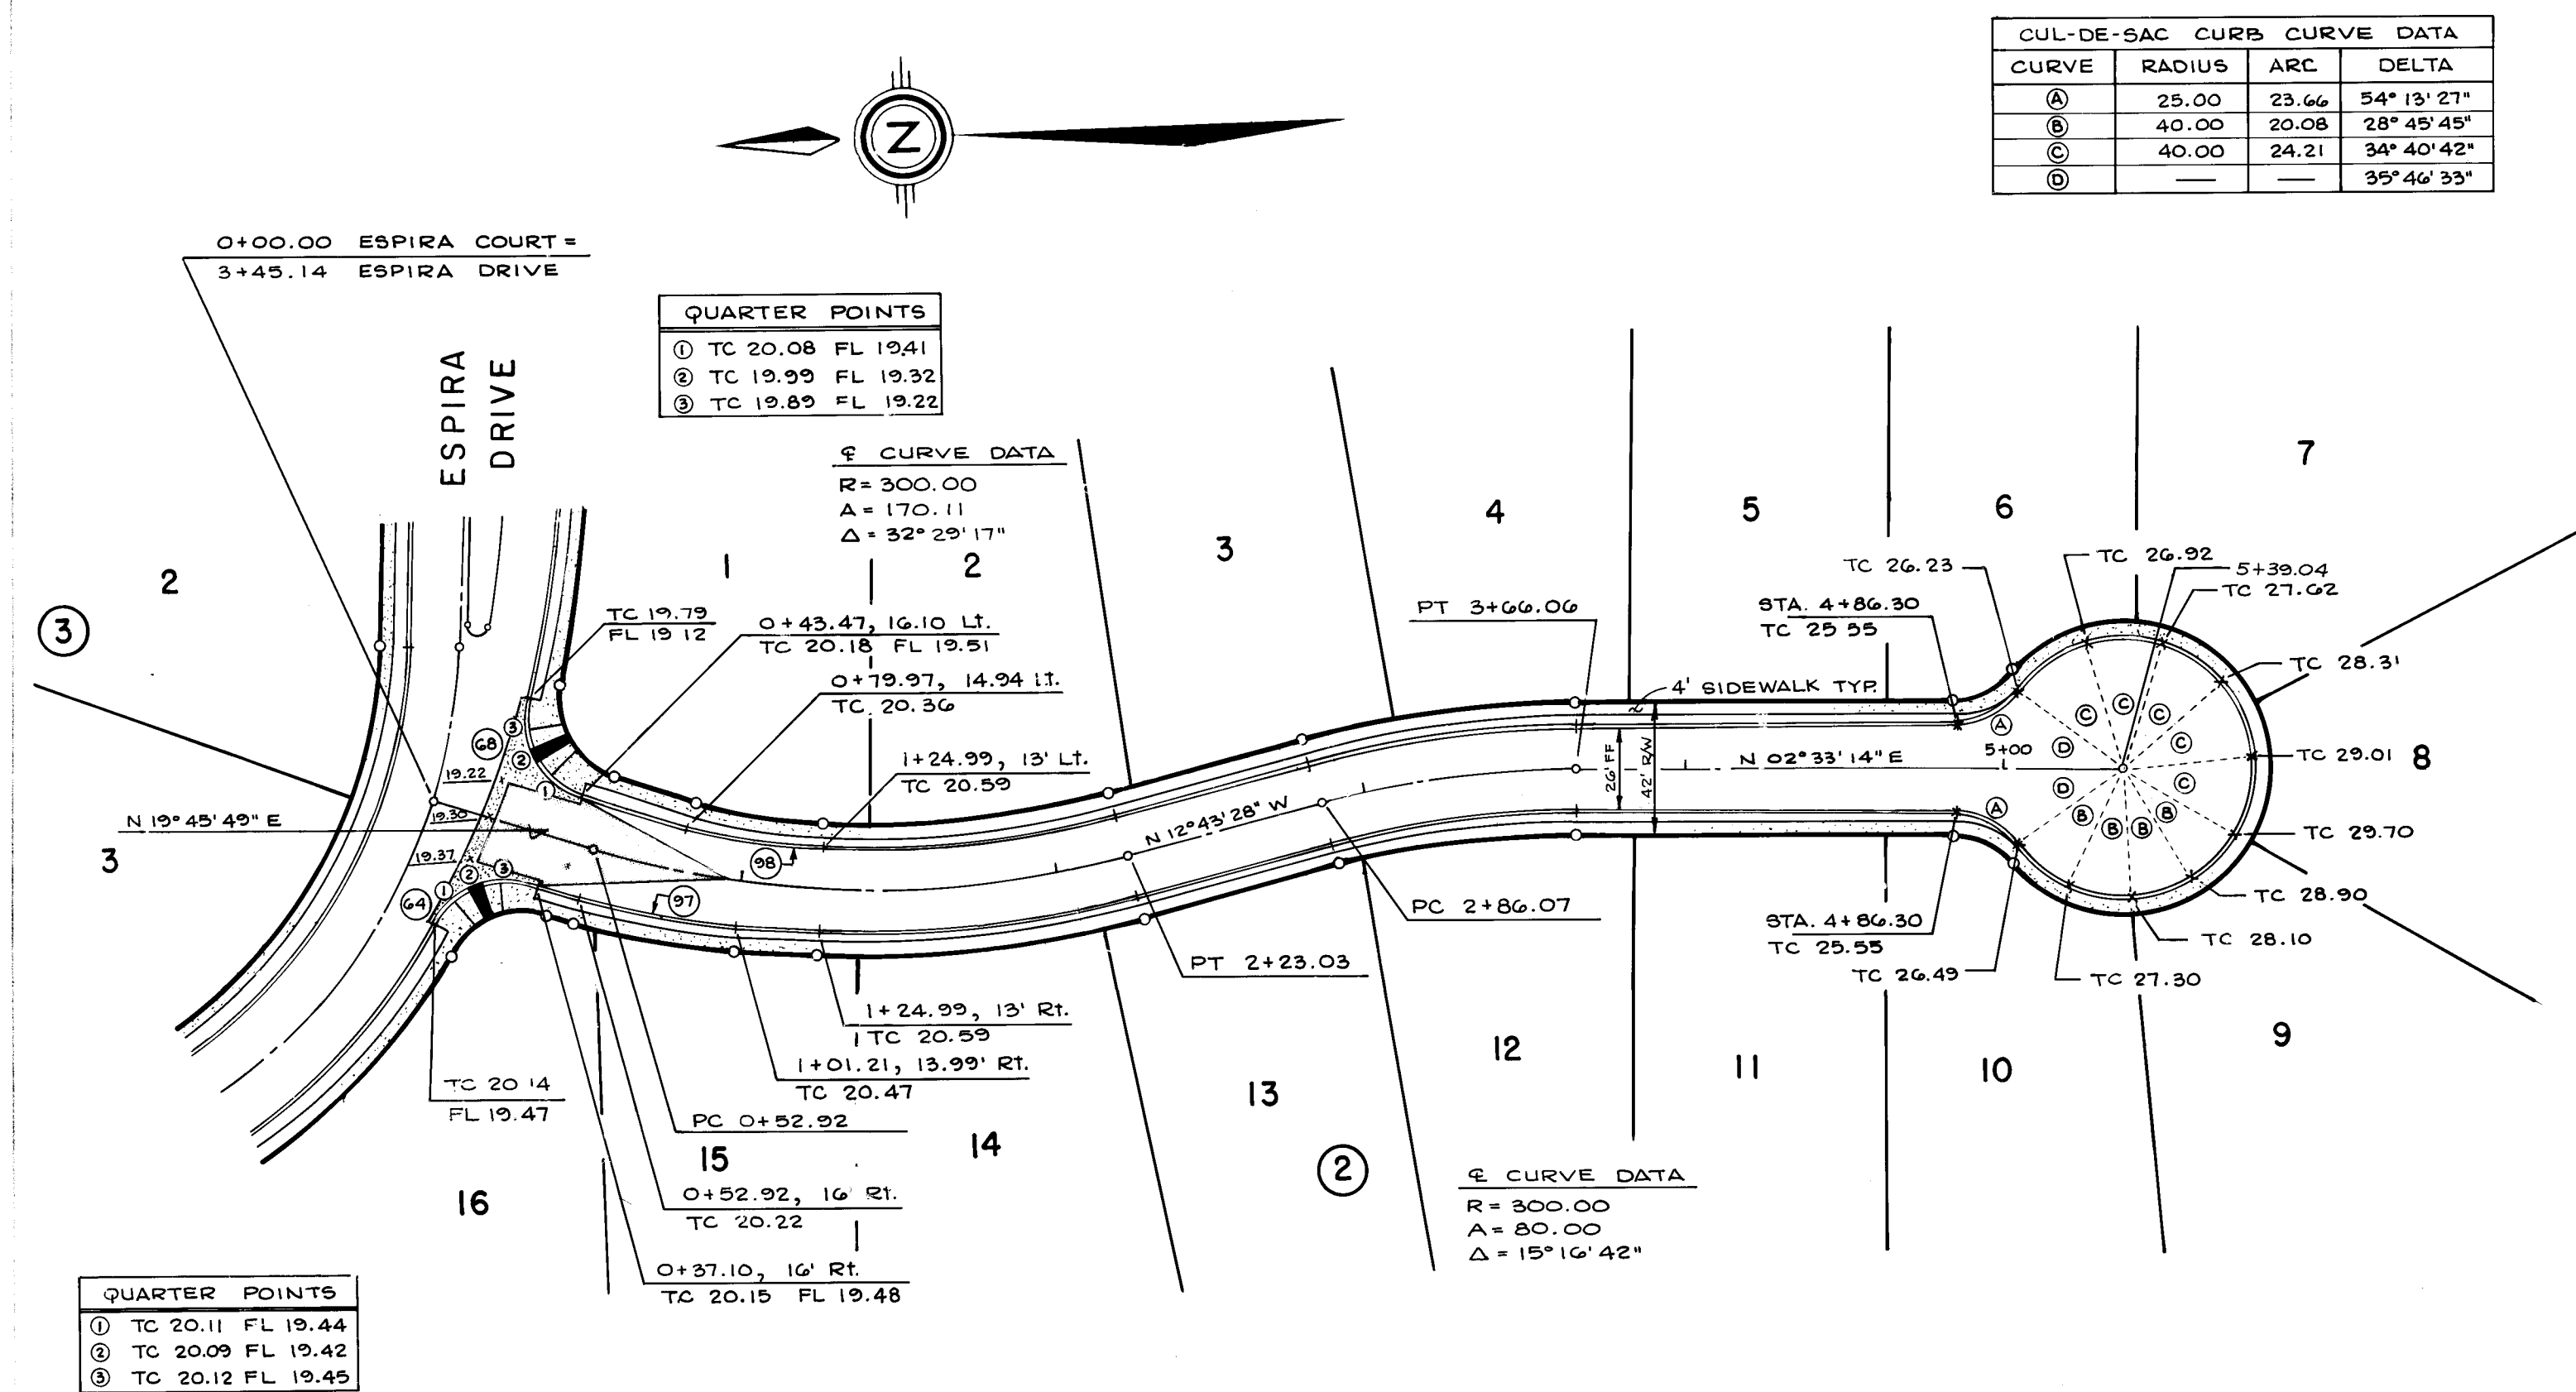

CURB CURVE DATA			
CURVE	RADIUS	ARC	DELTA
54	25.00	36.34	83°17'31"
61	25.00	38.35	87°53'36"
64	25.00	34.53	79°08'10"
66	25.00	38.06	87°14'08"
97	211.53	50.81	13°45'49"
98	179.11	43.03	13°45'49"

AS BUILT

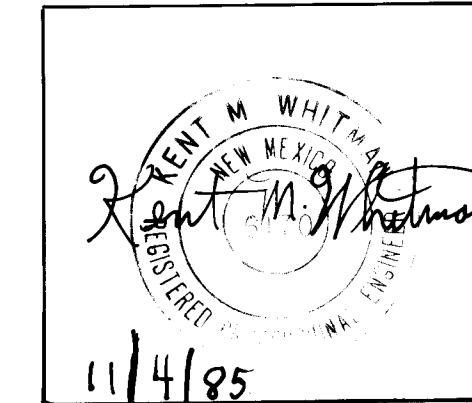

NOTE: THIS CERTIFICATION IS INTENDED TO INDICATE THAT IN THE ENGINEER'S OPINION THIS CONSTRUCTION IS IN SUBSTANTIAL COMPLIANCE WITH THE DESIGN AS SHOWN (OR AS ANNOTATED WITH UPDATED FIELD GRADES WHERE INDICATED). IT IS NOT A VERIFICATION OF CONTRACT COMPLIANCE IN THE LEVEL OF DETAIL ASSOCIATED WITH FULL CONSTRUCTION INSPECTION OF THE PROJECT.

26 16691586


SCALE: 1" = 50' Horizontal
1" = 10' Vertical

CITY OF ALBUQUERQUE
MUNICIPAL DEVELOPMENT DEPARTMENT
ENGINEERING DIVISION

TITLE: SALIDA DEL SOL UNIT ONE - PAVING PLAN & PROFILE
ESPIRA COURT
SERENATA PLACE


APPROVALS	ENGINEER	DATE	APPROVALS	ENGINEER	DATE
City Engineer	<i>[Signature]</i>	5/1/84	Water	<i>[Signature]</i>	7-8-84
A.C.E. Design	<i>[Signature]</i>	8/2/84	Traffic	<i>[Signature]</i>	7-8-84
A.C.E. Hydrology	<i>[Signature]</i>	2/2/84	Res	<i>[Signature]</i>	7-8-84

DRAWING NO. 1869 MAP NO. A-13 SHEET 15 OF 40

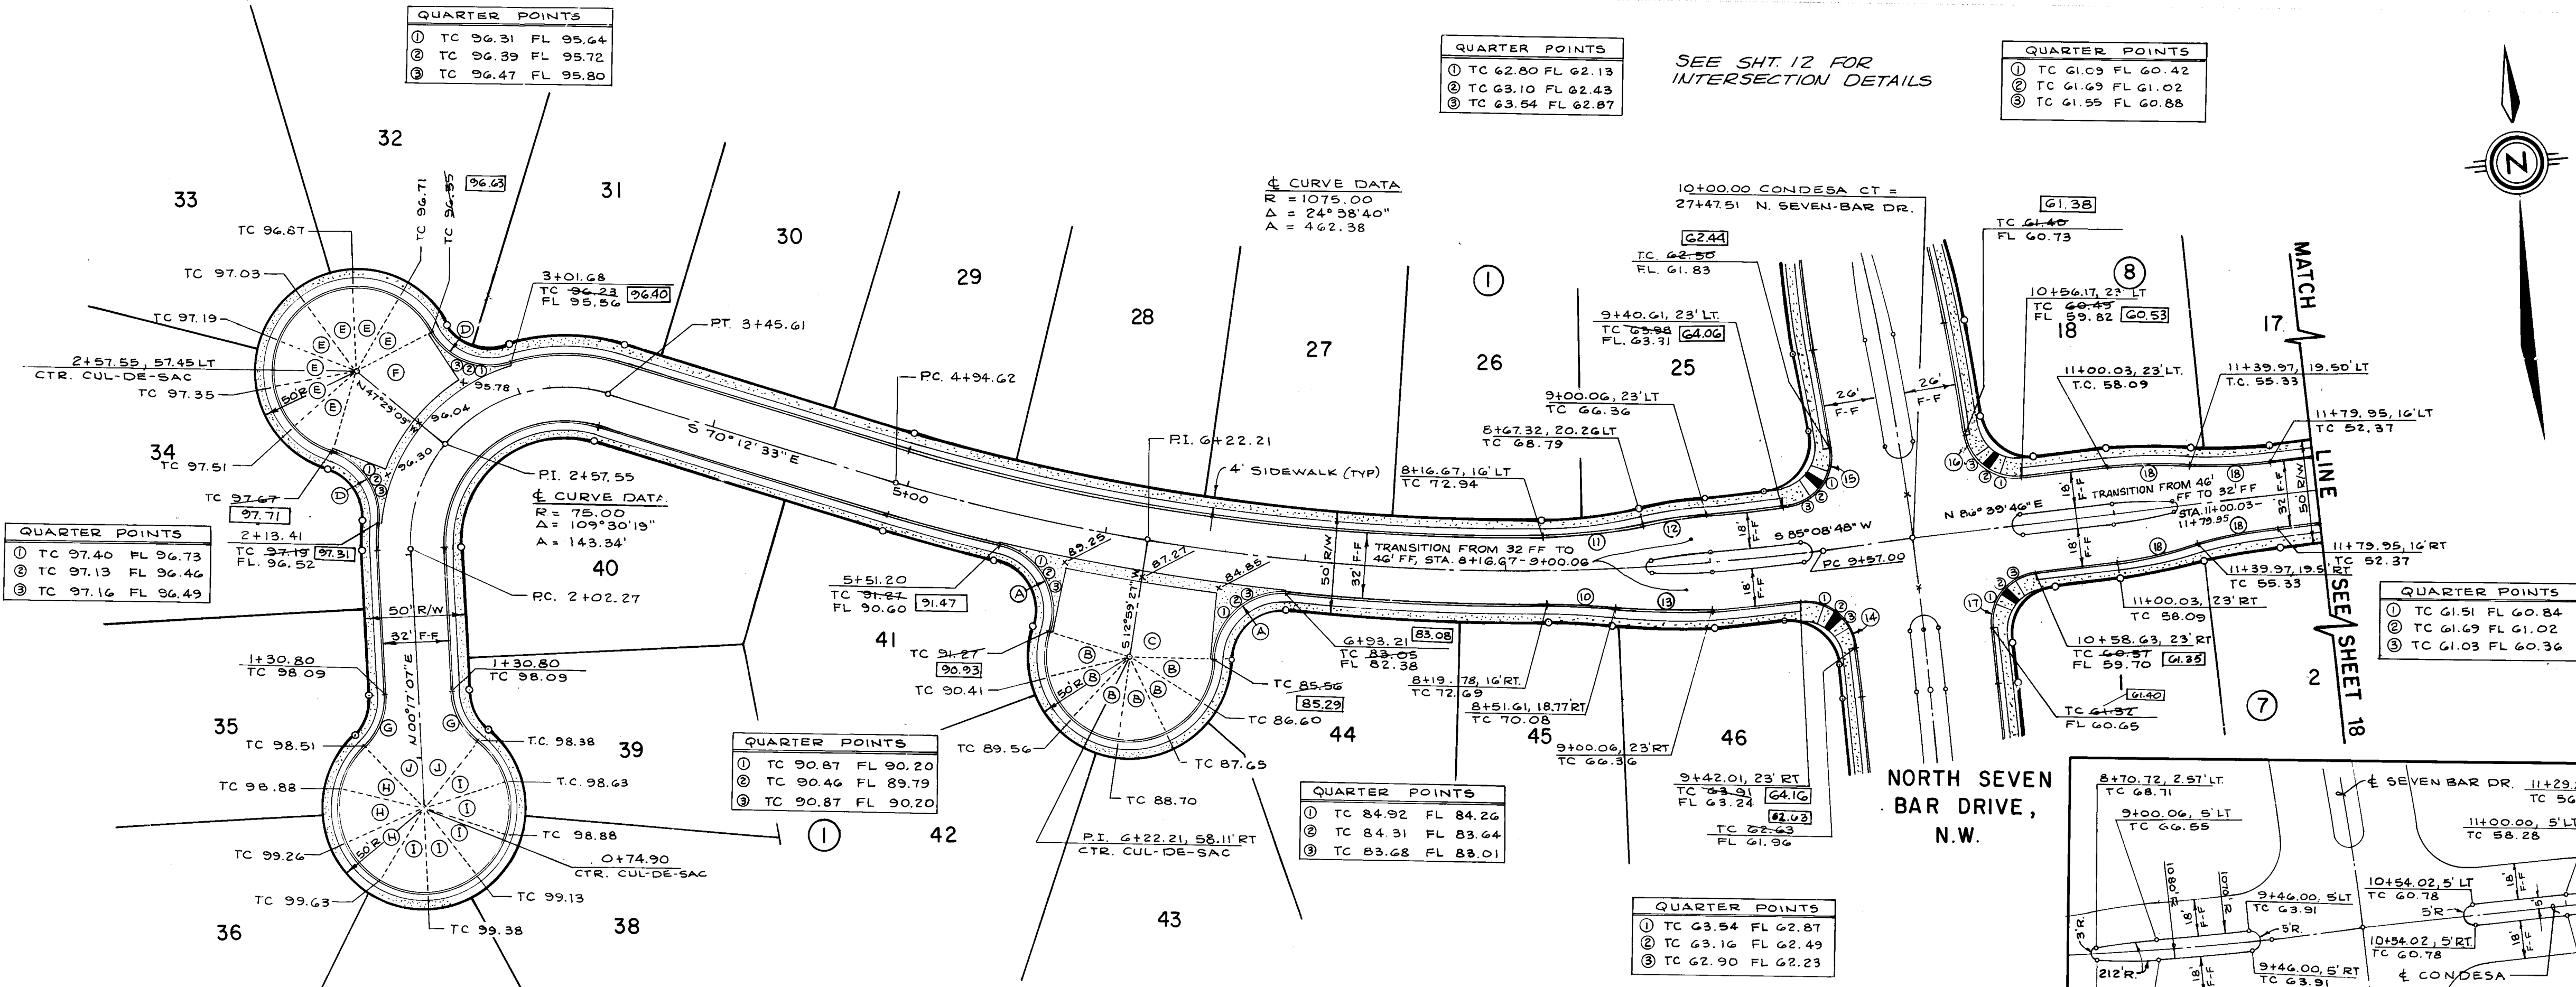

CURVE DATA			
CURVE	RADIUS	ARC	DELTA
(1)	34.00	55.97	94°18'54"
(2)	41.00	23.40	32°42'10"
(3)	34.00	46.64	78°36'01"
(4)	41.00	22.96	32°05'23"
(5)	—	—	67°41'04"
(6)	34.00	28.60	48°11'23"
(7)	41.00	25.61	35°47'03"
(8)	41.00	24.19	33°48'26"
(9)	—	—	41°48'37"

CURVE DATA			
CURVE	RADIUS	ARC	DELTA
(10)	230.00	32.49	08°05'34"
(11)	230.00	50.08	12°28'18"
(12)	230.00	32.22	08°01'39"
(13)	230.00	49.64	12°22'17"
(14)	25.00	39.61	90°44'35"
(15)	25.00	40.34	92°27'25"
(16)	25.00	37.98	87°02'59"
(17)	25.00	39.26	89°59'19"
(18)	230.00	40.18	10°00'30"

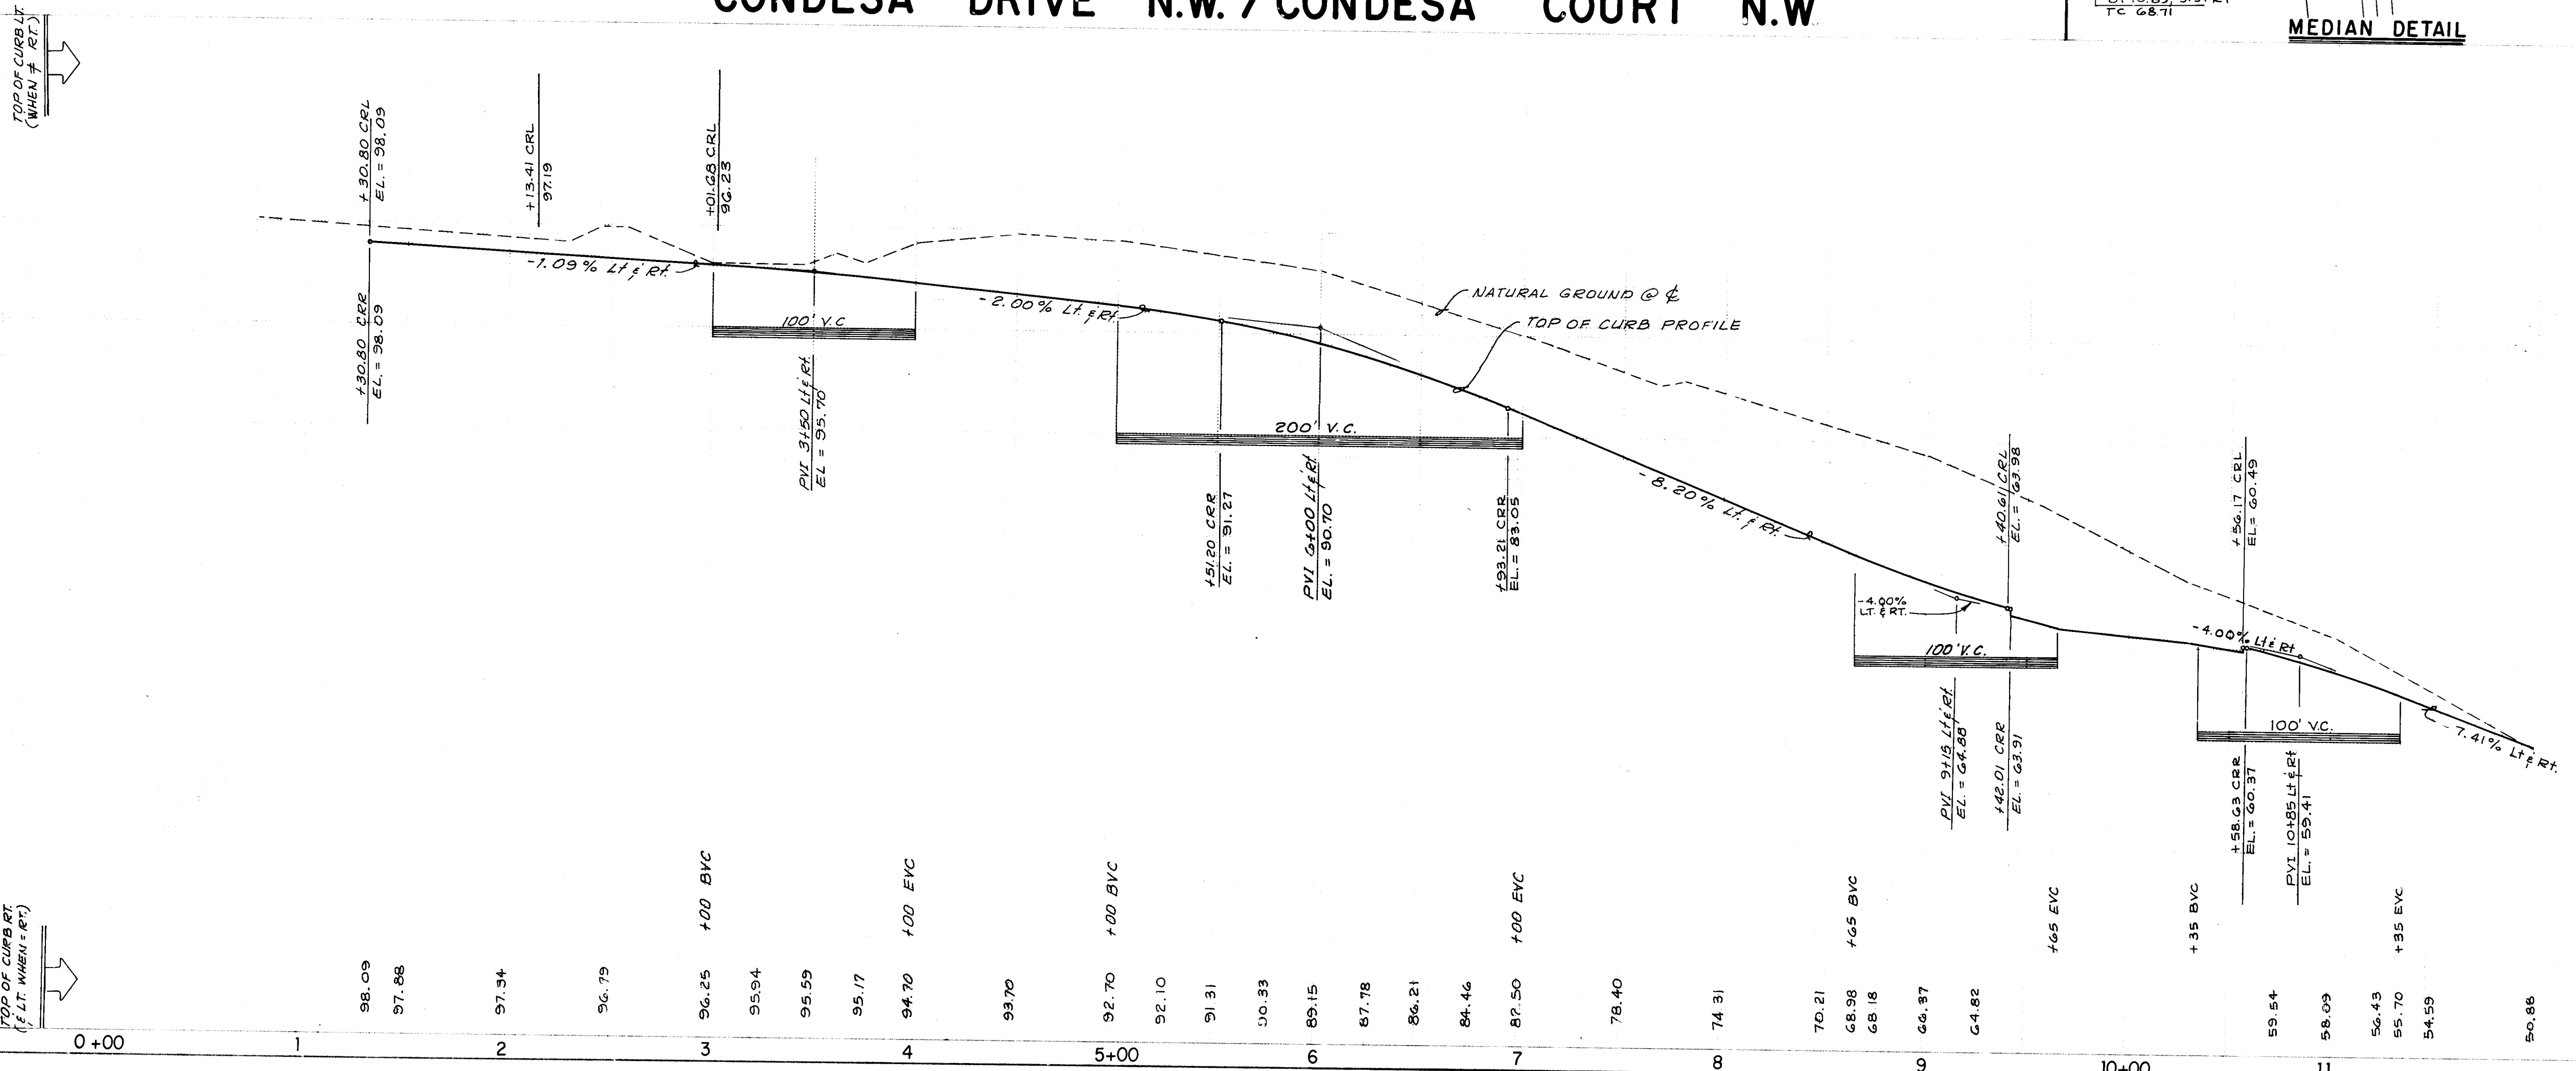


QUARTER POINTS			
(1)	TC 61.03	FL 60.42	
(2)	TC 61.63	FL 61.02	
(3)	TC 61.95	FL 60.85	

QUARTER POINTS			
(1)	TC 61.51	FL 60.84	
(2)	TC 61.69	FL 61.02	
(3)	TC 61.03	FL 60.36	

QUARTER POINTS			
(1)	TC 84.92	FL 84.26	
(2)	TC 84.31	FL 83.64	
(3)	TC 83.68	FL 83.01	

QUARTER POINTS			
(1)	TC 63.54	FL 62.87	
(2)	TC 63.16	FL 62.49	
(3)	TC 62.90	FL 62.23	

AS BUILT

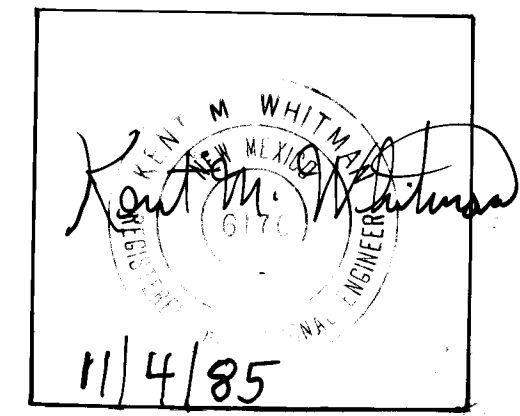


NOTE: THIS CERTIFICATION IS INTENDED TO INDICATE THAT IN THE ENGINEER'S OPINION THIS CONSTRUCTION IS IN SUBSTANTIAL COMPLIANCE WITH THE DESIGN AS SHOWN (OR AS ANNOTATED WITH UPDATED FIELD GRADES WHERE INDICATED). IT IS NOT A VERIFICATION OF CONTRACT COMPLIANCE IN THE LEVEL OF DETAIL ASSOCIATED WITH FULL CONSTRUCTION INSPECTION OF THE PROJECT.


26 18691786

SCALE: 1" = 50' Horizontal
1" = 10' Vertical



CITY OF ALBUQUERQUE MUNICIPAL DEVELOPMENT DEPARTMENT ENGINEERING DIVISION			
TITLE: SALIDA DEL SOL-UNIT TWO-PAVING PLAN & PROFILE CONDOSA COURT N.W./CONDOSA DRIVE N.W.			
APPROVALS	ENGINEER	DATE	APPROVALS
City Engineer	<i>Kenton M. Whitman</i>	11/4/85	Liquid-Waste
ACE Design	<i>[Signature]</i>	8/26/84	Traffic
ACE-Hydrology	<i>[Signature]</i>	2/28/84	Water
DRAWING NO. 1869		MAP NO. A-13	SHEET 17 OF 40

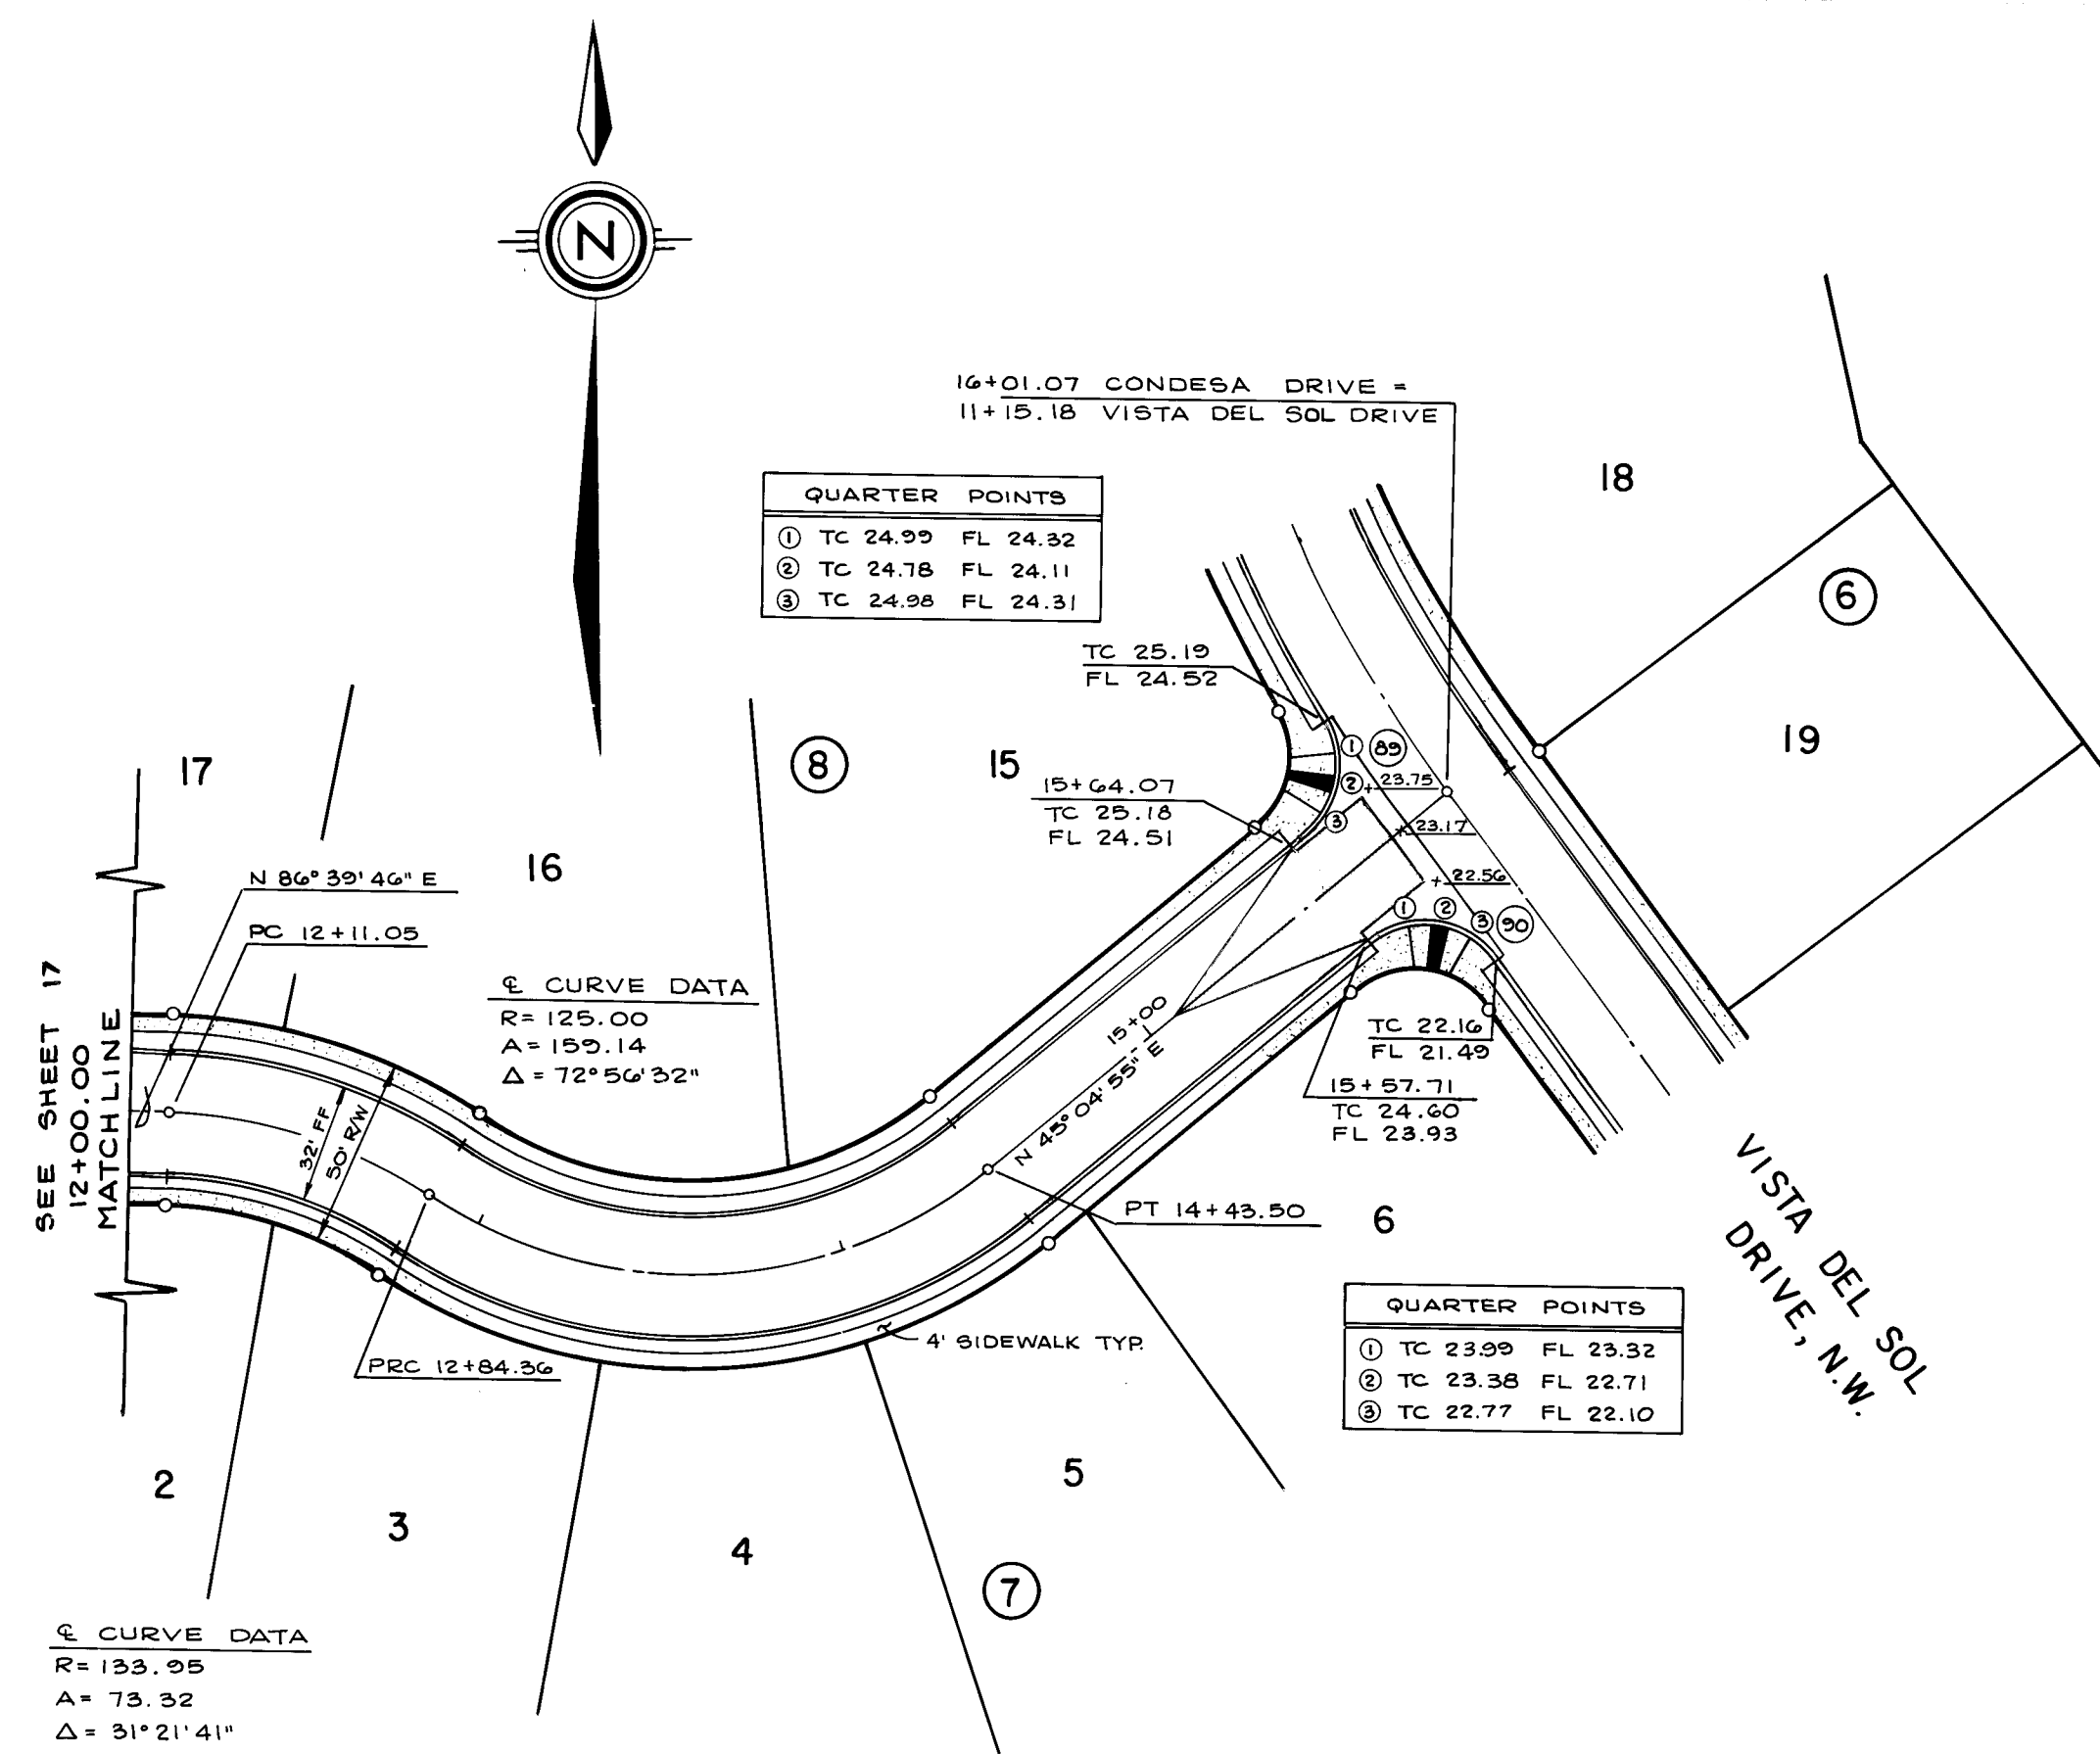


CONDESA DRIVE, N.W.

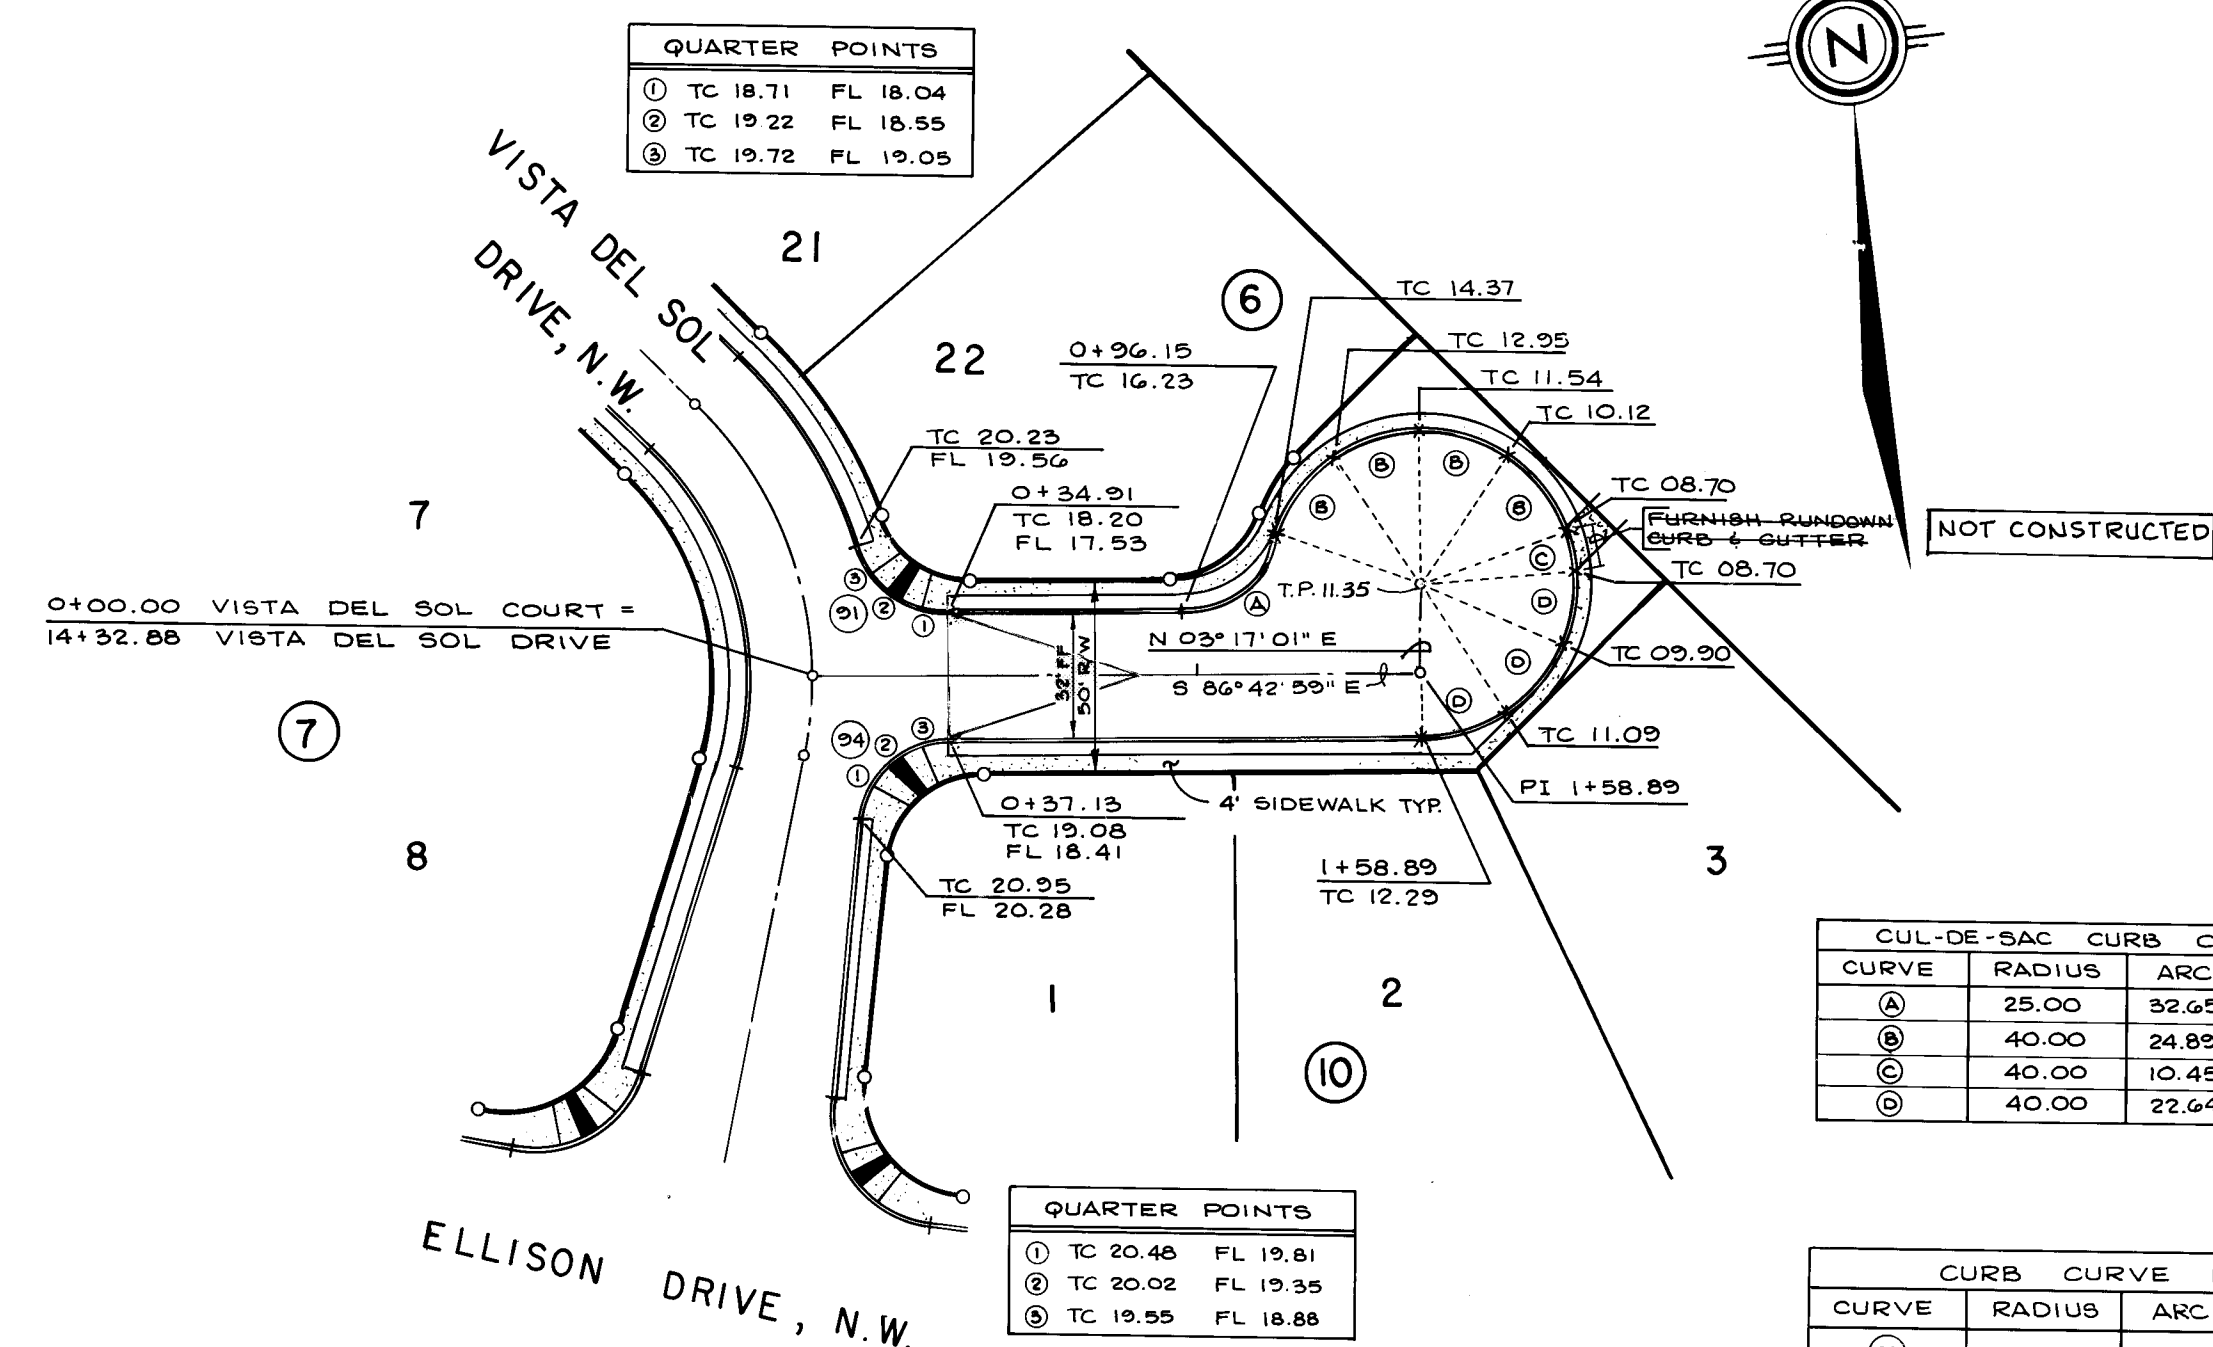

VISTA DEL SOL COURT, N.W.

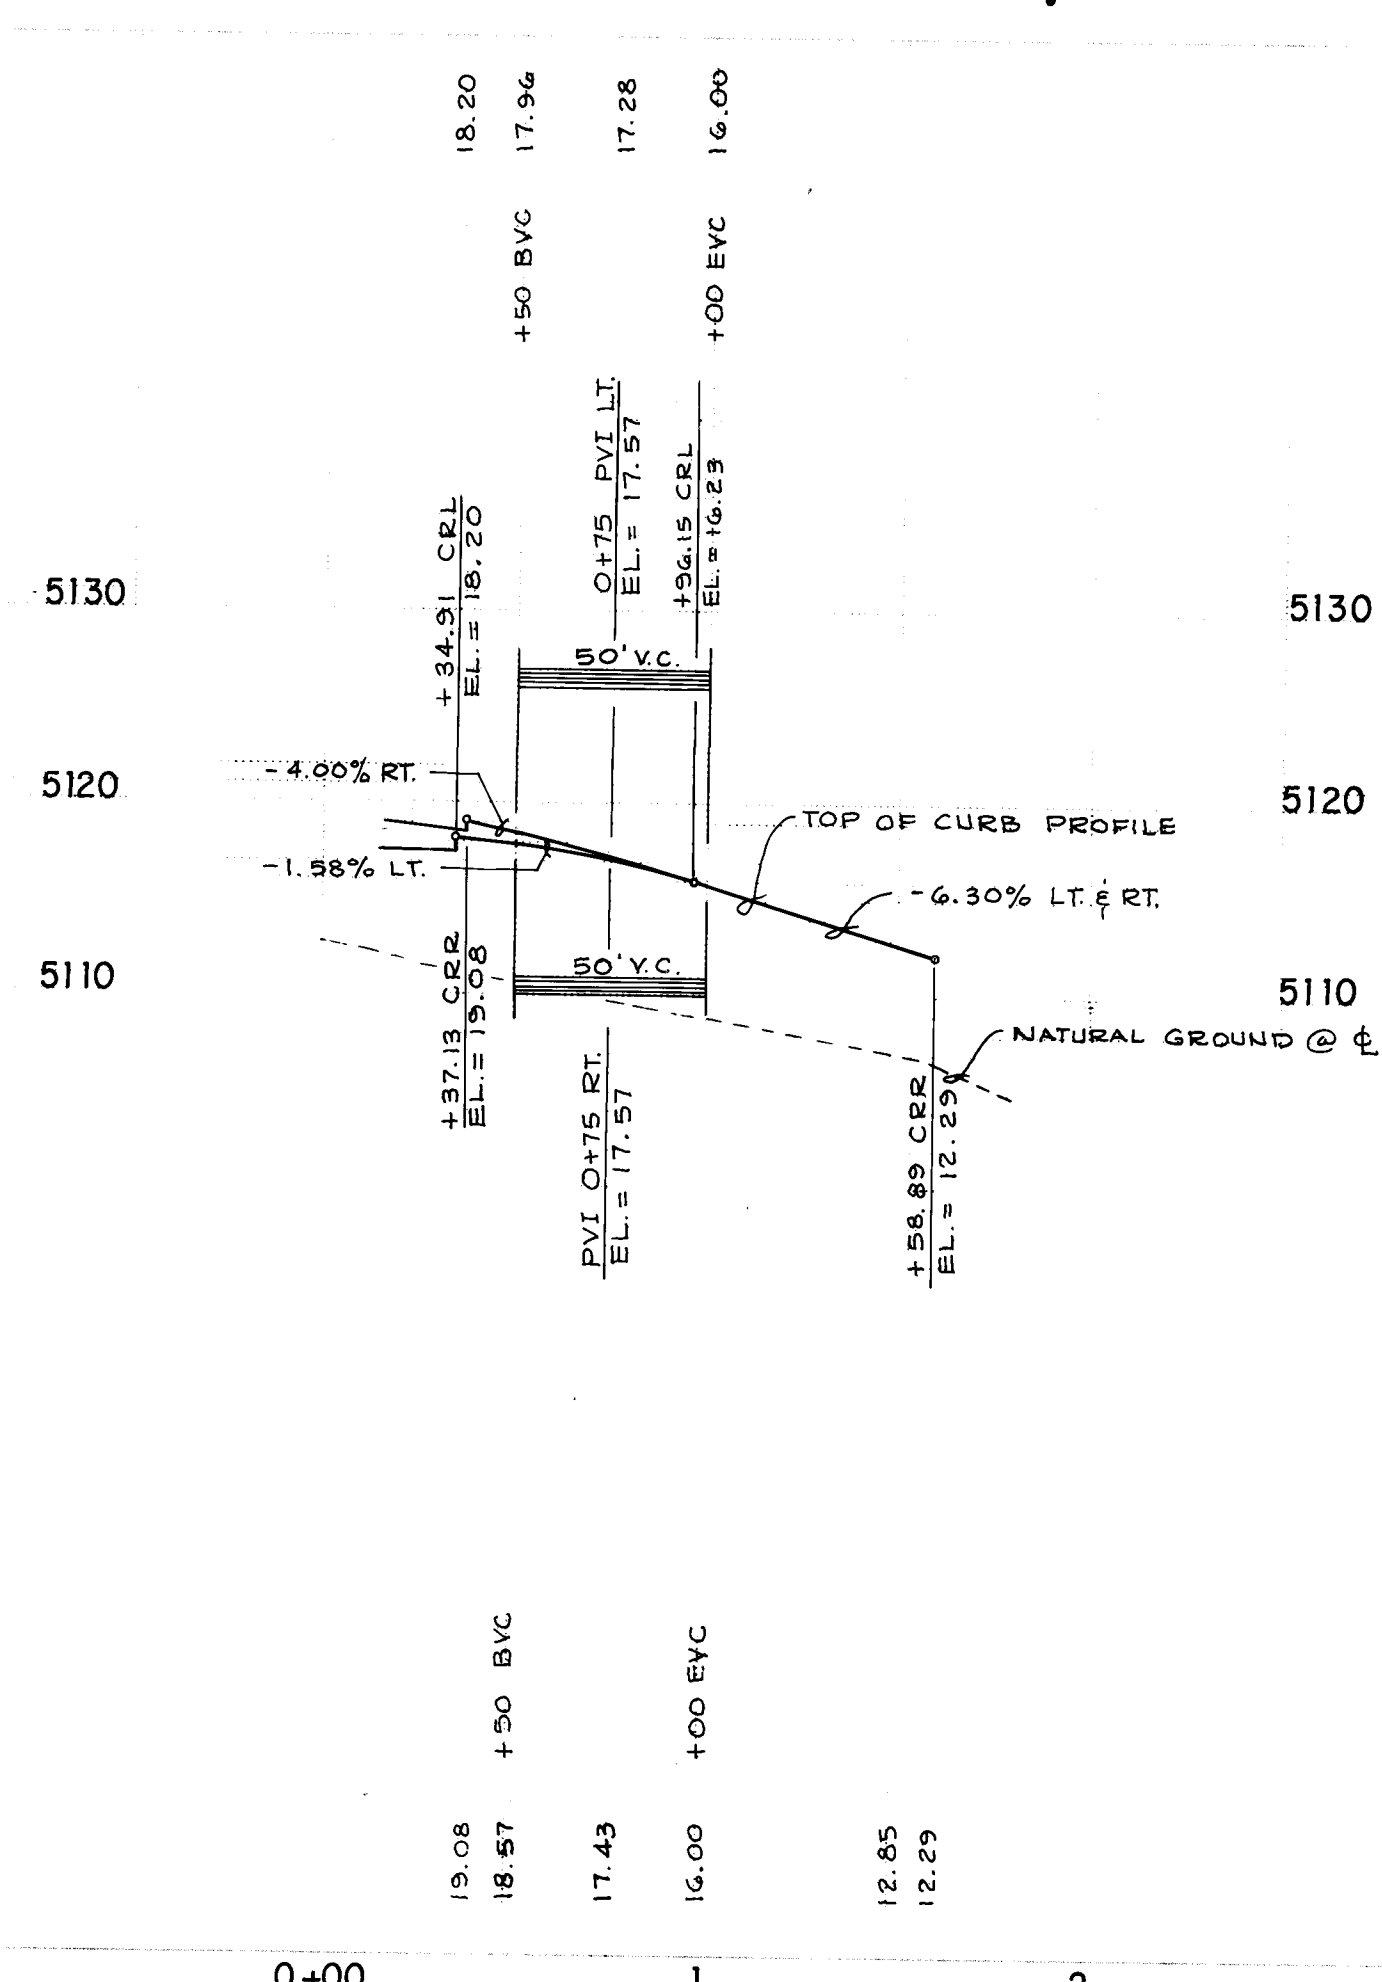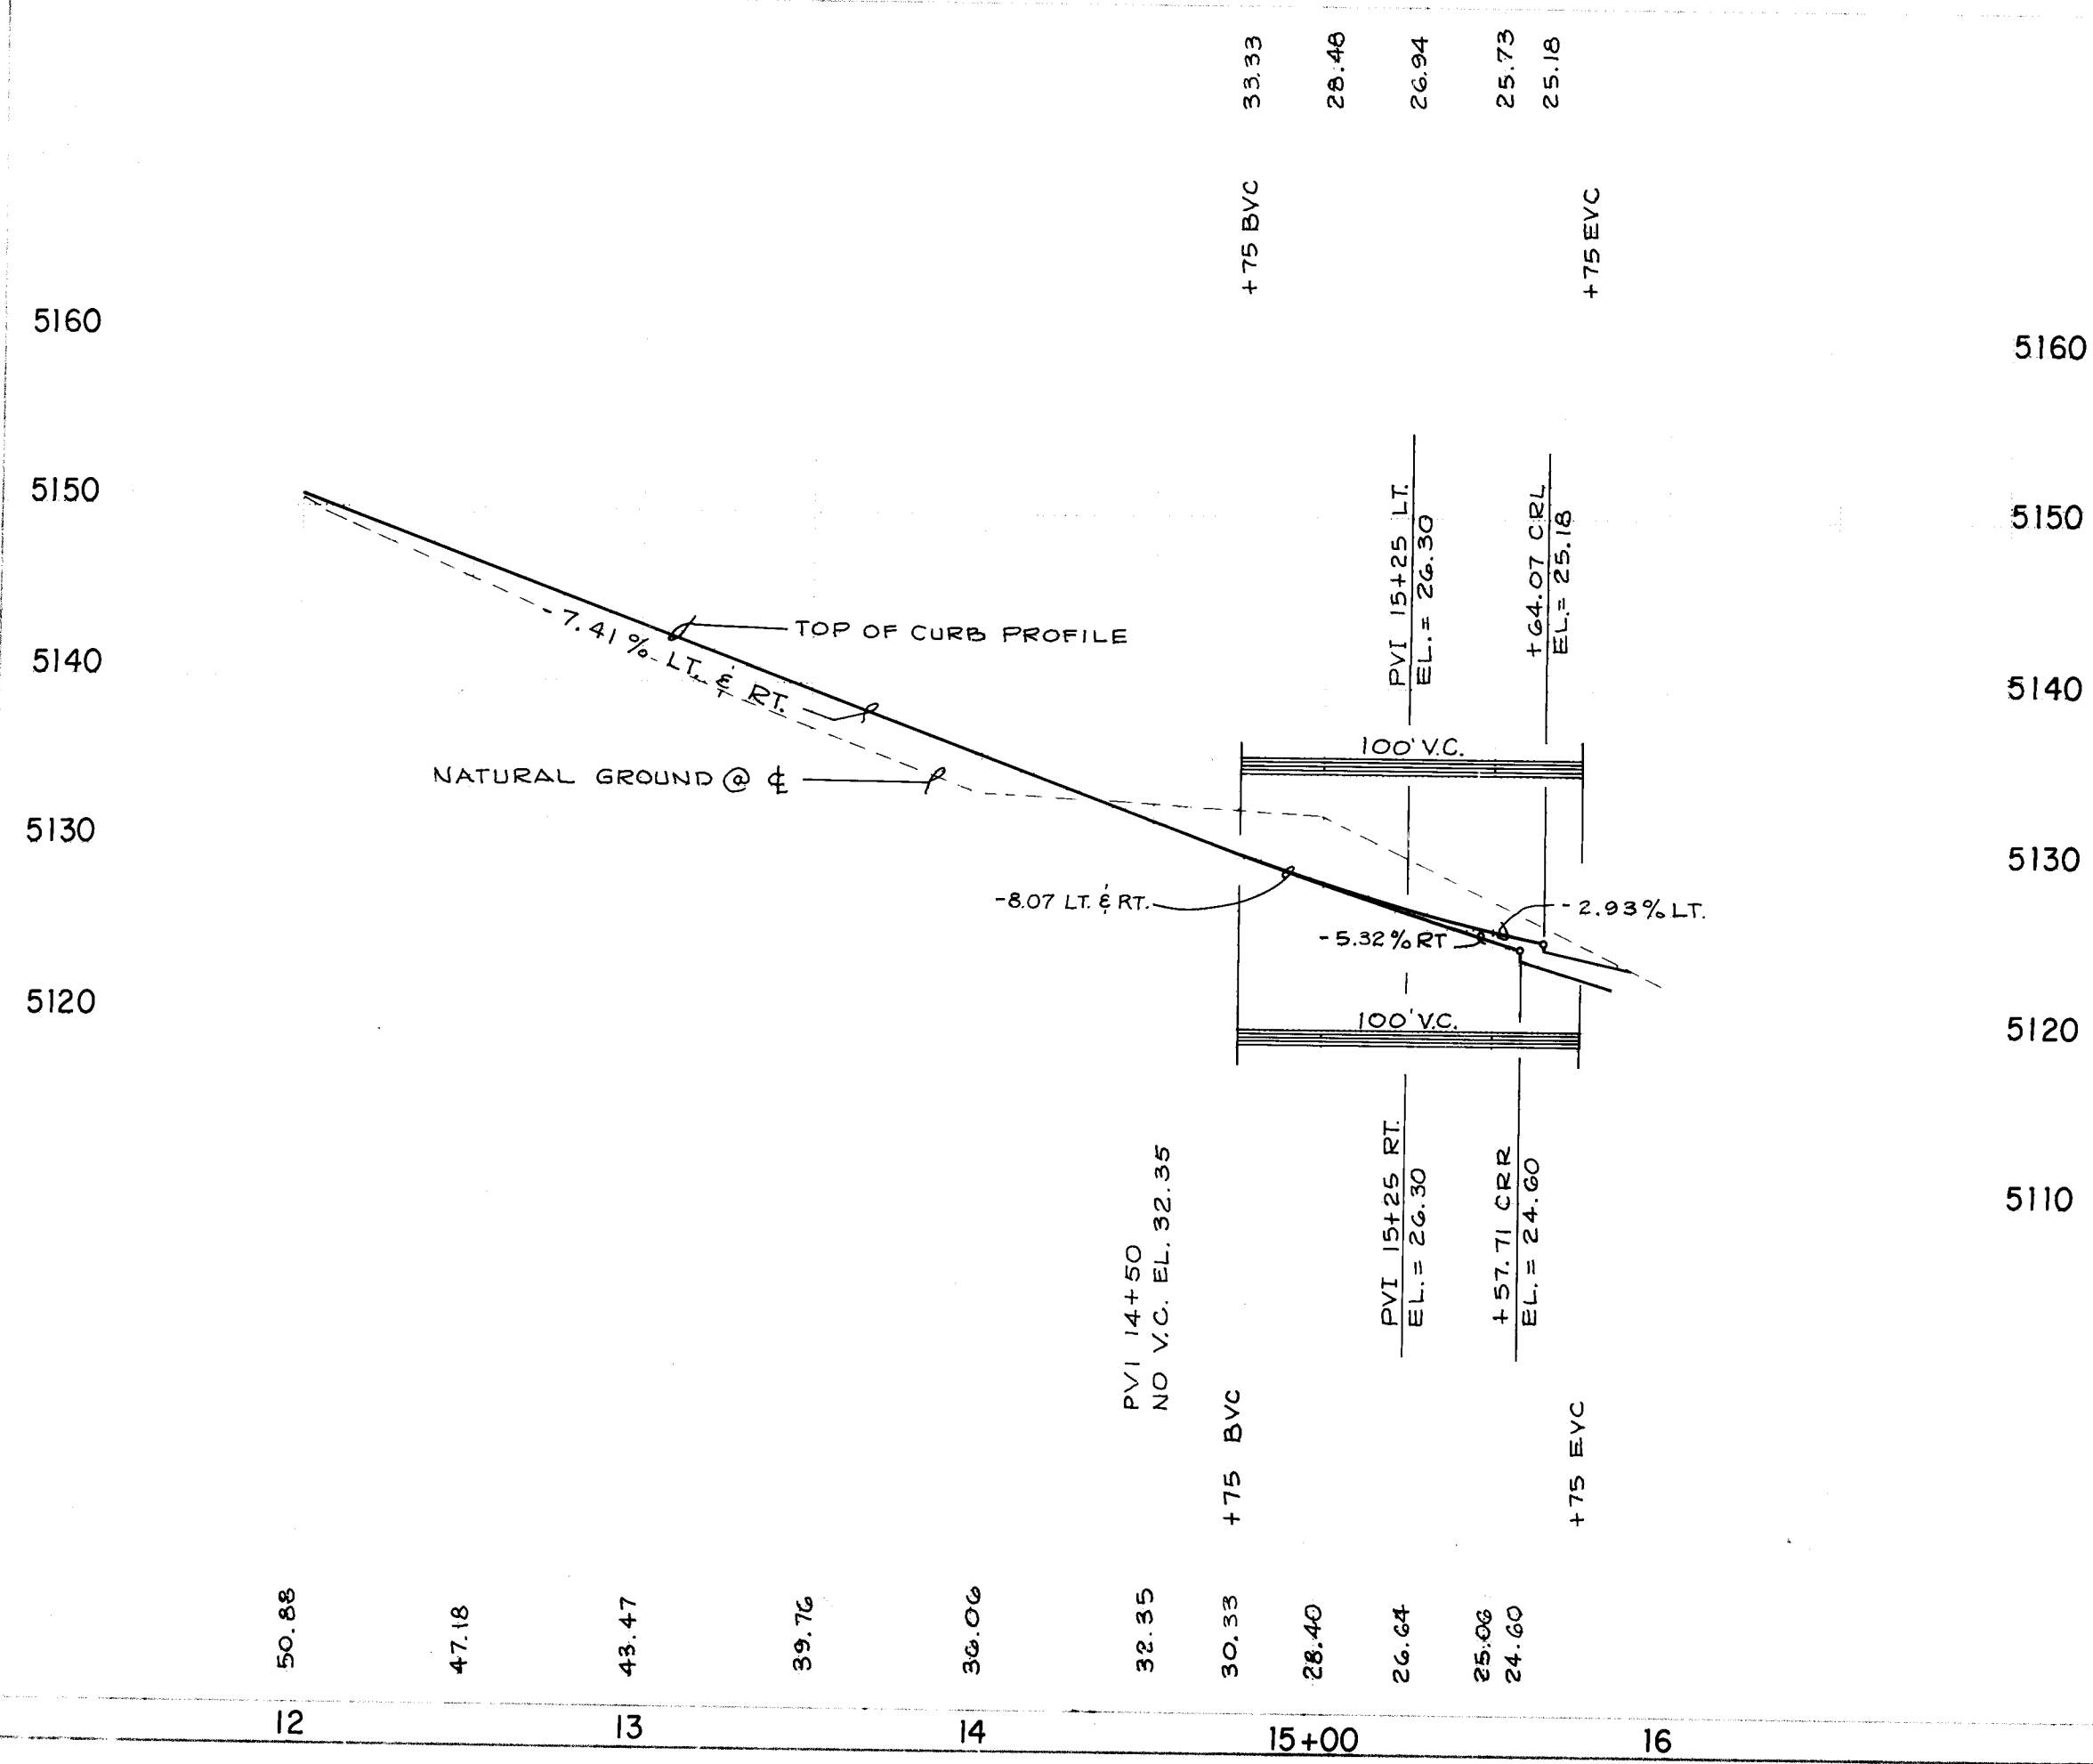

AS BUILT

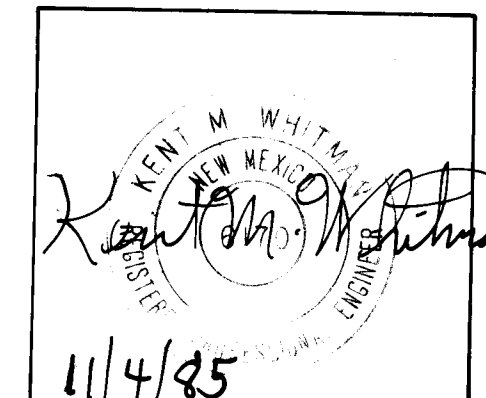

NOTE: THIS CERTIFICATION IS INTENDED TO INDICATE THAT IN THE ENGINEER'S OPINION THIS CONSTRUCTION IS IN SUBSTANTIAL COMPLIANCE WITH THE DESIGN AS SHOWN (OR AS ANNOTATED WITH UPDATED FIELD NOTES WHERE INDICATED). IT IS NOT A VERIFICATION OF CONTRACT COMPLIANCE IN THE LEVEL OF DETAIL ASSOCIATED WITH FULL CONSTRUCTION INSPECTION OF THE PROJECT.

26 18671886

SCALE: 1" = 50' Horizontal
1" = 10' Vertical

CITY OF ALBUQUERQUE
MUNICIPAL DEVELOPMENT DEPARTMENT
ENGINEERING DIVISION
TITLE: SALIDA DEL SOL-UNIT TWO-PAVING PLAN & PROFILE
CONDESA DRIVE, N.W.
VISTA DEL SOL COURT, N.W.

APPROVALS: ENGINEER DATE: 11/4/85
City Engineer: [Signature]
A.C.E. Design: [Signature]
A.C.E. Hydrology: [Signature]


DRAWING NO. 1869 MAP NO. A-13 SHEET 18 OF 40

BEACH MAP
A SQUARE CHISEL IN THE TOP OF THE EASTERLY WALL OF THE A.M.A.F.C.A. FLOOD DIVERSION NO. 2 CHANNEL, APPROXIMATELY 180 FEET SOUTH OF THE POINT OF CONFLUENCE WITH THE SKYVIEW DRAINAGE CHANNEL ESTABLISHED BY BOHANNAN-HUSTON AND MARKED "BM 205" ELEVATION = 5110.55

ENGINEER'S SEAL
KENT M. WHITMAN
STATE OF NEW MEXICO
LICENSE NO. 112784
DATE: 11/4/85

REMARKS
DIVISIONS
DATE: 10-85
DATE: 11-85
KMW
PKS

18671886

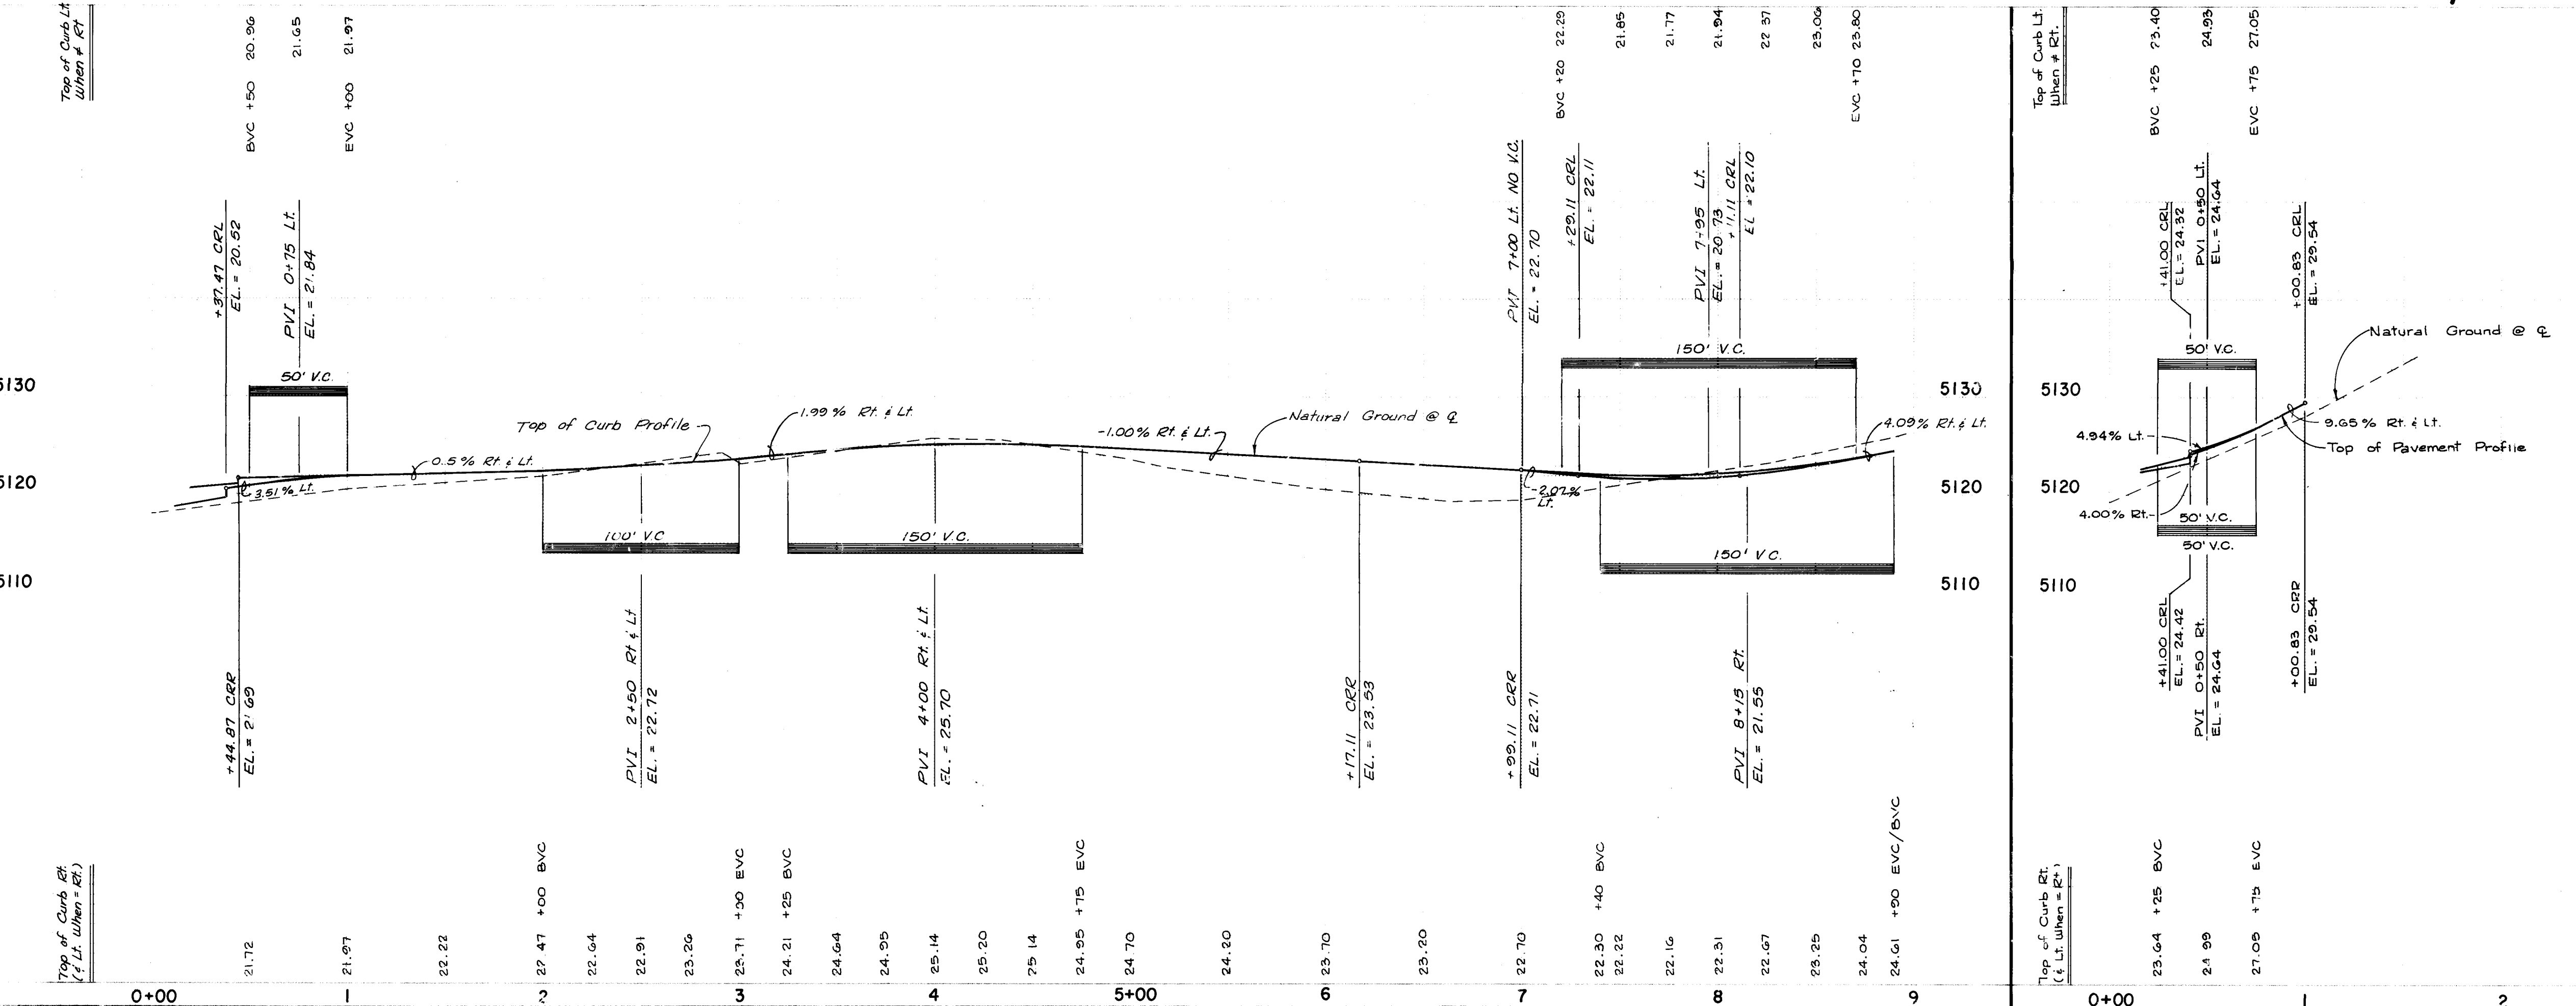


11/4/85

NOTE: THIS CERTIFICATION IS INTENDED TO INDICATE THAT IN THE ENGINEER'S OPINION THIS CONSTRUCTION IS IN SUBSTANTIAL COMPLIANCE WITH THE DESIGN AS SHOWN (OR AS ANNOTATED WITH UPDATED FIELD GRADES WHERE INDICATED). IT IS NOT A VERIFICATION OF CONTRACT COMPLIANCE IN THE LEVEL OF DETAIL ASSOCIATED WITH FULL CONSTRUCTION INSPECTION OF THE PROJECT.

26 18672086

SCALE : 1" = 50' Horizontal
1" = 10' Vertical

CITY OF ALBUQUERQUE MUNICIPAL DEVELOPMENT DEPARTMENT ENGINEERING DIVISION					
TITLE SALIDA DEL SOL - UNIT TWO - PAVING PLAN & PROFILE VISTA DEL SOL DRIVE, N.W. MIRASOL PLACE, N.W.					
APPROVAL	ENGINEER	DATE	APPROVAL	ENGINEER	DATE
CITY Engineer	<i>C. D. [Signature]</i>	5/1/64	Water		
A.C.E. Design	<i>[Signature]</i>	8/14/64	Traffic		
A.C.E. Hydrology	<i>[Signature]</i>	2/1/64	Water	Res	N/A W/F 2-8-64
DRAWING NO 1869		MAP NO A-13		SHEET 20 OF 40	

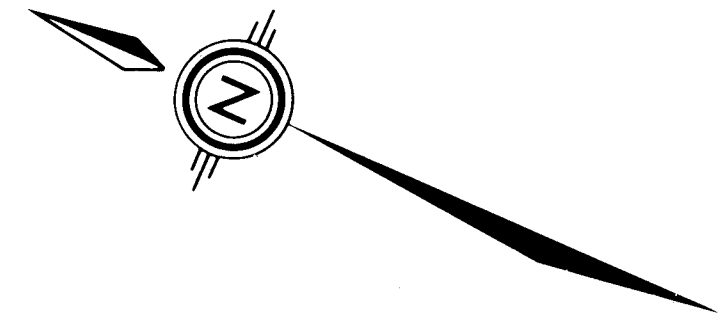

6 CURVE DATA
R = 384.45
A = 102.73
Δ = 24°15'05"

6 CURVE DATA
R = 180.67
A = 123.34
Δ = 37°51'22"

QUARTER POINTS
① TC 24.99 FL 24.32
② TC 24.78 FL 24.11
③ TC 25.02 FL 24.35

QUARTER POINTS
① TC 24.19 FL 23.92
② TC 23.52 FL 22.85
③ TC 22.84 FL 22.17


QUARTER POINTS
① TC 18.71 FL 18.04
② TC 19.22 FL 18.55
③ TC 19.72 FL 19.05

CURB CURVE DATA			
CURVE	RADIUS	ARC	DELTA
⑧	25.00	35.59	81°34'00"
⑨	25.00	40.66	93°11'25"
⑩	25.00	31.89	73°05'43"
⑪	25.00	36.32	83°14'14"


QUARTER POINTS
① TC 20.48 FL 19.81
② TC 20.02 FL 19.35
③ TC 19.55 FL 18.88

6 CURVE DATA
R = 100.00
A = 98.60
Δ = 56°56'34"

VISTA DEL SOL DRIVE, N.W.

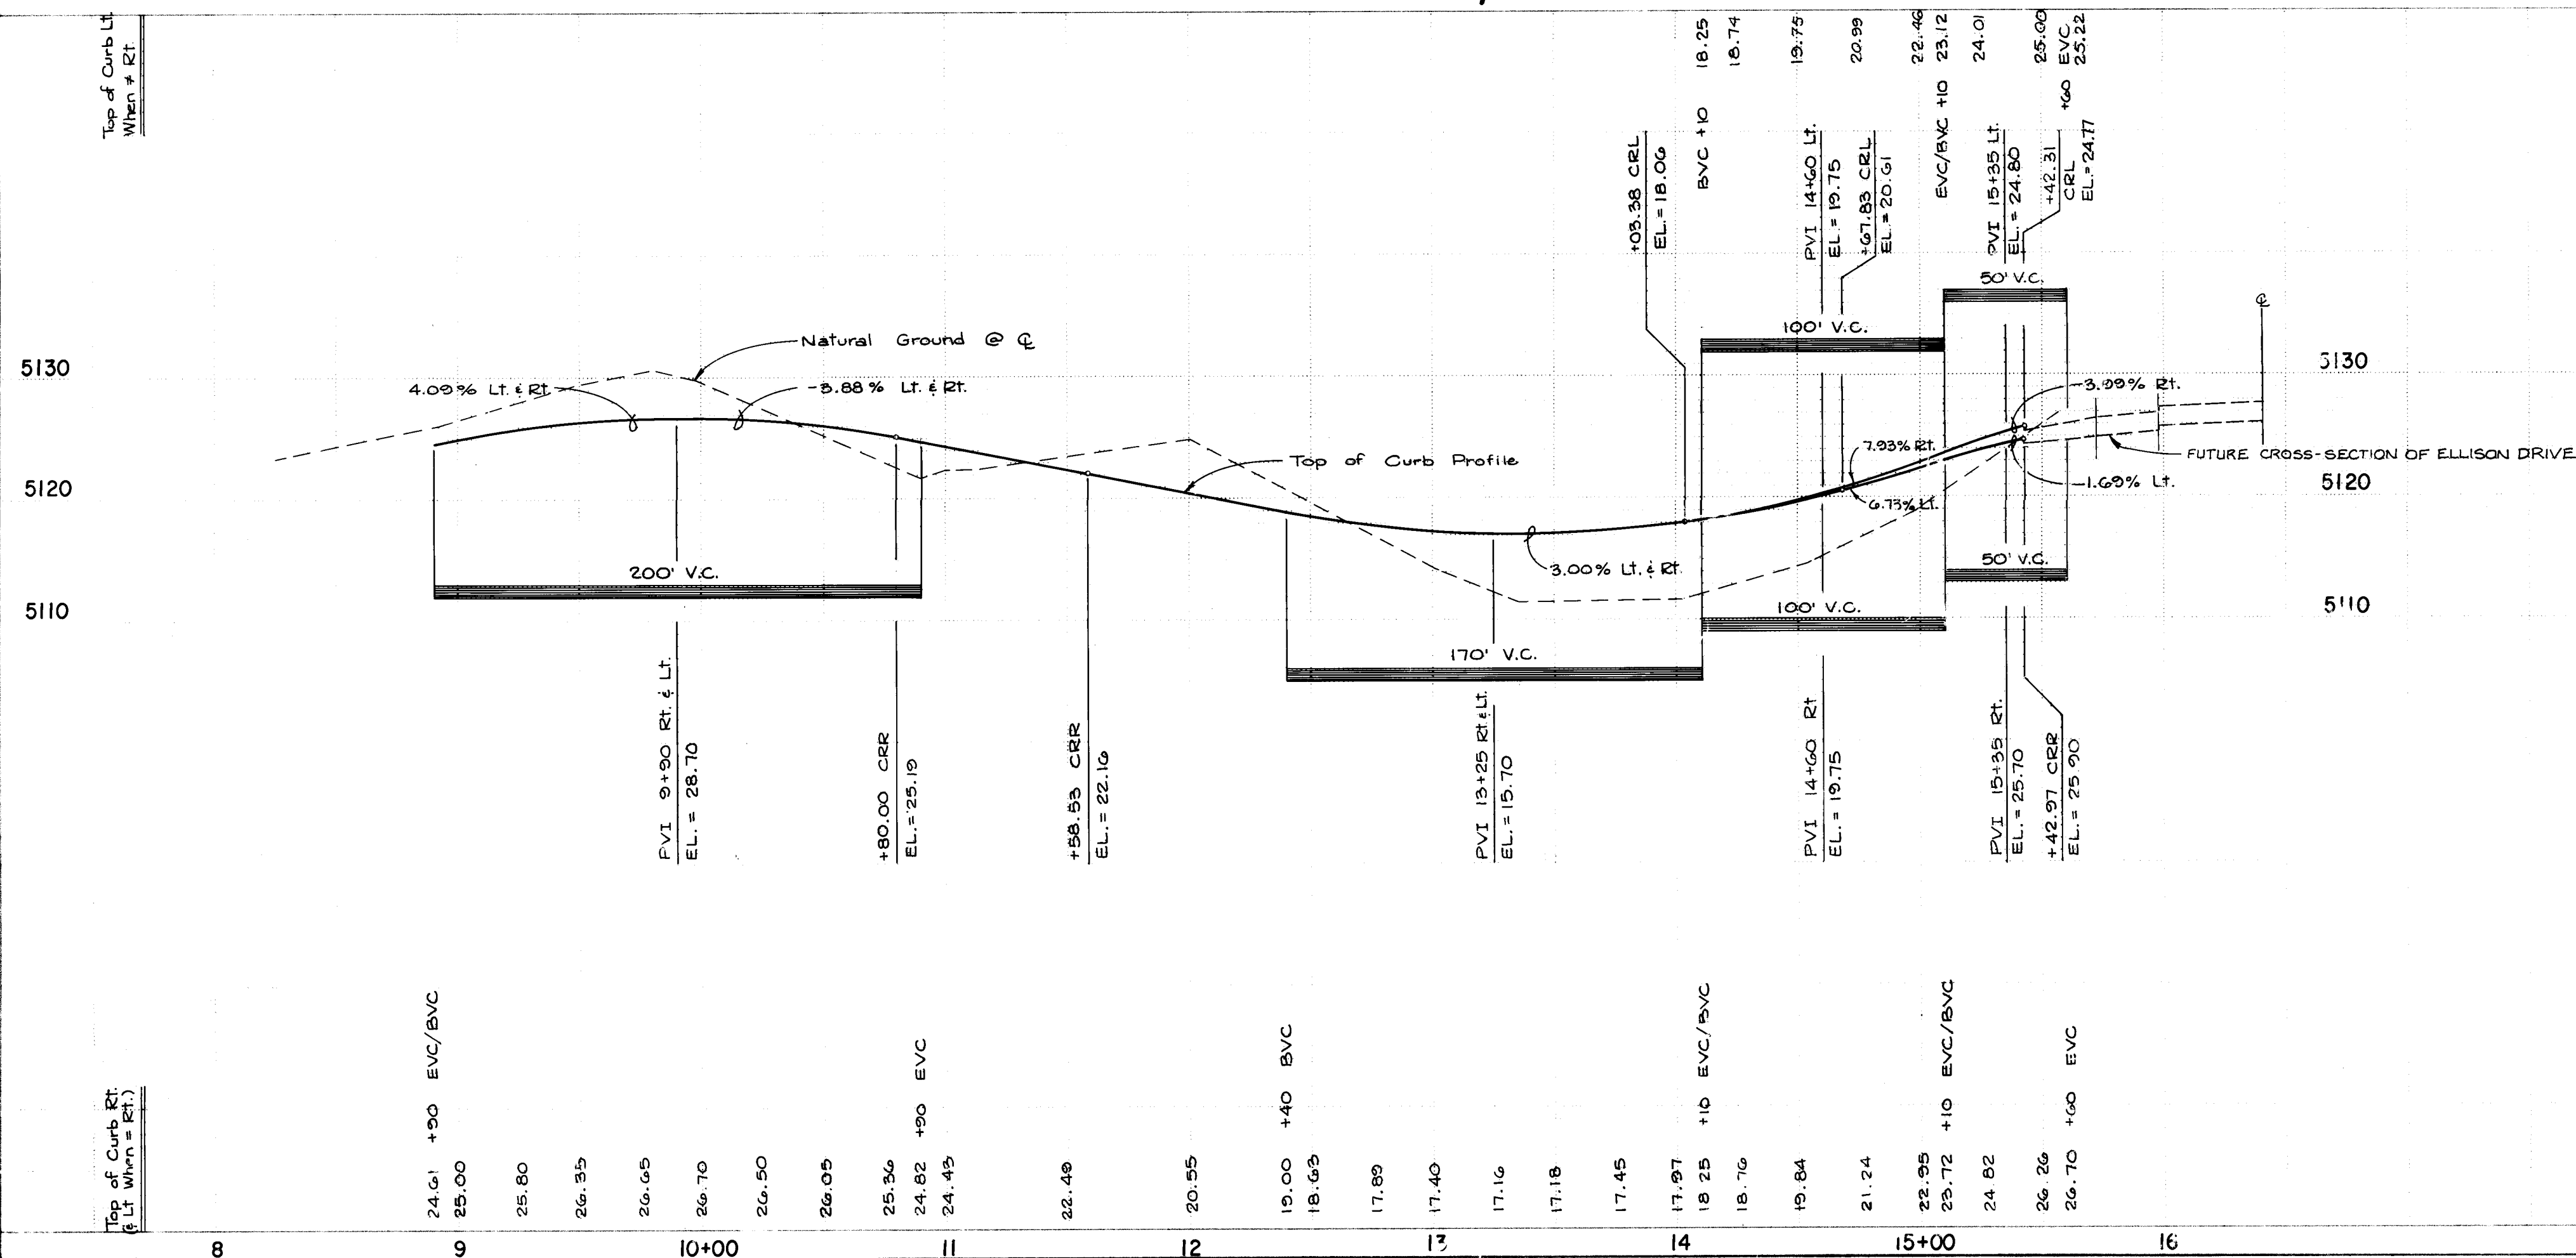

AS BUILT

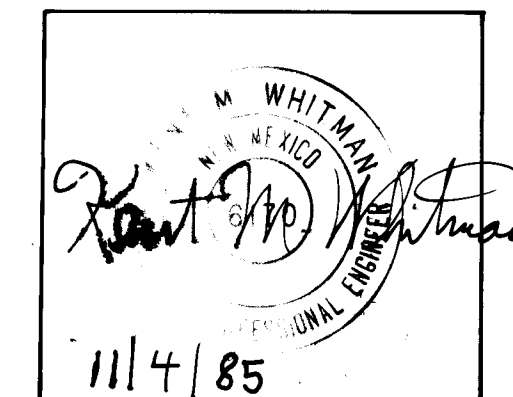

NOTE: THIS CERTIFICATION IS INTENDED TO INDICATE THAT IN THE ENGINEER'S OPINION THIS CONSTRUCTION IS IN SUBSTANTIAL COMPLIANCE WITH THE DESIGN AS SHOWN (OR AS ANNOTATED WITH UPDATED FIELD GRADES WHERE INDICATED). IT IS NOT A VERIFICATION OF CONTRACT COMPLIANCE IN THE LEVEL OF DETAIL ASSOCIATED WITH FULL CONSTRUCTION INSPECTION OF THE PROJECT.



SCALE: 1" = 50' Horizontal
1" = 10' Vertical

CITY OF ALBUQUERQUE MUNICIPAL DEVELOPMENT DEPARTMENT ENGINEERING DIVISION					
TITLE SALIDA DEL SOL - UNIT TWO - PAVING PLAN & PROFILE VISTA DEL SOL DRIVE, N.W.					
APPROVALS	ENGINEER	DATE	APPROVALS	ENGINEER	DATE
City Engineer	<i>[Signature]</i>	5/1/85	Liquid Waste		
A.C.E. Design	<i>[Signature]</i>	8/2/84	Traffic	<i>[Signature]</i>	2/2/85
A.C.E. Hydrology	<i>[Signature]</i>	2/2/84	Water	<i>[Signature]</i>	2-3-85
DRAWING NO	1869	MAP NO	A-13	SHEET	21 OF 40

AS BUILT

9/13/85

NOTE: THIS CERTIFICATION IS INTENDED TO INDICATE THAT IN THE ENGINEER'S OPINION THIS CONSTRUCTION IS IN SUBSTANTIAL COMPLIANCE WITH THE DESIGN AS SHOWN (OR AS ANNOTATED WITH UPDATED FIELD GRADES WHERE INDICATED). IT IS NOT A VERIFICATION OF CONTRACT COMPLIANCE IN THE LEVEL OF DETAIL ASSOCIATED WITH FULL CONSTRUCTION INSPECTION OF THE PROJECT.

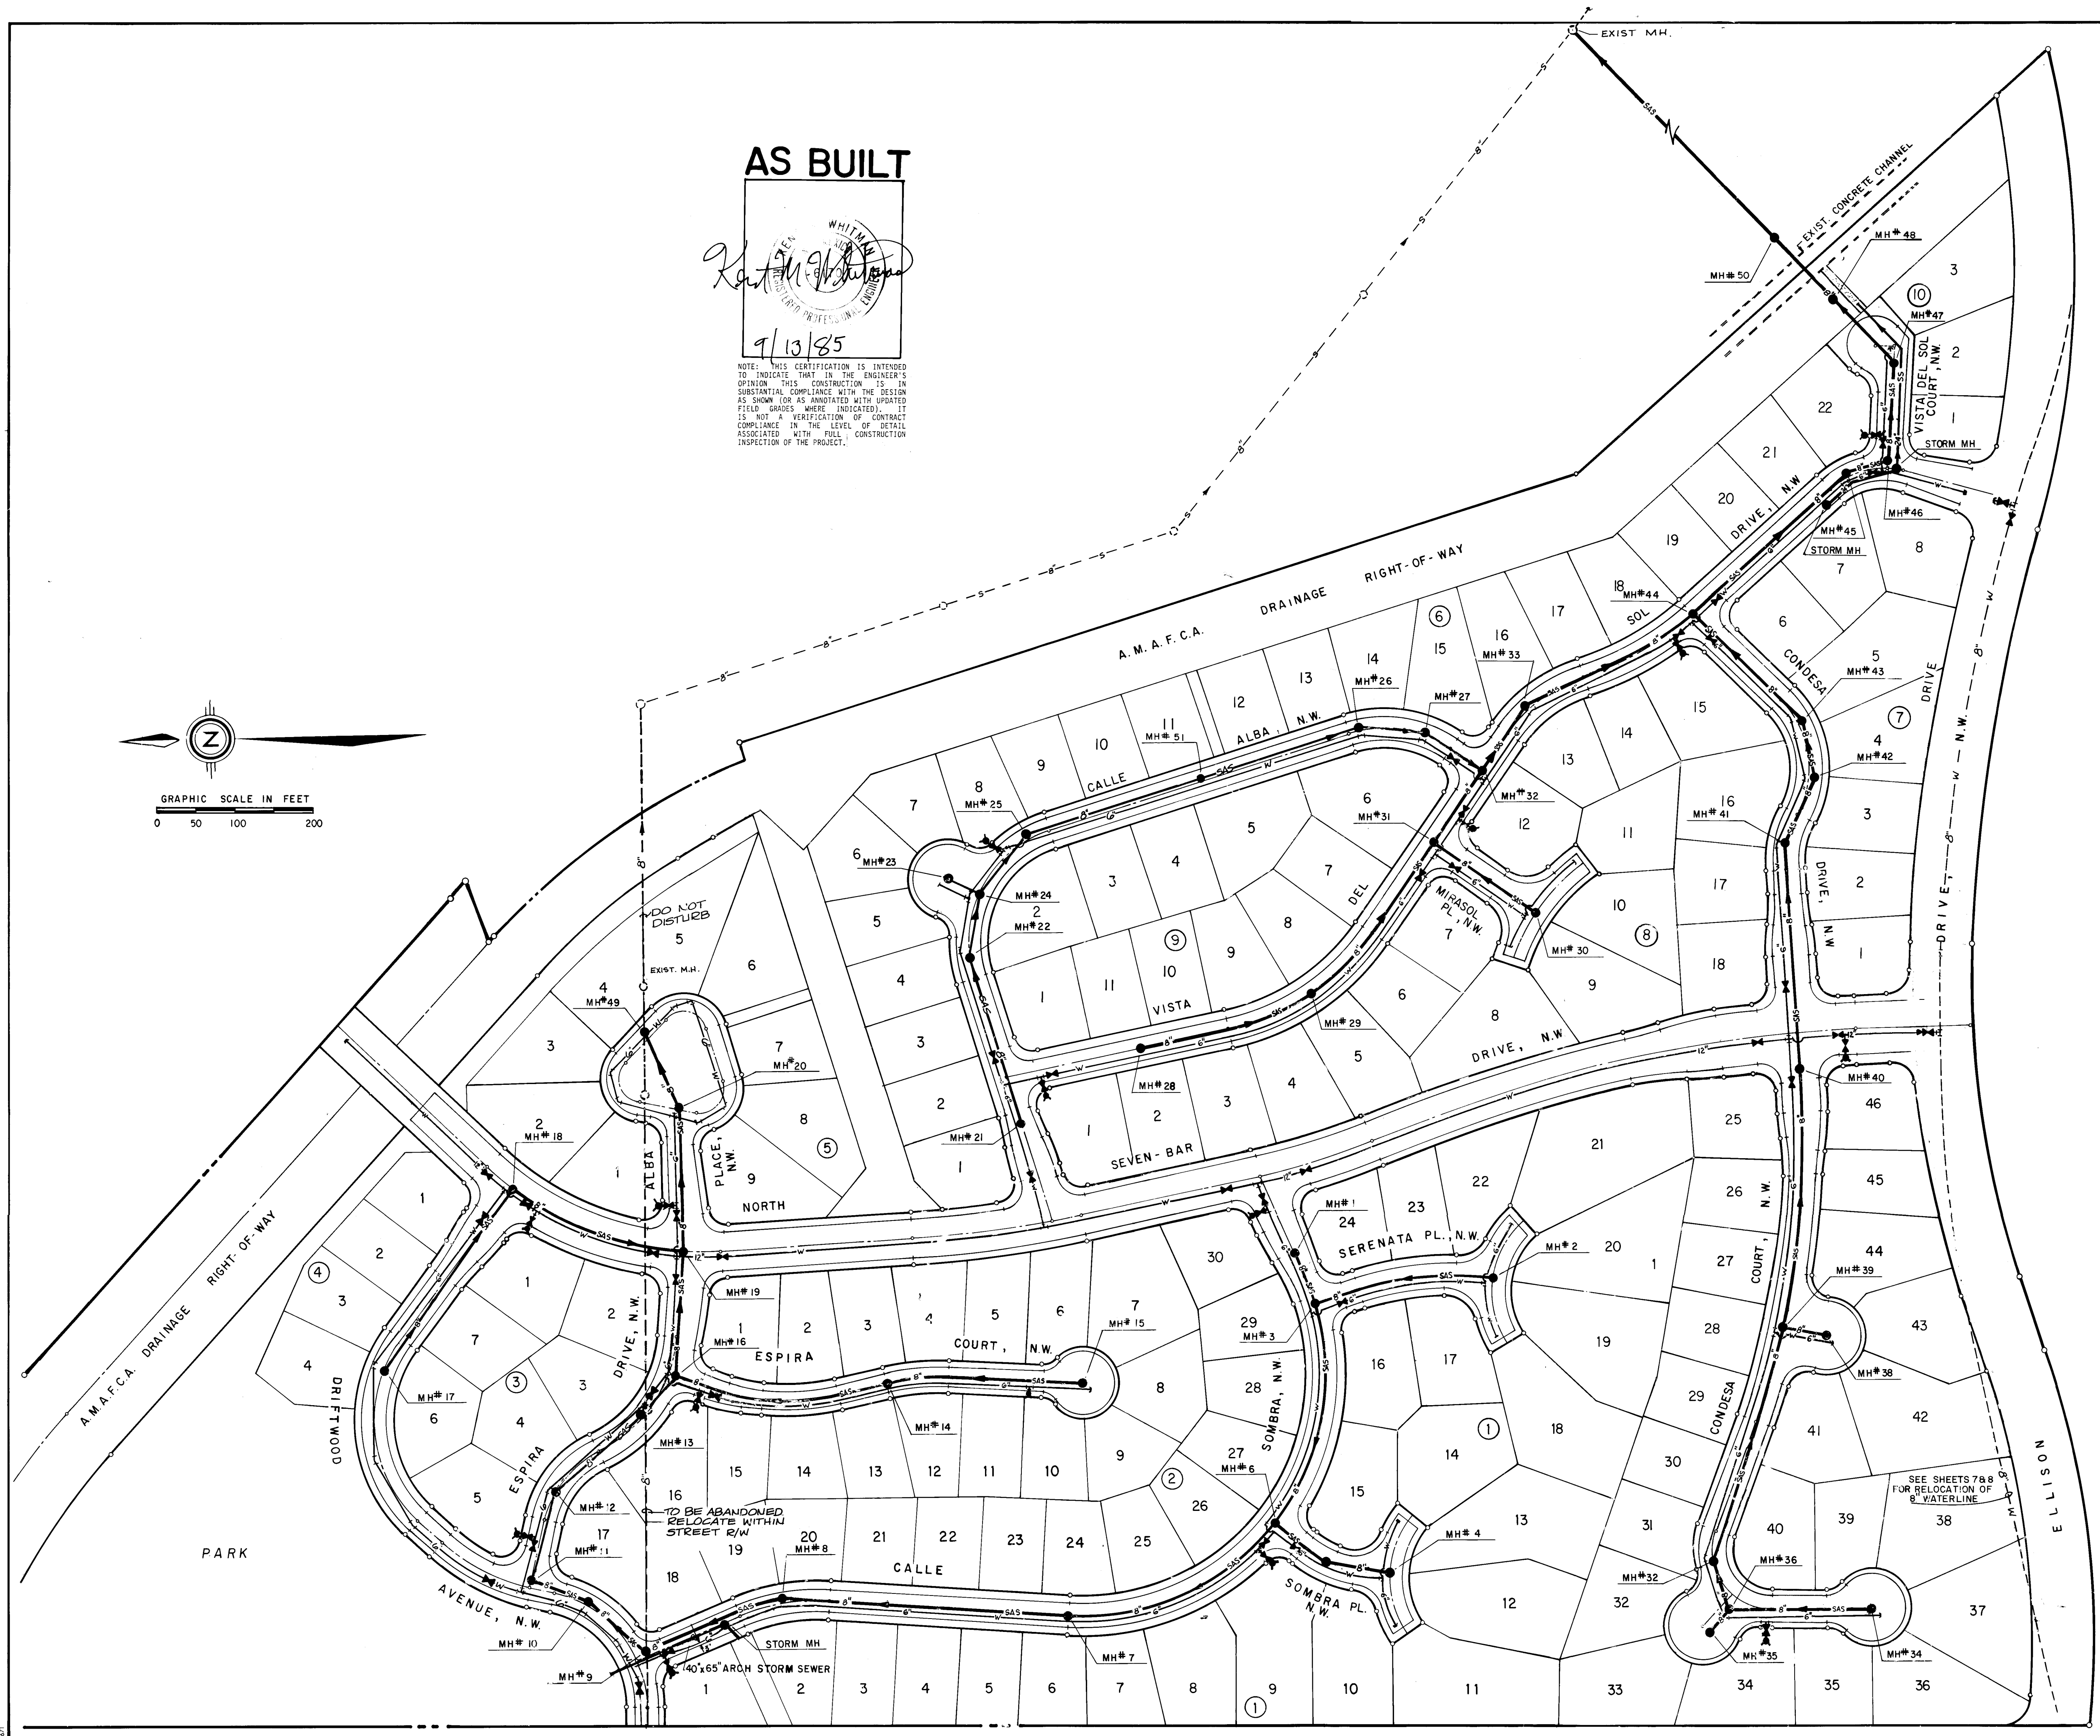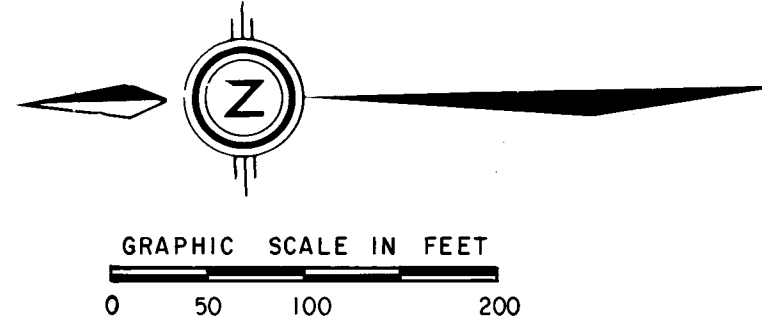

- GENERAL NOTES - ALL UTILITY SHEETS
- 1) The Contractor shall furnish ELDs on all Water & Sewer service stubs, caps and plugs.
 - 2) All stationing refers to street centerline.
 - 3) Contractor shall field verify locations and elevations of all existing pipe & utilities prior to construction.
 - 4) Water services shall be 1" diameter type K copper tubing. Class 160, with 3/4" meters.
 - 5) All tees, bends and caps shall be blocked according to City of Albuquerque Standards.
 - 6) All pipe shall be furnished with class "C" bedding unless otherwise noted.
 - 7) Where gate valves and hydrants are shown at intersections, these shall be located opposite curb return indicated.
 - 8) All trench backfill shall be compacted to a minimum of 90% of optimum (Modified).
 - 9) Water pipe shall be P.V.C. Class 150 AWWA C900. Sewer Pipe shall be P.V.C. Class SDR35.
 - 10) The following lots will require sewer services furnished with standard City of Albuquerque risers per drawing #S-7



Lot	Riser Height (ft.)
B2 L27	3'
B2 L28	4'
B6 L15	8'
B6 L16	14'
B6 L17	17'
B6 L18	16'
B6 L19	13'
B6 L20	9'
B6 L21	9'
B7 L6	10'
B7 L7	9'
B7 L8	8'
B8 L13	14'
B8 L14	15'
B8 L15	14'
B9 L6	5'
B10 L1	9'
B10 L2	4'
B10 L3	4'

- In addition the contractor shall note that services for Block 10, Lots 1, 2 & 3, and Block 7, Lot 8 shall pass beneath the 24" R.C.P. storm sewer.
- 11) All PVC Watermain fittings shall be "Grip-Tight" push-on type fittings - AWWA approved for PVC, C900 Watermain.
 - 12) All waterlines and sanitary sewer lines belong to the New Mexico Utility Company, not the City of Albuquerque.

LEGEND

- 6" — W — EXISTING WATER LINE
- 8" — W — PROPOSED WATER LINE
- 12" — W — PROPOSED GATE VALVE
- 12" — W — PROPOSED FIRE HYDRANT
- 12" — W — TEL
- 12" — W — CROSS
- 12" — W — BEND
- 12" — W — CAP OR PLUG
- 8" — SAS — EXISTING SANITARY SEWER LINE
- 8" — SAS — PROPOSED SANITARY SEWER LINE
- 12" — SAS — EXISTING MANHOLE
- 12" — SAS — PROPOSED MANHOLE
- 12" — SAS — DIRECTION OF FLOW

CITY OF ALBUQUERQUE MUNICIPAL DEVELOPMENT DEPARTMENT ENGINEERING DIVISION			
TITLE: SALIDA DEL SOL - UNITS ONE & TWO			
COMPOSITE SANITARY SEWER & WATER PLAN			
APPROVALS	ENGINEER	DATE	APPROVALS
City Engineer	C. Rodriguez	5/16/85	Liquid Waste
A.C.E. - Design	Shelton	8/1/84	Traffic
A.C.E. - Hydrology	NA	2/24/85	Water
DRAWING NO. 1869		SHEET 22 OF 40	

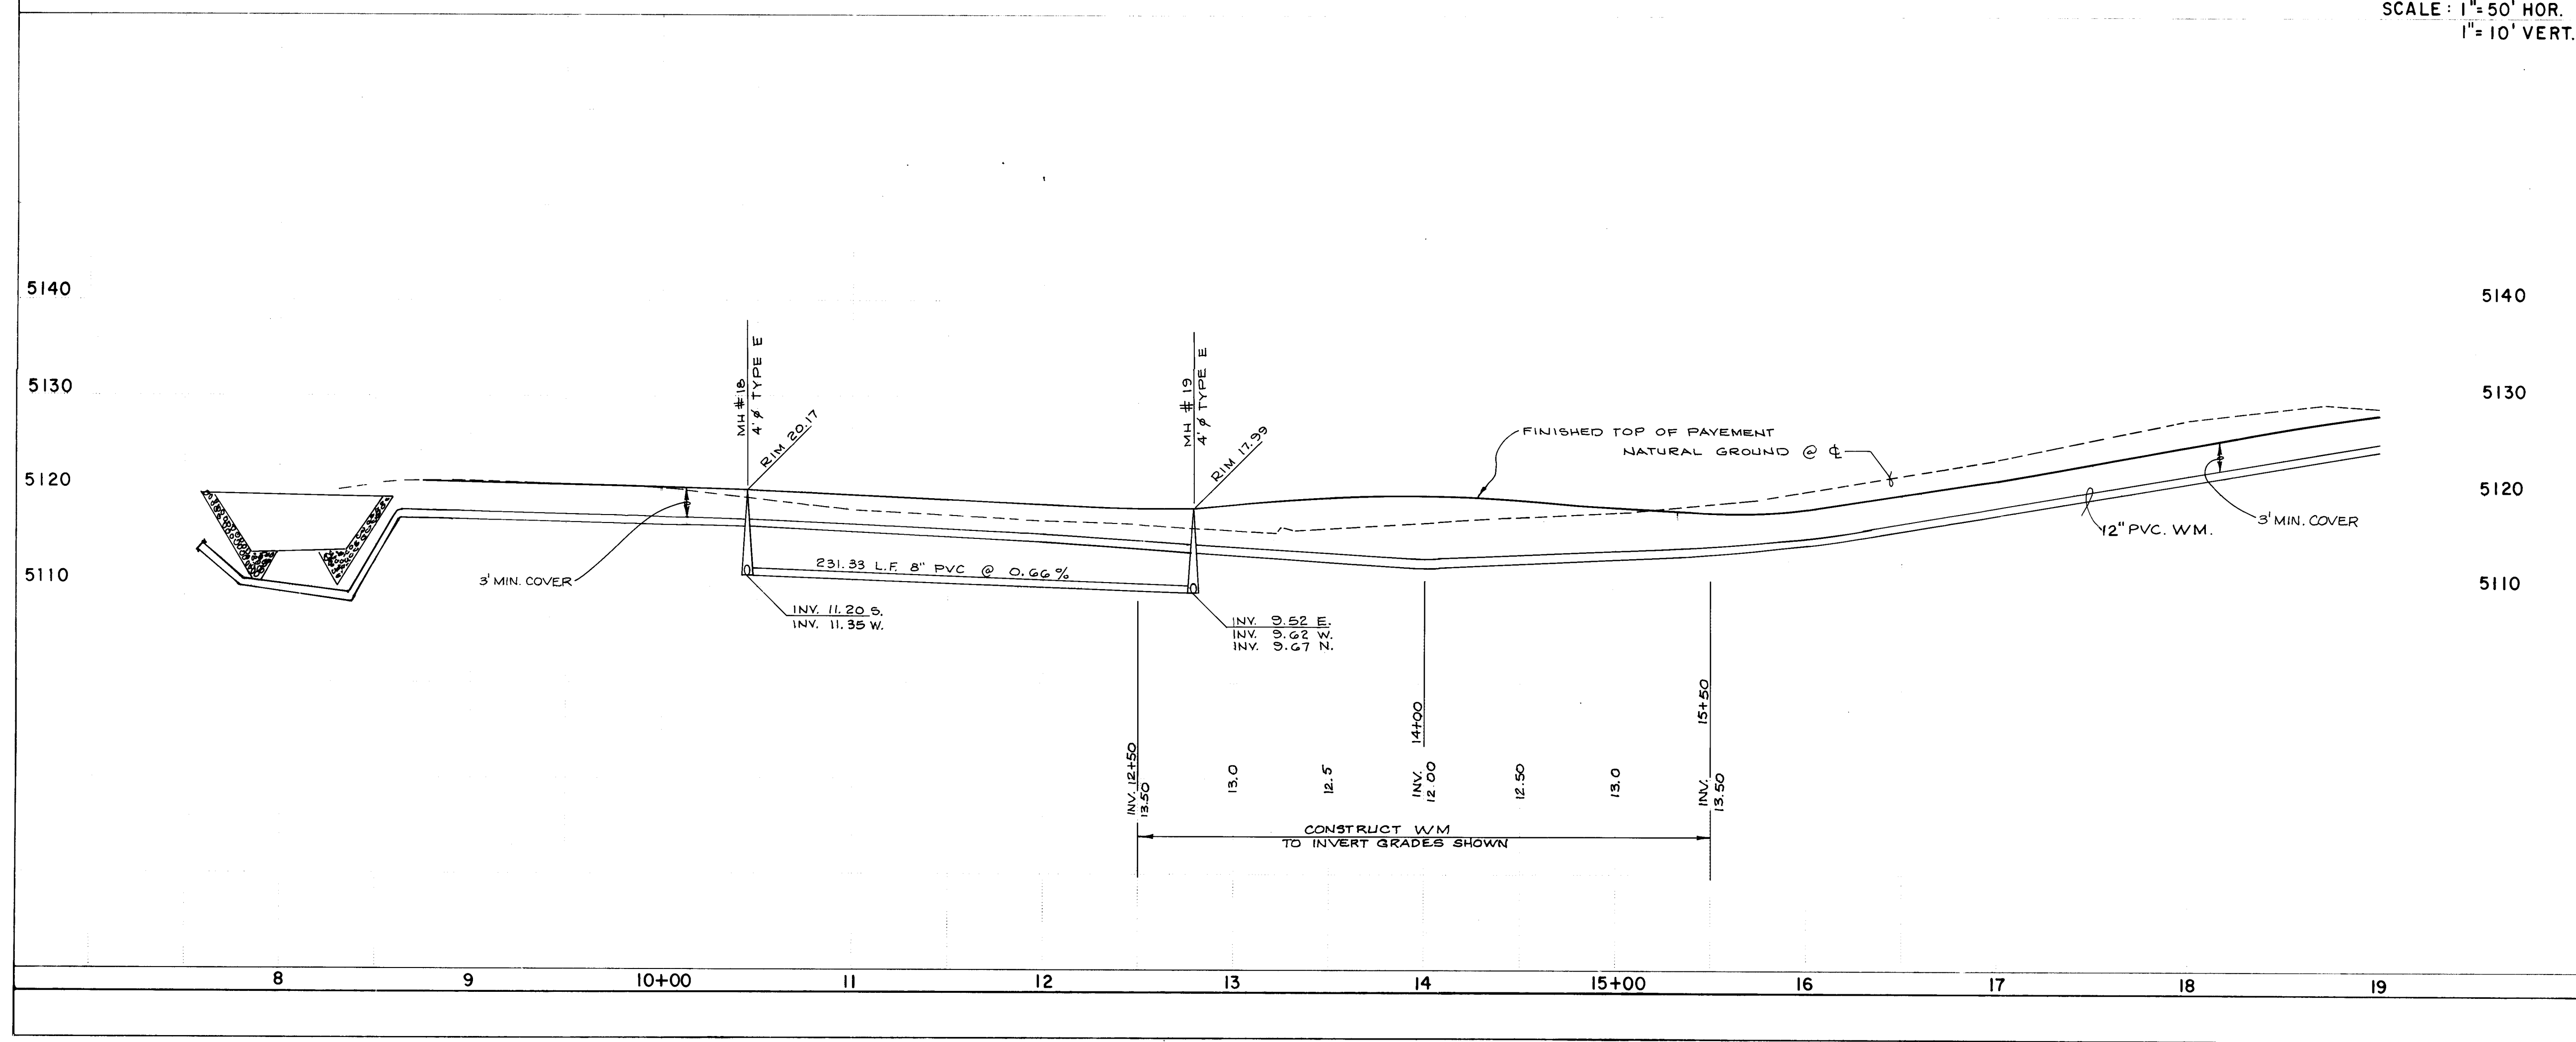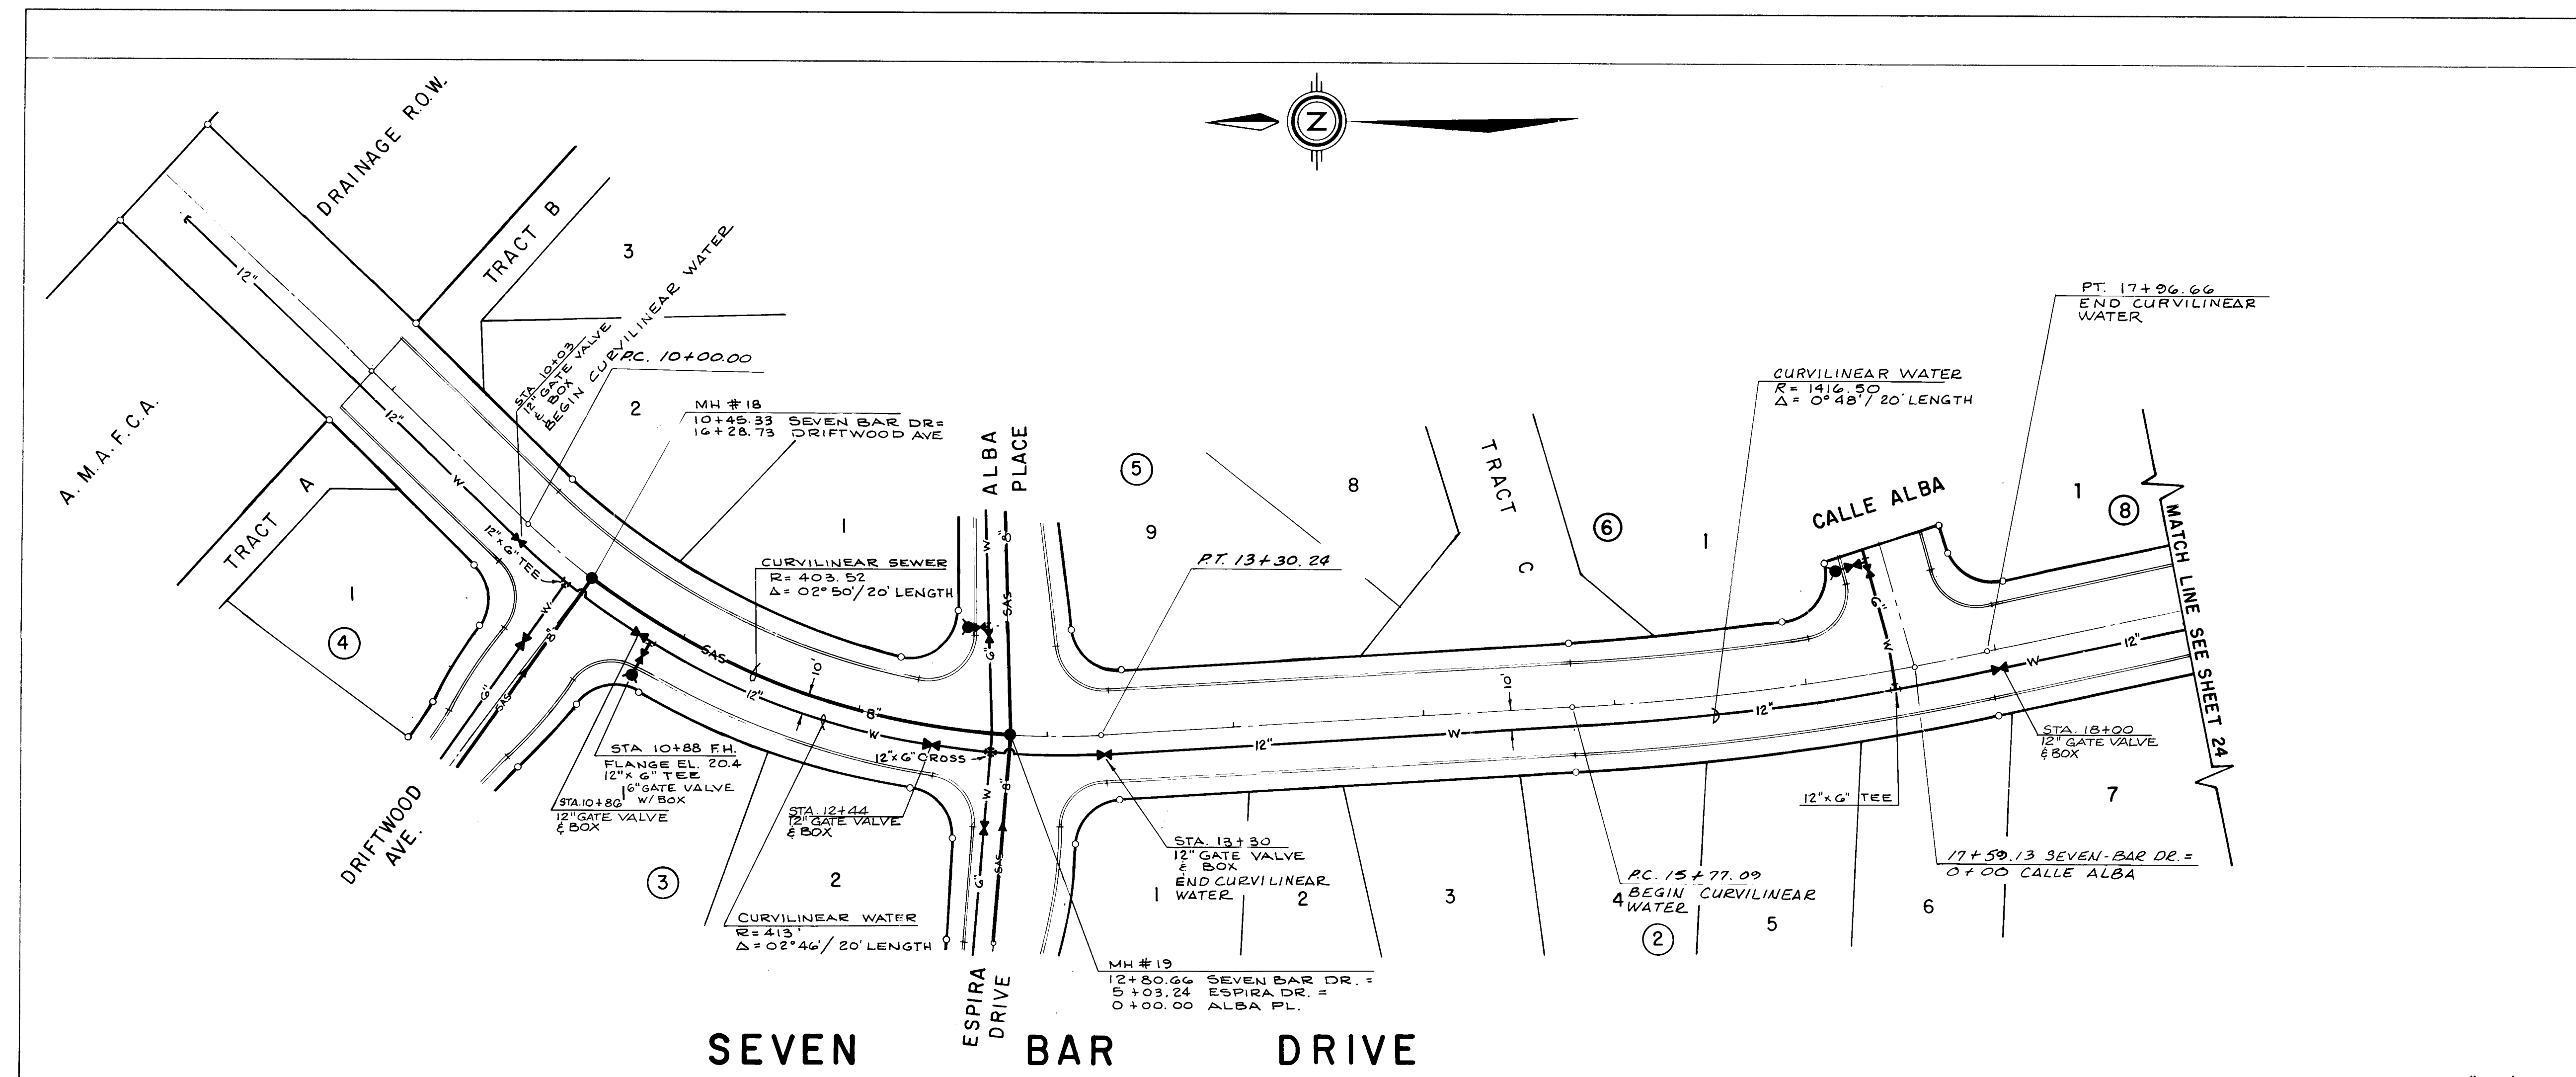

AS BUILT

SCALE: 1"=50' HOR.
1"=10' VERT.

NOTE: THIS CERTIFICATION IS INTENDED TO INDICATE THAT IN THE ENGINEER'S OPINION THIS CONSTRUCTION IS IN SUBSTANTIAL COMPLIANCE WITH THE DESIGN AS SHOWN (OR AS ANNOTATED WITH UPDATED FIELD GRADES WHERE INDICATED). IT IS NOT A VERIFICATION OF CONTRACT COMPLIANCE IN THE LEVEL OF DETAIL ASSOCIATED WITH FULL CONSTRUCTION INSPECTION OF THE PROJECT.

1/13/85

1/27/84



26 186923810

CITY OF ALBUQUERQUE
MUNICIPAL DEVELOPMENT DEPARTMENT
ENGINEERING DIVISION

TITLE: SALIDA DEL SOL - UNIT ONE - UTILITY PLAN & PROFILE
NORTH SEVEN BAR DRIVE, N.W.


APPROVALS	ENGINEER	DATE	APPROVALS	ENGINEER	DATE
City Engineer	C. J. [Signature]	2/1/84	City Engineer	[Signature]	2/1/84
ACE - Design	[Signature]	2/1/84	ACE - Design	[Signature]	2/1/84
ACE - Hydrology	[Signature]	2/1/84	ACE - Hydrology	[Signature]	2/1/84

DRAWING NO. 1869 MAP NO. A-13 SHEET 23 OF 40

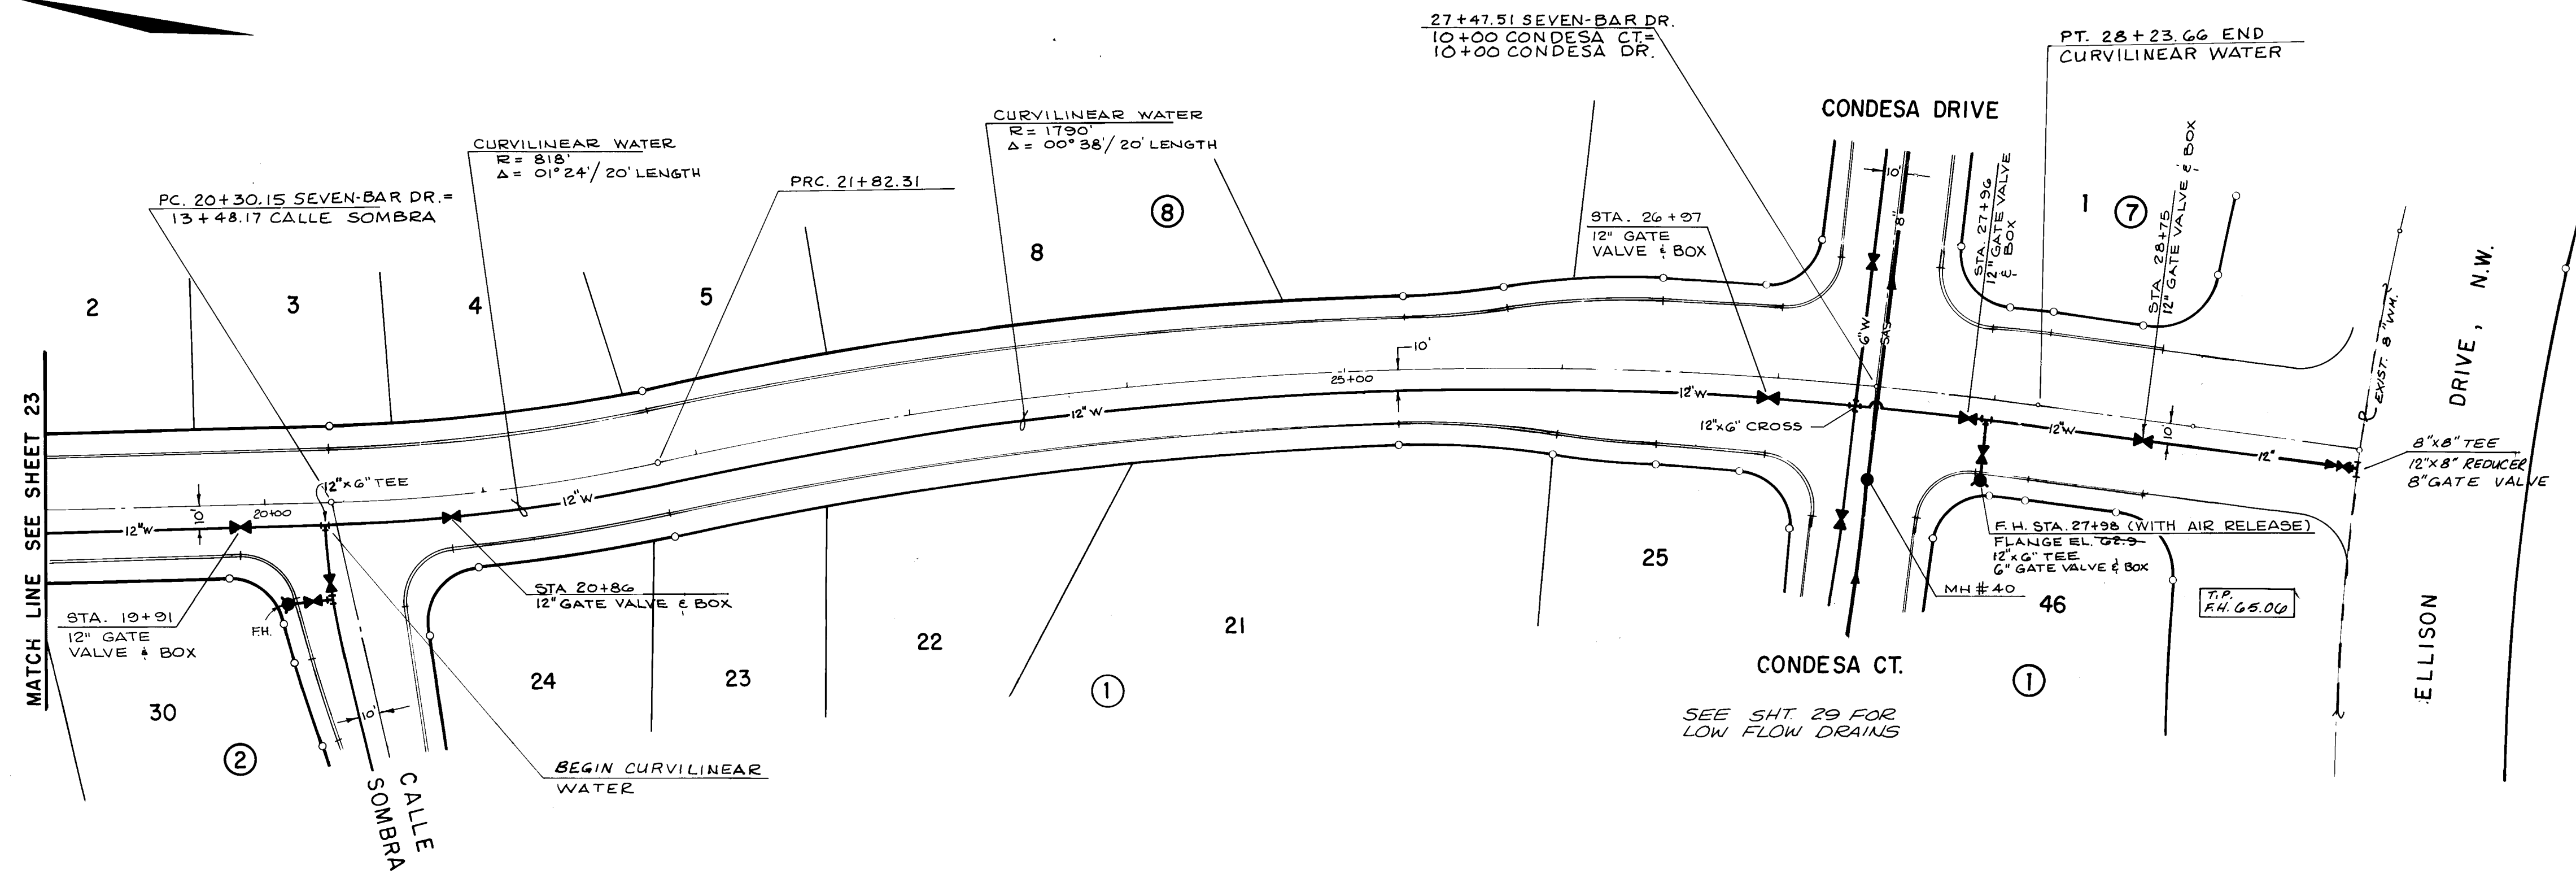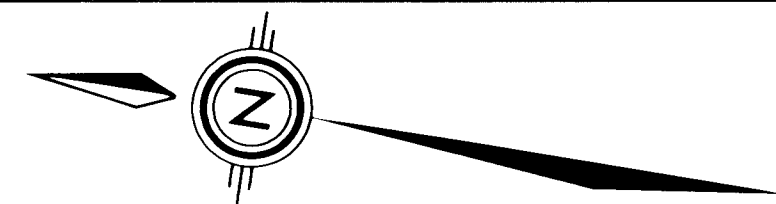


NORTH SEVEN BAR DRIVE, N.W.

SCALE: 1" = 50' HOR.
1" = 10' VERT.

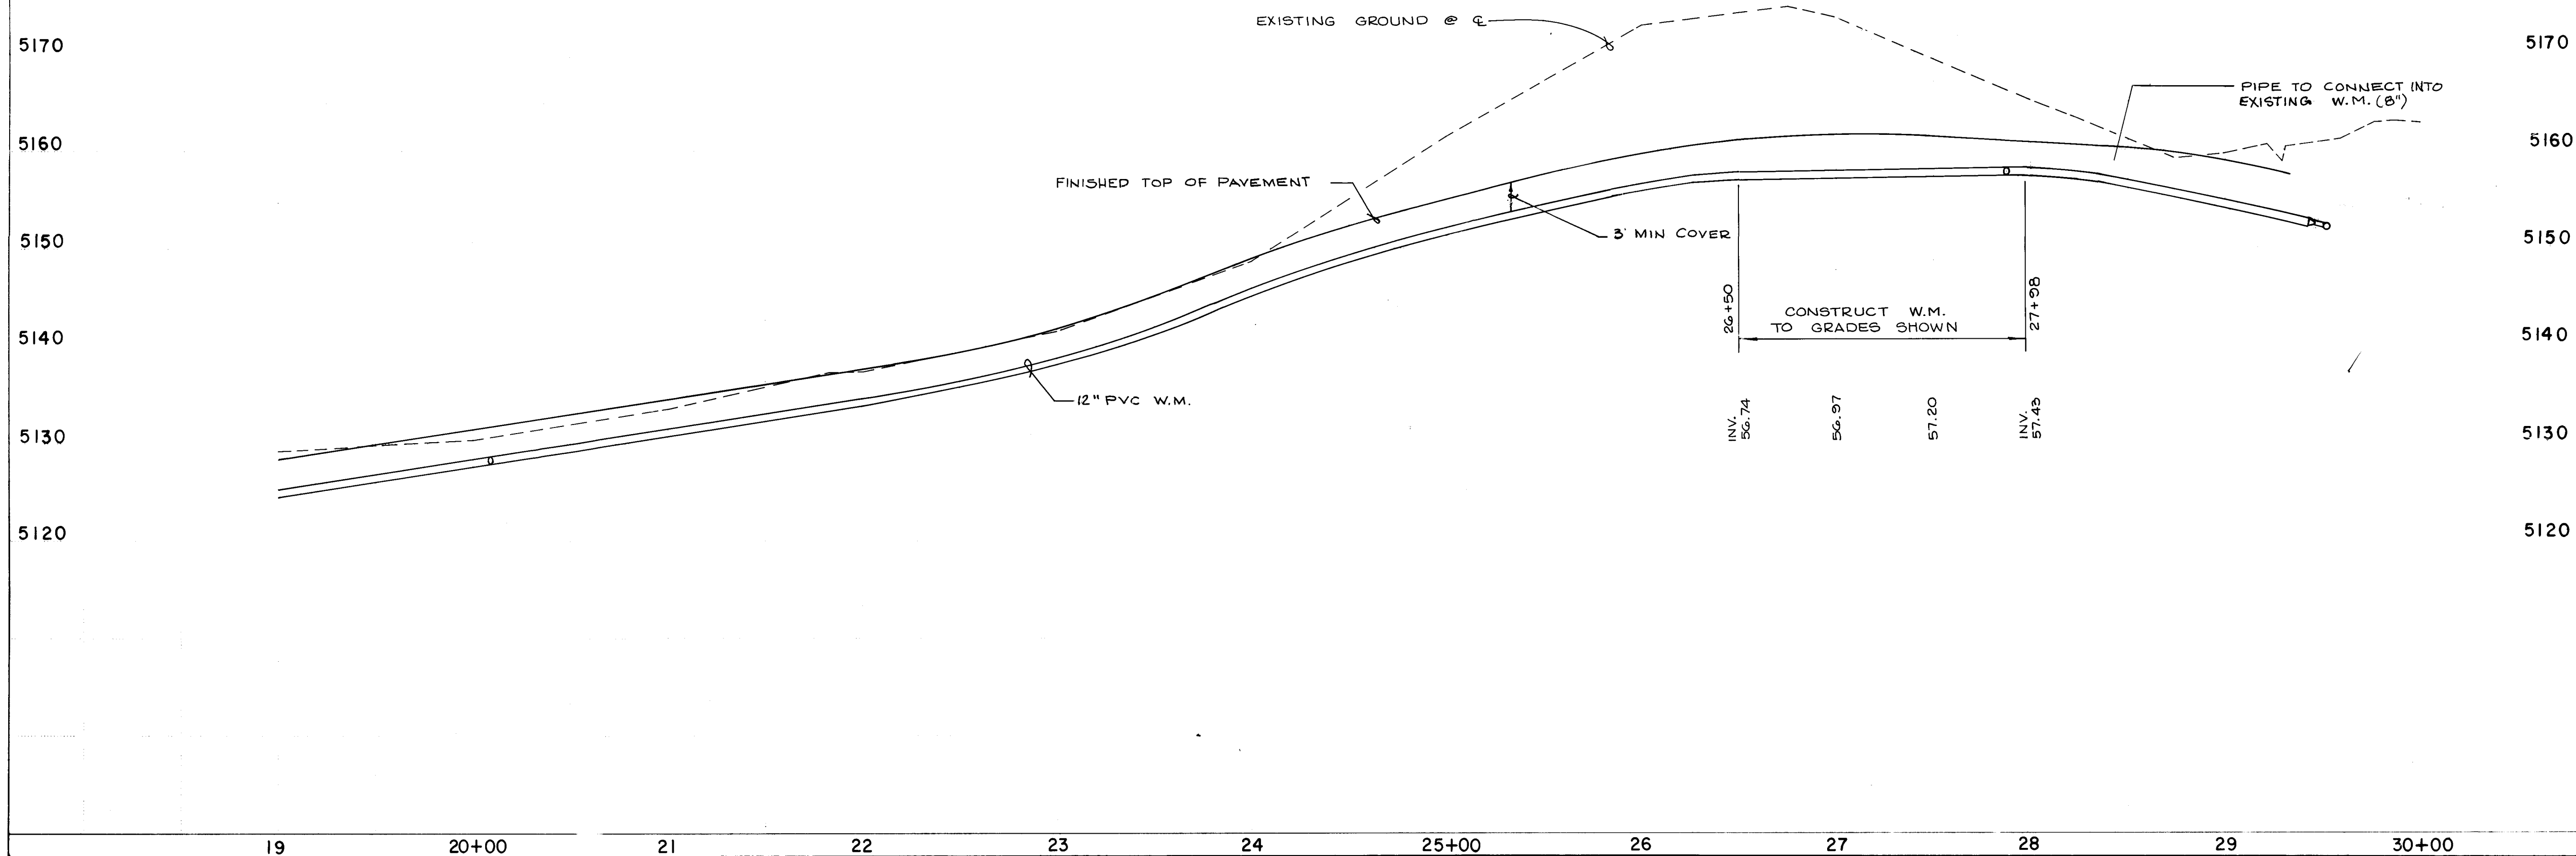

AS BUILT

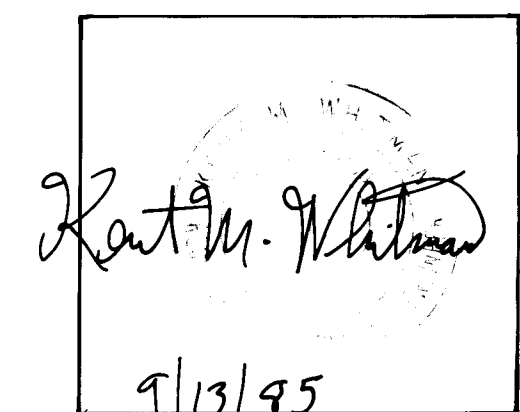

NOTE: THIS CERTIFICATION IS INTENDED TO INDICATE THAT IN THE ENGINEER'S OPINION, THIS CONSTRUCTION IS IN SUBSTANTIAL COMPLIANCE WITH THE DESIGN AS SHOWN (OR AS ANNOTATED WITH UPDATED FIELD GRADES WHERE INDICATED). IT IS NOT A VERIFICATION OF CONTRACT COMPLIANCE IN THE LEVEL OF DETAIL ASSOCIATED WITH FULL CONSTRUCTION INSPECTION OF THE PROJECT.

NOTE:
The water line and
sanitary sewer line
are to belong to New
Mexico Utility Company
Systems, not City of
Albuquerque.

CITY OF ALBUQUERQUE MUNICIPAL DEVELOPMENT DEPARTMENT ENGINEERING DIVISION					
TITLE: SALIDA DEL SOL-UNIT ONE-UTILITY PLAN & PROFILE NORTH SEVEN BAR DRIVE, N.W.					
APPROVALS	ENGINEER	DATE	APPROVALS	ENGINEER	DATE
City Engineer	<i>[Signature]</i>	8/1/95	Liquid Waste		
ACE Design	<i>[Signature]</i>	8/8/95	Traffic	<i>[Signature]</i>	8/8/95
ACE Hydrology	<i>[Signature]</i>	8/8/95	Water	<i>[Signature]</i>	8/8/95



REVISIONS	
NO.	DATE
1	8/1/95

DESIGNED BY	
NAME	DATE
K.M.W.	11-83

DRAWN BY	
NAME	DATE
M.K.S.	11-83

CHECKED BY	
NAME	DATE
K.M.W.	11-83

MICRO-FILM INFORMATION	
NO.	DATE

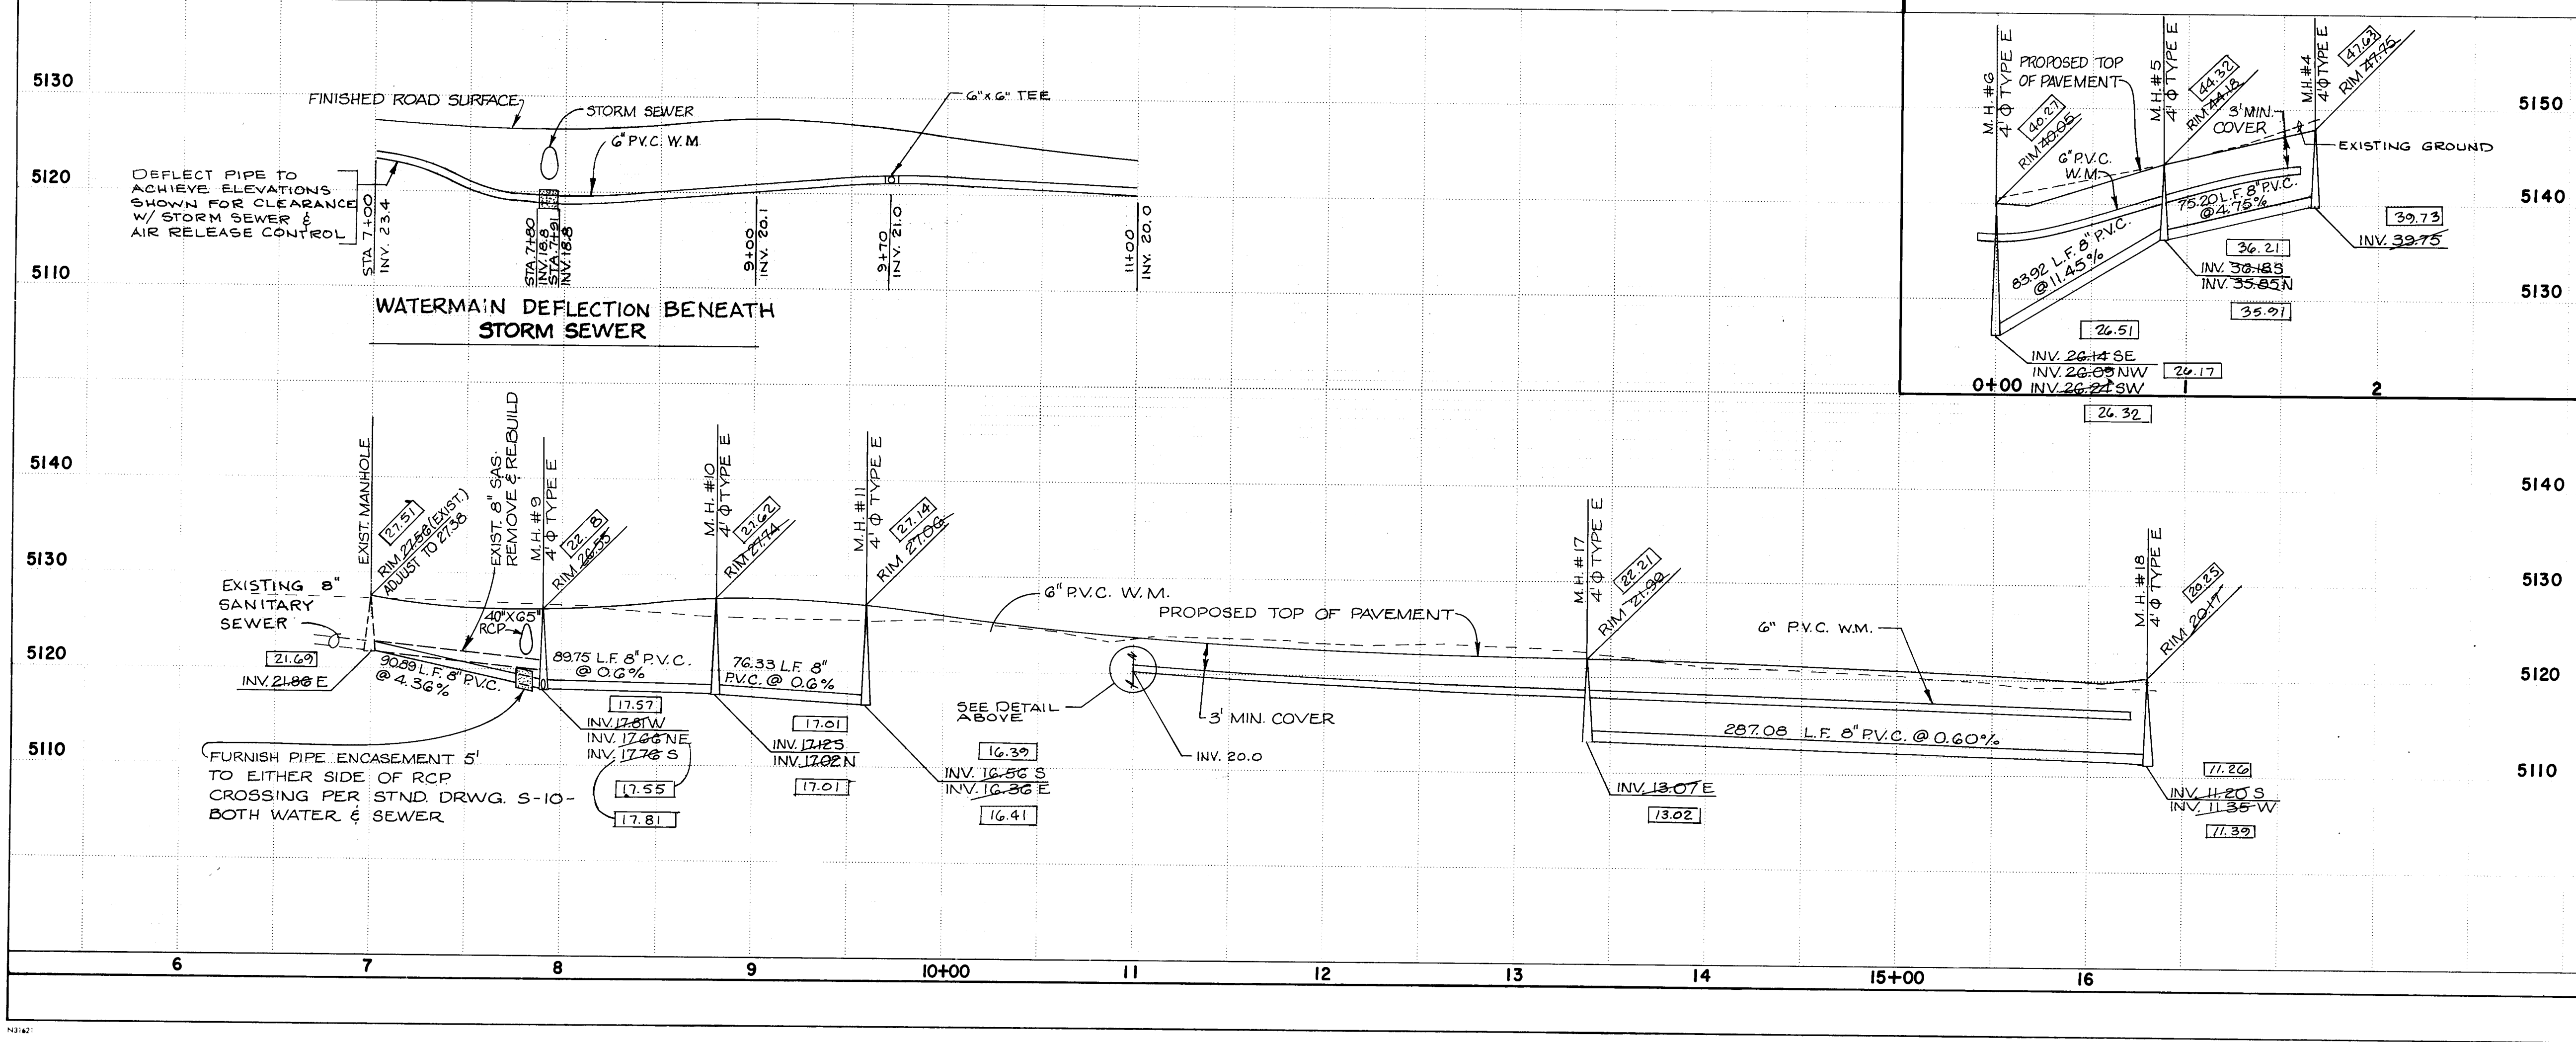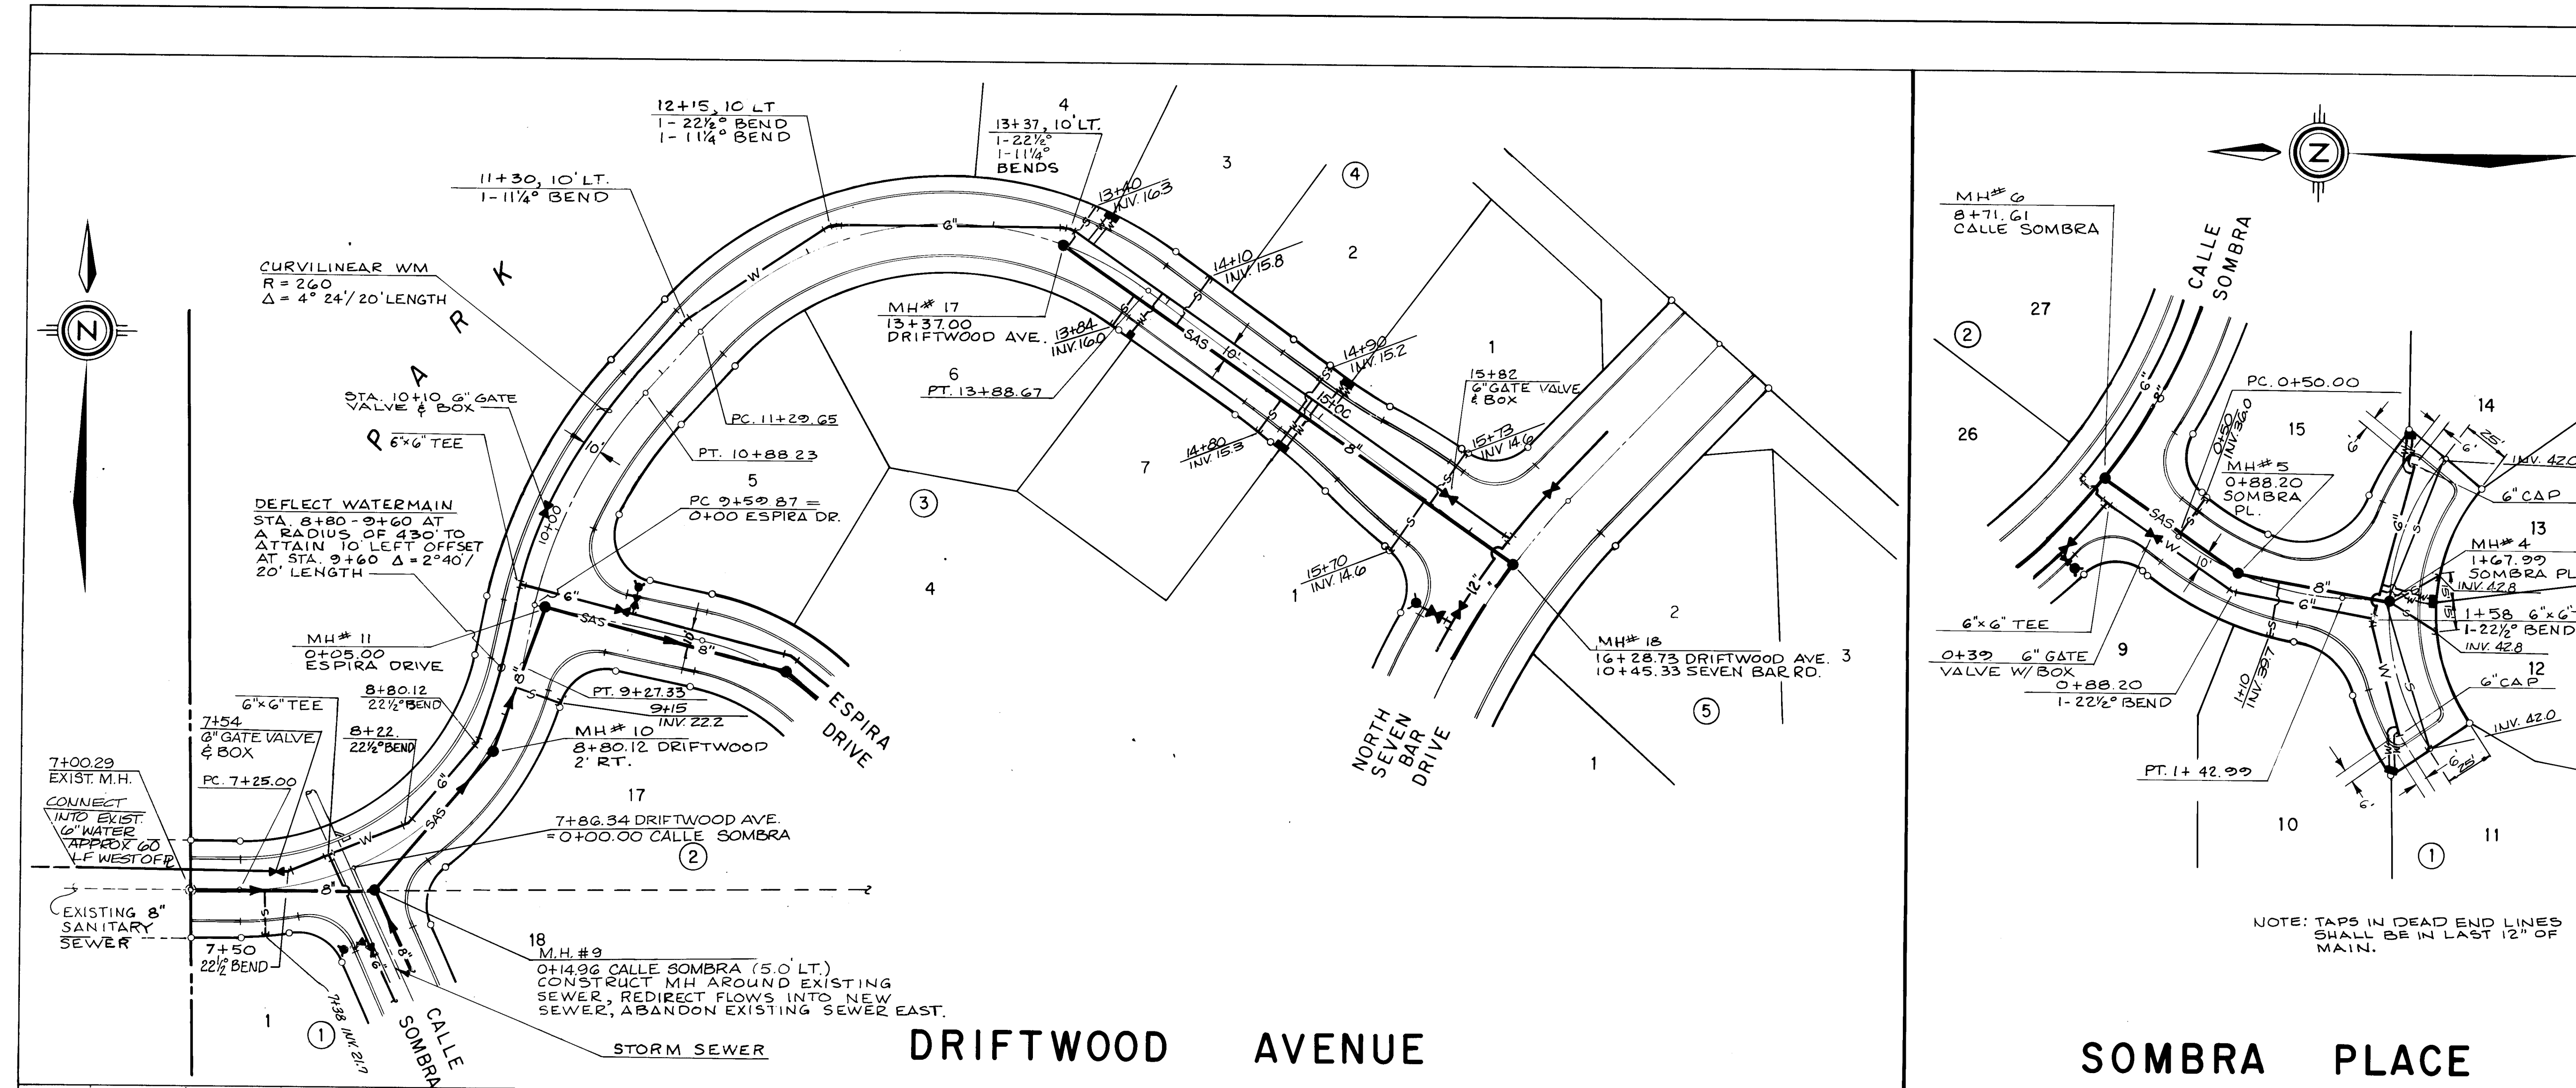

AS BUILT

Karl M. Wilson
9/12/85

NOTE: THIS CERTIFICATION IS INTENDED TO INDICATE THAT IN THE ENGINEER'S OPINION, THIS CONSTRUCTION IS IN SUBSTANTIAL COMPLIANCE WITH THE DESIGN AS SHOWN (OR AS ANNOTATED WITH UPDATED FIELD GRADES WHERE INDICATED). IT IS NOT A VERIFICATION OF CONTRACT COMPLIANCE IN THE LEVEL OF DETAIL ASSOCIATED WITH FULL CONSTRUCTION INSPECTION OF THE PROJECT.

ENGINEER'S SEAL			REVISIONS			BY			DATE		
			DESIGN			DATE			DATE		
			NO			DATE			DATE		
			DESIGNED BY			K.M.W.			DATE 11-83		
			DRAWN BY			R.D.Q.			DATE 11-83		
			CHECKED BY			K.M.W.			DATE 11-83		

CITY OF ALBUQUERQUE
MUNICIPAL DEVELOPMENT DEPARTMENT
ENGINEERING DIVISION

TITLE: SALIDA DEL SOL-UNIT ONE-UTILITY PLAN & PROFILE


DRIFTWOOD AVENUE SOMBRA PLACE

APPROVALS	ENGINEER	DATE	APPROVALS	ENGINEER	DATE
City Engineer	<i>Karl M. Wilson</i>	9/12/85	Liquid Waste		
A.C.E.-Design	<i>Karl M. Wilson</i>	9/12/85	Traffic	<i>W.B.</i>	2/28/84
A.C.E.-Hydrology	<i>Karl M. Wilson</i>	9/12/85	Water Res	<i>W.B.</i>	2-8-84


DRAWING NO. 1869

MAP NO. A-13

SHEET 25 OF 40


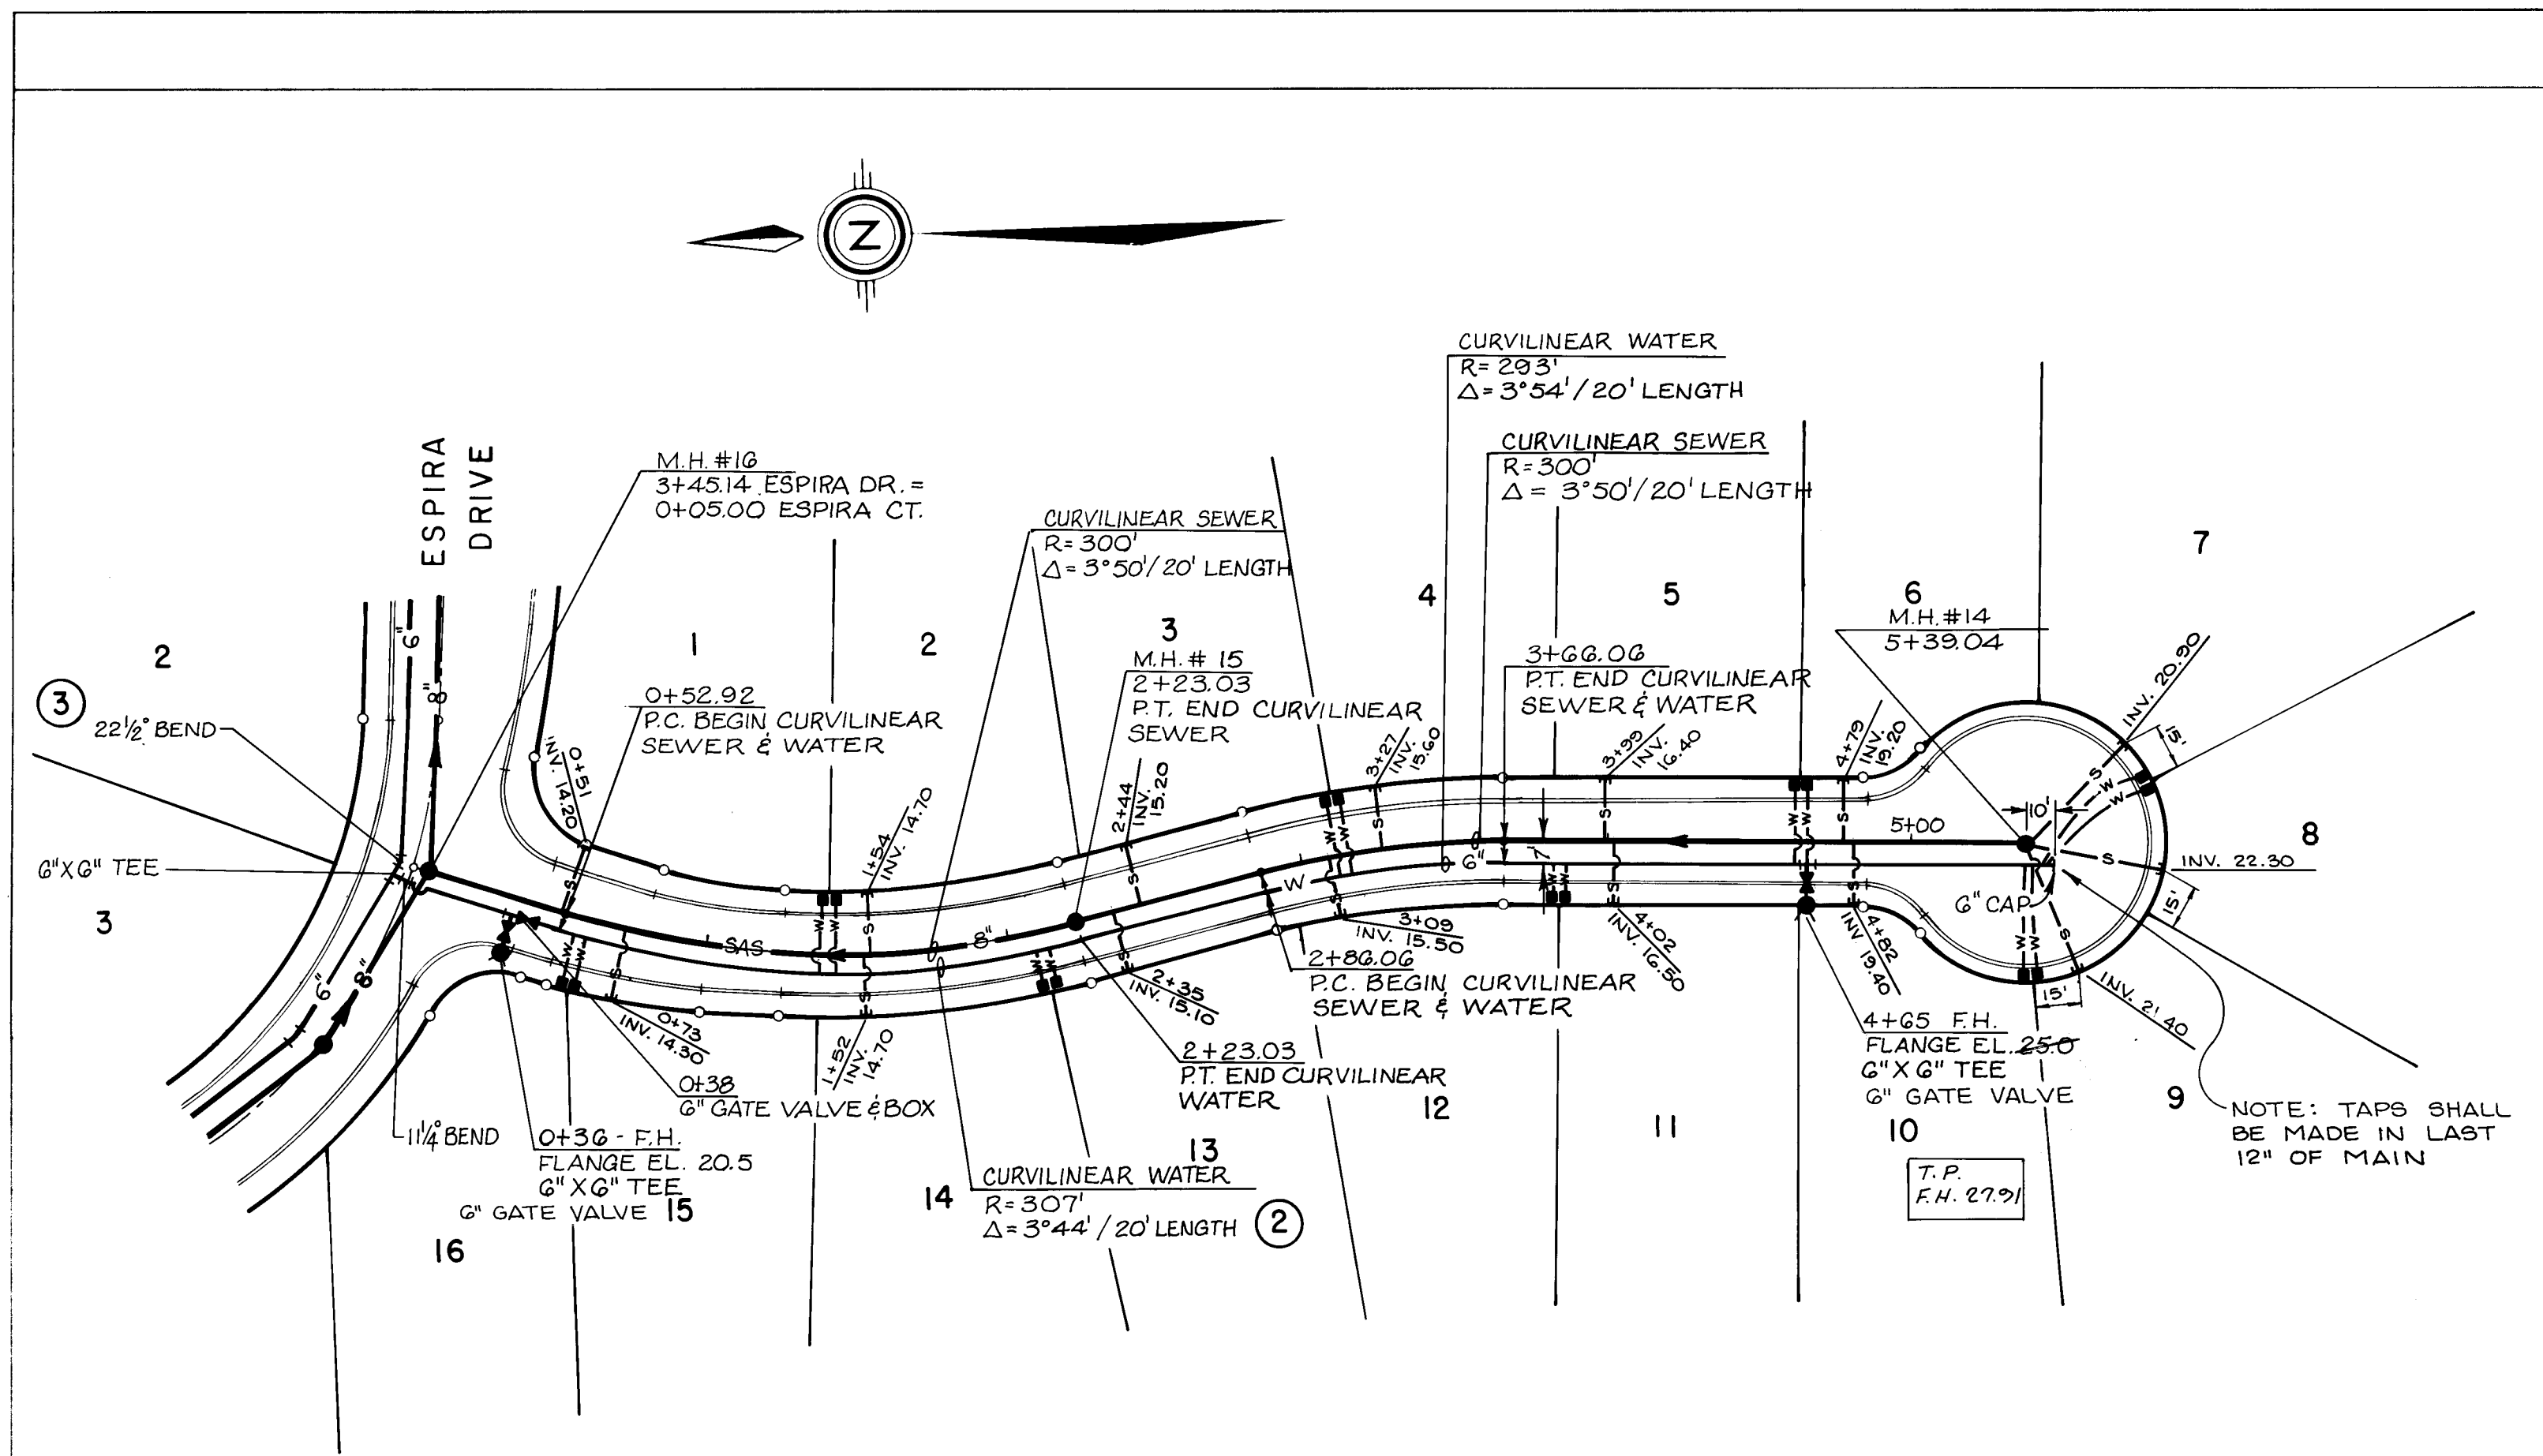


ESPIRA COURT

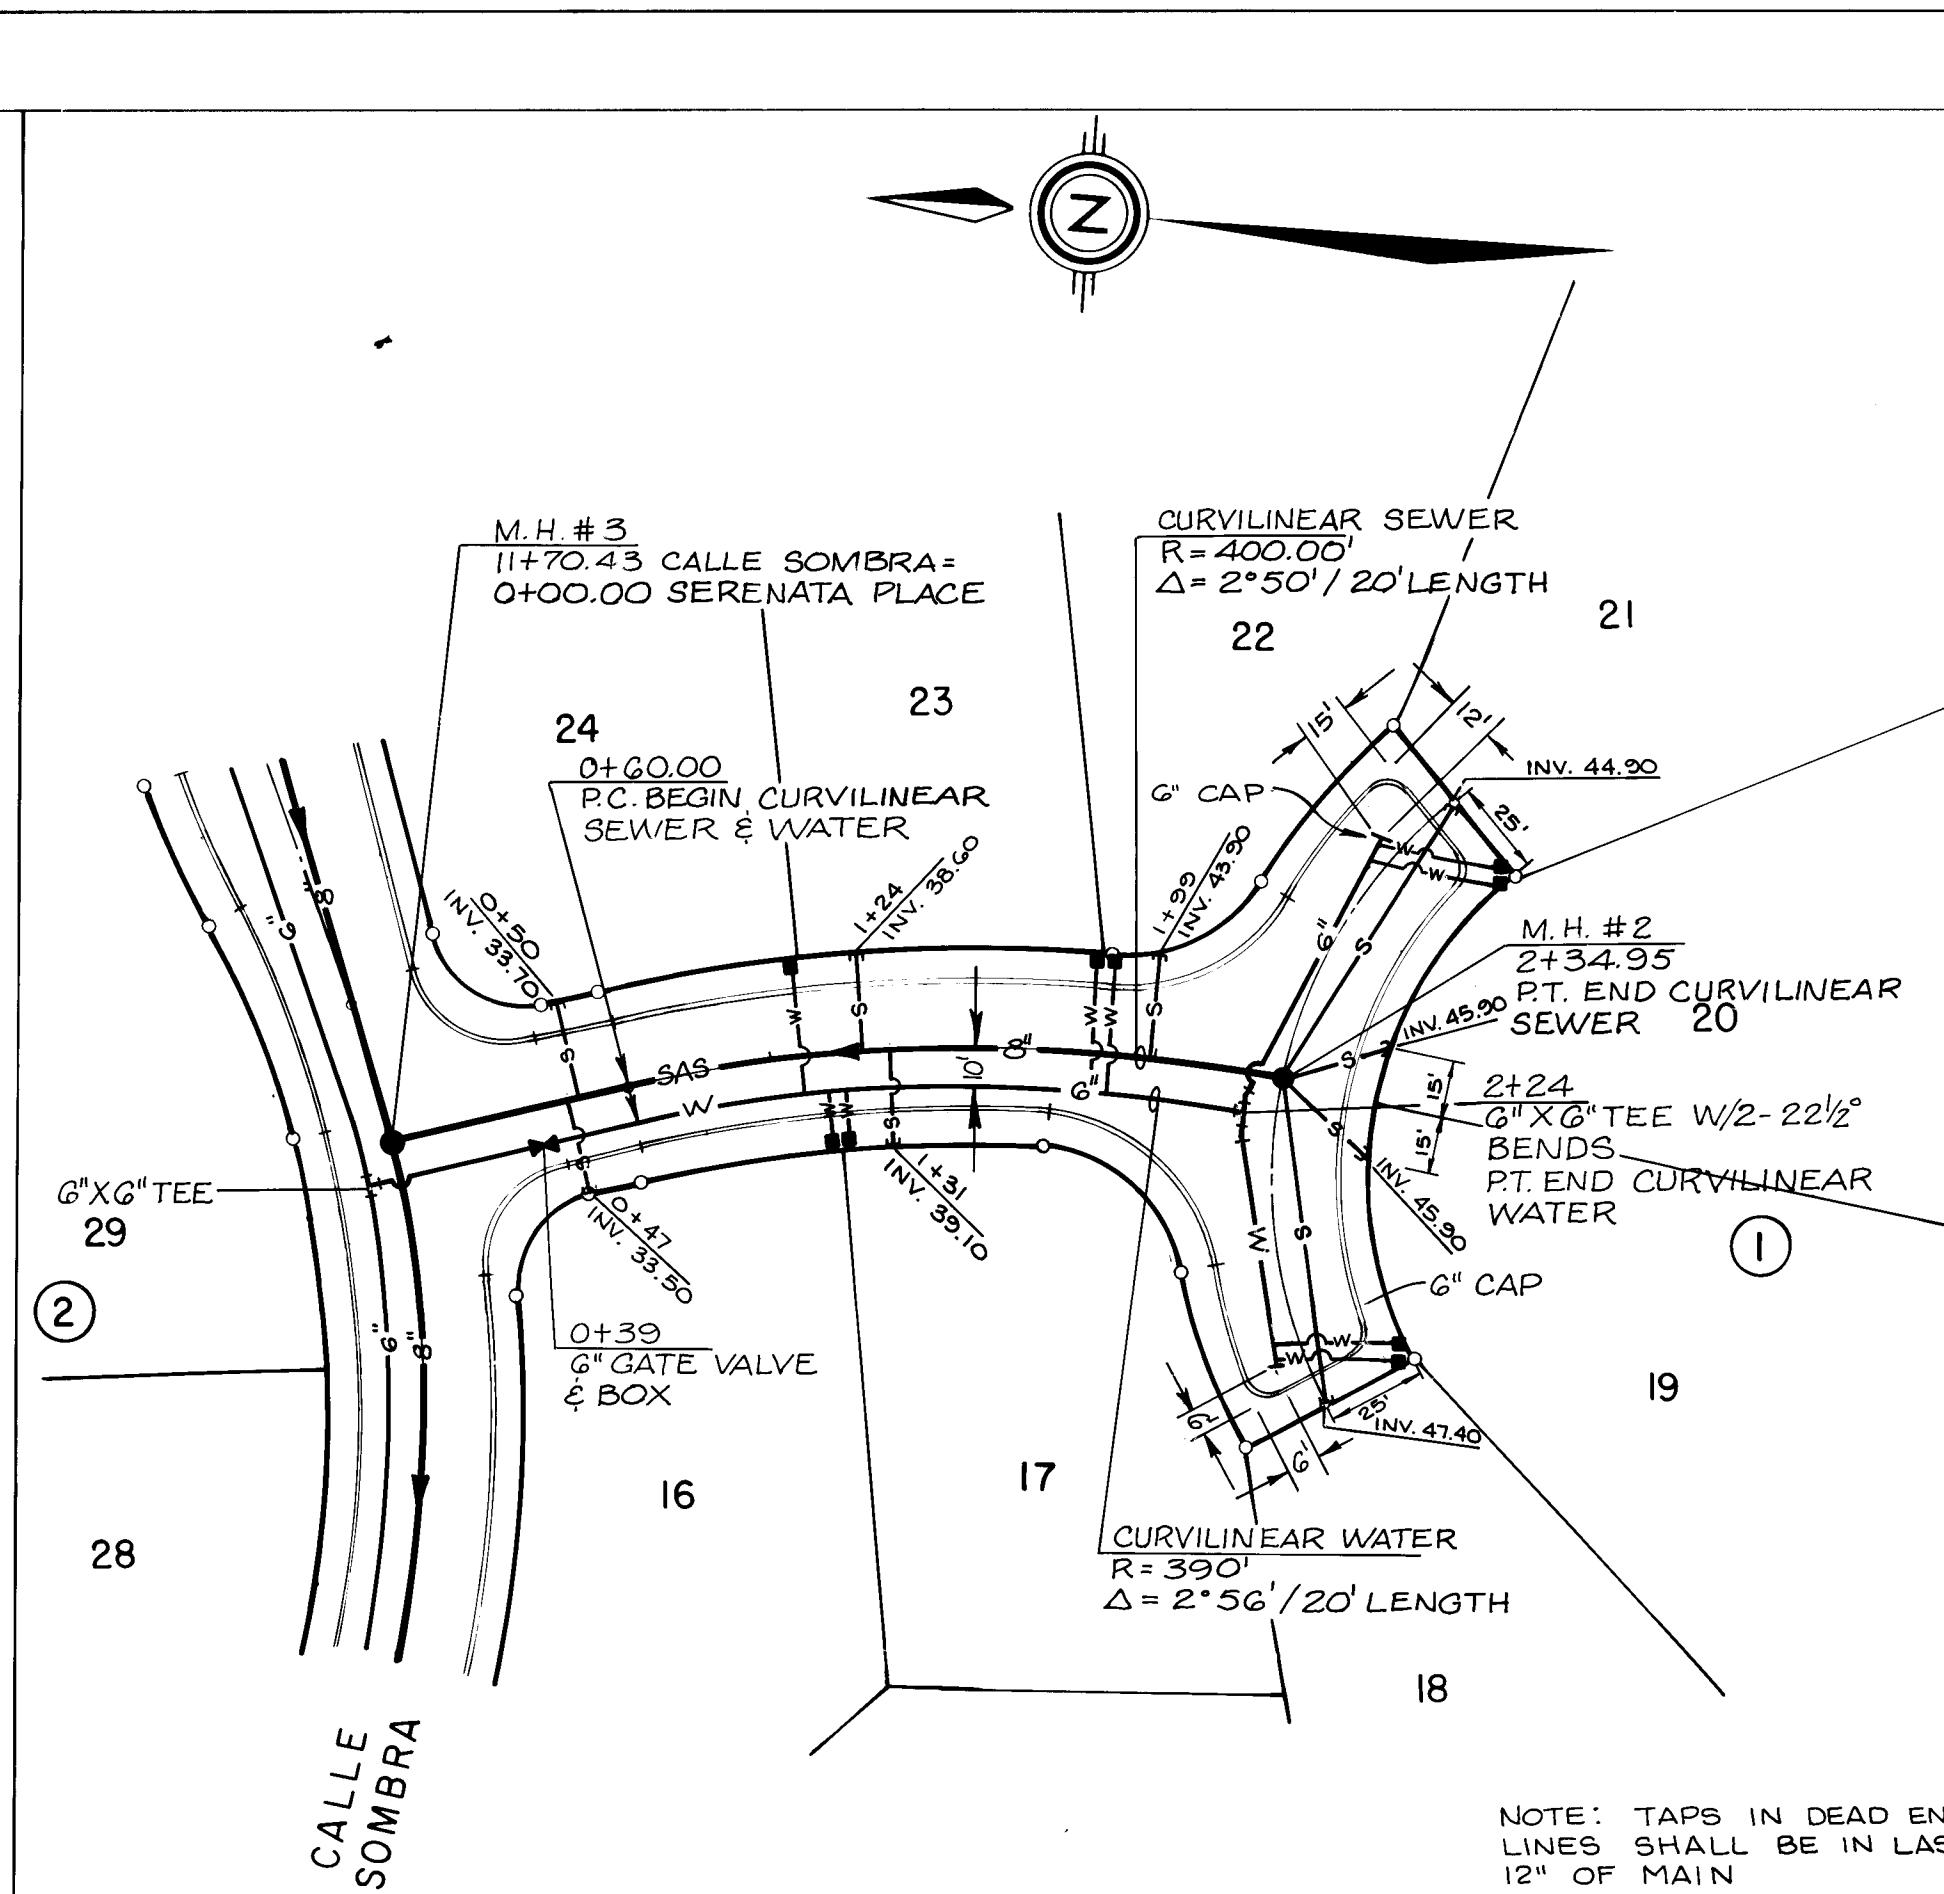

SERENATA PLACE

SCALE: 1" = 50' HOR.
1" = 10' VERT.

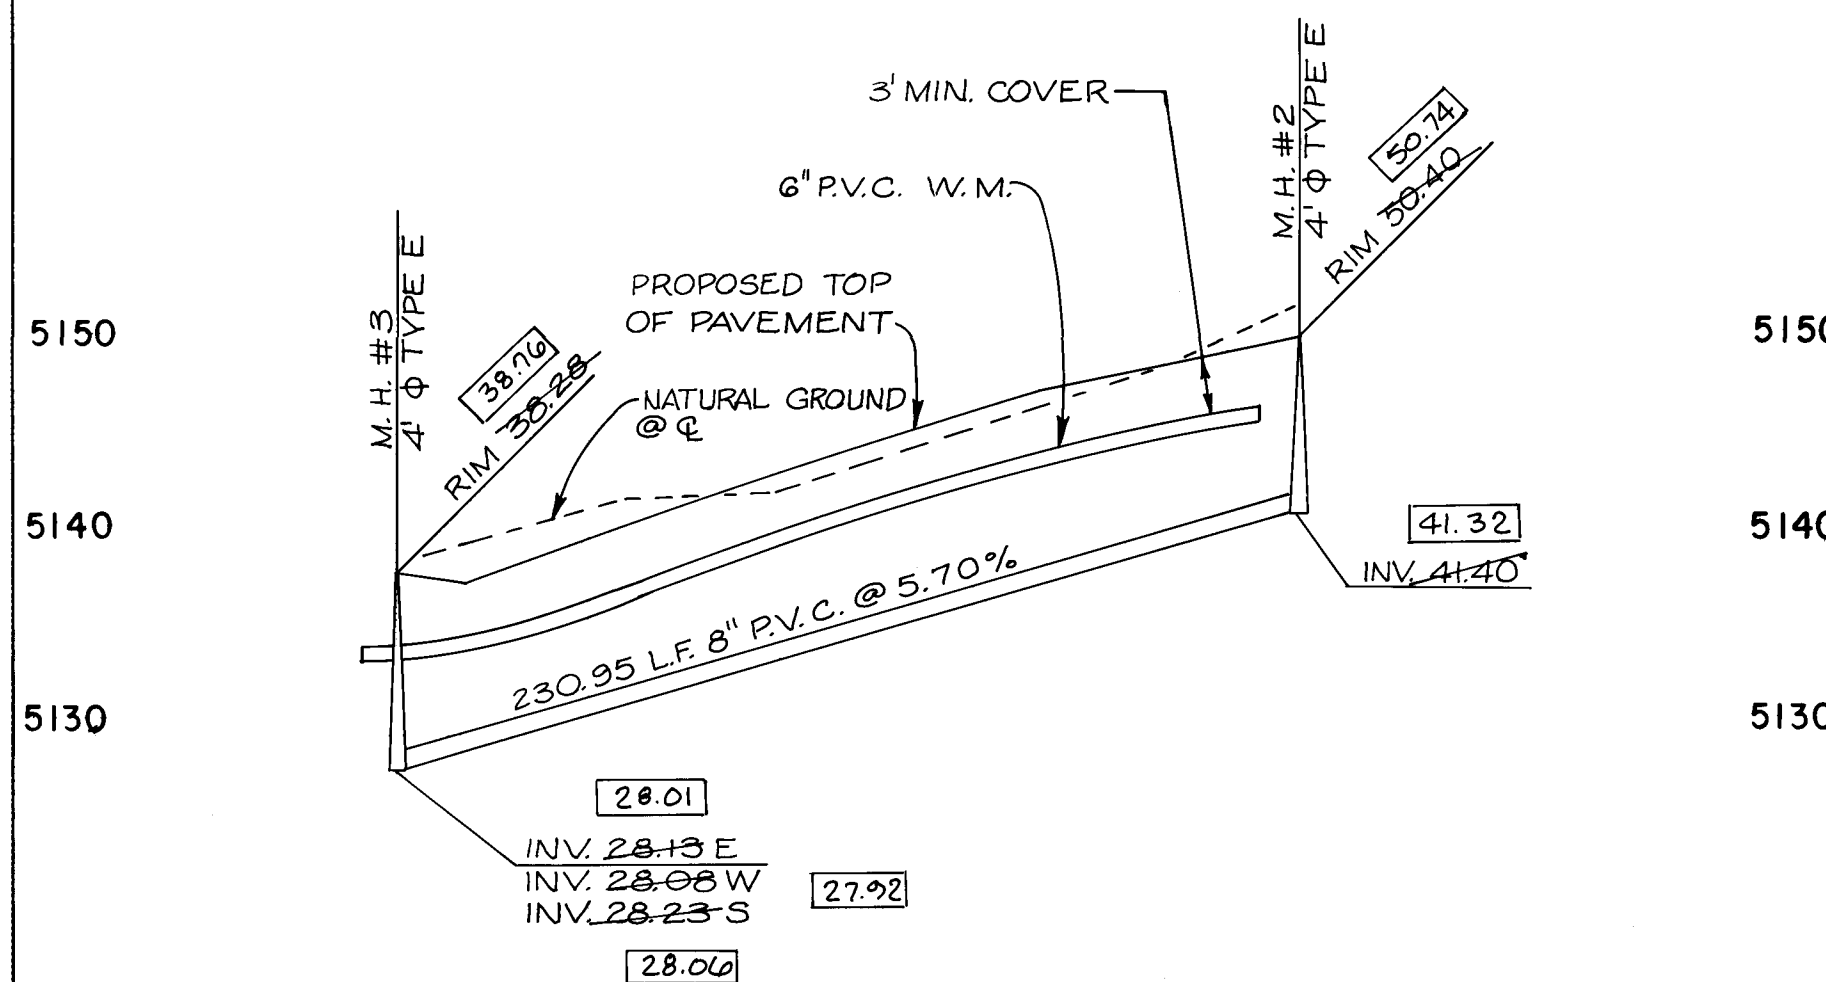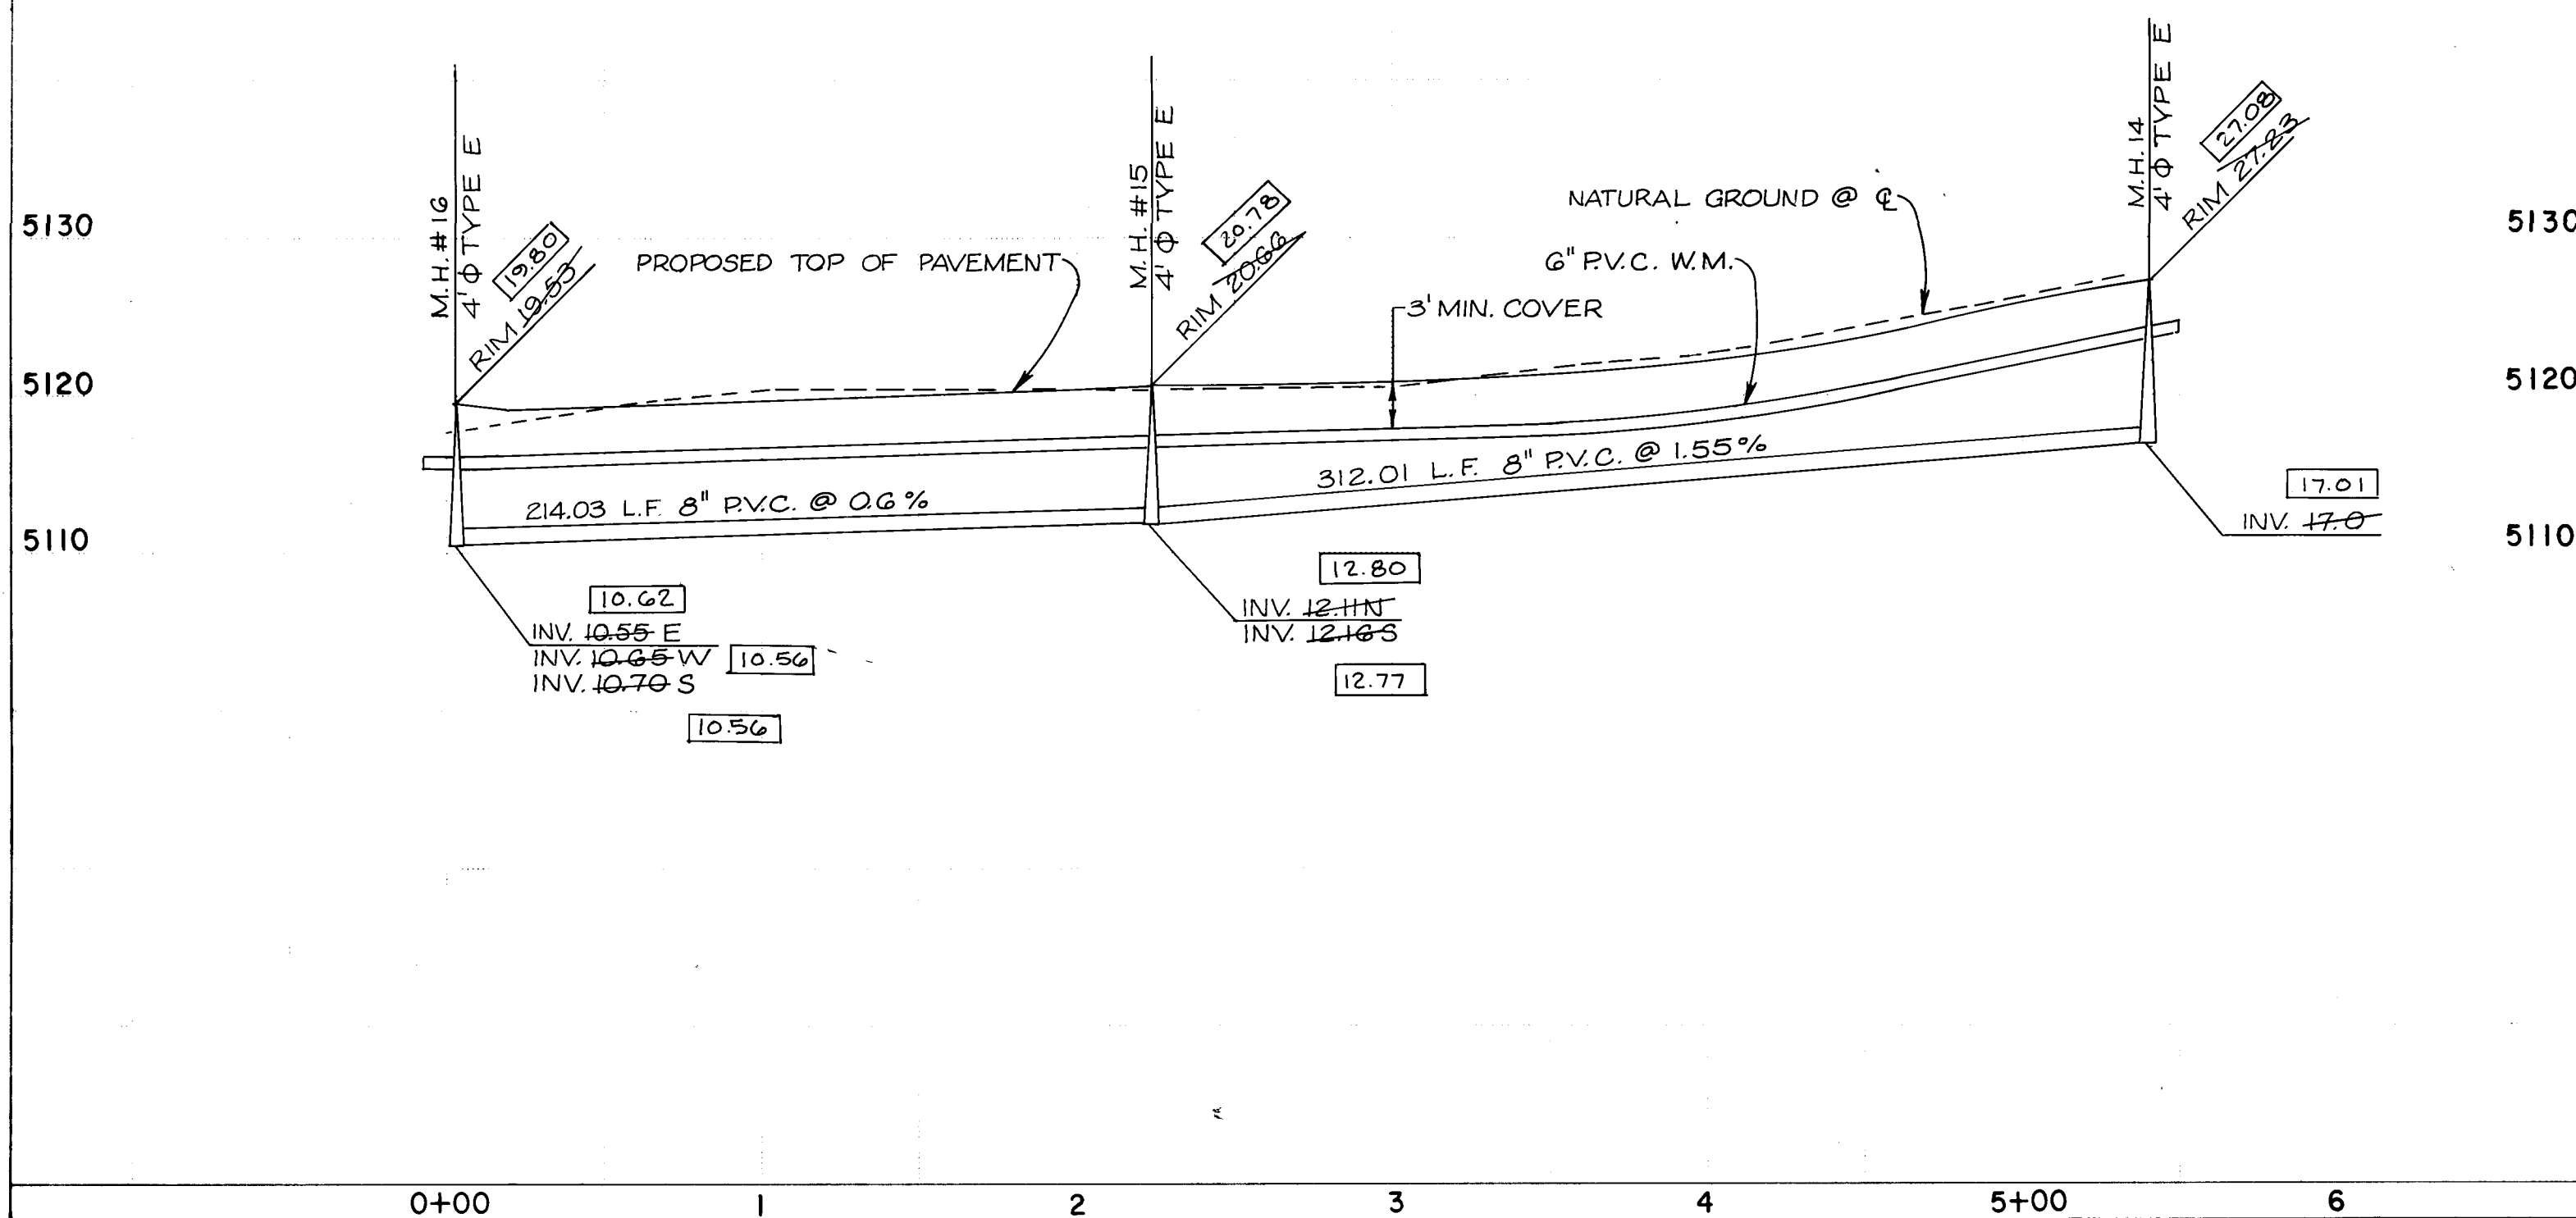

AS BUILT

11/4/85





NOTE: THIS CERTIFICATION IS INTENDED TO INDICATE THAT IN THE ENGINEER'S OPINION THIS CONSTRUCTION IS IN SUBSTANTIAL COMPLIANCE WITH THE DESIGN AS SHOWN (OR AS ANNOTATED WITH UPDATED FIELD GRADES WHERE INDICATED). IT IS NOT A VERIFICATION OF CONTRACT COMPLIANCE IN THE LEVEL OF DETAIL ASSOCIATED WITH FULL CONSTRUCTION INSPECTION OF THE PROJECT.

NOTE:
The water line and sanitary sewer line are to belong to New Mexico Utility Company Systems, not City of Albuquerque

26 18692786

CITY OF ALBUQUERQUE MUNICIPAL DEVELOPMENT DEPARTMENT ENGINEERING DIVISION			
TITLE SALI'IA DEL SOL - UNIT ONE UTILITY PLAN & PROFILE ESPIRA COURT / SERENATA PLACE			
APPROVALS	ENGINEER	DATE	APPROVALS
City Engineer	<i>[Signature]</i>	11/1/84	City Engineer
ACE Design	<i>[Signature]</i>	11/1/84	ACE Design
ACE Hydrology	<i>[Signature]</i>	11/1/84	ACE Hydrology
DESIGNED BY KMW, LLL		DATE 11-83	DRAWN BY JWB, MKS
CHECKED BY		DATE	
REVISIONS		BY	DATE
NO.		DATE	DATE

DRAWING NO.	MAP NO.	SHEET	OF
1869	A-13	27	40

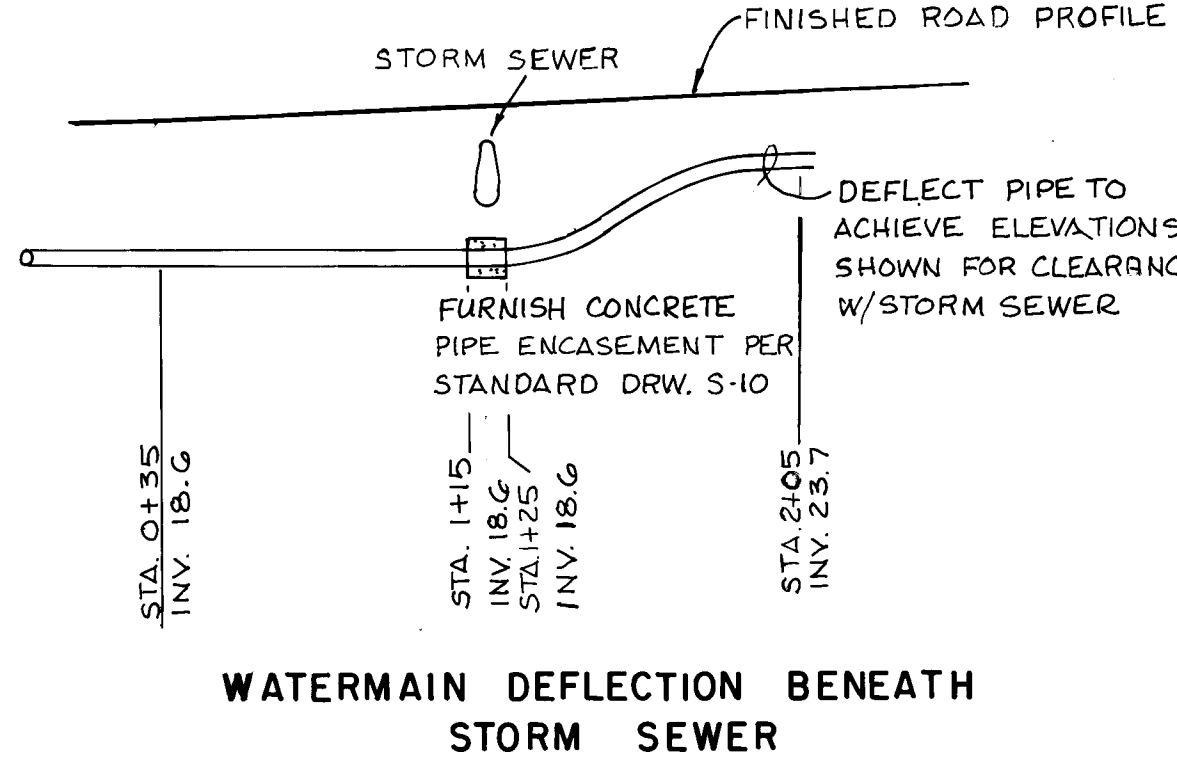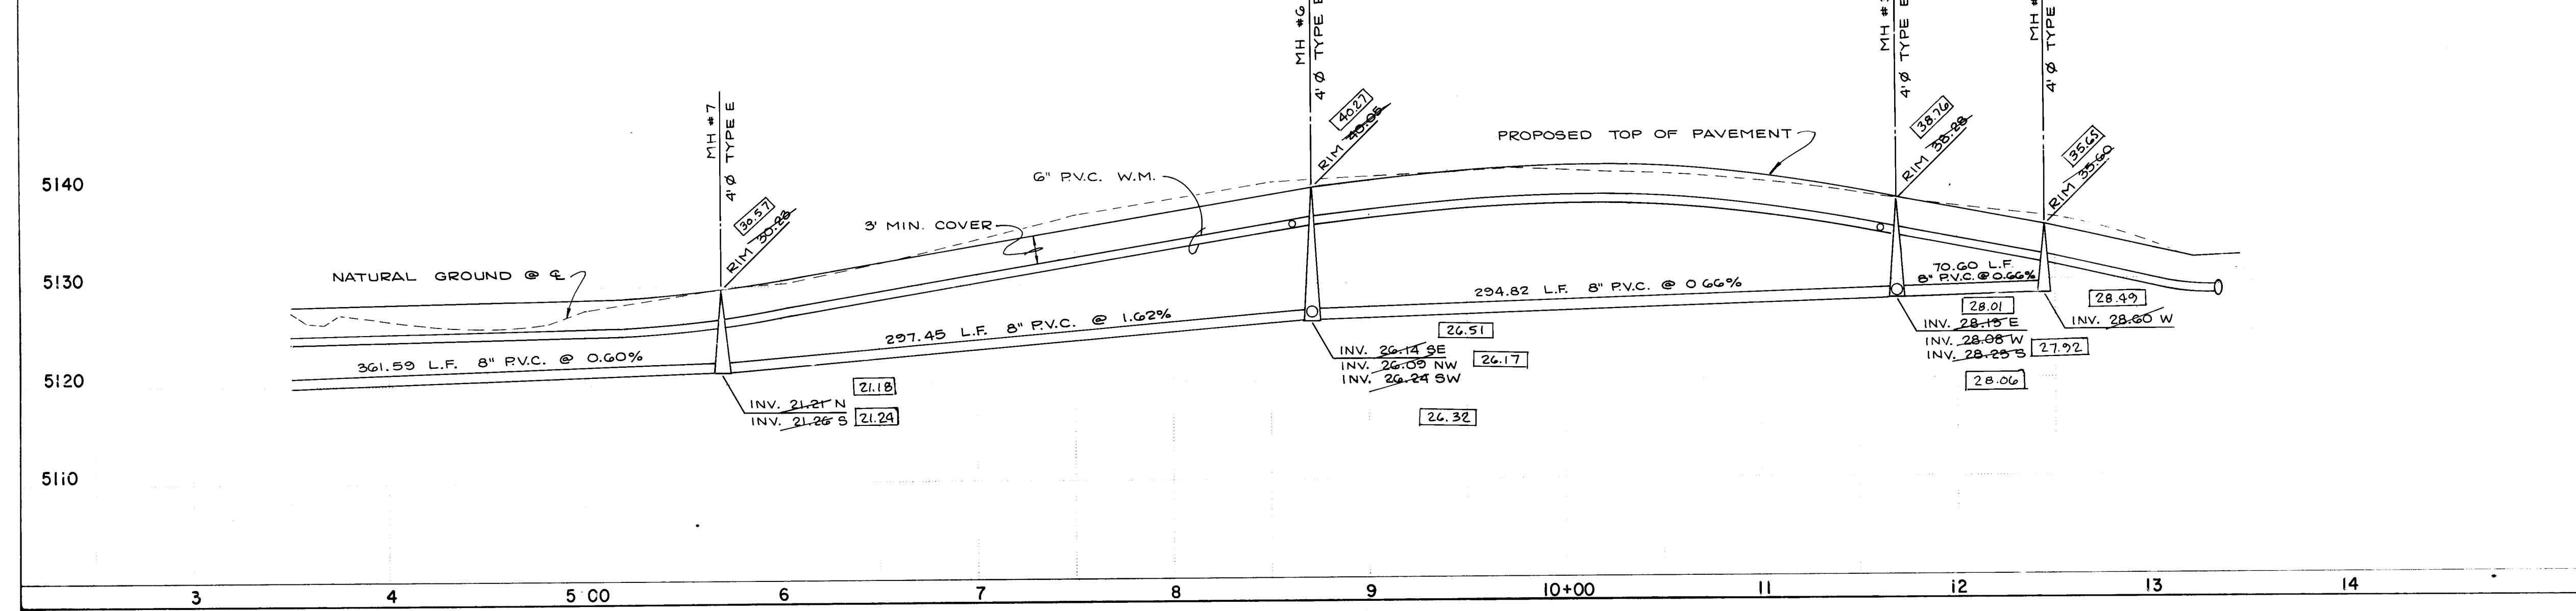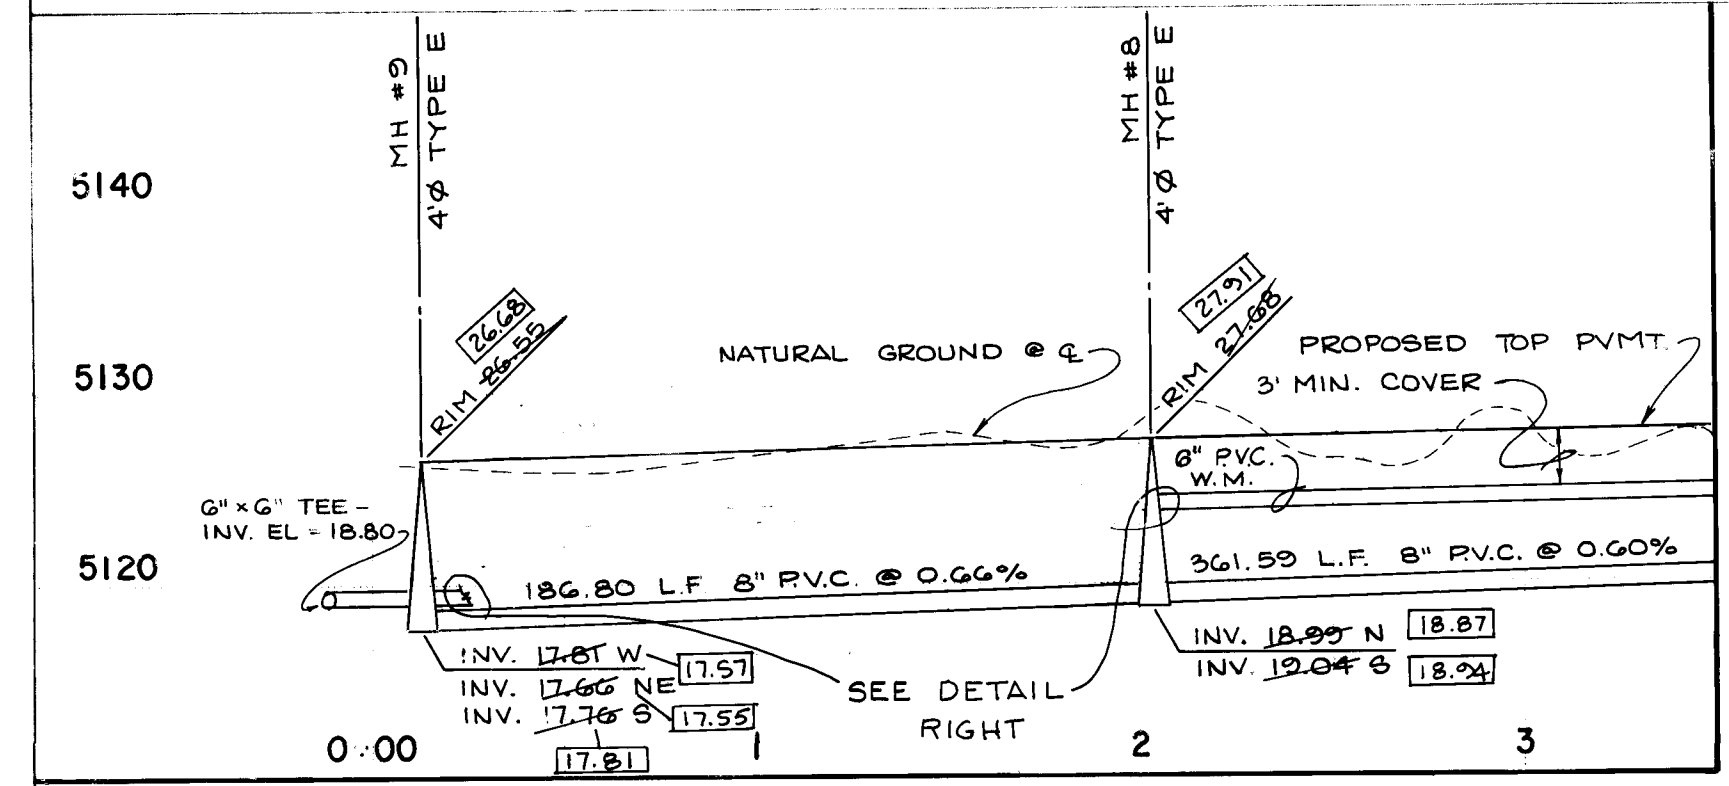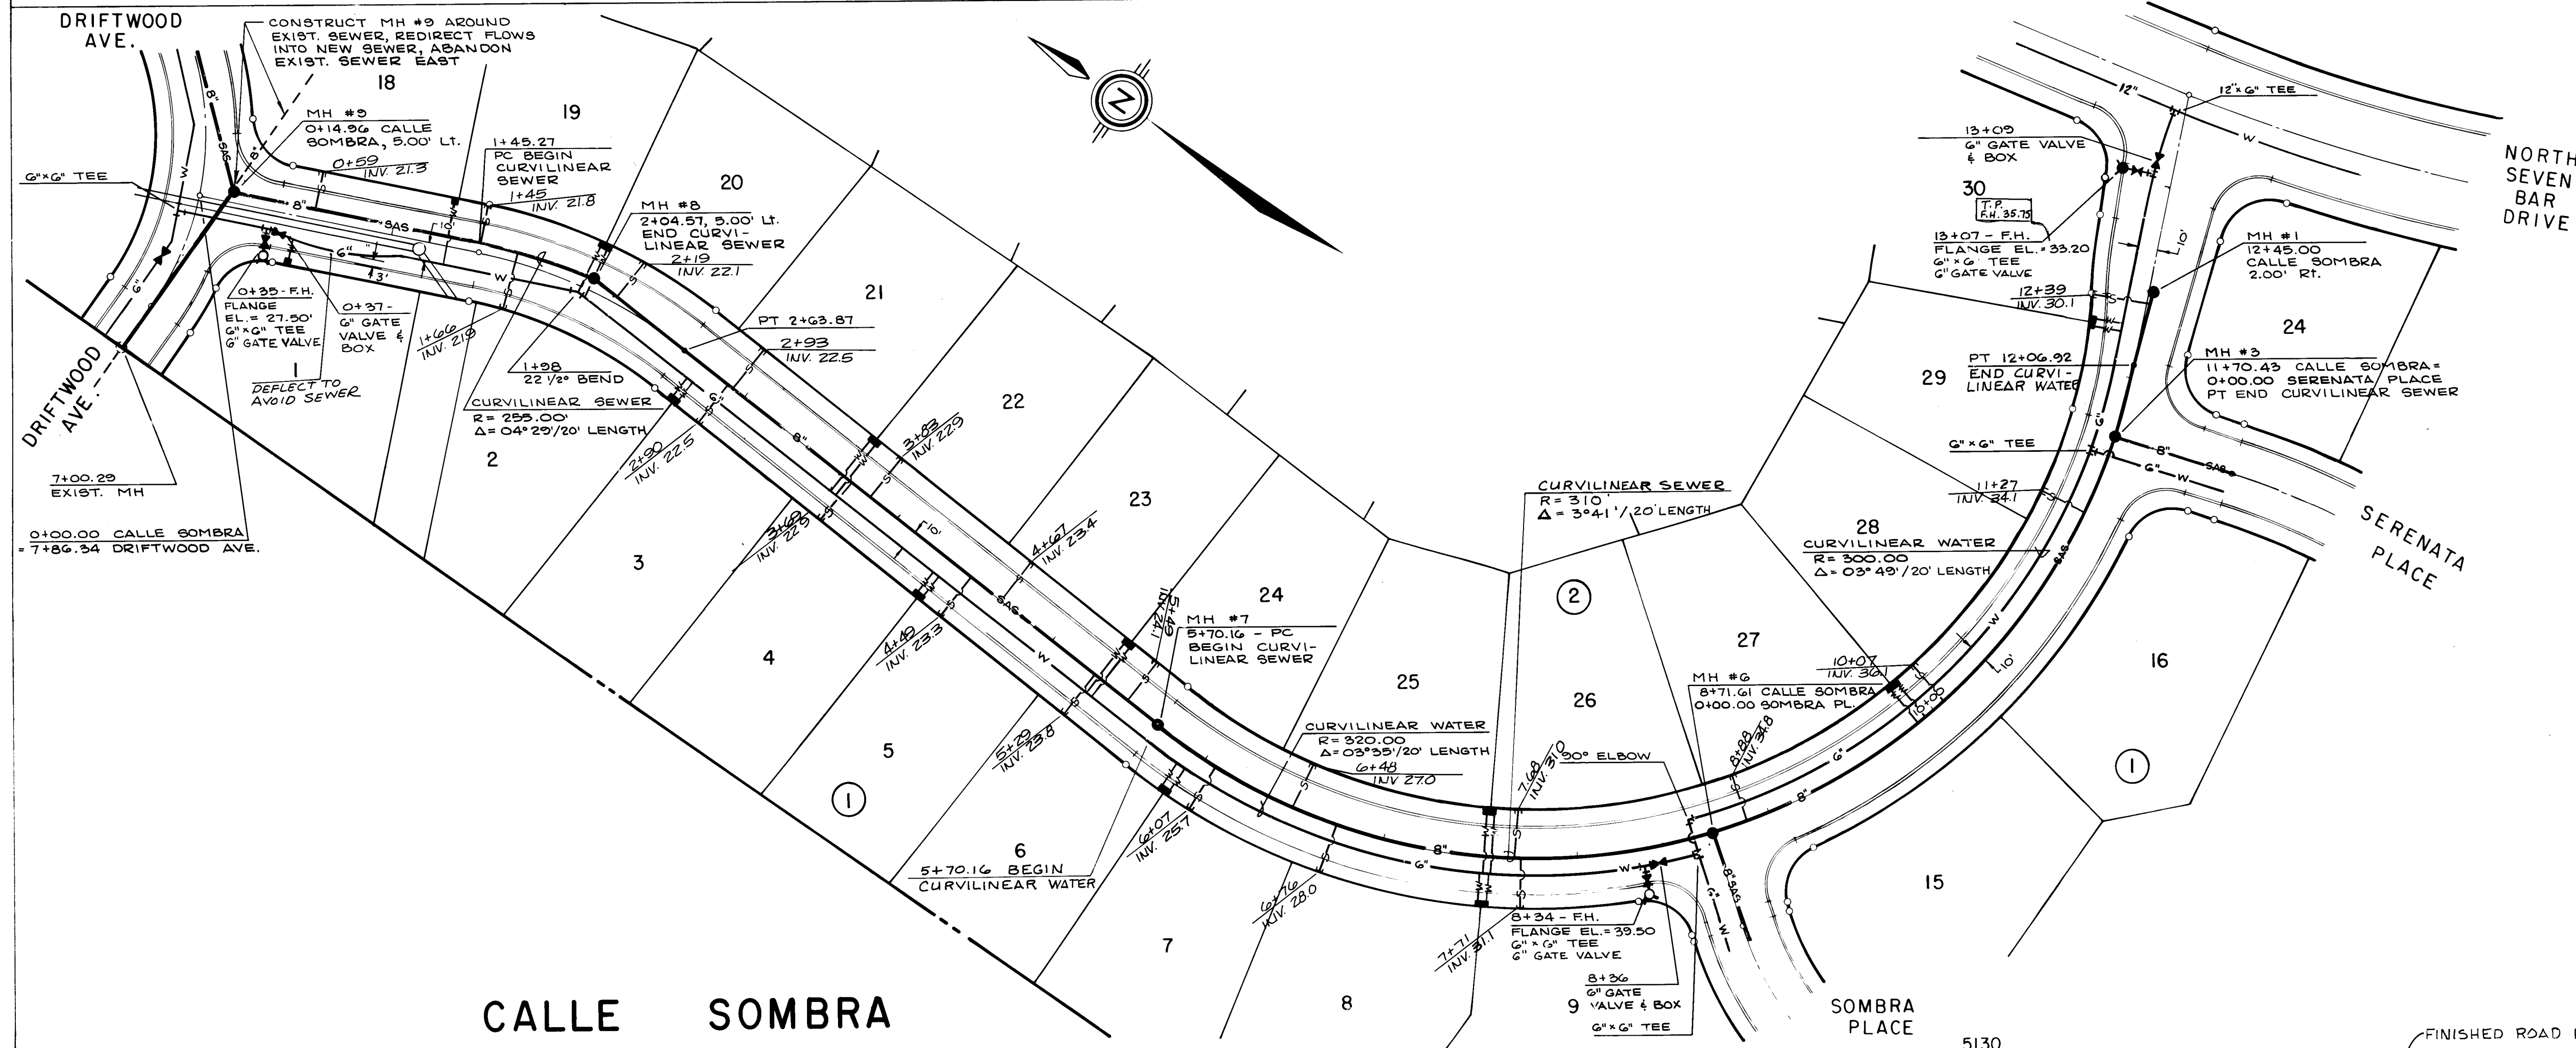

AS BUILT

11/4/85

NOTE: THIS CERTIFICATION IS INTENDED TO INDICATE THAT IN THE ENGINEER'S OPINION THIS CONSTRUCTION IS IN SUBSTANTIAL COMPLIANCE WITH THE DESIGN AS SHOWN FOR AS ANNOTATED WITH UPDATED FIELD NOTES WHERE INDICATED. IT IS NOT A VERIFICATION OF CONTRACT COMPLIANCE IN THE LEVEL OF DETAIL ASSOCIATED WITH FULL CONSTRUCTION INSPECTION OF THE PROJECT.

NOTE:
The waterline and sanitary sewer line are to belong to New Mexico Utility Company, not City of Albuquerque.


26 1869 2886
SCALE: 1" = 50' Horizontal
1" = 10' Vertical

CITY OF ALBUQUERQUE MUNICIPAL DEVELOPMENT DEPARTMENT ENGINEERING DIVISION					
TITLE SALIDA DEL SOL-UNIT ONE-UTILITY PLAN & PROFILE CALLE SOMBRA, N.W.					
APPROVALS	ENGINEER	DATE	APPROVALS	ENGINEER	DATE
City Engineer	<i>C. D. Hays</i>	11/4/85	ACE Design	<i>W. J. Hays</i>	11/4/85
ACE Design	<i>W. J. Hays</i>	11/4/85	ACE Hydrology	<i>W. J. Hays</i>	11/4/85
DRAWING NO 1869 MAP NO A-13 SHEET 28 OF 40					



AS BUILT INFORMATION	
BENCH MARK	DATE
AS BUILT INFORMATION	DATE
AS BUILT INFORMATION	DATE
AS BUILT INFORMATION	DATE
AS BUILT INFORMATION	DATE

ENGINEER'S SEAL	
NO	
11/21/84	

REVISIONS	BY	DATE
DESIGN	KMW, LLL	11-85
CHECKED	MKS	11-85

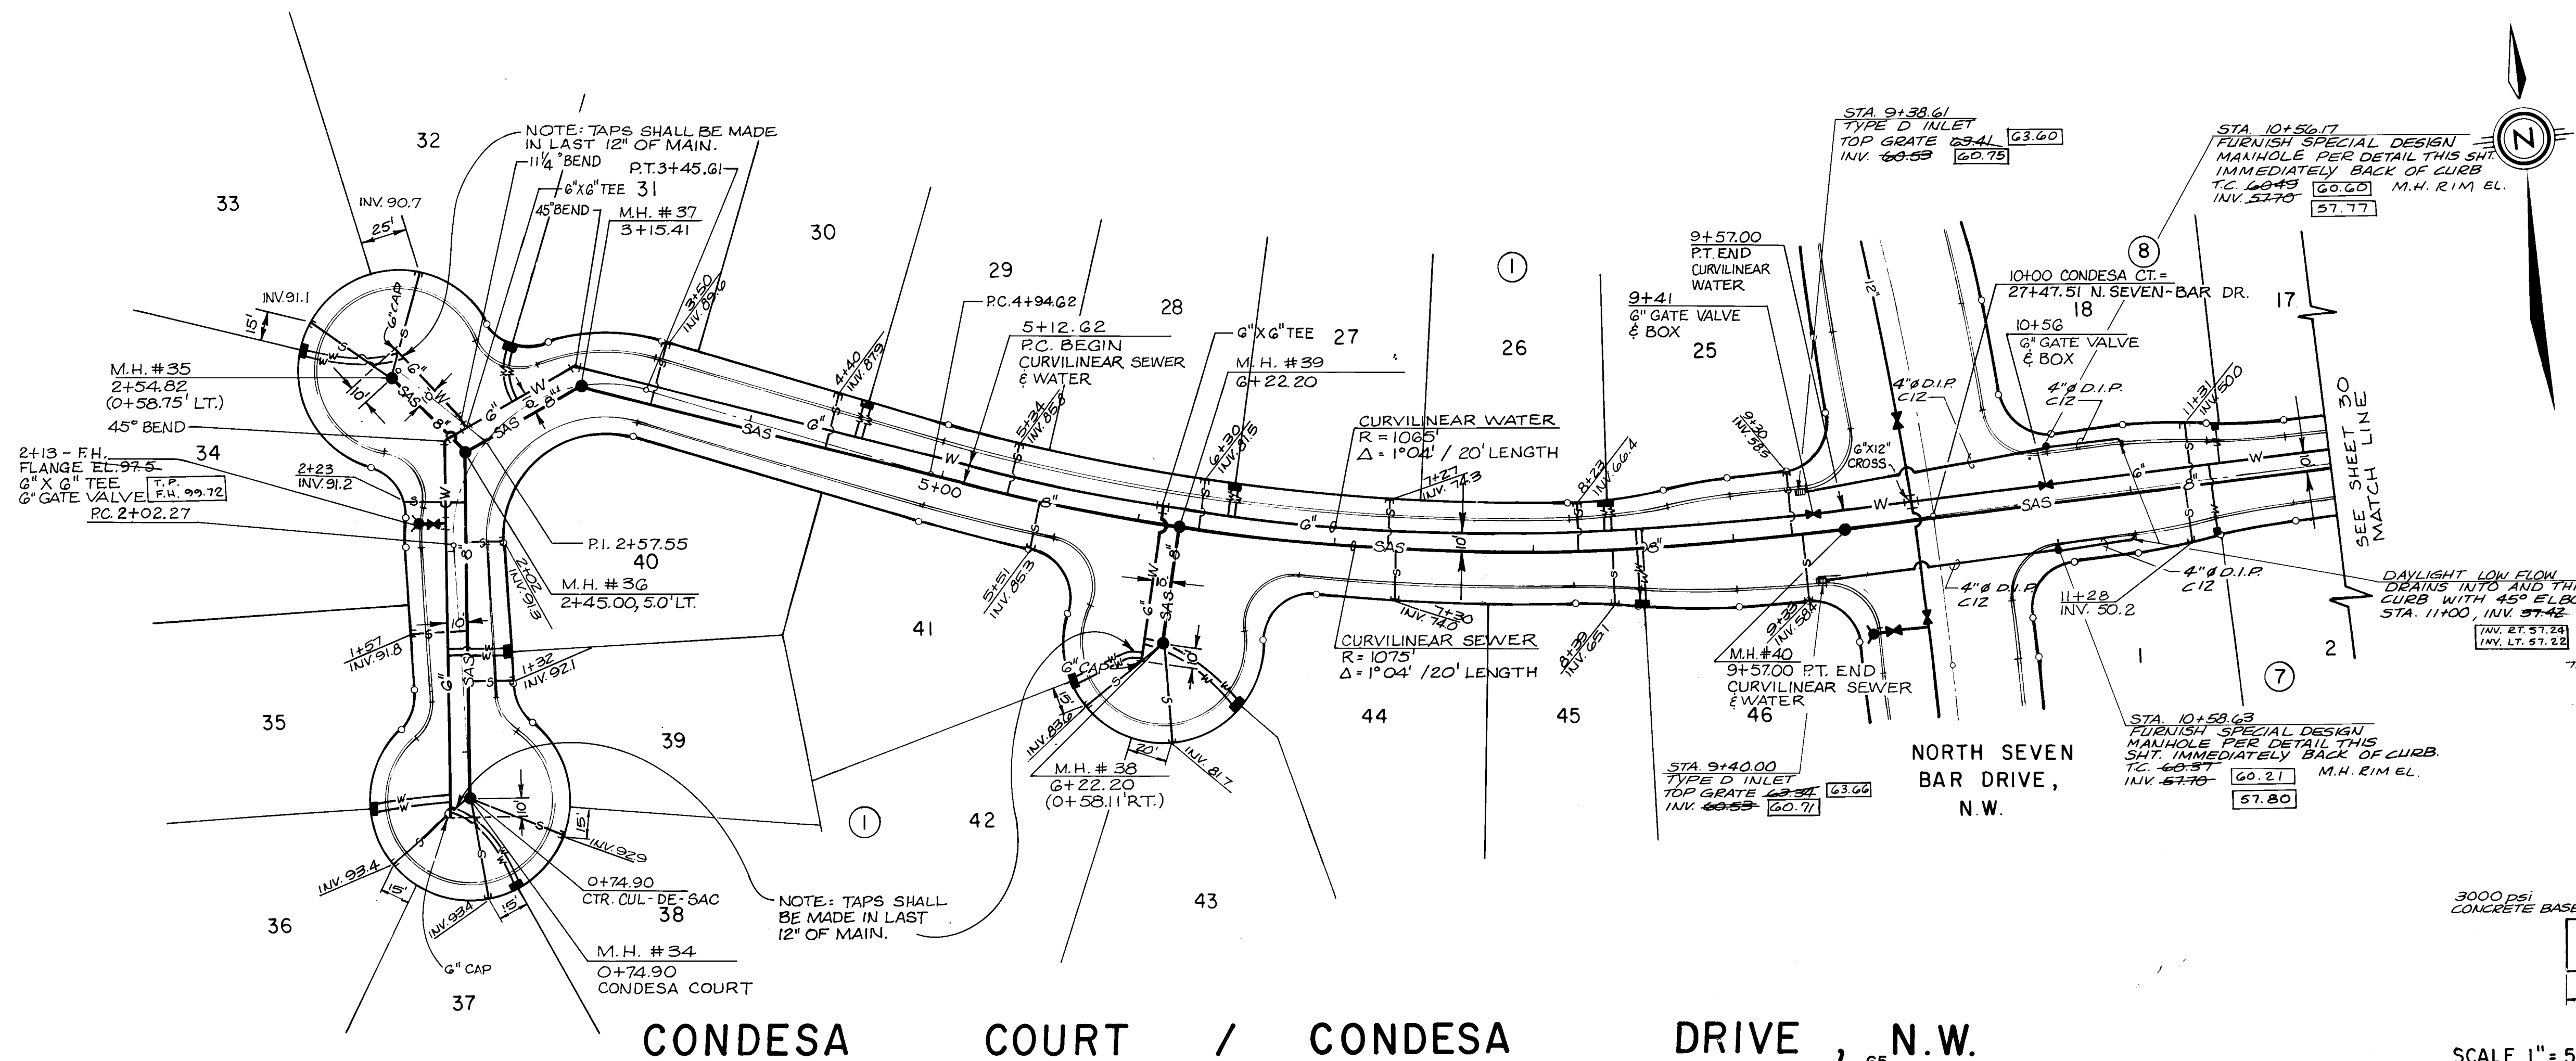

SCALE 1" = 50' HORIZ.
1" = 10' VERT.

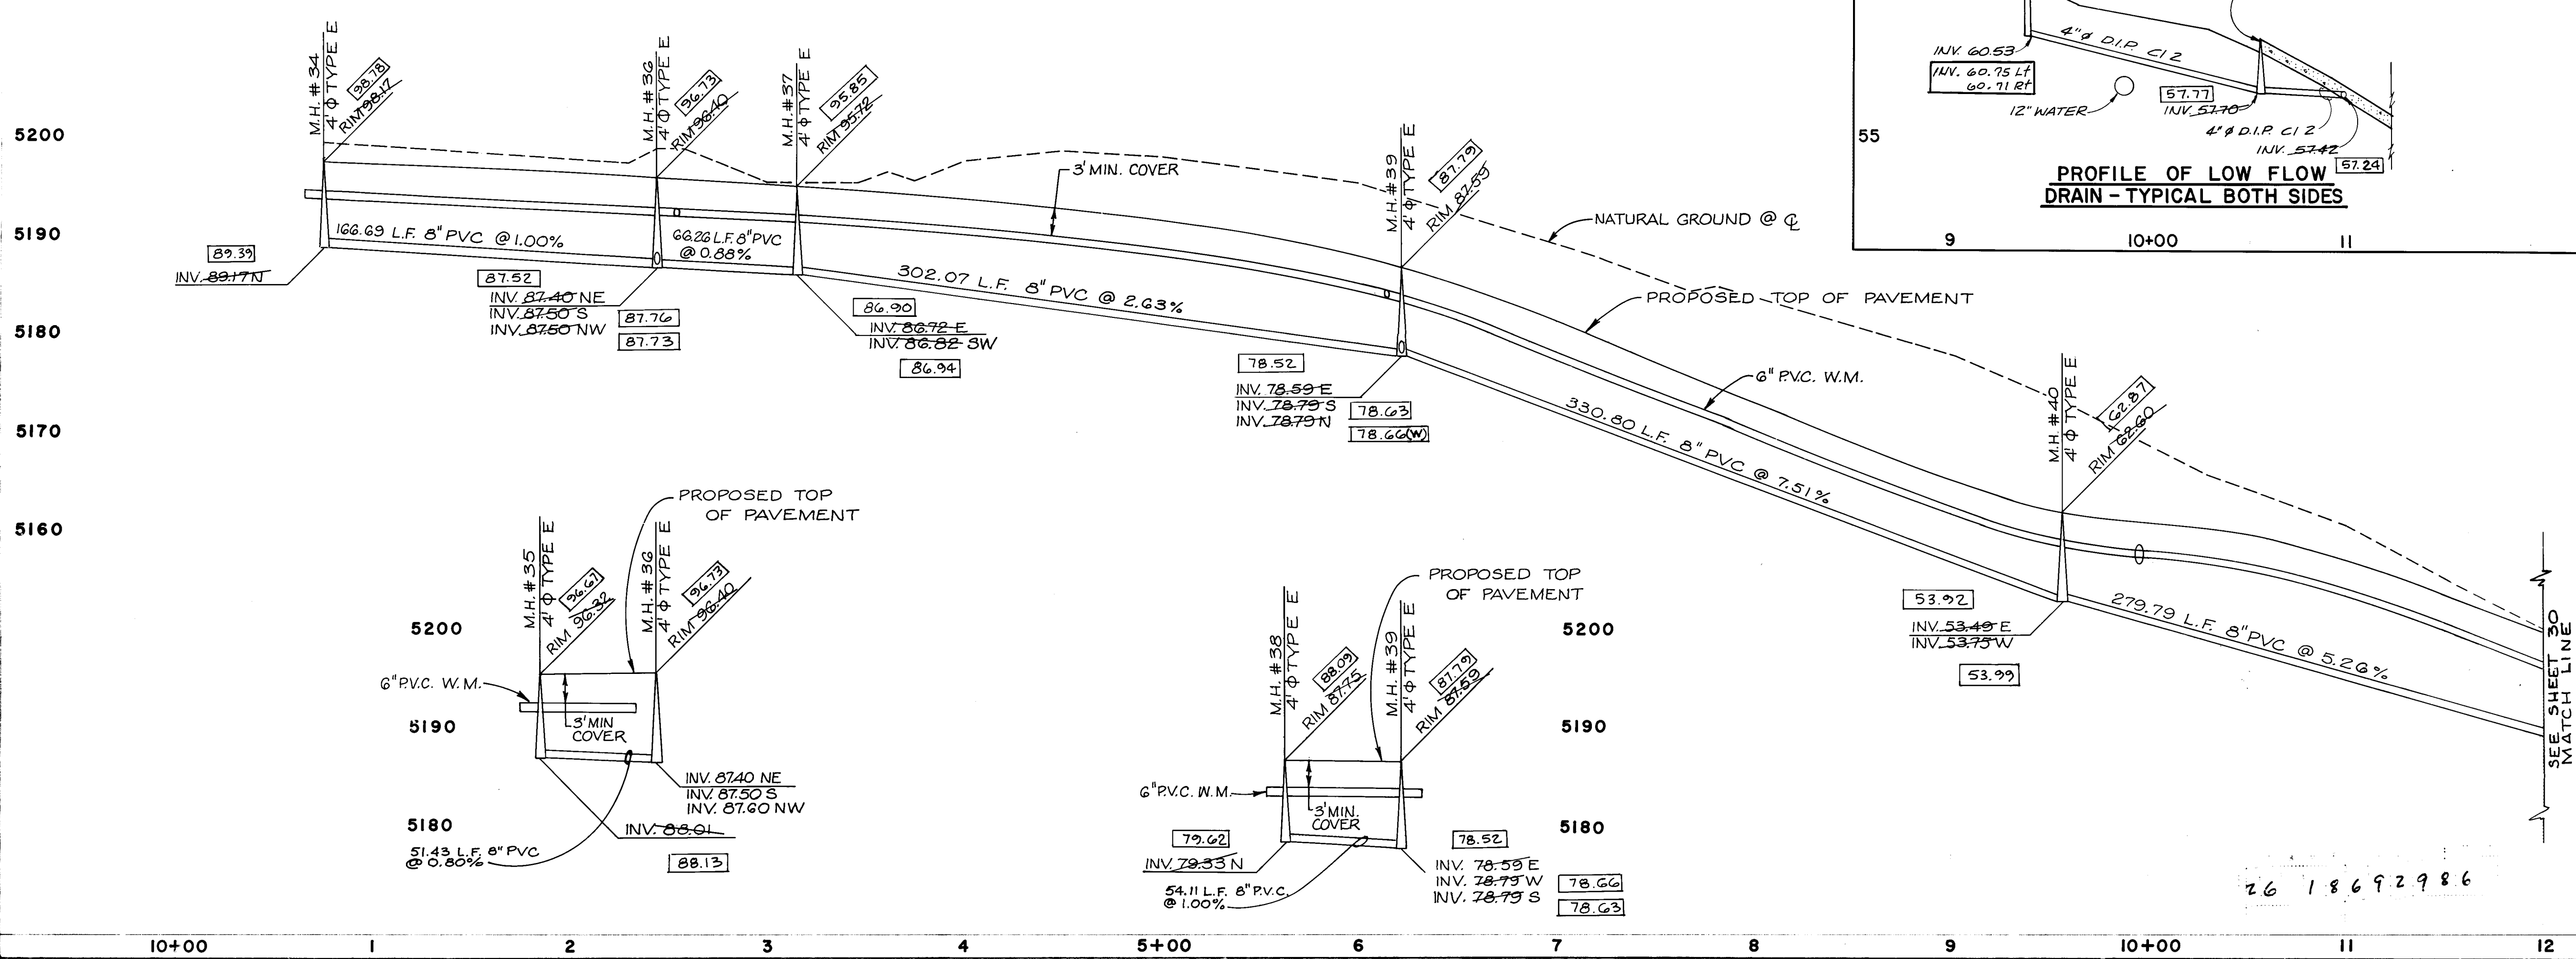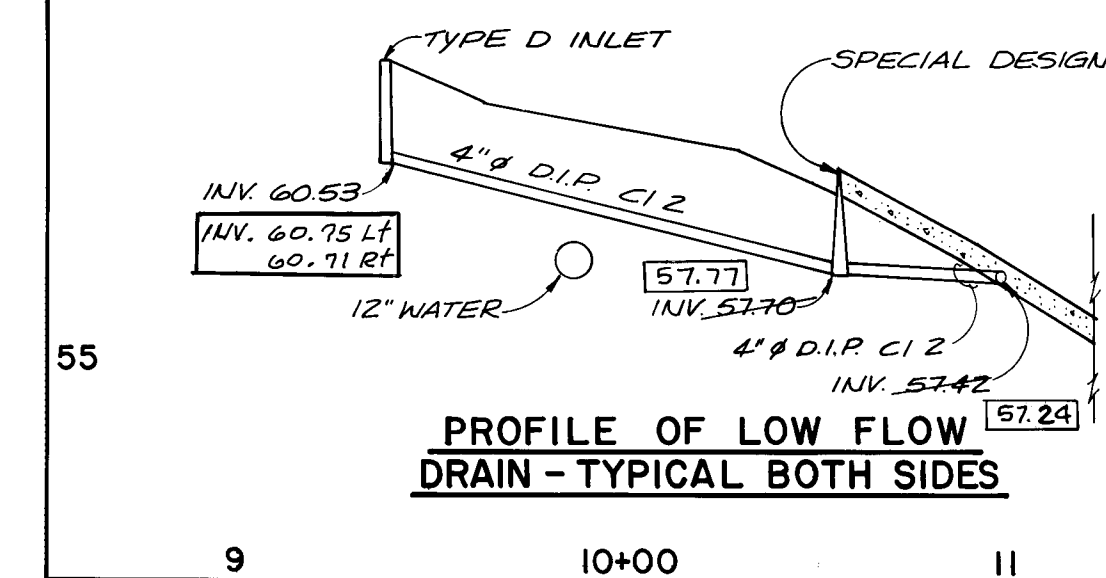

NOTE:
The waterline and sanitary sewer line are to belong to New Mexico Utility Company systems not City of Albuquerque


AS BUILT

11/4/85


NOTE: THIS CERTIFICATION IS INTENDED TO INDICATE THAT IN THE ENGINEER'S OPINION THIS CONSTRUCTION IS IN SUBSTANTIAL COMPLIANCE WITH THE DESIGN AS SHOWN (OR AS ANNOTATED WITH UPDATED FIELD GRADES WHERE INDICATED). IT IS NOT A VERIFICATION OF CONTRACT COMPLIANCE IN THE LEVEL OF DETAIL ASSOCIATED WITH FULL CONSTRUCTION INSPECTION OF THE PROJECT.

CITY OF ALBUQUERQUE MUNICIPAL DEVELOPMENT DEPARTMENT ENGINEERING DIVISION			
TITLE: SALIDA DEL SOL - UNIT TWO - UTILITY PLAN & PROFILE CONDESA COURT / CONDESA DRIVE N.W.			
APPROVALS	ENGINEER	DATE	APPROVALS
City Engineer	<i>[Signature]</i>	11/16/85	Public Works
ACE - Design	<i>[Signature]</i>	8/16/84	Traffic
ACE - Hydrology	<i>[Signature]</i>	2/28/84	Water
			Res
			Wtz
			2/28/84
DRAWING NO.	1869	MAP NO.	A-13
		SHEET	29
		OF	40


A SQUARE CHISEL IN THE TOP OF THE EASTERLY WALL OF THE A.M.A.F.C.A. FLOOD DIVERSION NO. 2 CHANNEL, APPROXIMATELY 180 FEET SOUTH OF THE POINT OF CONFLUENCE WITH THE SKYVIEW DRAINAGE CHANNEL ESTABLISHED BY BOHANNAN-HUSTON AND MARKED "BM 205". ELEVATION = 5110.55

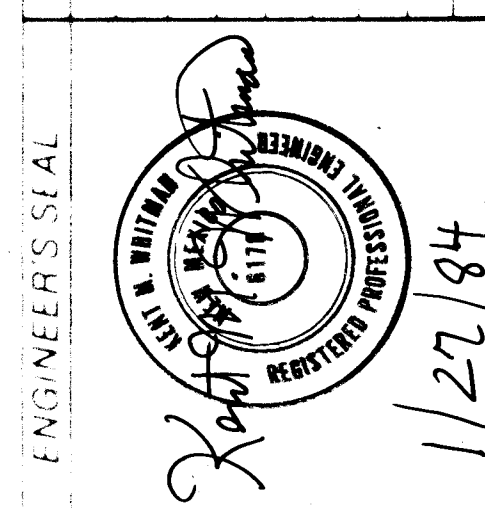



REVISIONS	DATE	BY
1	11-83	J.B.
2	11-83	K.M.W.
3	11-83	K.M.W.

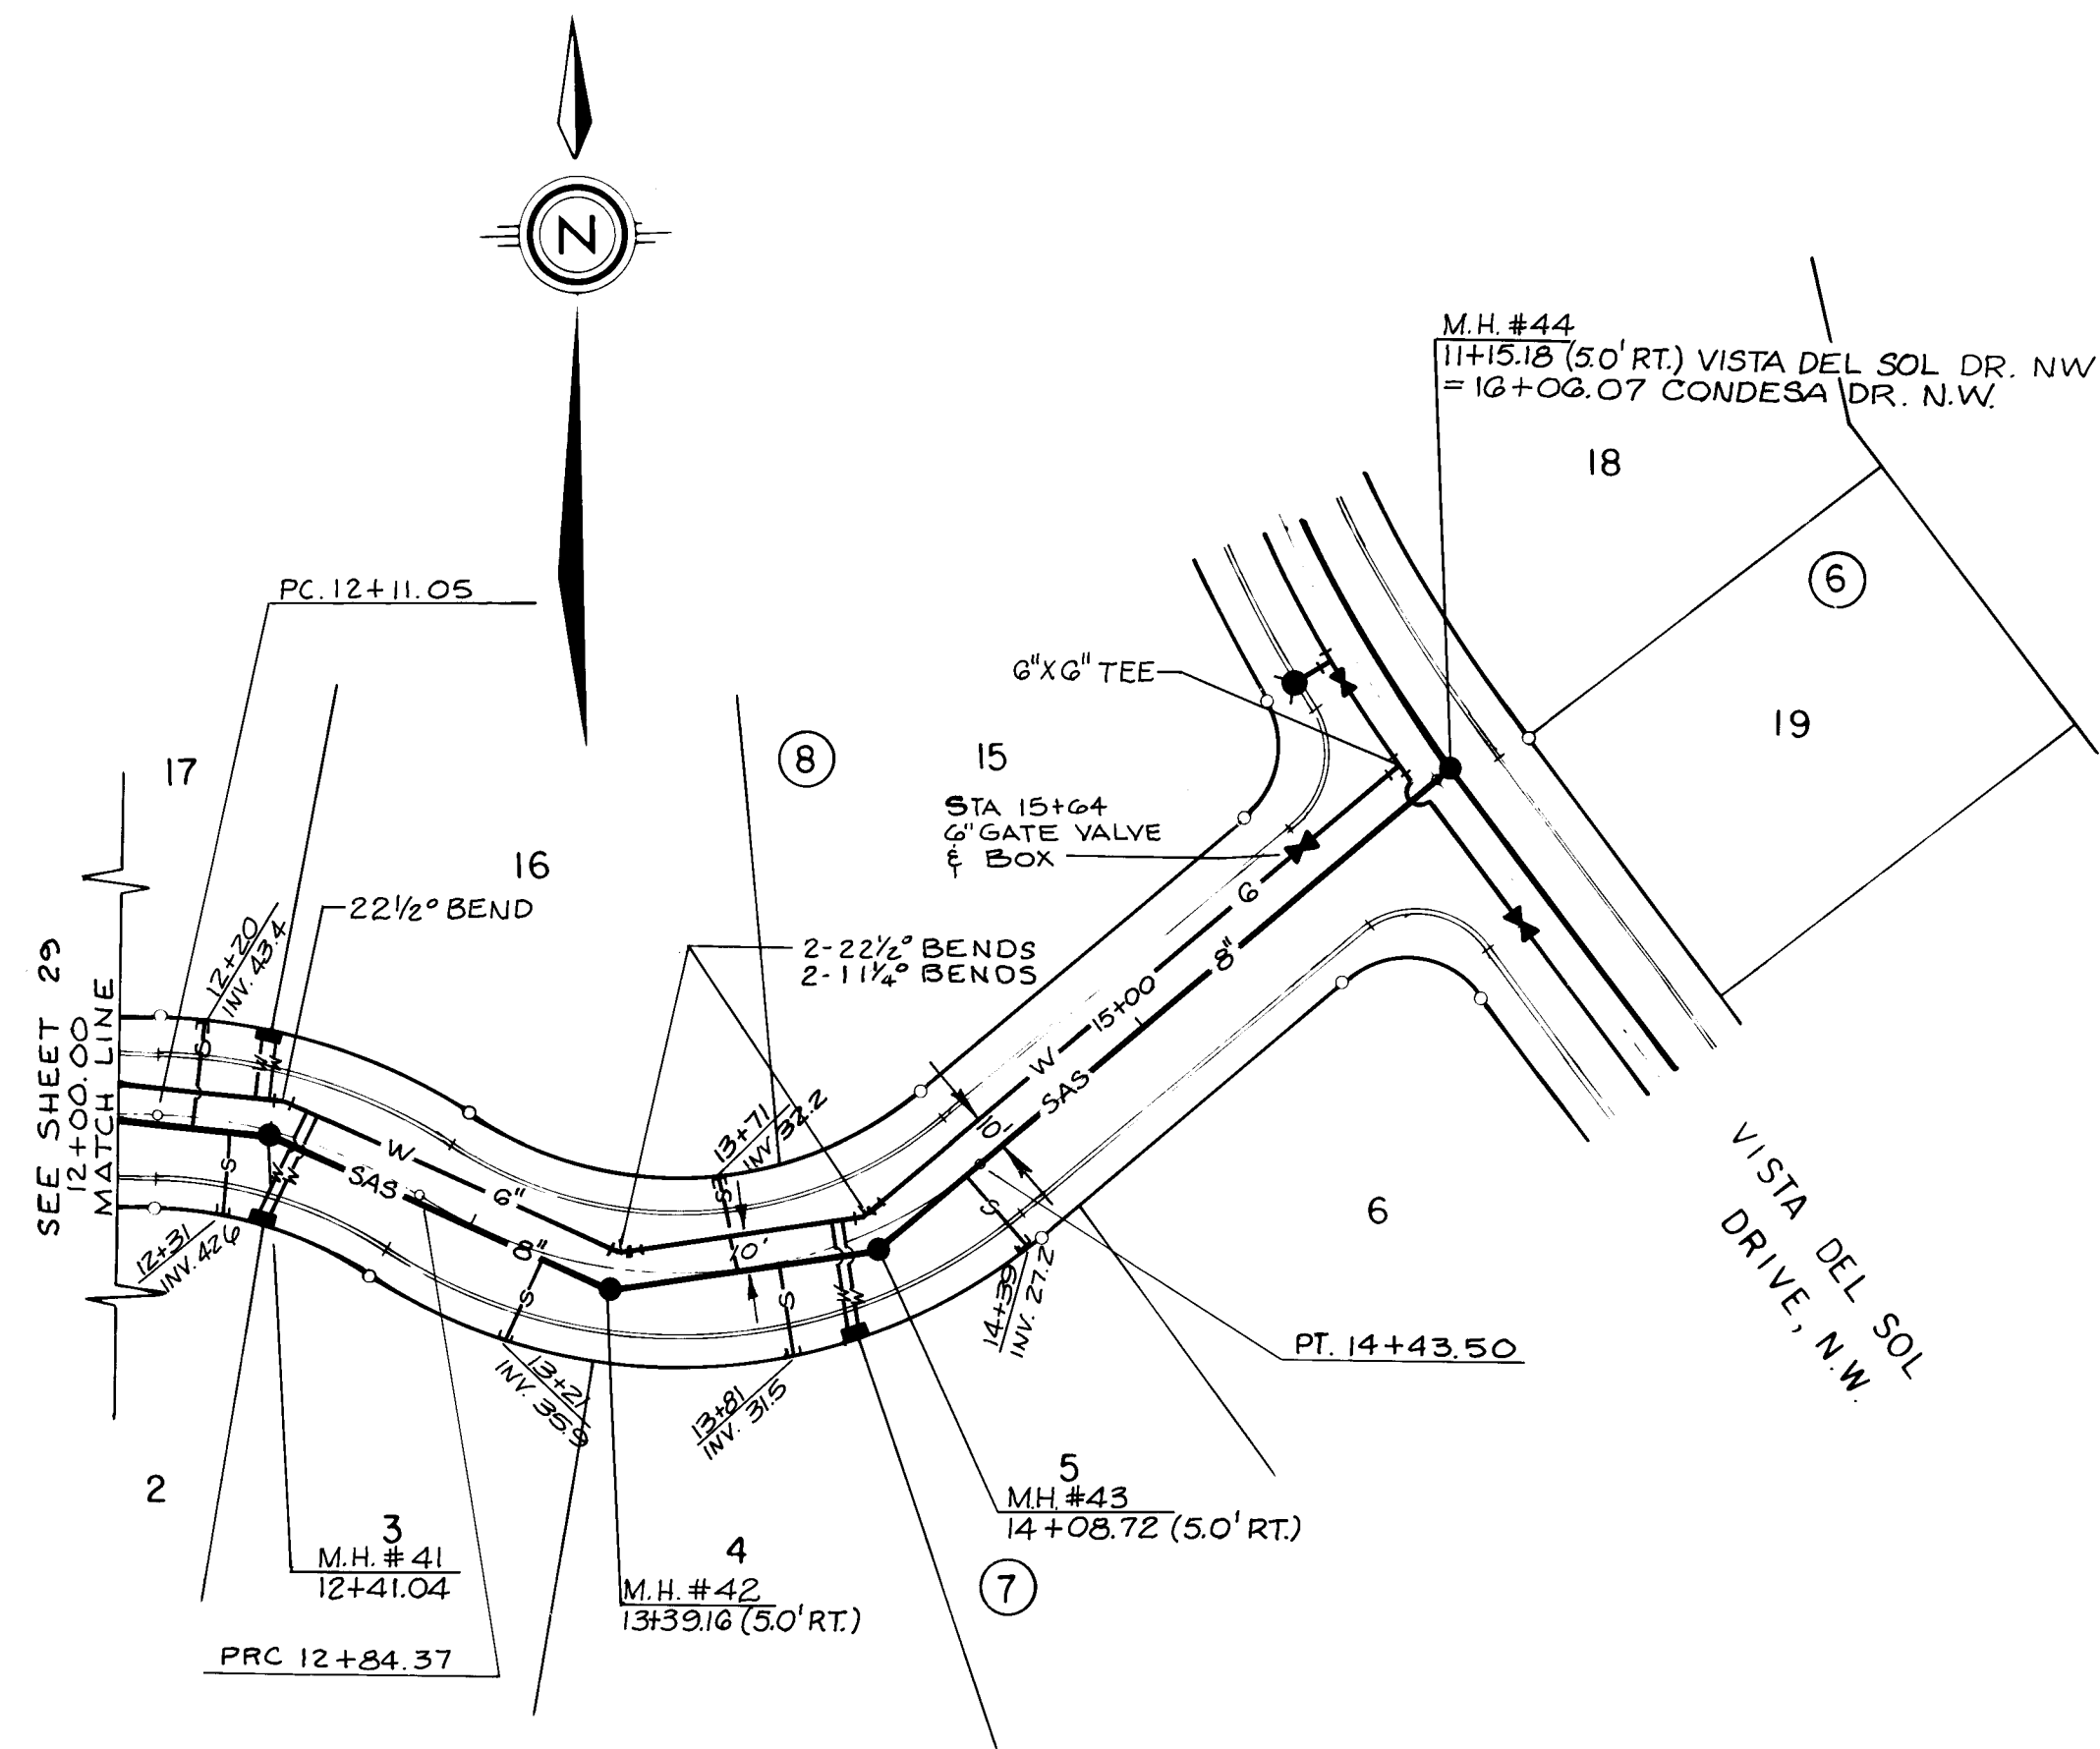


CONDESA DRIVE, N.W.

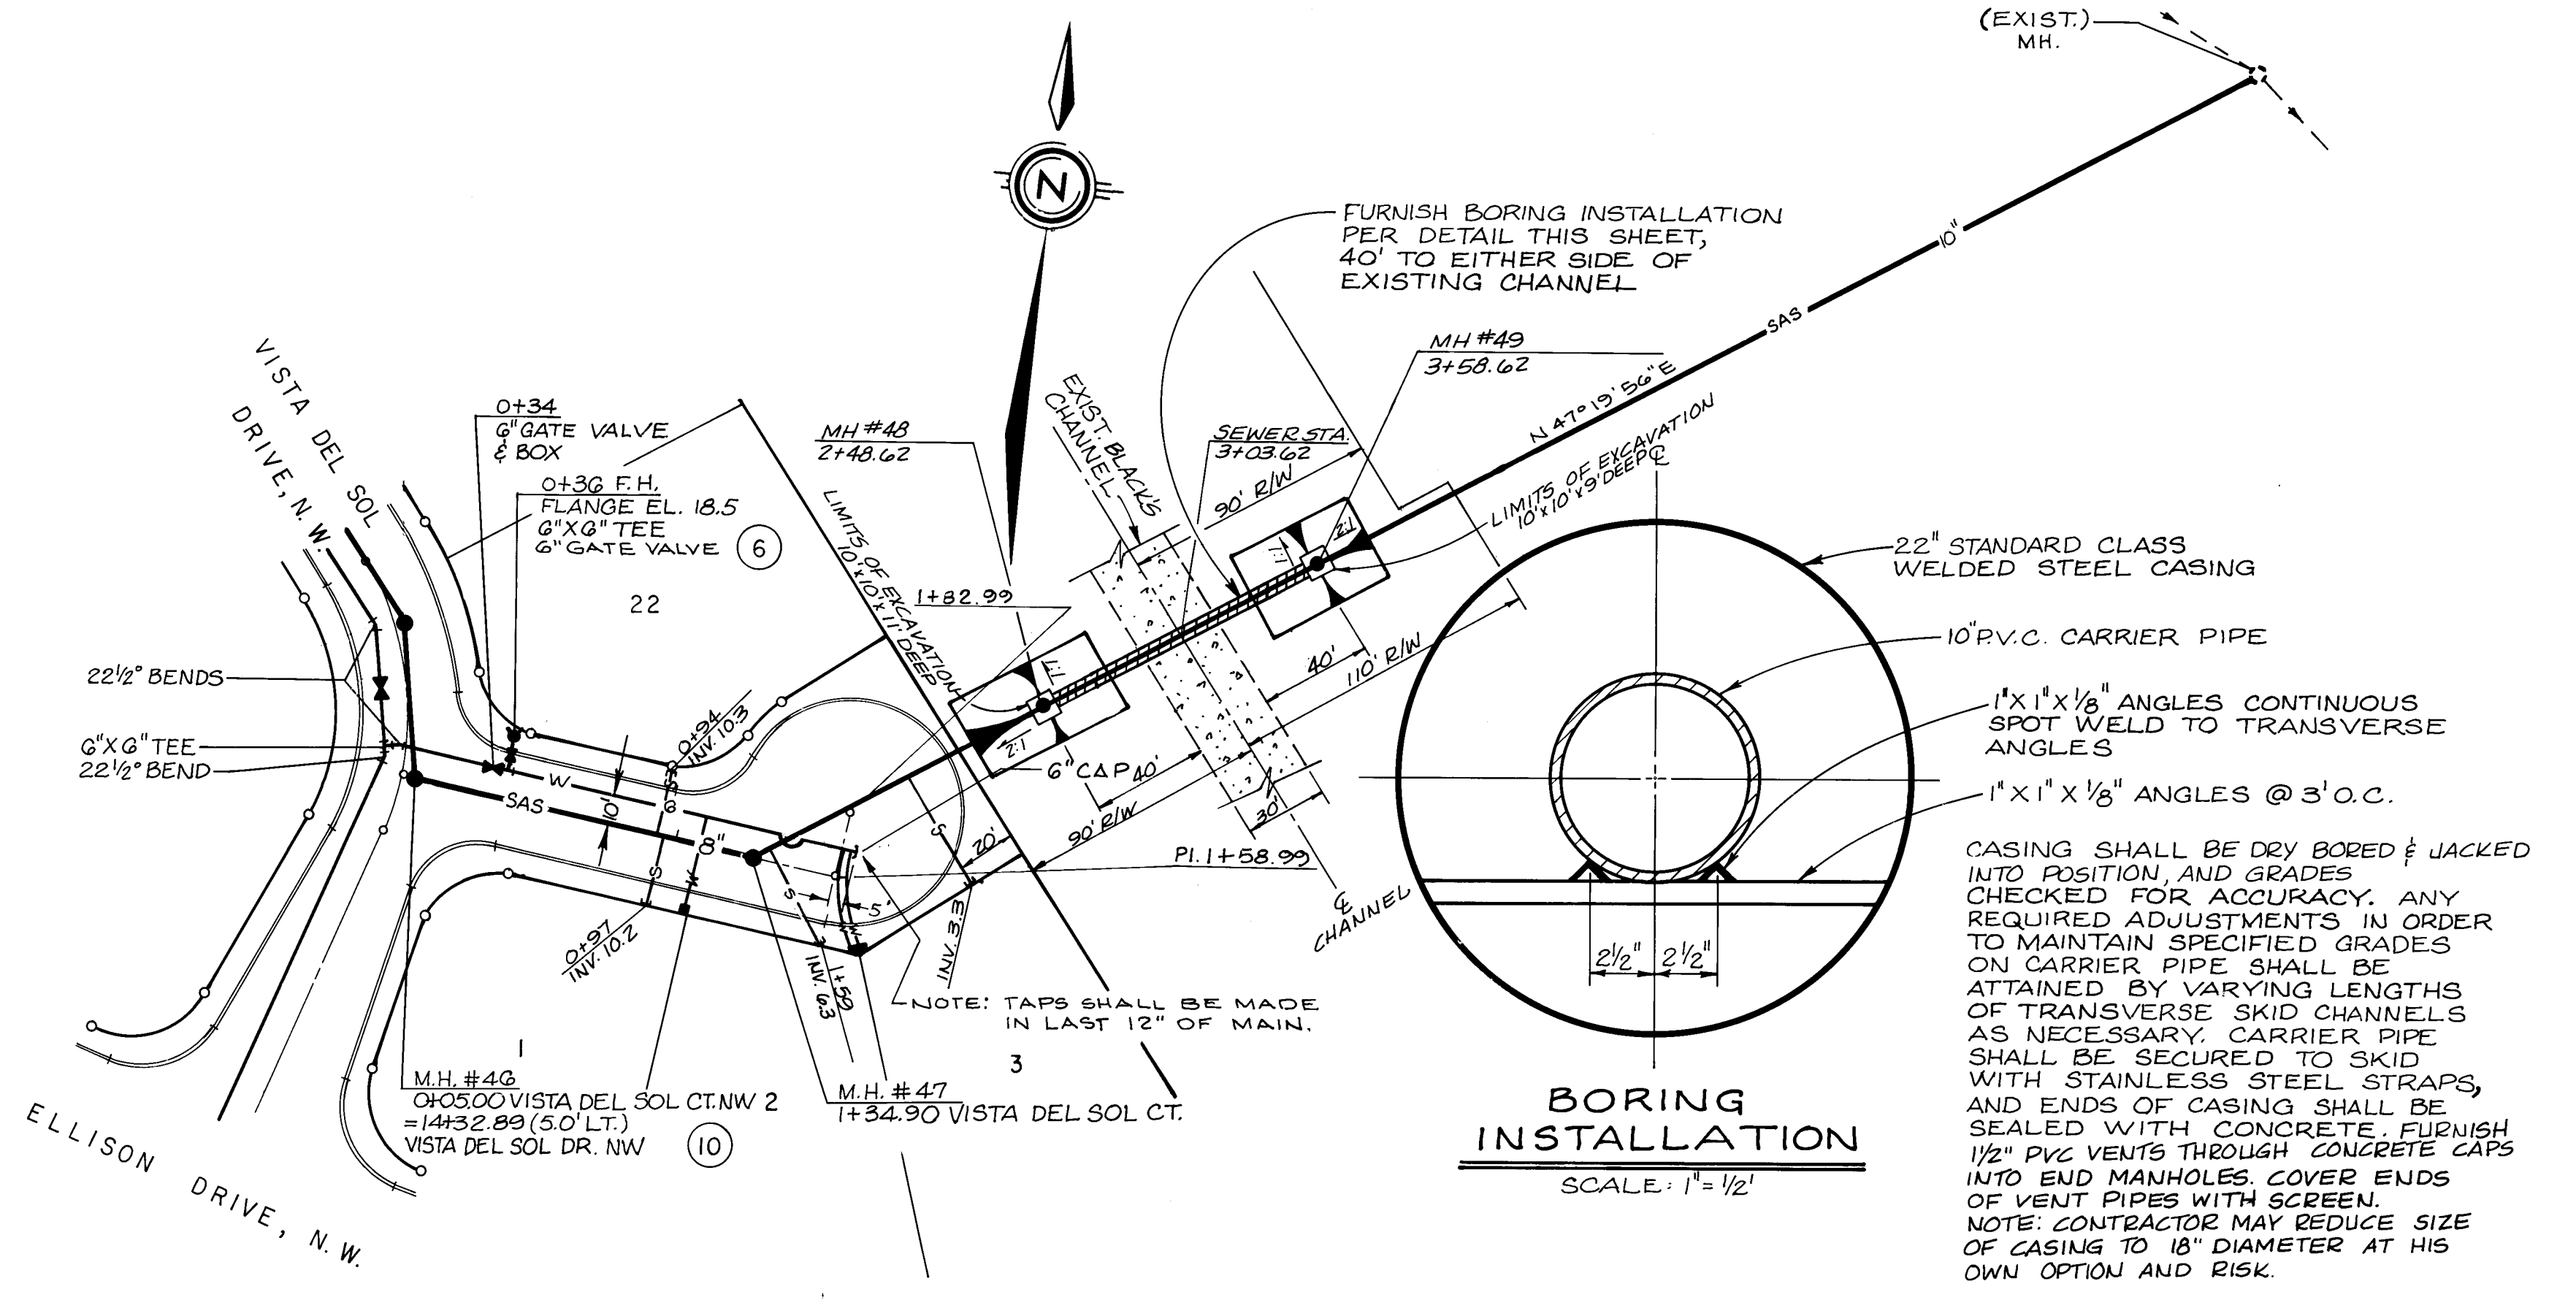

VISTA DEL SOL COURT, N.W.

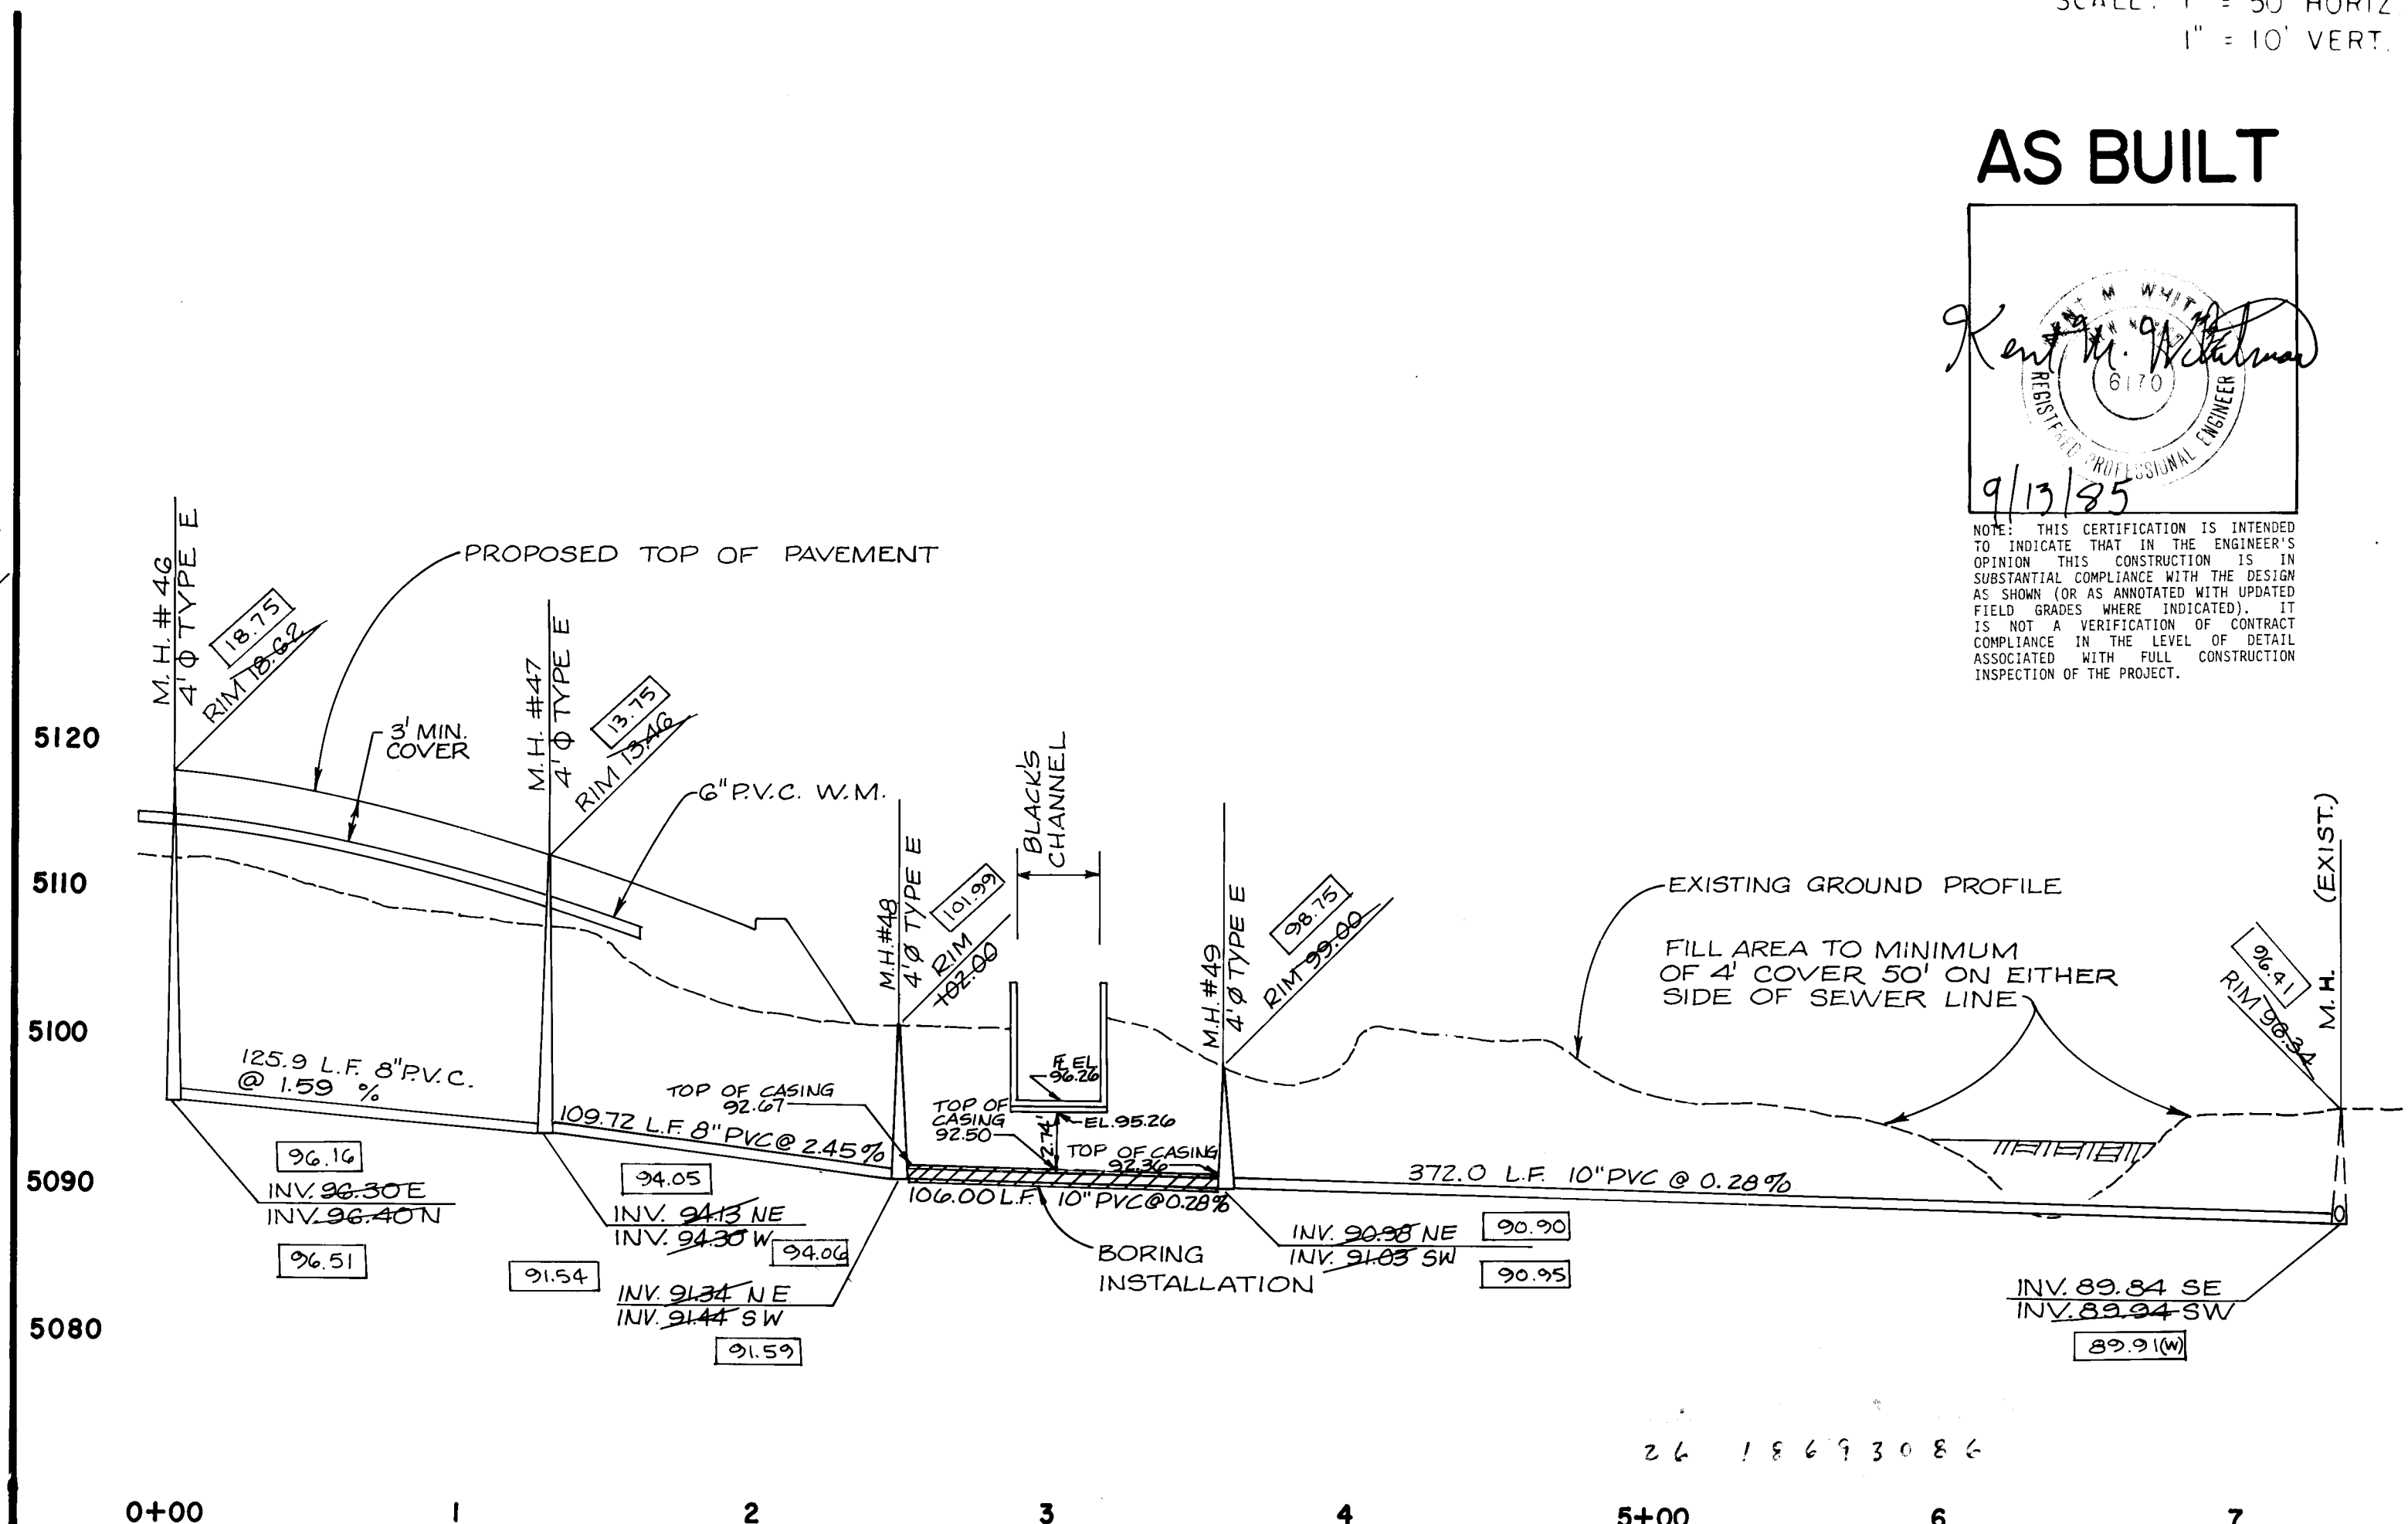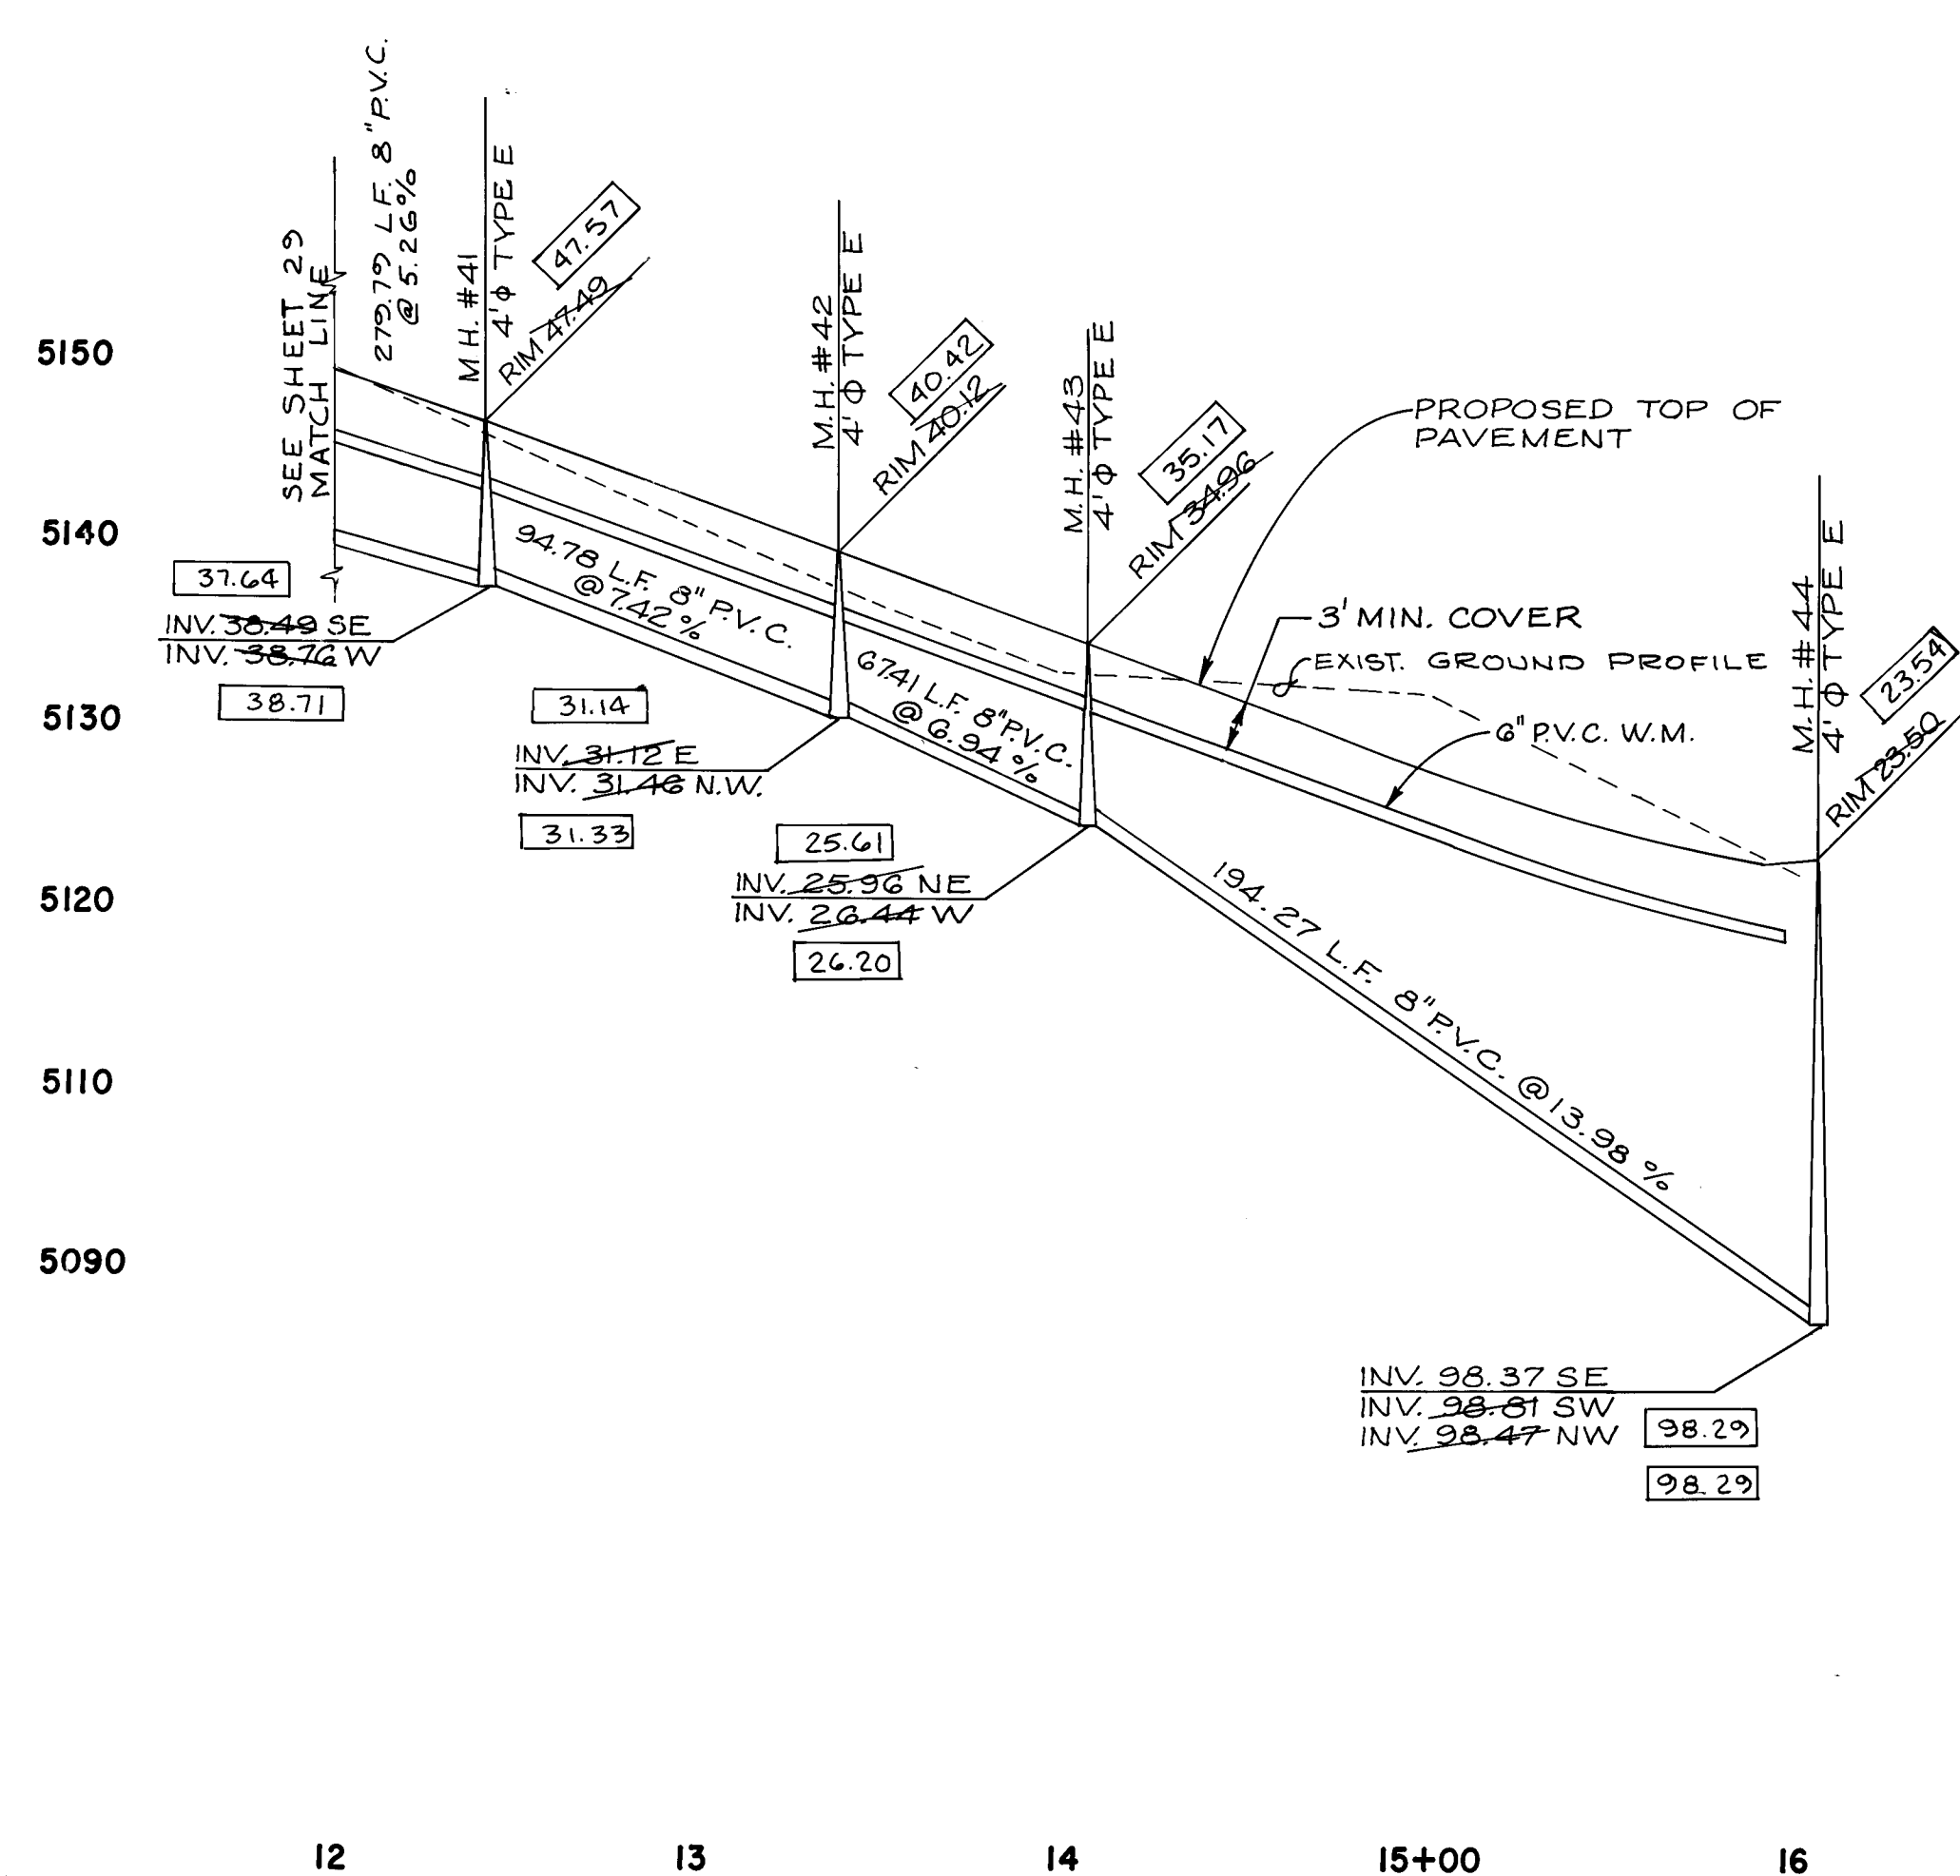

AS BUILT

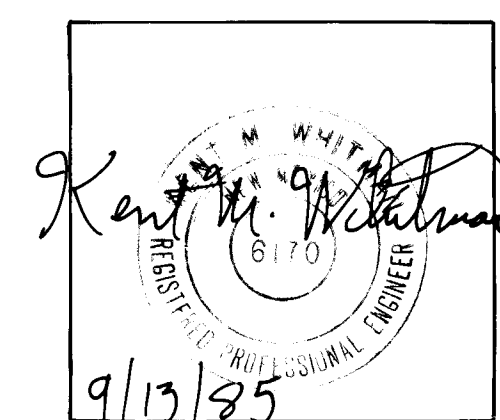

NOTE: THIS CERTIFICATION IS INTENDED TO INDICATE THAT IN THE ENGINEER'S OPINION THIS CONSTRUCTION IS IN SUBSTANTIAL COMPLIANCE WITH THE DESIGN AS SHOWN (OR AS ANNOTATED WITH UPDATED FIELD NOTES WHERE INDICATED). IT IS NOT A VERIFICATION OF CONTRACT COMPLIANCE IN THE LEVEL OF DETAIL ASSOCIATED WITH FULL CONSTRUCTION INSPECTION OF THE PROJECT.

NOTE: The water line and sanitary sewer line are to belong to New Mexico Utility Company systems, not City of Albuquerque.

SALIDA DEL SOL - UNIT TWO - UTILITY PLAN & PROFILE
CONDESA DRIVE N.W. / VISTA DEL SOL COURT N.W.

1869 A-13 30 40


A SQUARE CHISEL IN THE TOP OF THE EASTERLY WALL OF THE A.M.A.F.C.A. FLOOD DIVERSION NO. 2 CHANNEL, APPROXIMATELY 180 FEET SOUTH OF THE POINT OF CONFLUENCE WITH THE SKYVIEW DRAINAGE CHANNEL ESTABLISHED BY BOHANNAN-HUSTON AND MARKED "TBM 205". ELEVATION = 5110.55




11-83
11-83
11-83

7.84 REVISE SAS
K.M.W.
J.B.
K.M.W.


1/27/84
2/28/84
2/8/84

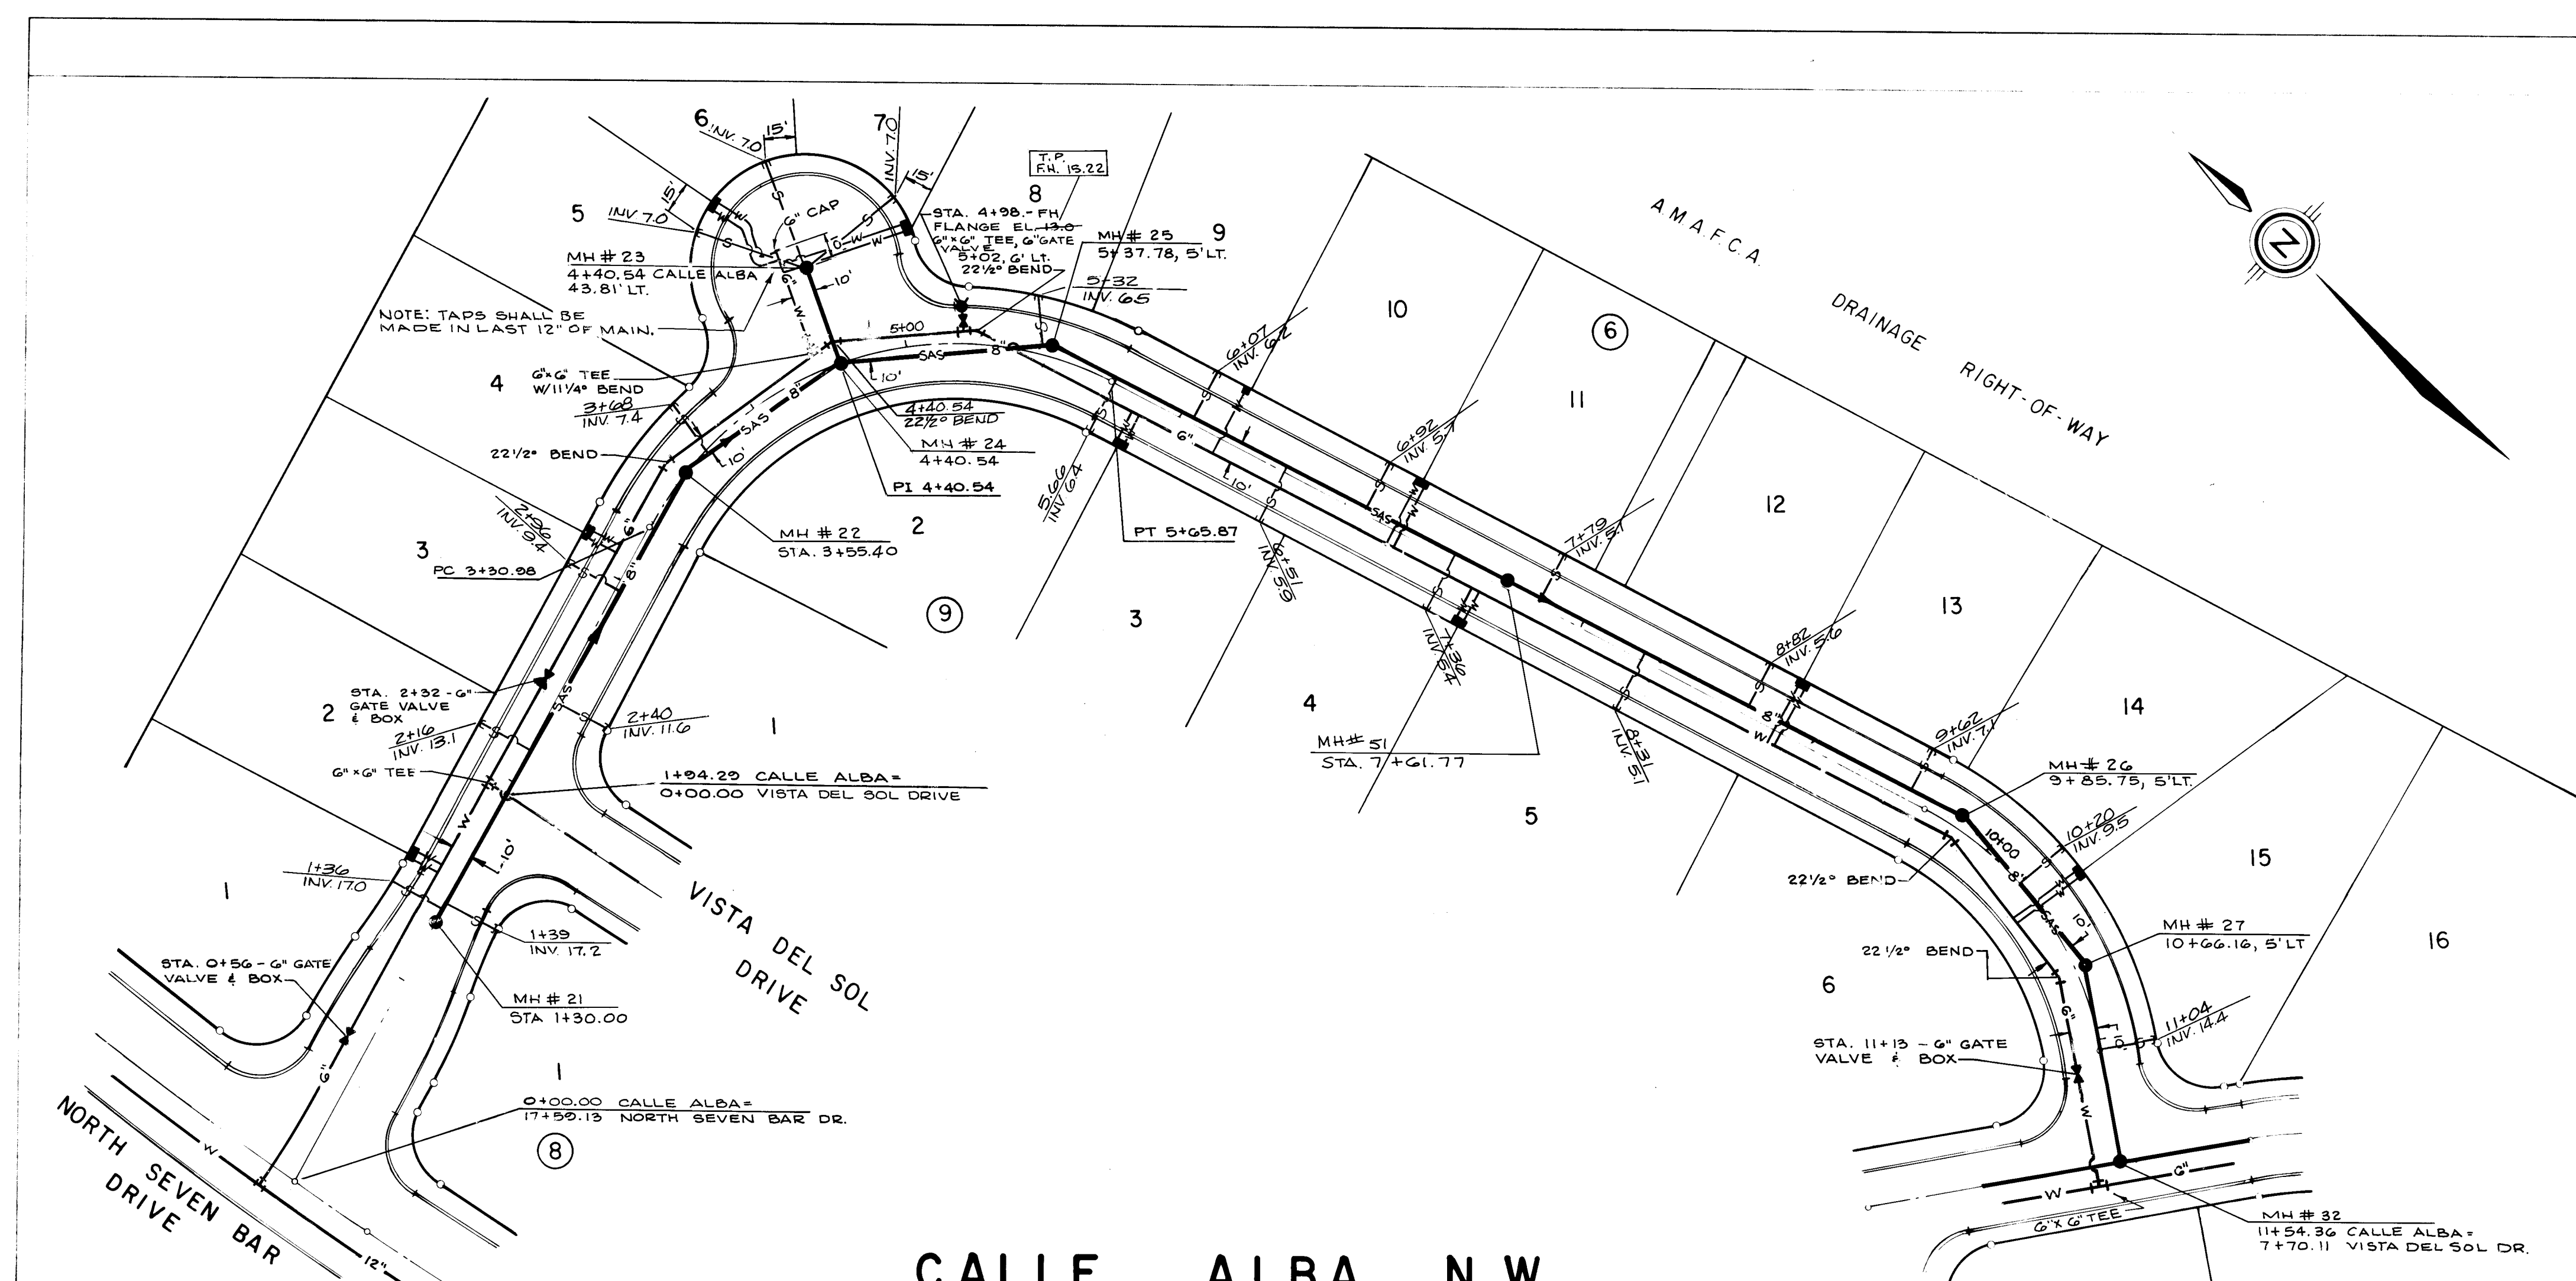

CALLE ALBA, N.W.

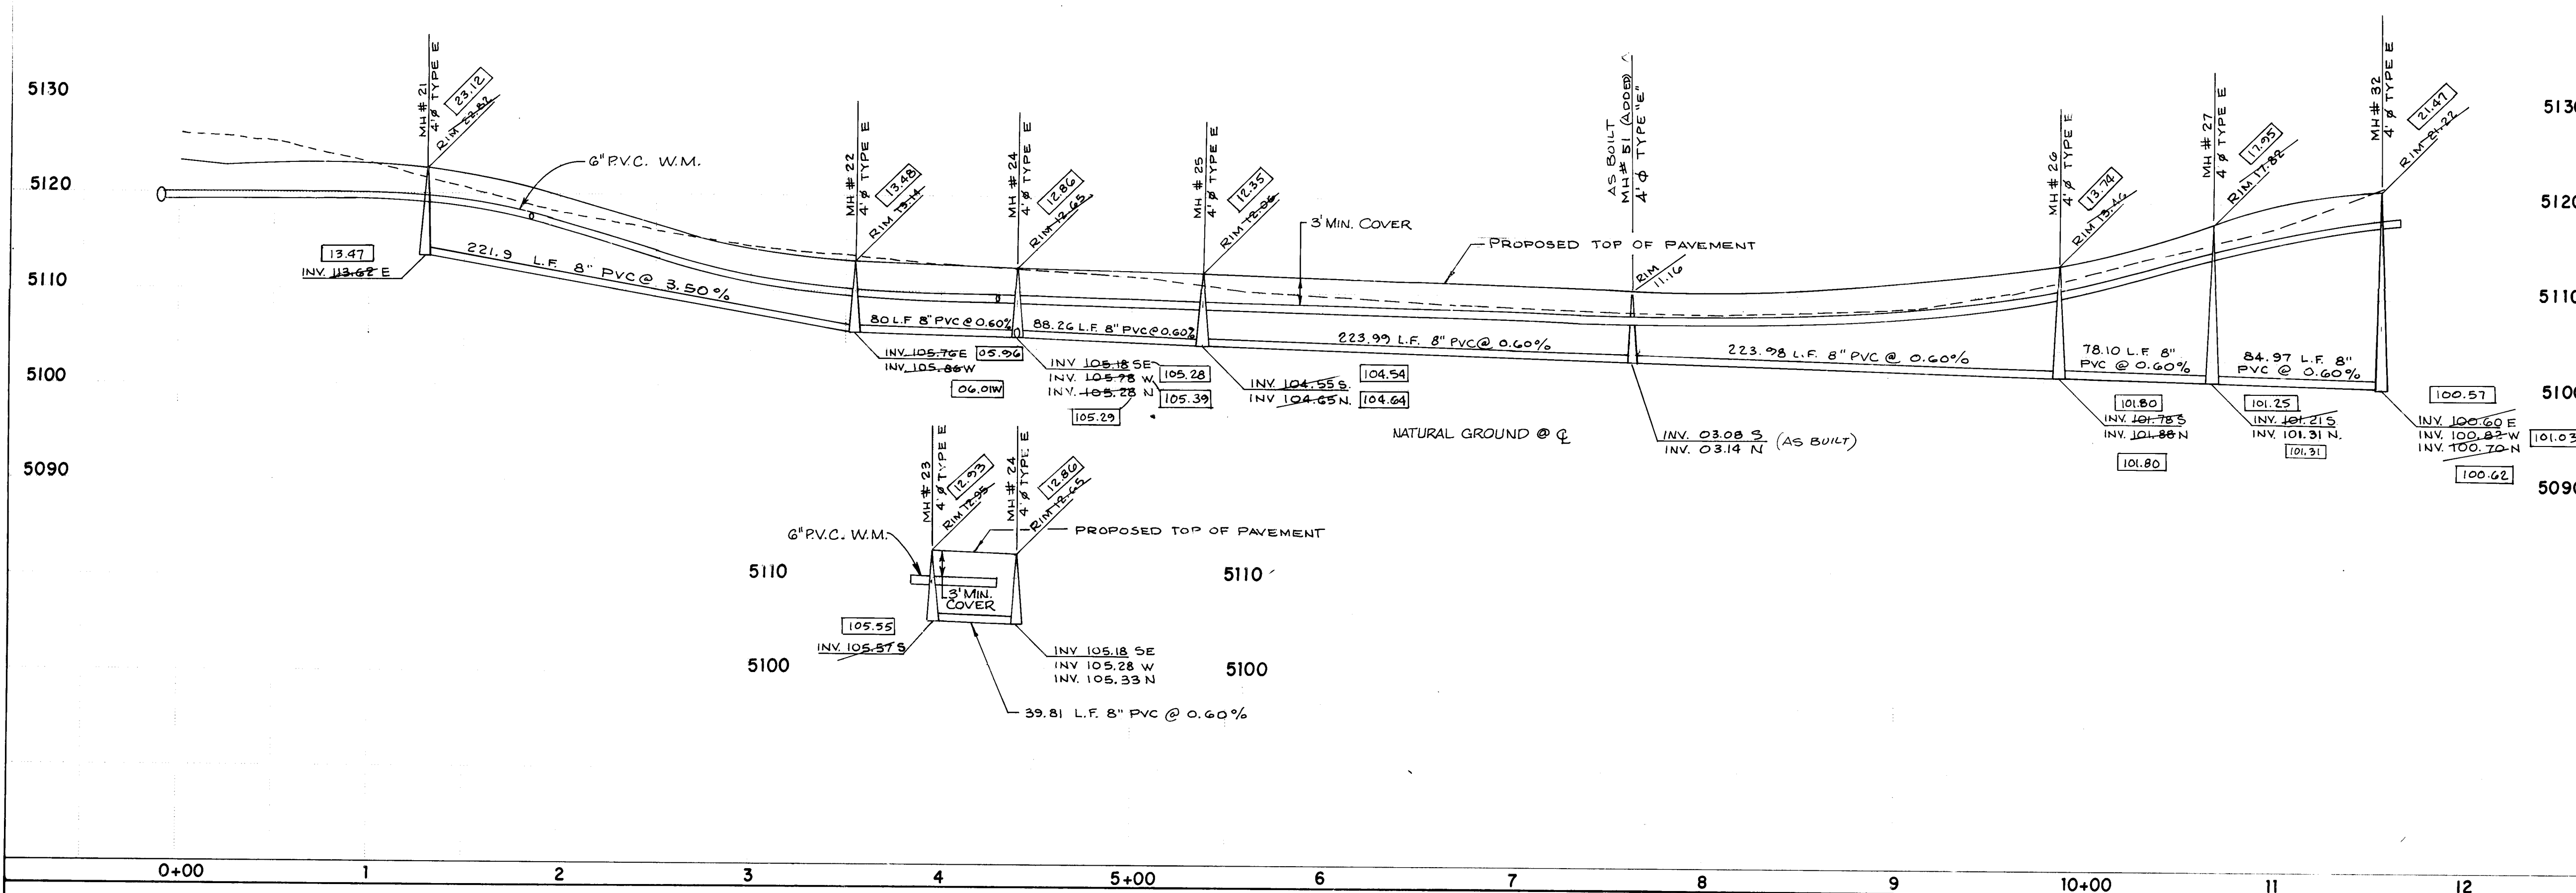


AS BUILT

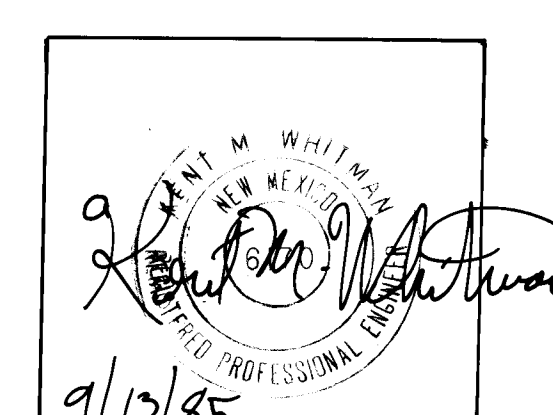

SCALE: 1" = 50' HORIZ
1" = 10' VERT.

NOTE:
The water line and
sanitary sewer line are
to belong to New Mexico
Utility Company systems,
not City of Albuquerque

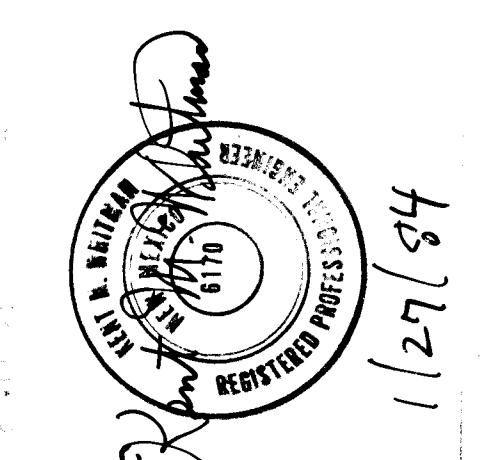

NO.	DATE	REMARKS	BY
1		DESIGN	
2		REVISIONS	
3		DESIGN	
4		DESIGN	
DESIGNED BY: K.W. LLI
DRAWN BY: MKS, RDO
CHECKED BY:

CITY OF ALBUQUERQUE
MUNICIPAL DEVELOPMENT DEPARTMENT
ENGINEERING DIVISION

TITLE: SALIDA DEL SOL-UNIT TWO-UTILITY PLAN & PROFILE
CALLE ALBA, N.W.



APPROVALS	ENGINEER	DATE	APPROVALS	ENGINEER	DATE
City Engineer	C. McQuinn	8/2/84	Liquid Waste		
A.C.E. Design	8/2/84		Traffic	NA	2/2/84
A.C.E. Hydrology	2/2/84		Water Res	WJ	2-8-84

DRAWING NO: 1869
MAP NO: A-13
SHEET 31 OF 40

A SQUARE CHISEL IN THE TOP OF THE EASTERLY WALL OF THE A.M.A.F.C.A. FLOOD DIVERSION NO. 2 CHANNEL, APPROXIMATELY 180 FEET SOUTH OF THE POINT OF CONFLUENCE WITH THE SKYVIEW DRAINAGE CHANNEL ESTABLISHED BY BOHANNAN-HUSTON AND MARKED "TBM 205". ELEVATION = 5110.55

1869

1869

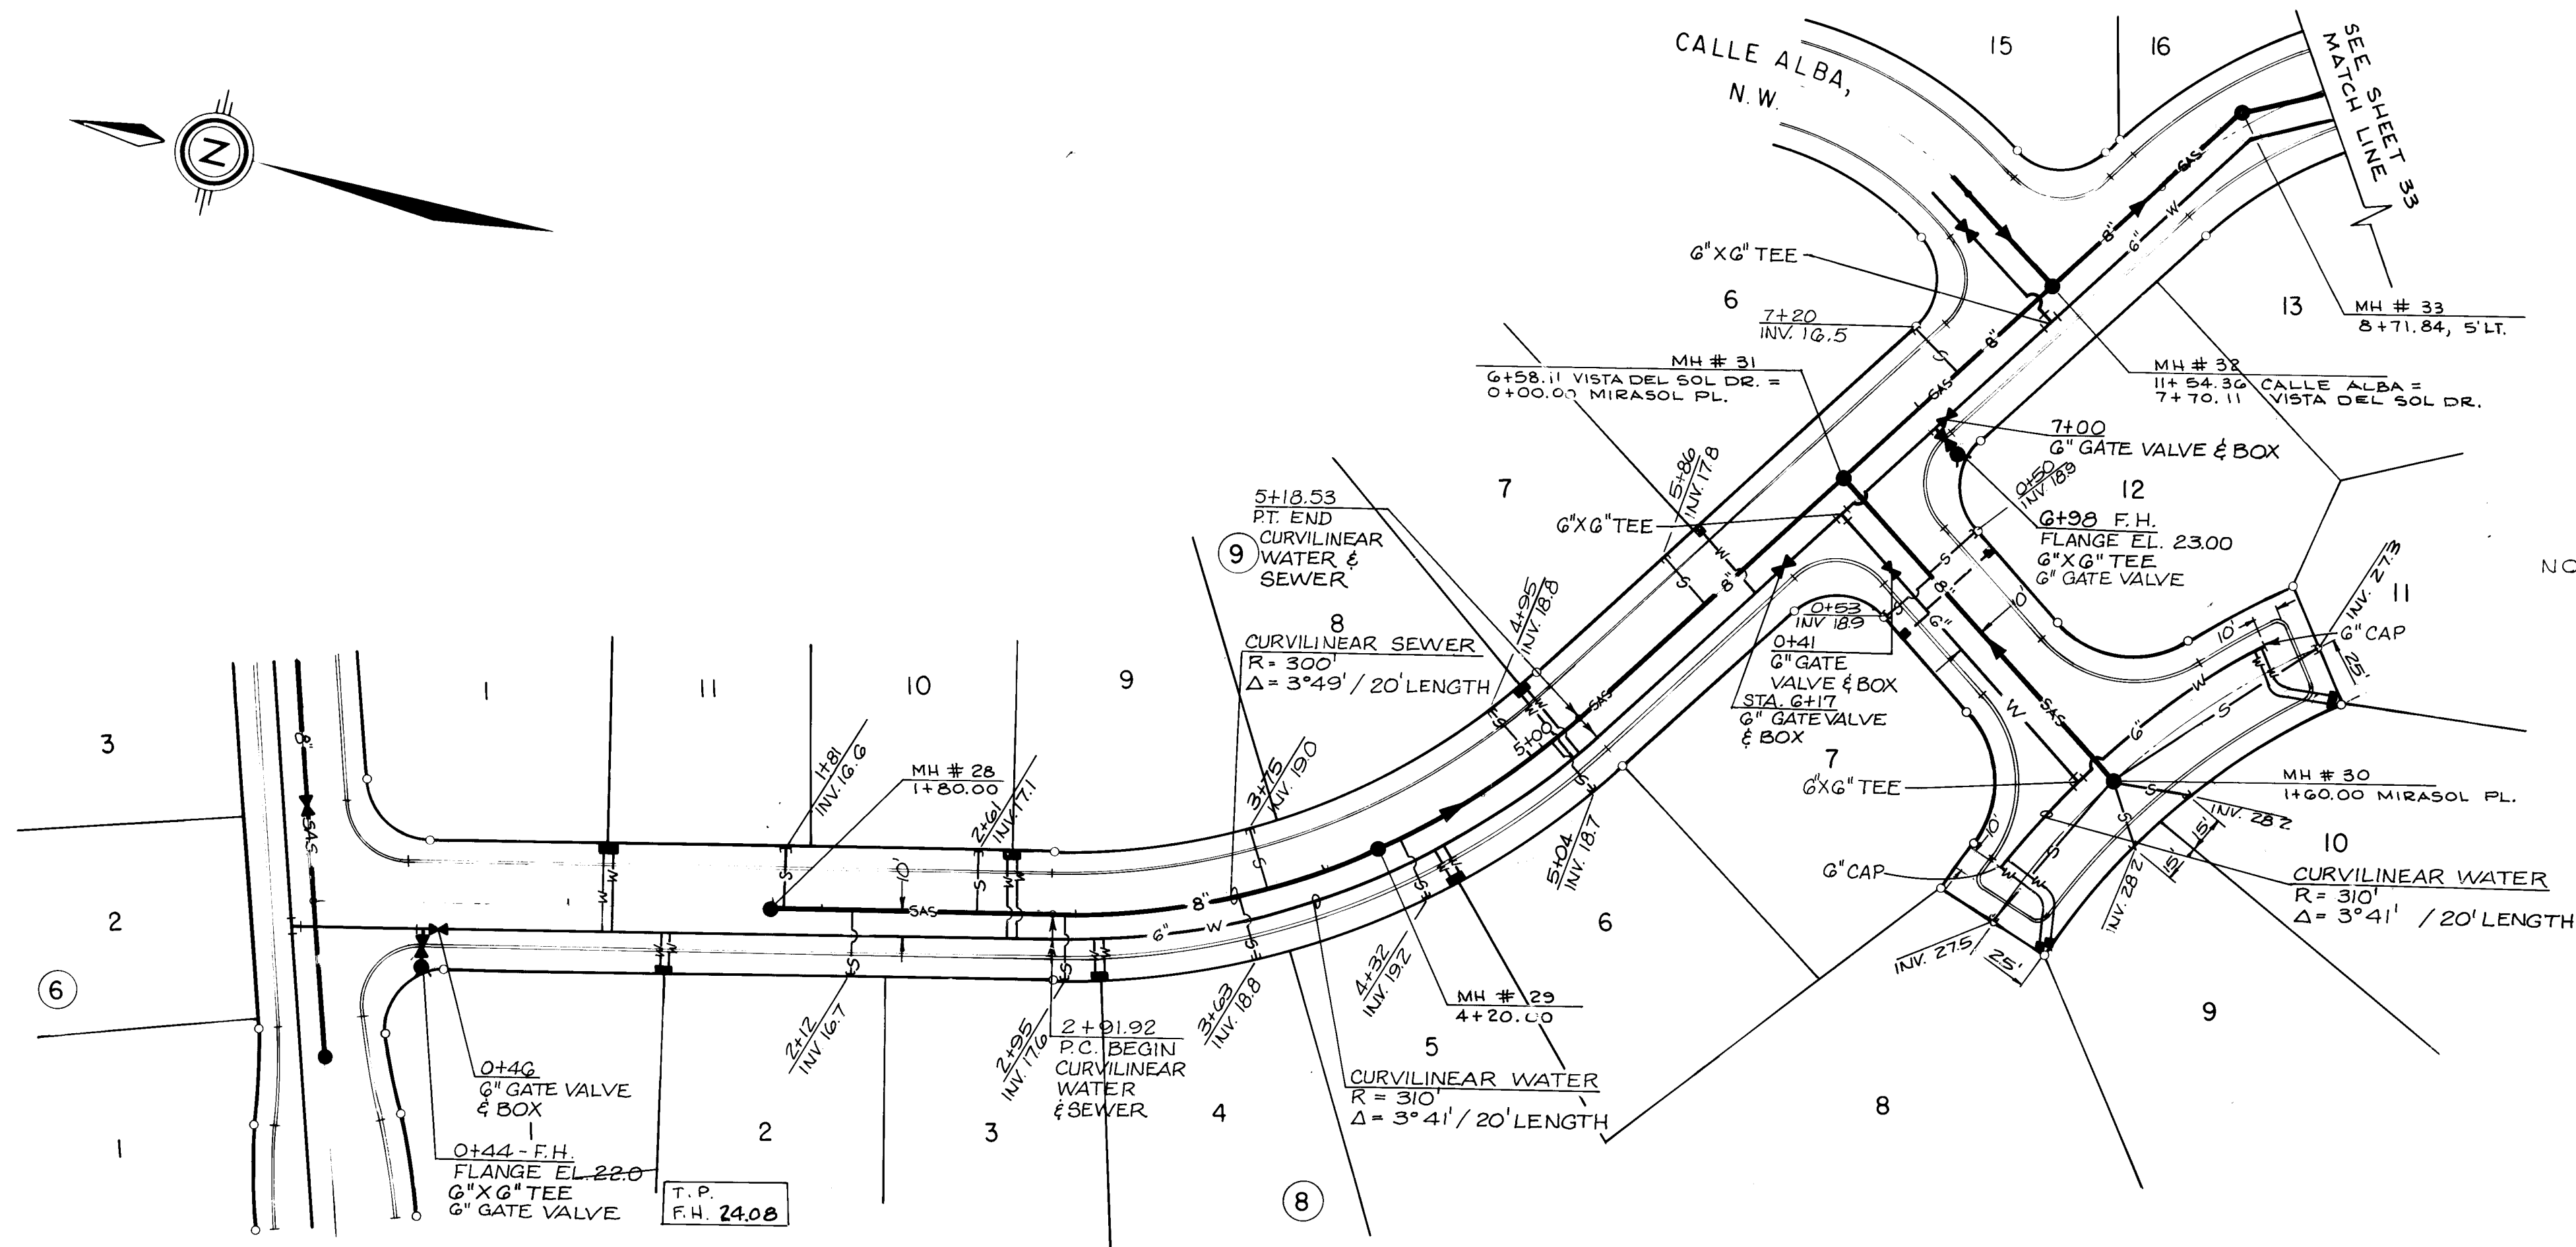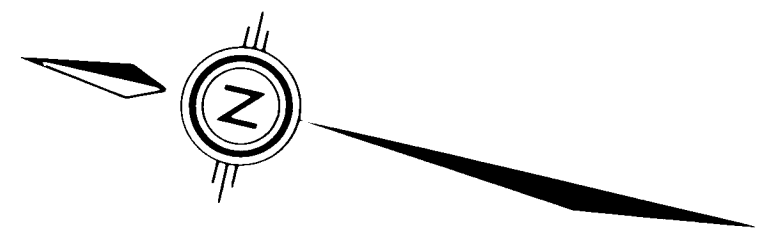


NOTE: TAPS IN DEAD END LINES SHALL BE MADE IN LAST 12" OF MAIN.

VISTA DEL SOL DRIVE, N.W.

MIRASOL PLACE, N.W.


SCALE: 1"=50 HORIZ.
1"=10 VERT.

AS BUILT

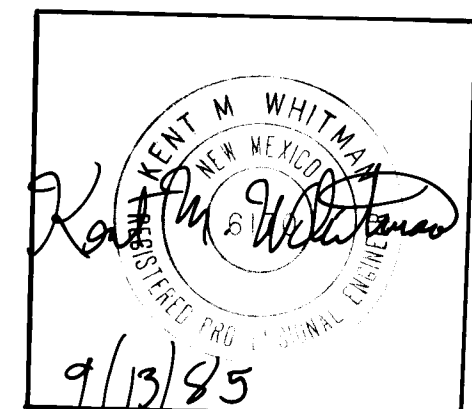



NOTES: THIS CERTIFICATION IS INTENDED TO INDICATE THAT IN THE ENGINEER'S OPINION THIS CONSTRUCTION IS IN SUBSTANTIAL COMPLIANCE WITH THE DESIGN AS SHOWN (OR AS ANNOTATED WITH UPDATES AS SHOWN WHERE INDICATED). IT IS NOT A VERIFICATION OF CONTRACT COMPLIANCE IN THE LEVEL OF DETAIL ASSOCIATED WITH FULL CONSTRUCTION INSPECTION OF THE PROJECT.

NOTE:
The waterline and sanitary sewer line are to belong to New Mexico Utility Company systems, NOT City of Albuquerque.

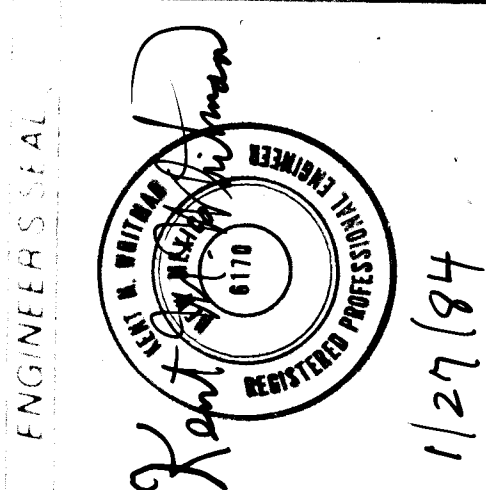

BY
DATE 11-83
DATE 11-83

DESIGN
KMM, LLL
MKS, BDQ

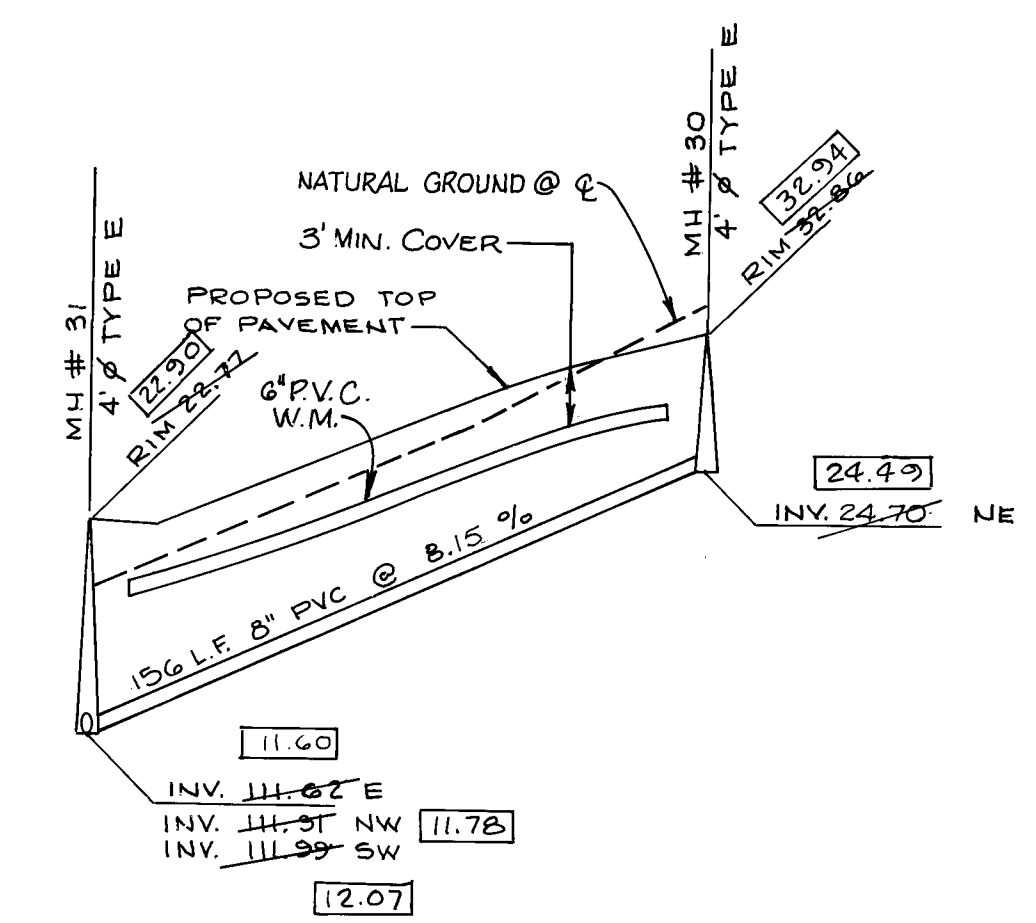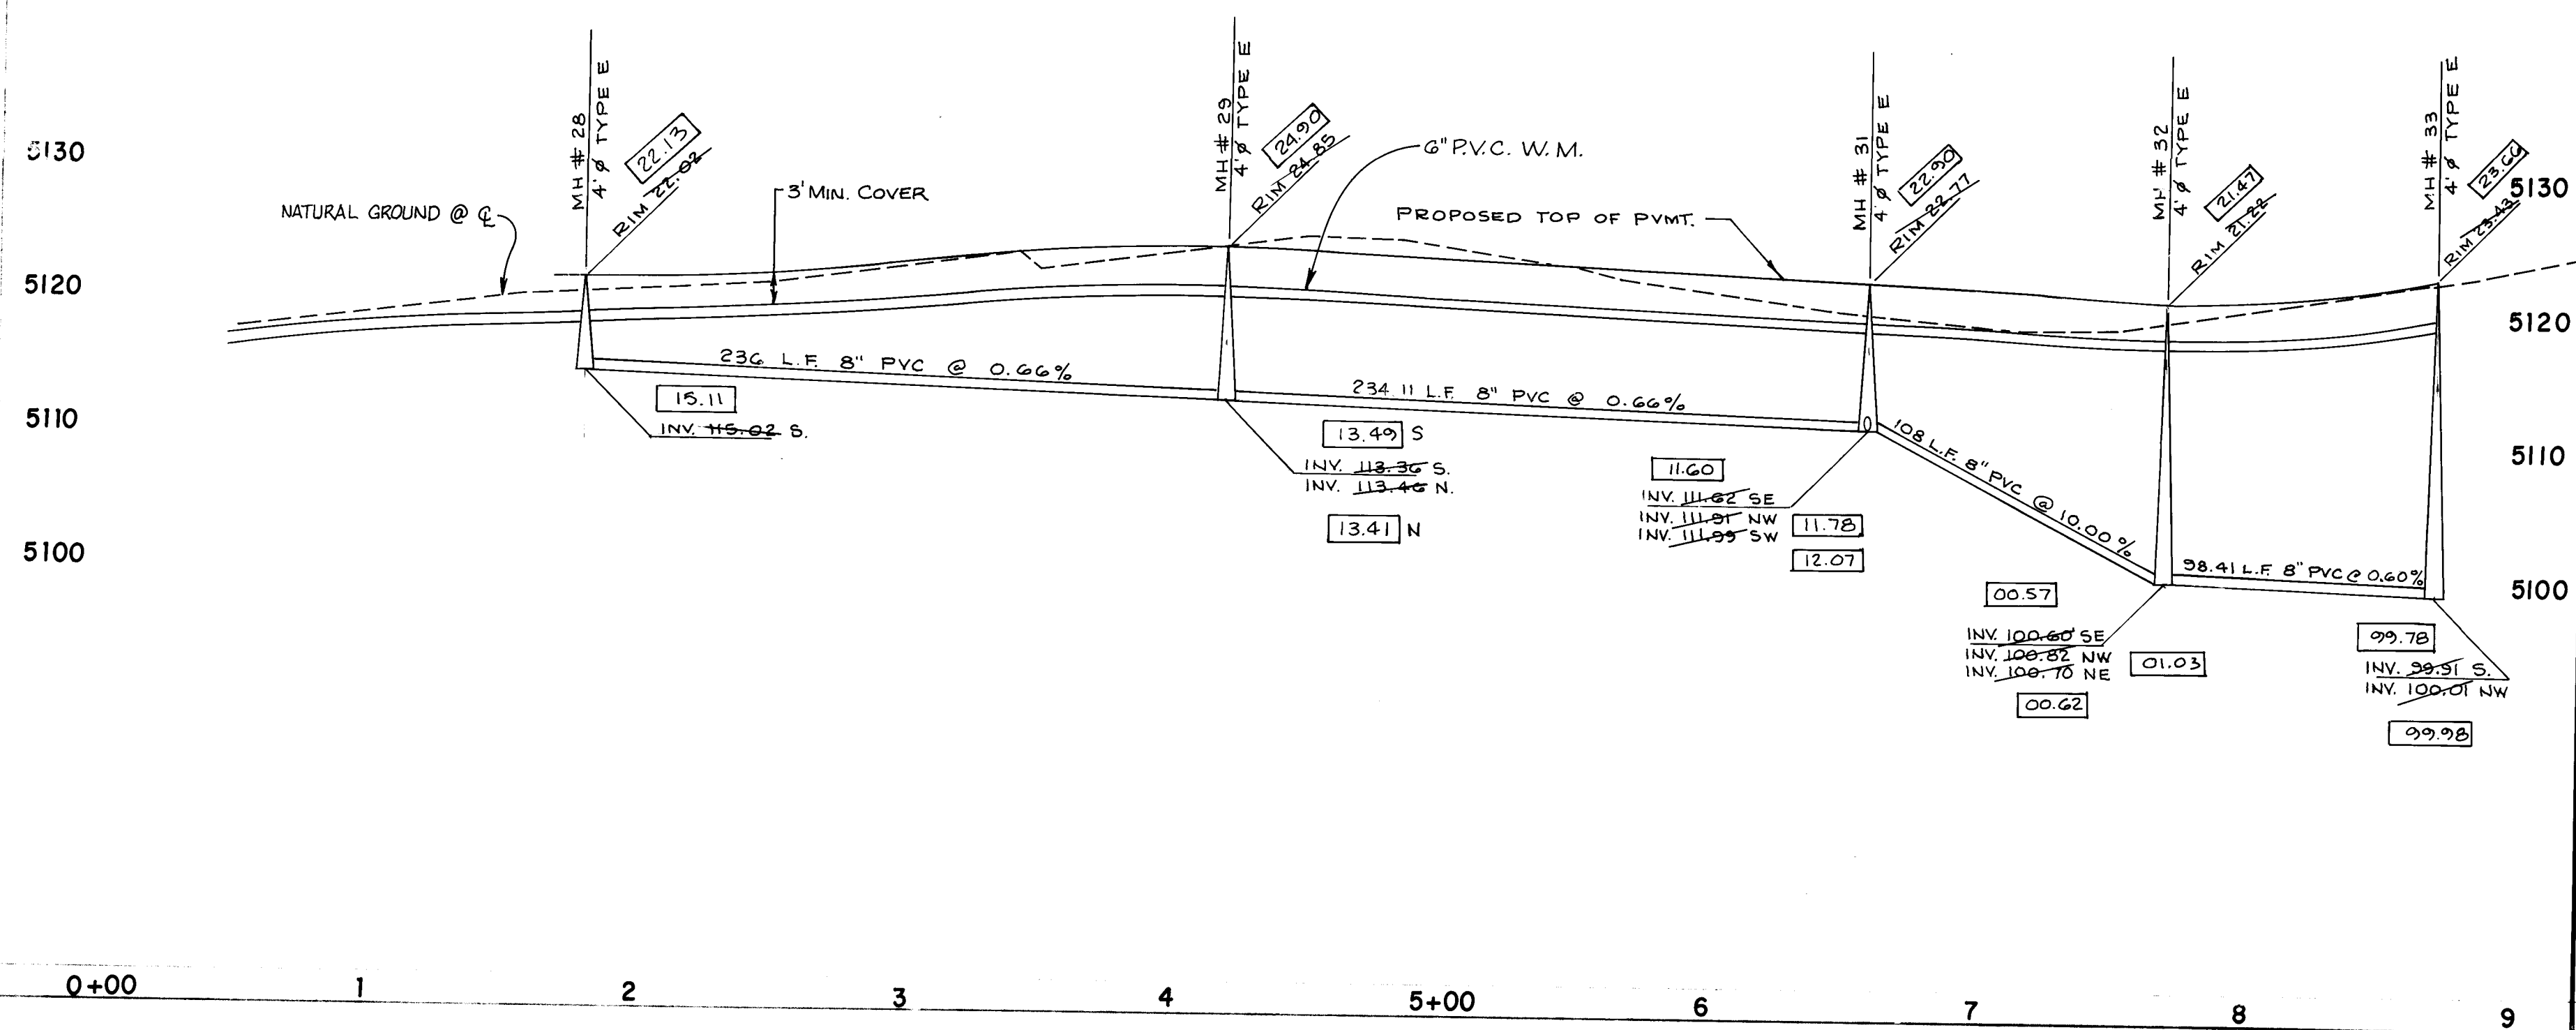

5130
5120
5110
5100



26 18693256

CITY OF ALBUQUERQUE
MUNICIPAL ENGINEERING DEPARTMENT
ENGINEERING DIVISION
TITLE: SALIDA DEL SOL - UNIT TWO - UTILITY PLAN & PROFILE
VISTA DEL SOL DRIVE NW / MIRASOL PLACE NW.


Engineer: [Signature]
A.E. Design: [Signature]
A.E. Hydrology: [Signature]
DATE: 2/28/84
Water: Ros
W#3
28-84

DRAWING NO. 1869
MAP NO. A-13
SHEET 32 OF 40

2081

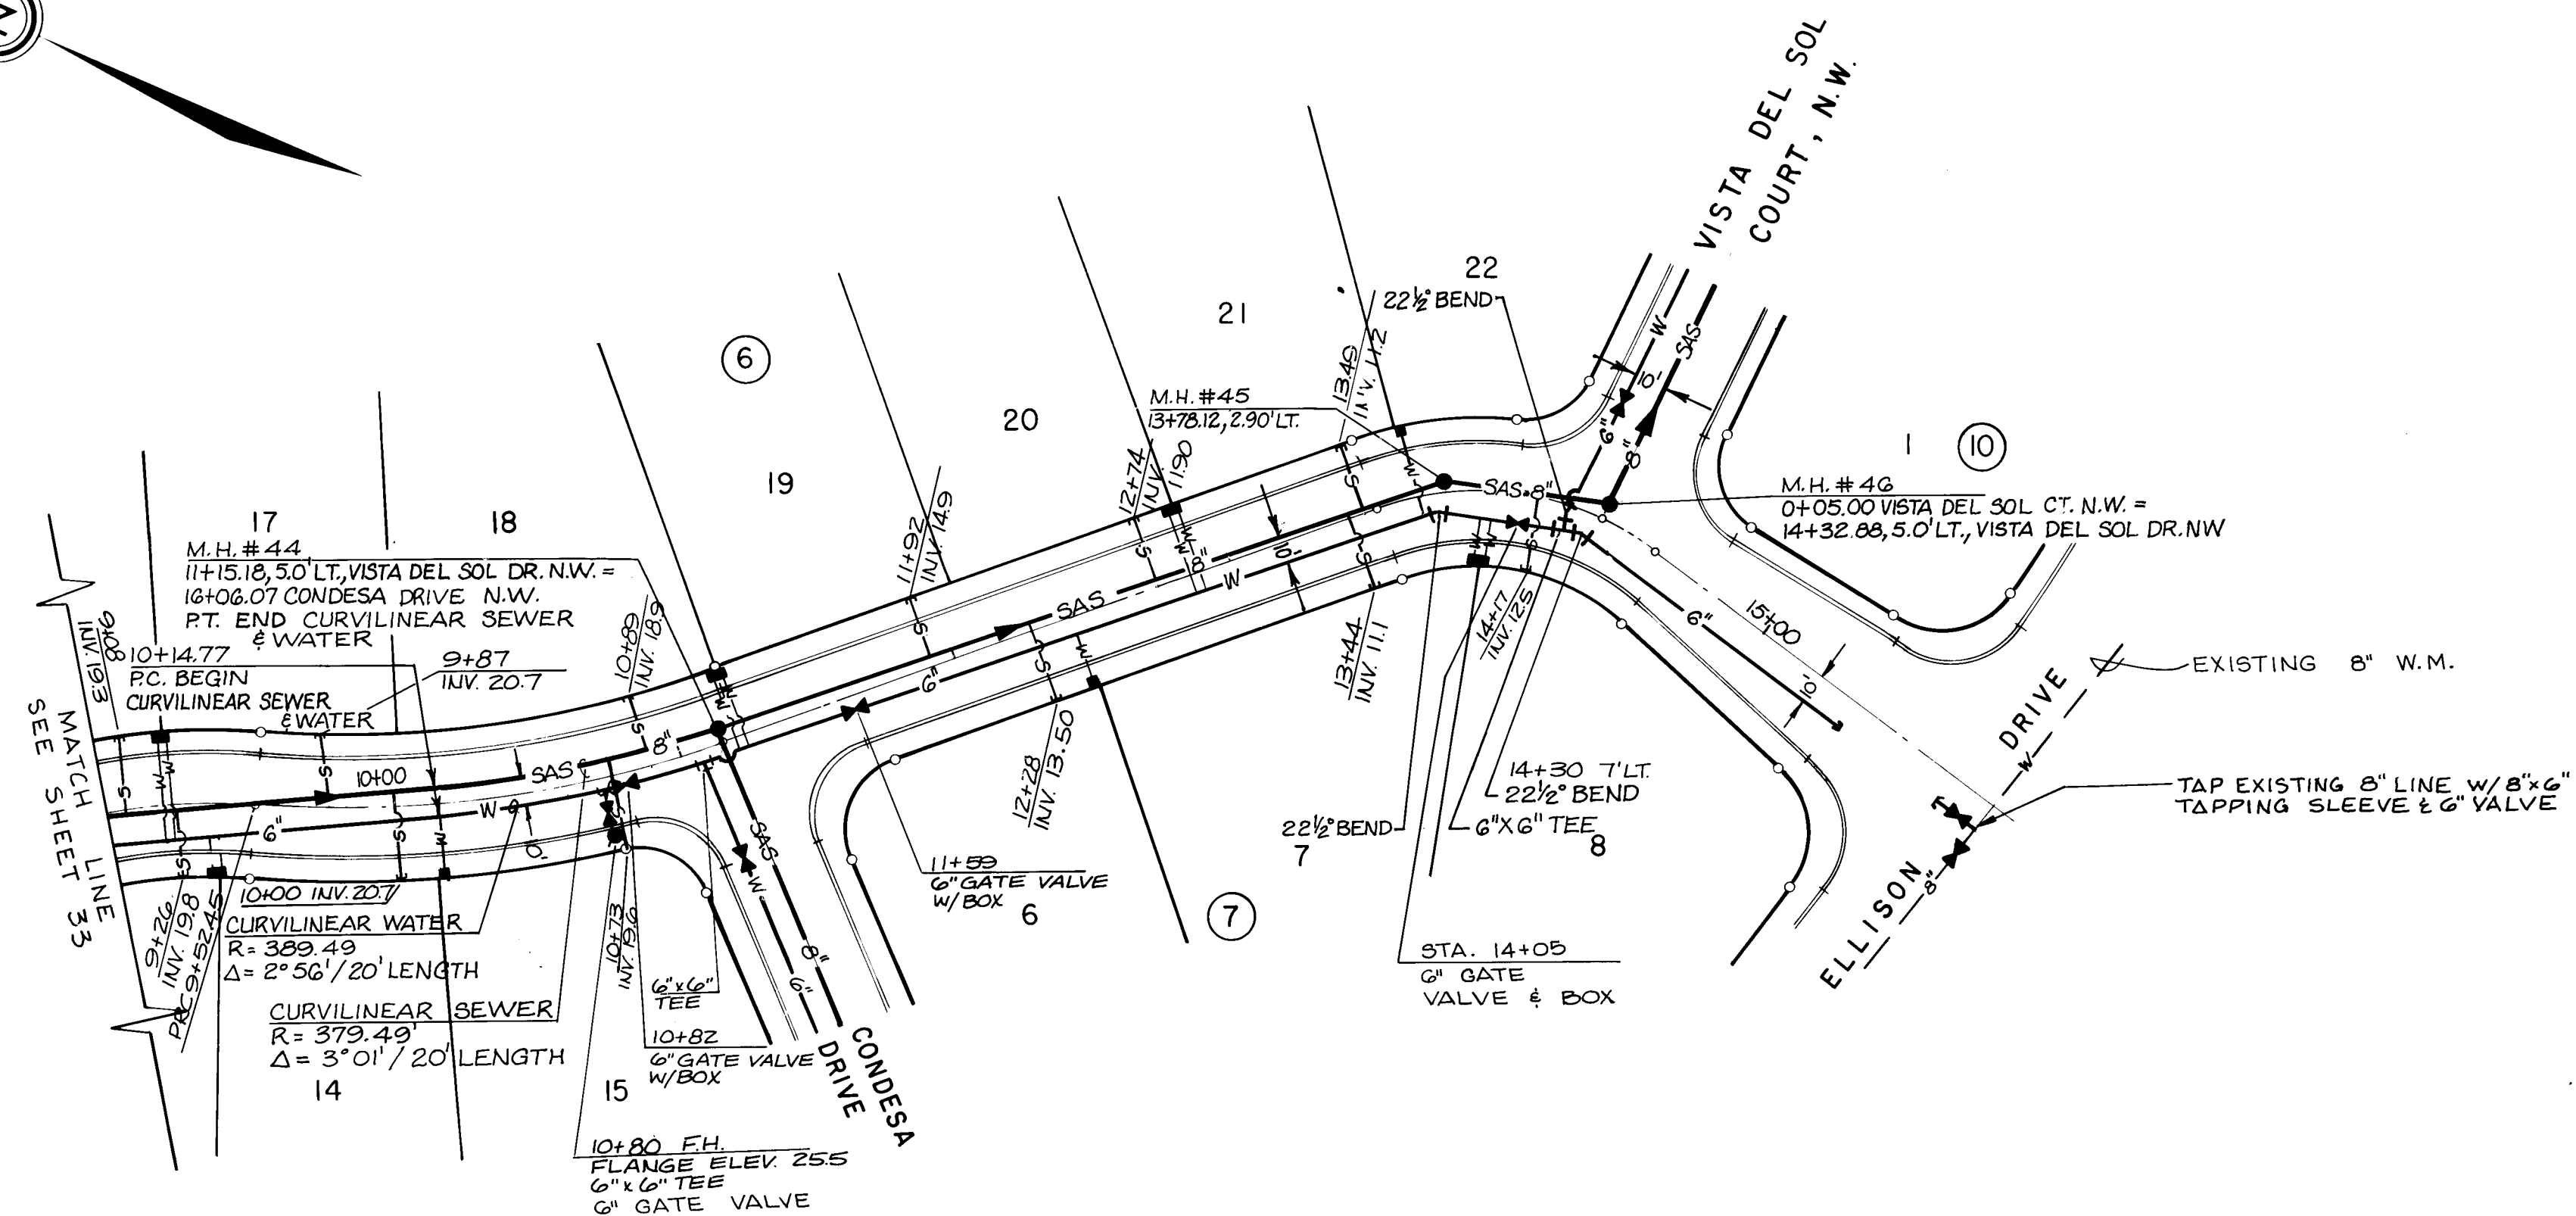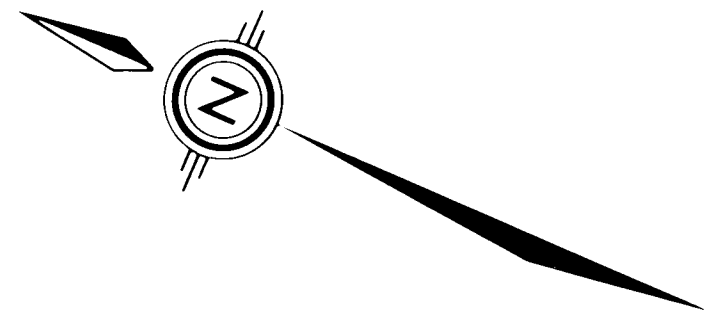


VISTA DEL SOL DRIVE

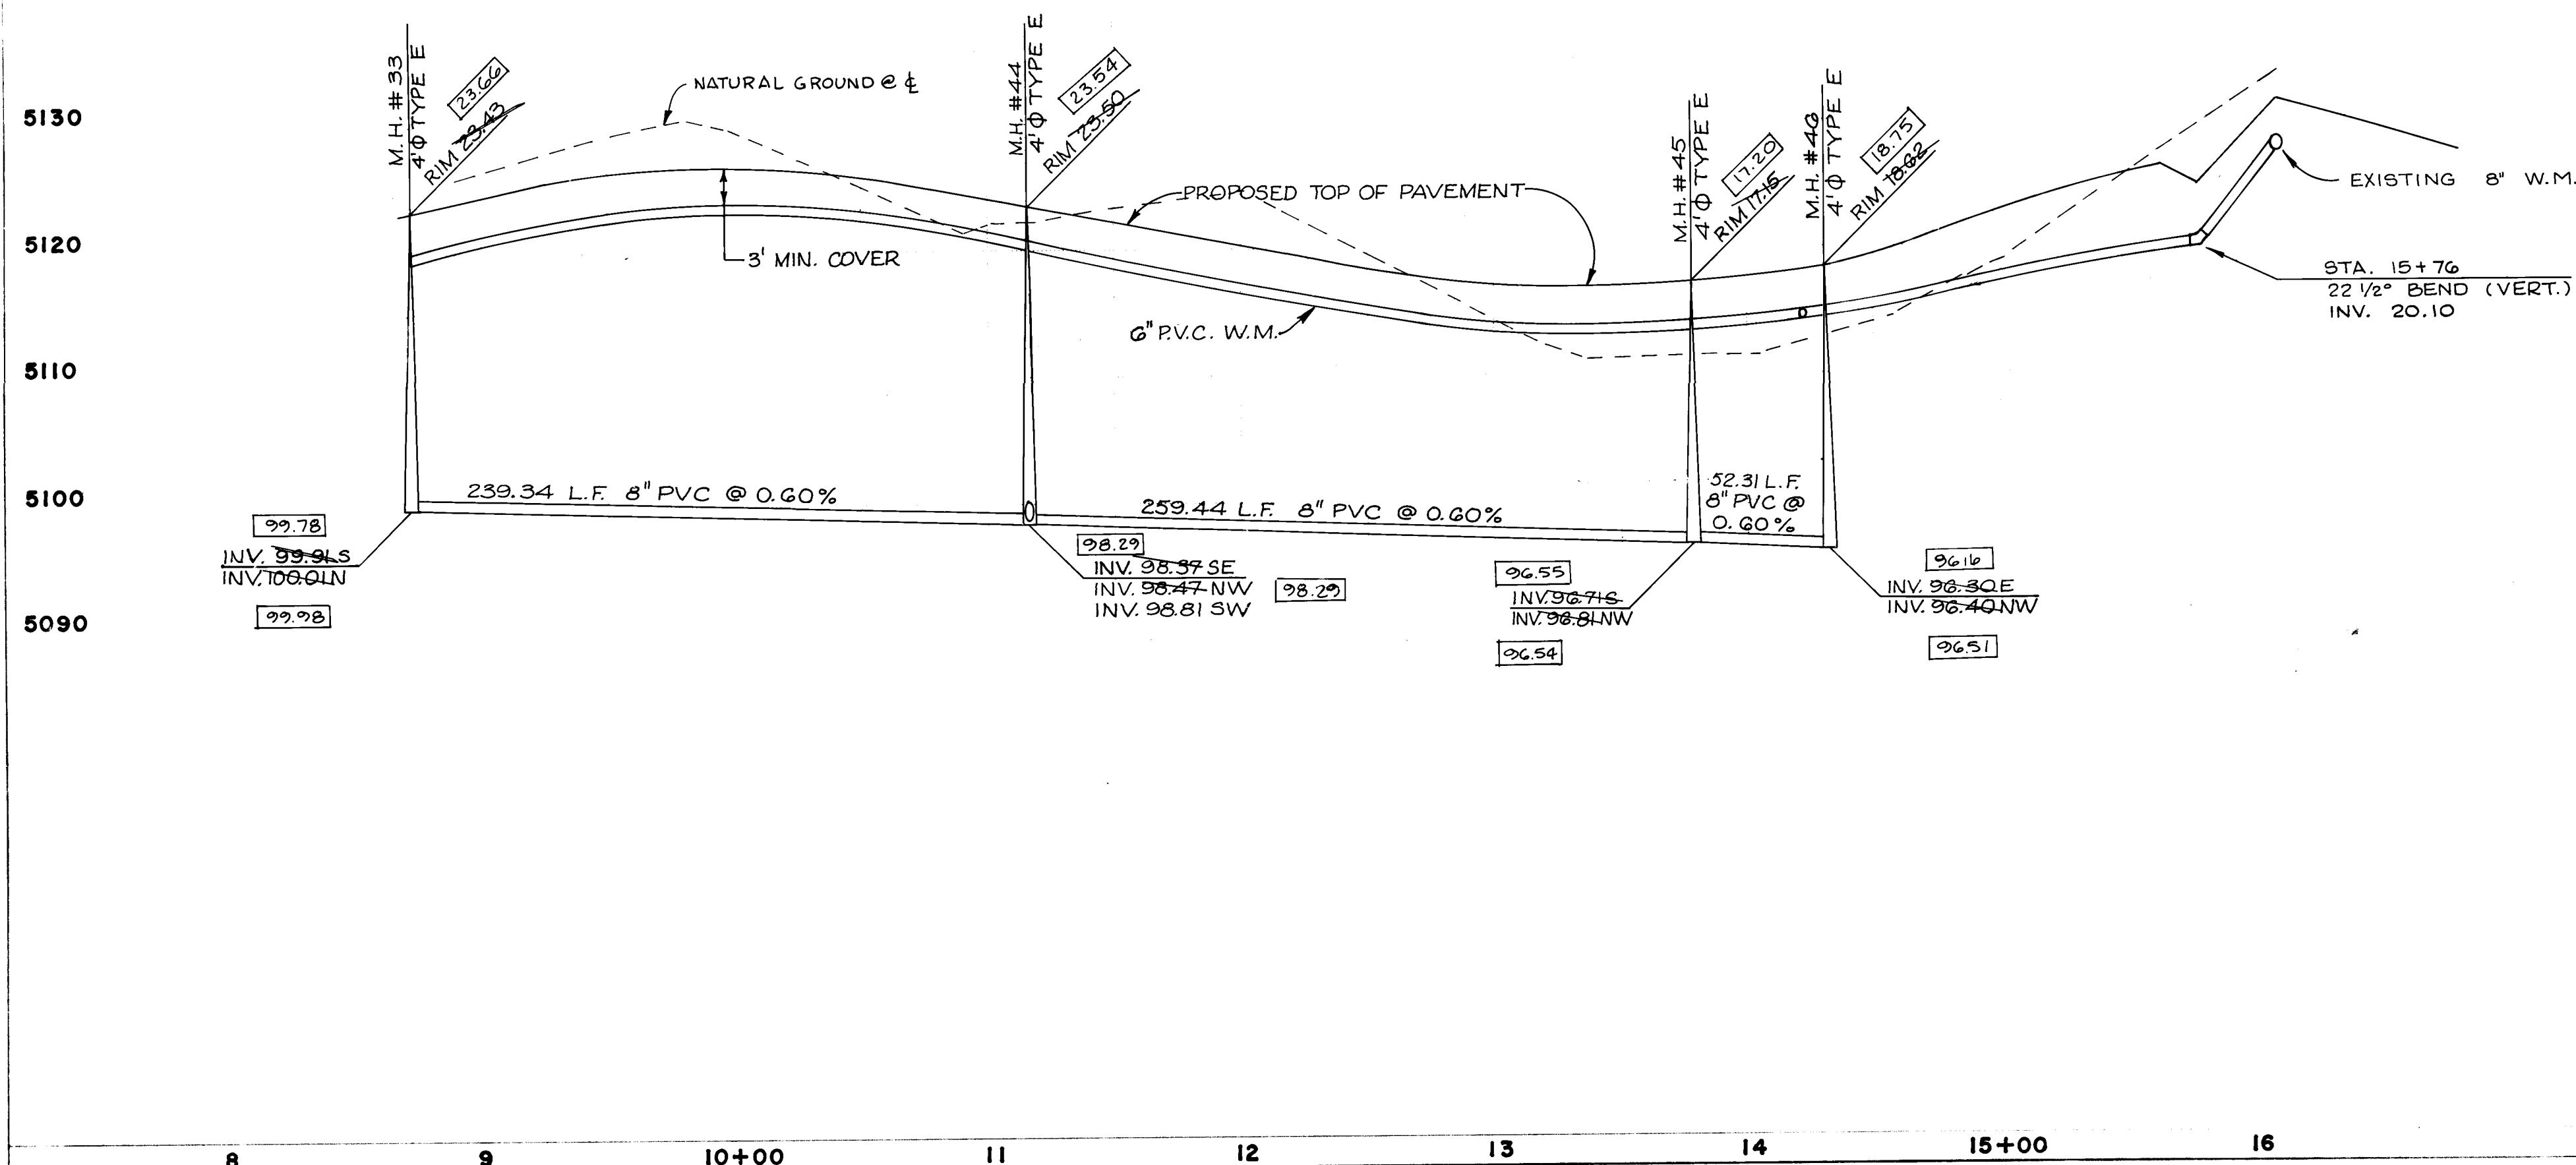


AS BUILT

SCALE: 1" = 50' HORIZ.
1" = 10' VERT.

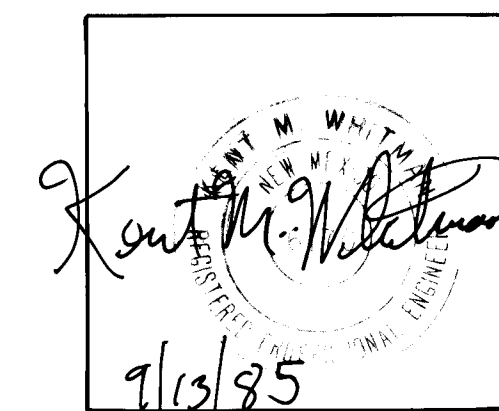

NOTE: THIS CERTIFICATION IS INTENDED TO INDICATE THAT IN THE ENGINEER'S OPINION THIS CONSTRUCTION IS IN SUBSTANTIAL COMPLIANCE WITH THE DESIGN AS SHOWN (OR AS ANNOTATED WITH UPDATED FIELD GRADES WHERE INDICATED). IT IS NOT A VERIFICATION OF CONTRACT COMPLIANCE IN THE LEVEL OF DETAIL ASSOCIATED WITH FULL CONSTRUCTION INSPECTION OF THE PROJECT.

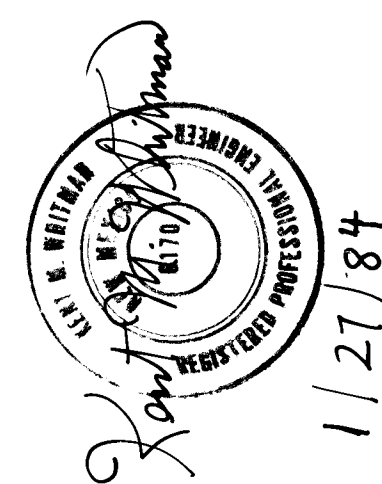

NOTE:

The waterline and sanitary sewerline are to belong to New Mexico Utility Company systems, not City of Albuquerque.

26 18693386

ENGINEER

Salida Del Sol - Unit Two - Utility Plan & Profile


VISTA DEL SOL DRIVE

1869

A-13


33 40

SOIL CEMENT EMBANKMENT STABILIZATION: SOIL CEMENT SHALL BE CONSTRUCTED FROM NATIVE GRANULAR SOILS WITH A 5% PORTLAND CEMENT CONTENT (BY WEIGHT) AND THOROUGHLY MIXED W/WATER TO OPTIMUM MOISTURE CONTENT. MIXTURE SHALL BE PROCESSED IN 6" LIFTS WITHIN 2 HRS. OF MIXING AND COMPACTED TO 95% OPTIMUM DRY DENSITY (MODIFIED) USING SMOOTH WHEELED VIBRATORY ROLLING EQUIPMENT. EMBANKMENT SHALL BE KEPT MOIST FOR 3 DAYS FOLLOWING PLACEMENT. AS AN ALTERNATE, CONTRACTOR MAY UTILIZE PLANT MIXED CEMENT TREATED BASE PER CURRENT CITY SPECIFICATIONS FOR ARTERIAL PAVEMENT. A 2' THICK X 4' DEEP CUT-OFF WALL OF THIS SAME SOIL CEMENT MIXTURE SHALL BE FURNISHED AT STA. 17 + 89 PER THE PROFILE BELOW.

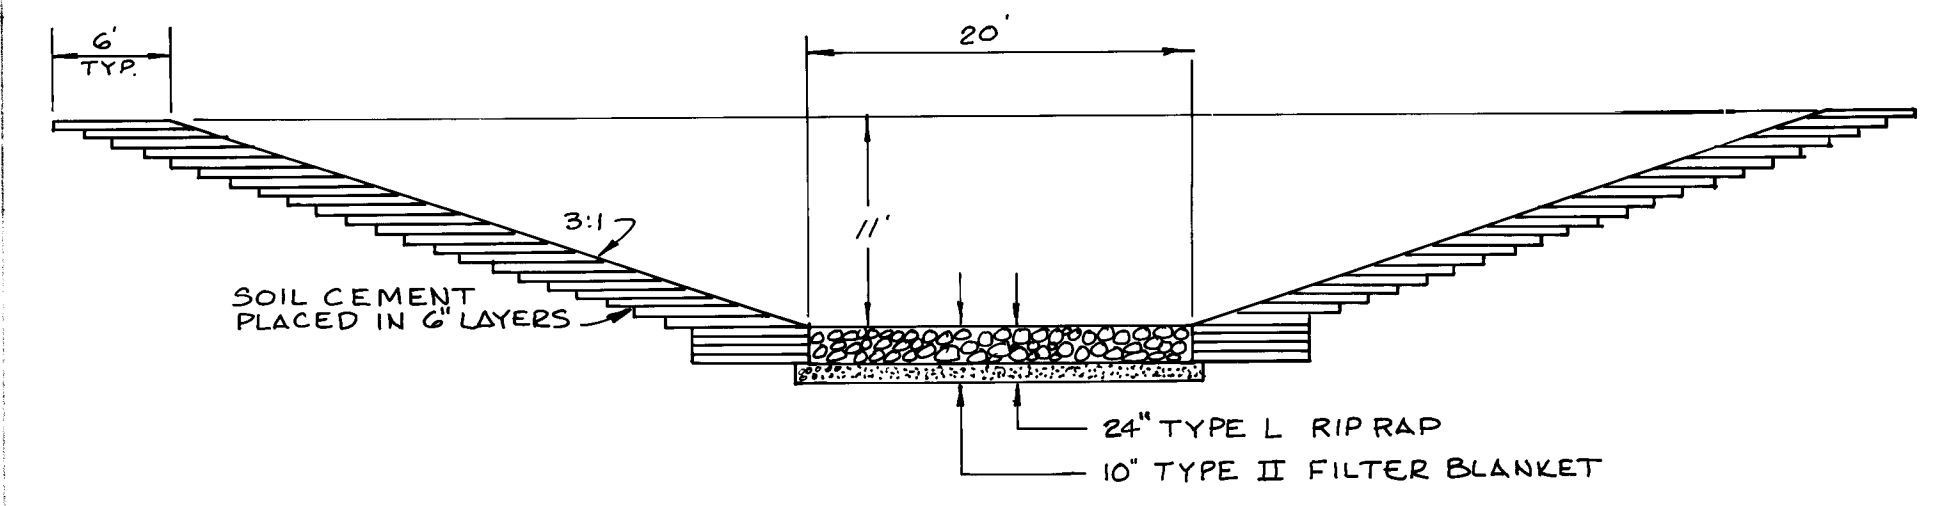


SECTION H
1" = 10'


CURVE DATA
 $\Delta = 28^\circ 16' 25''$
 $R = 465.0'$
 $T = 100.0'$

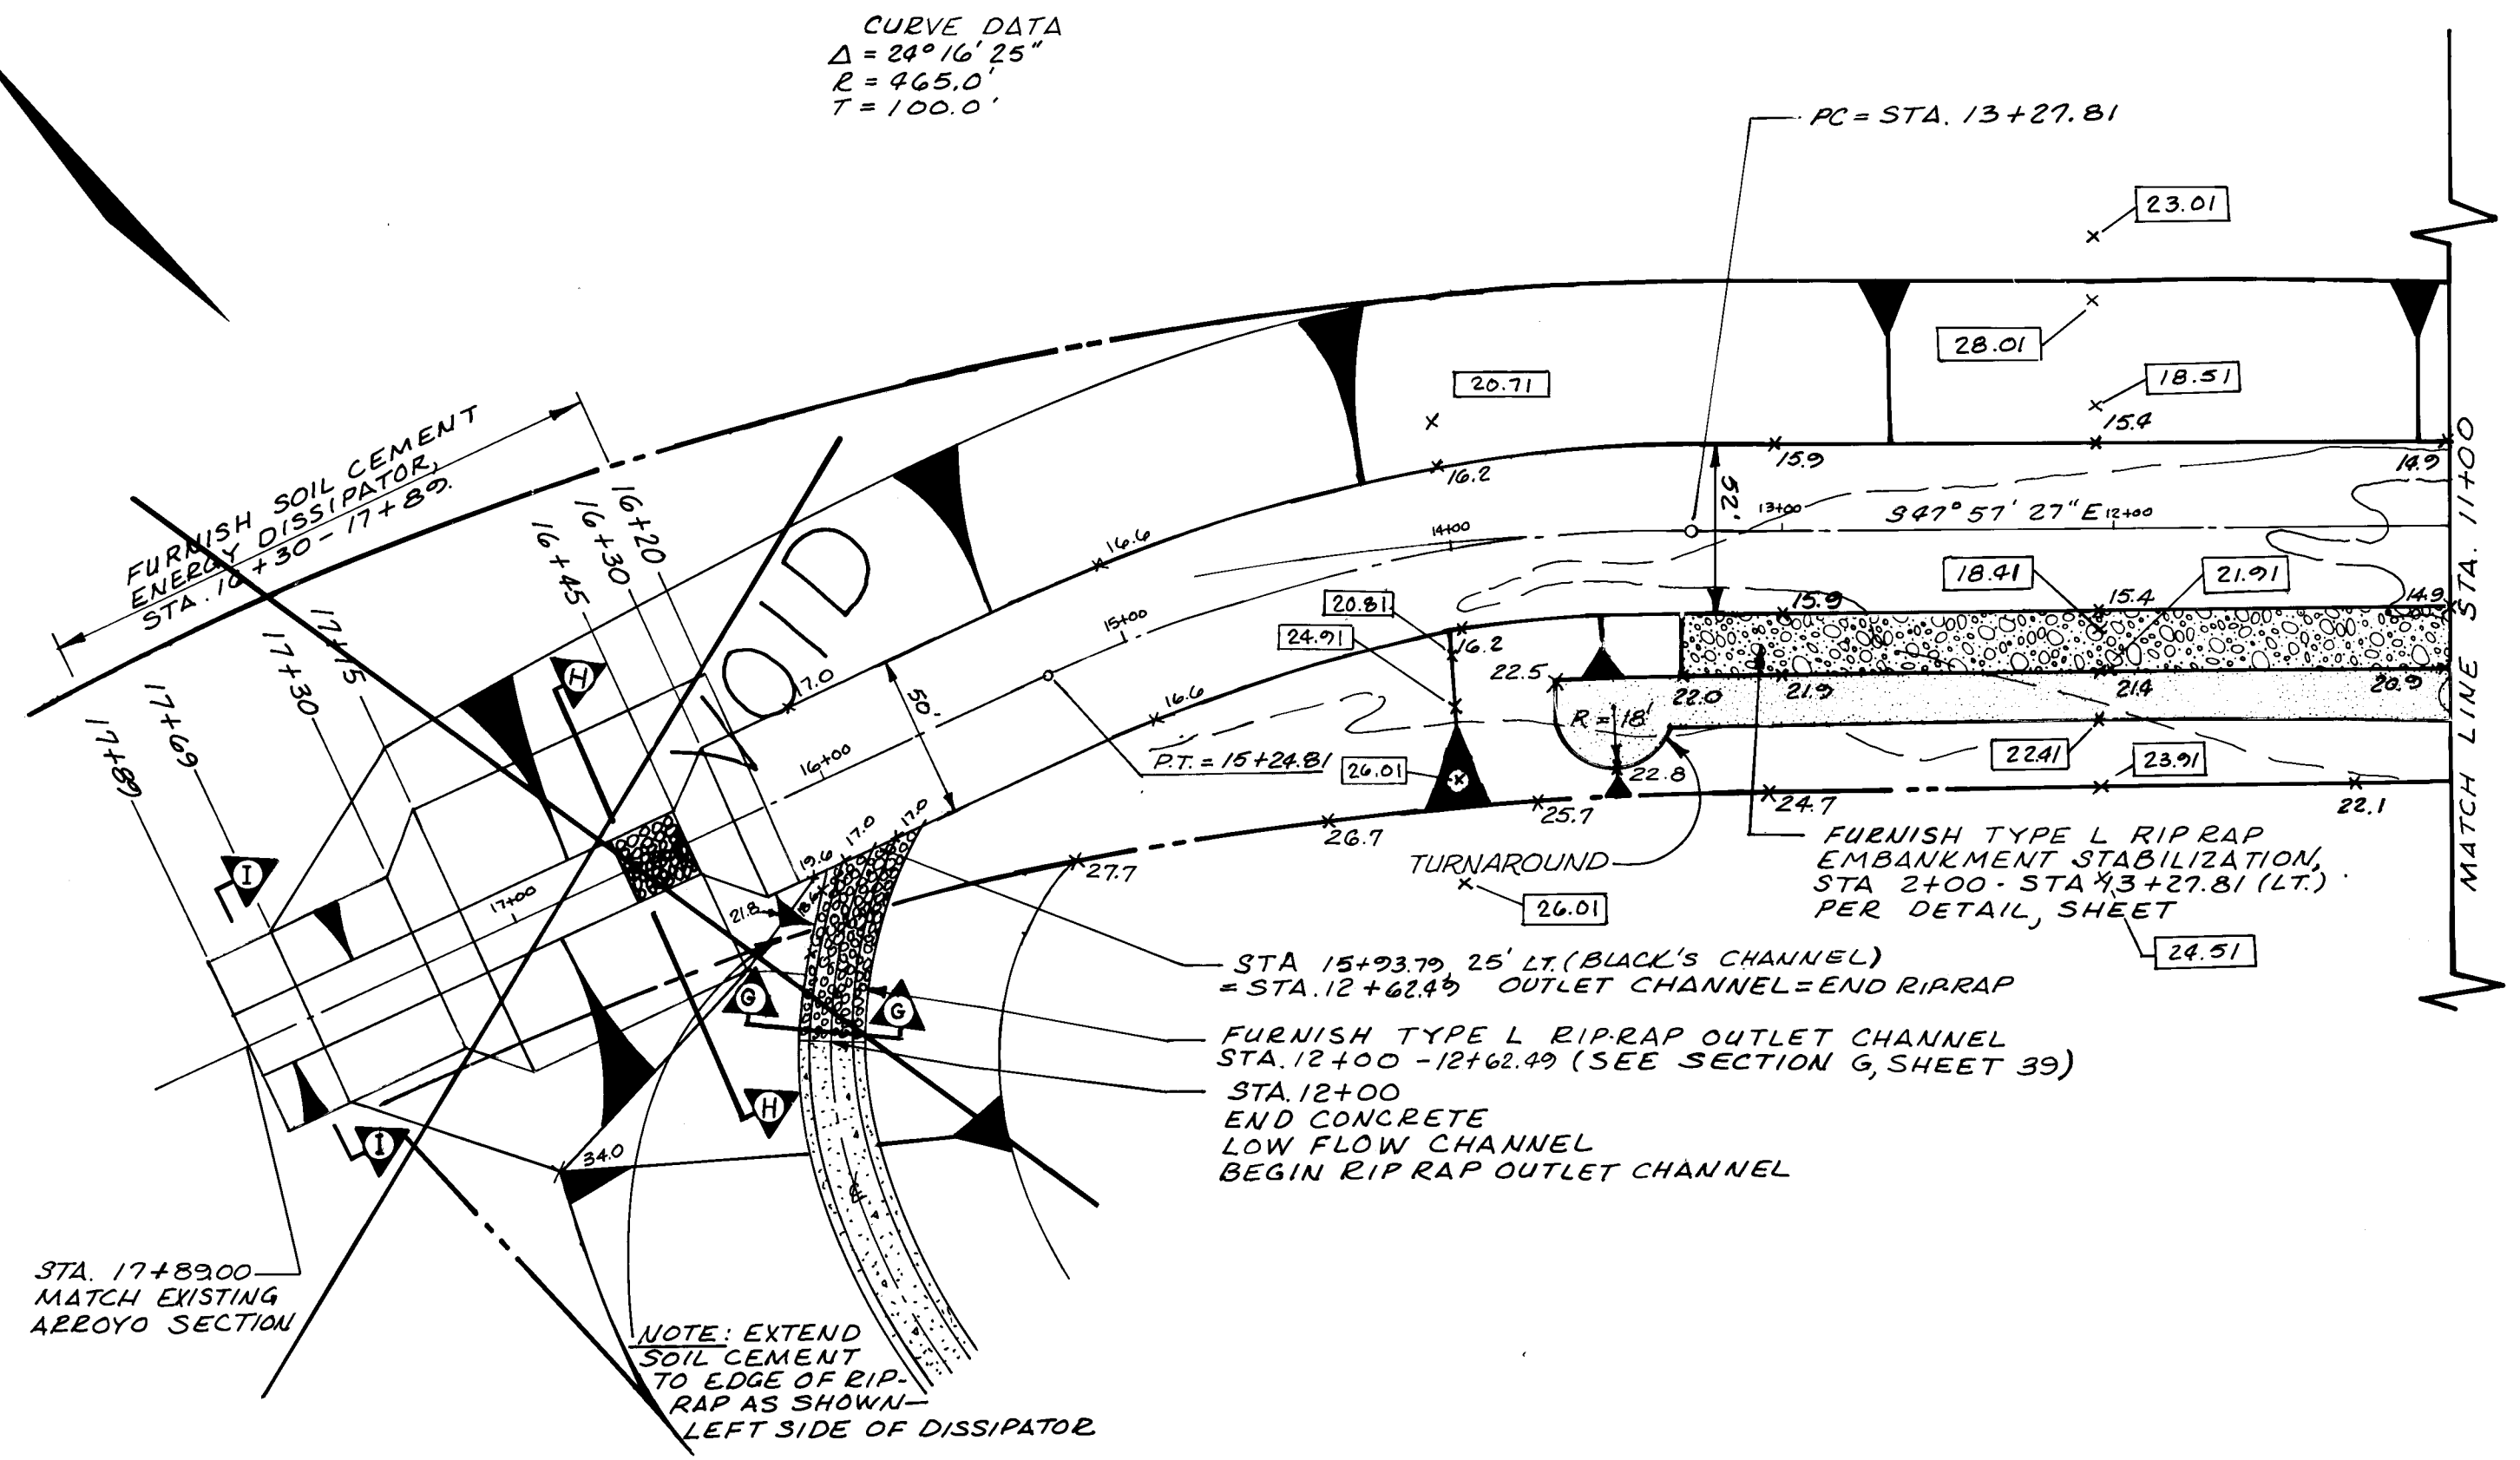


BLACK ARROYO CHANNEL

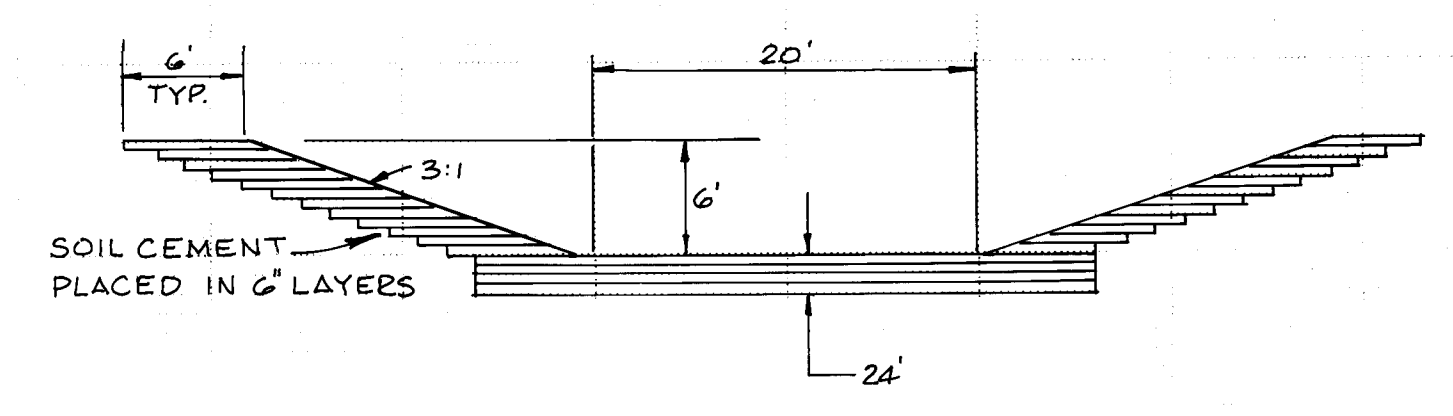

SECTION I
1" = 10'

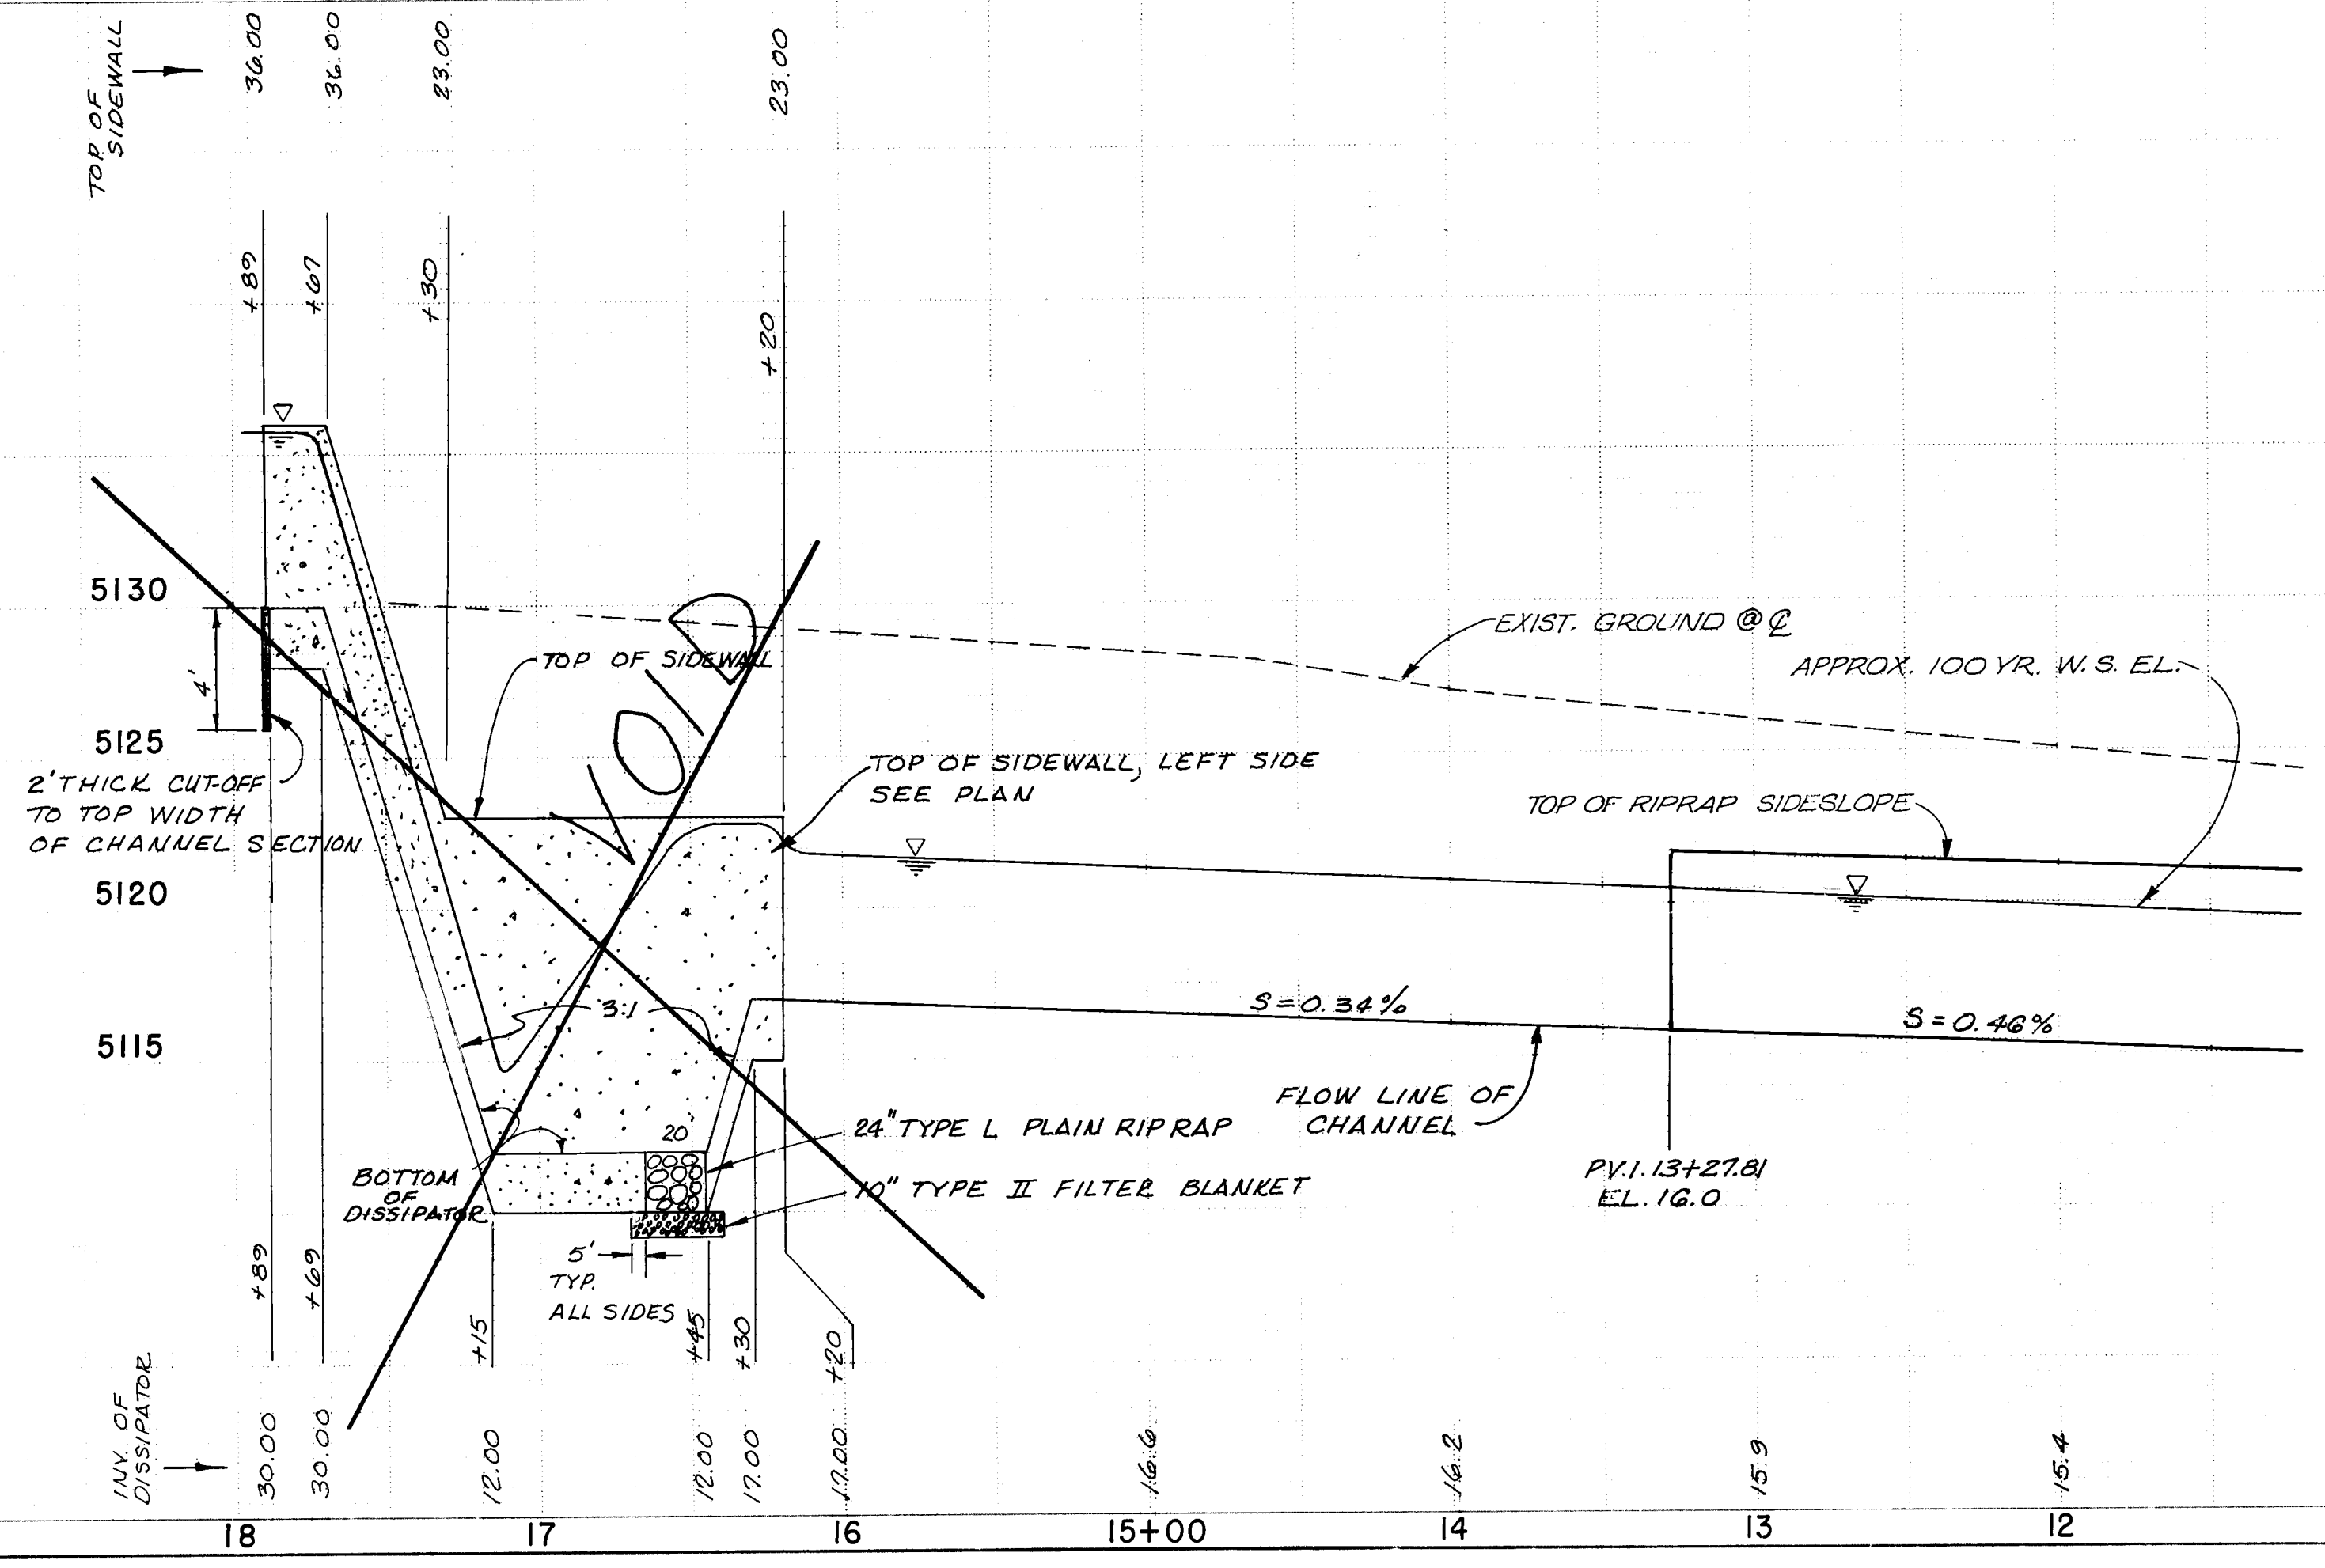

AS BUILT

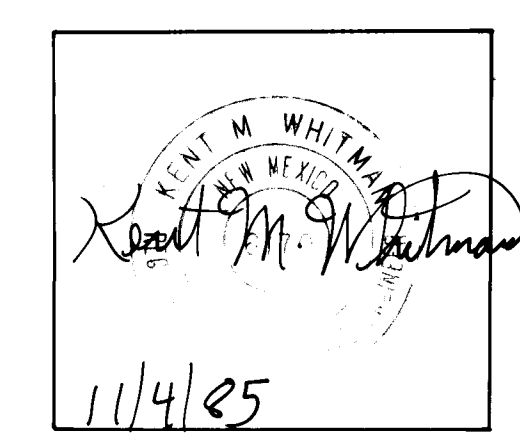

NOTE: THIS CERTIFICATION IS INTENDED TO INDICATE THAT IN THE ENGINEER'S OPINION THIS CONSTRUCTION IS IN SUBSTANTIAL COMPLIANCE WITH THE DESIGN AS SHOWN (OR AS ANNOTATED WITH UPDATED FIELD GRADES WHERE INDICATED). IT IS NOT A VERIFICATION OF CONTRACT COMPLIANCE IN THE LEVEL OF DETAIL ASSOCIATED WITH FULL CONSTRUCTION INSPECTION OF THE PROJECT.


SCALE: 1" = 50' Horizontal
1" = 5' Vertical


CITY OF ALBUQUERQUE
MUNICIPAL DEVELOPMENT DEPARTMENT
ENGINEERING DIVISION
TITLE: SALIDA DEL SOL-UNIT ONE-PAVING PLAN & PROFILE
BLACK ARROYO CHANNEL

APPROVALS	ENGINEER	DATE	APPROVALS	ENGINEER	DATE
City Engineer	<i>[Signature]</i>	8/16/04	Water	<i>[Signature]</i>	2/28/04
A.C.E. Design	<i>[Signature]</i>	8/26/04	Traffic	<i>[Signature]</i>	2/28/04
A.C.E. Hydrology	<i>[Signature]</i>	2/28/04	Water Res.	<i>[Signature]</i>	2/28/04
A.M.A.F.C.A.	<i>[Signature]</i>				

DRAWING NO. 1869 MAP NO. A-13 SHEET 35 OF 40

ENGINEER'S SEAL	SURVEY INFORMATION	BENCH MARKS	AS BUILT INFORMATION
	FIELD NOTES DATE BY	A SQUARE CHISEL IN THE TOP OF THE EASTERLY WALL OF THE A.M.A.F.C.A. FLOOD DIVERSION NO. 2 CHANNEL, APPROXIMATELY 180 FEET SOUTH OF THE POINT OF CONJUNCTION WITH THE SKYVIEW DRAINAGE CHANNEL ESTABLISHED BY BOHANNAN-HUSTON AND MARKED "TBM 205". ELEVATION = 5110.55	AS BUILT INFORMATION

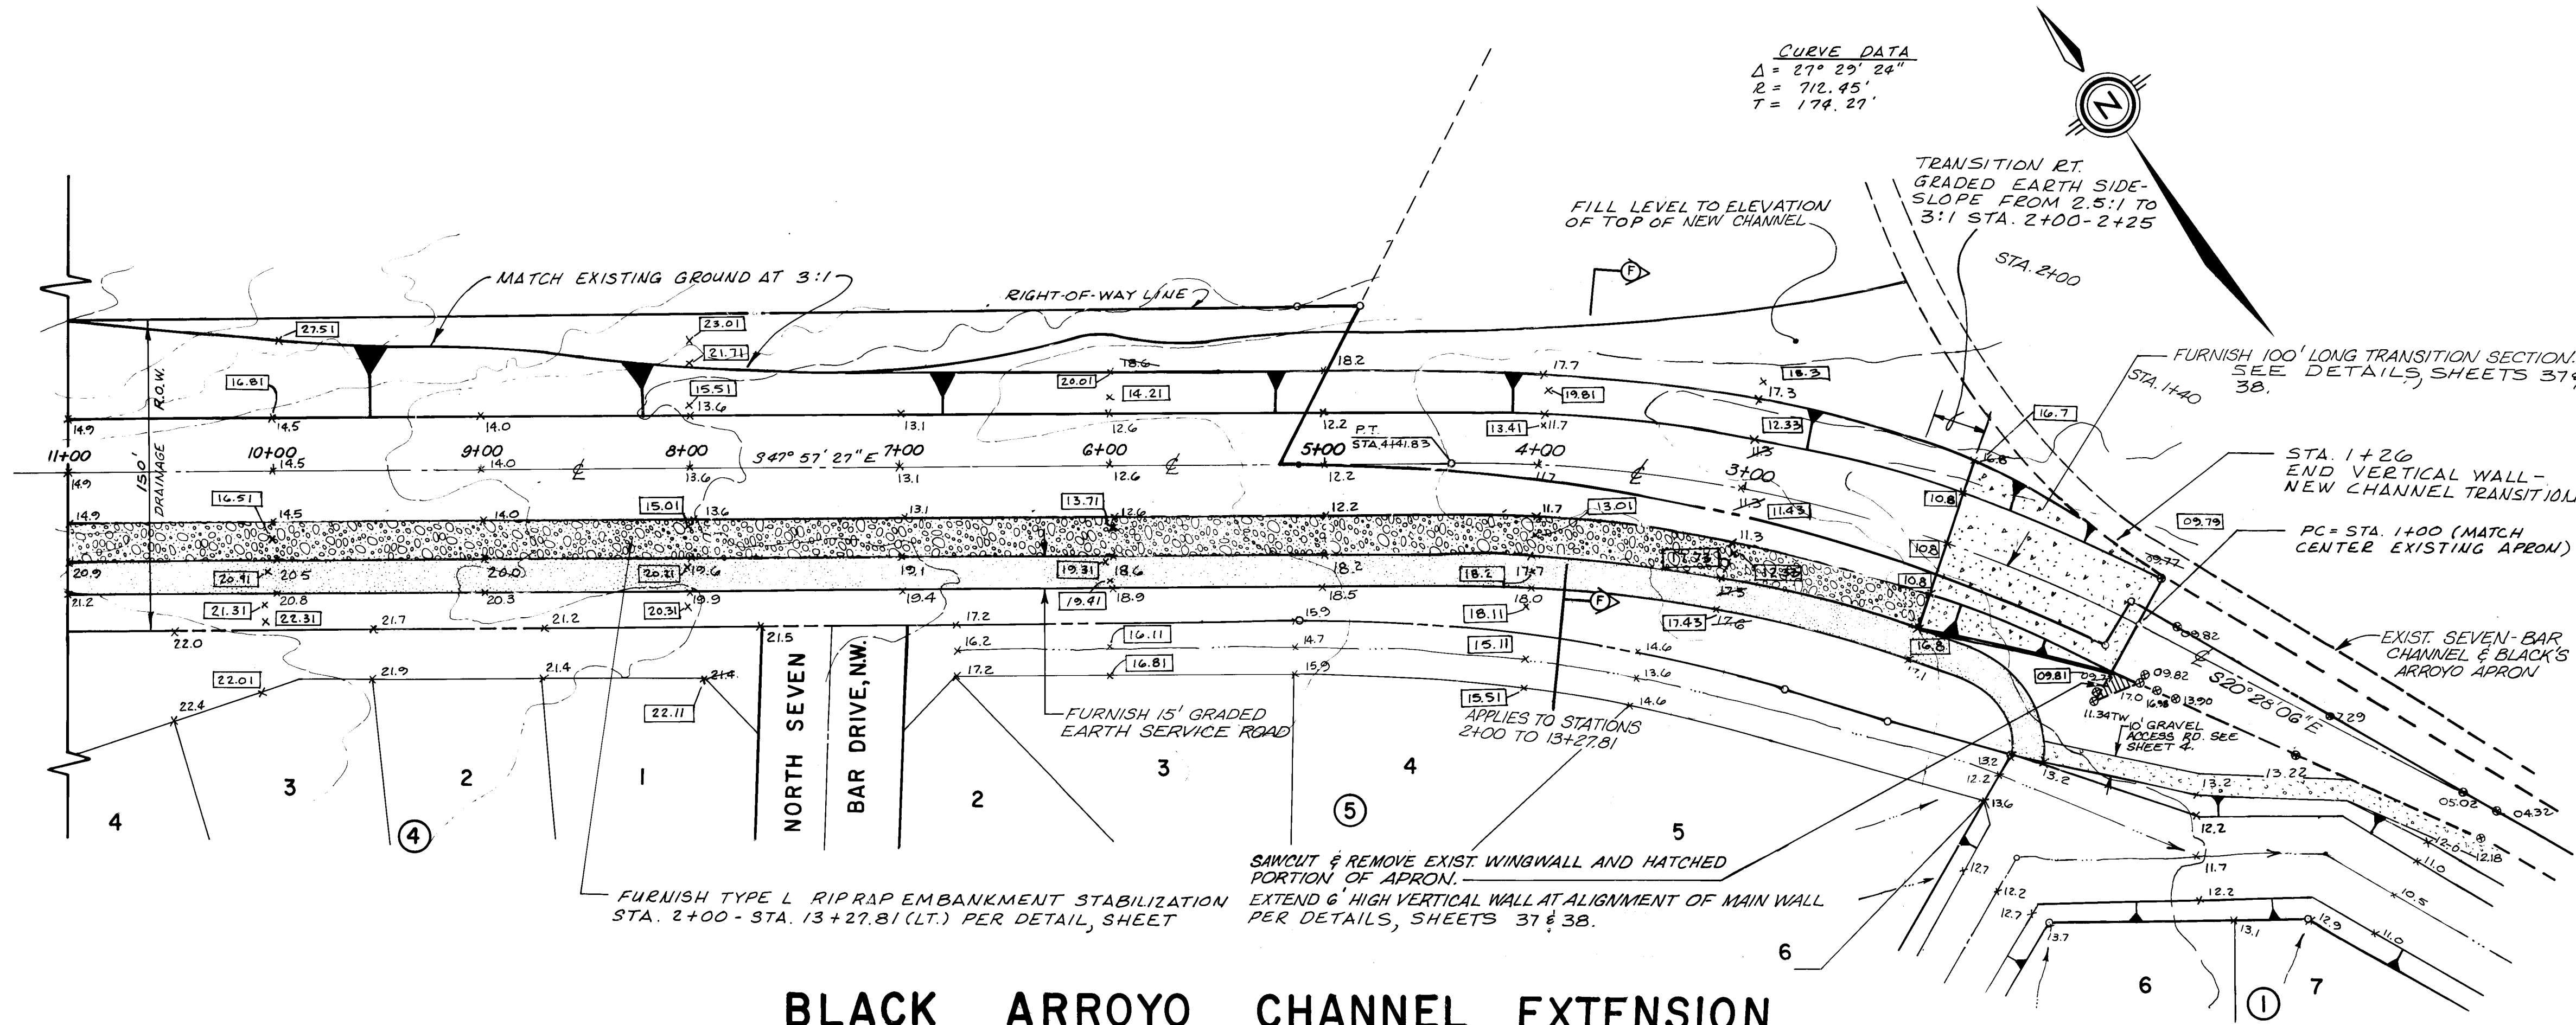

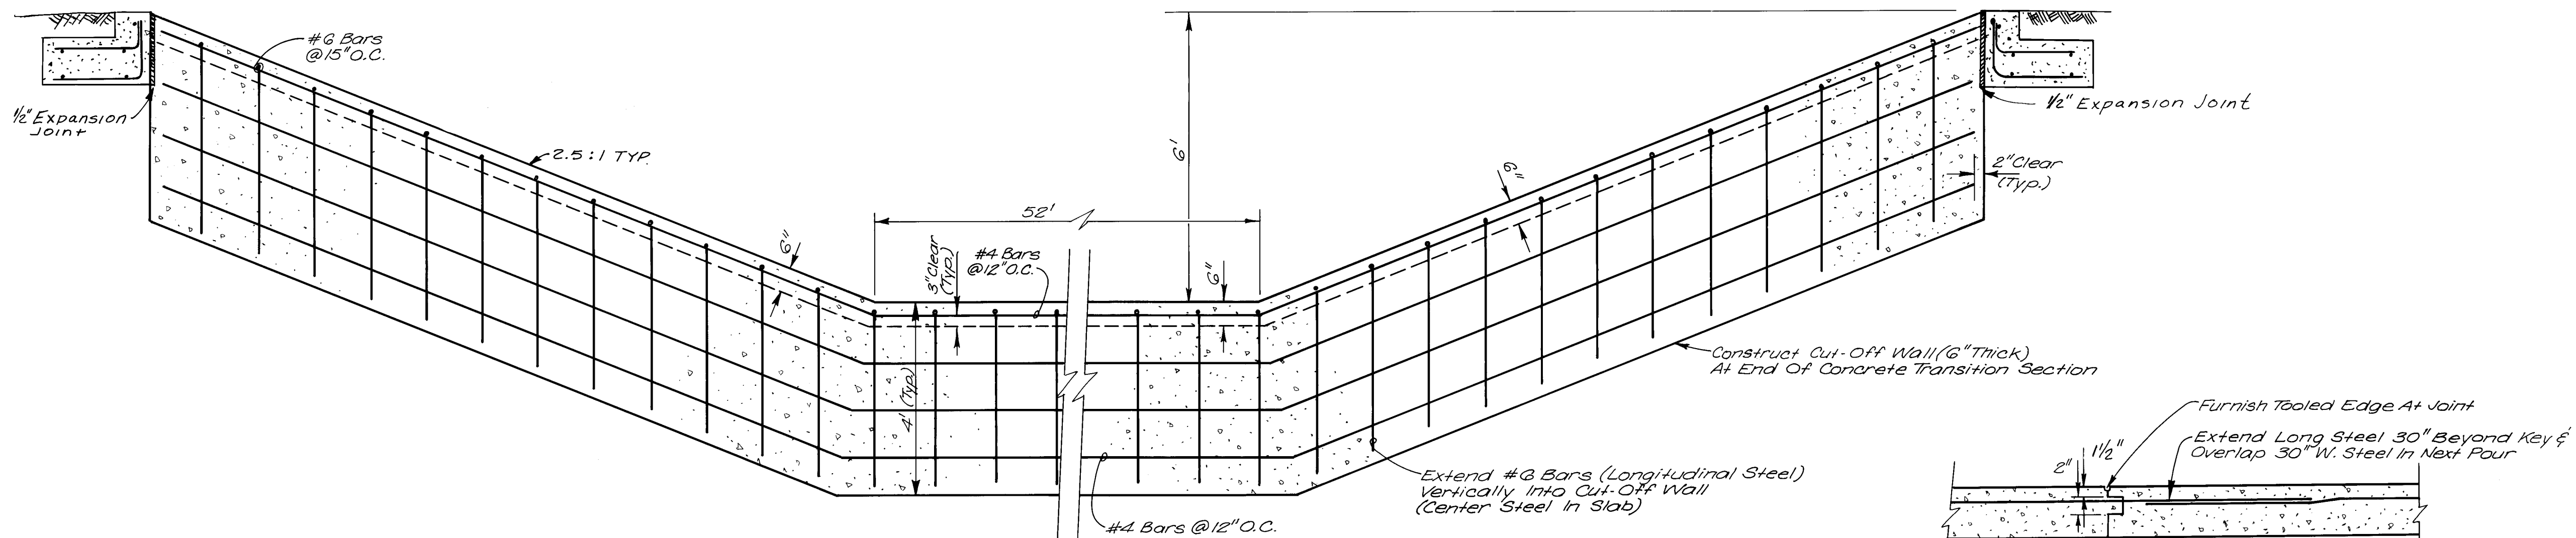


SECTION "E" - Concrete Cut-off @ End of Transition.

Scale: 1" = 2'


TYPICAL CONSTRUCTION JOINT

(TO BE USED BETWEEN POURS)
N.T.S.

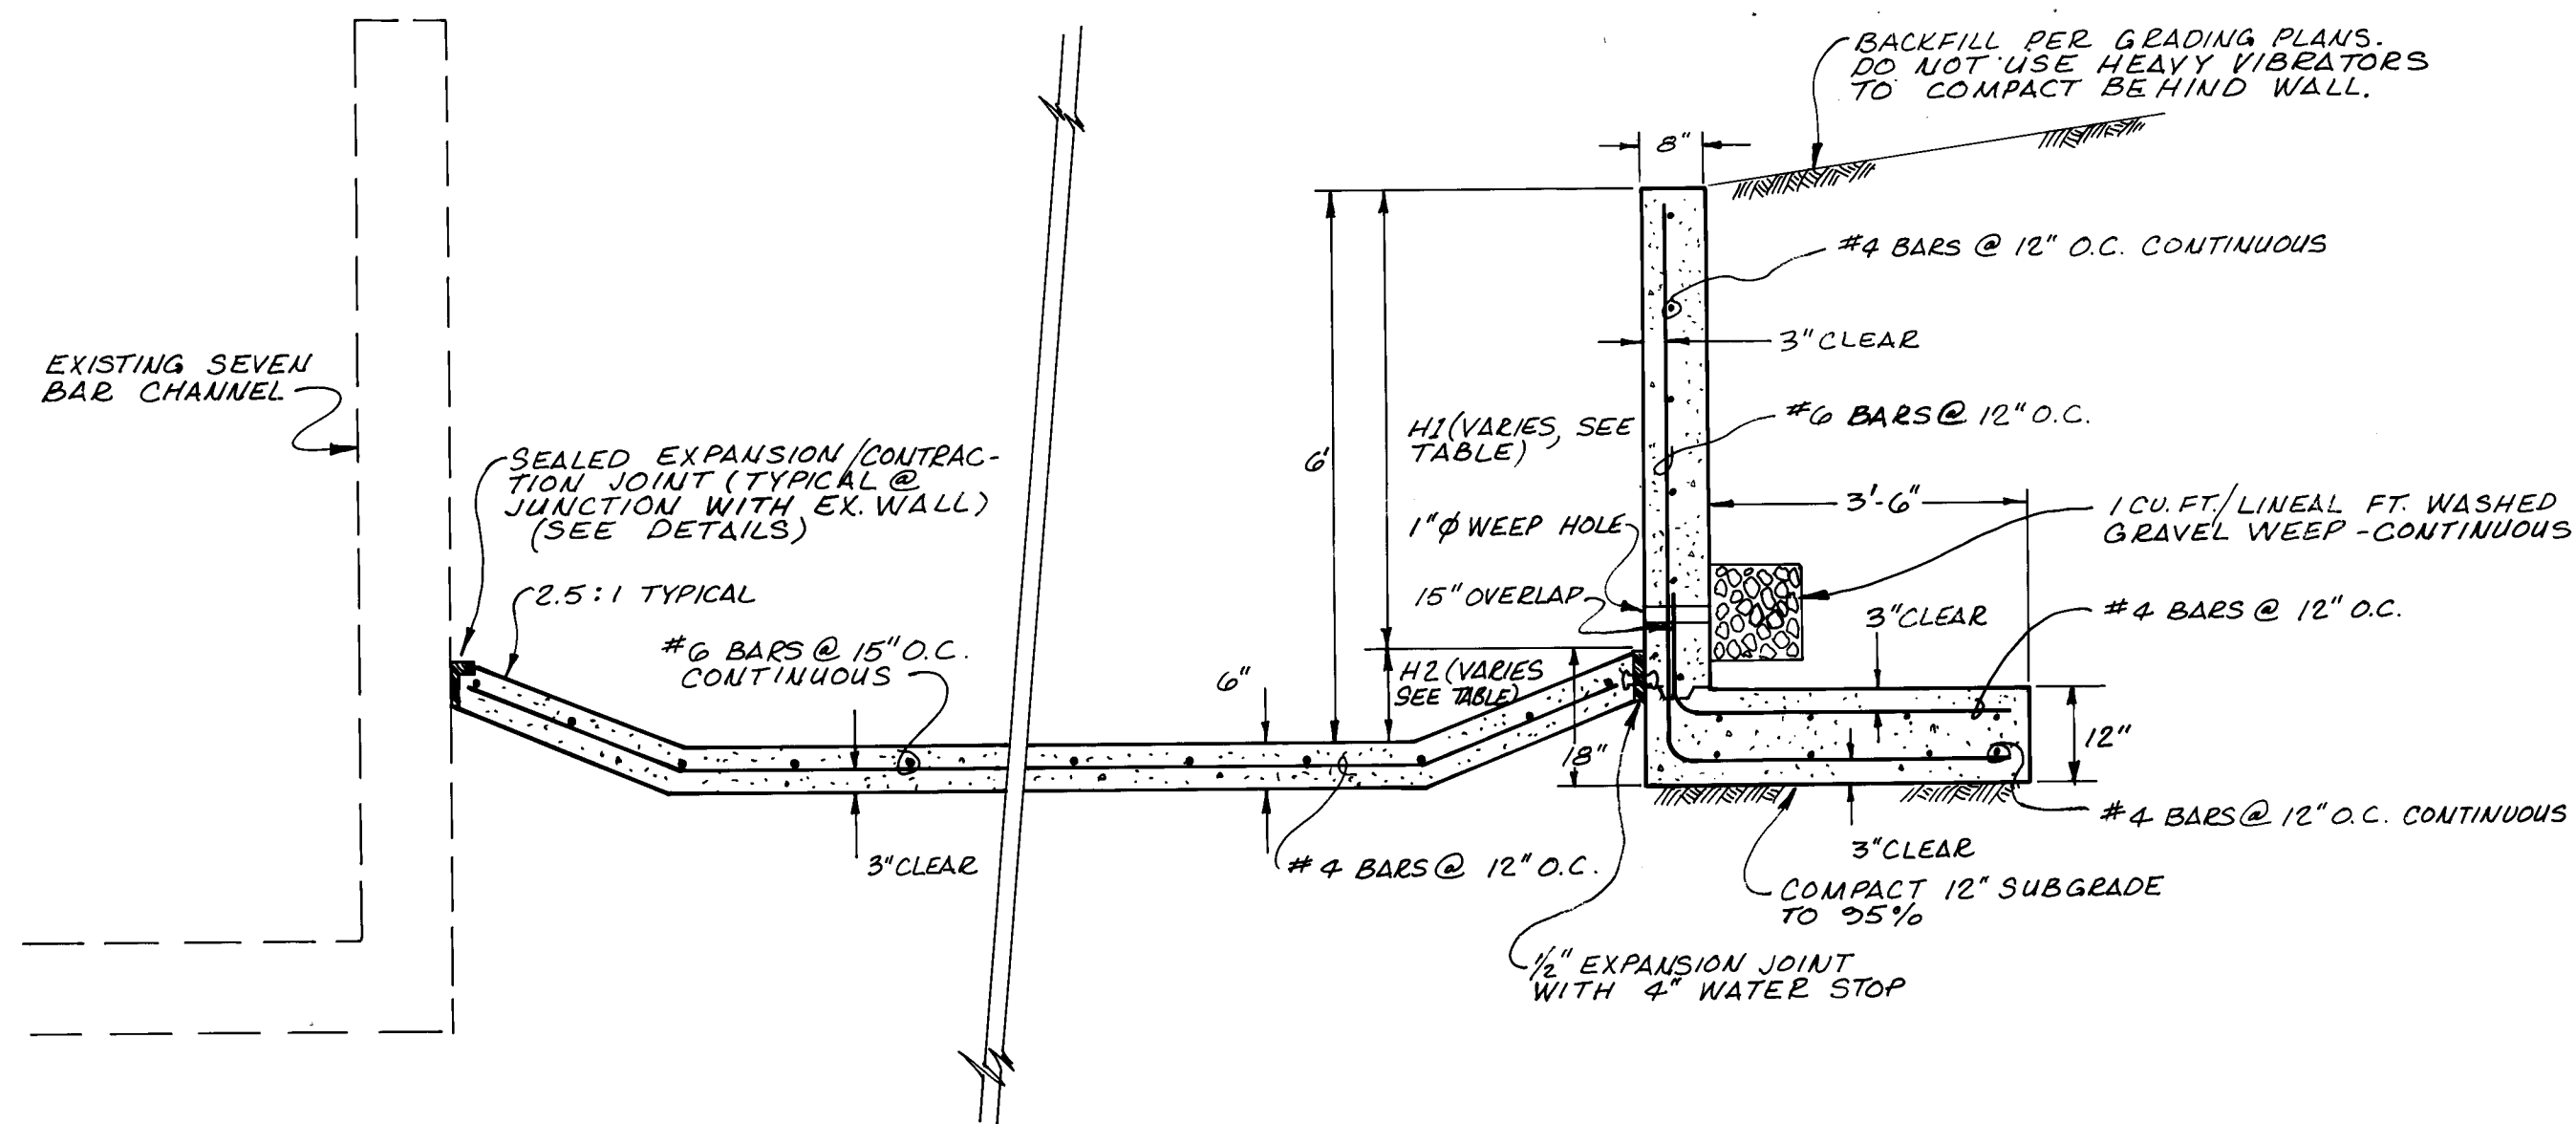


SECTION "B"

Scale: 1" = 2'

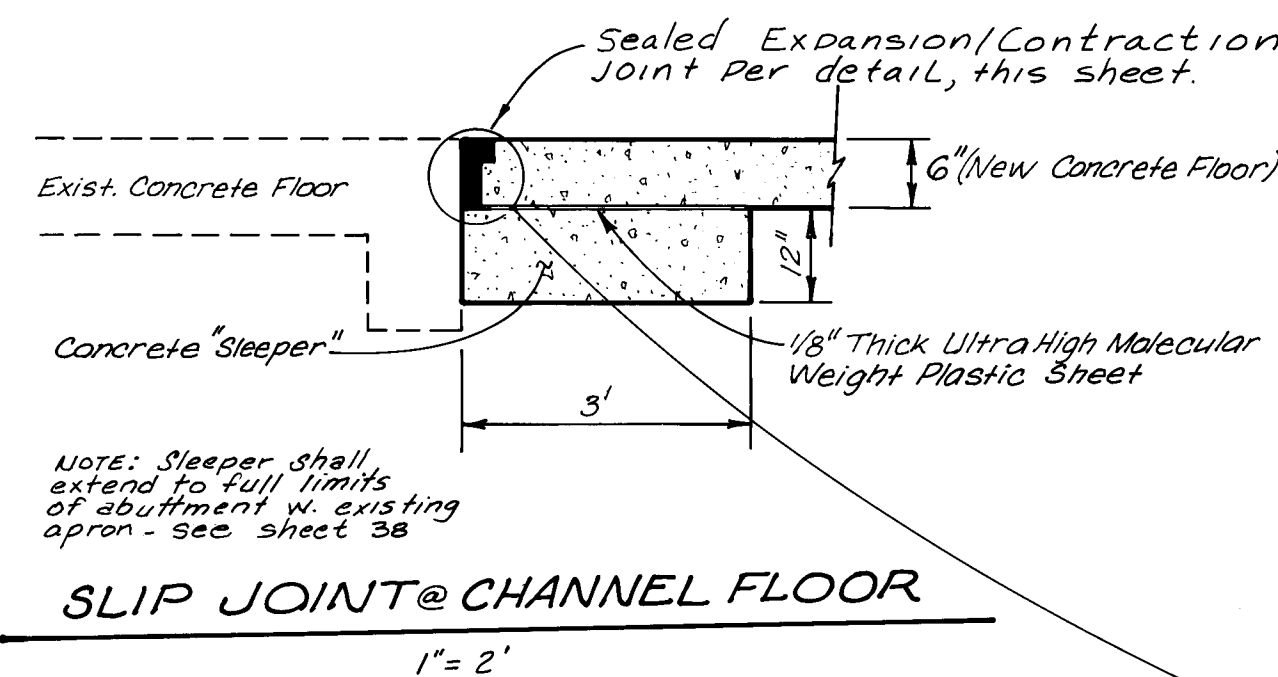


SLIP JOINT @ CHANNEL FLOOR

1" = 2'

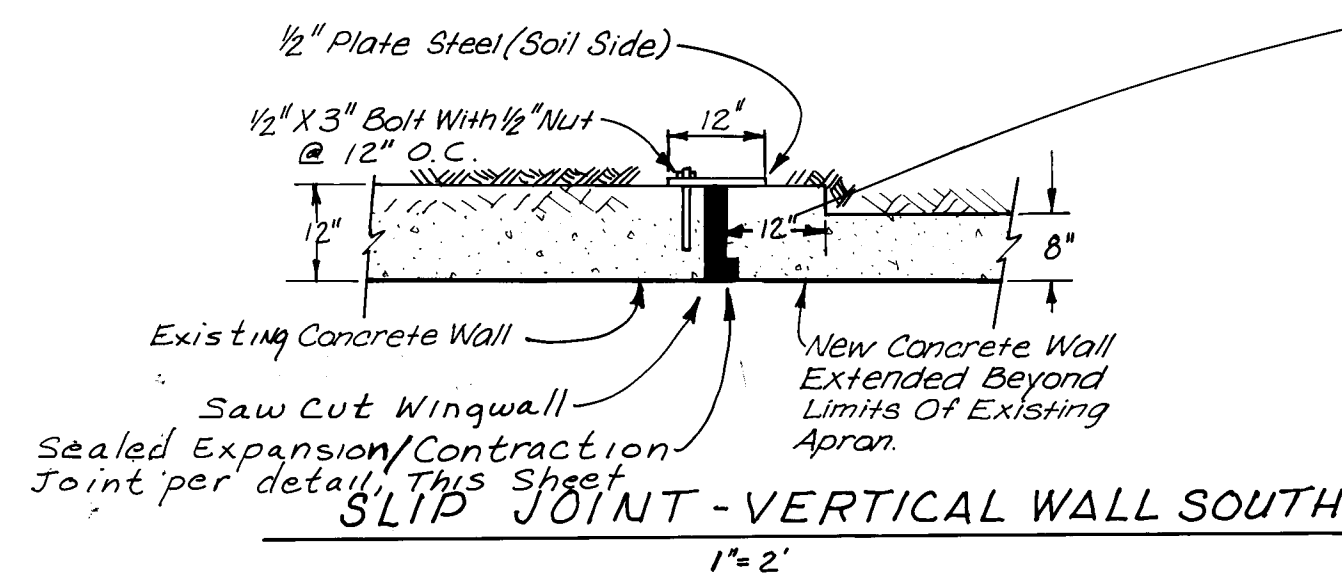

SLIP JOINT - VERTICAL WALL SOUTH

1" = 2'

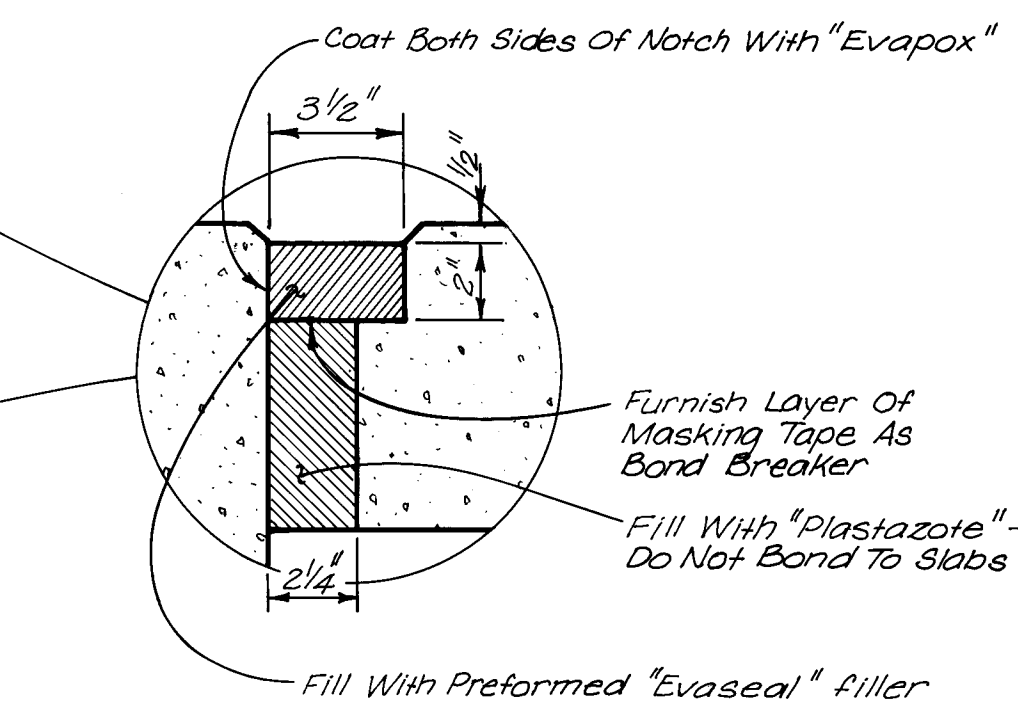

SEALED EXPANSION/CONTRACTION JOINT

1" = 1/2'

TYPE L RIPRAP SPECS


% Smaller Than Given Size By Weight	Minimum Dimension Inches	*K _m Inches
100	12	9
35-55	9	
10	2	

Type II Filter Specs

Sieve Size	% By Weight Passing Square Mesh Sieves
2"	80-100
3/4"	20-90
#4	0-20
#200	0-3

*K_m = Median Stone Size


RIp RAP SHALL BE HARD, DURABLE, ANGULAR STONE WITH A SPECIFIC GRAVITY OF 2.5 OR GREATER

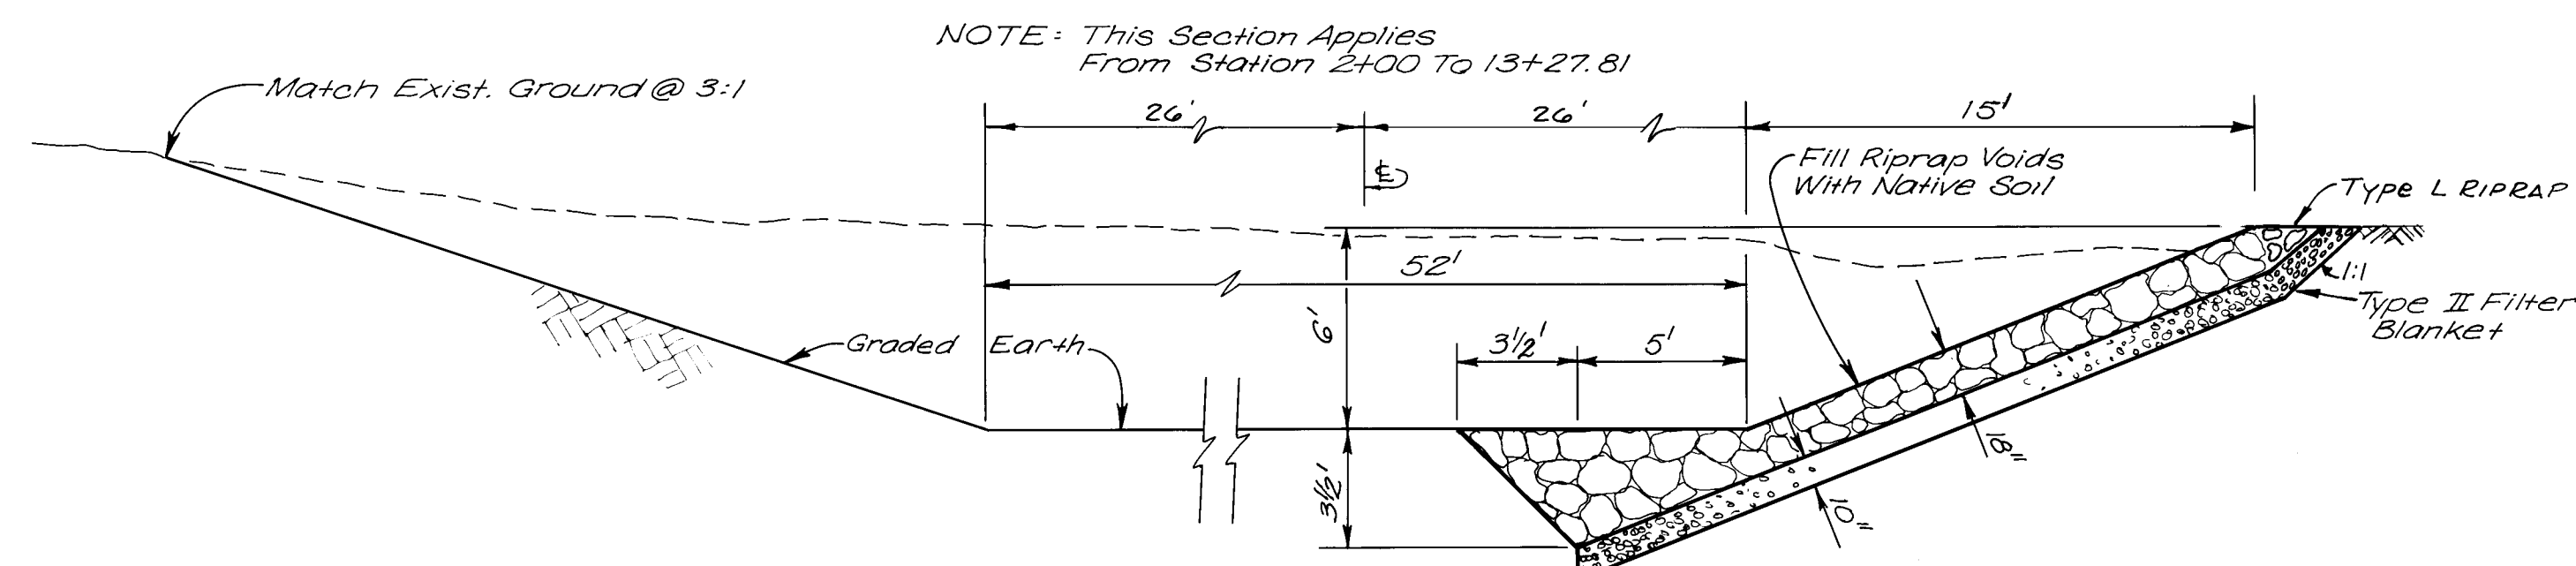

SECTION "F"

Scale: 1" = 5'

AS BUILT

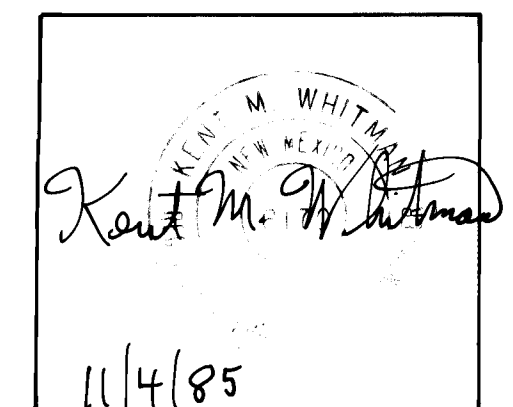

NOTE: THIS CERTIFICATION IS INTENDED TO INDICATE THAT IN THE ENGINEER'S OPINION, THE CONSTRUCTION IS IN SUBSTANTIAL COMPLIANCE WITH THE DESIGN AS SHOWN (OR AS ANNOTATED WITH UPDATED FIELD GRADES WHERE INDICATED). IT IS NOT A VERIFICATION OF CONTRACT COMPLIANCE IN THE LEVEL OF DETAIL ASSOCIATED WITH FULL CONSTRUCTION INSPECTION OF THE PROJECT.


26 18693786

CITY OF ALBUQUERQUE
MUNICIPAL DEVELOPMENT DEPARTMENT
ENGINEERING DIVISION

TITLE: SALIDA DEL SOL UNIT ONE
BLACK ARROYO CHANNEL DETAILS

APPROVALS	ENGINEER	DATE	APPROVALS	ENGINEER	DATE
City Engineer	<i>[Signature]</i>	8/1/84	Liquid Waste		
A.C.E. - Design	<i>[Signature]</i>	8/1/84	Tratic	<i>[Signature]</i>	4/15/84
A.C.E. - Hydrology	<i>[Signature]</i>	2/25/84	Water Res	<i>[Signature]</i>	2-8-84
A.M.A.F.C.A.	<i>[Signature]</i>	2/12/84			
DRAWING NO.	1869		MAP NO.	A-13	
			SHEET	37	OF 40

1869

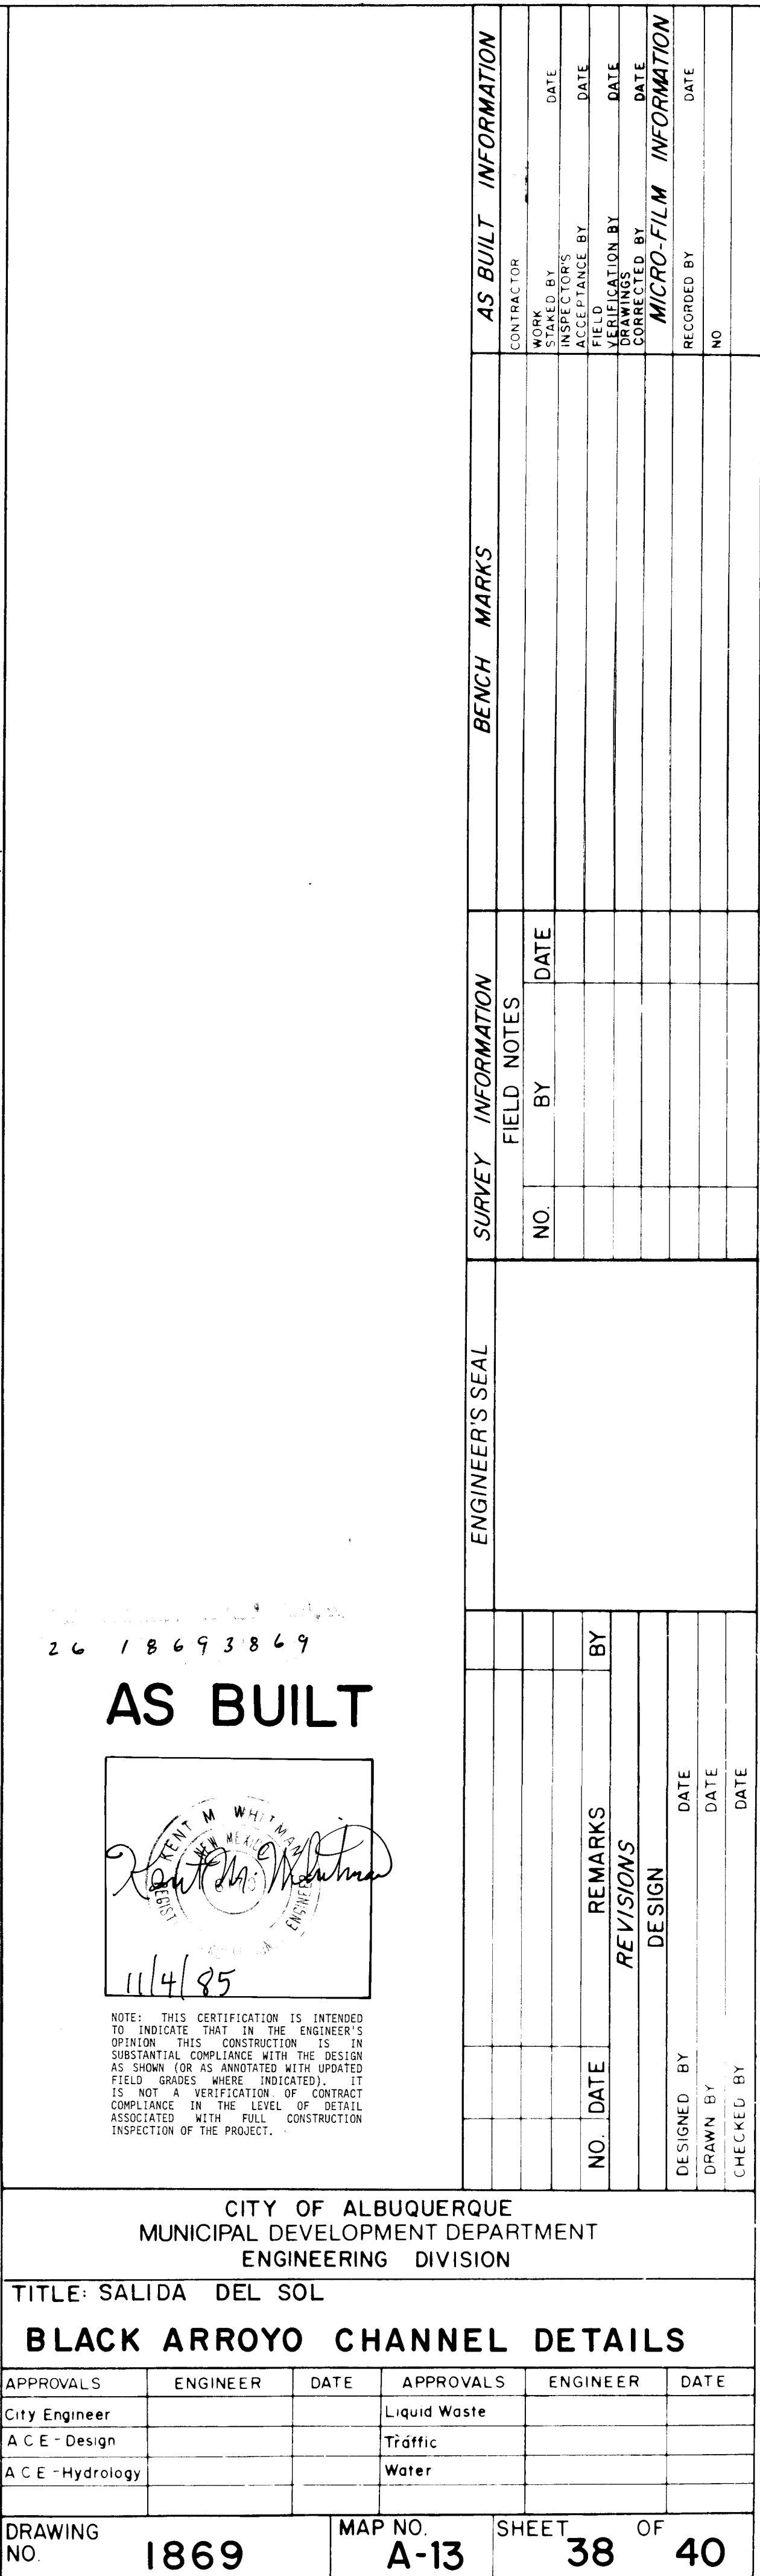

Scale : $1'' = 2'$

NOTE ON BENCHMARK:
Manhole Benchmark Shall Consist Of
3000 P.S.I. Concrete, Shall Conform
To The Cross Section Of The Pipe
Up To The Pipe Spring Line, And Shall
Be Vertical-Walled Thereafter
Extending Up To The Elevation Of The
Pipe Soffit.

Scale: $1'' = 2'$

Scale = 1" = 2'

SECTION "X"
Scale: 1" = 1'

NOTE: See Section "X" For
Details Of Steel Reinforcement

PLAN
Scale: 1" = 5'

SECTION "Y"
Scale = 1" = 5'

OVERALL WIDTH VARIES IN 8' SECTION INCREMENTS

2' 8' 8' 8' 2'

2' WIDE RED & WHITE REFLECTING TAPE SPACED 6" O.C. TYP. Note: Place reflective tape both sides of barricade for Vista

3-10" HORIZ. MEMBERS

6" x 6" POSTS TYP.

5' 20/20 30"

NOTE: STRUCTURAL MATERIAL SHALL BE WEATHER PROTECTED #2 PINE.

TYPICAL RESIDENTIAL
STREET SECTION

N. T. S. All streets except Seven Bar Dr.

*SPECIAL DESIGN
10' WIDE VALLEY GUTTER*

Scale: $1'' = 2'$

ENGINEER'S SEAL		SURVEY INFORMATION		BENCH MARKS		AS BUILT INFORMATION	
		FIELD NOTES		CONTRACTOR		CONTRACTOR	
		NO.	BY	DATE	INSPECTORS	DATE	DATE
					SKANED BY	DATE	DATE
					FIELD PLANCE BY	DATE	DATE
					VERIFICATION BY	DATE	DATE
				BOHANNAN-HUSTON AND MARKED "TBM 205".		ELEVATION	
				= 5110.55		MICRO-FILM INFORMATION	
						RECORDED BY	
						DATE	
						NO	

AS BUILT

NOTE: THIS CERTIFICATION IS INTENDED TO INDICATE THAT IN THE ENGINEER'S OPINION THIS CONSTRUCTION IS IN SUBSTANTIAL COMPLIANCE WITH THE DESIGN AS SHOWN (OR AS ANNOTATED WITH UPDATED FIELD GRADES WHERE INDICATED). IT IS NOT A VERIFICATION OF CONTRACT COMPLIANCE IN THE LEVEL OF DETAIL ASSOCIATED WITH FULL CONSTRUCTION INSPECTION OF THE PROJECT.

CITY OF ALBUQUERQUE
MUNICIPAL DEVELOPMENT DEPARTMENT
ENGINEERING DIVISION

TITLE: SALIDA DEL SOL UNITS ONE AND TWO
CROSS-SECTIONS & DETAILS

APPROVALS	ENGINEER	DATE	APPROVALS	ENGINEER	DATE
City Engineer	<i>C. J. [Signature]</i>	<i>3/14/88</i>	Liquid WASTE		
A C E - Design	<i>[Signature]</i>	<i>8/26/88</i>	Traffic	<i>T. W. [Signature]</i>	<i>2/20/88</i>
A C E - Hydrology	<i>[Signature]</i>	<i>2/20/88</i>	Water Res.	<i>NA</i>	<i>2/28/88</i>

DRAWING NO

1869

MAP NO

A-13


SHEET

39

OF


40

DRAWING NO	1869	MAP NO.	A-13	SHEET	39	OF	40
---------------	------	---------	------	-------	----	----	----

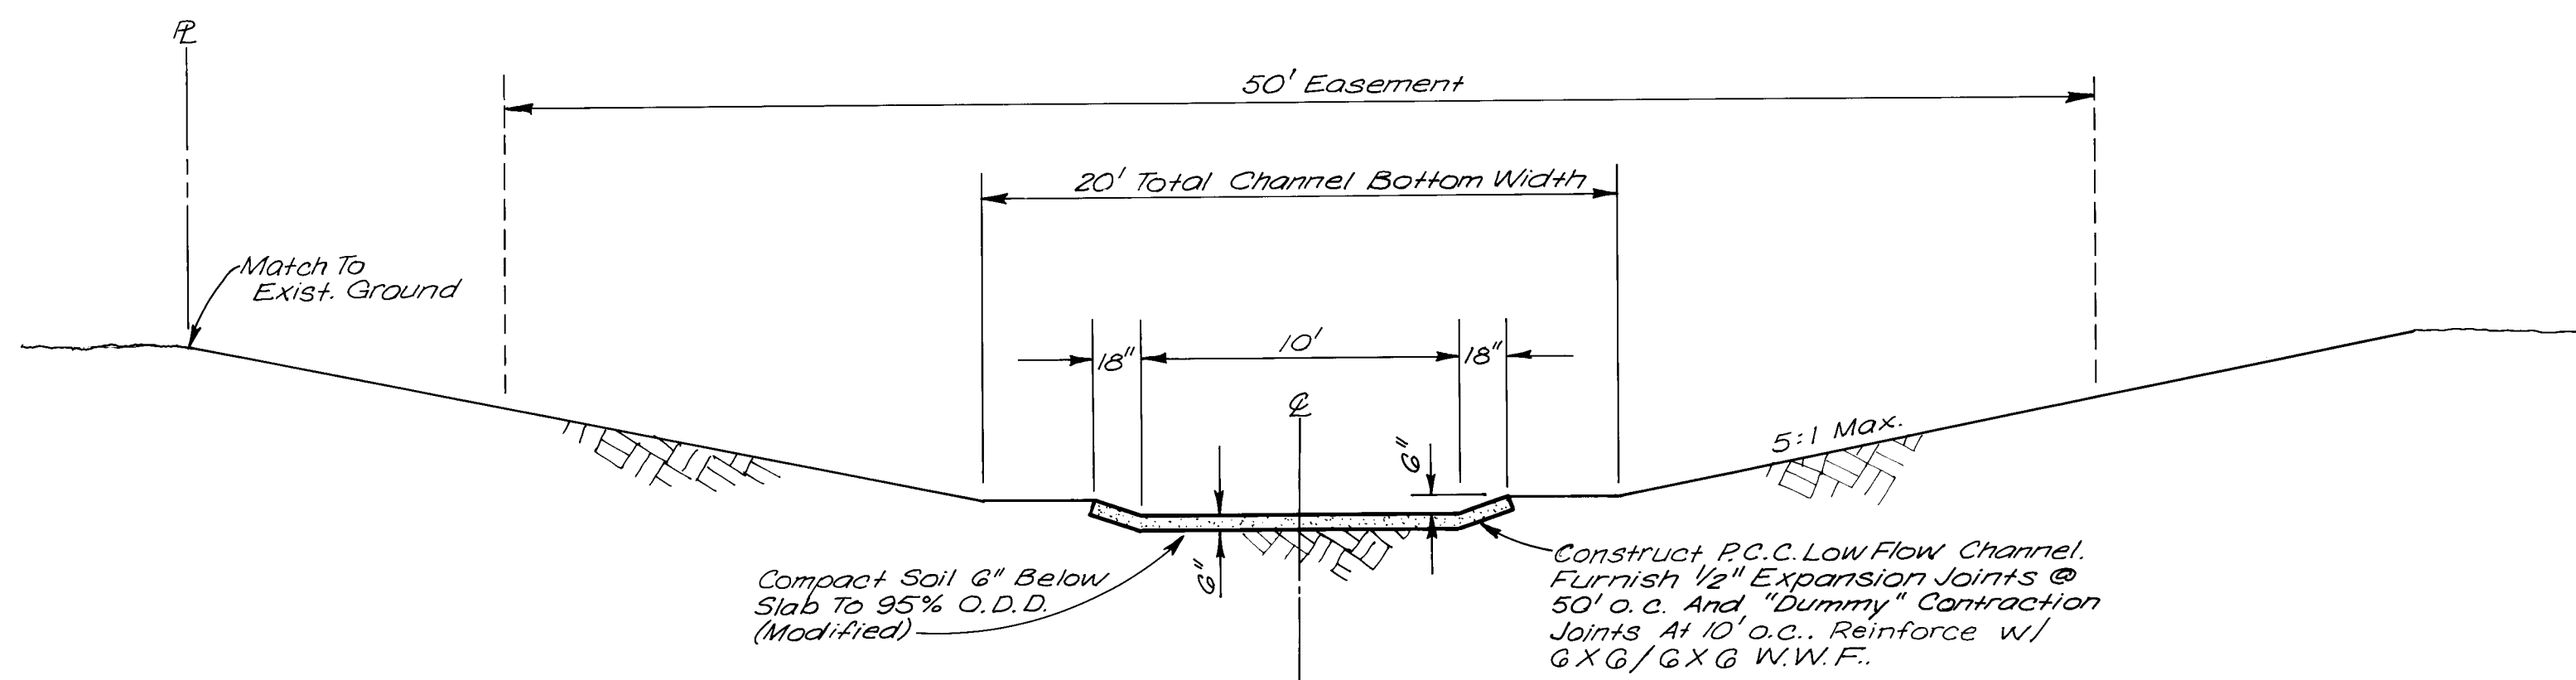


SECTION "C"

Scale: 1" = 5'

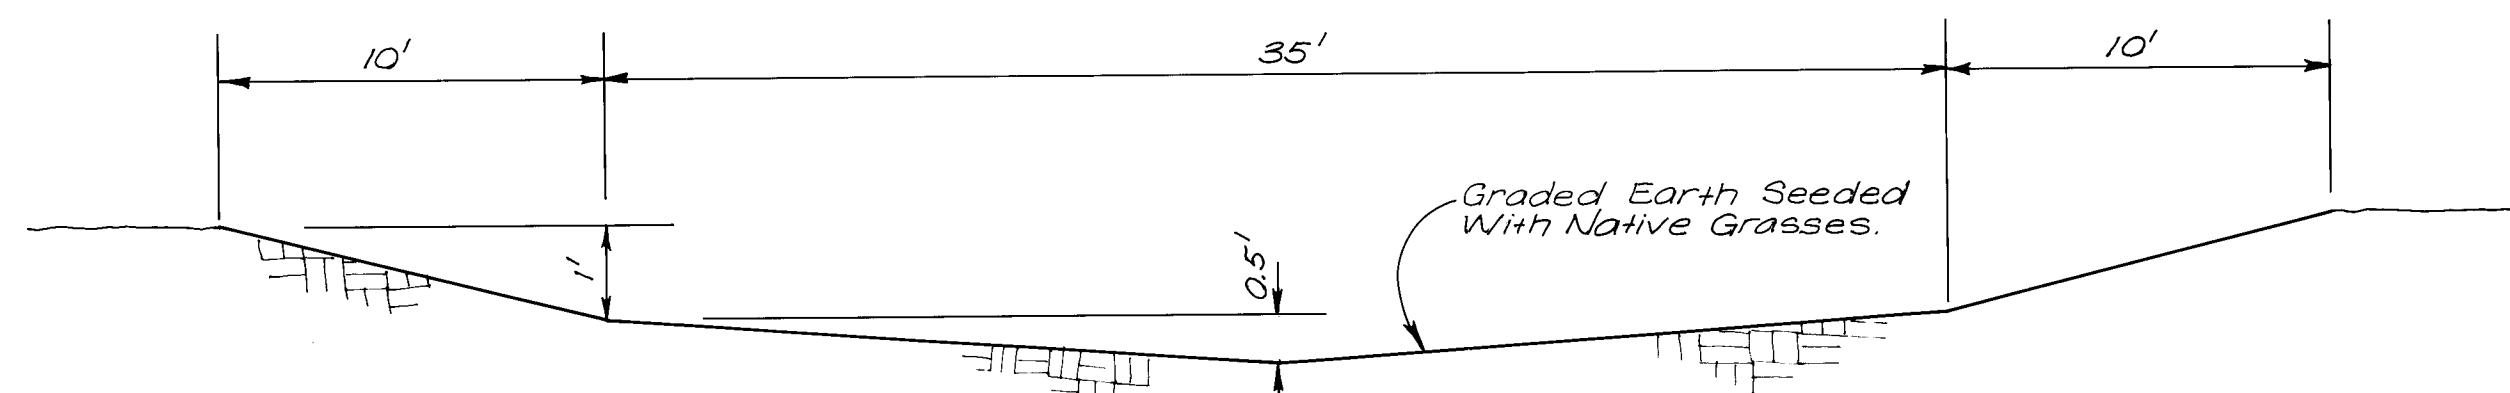


SECTION "A"

Scale: 1" = 5' Horiz.
1" = 2' Vert.

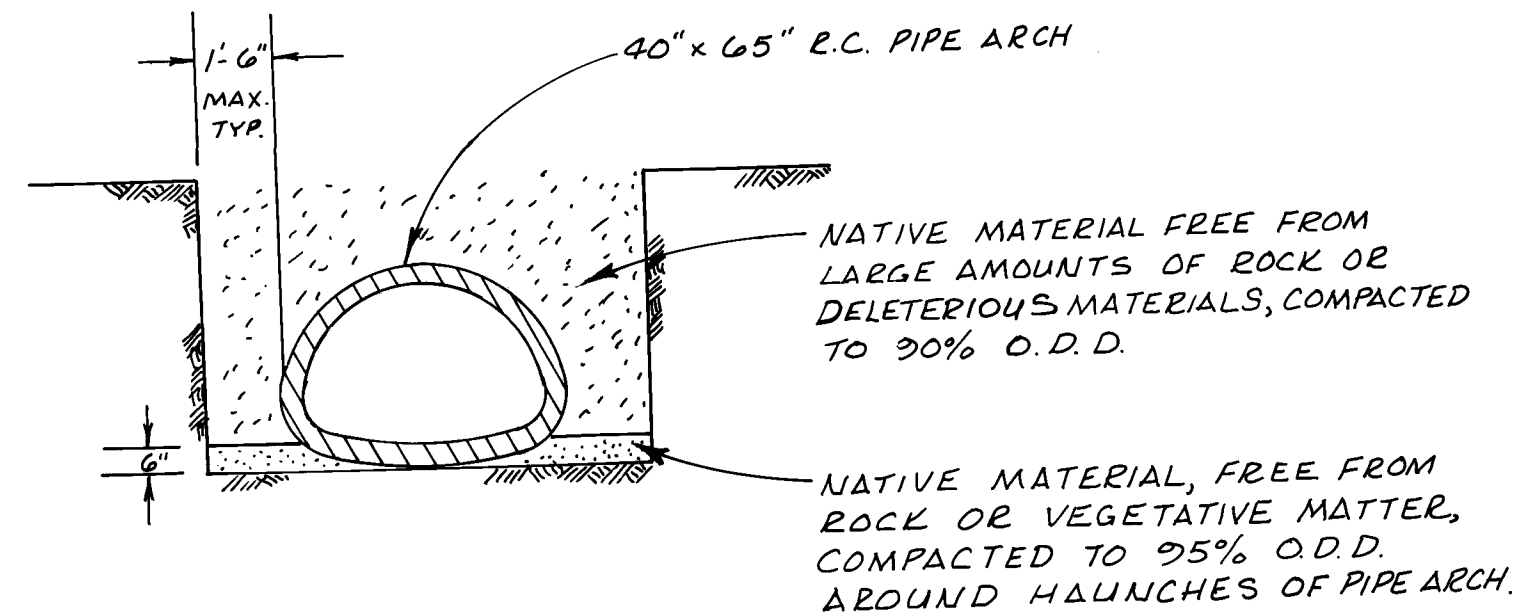


BEDDING DETAIL
R.C. PIPE ARCH

N.T.S.

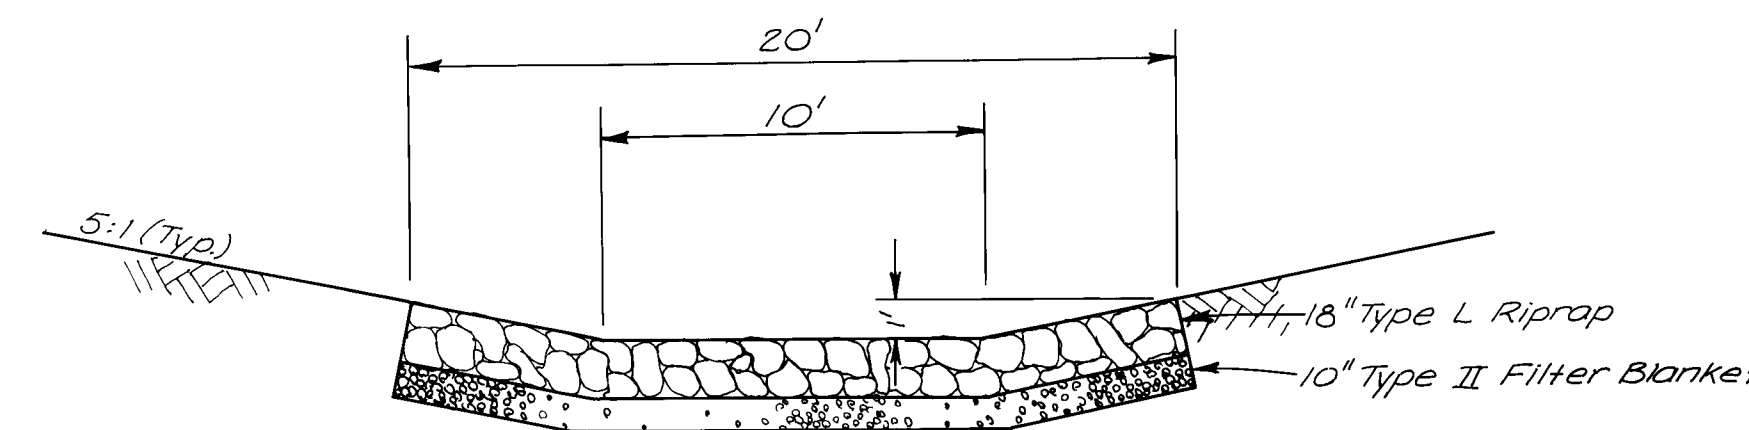


SECTION "G"

Scale: 1" = 5'

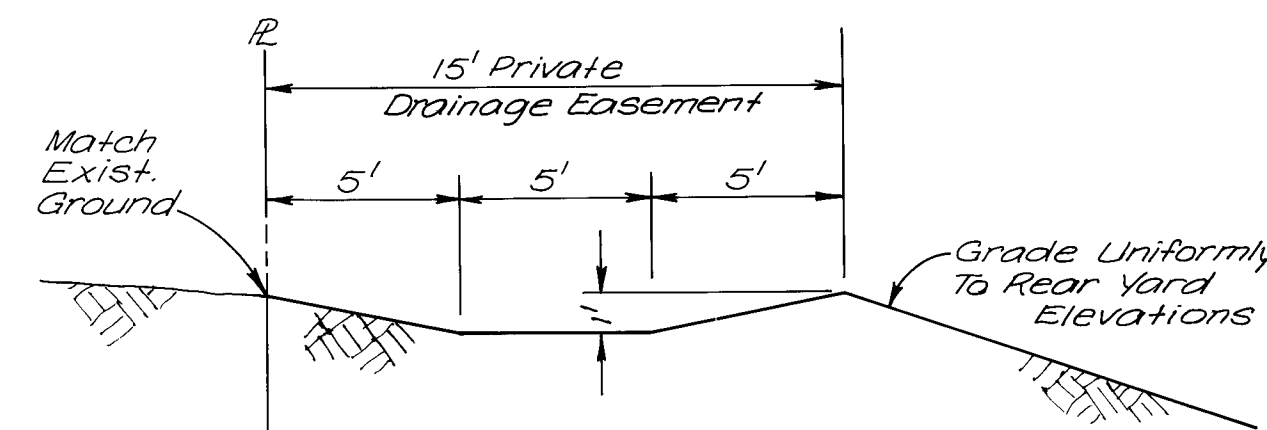


SECTION "B"


Scale: 1" = 5'

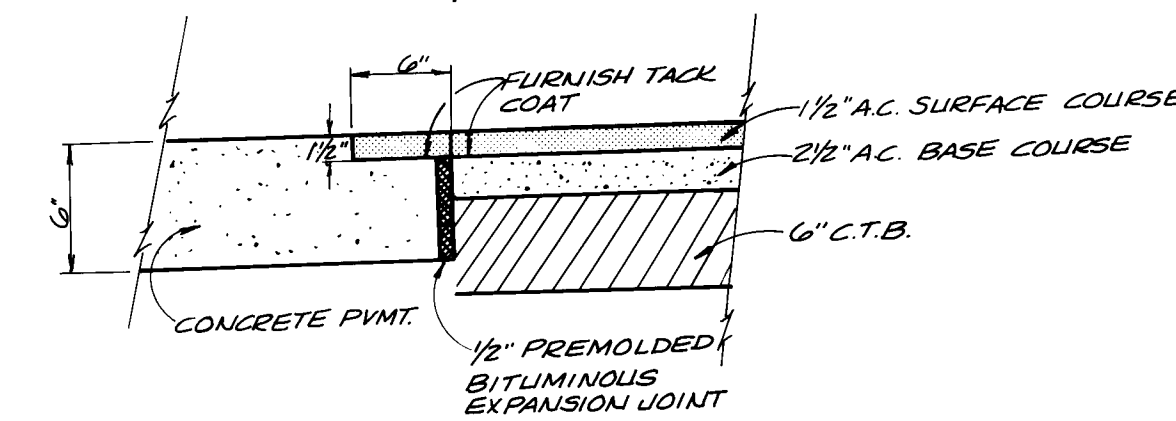

CONCRETE TO ASPHALT OVERLAP JOINTS
N.T.S.

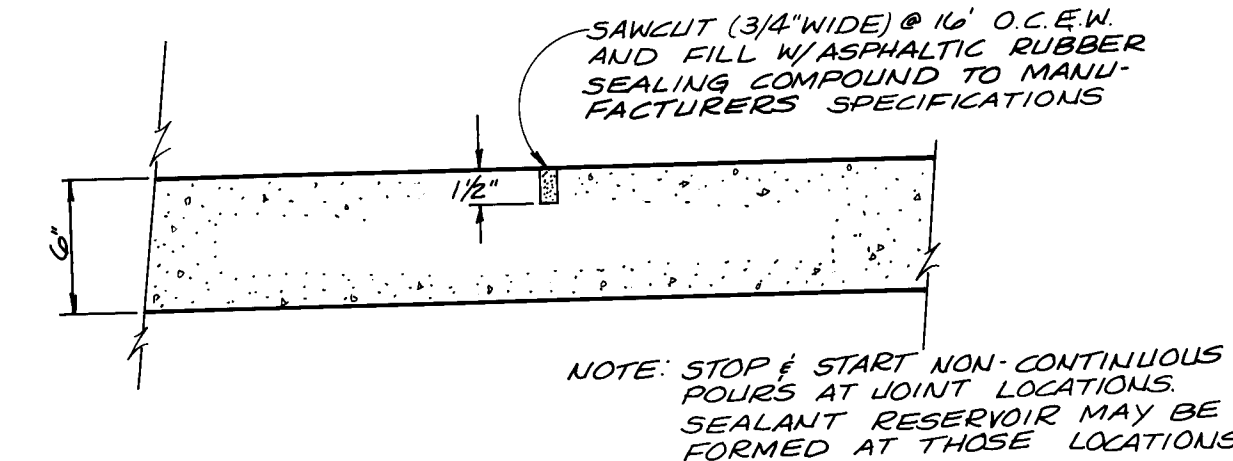


CONTRACTION JOINT
N.T.S.

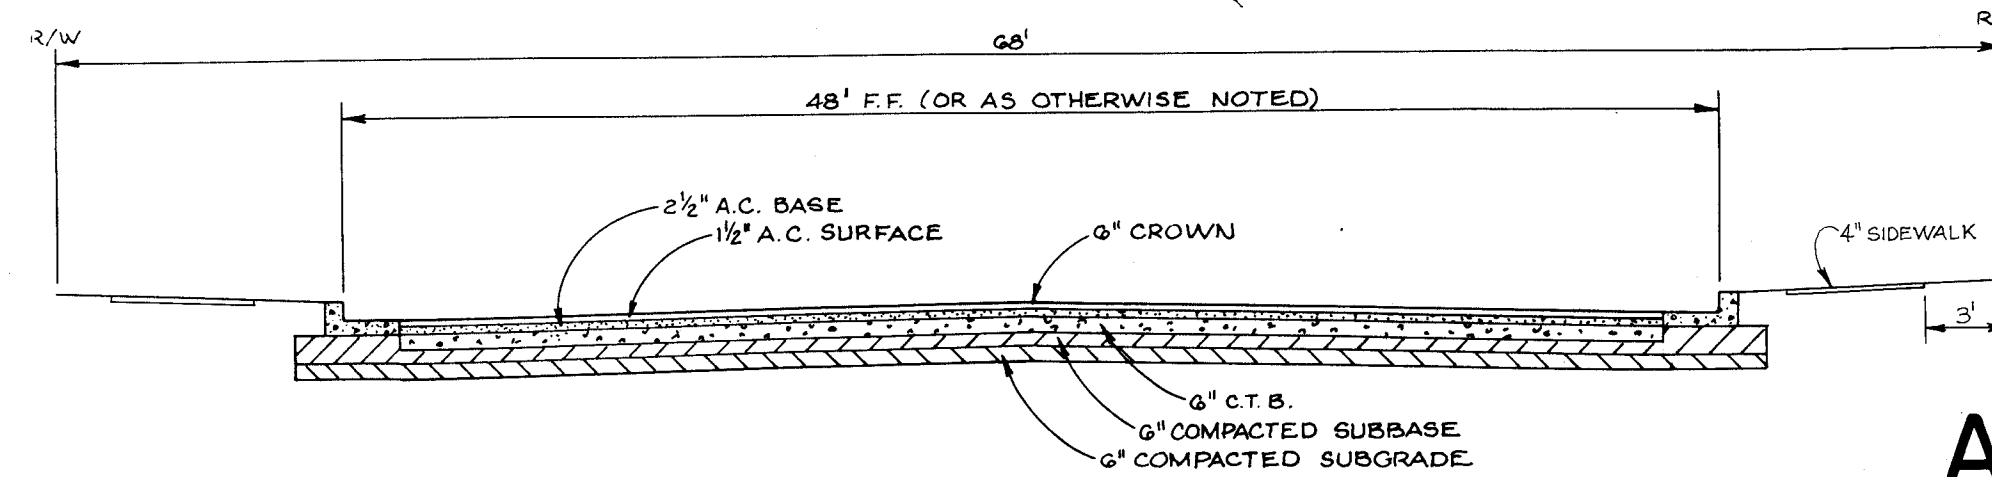

TYPICAL COLLECTOR
STREET SECTION
NOT TO SCALE

AS BUILT

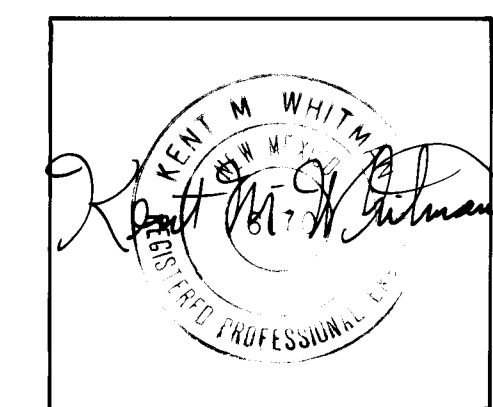

NOTE: THIS CERTIFICATION IS INTENDED TO INDICATE THAT IN THE ENGINEER'S OPINION THIS CONSTRUCTION IS IN SUBSTANTIAL COMPLIANCE WITH THE DESIGN AS SHOWN FOR AS ANNOTATED WITH UPDATED FIELD GRADES WHERE INDICATED. IT IS NOT A VERIFICATION OF CONTRACT COMPLIANCE IN THE LEVEL OF DETAIL ASSOCIATED WITH FULL CONSTRUCTION INSPECTION OF THE PROJECT.

ENGINEER'S SEAL			SURVEY INFORMATION			BENCH MARKS			AS BUILT INFORMATION		
 1/27/84			FIELD NOTES			A SQUARE CHISEL IN THE TOP OF THE EASTERLY WALL OF THE A.M.A.F.C.A. FLOOD DIVERSION NO. 2 CHANNEL, APPROXIMATELY 180 FEET SOUTH OF THE POINT OF CONFLUENCE WITH THE SKYVIEW DRAINAGE CHANNEL ESTABLISHED BY BOHANNAN-HUSTON AND MARKED "TBM 205". ELEVATION = 5110.55			CONTRACTOR		
			BY			DATE			WORK		
			NO.			DATE			STARTED BY		
			NO.			DATE			ACCEPTANCE BY		
REMARKS			BY			FIELD			DATE		
REVISIONS			BY			ELEVATION			DATE		
DESIGN			BY			ELEVATION			DATE		
DESIGNED BY K.M.W.			DATE 11-83			RECORDED BY			NO		
DRAWN BY J.B.			DATE 11-83			CORRECTED BY			NO		
CHECKED BY K.M.W.			DATE 11-83			MICRO-FILM INFORMATION			NO		
			</								

26 18694086

CITY OF ALBUQUERQUE MUNICIPAL DEVELOPMENT DEPARTMENT ENGINEERING DIVISION					
TITLE: SALIDA DEL SOL UNITS ONE AND TWO					
CROSS SECTIONS & DETAILS					
APPROVALS	ENGINEER	DATE	APPROVALS	ENGINEER	DATE
City Engineer	<i>[Signature]</i>	8/1/84	Liquid Waste	<i>[Signature]</i>	2/2/84
A.C.E. Design	<i>[Signature]</i>	8/1/84	Traffic	<i>[Signature]</i>	2/2/84
A.C.E. Hydrology	<i>[Signature]</i>	2/2/84	Water Res	<i>[Signature]</i>	2-8-84
DRAWING NO.	1869	MAP NO.	A-13	SHEET	40 OF 40