



1810

1810

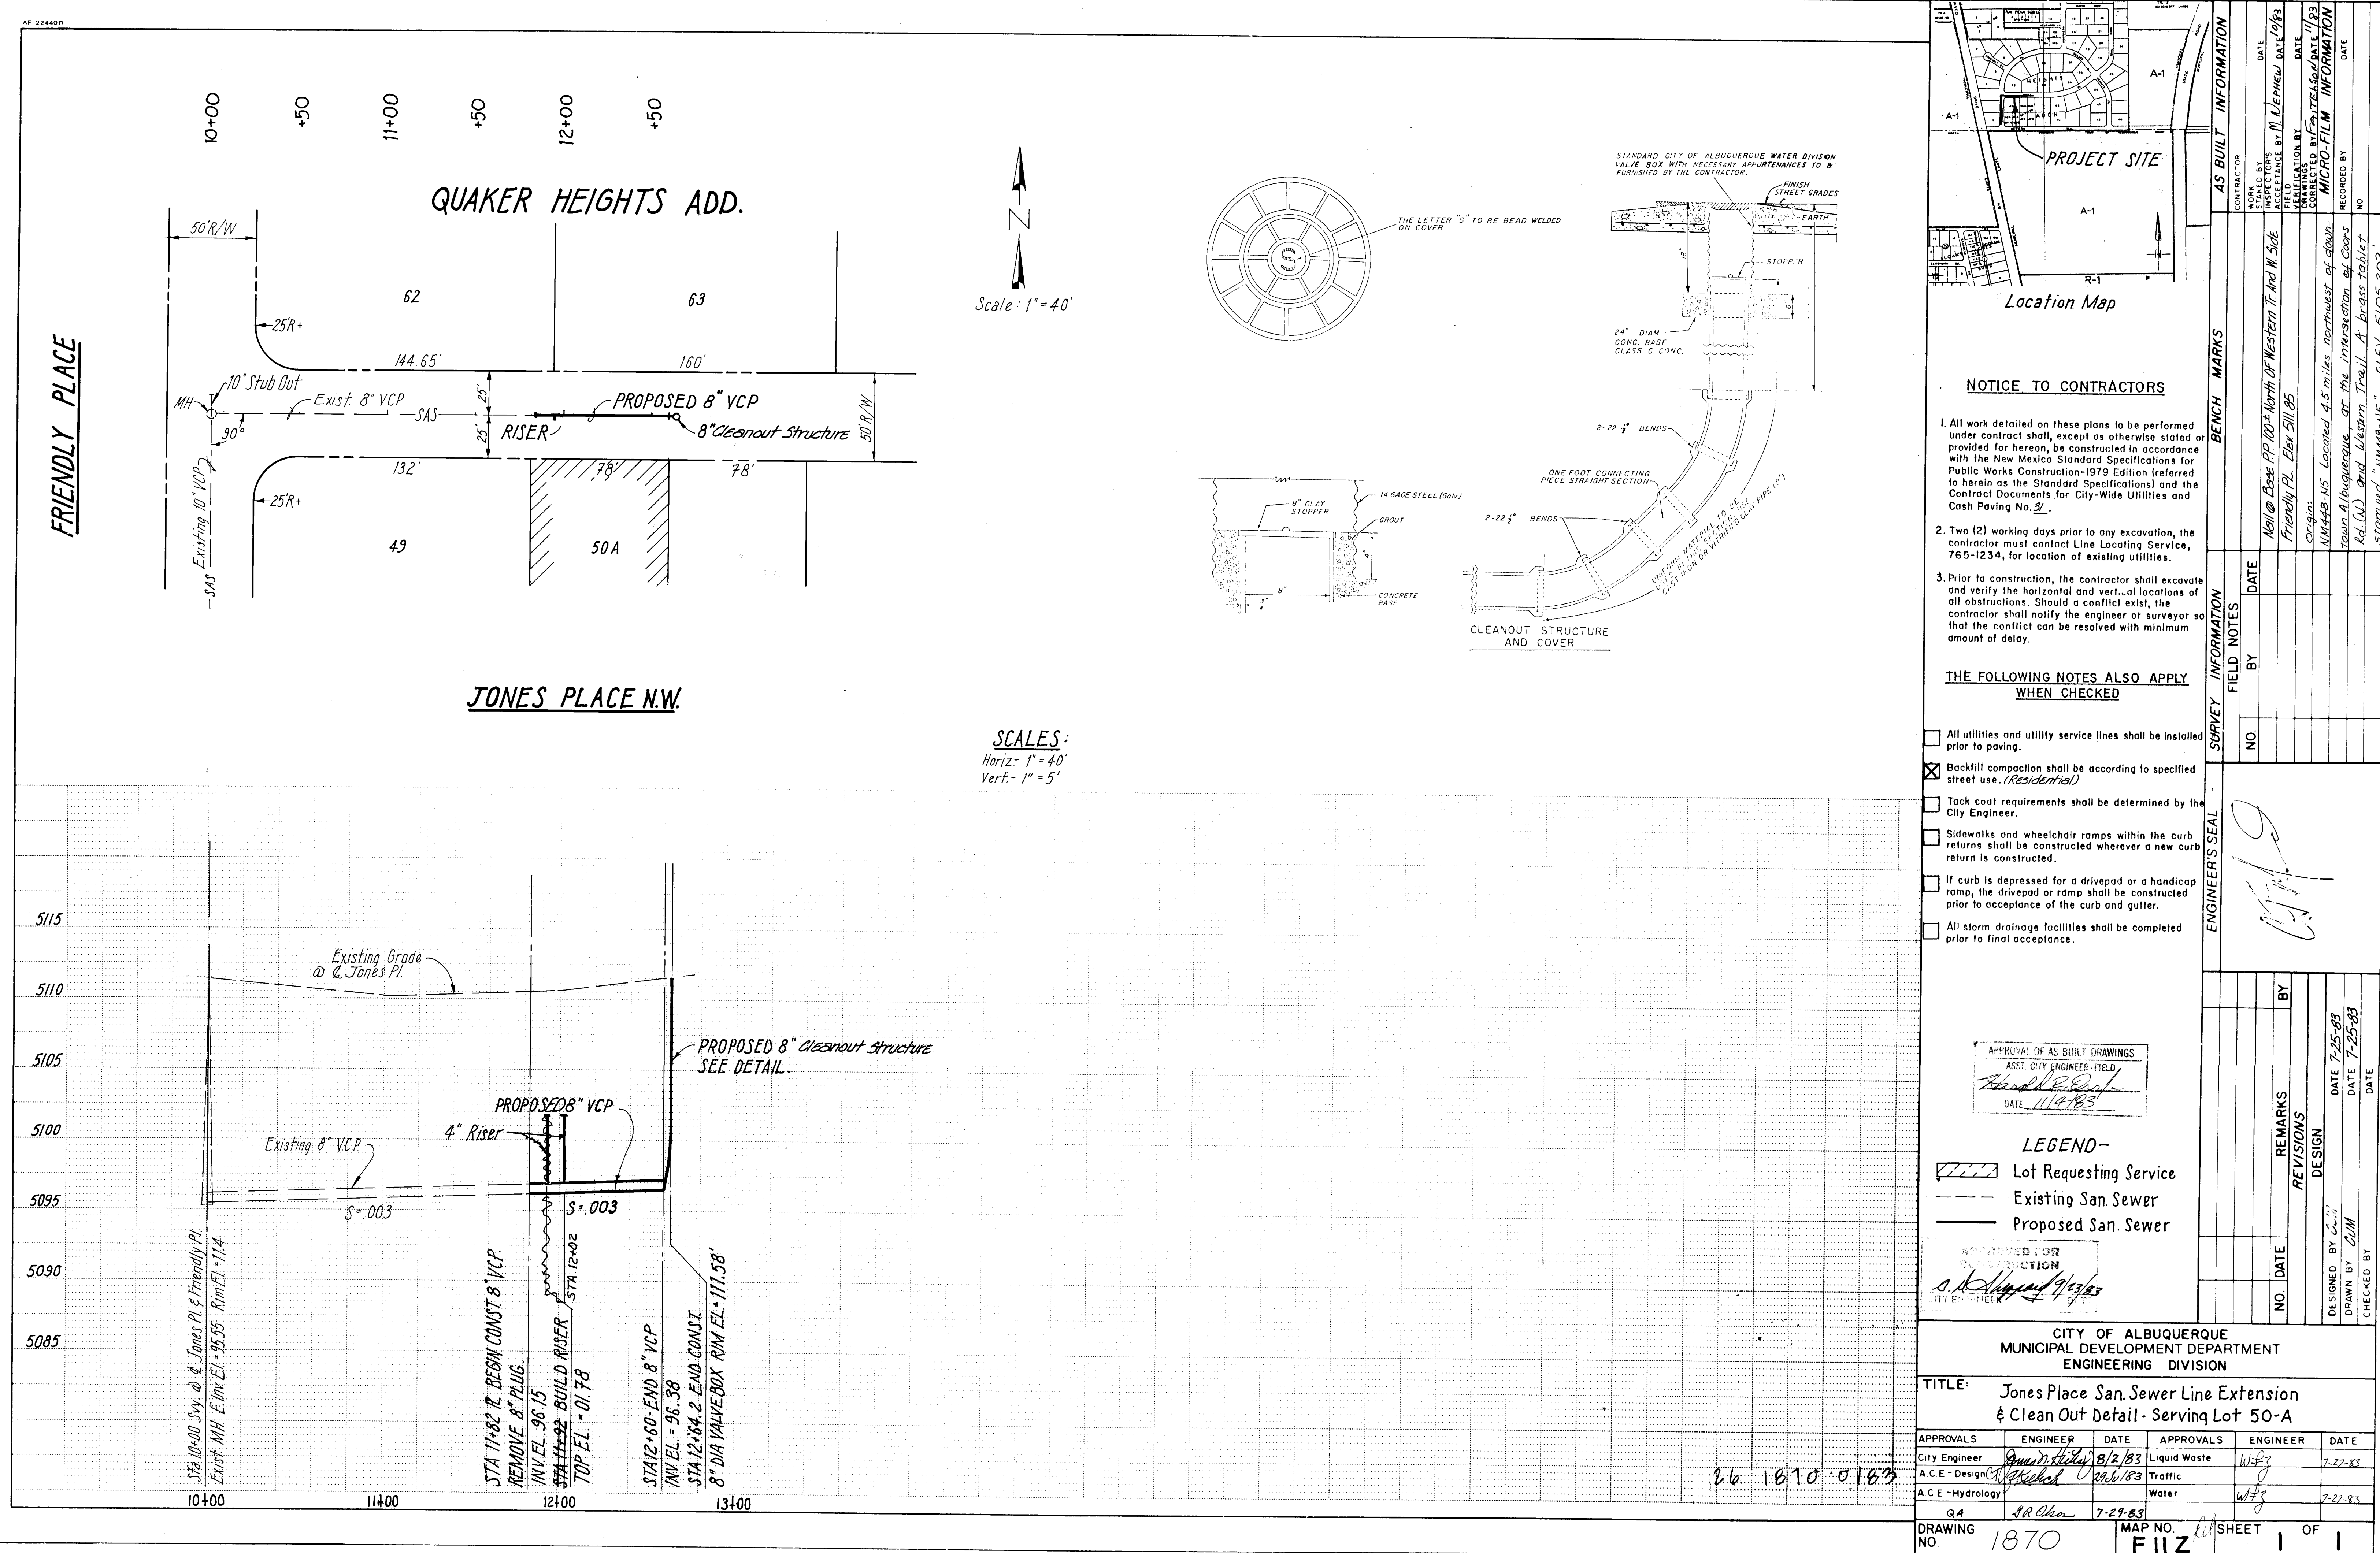

Scale: 1" = 40'

SCALES:
Horiz. 1" = 40'
Vert. 1" = 5'

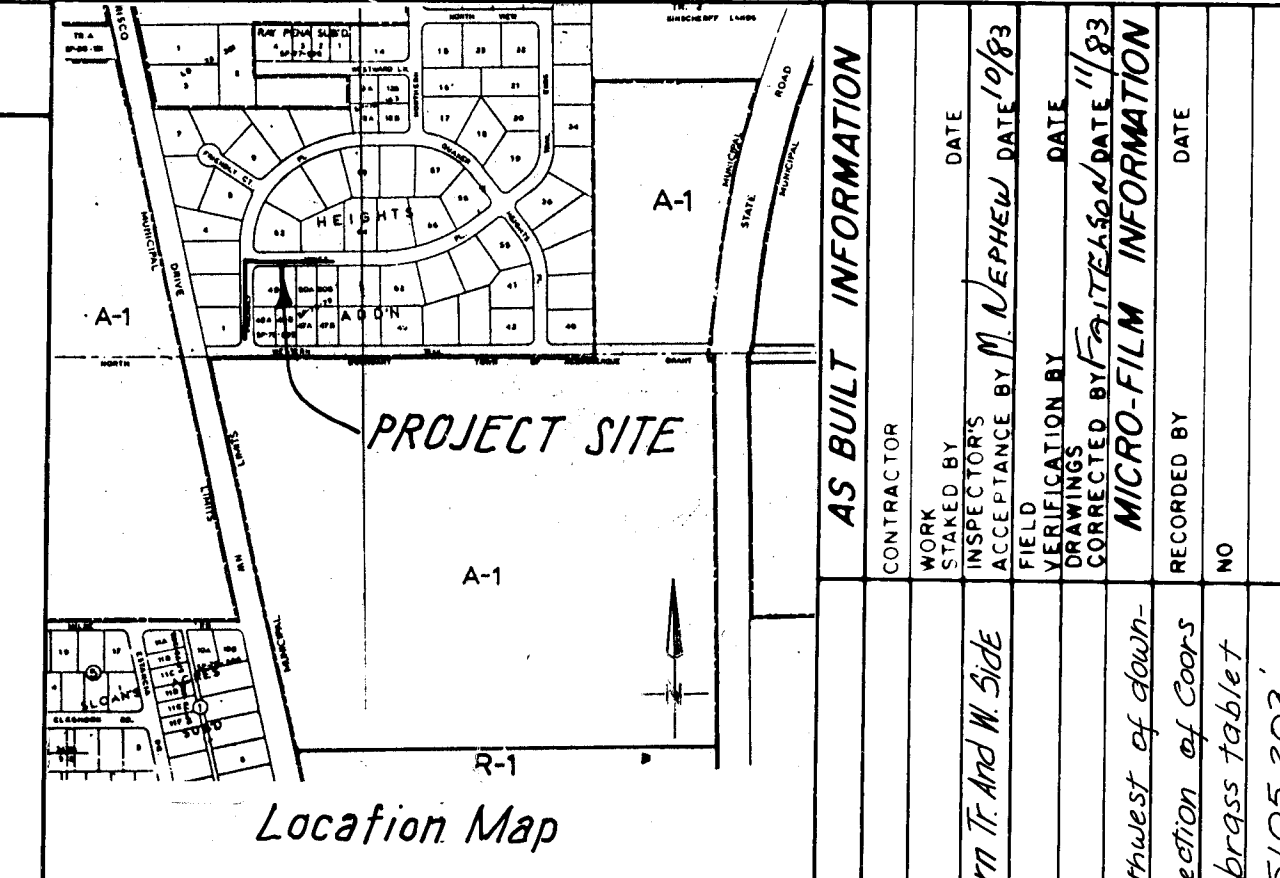

NOTICE TO CONTRACTORS

1. All work detailed on these plans to be performed under contract shall, except as otherwise stated or provided for herein, be constructed in accordance with the New Mexico Standard Specifications for Public Works Construction-1979 Edition (referred to herein as the Standard Specifications) and the Contract Documents for City-Wide Utilities and Cash Paving No. 3.

2. Two (2) working days prior to any excavation, the contractor must contact Line Locating Service, 765-1234, for location of existing utilities.

3. Prior to construction, the contractor shall excavate and verify the horizontal and vertical locations of all obstructions. Should a conflict exist, the contractor shall notify the engineer or surveyor so that the conflict can be resolved with minimum amount of delay.

THE FOLLOWING NOTES ALSO APPLY WHEN CHECKED

☐ All utilities and utility service lines shall be installed prior to paving.

☒ Backfill compaction shall be according to specified street use. (Residential)

☐ Tack coat requirements shall be determined by the City Engineer.

☐ Sidewalks and wheelchair ramps within the curb returns shall be constructed wherever a new curb return is constructed.

☐ If curb is depressed for a driveway or a handicap ramp, the driveway or ramp shall be constructed prior to acceptance of the curb and gutter.

☐ All storm drainage facilities shall be completed prior to final acceptance.

AS BUILT INFORMATION		BENCH MARKS		SURVEY INFORMATION		FIELD NOTES		ENGINEER'S SEAL	
CONTRACTOR	DATE	NO.	BY	NO.	BY	NO.	BY	NO.	BY
CONTRACTOR	DATE	NO.	BY	NO.	BY	NO.	BY	NO.	BY
INSPECTOR	DATE	NO.	BY	NO.	BY	NO.	BY	NO.	BY
ACCEPTANCE BY	DATE	NO.	BY	NO.	BY	NO.	BY	NO.	BY
FIELD BY	DATE	NO.	BY	NO.	BY	NO.	BY	NO.	BY
DRAWINGS	DATE	NO.	BY	NO.	BY	NO.	BY	NO.	BY
COORDINATOR	DATE	NO.	BY	NO.	BY	NO.	BY	NO.	BY
RECORDING	DATE	NO.	BY	NO.	BY	NO.	BY	NO.	BY
NO.	DATE	NO.	BY	NO.	BY	NO.	BY	NO.	BY

APPROVALS		REVISIONS	
ENGINEER	DATE	NO.	DATE
City Engineer	8/2/83	1	7-25-83
ACE - Design	8/2/83	2	7-25-83
ACE - Hydrology	8/2/83	3	7-25-83
QA	8/2/83	4	7-25-83

CITY OF ALBUQUERQUE MUNICIPAL DEVELOPMENT DEPARTMENT ENGINEERING DIVISION					
TITLE: Jones Place San. Sewer Line Extension & Clean Out Detail - Serving Lot 50-A					
APPROVALS	ENGINEER	DATE	APPROVALS	ENGINEER	DATE
City Engineer	<i>James Stealy</i>	8/2/83	Liquid Waste	<i>WJG</i>	7-27-83
A.C.E. - Design	<i>WJG</i>	2/26/83	Traffic		
A.C.E. - Hydrology			Water	<i>WJG</i>	7-27-83
QA	<i>J.R. Khan</i>	7-27-83			
DRAWING NO.	1870	MAP NO.	F11Z	SHEET	1 OF 1