



TRAFFIC SIGN TO BE
INSTALLED DURING
PHASE V CONSTRUCTION
ONLY.

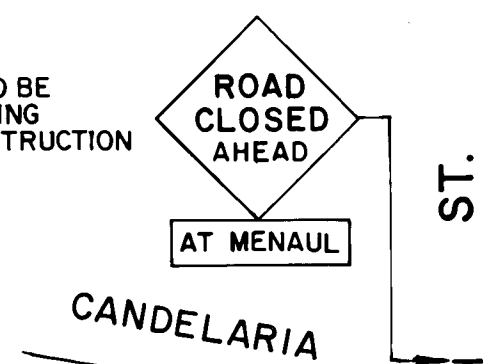

CANDELARIA

INSERT

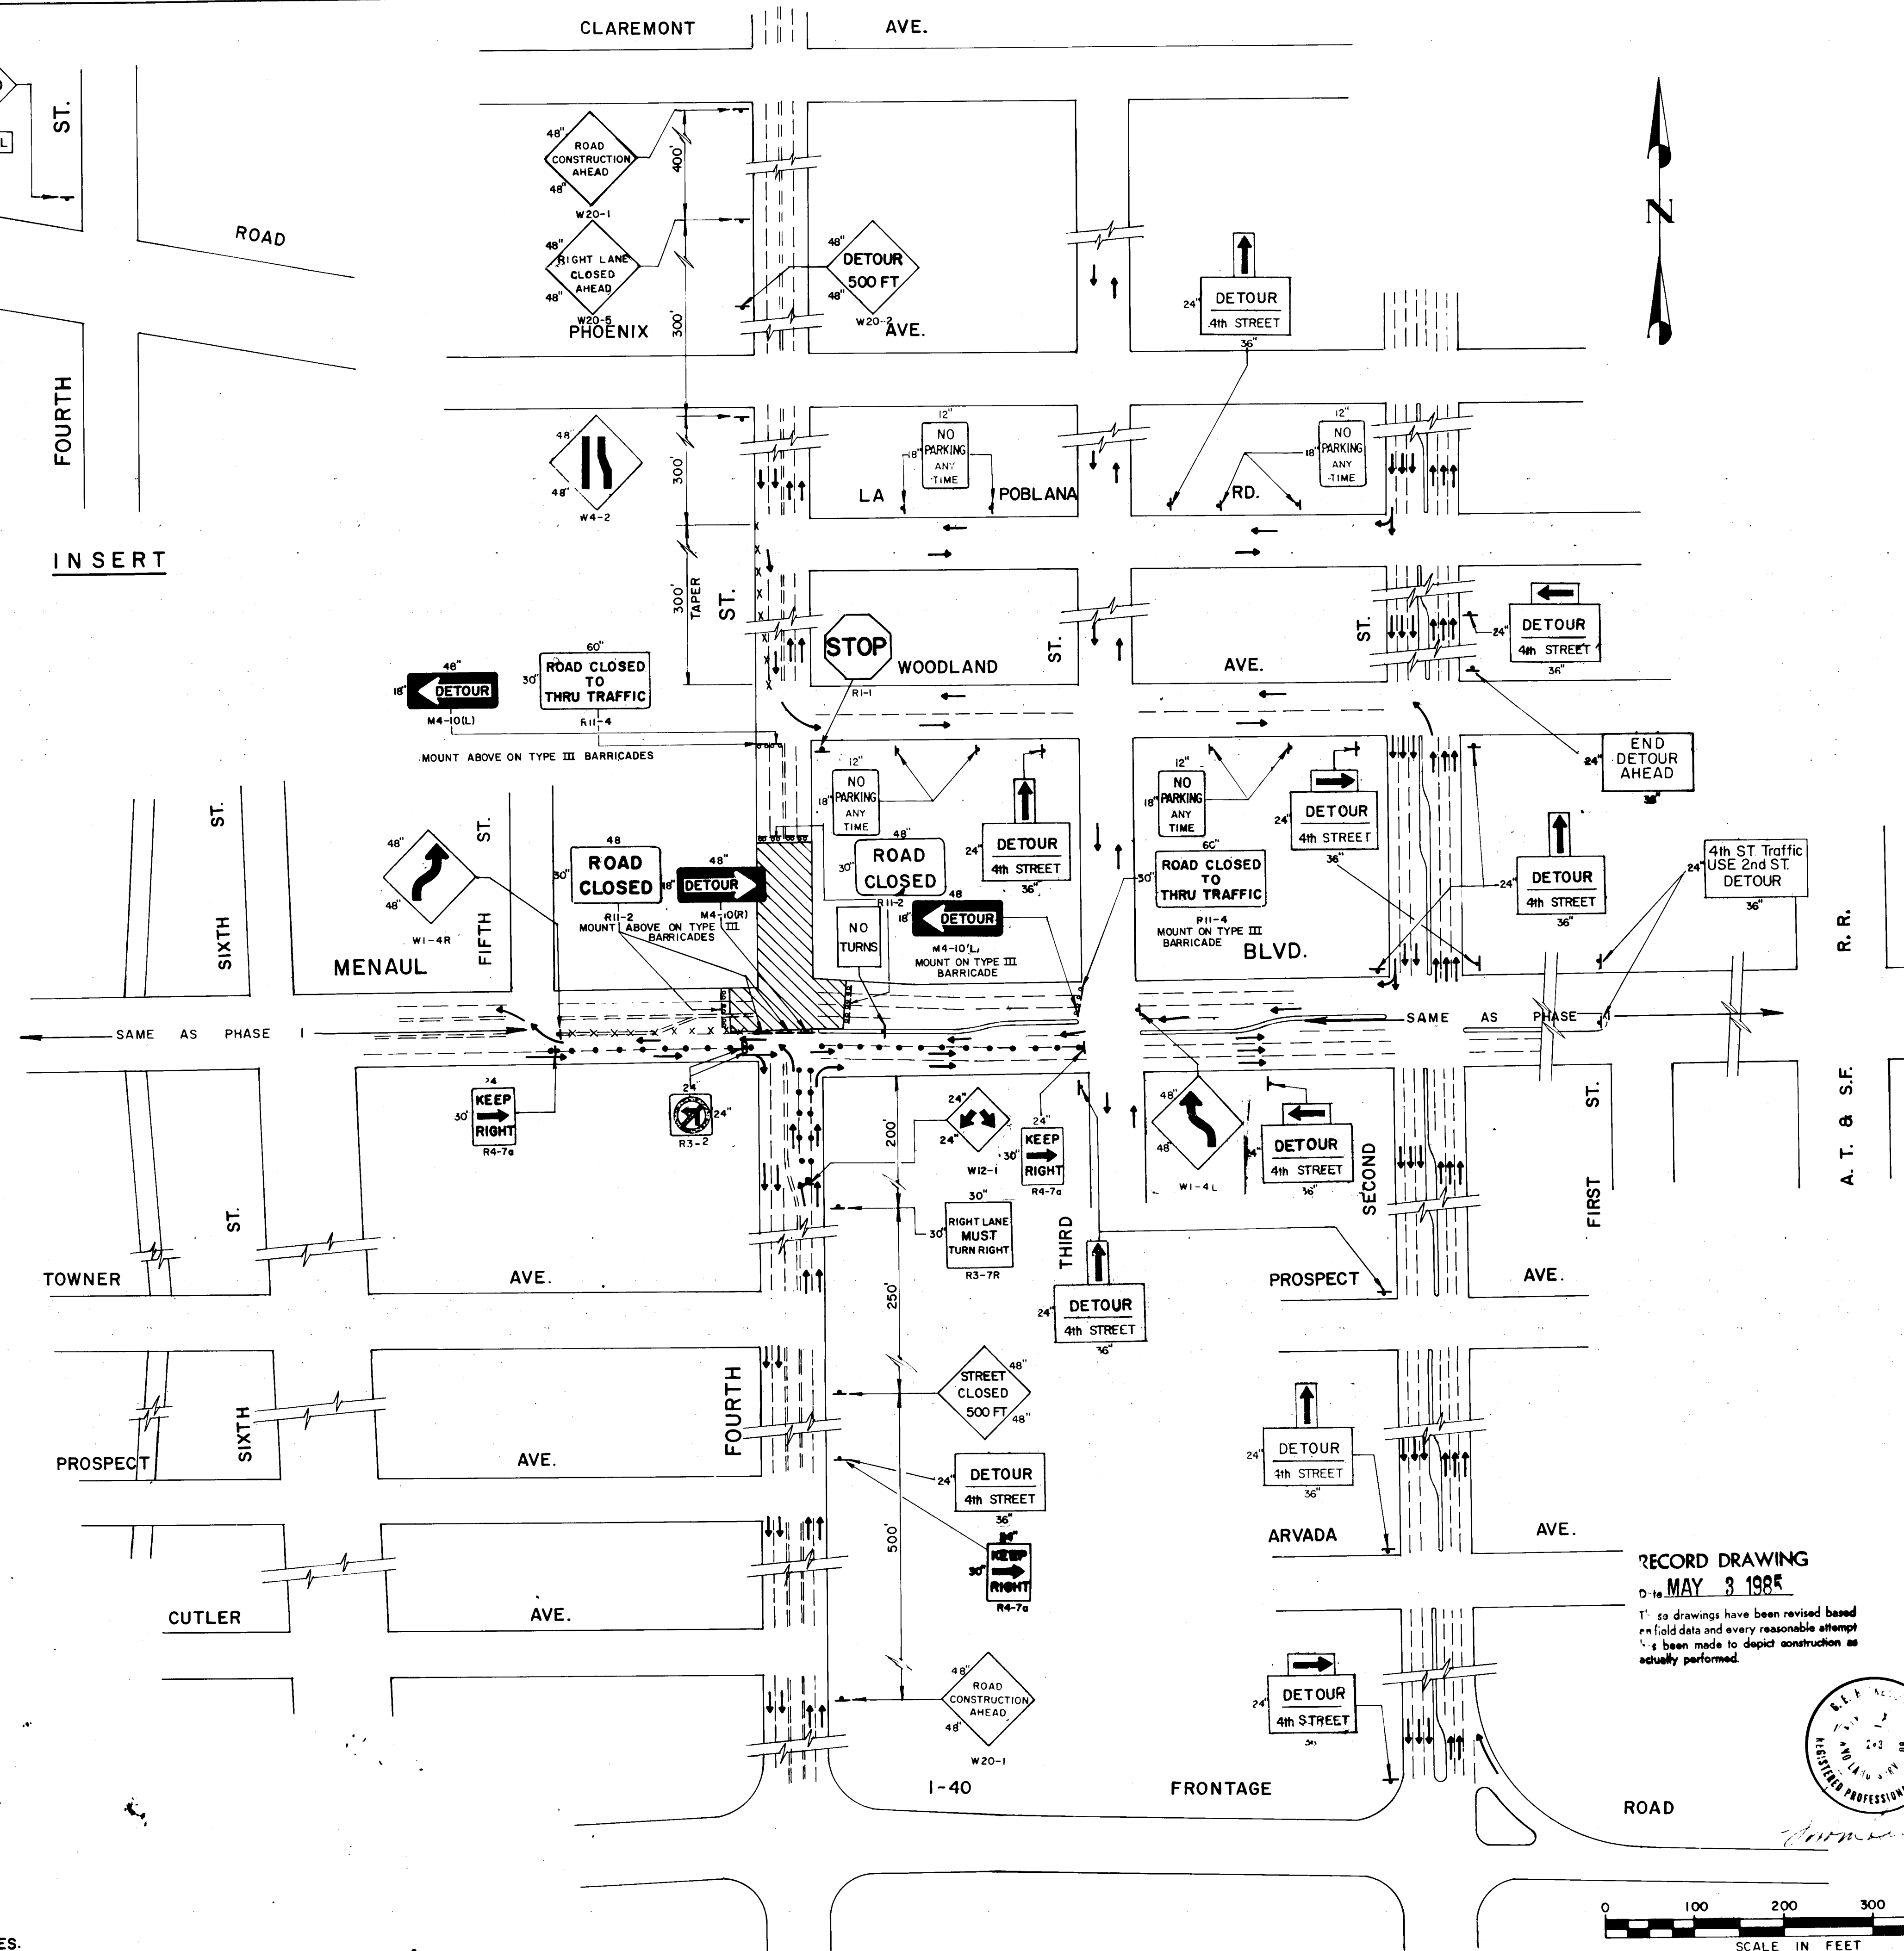

LEGEND



CONSTRUCTION ZONE

• • • • • VERTICAL PANELS

x x x x x x x - [BARRELS OR TYPE
II BARRICADES

→ → → TRAFFIC FLOW PATTERN
- - - TYPE III BARRICADES

NOTE: SEE SHEET 4 FOR GENERAL TRAFFIC PLAN NOTES

RECORD DRAWING

Date **MAY 3 1985**

These drawings have been revised based on field data and every reasonable attempt has been made to depict construction as actually performed.



CITY OF ALBUQUERQUE
TRANSPORTATION DEPARTMENT

TITLE: INTERSECTION RECONSTRUCTION
4TH. STREET AND MENAUL BLVD. N.W.
TRAFFIC CONTROL PLAN PHASE 5

APPROVALS	ENGINEER	DATE	APPROVALS	ENGINEER	DATE
City Engineer	<i>[Signature]</i>	6/20/89	Liquid Waste	<i>R. Rana</i>	6/20/89
A.C.E. - Design	<i>[Signature]</i>	6/20/89	Traffic	<i>David L. Harrison</i>	6/20/89
A.C.E. - Hydrology	<i>[Signature]</i>	6/20/89	Water	<i>R. Rana</i>	6/20/89

50		
	DRAWING NO.	1871

MAP NO.	H-14
---------	------

SHEET 8 OF 24