


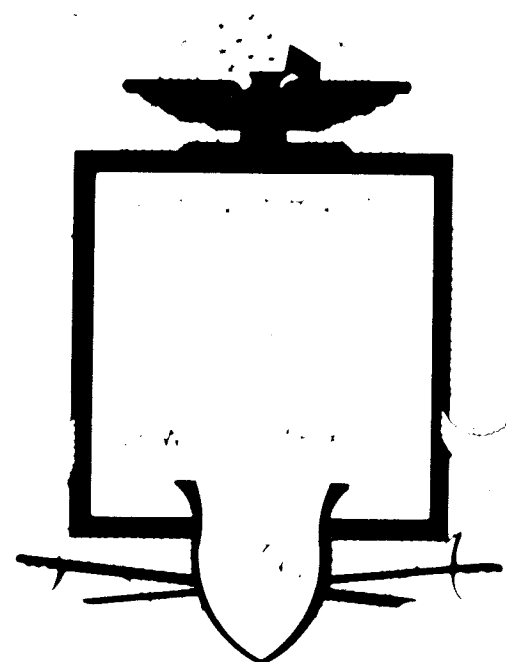

CITY OF ALBUQUERQUE, NEW MEXICO

CONSTRUCTION PLANS FOR MASTER PLAN SANITARY SEWER INTERCEPTOR

(64th STREET N.W. TO LAURELWOOD PARKWAY)


FOR
WATER RESOURCES DEP'T.

INDEX


- 1 TITLE & INDEX SHEET
- 2 GENERAL NOTES, LEGEND & SITE PLAN
- 3-6 PLAN & PROFILE SHEETS



DENNEY-GROSS & ASSOCIATES, INC.
ENGINEERS-PLANNERS
ALBUQUERQUE, NEW MEXICO 87107

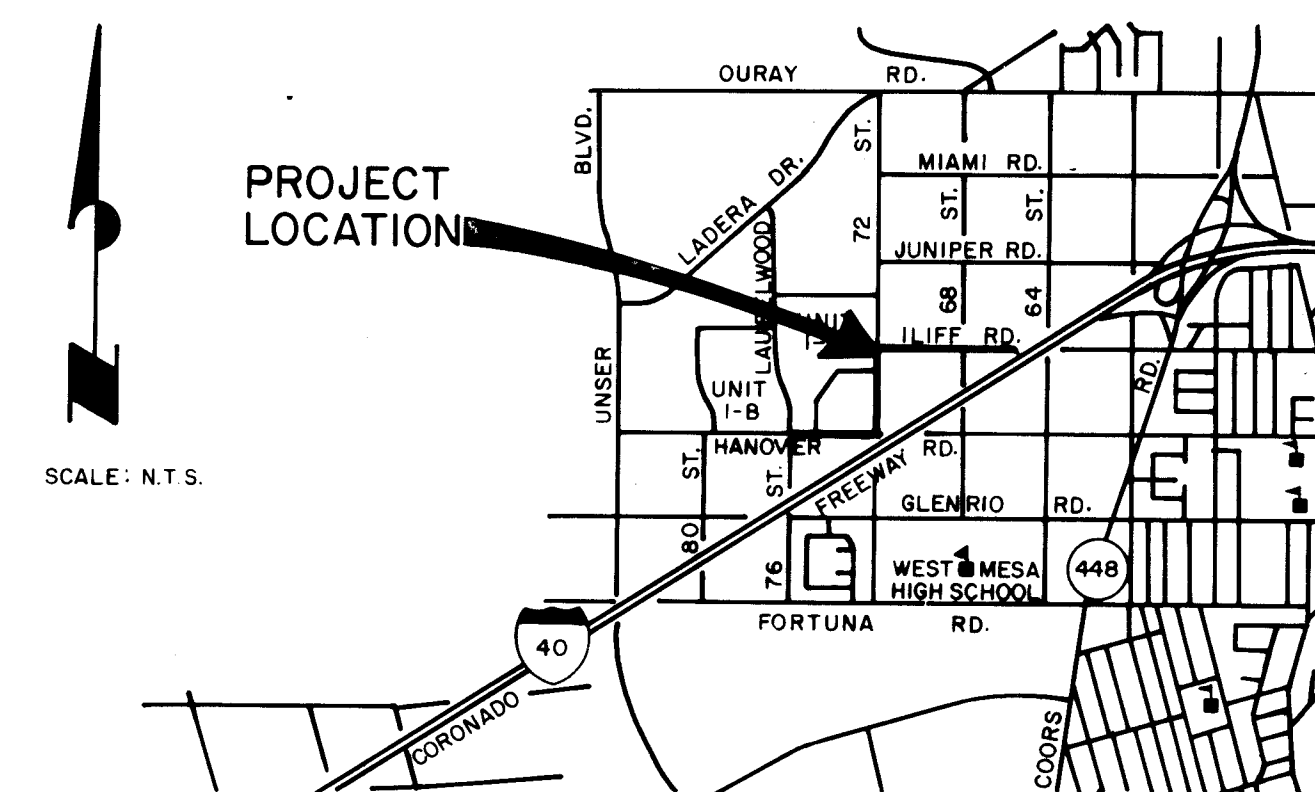

ZONE ATLAS N°: H,J-10

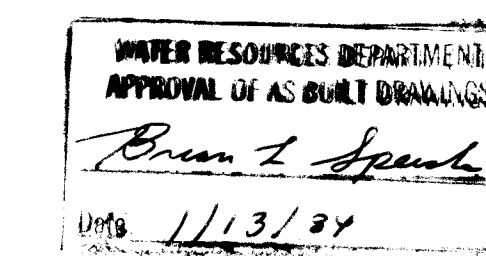

12-27-83 RECORD DRAWING
1-9-84 RECORD DRAWING

26 18740184

CHG.	CHG. NO.	DATE	USER	DEPT.	DATE	USER	DEPT.	DATE
APPROVAL OF REVISIONS								
1874			DENNEY-GROSS & ASSOC., INC. ENGINEERS-PLANNERS 2400 G. MANCHE, RD. N.E., ALBUQUERQUE, NM 87107 (505) 884-0041				APPROVED FOR CONSTRUCTION	
							C.E.	
							SHEET 1 OF 6	



1. The specifications used for this project, "The New Mexico Standard Specifications for Public Works Construction," 1979 Edition, as amended by the contract documents.
2. All existing utilities shown were taken from Record Drawings and are located as accurately as possible from information available. It will be the Contractor's responsibility to verify exact locations of these utilities before construction begins.
3. Policy On the Proximity of Water & Sanitary Sewer Lines (SAS): "Whenever possible, it is desirable to lay parallel water and sewer lines at least 10 feet apart horizontally, and the water line should be a higher elevation than the sewer. If this is not possible, separate trenches will be required, and in all cases (this shall be effective even though one line has been installed prior to the other), the water line shall be at least 2 feet above the sewer. When water and sewer lines cross each other, the water line shall be at least 3 feet above the sewer; otherwise the sewer shall be of ductile iron pipe." A preferred alternative is encasement in concrete as shown in the Standard Details for 10' on each side of the water line. If ductile iron pipe is used it must be run from manhole to manhole.
4. All sanitary sewer lines to be VCP or PVC as per contract documents.
5. All sanitary sewer manholes shall be Type "C" 4' Dia., City of Albuquerque Standard Drawing S-1-3, unless otherwise noted.
6. Contractor shall be responsible for obtaining Blue Stakes prior to excavation.
7. Final clean-up grading required after installation and backfilling are completed.

<u>PROPOSED</u>	<u>EXISTING</u>	
SAS	SAS	SANITARY SEWER LINE
SAS	SAS	SANITARY SEWER MANHOLE
SAS	SAS	SANITARY SEWER CAP

WATER RESOURCES DEPARTMENT
APPROVAL OF AS BUILT DRAWINGS
Brian L. Spauld
1/13/84


CITY OF ALBUQUERQUE					
PUBLIC WORKS DEPARTMENT					
ENGINEERING DIVISION					
TITLE: MASTER PLAN SANITARY SEWER INTERCEPTOR (64th STREET N.W. TO LAURELWOOD PARKWAY)					
GENERAL NOTES, LEGEND & SITE PLAN					
APPROVALS	ENGINEER	DATE	APPROVALS	ENGINEER	DATE
City Engineer			Liquid Waste		
A.C.E.-Design			Traffic		
A.C.E.-Hydrology			Water		
DRAWING NO. 1874			SHEET 2 OF 6		

**APPROVED FOR
CONSTRUCTION**


CITY ENGINEER DATE

DGA Job # 59931

TOWN OF ATRISCO GRANT UNIT 8

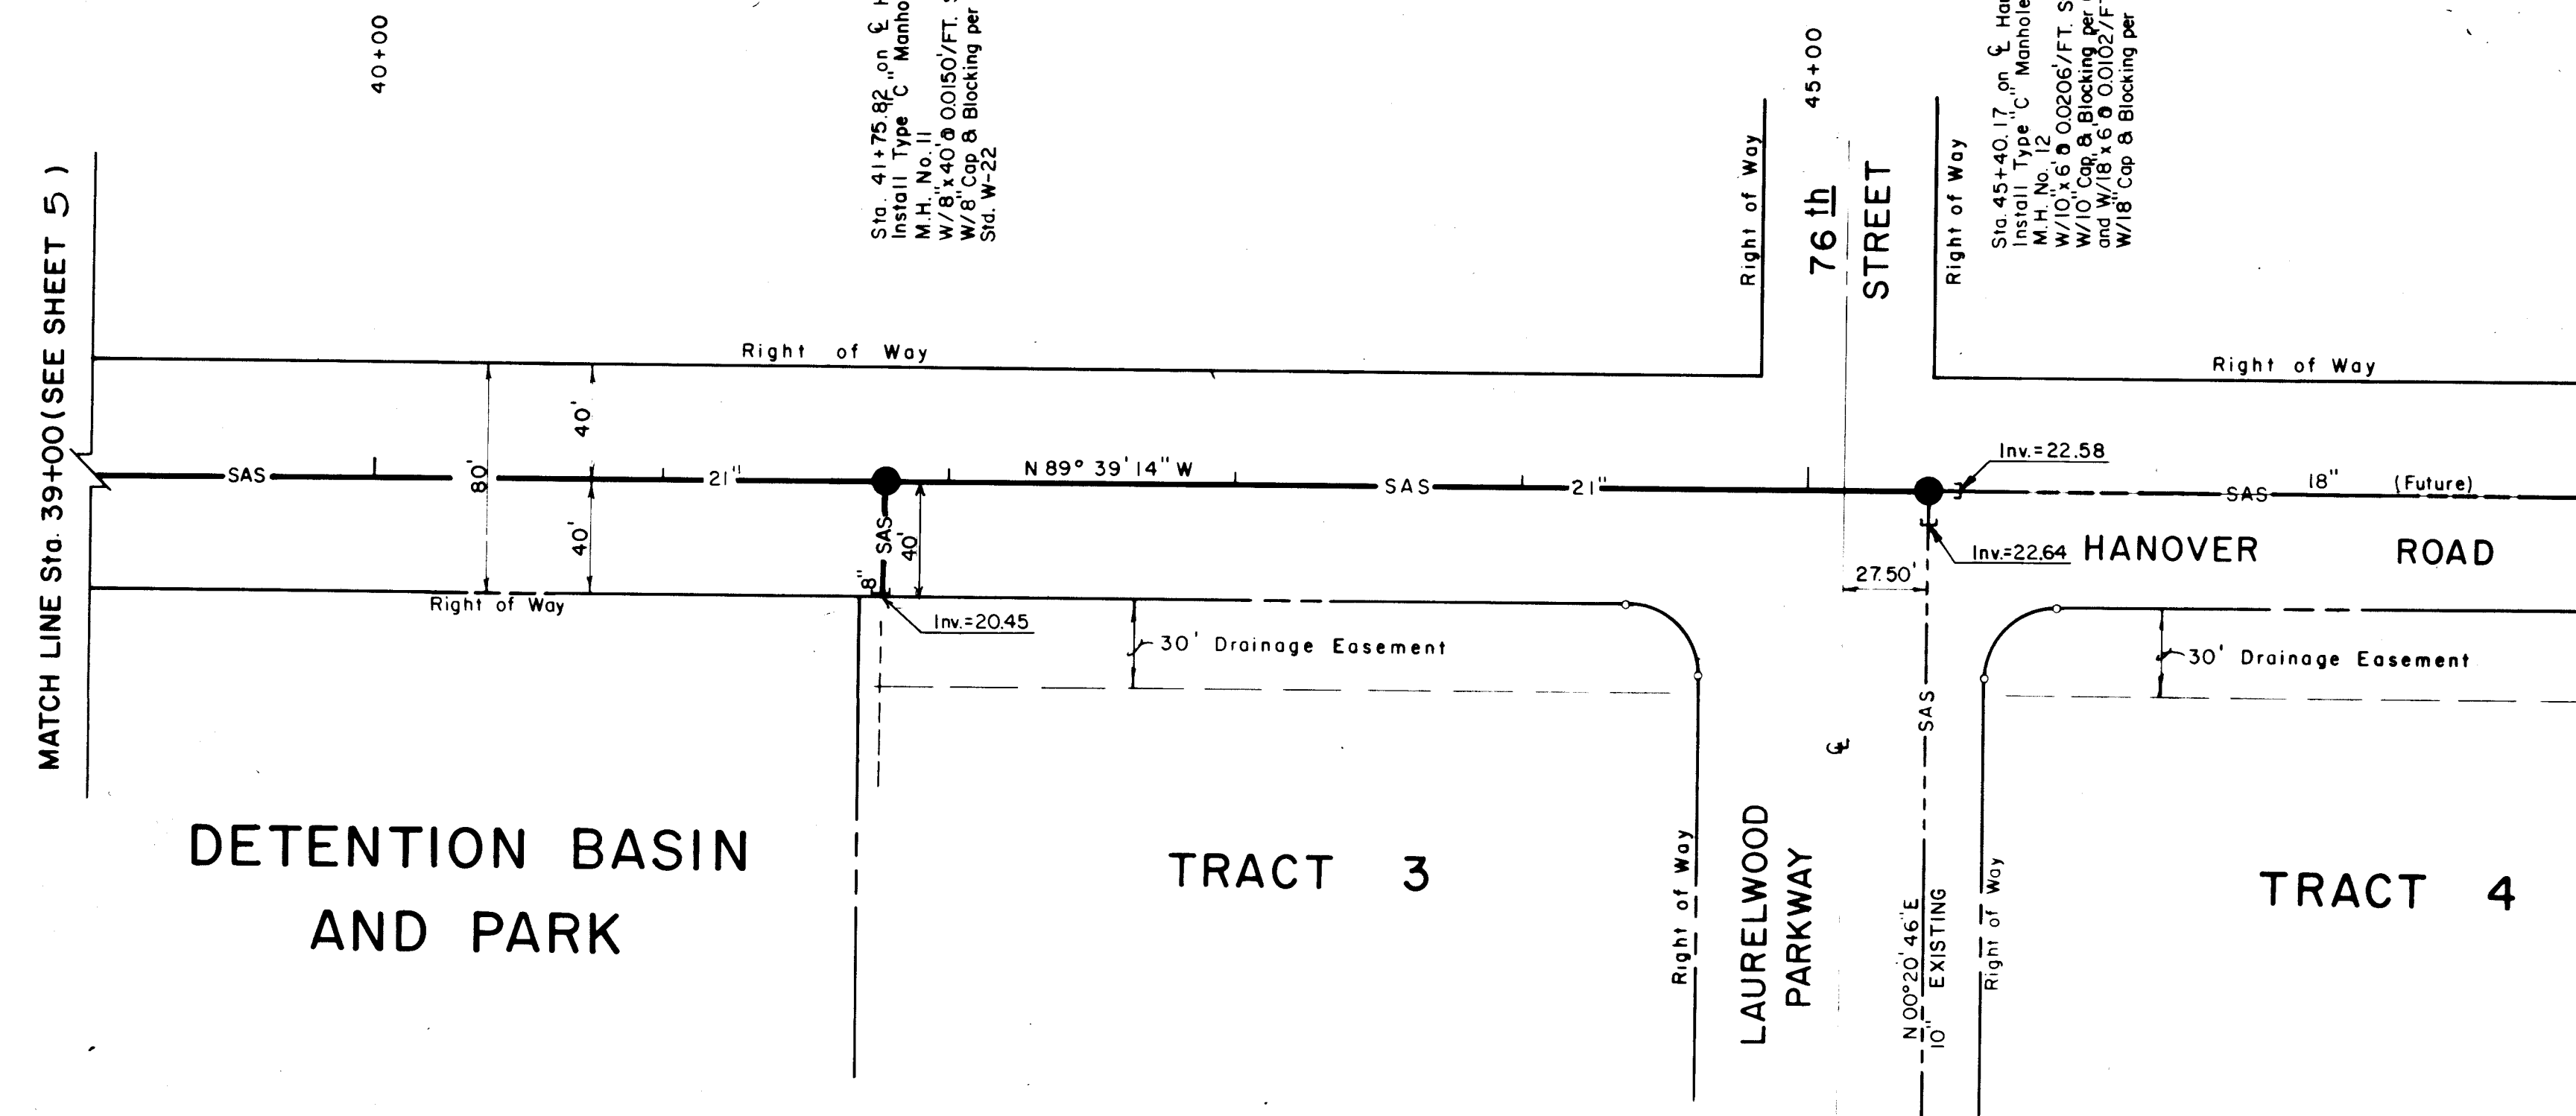

EL RANCHO ATRISCO PHASE III

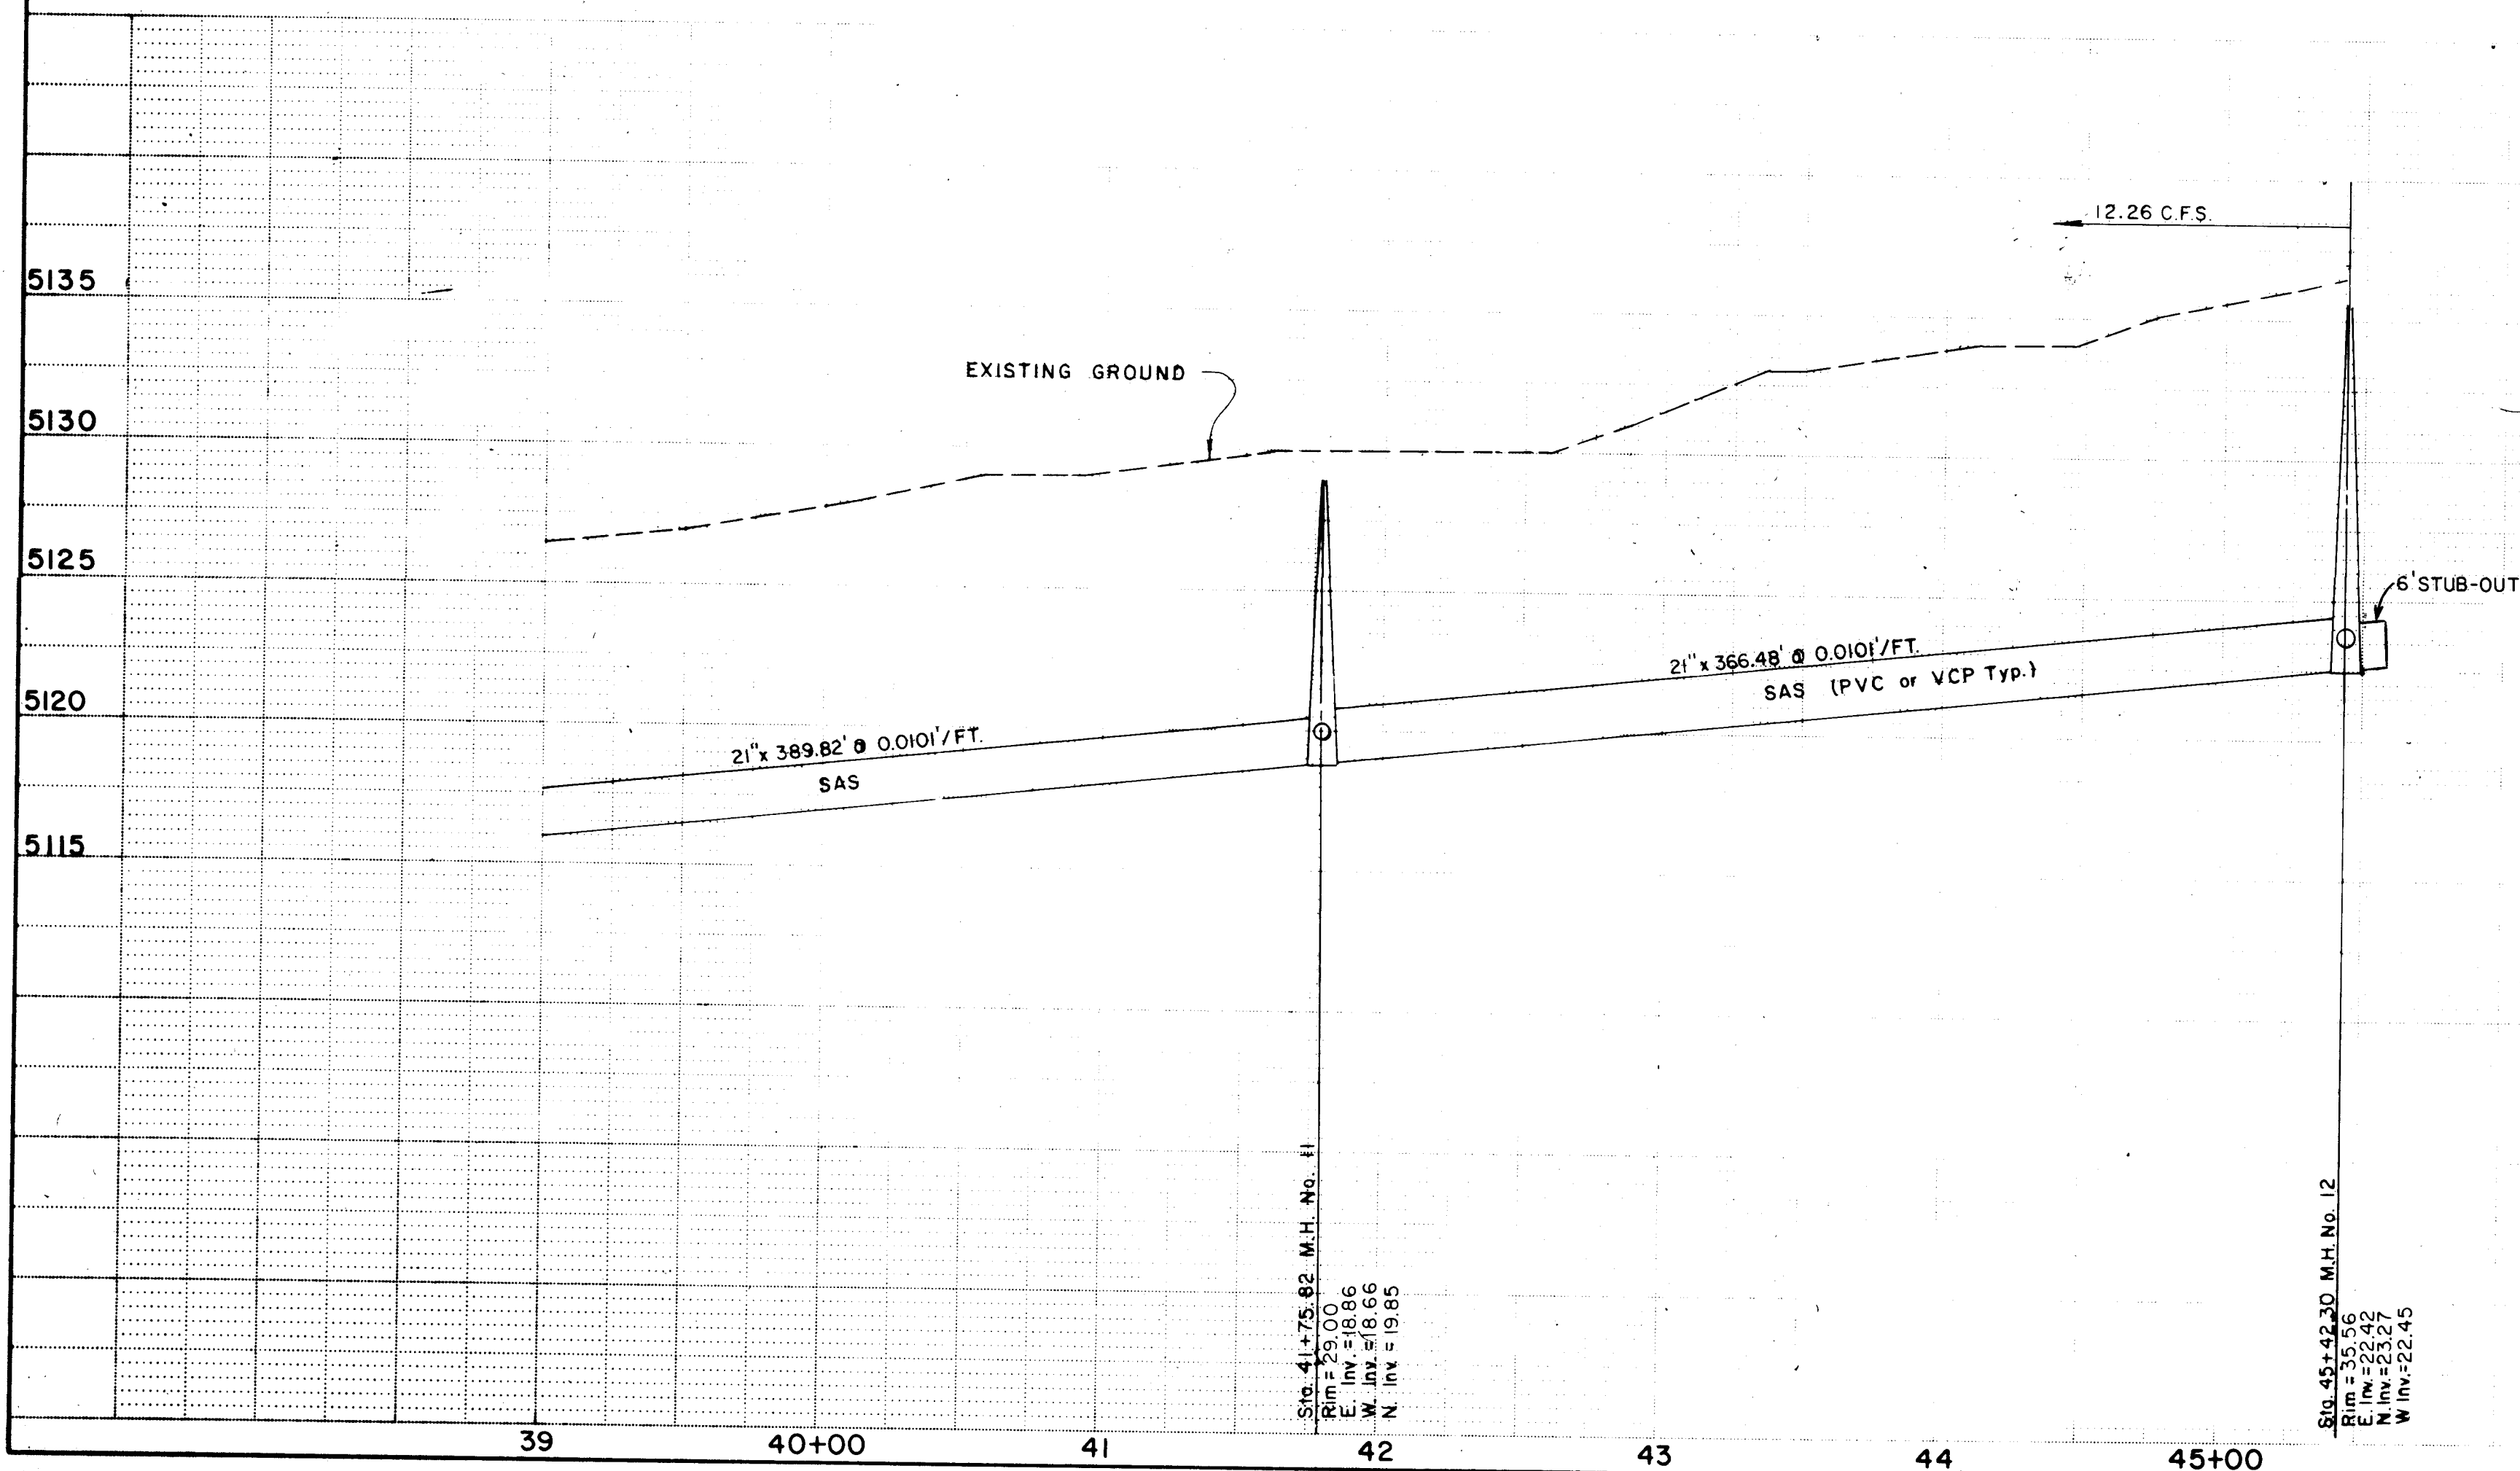

SCALE:
HORIZ. 1" = 50'
VERT. 1" = 5'

SURVEY INFORMATION		BENCH MARKS		AS BUILT INFORMATION	
NO.	DATE	NO.	DATE	NO.	DATE
1	1/13/84	1	1/13/84	1	1/13/84
2		2		2	
3		3		3	
4		4		4	
100		100		100	

APPROVED FOR
CONSTRUCTION

CITY OF ALBUQUERQUE
PUBLIC WORKS DEPARTMENT
ENGINEERING DIVISION

TITLE: MASTER PLAN SANITARY SEWER INTERCEPTOR
(64th STREET N.W. TO LAURELWOOD PARKWAY)
SANITARY SEWER PLAN & PROFILE

APPROVALS	ENGINEER	DATE	APPROVALS	ENGINEER	DATE
City Engineer			Liquid Waste		
A.C.E.-Design			Traffic		
A.C.E.-Hydrology			Water		

DRAWING NO. 1874