
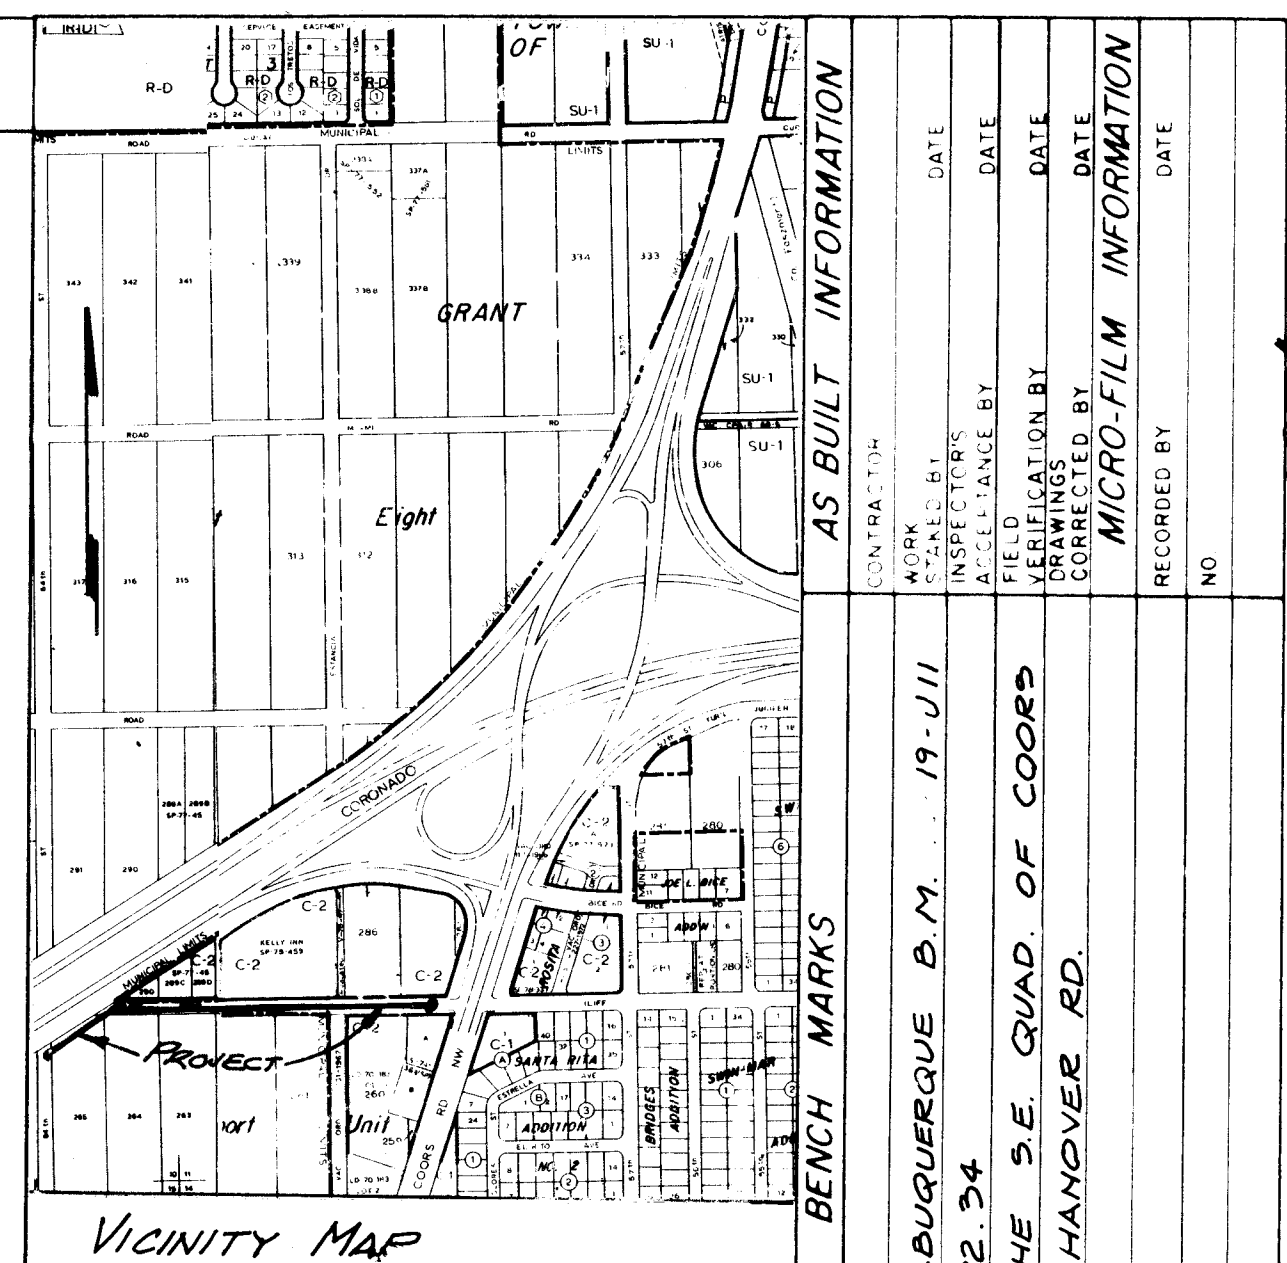
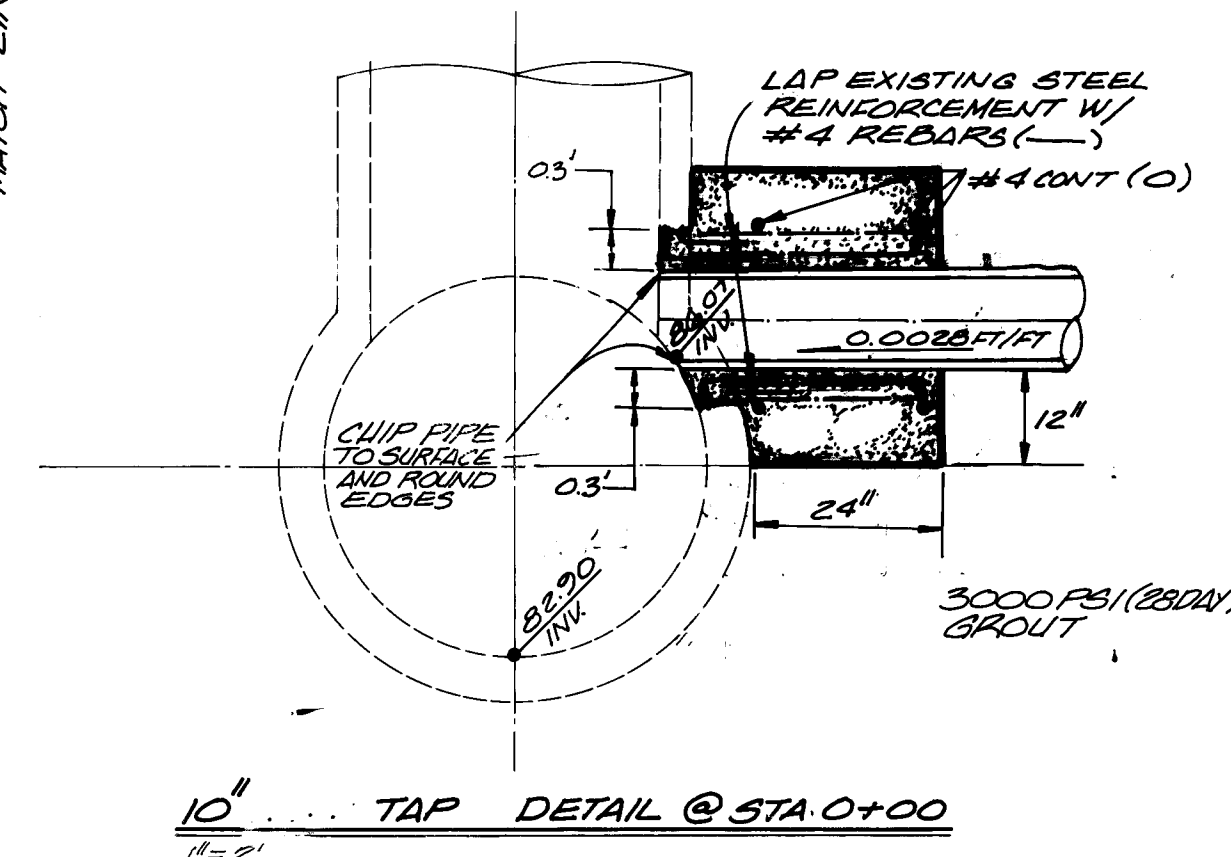
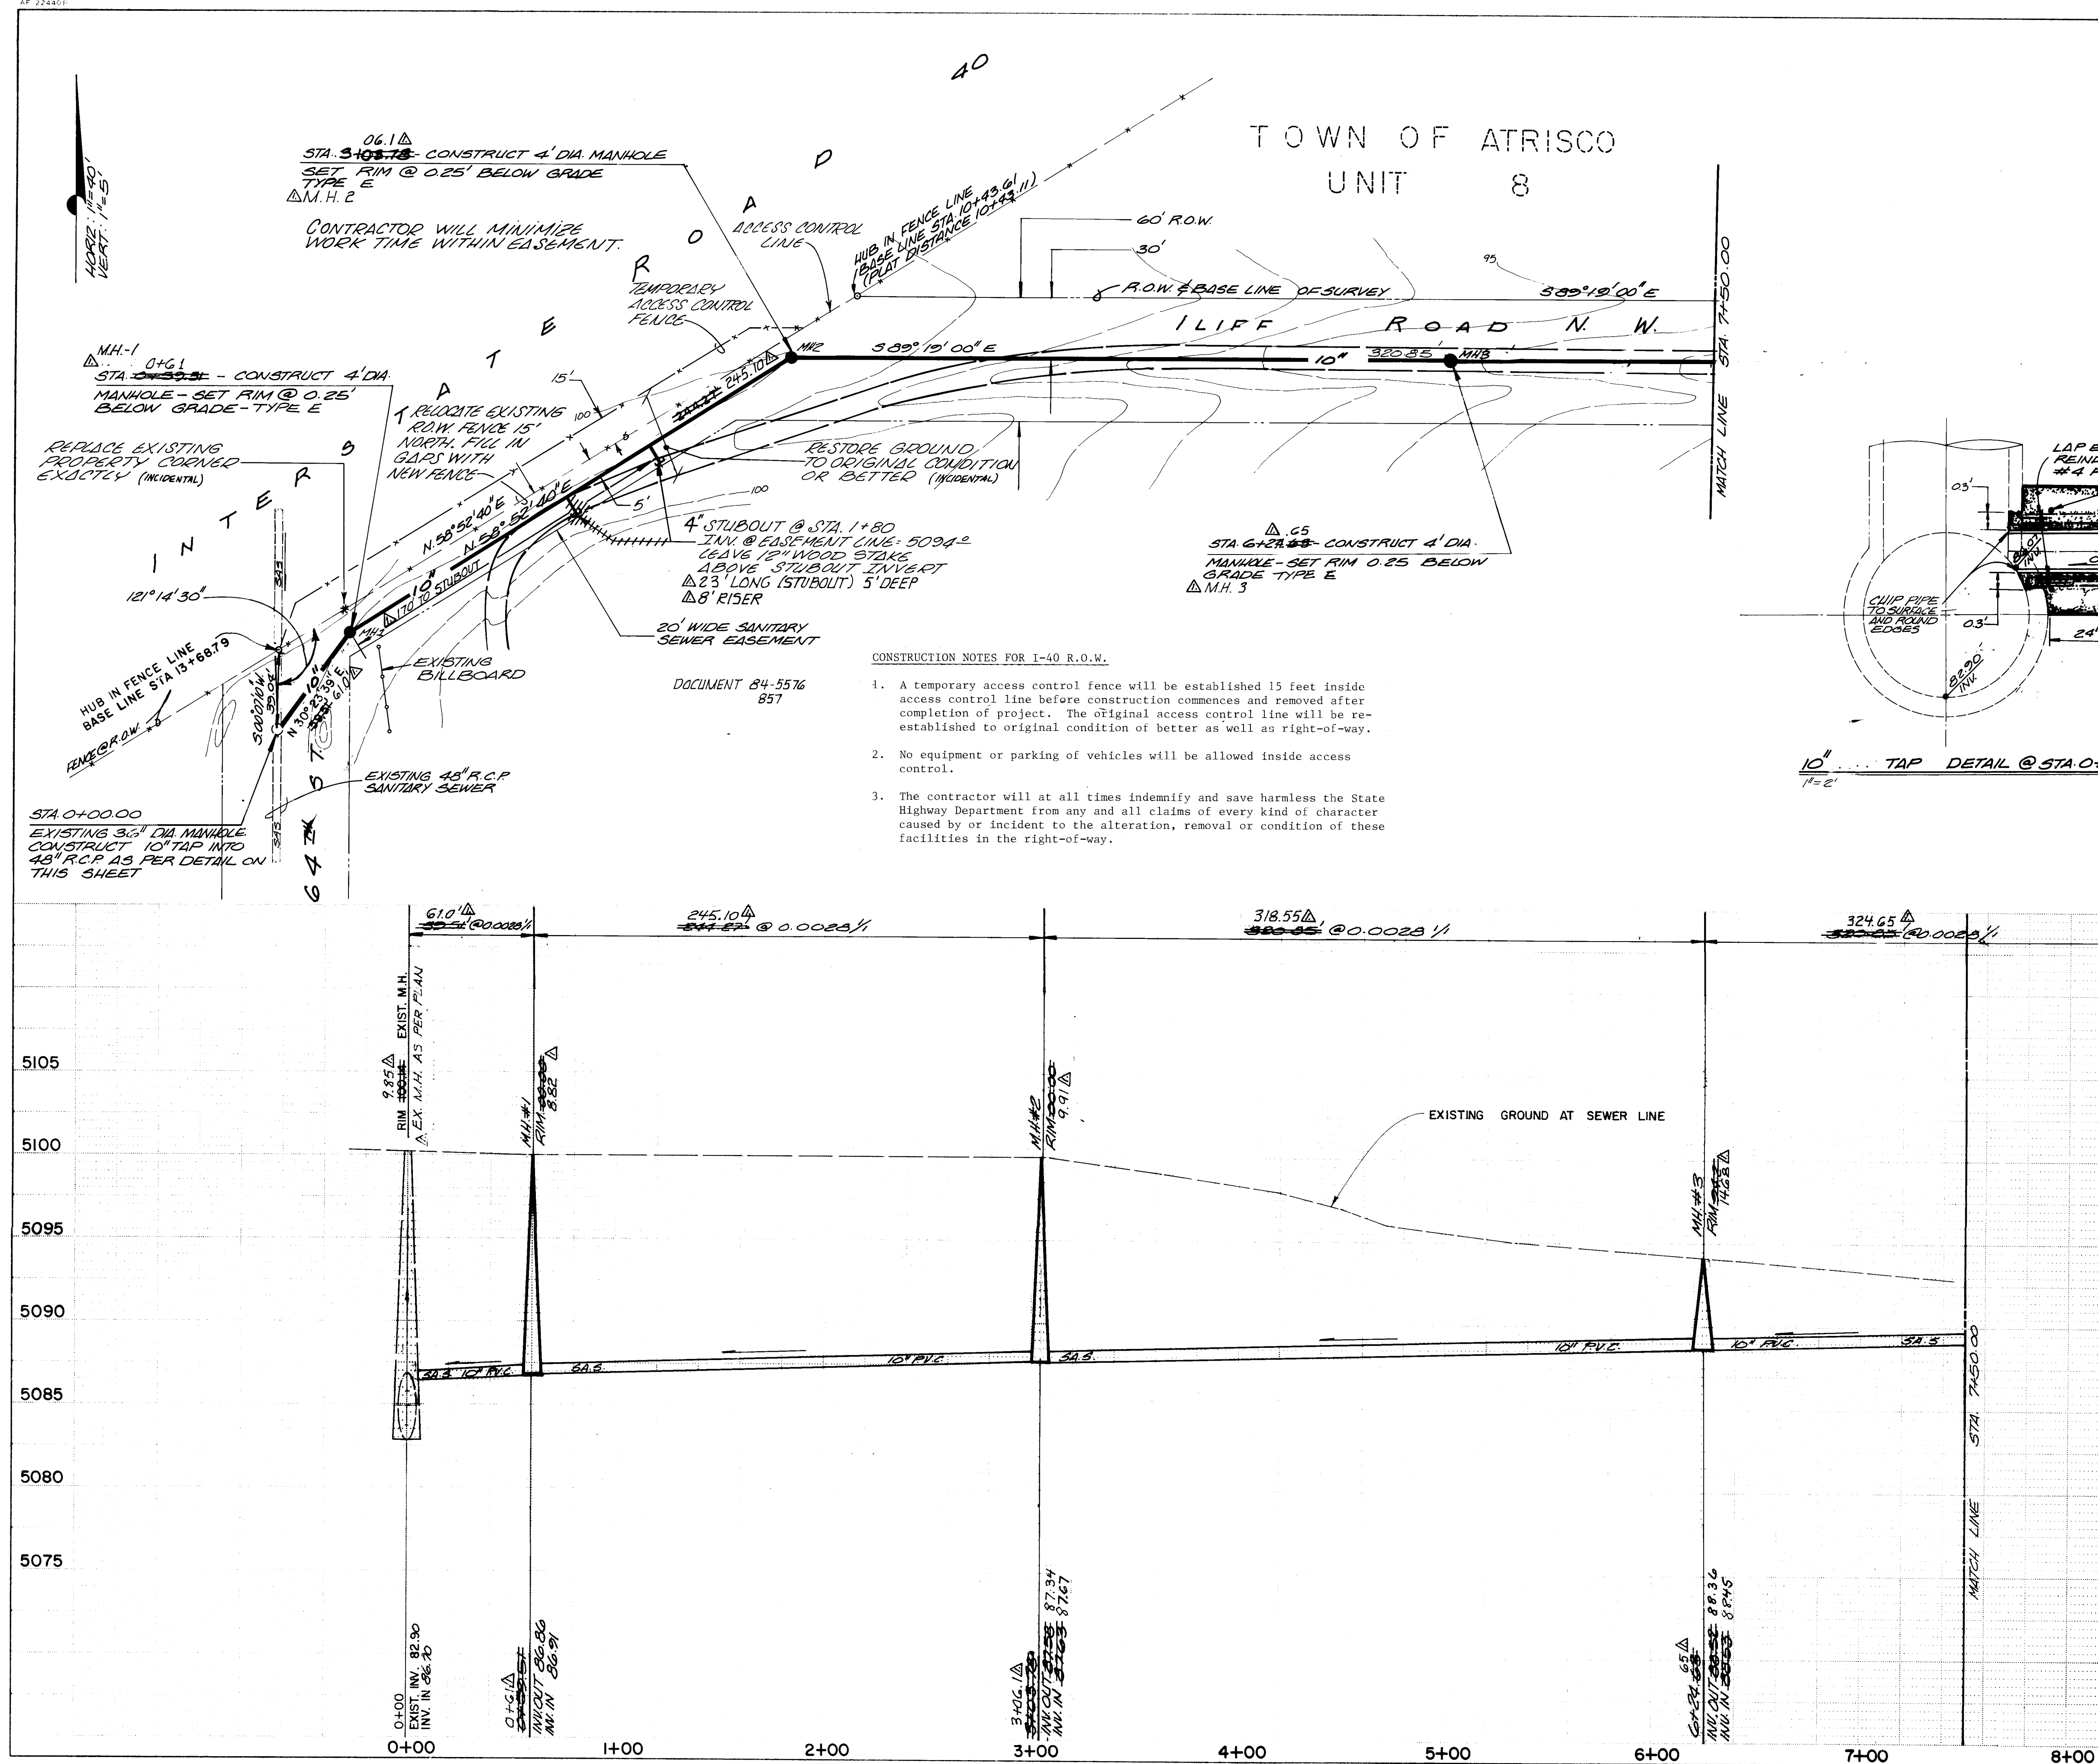


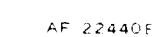

GENERAL NOTES

1. ALL WORK DETAILED ON THESE PLANS IS TO BE PERFORMED UNDER CONTRACT SHALL EXCEPT AS OTHERWISE SPECIFICALLY STATED OR PROVIDED FOR HEREON BE CONSTRUCTED IN ACCORDANCE WITH THE NEW MEXICO STANDARD SPECIFICATIONS FOR PUBLIC WORKS CONSTRUCTION - 1973 EDITION (REFERRED TO HEREIN AS THE STANDARD SPECIFICATIONS) AND THE CONTRACT DOCUMENTS FOR THE SAN ANTONIO SEWER EXTENSION - 64TH ST. TO WILSON ROAD PROJECT.
2. TWO (2) WORKING DAYS PRIOR TO ANY EXCAVATION, CONTRACTOR MUST CONTACT LINE LOCATING SERVICE, 765-1234, FOR LOCATION OF EXISTING UTILITIES.
3. PRIOR TO CONSTRUCTION, THE CONTRACTOR SHALL EXCAVATE & VERIFY THE HORIZONTAL & VERTICAL LOCATION OF ALL OBSTRUCTIONS. SHOULD A CONFLICT EXIST, THE CONTRACTOR SHALL CONTACT THE PROJECT ENGINEER OR THE OWNER SO THAT THE CONFLICT CAN BE RESOLVED WITH MINIMUM AMOUNT OF DELAY.

4. CONTRACTOR TO PERFORM CONSTRUCTION SURVEYING

SURVEY INFORMATION		FIELD NOTES
U.S.		


ENGINEER'S SEAL

[illegible]

CITY OF ALBUQUERQUE MUNICIPAL DEVELOPMENT DEPARTMENT ENGINEERING DIVISION					
TITLE: <i>SANITARY SEWER EXTENSION ON ILIFF ROAD - 64TH ST. TO COORS ROAD</i>					
APPROVALS	ENGINEER	DATE	APPROVALS	ENGINEER	DATE
City Engineer			Liquid Waste		
A.C.E. - Design			Traffic		
A.C.E. - Hydrology			Water		
DRAWING NO. <i>CHANGE ORDER-1874</i>		MAP NO. <i>H-10</i>		SHEET <i>1</i> OF <i>2</i>	

1874

AF 22440P

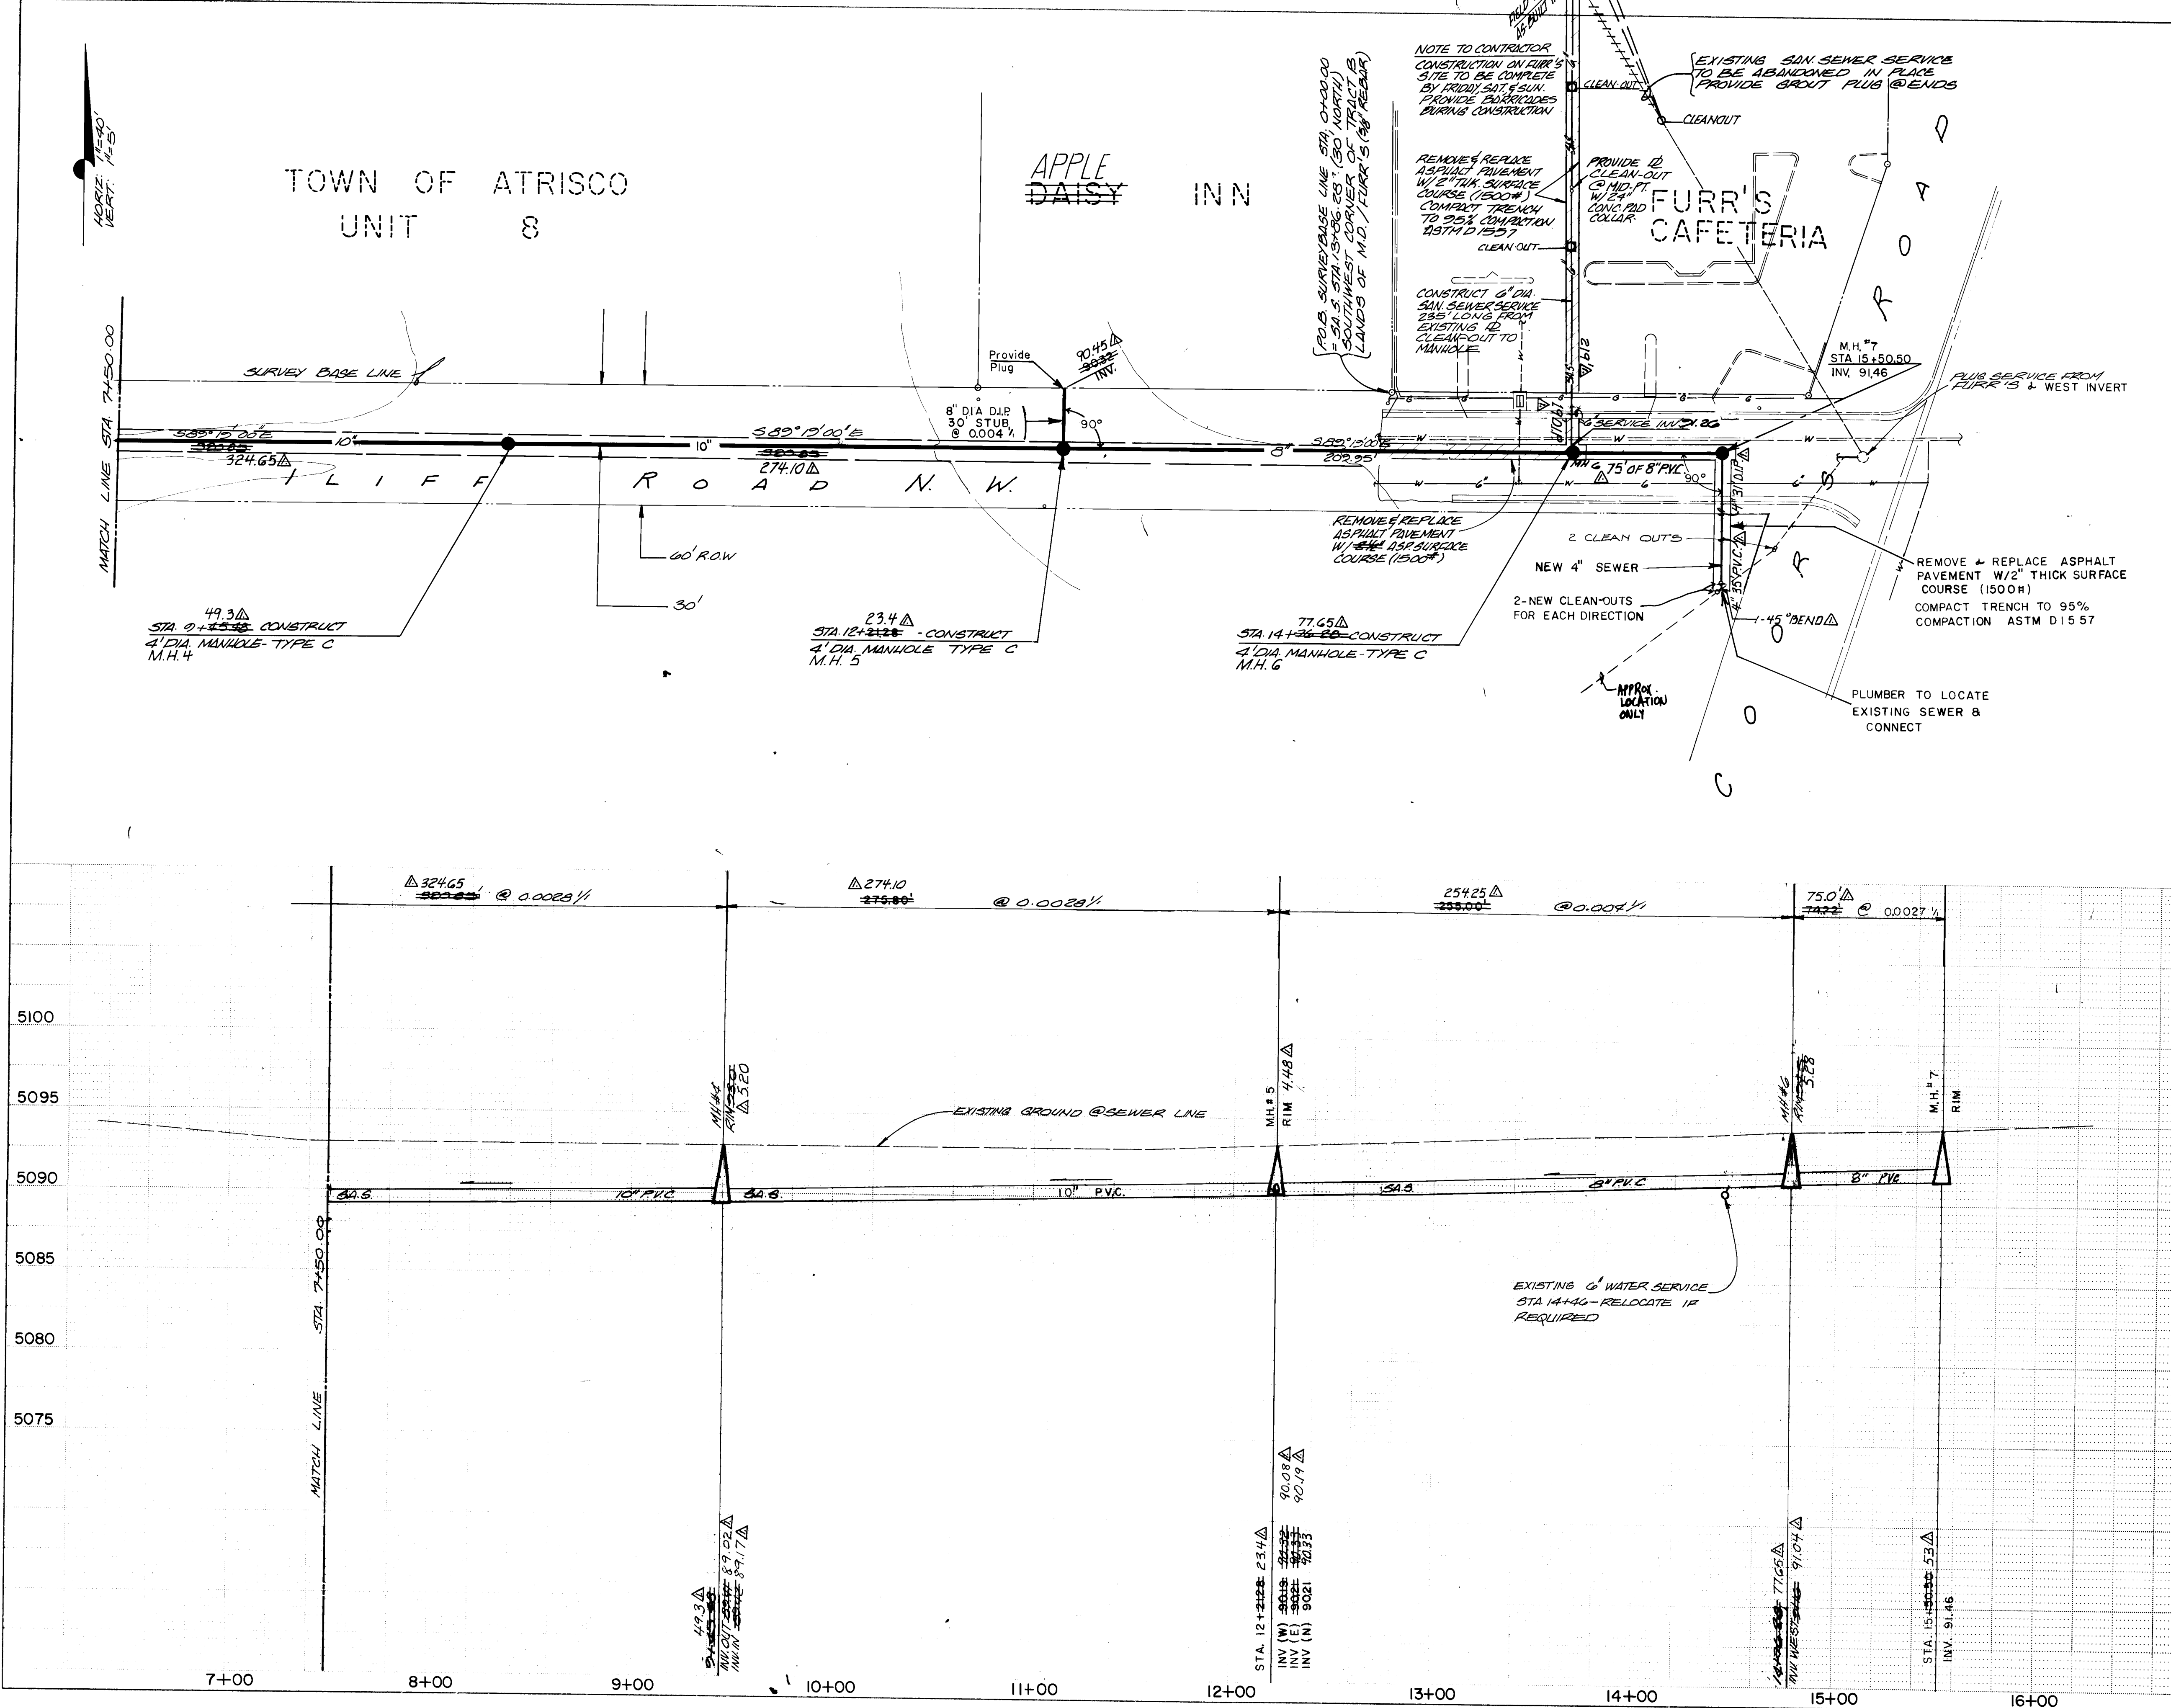

ENGINEER'S SEAL		SURVEY INFORMATION		BENCH MARKS		AS BUILT INFORMATION	
		FIELD NOTES		BENCH MARKS		AS BUILT INFORMATION	
		NO.	BY	DATE	DATE	DATE	DATE
REVISIONS		DESIGN		CONSTRUCTION		AS BUILT	
NO.		DATE		DATE		DATE	
DESIGNED BY		DRAWN BY		CHECKED BY		RECORDED BY	
DATE		DATE		DATE		DATE	
DATE		DATE		DATE		DATE	
DATE		DATE		DATE		DATE	

APPROVED FOR CONSTRUCTION
John H. Houle
WATER RESOURCES DEPARTMENT
ENGINEERING DIVISION

CITY OF ALBUQUERQUE
MUNICIPAL DEVELOPMENT DEPARTMENT
ENGINEERING DIVISION

TITLE: **SANITARY SEWER EXTENSION ON ILIFF ROAD - 64TH ST. TO COORS ROAD**

APPROVALS	ENGINEER	DATE	APPROVALS	ENGINEER	DATE
City Engineer			Liquid Waste		
A.C.E. - Design			Traffic		
A.C.E. - Hydrology			Water		

DRAWING NO. **CHANGE ORDER 1574** MAP NO. **H-10** SHEET **2** OF **2**