
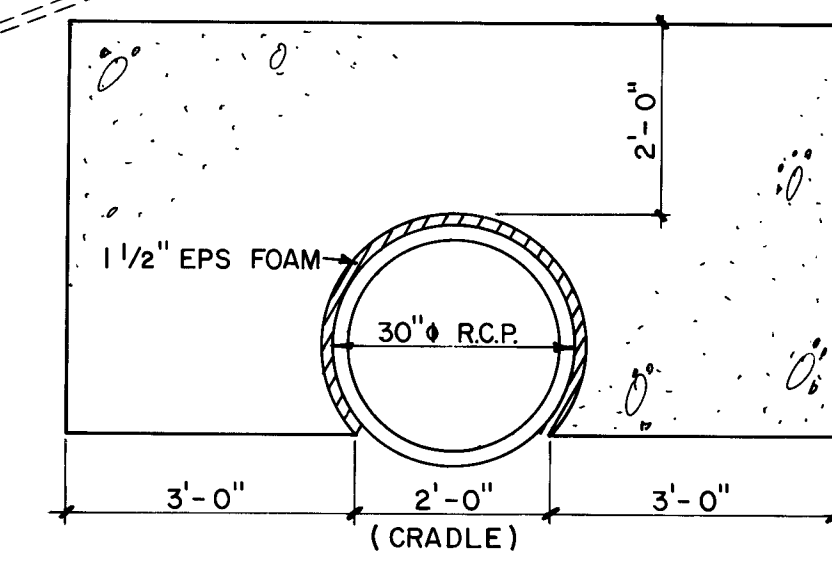
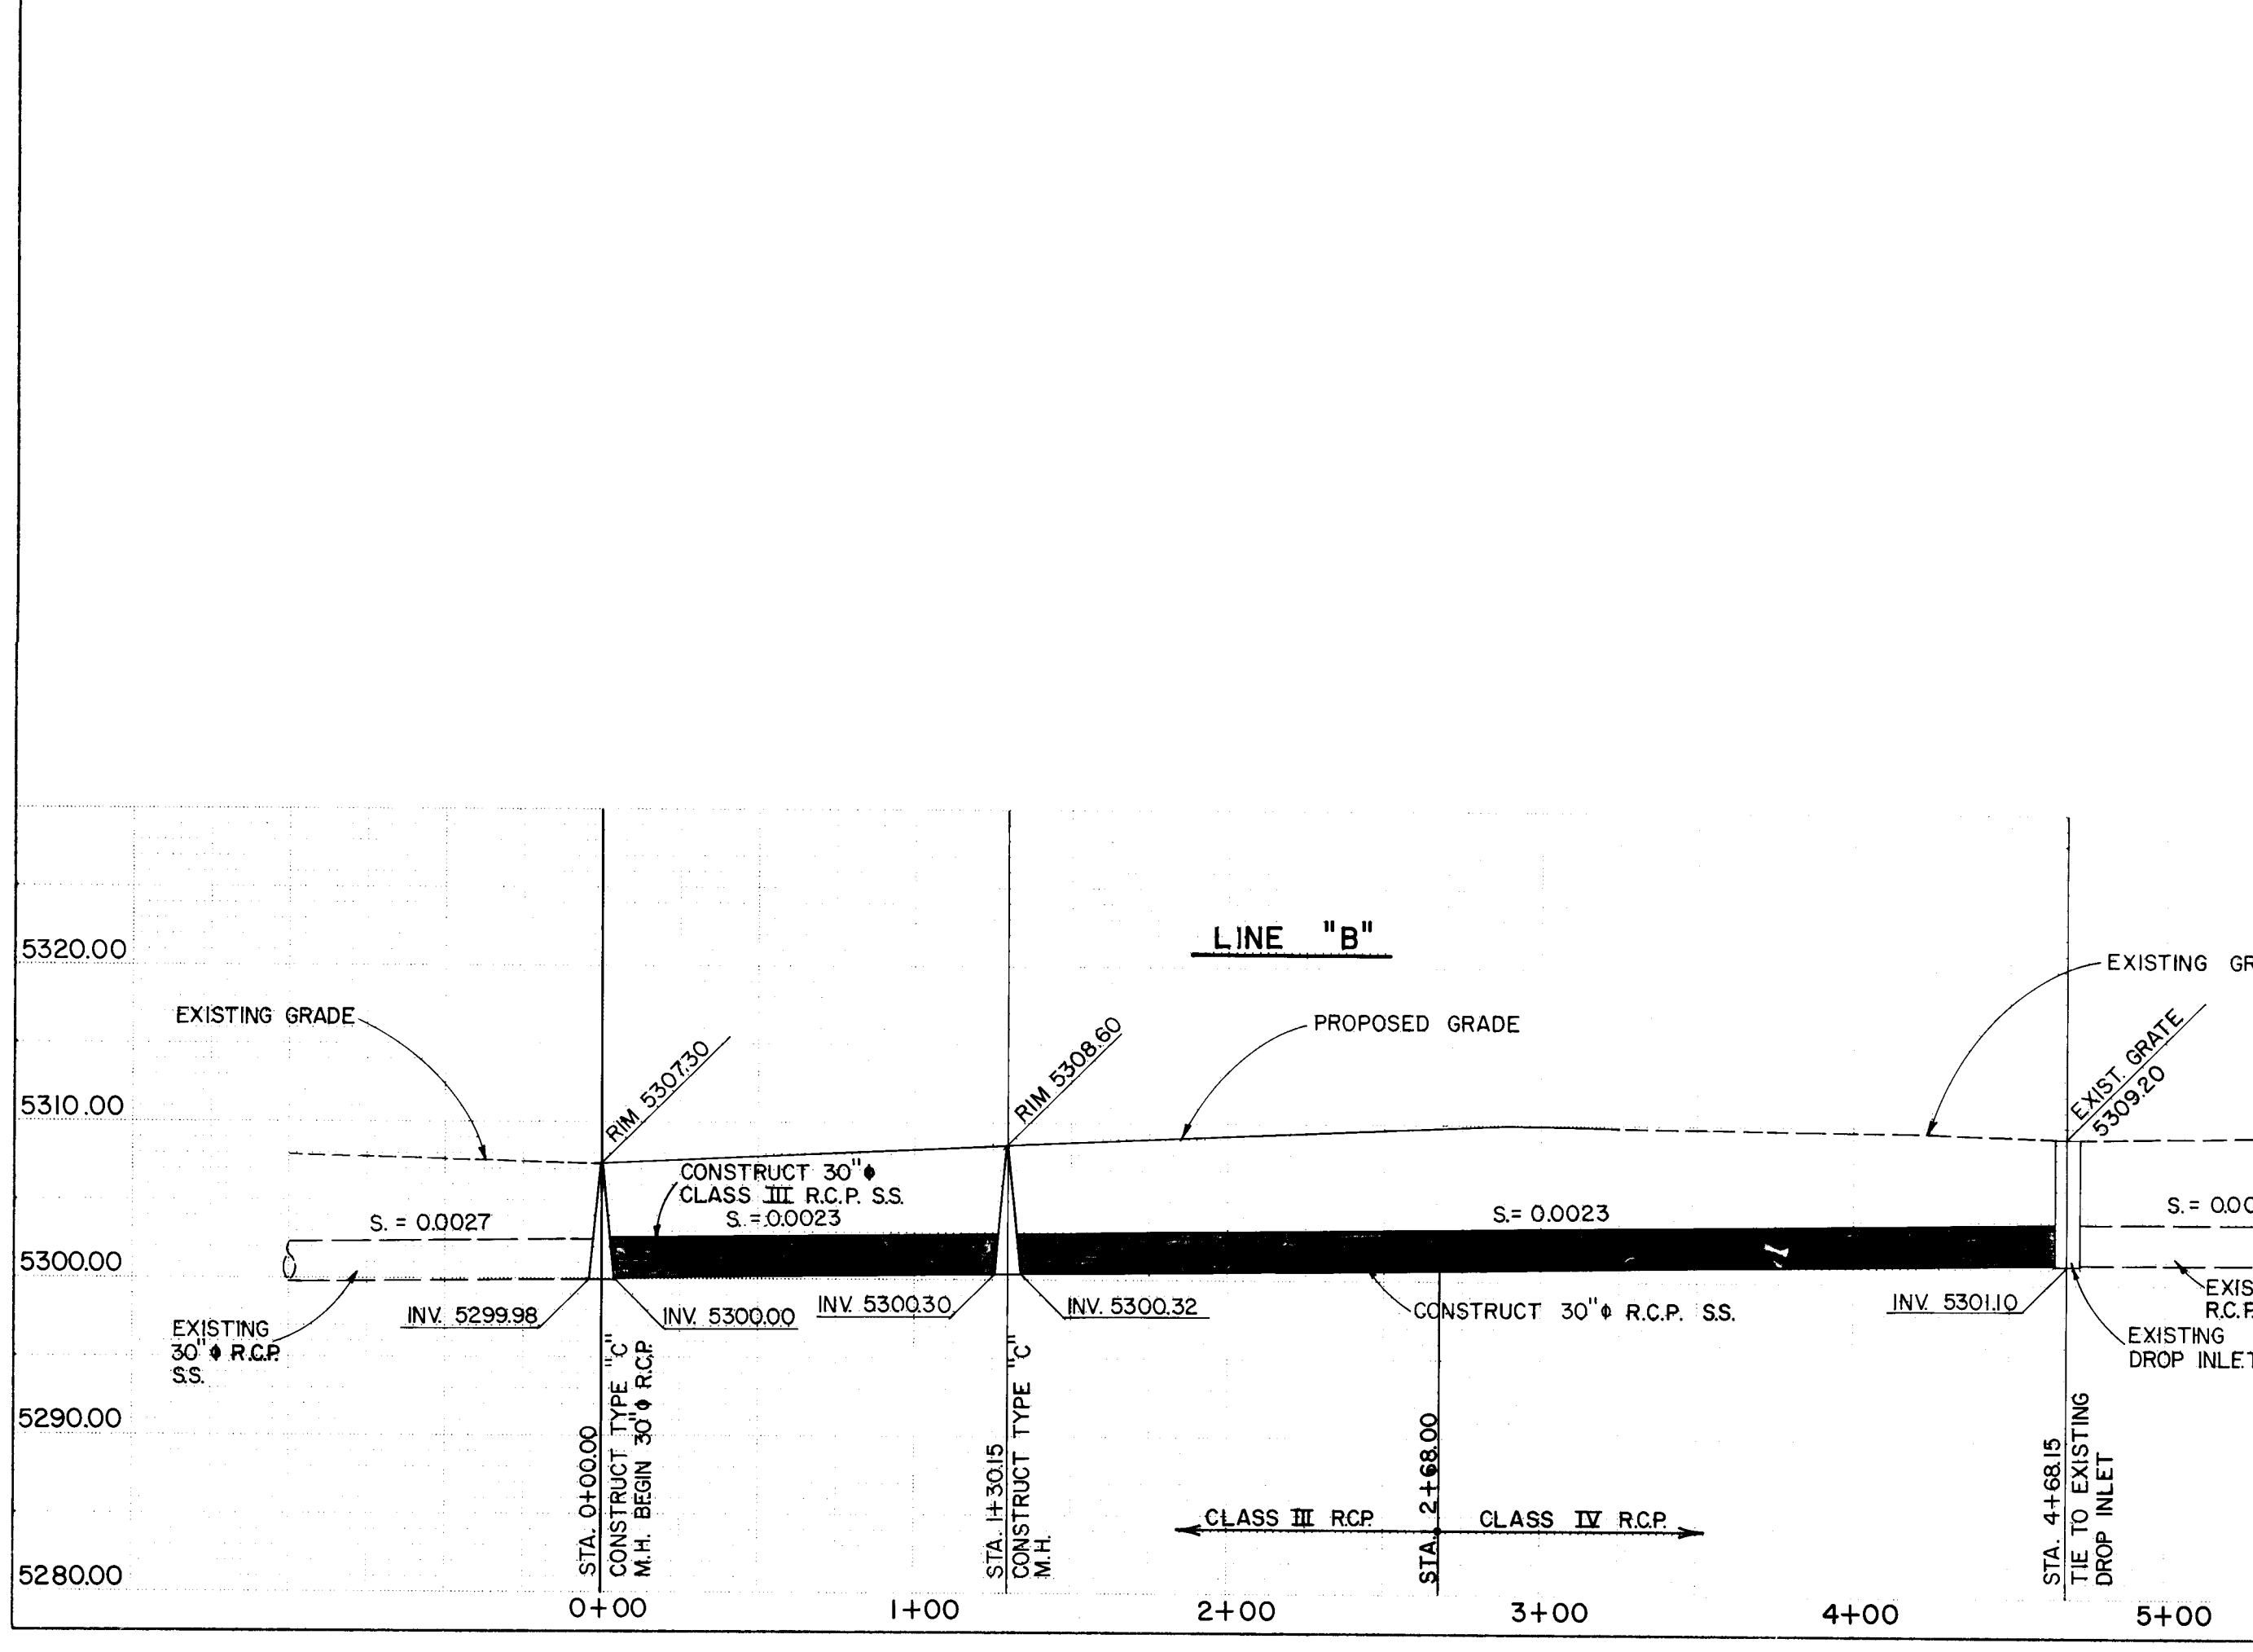
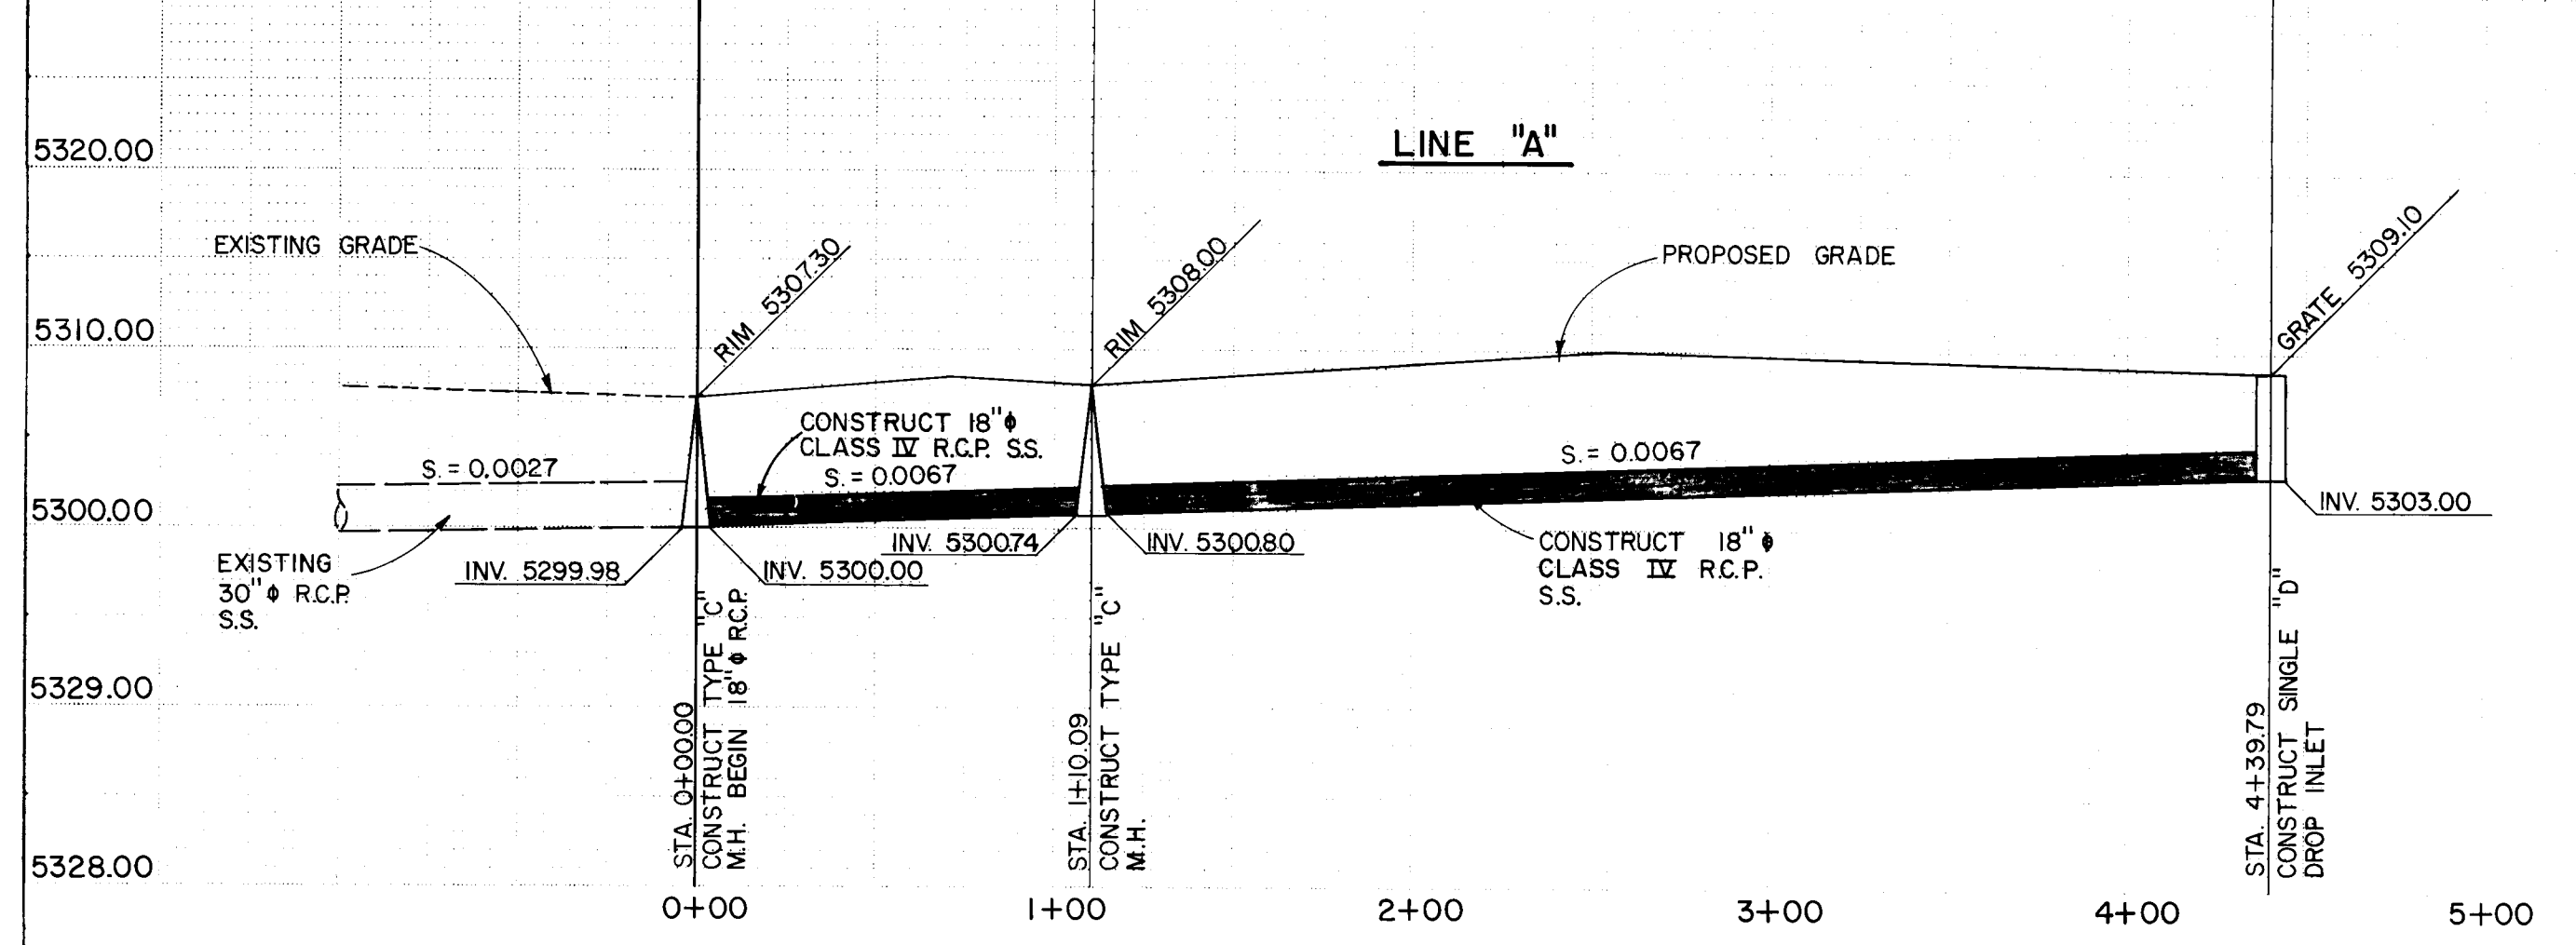


AP 254621

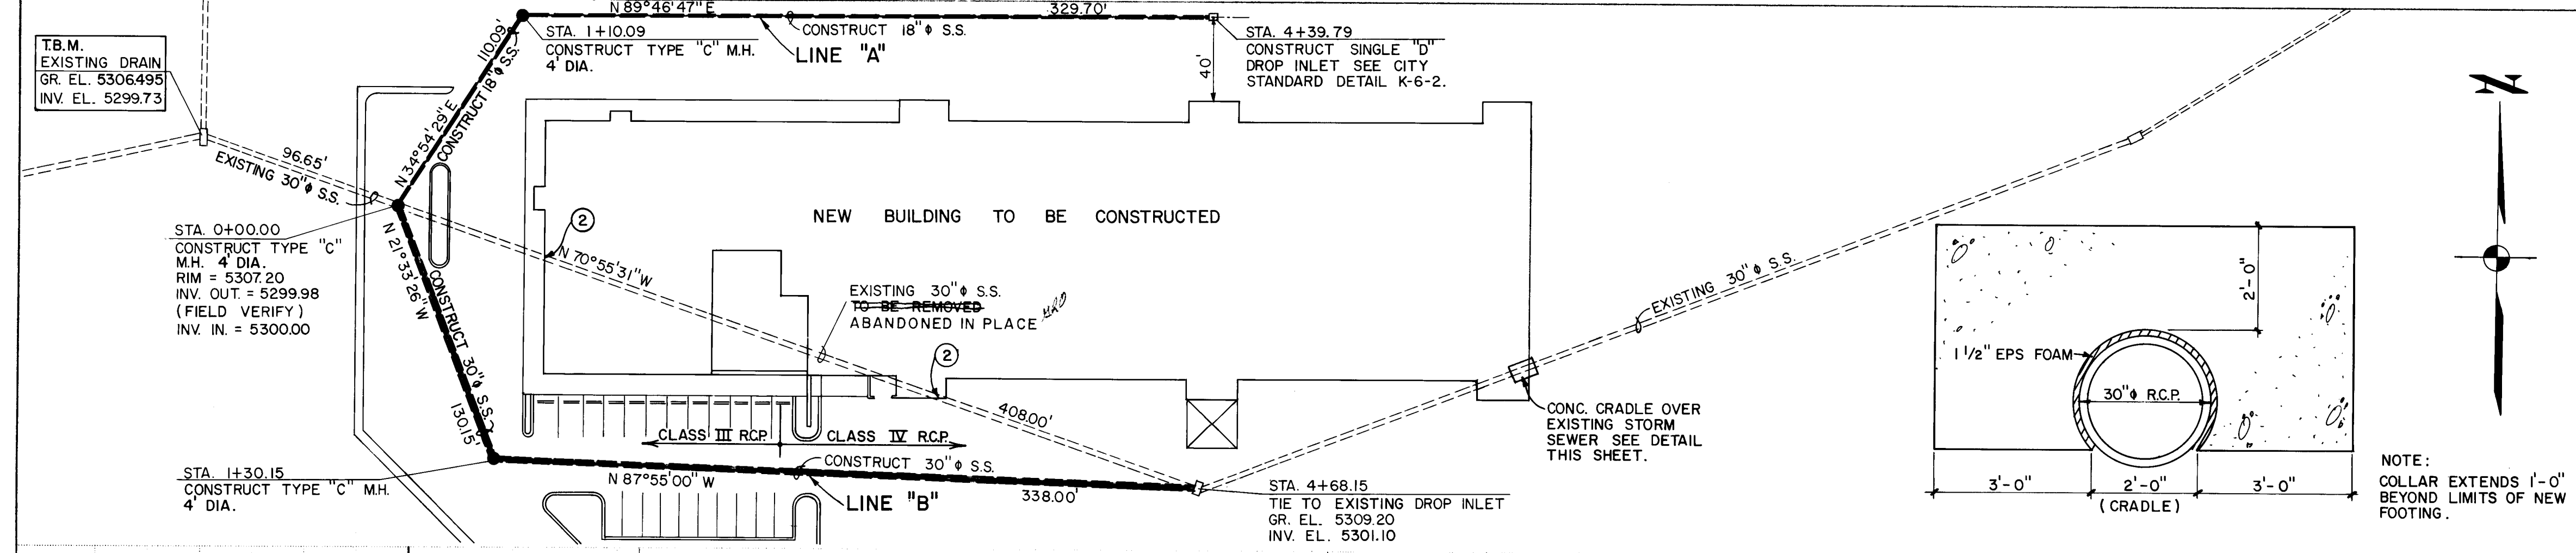

NOTE:
COLLAR EXTENDS 1'-0"
BEYOND LIMITS OF NEW
FOOTING.

SCALE
HORIZ. : 1" = 50'
VERT. : 1" = 10'


AS-BUILT
CERTIFICATION
BY [Signature]
TITLE AS-BUILT
DATE 5-11-84

SCALE
HORIZ. : 1" = 50'
VERT. : 1" = 10'

APPROVED
AVIATION DIRECTOR [Signature] DATE 5/11/84
CITY ENGINEER [Signature] DATE 5-11-84

CITY OF ALBUQUERQUE MUNICIPAL DEVELOPMENT DEPARTMENT ENGINEERING DIVISION					
TITLE: CUTTER FLYING SERVICE FIXED BASE OPERATION STORM DRAIN PLAN AND PROFILE					
APPROVALS	ENGINEER	DATE	APPROVALS	ENGINEER	DATE
City Engineer			Liquid Waste		
A.C.E. - Design			Traffic		
A.C.E. - Hydrology			Water		
DRAWING NO. 1880			MAP NO. N-16		
SHEET 1			OF 1		

- GENERAL NOTES:
- New storm drain shall be constructed in accordance with City of Albuquerque standards as outlined in Contract Documents for City-wide Utilities and Cash Paving No. 31.
 - Existing pipe removed below new footings. Remaining pipe plugged with concrete.

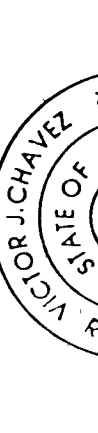ENGINEER'S SEAL				SURVEY INFORMATION		BENCH MARKS		AS BUILT INFORMATION	
				FIELD NOTES		ELEVATION INFORMATION		CONTRACT NO.	
				BY		DATE		JAYNES CORP.	
				NO.		MOLZEN-CORBIN & ASSOCIATES, PLANS		INSPECTED BY	
						76-22, DATED JULY, 1977		DATE	
						"GENERAL AVIATION AREA - DRAINAGE PLAN"		FIELD	
						T.B.M. - EXISTING DRAIN TOP OF GRATE ELEV. = 5306.495.		VERIFICATION BY	
								DATE	
								MICRO-FILM INFORMATION	
								RECORDED BY	
								NO	