


CLIFFORD PLAZA – MEDIAN REVISIONS
ON OSUNA AND KIRCHER

INDEX	
TITLE SHEET	1
PLAN-OSUNA	2
PLAN-KIRCHER	3

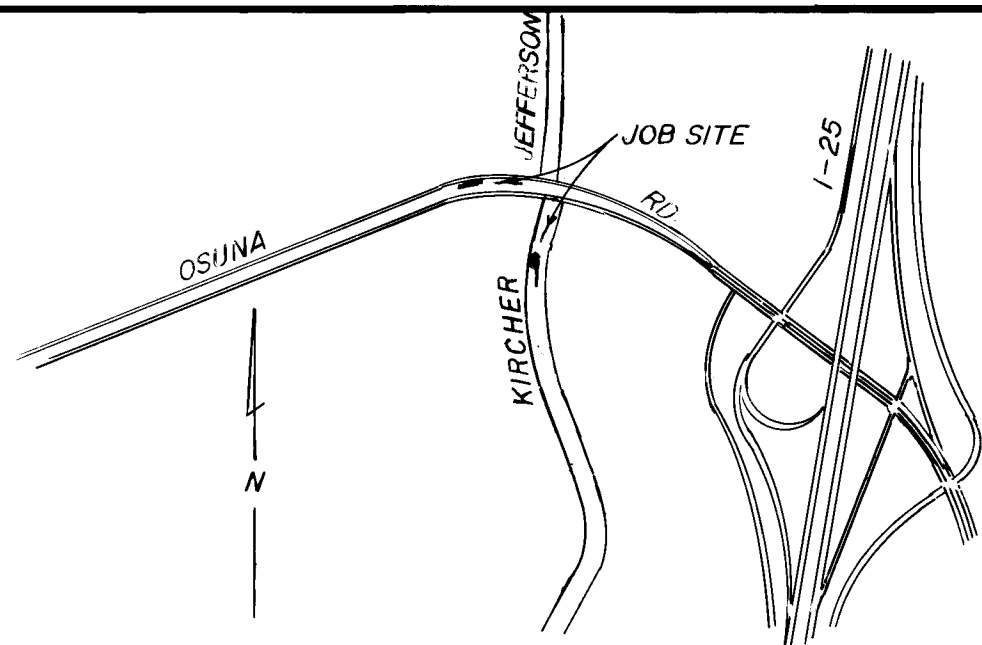

LOCATION MAP
ZONE ATLAS E-17

NOTICE TO CONTRACTORS

1. All work detailed on these plans to be performed under contract shall, except as otherwise stated or provided for hereon, be constructed in accordance with the New Mexico Standard Specifications for Public Works Construction - 1979 Edition (referred to herein as the Standard Specifications) and the Contract Documents for City Wide Utilities and Curb Paving No. 21.
2. Two (2) working days prior to any excavation, the contractor must contact Line Locating Service, 765-1234 for location of existing utilities.
3. Prior to construction, the contractor shall excavate and verify the horizontal and vertical locations of all obstructions. Should a conflict exist, the contractor shall notify the engineer or surveyor so that the conflict can be resolved with minimum amount of delay.


THE FOLLOWING NOTES ALSO APPLY
WHEN CHECKED


- ☐ All utilities and utility service lines shall be installed prior to paving.
- ☒ Packfill compaction shall be according to specified street use.
- ☒ Tack coat requirements shall be determined by the City Engineer. (Arterial)
- ☐ Sidewalks and wheelchair ramps within the curb returns shall be constructed wherever a new curb return is constructed.
- ☐ If curb is depressed for a driveway or a handicap ramp, the driveway or ramp shall be constructed prior to acceptance of the curb and gutter.
- ☐ All storm drainage facilities shall be completed prior to final acceptance.

APPROVAL OF AS BUILT DRAWING:
ASST. CITY ENGINEER FIELD
W. J. McNamee
DATE 4/25/84

26 1888 0184

	DRAWING NO. 1888	APPROVED FOR CONSTRUCTION <i>C. D. Chapman</i> CITY ENGINEER DATE
		SHEET OF 1 3

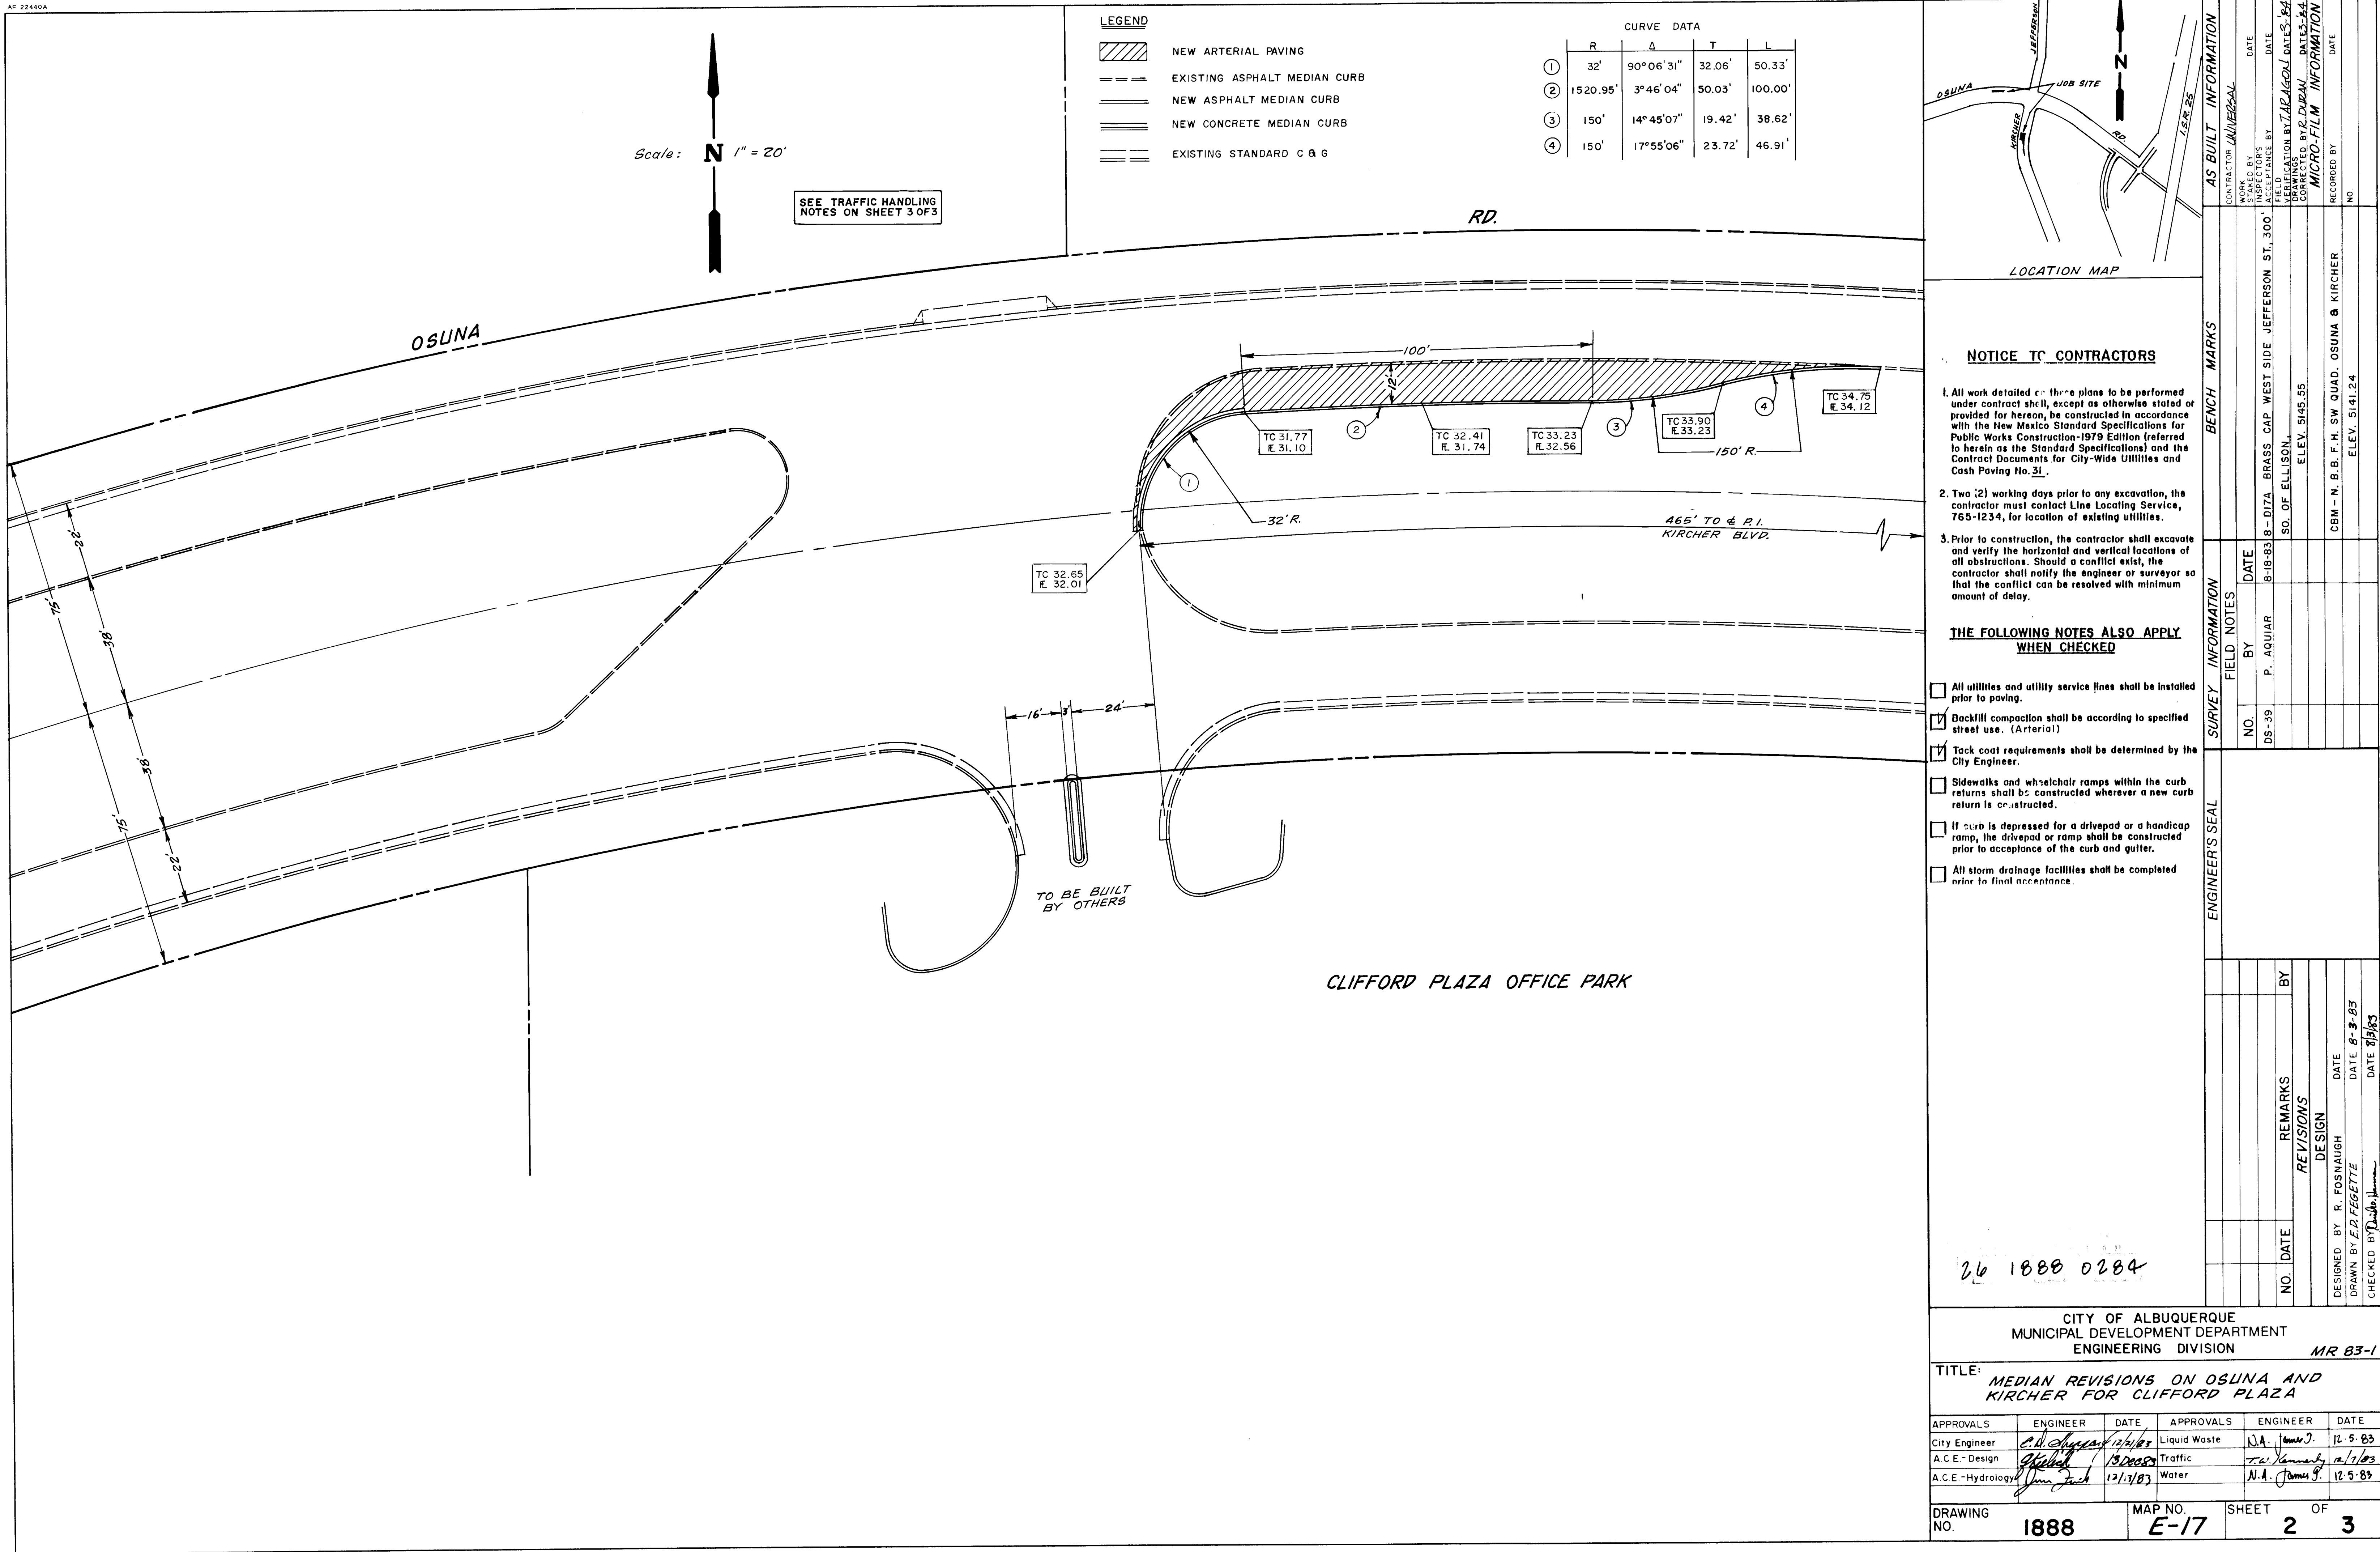

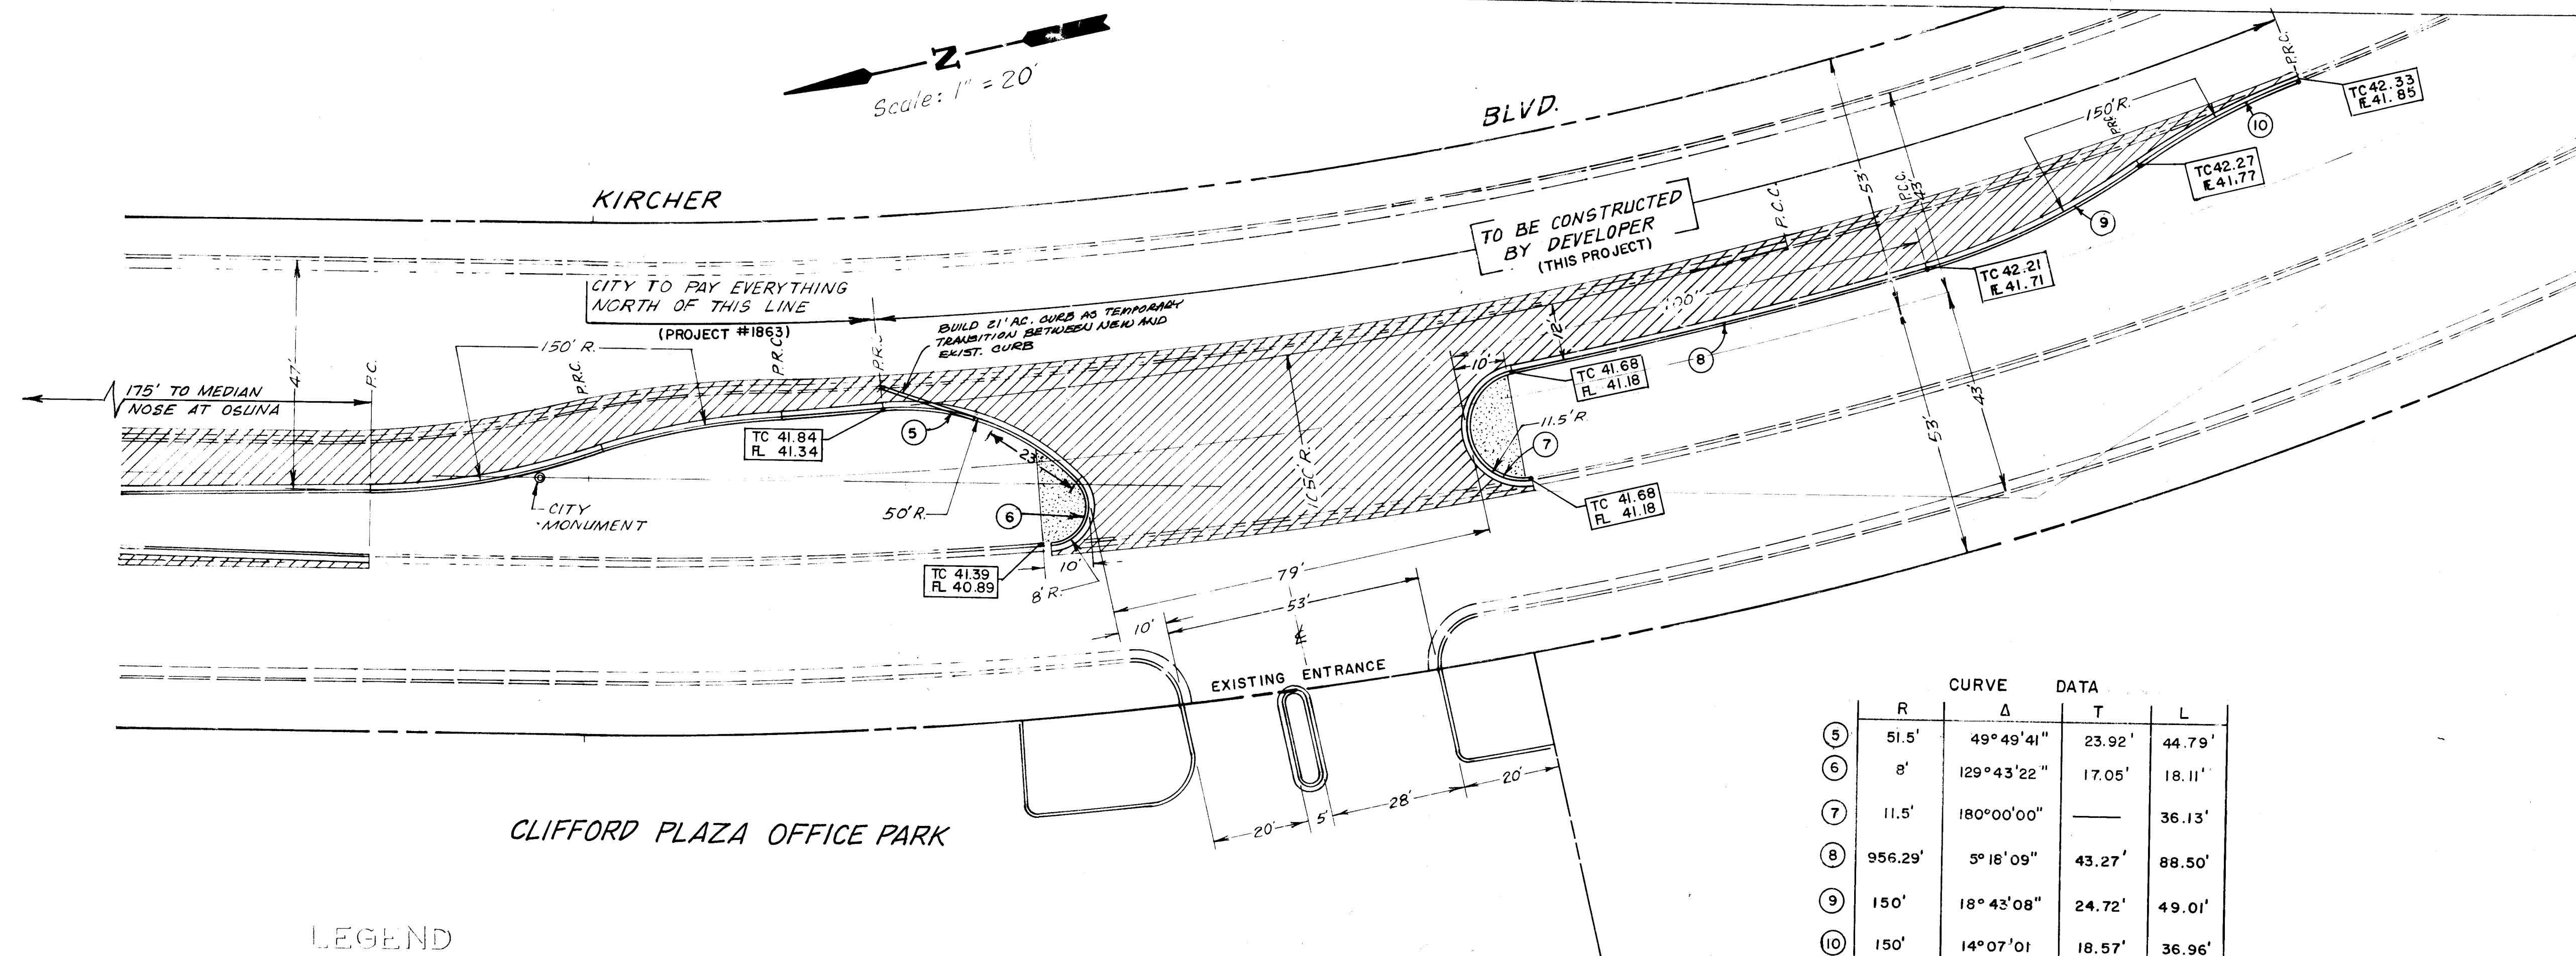

	R	Δ	T	L
⑤	51.5'	49°49'41"	23.92'	44.79'
⑥	8'	129°43'22"	17.05'	18.11'
⑦	11.5'	180°00'00"	—	36.13'
⑧	956.29'	5°16'09"	43.27'	88.50'
⑨	150'	18°43'08"	24.72'	49.01'
⑩	150'	14°07'01"	18.57'	36.96'

LEGEND

- NEW ARTERIAL PAVING
- EXISTING ASPHALT MEDIAN CURB
- NEW ASPHALT MEDIAN CURB
- EXISTING CONCRETE MEDIAN CURB
- NEW CONCRETE MEDIAN CURB
- EXISTING STANDARD CONCRETE CURB
- NEW STANDARD CONCRETE CURB
- 4" THICK CONCRETE, SIDEWALK STANDARD

TRAFFIC HANDLING NOTES

- CONTRACTOR MUST SUBMIT A CONSTRUCTION SIGNING AND BARRICADING PLAN TO TRAFFIC ENGINEERING DIVISION AND RECEIVE A BARRICADING PERMIT PRIOR TO CONSTRUCTION.
- ALL CONSTRUCTION SIGNING AND BARRICADING TO COMPLY WITH MANUAL ON UNIFORM TRAFFIC CONTROL DEVICES, 1978 EDITION AND SUBSEQUENT REVISIONS.
- CONTRACTOR'S OPERATION, BARRICADING AND SIGNING SHALL NOT AFFECT THRU LANES OF OSUNA, JEFFERSON OR KIRCHER BETWEEN 7 A.M. AND 9 A.M. OR 4 P.M. AND 6 P.M.

26 1888 03 84

CITY OF ALBUQUERQUE MUNICIPAL DEVELOPMENT DEPARTMENT ENGINEERING DIVISION			
TITLE: MEDIAN REVISIONS ON OSUNA AND KIRCHER FOR CLIFFORD PLAZA			
APPROVED	ENGINEER	DATE	APPROVED
City Engineer	<i>E. N. Thomas</i>	12/5/83	N.A. Thomas
A.E. Design	<i>W. J. Thomas</i>	12/5/83	N.A. Thomas
A.E. Hydrology	<i>W. J. Thomas</i>	12/5/83	N.A. Thomas
DRAWING NO. 1888		MAP NO. E-17	SHEET 3 OF 3

AS BUILT INFORMATION	UNIVERSAL
BENCH MARKS	8-DITA BRASS CAP WEST SIDE JEFFERSON ST., 300' SO. OF ELLISON, ELEV. 5145.55
SURVEY INFORMATION	FIELD NOTES
NO. DS-39	DATE 8-17-83
BY P. AGUIAR	DATE 8-17-83
ENGINEER'S SEAL	
REVISIONS	DESIGN
BY R. FOSNAUGH	DATE 8-3-83
BY E. F. FETTER	DATE