

DRAWING NO.	1914	MAP NO. J-16817	SHEET 1	OF 1
----------------	------	--------------------	------------	---------

TRAFFIC CONTROL NOTES

1. ALL TRAFFIC CONTROL DEVICES SHALL COMPLY WITH CHAPTER VII OF THE 1978 EDITION "MANUAL FOR UNIFORM TRAFFIC CONTROL DEVICES".
2. THE CONTRACTOR SHALL PREPARE AND SUBMIT TO THE PROJECT ENGINEER A DETAILED TRAFFIC CONTROL PLAN, IF AT VARIANCE WITH THE ENCLOSED TRAFFIC CONTROL PLAN, WHICH IS SUBJECT TO THE APPROVAL OF THE CITY TRAFFIC ENGINEER, 3 WORKING DAYS IN ADVANCE OF ANY REQUIRED LANE CLOSURES OTHER THAN THOSE SHOWN ON THESE PLANS.
3. ALL SIGNS MUST BE INSTALLED BEFORE CONSTRUCTION BEGINS AS DIRECTED BY THE ENGINEER. THE BOTTOM OF CONSTRUCTION WARNING SIGNS SHALL BE 7-FEET ABOVE THE SIDEWALK LEVEL.
4. ALL BARRELS MAY HAVE SAND OR WATER BALLAST LIMITED TO 100 LBS.
5. ALL SIGN LOCATIONS WILL BE SELECTED IN THE FIELD AND APPROVED BY THE PROJECT ENGINEER. DISTANCES MAY BE ADJUSTED FOR LOCAL CONDITIONS.
6. ALL SIGNS WILL BE GROUND MOUNTED ON SINGLE OR DOUBLE POSTS. EXISTING POSTS MAY BE USED AT SOME LOCATIONS WITH THE APPROVAL OF THE PROJECT ENGINEER. PORTABLE SIGN SUPPORTS WILL BE ACCEPTABLE AS AN ALTERNATE FOR SIGNS WHICH ARE IN PLACE LESS THAN 1 WEEK.
7. ALL SIGNS WILL BE MOVED FORWARD AS THE CONSTRUCTION PROGRESSES.
8. THE CONTRACTOR SHALL MAINTAIN VEHICULAR ACCESS TO ALL DREINWAYS OF BUSINESS AND RESIDENCES FRONTING THE CONSTRUCTION AREA AT ALL TIMES EXCEPT WHEN PAVING OCCURS DIRECTLY IN FRONT OF THE DREINWAY. WHEN BARRICADES ARE REQUIRED AFTER DARK, ALL ADVANCE WARNING SIGNS AND ALL BARRICADES SHALL BE EQUIPPED WITH FLASHING WARNING LIGHTS (TYPE A), EXCEPT THAT ALL CHANNELIZING BARRICADES SHALL HAVE STEADY BURNING WARNING LIGHTS (TYPE C).
9. ALL EXISTING REGULATORY SIGNS THAT NEED TO BE REMOVED, RELOCATED OR REINSTALLED SHALL BE DONE BY THE CITY OF ALBUQUERQUE TRAFFIC ENGINEERING DIVISION. THE CONTRACTOR SHALL NOTIFY THE TRAFFIC ENGINEERING DIVISION 3 WORKING DAYS IN ADVANCE OF ANY REQUIRED WORK.
10. THE CONTRACTOR SHALL PROVIDE AND MAINTAIN A SAFE AND ADEQUATE MEANS OF CHANNELIZING PEDESTRIAN TRAFFIC AROUND ALL WORK AREAS THROUGHOUT THE PERIOD OF CONSTRUCTION. ALL SUCH CHANNELIZATION SHALL BE ARRANGED TO PREVENT PEDESTRIANS FROM HAVING TO ENTER THE ROADWAY IN ORDER TO PASS AROUND THE WORK AREAS.
11. ALL CONSTRUCTION SIGNING SHALL BE BLACK ON A REFLECTORIZED ORANGE FIELD UNLESS OTHERWISE SPECIFIED. ALL CONSTRUCTION BARRICADES AND CHANNELIZATION DEVICES SHALL BE ORANGE OR WHITE, REFLECTORIZED, UNLESS OTHERWISE SPECIFIED.
12. ALL ADVANCE WARNING SIGNS NOT DIRECTLY APPLICABLE SHALL BE REMOVED, COVERED, OR TURNED AWAY FROM ONCOMING TRAFFIC.
13. A MINIMUM LANE WIDTH OF 14 FEET SHALL BE PROVIDED FOR TRAFFIC IN ONE DIRECTION, UNLESS OTHERWISE SPECIFIED.
14. ALL ADVANCE WARNING SIGNS SHALL BE 48" X 48" MINIMUM.
15. THE CONTRACTOR SHALL, THROUGH THE LOCAL NEWS PAPERS AND OTHER NEWS MEDIA, KEEP THE PUBLIC INFORMED OF CONSTRUCTION OPERATION INVOLVING STREET OR LANE CLOSURES AND SHALL PROVIDE THE CITY TRAFFIC ENGINEER DOCUMENTED PROOF THAT THIS HAS BEEN DONE.
16. EQUIPMENT AND MATERIALS ARE NOT TO BE STORED WITHIN 15' OF A TRAFFIC LANE.
17. EXCAVATION MUST BE PLATED OR PATCHED PRIOR TO OPENING TO TRAFFIC.
18. THE CONTRACTOR IS LIMITED TO THE RECONSTRUCTION OF ONE HALF OF THE LENGTH OF THE PROJECT (±1100 FT.) AT ANY ONE TIME DURING EITHER EAST OR WEST LANE CLOSURE PHASES (SEE SHEET 9).
19. THE CONTRACTOR SHALL REMOVE BARRICADES, TEMPORARY SIGNS AND/OR BARRELS, AS REQUESTED BY THE TRAFFIC ENGINEER, DURING ANY LANE CLOSURE PHASE IN LOCATIONS WHERE CONSTRUCTION IS NOT TAKING PLACE. COST INCURRED SHALL BE INCIDENTAL TO THE TRAFFIC CONTROL.

GENERAL NOTES

1. THE FOLLOWING MATERIAL SHALL BE REMOVED FROM THE PROJECT AND STOCKPILED AS INDICATED IN SECTION 212 OF THE SUPPLEMENTAL TECHNICAL SPECIFICATIONS: CURB, GUTTER & SIDEWALK. ALL COSTS INCURRED IN HAULING THIS MATERIAL TO THE DISPOSAL SITE DESIGNATED SHALL BE CONSIDERED INCIDENTAL TO THE PROJECT AND NO SEPARATE PAYMENT OR MEASUREMENT SHALL BE MADE. STORAGE AREA LOCATION FOR THIS PROJECT SHALL BE AREA 17 (ZONE A1145 F49) SOUTH SIDE OF BLAR CANYON ACRD WEST OF THE CITY NURSERY NEAR PENNSYLVANIA AND OSUNA ROAD. CONTACT STREET SUPERINTENDENT AT 766-7155 TO COORDINATE STOCKPILING. ASPHALT PAVEMENT & BASE SHALL BE DISPOSED OF BY THE CONTRACTOR. COSTS OF HAULING THIS MATERIAL IS CONSIDERED INCIDENTAL TO THE PROJECT. QUANTITIES SHOWN ARE FOR ESTIMATING PURPOSES ONLY. PAYMENT SHALL BE BASED ON ACTUAL QUANTITIES USED.
2. PAVEMENT STRIPS AND MARKINGS SHALL BE MAINTAINED BY THE CITY OF ALBUQUERQUE TRAFFIC DIVISION AND ARE NOT A PART OF THIS CONTRACT.
3. THE OWNER MAKES NO REPRESENTATION IN REGARD TO THE RELATIVE EASE OF DIFFICULTY THAT THE CONTRACTOR MAY ENCOUNTER IN PERFORMANCE OF THIS WORK. IT IS THE CONTRACTOR'S SOLE RESPONSIBILITY TO THOROUGHLY INVESTIGATE THE CONDITIONS AND SUBMIT A BID IN ACCORDANCE WITH WHAT HE HAS DISCOVERED. ANY AND ALL RECORDS PERTINENT TO THIS PROJECT ARE AVAILABLE FOR INSPECTION AT THE ENGINEER'S OFFICE.
4. THE CONTRACTOR SHALL ASSUME THE RESPONSIBILITY FOR ANY DAMAGE TO EXISTING CURB AND GUTTER DURING THE TOTAL ROADWAY REMOVAL AND REPLACEMENT OPERATION, APART FROM THOSE SECTIONS INDICATED FOR REMOVAL ON THE PLANS AND SHALL REPAIR OR REPLACE SAME AT HIS OWN EXPENSE. THE CONTRACTOR SHALL SATISFACTORILY PROTECT THE CURB AND GUTTER FROM INCIDENTAL SPLASHING DURING THE TACK COAT APPLICATION AND SHALL BE RESPONSIBLE FOR CLEANING SAME AT HIS OWN EXPENSE SHOULD SPLASHING OCCUR.
5. THE MAIN TRAVELLED WAY, EXISTING PAVEMENT, A WIDTH OF THIRTY TWO (32) FEET TO FIFTY SIX (56) FEET, INCLUDING INTERSECTIONS, SHALL BE COMPLETELY REMOVED AND REPLACED UNDER THIS CONTRACT WITH 6 INCHES OF FINEST GRADED BASE, 2 1/2 INCHES OF ASPHALTIC CONCRETE BASE COURSE, 1 1/2 INCHES OF ASPHALTIC CONCRETE SURFACE COURSE WITH TACK COAT AND AN OVERLAY OF 5/8 INCHES OF PLANT MIX SEAL COAT.
6. IF IT BECOMES NECESSARY TO PERFORM CONSTRUCTION UNDER THIS CONTRACT BETWEEN THE HOURS OF 7 PM AND 7 AM, ALL CITY STATE AND FEDERAL SAFETY REGULATIONS RELATIVE TO NIGHT TIME CONSTRUCTION ARE TO BE OBSERVED AND FOLLOWED.
7. THE CONTRACTOR SHALL NOTIFY ALL UTILITY COMPANIES WHEN WORKING NEAR THEIR SYSTEMS. CALL 765-1234 REGARDING LOCATION OF UTILITY LINES. UTILITY COMPANIES SHALL BE GIVEN 48 HOURS (WEEKEND EXCLUDED) ADVANCE NOTICE FOR LINE LOCATION.
8. AIR POLLUTION CONTROL REGULATIONS OF ALBUQUERQUE-BERNALILLO COUNTY AIR QUALITY CONTROL BOARD LIMIT EMISSION OF PARTICULATE MATTER AND THE USE OF CUT BACK ASPHALT. IT IS THE RESPONSIBILITY OF THE CONTRACTOR TO REVIEW THESE RESTRICTIONS WITH THE ENVIRONMENTAL HEALTH DEPARTMENT PRIOR TO SUBMITTAL OF BIDS TO AVOID CONFLICTS WITH THE REGULATIONS.
9. ALL FINISH GRADES, PROFILE AND SPOT ELEVATIONS ALONG CURB LINES ARE FLOW LINE UNLESS OTHERWISE NOTED.
10. THE NEW MEXICO STANDARD SPECIFICATIONS FOR PUBLIC WORKS CONSTRUCTION, 1975 EDITION, SHALL APPLY TO THE PROJECT AS AMENDED BY CITY OF ALBUQUERQUE CONTRACT DOCUMENTS FOR CITY-WIDE UTILITIES AND CASH PAVING NO. 31.
11. ALL REFERENCE TO CITY STANDARD DRAWINGS WILL BE PER CITY OF ALBUQUERQUE CONTRACT DOCUMENTS FOR CITY-WIDE UTILITIES AND CASH PAVING NO. 31.
12. THE CONTRACTOR WILL COORDINATE HIS CONSTRUCTION ACTIVITIES WITH OTHER CONTRACTORS AND UTILITY COMPANIES WORKING IN THE SAME AREA.

13. CONTRACTOR MUST CLEAN & INSPECT (T.V.) EXISTING 8" CONC. PIPE BEFORE SLEPPING.
14. CONTRACTOR IS NOT TO REPLACE PAVEMENT AS PART OF THE SLEPPING WORK. THIS WILL BE DONE IN THE STREET RECONSTRUCTION WORK. TEMPORARY PAVEMENT (LEVELING COURSE) SHALL BE USED AS A COVER TO ALLOW TRAFFIC ONTO PIT AREA IF NEEDED.
15. CONTRACTOR SHALL NOT CONSTRUCT INSERTION PIT FOR SLEPPING CONSTRUCTION AT MACKLAND DRIVE INTERSECTION.
16. CONTRACTOR SHALL CONTACT PLANNING & PROGRAMMING DIVISION, TRANSPORTATION DEPARTMENT (A.P. KELLY 766-4700) 24 HOURS PRIOR TO T.V. INSPECTION OF 8" CONCRETE PIPE.
17. ALLEY INTERSECTION CONSTRUCTION SHALL BE BID AT THE SAME UNIT PRICE AS DRIVEWAY CONSTRUCTION.
18. CONTRACTOR SHALL TRANSITION ALL NEW STD. CURB & GUTTER SECTIONS GREATER THAN SIX (6) FEET IN LENGTH TO EXISTING C&G AT BOTH ENDS OF NEW G&G CONSTRUCTION.
19. PROPERTY OWNERS, ADJACENT TO THE PROJECT, MAY DESIRE REPLACEMENT OF THEIR EXISTING DETERIORATED SANITARY SEWER SERVICE AT THE TIME THE SERVICE IS EXPOSED DURING THE NORMAL CONSTRUCTION. THIS WORK SHALL BE SEPARATE FROM THIS PROJECT AND SHALL BE PAID FOR BY THE REQUESTOR DIRECTLY TO (A) THE PROJECT CONTRACTOR, OR (B) A PRIVATE PLUMBING CONTRACTOR WHO SHALL COORDINATE HIS ACTIVITIES WITH THE PROJECT CONTRACTOR.
20. CONTRACTOR SHALL RECONNECT ALL SANITARY SEWER HOUSE SERVICES IN THE MANNER AND DIRECTION AS ORIGINALLY FOUND; EVEN IF THIS SHALL MEAN THE SERVICE MAY BE AT AN ANGLE OTHER THAN 90 DEGREES FROM THE MAIN; PER AGREEMENT WITH THE MECHANICAL SECTION/CODE ADMINISTRATION DIVISION.
21. WHEN EXISTING SANITARY SEWER SERVICES HAVE BEEN RECONNECTED TO REPLACEMENT MAINS, THE CONTRACTOR SHALL STAMP OR CHISEL A 3-INCH SIZE "S" ON TOP OF CURB OVER THE LOCATION OF THE SERVICE LINE. THE CURB CUT FOR THE "S" MUST BE MINIMUM 1/4 INCH.
22. THE CONTRACTOR SHALL CONSTRUCT THE SLEPPING PORTION OF THE PROJECT FIRST AND SHALL BACKFILL AND TEMPORARILY PAVE ALL TRENCHES AND EXCAVATION AREAS PRIOR TO BEGINNING ROADWAY RECONSTRUCTION.

LENGTH OF PROJECT			
STA. & STA.	IN. FT.	ALTS.	REMARKS
CHUCK 22164	2,242	0.43	BOTH DIRECTIONS

REQUIRED SURFACING FACTOR				
ITEM	HYDRATED LIME	60-70 (AC-20) ASPH. CEMENT	ASPHALT FOR TACK COAT	WEIGHT
ASPHALTIC CONCRETE SURFACE COURSE	1.00%	5.50%	CS-1 OR CS-1	3000 LBS/CY.
PLANT MIXED SEAL COAT	1.00%	6%	CS-1 OR CS-1	3000 LBS/CY.

4. ASPHALT TREATED BASE 4" THICK 1000LB STABILITY, MACHINE LAY DOWN PER S.F. (SUBSTITUTED FOR C.T.B.)

SUMMARY OF QUANTITIES

SUMMARY OF QUANTITIES




SUMMARY OF QUANTITIES

BID ITEM NUMBER	DESCRIPTION	ESTIMATED QUANTITY	FINAL QUANTITY	BID ITEM NUMBER	DESCRIPTION	ESTIMATED QUANTITY	FINAL QUANTITY	BID ITEM NUMBER	DESCRIPTION	ESTIMATED QUANTITY	FINAL QUANTITY
1.	GRADING FOR LESS THAN 2 FEET EXCAVATION, PER S.F.	3,000	0	14.	MEDIAN GRADING, PER S.F.	135	137	32.	FALSE SERVICE RECONNECTIONS, PER EACH	24	5
2.	ASPHALTIC CONCRETE SURFACE COURSE, 1 1/2" THICK, 1800 LB. STABILITY, MACHINE LAY DOWN, PER S.F.	3,800	3,983	15.	IMPRESSION PATTERN COLORED CONCRETE MEDIAN PAVING, 4" THICK, COMPLETE IN PLACE, PER S.F.	360	365	33.	ASPHALT LEVELING COURSE, 1 1/2" THICK, PER 100	20	0
3.	ASPHALTIC CONCRETE BASE COURSE, 2 1/2" THICK, 1500 LB. STABILITY, MACHINE LAYDOWN, PER S.F.	3,800	3,983	16.	MAINTAIN TRAFFIC, COMPLETE AS SHOWN IN THE TRAFFIC CONTROL PLAN, PER LUMP SUM	L.S.	L.S.	34.	NEW SERVICE LINE, 3/4" SINGLE SERVICE CONNECTION, COMPLETE WITH LABOR AND MATERIAL AS PER STD. DETAILS, PER EA.	1	1
4.	CEMENT TREATED BASE COURSE, 6" THICK, CENTRAL PLANT MIXED, COMPLETE IN PLACE, PER S.F.	9,800	9,797	17.	PORTLAND CEMENT CONCRETE DRIVEPAD, 6" THICK, COMPLETE IN PLACE, PER S.F.	500	1,313	35.	PORTLAND CEMENT CONCRETE VALLEY GUTTER COMPLETE IN PLACE, INCLUDING SUBBASE PREP PER S.F.	1,400	2,488
5.	EMULSIFIED ASPHALT TACK COAT, COMPLETE IN PLACE, PER S.F.	3,800	4,205	18.	PORTLAND CEMENT CONCRETE SIDEWALK, 4" THICK, COMPLETE IN PLACE PER S.F.	350	2,693				
6.	PROCESS AND COMPACT EXISTING MATERIAL THAT HAS A SOIL BEARING VALUE OF 20 OR MORE, 6" THICK, COMPLETE IN PLACE, PER S.F.	9,800	9,547	19.	TRAFFIC SIGNAL ELECTRICAL CONDUIT 2" RIGID, COMPLETE IN PLACE, INCLUDING CONNECTIONS TO EXISTING CONDUIT, IF REQUIRED PER L.F.	40	40				
7.	5/8" PLANT MIX SEAL COAT, PER S.F.	3,400	3,583	20.	TRAFFIC SIGNAL FOUNDATION FOR PEDIESTAL (SP) TYPE 1, COMPLETE IN PLACE PER EA.	1	1				
8.	CUTTING, REMOVAL AND DISPOSAL OF EXISTING ASPHALTIC CONCRETE PAVING, WHERE SAWCUTTING IS NOT REQUIRED, PER S.F.	3,800	10,206	21.	TRAFFIC SIGNAL MULLPOX, COMPLETE IN PLACE, PER EA.	2	2				
9.	REMOVAL AND DISPOSAL OF EXISTING P.C.C. CURB AND GUTTER, PER LINEAR FOOT.	1,150	1,346	22.	ADJUST MANHOLE FRAMES TO GRADE, 2" OR LESS, PER EA.	8	8				
10.	CUTTING, REMOVAL AND DISPOSAL OF EXISTING PORTLAND CEMENT CONCRETE SIDEWALK AND DRIVEPADS, PER S.F.	100	445	23.	ADJUST MANHOLE FRAMES TO GRADE WITH MAXIMUM CONSTRUCTION (OVER 2") PER EA.	5	5				
11.	PORTLAND CEMENT CONCRETE MEDIAN CURB AND GUTTER, COMPLETE IN PLACE, INCLUDING SUBGRADE PREPARATION, PER LINEAR FOOT.	430	498	24.	ADJUST WATER VALVE BOXES TO GRADE PER EA.	8	7				
12.	PORTLAND CEMENT CONCRETE STANDARD CURB AND GUTTER COMPLETE IN PLACE, INCLUDING SUBGRADE PREPARATION, PER LINEAR FOOT.	1,150	1,346	25.	INSTALL HIGH DENSITY POLYETHYLENE LINER PIPE (7125"OD), PER L.F. SEC. 600.0	594	594				
13.	REMOVAL AND DISPOSAL OF EXISTING ASPHALTIC CONCRETE CURB, PER L.F.	415	415	26.	TELEVISION INSPECTION, PER L.F. SEC. 600.2	594	594				
				27.	SERVICE RECONNECTIONS - POLYETHYLENE PER EA. SEC. 600.10	12	7				
				28.	MANHOLE REHABILITATION, PER EA. SEC. 600.13	3	3				
				29.	REMOVAL OF PROTRUDING SERVICE, PER EA. SEC. 600.2	1	1				
				30.	POINT REPAIR, PER EA. SEC. 600.5 (SEE SHT. 10)	1	0				
				31.	EXTENSION OF POINT REPAIR, PER L.F. SEC. 600.6 (SEE SHT. 10)	1	0				


NOTES & SUMMARY OF QUANTITY SHEET
George Meador 8/27/87
Due August 29, 1987
RECORD DRAWINGS

1 2 3 4 5 6 7 8 9 10 11 12
26 19140287

CITY OF ALBUQUERQUE TRANSPORTATION DEPARTMENT PLANNING AND PROGRAMMING DIVISION					
TITLE: CARLISLE BOULEVARD MESA VERDE AVENUE TO CONSTITUTION AVENUE					
APPROVALS	ENGINEER	DATE	APPROVALS	ENGINEER	DATE
City Engineer	8/27/87	8/27/87	Traffic	8/27/87	8/27/87
A.C.E.-Design	8/27/87	8/27/87	Water Resources	8/27/87	8/27/87
A.C.E.-Hydrology	8/27/87	8/27/87			
QA	8/27/87	8/27/87			
DRAWING NO.	1914	MAP NO. J-16 #17	SHEET	2	OF 11

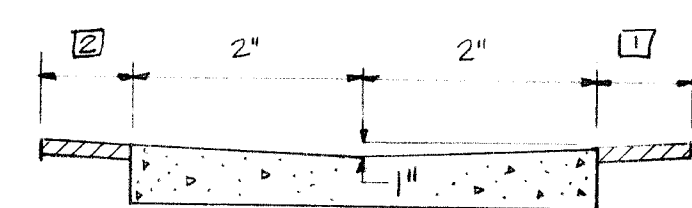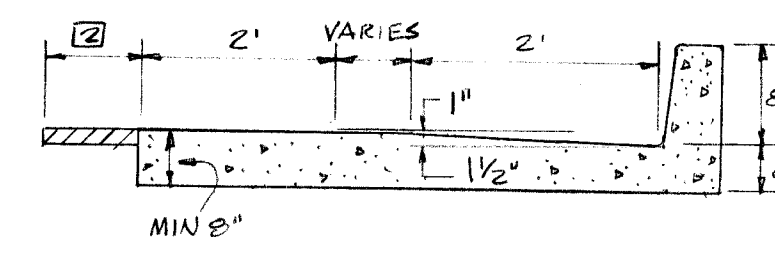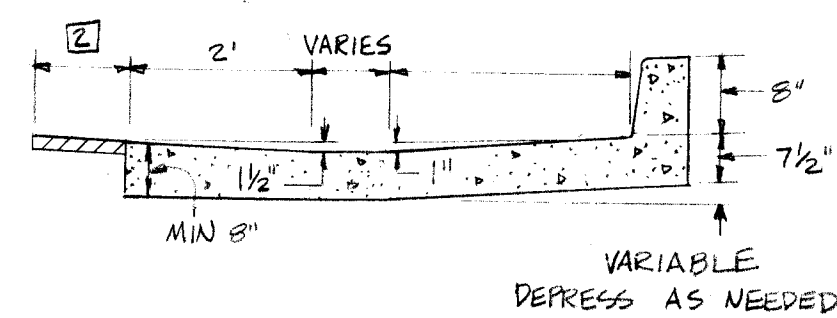


F-F SECTION - VALLEY GUTTER

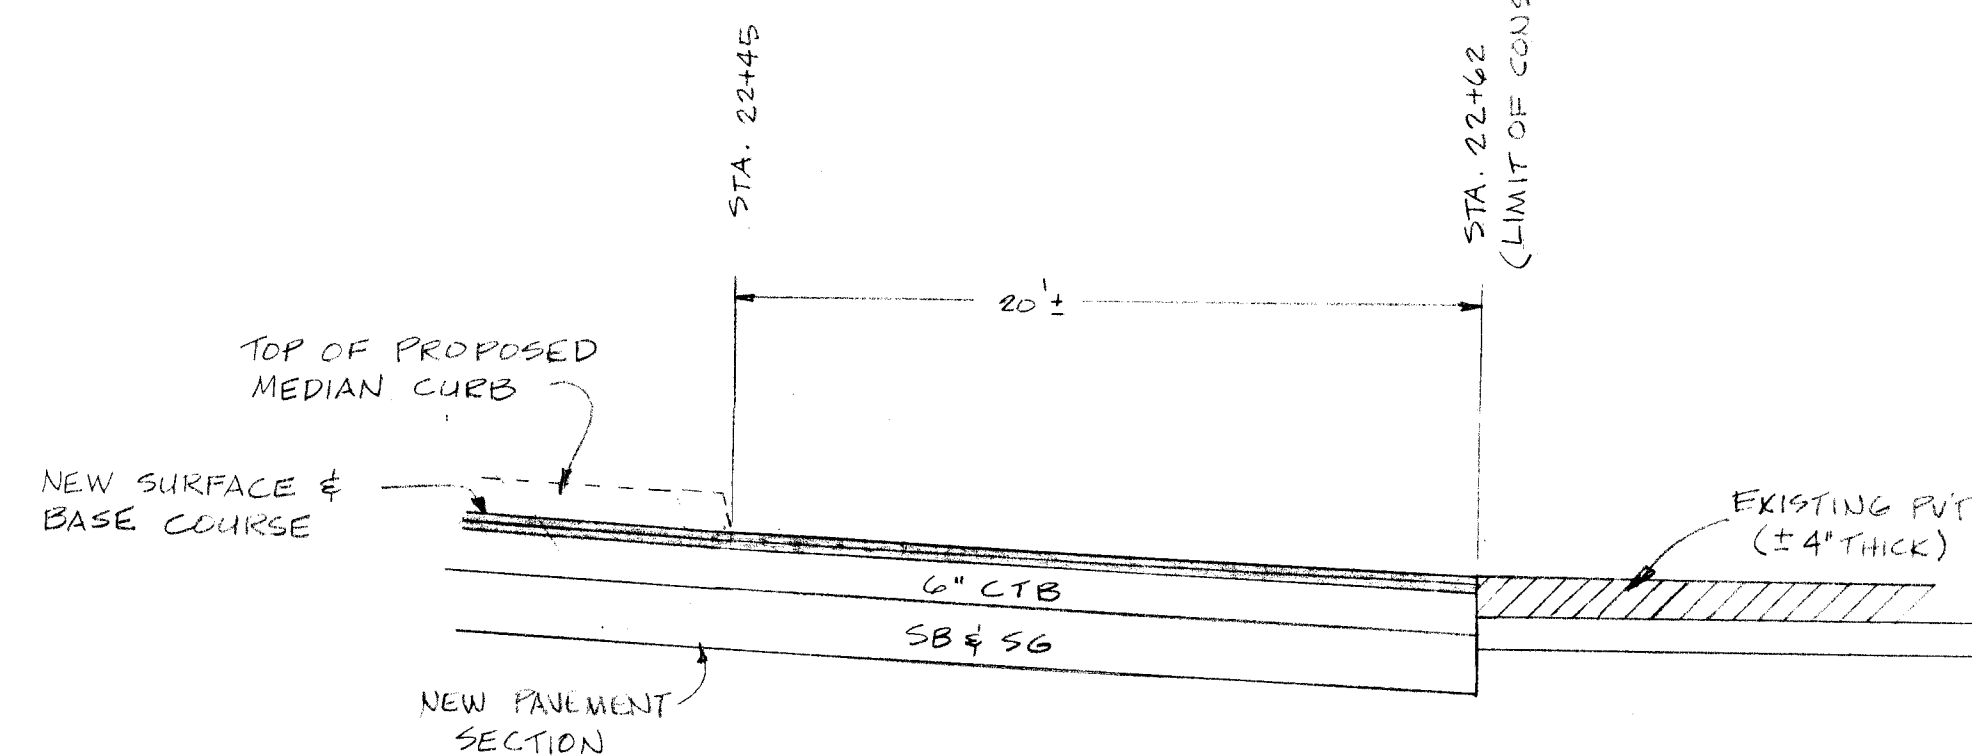

SECTION @ E CARLISLE

NOTE: SEE SHT. 8 OF PLANS


DETAIL C-C
not to scale

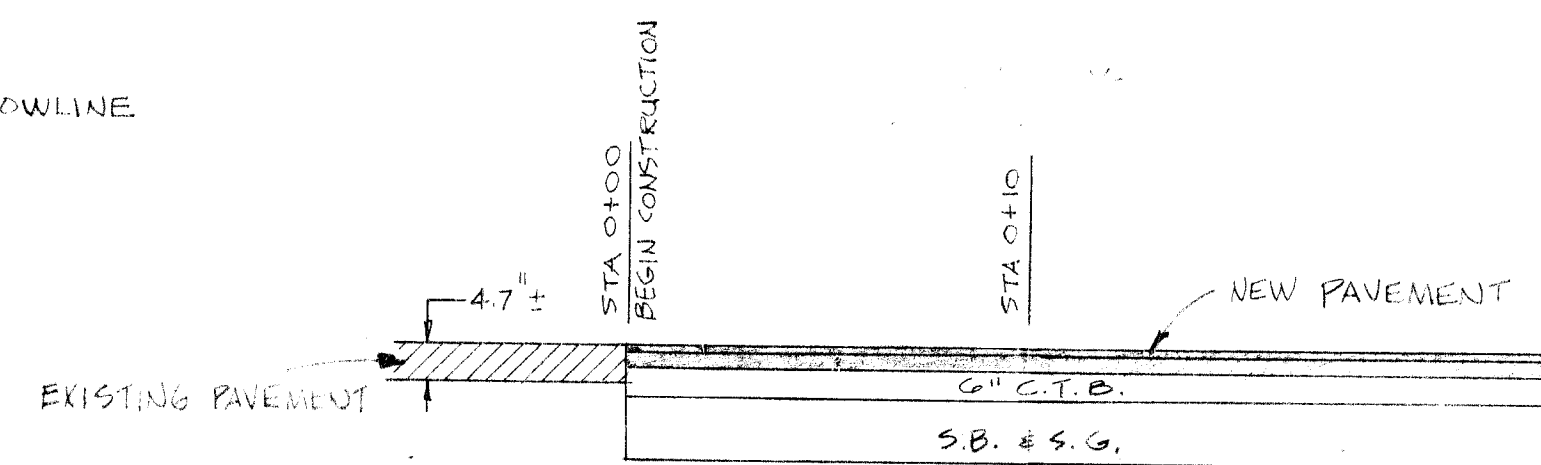

SECTION @ 4 CARLISLE
STA 0+00 - STA 0+10

NOTE: SEE SHT. 4 OF PLANS


DETAIL D-D
not to scale

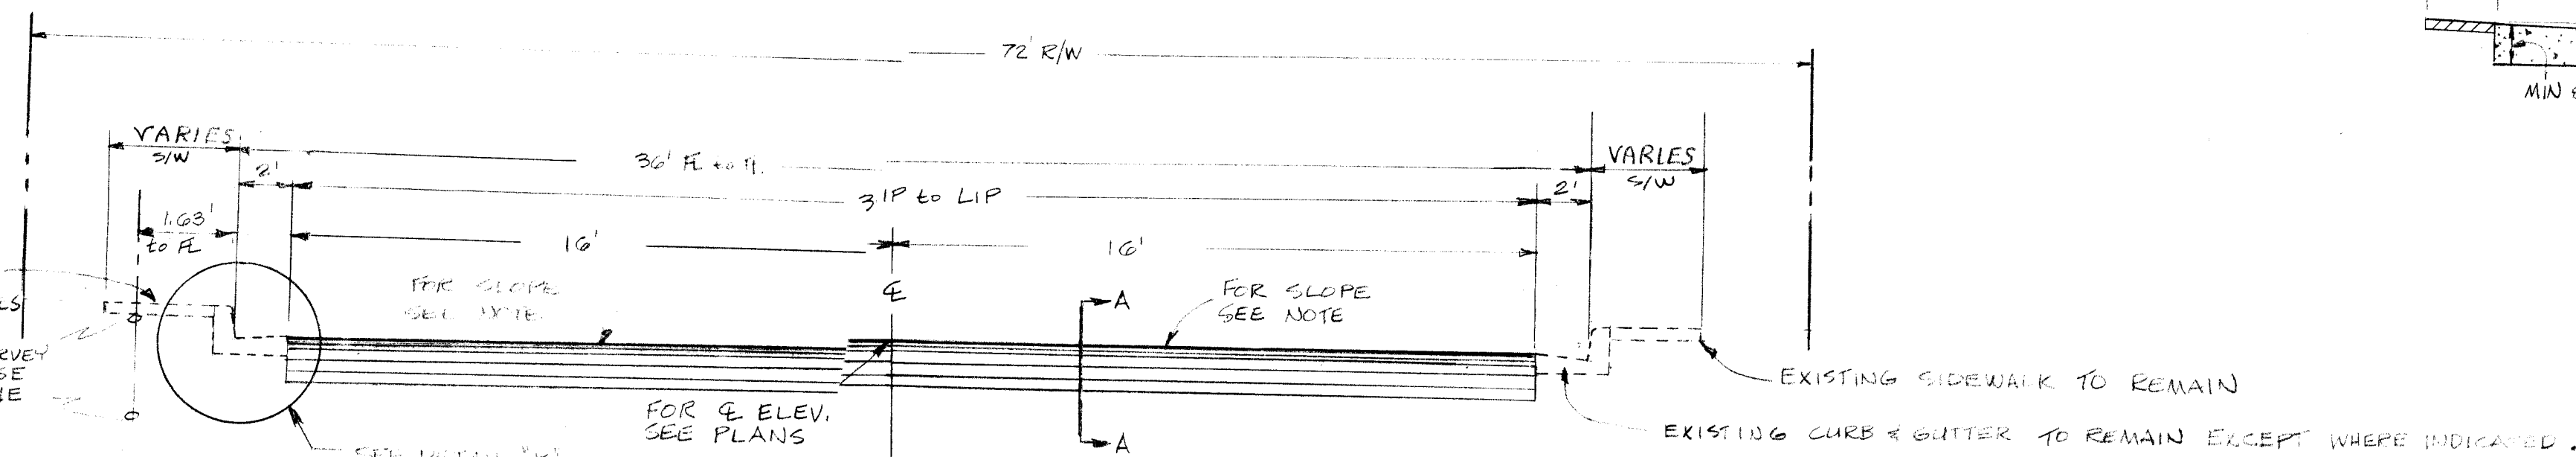

TYPICAL STREET SECTION - STA 0+00 to STA 19+08

JOT TO SCALE

NOTE:
CROSS SLOPE VARIABLE BETWEEN STA. 0+00 TO STA. 19+08 WITH 2% MIN ON HIGH CURB SIDE. CROSS SLOPE DETERMINED BY EXISTING FLOW LINE ELEVATIONS AND PROPOSED $\pm$ ELEVATIONS ALL OTHER LOCATIONS ARE AS SHOWN ON PLANS.

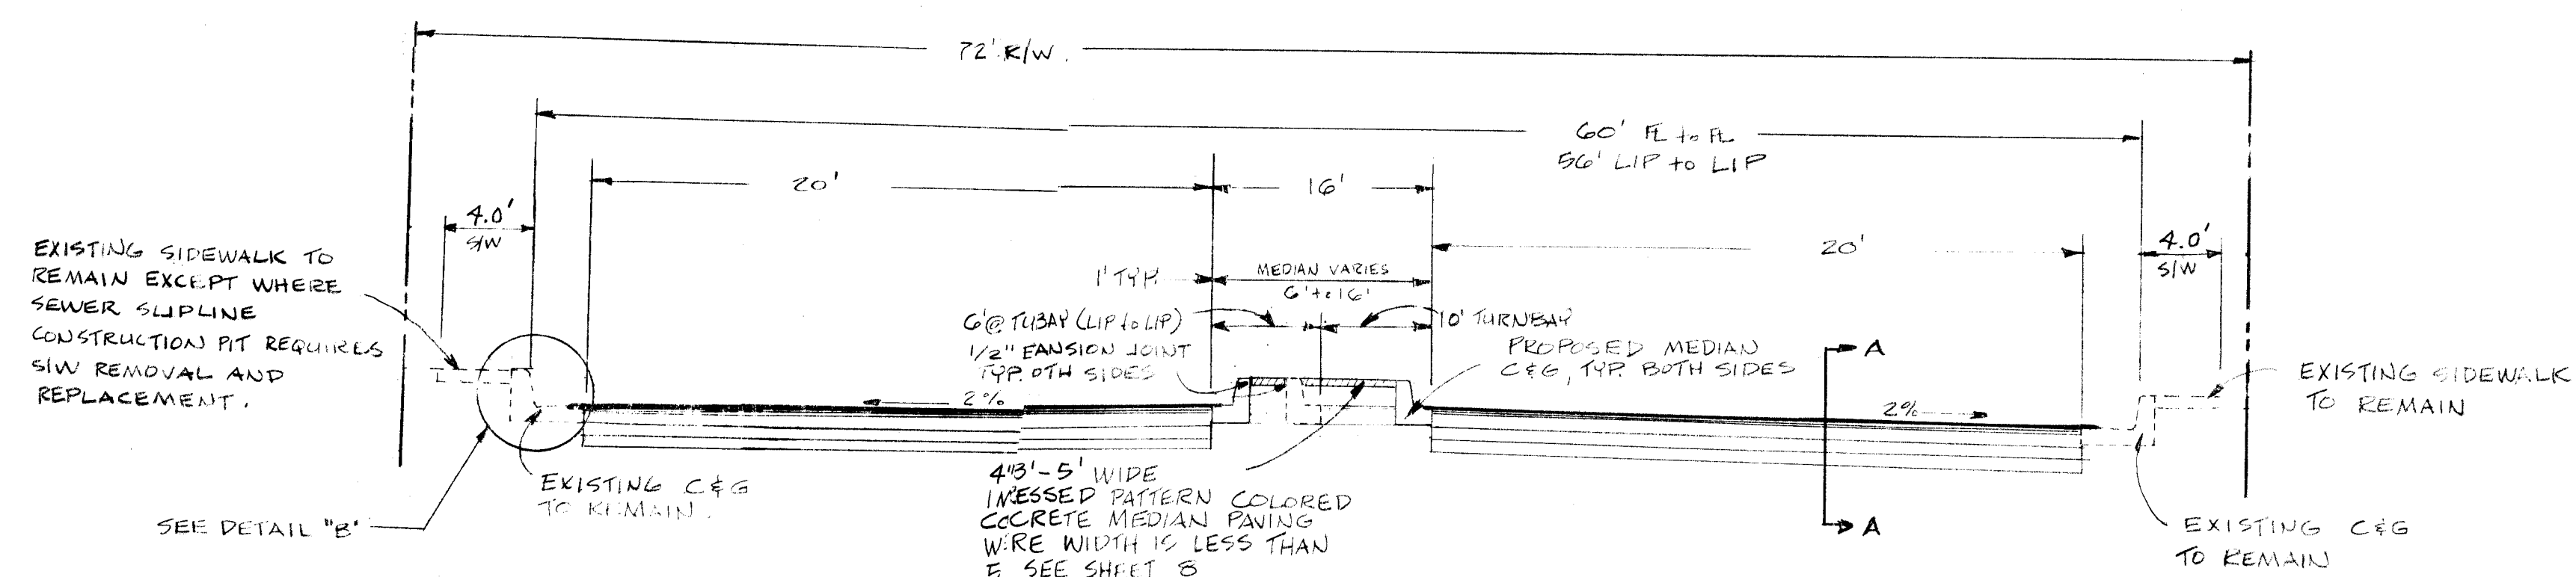


TYPICAL STREET SECTION - STA. 19+86 to STA. 22+62


NOT TO SCALE

NOTES :

1. CURB & GUTTER TO BE REPLACED WILL BE LOCATED BY ENGINEER IN FIELD
2. ALL EXISTING ELEVATIONS SHOWN ARE FLOWLINE

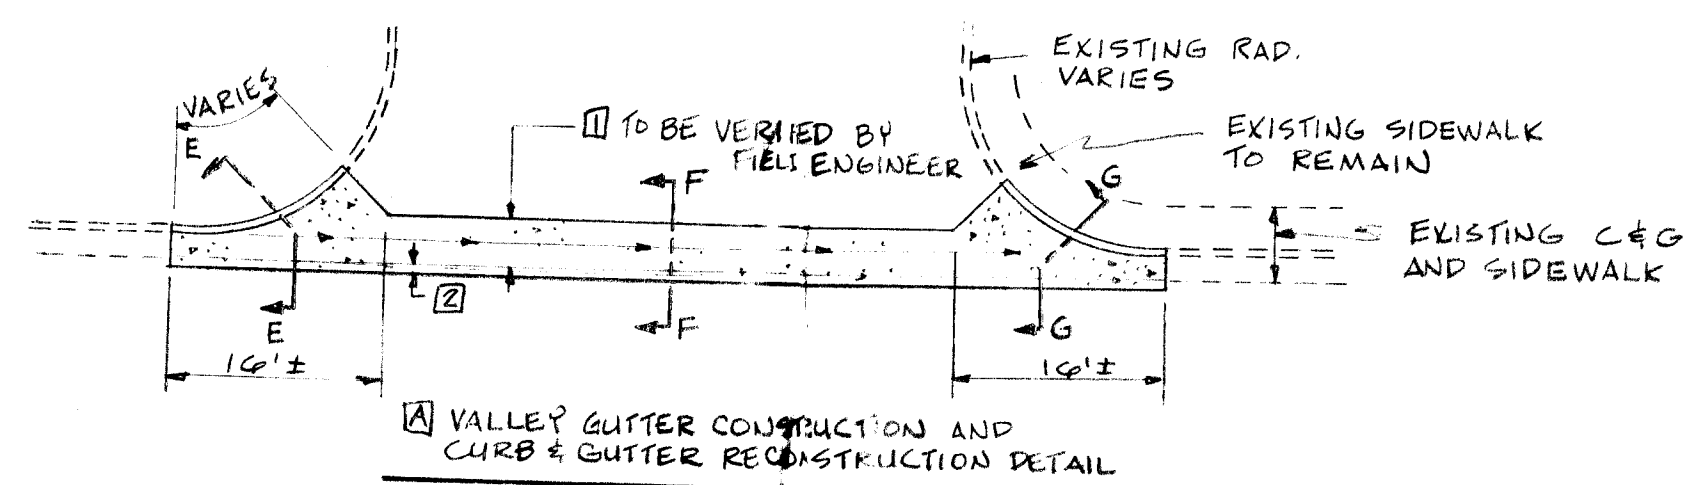

TYPICAL SECTION A-A

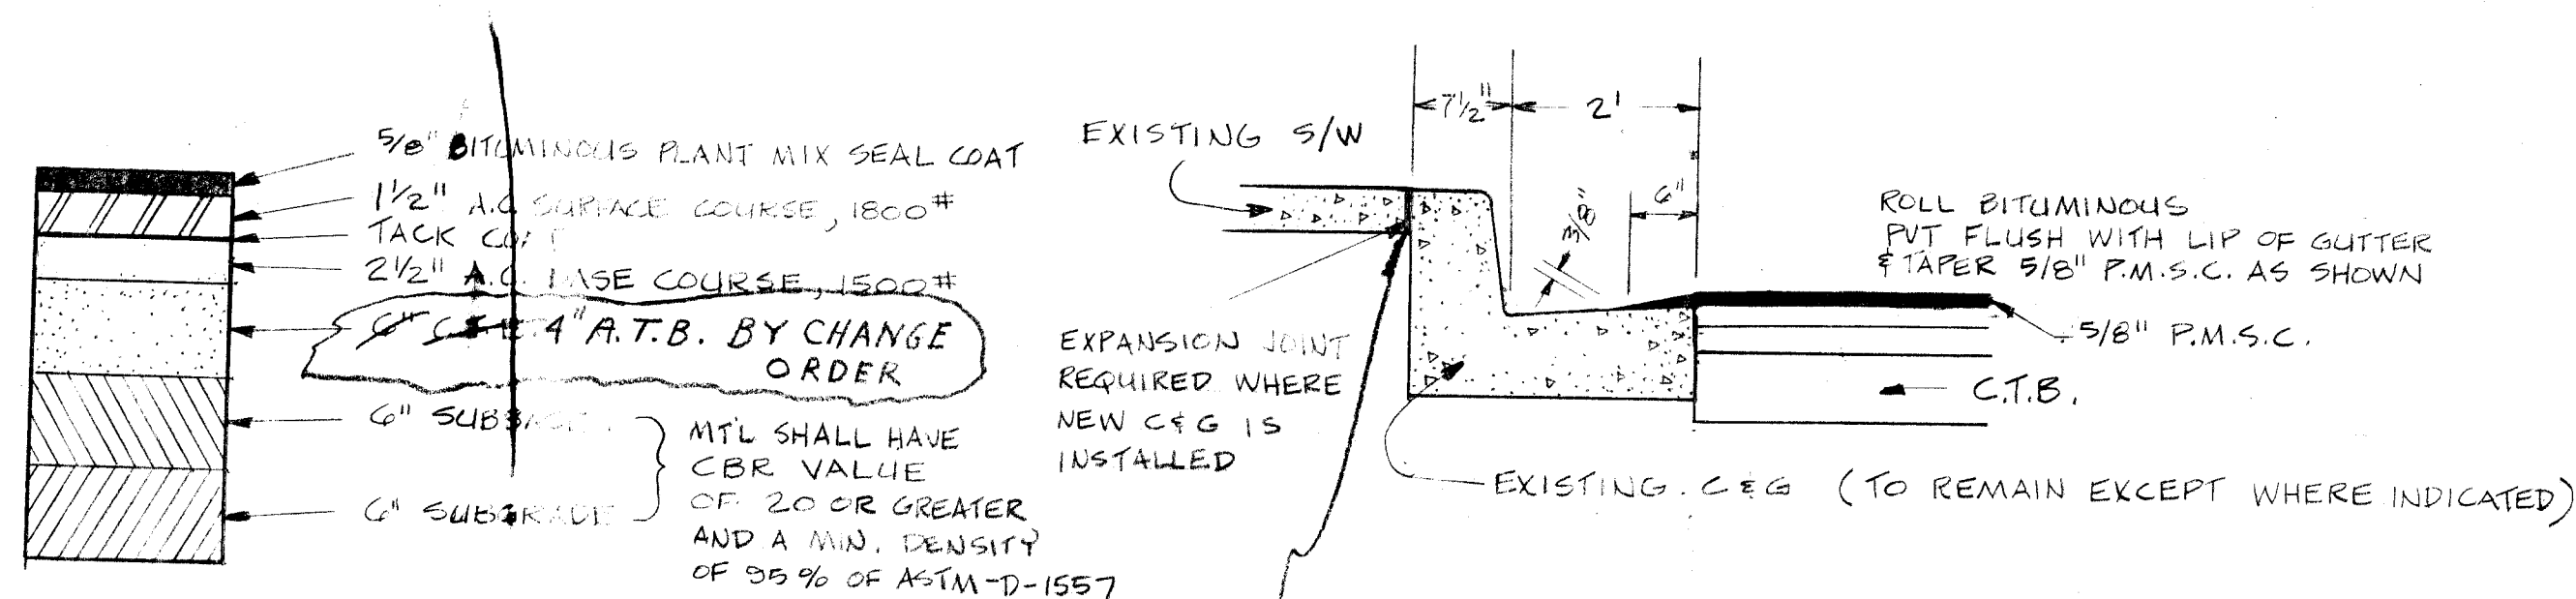

DETAIL "B"

AS BUILT NOTE:

EXPANSION JOINT NOT PLACED BACK-OF-CURB

-
- CURB STONES TO BE REMOVED
- MANHOLES
- WATER VALVES
- EXISTING CURB & GUTTER
- EXISTING DRIVEWAYS
- EXISTING ELEVATION
59.27
- PROPOSED ELEVATION
55.83
- EXISTING STORM DRAIN INLET
- PROPOSED STORM DRAIN INLET
- 8" VCP
- SANITARY SEWER PIPE (TO BE SLOPED)
- MEDIAN PAVING (IMPRESSED PATTERN COLLOID CONCRETE)
- ASPHALTIC LEVELING COURSE, 1800 # STABILITY

GRADE CHANGE

George Meador 8/27/87
RECORD DRAWINGS

George Meador 8/27/87

ORD DRAW
Due Sept 9/28/87

1	2	3	4	5	6	7	8	9	10	11	12
26			19	14	03	87					



DETAIL SHEET

CITY OF ALBUQUERQUE
TRANSPORTATION DEPARTMENT
PLANNING AND PROGRAMMING DIVISION

TITLE : CARLISLE BOULEVARD
MESA VERDE AVENUE TO CONSTITUTION AVENUE


APPROVALS	ENGINEER	DATE	APPROVALS	ENGINEER	DATE
City Engineer	<i>GA</i>	7-28-84	Liquid Waste		
A.C.E.-Design			Traffic	<i>T. Williams</i>	7-29-84
A.C.E.-Hydrology	<i>Jim Ford</i>	7-28-84	Water Resources	<i>W.A. James</i>	7-29-84
CR	<i>GA</i>	7-28-84			

DRAWING NO.	1914	MAP NO. 4-16417	SHEET <u>3</u> OF <u>11</u>
----------------	------	--------------------	-----------------------------

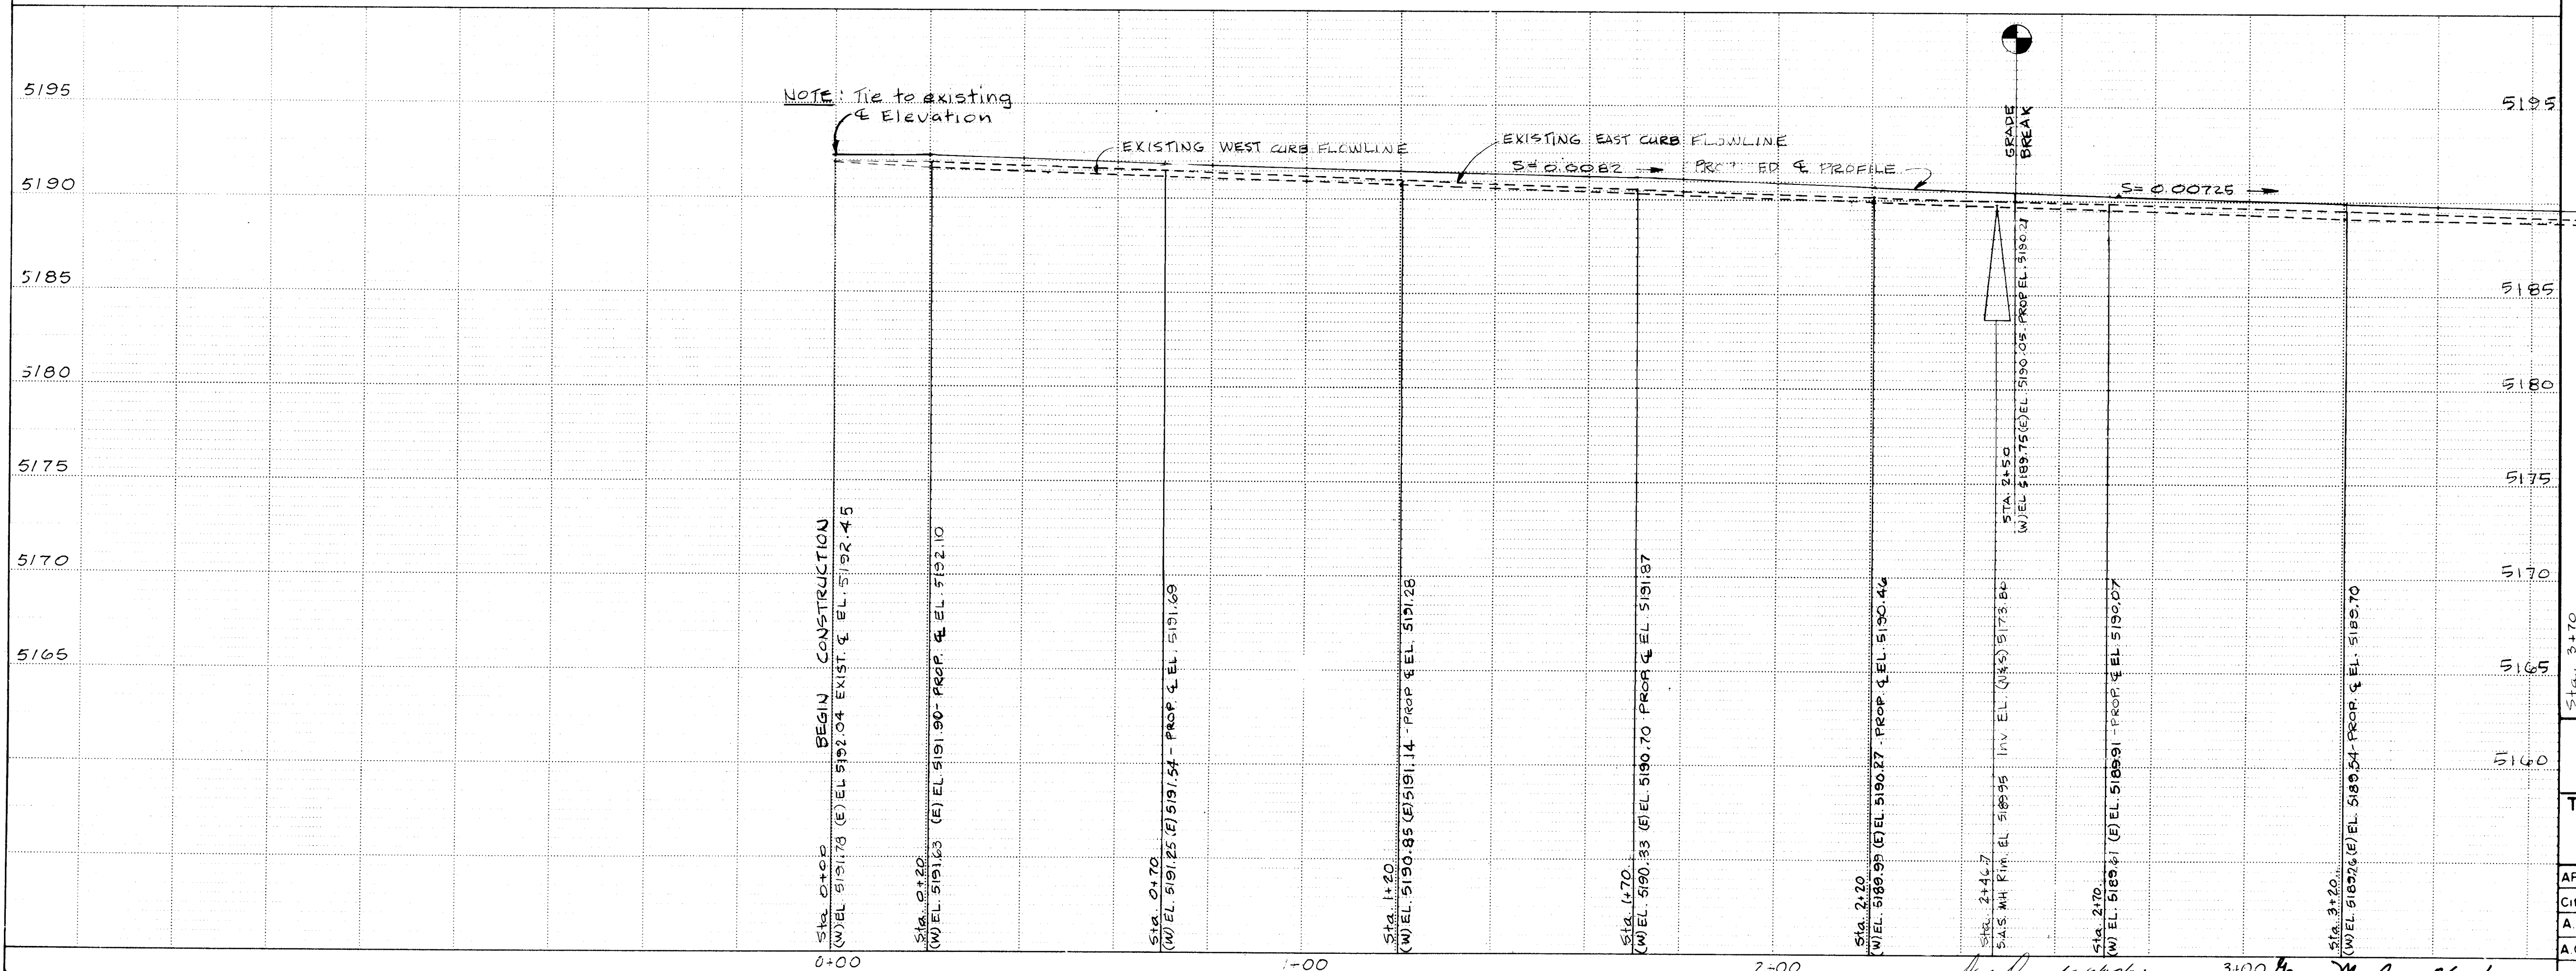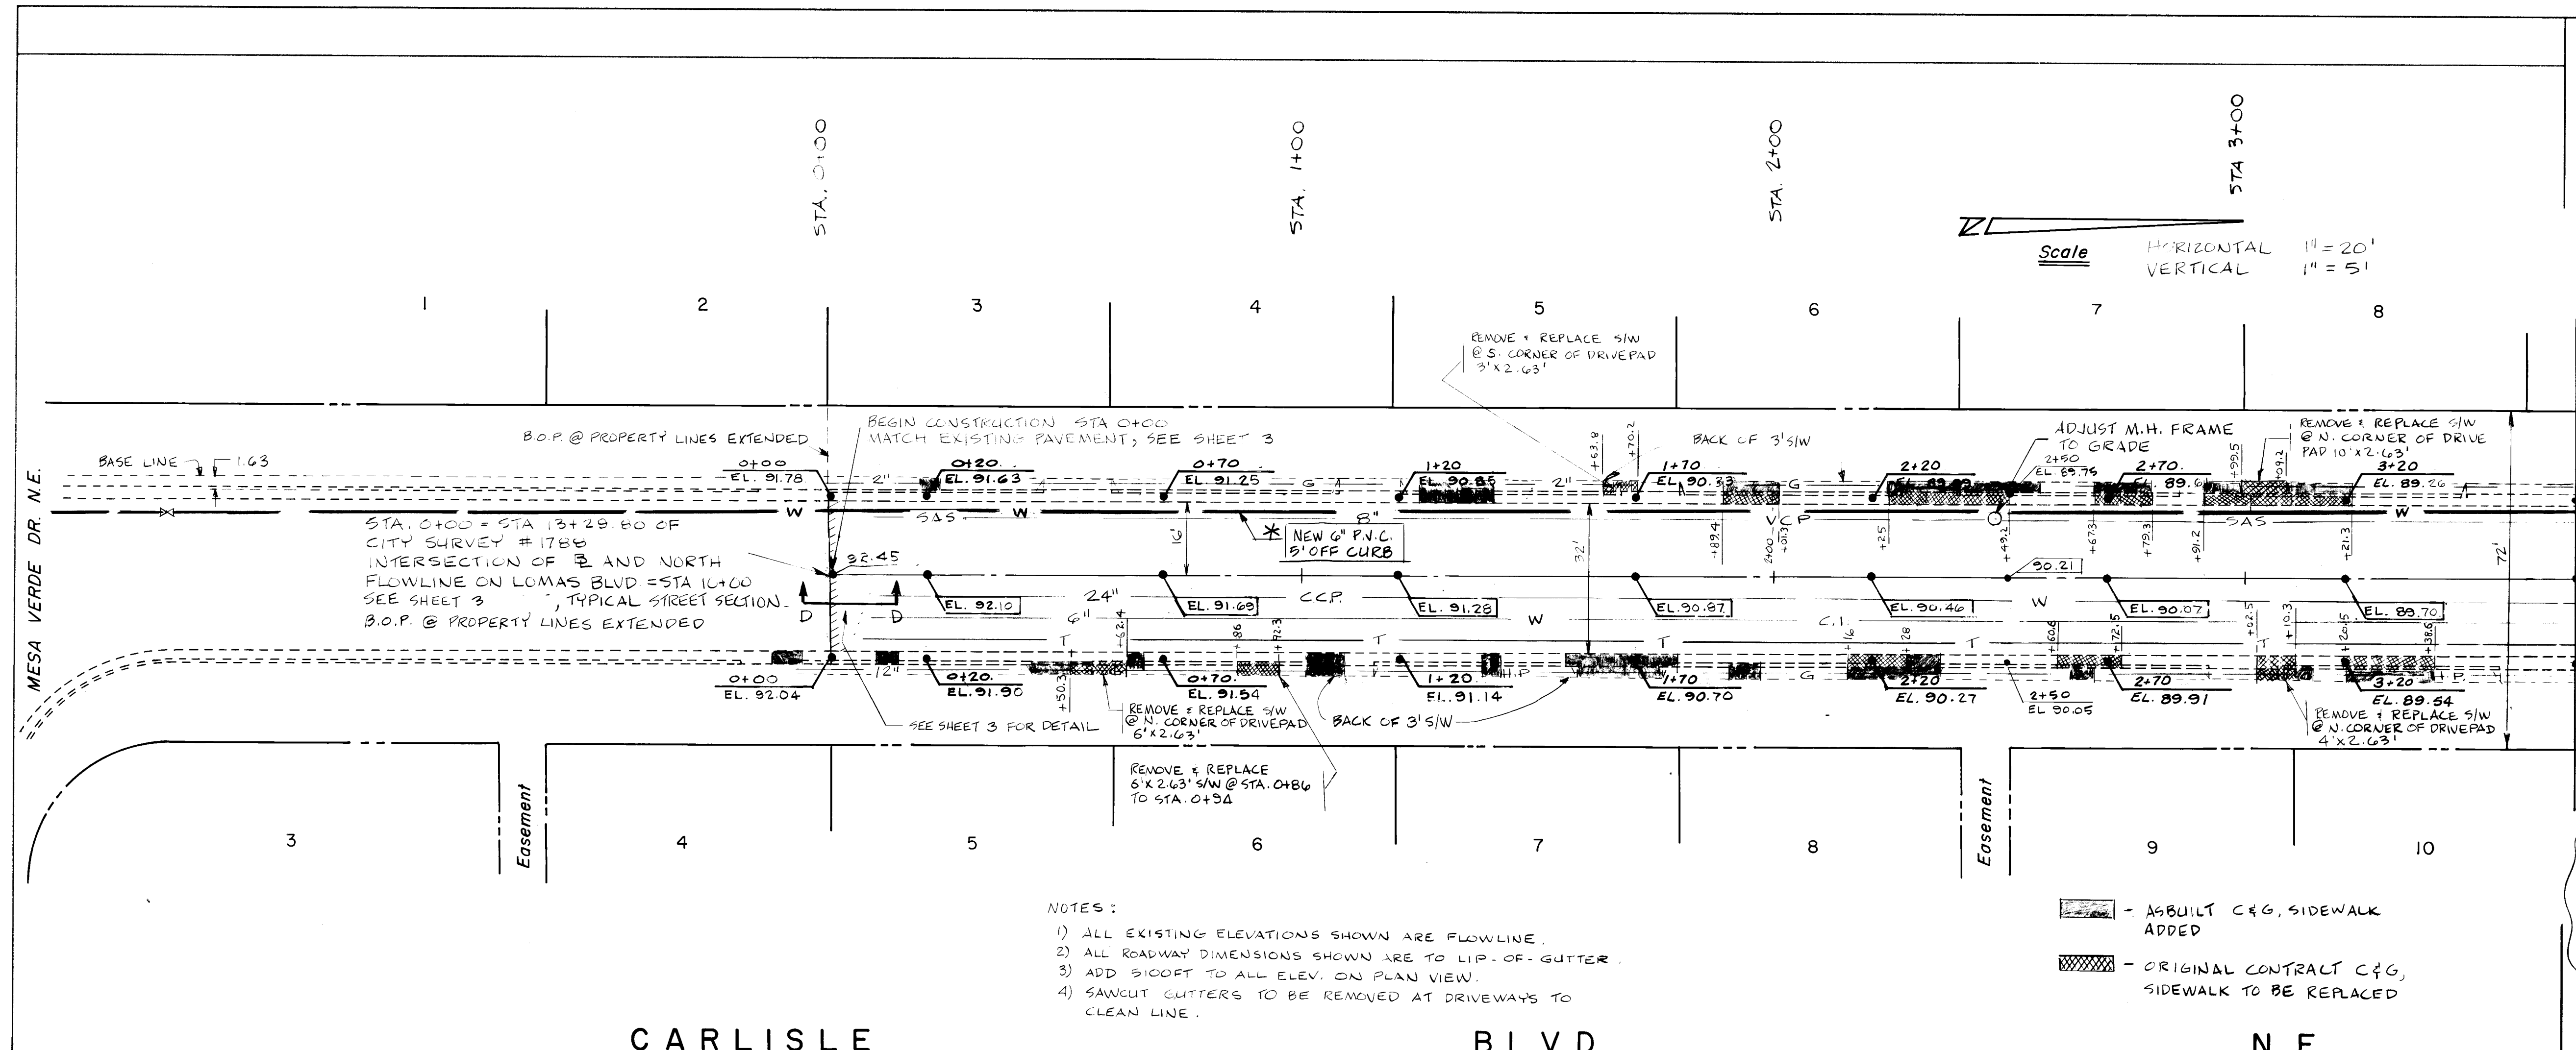

AS BUILT INFORMATION			BENCH MARKS			SURVEY INFORMATION			ENGINEER'S SEAL		
CONTRACT: 10th UNIVERSAL CONST.			STANDARD A.C.S.			FIELD NOTES			PREPARED UNDER THE DIRECTION OF		
WORK: JAKE VIGIL DATE: 4/1/84			BRASS CAP SET ON 5\"/>								
INSPECTOR: J. J. GILLES DATE: 11/18/84			LOMAS & CARLISLE ELEV. 5193.03			NO.			BY		
FIELD: J. J. GILLES DATE: 11/18/84			C.B.M. 3 J17			DATE			REVISIONS		
DRAWINGS: J. J. GILLES DATE: 11/18/84						NO.			BY		
CHECKED BY: M. Z. DATE: 11/18/84						DATE			DESIGN		
RECORDED BY: DATE:						DATE			DATE		
NO.						DATE			DATE		
CITY OF ALBUQUERQUE TRANSPORTATION DEPARTMENT PLANNING AND PROGRAMMING DIVISION											
TITLE: CARLISLE BOULEVARD MESA VERDE AVENUE TO CONSTITUTION AVENUE											
APPROVALS			ENGINEER			DATE			APPROVALS		
City Engineer			[Signature]			5/1/84			Liquid Waste		
A.C.E. - Design			[Signature]			2-28-84			Traffic		
A.C.E. - Hydrology			[Signature]			2-28-84			Water Resources		
DRAWING NO. 1914			MAP NO. J-16 #17			SHEET 4 OF 11			DESIGNED BY A.P.K. DATE 8/11/83		
									DRAWN BY M.Z. DATE 8/11/83		
									CHECKED BY G.M. DATE 8/11/83		


RECORD DRAWINGS

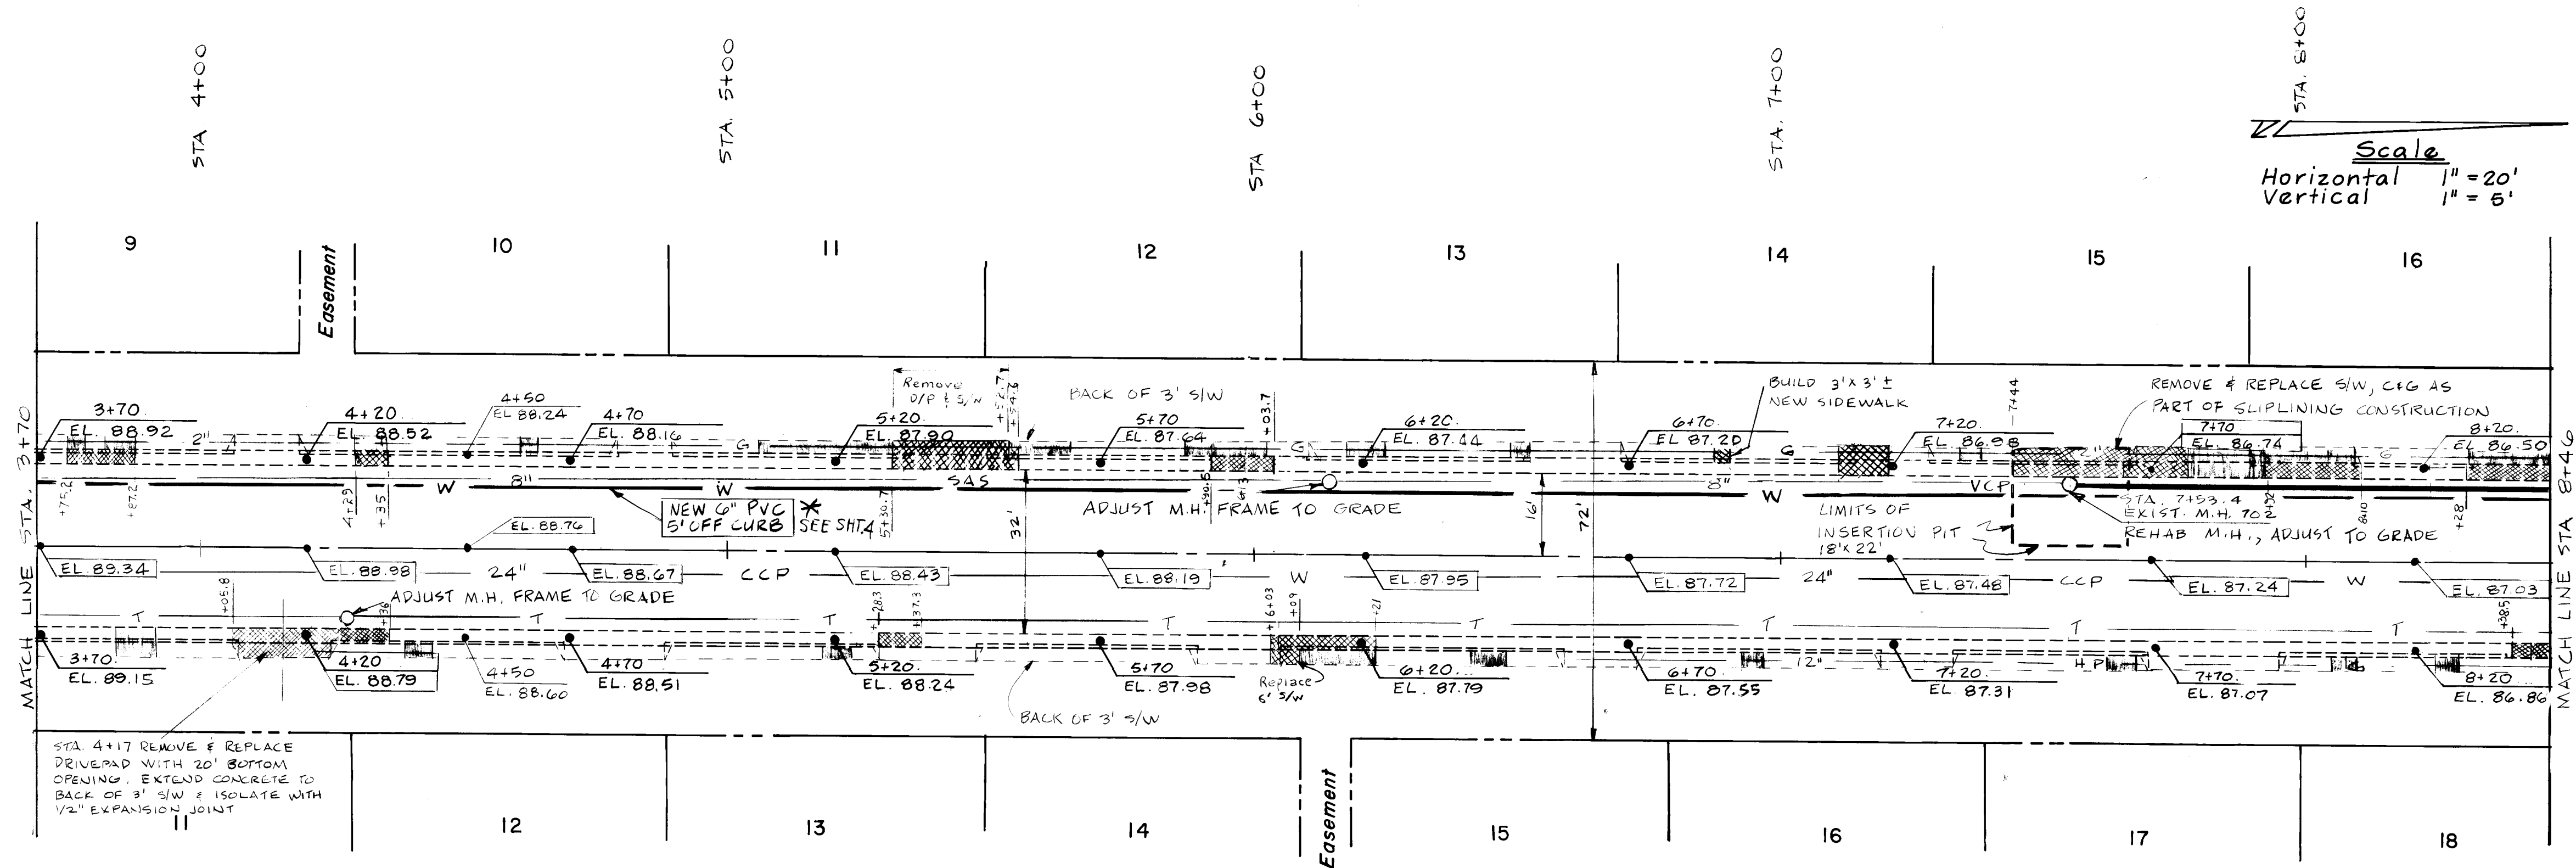

- NOTES:
- 1) ALL EXISTING ELEVATIONS SHOWN ARE FLOWLINE
 - 2) ALL ROADWAY DIMENSIONS SHOWN ARE TO LIP-OF-GUTTER.
 - 3) ADD 5100 FT. TO ELEV. ON PLAN VIEW.
 - 4) SAWCUT ALL GUTTERS TO BE REMOVED AT DRIVEWAYS TO CLEAN LINE

- LEGEND:
- AS-BUILT C & G, SIDEWALK ADDED
 - ORIGINAL CONTRACT C & G, SIDEWALK TO BE REPLACED



CARLISLE BLVD. N.E.

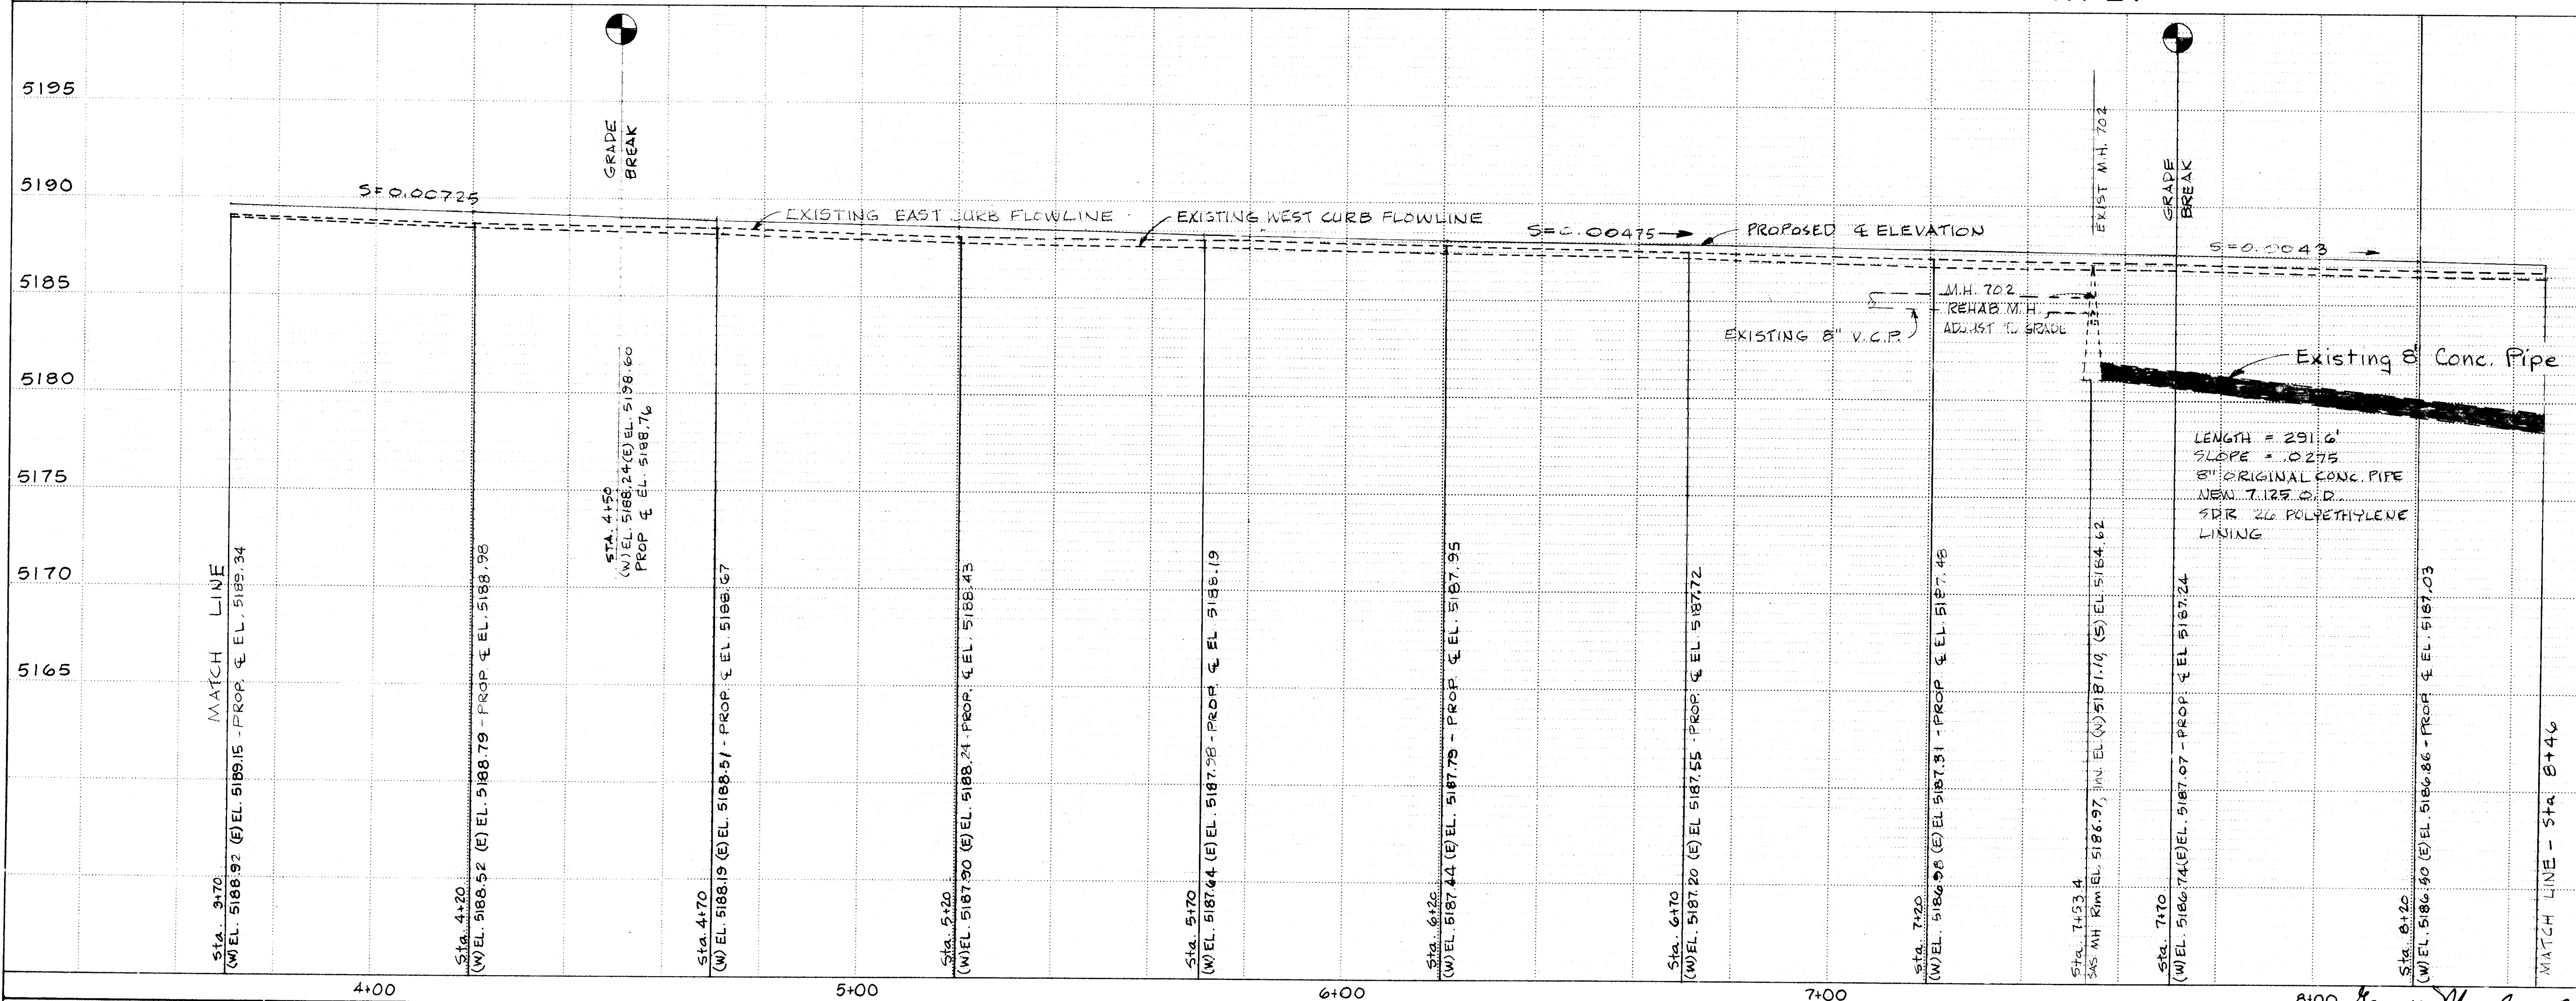

26 19140587

STA 3+70 TO STA 8+40

CITY OF ALBUQUERQUE TRANSPORTATION DEPARTMENT PLANNING AND PROGRAMMING DIVISION					
TITLE: CARLISLE BOULEVARD MESA VERDE AVENUE TO CONSTITUTION AVENUE					
APPROVALS	ENGINEER	DATE	APPROVALS	ENGINEER	DATE
City Engineer	<i>[Signature]</i>	9/29/84	liquid waste		
A.C.E.-Design			Traffic	T.W. Kennedy	2/25/84
A.C.E.-Hydrology	<i>[Signature]</i>	2-28-84	Water Resources	James J. J. J.	2-24-84
DRAWING NO. 1914		MAP NO. J-16 & 17		SHEET 5 OF 11	

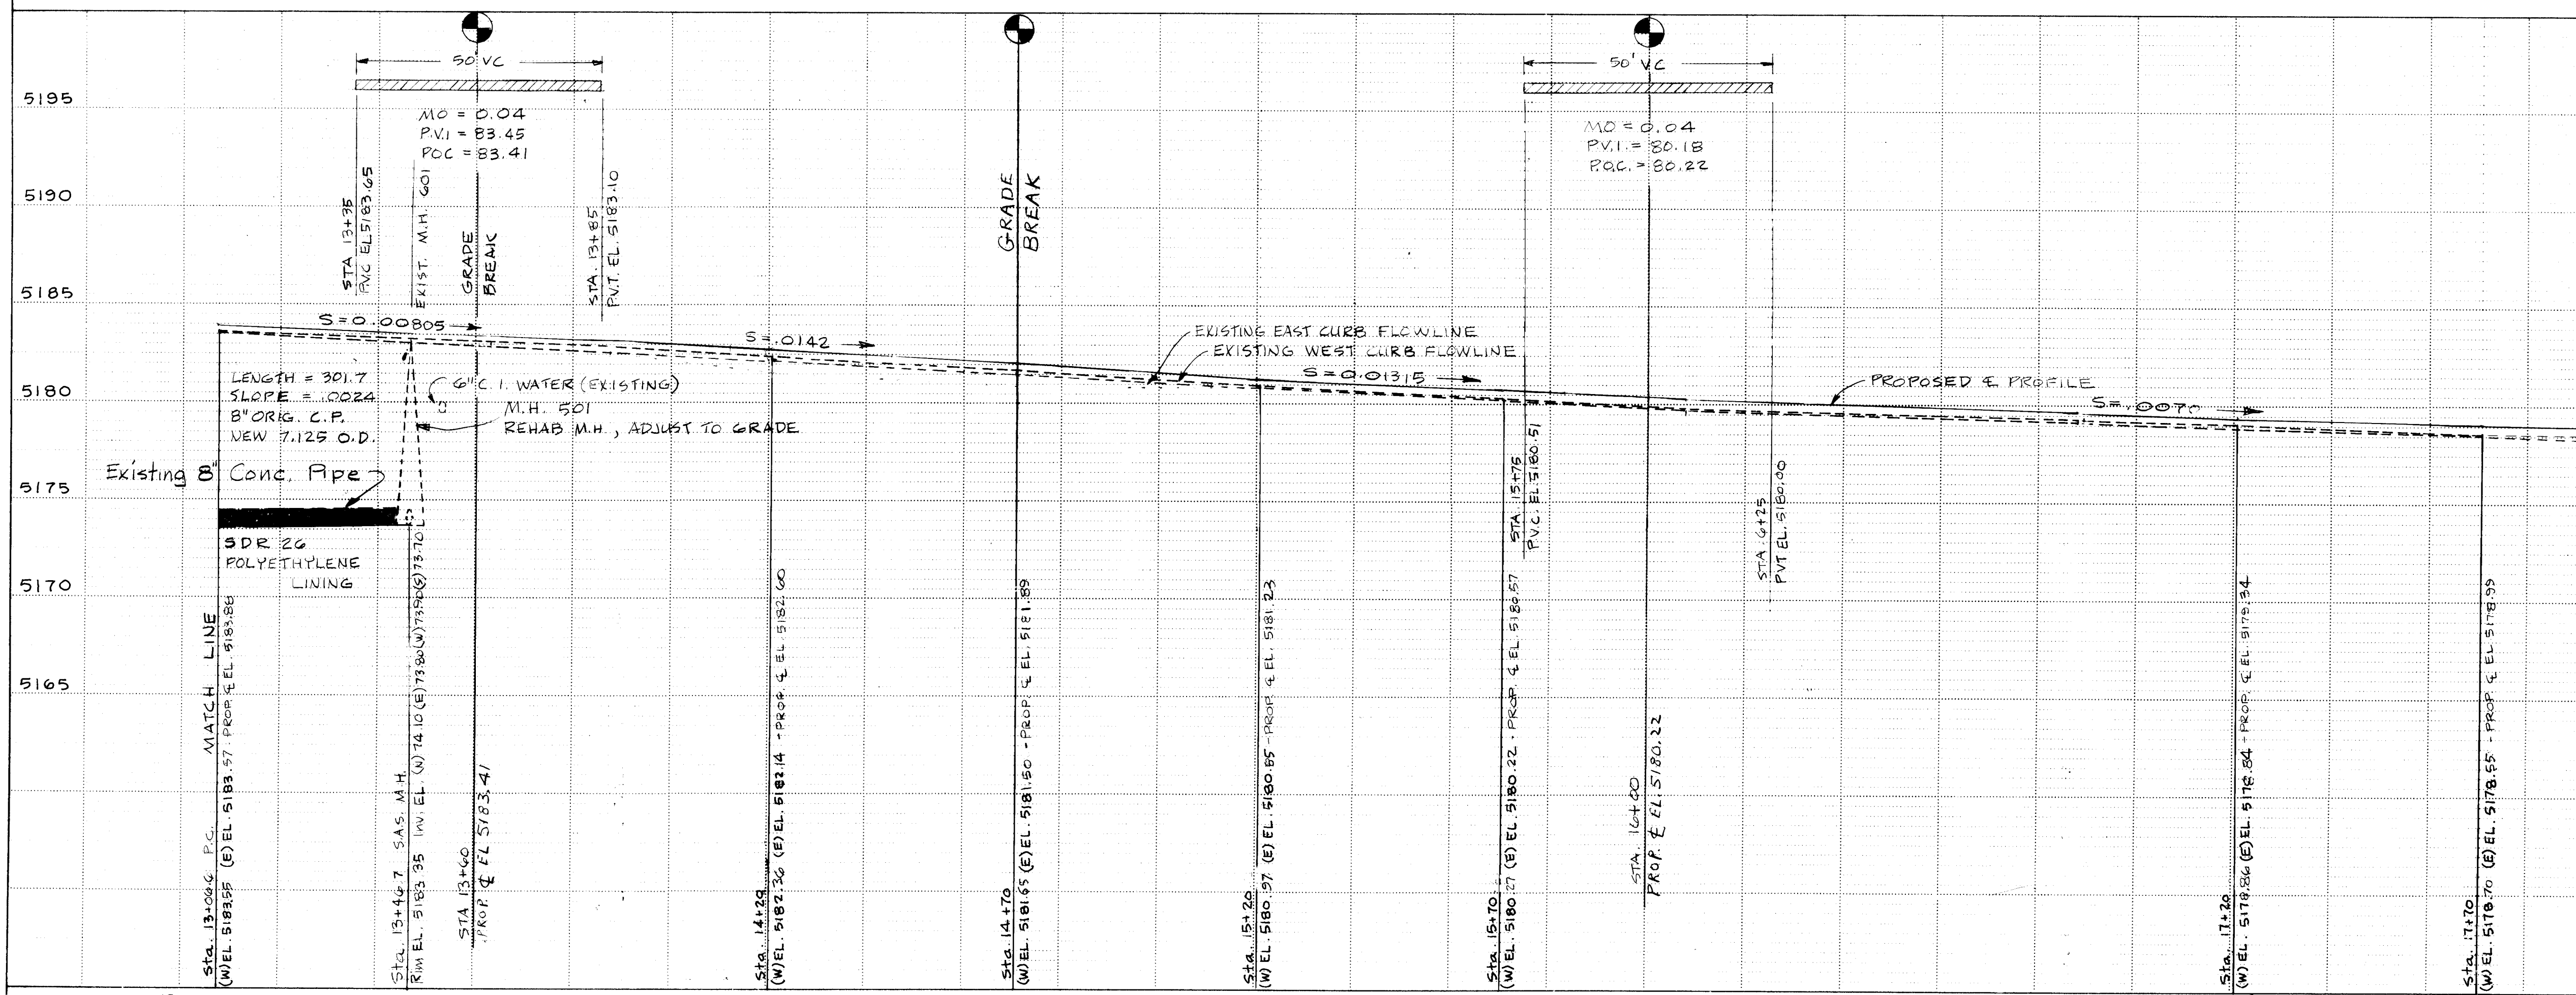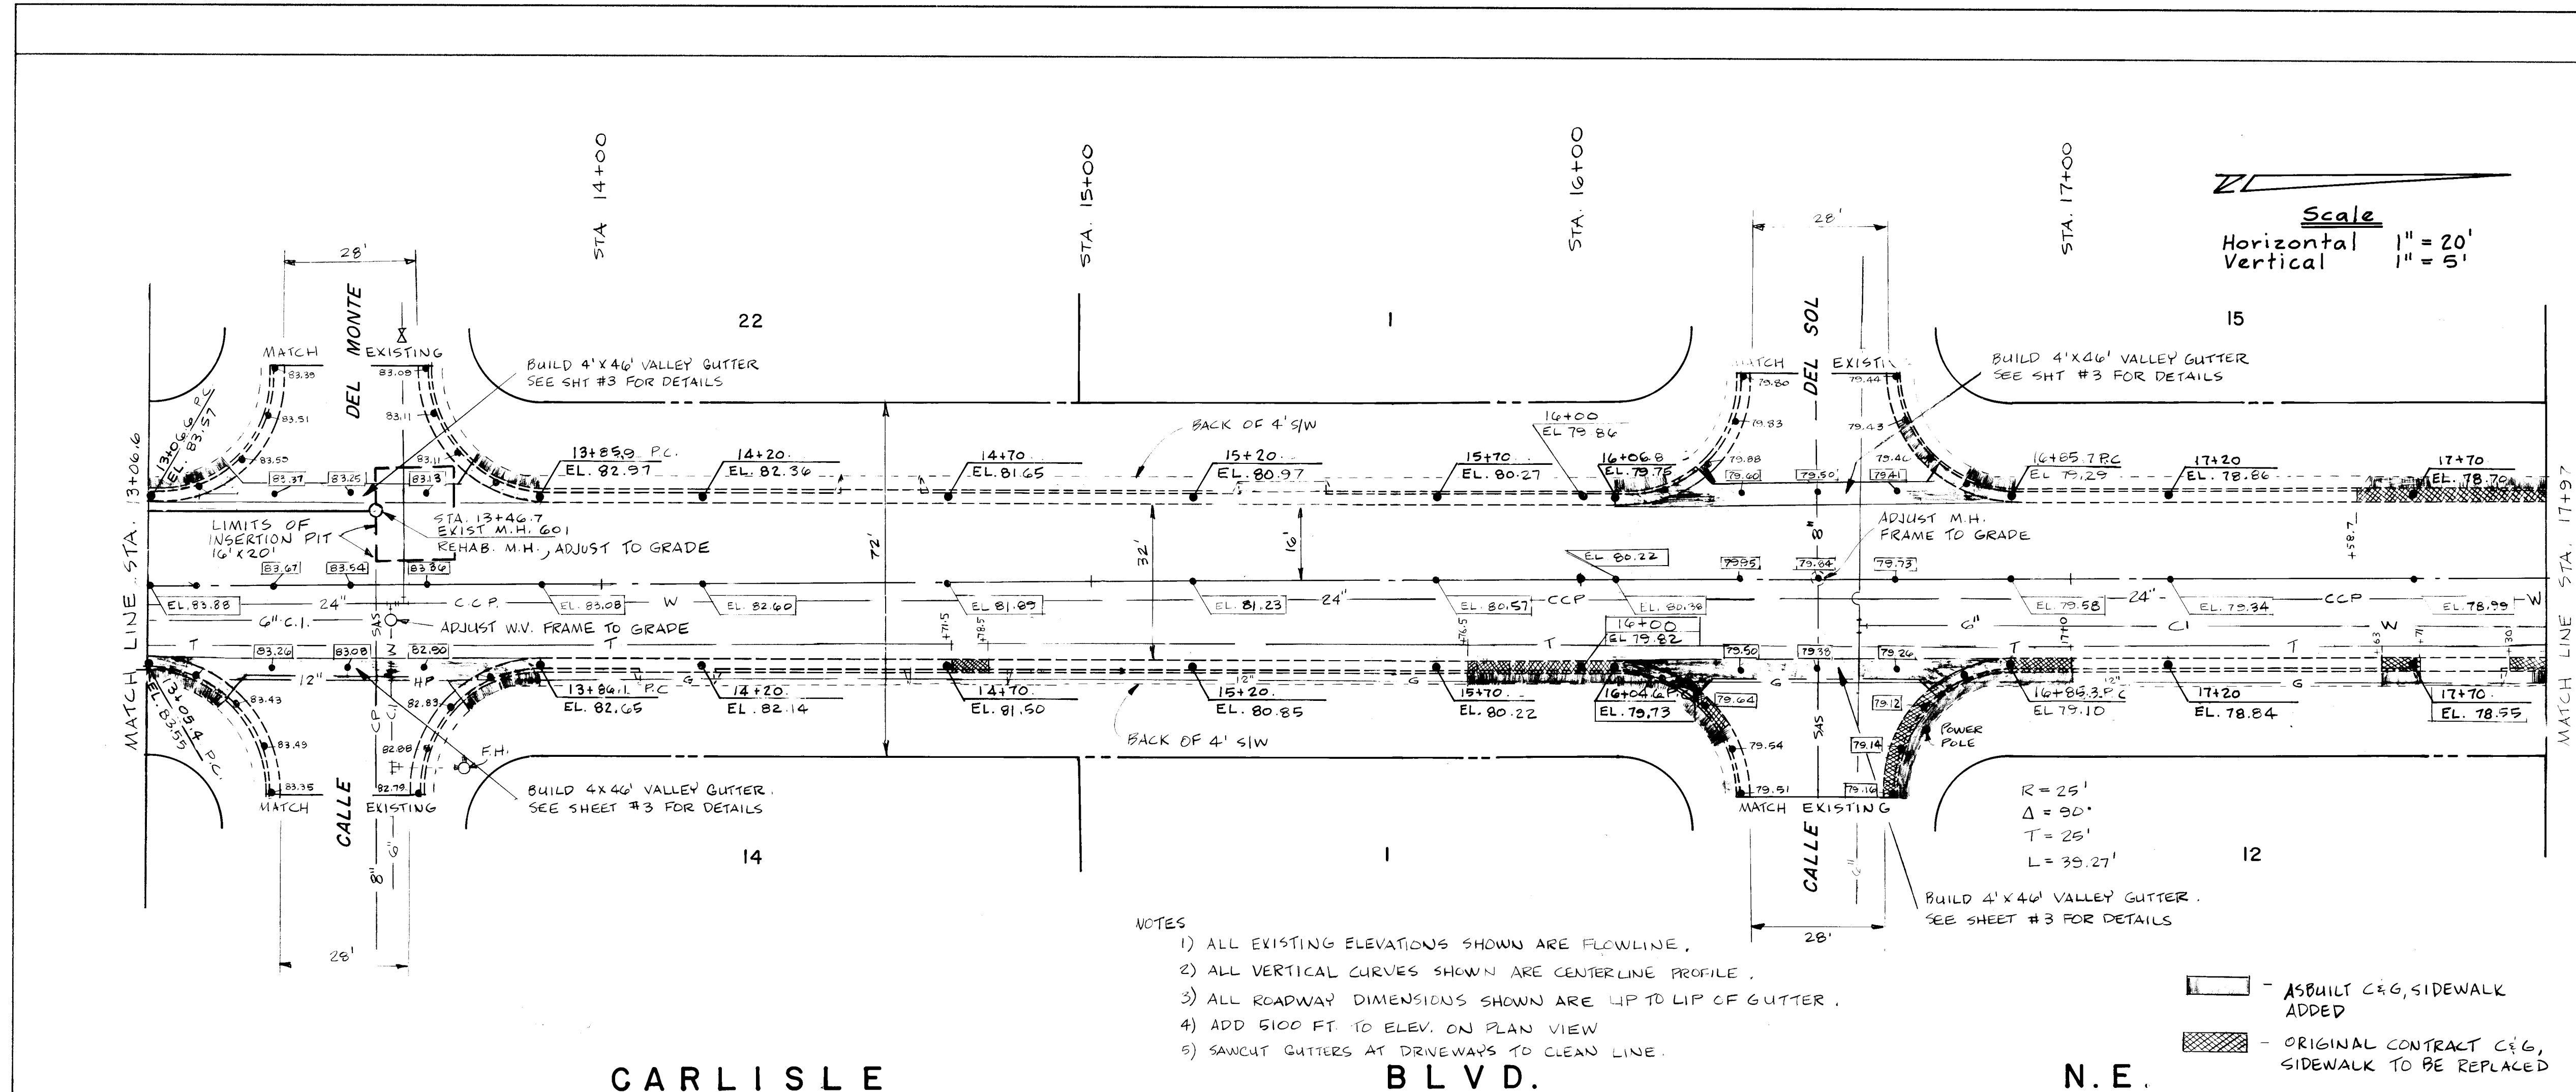

AS BUILT INFORMATION			BENCH MARKS			SURVEY INFORMATION			ENGINEER'S SEAL		
CONTRACTOR UNIVERSAL CONST.			STANDARD A.C.S.			FIELD NOTES			PREPARED UNDER THE DIRECTION OF		
WORK BY JAKE VIGIL			BRASS CAP SET ON S.W. AT ENE RETURN			NO.			George Meador		
DATE 10/14/04			CORNER LONAS & CARLISLE, ELEV 5193.03			DATE			BY		
INSPECTED BY J. L. JAMES			C.B.M. 3117			NO.			REVISIONS		
DATE 10/14/04			VERIFICATION BY R. GUILER			DATE			DESIGN		
DRAWN BY J. L. JAMES			C.B.M. N.B. E.H. NE QUAD @ CALLE			NO.			REVISIONS		
DATE 10/14/04			CORNER LONAS & CARLISLE, ELEV 5193.03			DATE			DESIGN		
DRAWN BY J. L. JAMES			DEL MONTE, ELEV 5180.01			NO.			REVISIONS		
DATE 10/14/04			MICRO-FILM INFORMATION			NO.			DESIGN		
RECORDED BY			NO.			NO.			DESIGN		
DATE			NO.			NO.			DESIGN		

26 19140787

STA. 13+07 to STA. 17+97

CITY OF ALBUQUERQUE
TRANSPORTATION DEPARTMENT
PLANNING AND PROGRAMMING DIVISION



TITLE: CARLISLE BOULEVARD

MESA VERDE AVENUE to CONSTITUTION AVENUE


APPROVALS	ENGINEER	DATE	APPROVALS	ENGINEER	DATE
City Engineer	George Meador	8/27/07	Liquor Waste		
A.C.E. - Design			Traffic		
A.C.E. - Hydrology	Jim Zink	2-28-89	Water Resources	James Joplin	2-24-84

DRAWING NO. 1914 MAP NO. J-16 & 17 SHEET 7 OF 11

RECORD DRAWINGS

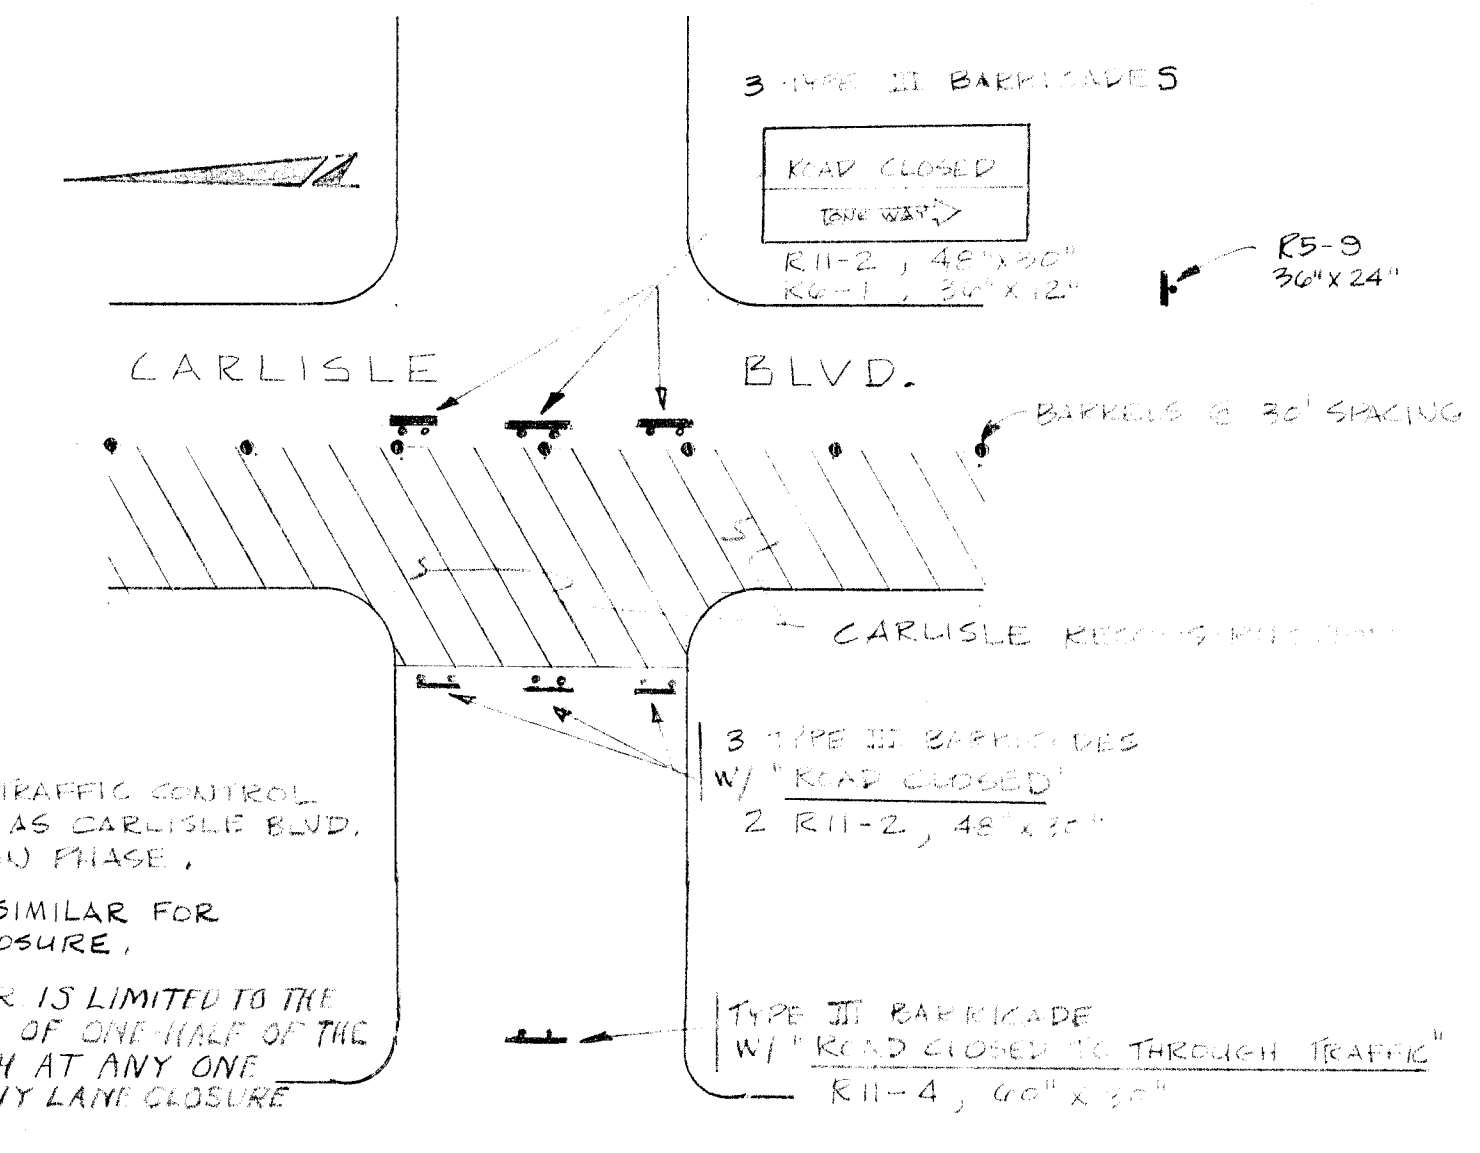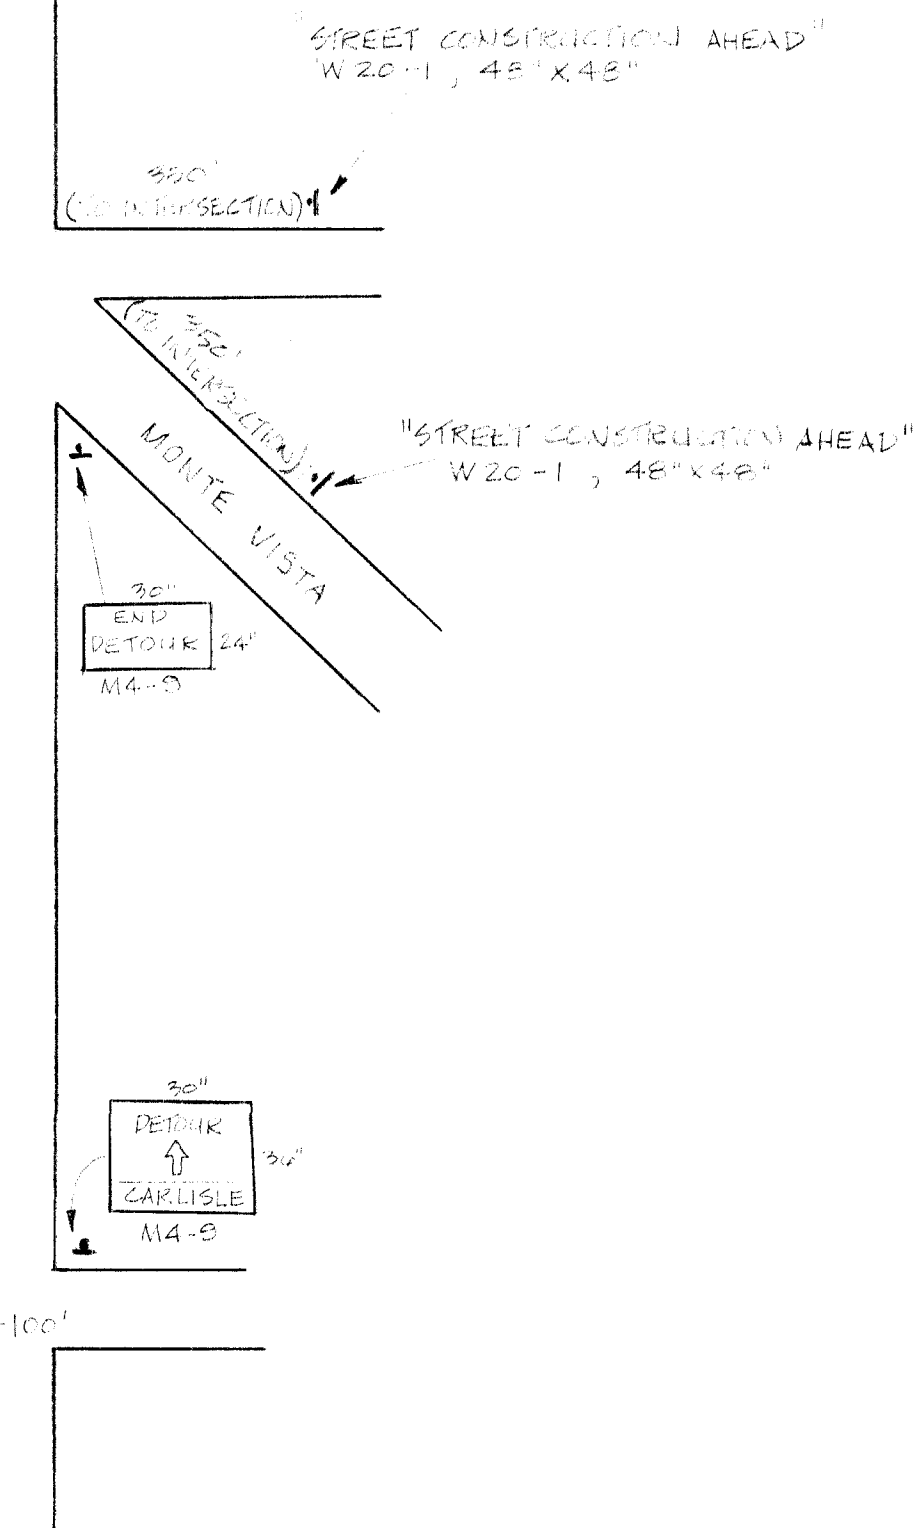


(MACRIGU, CALLES DEL SOL, CALLES DEL ARROYO, CALLES DEL RANCHERO)

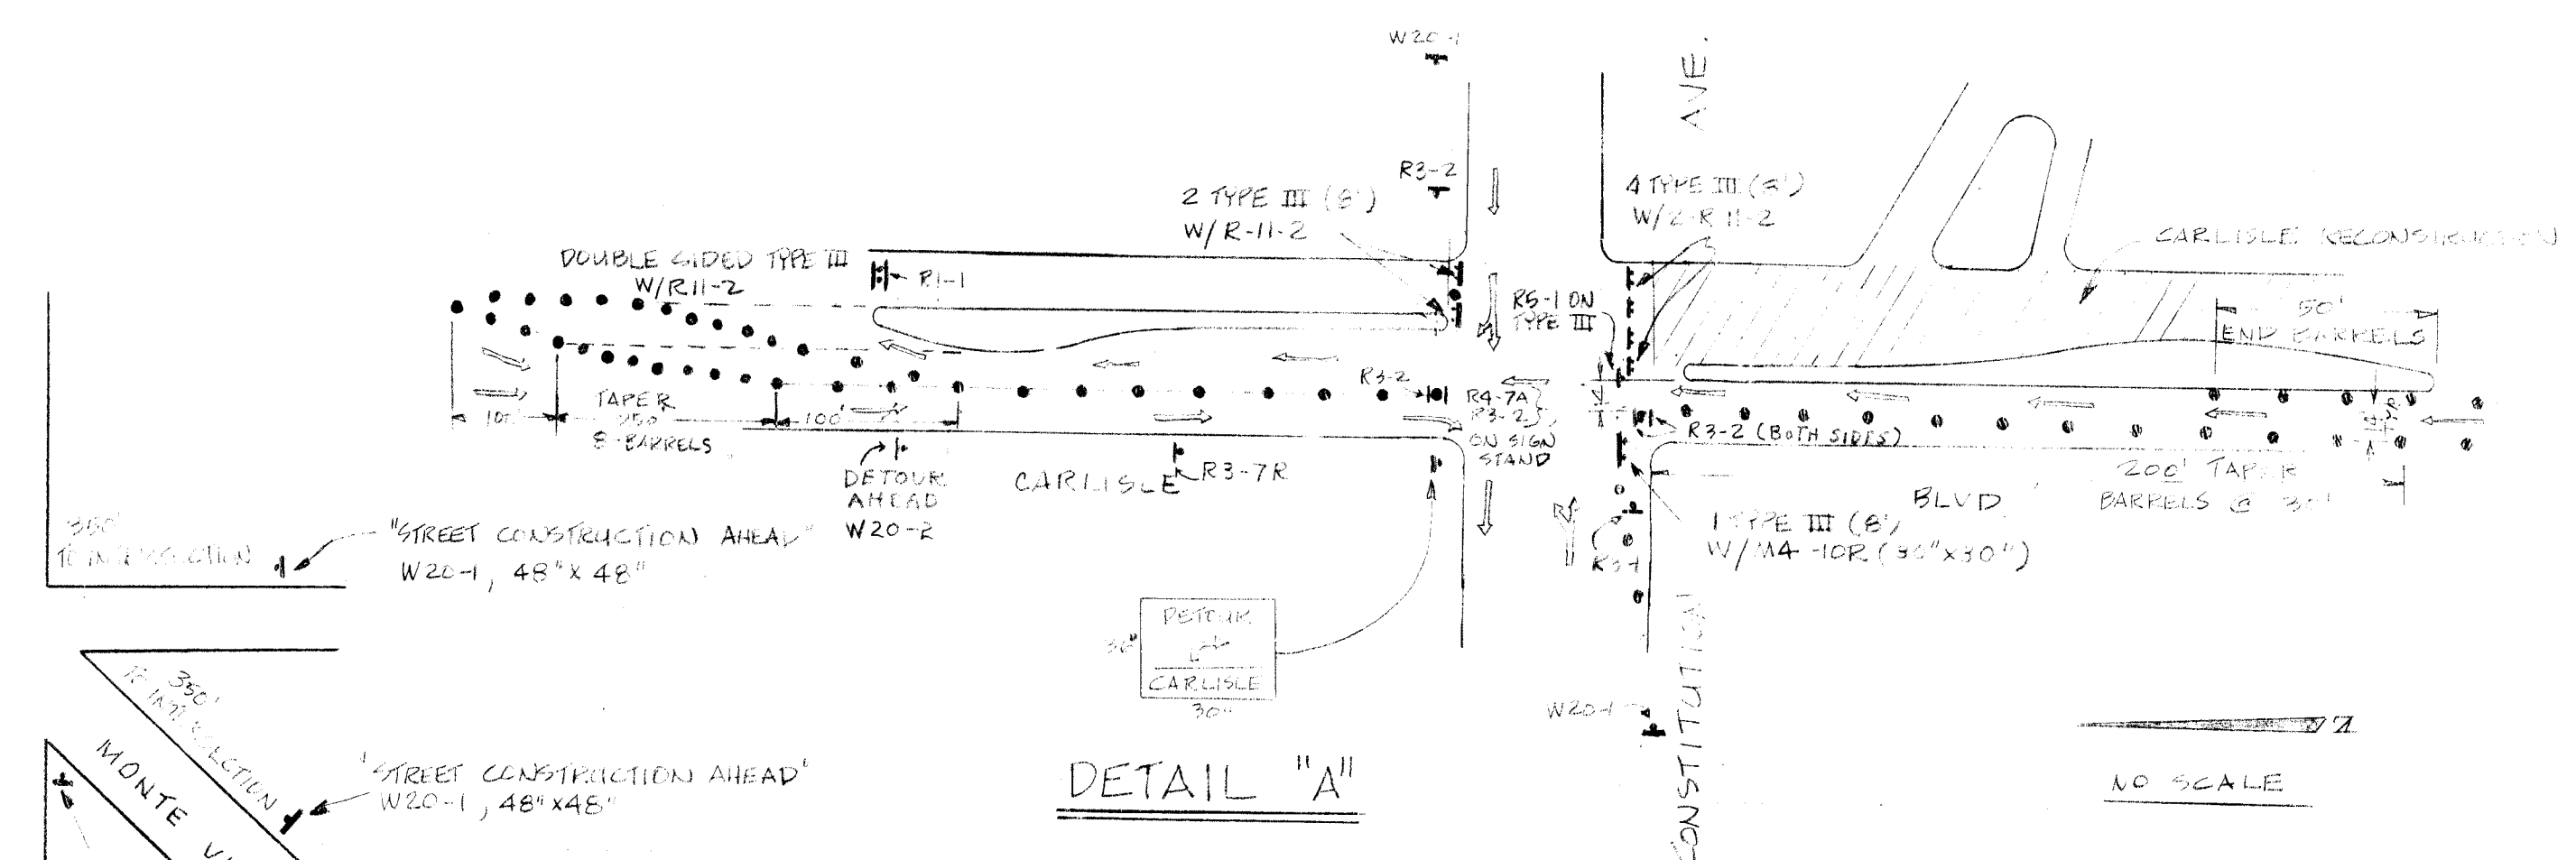

TRAFFIC CONTROL DEVICE QUANTITIES																				
	POLY BARRICADES	BARRELS OR RAILROADS	M-6	N20-1	N20-2	N20-6	K-4-2	M-4-1CR	W-4-ZL	L-7E	W-4-K	X-10	P-1	R-1	KH-2	T-1	N-3	SIGNAL SIGNS	PH-4	PH-1
WEST LANE CHURCH	33	115	9	6	2		1	2		1	1			2	4	13	4		8	1
EAST LANE CHURCH	42	120	10	6	2	1	1	1	1	2	1	2	1	4	16	4	1	5	4	

NOTES: 1) TYPE II BARRICADES MAY BE USED IN LIEU OF BARRELS.
2) THIS CHART IS TO ASSIST CONTRACTOR AND DOES NOT SHOW TOTAL PLACING QUANTITIES.

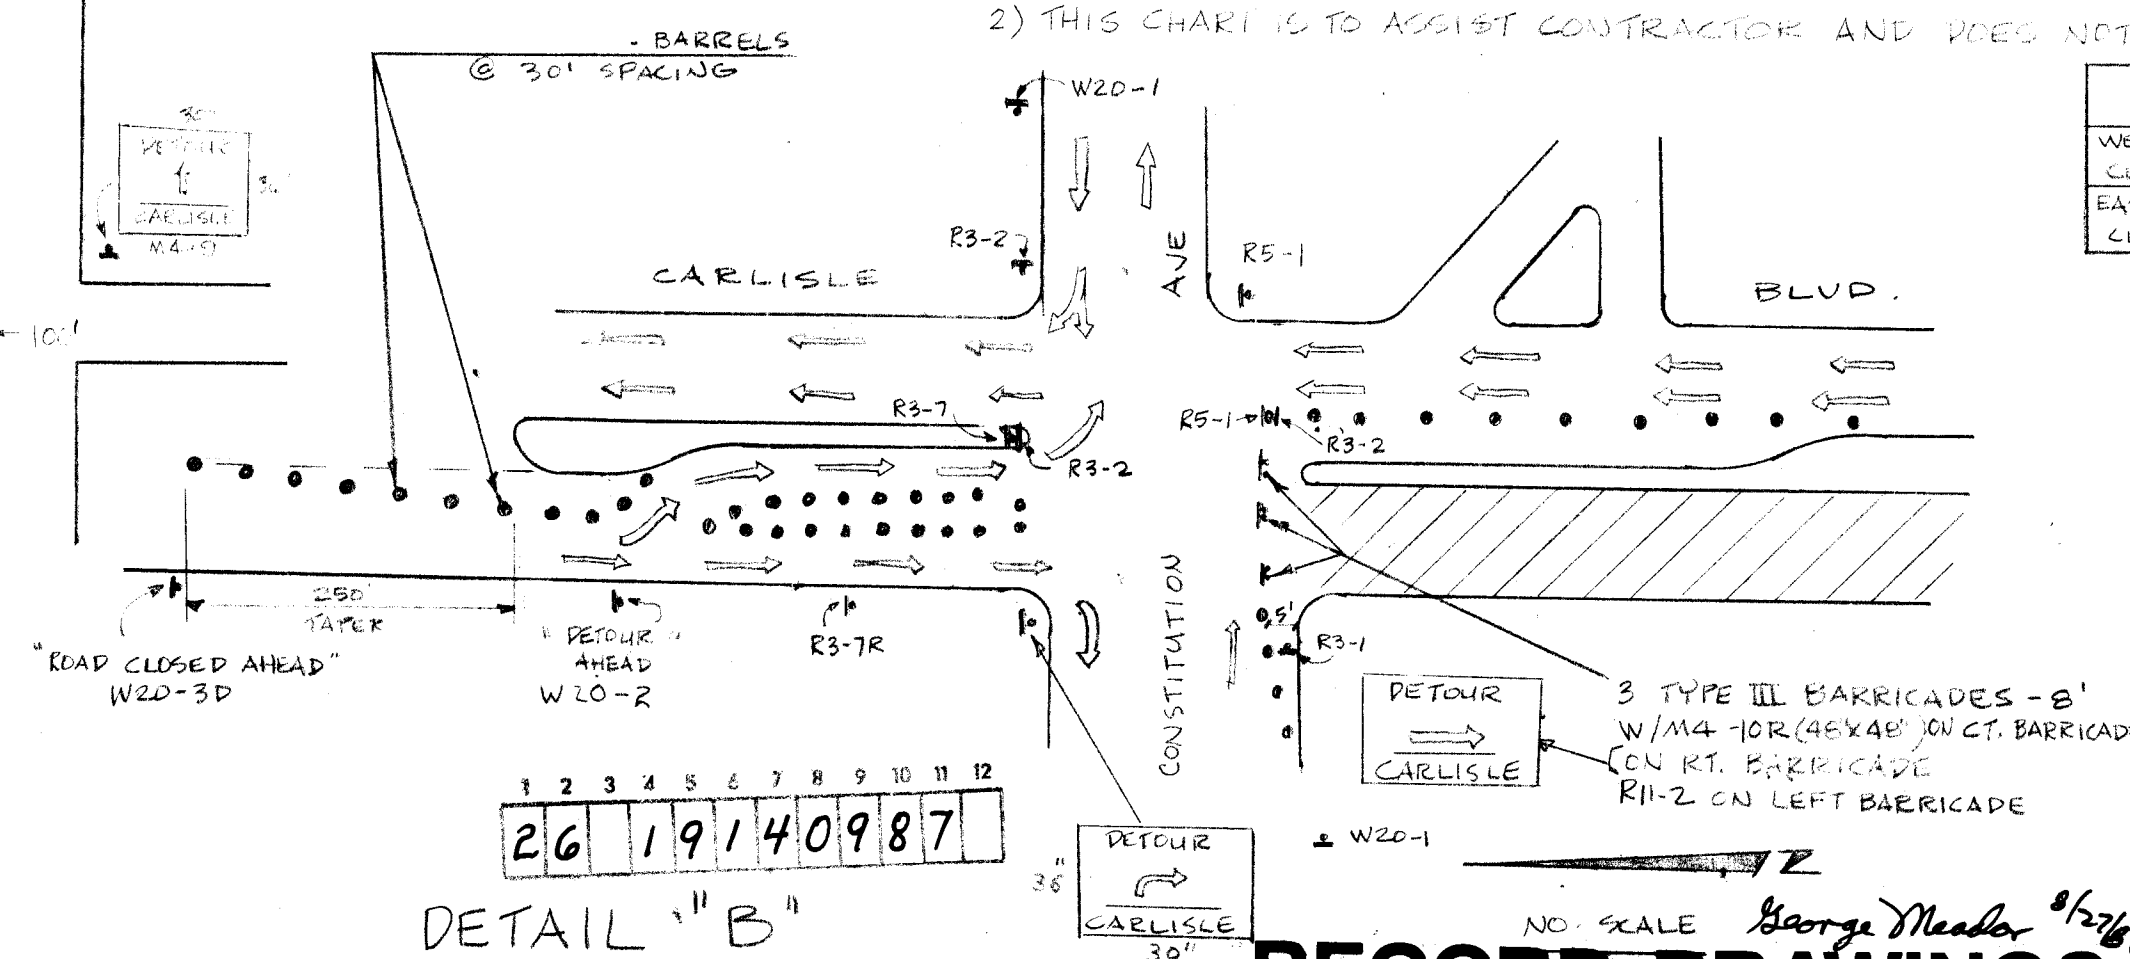

DETAIL "B"

	W1-4 (R)	R2-7	R3-TR	R5-9	R3-2	W4-2
WEST LANE CLOSURE	1	1	1	4	5	1
EAST LANE CLOSURE	1	1	1	4	6	1

TRAFFIC CONTROL PLAN

CITY OF ALBUQUERQUE
TRANSPORTATION DEPARTMENT
PLANNING AND PROGRAMMING DIVISION

TITLE: CARLISLE BOULEVARD
MESA VERDE AVENUE to CONSTITUTION AVENUE

PREPARED	INITIALS	DATE	APPROVALS	ENGINEER	DATE
City Engineer	<i>[Signature]</i>	4/29/82	Water Resources		
ARE Drawn		4/29/82	Water	T. W. Kennedy	2/29/82
City Engineer	<i>[Signature]</i>	2-28-84	Water Resources	N.A. Jomari	2-21-84
nd	<i>[Signature]</i>	2-28-84			








DRAWING NO.	1914	MAP NO. J-16 & 17	SHEET <u>9</u> OF <u>11</u>
----------------	------	----------------------	-----------------------------

SOURCE INFORMATION		RECORD NUMBER	AS-BUILT INFORMATION
DATE	FIELD NUMBER		
			CONTRACTOR
			PROJECT NAME
			INTERSECTION
			ADDRESS
			CITY
			STATE
			DATE
			TIME
			PROJECT NUMBER
			PROJECT NAME
			DATE
			TIME

ENVELOPE SEAL
PREPARED UNDER THE
DIRECTION OF
George Meador

[illegible]

DISTRICT
 DEPARTMENT
 PLANNING DIVISION
 BOULEVARD
 CONSTITUTION AVENUE

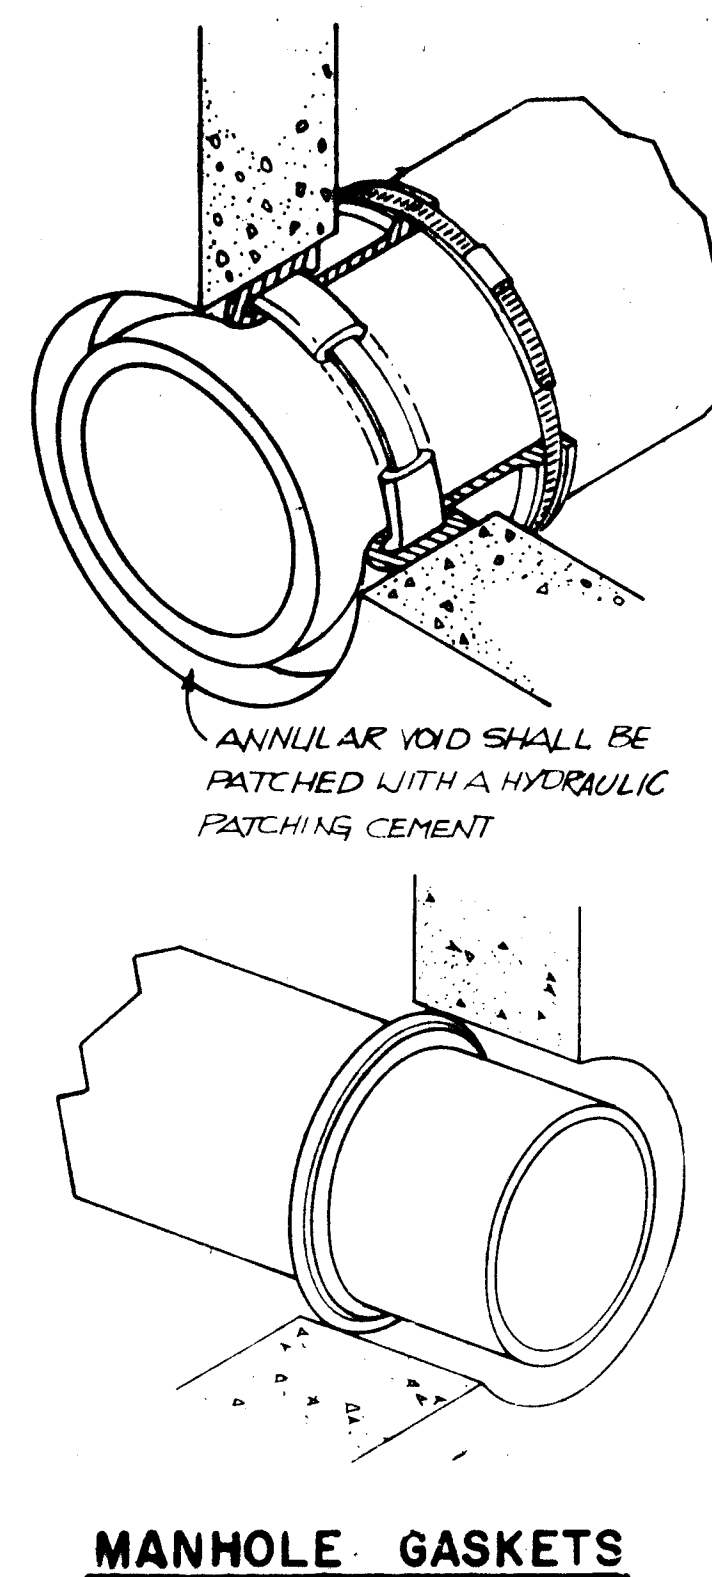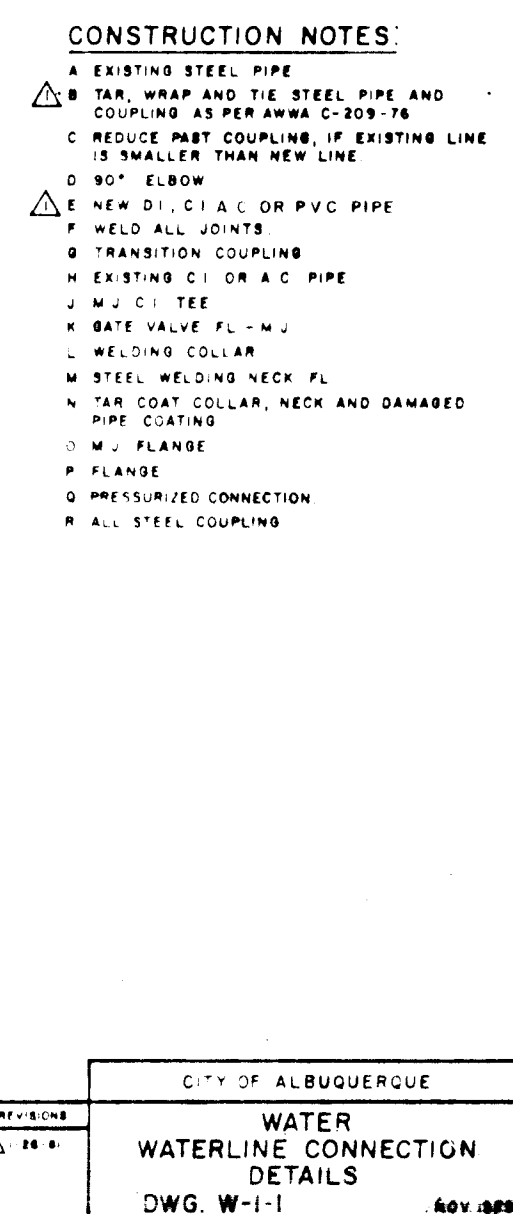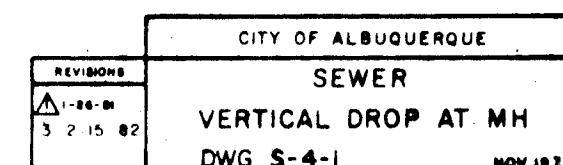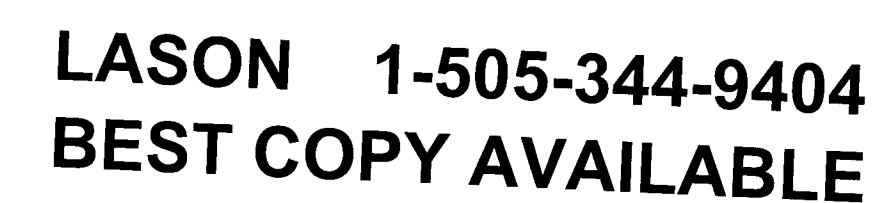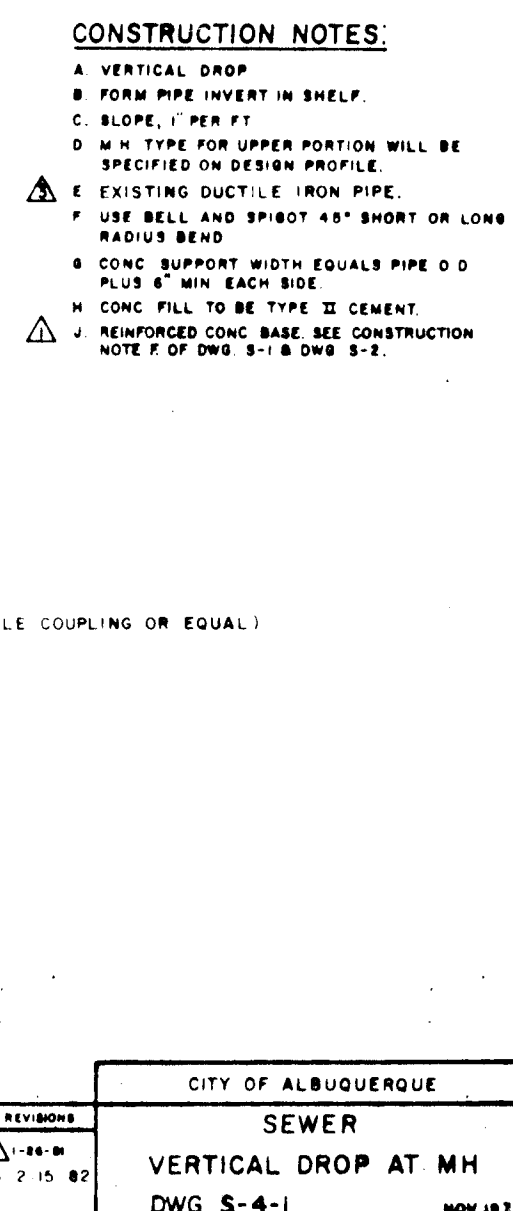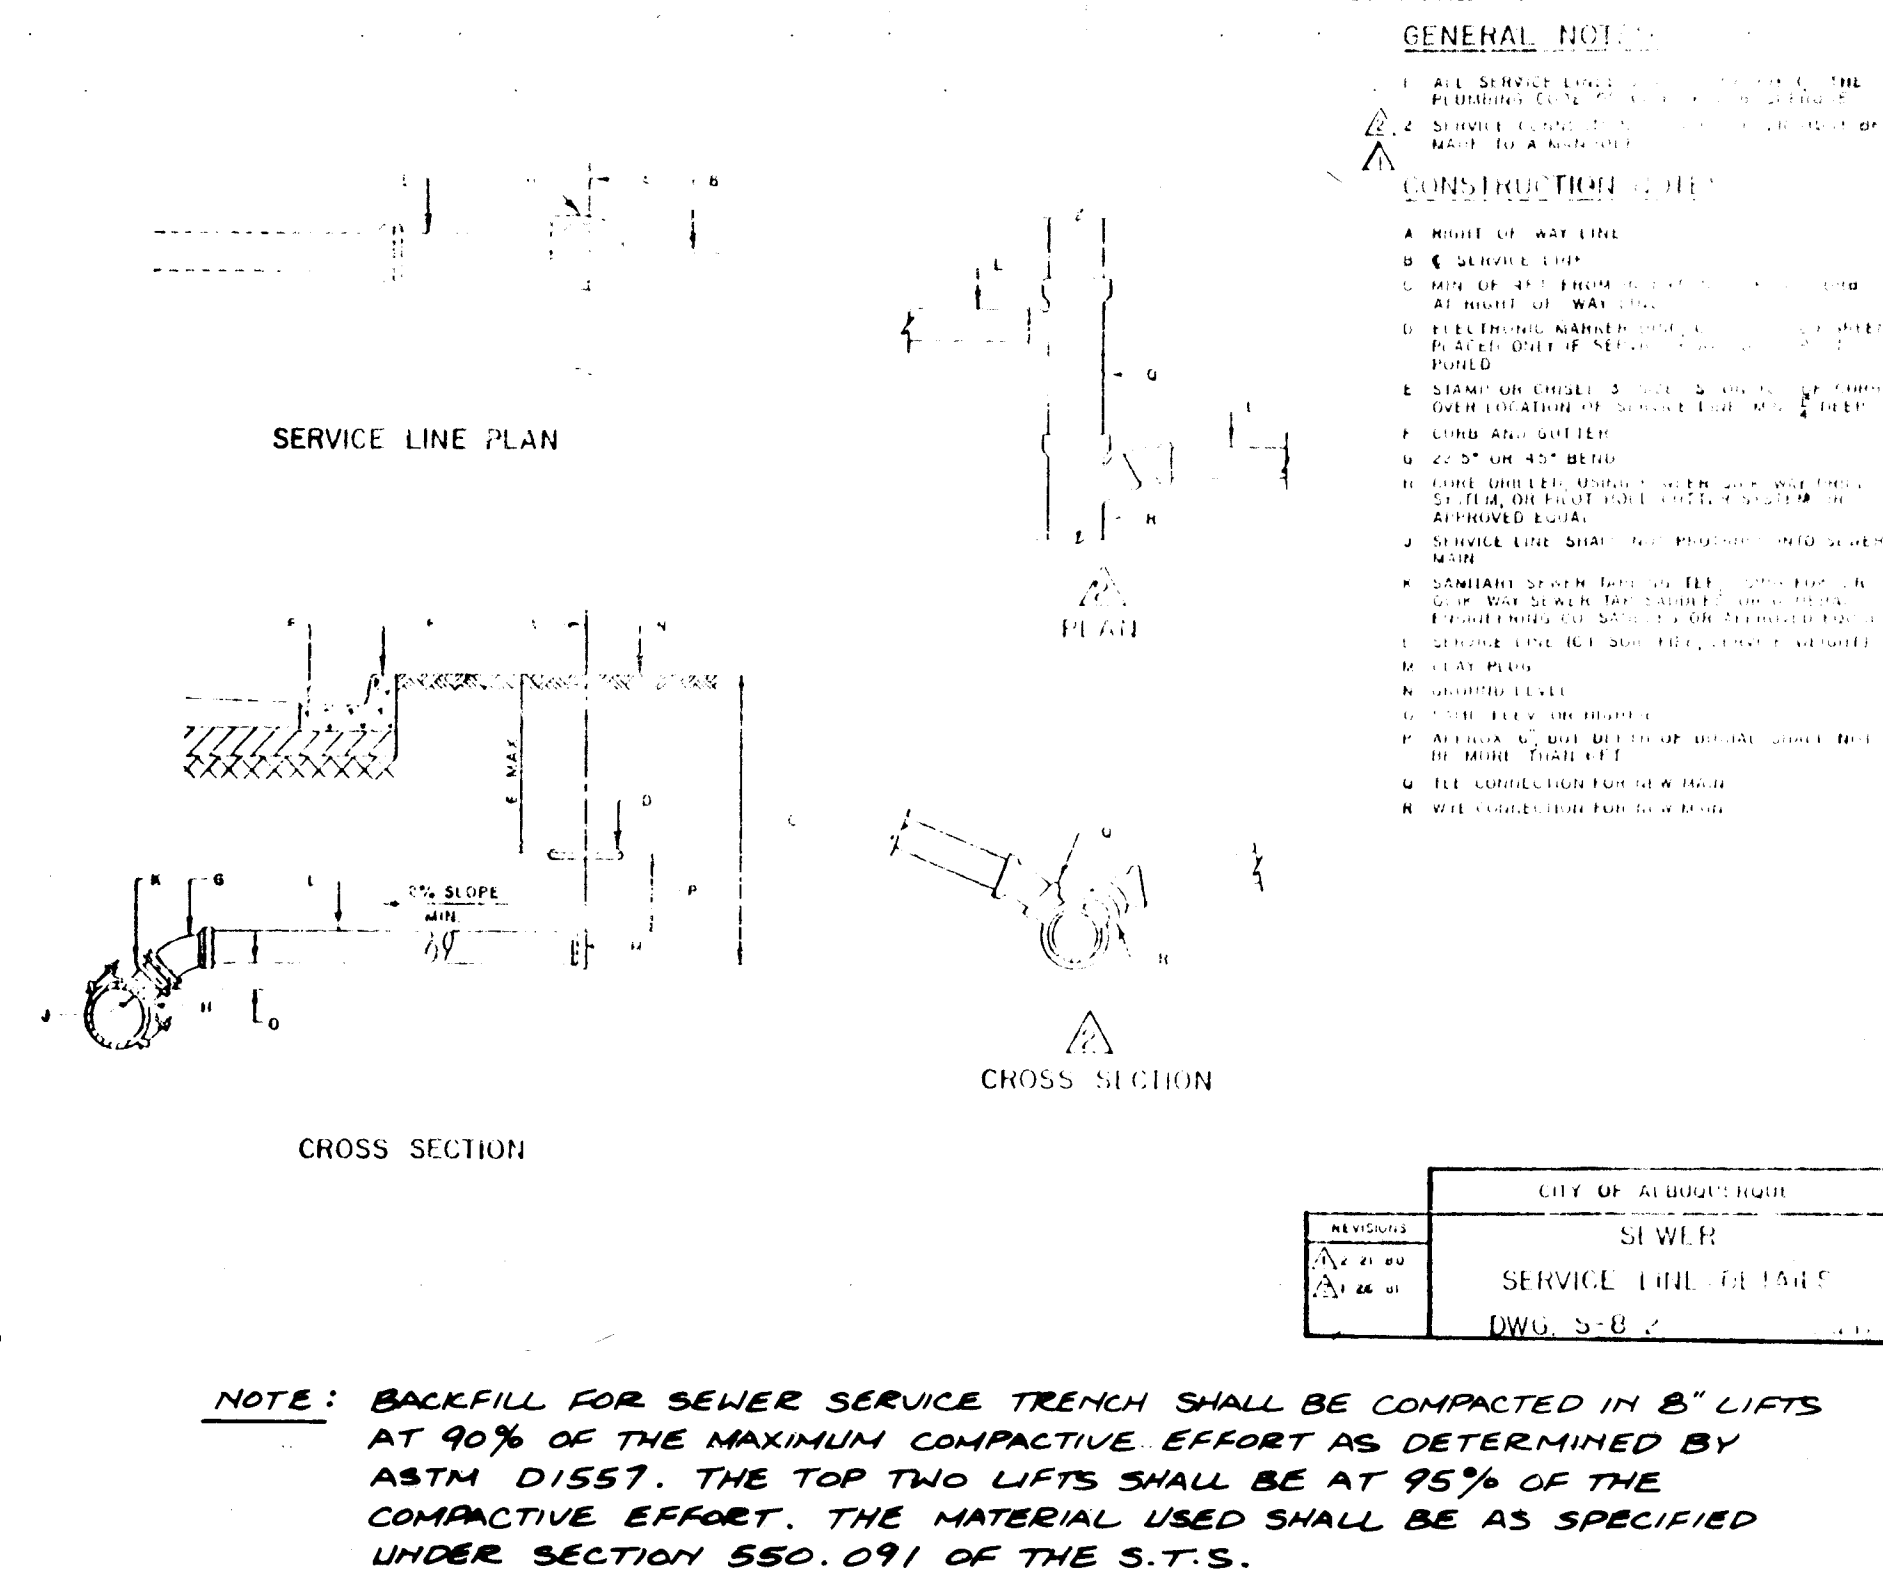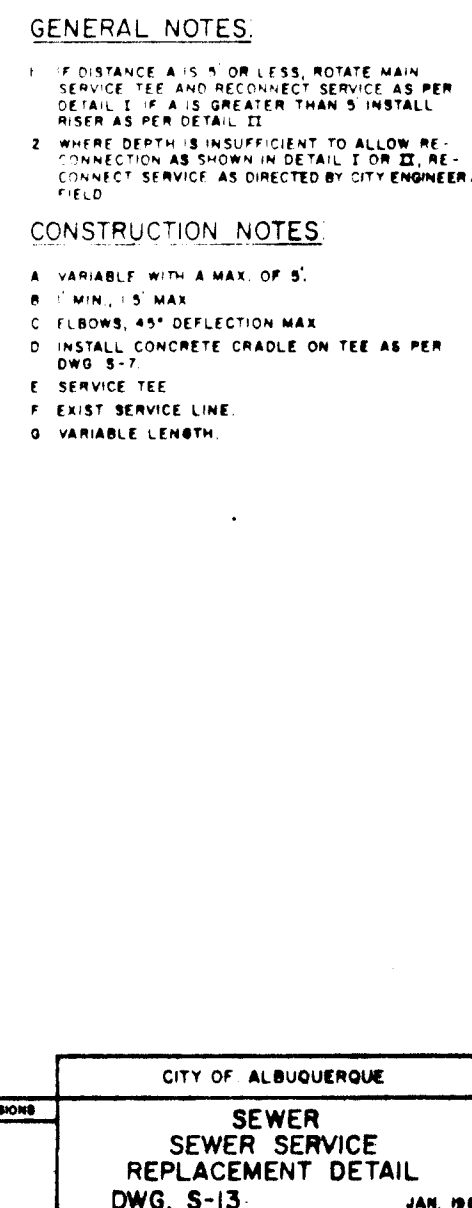

BENCH MARKS						SURVEY INFORMATION		AS BUILT INFORMATION	
						FIELD NOTES			
						BY DATE			
						NA			
NA									
STANDARD A.C.S.									
BRASS CAP SET ON 1/4" AT E.N.E.									
RETURN.									
LOMAS # CARLISLE ELEV. 9193.03									
CBM 3J17									

MICRO-FILM INFORMATION
 RECORDED BY _____
 DATE _____