

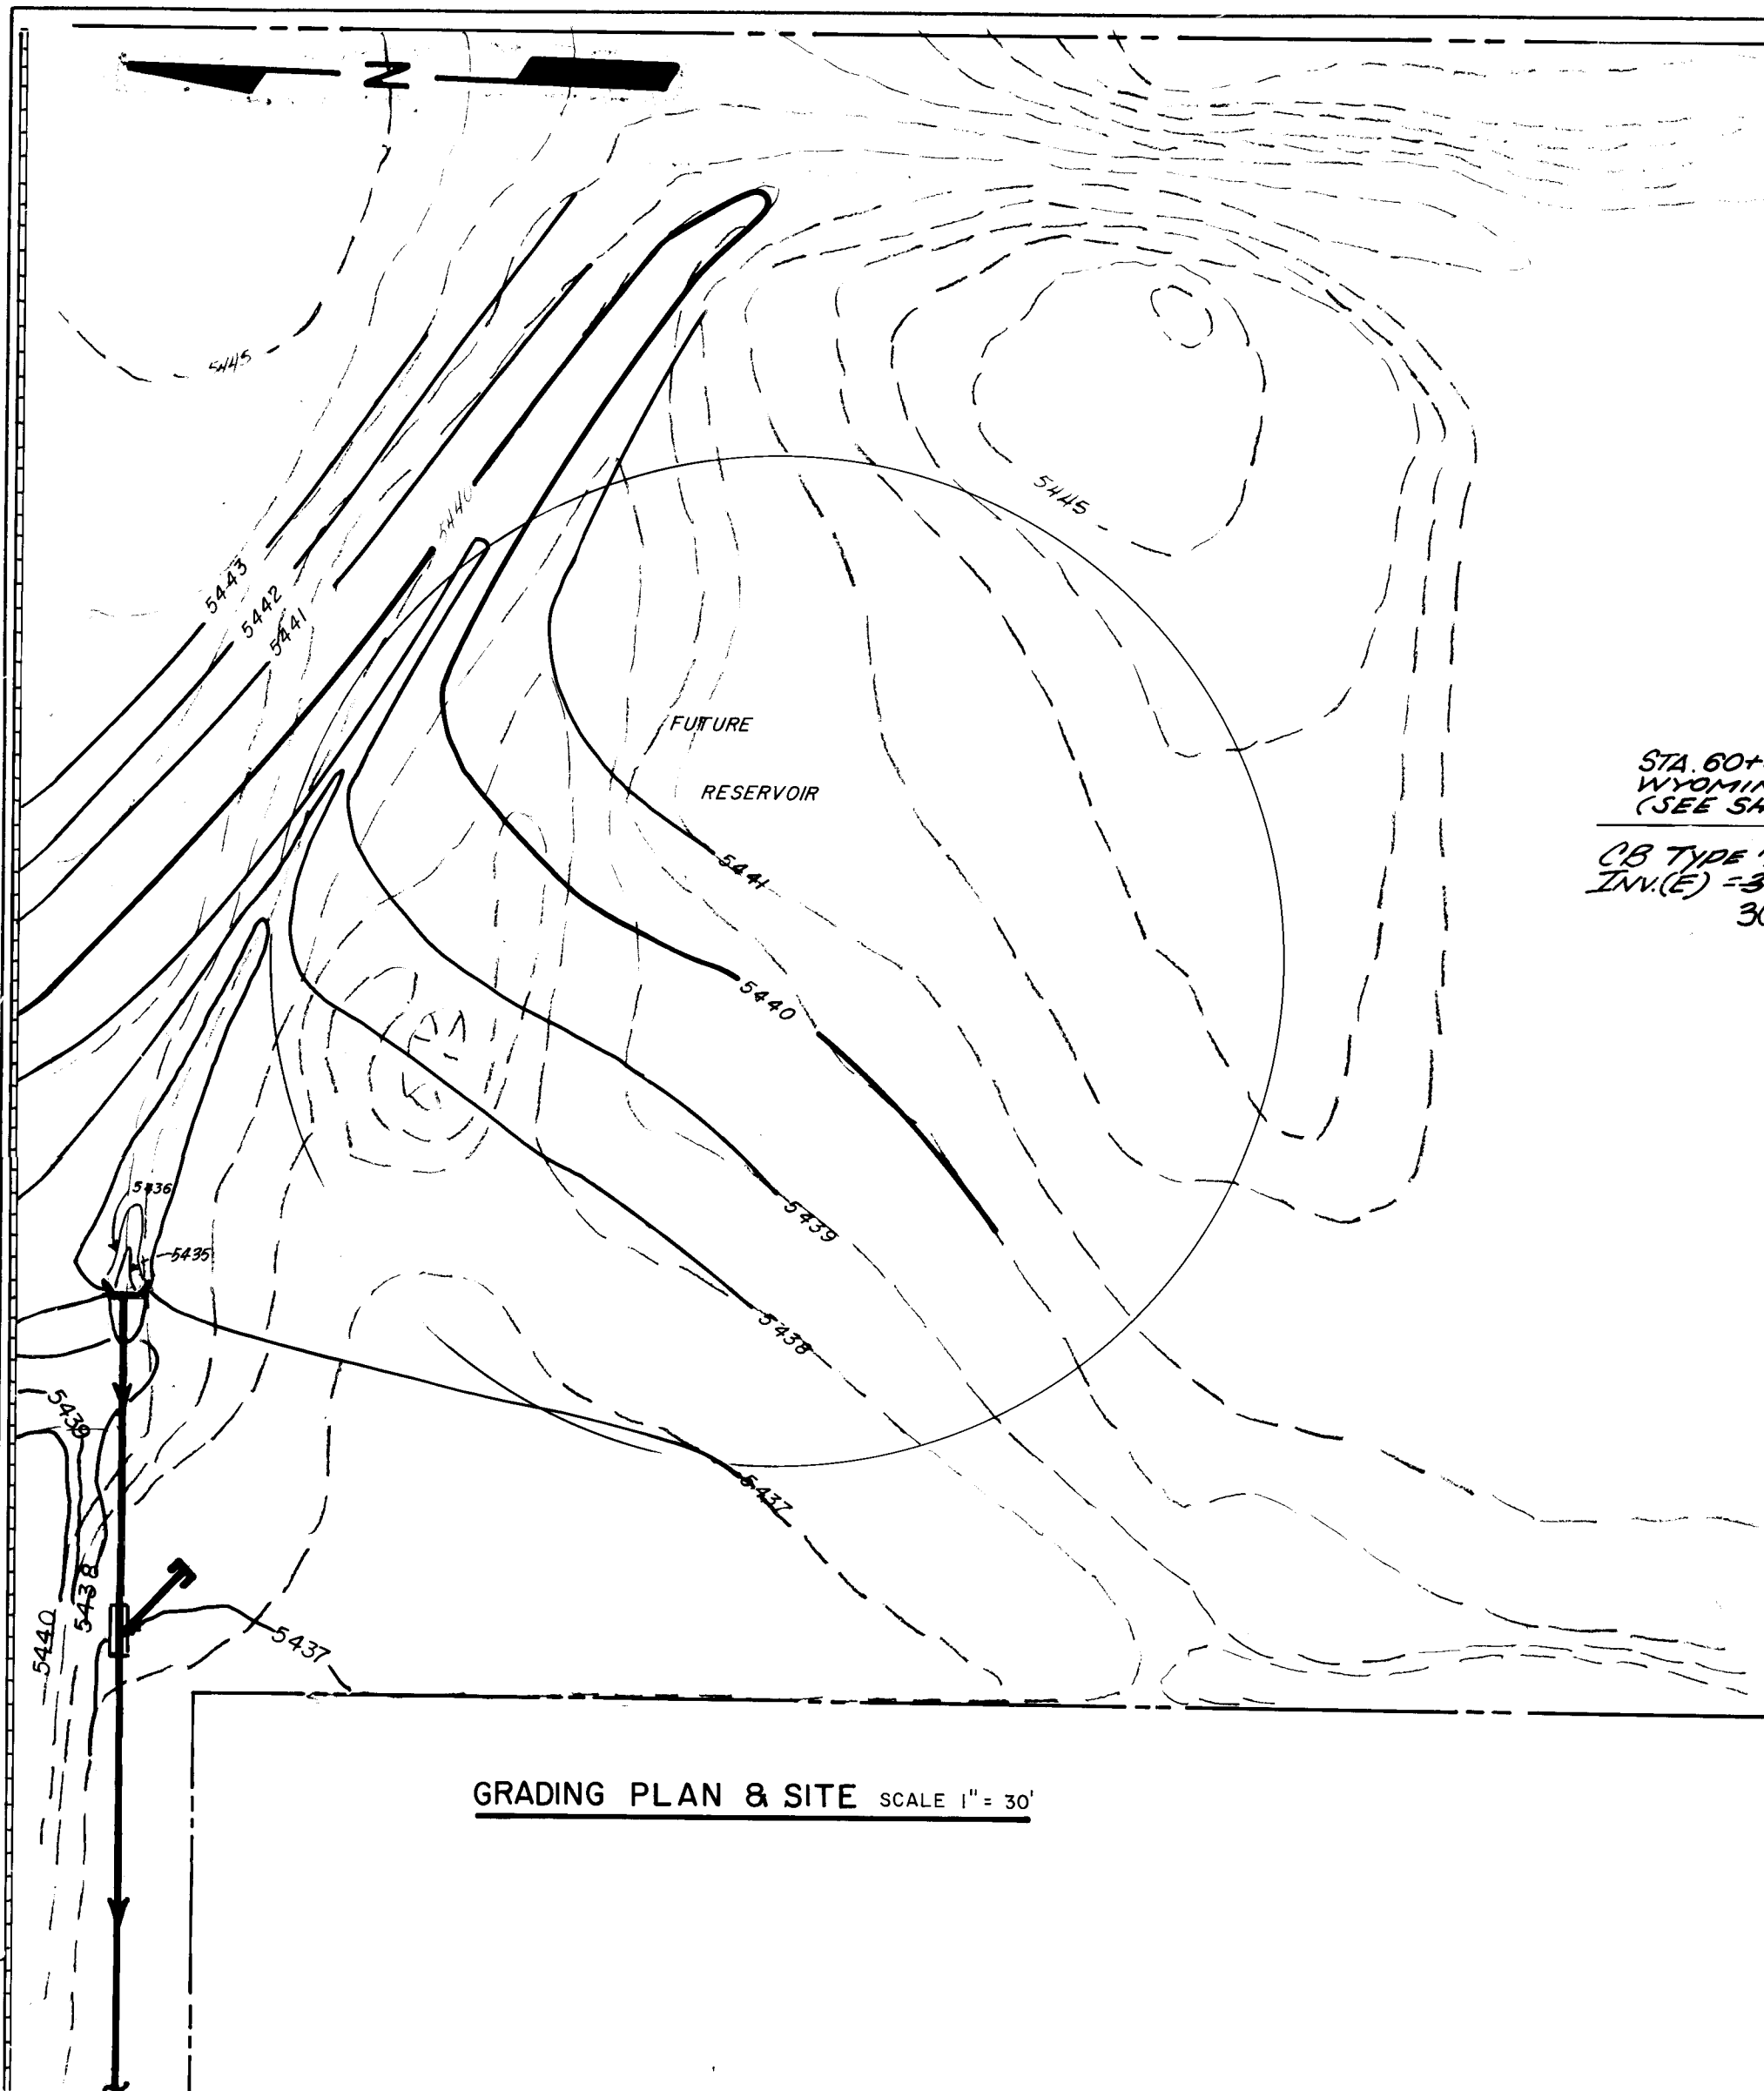
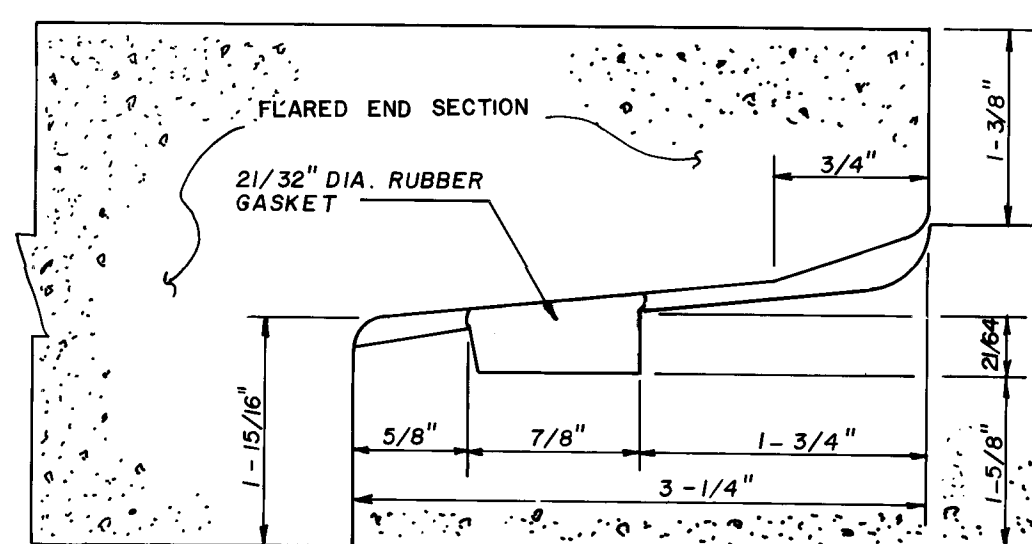



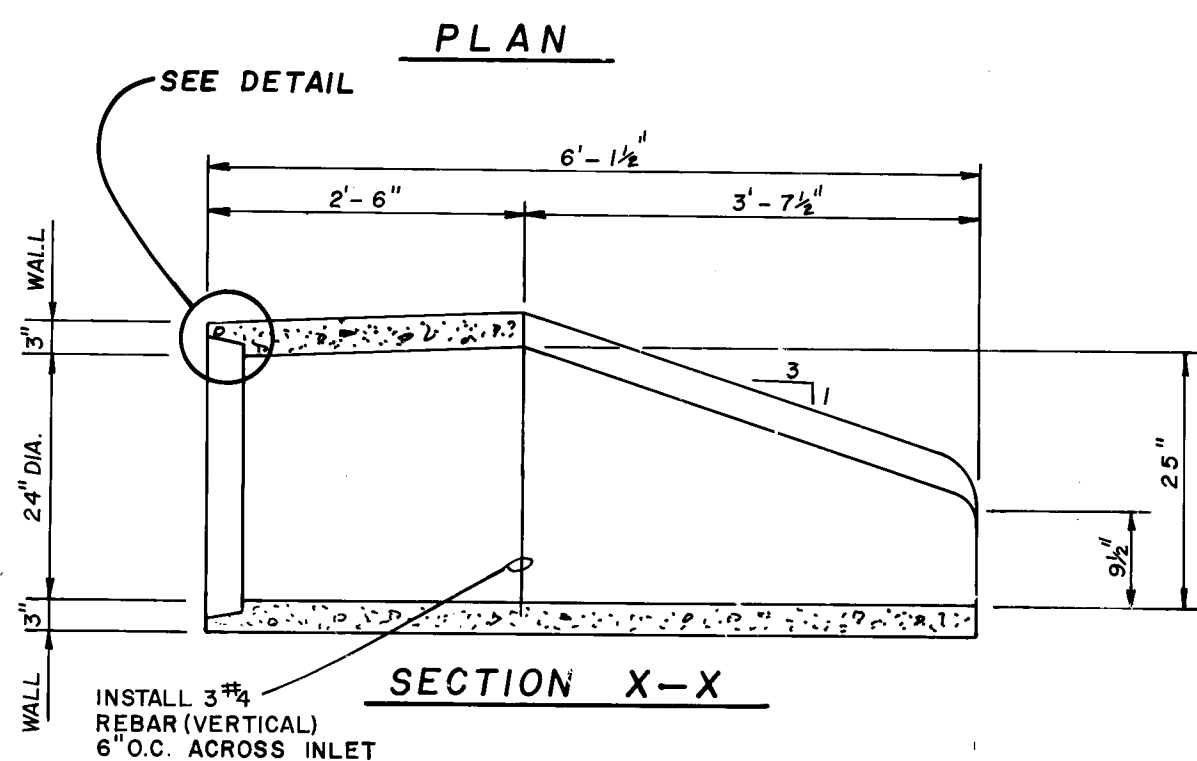


### CONCRETE FLAIED END SECTION DETAILS

SER. ES-1 (NMSHD)

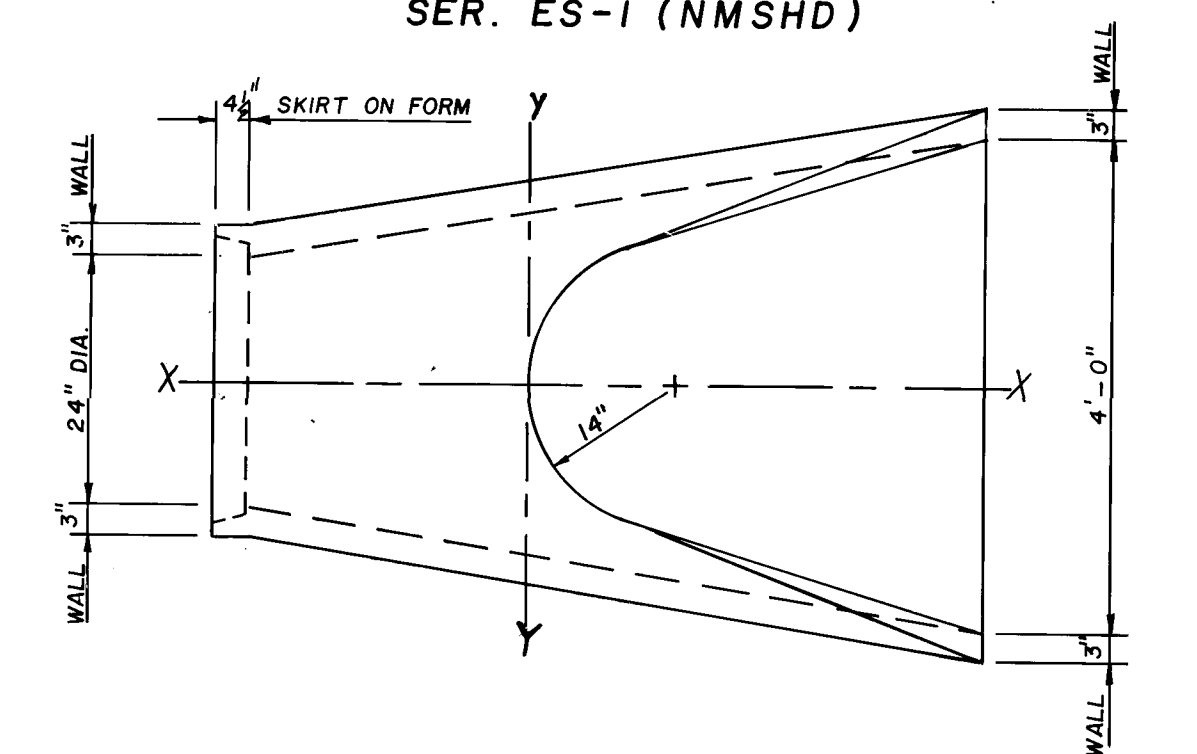

### DETAIL ("O" RING GASKET)

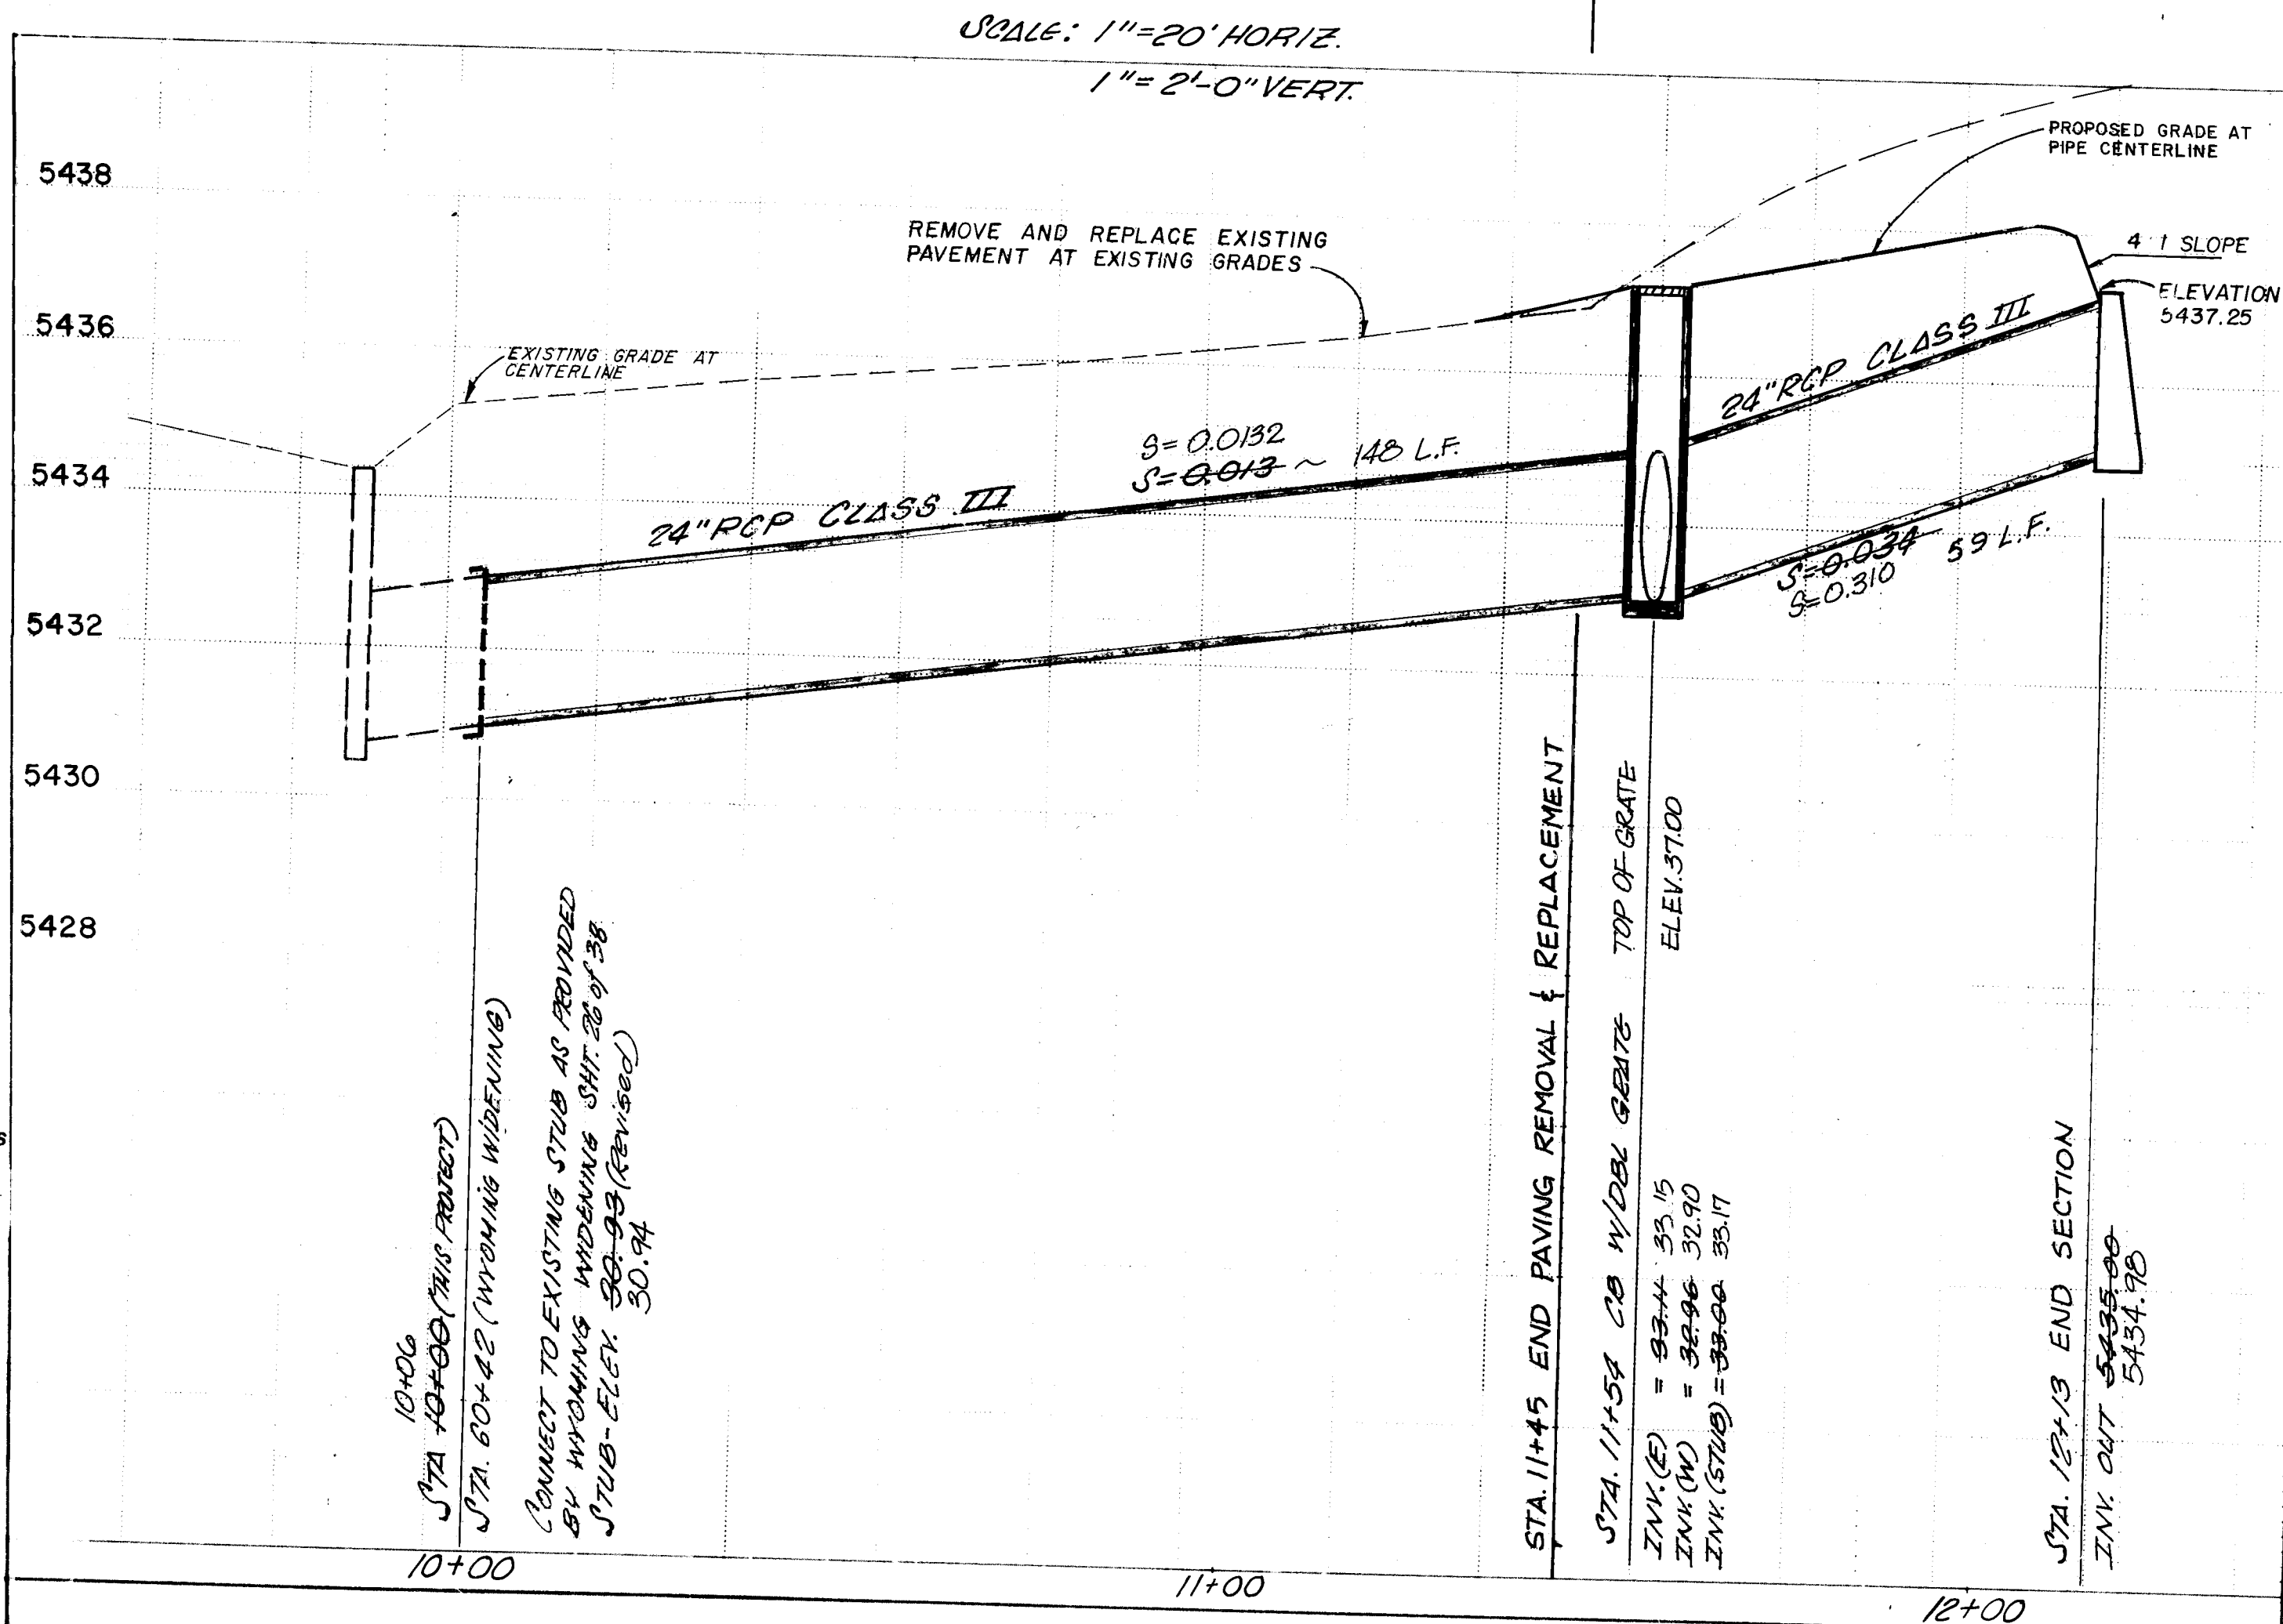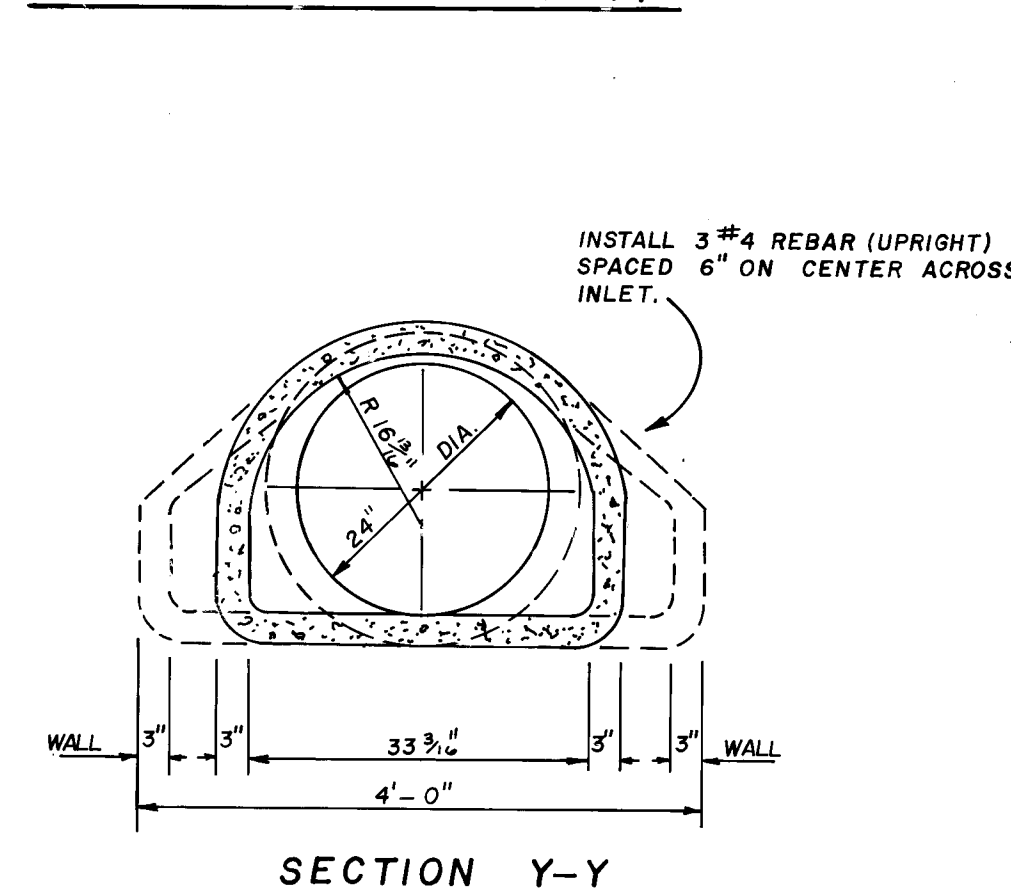

OFIHIANO GUTIERREZ ADDN.

STA. 11+54

INSTALL C.B. TYPE "D" W/ DBL. GRADE

TOP GRADE = 37.00

INV. (E) = 33.11 33.15

INV. (W) = 32.96 32.90

INV. (STUB) = 33.00 33.17

EXISTING BLOCK WALL

EXISTING LIGHT POLES TO REMAIN

REMOVE/REPLACE EXIST ASPH. PAVMT.

24" RCP

S = 0.0132

STA. 12+13 PROPOSED END SECTION

SEE DETAIL THIS SHEET

STA. 11+55.62

24" R.C.P. INTERSECTS D.I.

24" RCP

S = 0.034

S = 0.310

24" RCP STUB-OUT - 10 L.F.

W/ PRECAST CONC. PLUG

PLUG INV. 5433.21


5433.21

THOMAS RESERVOIR

SITE

(Quarter's Rest.)

TRACT 11N

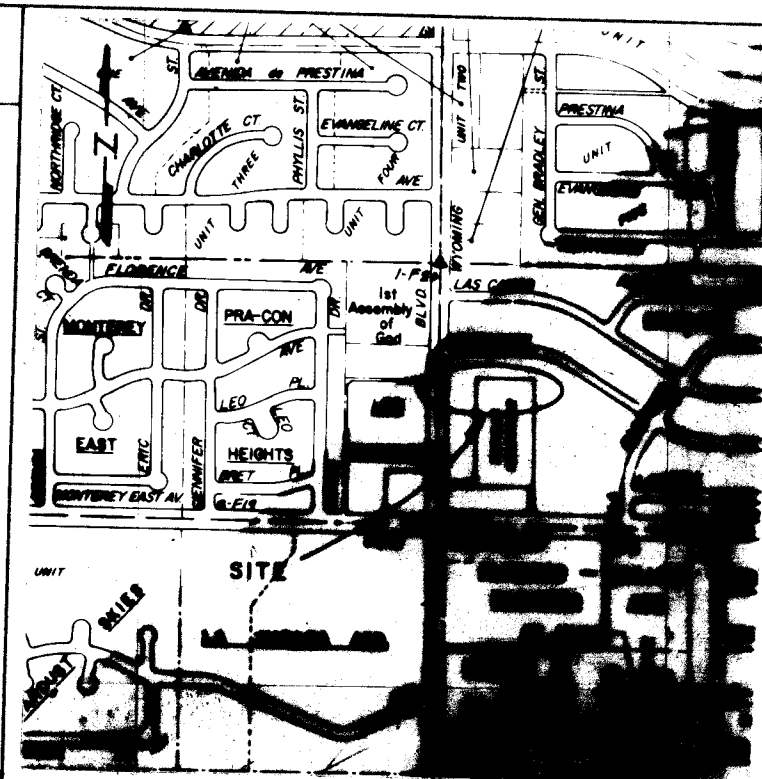

### "NOTICE TO CONTRACTORS"

- 1) New Mexico Standard Specifications for Public Works Construction-1978 Edition, will be referred to herein as the "Standard Specification".
- 2) All work detailed on these plans to be performed under contract shall, except as otherwise stated or provided for herein, be constructed in accordance with "Contract Documents for Citywide Utilities and Cash Paving No. 21" and the Standard Specification.
- 3) Two working days prior to any excavation, contractor must contact Line Locating Service, 765-1234, for location of existing utilities.
- 4) Prior to construction, the contractor shall excavate and verify the horizontal and vertical locations of all obstructions. Should a conflict exist, the contractor shall notify the engineer or surveyor so that the conflict can be resolved with minimum amount of delay.

### THE FOLLOWING NOTES APPLY WHEN CHECKED

- ☐ All utilities and utility service lines shall be marked prior to paving.
- ☒ Backfill compaction shall be according to specified street use (TEMPORARY).
- ☐ Test cut requirements shall be determined by the City Engineer.
- ☐ Sidewalks and wheelchair ramps within the curb return shall be constructed wherever a new curb return is constructed.
- ☐ If curb is depressed for a driveway, the driveway shall be constructed prior to acceptance of the curb and gutter.
- ☐ All storm drainage facilities shall be completed prior to final acceptance.

### NOTE:

CONTRACTOR TO FIELD LOCATE AND VERIFY HORIZONTAL AND VERTICAL ALIGNMENT OF EXISTING STUB AT STA. 10+00 THIS PROJECT.

26 1921 0164

APPROVAL OF AS BUILT DRAWING  
W. J. McPherson  
DATE 5/14/84

C. J. Alford 10/29/83  
M.H. for CRO 10/21/83

CITY OF ALBUQUERQUE  
WATER RESOURCES DEPARTMENT  
ENGINEERING DIVISION

TITLE: THOMAS RESERVOIR, STORM DRAIN ENDWALL  
DETAIL, GRADING PLAN, & PLAN & PROFILE OF 24" RCP

| APPROVALS       | ENGINEER        | DATE     | APPROVALS    | ENGINEER        | DATE     |
|-----------------|-----------------|----------|--------------|-----------------|----------|
| City Engineer   | W. J. McPherson | 10/29/83 | Liquid Waste | W. J. McPherson | 7-23-83  |
| ACE - Design    | W. J. McPherson | 11/06/83 | Traffic      | W. J. McPherson | 10/11/83 |
| ACE - Hydrology | W. J. McPherson | 7/28/83  | Water        | W. J. McPherson | 7-22-83  |

DRAWING NO. 1921 MAP NO. F-19 SHEET 1 OF 1