


PENNSYLVANIA & OSUNA RD.
PAVING REPLACEMENT & STORM DRAINAGE

INDEX
SHT. 1 TITLE SHEET
SHT. 2 PLAN & PROFILE
2A PLAN & PROFILE

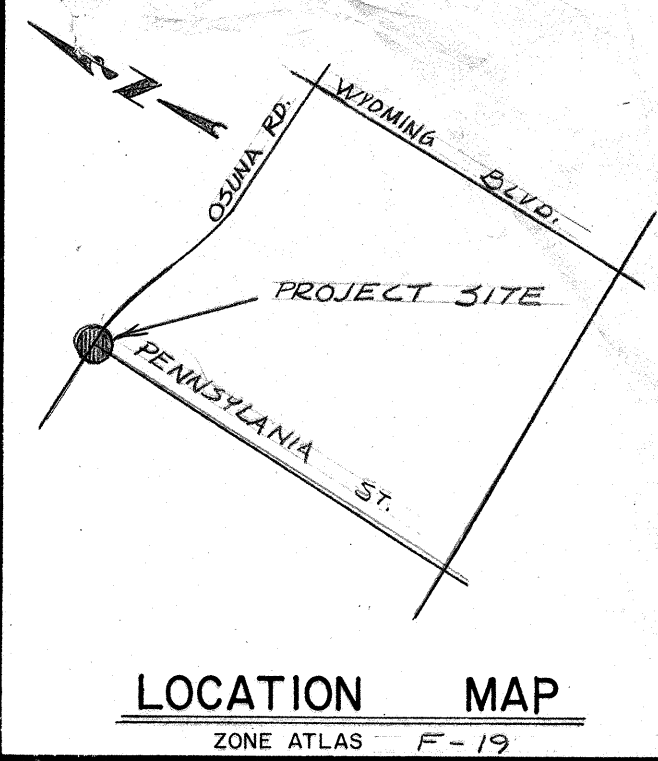


"NOTICE TO CONTRACTORS"

- 1.) New Mexico Standard Specifications for Public Works Construction - 1979 Edition will be referred to hereon as the "Standard Specification."
- 2.) All work detailed on these plans to be performed under contract shall, except as otherwise stated or provided for hereon, be constructed in accordance with "Contract Documents for City-Wide Utilities and Curb Paving No. 2-3" and the Standard Specification."
- 3.) Two working days prior to any excavation, contractor must contact Line Locating Service, 765-1234, for location of existing utilities.
- 4.) Prior to construction, the contractor shall excavate and verify the horizontal and vertical locations of all obstructions. Should a conflict exist, the contractor shall notify the engineer or surveyor so that the conflict can be resolved with minimum amount of delay.

THE FOLLOWING NOTES APPLY WHEN CHECKED

- ☒ All utilities and utility service lines shall be installed prior to paving.
- ☒ Backfill compaction shall be according to specified street use.
- ☒ Tack coat requirements shall be determined by the City Engineer.
- ☒ Sidewalks and wheelchair ramps within the curb returns shall be constructed wherever a new curb return is constructed.
- ☒ If curb is depressed for a drivepad, the drivepad shall be constructed prior to acceptance of the curb and gutter.
- ☒ All storm drainage facilities shall be completed prior to final acceptance.


20190129

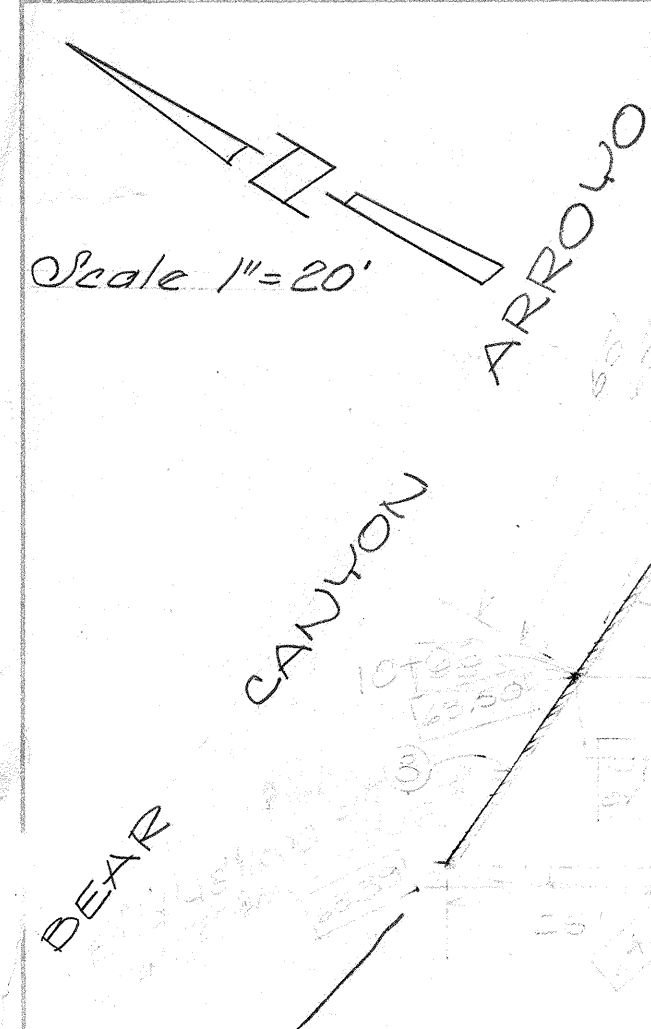


ARROYO DEL OSO
GOLF COURSE

Legend

- 67.20 PROPOSED FINISHED ELEVATION
- 65.10 EXISTING ELEVATION
- PROPOSED STORM DRAIN
- LIMITS OF PAVING REMOVAL AND REPLACEMENT
- WHEEL CHAIR RAMP

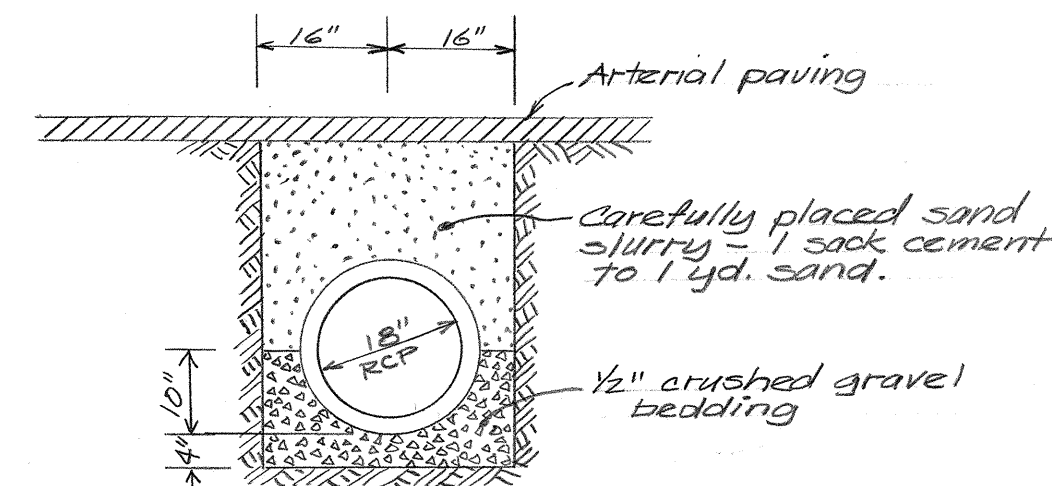


SECTION B-B
COVER AND BEDDING FOR
18" RCP.

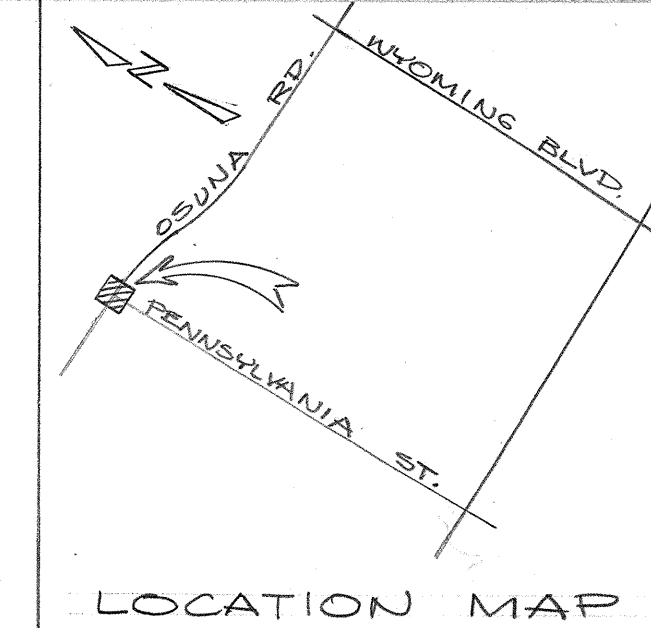


NOTES:

- Remove curb & gutter and sidewalk. Build new curb & gutter (quarter point elevations shown in box). Build wheelchair ramps & sidewalk.
- Build single "C" catch basin.
- Remove paving in intersection. Build arterial paving to grades shown.
- Install guard rail 34.75' long.
- Contractor shall verify horizontal and vertical location of underground utilities before installing storm drain lines. Lower water lines as necessary.
- Contractor shall notify Special Facilities (766-5080) 48 hours before construction starts.
- Adjust M.H. rim and valve boxes to new grade.

Exist smooth wire fence

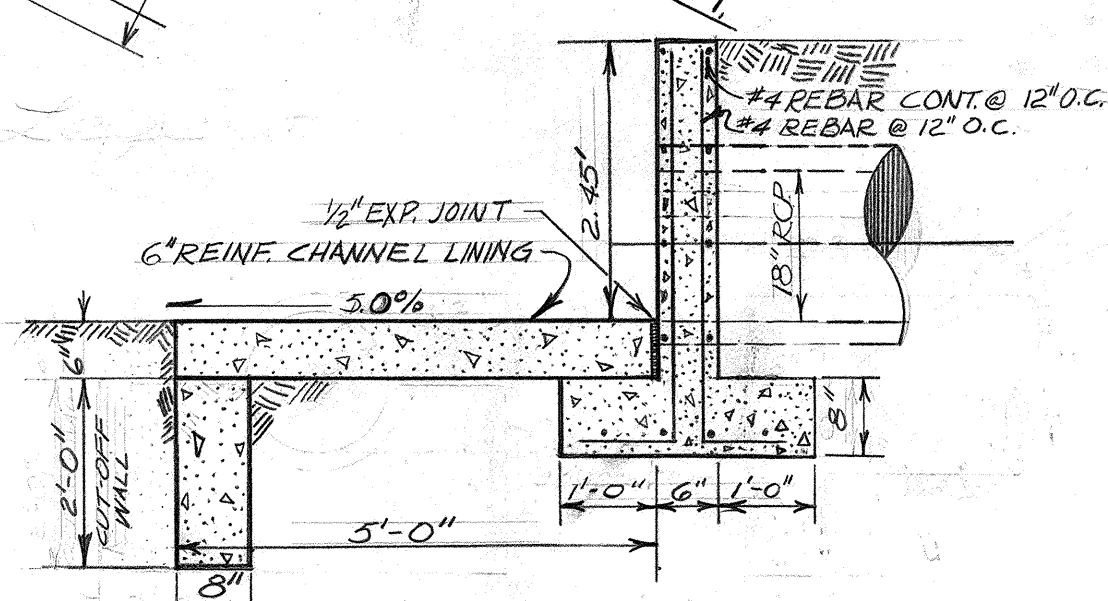


SECTION A-A
SCALE: 1"=2'

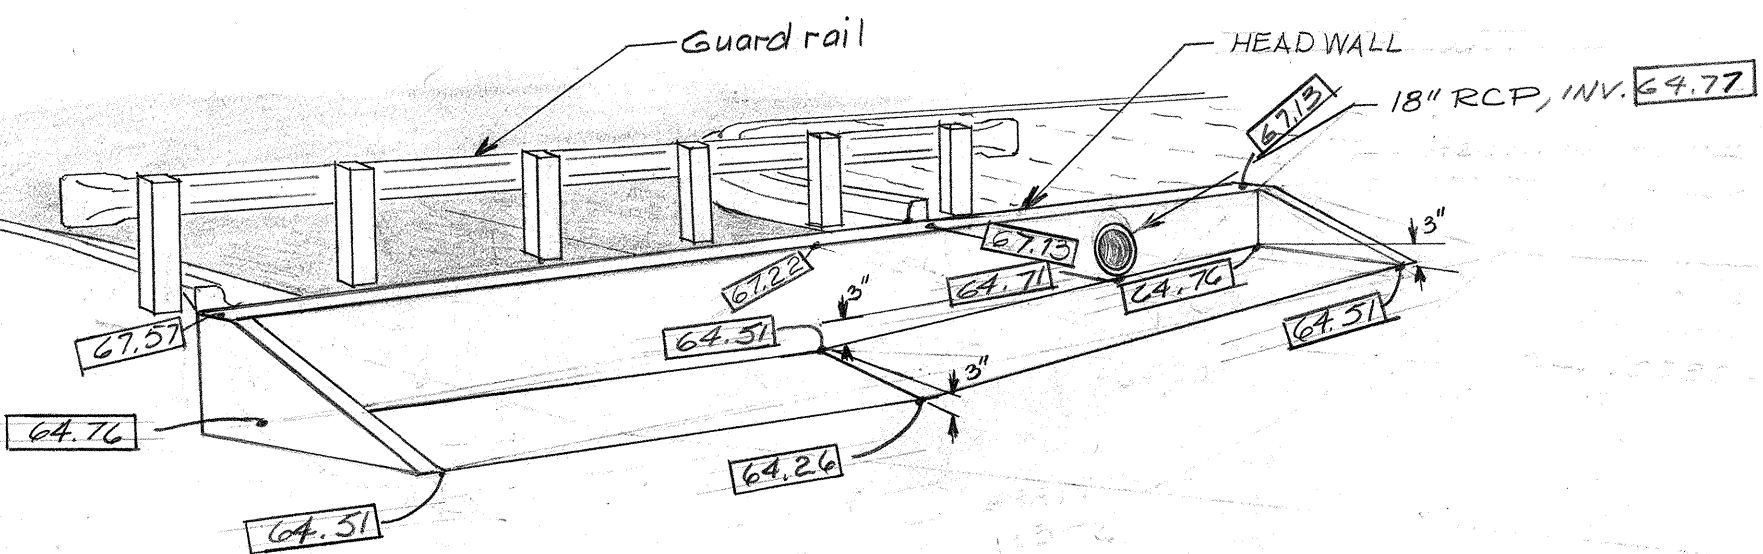

PERSPECTIVE VIEW OF ASPH. APRON

NOTE:
PARKS & RECREATION DEPT.
(AL BODER) AGREE'S TO
REMOVE AND RELAY SMOOTH
WIRE FENCE.

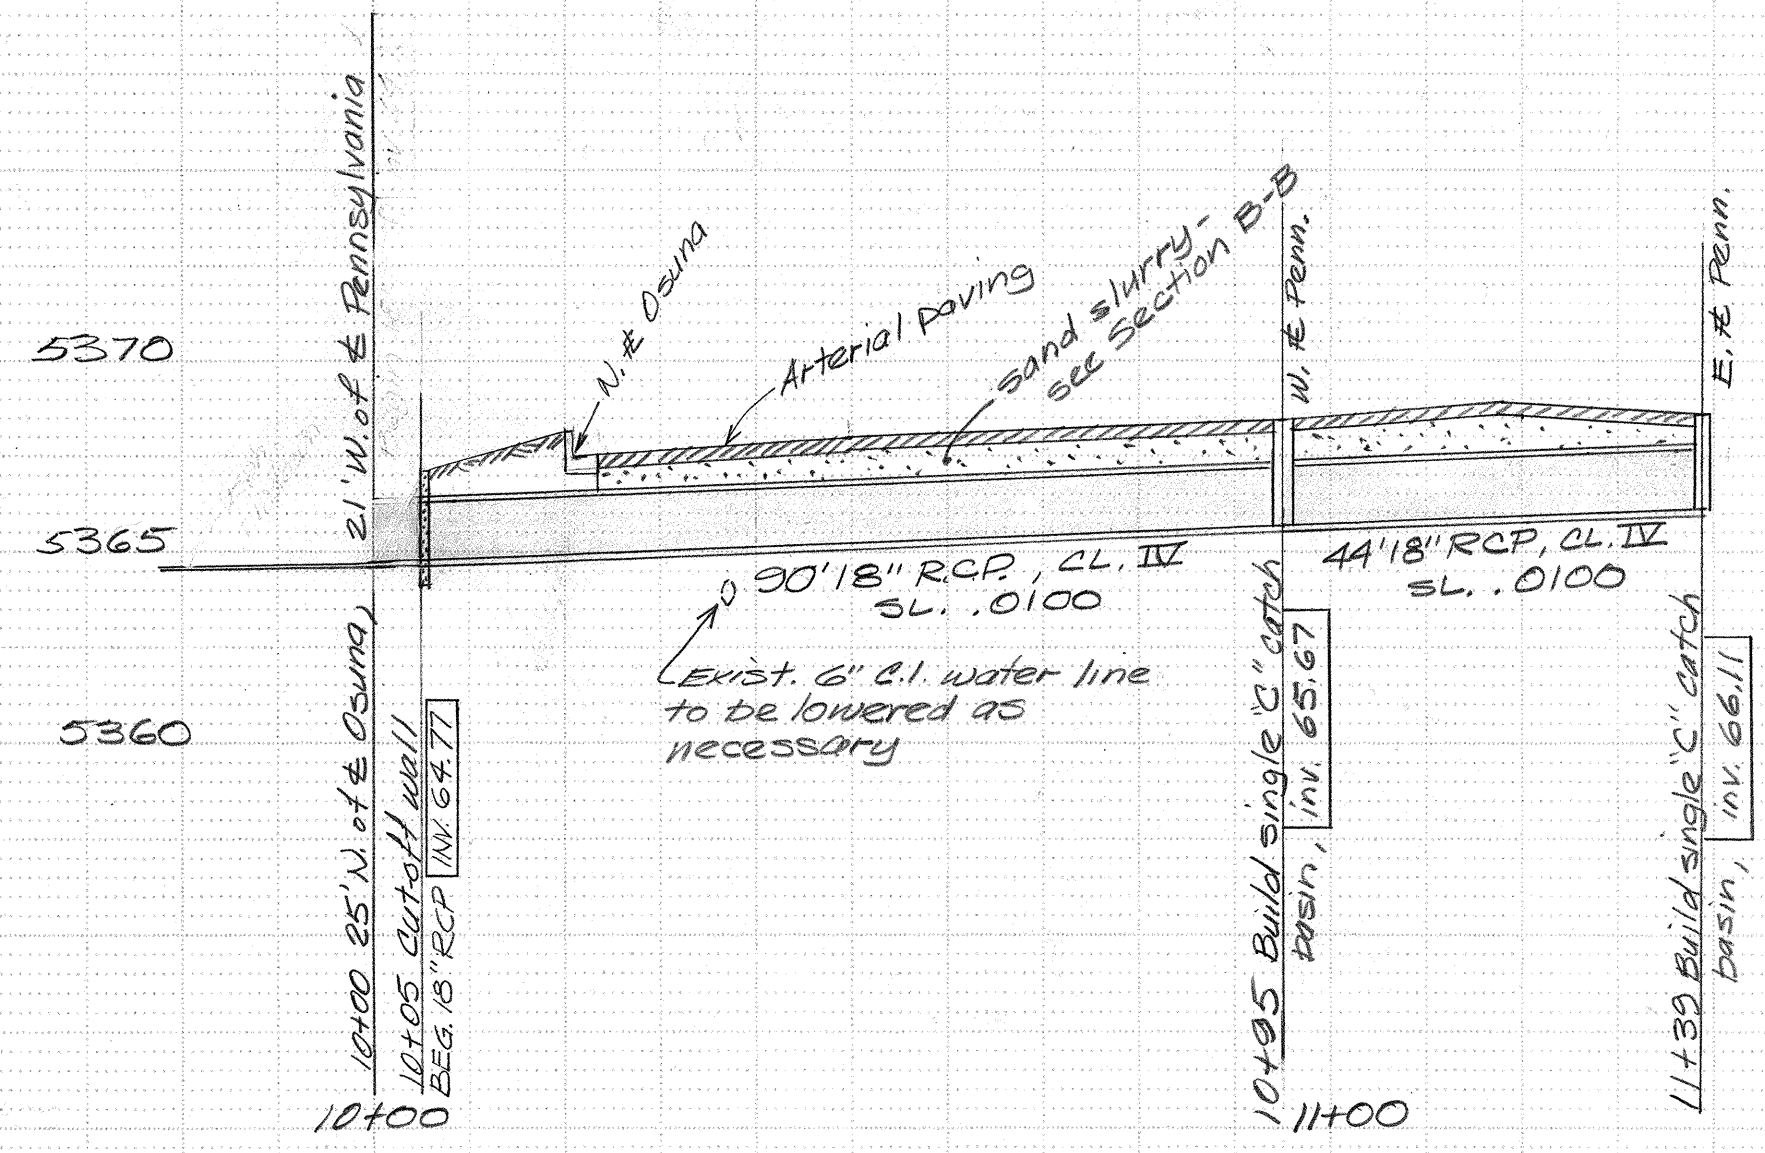

PROFILE "A"
18" STORM DRAIN

SCALE HOR. 1"=20'
VERT. 1"=5'




20 195 0229

APPROVED FOR
CONSTRUCTION
Richard S. Hill 3/30/81
CITY ENGINEER DATE


CITY OF ALBUQUERQUE PUBLIC WORKS DEPARTMENT ENGINEERING DIVISION				
TITLE: PENNSYLVANIA ST. & OSUNA RD. STORM DRAINAGE AND PAVING REPLACEMENT				
APPROVALS	ENGINEER	DATE	APPROVALS	ENGINEER
City Engineer	Richard S. Hill	9/23/80	Liquid Waste	
A.C.E. Design	A. J. Hill	1/29/81	Traffic	
A.C.E. Hydrology			Water	
Parks	M. Valles	9/21/80	ST. MAINT.	McPaul
DRAWING NO.	SD-29-195		SHEET	2 OF 2

SCALE: 1"=20'

00.00 FINISHED ELEVATION
 STORM DRAIN LINES
 L L L L LIMITS PAVING REMOVAL
 & REPLACEMENT
 WHEEL CHAIR RAMP

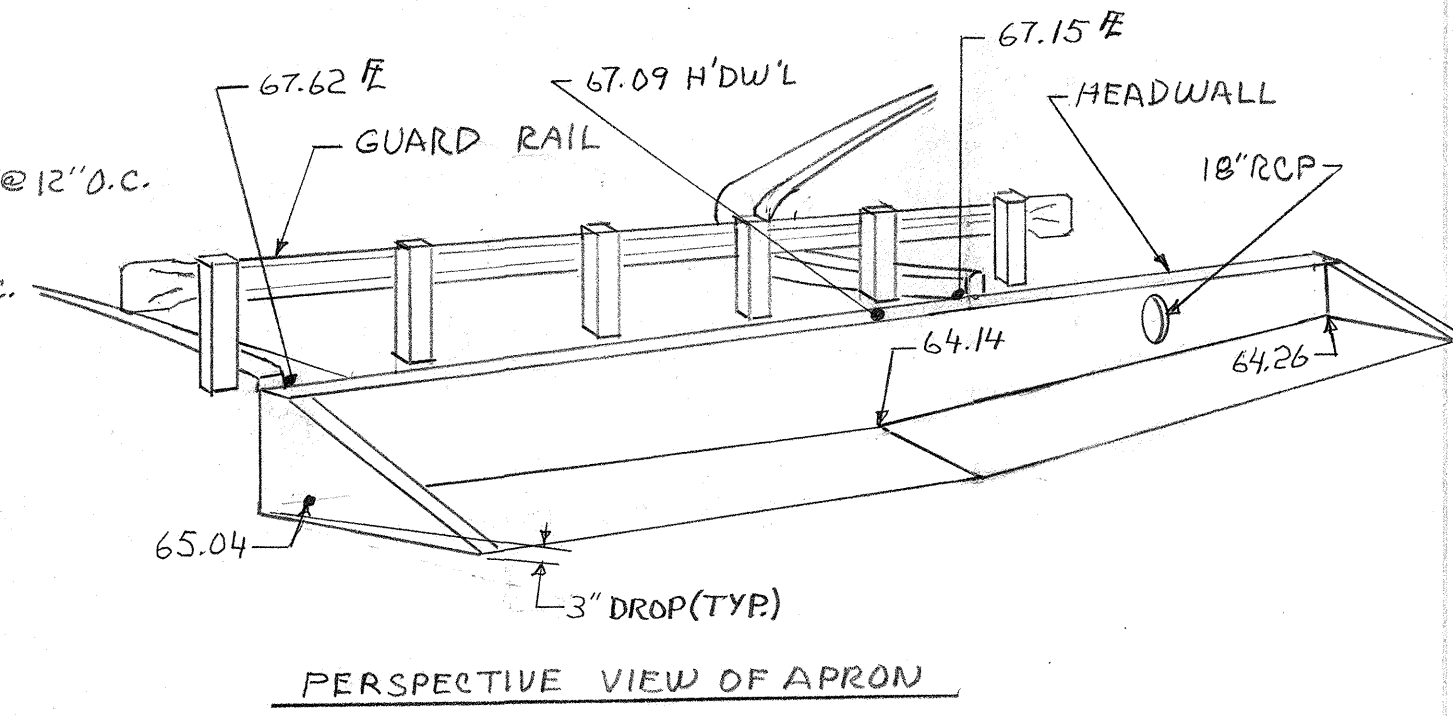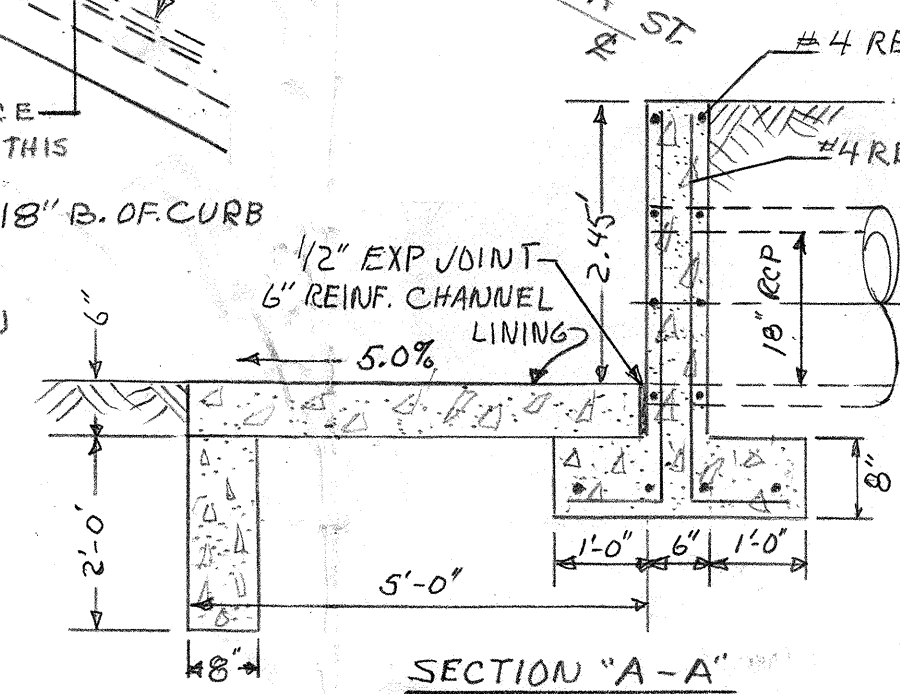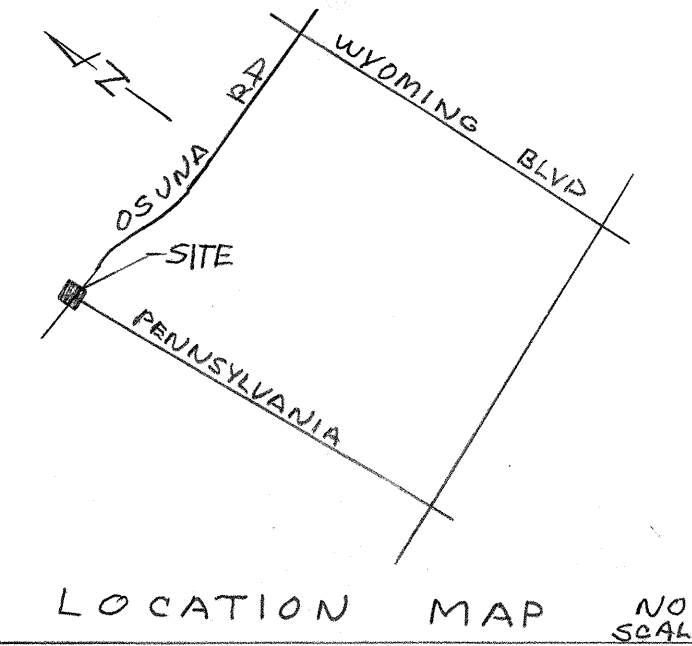

1. REMOVE CURB, GUTTER & SIDEWALK.
BUILD NEW CURB, GUTTER, SIDE-
WALK & WHEELCHAIR RAMPS.
2. BUILD SINGLE "C" CATCH BASINS
3. REMOVE PAVING IN INTERSECTION.
BUILD ARTERIAL PAVING.
4. INSTALL GUARD RAIL - 34.73'
LONG
5. CONTRACTOR SHALL VERIFY HORIZ &
VERTICAL LOCATION OF UNDER-
GROUND UTILITIES BEFORE INSTALL-
ING STORM DRAIN LINES. LOWER
WATER LINES AS NECESSARY.
6. CONTRACTOR SHALL NOTIFY
SPECIAL FACILITIES (766-5080)
48 HRS. PRIOR TO CONSTRUCT-
TION STARTS
7. ADJUST M.H. RIMS & VALVE
BOXES TO NEW GRADES

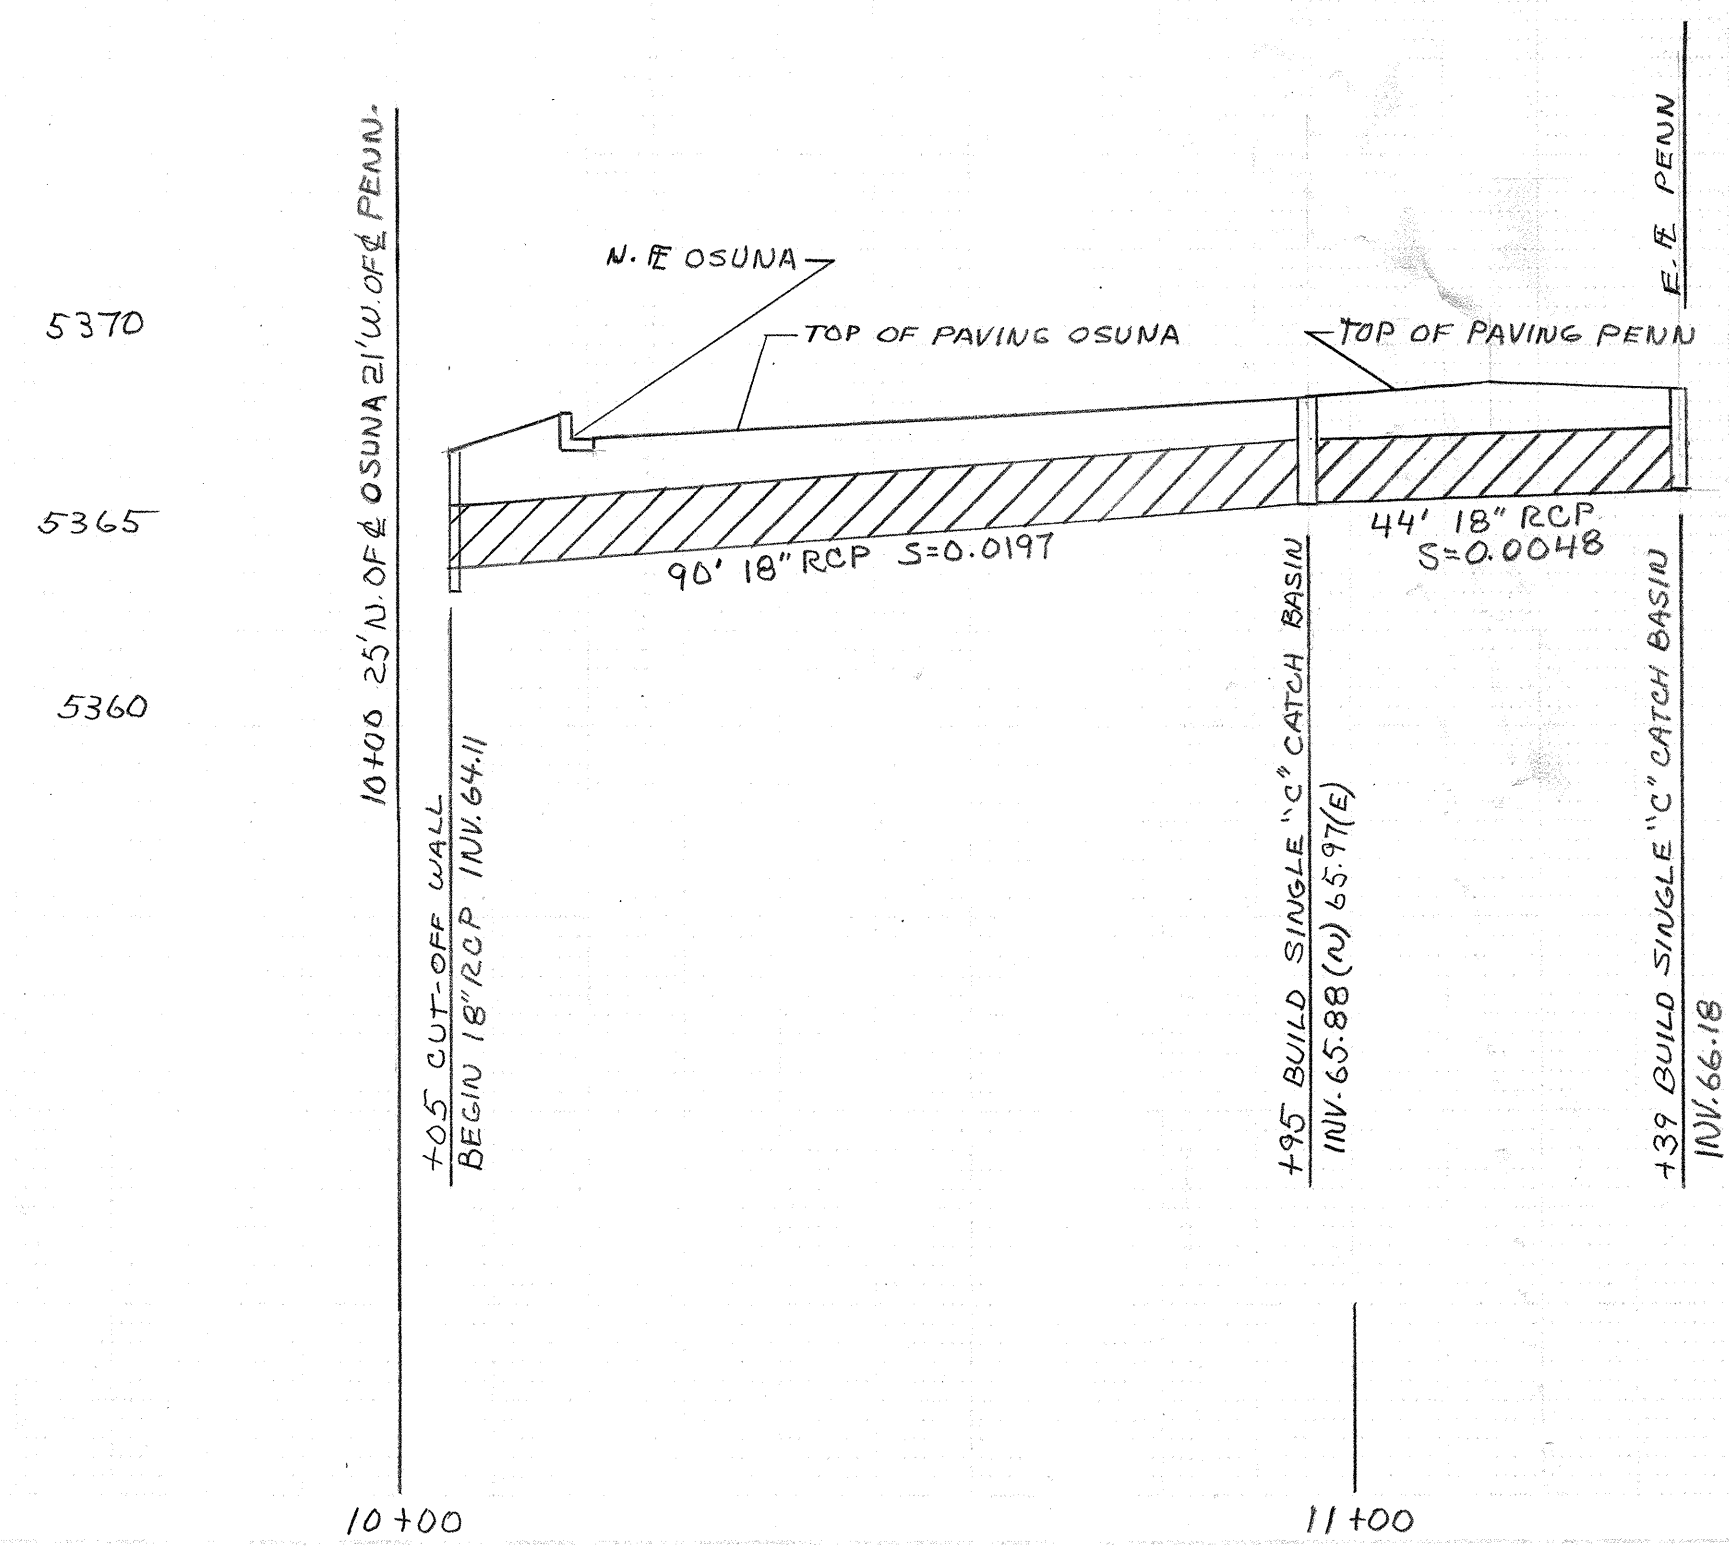

APPROVAL OF AS BUILT DRAWINGS
ASST. CITY ENGINEER - FIELD
[Signature]
DATE 3-16-82

1	2	3	4	5	6	7	8	9	10	11	12
2	0		1	9	5		0	1	2	9	

THIS "AS-BUILT" COMPILED FROM
FIELD NOTES & FIELD ENGINEER'S
INSTRUCTIONS. THIS IS FOR RECORD
PURPOSES.

TITLE: STORM DRAINAGE CONSTRUCTION & PAVING
REPLACEMENT AT INTERSECTION OF OSUNA RD
AND PENNSYLVANIA ST.

APPROVALS	ENGINEER	DATE	APPROVALS	ENGINEER	DATE
City Engineer			Liquid Waste		
A.C.E - Design			Electric		
A.C.E - Hydrology			Water		

DRAWING NO.	SD-29-195	MAP NO. F-19	SHEET 2A	OF 2
----------------	-----------	-----------------	-------------	---------