


0726019

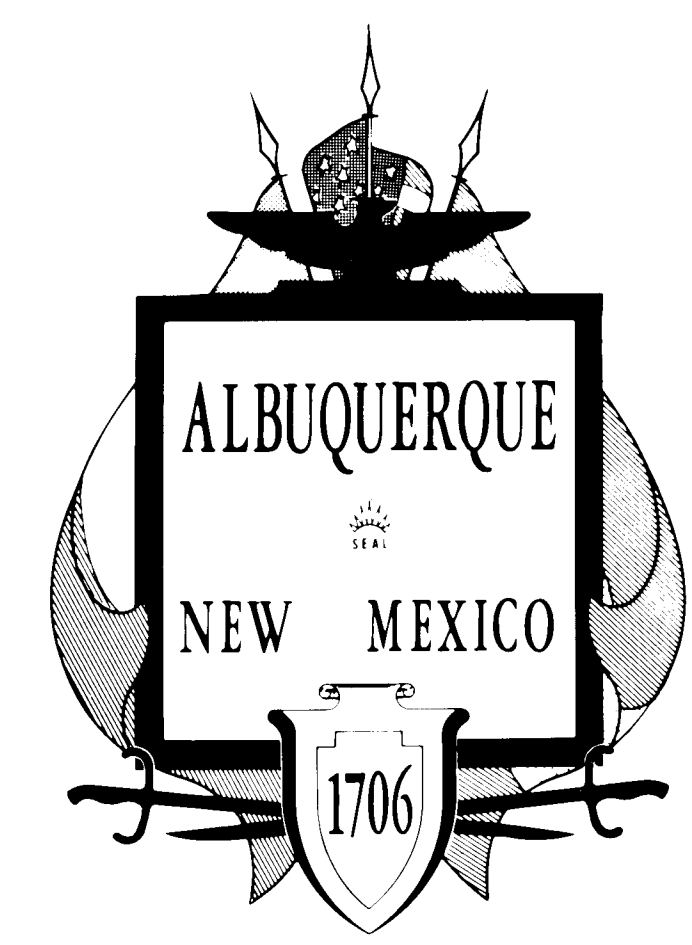


CITY OF ALBUQUERQUE, NEW MEXICO
DEPARTMENT OF TRANSPORTATION

MUNICIPAL ARTERIAL PROJECT
MAP-M-6019(900)
MDD PROJECT NO. 1960

RECONSTRUCTION AND WIDENING

YALE BOULEVARD S. E. - Stadium Blvd. S. E. to Gibson Blvd. S. E.

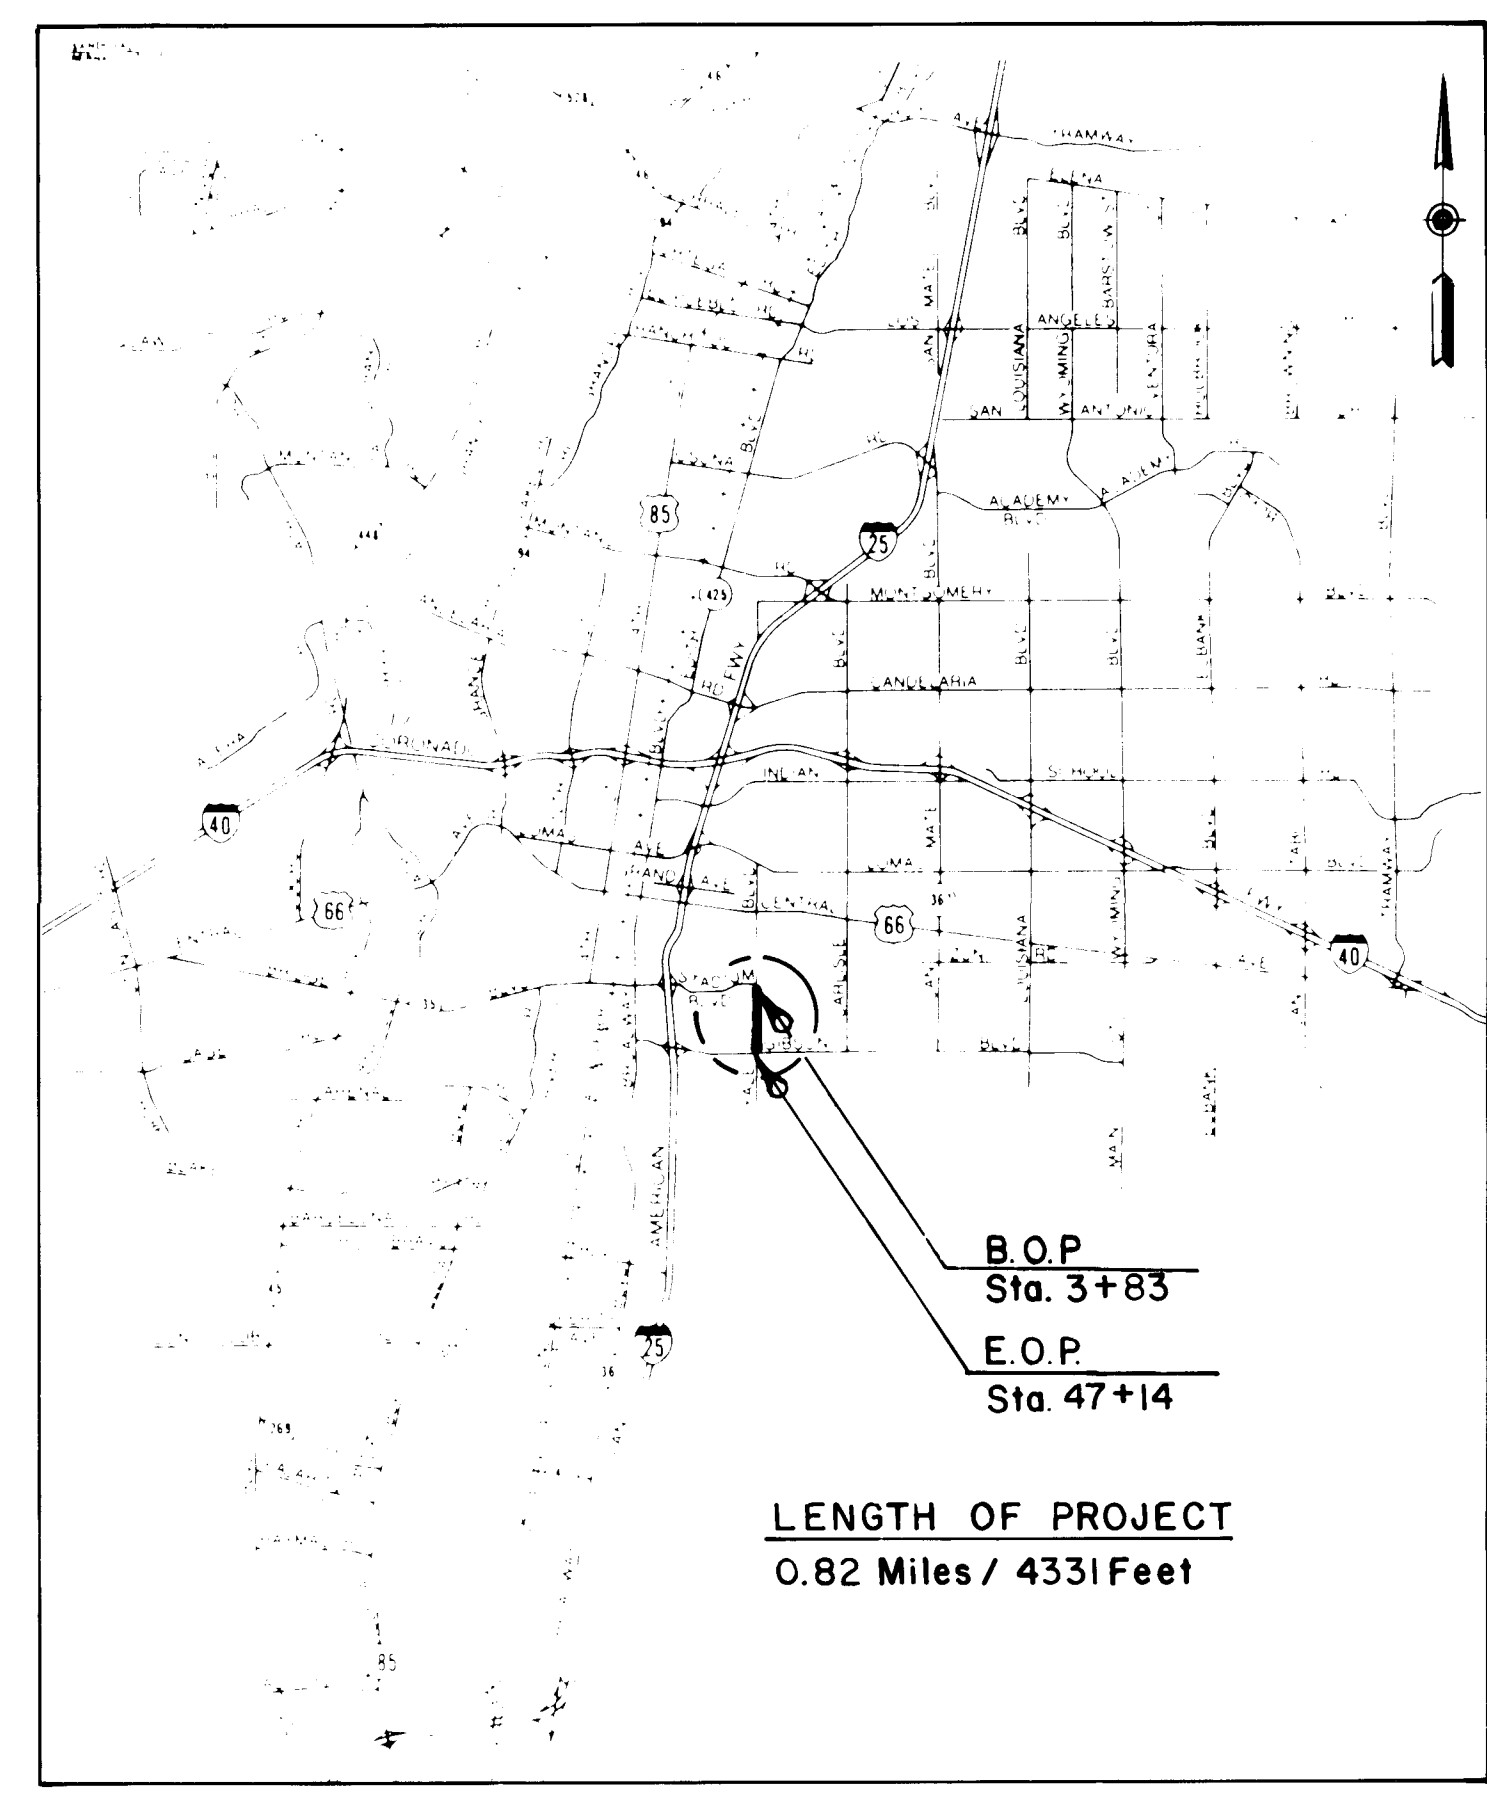

LOCATION MAP


INDEX			
SHT. NO.	DESCRIPTION	REV. DATE	SERIAL
1-1	COVER SHEET		
1-2	LOCATION MAP AND LEGEND		
1-3	GENERAL NOTES AND MISCELLANEOUS DETAILS		
1-4	TYPICAL ROADWAY SECTIONS		
2-1	SUMMARY OF QUANTITIES & SPECIAL PROVISIONS		
2-2	MISCELLANEOUS QUANTITIES		
2-3	PIT SHEET		
3-1 thru 3-4	YALE BLVD. PAVING-PLAN & PROFILE		
3-5 thru 3-8	YALE BLVD. UTILITIES-PLAN & PROFILE		
3-9	YALE BLVD. & STADIUM BLVD. INTERSECTION DETAILS		
3-10	YALE BLVD. & GIBSON BLVD. INTERSECTION DETAILS		
3-11 & 3-12	STORM DRAIN STRUCTURE DETAILS		
3-13 & 3-14	YALE BLVD WIDENING		
CONSTRUCTION TRAFFIC CONTROL			
4-1	SIGN FACE DETAILS		
4-2 & 4-3	PHASE I		
4-4 & 4-5	PHASE II		
4-6	PHASE II-A		
4-7	PHASE III		
4-8	PHASE IV		
4-9	PHASE IV-A		
4-10	PHASE IV-B		
4-11 thru 4-13	TRAFFIC CONTROL SUMMARY OF QUANTITIES		
STANDARD DRAWINGS			
5-1	DESIGN LOADS FOR SQUARE TUBING POSTS	8-6-80	SN 75-1
5-2	BARRICADES AND CHANNELIZATION DEVICES	3-15-80	SN 77-9
5-3	DESIGN LOADS FOR BREAKAWAY FLANGED CHANNEL POSTS	6-30-82	TBAC-001
5-4	DESIGN DETAILS FOR BREAKAWAY FLANGED CHANNEL POST & HARDWARE	6-29-82	TBAC-002
YALE BOULEVARD WATER & SANITARY SEWER WATER RESOURCES DEPARTMENT			
11-1	TITLE SHEET & GENERAL NOTES		
11-2 thru 11-5	YALE BOULEVARD WATER & SEWER REPLACEMENTS		
1 thru 3	YALE BOULEVARD SEWER		

PROJECT 1960


RECORD DRAWING		As-Built Revisions		G-SG WMA	
Drawings revised to reflect the best information available. Do not use without field verification.		No.		DATE BY	
REVISIONS (OR CHANGE NOTICES)					

Russell B. ...
1-15-87
26 19600187
EL ...
1/26/85
CHIEF HIGHWAY ADMINISTRATOR
STATE OF NEW MEXICO, HIGHWAY DEPARTMENT
C. D. ...
1/22/85
CITY ENGINEER, CITY OF ALBUQUERQUE
...
1-21-...
DIRECTOR, DEPARTMENT OF TRANSPORTATION
CITY OF ALBUQUERQUE
William S. Matotan
1/24/88
PREPARED BY WILLIAM MATOTAN & ASSOCIATES, INC.
DATE
Frank G. ...
1/24/88
MAYOR, CITY OF ALBUQUERQUE, NEW MEXICO
DATE



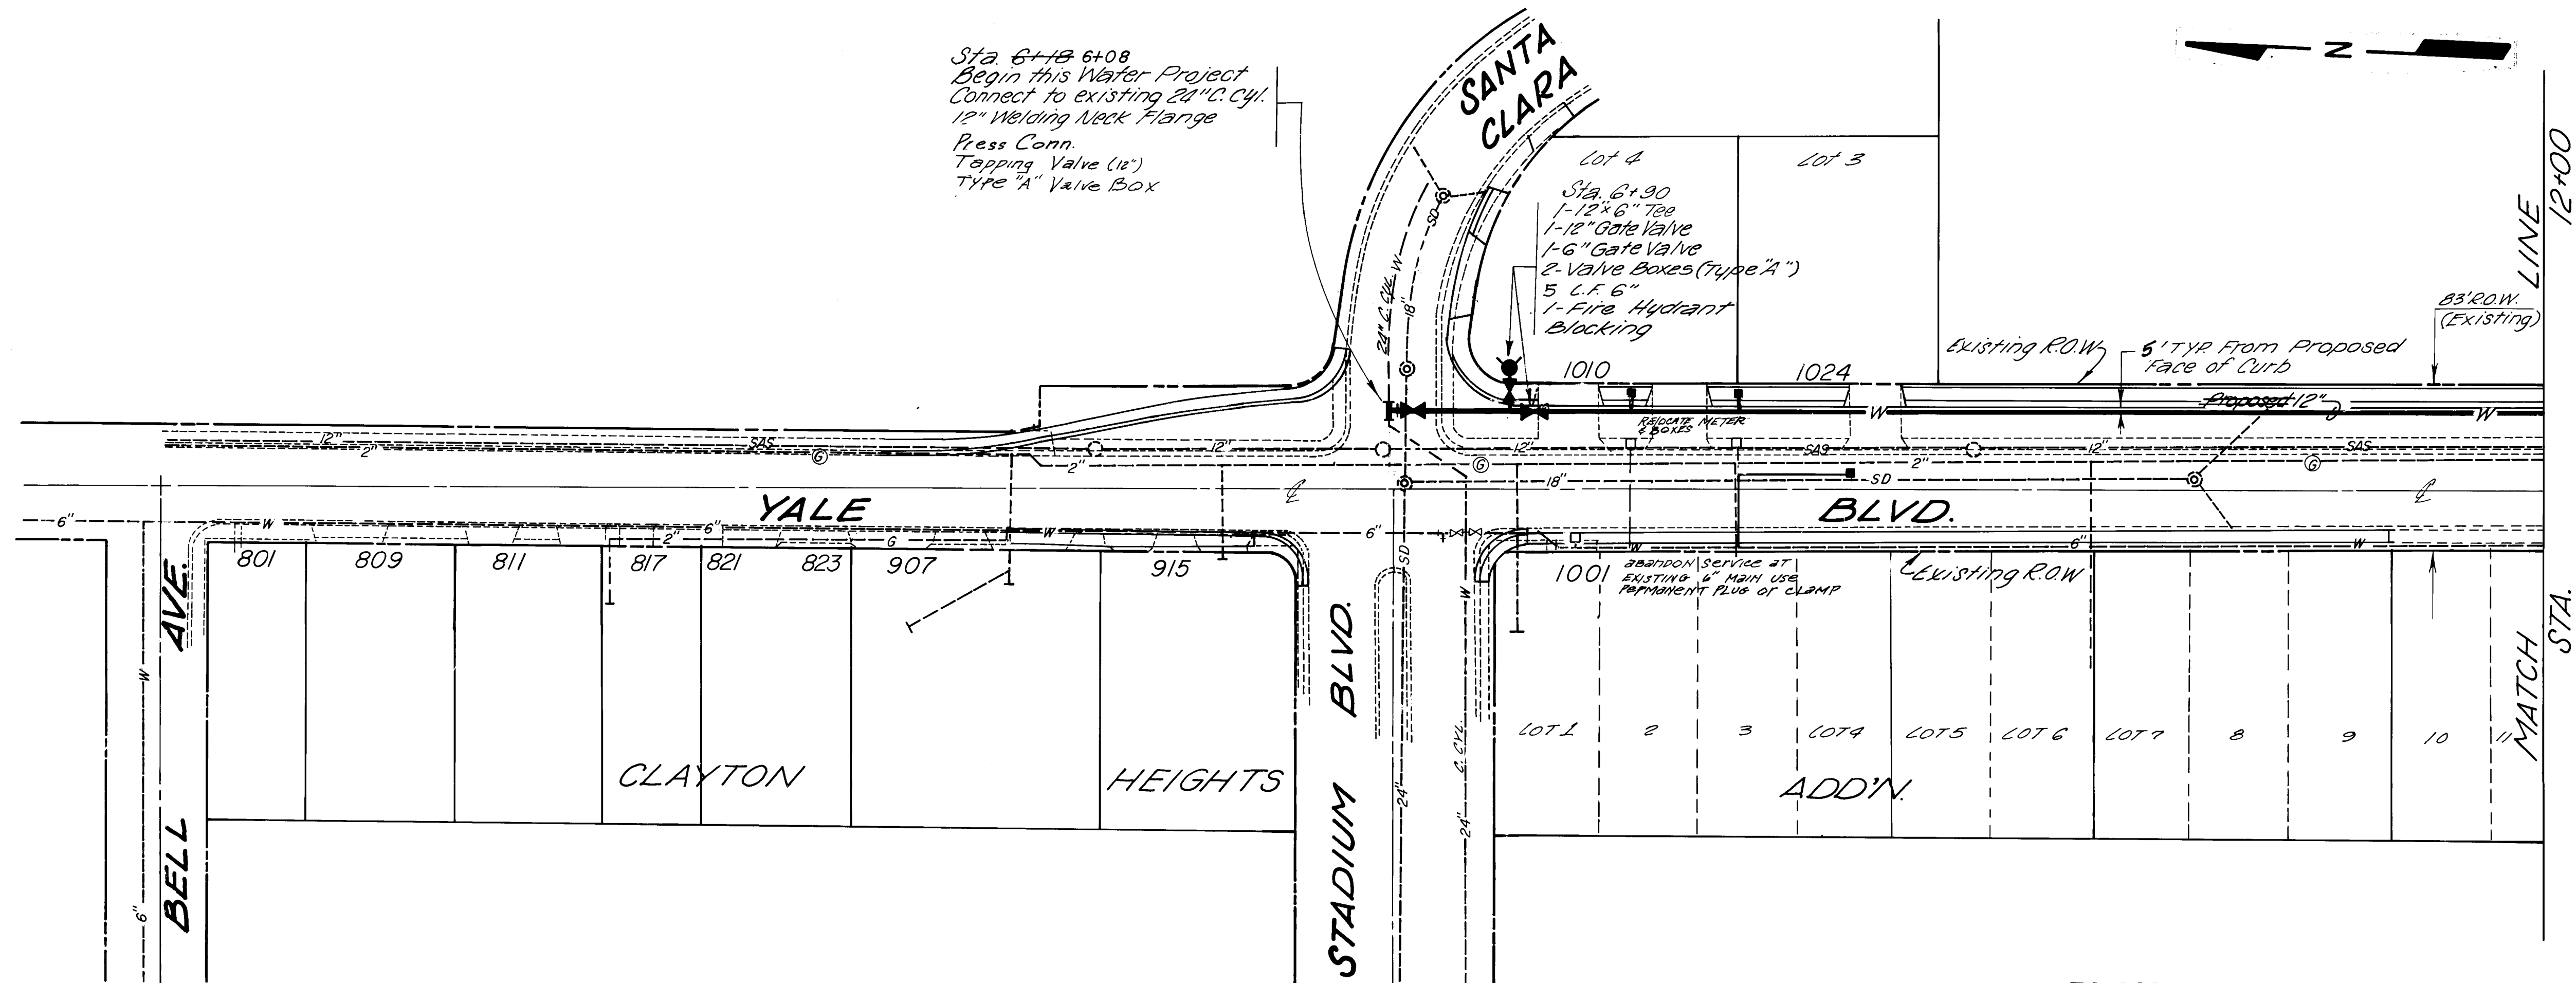

PLAN
SCALE: 1"=50'
PROFILE
SCALE: 1"=50' HORIZ.
1"=5' VERT.


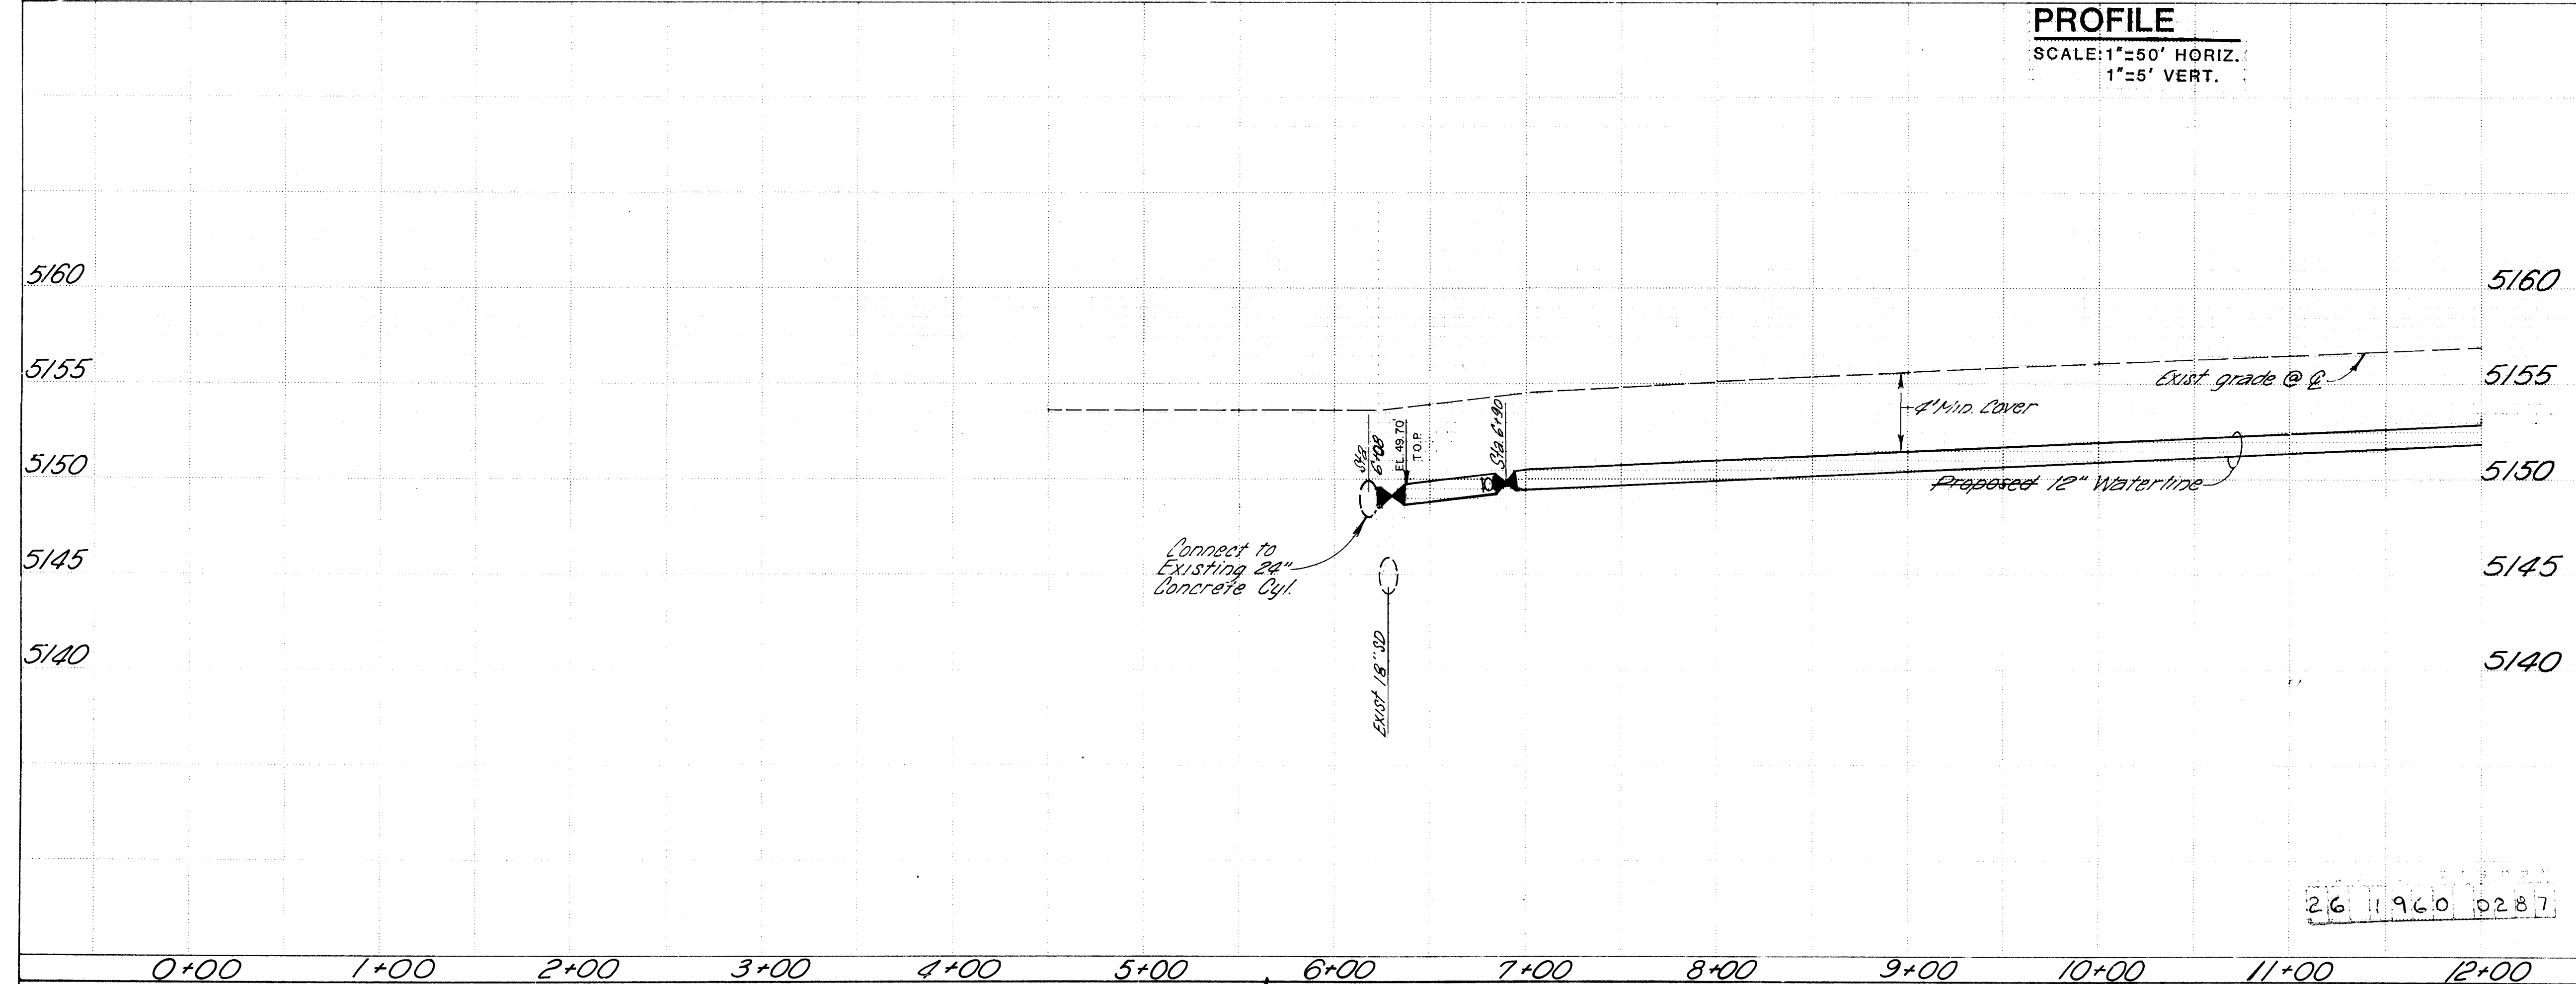


See General Notes on
Sht. II-1 of 5

AS-BUILT OF WATER &
SANITARY SEWER ONLY
AUGUST 1986

CITY OF ALBUQUERQUE WATER RESOURCES DEPARTMENT ENGINEERING DIVISION							
TITLE: YALE BOULEVARD WATER AND SEWER REPLACEMENTS							
APPROVALS	ENGINEER	DATE	APPROVALS	ENGINEER	DATE		
City Engineer			Liquid Waste	R. Pina	1/14/85		
A.C.E. - Design			Traffic	N.A. Pina	1-21-85		
A.C.E. - Hydrology			Water	R. Pina	1/14/85		
DESIGNED BY: MT				DATE: AUG 84			
DRAWN BY: MT/UP				DATE: AUG 84			
CHECKED BY:				DATE:			
DRAWING NO.		MAP NO.		SHEET		OF	
L-16				II-2		5	

ENGINEER'S SEAL			SURVEY INFORMATION		BENCH MARKS		AS BUILT INFORMATION	
 <i>Andrew J. Pappalardo</i>			FIELD NOTES		No 1-L16 Located in N.E. curb return at the intersection of Yale & Ross Elev. - 5176.097		CONTRACT NO. 100-10000	
			NO BY DATE				NO. DATE	
REMARKS			BY		No 2-L16 Located in E.N.E. curb return at the intersection of Yale & Kathryn Elev-5162.66		INSPECTED BY W.U.D. DATE	
NO. DATE							FIELD CORRECTION BY W.U.D. DATE	
DESIGN					MICRO-FILM INFORMATION		RECORDED BY DATE	
DESIGNED BY MT DATE AUG. 84							NO	
DRAWN BY MT/LJP					No 1-M16 Located in the middle of the intersection of Yale & Gibson Elev.-5190.03		DATE	
CHECKED BY DATE							NO	

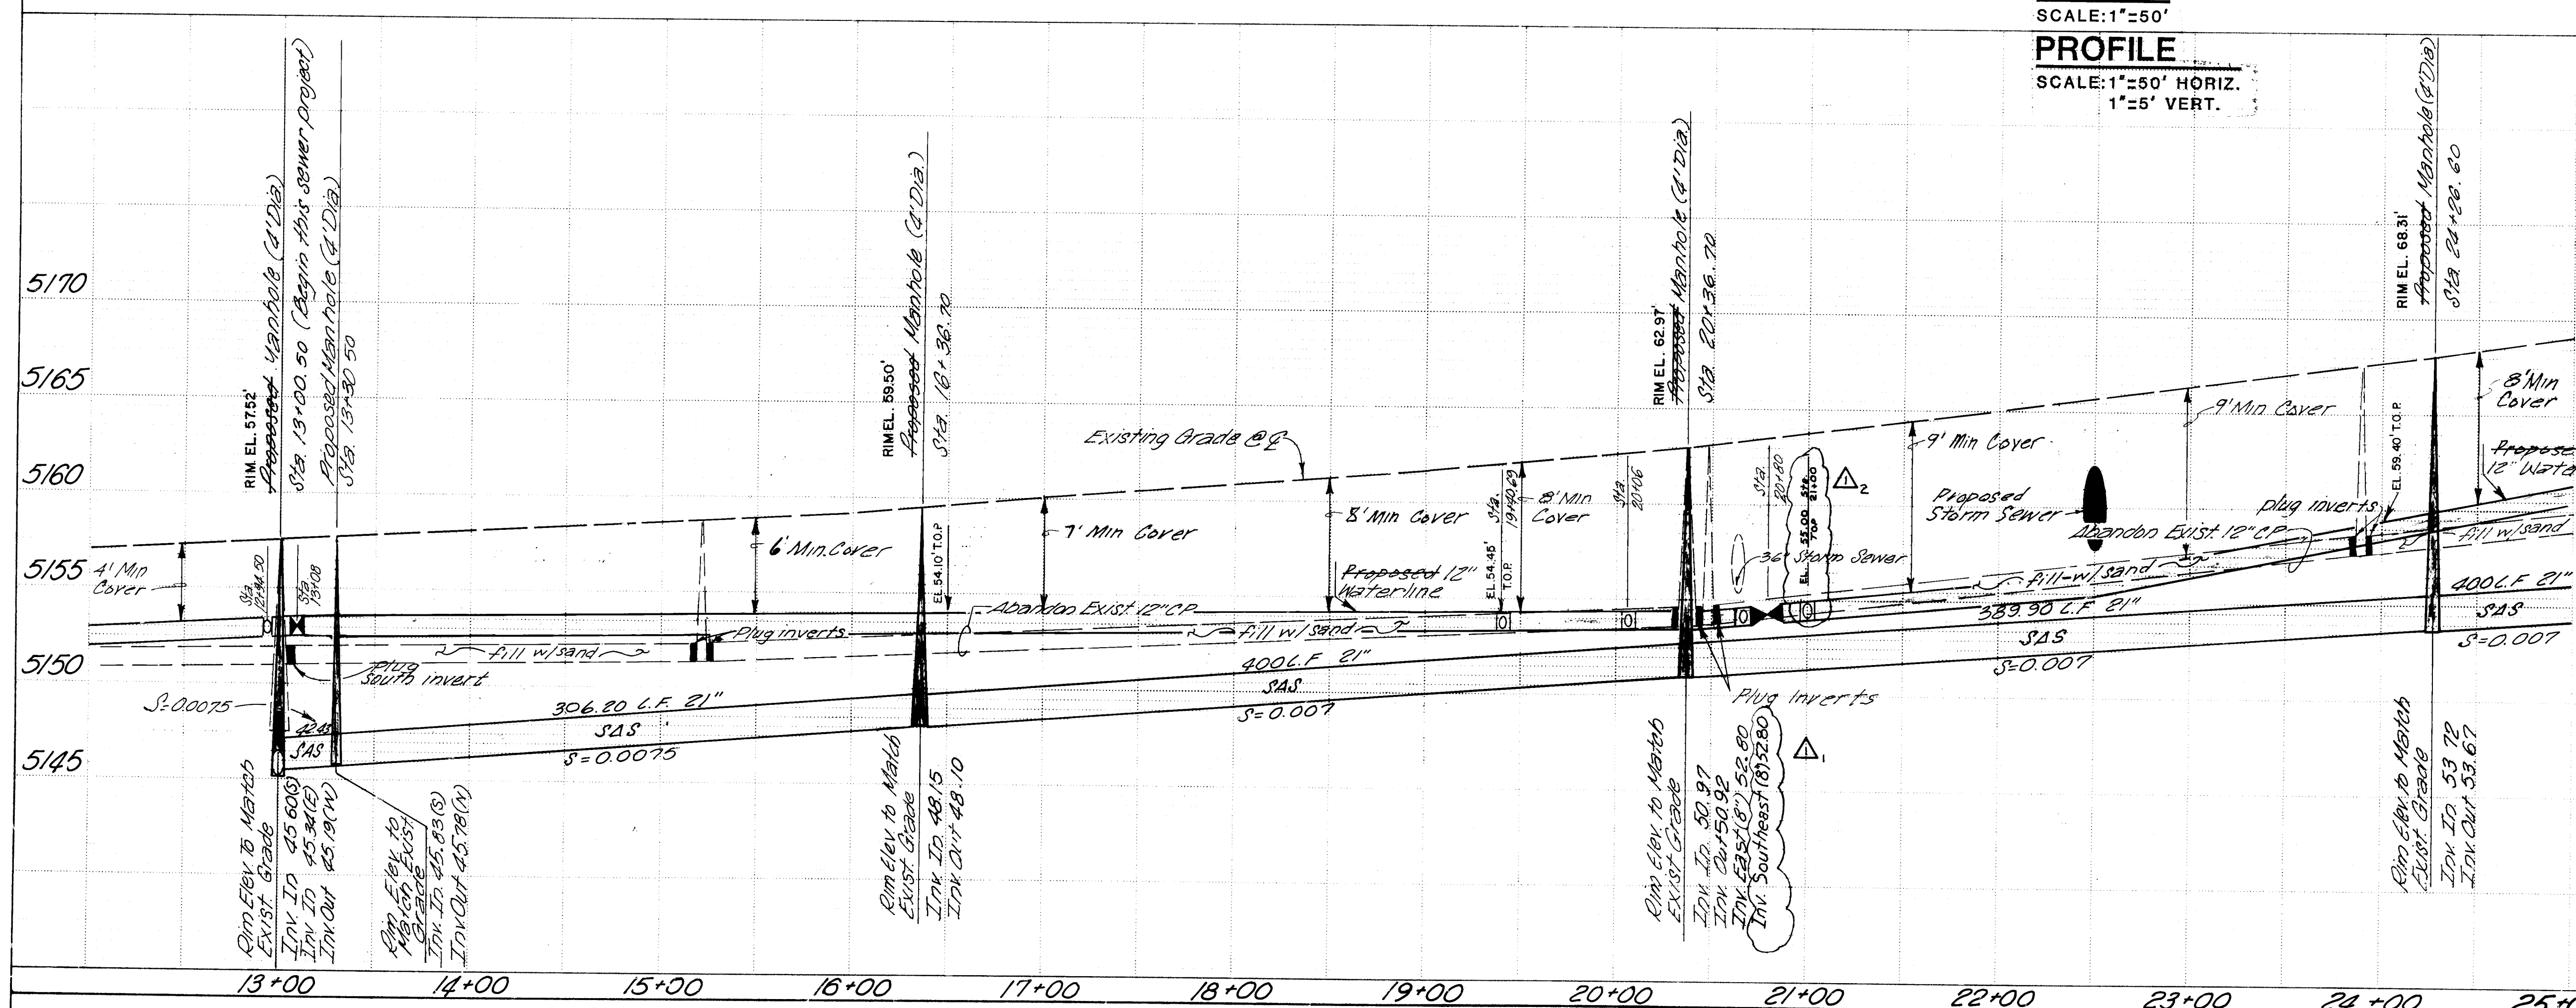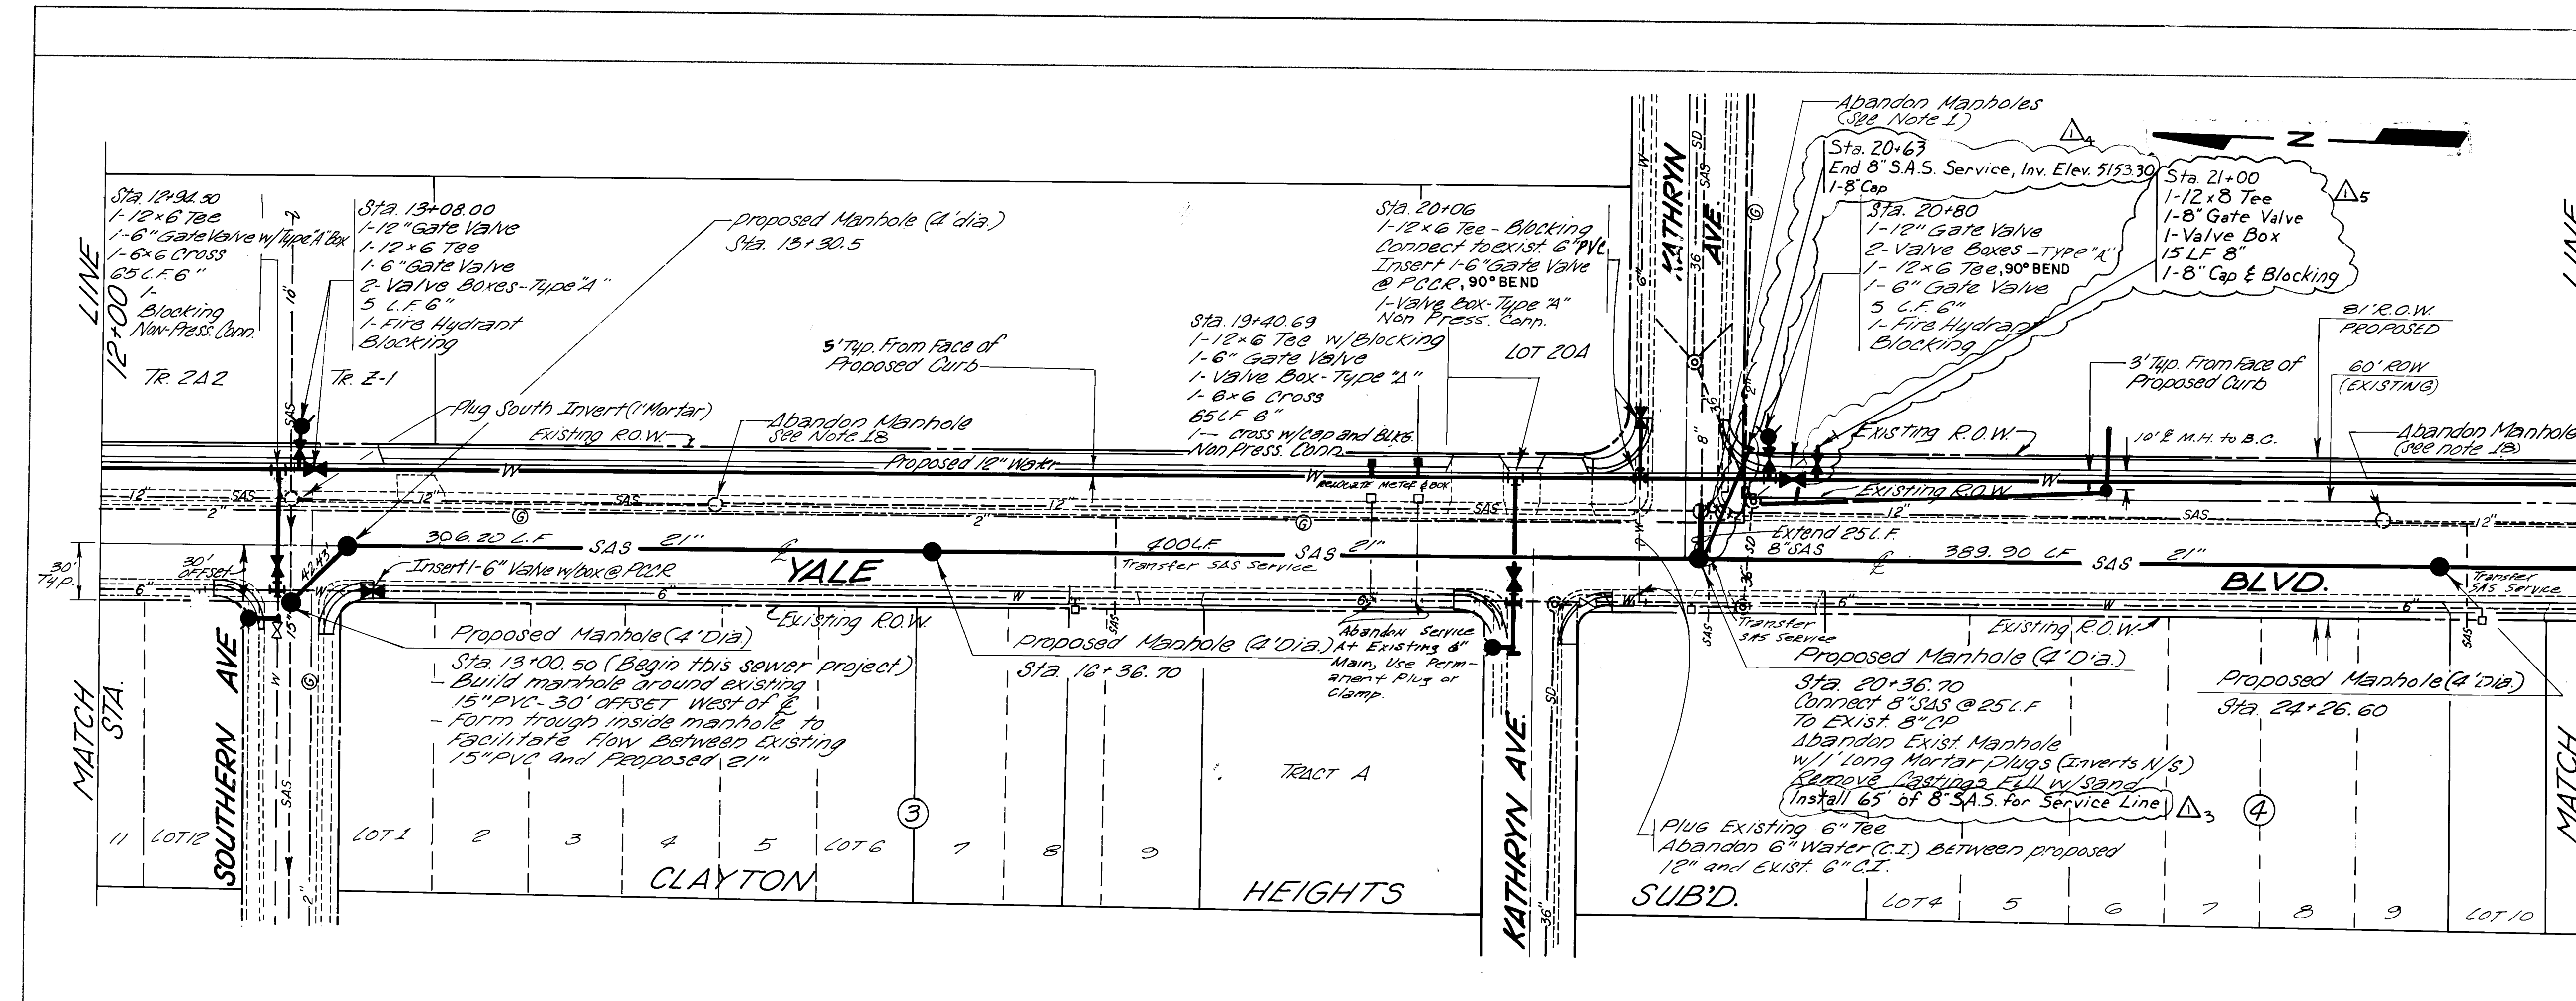

NOTE:

ABANDONMENT OF EXISTING 12" CP SAS LINE AND MANHOLES WILL BE DONE BY FILLING LINE WITH SAND AND PLUGGING INVERTS WITH 1' LONG MORTAR PLUGS, BREAKUP BOTTOM OF MANHOLE, FILL MANHOLE WITH SAND AND REMOVE AND RETURN CASTINGS AND LIDS TO THE CITY YARDS.

See General Notes on Sht. II-1 of 5

BLOCKING TYPICAL

AS-BUILT OF WATER & SANITARY SEWER ONLY AUGUST 1986.

CITY OF ALBUQUERQUE
WATER RESOURCES DEPARTMENT
ENGINEERING DIVISION

TITLE: YALE BOULEVARD WATER AND SEWER REPLACEMENTS

APPROVALS	ENGINEER	DATE	APPROVALS	ENGINEER	DATE
City Engineer			Liquid Waste	R. Pina	1/14/85
A-E Design	H. L. Lina	1/21/85	Traffic	M. R. R. R.	1-21-85
A-E Hydrology	D. H. H.	1/14/85	Water	R. Pina	1/14/85

DESIGNED BY: MT
DRAWN BY: MT/LF
CHECKED BY:

REVISIONS:

NO.	DATE	REMARKS
1	6-24-85	Water and Sanitary Services added

AS BUILT INFORMATION:



CONTRACTOR	INSPECTOR	DATE	W.U.D.	DATE	W.U.D.	DATE

AS BUILT INFORMATION:

NO.	DATE	REMARKS
No. 1-L16	Located in N.E. curb return at the intersection of Yale & Ross	Elev. - 5176.097
No. 2-L16	Located in E.N.E. curb return at the intersection of Yale & Kathryn	Elev. 5162.66
No. 1-M16	Located in the middle of the intersection of Yale & Gibson	Elev. - 5190.03

DRAWING NO: L-16
MAP NO: L-16
SHEET: II-3
OF: 5

26 1960 0387

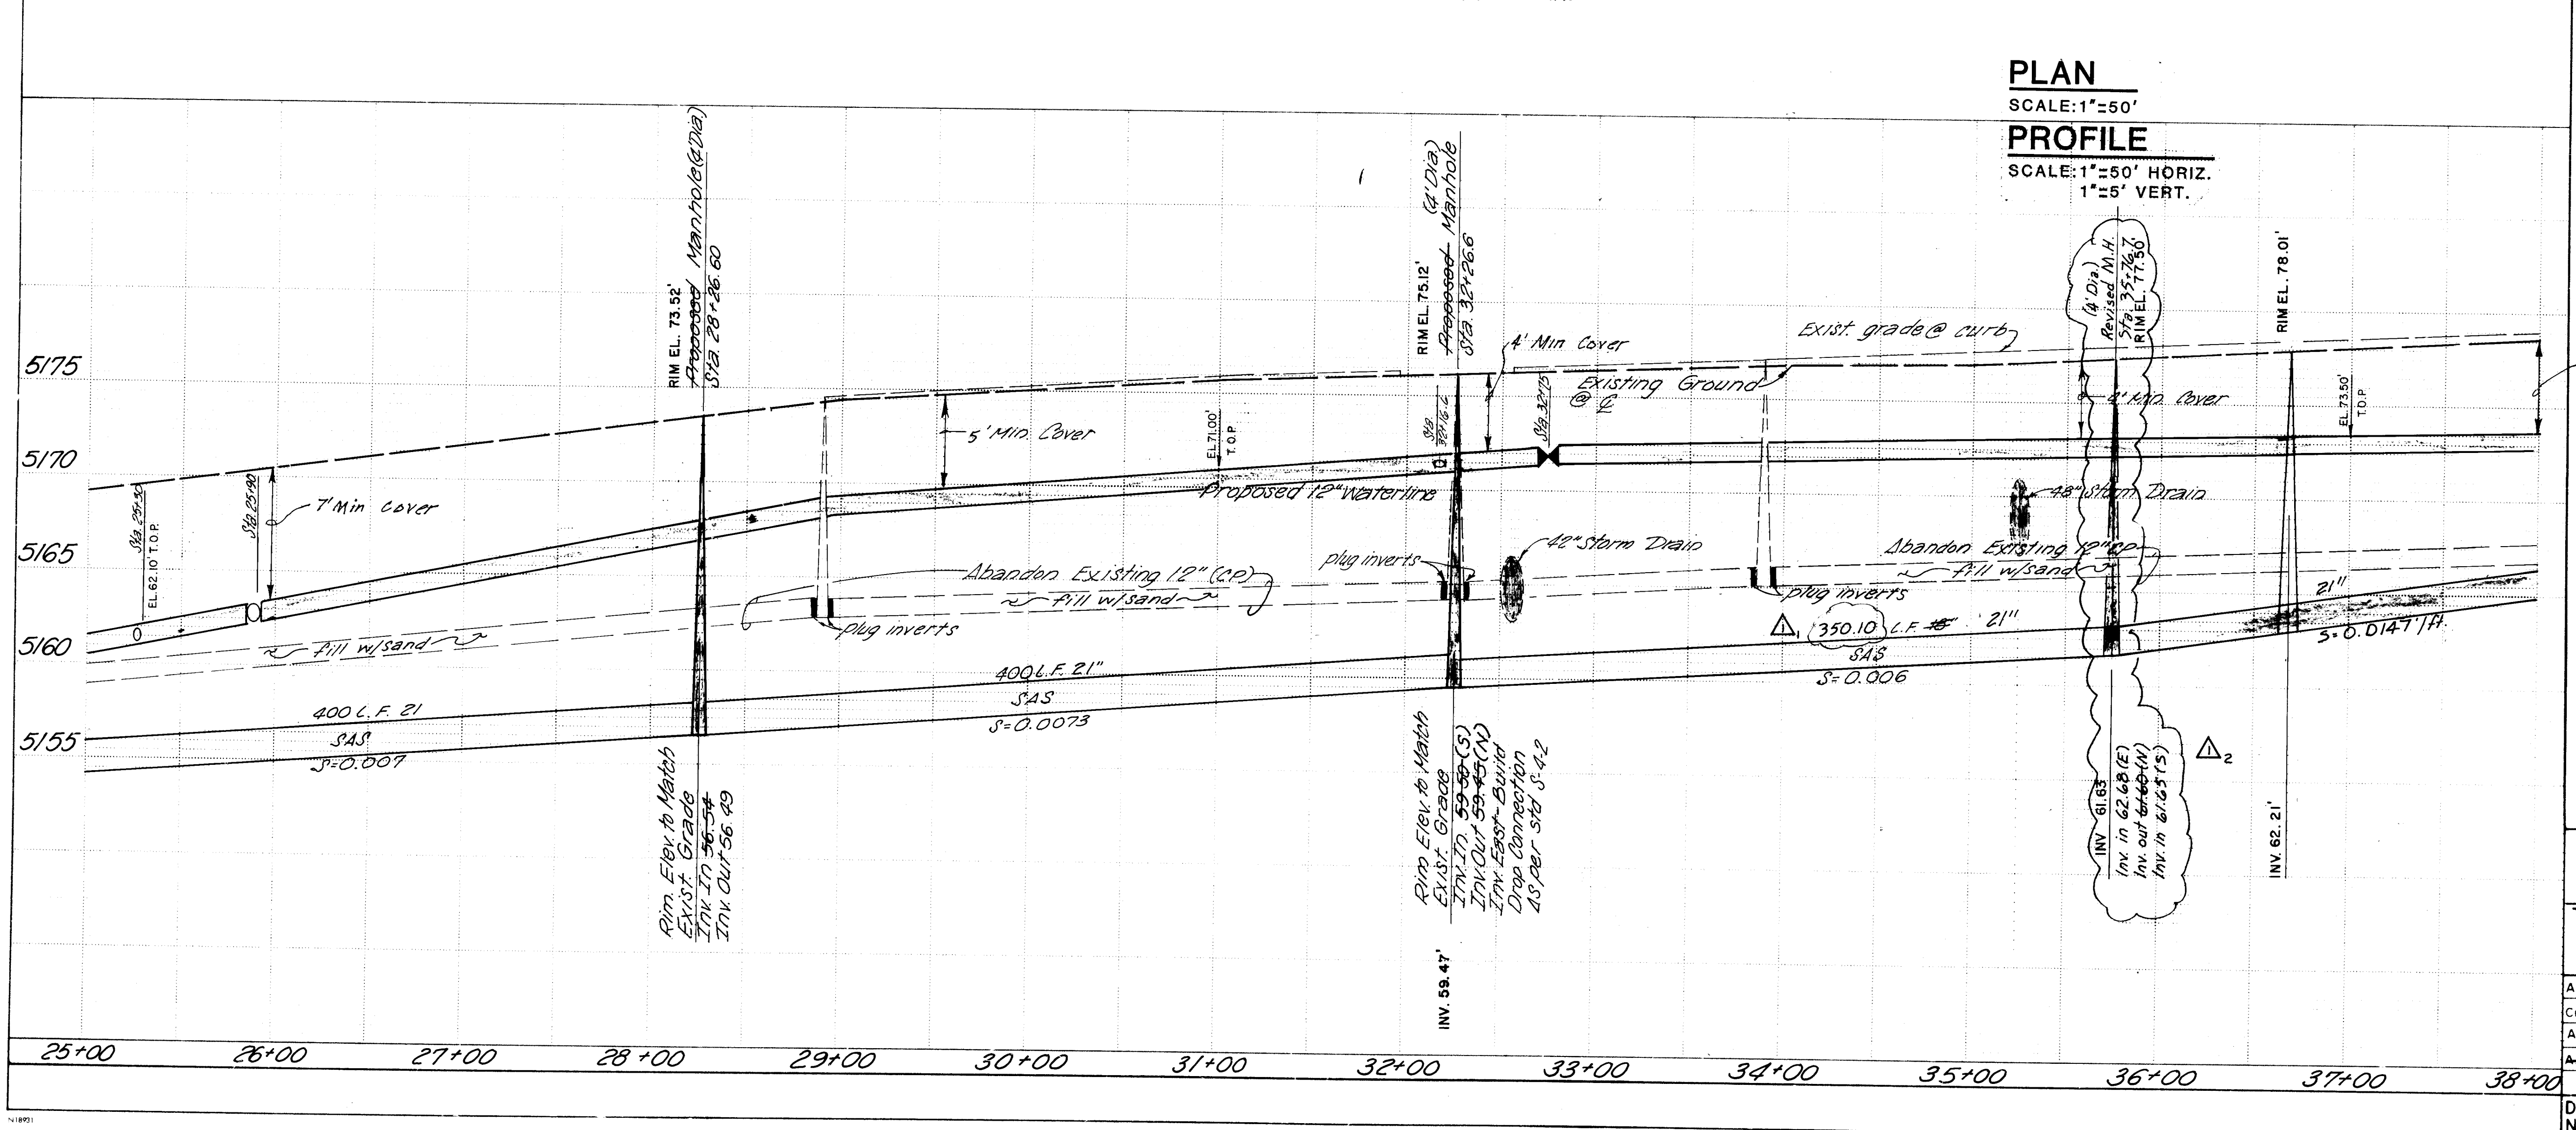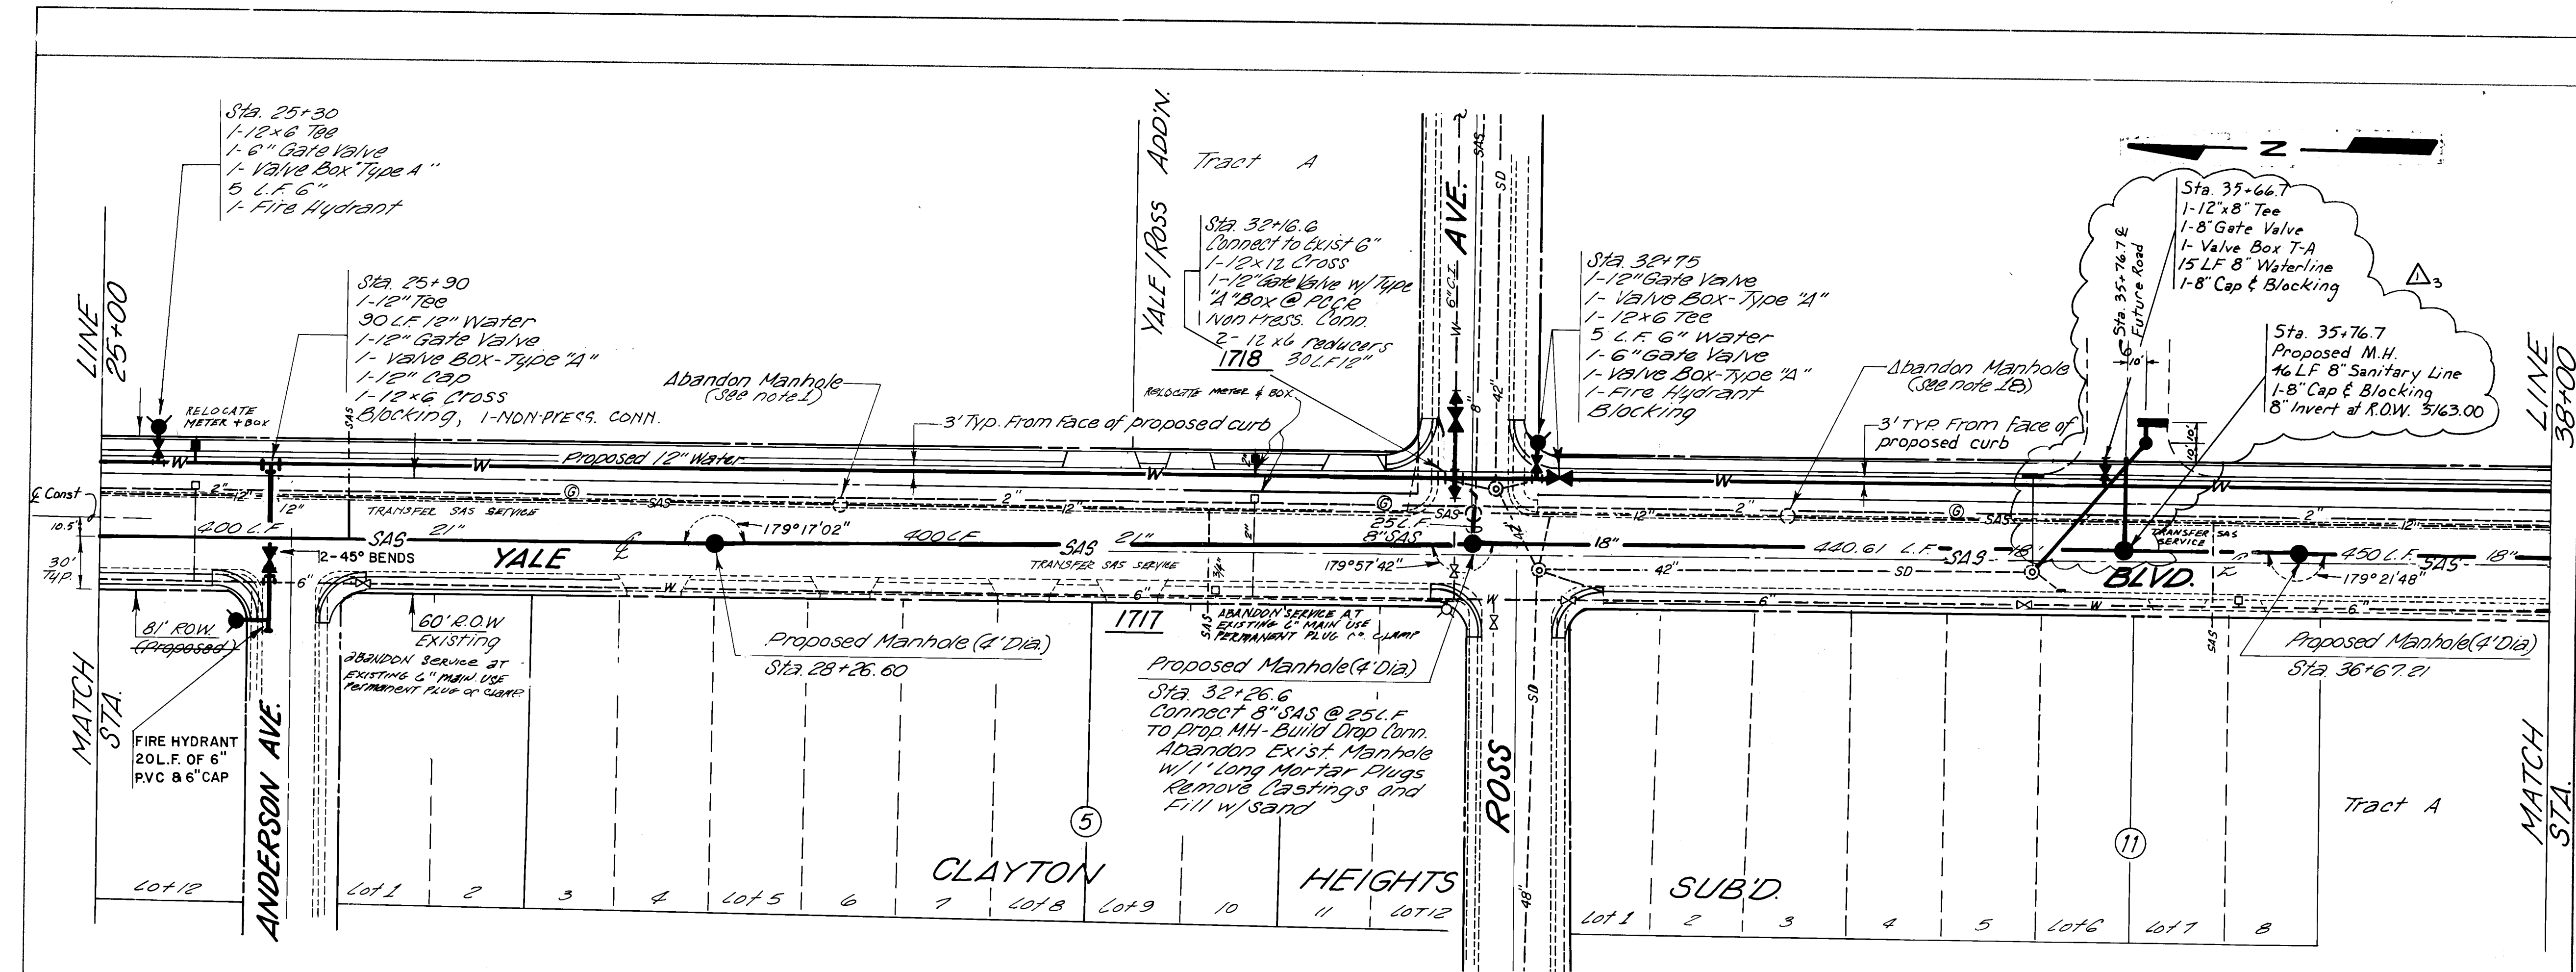

NOTE:
ABANDONMENT OF EXISTING 12" CP SAS LINE AND MANHOLES WILL BE DONE BY FILLING LINE WITH SAND AND PLUGGING INVERTS WITH 1' LONG MORTAR PLUGS, BREAKUP BOTTOM OF MANHOLE, FILL MANHOLE WITH SAND AND REMOVE AND RETURN CASTINGS AND LIDS TO THE CITY YARDS.

See General Notes on Sht II-1 of 5



AS BUILT INFORMATION			BENCH MARKS			SURVEY INFORMATION			ENGINEER'S SEAL		
DATE	BY	NO.	DATE	BY	NO.	DATE	BY	NO.	DATE	BY	NO.
11/14/85	R. Pina	1	11/14/85	R. Pina	1	11/14/85	R. Pina	1	11/14/85	R. Pina	1
11/14/85	R. Pina	2	11/14/85	R. Pina	2	11/14/85	R. Pina	2	11/14/85	R. Pina	2
11/14/85	R. Pina	3	11/14/85	R. Pina	3	11/14/85	R. Pina	3	11/14/85	R. Pina	3

CITY OF ALBUQUERQUE
WATER RESOURCES DEPARTMENT
ENGINEERING DIVISION

TITLE:
YALE BOULEVARD
WATER AND SEWER
REPLACEMENTS

APPROVALS	ENGINEER	DATE	APPROVALS	ENGINEER	DATE
City Engineer	R. Pina	11/14/85	Liquid Waste	R. Pina	11/14/85
ACE-Design	N. P. Pina	11/14/85	Traffic	N. P. Pina	11/14/85
ACE-Hydrology	N. P. Pina	11/14/85	Water	N. P. Pina	11/14/85

DRAWING NO. 1-16 **MAP NO.** L-16 **SHEET** II-4 **OF** 5

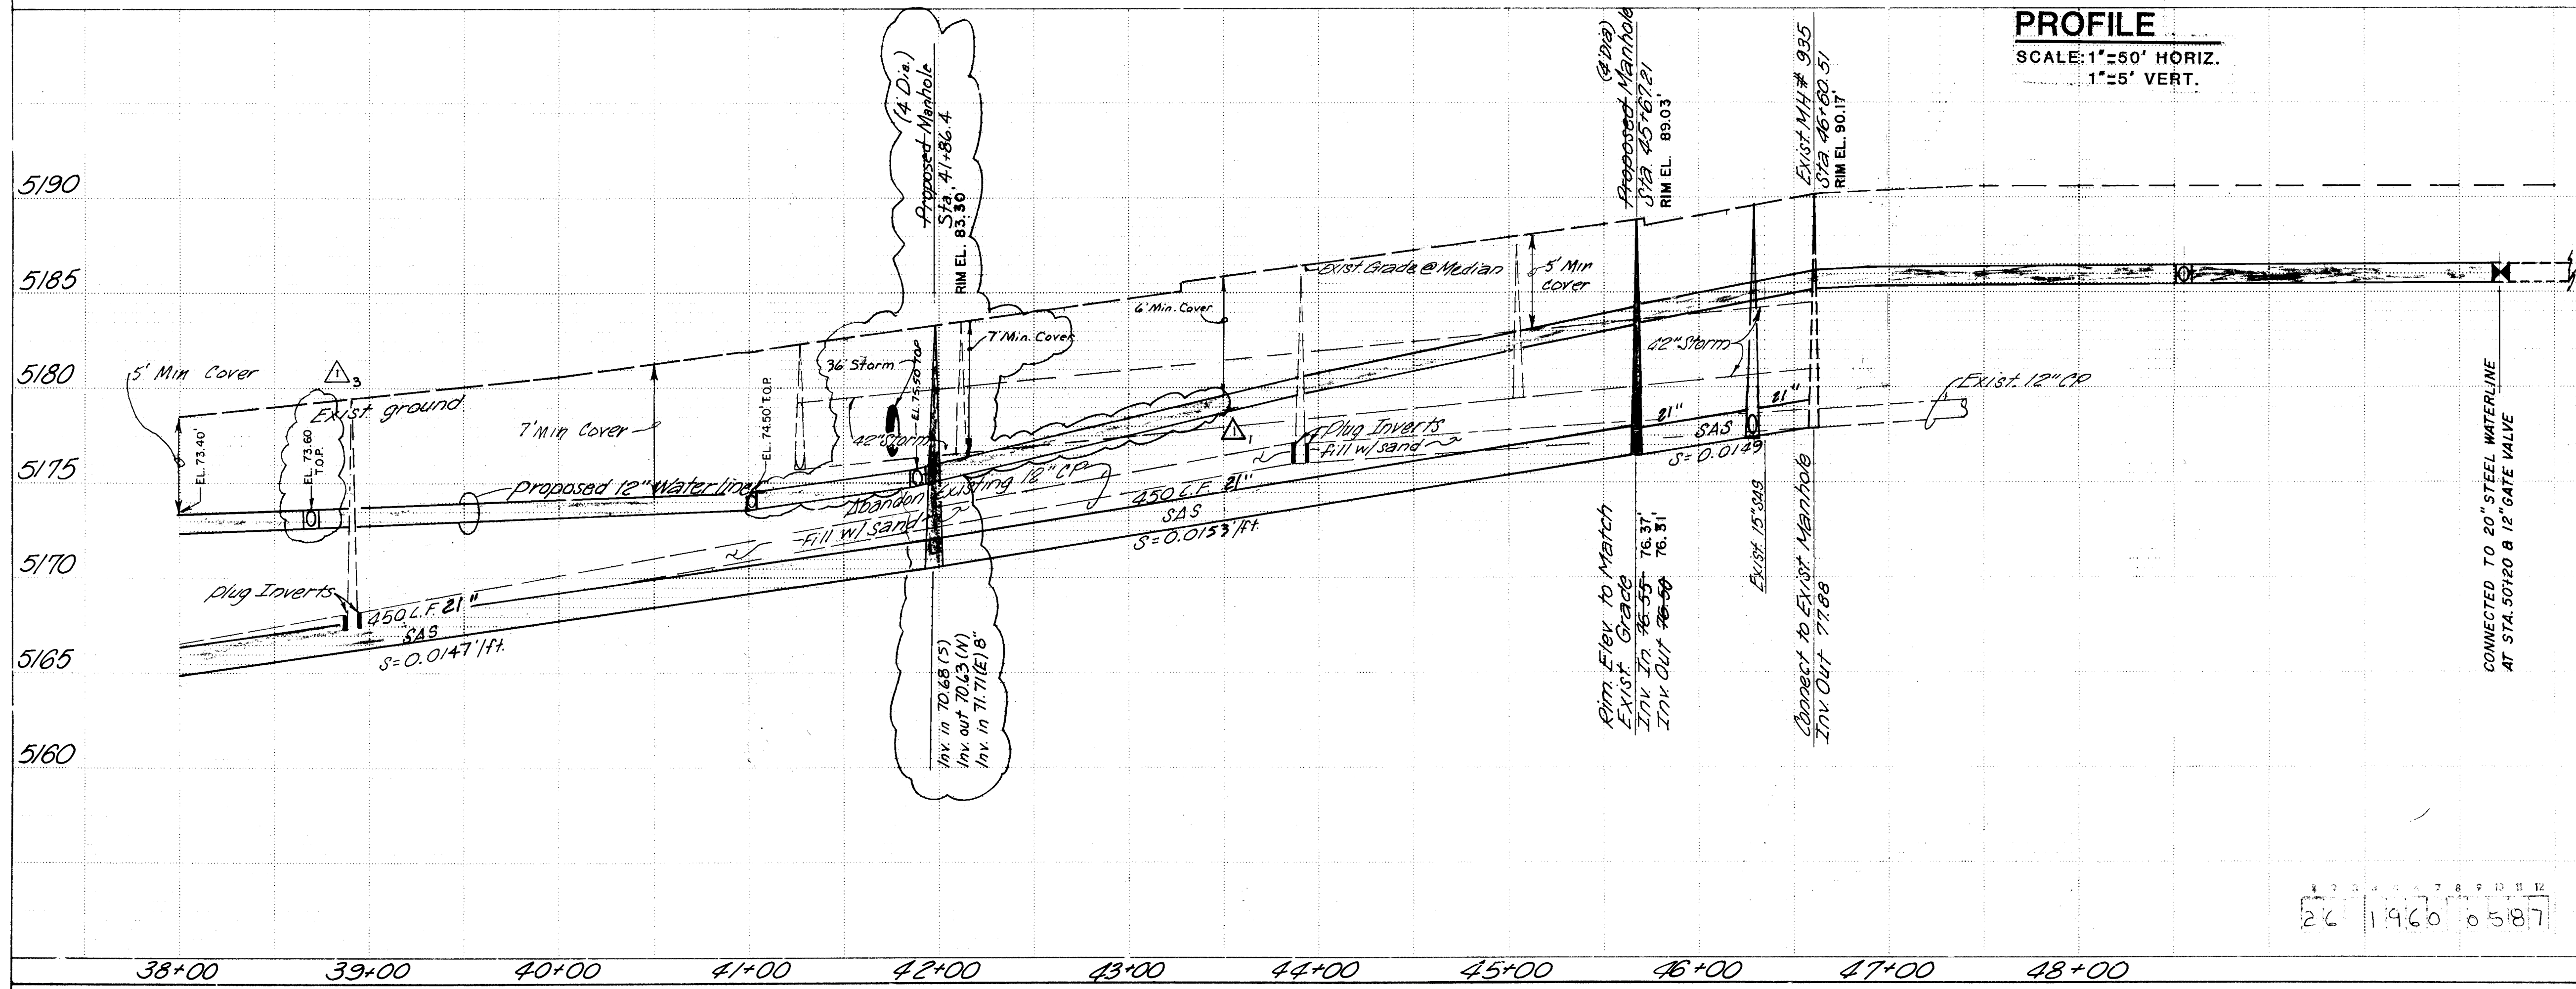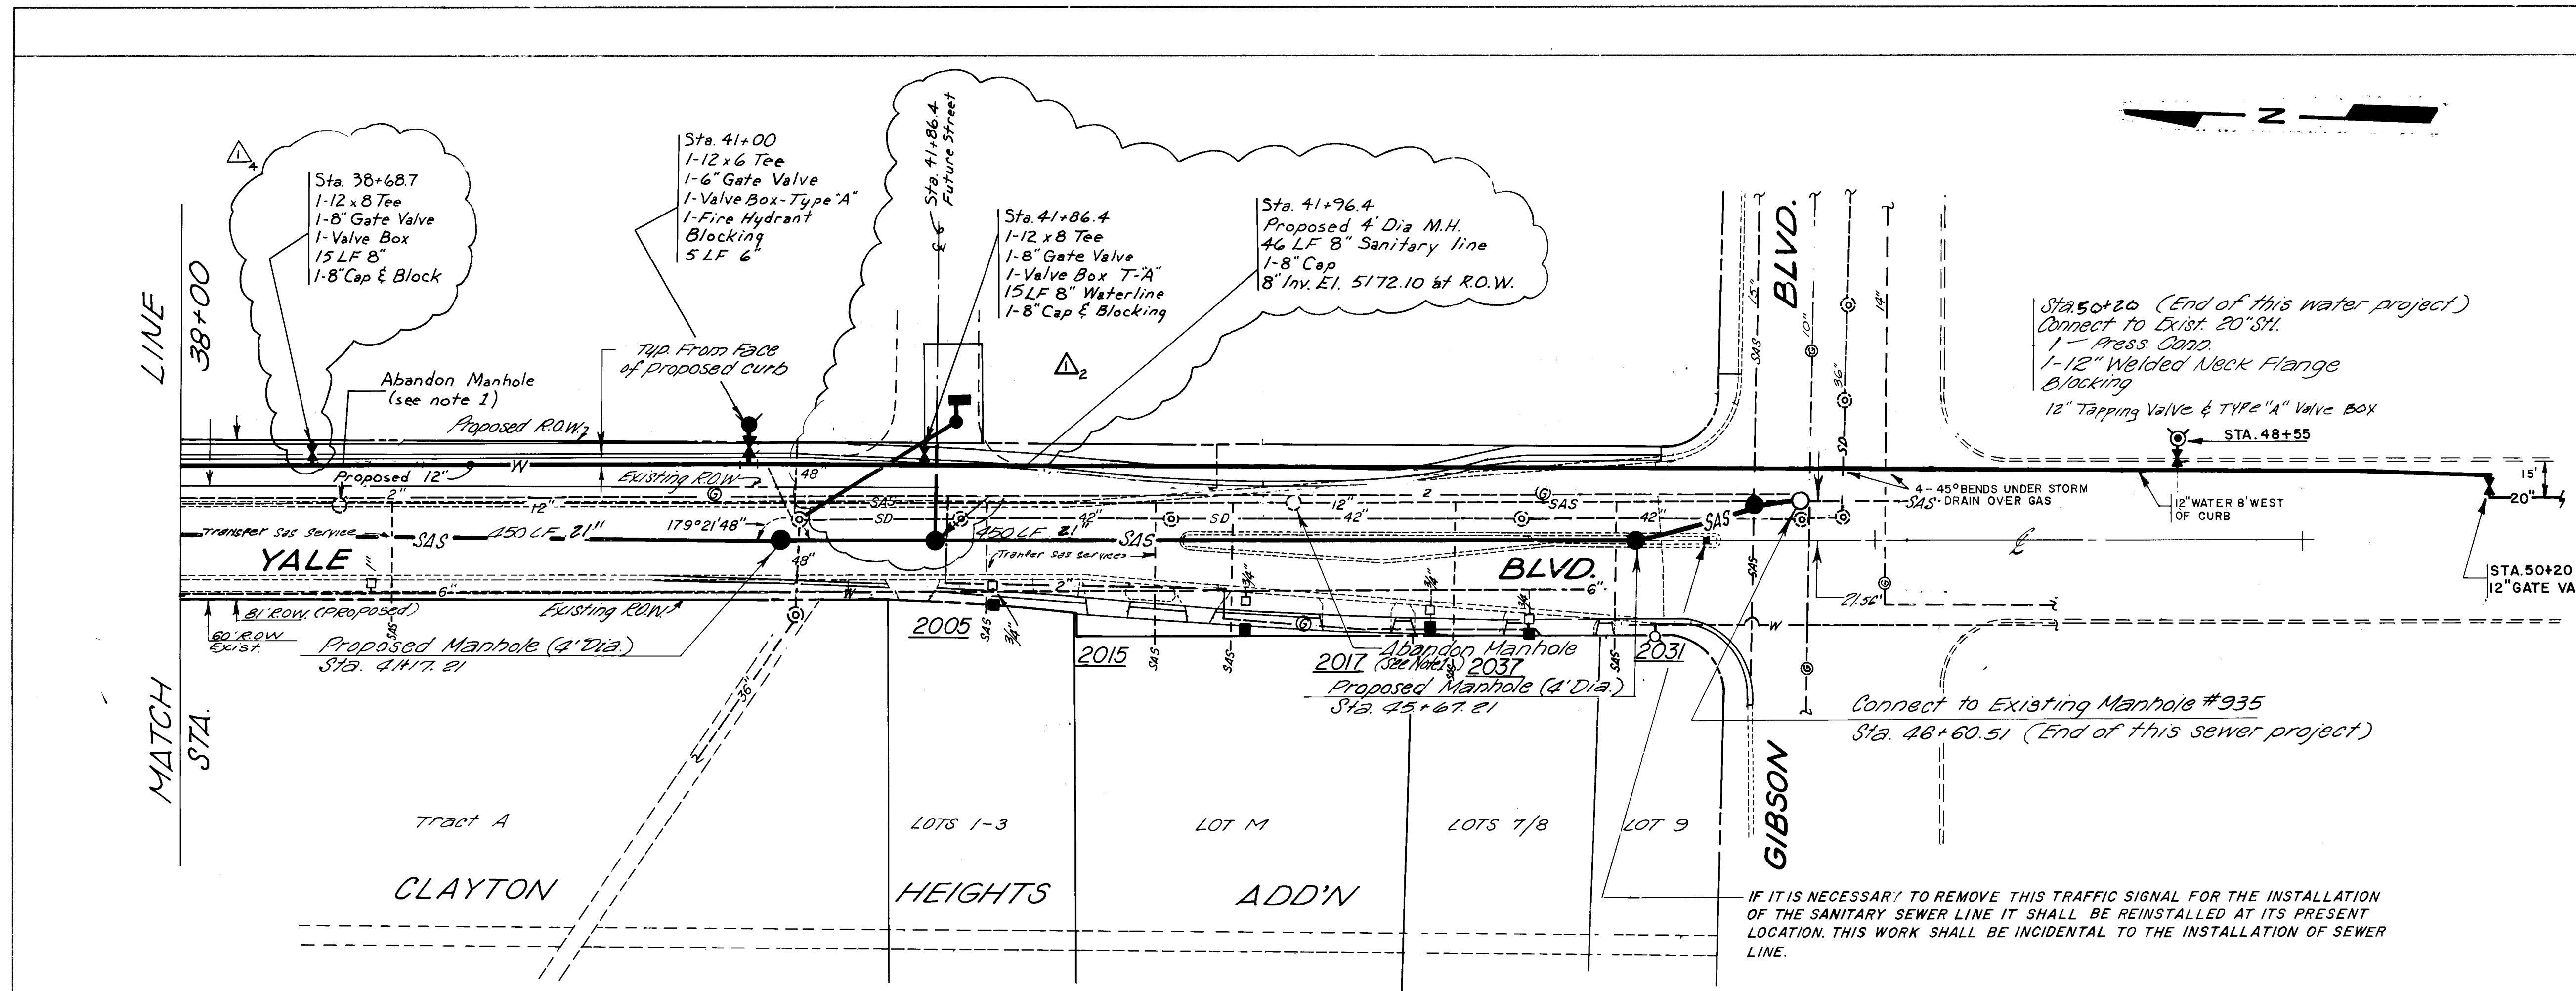

NOTE:

ABANDONMENT OF EXISTING 12" CP SAS LINE AND MANHOLES WILL BE DONE BY FILLING LINE WITH SAND AND PLUGGING INVERTS WITH 1' LONG MORTAR PLUGS, BREAKUP BOTTOM OF MANHOLE, FILL MANHOLE WITH SAND AND REMOVE AND RETURN CASTINGS AND LIDS TO THE CITY YARDS.

See General Notes on Sht. II-1 of 5

AS-BUILT OF WATER & SANITARY SEWER ONLY AUGUST 1986

CITY OF ALBUQUERQUE
WATER RESOURCES DEPARTMENT
ENGINEERING DIVISION

TITLE:
YALE BOULEVARD
WATER AND SEWER
REPLACEMENTS

APPROVALS	ENGINEER	DATE	APPROVALS	ENGINEER	DATE
City Engineer			Liquid Waste	R. Diaz	11/4/85
A.C.E. - Design	H. W. Diaz	1/21/85	Traffic	N.A. Diaz	1-21-85
A.C.E. - Hydrology	Don Hogg	1/14/85	Water	R. Diaz	1/14/85

NO.	DATE	REMARKS	DESIGNED BY	DATE	DRAWN BY	DATE	CHECKED BY	DATE
1	5/2/85	STA. 41+1721, SAS LINE TO STA. 36+6721	A.T.O.					
2	6-24-85	Water and Sanitary Services added	S.A.M.					
3	10-24-85	Water and Sanitary Services added	S.A.M.					
4	10-24-85	Water and Sanitary Services added	S.A.M.					
5	10-24-85	Water and Sanitary Services added	S.A.M.					

AS BUILT INFORMATION

NO.	DATE	REMARKS	DESIGNED BY	DATE	DRAWN BY	DATE	CHECKED BY	DATE
1	5/2/85	STA. 41+1721, SAS LINE TO STA. 36+6721	A.T.O.					
2	6-24-85	Water and Sanitary Services added	S.A.M.					
3	10-24-85	Water and Sanitary Services added	S.A.M.					
4	10-24-85	Water and Sanitary Services added	S.A.M.					
5	10-24-85	Water and Sanitary Services added	S.A.M.					

ENGINEER'S SEAL

REVISIONS



DESIGNED BY MT **DATE** AUG 84

DRAWN BY MT/LIF **DATE** AUG 84

CHECKED BY


MAP NO. L-16 **SHEET** II-5 **OF** 5

07260-16

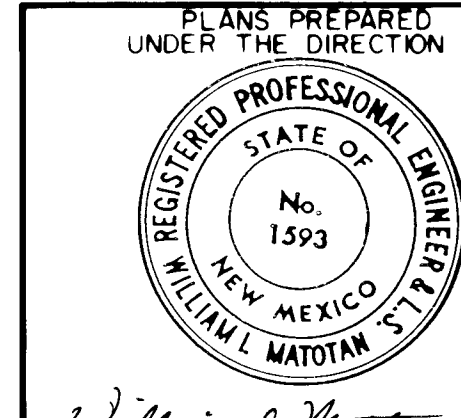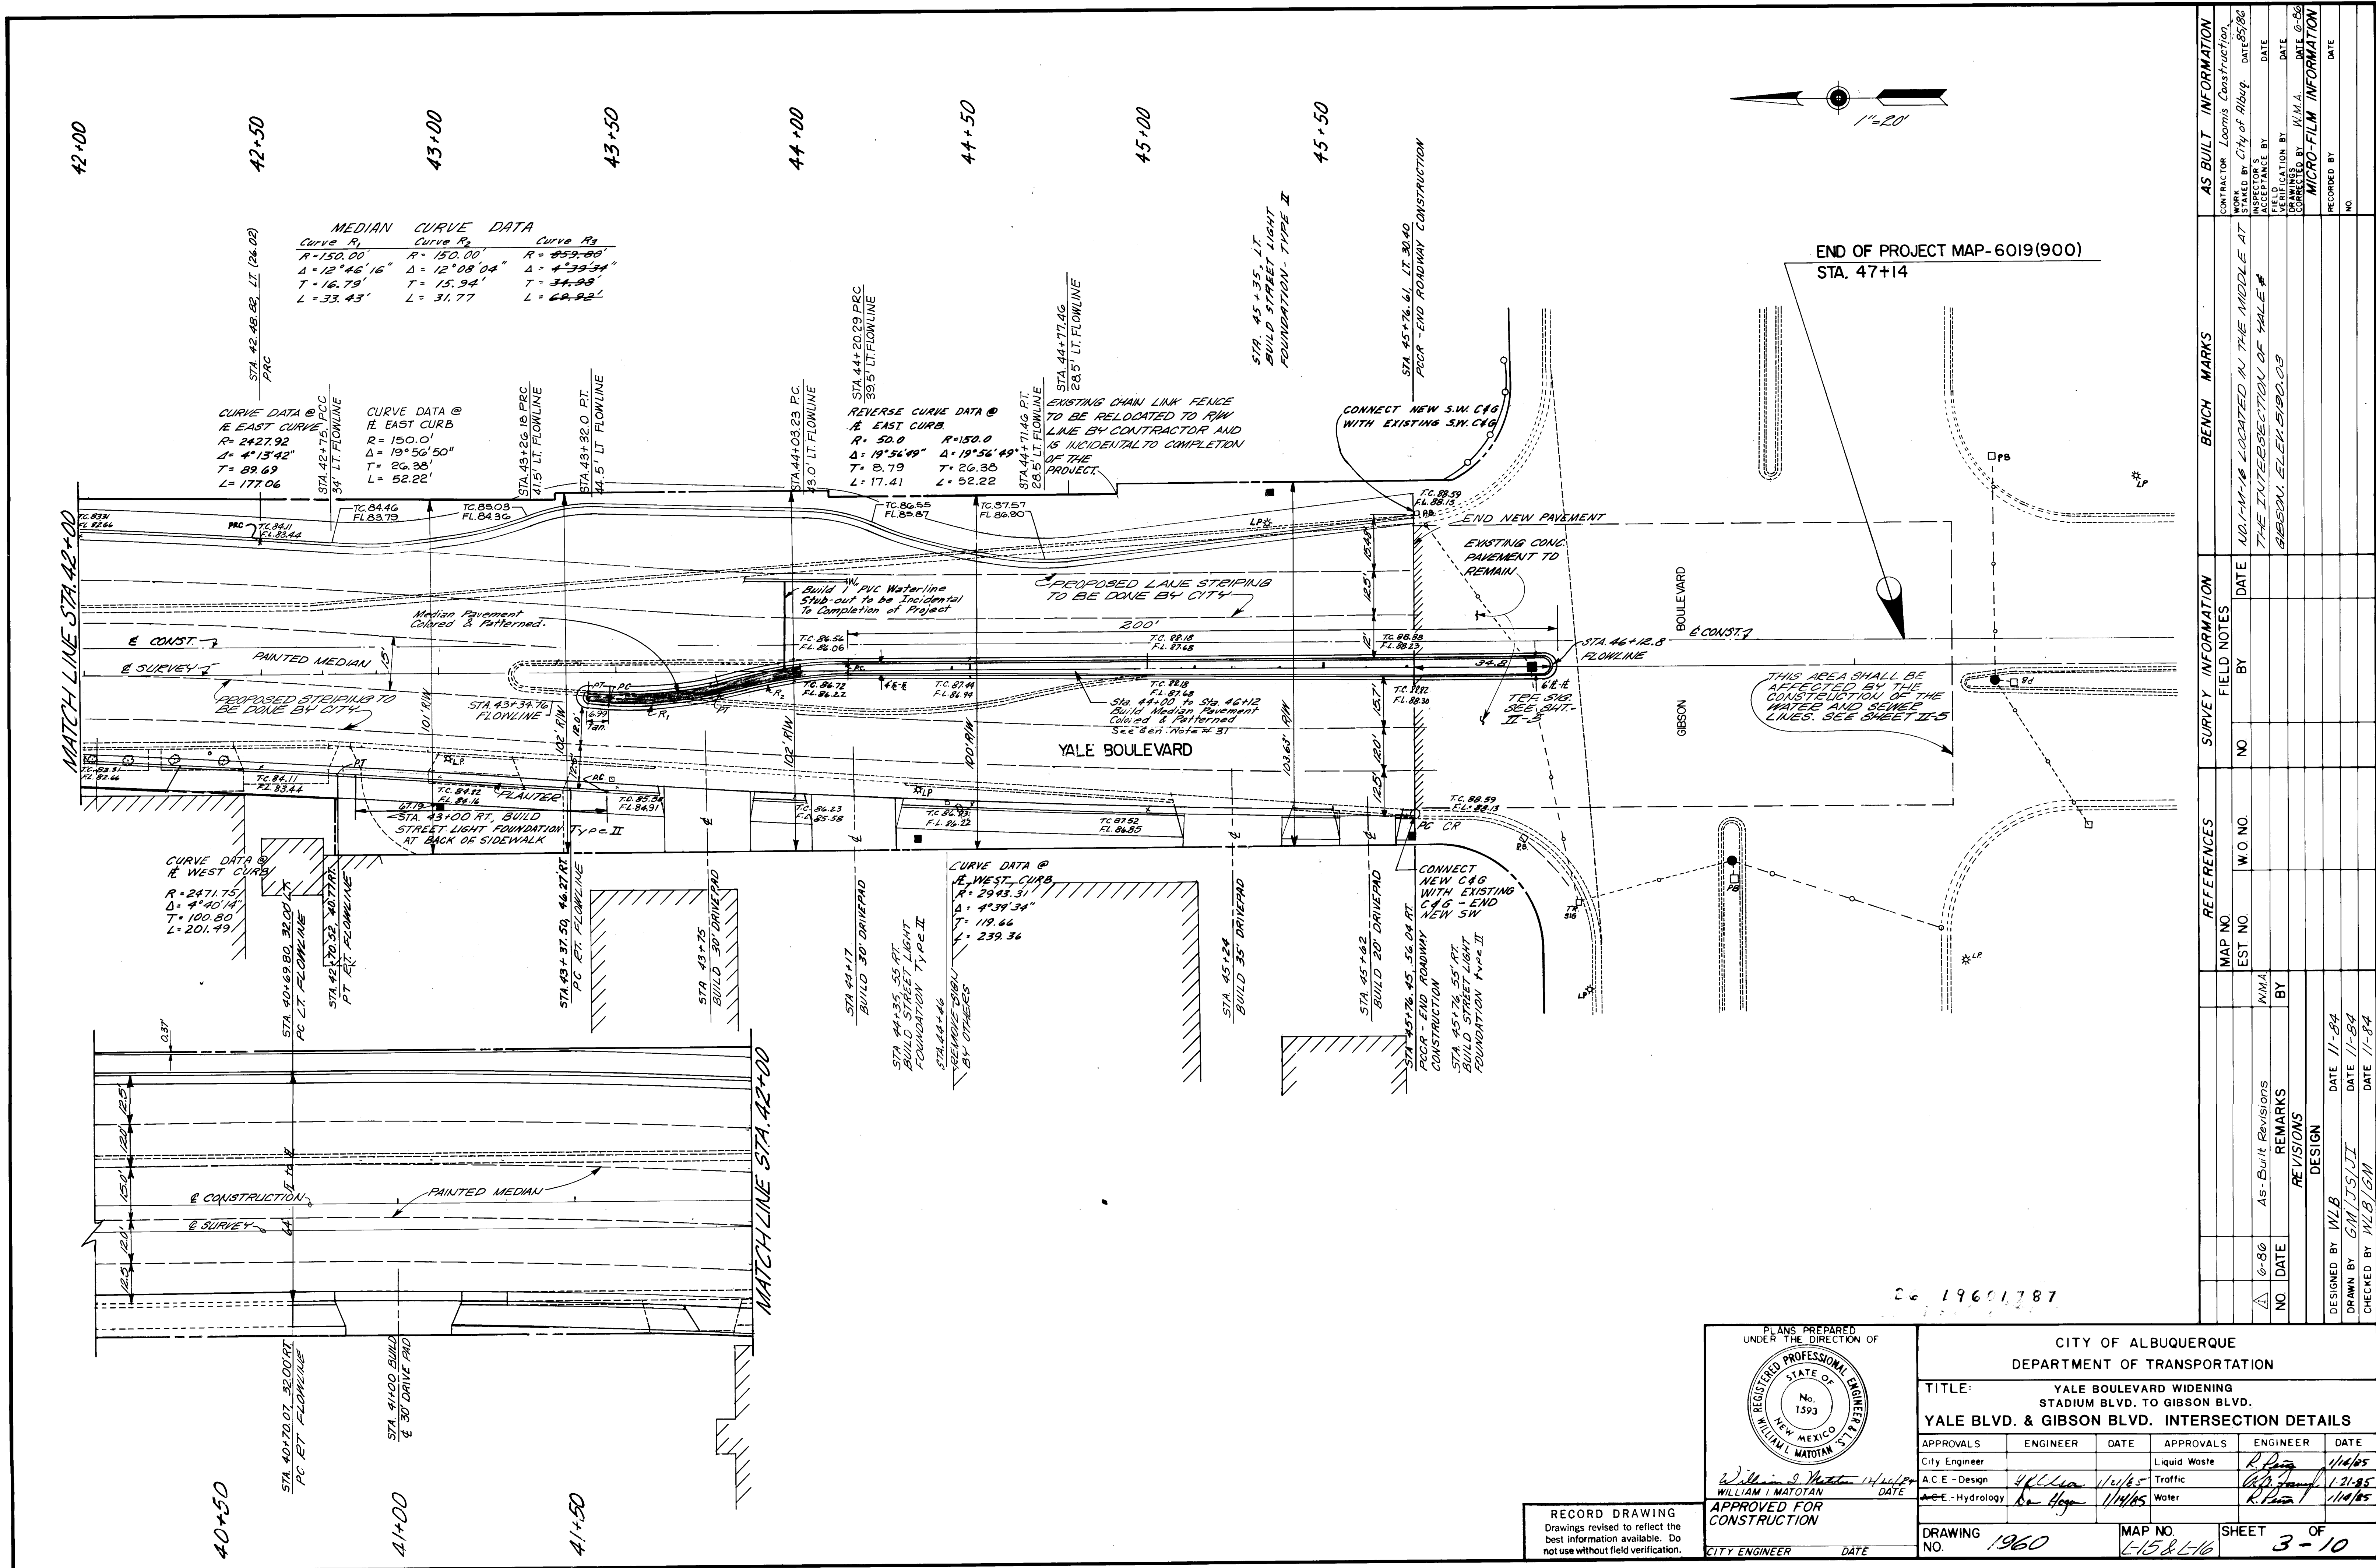



CITY OF ALBUQUERQUE DEPARTMENT OF TRANSPORTATION					
TITLE: YALE BOULEVARD WIDENING STADIUM BLVD. TO GIBSON BLVD. YALE BLVD. & GIBSON BLVD. INTERSECTION DETAILS					
APPROVALS	ENGINEER	DATE	APPROVALS	ENGINEER	DATE
City Engineer			Liquid Waste	R. J. [Signature]	1/14/85
ACE - Design	[Signature]	1/14/85	Traffic	[Signature]	1/14/85
ACE - Hydrology	[Signature]	1/14/85	Water	[Signature]	1/14/85
DRAWING NO. 1960		MAP NO. 6-15 & 16		SHEET 3 OF 10	

REFERENCES		SURVEY INFORMATION		BENCH MARKS		AS BUILT INFORMATION	
MAP NO.	W.O. NO.	NO.	DATE	NO.	DATE	NO.	DATE
EST. NO.	BY	NO.	DATE	NO.	DATE	NO.	DATE
NO.	DATE	NO.	DATE	NO.	DATE	NO.	DATE
DESIGNED BY: WLB	DATE: 11-84	NO.	DATE	NO.	DATE	NO.	DATE
DRAWN BY: GML/TS/LIT	DATE: 11-84	NO.	DATE	NO.	DATE	NO.	DATE
CHECKED BY: WLB/GML	DATE: 11-84	NO.	DATE	NO.	DATE	NO.	DATE

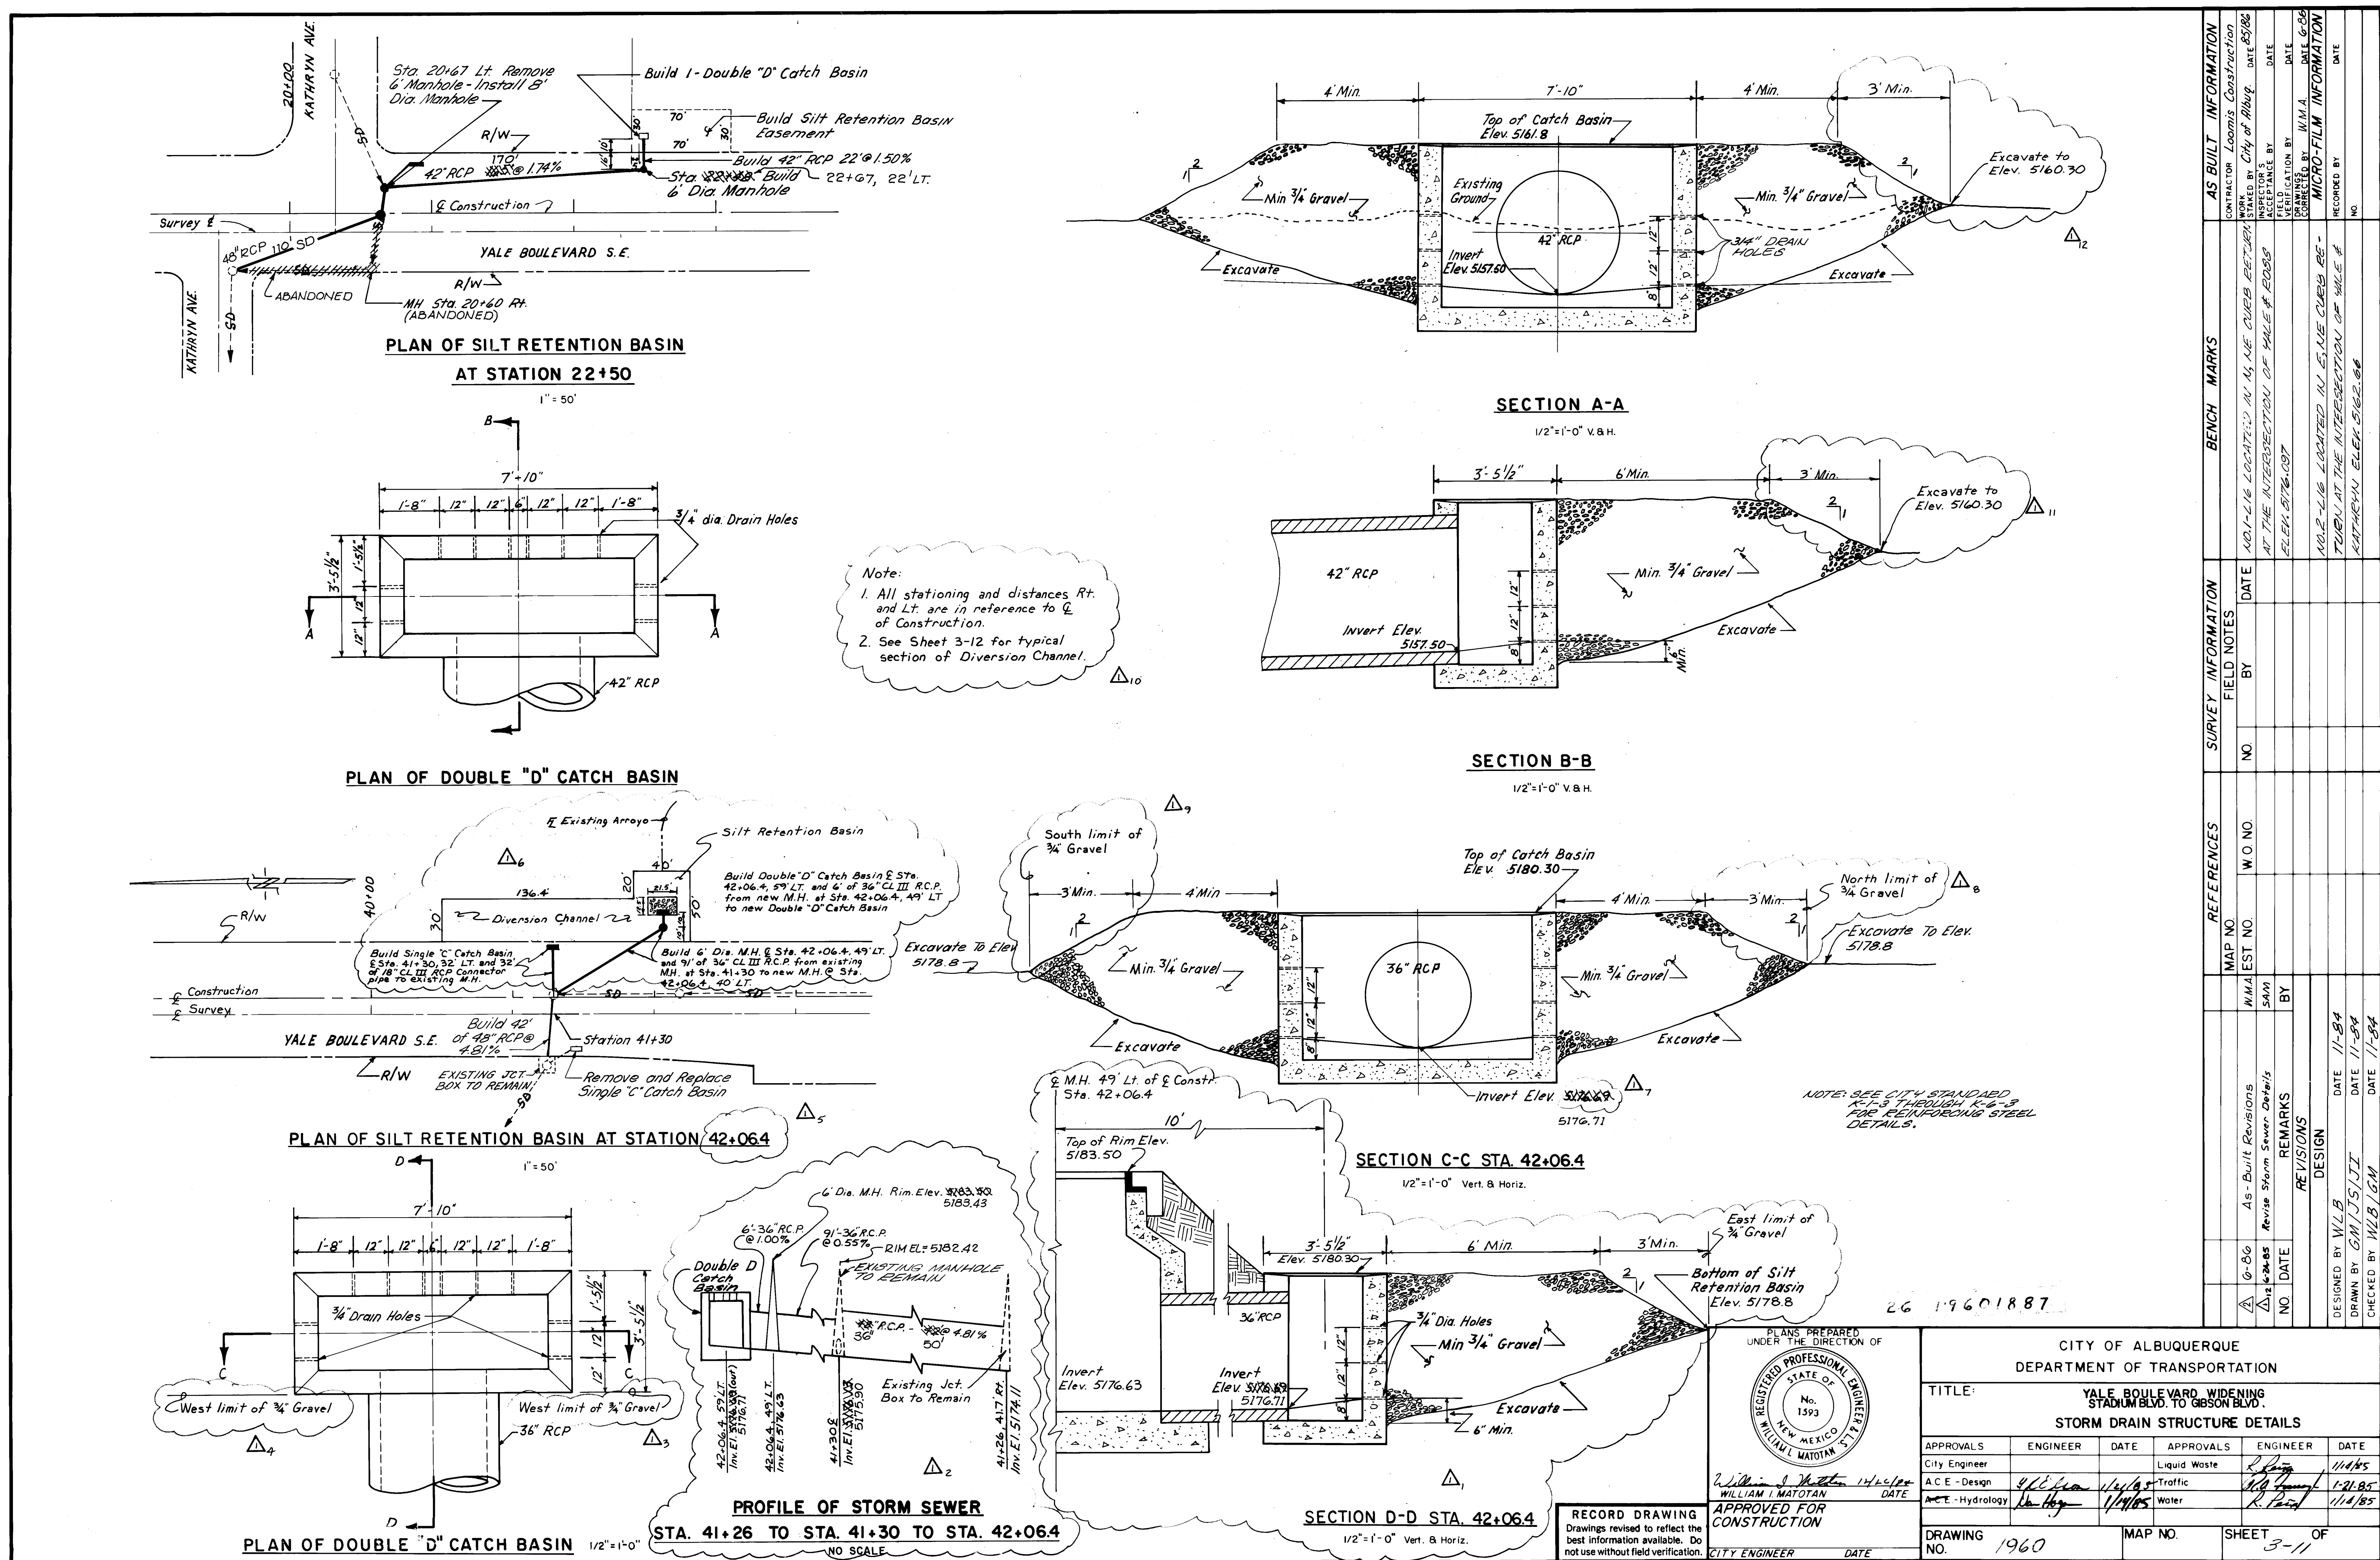

0726021

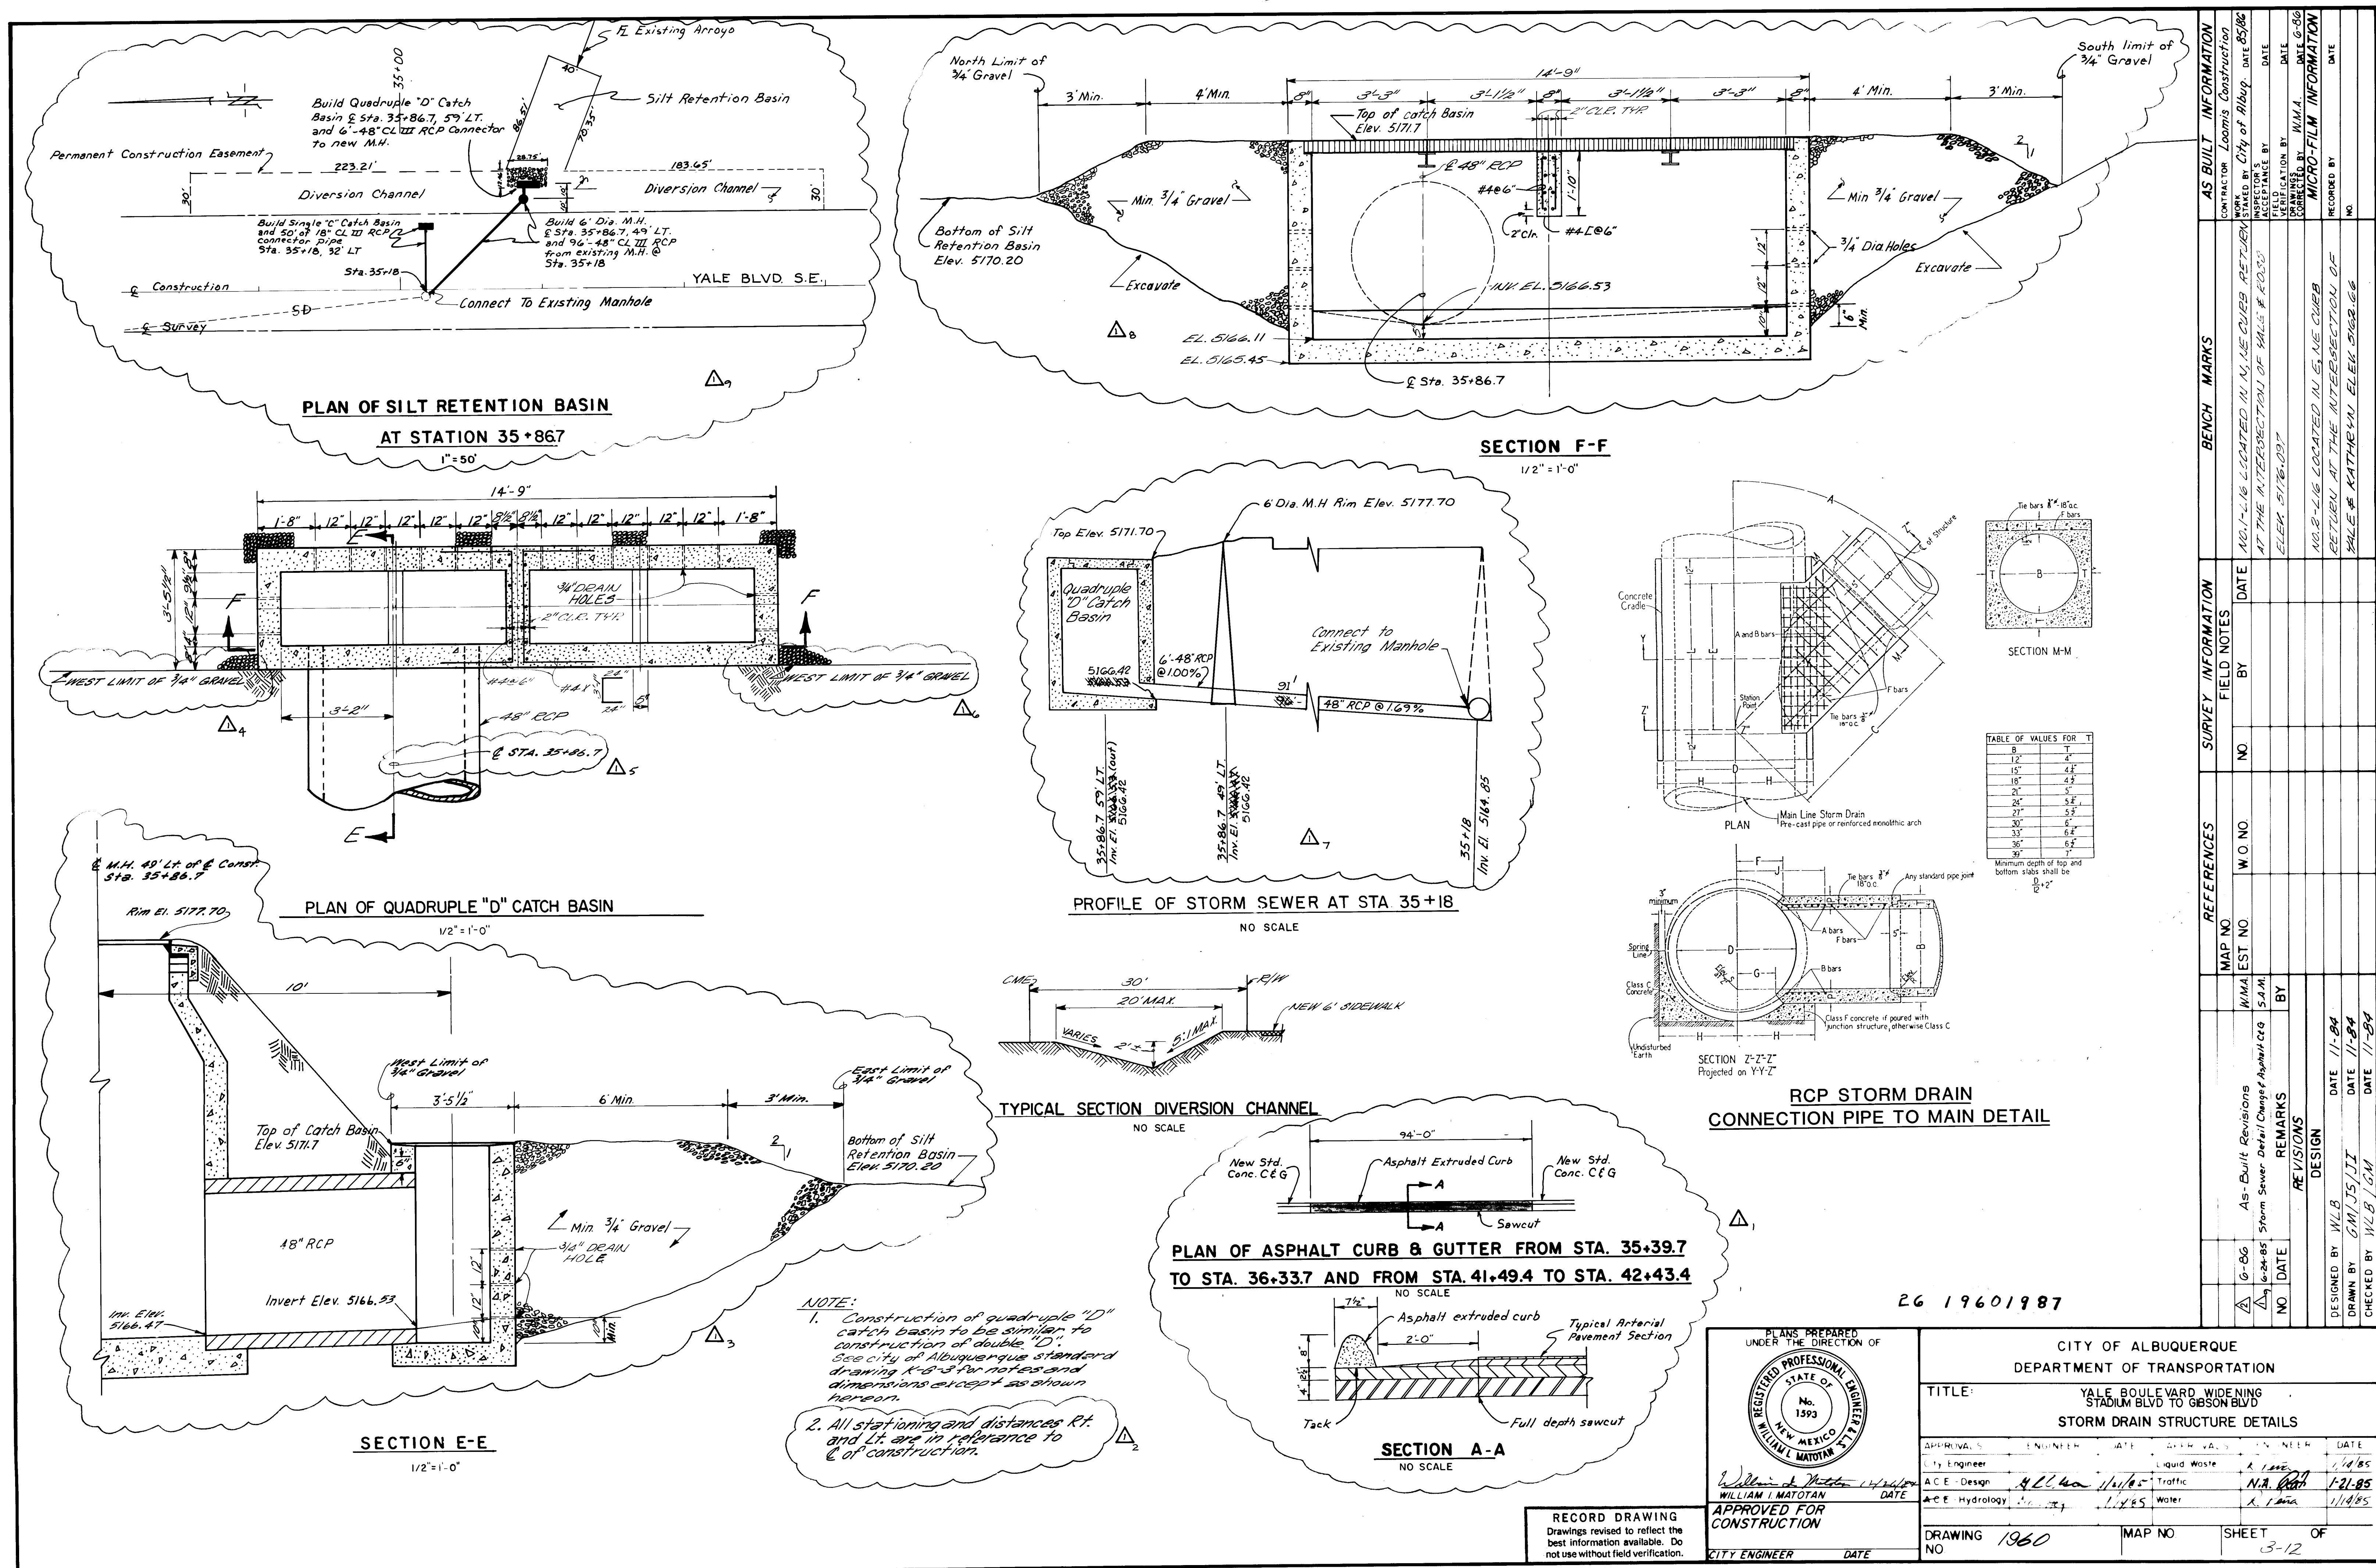

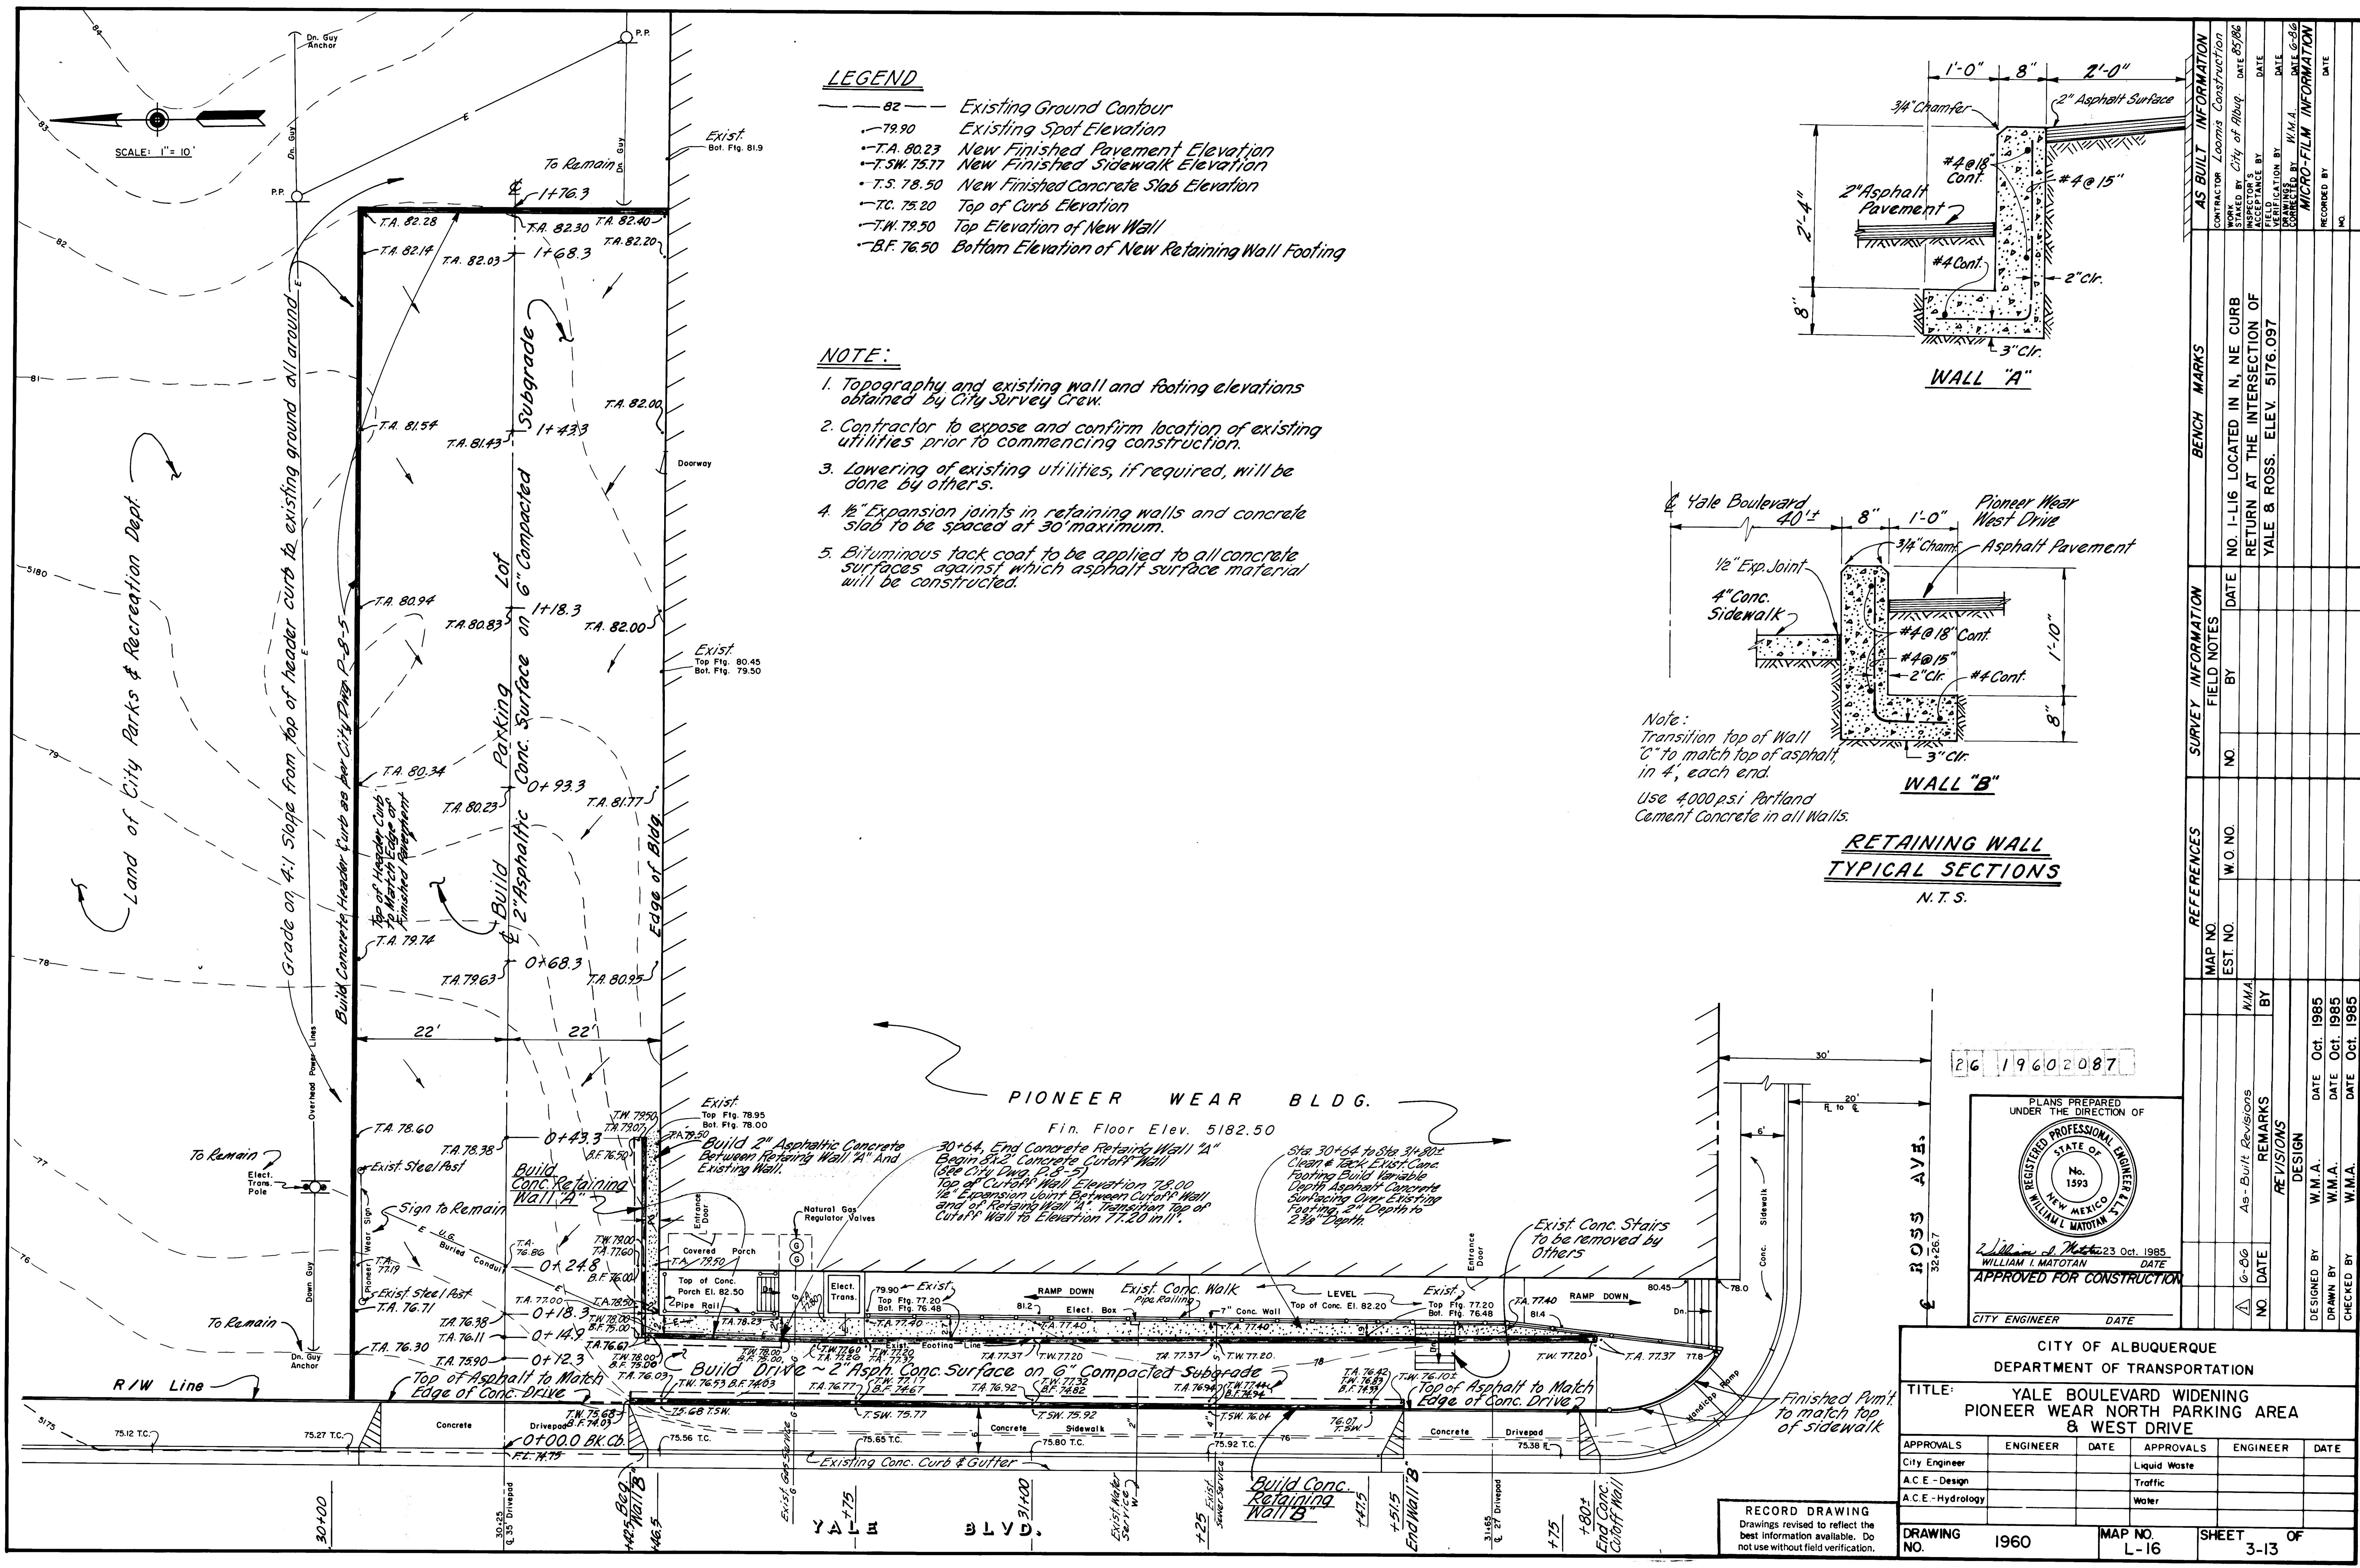


LEGEND


- 82 Existing Ground Contour
79.90 Existing Spot Elevation
T.A. 80.23 New Finished Pavement Elevation
T.S.W. 75.77 New Finished Sidewalk Elevation
T.S. 78.50 New Finished Concrete Slab Elevation
T.C. 75.20 Top of Curb Elevation
T.W. 79.50 Top Elevation of New Wall
B.F. 76.50 Bottom Elevation of New Retaining Wall Footing

NOTE:

- 1. Topography and existing wall and footing elevations obtained by City Survey Crew.
2. Contractor to expose and confirm location of existing utilities prior to commencing construction.
3. Lowering of existing utilities, if required, will be done by others.
4. 16" Expansion joints in retaining walls and concrete slabs to be spaced at 30' maximum.
5. Bituminous tack coat to be applied to all concrete surfaces against which asphalt surface material will be constructed.

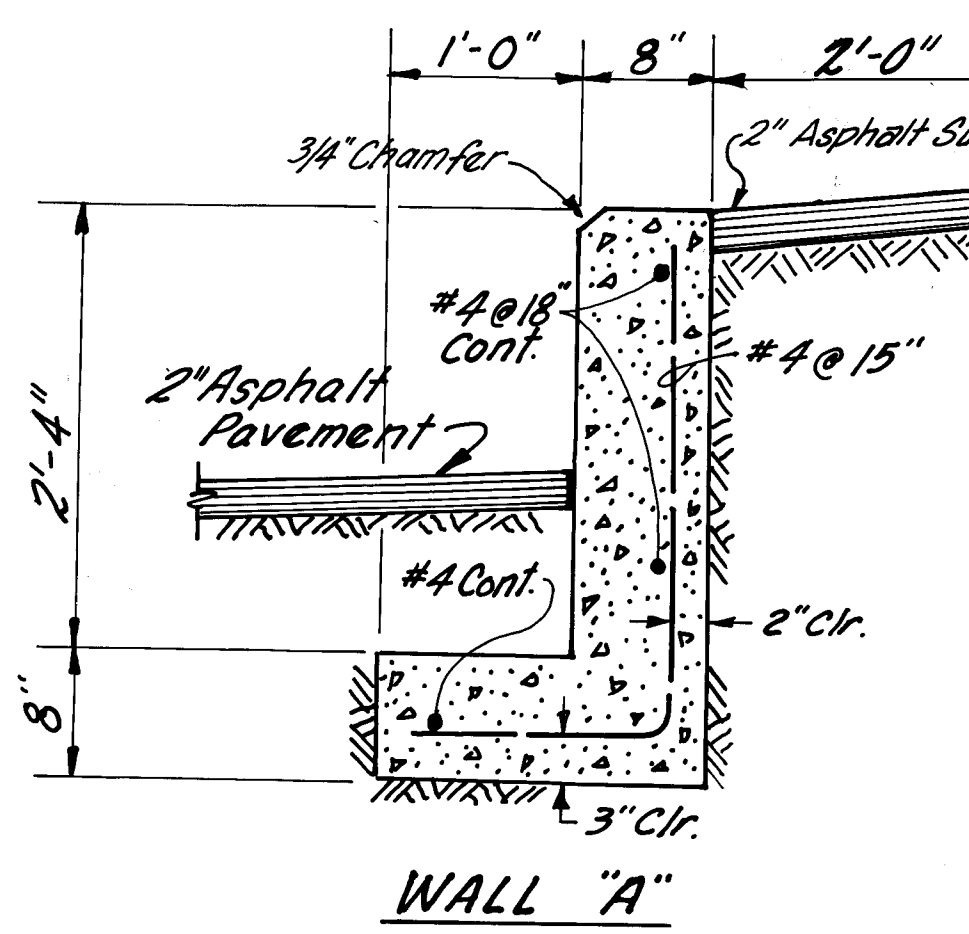

WALL "A"


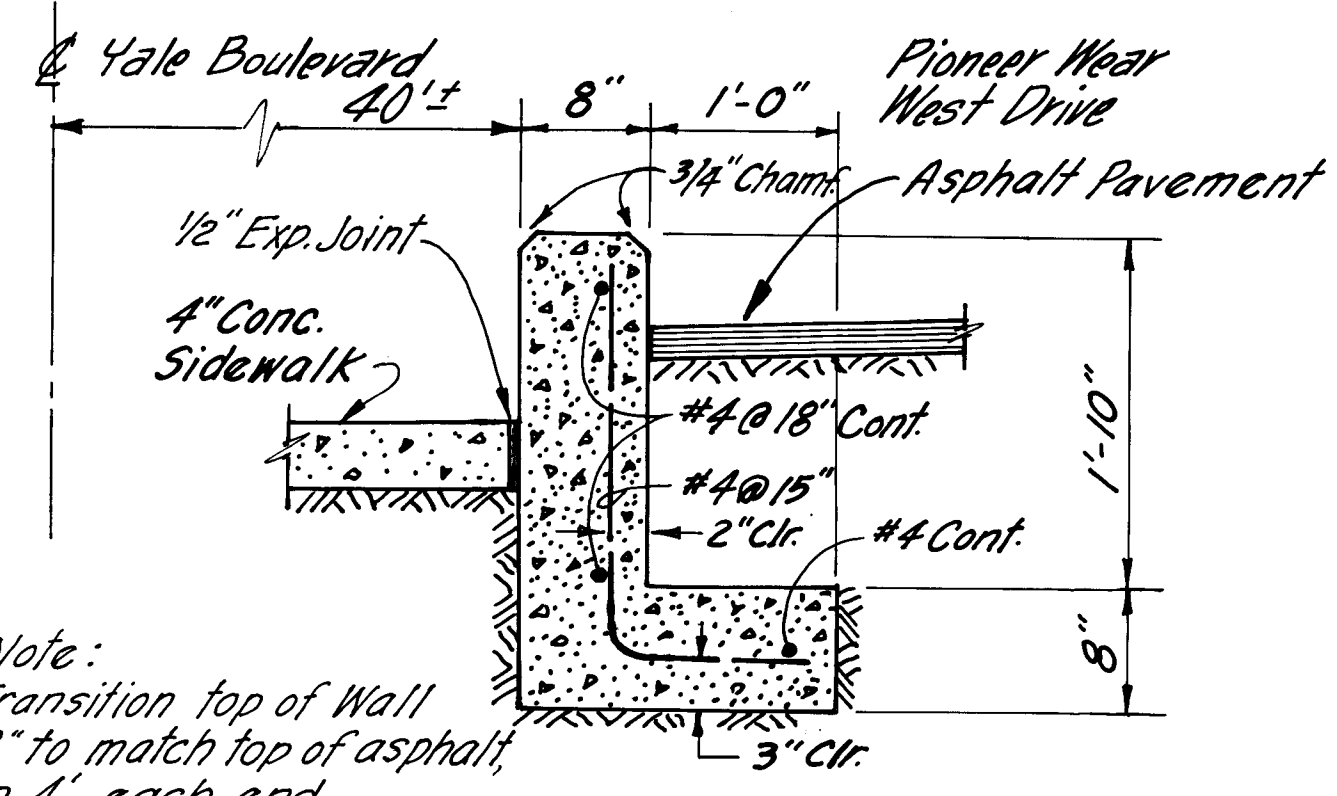


WALL "B"


Note: Transition top of Wall 'C' to match top of asphalt in 4' each end. Use 4000 psi Portland Cement concrete in all walls.

RETAINING WALL TYPICAL SECTIONS N.T.S.

Table with project information, approvals, and drawing log. Includes fields for AS BUILT INFORMATION, BENCH MARKS, SURVEY INFORMATION, REFERENCES, and a table for APPROVALS and DRAWING LOG.

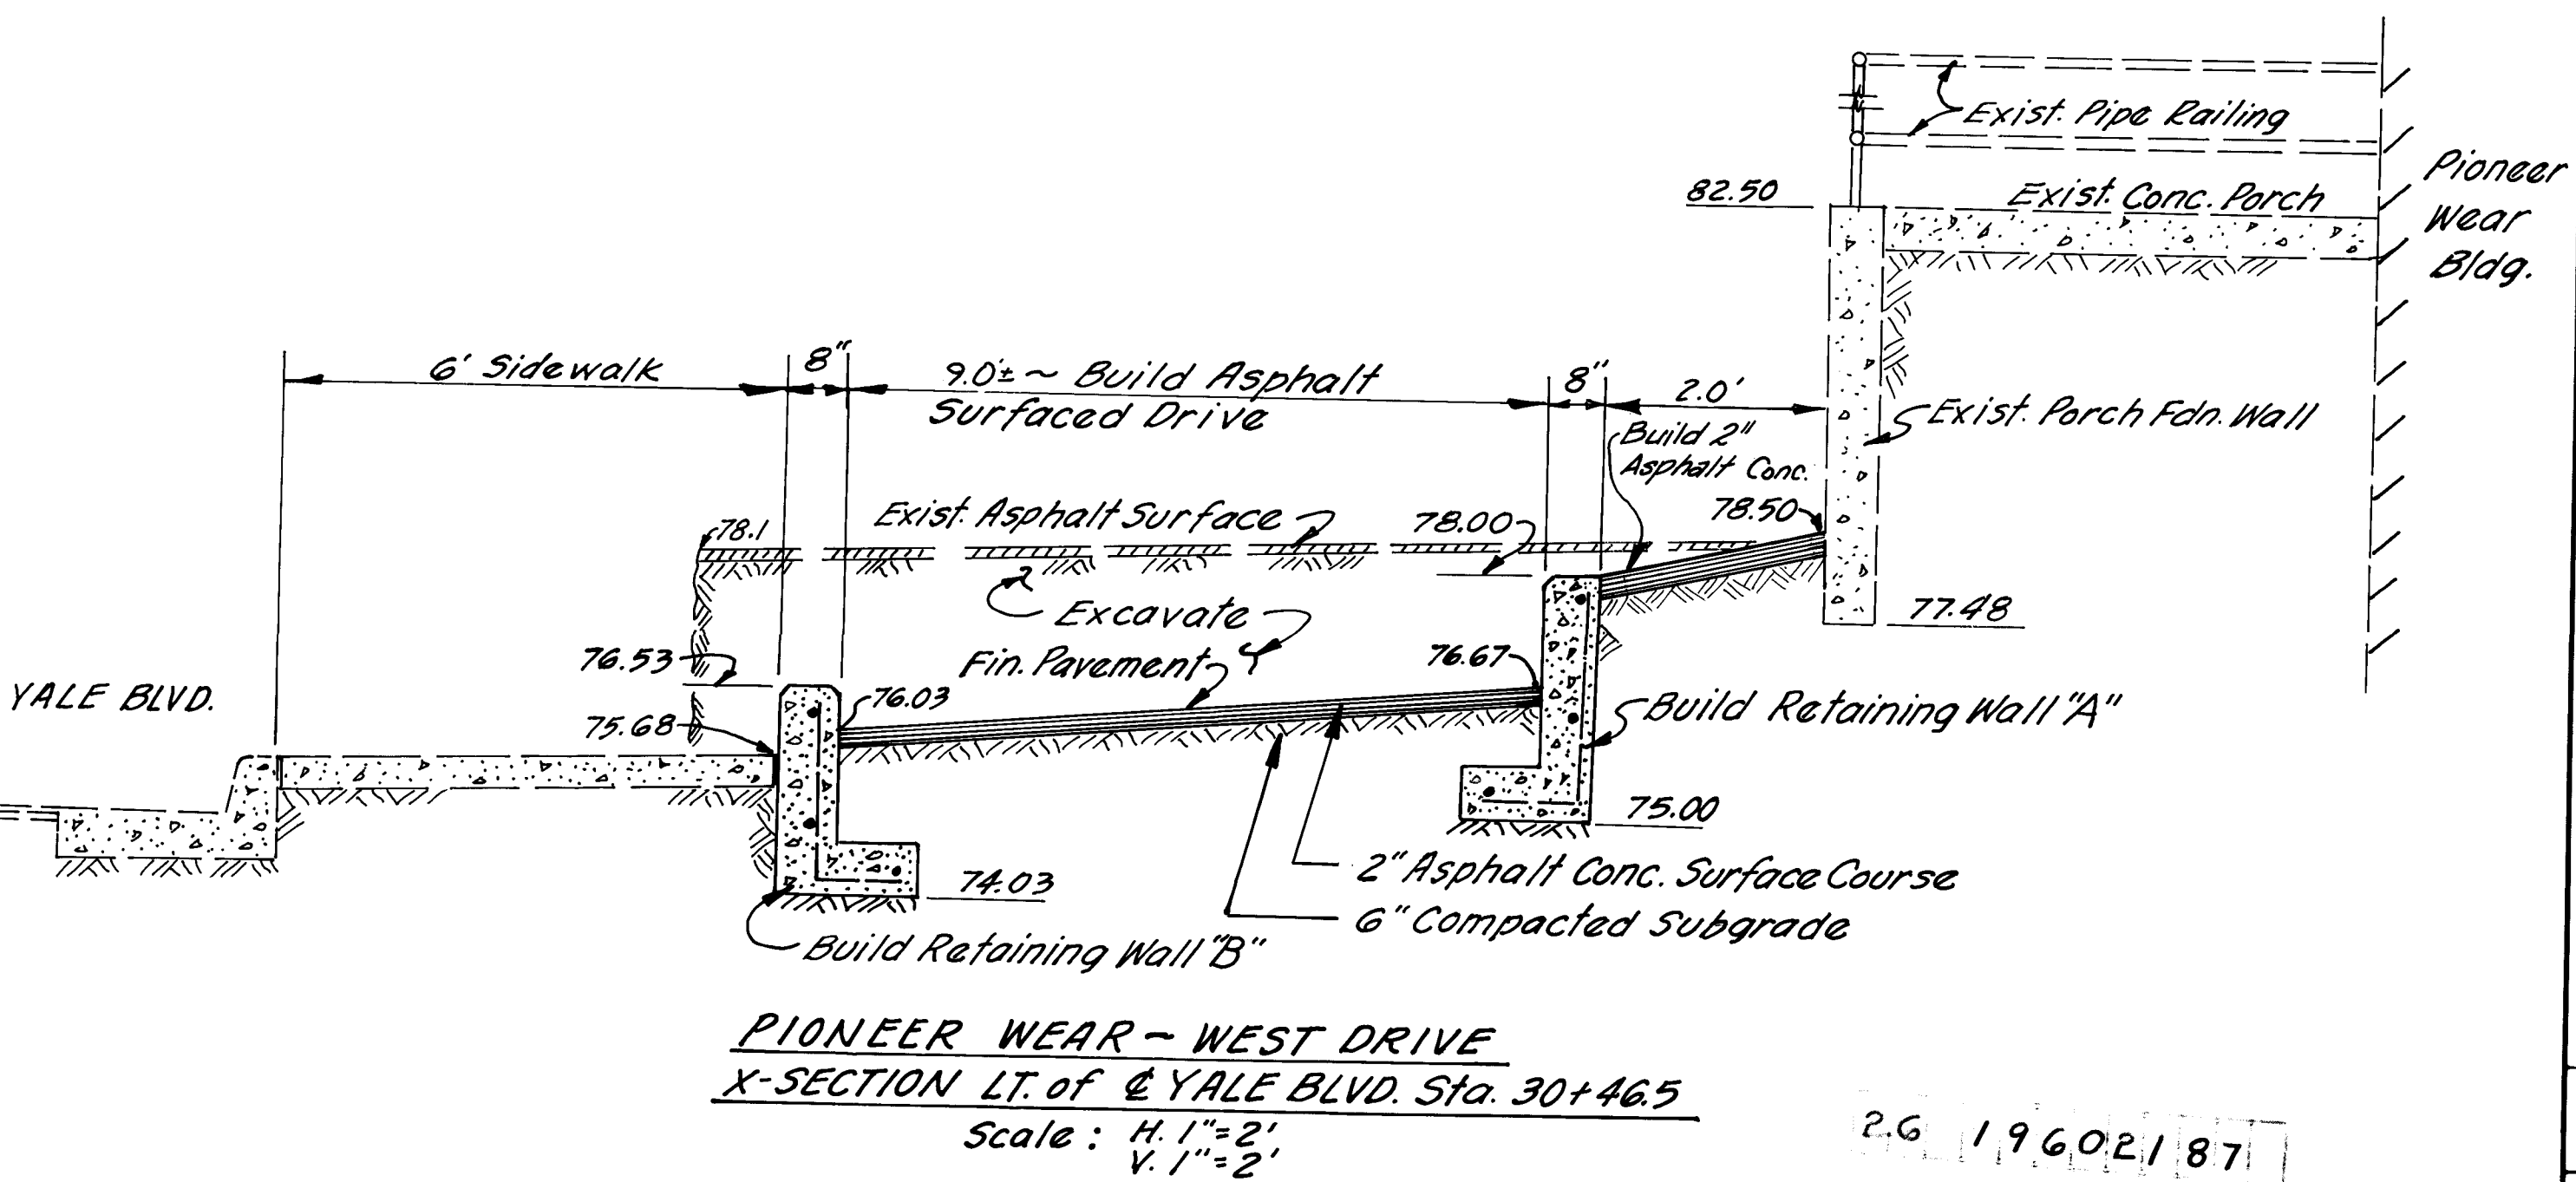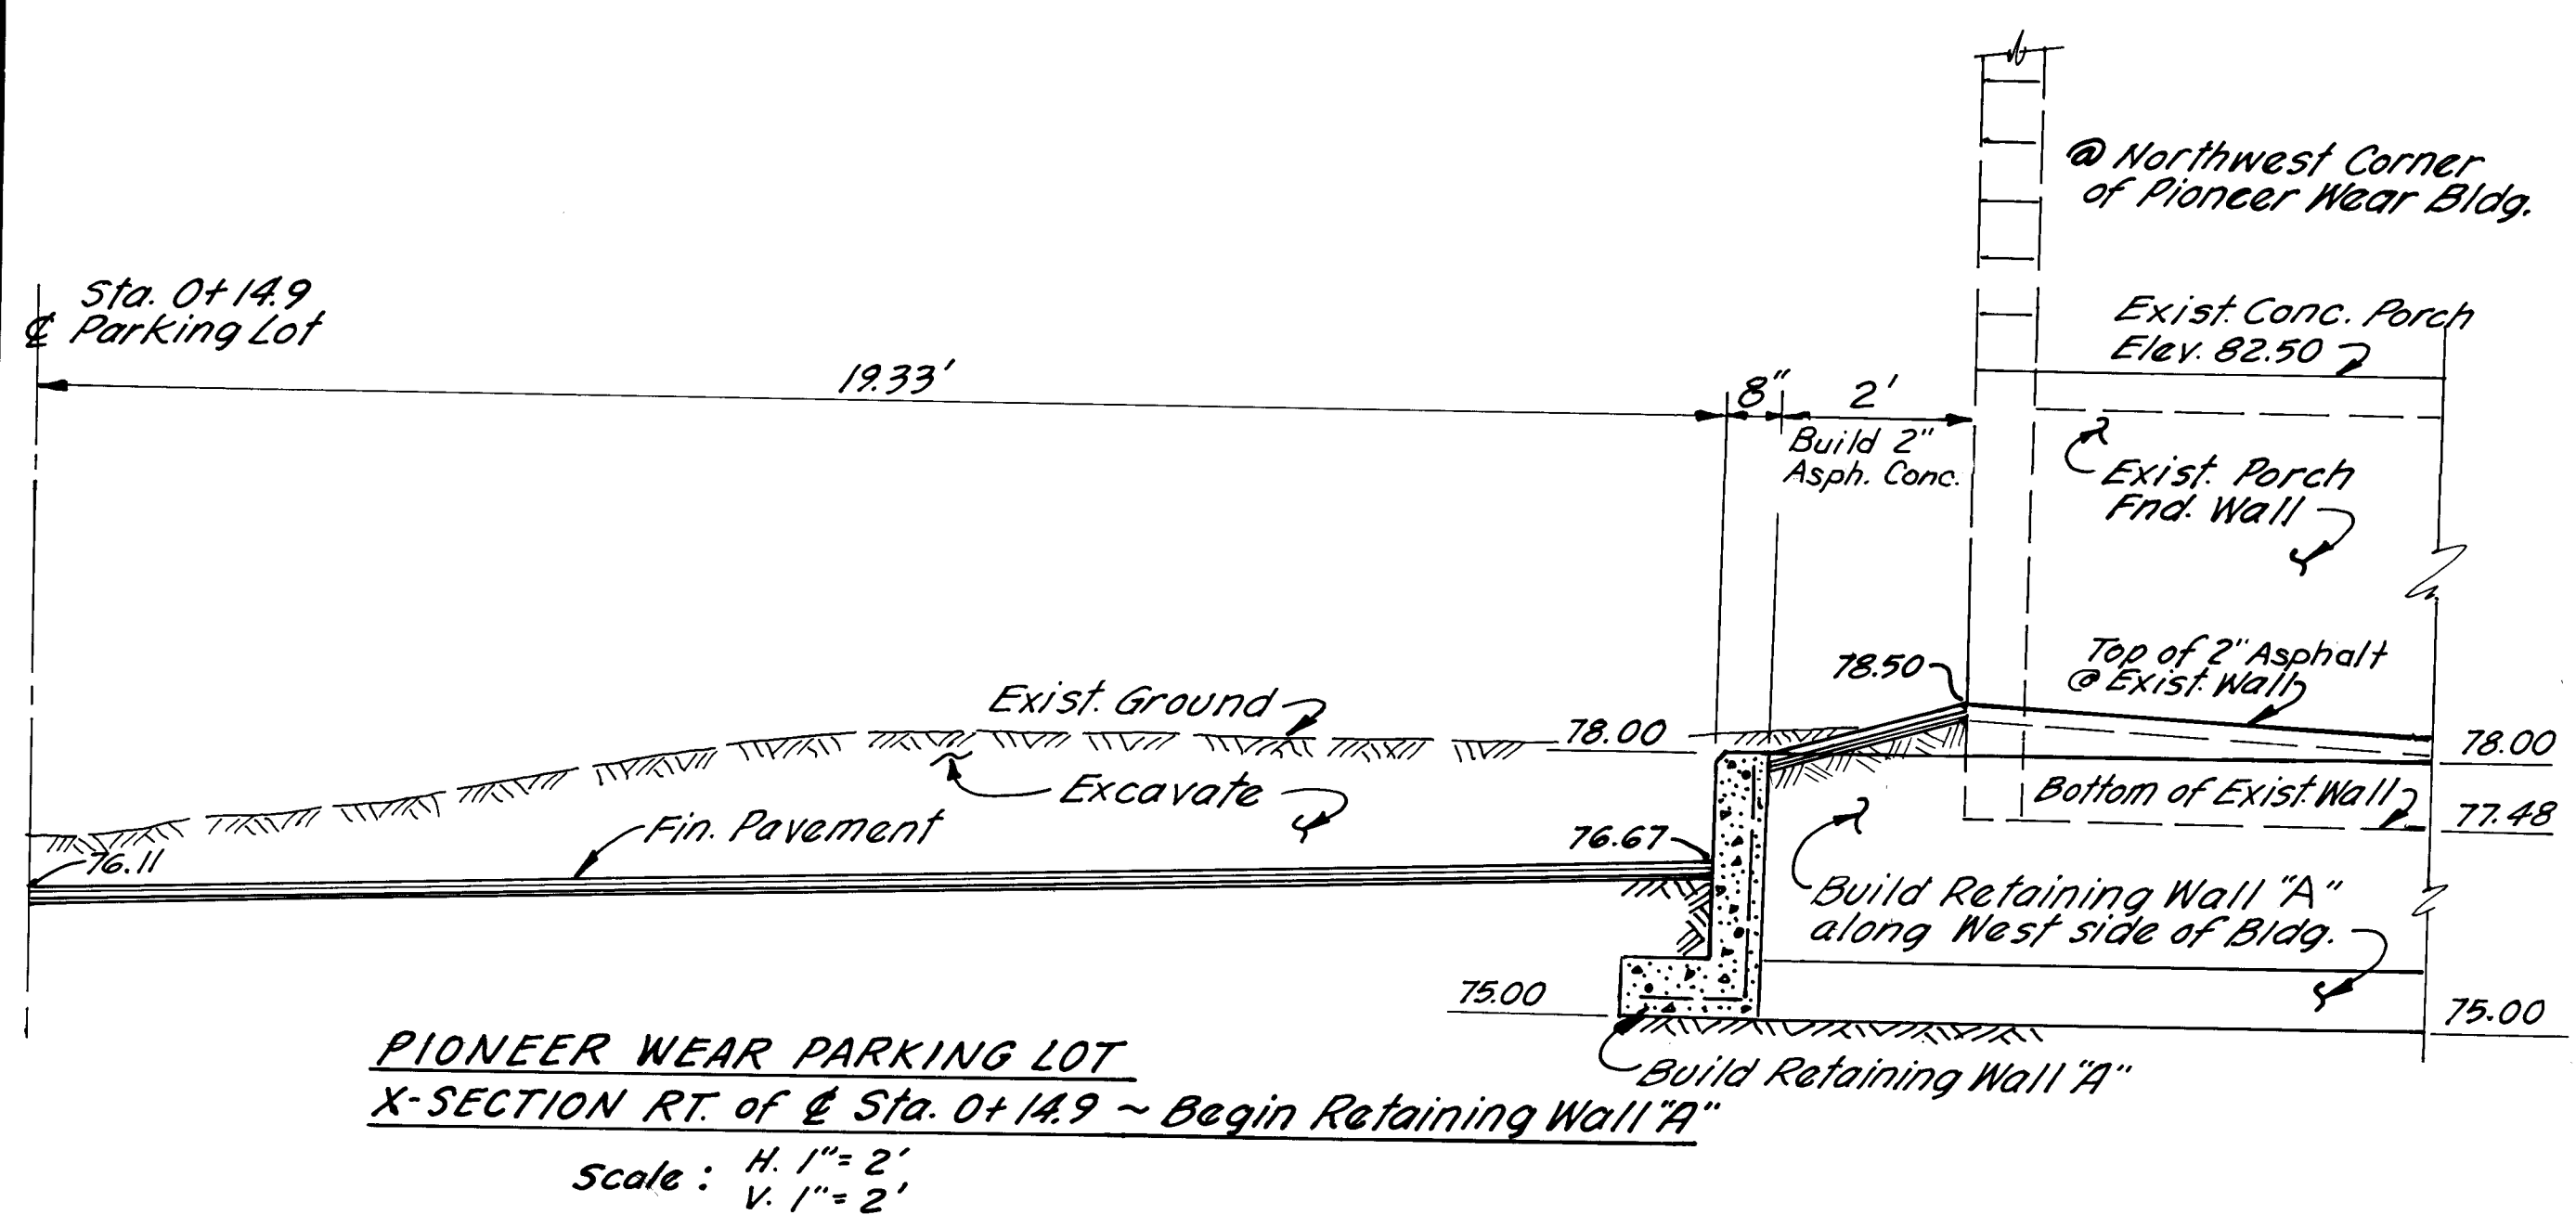[illegible]

27

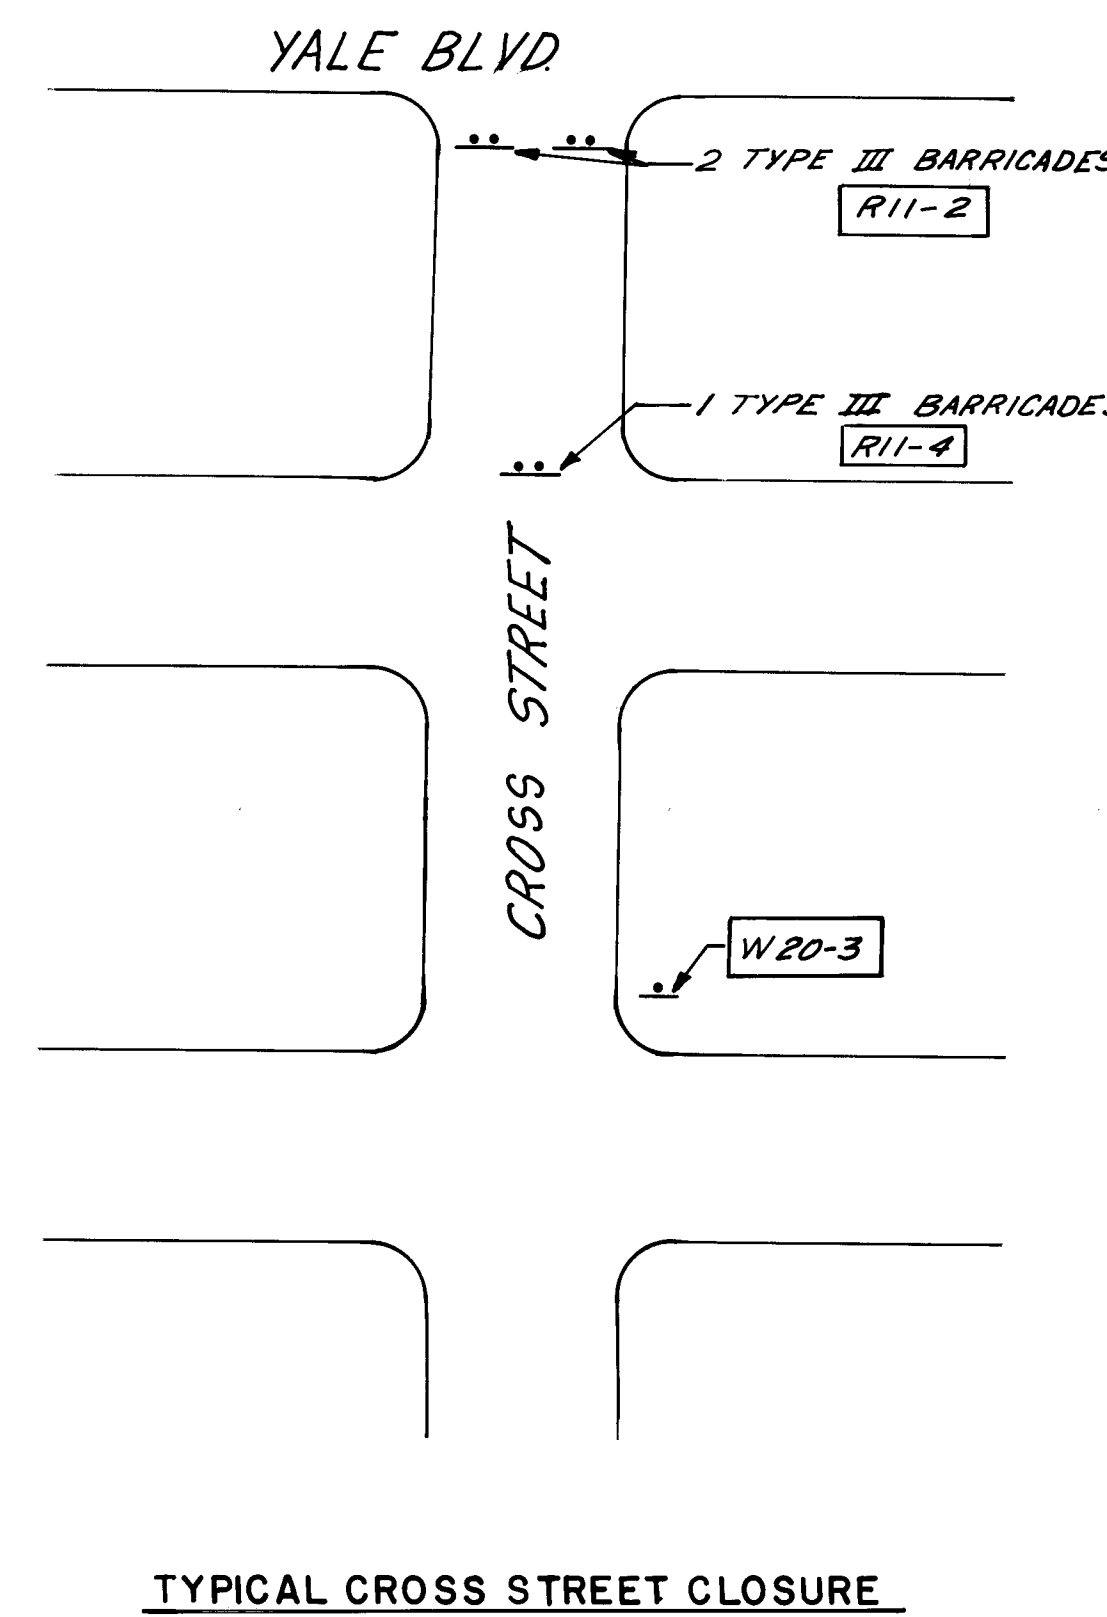


26 19602287



PLANS PREPARED UNDER THE DIRECTION OF  <i>R. J. [Signature]</i> WILSON MASTON	CITY OF ALBUQUERQUE DEPARTMENT OF TRANSPORTATION TITLE: YALE BOULEVARD WIDENING STADIUM BLVD. TO GIBSON BLVD. SIGN FACE DETAILS <table border="1" style="width: 100%; border-collapse: collapse;"> <thead> <tr> <th style="width: 25%;">APPROVALS</th> <th style="width: 25%;">ENGINEER</th> <th style="width: 25%;">DATE</th> <th style="width: 25%;">APPROVALS</th> <th style="width: 25%;">ENGINEER</th> <th style="width: 25%;">DATE</th> </tr> </thead> <tbody> <tr> <td></td> <td>City Engineer</td> <td></td> <td>Liquid Waste</td> <td><i>R. J. [Signature]</i></td> <td>11/18</td> </tr> <tr> <td></td> <td>A.C.E. - Design</td> <td></td> <td>Traffic</td> <td><i>[Signature]</i></td> <td>1-18</td> </tr> <tr> <td></td> <td>Hydrology</td> <td></td> <td>Water</td> <td><i>R. J. [Signature]</i></td> <td>11/18</td> </tr> </tbody> </table>	APPROVALS	ENGINEER	DATE	APPROVALS	ENGINEER	DATE		City Engineer		Liquid Waste	<i>R. J. [Signature]</i>	11/18		A.C.E. - Design		Traffic	<i>[Signature]</i>	1-18		Hydrology		Water	<i>R. J. [Signature]</i>	11/18
APPROVALS	ENGINEER	DATE	APPROVALS	ENGINEER	DATE																				
	City Engineer		Liquid Waste	<i>R. J. [Signature]</i>	11/18																				
	A.C.E. - Design		Traffic	<i>[Signature]</i>	1-18																				
	Hydrology		Water	<i>R. J. [Signature]</i>	11/18																				

RECORD DRAWING Drawings revised to reflect the best information available. Do not use without full verification.	APPROVED FOR CONSTRUCTION DRAWING NO. 1960 MAP NO. SHEET 4-1 OF
---	--


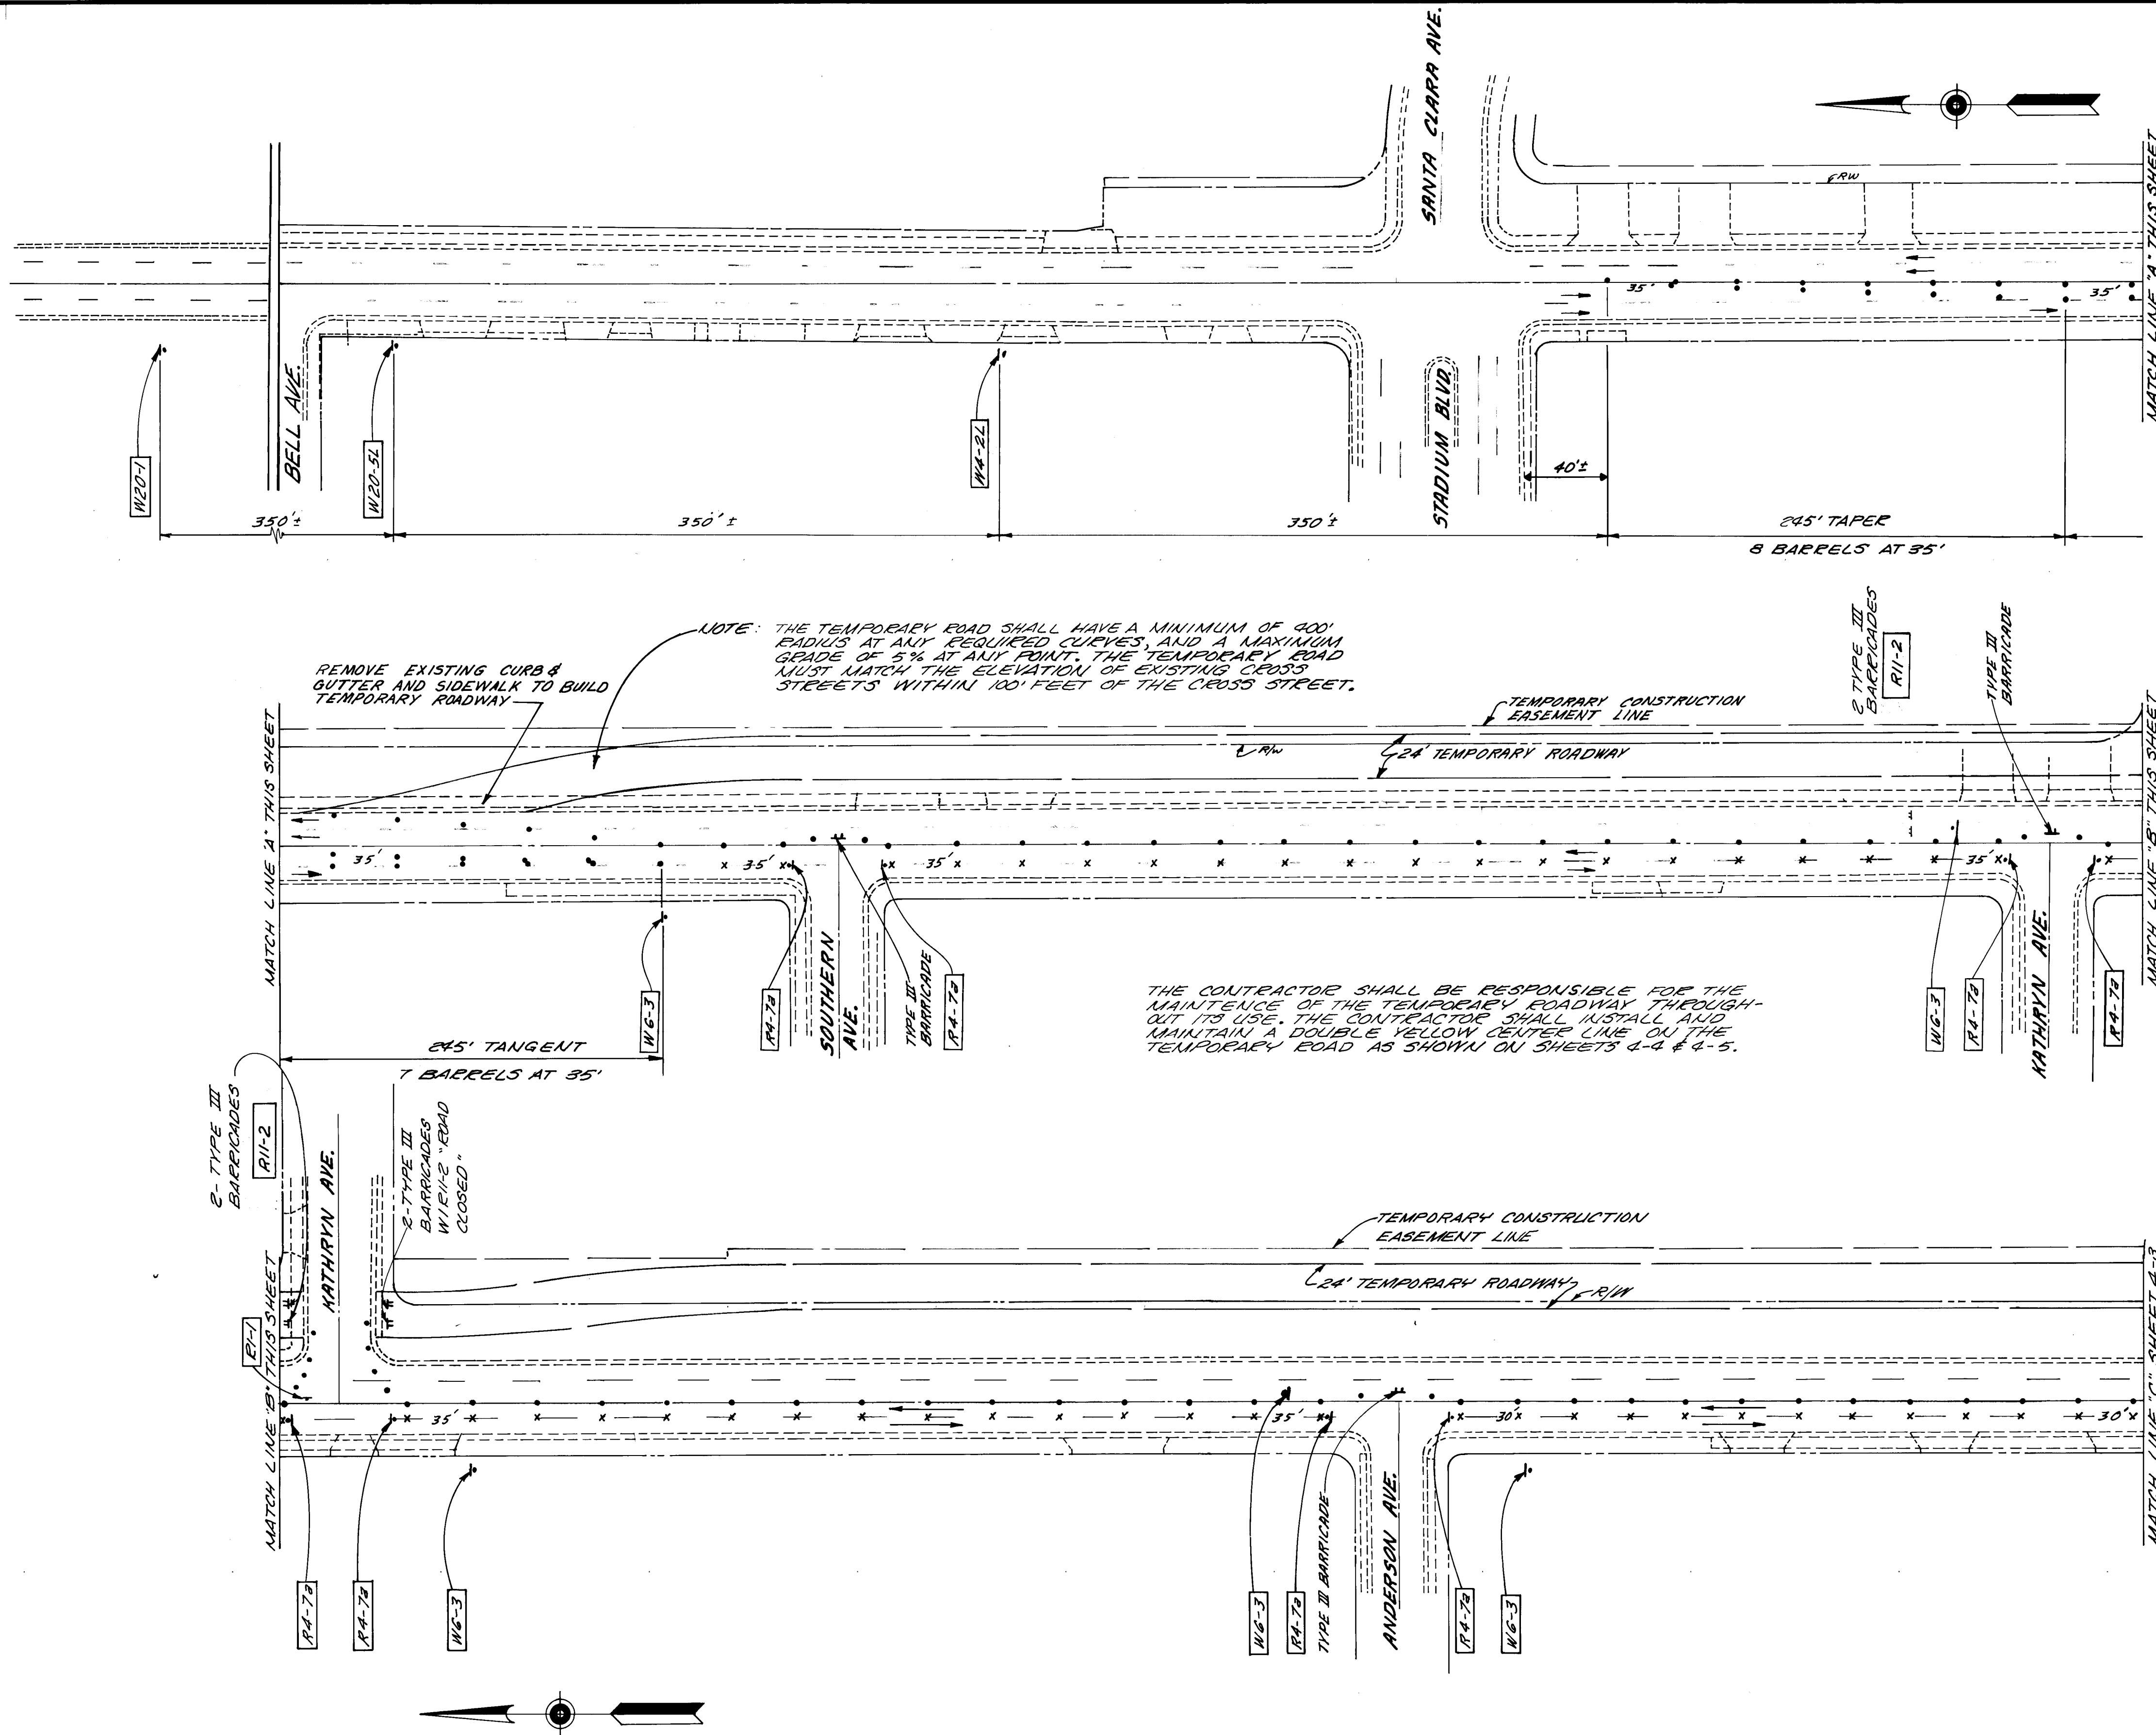


- PHASE I
- CONTRACTOR SHALL CONSTRUCT A TEMPORARY 24' WIDE ROAD INCLUDING ANY NECESSARY TEMPORARY DRAINAGE STRUCTURES TO THE EAST OF THE PRESENT ROAD USING NEWLY OBTAINED RIGHT-OF-WAY AND CONSTRUCTION EASEMENT IN SUCH A WAY THAT TWO-WAY TRAFFIC MAY BE MAINTAINED ON THE ROAD DURING THE INSTALLATION OF THE SEWER LINE. THE TEMPORARY DRAINAGE STRUCTURES SHALL HAVE THE SAME WATERWAY OPENING THAT PRESENTLY EXISTS. THE STRUCTURES SHALL BE FURNISHED AND INSTALLED AS PART OF THE TEMPORARY ROADWAY AND SHALL BE REMOVED AND REMAIN THE PROPERTY OF THE CONTRACTOR AFTER USE. THIS WORK SHALL BE INCIDENTAL TO CONSTRUCTION OF THE SEWER LINE.
 - TRAFFIC MAY BE DETOURED AS SHOWN IN ORDER TO INSTALL THE TEMPORARY ROAD.
 - THE MEDIAN NORTH OF GIBSON ON YALE WILL HAVE TO BE REMOVED AS SHOWN IN ORDER TO INSTALL THE TEMPORARY ROAD.
 - ACCESS MUST BE MAINTAINED TO BUSINESSES AT ALL TIMES. ADDITIONAL BARRICADES AND ACCESS SIGNS SHALL BE PROVIDED BY THE CONTRACTOR IN ORDER TO INSURE THAT ACCESS IS MAINTAINED.

PLANS PREPARED UNDER THE DIRECTION OF		CITY OF ALBUQUERQUE DEPARTMENT OF TRANSPORTATION	
		TITLE: YALE BOULEVARD WIDENING STADIUM BLVD. TO GIBSON BLVD. TRAFFIC CONTROL - PHASE I	
APPROVALS	ENGINEER	DATE	APPROVALS
City Engineer			Liquid Waste
A.C.E. - Design	W.I. Matotian	1/21/85	Traffic
A.C.E. - Hydrology	W.I. Matotian	1/14/85	Water
APPROVED FOR CONSTRUCTION		DESIGN	
CITY ENGINEER	DATE	DESIGNED BY	DATE
		W.I.B.	11-84
DRAWING NO. 1960		DRAWN BY	DATE
		GM/JJS/JT	11-84
MAP NO. L-1582-16		CHECKED BY	DATE
		W.I.B./GM	11-84
SHEET 4-2 OF			

26 19602387

RECORD DRAWING
Drawings revised to reflect the best information available. Do not use without field verification.

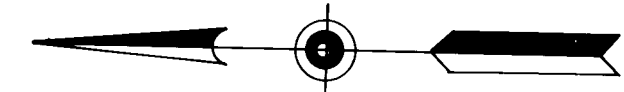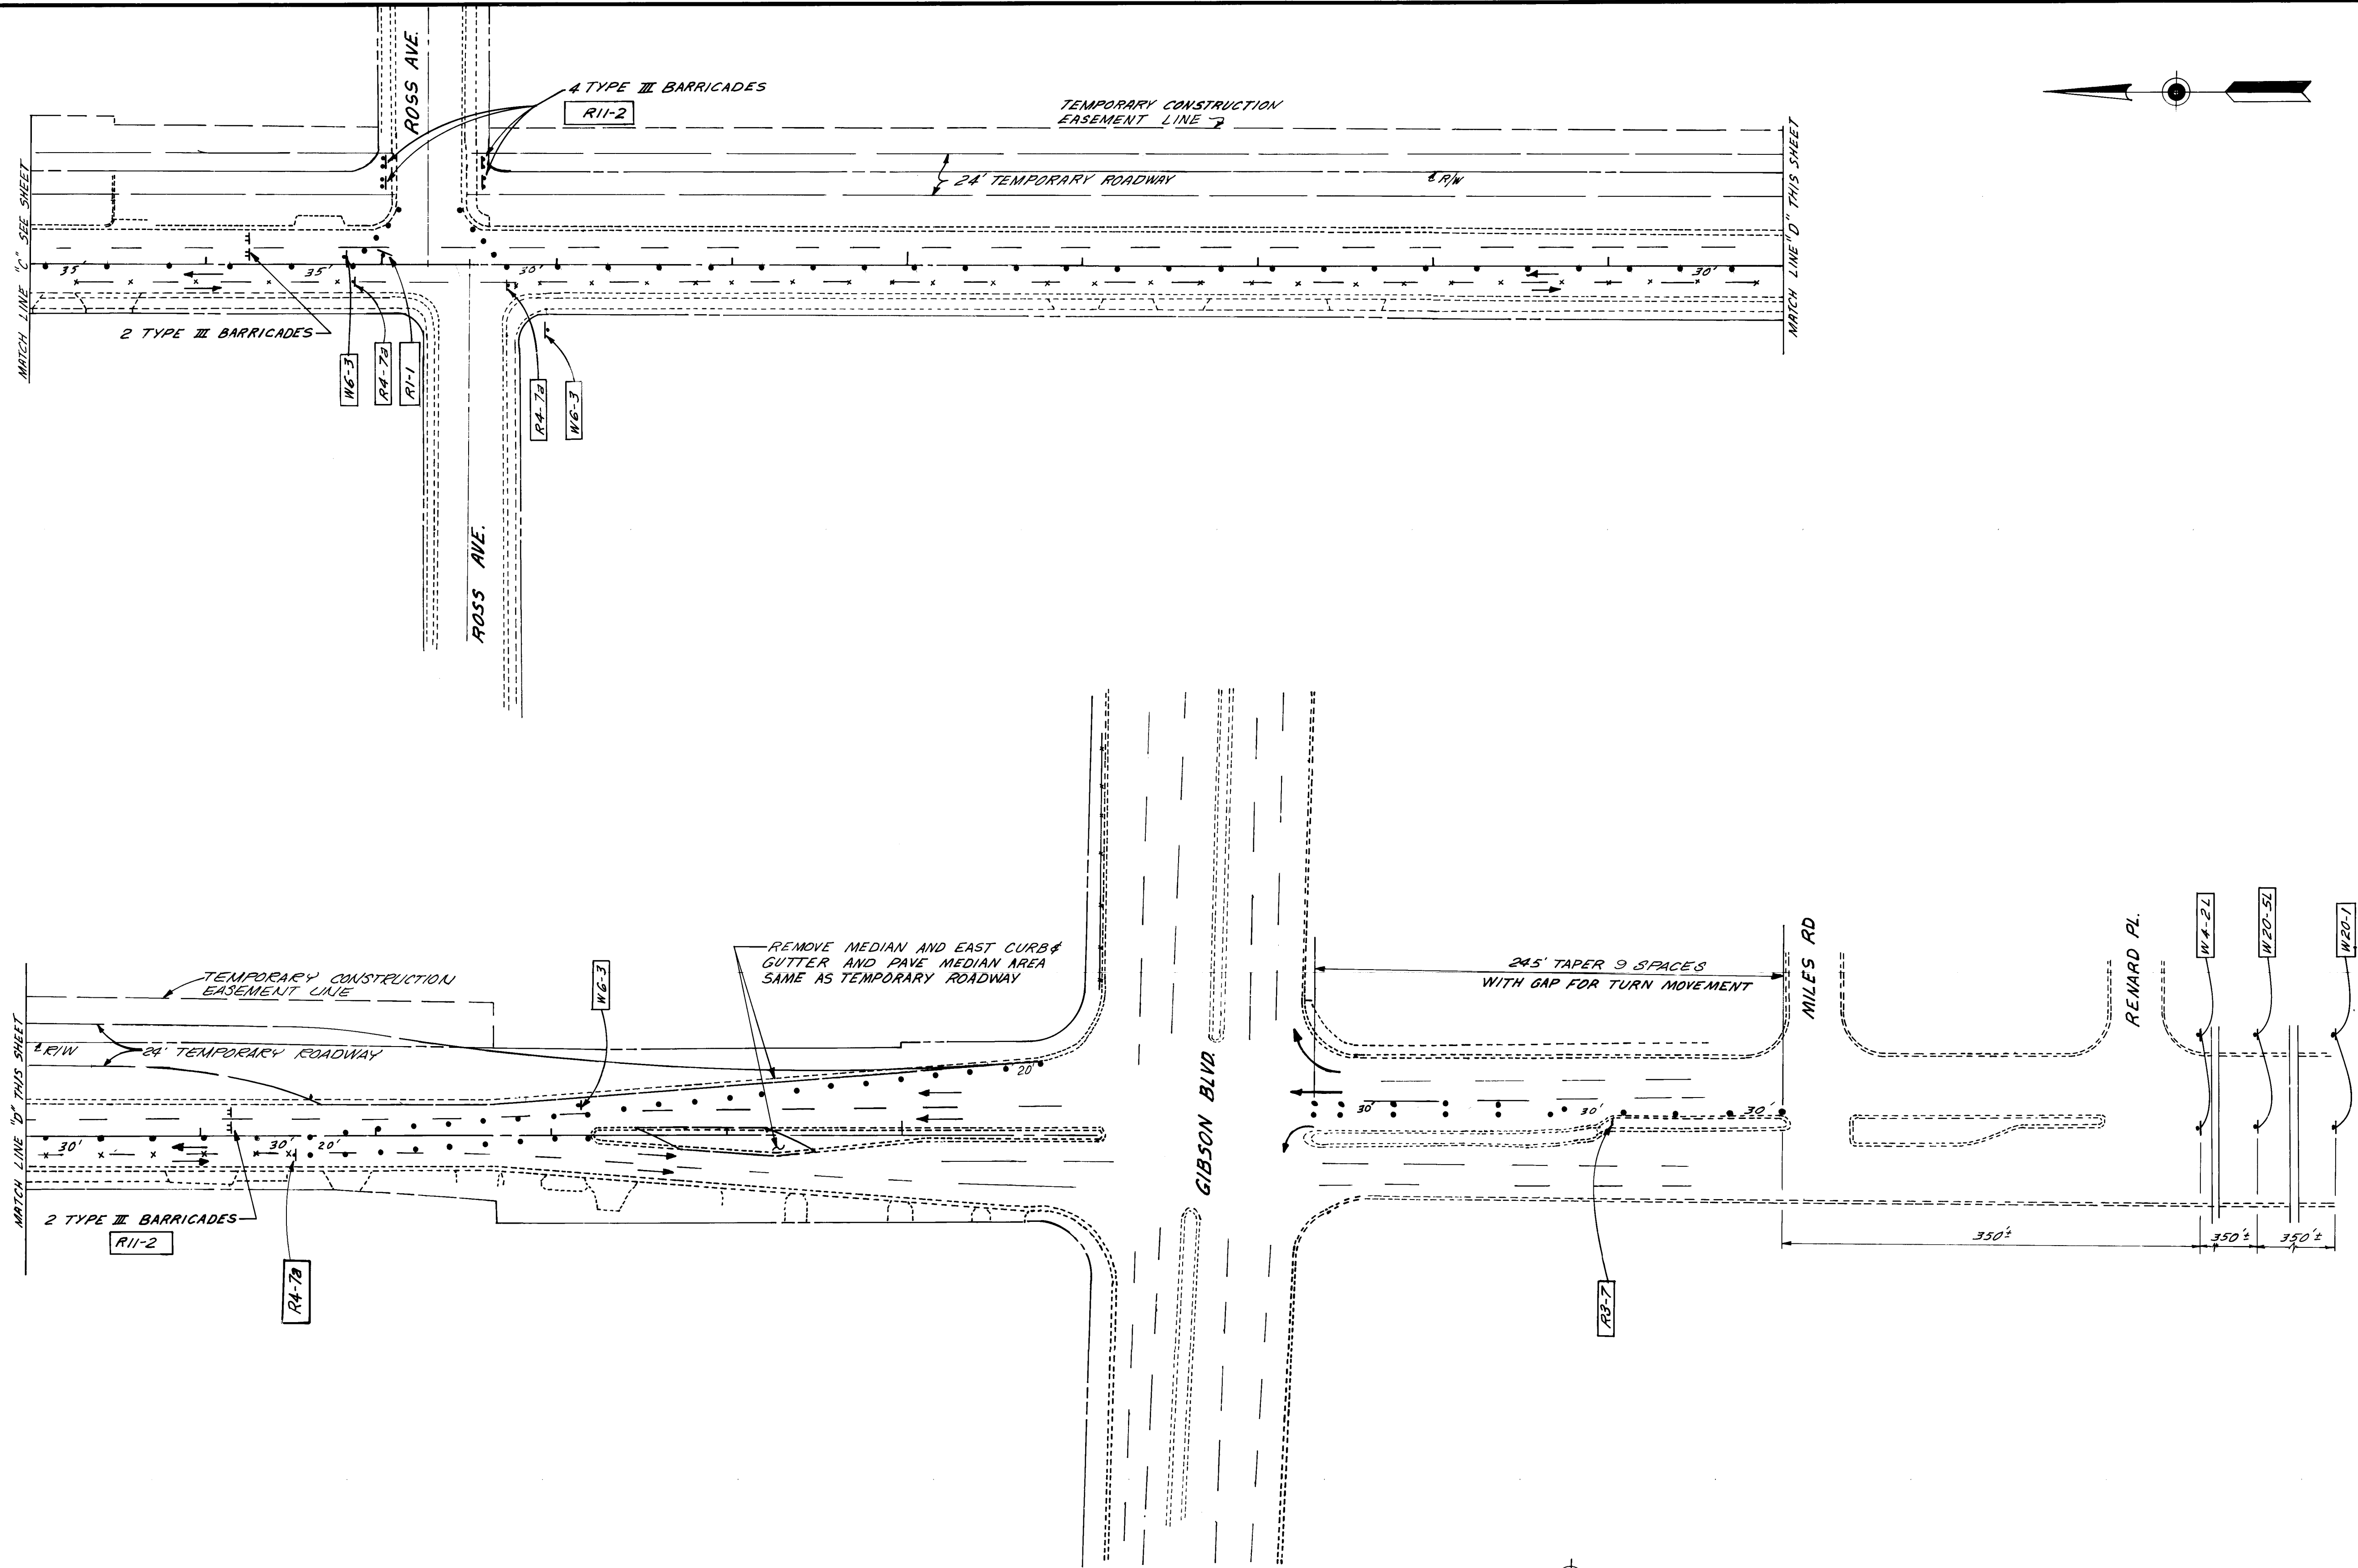

PLANS PREPARED
UNDER THE DIRECTION OF


REGISTERED PROFESSIONAL ENGINEER
STATE OF
NEW MEXICO
No. 1593
WILLIAM I. MATOTAN

APPROVED FOR
CONSTRUCTION

CITY ENGINEER DATE

RECORD DRAWING
Drawings revised to reflect the
best information available. Do
not use without field verification.

CITY OF ALBUQUERQUE DEPARTMENT OF TRANSPORTATION					
TITLE: YALE BOULEVARD WIDENING STADIUM BLVD. TO GIBSON BLVD. TRAFFIC CONTROL - PHASE I					
APPROVALS	ENGINEER	DATE	APPROVALS	ENGINEER	DATE
City Engineer			Liquid Waste	R. Panta	1/14/85
A.C.E. - Design	W.C. Lee	1/14/85	Traffic	R. Panta	1-21-85
A.C.E. - Hydrology	Don Hays	1/14/85	Water	R. Panta	1/14/85
DRAWING NO. 1960			MAP NO. L-15 & L-16		
SHEET 4-3 OF 4			SHEET 4-3 OF 4		


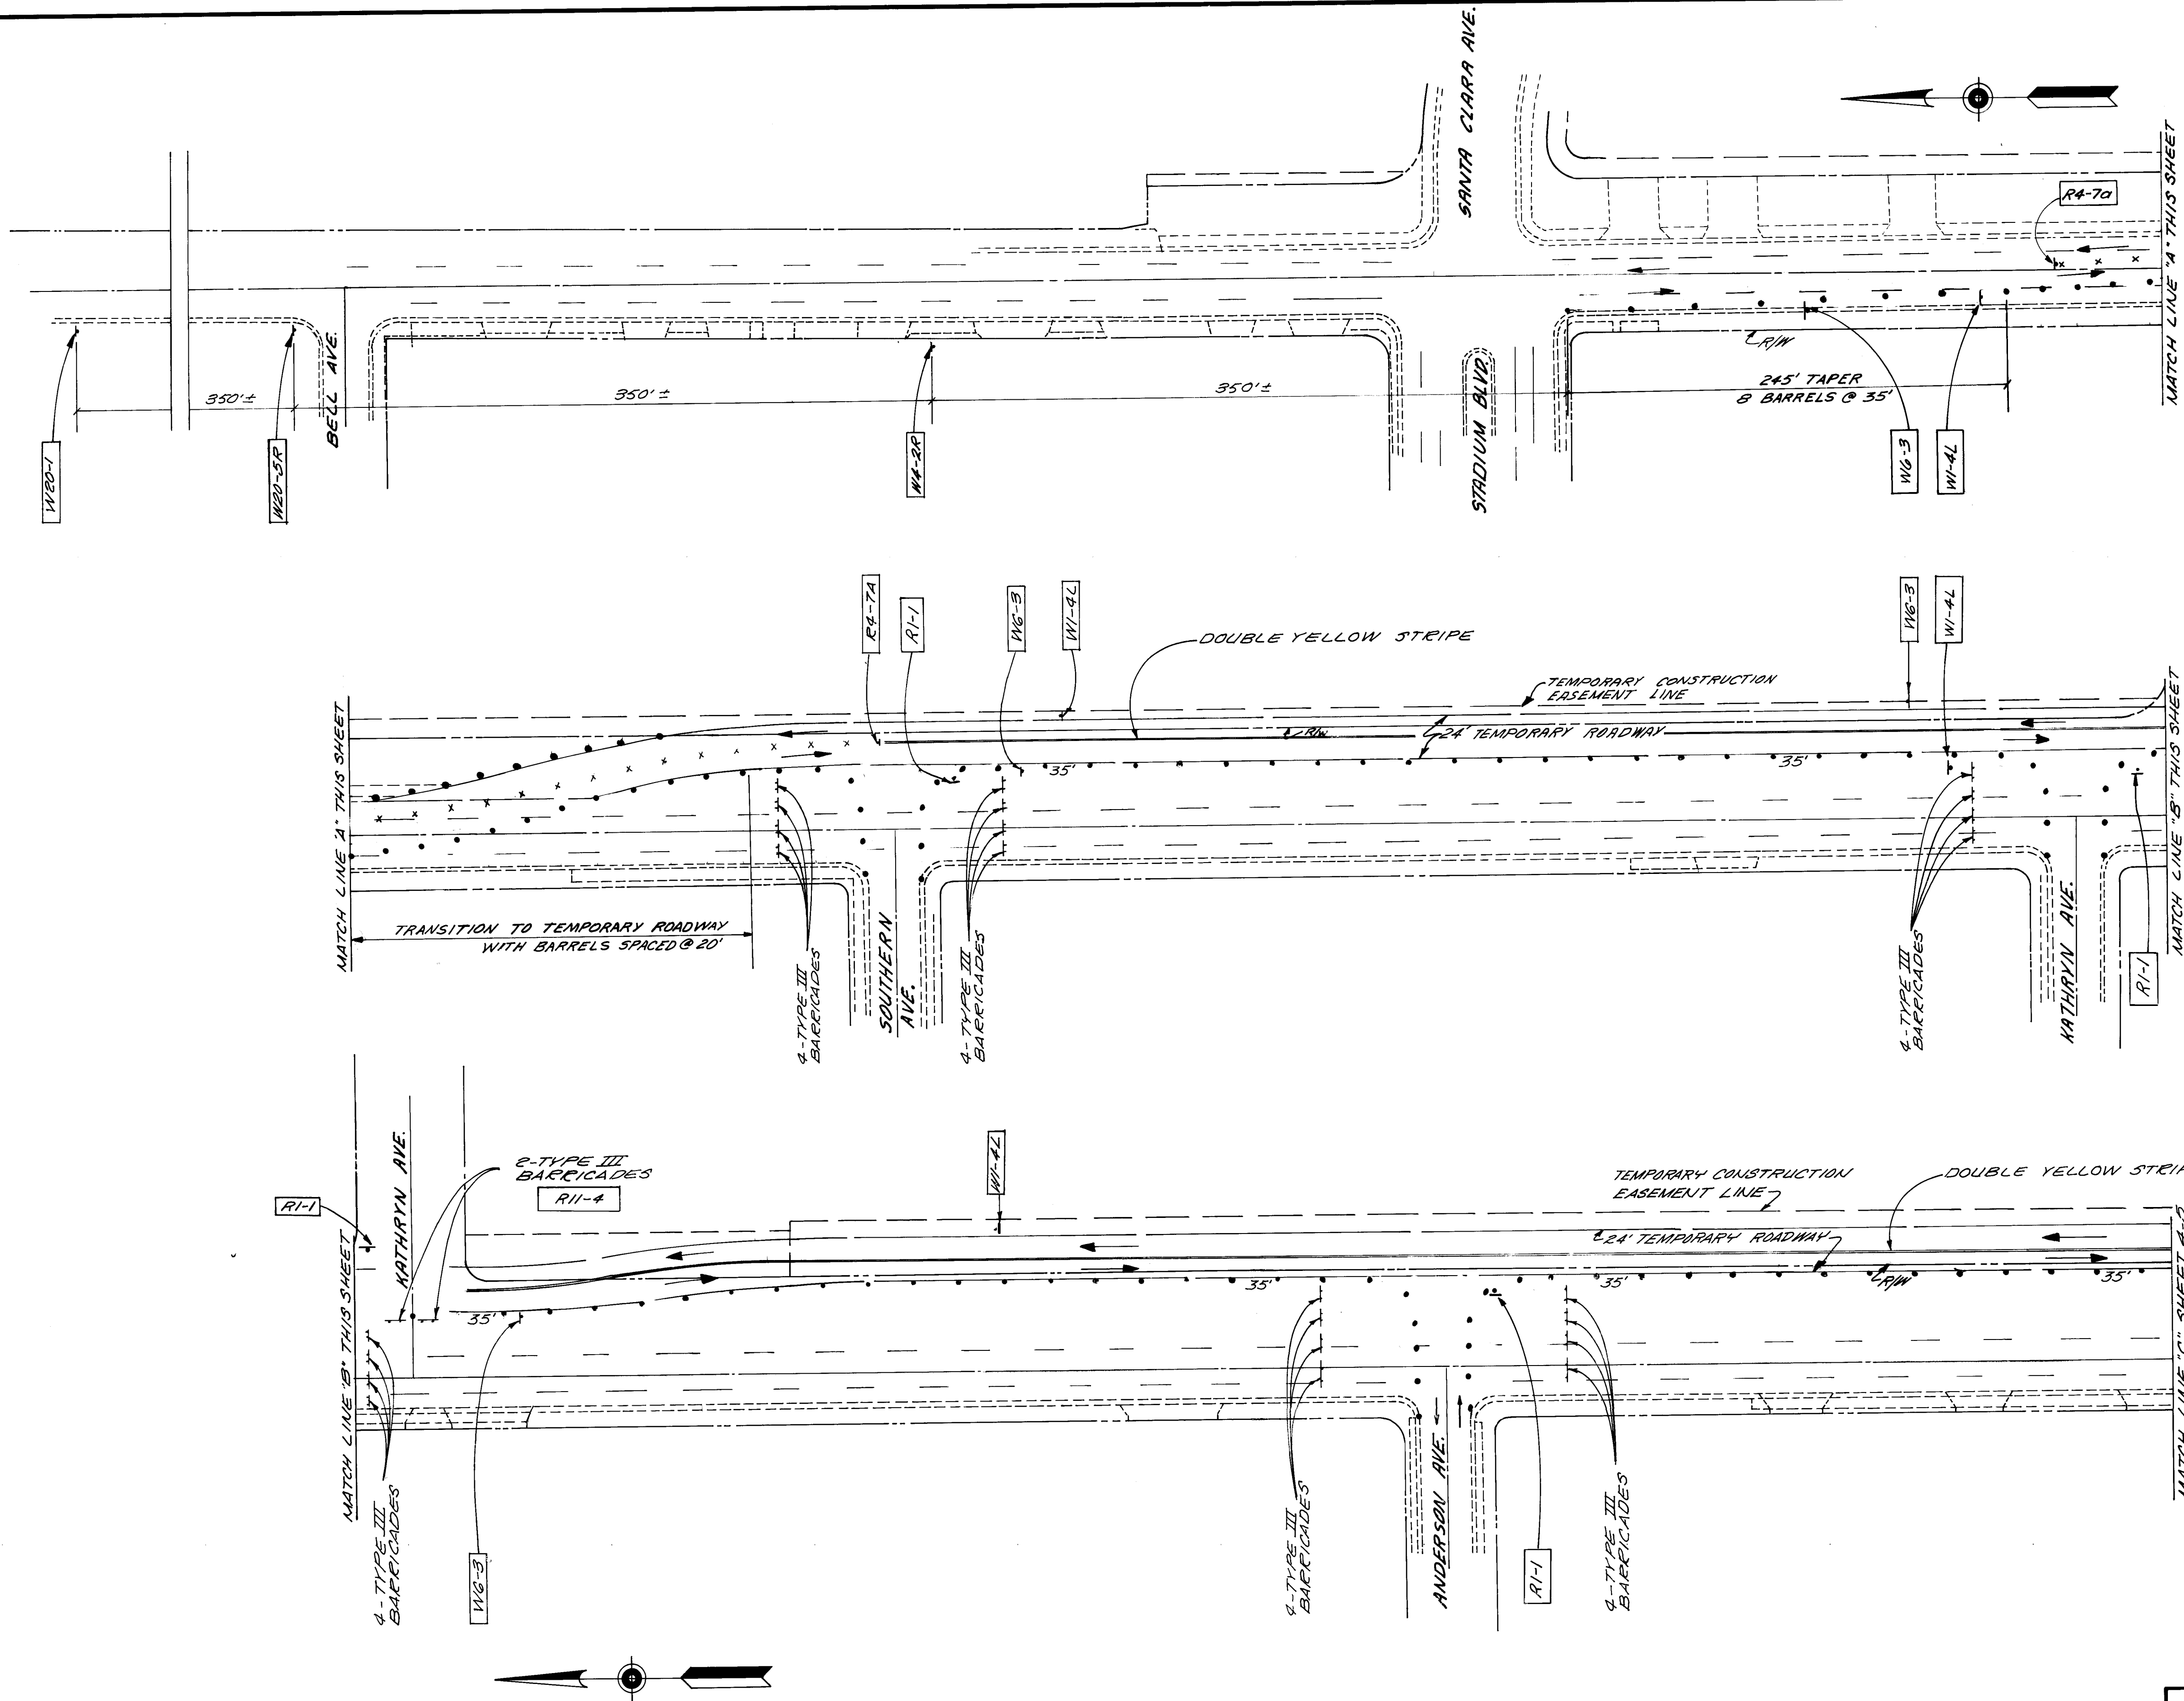


- PHASE II**
- 1.) TRAFFIC MAY BE DETOURED ONTO TEMPORARY ROAD AS SHOWN IN ORDER TO INSTALL SEWER LINE.
 - 2.) BARRICADES SHALL BE PLACED AT 10' INCREMENTS BETWEEN THE TEMPORARY ROAD AND EXCAVATION AND EXTEND 50 FEET FROM EACH END OF THE EXCAVATION IN PLACE OF BARRIERS. BARRIERS MAY BE PLACED AT 35' INCREMENTS AT OTHER TIMES. SHOULD THE EXCAVATION OF THE SEWER LINE COME WITHIN THREE (3) FEET OF THE TRAVEL WAY, JERSEY BARRIERS MEETING ALL APPLICABLE STATE REGULATIONS SHALL BE USED TO SEPARATE TRAFFIC FROM THE WORK AREA.
 - 3.) GIBSON MAY BE BLOCKED AS SHOWN IN PHASE II-A FOR MAXIMUM OF 10 DAYS IN ORDER TO INSTALL THE REMAINING PORTION OF THE SEWER LINE. A RAMP WILL BE REQUIRED AS SHOWN. THE CURB SHALL BE COMPLETELY CLEANSSED OF ALL ASPHALT DISCOLORATION UPON REMOVAL OF ASPHALT CONCRETE RAMP.
 - 4.) THE MEDIAN NORTH OF GIBSON ON YALE SHALL BE RECONSTRUCTED ACCORDING TO PLANS DURING THIS PHASE.
 - 5.) INSTALLATION OF THE NEW PAVEMENT ON THE WEST SIDE OF YALE MAY START AS SOON AS THE SEWER LINE IS INSTALLED.
 - 6.) THE CONTRACTOR SHALL NOT HAVE MORE THAN 200' OF OPEN TRENCH AT ANY GIVEN TIME.
 - 7.) ACCESS MUST BE MAINTAINED TO ALL BUSINESSES AND RESIDENCES AT ALL TIMES. ALL ADDITIONAL SIGNING AND BARRICADING REQUIRED TO ACCOMPLISH THIS SHALL BE CONSIDERED INCIDENTAL.

PLANS PREPARED UNDER THE DIRECTION OF		CITY OF ALBUQUERQUE DEPARTMENT OF TRANSPORTATION			
REGISTERED PROFESSIONAL ENGINEER No. 1593 NEW MEXICO WILLIAM I. MATOTAN		TITLE: YALE BOULEVARD WIDENING STADIUM BLVD. TO GIBSON BLVD. TRAFFIC CONTROL - PHASE II			
APPROVALS	ENGINEER	DATE	APPROVALS	ENGINEER	DATE
City Engineer			Liquid Waste	R. P. [Signature]	1/14/85
A.C.E. - Design	W. I. Matotan	1/14/85	Traffic	W. I. Matotan	1/21/85
A.C.E. - Hydrology	New Hagen	1/14/85	Water	R. P. [Signature]	1/14/85
DRAWING NO. 1960		MAP NO. L-15 & L-16		SHEET 44 OF	
CITY ENGINEER		DATE		DATE	


RECORD DRAWING
Drawings revised to reflect the best information available. Do not use without field verification.

15026031

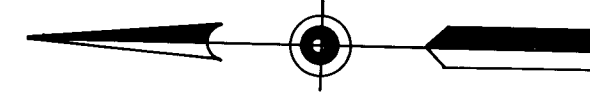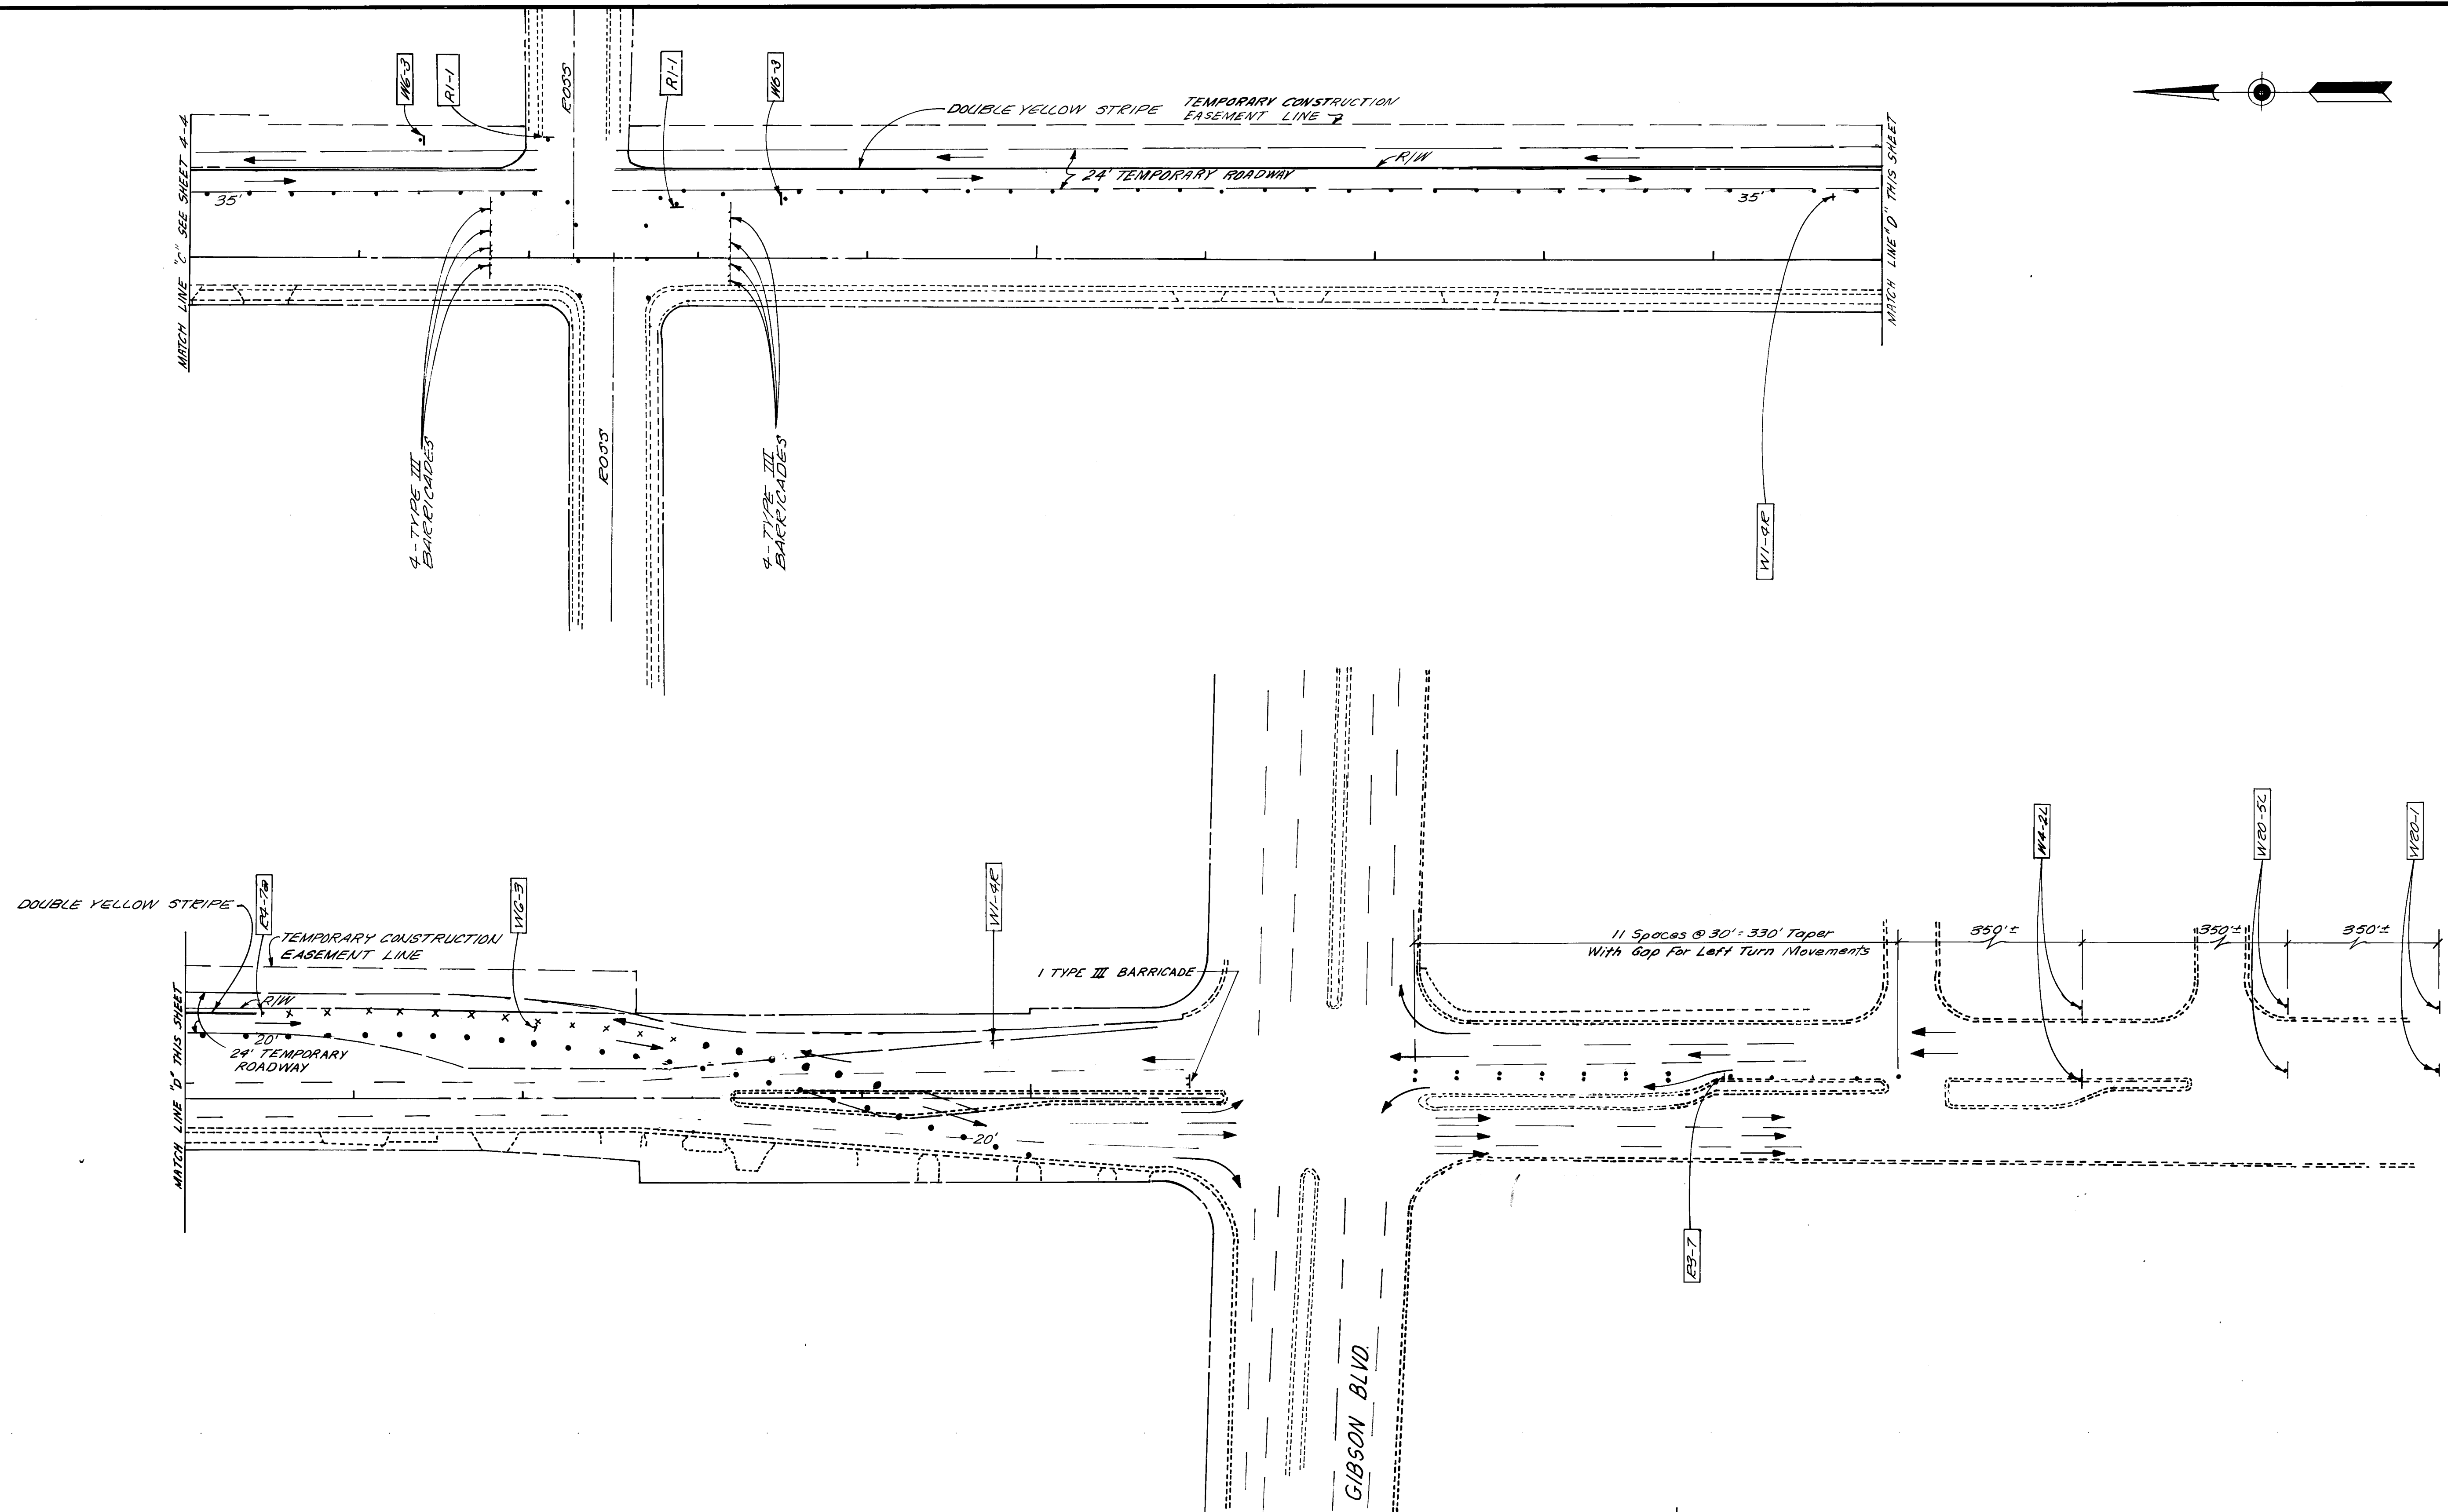

19602687

RECORD DRAWING
Drawings revised to reflect the best information available. Do not use without field verification.

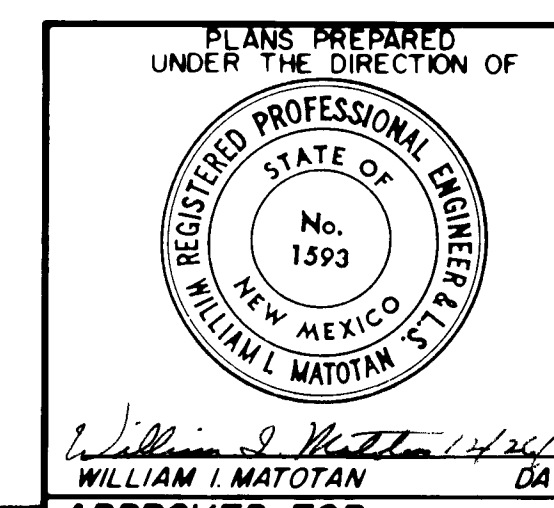


APPROVED FOR CONSTRUCTION
CITY ENGINEER DATE

CITY OF ALBUQUERQUE DEPARTMENT OF TRANSPORTATION					
TITLE: STADIUM BLVD. TO GIBSON BLVD. TRAFFIC CONTROL - PHASE II					
APPROVALS	ENGINEER	DATE	APPROVALS	ENGINEER	DATE
City Engineer			Liquid Waste	R. P. Hays	1/14/85
A.C.E. - Design	W. I. Matotan	1/14/85	Traffic	R. P. Hays	1/21/85
A.G.E. - Hydrology	Don Hays	1/14/85	Water	R. P. Hays	1/14/85
DRAWING NO. 1960		MAP NO. L-15&L-16		SHEET 4-5 OF	

REFERENCES		SURVEY INFORMATION		BENCH MARKS		AS BUILT INFORMATION	
MAP NO.	EST. NO.	W.O. NO.	NO.	BY	DATE	CONTRACTOR	LOANS Construction
						STAKED BY	City of Albuquerque
						INSPECTOR'S	DATE
						ACCEPTANCE BY	DATE
						VERIFICATION BY	DATE
						COMPLETED BY	DATE
						RECORDED BY	DATE
						NO.	

REVISIONS		MICRO-FILM INFORMATION	
NO.	DATE	NO.	DATE
1	11-84		
2	11-84		
3	11-84		

0726038

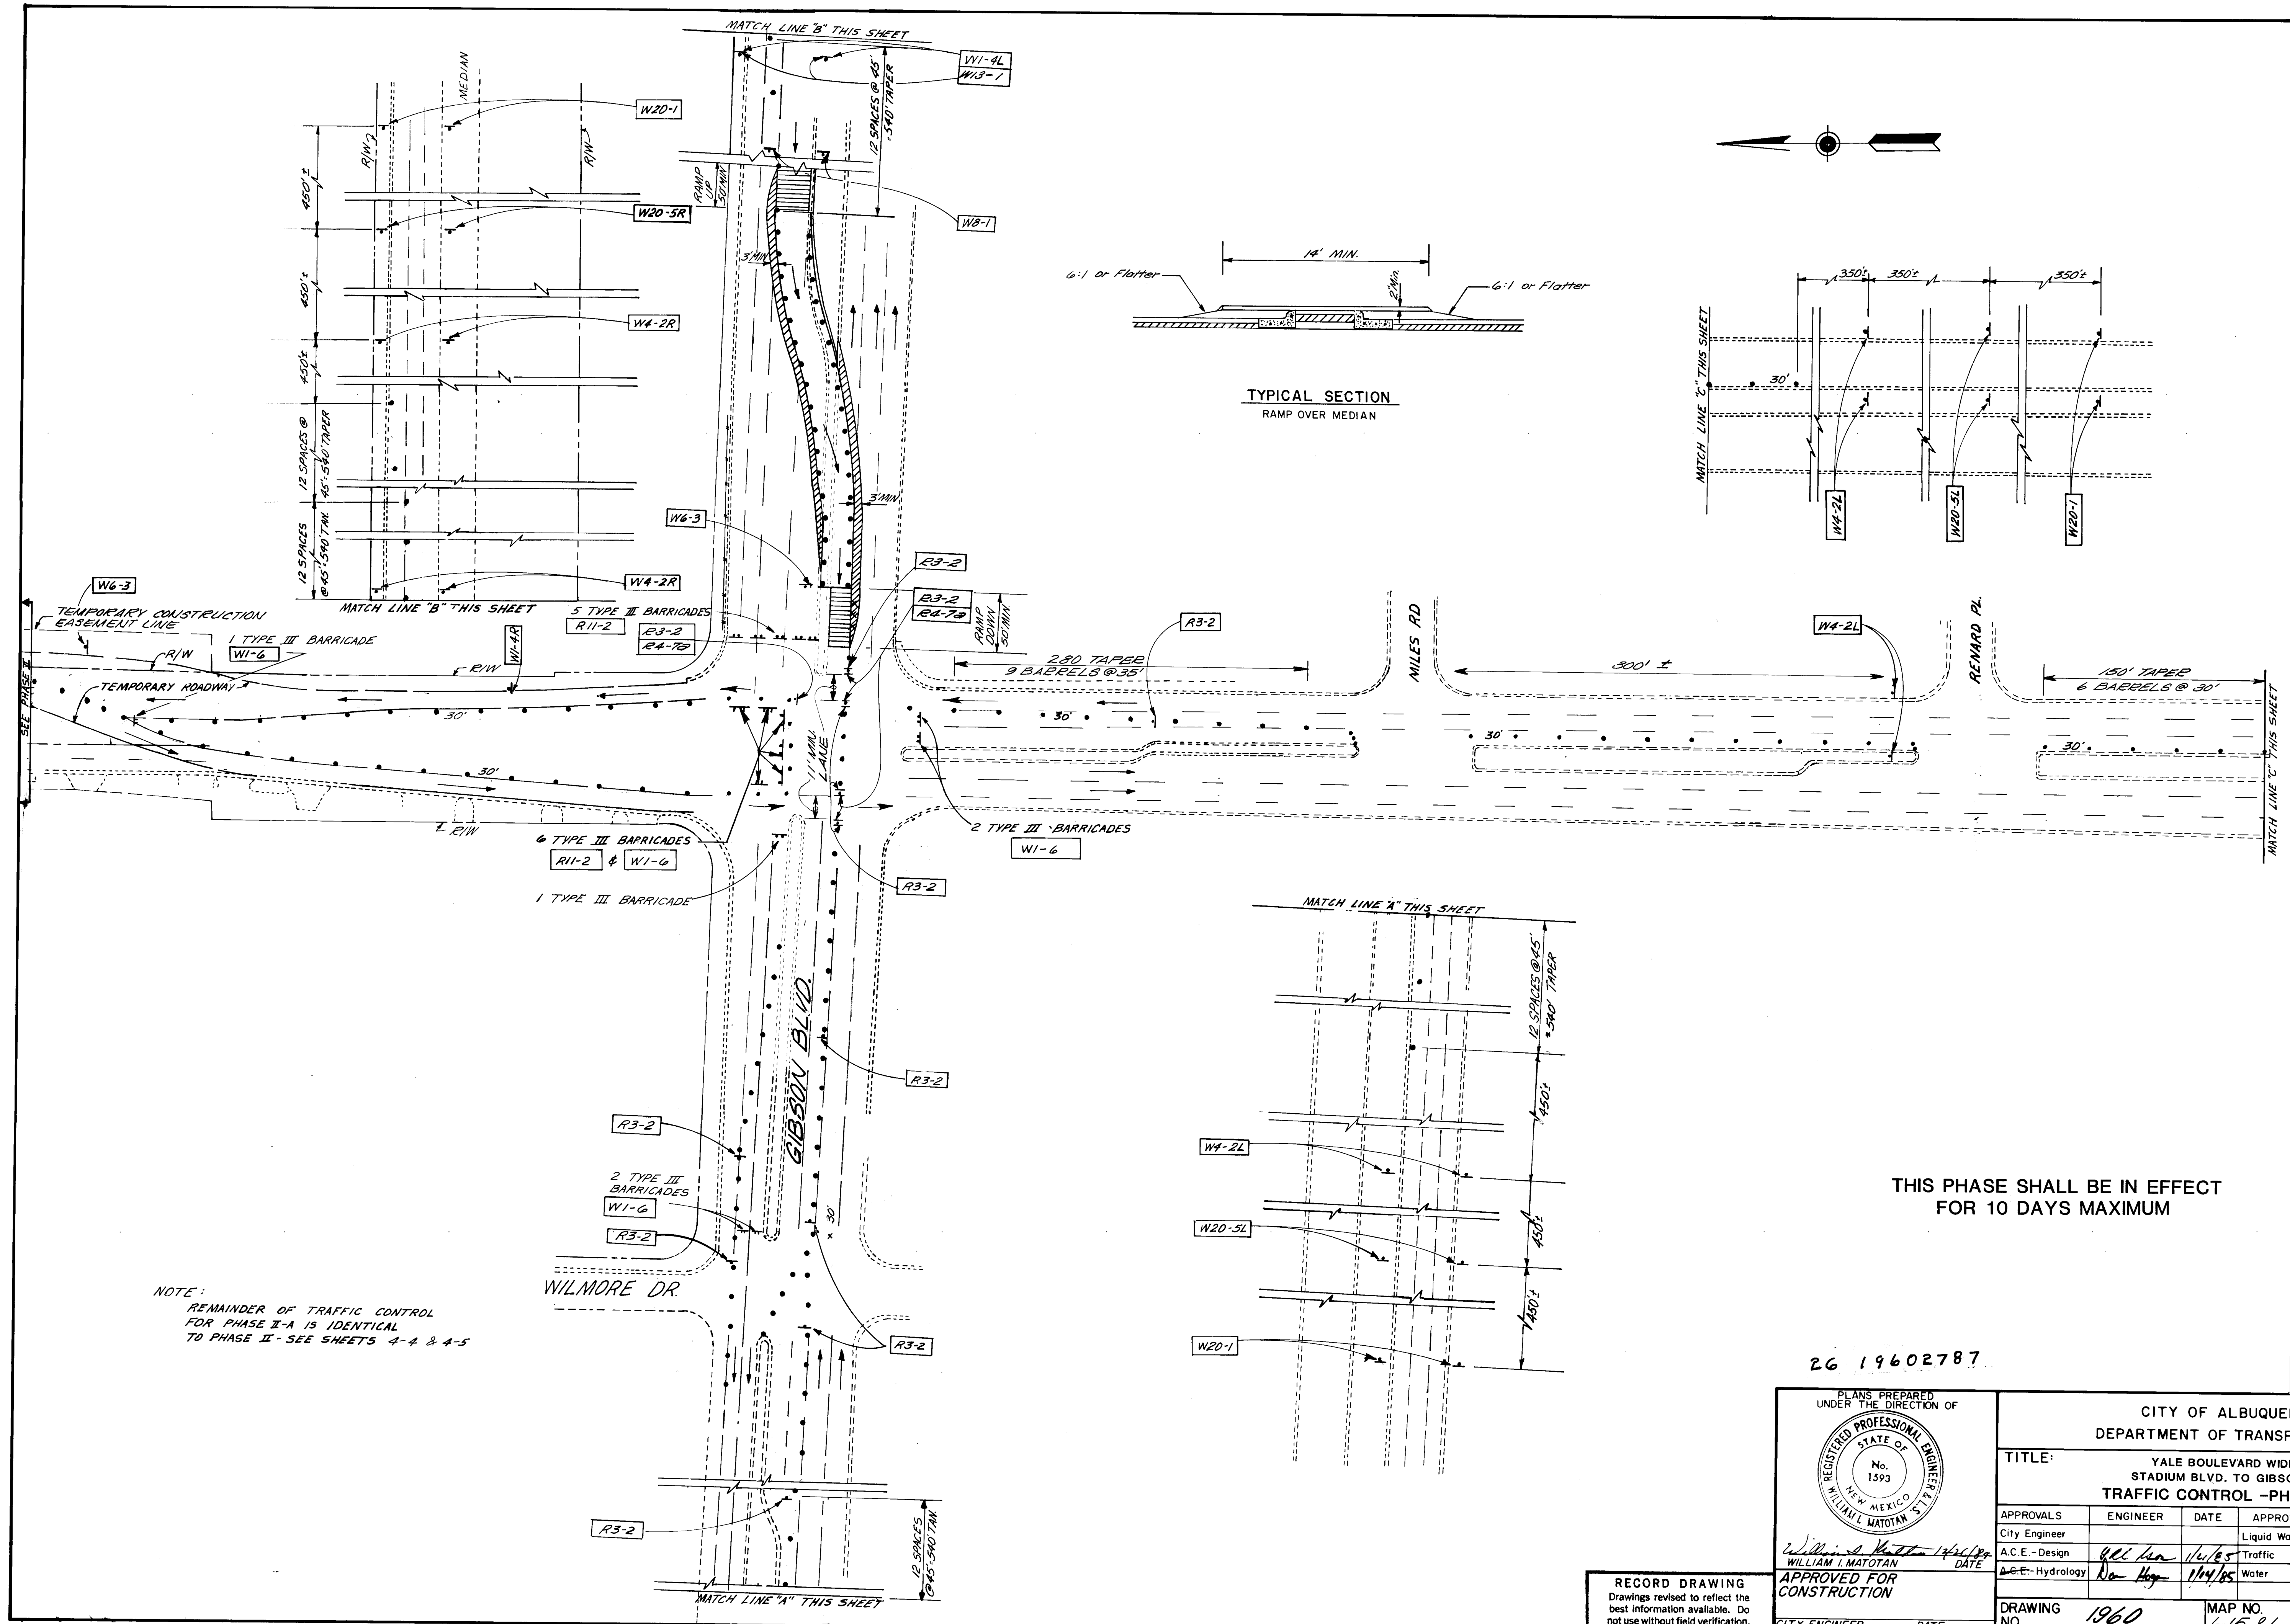


THIS PHASE SHALL BE IN EFFECT FOR 10 DAYS MAXIMUM


26 19602787

PLANS PREPARED UNDER THE DIRECTION OF REGISTERED PROFESSIONAL ENGINEER STATE OF NEW MEXICO No. 1593 WILLIAM I. MATOTAN DATE 1/14/85 APPROVED FOR CONSTRUCTION CITY ENGINEER DATE		CITY OF ALBUQUERQUE DEPARTMENT OF TRANSPORTATION TITLE: YALE BOULEVARD WIDENING STADIUM BLVD. TO GIBSON BLVD. TRAFFIC CONTROL - PHASE II-A			
APPROVALS	ENGINEER	DATE	APPROVALS	ENGINEER	DATE
City Engineer			Liquid Waste	R. P. 1/14/85	
A.C.E. - Design	W. I. Matotan	1/14/85	Traffic	R. P. 1/14/85	
A.C.E. - Hydrology	R. H. 1/14/85		Water	R. P. 1/14/85	
DRAWING NO. 1960		MAP NO. L-15 & L-16		SHEET 4-6 OF	

RECORD DRAWING
Drawings revised to reflect the best information available. Do not use without field verification.

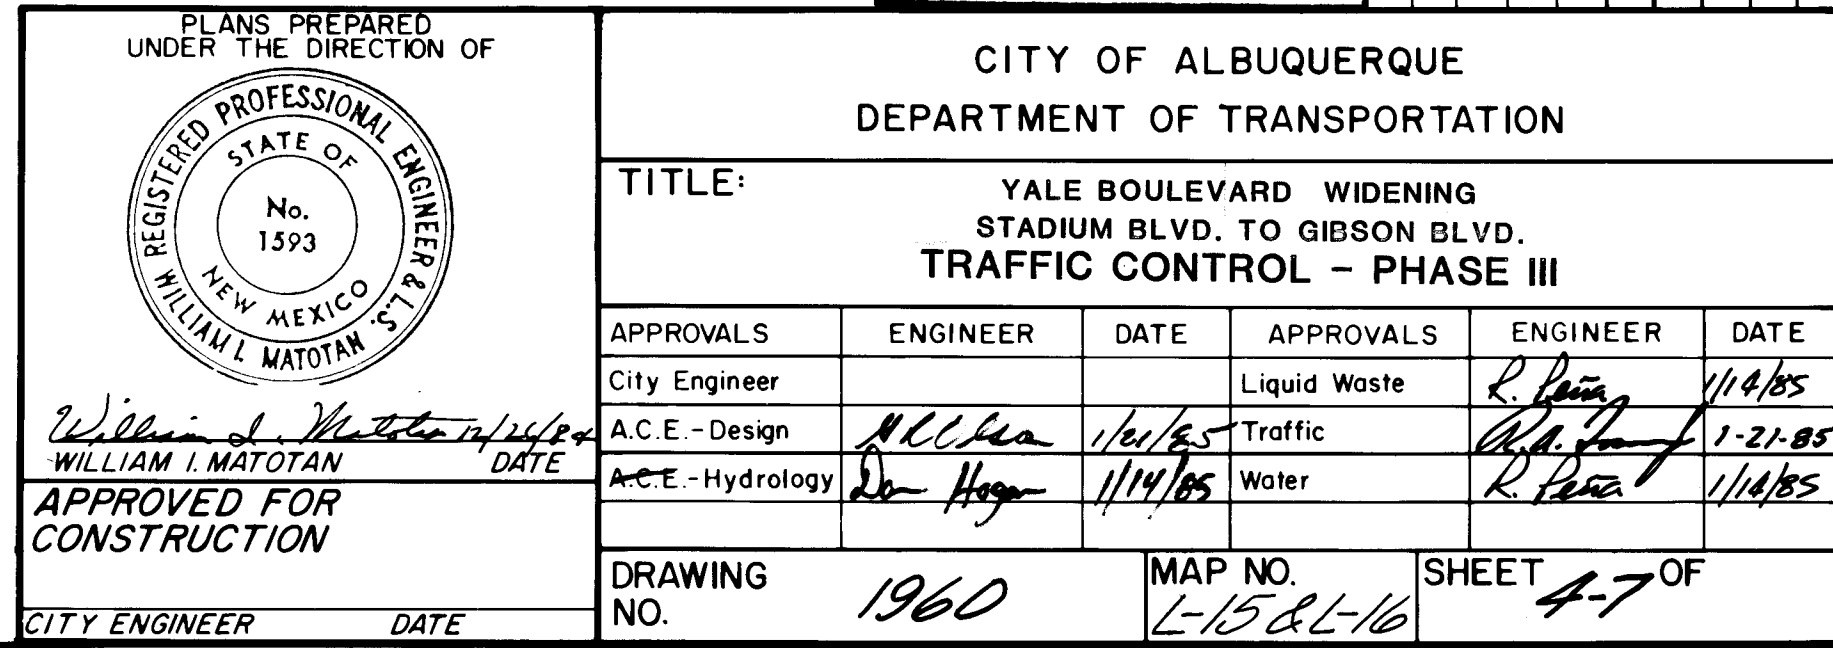


0726035

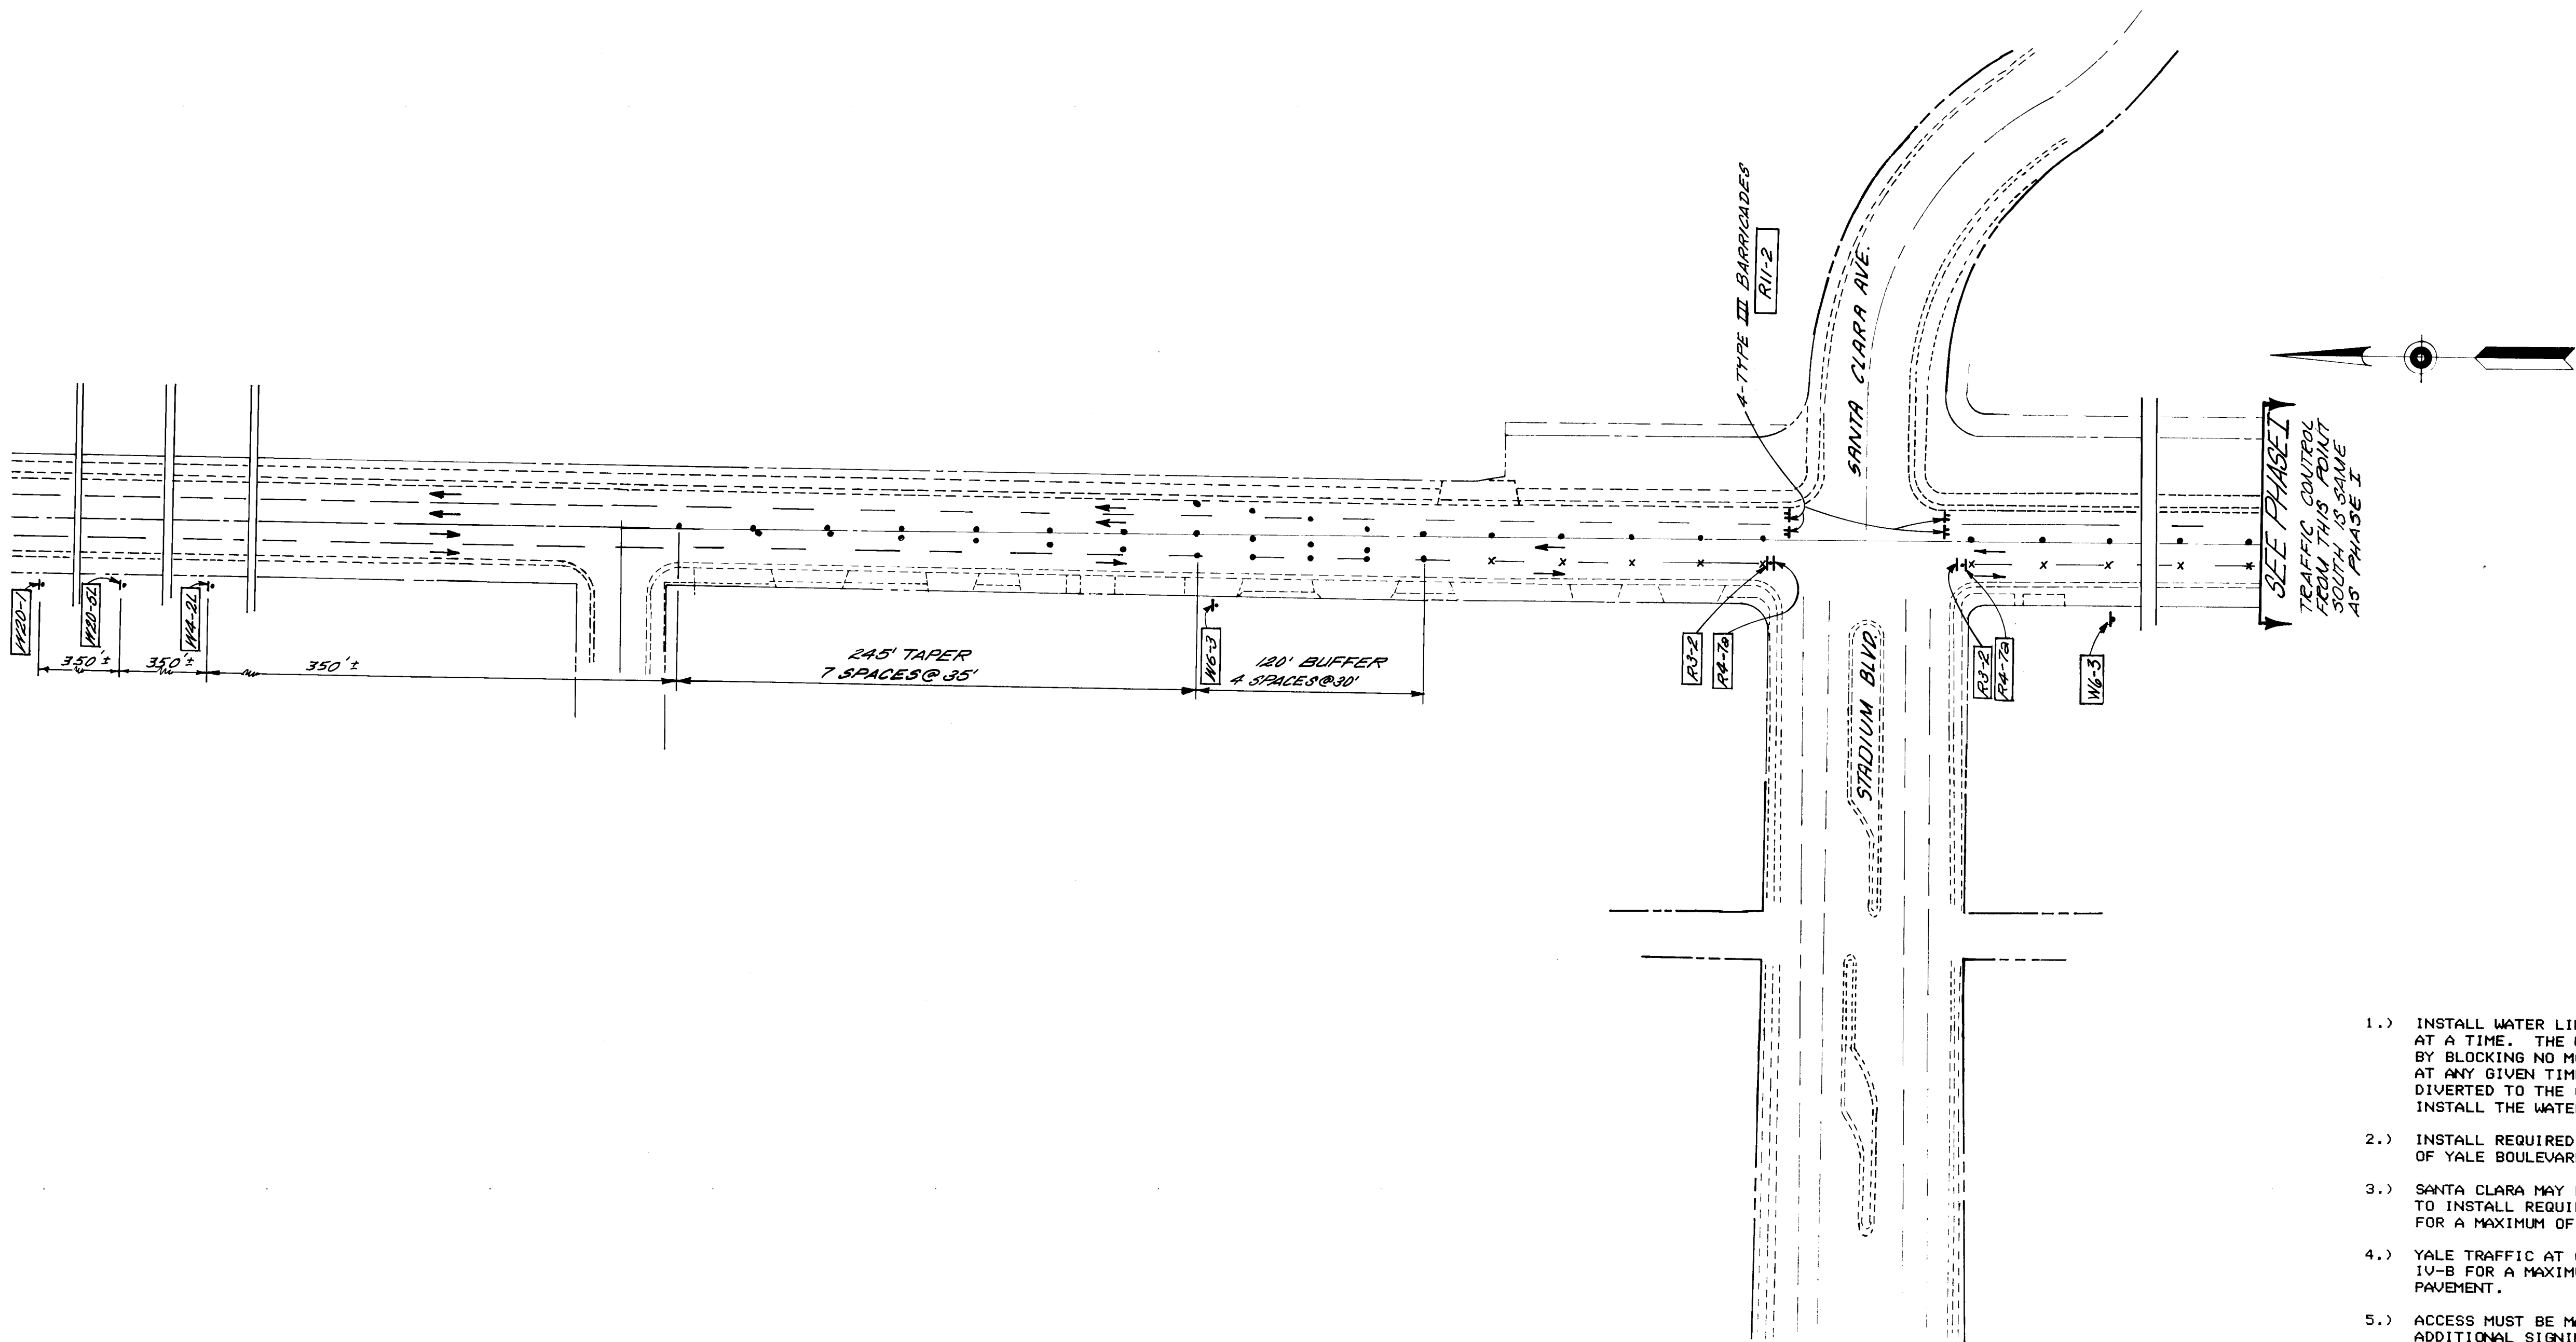

PHASE IV

- 1.) INSTALL WATER LINE IN NO MORE THAN 200' OF OPEN TRENCH AT A TIME. THE WATER LINE TIE-IN ON GIBSON SHALL BE DONE BY BLOCKING NO MORE THAN TWO LANES OF TRAFFIC ON GIBSON AT ANY GIVEN TIME. AT NO TIME SHALL GIBSON TRAFFIC BE DIVERTED TO THE OPPOSITE SIDE OF THE MEDIAN IN ORDER TO INSTALL THE WATER LINE OR PATCH THE CONCRETE INTERSECTION.
- 2.) INSTALL REQUIRED CURB, GUTTER AND PAVEMENT ON THE EAST SIDE OF YALE BOULEVARD.
- 3.) SANTA CLARA MAY BE BLOCKED AS SHOWN IN PHASE IV-A IN ORDER TO INSTALL REQUIRED PAVEMENT. SANTA CLARA MAY BE BLOCKED FOR A MAXIMUM OF 15 DAYS. INSTALL REQUIRED MEDIANS.
- 4.) YALE TRAFFIC AT GIBSON MAY BE DETOURED AS SHOWN IN PHASE IV-B FOR A MAXIMUM OF 15 DAYS IN ORDER TO INSTALL REQUIRED PAVEMENT.
- 5.) ACCESS MUST BE MAINTAINED TO ALL BUSINESSES AT ALL TIMES. ADDITIONAL SIGNING AND BARRICADING SHALL BE SUPPLIED BY THE CONTRACTOR.

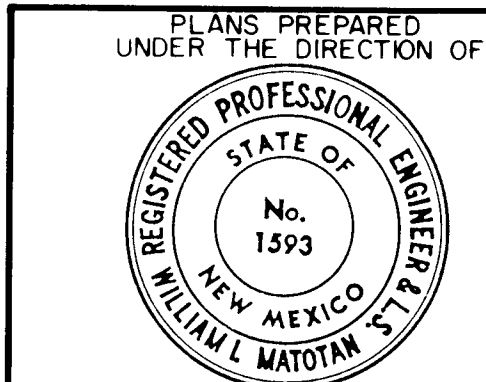

WILLIAM I. MATOTIAN
DATE 12/14/84

APPROVED FOR
CONSTRUCTION

CITY ENGINEER DATE

RECORD DRAWING
Drawings revised to reflect the
best information available. Do
not use without field verification.

CITY OF ALBUQUERQUE
DEPARTMENT OF TRANSPORTATION


TITLE:
YALE BOULEVARD WIDENING
STADIUM BLVD. TO GIBSON BLVD.
TRAFFIC CONTROL - PHASE IV

APPROVALS	ENGINEER	DATE	APPROVALS	ENGINEER	DATE
City Engineer			Liquid Waste	R. Pina	11/18/85
A.C.E. - Design	ACI/11/11	11/21/85	Traffic	R. Pina	11/21/85
A.E.E. - Hydrology	Don Hoyt	11/14/85	Water	R. Pina	11/14/85

DRAWING NO. 1960 MAP NO. L-15 & L-16 SHEET 48 OF 48

REFERENCES		SURVEY INFORMATION		BENCH MARKS		AS BUILT INFORMATION	
MAP NO.	EST. NO.	W.O. NO.	NO.	BY	DATE	CONTRACTOR	Loomis Construction
						WORK	STAKED BY
							City of Albuquerque
							DATE 8/86
							ACCEPTANCE BY
							DATE
							FIELD LOCATION BY
							DATE
							DRAWINGS
							CORRECTED BY
							W.M.A.
							DATE 6-86
							RECORDED BY
							DATE
							NO.

0116026

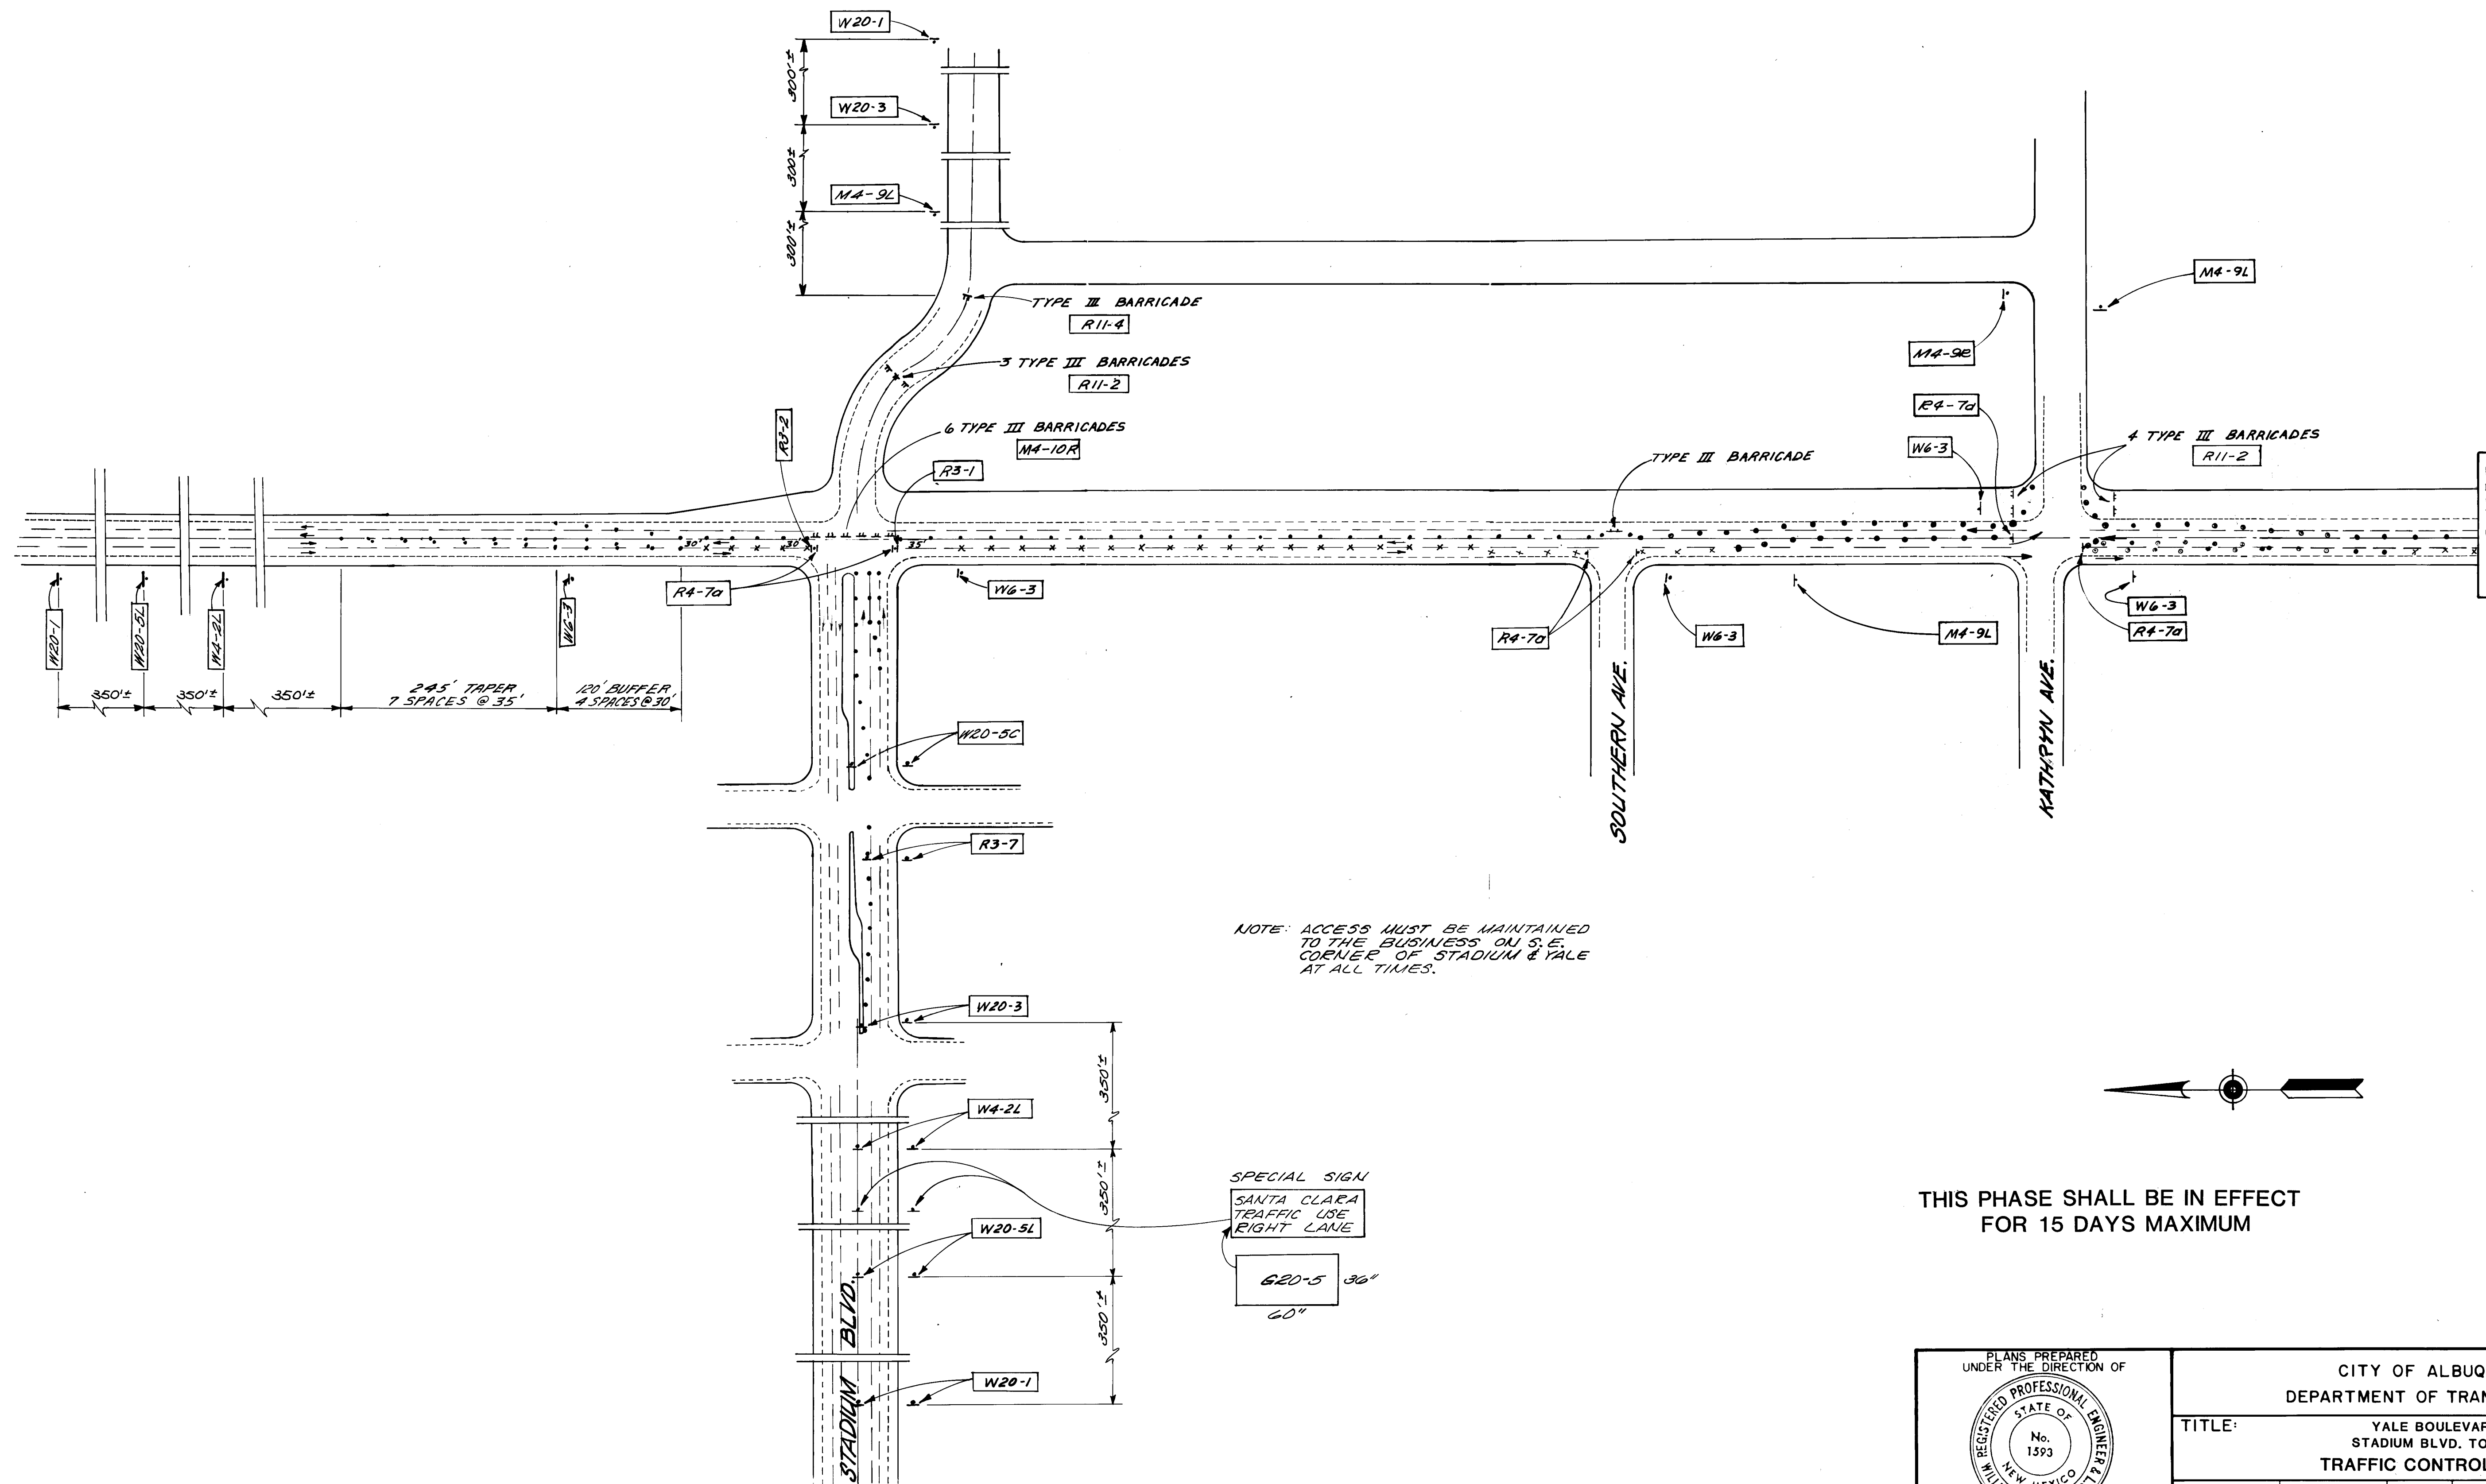

NOTE: ACCESS MUST BE MAINTAINED TO THE BUSINESS ON S.E. CORNER OF STADIUM & YALE AT ALL TIMES.

SPECIAL SIGN
SANTA CLARA
TRAFFIC USE
RIGHT LANE
G20-5 36"
60"

THIS PHASE SHALL BE IN EFFECT FOR 15 DAYS MAXIMUM

PLANS PREPARED UNDER THE DIRECTION OF						CITY OF ALBUQUERQUE DEPARTMENT OF TRANSPORTATION					
						TITLE: YALE BOULEVARD WIDENING STADIUM BLVD. TO GIBSON BLVD. TRAFFIC CONTROL - PHASE IV-A					
						APPROVALS					
City Engineer		ENGINEER		DATE		APPROVALS		ENGINEER		DATE	
A.C.E. - Design		WLC		11/1/85		Liquid Waste		R. Hays		11/14/85	
A.C.E. - Hydrology		Don Hays		11/14/85		Water		R. Hays		11/14/85	
DRAWING NO. 1960						MAP NO. L-15&L-16		SHEET 4-9 OF			

RECORD DRAWING
Drawings revised to reflect the best information available. Do not use without field verification.

AS BUILT INFORMATION		BENCH MARKS		SURVEY INFORMATION		REFERENCES		REVISIONS		DESIGN	
CONTRACTOR	Loomis Construction	STAKED BY	City of Albuquerque	DATE	05/82	MAP NO.	EST. NO.	W.O. NO.	BY	DATE	DATE
INSPECTOR'S		ACCEPTANCE BY		DATE							
VERIFICATION BY		DATE									
DRAWINGS BY	W.M.A.	DATE	0-86								
REVISIONS											
MICRO-FILM INFORMATION											
RECORDED BY		DATE									
NO.											

26 19603087

27



PLANS PREPARED
UNDER THE DIRECTION OF



WILLIAM L. MATOTIAN

DATE 1/14/85

APPROVED FOR
CONSTRUCTION

CITY ENGINEER DATE

CITY OF ALBUQUERQUE
DEPARTMENT OF TRANSPORTATION

TITLE: YALE BOULEVARD WIDENING
STADIUM BLVD. TO GIBSON BLVD.
TRAFFIC CONTROL - PHASE IV-B

APPROVALS	ENGINEER	DATE	APPROVALS	ENGINEER	DATE
City Engineer			Liquid Waste	<i>R. Pina</i>	<u>1/14/85</u>
A.C.E. - Design	<i>W.C. Lee</i>	<u>1/14/85</u>	Traffic	<i>R. Pina</i>	<u>1-21-85</u>
A.C.E. - Hydrology	<i>Don Nguyen</i>	<u>1/14/85</u>	Water	<i>R. Pina</i>	<u>1/14/85</u>

DRAWING NO. 1960

MAP NO. L-155 & L-16

SHEET 4-10 OF

CHART TO DETERMINE SINGLE POST SIZE Δ


POST SIZE	K FACTOR (B x A)	5	6	7	8	9	10	11	12	13	14	15	16	A(FT ²) SIGN AREA
200LB/FT	DOES NOT APPLY				3.9				3.7	3.4	3.2	2.9	2.8	
225LB/FT					5.1			4.6	4.2	3.9	3.6	3.4	3.2	
275LB/FT					6.7			6.0	5.5	5.1	4.7	4.4	4.1	
300LB/FT					7.3			6.7	6.2	5.6	5.1	5.0		
400LB/FT					9.4				8.6	8.0	7.5	7.0		

CHART TO DETERMINE DOUBLE POST SIZE Δ


POST SIZE	K FACTOR (B x A)	5	6	7	8	9	10	11	12	13	14	15	16	A(FT ²) SIGN AREA
200LB/FT	97.00	19.4	16.1	13.8	12.1	10.8	9.7	8.8	8.1	7.5	6.9	6.5	6.1	
225LB/FT	109.00	21.9	18.2	15.6	13.7	12.2	10.9	9.9	9.1	8.4	7.8	7.3	6.8	
275LB/FT	142.00	28.4	23.7	20.3	17.8	15.8	14.2	12.9	11.8	10.9	10.1	9.5	8.9	
300LB/FT	174.00	34.8	29.0	24.9	21.8	19.3	17.4	15.8	14.5	13.4	12.4	11.6	10.9	
400LB/FT	241.00	43.2	40.2	34.4	30.1	26.8	24.1	21.9	20.1	18.5	17.2	16.1	15.1	

CHART TO DETERMINE THREE POST SIZE Δ

POST SIZE	K FACTOR (B x A)	5	6	7	8	9	10	11	12	13	14	15	16	A(FT ²) SIGN AREA
200LB/FT	145.00	29.0	24.2	20.7	18.1	16.1	14.5	13.2	12.1	11.2	10.4	9.7	9.1	
225LB/FT	164.00	32.8	27.3	23.4	20.5	18.2	16.4	14.9	13.7	12.6	11.7	10.9	10.3	
275LB/FT	213.00	42.6	35.5	30.4	26.6	23.6	21.3	19.3	17.7	16.3	15.2	14.2	13.3	
300LB/FT	261.00	52.2	43.5	37.3	32.6	29.0	26.1	23.7	21.7	20.0	18.6	17.4	16.3	
400LB/FT	361.00	72.2	60.1	51.5	45.1	40.1	36.1	32.8	30.0	27.7	25.8	24.0	22.5	

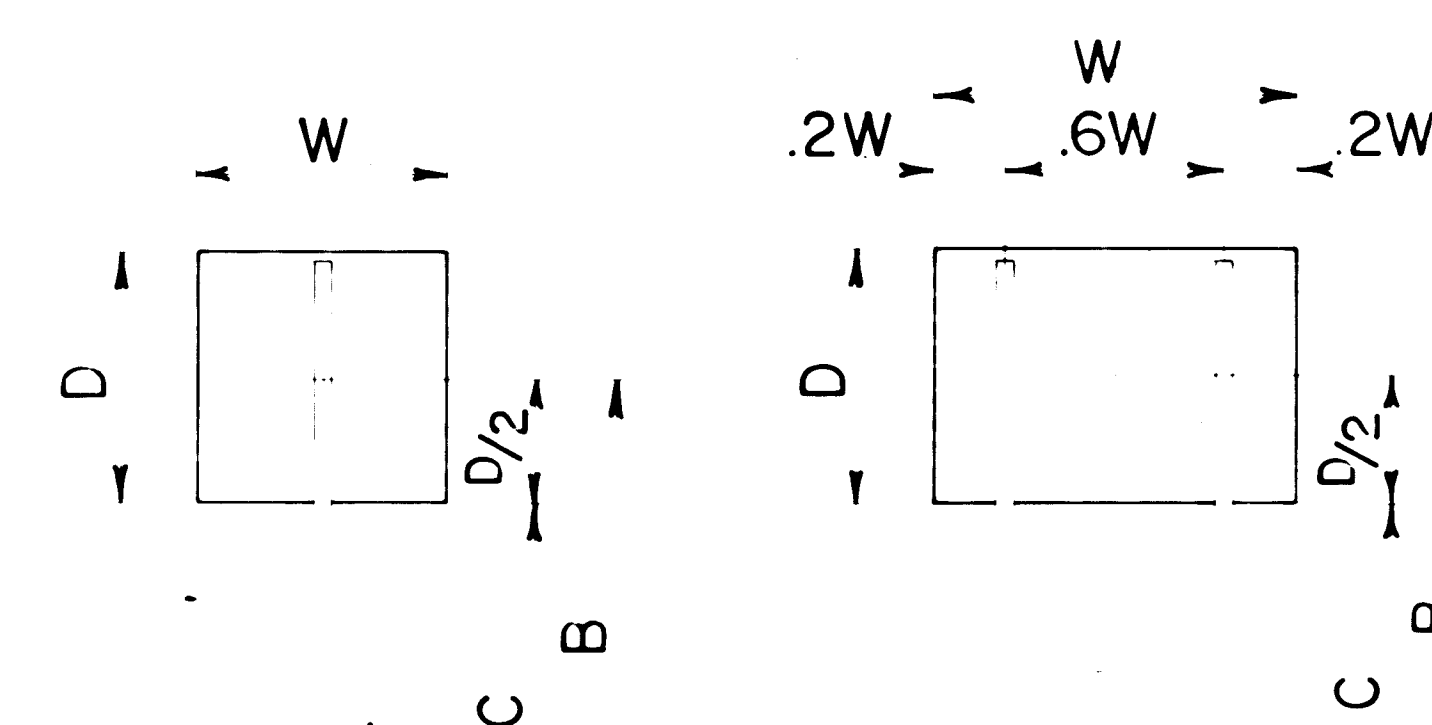


SINGLE POST SIZE DOUBLE POST SIZE

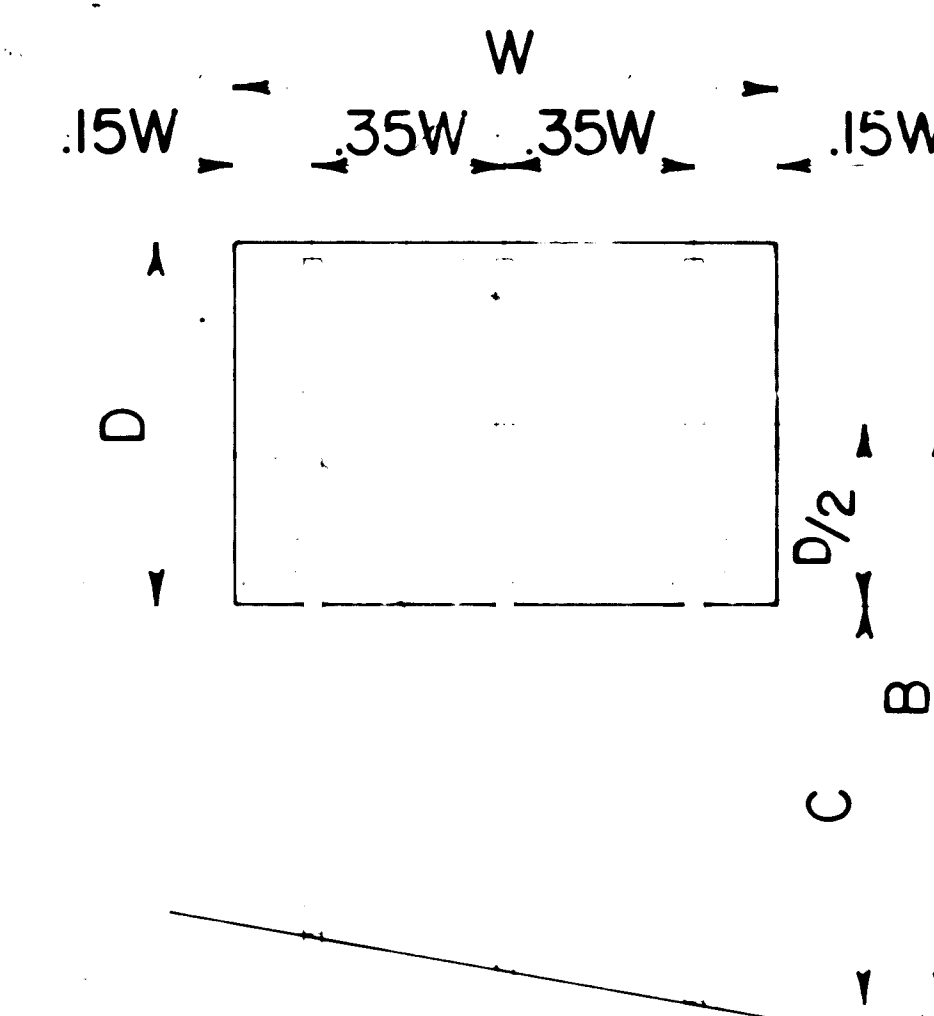

THREE POST SIZE

INSTALLATION PROCEDURE

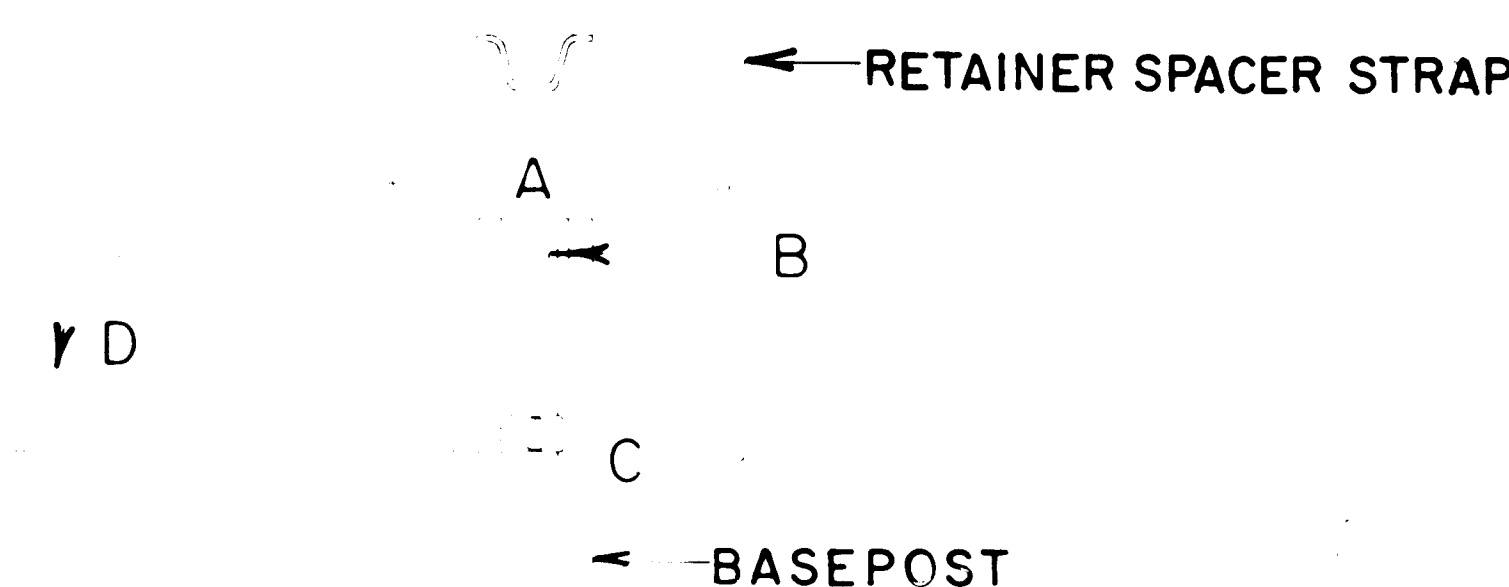

2

Drive basepost to within 12" of ground level. Proper assembly established by lining up top 3/4" slot of retainer spacer strap with top hole of basepost. Assemble strap to basepost.

Strap 90° to left.

A - Drive basepost to 5" dimension.
B - Rotate strap to vertical position.

3

A - Place 3/8-16 UNC x 2.0" bolt in bottom of sign post to facilitate alignment of sign post with proper hole in base post. (This coincides with bottom 3/4" slot in strap).
B - Alternately tighten two connector bolts.

4

A - Complete assembly by tightening retainer bolt. (This fastens sign post to retainer spacer strap).

EXAMPLE

Required: Determine post requirements for a 5' wide, 4' high sign. Located on a rural highway.
Given: W = 5'
D = 4'

Solution: 1. For a rural location.
C (min) = 5'
2. D/2 = 4/2 = 2
3. B = C + D/2
= 5' + 2' = 7'
4. A = W x D
= 5' x 4' = 20.00 sq. ft.
5. Enter the column for B=7' and continue down the B=7' column until the "A" factor equals or exceeds 20 sq ft. 2 posts of 2.75lb/ft. yields a factor of 20.3 which is optimum.

Example: POST B=7'
2.75 LB/FT 20.3
3.00 LB/FT 24.9
4.00 LB/FT 34.4


REVISED INSTALLATION PROCEDURE
REFLECTED NOTE: N/A
REVISED NOTE: N/A
REVISED NOTE: N/A
STATE


DESIGN LOADS FOR
BREAKAWAY FLARE
CHANNEL POSTS

26 19603787


PROFILE NO. _____	SURVEYED _____ PLOTTED _____ GRADES CHECKED _____ B. M.'S NOTED _____		BY _____ DATE _____

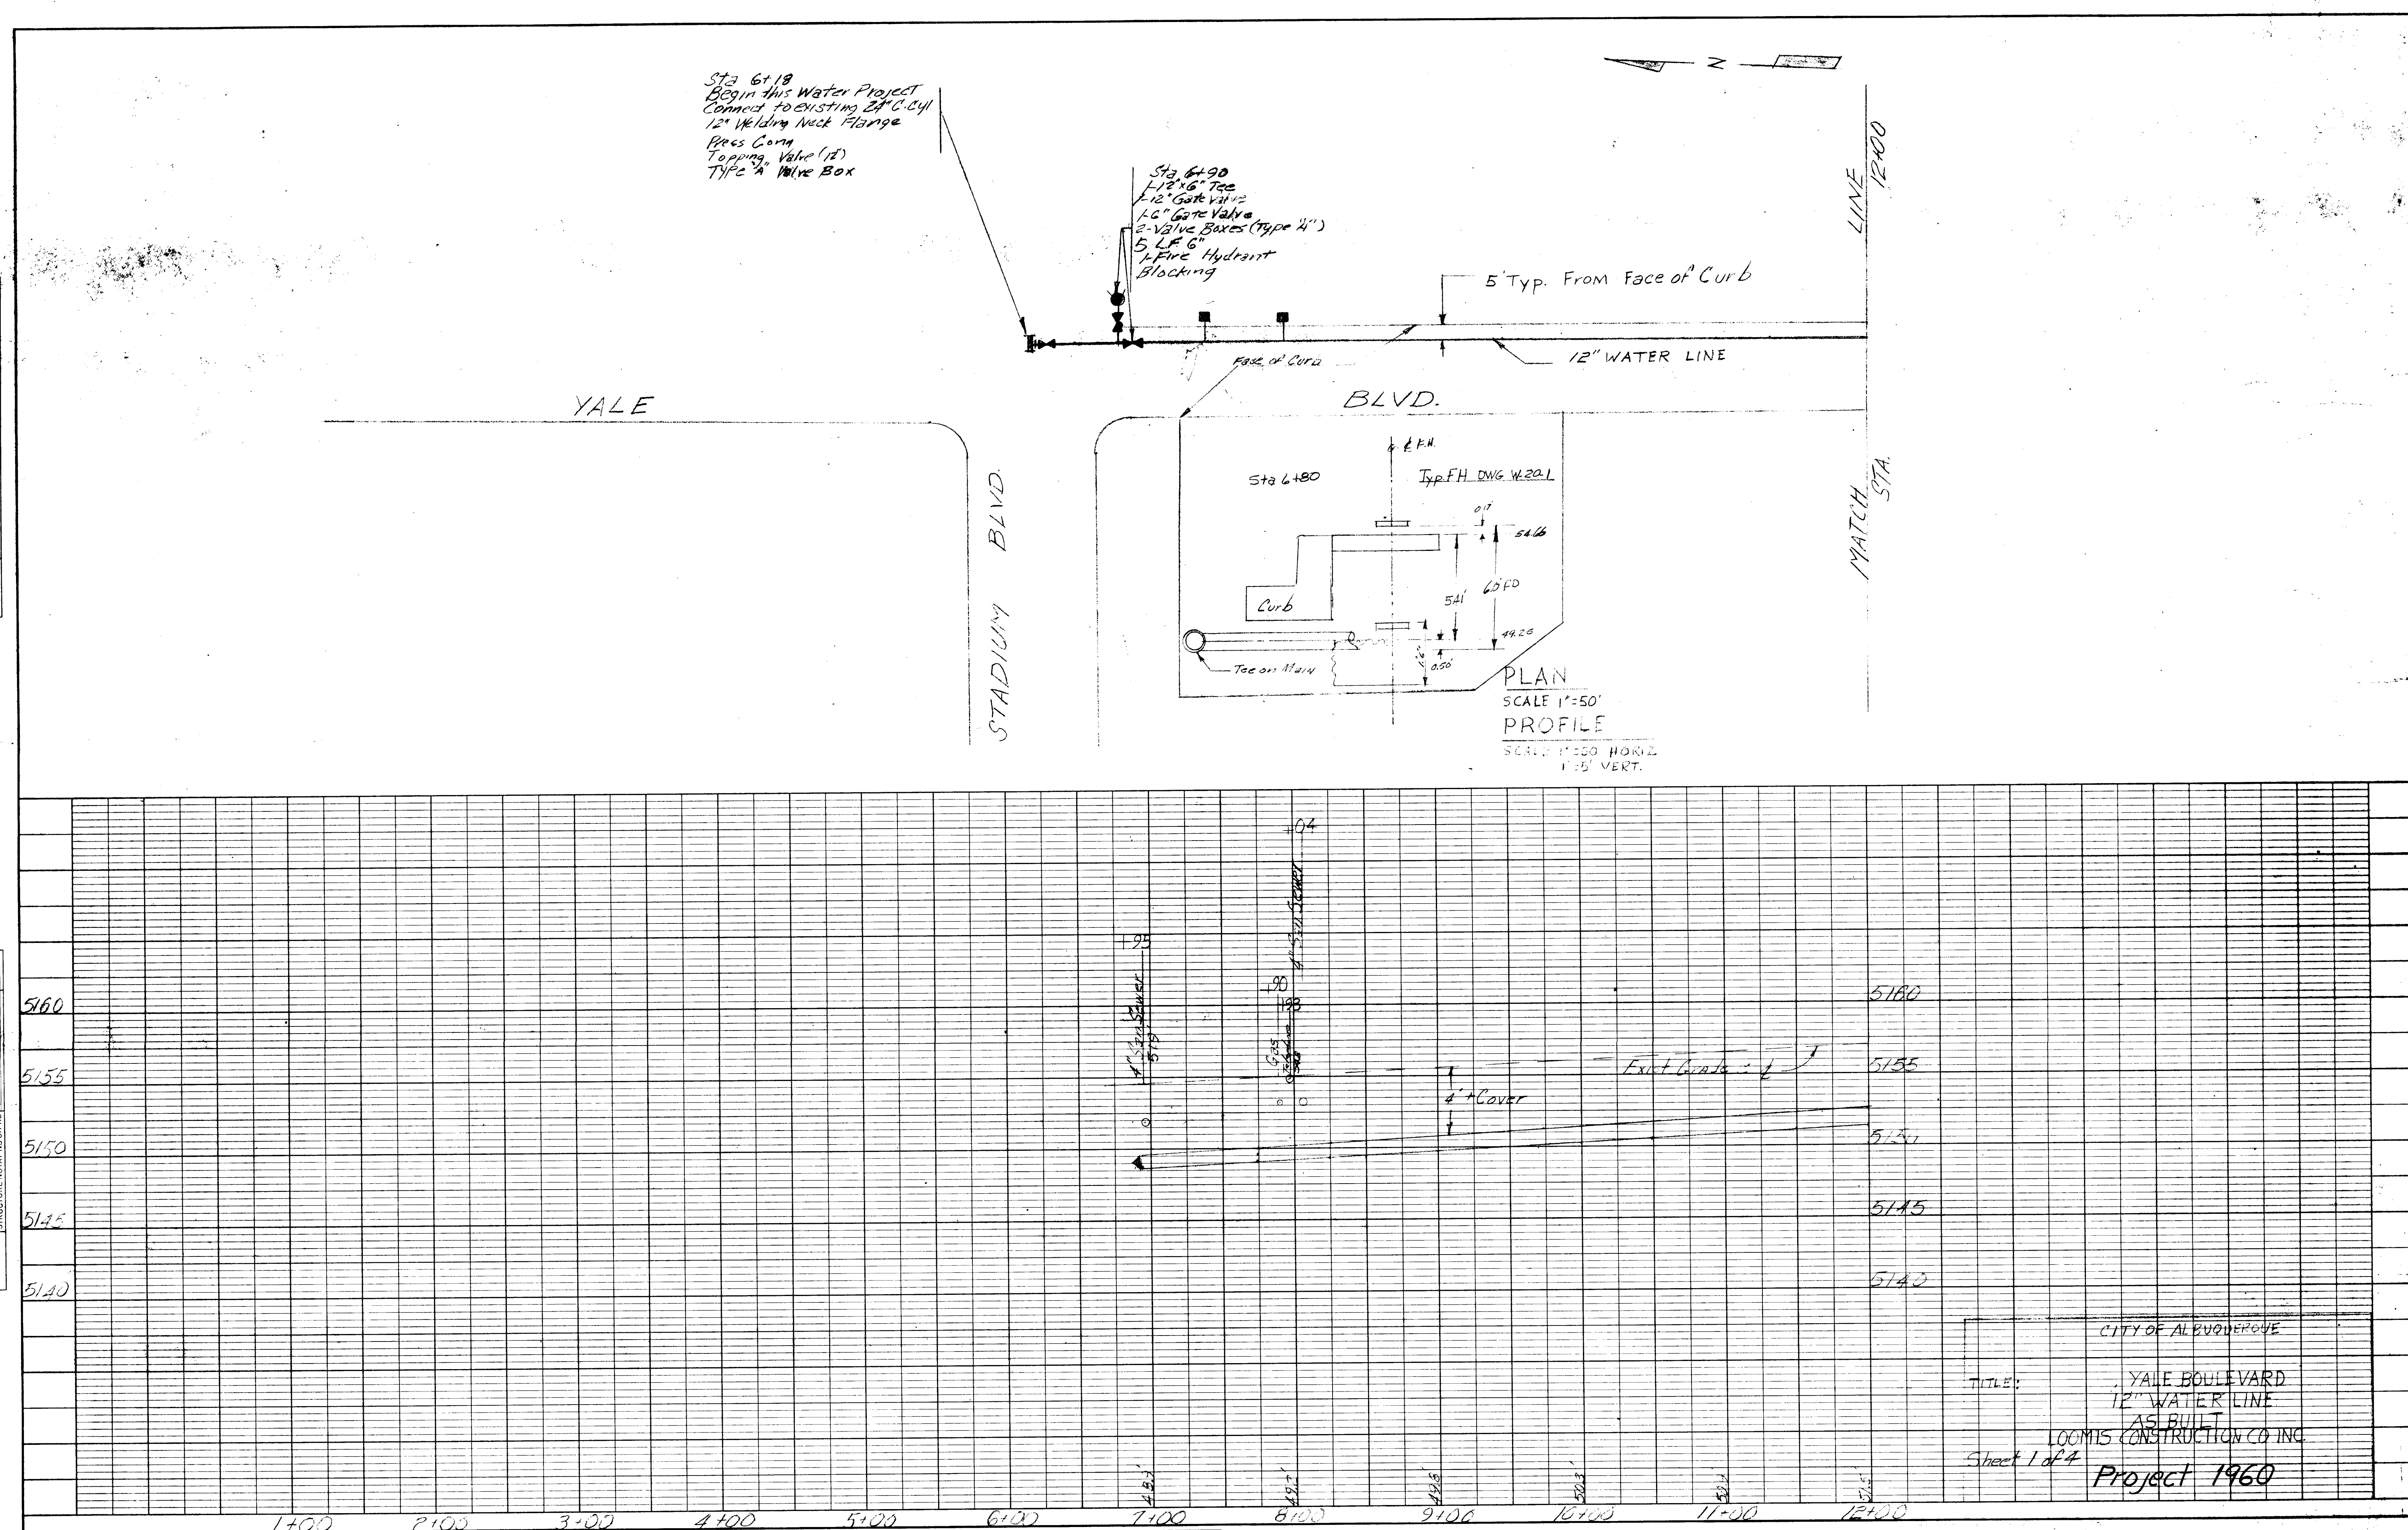

PROFILE NOTE BOOK NO. _____	SURVEYED _____ PLOTTED _____ GRADES CHECKED _____ B. M.'S NOTED _____ STRUCTURES NOTATING QUAD _____	BY _____ DATE _____
--	--	------------------------

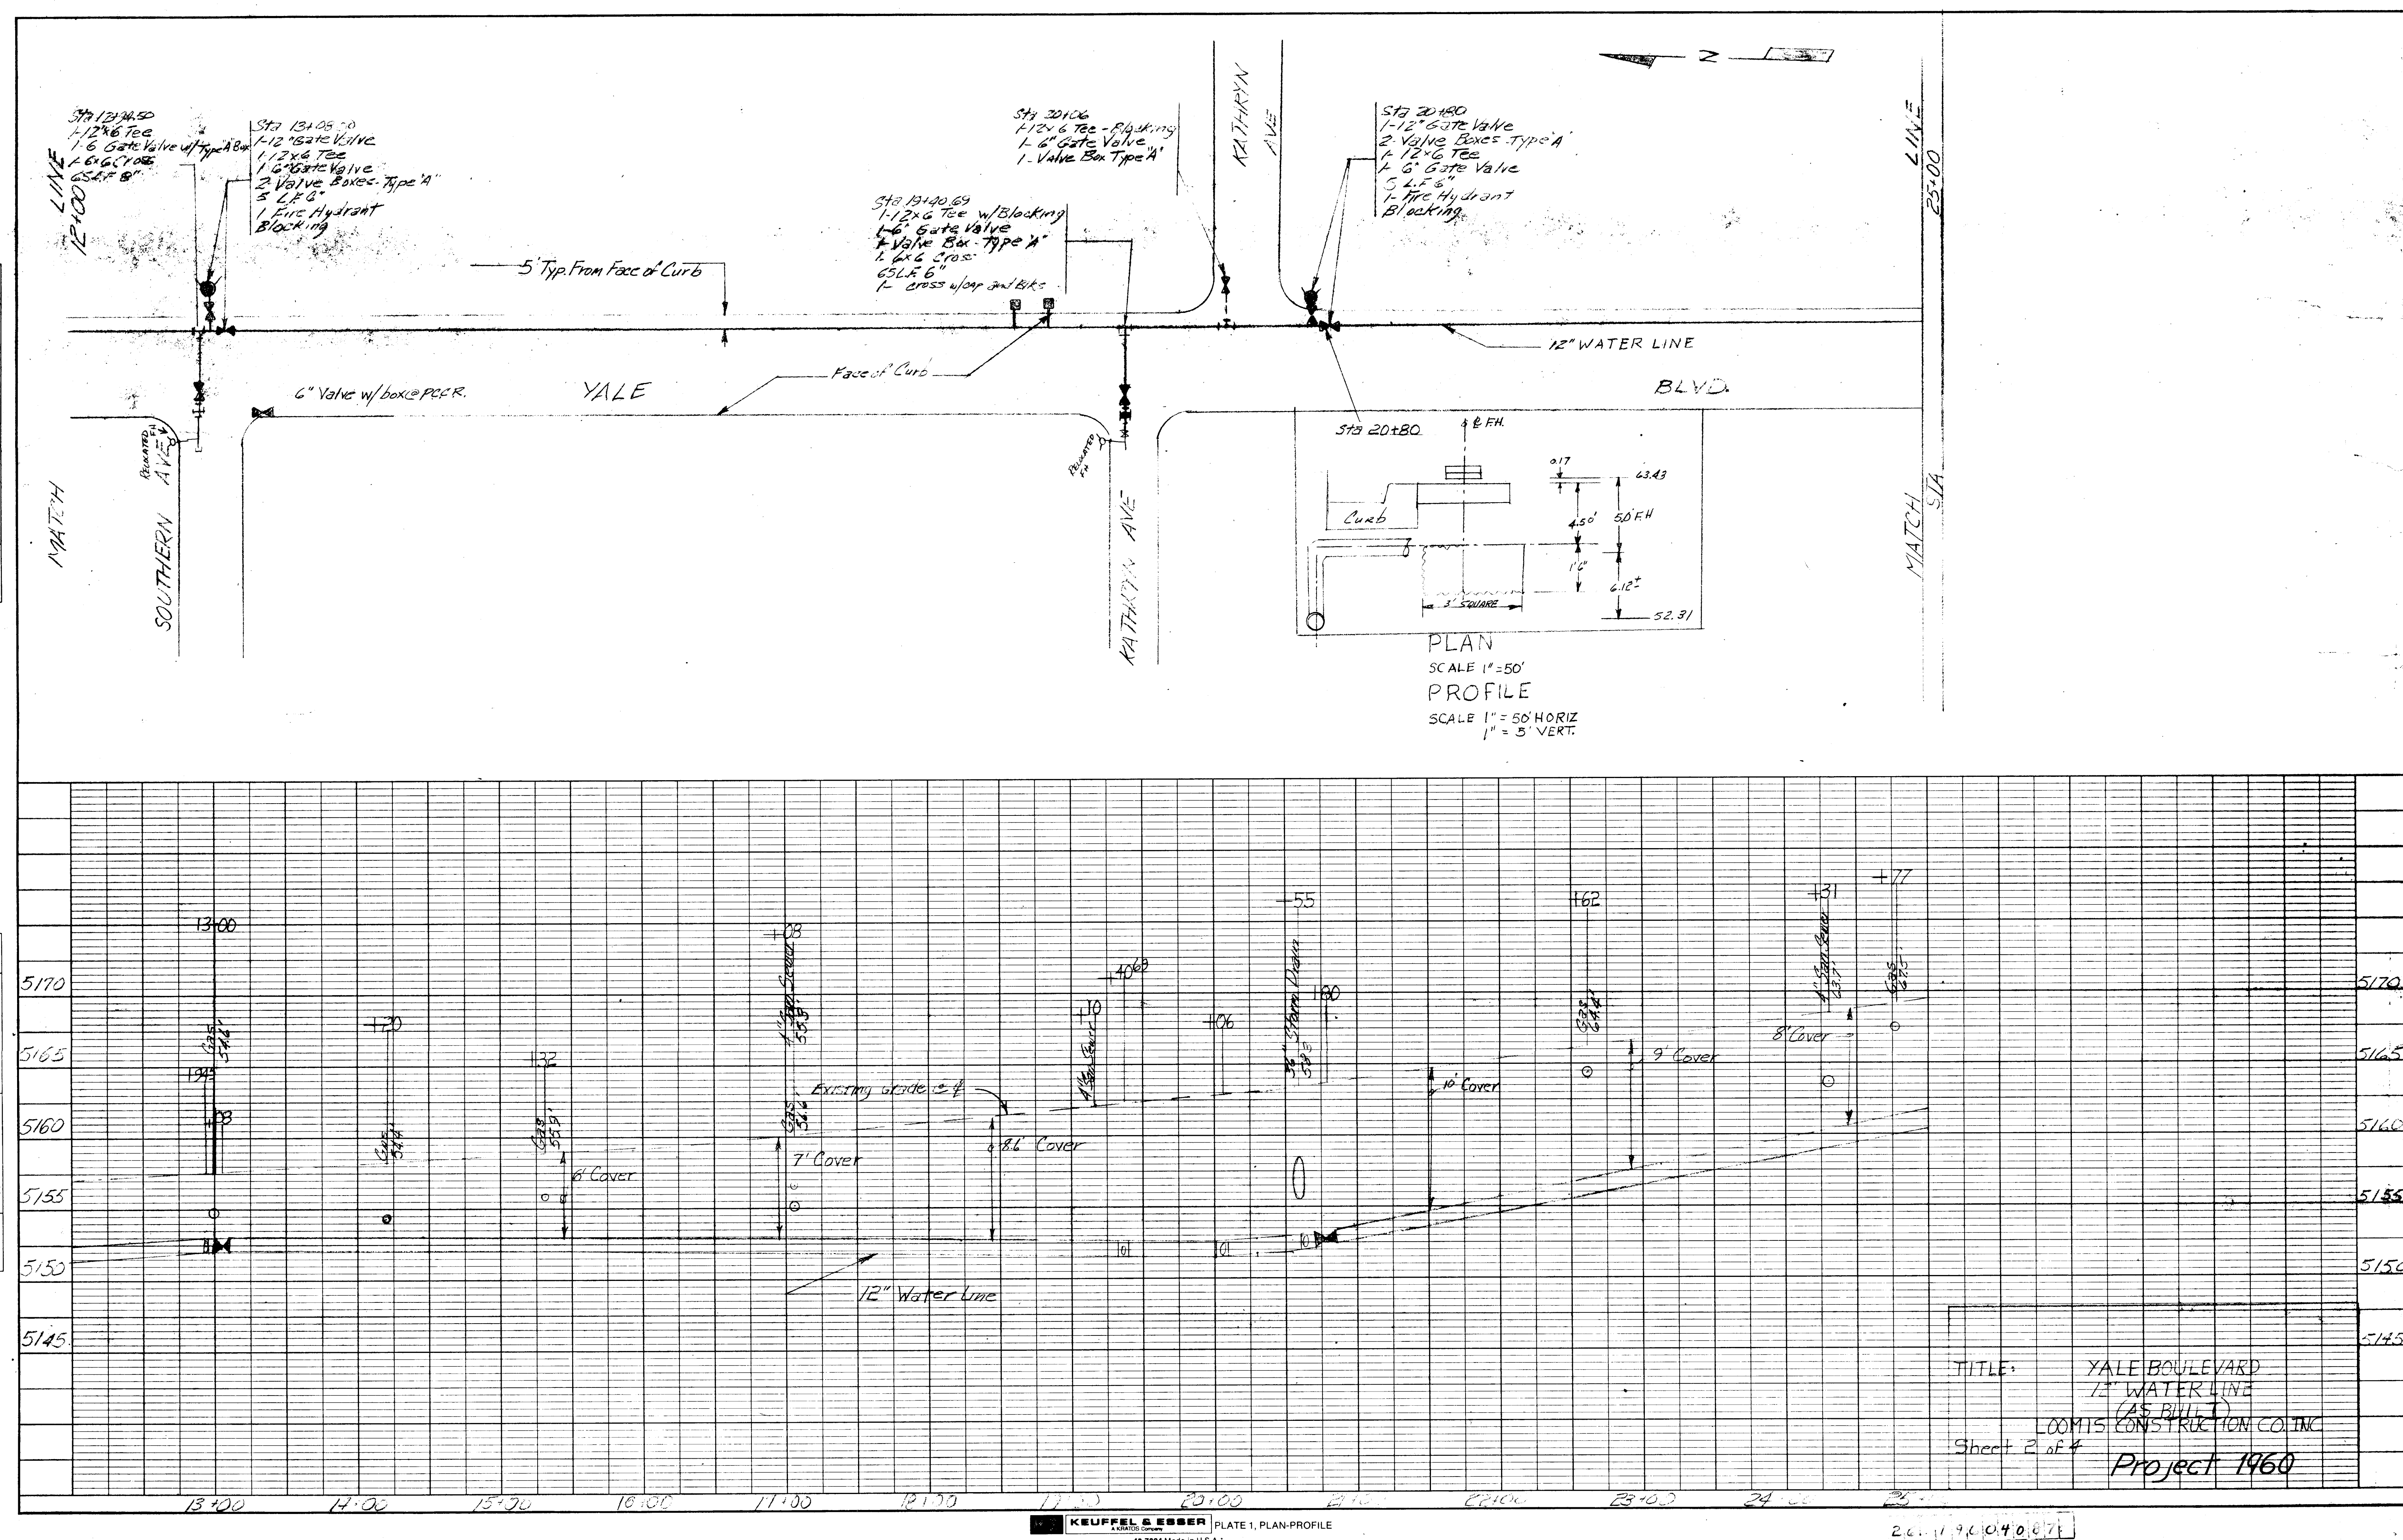

PROFILE	SURVEYED	BY	DATE
NOTE BOOK	PLOTTED		
	GRADES CHECKED		
	B. M.'S NOTED		
NO.	STRUCTURE NOTATIONS CHECKED		

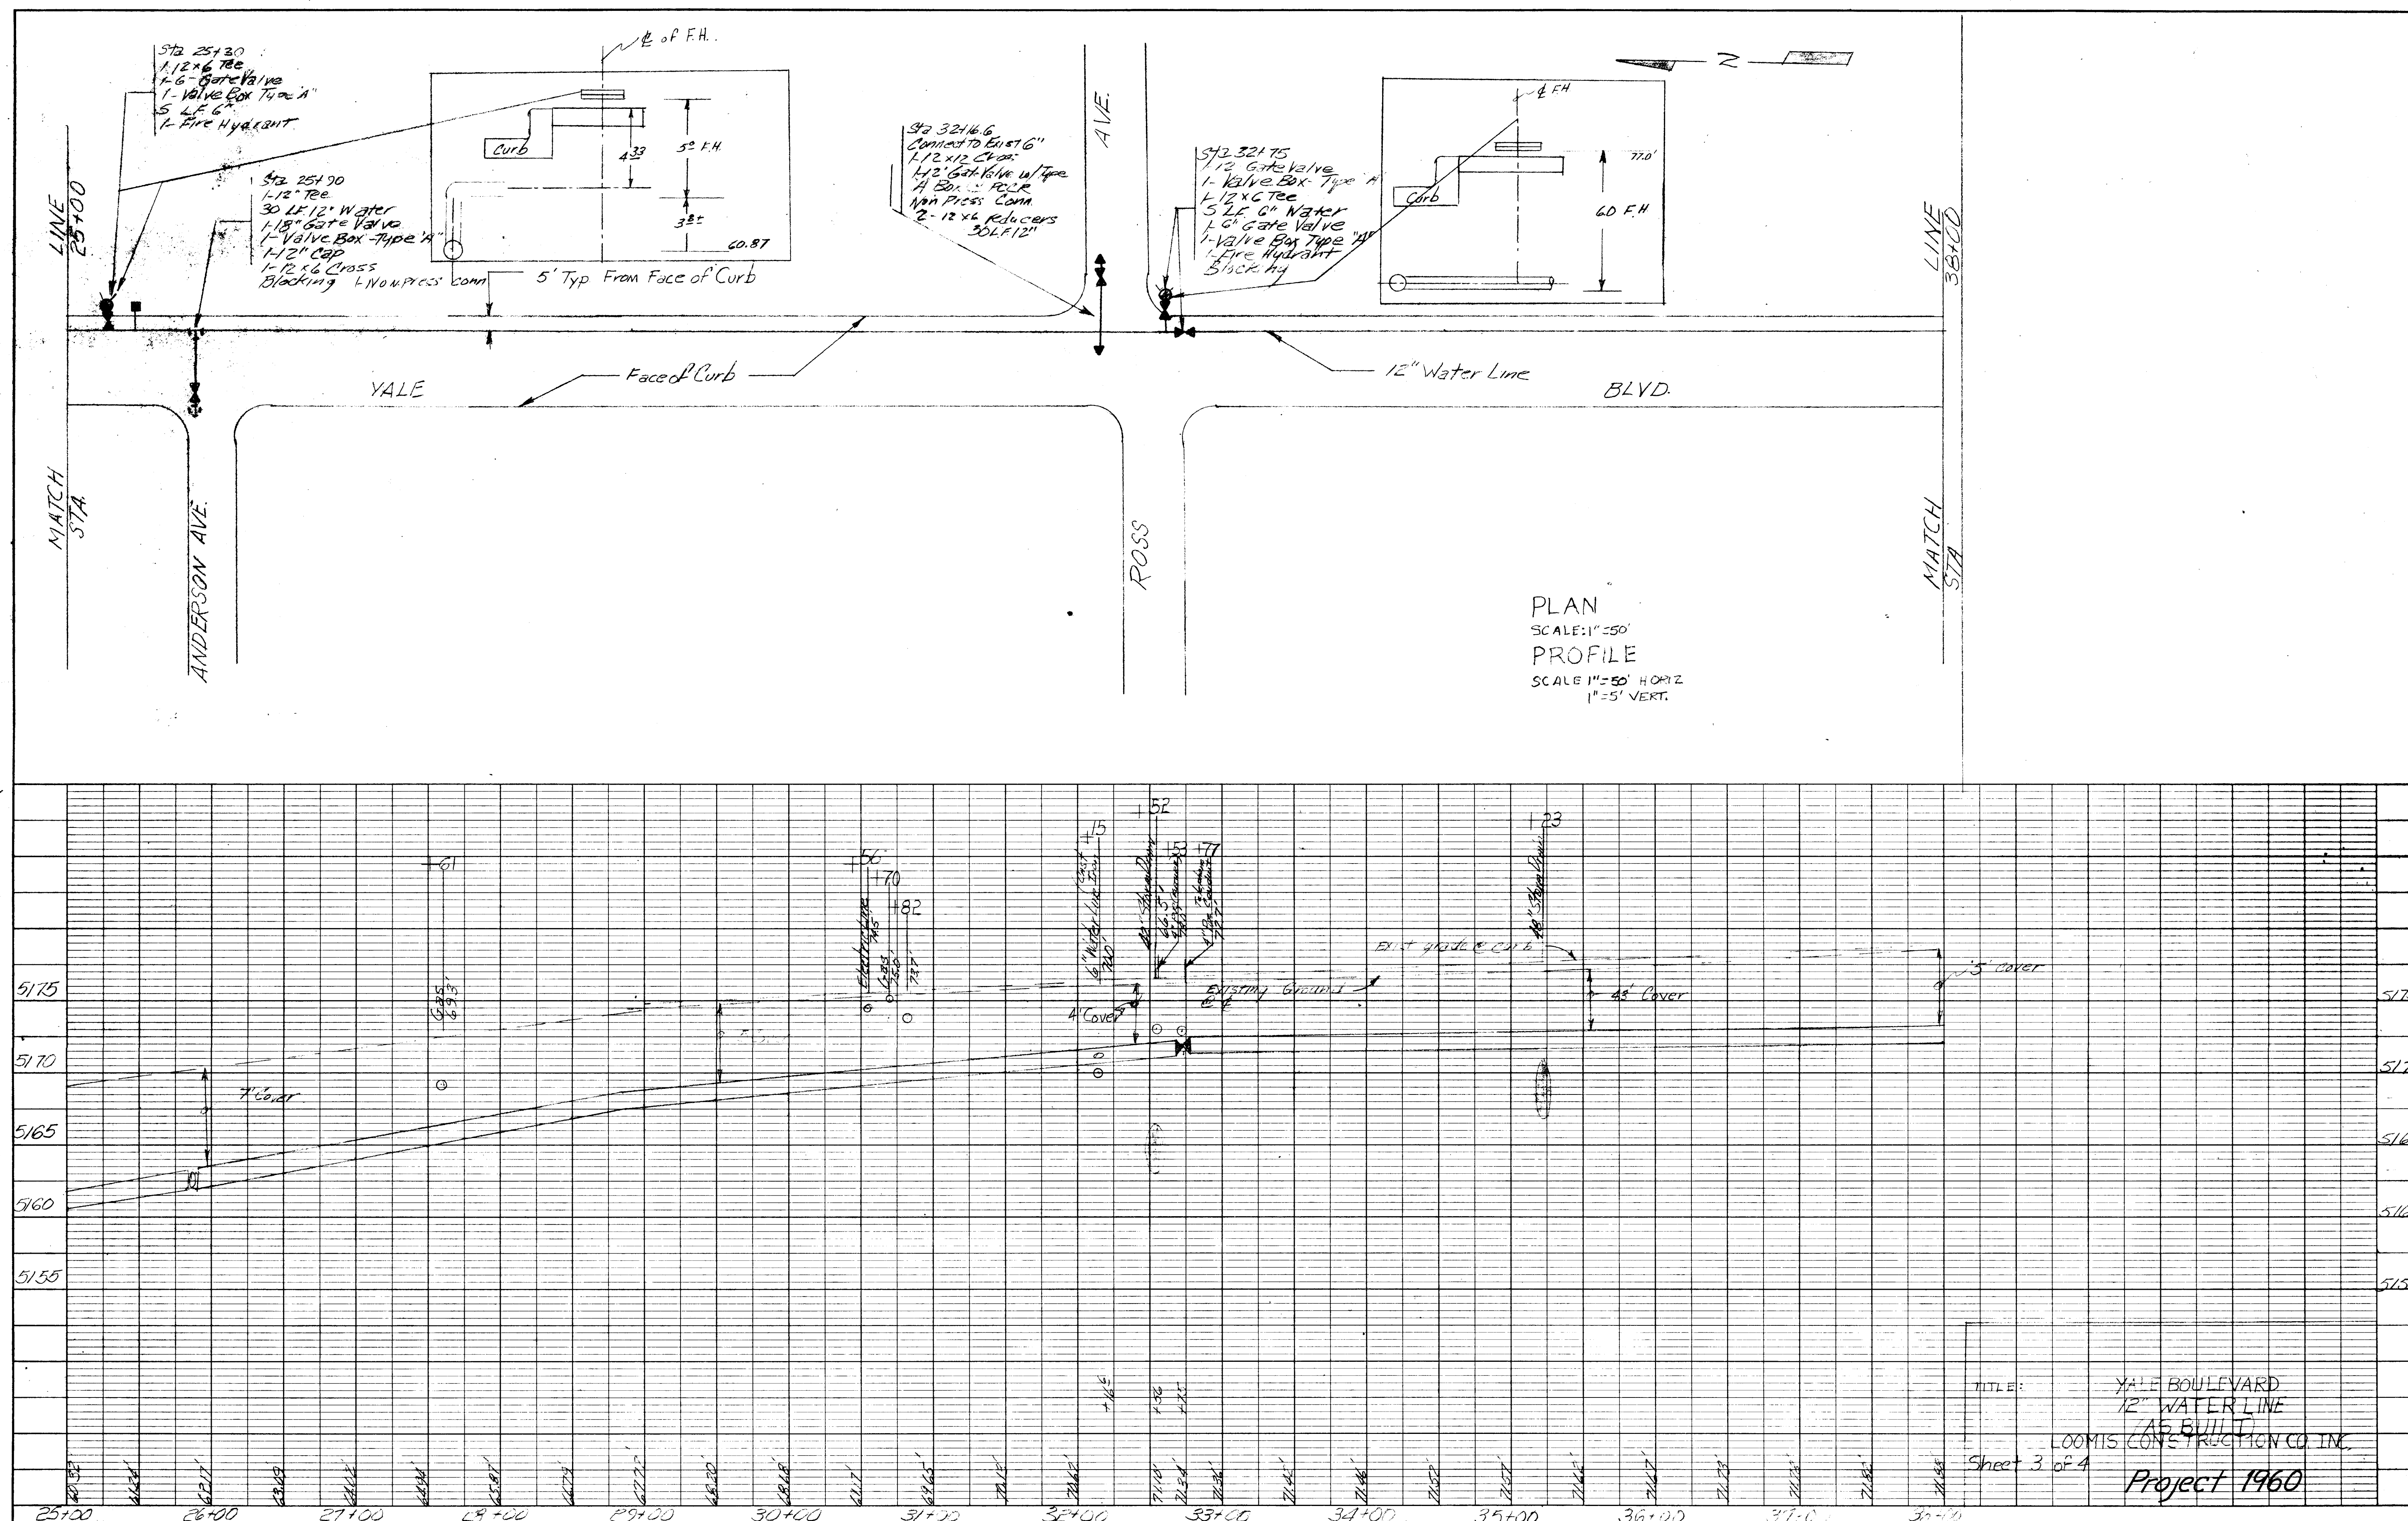


LIST OF DRAWINGS

SHEET NO.	DRAWING NO.	TITLE
1.	WRD 84.	TITLE SHEET, LEGEND, INDEX, & GEN. NOTES
2.	WRD 84.	YALE BLVD.
3.	WRD 84.	YALE BLVD.
4.	WRD 84.	YALE BLVD.
5.	WRD 84.	YALE BLVD.
6.	WRD 84.	TRAFFIC CONTROL

YALE BLVD. WATER & SANITARY SEWER REPLACEMENT

(BETWEEN STADIUM BLVD. & GIBSON BLVD.)

12" MASTERPLAN WATERMAIN — YALE BLVD. S.E.
18" AND 21" SANITARY SEWER — YALE BLVD. S.E.

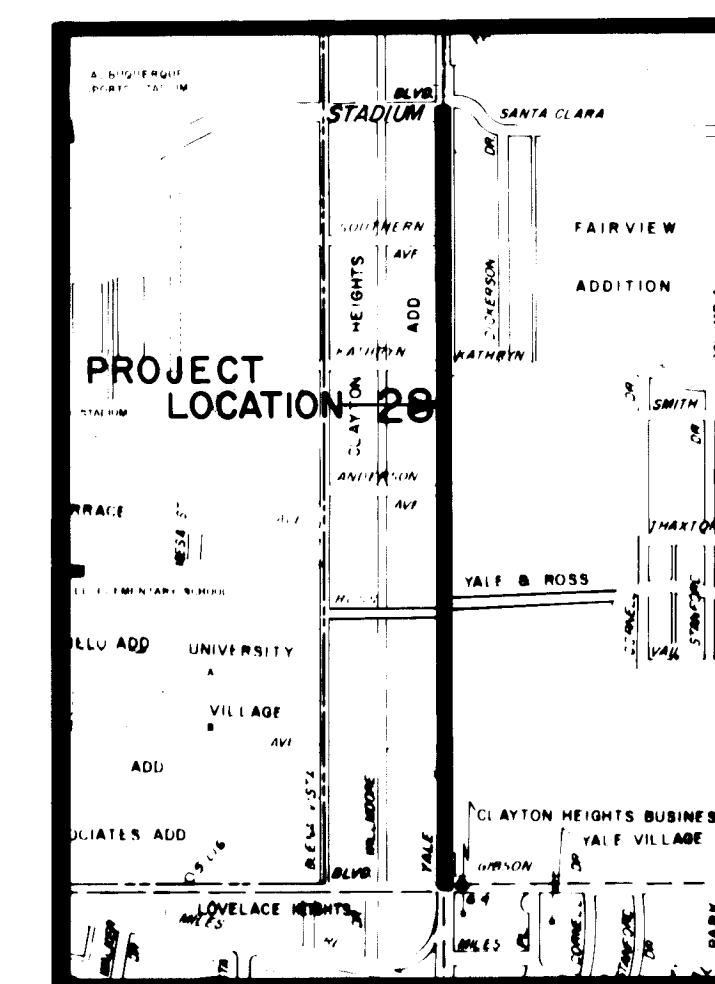

GENERAL NOTES

1. THE LOCATION OF ALL EXISTING UTILITIES, AS SHOWN ON THE DRAWINGS, ARE APPROXIMATE LOCATIONS. THE CONTRACTOR SHALL BE RESPONSIBLE FOR MAKING FINAL UTILITY LOCATION DETERMINATION IN THE FIELD DURING CONSTRUCTION. THIS IS INCIDENTAL TO CONTRACT.
2. THE CONTRACTOR SHALL NOTIFY ALL UTILITY COMPANIES BY CALLING "BLUESTAKES" AT 765-1234 AT LEAST 48 HOURS PRIOR TO COMMENCING WORK IN ANY PART OF THE PROJECT AREA.
3. THE CONTRACTOR SHALL BE RESPONSIBLE FOR PROTECTING AND MAINTAINING IN SERVICE ALL EXISTING UTILITIES (STORM, WATER, SEWER, GAS, ELECTRIC, PHONE, ETC.)
4. THE CONTRACTOR SHALL CONFINE HIS WORK TO WITHIN THE CONSTRUCTION LIMITS AND/OR RIGHT-OF-WAY TO PRESERVE EXISTING VEGETATION AND PRIVATE PROPERTY. OVERNIGHT PARKING OF CONTRACTOR'S EQUIPMENT SHALL NOT OBSTRUCT DRIVEWAY OPENINGS OR DESIGNATED TRAFFIC LANES. THE CONTRACTOR SHALL SCHEDULE HIS TRENCHING INSTALLATION AND BACKFILL OPERATIONS SO THAT ACCESS TO ANY DRIVEWAY IS NOT DISRUPTED LONGER THAN ONE WORKING DAY.
5. THE CONTRACTOR SHALL COORDINATE HIS ACTIVITIES WITH THE ENGINEER TO MINIMIZE TRAFFIC DISRUPTIONS.
6. A DISPOSAL SITE FOR ALL EXCESS EXCAVATION MATERIALS SHALL BE OBTAINED BY THE CONTRACTOR AND APPROVED BY THE ENGINEER. ALL COSTS INCURRED IN OBTAINING A DISPOSAL SITE, HAULING THERETO AND PROPER DISPOSAL THEREOF SHALL BE CONSIDERED INCIDENTAL TO CONSTRUCTION AND NO DIRECT PAYMENT WILL BE MADE THEREFOR.
7. THE CITY OF ALBUQUERQUE STANDARD DETAILS ARE INCLUDED IN THE SPECIFICATIONS AND MADE PART OF THIS CONTRACT.
8. THE NEW MEXICO STANDARD SPECIFICATIONS FOR PUBLIC WORKS CONSTRUCTION, 1979 EDITION AND SUPPLEMENTAL SPECIFICATIONS WILL GOVERN WORK ON THIS PROJECT, UNLESS OTHERWISE NOTED IN THE CONTRACT DOCUMENTS.
9. WHERE CONCRETE BLOCKING IS CALLED FOR, WRAP ALL BENDS, TEES, AND OTHER FITTINGS WITH POLYETHYLENE.
10. WATER SYSTEMS DIVISION SHALL BE THE ONLY AUTHORIZED PERSONNEL TO OPERATE EXISTING VALVES, FIRE HYDRANTS, ETC. ALL WORK SHUTOFFS MUST BE COORDINATED WITH SAID DIVISION THREE (3) FULL WORKING DAYS PRIOR TO PROPOSED SHUTOFFS. CALL 823-4052.
11. NEW WATER LINE TO EXISTING STEEL PIPE RECONNECTION--SEE SPECIAL NOTE ON STD. DRAWING W-1-3 IN CONTRACT DOCUMENTS WHEN NEW LINE MUST REDUCE IN SIZE TO EXISTING LINE.
12. PROPERTY OWNERS, ADJACENT TO THE PROJECT, MAY DESIRE REPLACEMENT OF THEIR EXISTING DETERIORATED SANITARY SEWER SERVICE OUTSIDE THE LIMITS OF YALE BLVD. R.O.W. AT THE TIME THE SERVICE IS EXPOSED DURING THE NORMAL CONSTRUCTION. THIS WORK SHALL BE SEPARATE FROM THIS PROJECT AND SHALL BE PAID FOR BY THE REQUESTOR DIRECTLY TO (A) THE PROJECT CONTRACTOR, OR (B) A PRIVATE PLUMBING CONTRACTOR WHO SHALL COORDINATE HIS ACTIVITIES WITH THE PROJECT CONTRACTOR.
13. WATER SYSTEMS DIVISION SHALL HAVE THE AUTHORITY TO CANCEL ALL SCHEDULED SHUTOFFS.
14. CONTRACTOR SHALL RECONNECT ALL SANITARY SEWER HOUSE SERVICES IN THE MANNER AND DIRECTION AS ORIGINALLY FOUND; EVEN IF THIS SHALL MEAN THE SERVICE MAY BE AT AN ANGLE OTHER THAN 90 DEGREES FROM THE MAIN; PER AGREEMENT WITH THE MECHANICAL SECTION/CODE ADMINISTRATION DIVISION.
15. THE CARE AND PROTECTION OF ALL OTHER UTILITIES, CURB AND GUTTER, SIDEWALK, AND OTHER STREET APPURTENANCES THAT ARE NOT A PART OF THE INTENDED WORK AS SHOWN ON PLANS ARE THE RESPONSIBILITY OF THE CONTRACTOR. IF DAMAGED, LOST IN TRENCH, OR OTHERWISE HARMFULLY DISTURBED, THESE ITEMS WILL BE REPAIRED OR REPLACED AT THE CONTRACTOR'S EXPENSE.
16. WHEN EXISTING SANITARY SEWER SERVICES HAVE BEEN RECONNECTED TO REPLACEMENT MAINS, THE CONTRACT SHALL STAMP OR CHISEL A 3-INCH SIZE "S" ON TOP OF CURB OVER THE LOCATION OF THE SERVICE LINE. THE CURB CUT FOR "S" MUST BE MINIMUM 1/4-INCH DEEP.
17. WHEN EXISTING WATER SERVICES HAVE BEEN RECONNECTED TO REPLACEMENT MAINS, THE CONTRACTOR SHALL STAMP OR CHISEL A 4-INCH SIZE "W" ON THE TOP OF CURB OVER THE LOCATION OF THE SERVICE LINE. THE CURB CUT FOR THE "W" MUST BE A MINIMUM 1/4-INCH DEEP.
18. ABANDONMENT OF EXISTING 12" CP SAS LINE AND MANHOLES WILL BE DONE BY FILLING LINE WITH SAND AND PLUGGING INVERTS WITH 1" LONG MORTAR PLUGS, BREAKUP BOTTOM OF MANHOLE, FILL MANHOLE WITH SAND AND REMOVE AND RETURN CASTINGS AND LIDS TO THE CITY YARDS.

19. CONTRACTOR SHALL CONSTRUCT A TEMPORARY 24' WIDE ROAD TO THE EAST OF THE PRESENT ROAD USING NEWLY OBTAINED RIGHT-OF-WAY AND CONSTRUCTION EASEMENT IN SUCH A WAY THAT TWO-WAY TRAFFIC MAY BE MAINTAINED ON THE ROAD DURING THE INSTALLATION OF THE SEWER LINE. DRAINAGE STRUCTURES AT STATIONS SHALL BE EXTENDED USING PIPE OF THE SAME DIAMETER AS EXISTING PIPE. THE PIPE SHALL BE FURNISHED BY THE CONTRACTOR AND REMAINS HIS PROPERTY AFTER REMOVAL. THIS WORK SHALL BE INCIDENTAL TO CONSTRUCTION OF THE SEWER LINE.
20. THE REPLACEMENT OF CONCRETE PAVEMENT REMOVED FOR THE SANITARY UTILITY LINE SHALL CONFORM TO THE APPLICABLE PORTIONS OF SECTION 431, PORTLAND CEMENT CONCRETE PAVEMENT, NEW MEXICO STATE HIGHWAY DEPARTMENT, STANDARD SPECIFICATIONS FOR ROAD AND BRIDGE CONSTRUCTION, 1984 EDITION, AND SHALL BE REPLACED TO ITS ORIGINAL THICKNESS AND REINFORCEMENTS.
21. EXISTING 12" OF SAS LINE AND MANHOLES SHALL NOT BE ABANDONED UNTIL ALL SAS SERVICE AND 8" CONNECTIONS HAVE BEEN TRANSFERRED TO NEW 18" OR 21" SAS LINE OR MANHOLES.
22. NO SAS SERVICES OR 8" CONNECTIONS SHALL BE TRANSFERRED TO NEW 18" OR 21" SAS LINE UNTIL ALL TESTING OF NEW 18" OR 21" SAS LINE AND MANHOLES HAS BEEN COMPLETED AND PASSED (E.G. INFILTRATION, EXFILTRATION, LAMPING AND UP TO MID-TRENCH BACKFILL DENSITIES).
23. NO WATER SERVICES OR METERS SHALL BE TRANSFERRED TO THE NEW 12" WATER LINE UNTIL ALL PRESSURE TESTING OF THE NEW 12" WATER LINE AND SERVICES HAS BEEN COMPLETED AND PASSED AND THE NEW 12" WATER LINE AND SERVICE PROPERLY DISINFECTED AND FLUSHED.
24. CONTRACTOR SHALL CONSTRUCT A TEMPORARY 24' WIDE ROAD TO THE EAST OF THE PRESENT ROAD USING NEWLY OBTAINED RIGHT-OF-WAY AND CONSTRUCTION EASEMENT IN SUCH A WAY THAT TWO-WAY TRAFFIC MAY BE MAINTAINED ON THE ROAD DURING THE INSTALLATION OF THE SEWER LINE. THIS WORK SHALL BE SUBSIDIARY TO CONSTRUCTION OF THE SEWER LINE.
25. Connection to concrete cylinder line shall be coordinated through the Water Systems Division 823-4052.

LEGEND


	PROPOSED WATER LINE		EXISTING WATER METER
	PROPOSED SEWER LINE		METER BOX REHABILITATION
	PROPOSED GATE VALVE (WATER)		RELOCATE BOX & PLATE
	PROPOSED FIRE HYDRANT		REPLACE EXISTING SERVICE LINE/OR INSTALL NEW SERVICE LINE
	PROPOSED TEE		REPLACE EXISTING SERVICE LINE ONLY
	PROPOSED SANITARY MANHOLE		INSTALL DOUBLE BOX & PLATE
	EXISTING WATER LINE & VALVE		
	EXISTING SEWER LINE & MANHOLE		
	EXISTING STORM DRAIN & MANHOLE		
	GAS MAIN		
	UNDERGROUND TELEPHONE		
	TELEPHONE MANHOLE		
	UTILITY POLE		
	EXISTING TEE (WATER)		
	EXISTING CURB & GUTTER WITH STORM INLET		
	(PROPOSED CURB & GUTTER) NOT PART OF THIS CONTRACT		



AS-BUILT OF WATER &
SANITARY SEWER ONLY
AUGUST 1986

26 1960 0187


REV.	SHEETS	CITY	ENGR.	DATE	USER	DEPT.	DATE	USER	DEPT.	DATE
APPROVAL OF REVISIONS										

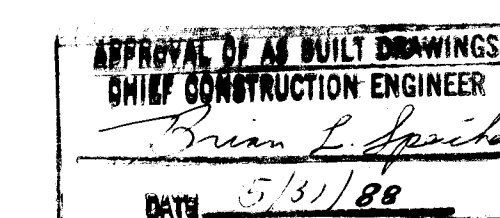

APPROVED FOR CONSTRUCTION  W. D. CHIEF ENGINEER	APPROVED FOR CONSTRUCTION 	APPROVED FOR CONSTRUCTION
PROJECT	CITY ENGINEER	SHEET ____ OF ____ II-1 5

PREPARED BY

CITY OF ALBUQUERQUE BERNALILLO COUNTY WATER RESOURCES DEPARTMENT

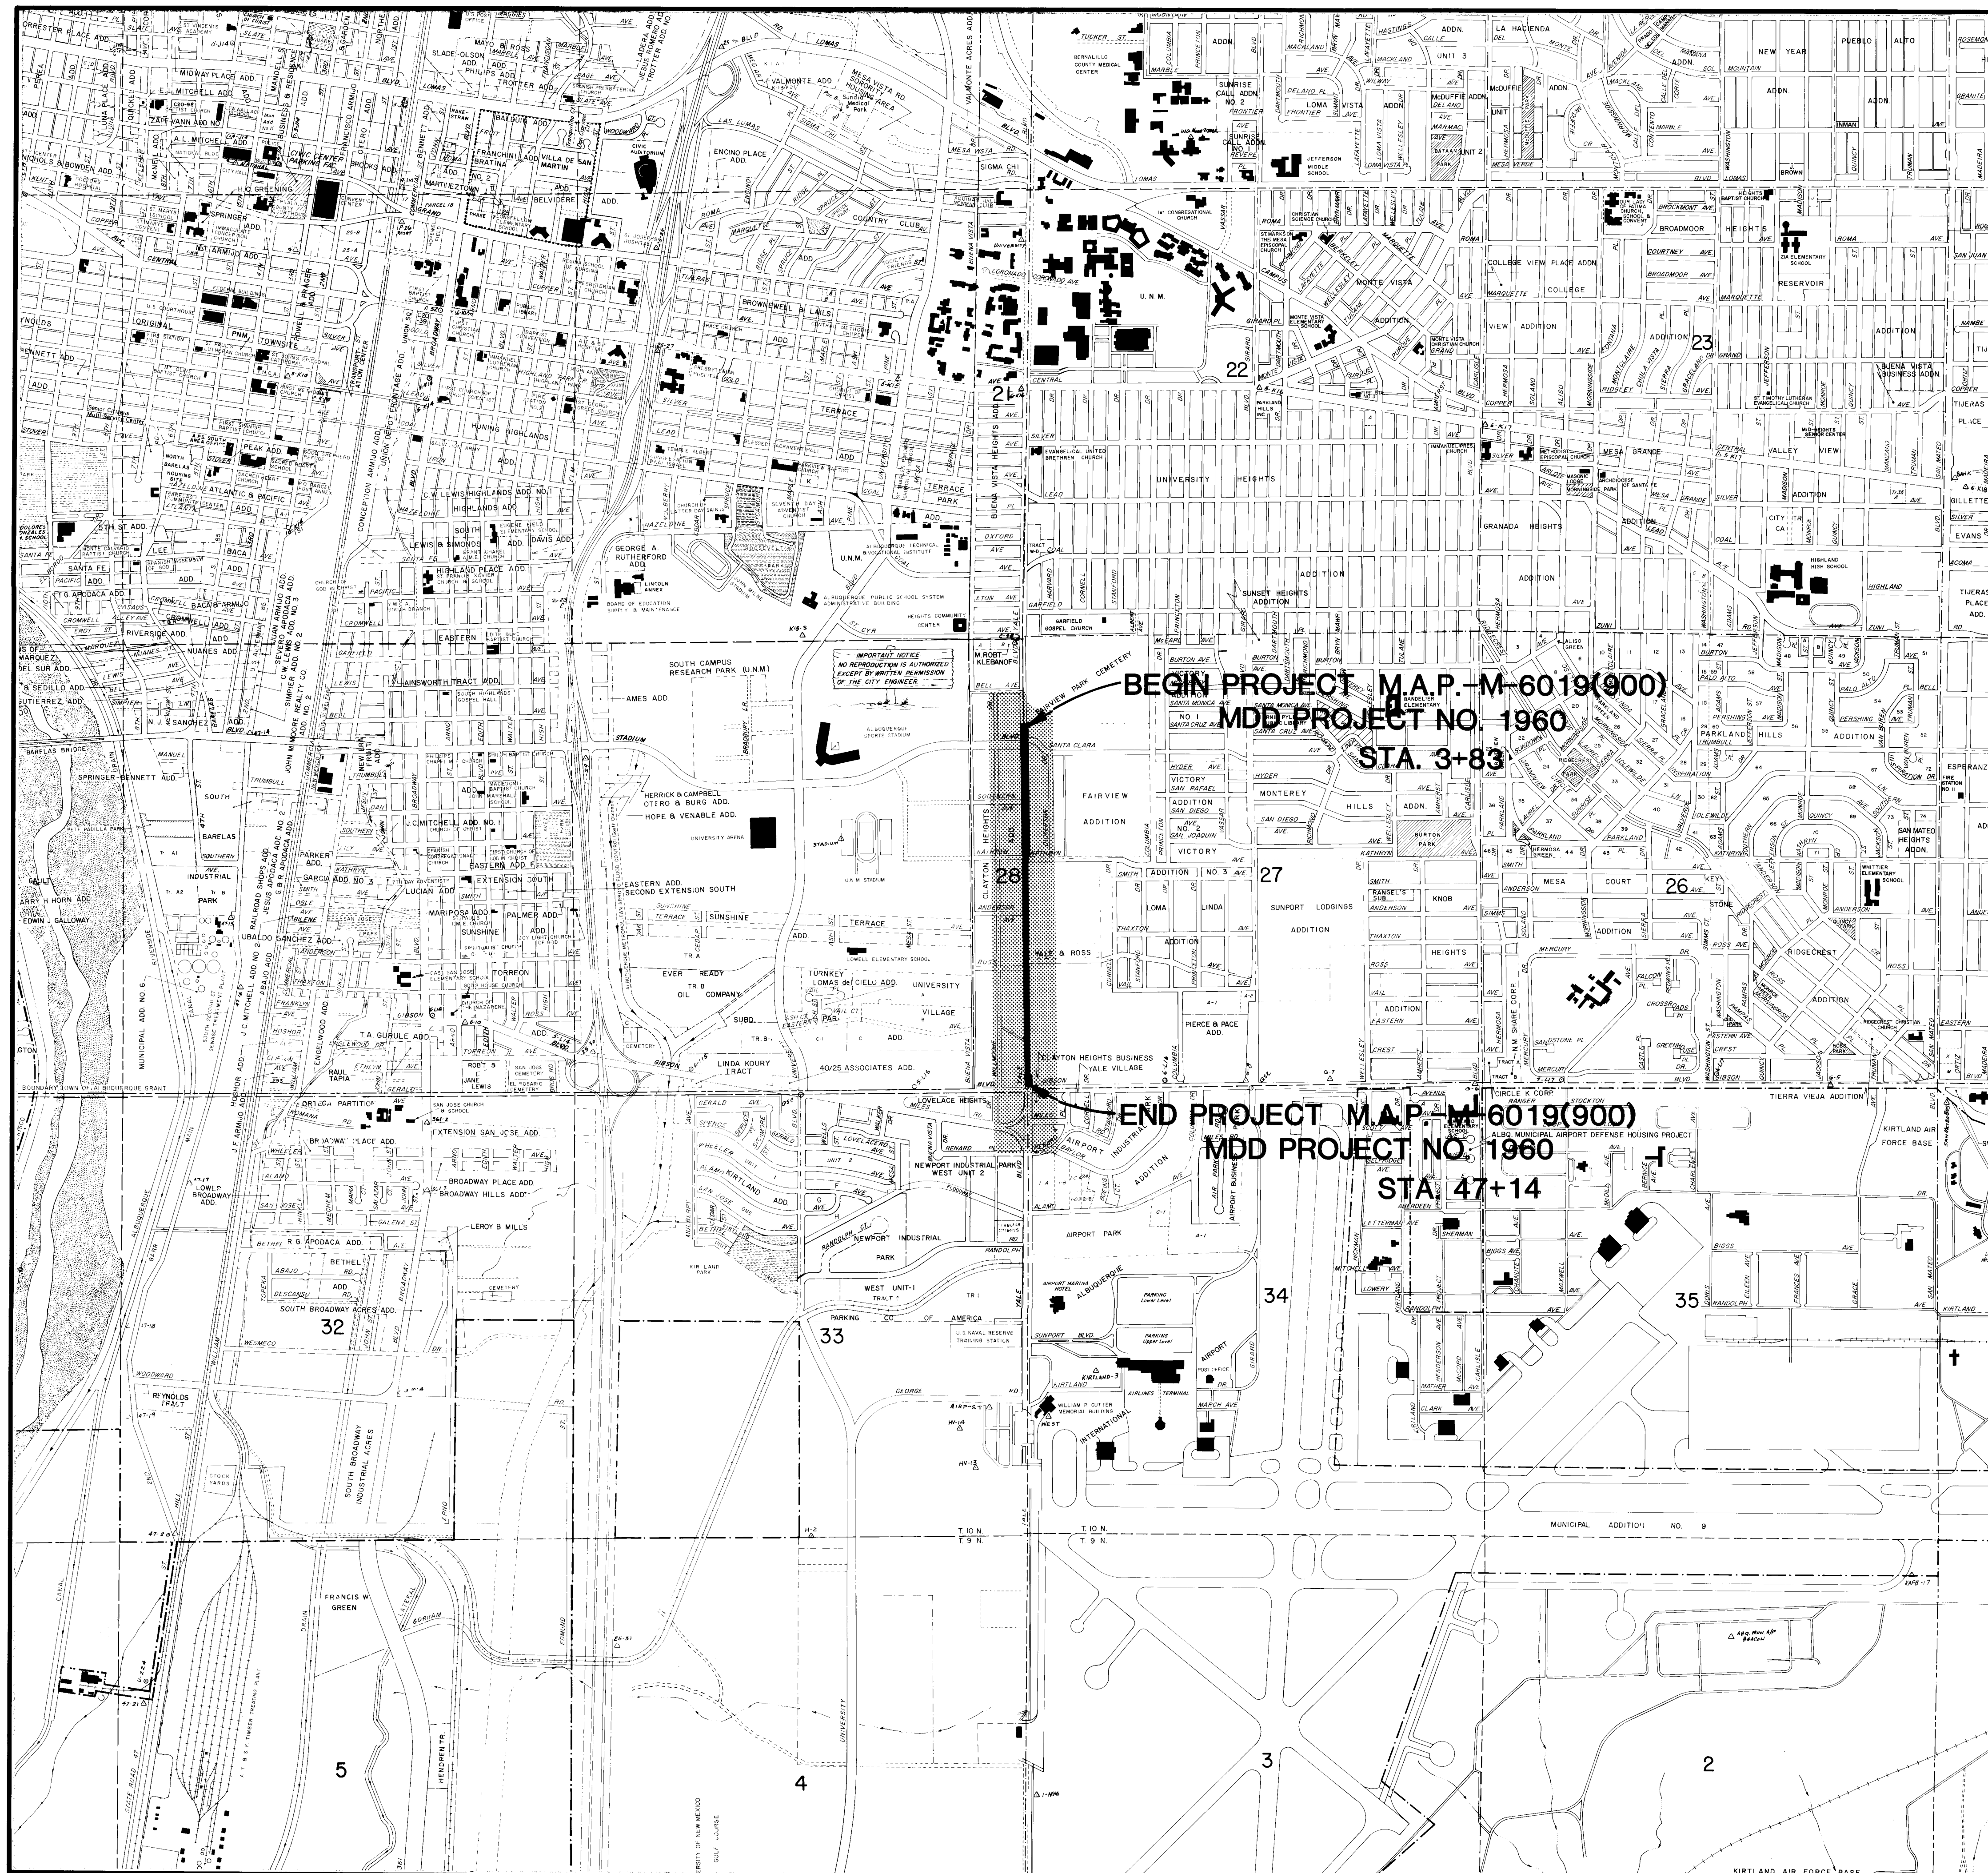


LEGEND


PLAN VIEW

NE

EXISTING

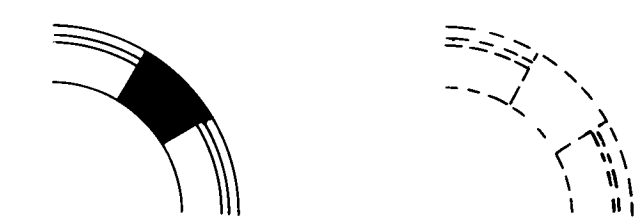

PROFILE

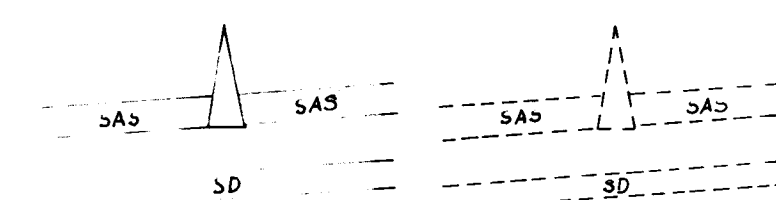

26 19600287

RECORD DRAWING
Drawings revised to reflect the
best information available. Do
not use without field verification.

PLANS PREPARED
UNDER THE DIRECTION

REGISTERED PROFESSIONAL ENGINEER & ARCHT.
STATE OF
No. 1593
NEW MEXICO
WILLIAM I. MATOTAN

William I. Matotan
WILLIAM I. MATOTAN

APPROVED FOR
CONSTRUCTION


CITY ENGINEER

CITY OF ALBUQUERQUE
DEPARTMENT OF TRANSPORTATION


TITLE: YALE BOULEVARD WIDENING
STADIUM BLVD. TO GIBSON BLVD.
LOCATION MAP AND LEGEND

APPROVALS	ENGINEER	DATE	APPROVALS	ENGINEER	DATE
City Engineer			Liquid Waste	R. Perry	11/1/85
A.C.E.-Design	H. C. Cline	12/1/85	Traffic	R. Perry	12/1/85
A.C.E.-Hydrology	H. C. Cline	12/1/85	Water	R. Perry	12/1/85


DRAWING NO.	1960	MAP NO.	SHEET 1-2 OF
-------------	------	---------	--------------

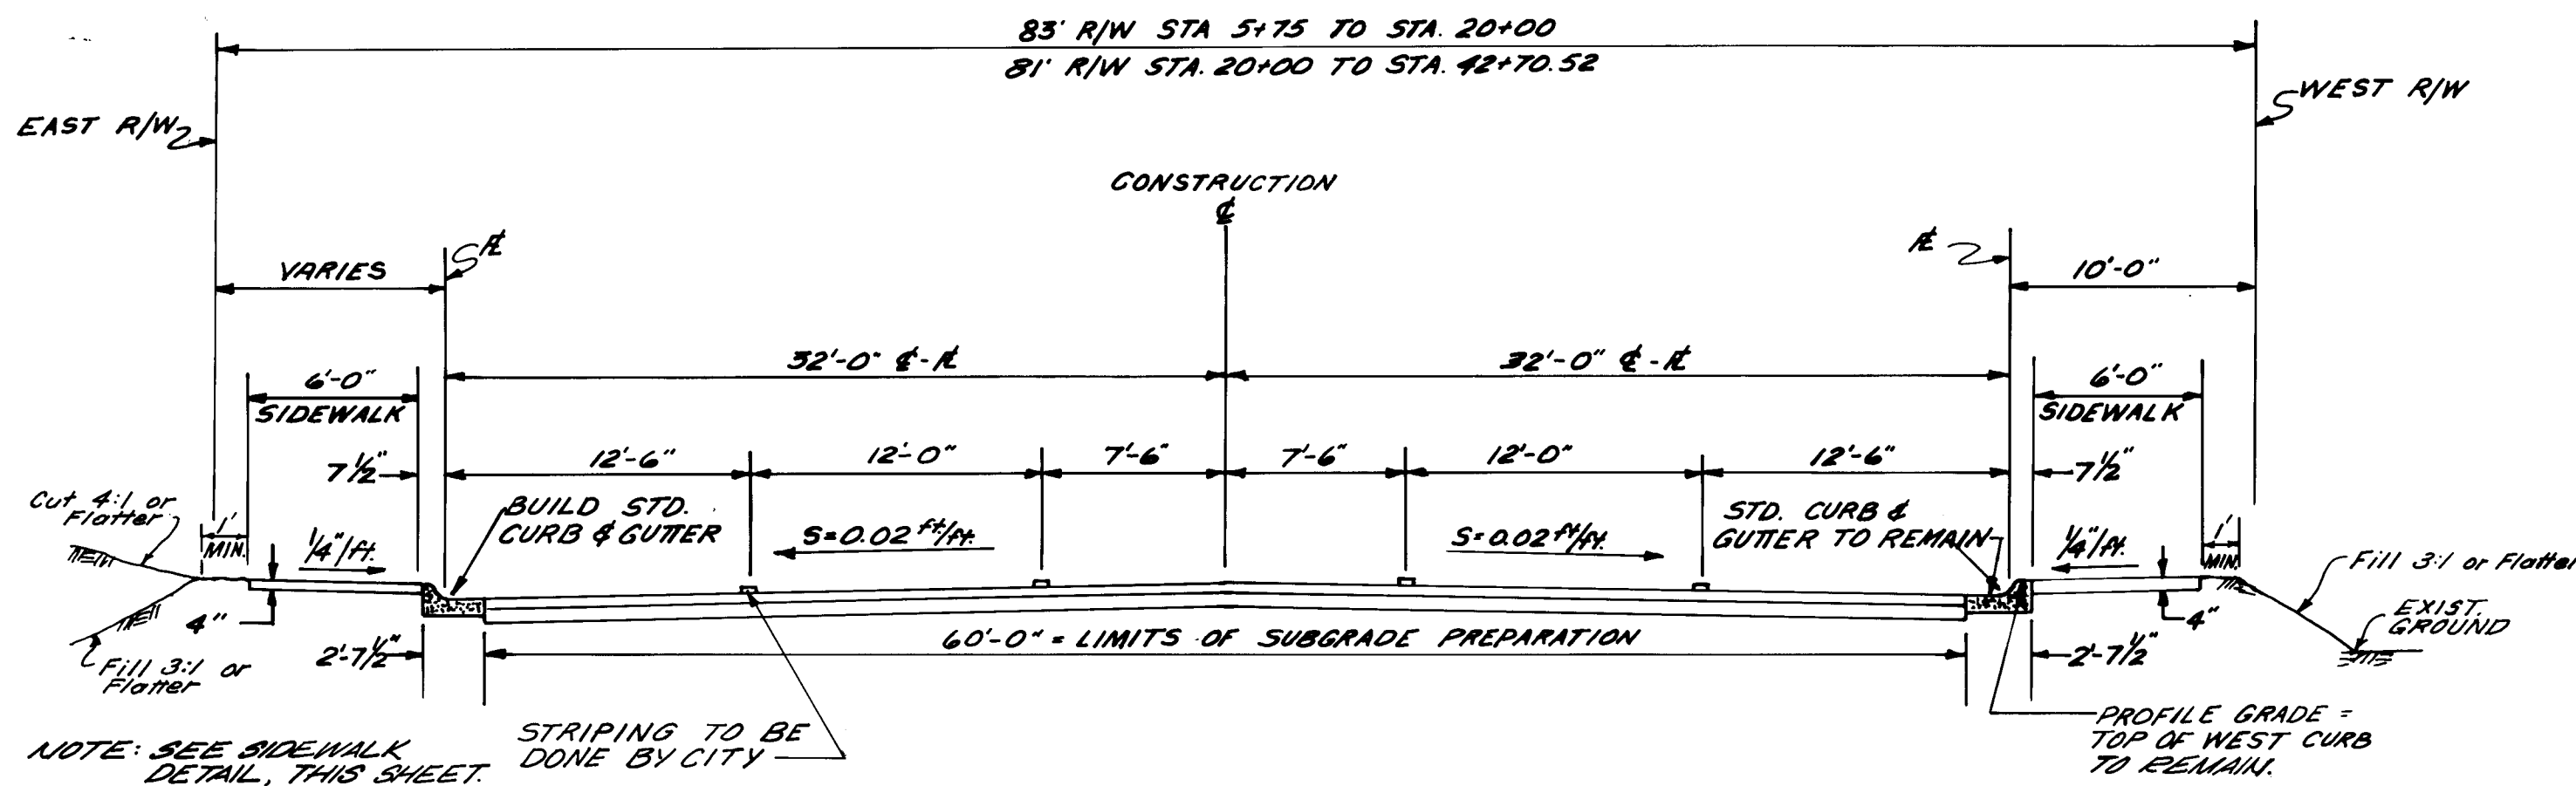


TYPICAL ROADWAY SECTION
DESIGN SPEED 45 M.P.H.

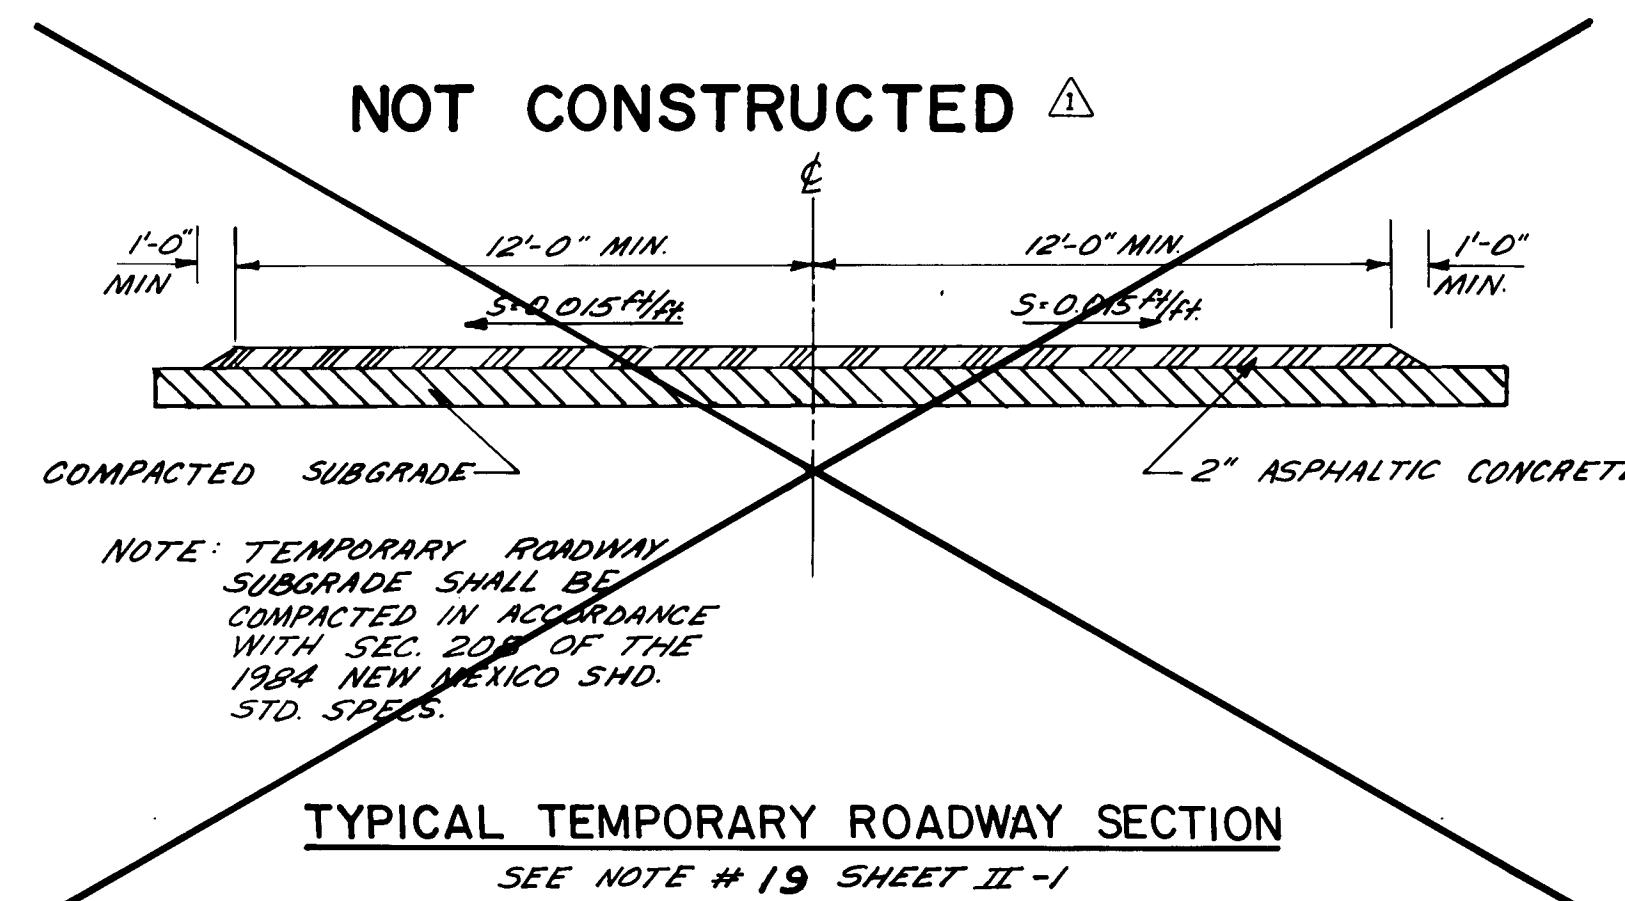


TYPICAL TEMPORARY ROADWAY SECTION
SEE NOTE # 19 SHEET II-1

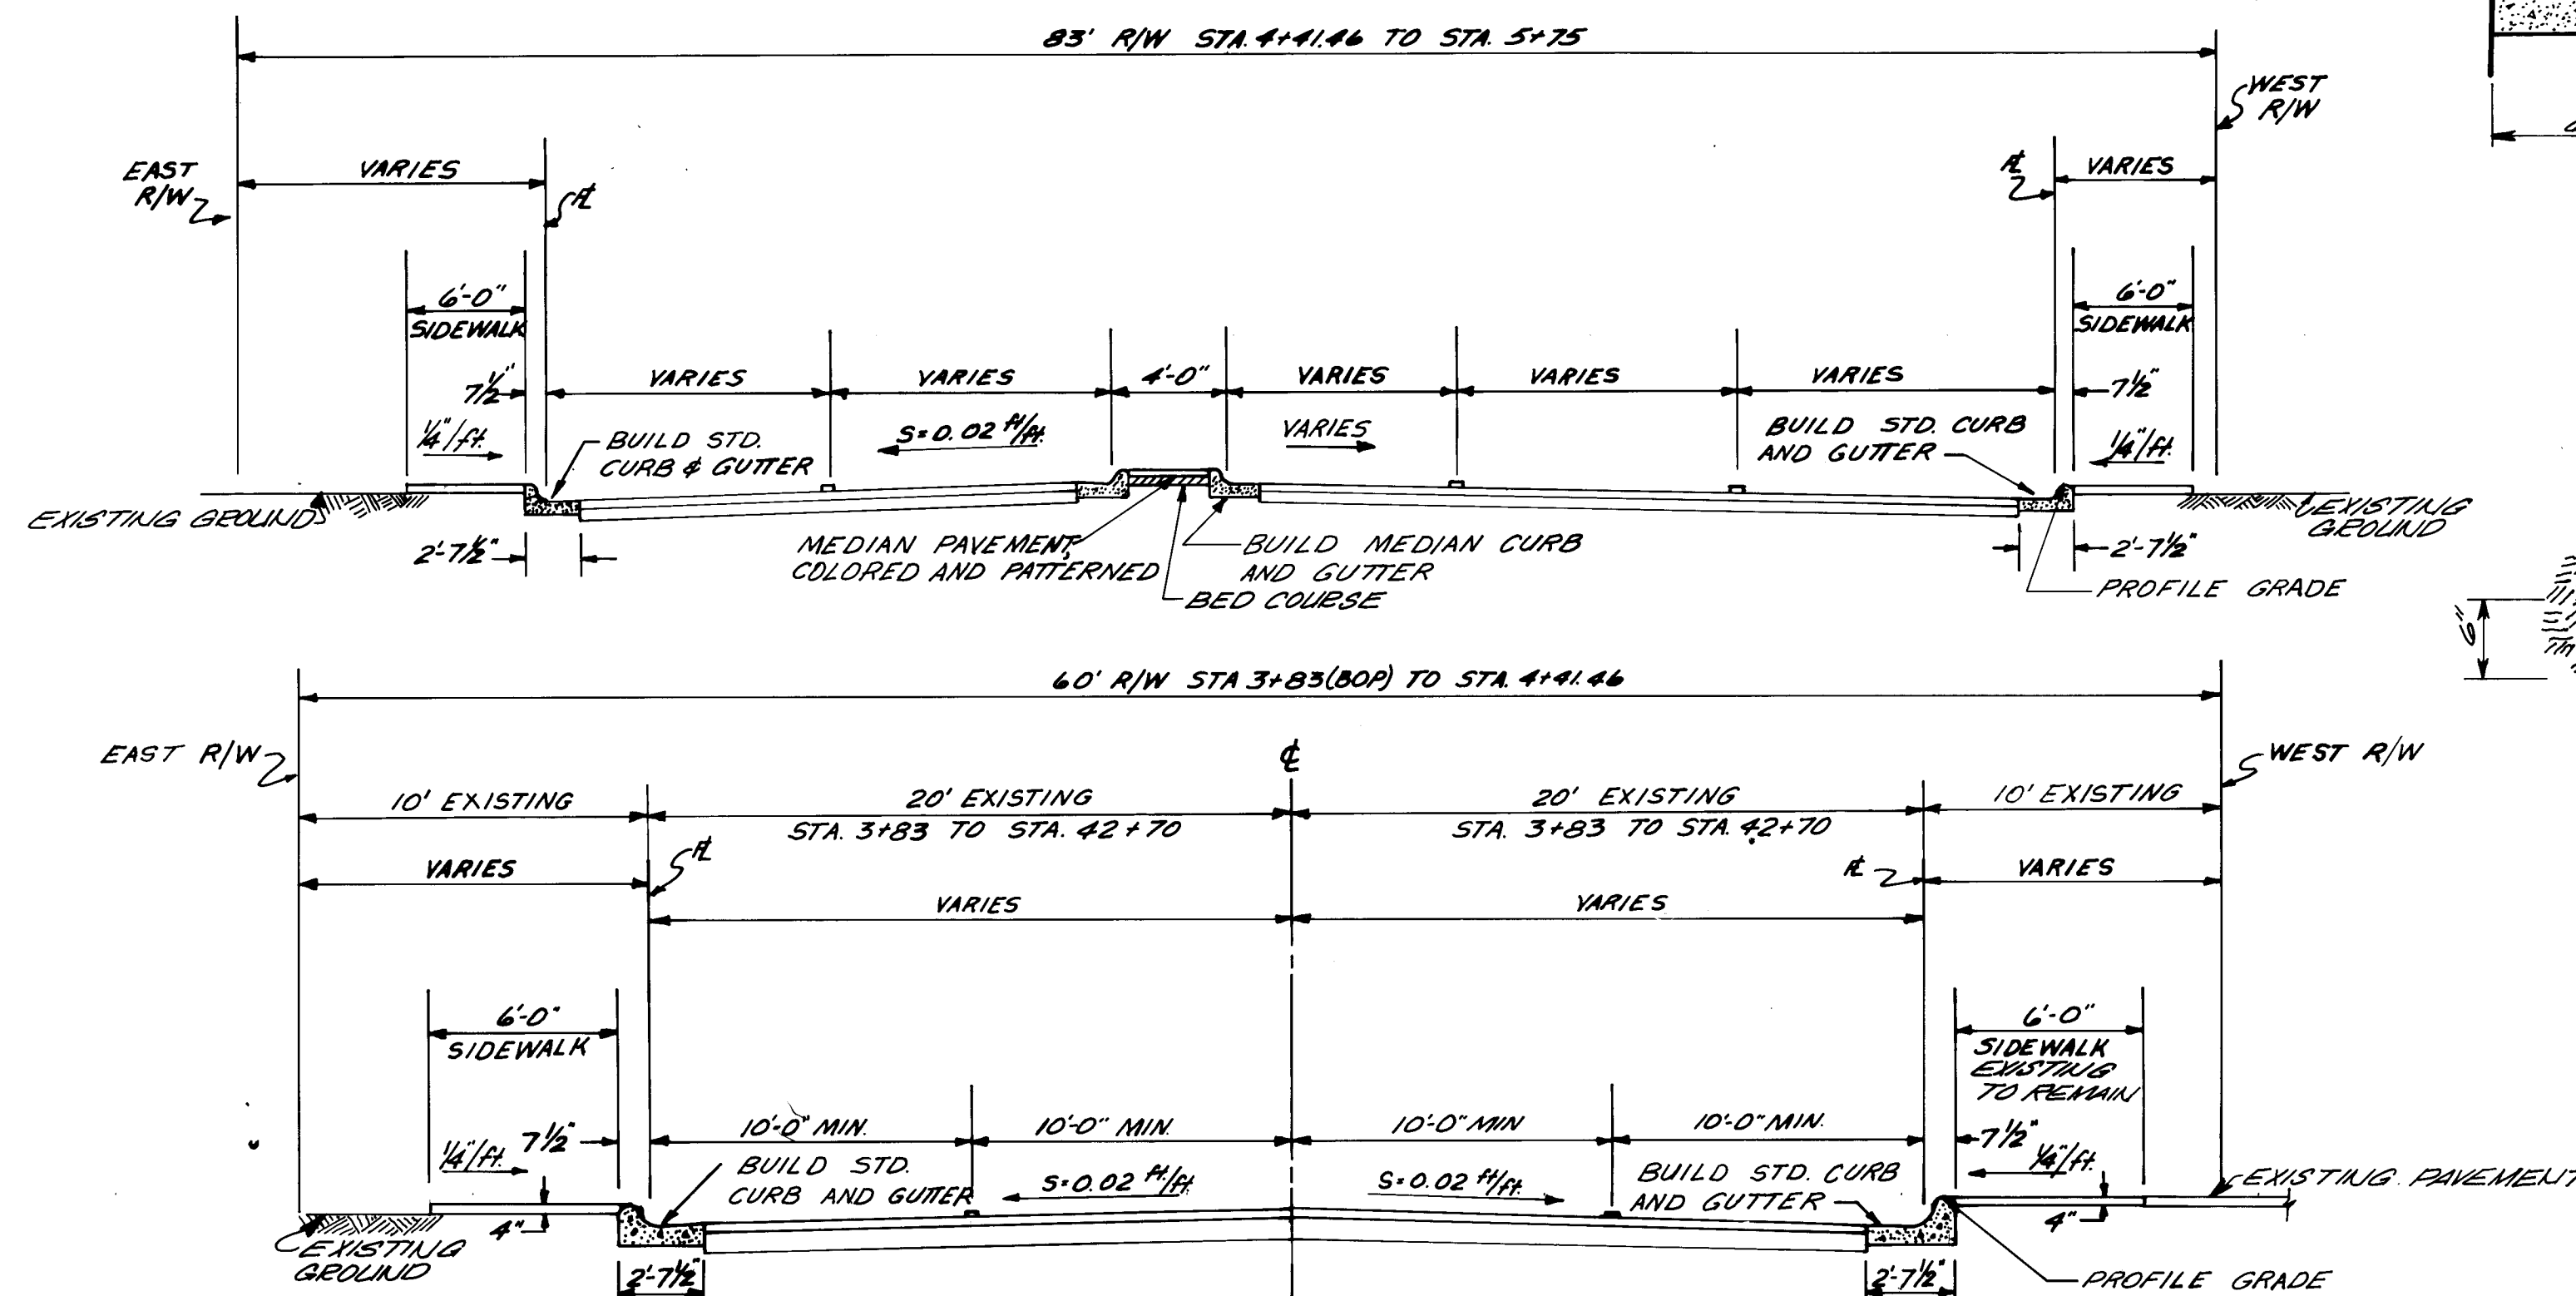


NORTH END TRANSITION SECTIONS

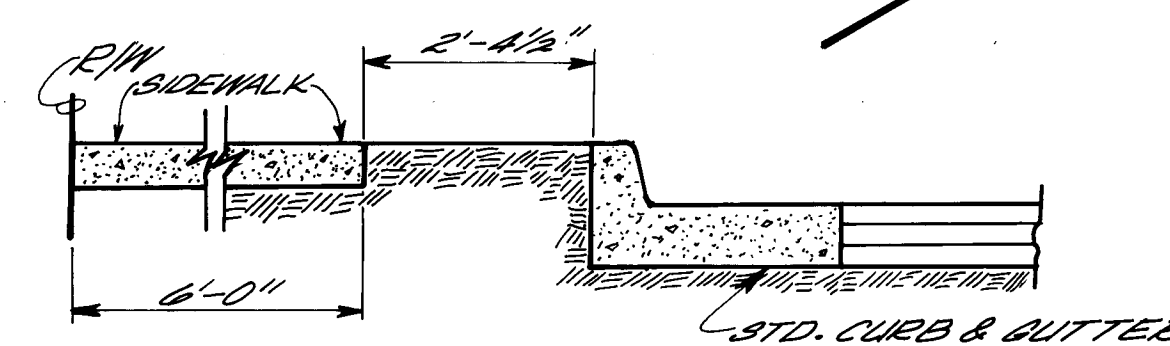

SIDEWALK DETAIL
STA. 6+80 TO STA. 19+85.49 LT.

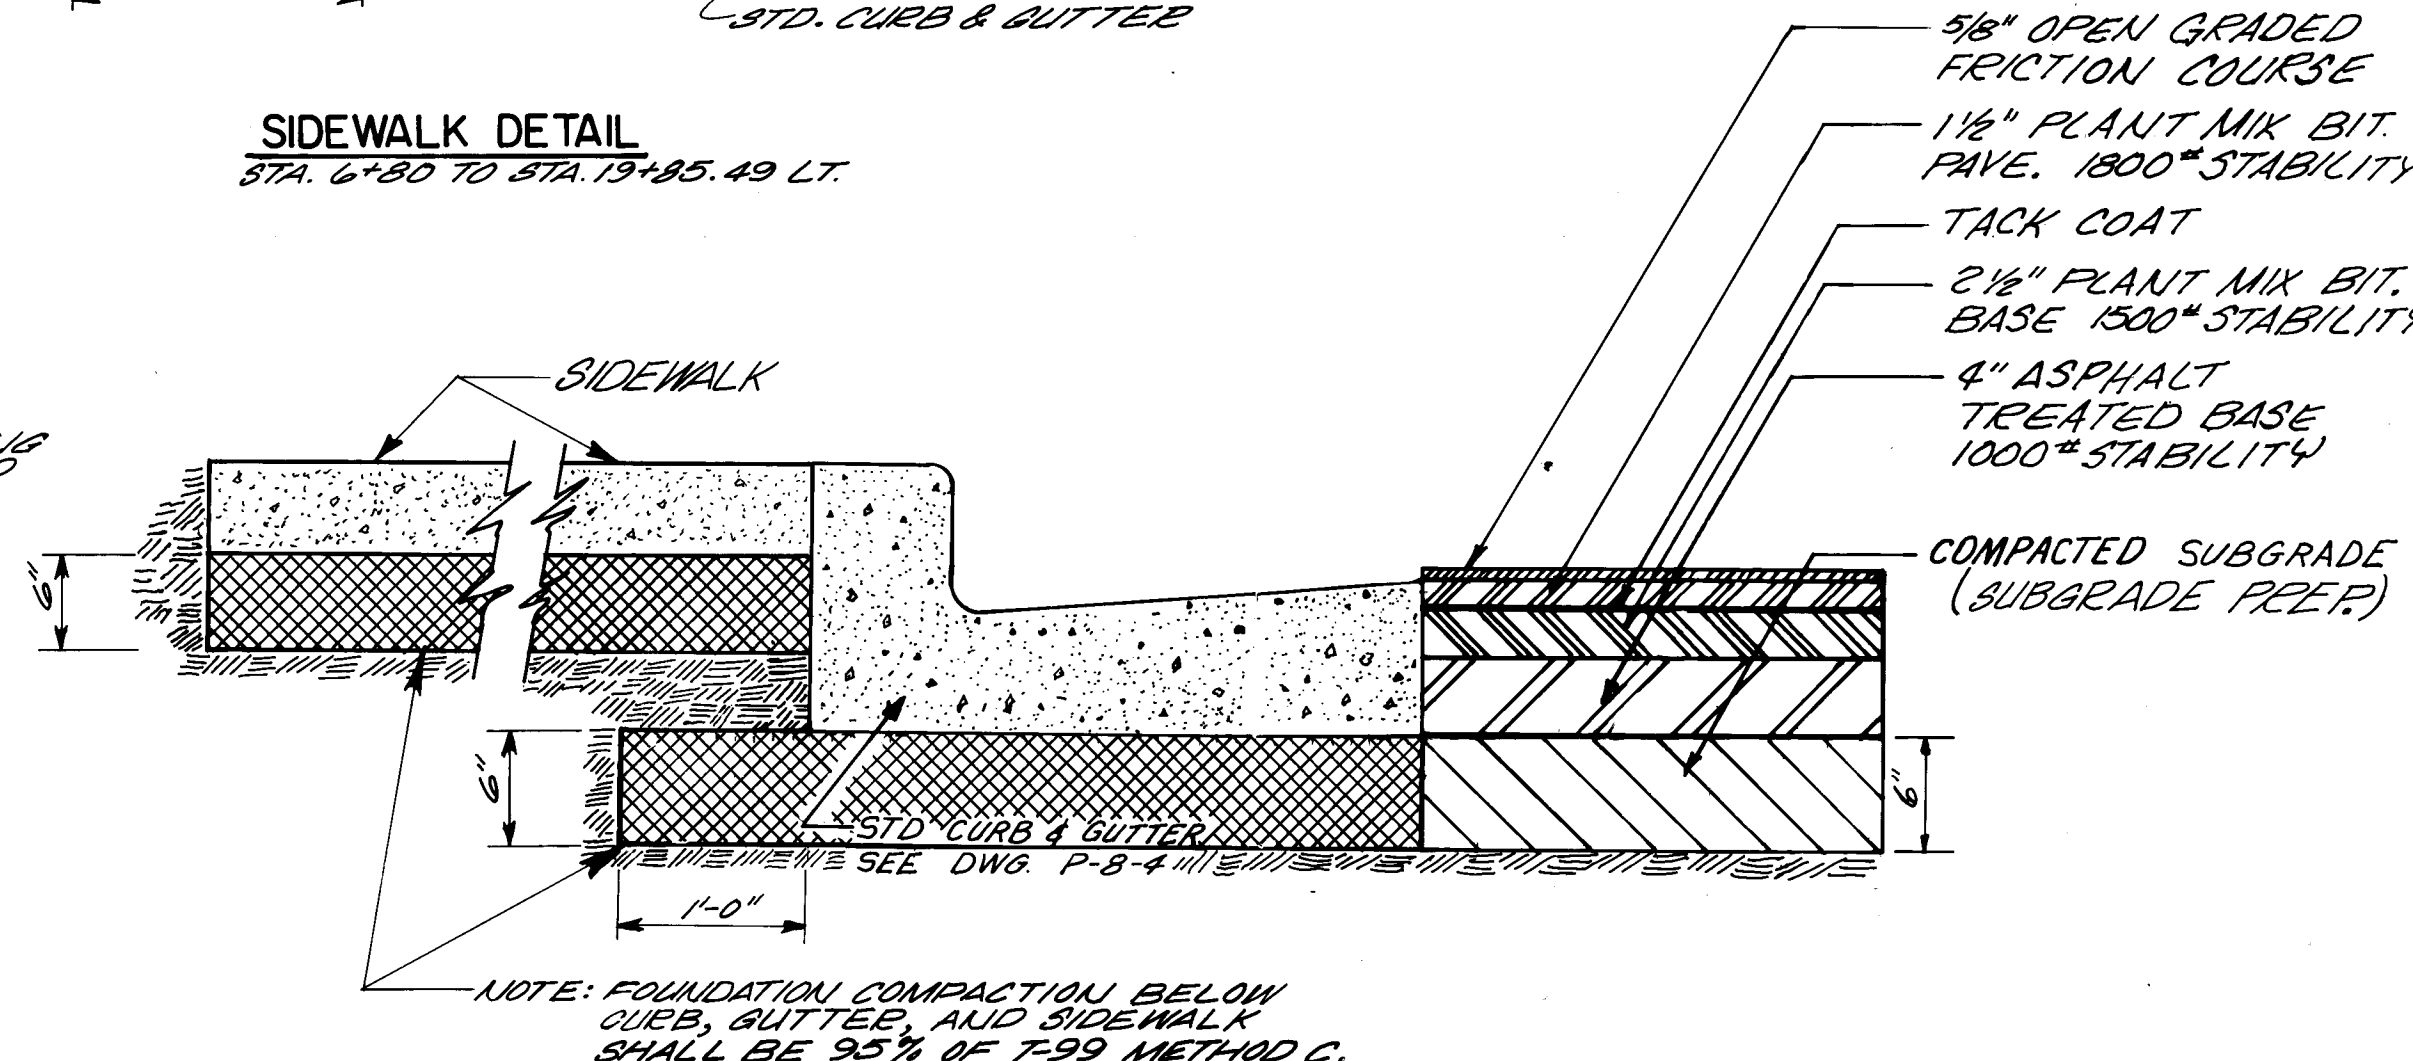

TYPICAL ARTERIAL
PAVEMENT SECTION

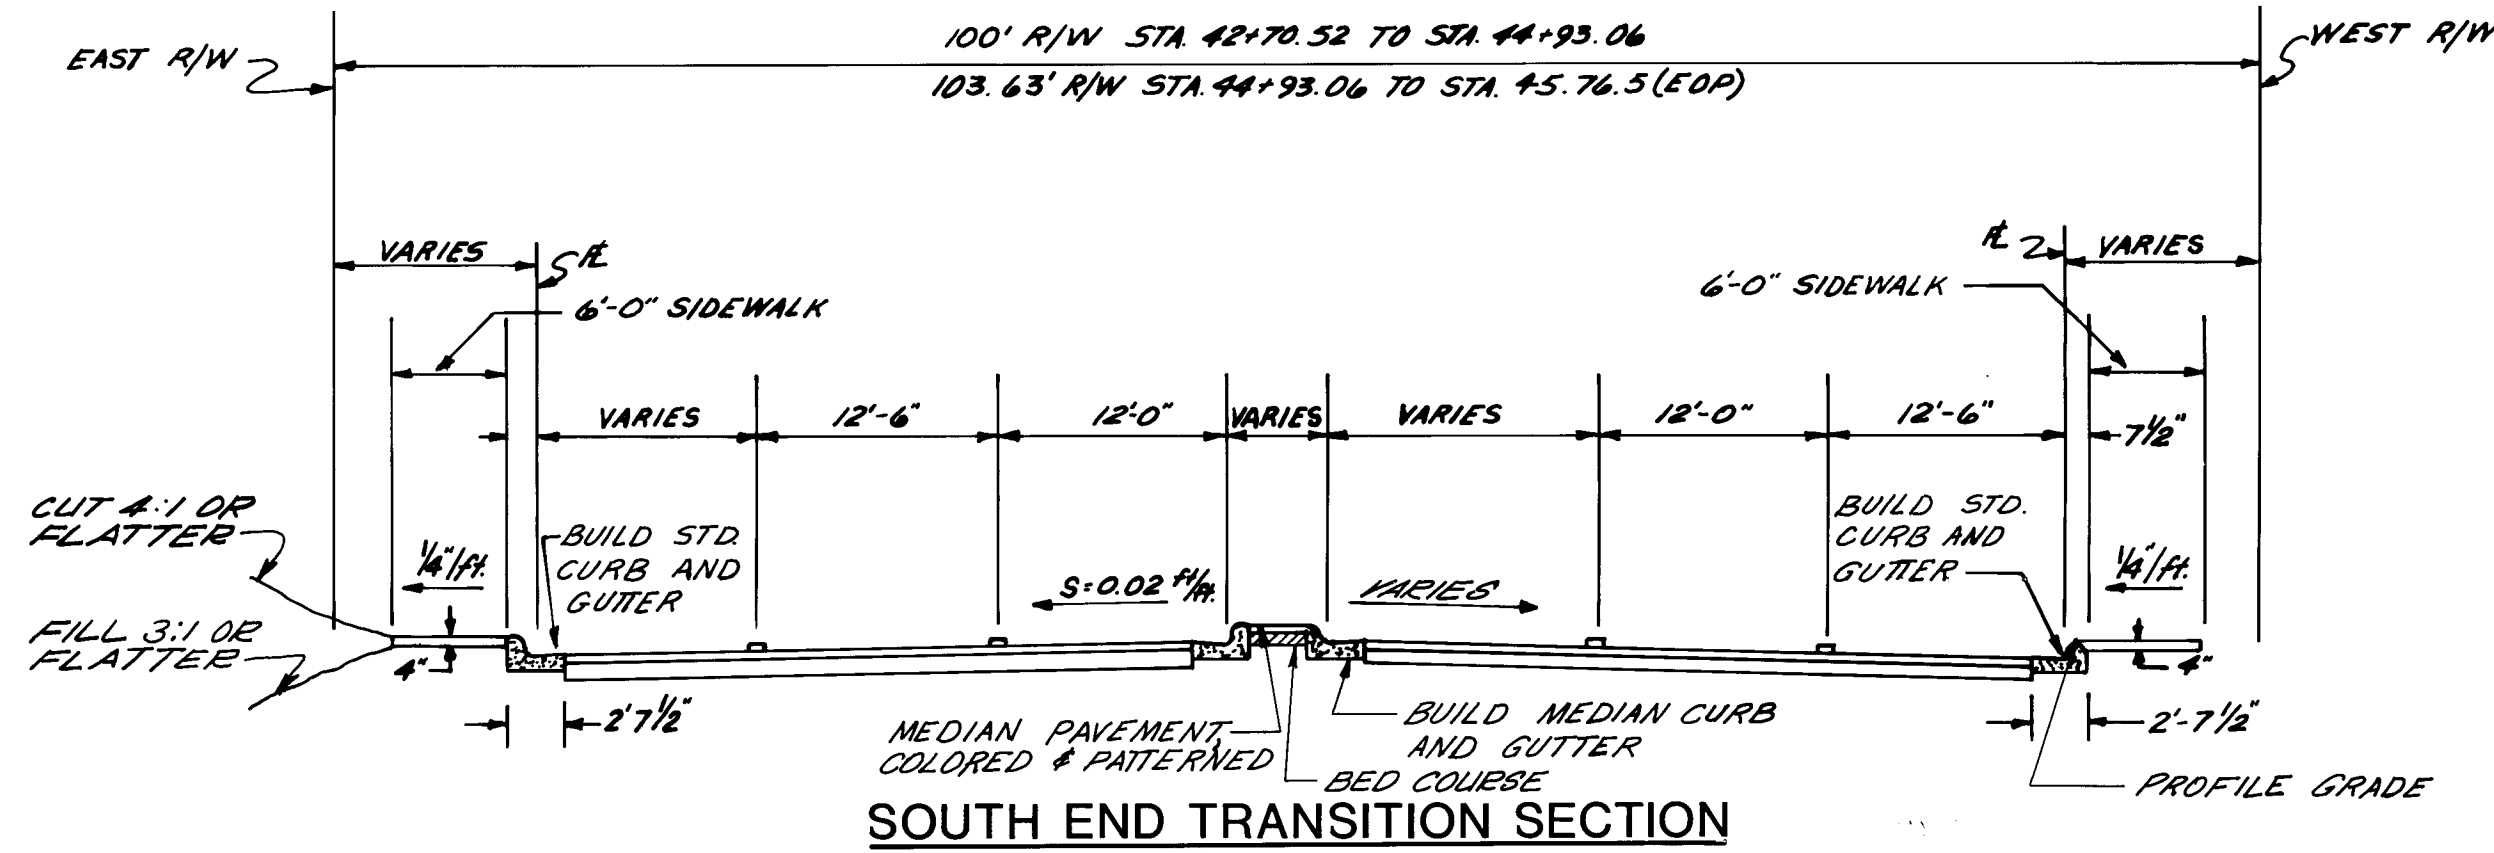

SOUTH END TRANSITION SECTION

TRAFFIC VOLUME ESTIMATE	
LENGTH (MILES)	0.82
A.D.T. (1983)	8000
A.D.T. (2005)	15000
DHV (2005)	1050
% HVY COMM (1983)	10
% HVY COMM (2005)	10
ADL (20) FLEXIBLE	379

LENGTH OF PROJECT

STATION	TO STATION	LINEAR FEET	MILES
3+83	47+14	4331	0.820

26 19600487

RECORD DRAWING
Drawings revised to reflect the best information available. Do not use without field verification.

PLANS PREPARED UNDER THE DIRECTION OF		CITY OF ALBUQUERQUE DEPARTMENT OF TRANSPORTATION	
REGISTERED PROFESSIONAL ENGINEER STATE OF NEW MEXICO No. 1593 WILLIAM I. MATOTAN		TITLE: YALE BOULEVARD WIDENING STADIUM BLVD. TO GIBSON BLVD. TYPICAL ROADWAY SECTIONS	
APPROVALS	ENGINEER	DATE	APPROVALS
City Engineer			Liquid Waste
A.C.E - Design	W. I. Matotan	1/14/85	Traffic
A.C.E - Hydrology	W. I. Matotan	1/14/85	Water
DRAWING NO. 1960		MAP NO.	SHEET 1-4
CITY ENGINEER		DATE	

AS BUILT INFORMATION		BENCH MARKS		SURVEY INFORMATION		REFERENCES		REVISIONS		DESIGN	
CONTRACTOR	Loomis Construction	STATIONED BY	City of Albuquerque	DATE	8/5/84	MAP NO.		EST. NO.	W.O. NO.	NO.	DATE
INSPECTOR		ACCEPTANCE BY		DATE							
DESIGNED BY	W.I. Matotan	DATE	1/14/85	DESIGNED BY	W.I. Matotan	DATE	1/14/85	DRAWN BY	G.M. / W.I. Matotan	DATE	1/14/85
CHECKED BY		DATE		CHECKED BY		DATE					

0716002

SPECIAL PROVISIONS

FOR CONTACTING NEWS MEDIA
FOR MINIMUM WAGE RATES 8-17-84
FOR IMPENDING CONSTRUCTION SIGNS
FOR SUBMISSION OF WEEKLY PAYROLLS 8-20-84
FOR APPRENTICES 4-26-82
FOR MODIFYING SECTION 106 - CONTROL OF MATERIALS 3-28-84
FOR MODIFYING SECTION 106 - CONTROL OF MATERIALS 9-21-84
FOR MODIFYING SECTION 109 - MEASUREMENT AND PAYMENT 8-23-84
FOR MODIFYING SECTION 401 - PLANT MIX BITUMINOUS PAVEMENT 9-14-84
FOR MODIFYING SECTION 401 - PLANT MIX BITUMINOUS PAVEMENT 8-24-84
FOR MODIFYING SECTION 404 - OPEN-GRADED FRICTION COURSE 8-23-84
FOR MODIFYING SECTION 404 - OPEN-GRADED FRICTION COURSE 8-27-84
FOR MODIFYING SECTION 503 - PORTLAND CEMENT CONCRETE 12-10-84

SUMMARY OF QUANTITIES

ITEM NO	ROADWAY		CONSTRUCTION SIGNING						UNIT	ROADWAY ITEMS
	ESTIMATE	FINAL	ESTIMATE	FINAL	ESTIMATE	FINAL	ESTIMATE	FINAL		
201002	L.S.	L.S.							L.S.	CLEARING & GRUBBING
202001	L.S.	L.S.							L.S.	REMOVAL OF STRUCTURES & OBSTRUCTIONS
202021	18950	18854.61							SQ.YD.	REMOVAL OF EXISTING PAVEMENT 4"
202022	30150	30580.87							SQ.YD.	REMOVAL OF EXISTING SUBGRADE 4"
207001	30150	30580.87							SQ.YD.	SUBGRADE PREPARATION
301007	30150	30473.64							SQ.YD.	PLANT MIX BITUMINOUS TREATED BASE CL II B 2 1/2"
301008	30150	30726.59							SQ.YD.	ASPHALT TREATED BASE 4"
401107	30150	30227.74							SQ.YD.	PLANT MIXED BITUMINOUS PAVEMENT TYPE I GRADING B 1/2"
404002	30150	30238.50							SQ.YD.	OPEN - GRADED FRICTION COURSE
407012	30150	30227.74							SQ.YD.	TACK COAT
501311	466	473							L.F.	18" REINFORCED CONCRETE PIPE CL III
501325	262	264							L.F.	24" REINFORCED CONCRETE PIPE CL III
501337	48	147							L.F.	36" REINFORCED CONCRETE PIPE CL III
501343	187	192							L.F.	42" REINFORCED CONCRETE PIPE CL III
501349	265	267							L.F.	48" REINFORCED CONCRETE PIPE CL III
608005	4384	4172.91							SQ.YD.	CONCRETE SIDEWALK, 4"
608020	682	701.12							SQ.YD.	DRIVE PAD, 6"
608032	184	217.55							SQ.YD.	MEDIAN PAVEMENT, 4" (COLORED AND PATTERNED)
609020	894	1143.00							L.F.	MEDIAN CURB AND GUTTER (CITY)
609021	4737	5086.70							L.F.	STANDARD CURB AND GUTTER (CITY)
609073	72	72							L.F.	CONCRETE VALLEY GUTTER
623001	3	3							EA.	CATCH BASIN DOUBLE "C"
623072	11	12							EA.	CATCH BASIN SINGLE "C"
623077	2	2							EA.	CATCH BASIN DOUBLE "D"
623078	1	1							EA.	CATCH BASIN QUADRUPLE "D"
660075	828	737							L.F.	TRENCH & BACKFILL 18" - 36" (8-10 FT. DEPTH)
660078	547	606							L.F.	TRENCH & BACKFILL 36" - 48" (8-10 FT. DEPTH)
662040	2	2							EA.	4" DIA. MANHOLE TYPE "E" (6-10 FT. DEPTH)
662061	3	3							EA.	6" DIA. MANHOLE TYPE "E" (6-10 FT. DEPTH)
664075	11	9							EA.	ADJUST WATER VALVE BOX TO GRADE
664080	13	13							EA.	ADJUST SEWER MANHOLE TO GRADE
664090	2	2							EA.	RELOCATE EXISTING WATER METER & BOX
664095	5	4							EA.	RELOCATE EXISTING FIRE HYDRANT
708008	6	7							EA.	PEDESTAL FOUNDATION, TYPE I
708020	3	3							EA.	MASTARM FOUNDATION, TYPE II
708028	1	1							EA.	CONTROLLER FOUNDATION, TYPE I
709030	1865	2315							L.F.	RIGID ELECTRICAL CONDUIT 2"
710010	11	13							EA.	ELECTRICAL PULL BOX
765029	1	1							EA.	8" DIA. MANHOLE TYPE C (6-10 FT. DEPTH)
708204	18	16							EA.	STREET LIGHT FOUNDATION
702000			1896	*100%					*L.S.	SAFF. CONSTRUCTION SIGNING
702003			215						L.P.	STEEL POSTS & BASE POSTS FOR CONSTRUCTION SIGNING
702015			185						EA.	BARICADE, TYPE III - 8'
702035			185						EA.	VERTICAL PANEL, BACK TO BACK TYPE
702045			24						EA.	PORTABLE SIGN SUPPORT
702050			354						EA.	CHANNELIZING DEVICE - TYPE "B"

FOR INFORMATION OF THE CONTRACTOR ONLY

* Change Order No. 1

26 19600587

RECORD DRAWING
Drawings revised to reflect the best information available. Do not use without field verification.

PLANS PREPARED UNDER THE DIRECTION OF



WILLIAM J. MATOTAN
CITY ENGINEER

CITY OF ALBUQUERQUE
DEPARTMENT OF TRANSPORTATION

TITLE: YALE BOULEVARD WIDENING
STADIUM BLVD. TO GIBSON BLVD.
SUMMARY OF QUANTITIES & SPECIAL PROVISIONS

APPROVALS	ENGINEER	DATE	APPROVALS	ENGINEER	DATE
City Engineer			Liquid Waste	R. Perea	1/14/85
A.C.E. - Design	W. J. Matotan	1/21/85	Traffic	R. Perea	1/21/85
A.C.E. - Hydrology	W. J. Matotan	1/14/85	Water	R. Perea	1/14/85

DRAWING NO. 1960
MAP NO. SHEET 2-1 OF

AS BUILT INFORMATION	CONTRACTOR	Loomis Construction	DATE	8-25-84
BENCH MARKS	STAKED BY	City of Albuq.	DATE	
SURVEY INFORMATION	INSPECTOR'S ACCEPTANCE BY		DATE	
REFERENCES	W.O. NO.		DATE	
REVISIONS	REMARKS	BY	DATE	
DESIGN	WILLIAM J. MATOTAN	1/19/84	DATE	1/19/84
DRAWN BY	WILLIAM J. MATOTAN	1/19/84	DATE	1/19/84
CHECKED BY	WILLIAM J. MATOTAN	1/19/84	DATE	1/19/84

0726.043

CONCRETE
CURB AND GUTTER
8" STANDARD

LEFT		
STATION TO STATION	LENGTH L.F.	
3+83	6+02	201'
6+50	12+00	467'
12+00	20+00	740'
20+50	25+00	479'
25+00	32+06	671'
32+06	38+00	539'
38+00	45+73	773'
TOTAL LEFT		3870'
RIGHT		
STATION TO STATION	LENGTH L.F.	
4+23	5+53	92'
6+67	6+92	39'
12+60	12+85	39'
13+17	13+42	39'
19+10	19+35	39'
19+65	19+92	39'
25+60	26+85	39'
26+17	26+42	39'
32+10	32+35	39'
32+75	33+05	39'
40+70	45+77	331'
TOTAL RIGHT		774'
SANTA CLARA		
STATION TO STATION	LENGTH L.F.	
0+62	2+20	93'
TOTAL SANTA CLARA		93'
YALE BLVD LEFT 3870'		
YALE BLVD RIGHT 774'		
SANTA CLARA 93'		
TOTAL 4737 L.F.		

LEFT		
STATION TO STATION	LENGTH L.F.	
3+83	6+02	199'
6+50	12+00	467'
12+00	20+00	740'
20+50	25+00	464'
25+00	32+06	685'
32+06	38+00	569'
38+00	45+73	773'
TOTAL LEFT		3897'
RIGHT		
STATION TO STATION	LENGTH L.F.	
4+23	5+53	92'
6+67	11+22	479'
12+59	12+84	39'
13+19	17+05	400'
17+75	19+34	173'
19+63	19+88	39'
20+28	20+62	34'
21+00	25+00	365'
25+00	25+85	99'
26+17	27+49	176'
32+08	32+33	39'
32+69	35+75	320'
40+70	45+77	331'
TOTAL RIGHT		2586'
SANTA CLARA		
STATION TO STATION	LENGTH L.F.	
0+62	2+20	93'
TOTAL SANTA CLARA		93'
YALE BLVD LEFT 3897'		
YALE BLVD RIGHT 2586'		
SANTA CLARA 93'		
TOTAL L.F. 6876'		
(6876 L.F. X 6 L.F.) / 9 = 4384 Sq. Yd.		

WATER VALVE ADJUSTMENT		
LOCATION	RT.	LT.
STATION		
4+05	/	/
4+06	/	/
6+53	/	/
6+58	/	/
7+19	/	/
19+79	/	/
26+29	/	/
31+92	/	/
32+15	/	/
32+89	/	/
32+40.4	/	/
TOTAL		7 4

WATER METER ADJUSTMENT	
STATION	NUMBER
7+15 RT.	1
24+78 RT.	1

FIRE HYDRANTS	
STATION	RELOCATE
5+64 RT.	1
12+73 RT.	1
19+23 RT.	1
26+20 RT.	1
32+16 RT.	1
TOTAL	5

STORM DRAIN MANHOLES			
LOCATION	TYPE	HEIGHT	DIAMETER
6+28	E	10'	4'
8+90	E	9'	4'
20+67 LT.	C	10'	8'
22+48 LT.	E	10'	6'
35+87 LT.	E	10'	6'
42+06 LT.	E	10'	6'
TOTAL		46	

CATCH BASIN					
LOCATION	TYPE	DEPTH*	18" RCP	TREN DEP	
YALE BLVD.					
5+77 LT.	"C"	7.4	65' 56"	9.5'	
6+85 LT.	"C"	7.0	65' 70"	8'	
9+10 RT.	"C"	7.0	30' 40"	8'	
9+30 LT.	"C"	7.0	60' 55"	8'	
20+30 RT.	"C"	7.0	30' 12"	8'	
20+89 LT.	"C"	7.0	30' 34"	8'	
32+76 LT.	"C"	7.0	40' 42"	8'	
35+18	35+30 LT	"C"	7.0	24' 50"	8'
41+30	41+40 LT.	"C"	7.0	10' 32"	8'
32+07 LT.	"d/c"	4.7'	55' 30"	9'	
32+43 LT.	"d/c"	4.8'	40'	9'	
41+40 RT.	"d/c"	4.5'	0'	0'	
22+50 LT	"d/d"	5.5	—	—	
41+30 LT	"d/d"	5.0	—	—	
35+86	35+78 LT	Quadruple"D"	6.5	—	
SANTA CLARA AVE.					
0+65 RT.	"C"	5'	6'	6'	
1+69 RT.	"C"	5'	6'	8'	
TOTAL 18			466'		

* INVERT DEPTH FROM TOP OF CURB

STORM DRAIN LINE			
LOCATION	24" R.C.P.	42" R.C.P.	48" R.C.P.
STATION TO STATION	CLASS III	CLASS III	CLASS III
6+28	8+90	24" R.C.P.	
19+10	20+67 LT.		97
20+30 RT.	20+89 LT.		41' 20"
22+48 LT.	22+48 LT.	170' 65"	
22+48 LT.	22+50 LT.	22	
35+18	35+86		45' 95"
36" R.C.P. CL. II			
41+30 40	48' 147	262	787
TOTAL		264	192
		267	

TRENCHING STORM DRAIN		
LOCATION	TRENCH 8'-10'	
STATION TO STATION	18"-36"	36"-48"
6+28	8+90	262' 20"
19+61	20+67	100
20+69	20+67	41
20+67 LT.	22+48 LT.	165
22+48 LT.	22+50 LT.	25
35+18		50
41+30		50' 32"
TOTAL		342' 461'
		737' 606'

CONCRETE DRIVEPADS 6"							
LEFT				RIGHT			
STATION	WIDTH	LENGTH	SQ. YD.	STATION	WIDTH	LENGTH	SQ. YD.
4+28	8.6	35	33.4	4+42	9.3	30	31
7+10	8.4	35	32.7	4+91	9.3	25	26
7+67	8.4	35	32.7	5+35	9.3	30	31
8+65	8.4	30	28	20+10	9.3	35	36.2
13+27	8.4	30	28	20+79	9.3	35	36.2
19+18	8.4	30	28	41+00	18.0	30	60
19+64	8.4	30	28	41+83	9	30	30
29+78	8.4	36	33.6	43+75	14	30	46.7
				44+17	9	30	30
				45+24	8	35	31
				45+62	8	20	17.8
TOTAL LEFT 244.4 Sq.Yd.				TOTAL RIGHT 376 Sq.Yd.			
SANTA CLARA							
				1+17	8.6	35	33.4
				1+89	8.6	30	28.6
				TOTAL RIGHT 620 Sq.Yd.			
YALE BLVD TOTAL LEFT				244	Sq.Yd.		
YALE BLVD TOTAL RIGHT				376	Sq.Yd.		
SANTA CLARA TOTAL RIGHT				62	Sq.Yd.		
TOTAL				682	Sq.Yd.		

CONC. MEDIAN PAVEMENT		
STA. TO STA.	SQ. YD.	
4+85	5+75	40
6+94	8+92	45
43+35	45+77.83	99
TOTAL SQ. YD.		184

CONC. VALLEY GUTTER		
STA. TO STA.	LENGTH	
20+12	20+49	36'
32+29	32+45	36'
TOTAL L.F.		72'

MEDIAN CURB & GUTTER		
STA. TO STA.	LENGTH	
4+85	5+75	180'
6+94	8+92	45'
43+35	45+77.83	299'
TOTAL L.F.		594'

ADJ. MANHOLES TO GR.	
LOCATION	NO.
4+70	1
6+28	1
8+90	1
19+61	1
20+67	1
32+37	1
32+59	1
35+18	1
41+23	1
41+27	1
42+16	1
43+71	1
43+10	1

BOLLARD SCHEDULE	
LOCATION	NO.
STADIUM - YALE INST.	8
YALE - SOUTHERN INST.	4
YALE - KATHYRN WEST INST.	4
YALE - KATHYRN EAST INST.	4
YALE - ANDERSON INST.	4
YALE - ROSS WEST INST.	4
YALE - ROSS EAST INST.	4
TOTAL	32 ea.

26 19600687


RECORD DRAWING
Drawings revised to reflect the best information available. Do not use without field verification.

PLANS PREPARED UNDER THE DIRECTION OF  WILLIAM I. MATOTAN APPROVED FOR CONSTRUCTION CITY ENGINEER DATE	CITY OF ALBUQUERQUE DEPARTMENT OF TRANSPORTATION TITLE: YALE BOULEVARD WIDENING STADIUM BLVD. TO GIBSON BLVD. MISCELLANEOUS QUANTITIES
APPROVALS City Engineer A.C.E. - Design Hydrology	ENGINEER DATE 1/14/85 1/14/85
APPROVALS ENGINEER DATE 1/14/85 1/14/85	DATE 1/14/85 1/14/85
DRAWING NO. 1960	MAP NO. SHEET 2-2 OF

RECORD DRAWING
Drawings revised to reflect the best information available. Do not use without field verification.



0+00

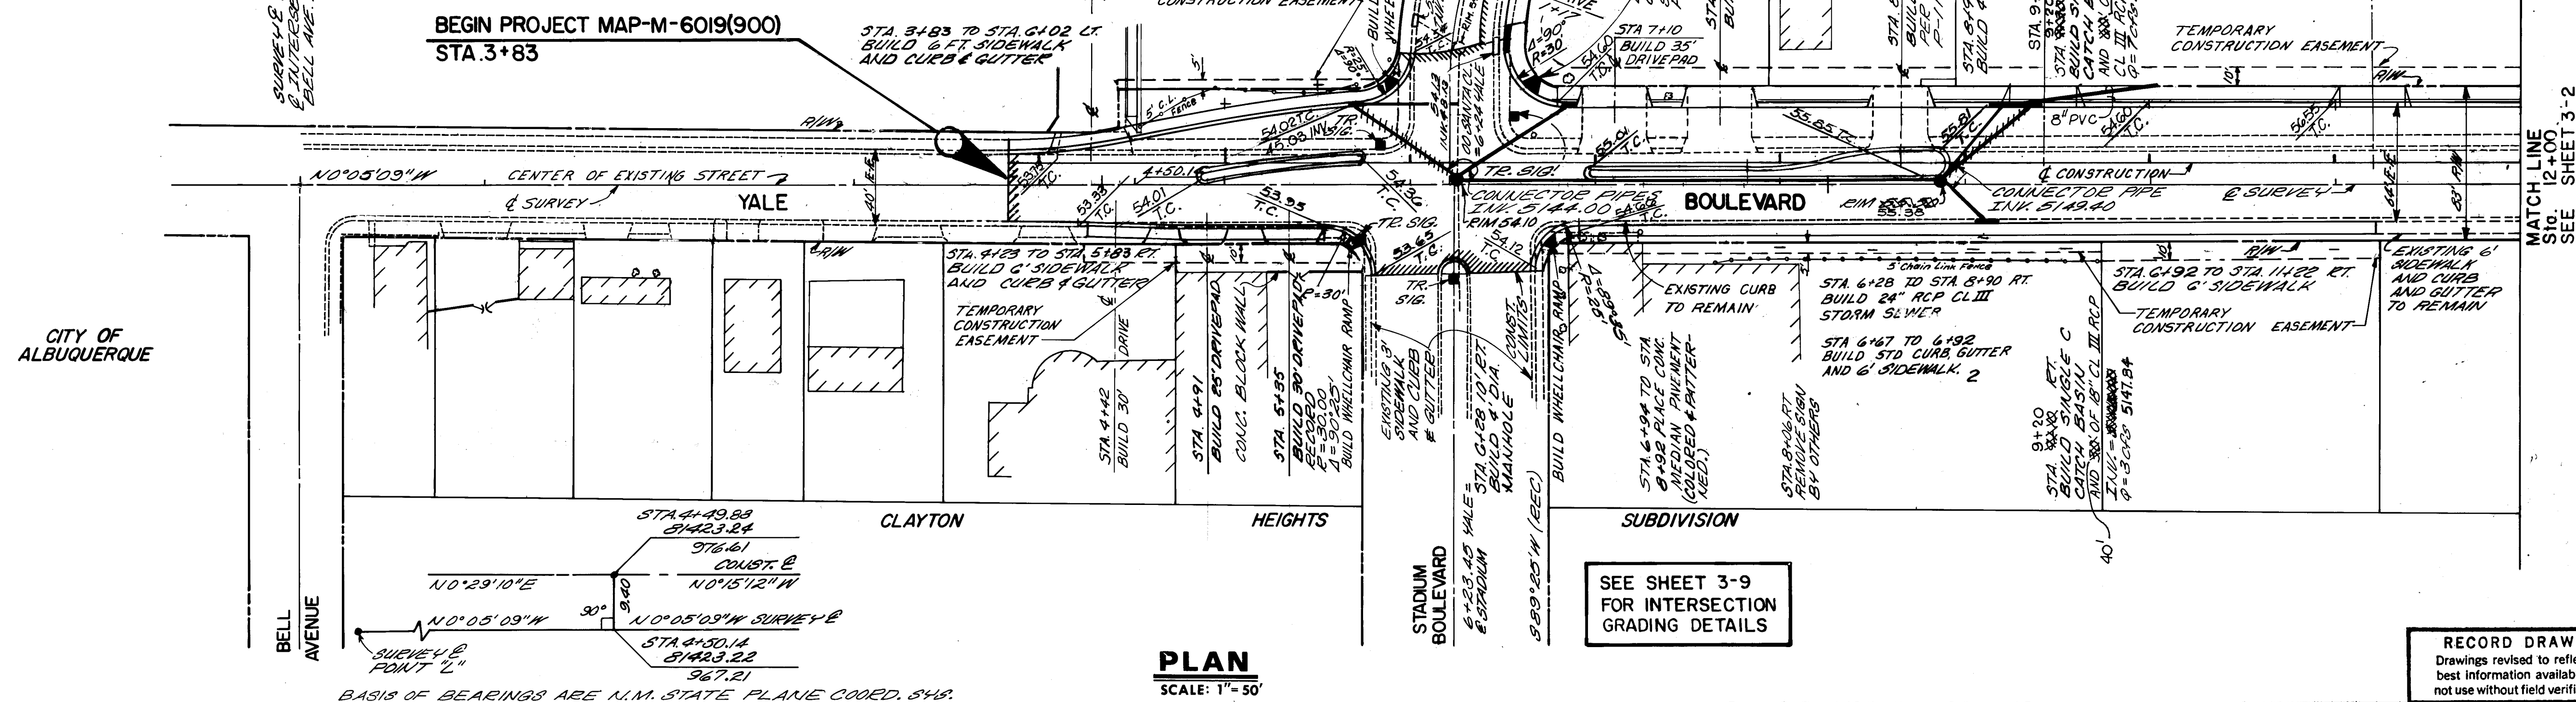
 $10+00$ 

BASIS OF BEARINGS ARE N.M. STATE PLANE COORD. SYS.


PLAN
SCALE: 1" = 50'

PROFILE
SCALE: 1" = 50' Horiz.
1" = 5' Vert.

RECORD DRAWING
Drawings revised to reflect the
best information available. Do
not use without field verification.

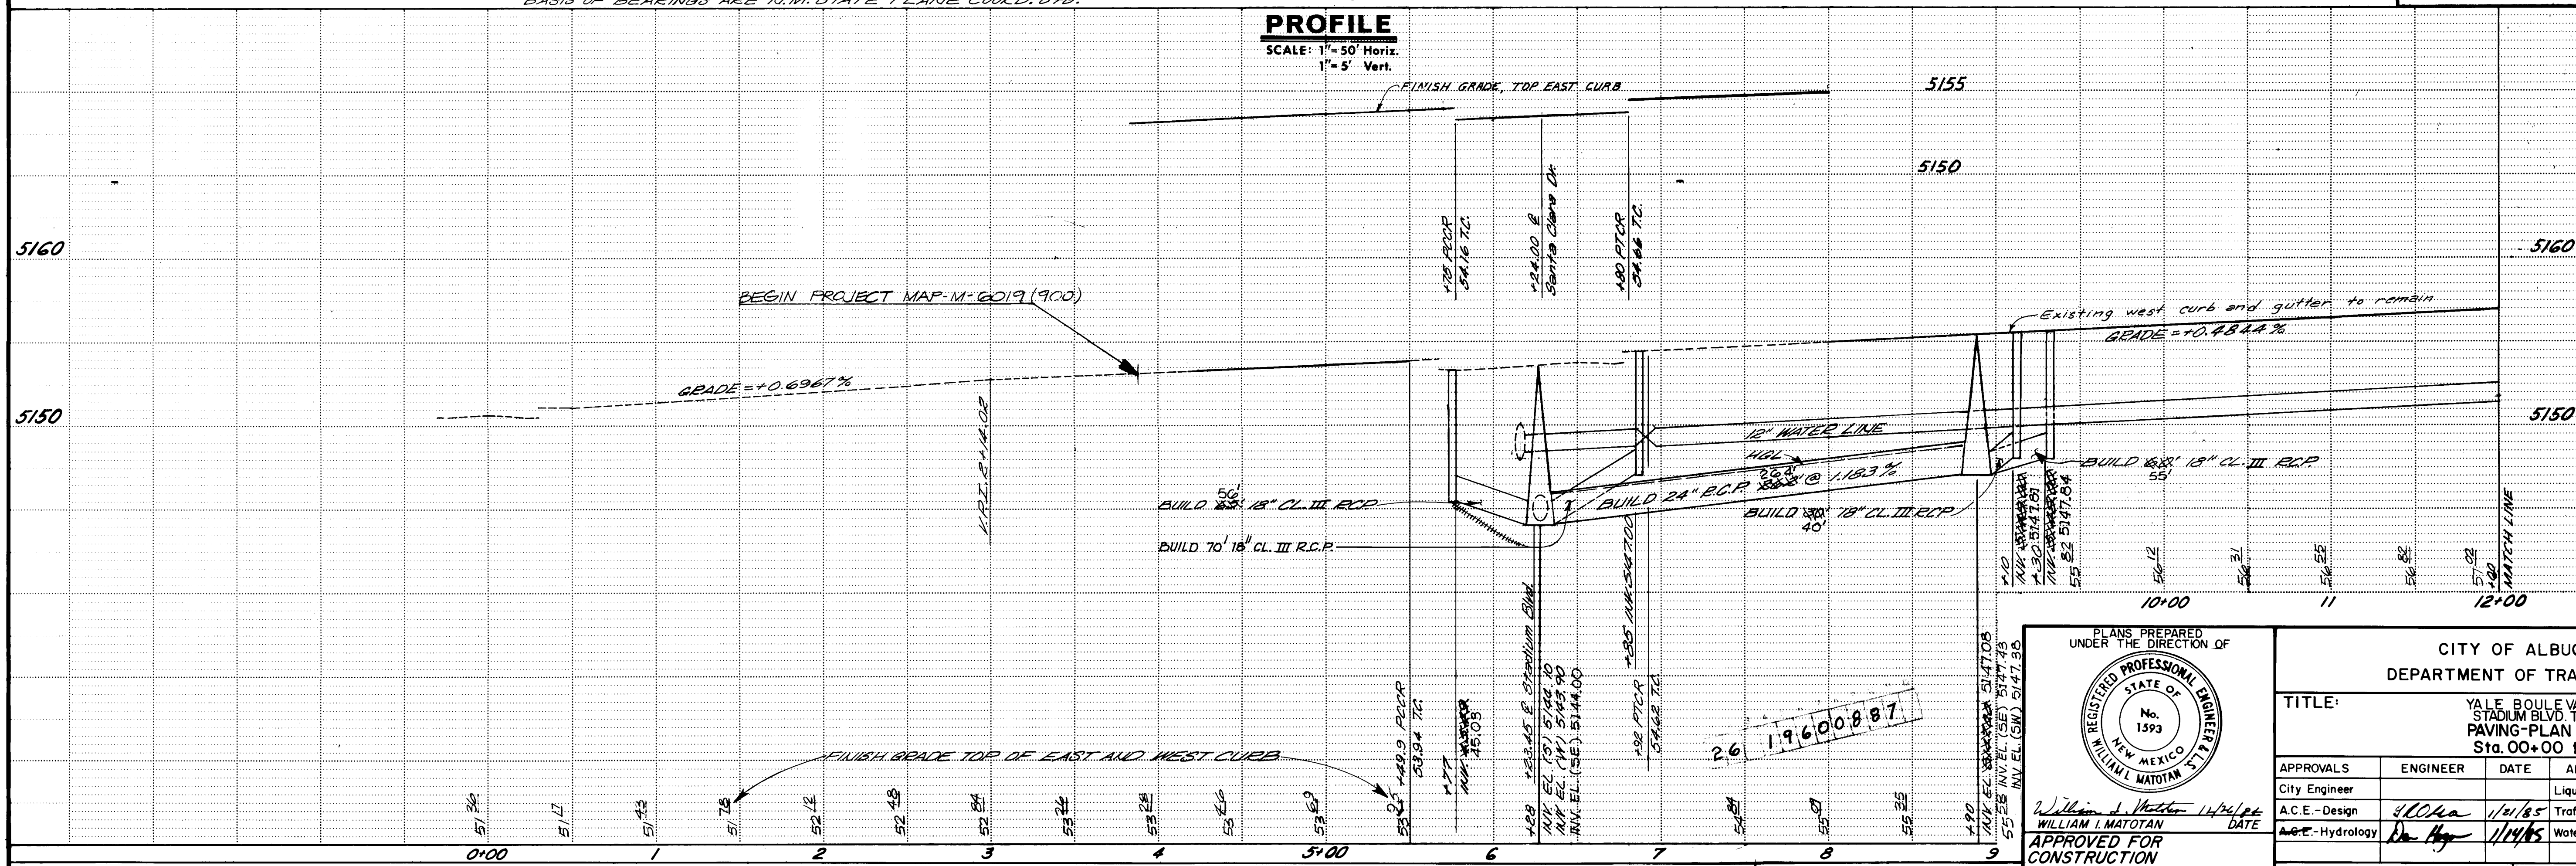

WILLIAM MATOTAN & ASSOCIATES, INC.
ALBUQUERQUE, NEW MEXICO

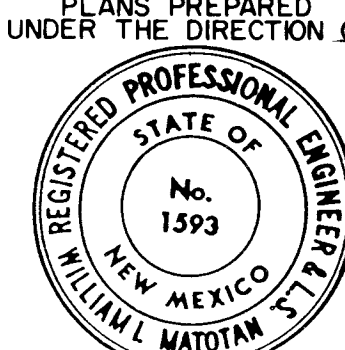

PLANS PREPARED
UNDER THE DIRECTION OF

REGISTERED PROFESSIONAL ENGINEER & ARCHT.
STATE OF
No. 1593
NEW MEXICO
WILLIAM I. MATOTAN

William I. Matotan 1/26/68
WILLIAM I. MATOTAN DATE

APPROVED FOR
CONSTRUCTION


CITY OF ALBUQUERQUE
DEPARTMENT OF TRANSPORTATION

TITLE: YALE BOULEVARD WIDENING
STADIUM BLVD. TO GIBSON BLVD.
PAVING-PLAN AND PROFILE
Sta. 00+00 to Sta. 12+00



APPROVALS	ENGINEER	DATE	APPROVALS	ENGINEER	DATE
City Engineer			Liquid Waste	<i>R. B. [Signature]</i>	1/14/85
A.C.E. - Design	<i>400ha</i>	1/21/85	Traffic	<i>R. B. [Signature]</i>	1-21-85
A.C.E. - Hydrology	<i>Don Han</i>	1/14/85	Water	<i>R. B. [Signature]</i>	1/14/85

DRAWING NO.	1960	MAP NO.	1-45 & 1-16	SHEET	3-1	OF	
-------------	------	---------	-------------	-------	-----	----	--

0722 003

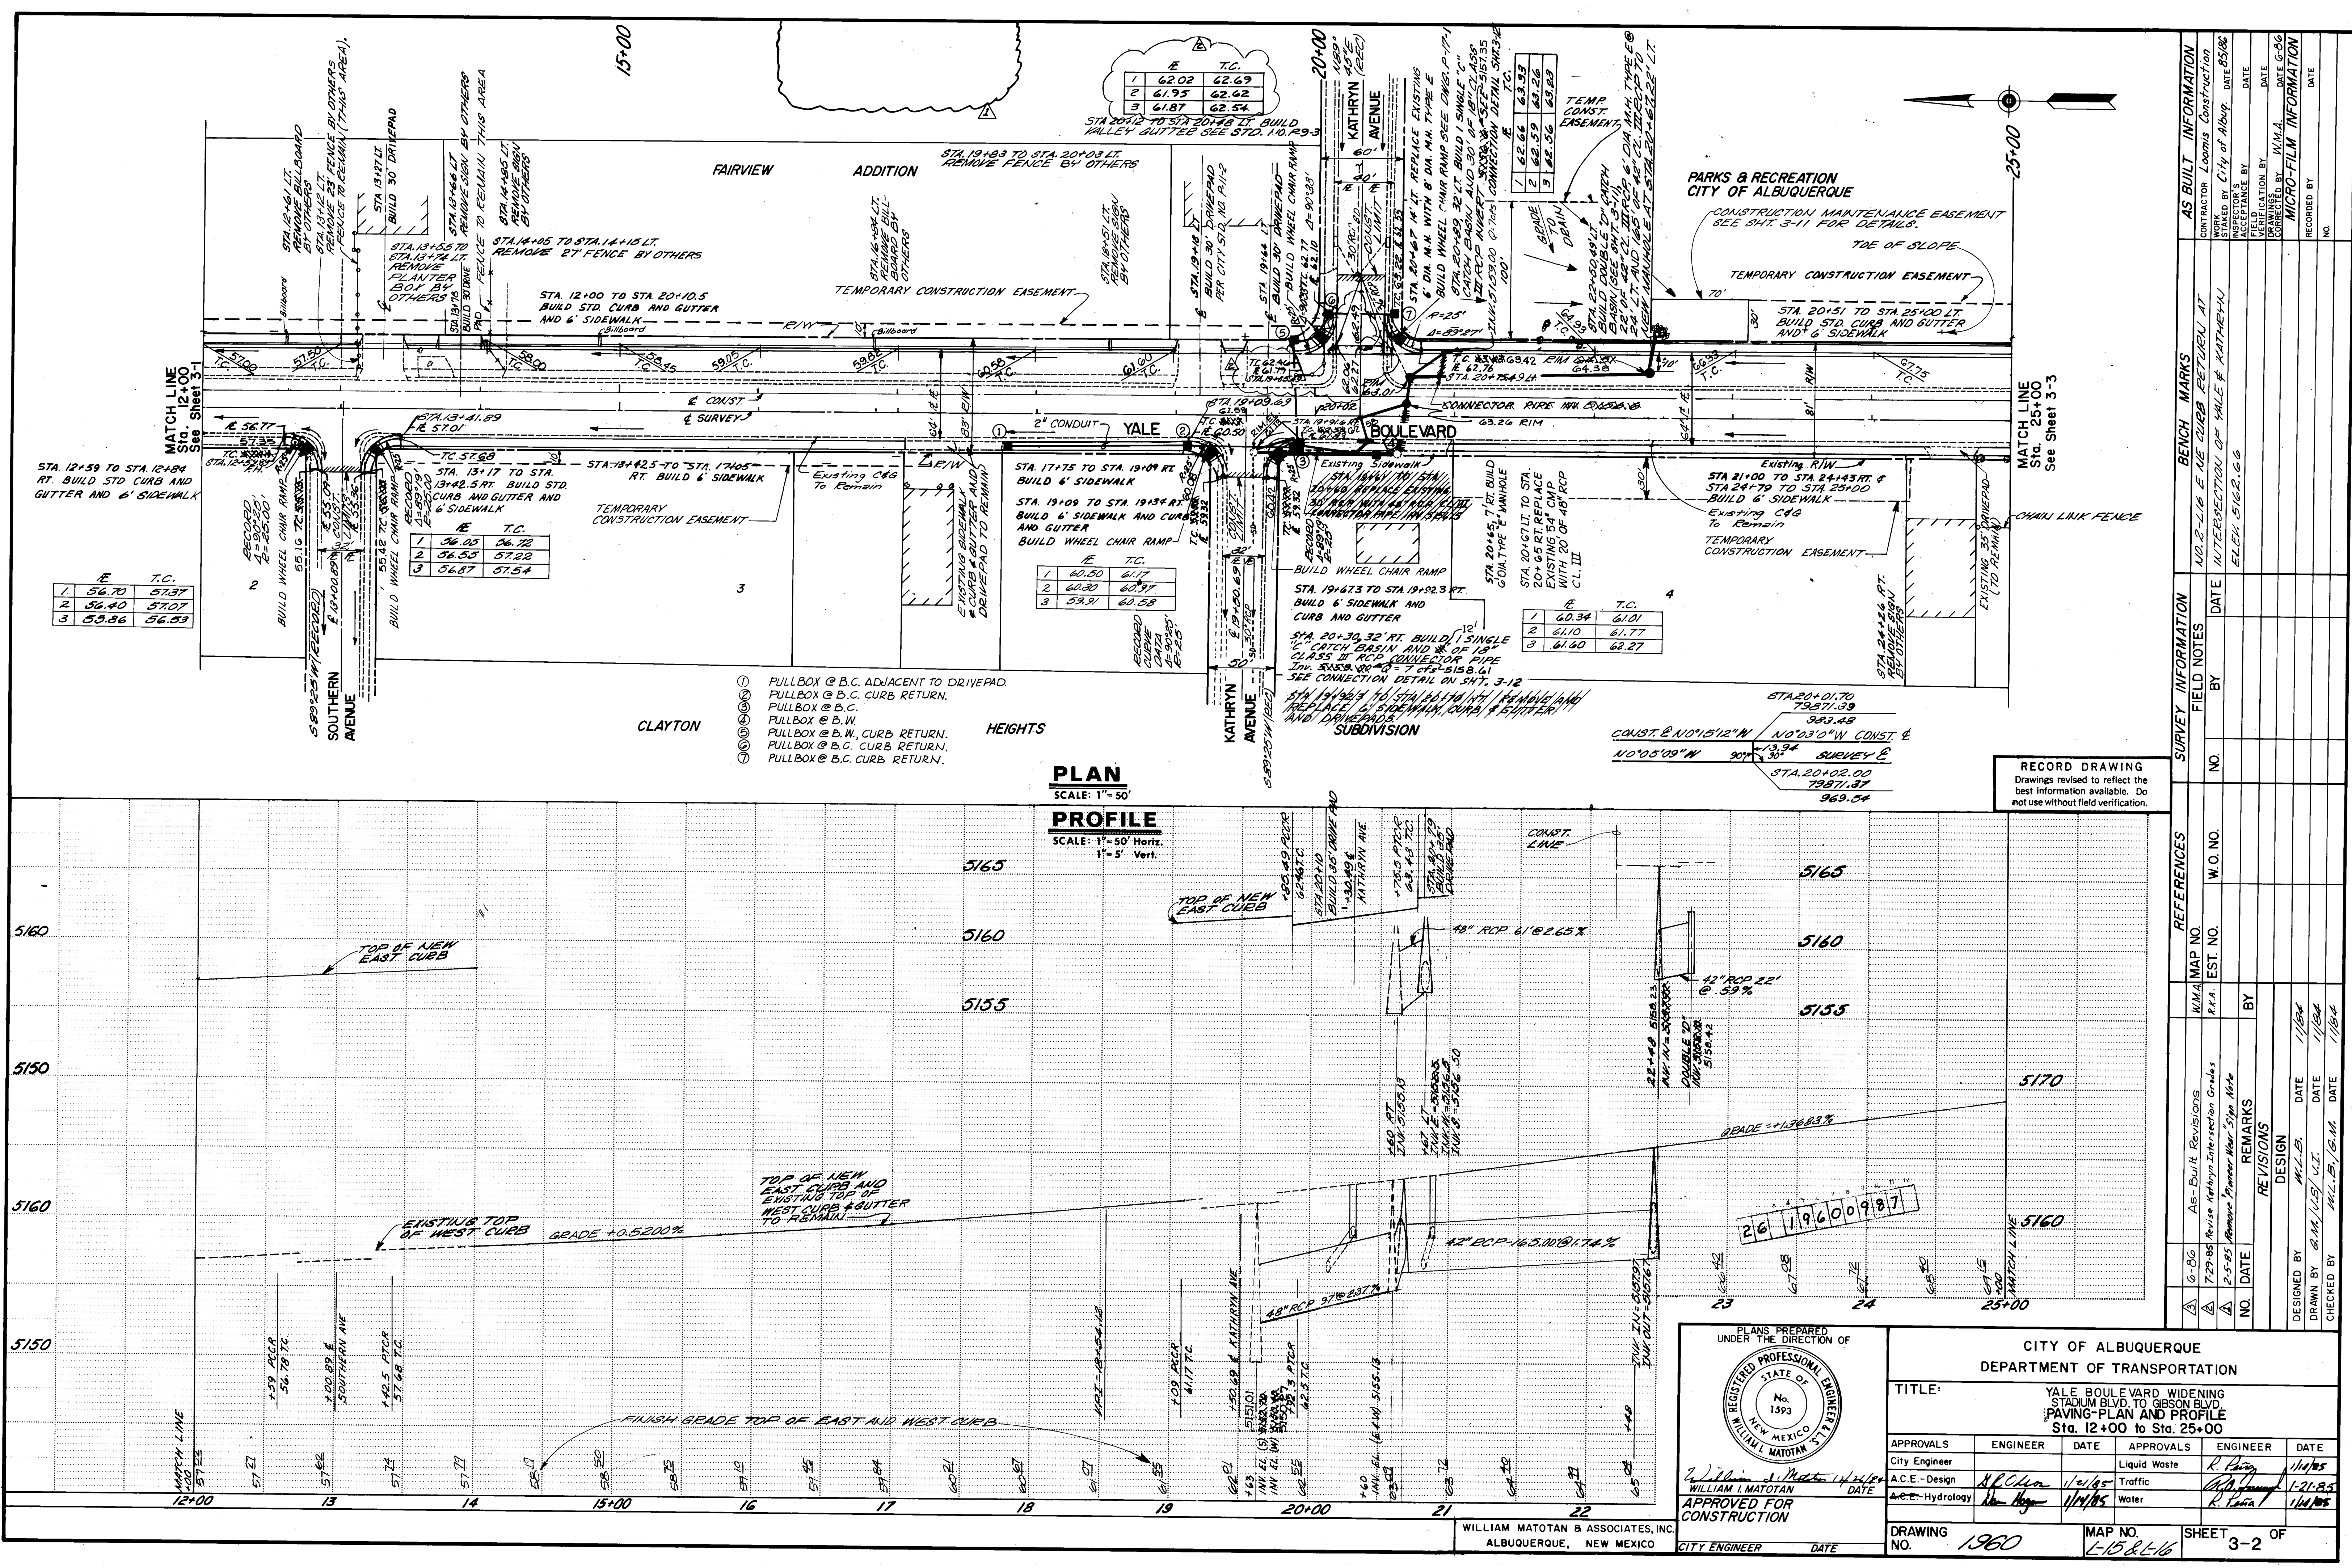

0726009

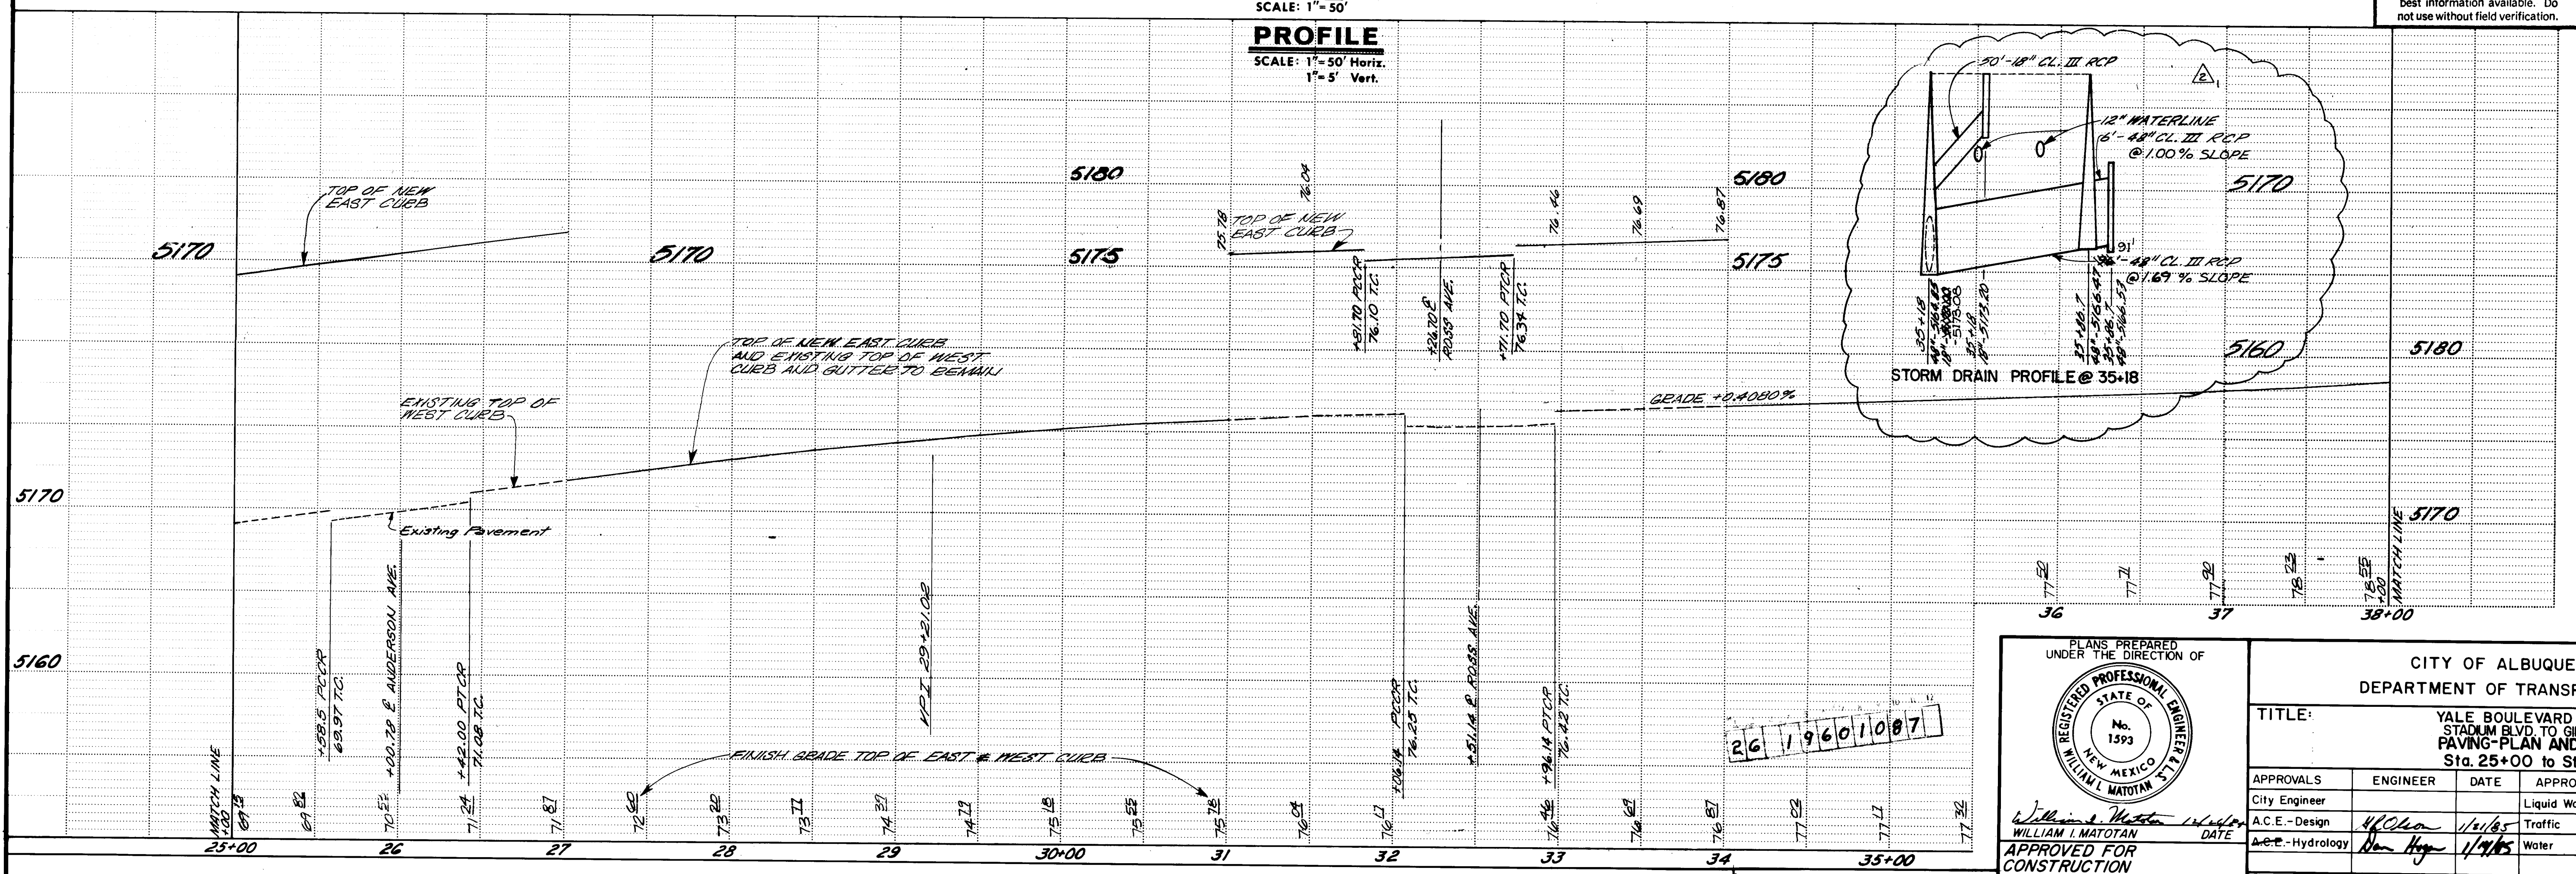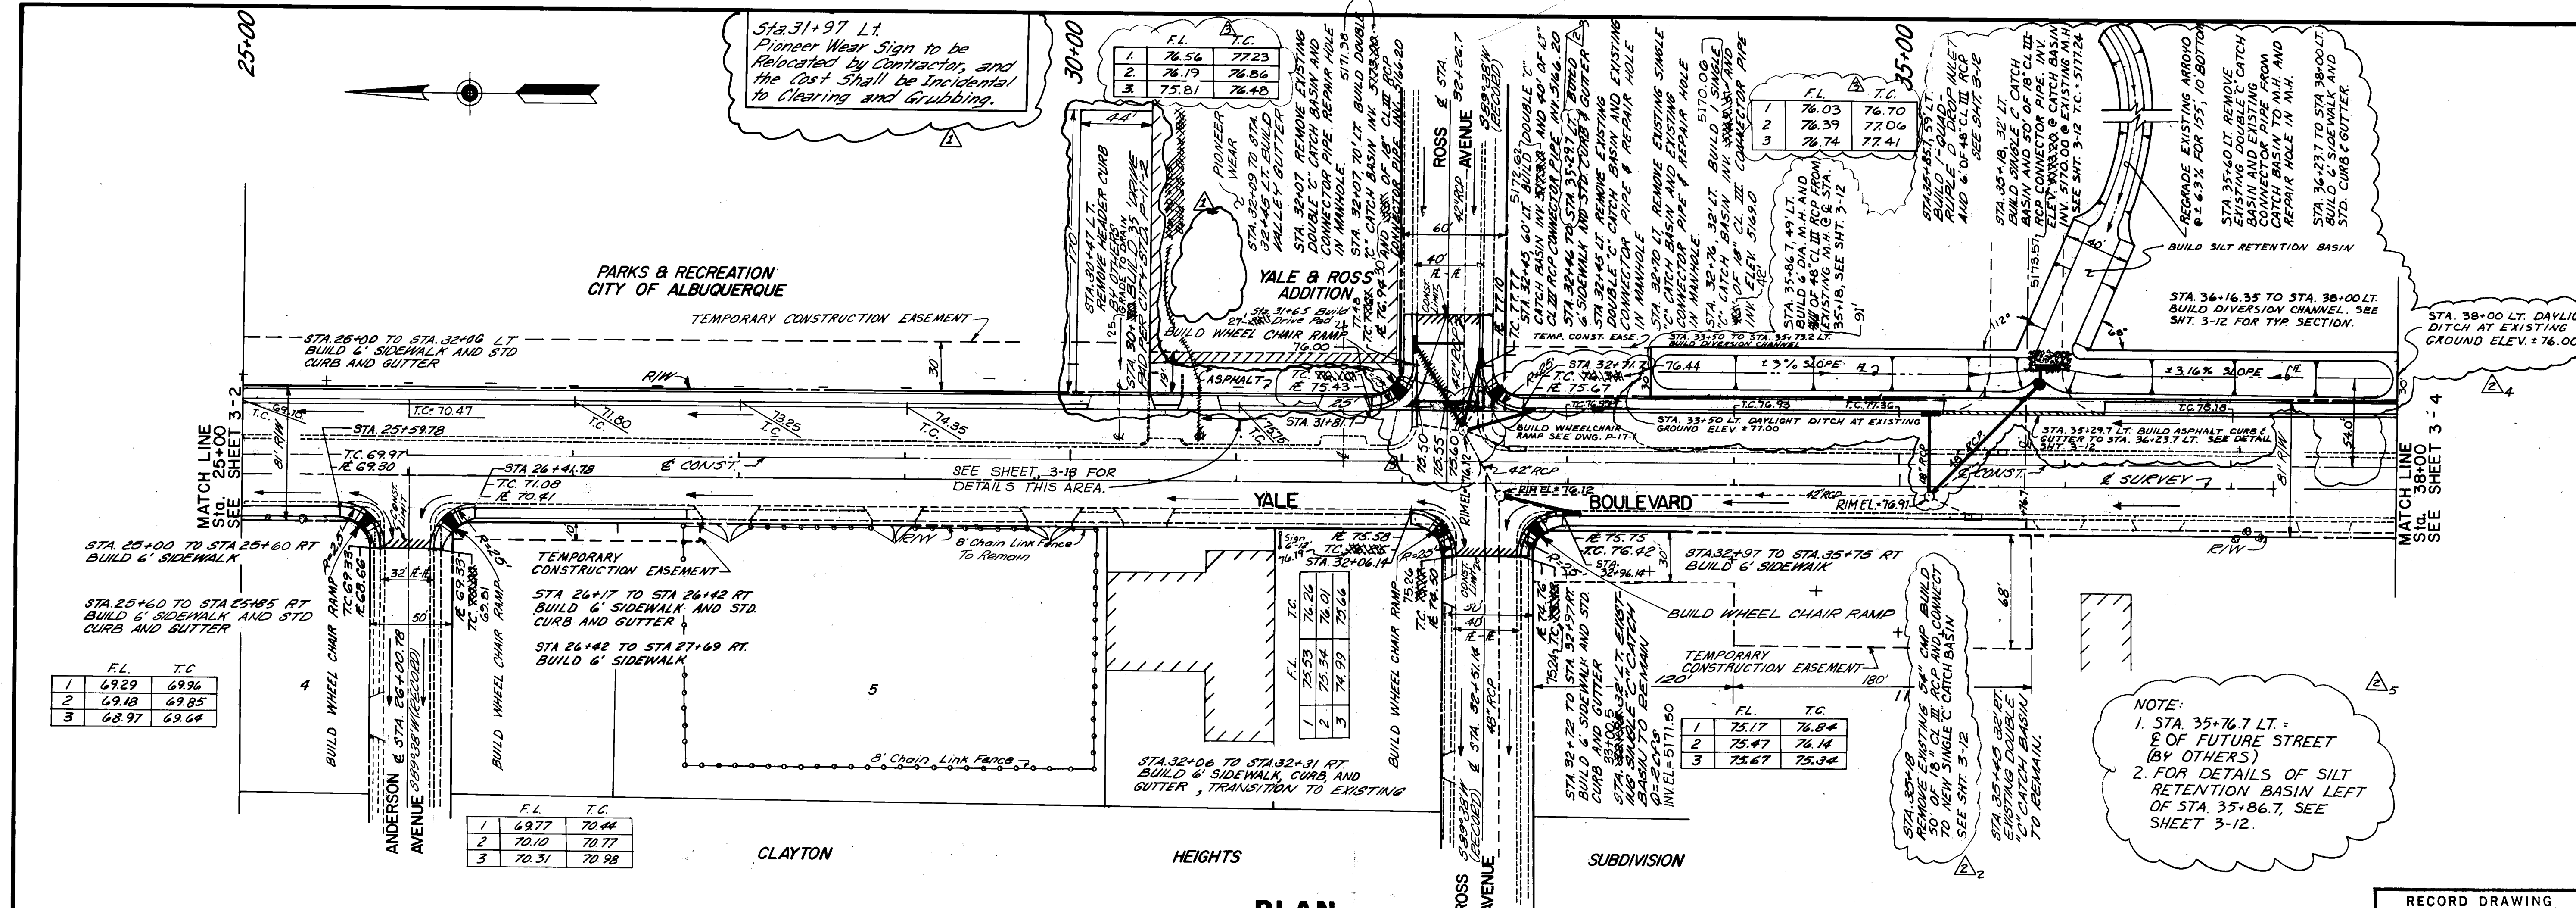

AS BUILT INFORMATION			
CONTRACTOR	Loonis Construction	DATE	8/5/82
STATIONED BY	City of Albuquerque	DATE	
INSPECTOR'S		DATE	
FIELD CHANGE BY		DATE	
VERIFICATION BY		DATE	
CORRECTION BY		DATE	
W.M.A.		DATE	
RECORDED BY		DATE	


SURVEY INFORMATION			
FIELD NOTES	DATE	BY	NO.
NO. 1 L-16 LOCATED AT LINE CURB			
RETURN AT INTERSECTION OF			
YALE AND BOULEVARD ELEV. 5176.097			

REFERENCES			
W.M.A.	MAP NO.	EST. NO.	W.O. NO.
10-86	As-Built Revisions		
7-29-85	Revise Ross Intersection Grades		
6-24-85	Revise Storm Sewer Location		
2-5-85	Revise Pioneer Way Sign & Drive Pad Notes		

REVISIONS			
NO.	DATE	BY	REMARKS
1	11/84	DATE	DESIGN
2	11/84	DATE	DESIGN
3	11/84	DATE	DESIGN



CITY OF ALBUQUERQUE DEPARTMENT OF TRANSPORTATION			
TITLE: YALE BOULEVARD WIDENING STADIUM BLVD. TO GIBSON BLVD. PAVING-PLAN AND PROFILE Sta. 25+00 to Sta. 38+00			
APPROVALS	ENGINEER	DATE	APPROVALS
City Engineer			Liquid Waste
A.C.E. - Design	1/1/85	1/1/85	Traffic
A.C.E. - Hydrology	1/1/85	1/1/85	Water
DRAWING NO.	1960	MAP NO.	L-15 & L-16
CITY ENGINEER	DATE	SHEET	3-3 OF

11022011

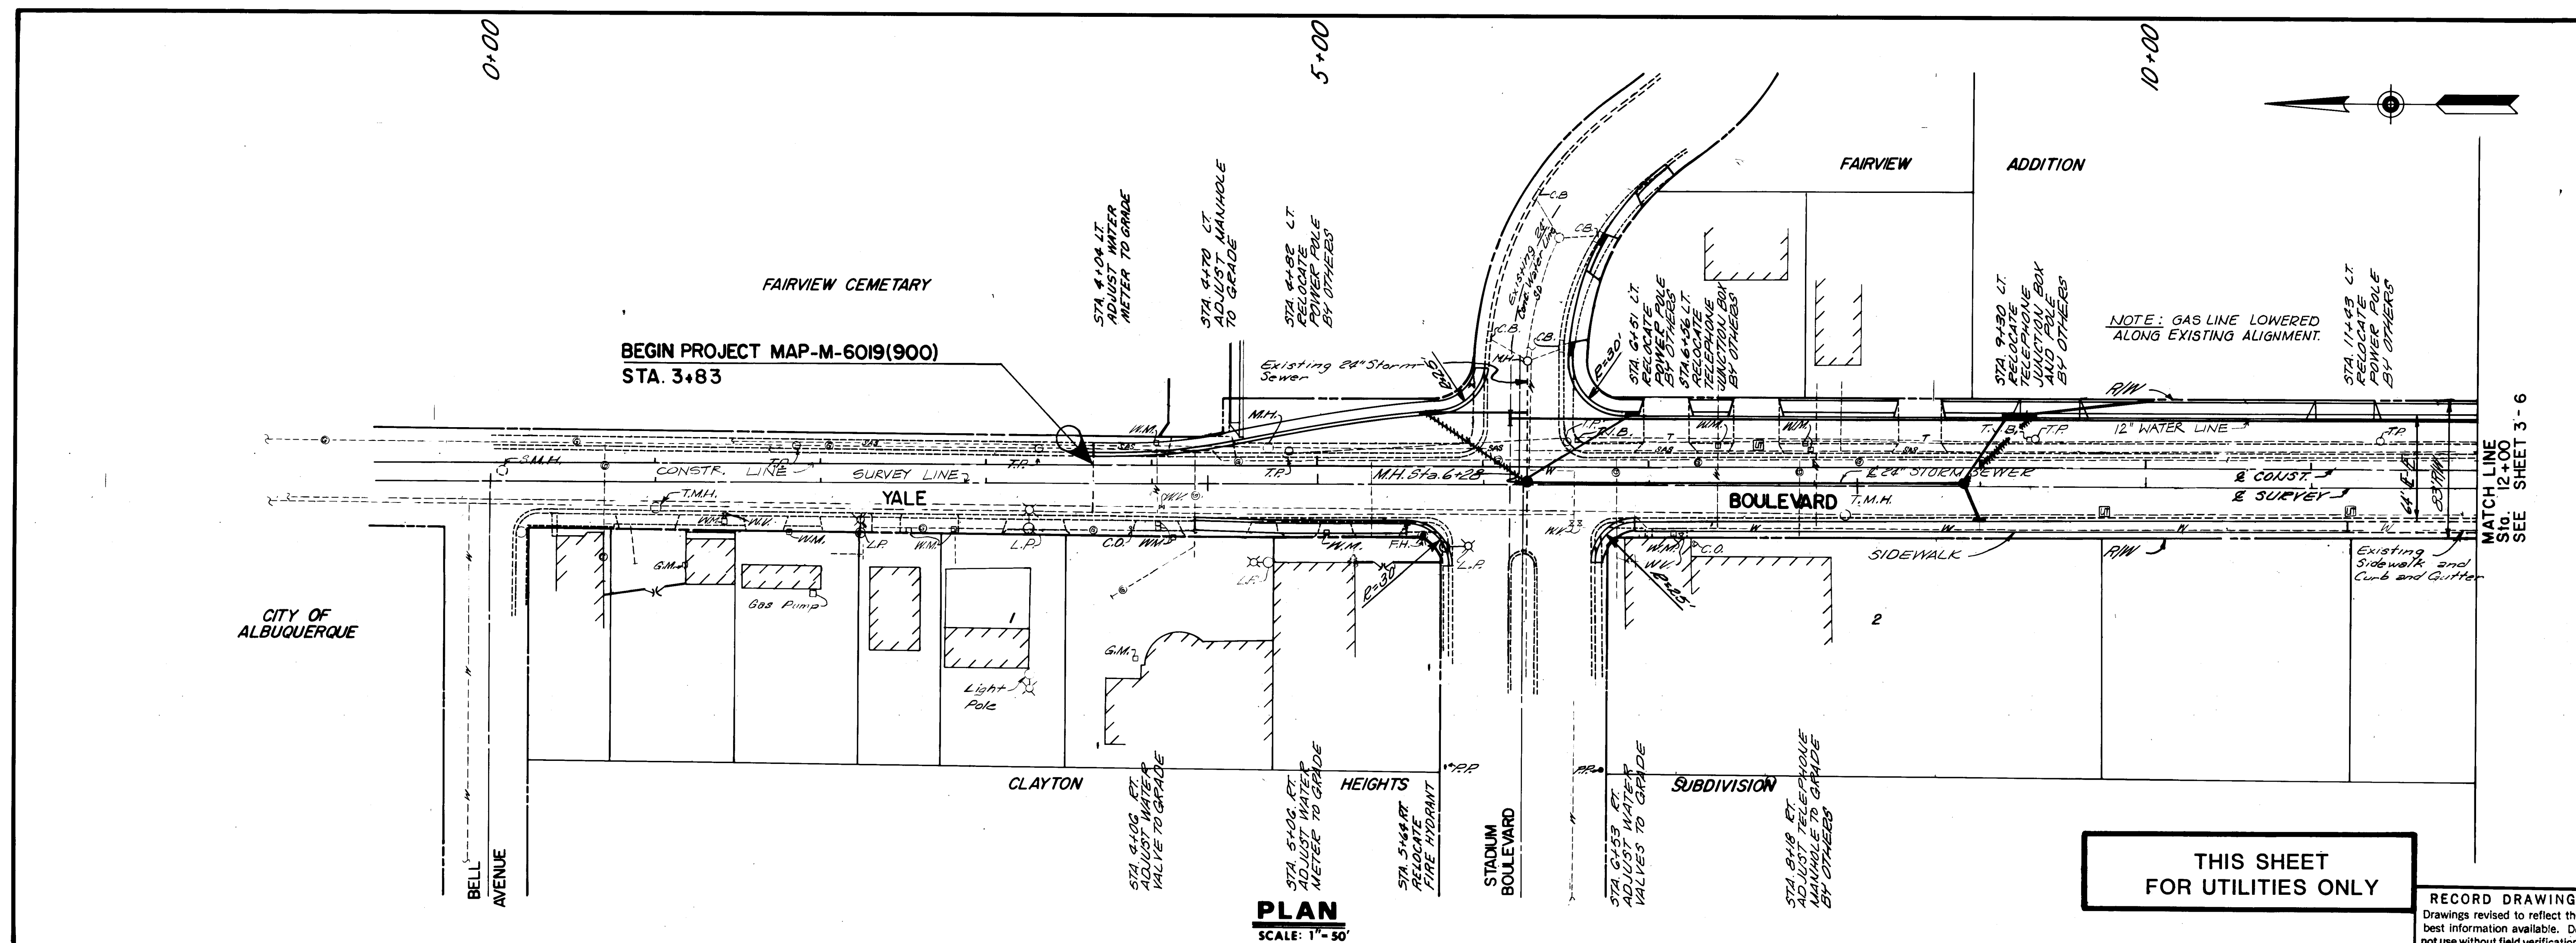


PLAN
SCALE: 1" = 50'

PROFILE
SCALE: 1" = 50' Horiz.
1" = 5' Vert.

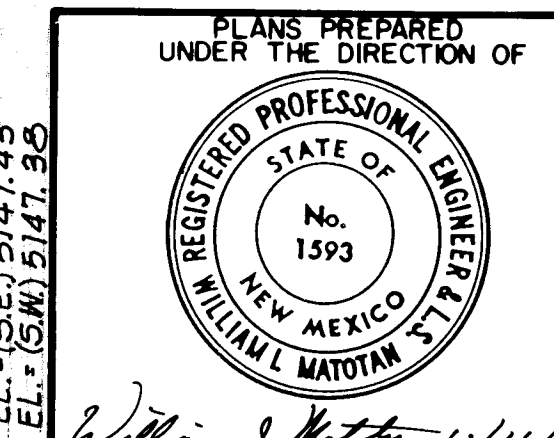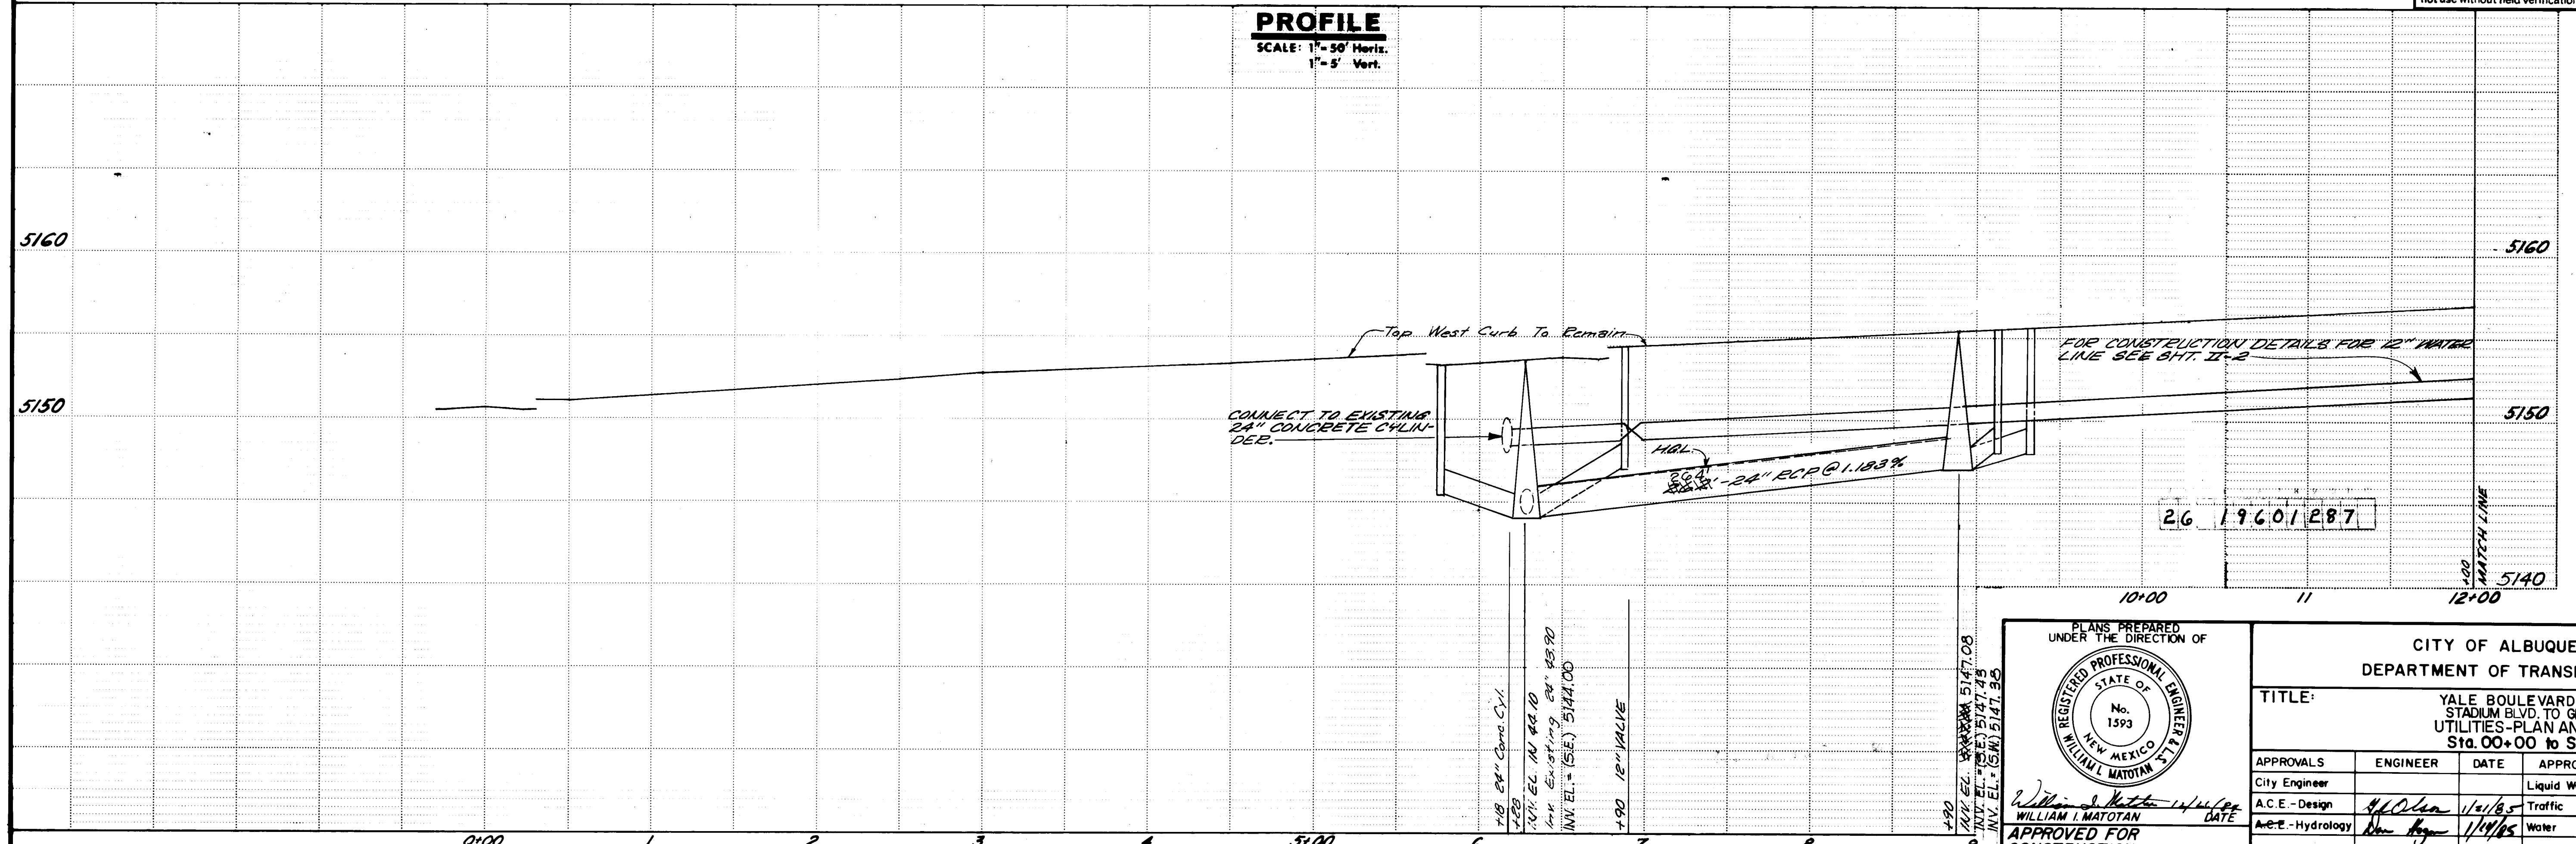


CITY OF ALBUQUERQUE DEPARTMENT OF TRANSPORTATION					
TITLE: YALE BOULEVARD WIDENING STADIUM BLVD. TO GIBSON BLVD. UTILITIES-PLAN AND PROFILE Sta. 0+00 to Sta. 12+00					
APPROVALS	ENGINEER	DATE	APPROVALS	ENGINEER	DATE
City Engineer			Liquid Waste	R. Pina	1/14/85
A.C.E.-Design	W. Matotan	1/14/85	Traffic	N.A. Pina	1-21-85
A.C.E.-Hydrology	W. Matotan	1/14/85	Water	R. Pina	1/14/85
DRAWING NO. 1960		MAP NO. L-1584-16		SHEET 3-5 OF	

REFERENCES		SURVEY INFORMATION		BENCH MARKS		AS BUILT INFORMATION	
MAP NO.	EST. NO.	W.O. NO.	NO.	BY	DATE	CONTRACTOR	LOANS CONSTRUCTION
						WORK STATED BY	CITY OF ALBUQ. DATE 8/5/86
						APPROVED BY	DATE
						FIELD VERIFICATION BY	DATE
						REVISIONS	DATE
						DESIGN	DATE
						DRAWN BY	DATE
						CHECKED BY	DATE

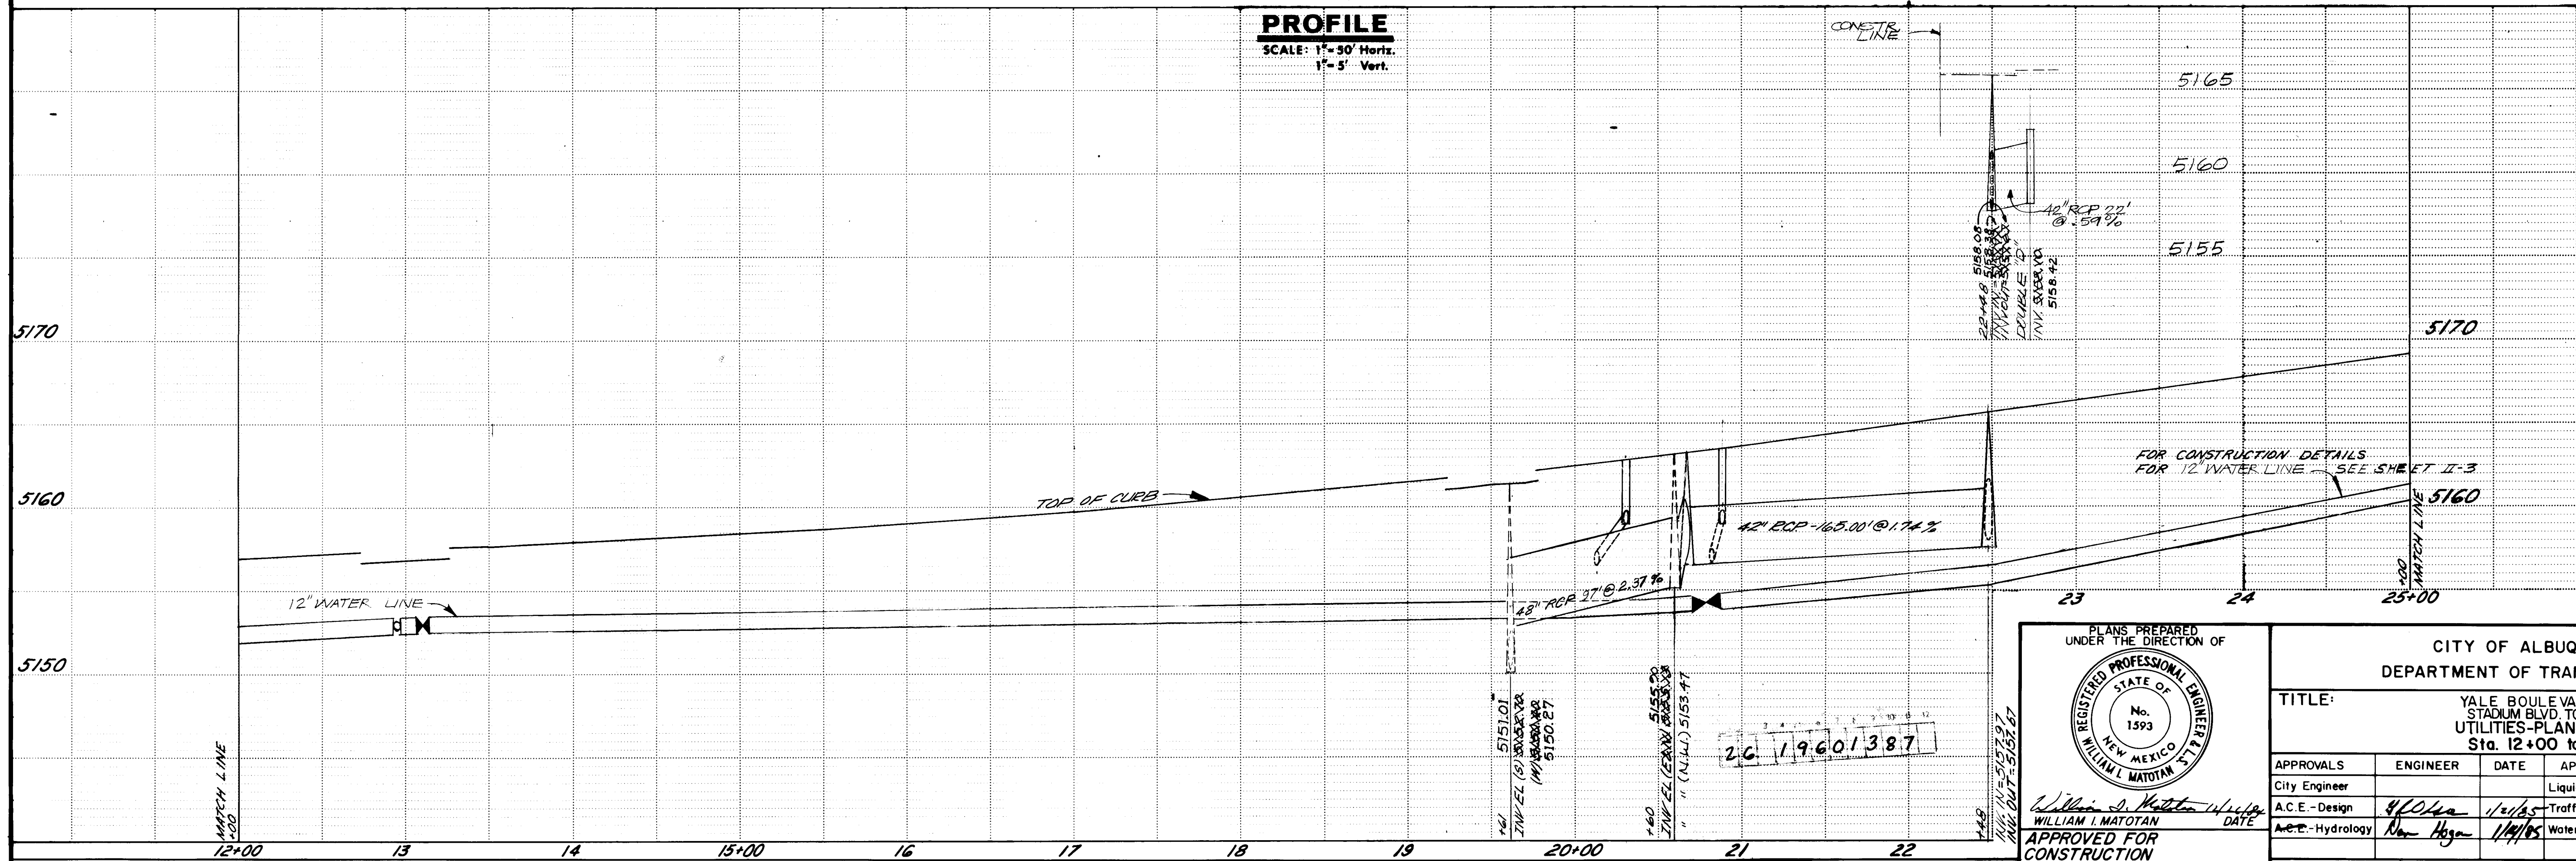

SURVEY INFORMATION										BENCH MARKS		AS BUILT INFORMATION	
REFERENCES		FIELD NOTES		NO.		BY		DATE		CONTRACTOR		LOANIS CONSTRUCTION	
MAP NO.		W.O. NO.		EST. NO.		N/A		DATE		WORK STATED BY		CITY OF HIBBING	
NO.		DATE		REMARKS		BY		DATE		INSPECTOR'S FIELD EXAMINE BY		DATE	
NO.		DATE		REVISIONS		BY		DATE		FIELD VERIFICATION BY		DATE	
DESIGNED BY		DATE		DRAWN BY		DATE		CHECKED BY		DATE		MICRO-FILM INFORMATION	
M.L.B.		1/18/4		M.L.B.		1/18/4		M.L.B.		1/18/4		M.L.B.	
G.M./L.L.T.		1/18/4		G.M./L.L.T.		1/18/4		G.M./L.L.T.		1/18/4		G.M./L.L.T.	
M.L.B./G.M.		1/18/4		M.L.B./G.M.		1/18/4		M.L.B./G.M.		1/18/4		M.L.B./G.M.	


0726013

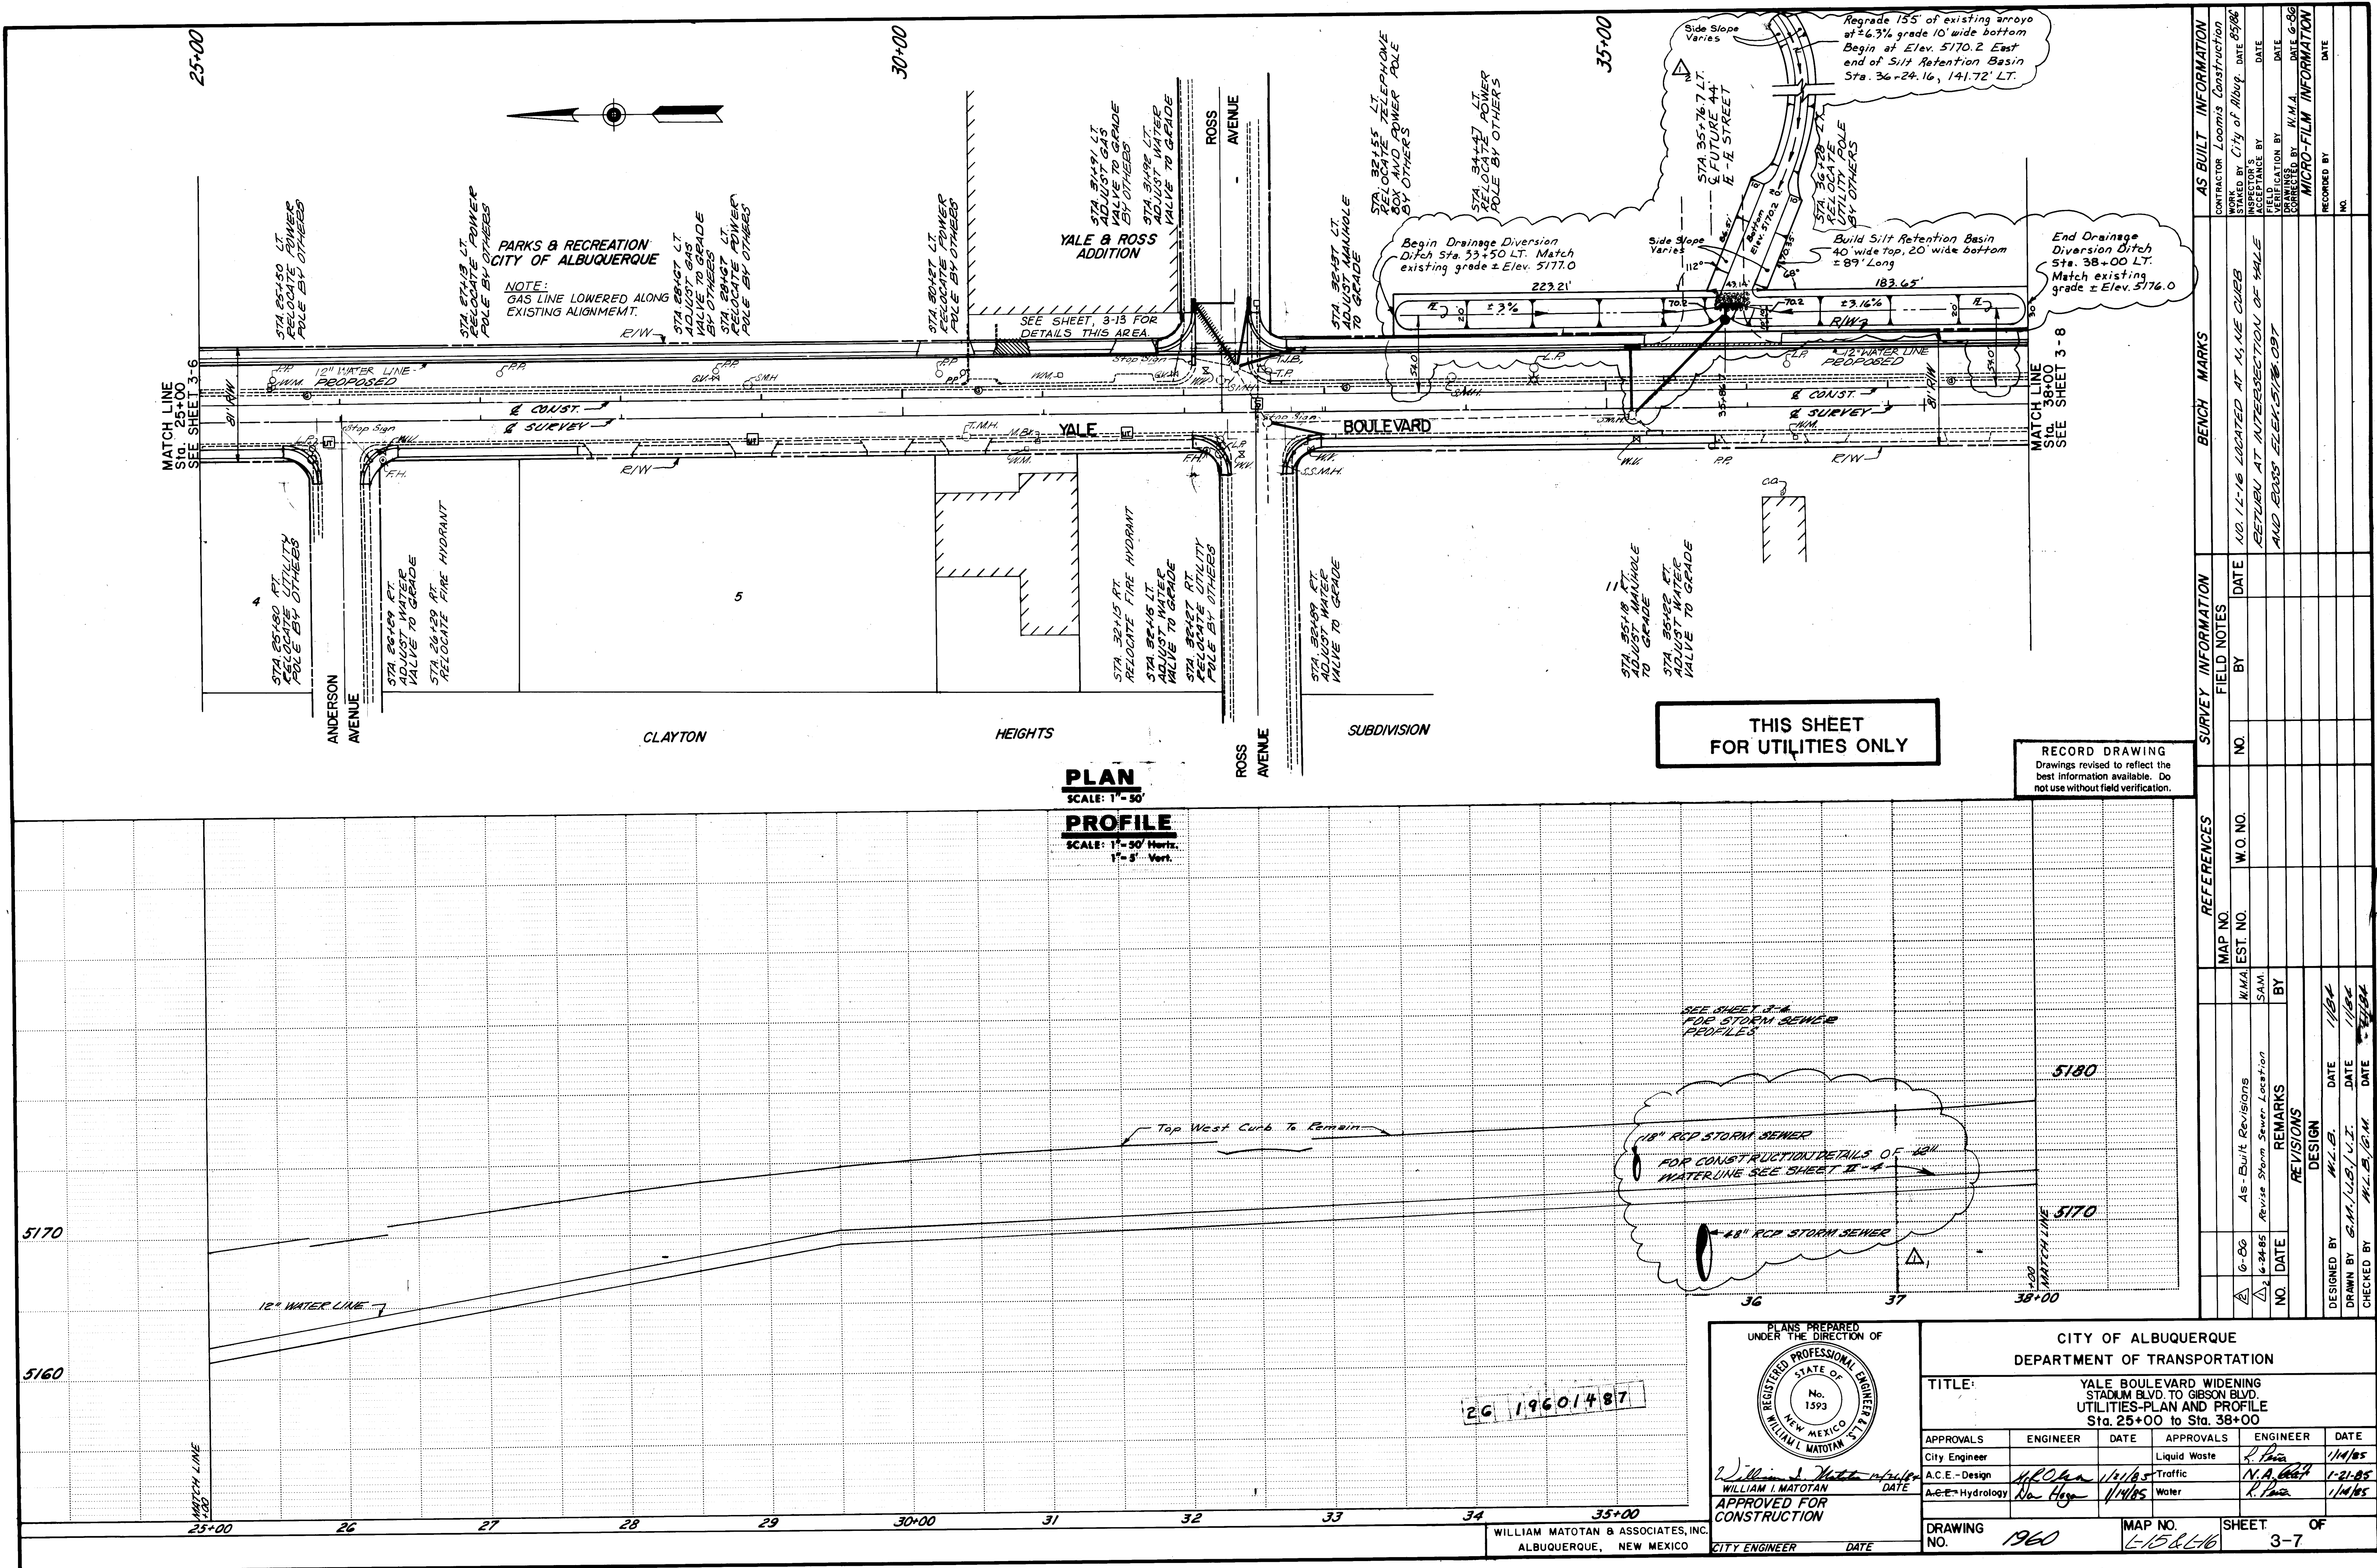

AS BUILT INFORMATION										BENCH MARKS		SURVEY INFORMATION				REFERENCES				FIELD NOTES			
CONTRACTOR Loomis Construction																							
WORKED BY City of Albuquerque																							
INSPECTOR'S ACCEPTANCE BY																							
DATE																							
DATE																							
RECORD DRAWING
Drawings revised to reflect the best information available. Do not use without field verification.

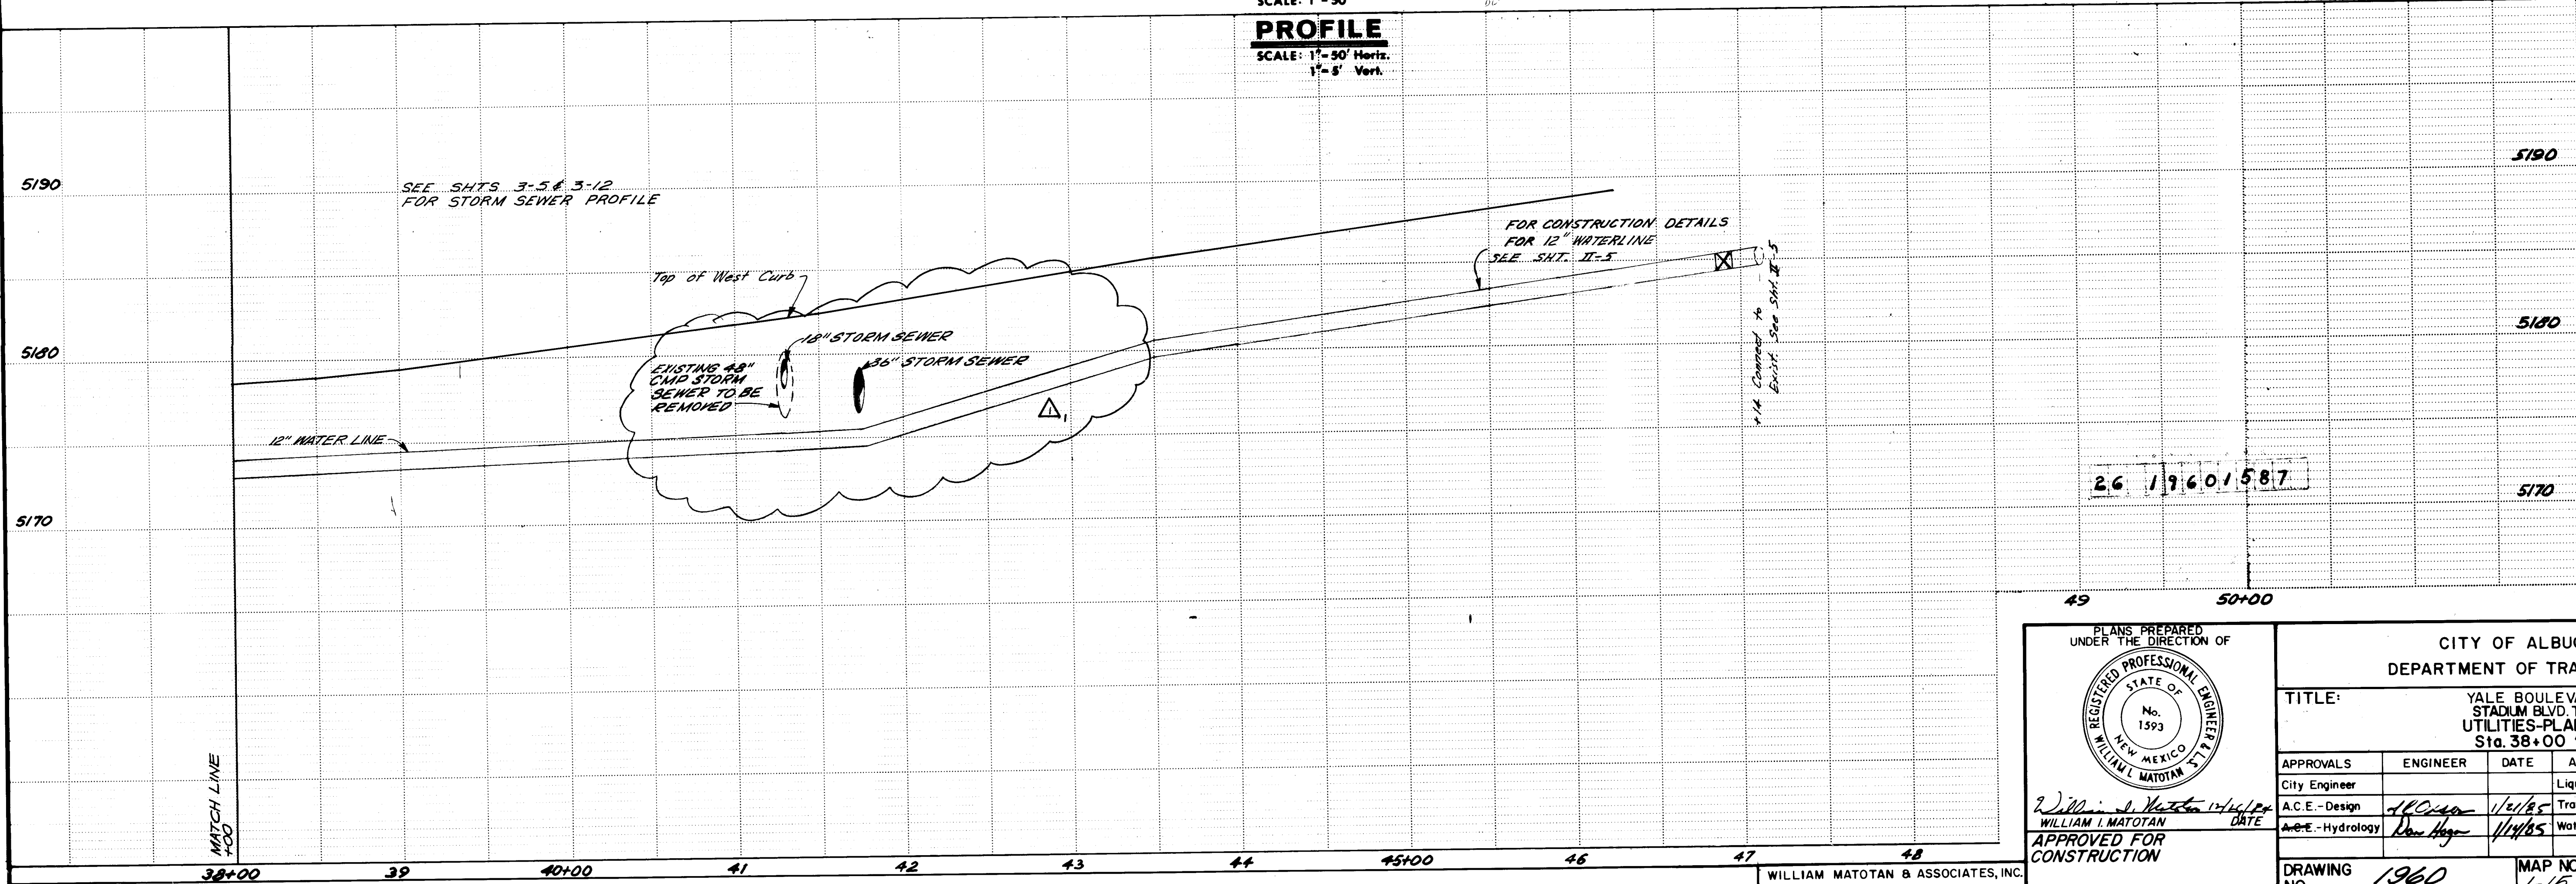

PLANS PREPARED UNDER THE DIRECTION OF  <i>William I. Matotian</i> WILLIAM I. MATOTIAN DATE <i>12/10/85</i> APPROVED FOR CONSTRUCTION	CITY OF ALBUQUERQUE DEPARTMENT OF TRANSPORTATION TITLE: YALE BOULEVARD WIDENING STADIUM BLVD. TO GIBSON BLVD. UTILITIES-PLAN AND PROFILE Sta. 38+00 to Sta. 50+00 <table border="1" style="width: 100%; border-collapse: collapse;"> <tr> <th>APPROVALS</th> <th>ENGINEER</th> <th>DATE</th> <th>APPROVALS</th> <th>ENGINEER</th> <th>DATE</th> </tr> <tr> <td>City Engineer</td> <td></td> <td></td> <td>Liquid Waste</td> <td><i>R. Fain</i></td> <td><i>1/14/85</i></td> </tr> <tr> <td>A.C.E. - Design</td> <td><i>180-040</i></td> <td><i>12/1/85</i></td> <td>Traffic</td> <td><i>N. A. Clark</i></td> <td><i>1-21-85</i></td> </tr> <tr> <td>Arche - Hydrology</td> <td><i>Don Hager</i></td> <td><i>1/14/85</i></td> <td>Water</td> <td><i>R. Fain</i></td> <td><i>1/14/85</i></td> </tr> </table> DRAWING NO. <i>1960</i> MAP NO. <i>L-15 & L-16</i> SHEET <i>3-8</i> OF <i>4</i>	APPROVALS	ENGINEER	DATE	APPROVALS	ENGINEER	DATE	City Engineer			Liquid Waste	<i>R. Fain</i>	<i>1/14/85</i>	A.C.E. - Design	<i>180-040</i>	<i>12/1/85</i>	Traffic	<i>N. A. Clark</i>	<i>1-21-85</i>	Arche - Hydrology	<i>Don Hager</i>	<i>1/14/85</i>	Water	<i>R. Fain</i>	<i>1/14/85</i>
APPROVALS	ENGINEER	DATE	APPROVALS	ENGINEER	DATE																				
City Engineer			Liquid Waste	<i>R. Fain</i>	<i>1/14/85</i>																				
A.C.E. - Design	<i>180-040</i>	<i>12/1/85</i>	Traffic	<i>N. A. Clark</i>	<i>1-21-85</i>																				
Arche - Hydrology	<i>Don Hager</i>	<i>1/14/85</i>	Water	<i>R. Fain</i>	<i>1/14/85</i>																				

27

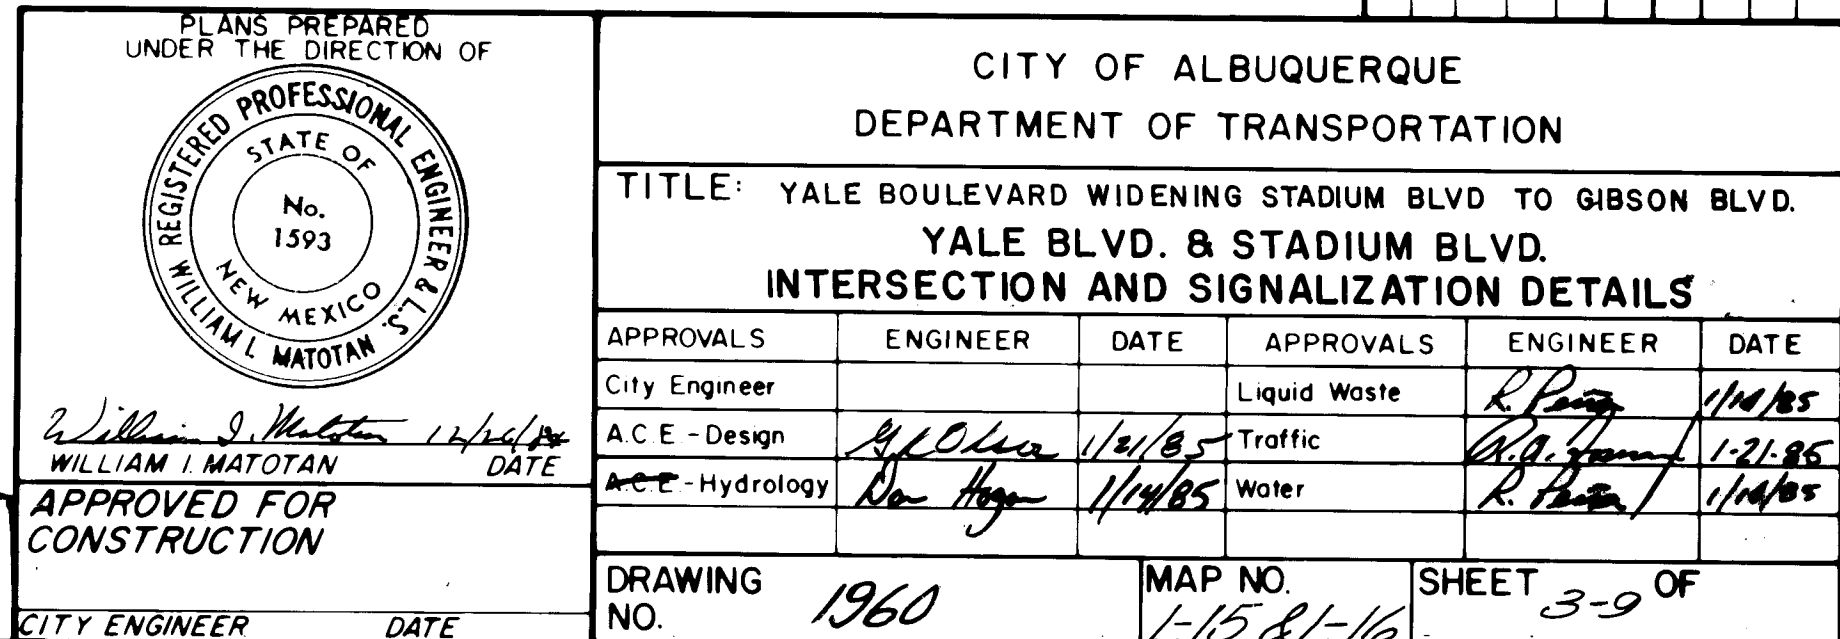


27

SIGN CODE	N° OF SIGNS	TOTAL SIGN AREA SQ. FT.	POST LENGTHS				MOUNTING REQUIREMENTS						BASE-POSTS		
			LEFT	CTR.	RIGHT	TOTAL	FLANGED CHANNEL			DRIVEDOWN POSTS 0.1345 THICK		PORTABLE SIGN SUPPORT	N°	TOTAL LENGTH	
							2.25 Lb/Ft	3.00 Lb/Ft	4.00 Lb/Ft	2 3/16" x 2 3/16"	2 1/2" x 2 1/2"				
						PHASE III									
R3-2	(4)	(16)										(4)			
R3-7	(1)	(6.25)										(1)			
R3-7	1	6.25										(1)			
R4-7a	10	120										(10)			
W1-4L	5	(80)	//		//	(110)	✓			✓			10	35	
W1-4R	(2)	(32)	//		//	(44)	✓			✓			4	14	
W4-2L	(2)	(32)	//		//	(44)	✓			✓			4	14	
W4-2R	(1) & 4	(16) & 64	//		//	(88)	✓			✓			8	35	
W6-3	(6)	(96)	//		//	(132)	✓			✓			12	12	
W20-1	(7) & 1	(112) & 16	//		//	(176)	✓			✓			14	56	
W20-5L	(2)	(32)	//		//	(44)	✓			✓			4	14	
W20-5R	(3)	(48)	//		//	(66)	✓			✓			6	21	
W1-6L	(6)	(48)													
R11-2	(3)	(30)													
		-206.25-				-0-						-0-	-62-	-201-	
						PHASE IV									
R3-2	(2)	(8)										(2)			
R3-7	(1)	(6.25)										(1)			
R4-7a	(11)	(132)										(11)			
R4-7a	2	24										(2)			
W4-2L	(3)	(48)	//		//	(66)	✓			✓			6	21	
W6-3	(8) & 2	(128) & 32	//		//	(220)	✓			✓			22	77	
W20-1	(3)	(48)	//		//	(66)	✓			✓			6	21	
W20-5L	(3)	(48)	//		//	(66)	✓			✓			6	21	
R11-2	(2) & 4	(120) & 40													
		-96-				-0-						-0-	-40-	-140-	
						PHASE IV-A									
M4-9L	3	36		9		(27)	✓			✓			3	10.5	
R3-1	1	4										(1)			
R3-2	(1)	(4)										(1)			
R3-7	(2)	(12.5)	//		//	(44)	✓			✓		(1)	2	7	
R3-7	1	6.25										(1)			
R4-7a	(11)	(121)										(11)			
W4-2L	(3)	(80)	//		//	(110)	✓			✓		(2)	6	21	
W6-3	(8)	(128)	//		//	(176)	✓			✓			16	56	
W6-3	2	32	//		//	(44)	✓			✓			4	14	
W20-1	6	96	//		//	(132)	✓			✓			12	42	
W20-3	3	48	//		//	(66)	✓			✓			6	21	
W20-5L	(4)	(64)	//		//	(88)	✓			✓			8	28	
W20-5L	1	16	//		//	(22)	✓			✓			2	7	
W20-5C	2	32	//		//	(44)	✓			✓			4	14	
M4-9R	1	12	//		//	(6) & 6	✓			✓			2	7	
G20-5	2	30	//		//	44	✓			✓			4	14	
R11-2	(13)	(130)													
R11-4	(1)	(12.5)													
M4-10R	6	66													
		-378.25-				-50-						-0-	-69-	-241.5-	

- ▲ Mount On Special Portable Support - See Sheet __-__ For Details.
 () Sign(s) And Or Support(s) Used In Other Construction Phase(s). No Additional Payment Therefore.
 * No Additional Post Needed Sign To Be Mounted On Common Post With Another Sign
 ● Mount Back-To-Back

SUMMARY OF QUANTITIES.

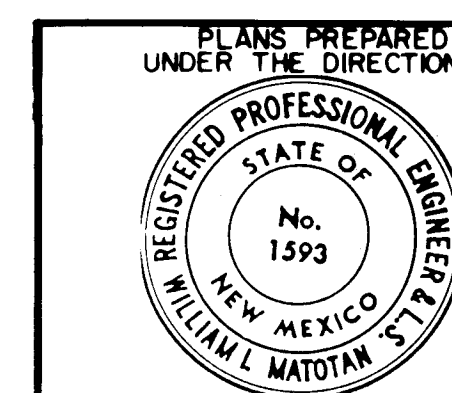[illegible][illegible]

WILLIAM I. MATOTAN 14/26/87
DATE
APPROVED FOR
CONSTRUCTION
CITY ENGINEER DATE

CITY OF ALBUQUERQUE
DEPARTMENT OF TRANSPORTATION

TITLE:	YALE BOULEVARD WIDENING STADIUM BLVD. TO GIBSON BLVD. TRAFFIC CONTROL - SUMMARY OF QUANTITIES
--------	---

APPROVALS	ENGINEER	DATE	APPROVALS	ENGINEER	DATE
City Engineer			Liquid Waste	R. Poirer	1/14/85
A.C.E. - Design	M. L. Loran	1/20/85	Traffic	A. J. Loran	1-21-85
A.C.E. - Hydrology	Don Hosa	1/14/85	Water	R. Poirer	1/14/85

DRAWING NO.	1960	MAP NO.	L-15 & L-16	SHEET	4-12	OF	
-------------	------	---------	-------------	-------	------	----	--

RECORD DRAWING
Drawings revised to reflect the
best information available. Do
not use without field verification

DESIGNED BY


[illegible]

- ▲ Mount On Special Portable Support - See Sheet ____ For Details.
() Sign(s) And Or Support(s) Used In Other Construction Phase(s). No Additional Payment Therefore.
★ No Additional Post Needed Sign To Be Mounted On Common Post With Another Sign
● Mount Back-To-Back

SUMMARY OF QUANTITIES.

[illegible]

				REFERENCES		SURVEY INFORMATION		BENCH MARKS		AS BUILT INFORMATION		
		MAP NO.	FIELD NOTES									
		EST. NO.	NO.	BY	DATE							
Δ	G-86	As-Built Revisions	N/A									
NO.	DATE	REMARKS	BY									
REVISIONS												
DESIGN												
DESIGNED BY WLB												
DATE 11-84												
DRAWN BY GMI/JS/JZ												
DATE 11-84												
CHECKED BY WLB/GM												
DATE 11-84												
CONTRACTOR Loomis Construction												
STATED BY City of Alhambra DATE 8-5-86												
INSPECTOR'S ACCEPTANCE BY DATE												
VERIFICATION BY DATE												
DRAWN BY W.M.A. DATE 6-86												
MICRO-FILM INFORMATION												
RECORDED BY DATE												
NO.												

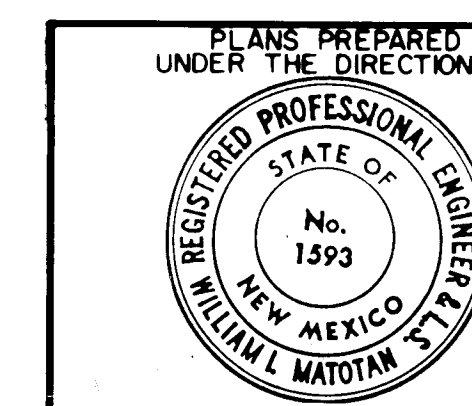

RECORD DRAWING
Drawings revised to reflect the
best information available. Do
not use without field verification

WILLIAM I. MATOTAN 12/26/81
DATE
APPROVED FOR
CONSTRUCTION

CITY ENGINEER	DATE
---------------	------

CITY OF ALBUQUERQUE
DEPARTMENT OF TRANSPORTATION

TITLE: YALE BOULEVARD WIDENING
STADIUM BLVD. TO GIBSON BLVD.
TRAFFIC CONTROL - SUMMARY OF QUANTITIES

APPROVALS	ENGINEER	DATE	APPROVALS	ENGINEER	DATE
City Engineer			Liquid Waste	R. Pagan	1/14/85
A.C.E. - Design	G. L. Lea	1/14/85	Traffic	R. P. Pagan	1-21-85
A.E.E. - Hydrology	Don Hagan	1/14/85	Water	R. Pagan	1/14/85

DRAWING NO.	1960	MAP NO.	L-15 & L-16	SHEET	4-13	OF	
-------------	------	---------	-------------	-------	------	----	--

CHART TO DETERMINE POST SIZE

		H in feet										
SIGN AREA PER POST	H	5	6	7	8	9	10	11	12	13	14	15
		4.9	3.5	3.0	2.7	2.4	2.2	2.0	1.9	1.7		
2' x 2' 1/2"	1	7.5	6.2	5.3	4.7	4.1	3.7	3.4	3.1	2.9	2.7	
	2	10.5	8.8	7.5	6.6	5.8	5.3	4.8	4.4	4.0	3.8	
2' x 3' 1/2"	1	14.0	11.7	10.0	8.8	7.7	7.1	6.4	5.9	5.3	5.1	
	2	16.7	13.9	11.9	10.4	9.3	8.3	7.6	7.0	6.4	6.0	5.2
2' x 4' 1/2"	1	22.2	18.5	15.8	13.8	12.3	11.1	10.1	9.2	8.5	7.9	7.4
	2											

EXAMPLE:


DESIGNER SIZE AND NUMBER OF POSTS TO USE WITH SIGN 4'x4' AREA = 16'²
 SIGN HEIGHT FROM ROADWAY CROSS SECTION IN CONJUNCTION WITH SIGN SIZE
 SIGN HEIGHT (H) FROM THE GROUND ELEVATION AT THE BASE OF THE LONGEST POST TO
 CENTER OF SIGN.

SOLUTION:

ROADWAY CROSS SECTION, CLEARANCE TO BOTTOM OF SIGN = 9' 6"
 SIGN HEIGHT = 2' 6" $H = 12'$

POST HEIGHT NEEDED FOR 16'² WOULD BE 11.5 SAY 12'
 SIGN AREA PER POST = 16' / 12' = 1.33 PER POST

INTERPOLATE AT TOP WHERE H=12' PROCEED DOWNWARD TO AN AREA EQUAL TO OR GREATER
 THAN 1.33 PER POST THEN PROCEED TO THE LEFT TO FIND THE REQUIRED POST SIZE
 WE FIND TO BE A 2' x 2' 1/2" 10 GA POST
 LENGTH OF THE LONGER POST WILL THEN BE THE 9.5 FROM GROUND LINE TO BOTTOM
 OF THE SIGN HEIGHT (5.0 IN THIS CASE) PLUS THE 1.5' IN THE GROUND FOR A TOTAL
 OF 11.0' THE OTHER POST LENGTH WILL BE 16.0 MINUS THE DIFFERENCE Δ IN THIS CASE
 11.0' = 5.0'

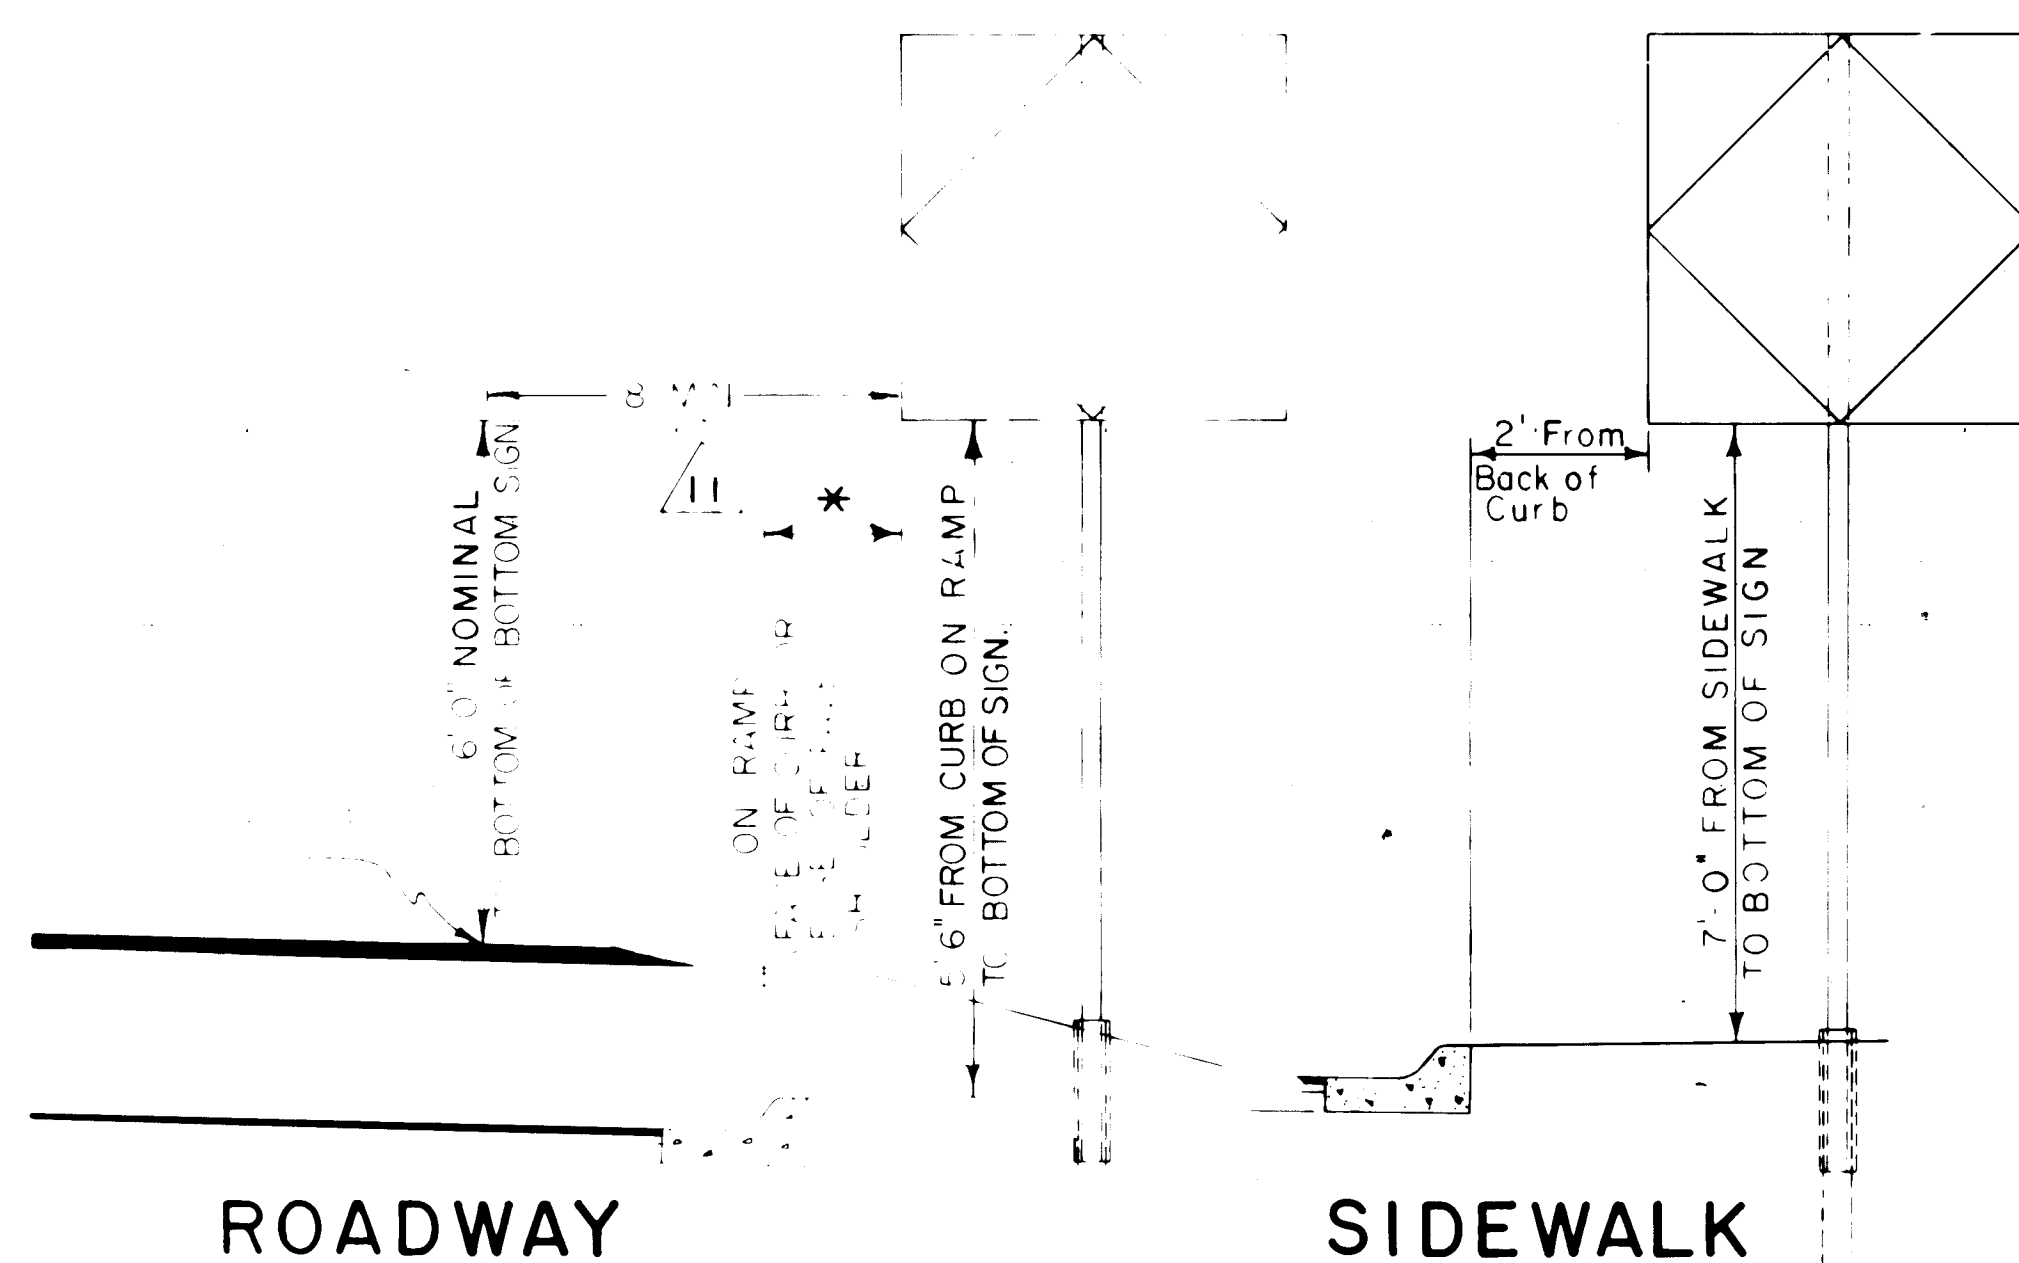


ROADWAY


POST INSTALLATION

* 3' MIN. FROM FACE OF CURB OR

6' MIN. FROM EDGE OF PAVED SHOULDER

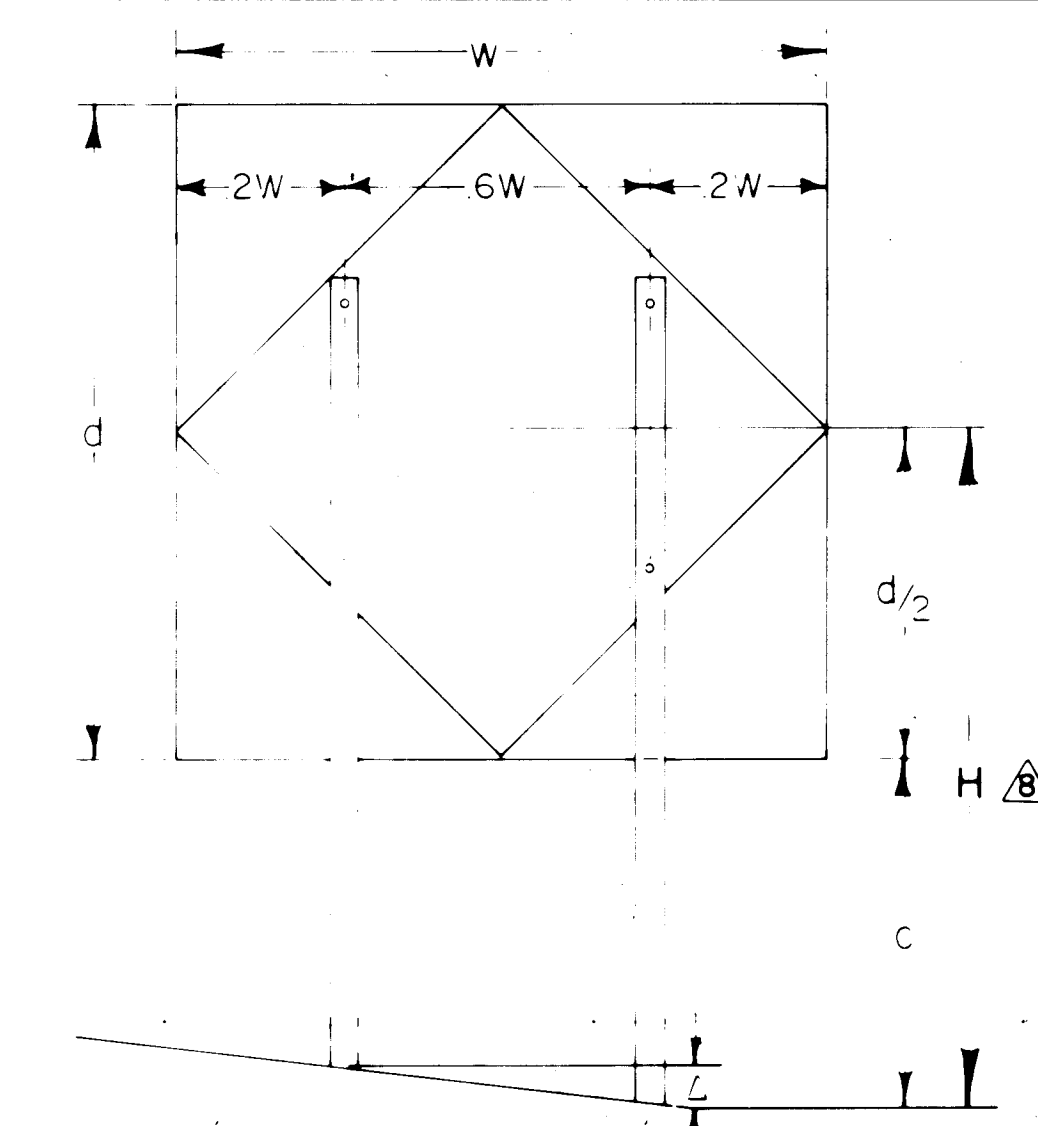


POST SIZE CALCULATION

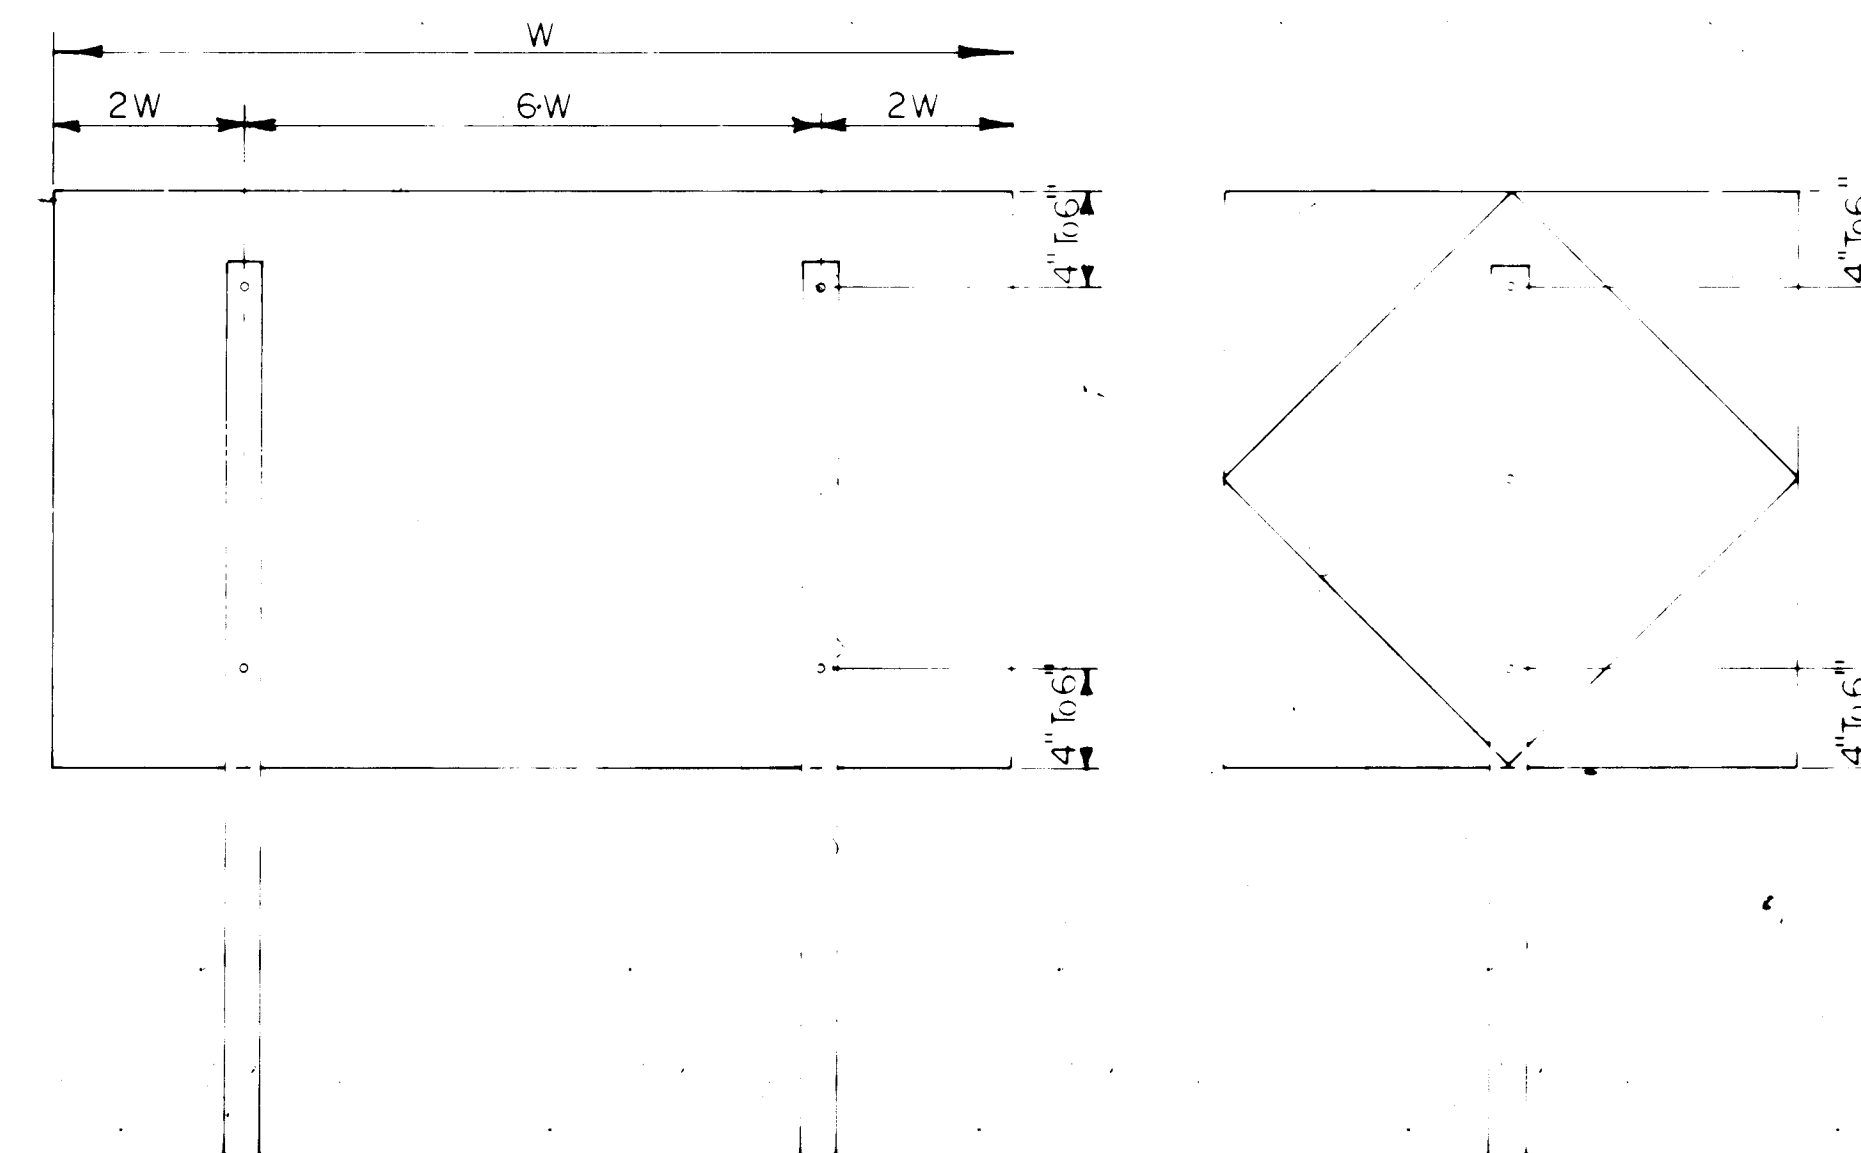

POST SPACING & SIGN MOUNTING

NOTE WHERE 3 POSTS ARE USED SPACING SHOULD BE
 15W - 35W - 35W - 15W


POSTS
 0.1345" THICK (10 GA.)

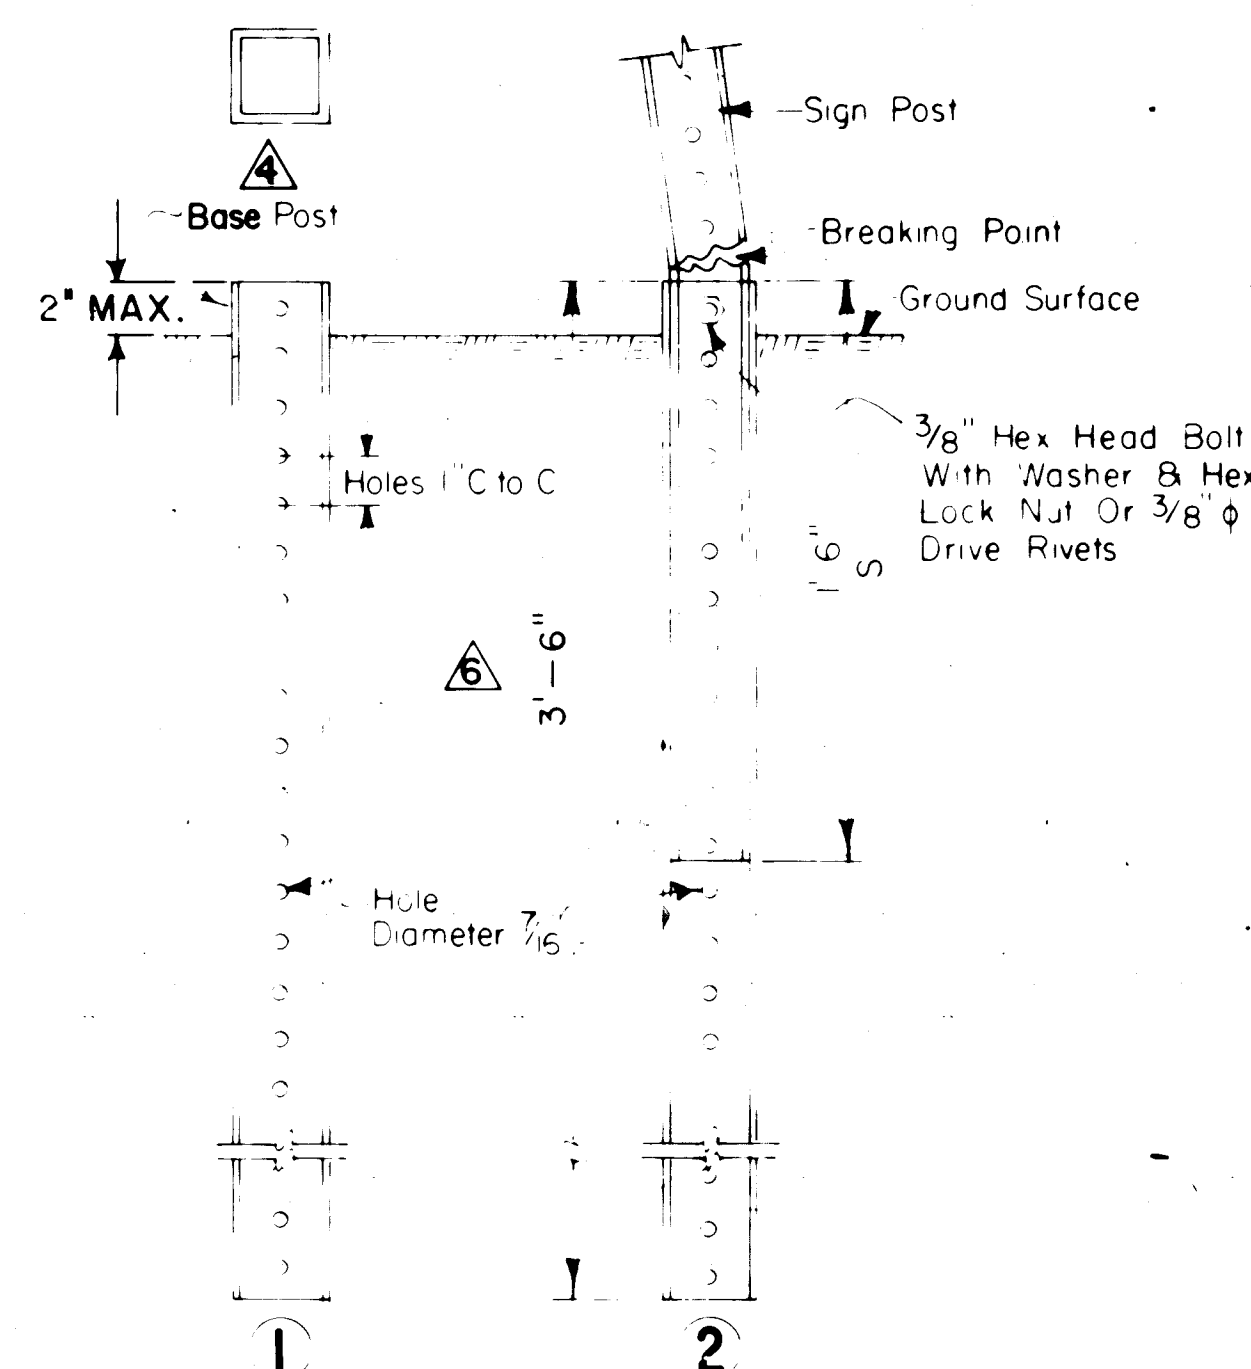

GROUND INSTALLATION

1. DRIVE BASE POST UNTIL ONE HOLE IS EXPOSED ABOVE GROUND FOR RIVET OR BOLT INSTALLATION.
2. INSERT SIGN POST 1'6" AND FASTEN WITH 2 EACH 3/8" ϕ DRIVE RIVET OR 3/8" ϕ BOLT.
3. THE HOLE PATTERN SHOWN IS ONLY REQUIRED IN THE AREA OF THE BREAKAWAY INFLUENCE AND AT THE SIGN PANEL LOCATION (HOLES MAY BE FIELD DRILLED).

POSTS
 0.1046" THICK (12 GA.)

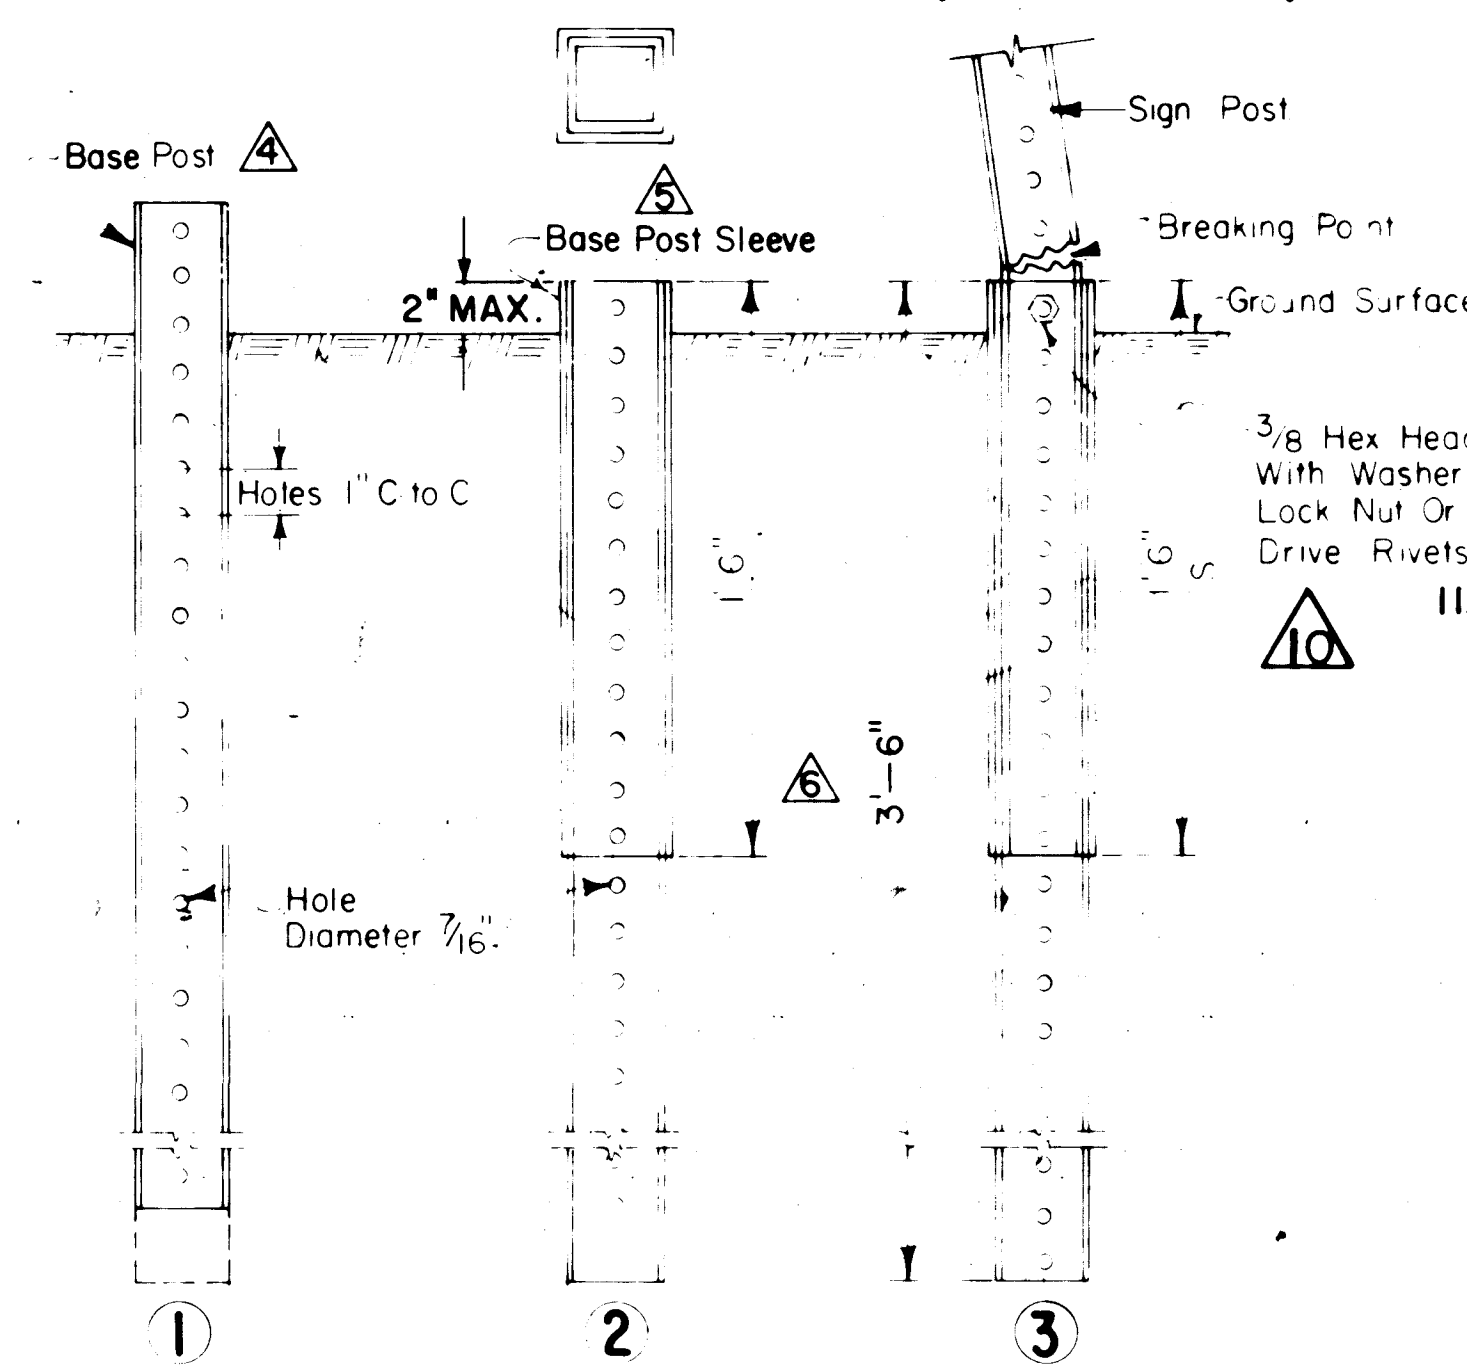

GROUND INSTALLATION

1. DRIVE BASE POST TO WITHIN THREE OR FOUR INCHES OF SURFACE BASE POST IS NEXT SIZE LARGER SECTION THAN SIGN POST.
2. PRE-CUT BASE POST SLEEVE (of next size larger tube) SO THAT THE HOLES WILL MATCH AND STILL BE FLUSH WITH TOP OF THE BASE POST. DRIVE BASE POST SLEEVE UNTIL HOLES MATCH AS NOTED ABOVE, THEN DRIVE BOTH THE BASE POST SLEEVE AND THE BASE POST UNTIL ONE HOLE IS EXPOSED ABOVE GROUND FOR BOLT CONNECTION.
3. INSERT SIGN POST 1'6" FASTEN WITH 2 EACH 3/8" ϕ DRIVE RIVETS OR 3/8" ϕ BOLT.
4. THE HOLE PATTERN SHOWN IS ONLY REQUIRED IN THE AREAS OF THE BREAKAWAY INFLUENCE AND AT THE SIGN PANEL LOCATION (HOLES MAY BE FIELD DRILLED).

F.H.W.A. Region No.	STATE	SHEET NO.	TOTAL SHEETS
6	NEW MEXICO	119	

NOTES:

1. MATERIALS AND WORKMANSHIP SHALL CONFORM TO NEW MEXICO STATE HIGHWAY DEPARTMENT STANDARD SPECIFICATIONS FOR ROAD AND BRIDGE CONSTRUCTION.
2. BREAKAWAY SIGN SUPPORTS SHALL BE FABRICATED FROM PERFORATED STEEL AND SHALL CONFORM TO THE BREAKAWAY DESIGN SHOWN ON THIS SHEET. ALL HOLES TO BE 7/16" ϕ .
3. THE STEEL POSTS SHALL CONFORM TO COMMERCIAL QUALITY ASTM DESIGNATION A 446 GRADE A ZINC COATED (G 90) ASTM A 525. THE CROSS SECTION OF THE POST SHALL BE SQUARE TUBE FORMED OF 0.1046" THICK OR 0.1345" THICK. ROLL FORMED CARBON STEEL WELDED DIRECTLY IN THE CORNER BY HIGH FREQUENCY RESISTANCE WELDING OR EQUAL AND EXTERNALLY SCARFED TO AGREE WITH CORNER RADIUS. STANDARD OUTSIDE CORNER RADIUS SHALL BE 9/32" PLUS OR MINUS 1/64".
4. BOLTS AND NUTS SHALL BE CARBON STEEL A-307 OR STAINLESS STEEL A-193.
5. DRIVING CAPS MUST BE USED TO DRIVE POSTS 1'6".
6. BASE POST SLEEVE IS REQUIRED WITH 0.1046" THICK POST, BUT NOT WITH 0.1345" THICK.
7. 3" x 3" x 4' 0" BASE POST OF 3/16" WALL THICKNESS TO BE USED WITH 2 1/2" x 2 1/2" 0.1345 POST.
8. POSTS SHALL HAVE A MINIMUM COLD FORMED YIELD STRESS OF 40,000 PSI.
9. DESIGN IS IN ACCORDANCE WITH AASHTO STANDARD SPECIFICATIONS FOR STRUCTURAL SUPPORTS FOR HIGHWAY SIGNS, LUMINAIRES AND TRAFFIC SIGNALS, 1976. WIND LOAD: 9 LBS./SQ.FT. (70 MPH) SOIL BEARING CAPACITY: 3 K/SQ.FT.
10. CARBON STEEL NUTS, BOLTS AND WASHERS SHALL BE HOT DIP GALVANIZED A-153, CLASS D, ZINC COATED A-164, TYPE LS (0.0005 THICKNESS), OR CADMIUM COATED A 165, TYPE OS (0.0003 THICKNESS).
11. AS AN ALTERNATE TO GALVANIZING, STEEL POSTS AND BASE POSTS MAY BE PAINTED WITH A GREEN MODIFIED POLYESTER PAINT MEETING THE COLOR REQUIREMENTS OF FS 595-A (COLOR NO. 14109). METHOD OF APPLICATION SHALL BE BY ELECTRODEPOSITION TO A MINIMUM 1 MIL THICKNESS. FINISHED POSTS SHALL HAVE A SMOOTH, UNIFORM FINISH FREE FROM DEFECTS AFFECTING STRENGTH OR APPEARANCE.

IDENT. NO.	DESCRIPTION	DATE BY
10	ADDED NOTE No. 11	8/6/81 TGM
9	REVISED NOTE No. 9	9/24/79 TM
8	CORRECTED LETTER REFERENCE	7-2478 TGM
7	ADDED LARGER POST SIZE TO CHART	2-2875 TGM
6	REV. BASE POST DIMENSION	12-577 T.M.
5	ANCHOR SLEEVE TO BASE POST SLEEVE	12-577 T.M.
4	SIGN POST ANCHOR TO BASE POST	12-577 T.M.
3	Rev. Note 4 & Add Note 10	6-677 J.G.
2	Rev. Note 4	3-377 T.M.
1	Rev. Offset Distance	5/14/81 T.M.

REVISIONS (OR CHANGE NOTICES)

NEW MEXICO
 STATE HIGHWAY DEPARTMENT

DESIGN LOADS FOR
 SQUARE TUBING POSTS


DESIGNED BY JG	APPROVAL
DRAWN BY JP	RECOMMENDED - TRAFFIC ENGINEER DATE
CHECKED BY JG	APPROVED - ENGINEER OF DESIGN DATE

SERIAL Sn 75-1 SHEET OF

26 19603507


Stands may be detachable for portability. Type "I" Barricades have two (2) reflectorized rail faces (one in each direction). The stand materials may be metal, wood or other suitable light weight materials of structural soundness.

TYPICAL
TYPE "I" BARRICADE

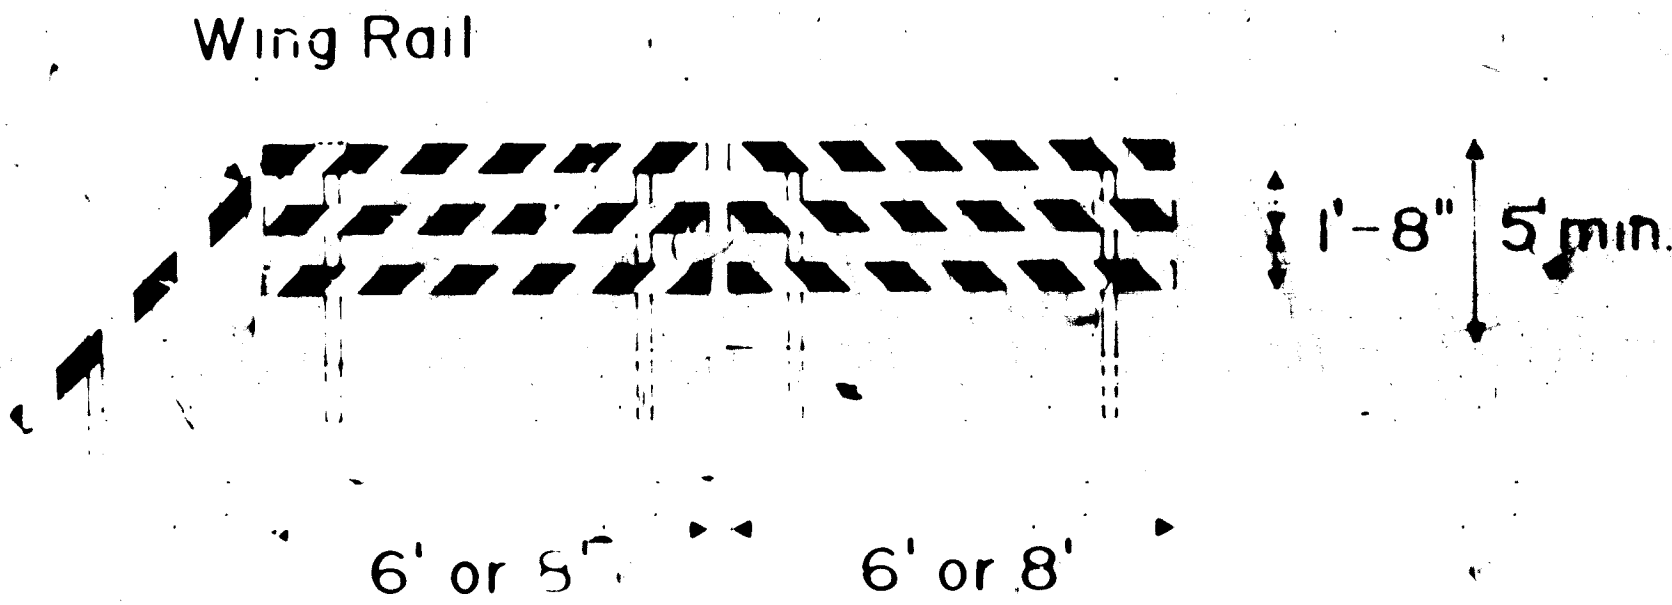

Type "III" Barricades have 3 reflectorized rail faces when facing traffic in one direction; 6 if facing traffic in two directions. Wing Rail may be fitted to the back of the top rail attached by two 5/16" bolts, nuts, and washers.

TYPICAL
FIXED TYPE "III" BARRICADE

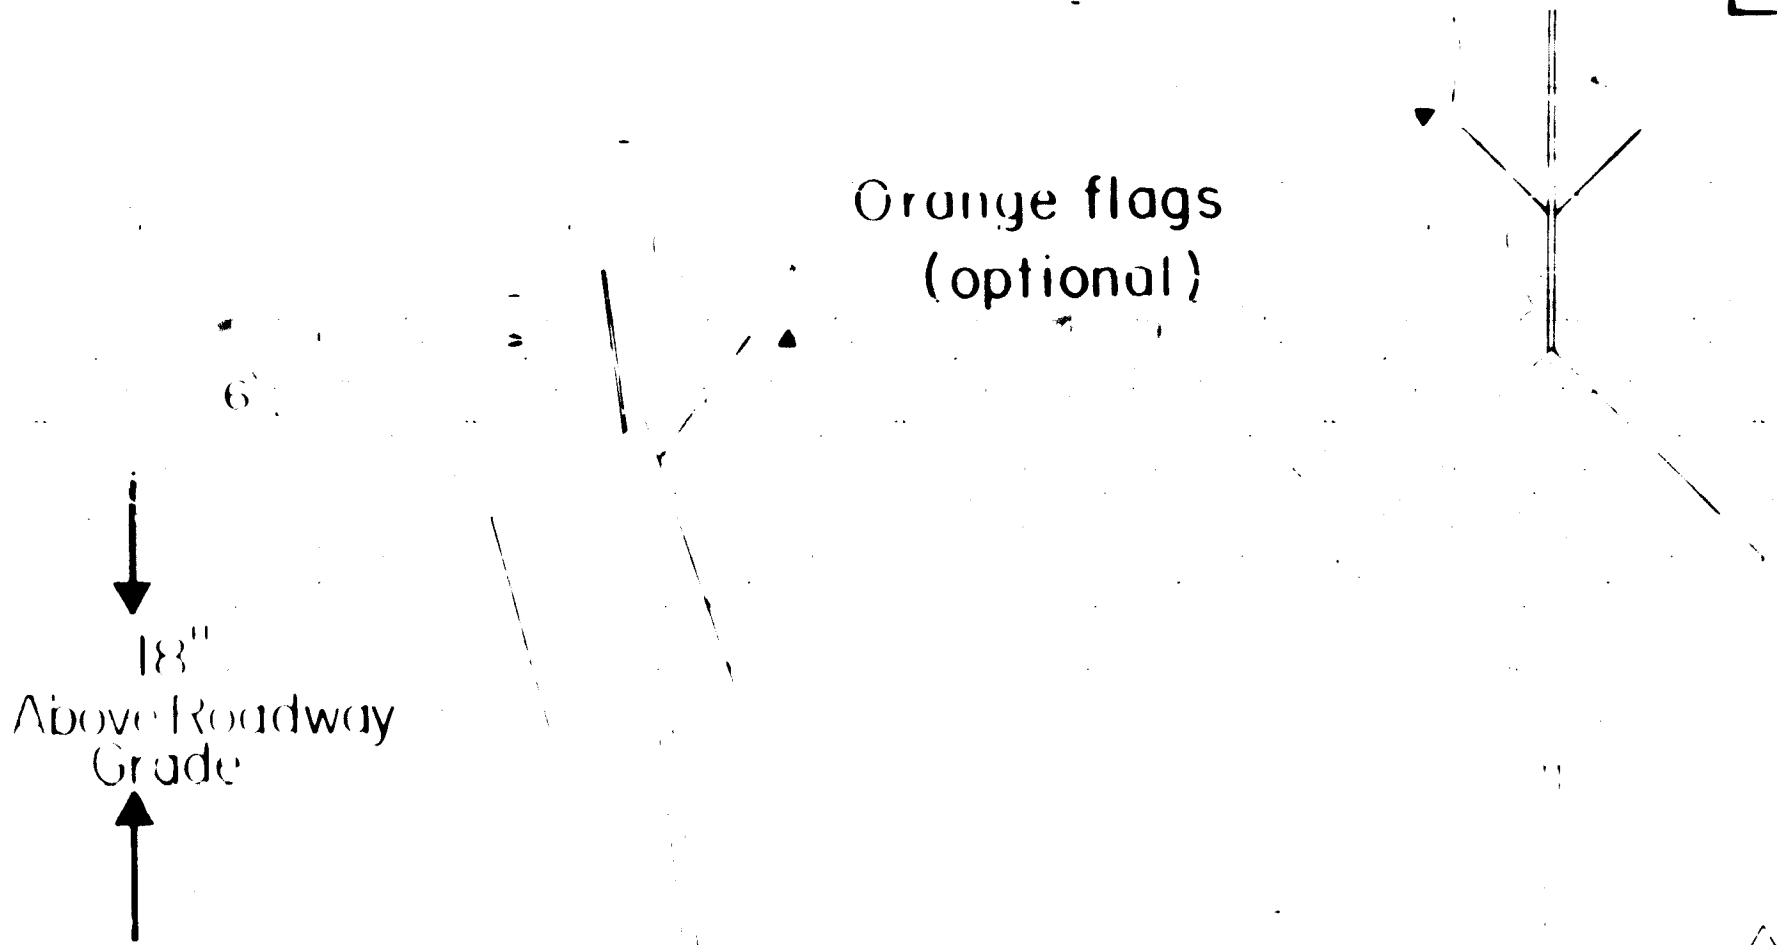

Portable sign supports shall be submitted to the engineer for approval prior to use Sand bags may be utilized for stability. Portable sign supports shall be used for temporary emergency construction operation only.


PORTABLE SIGN SUPPORT (TYPICAL)

Type "II" Barricades have four (4) reflectorized rail faces (two in each direction). Folding stands shall be of materials similar to Type "I" Barricade stands.

TYPICAL
TYPE "II" BARRICADE

BARRICADES - CHARACTERISTICS



	I	II	III
WIDTH OF RAIL	8" min.-12" max.	8" min.-12" max.	8" min.-12" max.
LENGTH OF RAIL	6' to 8'	3' min.-4' max.	6' or 8'
WIDTH OF STRIPES	6 ins.	6 ins.	6 ins.
HEIGHT	3 ft. min.	3 ft. min.	5 ft. min.
TYPE OF FRAME	Demountable or heavy "A" frame	Light "A" frame	Posts or skids
FLEXIBILITY	Essentially movable	Portable	Essentially permanent

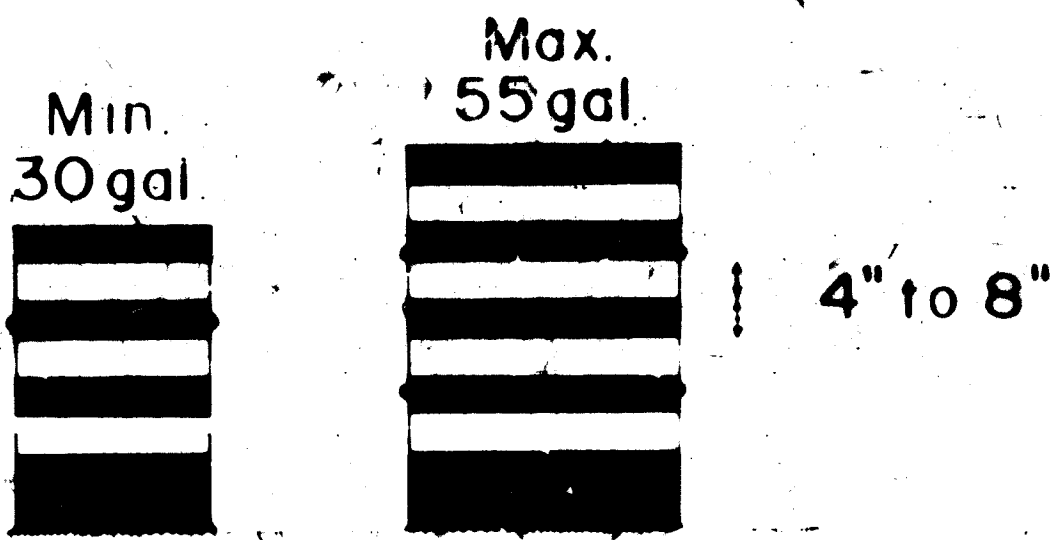

With three (3) orange stripes minimum and alternating white stripes, all reflective tape or sheeting.


CHANNELIZATION DEVICES
(BARRELS)

Sand bags for added stability

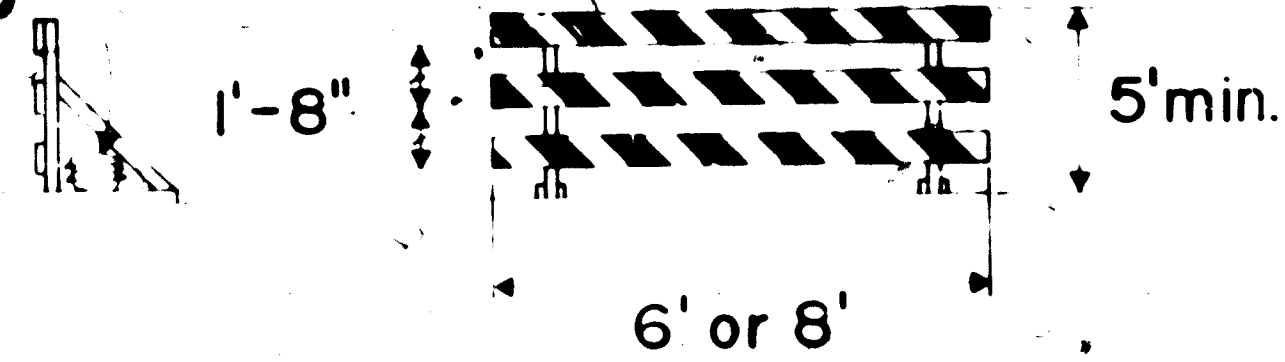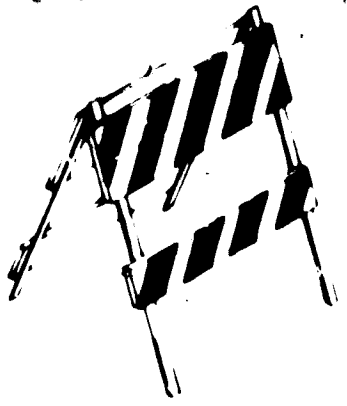


Type "III" Barricade framing and supports shall be 2"x2" min.-12Ga., square metal tubing or driven down posts.

TYPICAL
MOVABLE TYPE "III" BARRICADE

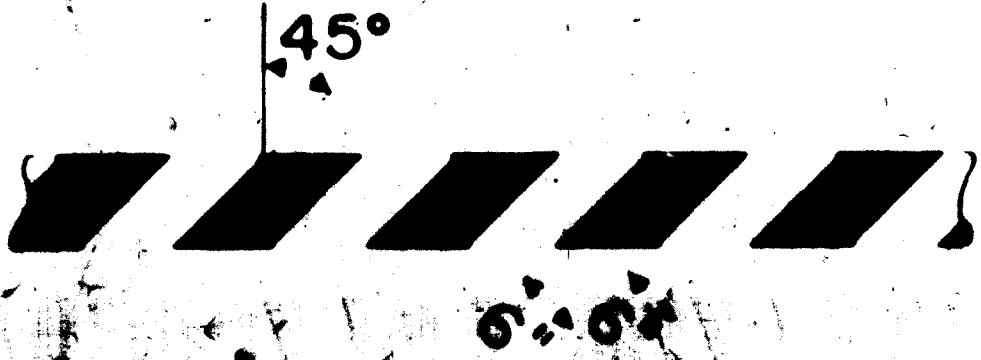


Rail shall be 1/2" min. 5 ply sign grade plywood or 2" x 8" S4S quality wood. On Types "I" and "II", metal rails, if used, must be light weight material, commensurate with structural soundness. Stripes shall slant downward at 45° toward the side which traffic is to pass.

DETAIL OF BARRICADE
RAIL STRIPING

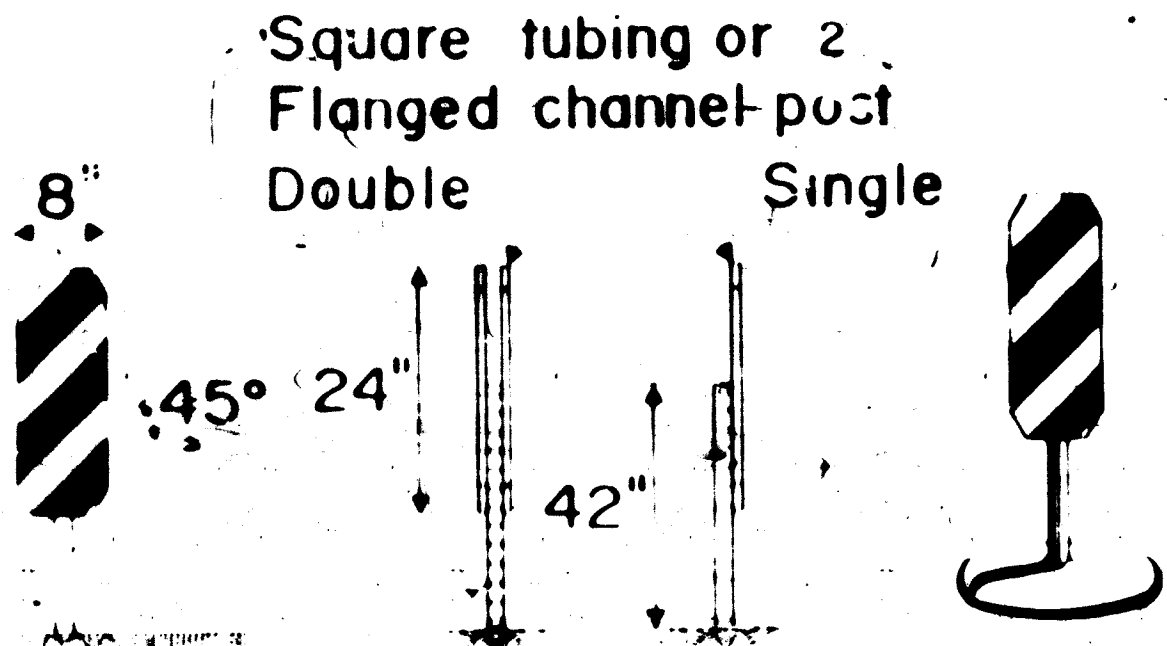

Panels to be 0.060 min., 6061-T6, or 5052-H38 aluminum alloy mounted on 1 1/2" min. square steel tubing post or 1.33 lb/ft min. flanged channel post. Stripes shall slant downward at 45° toward the side which traffic is to pass. For temporary installation the post may be set to 3 ft. below ground or the panels may be mounted on stanchions.

CHANNELIZATION DEVICES
(VERTICAL PANELS)

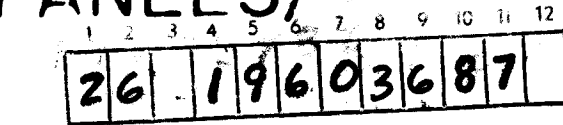

GENERAL NOTES

- All signs, sign materials, beacons, and barricade warning lights shall conform to the standards set forth in the M.U.T.C.D. 1978 edition.
- The entire area of orange and white stripes shall be reflectorized on all barricades, barrels, vertical panels or other channelization devices when used on construction, detours, or participating connections, by use of reflective sheeting or tape.
- Red and white barricades may be used to mark the end of a road, street, or highway where there is no crossroad or outlet at locations considered permanent and semi-permanent closures or termination of roadways.
- Flashing beacons or steady burn lights, when used on barricades, shall be positioned above the top rail of the barricade, facing traffic.
- High intensity flashing beacons shall be used to mark obstructions or hazards. Type "C" steady burn light may be used for delineation at night.
- All barricade framing and supports, other than galvanized metal, shall be painted white.

1	REVISED PORT SIGN SUPPORT DETAILS	3/15/80 T.C.M.
2	REVISED PORT SIGN SUPPORT DETAILS	1/31/80 T.G.M.
3	REVISED NOTE No 1	9/24/79 T.G.M.
4	ADDED 5052-H38 ALUMINUM ALLOY	5-9-78 T.G.M.
5	ADDED FLANGED CHANNEL POST	5-4-78 T.G.M.
6	REMOVED SIGN CLEARANCE DIMENSION	12-8-77 T.G.M.
7	REMOVED SIGN CLEARANCE DIMENSION	12-8-77 T.G.M.

NEW MEXICO
STATE HIGHWAY DEPARTMENT

BARRICADES AND
CHANNELIZATION
DEVICES

APPROVAL

RECOMMENDED

APPROVED

DATE


DATE

DATE


PROJECT	BY	DATE
SURVEYED		
PLOTTED		
GRADE CHECKED		
S. M. S. NOTED		
STRUCTURE NOTATIONS CHECKED		

PLAN	SURVEYED	DATE
	NOTED	BY
	ALIGNED	BY
	RT. OF WAY	BY

PROFILE	SURVEYED	DATE
	NOTED	BY
	ALIGNED	BY
	RT. OF WAY	BY

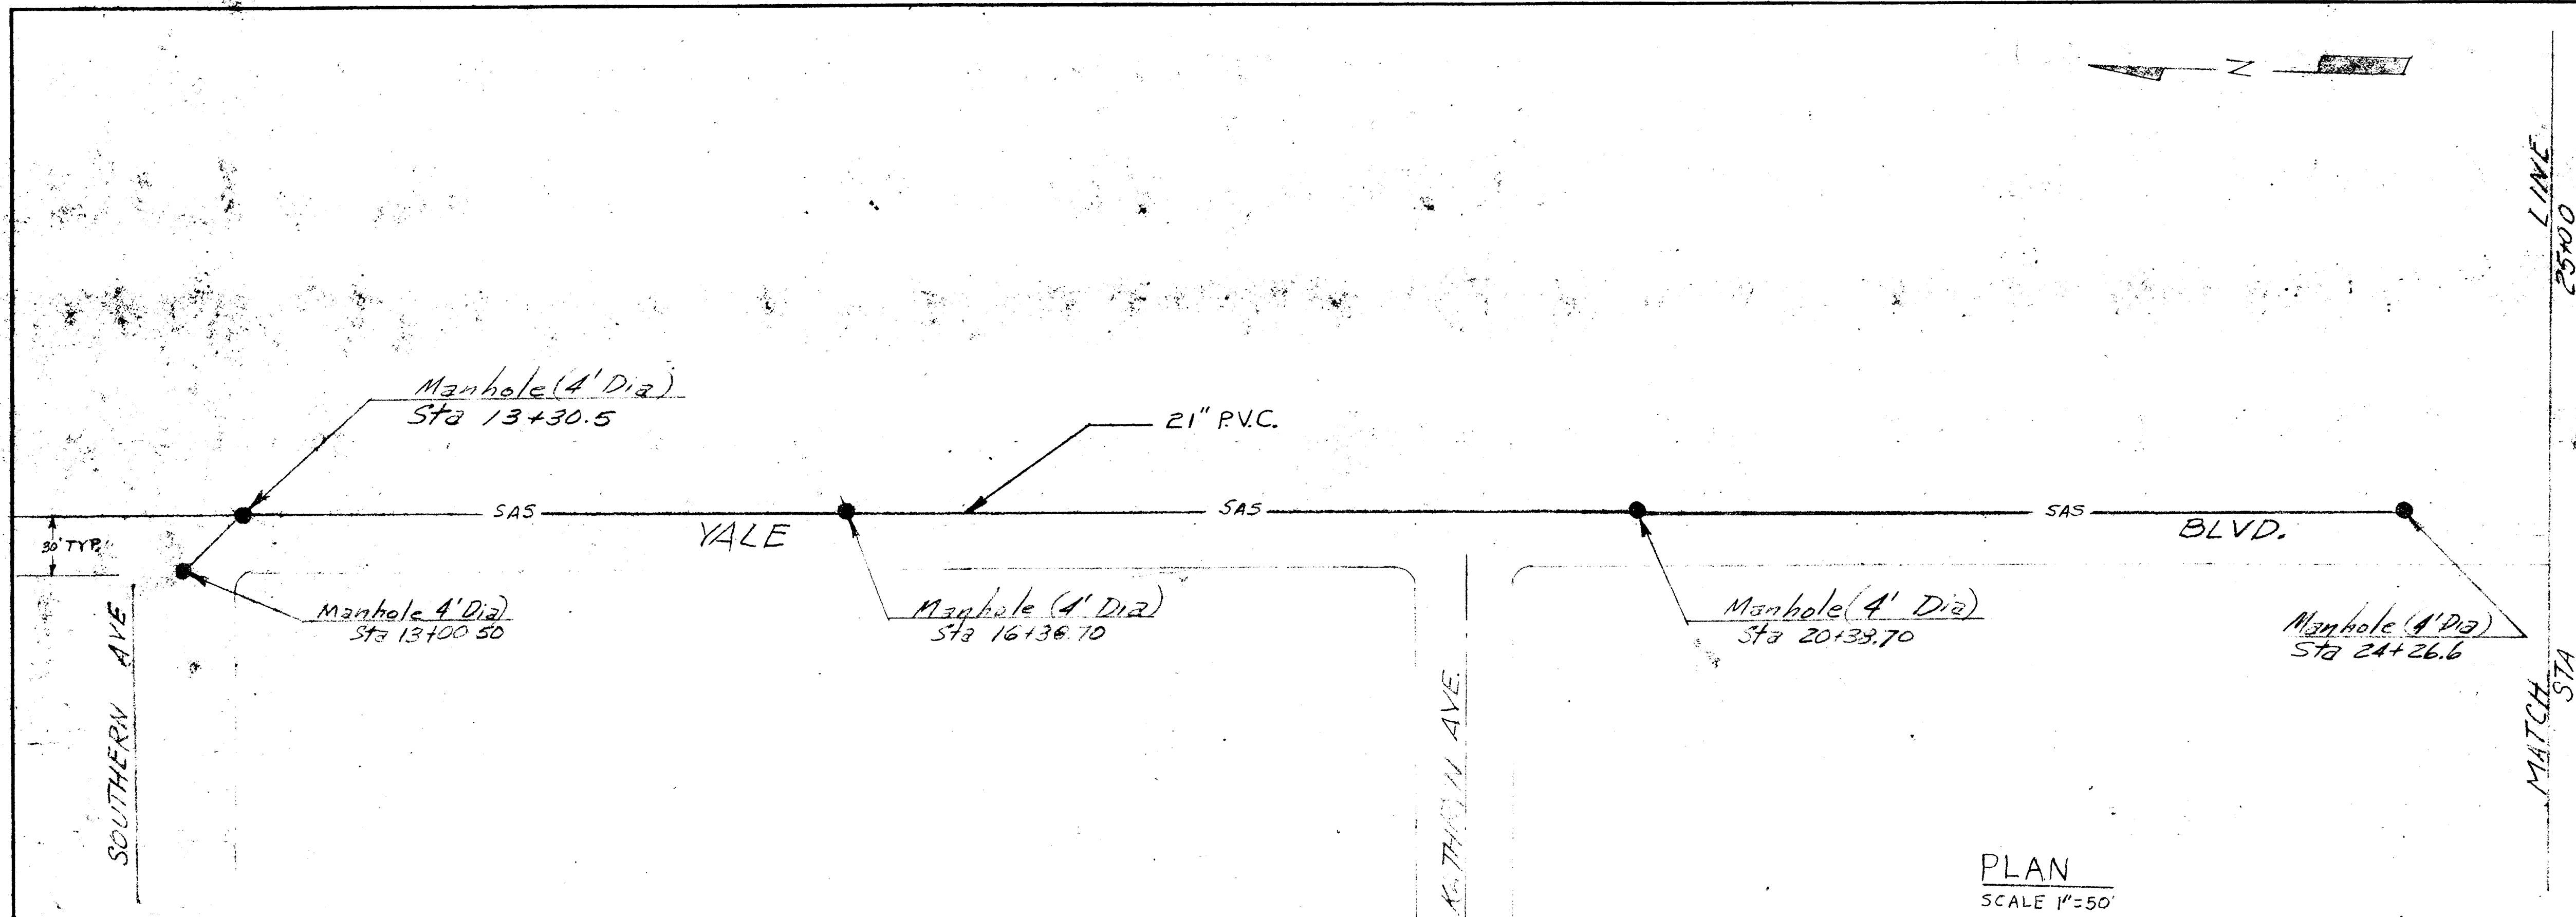


PLAN
SCALE 1"=50'
PROFILE
SCALE 1"=50' HORIZ.
1"=5' VERT.

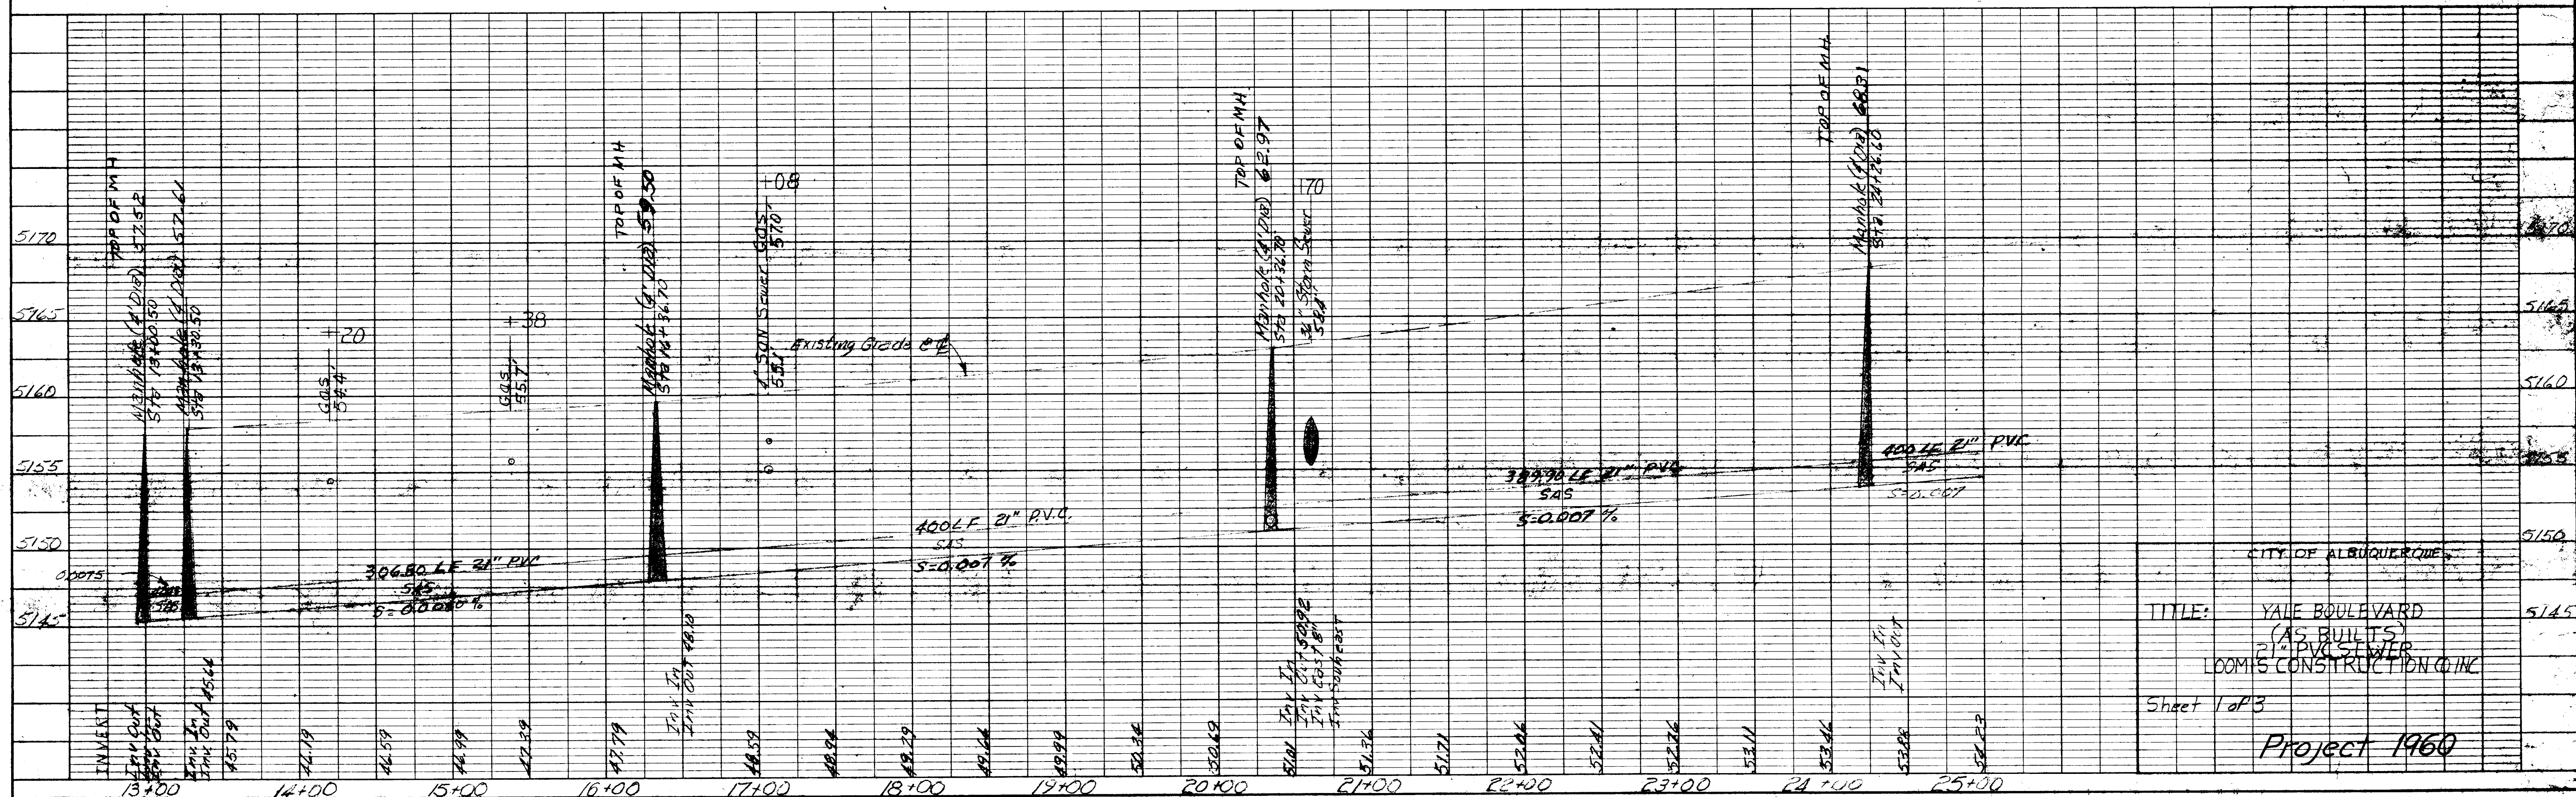

CITY OF ALBUQUERQUE
TITLE: YALE BOULEVARD
(AS BUILT)
21" PVC SEWER
LOOMIS CONSTRUCTION CO. INC.
Sheet 1 of 3
Project 1960

PLAN	SURVEYED	DATE
BY	BY	BY
NO.	NO.	NO.
NOTE BOOK	ALIGNED CHECKED	RT. OF WAY CHECKED



PROFILE	SURVEYED	DATE
BY	BY	BY
NO.	NO.	NO.
NOTE BOOK	GRADES CHECKED	STRUCTURE NOTATIONS CHECKED

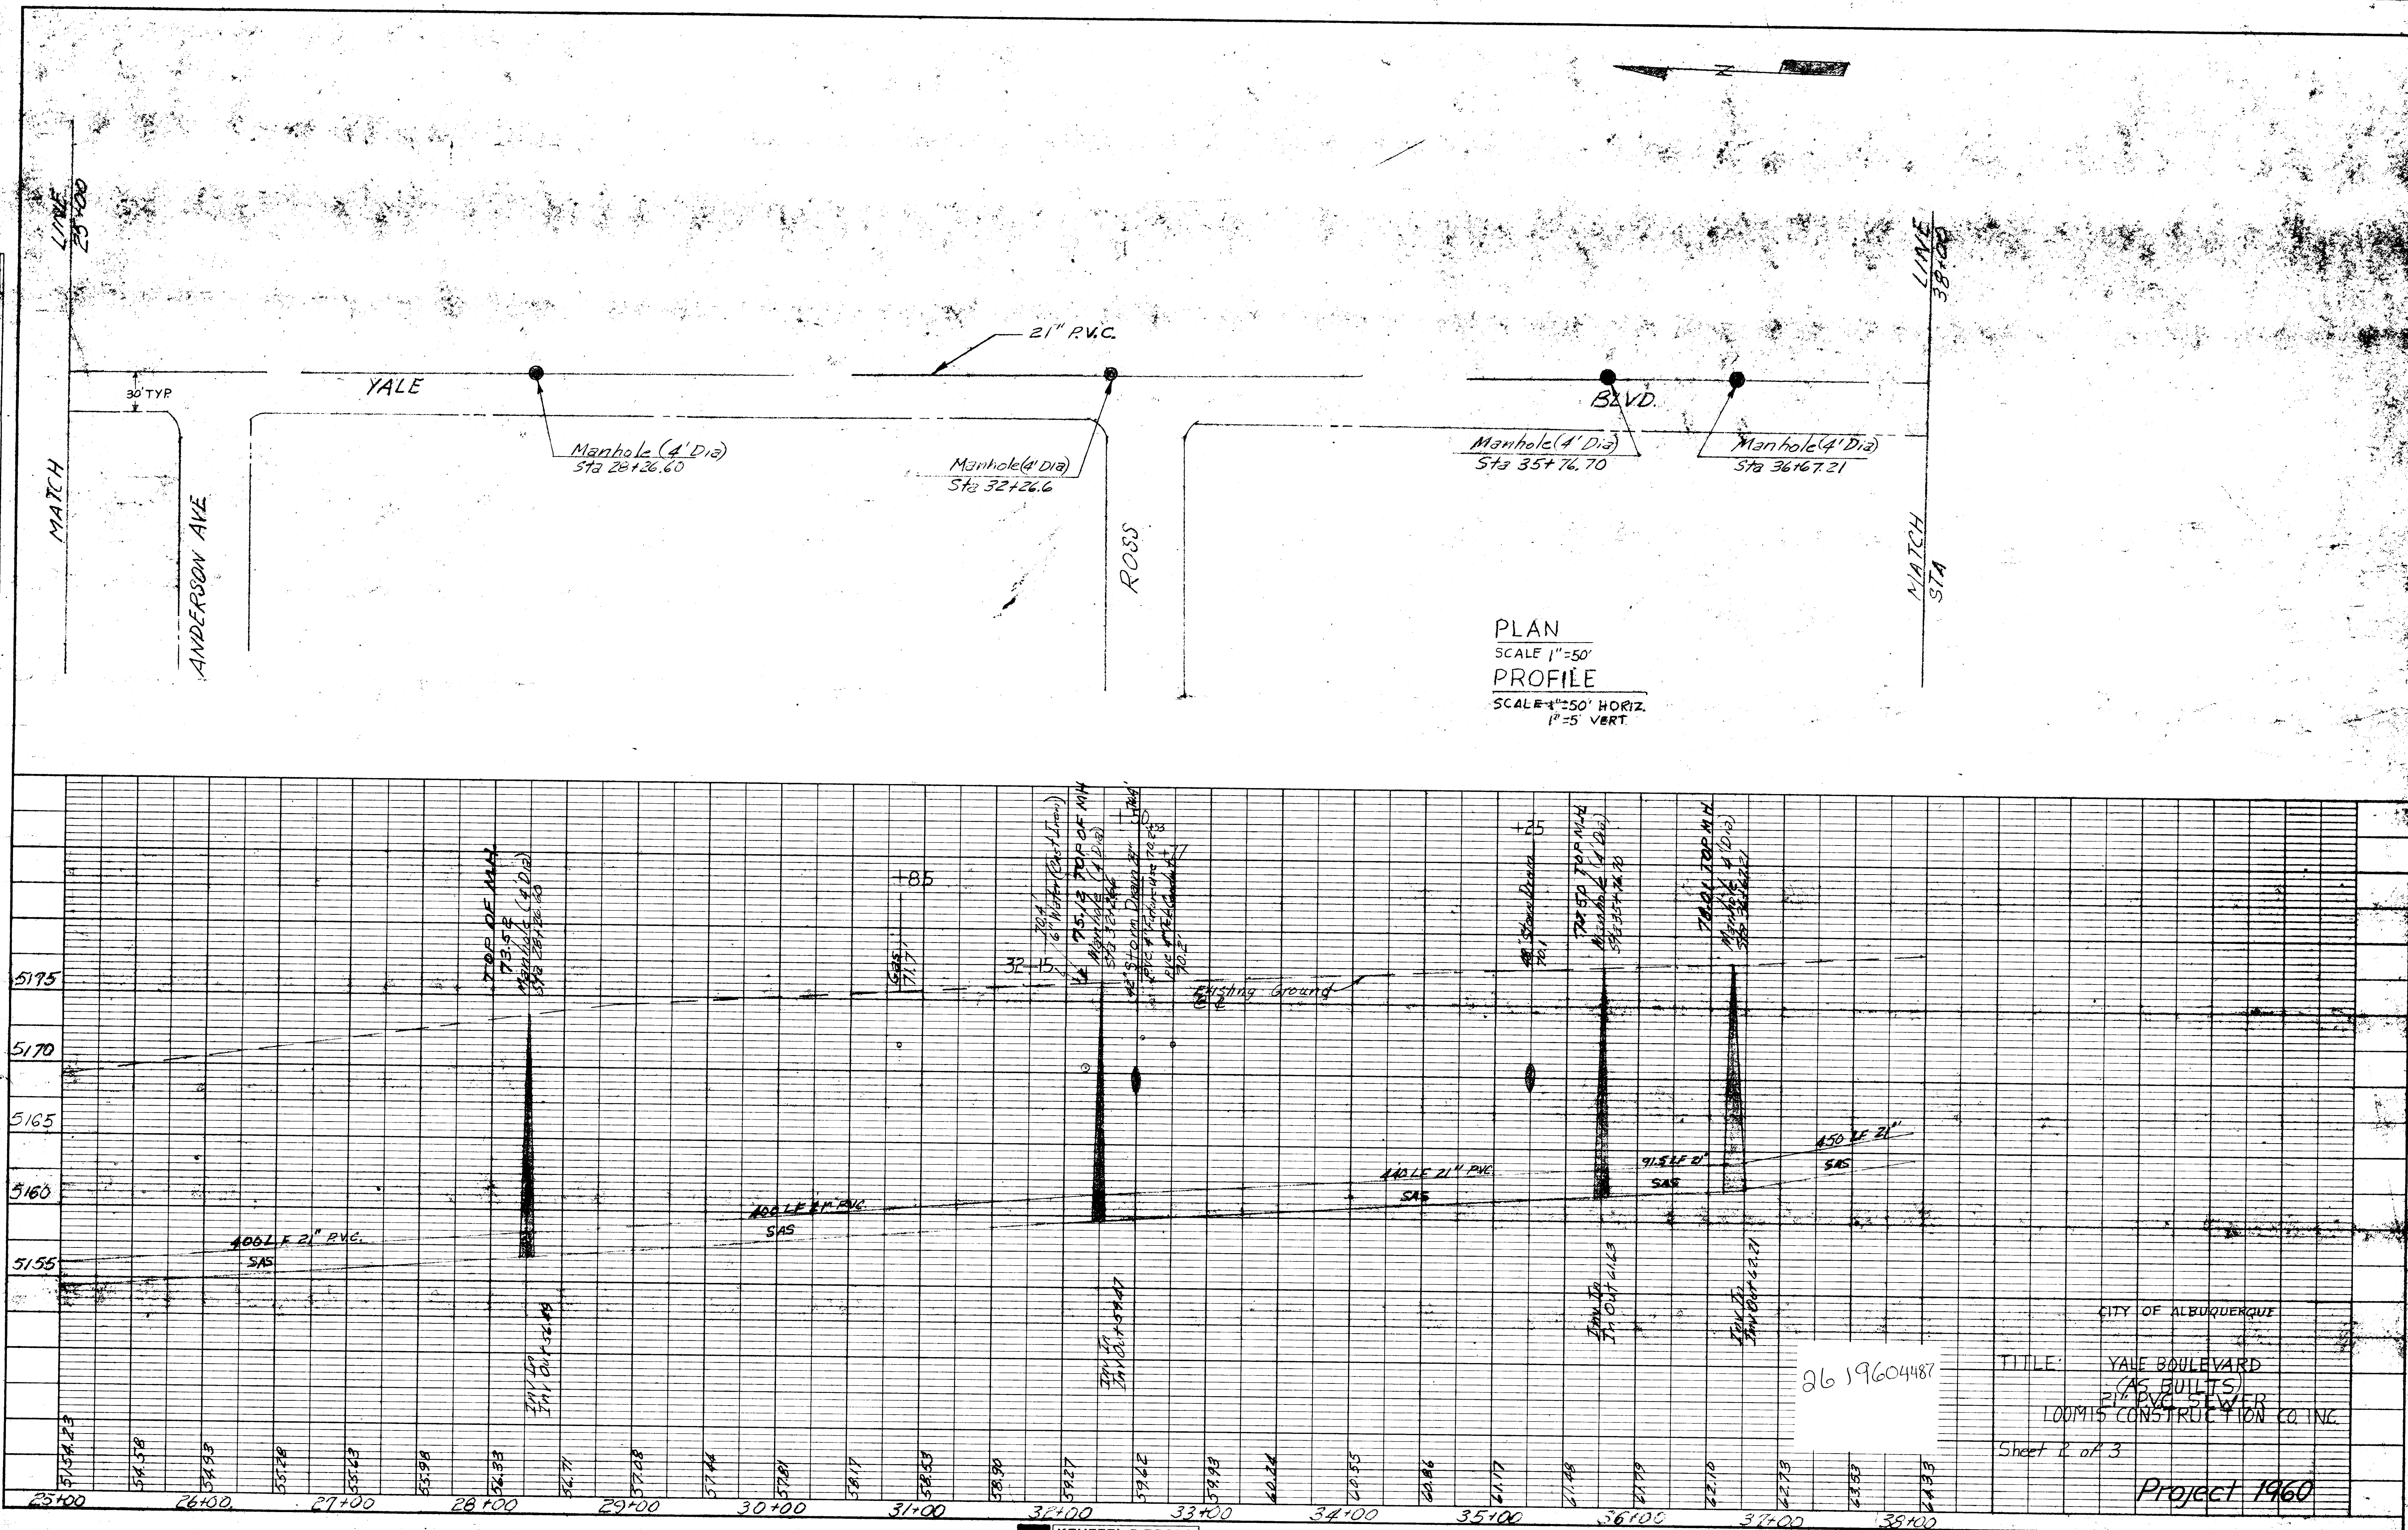

CITY OF ALBUQUERQUE
TITLE: YALE BOULEVARD
(AS BUILT)
21" PVC SEWER
100MIS CONSTRUCTION CO. INC.
Sheet 2 of 3
Project 1960

PLAN	SURVEYED	BY	DATE
	NOTED		
NOTE BOOK	PLANNED		
	RT OF WAY CHECKED		
NO.	NO.		
	NO.		

PROFILE	SURVEYED	BY	DATE
	NOTED		
NOTE BOOK	PLANNED		
	STRUCTURE NOTATIONS		
NO.	NO.		
	NO.		

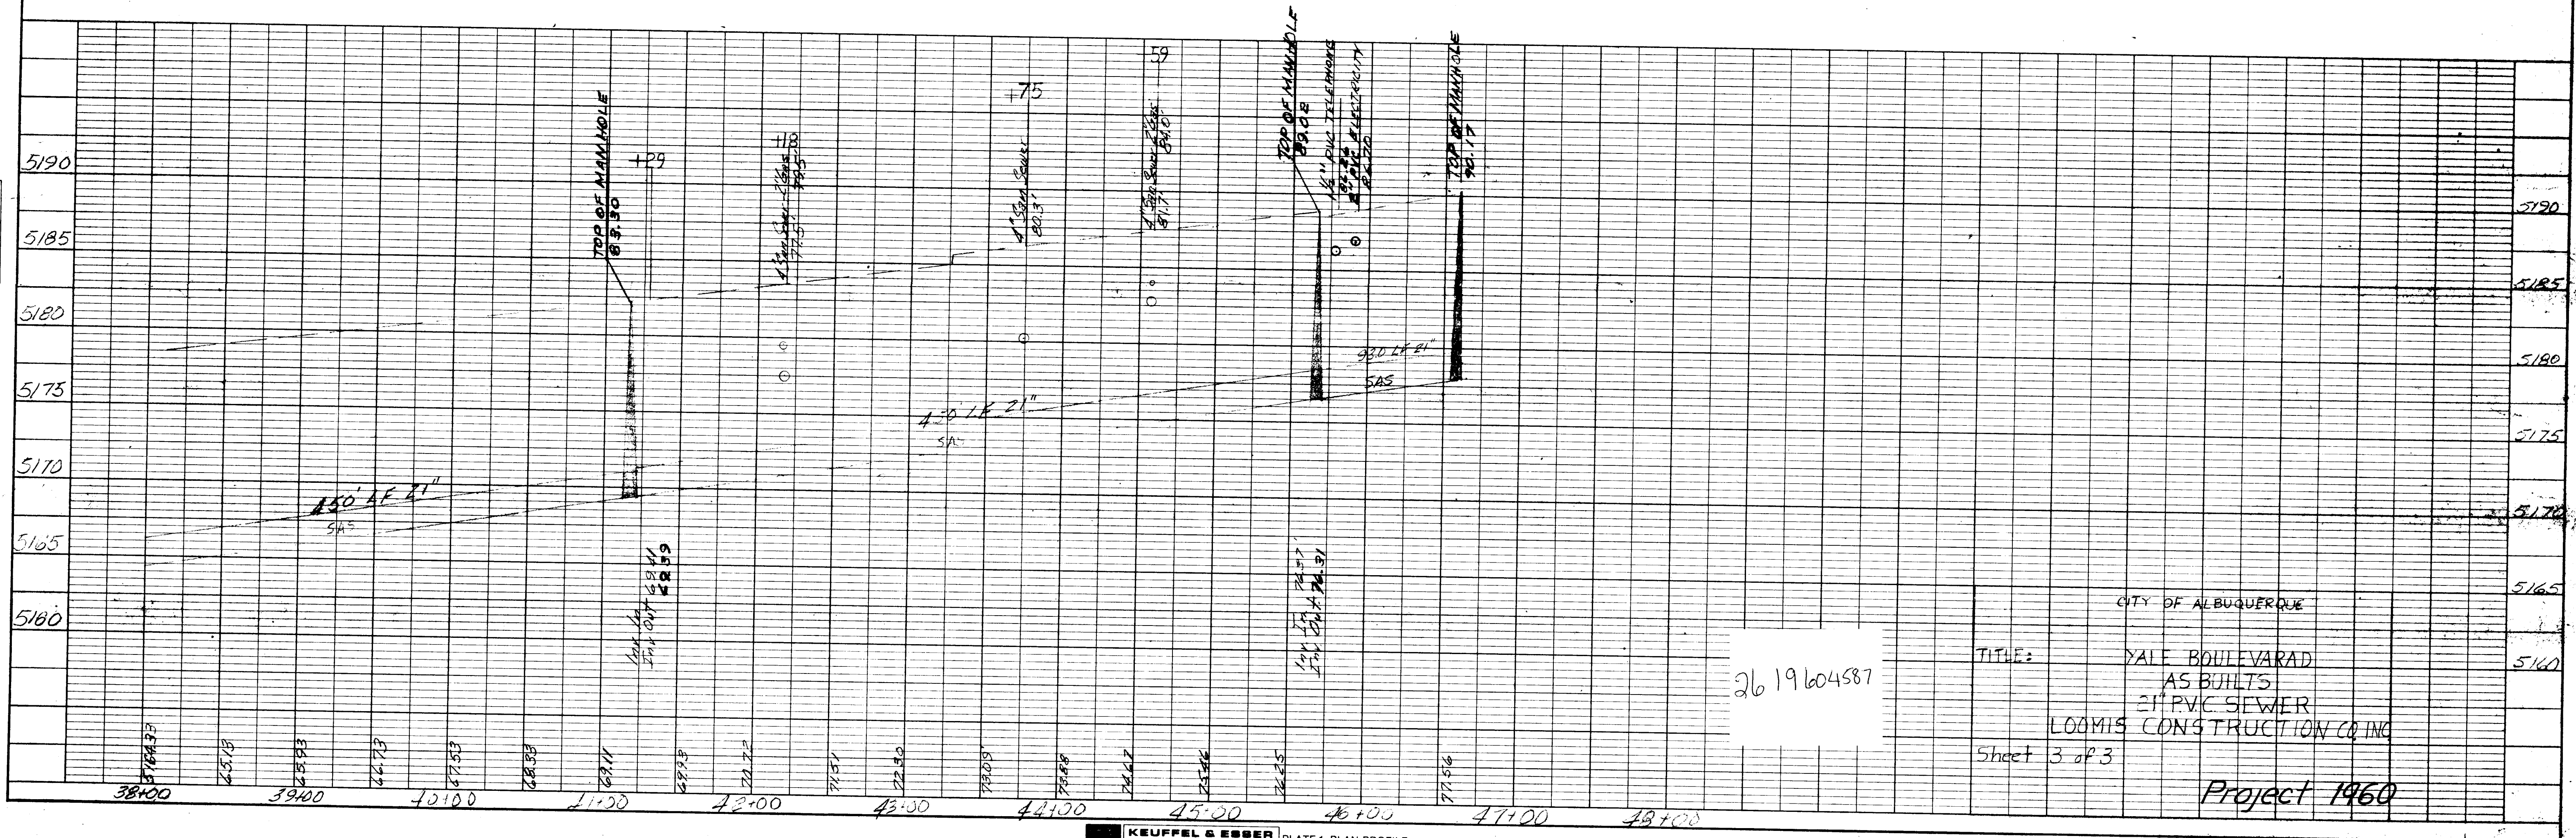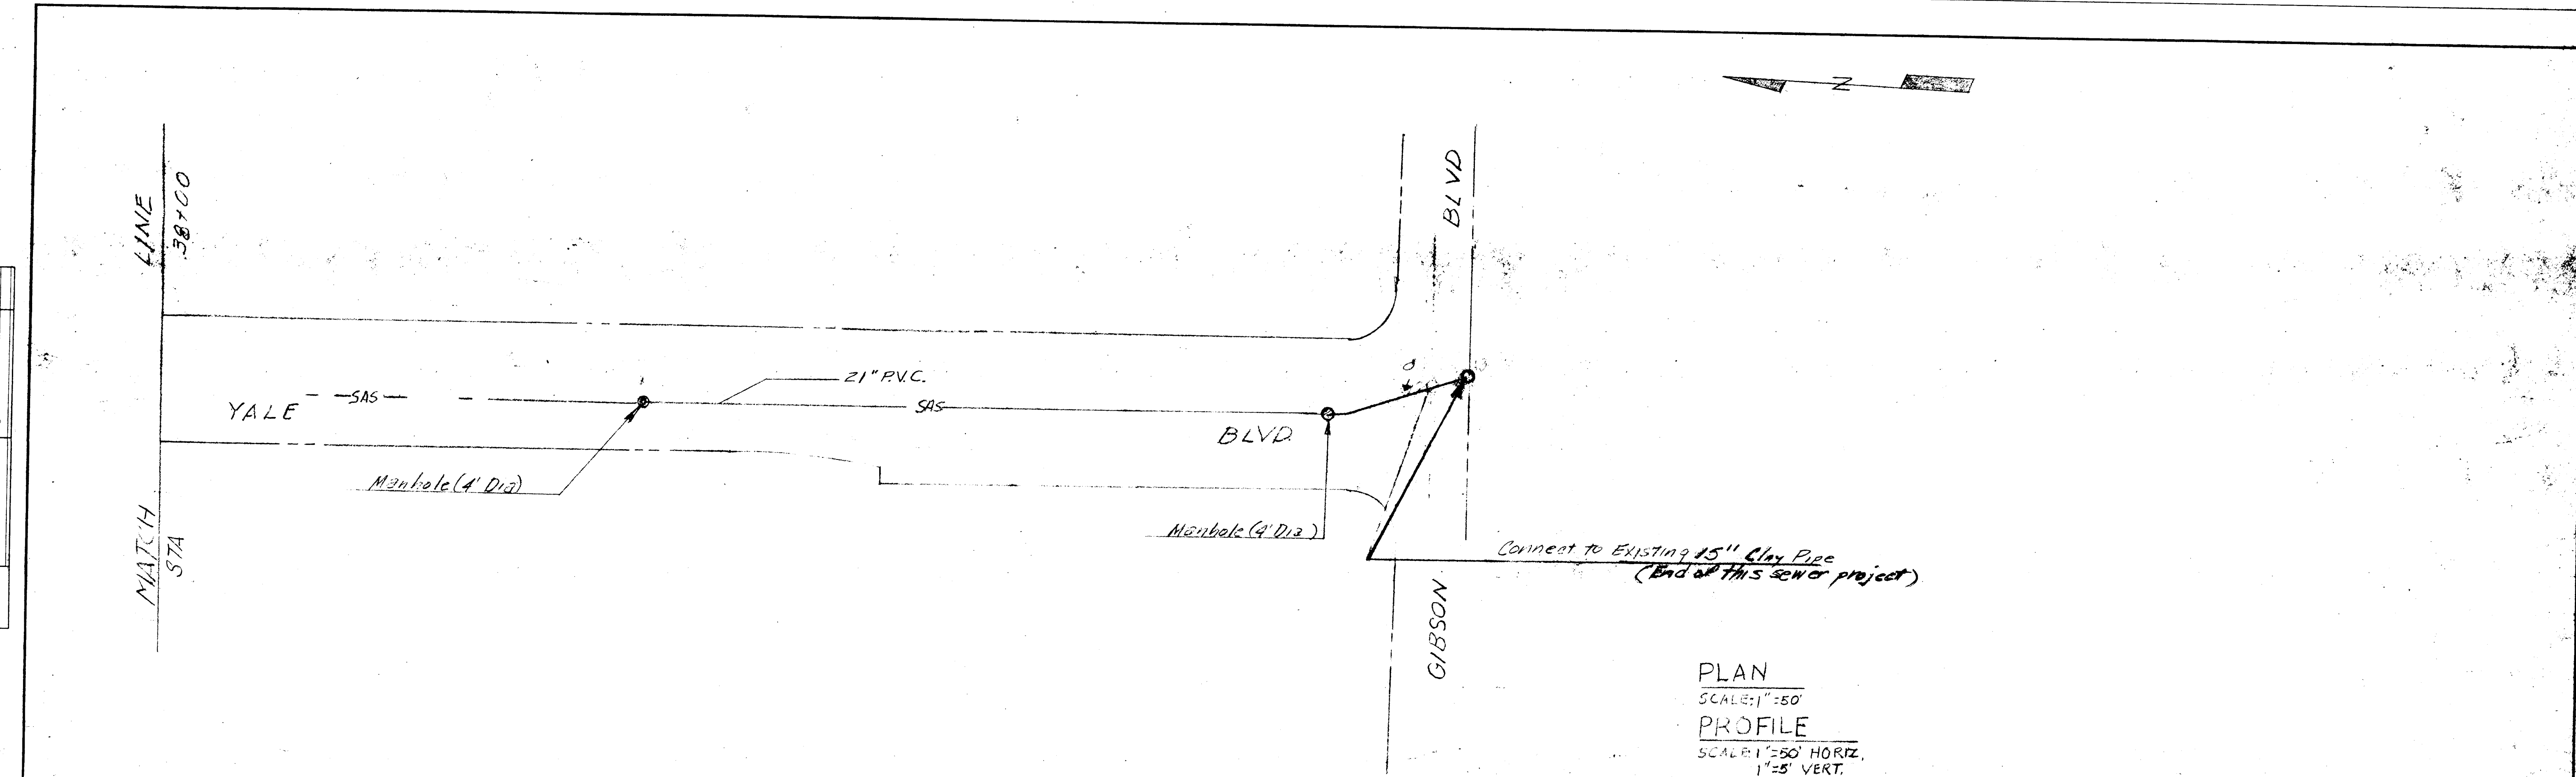

DESIGNED BY

SIGN CODE	N° OF SIGNS	TOTAL SIGN AREA SQ. FT.	POST LENGTHS				MOUNTING REQUIREMENTS						BASE-POSTS		
			LEFT	CTR.	RIGHT	TOTAL	FLANGED CHANNEL			DRIVEDOWN POSTS 0.1345 THICK		PORTABLE SIGN SUPPORT	N°	TOTAL LENGTH	
							2.25 Lb/Ft.	3.00 Lb/Ft.	4.00 Lb/Ft.	2 3/16" x 2 3/16"	2 1/2" x 2 1/2"				
						PHASE I									
R3-7	1	6.25	9 1/2		9 1/2	19	✓				✓			2	7
R4-7a	11	132										11			
W4-2L	3	48	11		11	66	✓				✓		6	21	
W6-3	8	128	11		11	176	✓				✓		16	56	
W20-1	3	48	11		11	66	✓				✓		6	21	
W20-5L	3	48	11		11	66	✓				✓		6	21	
R11-2	12	120													
		-530.25-				-393-							-36-	-126-	
						PHASE II									
R1-1	6	36										(6)			
R3-7	(1)	(6.25)	9 1/2		9 1/2	(19)	✓				✓		6	21	
R4-7a	(3)	(36)										(3)			
W1-4L	4	64	11		11	(88)	✓				✓		8	28	
W1-4R	2	32	11		11	(44)	✓				✓		4	14	
W4-2L	(2)	(32)	(11)		(11)	(44)	✓				✓		4	14	
W4-2R	1	16	11		11	(22)	✓				✓		2	7	
W6-3	(7)	(112)	11		11	(154)	✓				✓		14	49	
W20-1	(3)	(48)	11		11	(22) & 44	✓				✓		6	21	
W20-5L	(2)	(32)	11		11	44	✓				✓		6	14	
W20-5R	1	16	11		11	22							2	7	
R11-2	(2)	(20.0)													
R11-4	2	25													
W20-3	1	16										(1)			
		-217.5-				-110-						-0-		-175-	
						PHASE II-A									
R3-2	13	52										(9)			
R4-7a	(6)	(72)										(2) & 4			
W1-4L	(4)	(64)	11		11	(88)	✓				✓		8	28	
W1-4L	2	32	11		11	(44)							4	14	
W1-4R	(1)	(16)	9		9	(18)	✓				✓		2	7	
W4-2L	(3)	(48)	11		11	(66)	✓				✓		6	21	
W4-2L	3	48	11		11	(66)	✓				✓		6	21	
W6-3	(8)	(128)	11		11	(176)	✓				✓		2	8	28
W8-1	2	12.5	11		11	(22)	✓				✓		1	2	7
W20-1	(3)	(48)	11		11	(22) & 44	✓				✓		6	21	
W20-1	4	64	11		11	88	✓				✓		8	28	
W20-5L	(3)	(48)	11		11	66	✓				✓		6	21	
W20-5L	1	16	11		11	22	✓				✓		2	7	
W20-5R	(1)	(16)	11		11	2	✓				✓		2	7	
W20-5R	2	32	11		11	44	✓				✓		2	7	
W1-6	11	88													
R11-2	(11)	(110)													
R11-4	(2)	(25)													
		-344.5-				-266-							-7-	-62-	-217-

- ▲ Mount On Special Portable Support - See Sheet __-__ For Details.
() Sign(s) And Or Support(s) Used In Other Construction Phase(s). No Additional Payment Therefore.
✱ No Additional Post Needed Sign To Be Mounted On Common Post With Another Sign
● Mount Back-To-Back

GENERAL NOTES FOR TRAFFIC CONTROL

1. ALL TRAFFIC CONTROL DEVICES SHALL COMPLY WITH CHAPTER VI OF THE 1978 EDITION OF THE "MANUAL FOR UNIFORM TRAFFIC CONTROL DEVICES."
2. THE CONTRACTOR SHALL PREPARE AND SUBMIT TO THE PROJECT ENGINEER A DETAILED CONSTRUCTION SCHEDULE, WHICH IS SUBJECT TO THE APPROVAL OF THE CITY TRAFFIC ENGINEER, (THREE) 3 WORKING DAYS PRIOR TO COMMENCING CONSTRUCTION.
3. UNLESS OTHERWISE PROVIDED AS PART OF THE CONSTRUCTION DOCUMENTS, THE CONTRACTOR SHALL PREPARE AND SUBMIT TO THE PROJECT ENGINEER A DETAILED TRAFFIC CONTROL PLAN, WHICH IS SUBJECT TO THE APPROVAL OF THE CITY TRAFFIC ENGINEER, (THREE) 3 WORKING DAYS IN ADVANCE OF ANY REQUIRED CLOSURES.
4. CONTRACTOR SHALL NOTIFY THE FOLLOWING SERVICES 24 HOURS IN ADVANCE OF ANY COMPLETE CLOSURES: POLICE DEPARTMENT, FIRE DEPARTMENT, AMBULANCE SERVICES, AND THE TRANSIT DEPARTMENT.
5. PERMITS TO BARRICADE OR DETOUR TRAFFIC MUST BE OBTAINED FOR EACH PHASE OF CONSTRUCTION THROUGH THE TRAFFIC ENGINEERS OFFICE AT LEAST 24 HOURS IN ADVANCE OF CONSTRUCTION ACTIVITIES.
6. ALL ADVANCE WARNING SIGNS AND BARRICADES MUST BE INSTALLED BEFORE CONSTRUCTION BEGINS AS DIRECTED BY THE ENGINEER.
7. ALL SIGN LOCATIONS WILL BE SELECTED IN THE FIELD AND APPROVED BY THE PROJECT ENGINEER.
8. ALL ADVANCE WARNING SIGNS SHALL BE 48" x 48" MINIMUM.
9. ALL ADVANCE WARNING SIGNS NOT DIRECTLY APPLICABLE SHALL BE REMOVED, COMPLETELY COVERED OR TURNED AWAY FROM ONCOMING TRAFFIC.
10. ALL CONSTRUCTION SIGNING SHALL BE BLACK ON A REFLECTORIZED ORANGE FIELD UNLESS OTHERWISE SPECIFIED. ALL CONSTRUCTION BARRICADES AND CHANNELIZATION DEVICES SHALL BE ORANGE ON WHITE, REFLECTORIZED, UNLESS OTHERWISE SPECIFIED.
11. ALL SIGNS WILL BE GROUND MOUNTED ON SINGLE OR DOUBLE POSTS WITH THE BOTTOM OF THE SIGN (SEVEN) 7 FEET ABOVE SIDEWALK LEVEL. EXISTING POSTS MAY BE USED AT SOME LOCATIONS, WITH THE APPROVAL OF THE PROJECT ENGINEER. PORTABLE SIGNS SUPPORTS WILL BE ACCEPTABLE AS AN ALTERNATE FOR SIGNS WHICH ARE IN PLACE FOR LESS THAN ONE (1) WEEK.
12. ALL EXISTING REGULATORY SIGNS THAT NEED TO BE REMOVED, RE-LOCATED OR REINSTALLED SHALL BE DONE BY THE CITY OF ALBUQUERQUE, TRAFFIC ENGINEERING DIVISION. THE CONTRACTOR SHALL NOTIFY THE TRAFFIC ENGINEERING DIVISION (THREE) 3 WORKING DAYS IN ADVANCE OF ANY REQUIRED WORK.
13. TRAFFIC CONTROL DEVICES REQUIRED AFTER DARK ARE TO BE EQUIPPED WITH WARNING LIGHTS. TYPE (A) FLASHING WARNING LIGHTS SHALL BE USED ON ALL ADVANCE WARNING SIGNS AND ON ALL DEVICES WHICH ARE INTENDED TO WARN MOTORISTS OR PEDESTRIANS OF HAZARDS OR OBSTRUCTIONS IN OR NEAR THE TRAVEL PATH. TYPE (C) STEADY BURN LIGHTS SHALL BE USED ON ALL DEVICES WHICH ARE INTENDED TO DEFINE THE TRAVEL PATH.
14. ALL SIGNS, BARRICADES AND/OR BARRELS WILL BE REFLECTORIZED. ALL BARRELS MAY HAVE SAND OR WATER BALLAST LIMITED TO 100 LBS.
15. ALL SIGNS, BARRICADES AND/OR BARRELS WILL BE MOVED FORWARD AS THE CONSTRUCTION PROGRESSES (WHERE APPLICABLE).
16. CONTRACTOR SHALL INSPECT AND MAINTAIN ALL BARRICADES AT LEAST ONCE EACH DAY EXCEPT FOR BARRICADES ON OR ADJACENT TO ARTERIAL AND COLLECTOR STREETS WHICH SHALL BE CHECKED TWICE DAILY, INCLUDING INSPECTION DURING HOURS OF DARKNESS.
17. BARRELS AND BARRICADES ARE NOT TO BE INTERMIXED IN THE SAME SERIES OF CHANNELIZATION.
18. EXCAVATIONS MUST BE PLATED OR PATCHED PRIOR TO OPENING TO TRAFFIC.
19. A MINIMUM WIDTH OF 11 FEET SHALL BE PROVIDED FOR TRAFFIC IN ONE DIRECTION.
20. EQUIPMENT AND MATERIALS ARE NOT TO BE STORED WITHIN THE STREET RIGHT-OF-WAY DURING NON-WORKING HOURS.
21. THE CONTRACTOR SHALL MAINTAIN ACCESS TO BUSINESS AND RESIDENCES ADJACENT TO THE CONSTRUCTION AREA.
22. THE CONTRACTOR SHALL PROVIDE AND MAINTAIN A SAFE AND ADEQUATE MEANS OF CHANNELIZING PEDESTRIAN TRAFFIC AROUND ALL WORK AREAS THROUGHOUT THE PERIOD OF CONSTRUCTION. ALL SUCH CHANNELIZATION SHALL BE ARRANGED TO PREVENT PEDESTRIANS FROM HAVING TO ENTER THE ROADWAY IN ORDER TO PASS AROUND THE WORK AREAS.
23. THE CONTRACTOR SHALL BE REQUIRED TO KEEP THE PUBLIC INFORMED, THROUGH THE LOCAL NEWS MEDIA, OR CONSTRUCTION OPERATIONS INVOLVING STREET OR LANE CLOSURES, AND SHALL PROVIDE THE CITY TRAFFIC ENGINEER DOCUMENTED PROOF THAT THIS HAS BEEN DONE.
24. ALL SIGNS SHALL BE MOUNTED ON SIGN POSTS, PORTABLE SIGN SUPPORTS OR TYPE III BARRICADES.
25. THE CONTRACTOR SHALL BE RESPONSIBLE FOR CONSTRUCTING AND INSTALLING "IMPENDING CONSTRUCTION" SIGNS, SUBSEQUENT TO THE AWARD OF THE CONTRACT, AND NO LESS THAN SEVEN (7) DAYS PRIOR TO THE FIRST DAY OF EXPECTED CONSTRUCTION WORK. (SEE SPECIAL PROVISIONS, SECTION 3A, OF THE PROJECT SPECIFICATIONS.)

SUMMARY OF QUANTITIES.

[illegible]

26. CONTRACTOR SHALL CONSTRUCT A TEMPORARY 24' WIDE ROAD TO THE EAST OF THE PRESENT ROAD USING NEWLY OBTAINED RIGHT-OF-WAY AND CONSTRUCTION EASEMENT IN SUCH A WAY THAT TWO-WAY TRAFFIC MAY BE MAINTAINED ON THE ROAD DURING THE INSTALLATION OF THE SEWER LINE. DRAINAGE STRUCTURES AT STATIONS SHALL BE EXTENDED USING PIPE OF THE SAME DRAINAGE AS EXISTING PIPE. THE PIPE SHALL BE FURNISHED BY THE CONTRACTOR AND REMAINS HIS PROPERTY AFTER REMOVAL. THIS WORK SHALL BE INCIDENTAL TO CONSTRUCTION OF THE SEWER LINE.
27. WHENEVER THE TEMPORARY ROAD SHIFTS TO AN AREA WHERE PAVEMENT HAS BEEN REMOVED, TEMPORARY PAVEMENT OR PERMANENT PAVEMENT SHALL BE PLACED BEFORE TRAFFIC IS TRANSFERRED.

PLANS PREPARED
UNDER THE DIRECTION OF



William I. Matotian 1/4/1965
WILLIAM I. MATOTIAN DATE

APPROVED FOR
CONSTRUCTION

CITY ENGINEER DATE

CITY OF ALBUQUERQUE
DEPARTMENT OF TRANSPORTATION

TITLE: YALE BOULEVARD WIDENING
STADIUM BLVD. TO GIBSON BLVD.

TRAFFIC CONTROL - SUMMARY OF QUANTITIES

APPROVALS	ENGINEER	DATE	APPROVALS	ENGINEER	DATE
City Engineer			Liquid Waste	<i>R. Piza</i>	1/16/65
A.C.E. - Design	<i>W.C. Lee</i>	1/14/65	Traffic	<i>W.C. Lee</i>	1-21-65
A.C.E. - Hydrology	<i>Don Hays</i>	1/14/65	Water	<i>R. Piza</i>	1/16/65

DRAWING NO. 1960

MAP NO. L-154-L-16

SHEET 4-11 OF

OF

RECORD DRAWING
Drawings revised to reflect the
best information available. Do
not use without field verification