

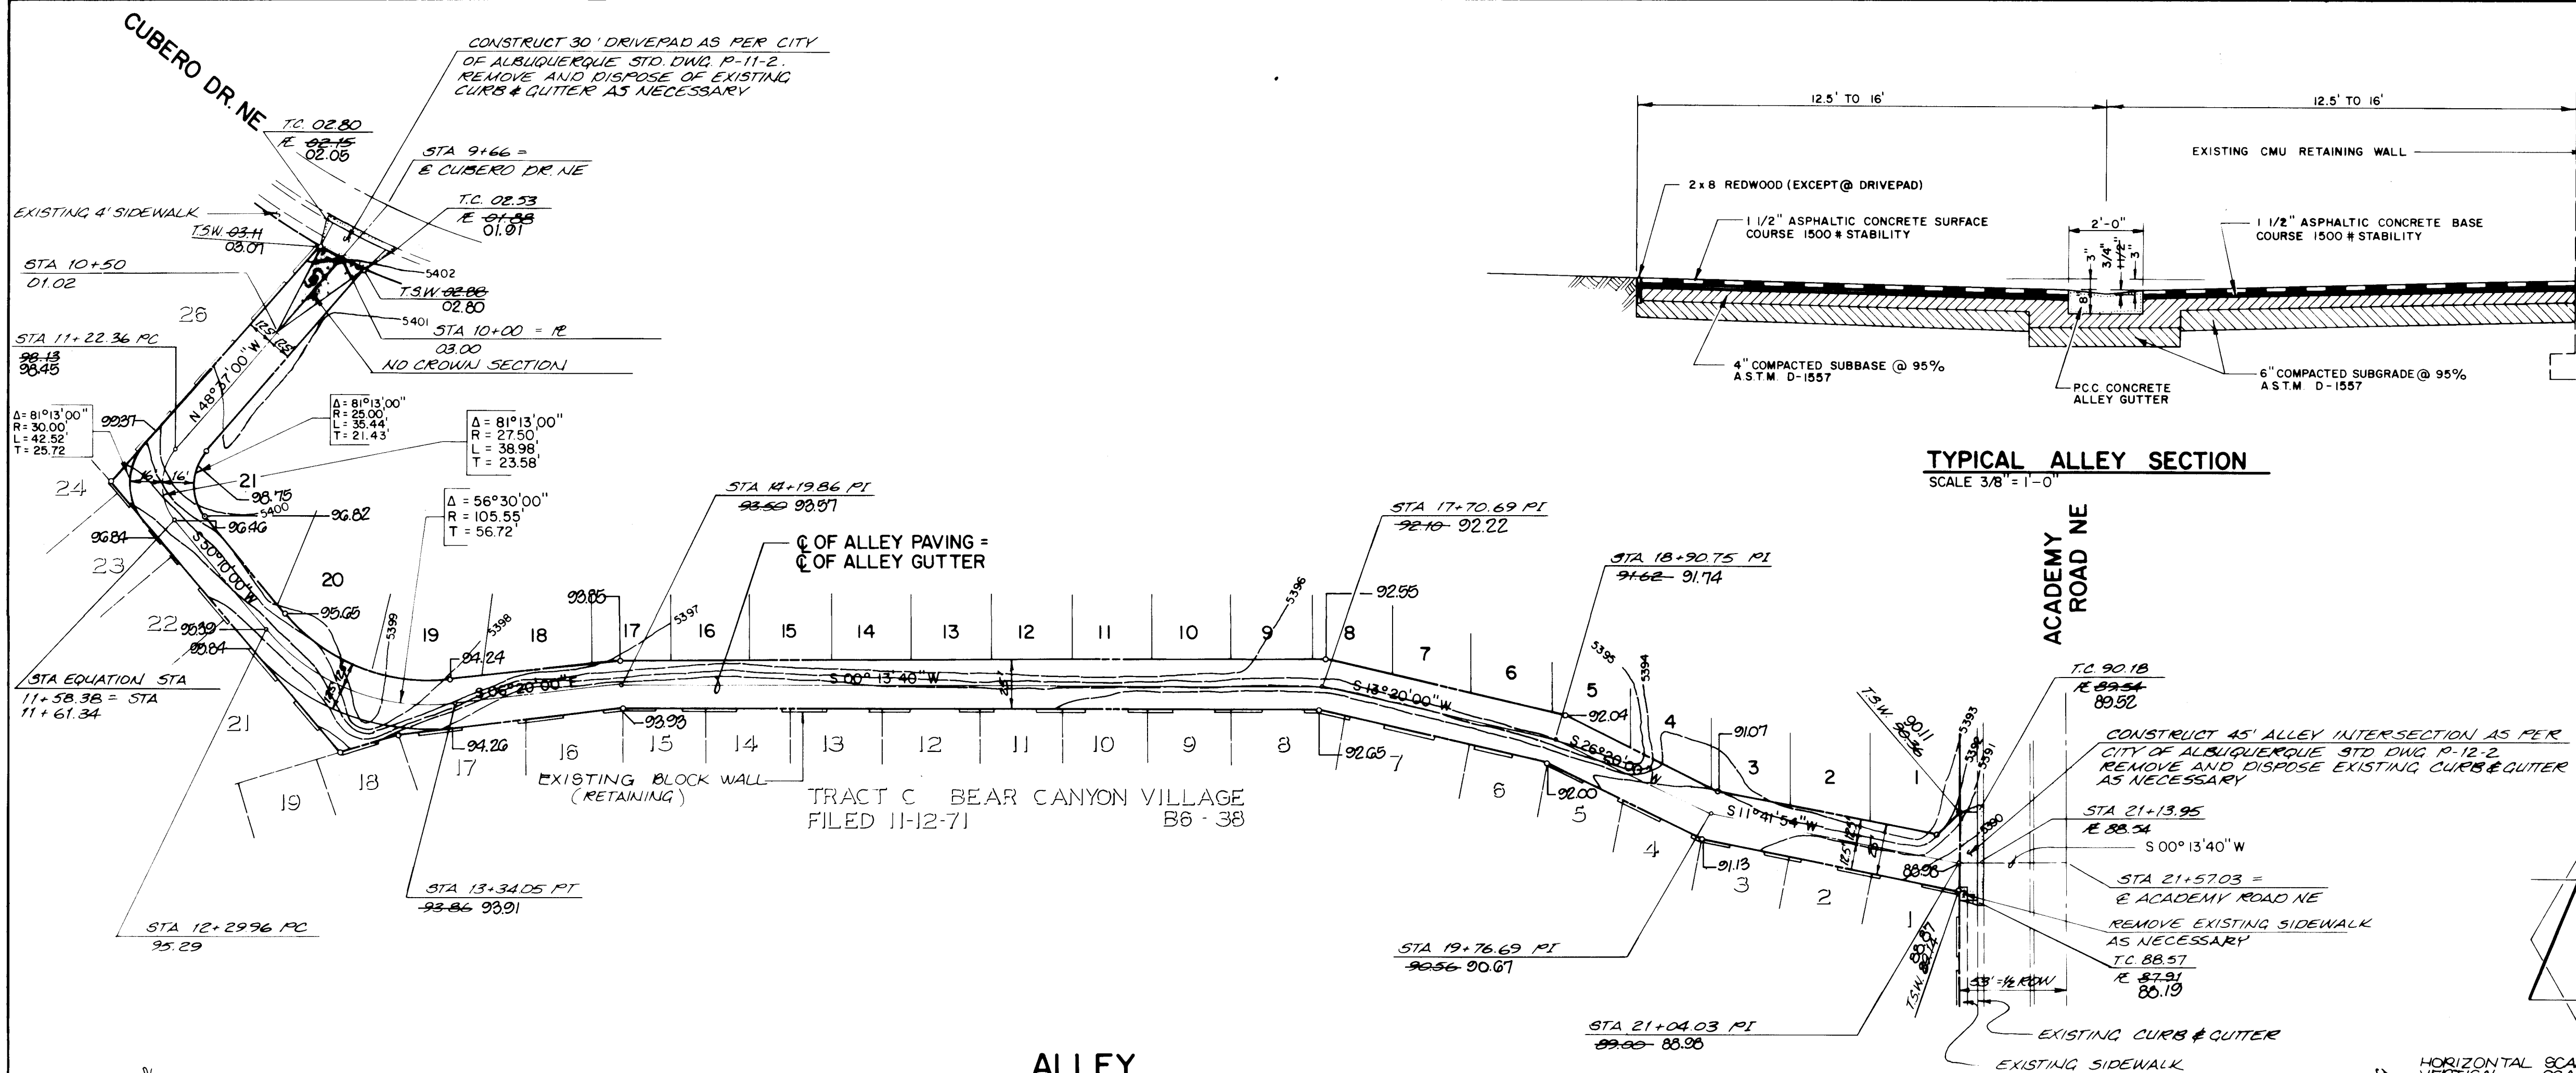
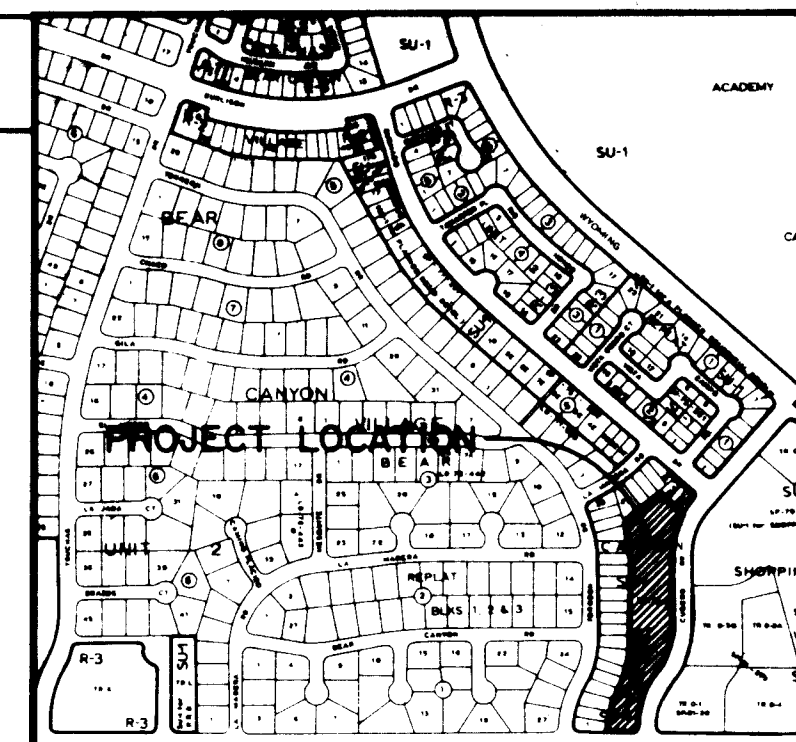


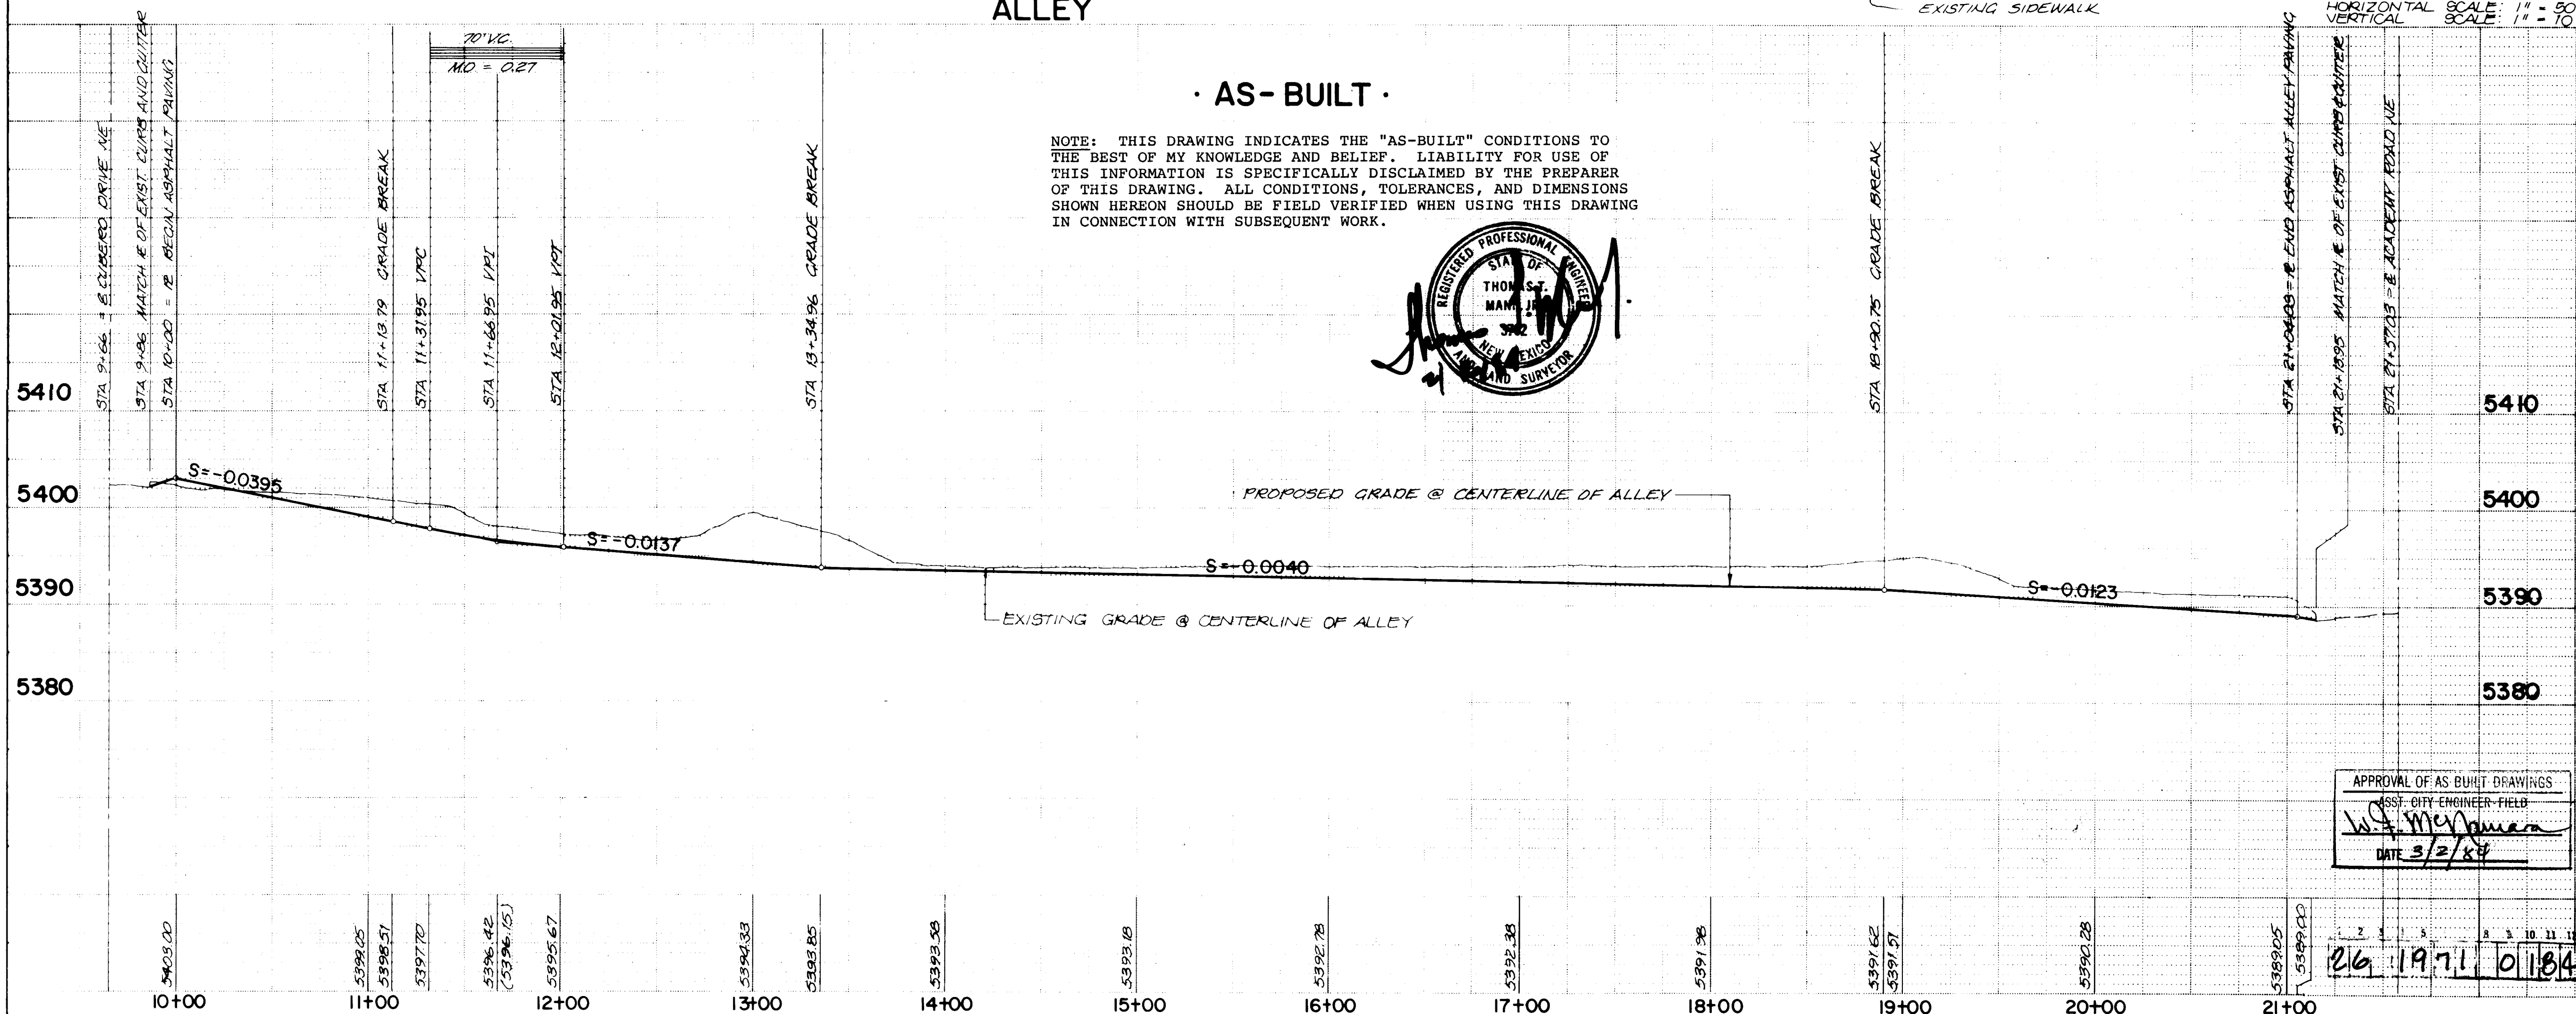

ALLEY

AS-BUILT

NOTE: THIS DRAWING INDICATES THE "AS-BUILT" CONDITIONS TO THE BEST OF MY KNOWLEDGE AND BELIEF. LIABILITY FOR USE OF THIS INFORMATION IS SPECIFICALLY DISCLAIMED BY THE PREPARER OF THIS DRAWING. ALL CONDITIONS, TOLERANCES, AND DIMENSIONS SHOWN HEREON SHOULD BE FIELD VERIFIED WHEN USING THIS DRAWING IN CONNECTION WITH SUBSEQUENT WORK.

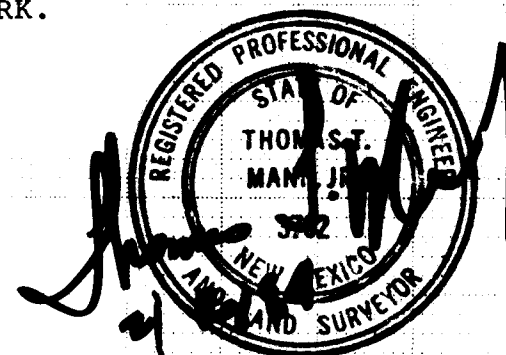


VICINITY MAP

E-19

GENERAL NOTES

- All work detailed on these plans to be performed under contract shall, except otherwise stated or provided for hereon, be constructed in accordance with the New Mexico Standard Specifications for Public Works Construction - 1979 Edition (referred to herein as the Standard Specifications) and the City of Albuquerque Contract Documents for City-Wide Utilities and Cash Paving No. 31.
- Two (2) working days prior to any excavation, Contractor must contact line locating service, 765-1234, for location of existing utilities.
- Prior to construction, the Contractor shall excavate and verify the horizontal and vertical locations of all potential obstructions. Should a conflict exist, the Contractor shall notify the Engineer so that the conflict can be resolved with a minimum amount of delay.
- The Contractor shall maintain access to adjacent properties during construction.
- All work on this project shall be performed in accordance with applicable federal, state, and local laws, rules and regulations concerning construction safety and health.
- The contractor must submit a construction signing and barricading plan to Traffic Engineering to receive a barricading permit prior to construction.
- Backfill compaction shall be according to specified street use.
- Contractor shall take necessary precautions to protect existing retaining wall during construction.

ENGINEER'S SEAL

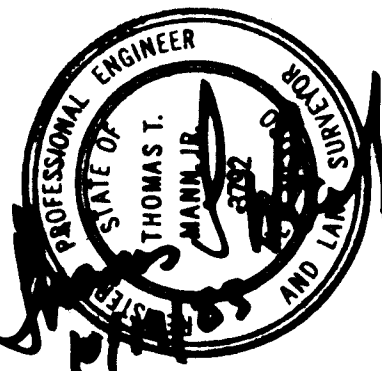

BY

REMARKS

NO. DATE

CITY OF ALBUQUERQUE
MUNICIPAL DEVELOPMENT DEPARTMENT
ENGINEERING DIVISION



TITLE: BEAR CANYON ESTATES
ALLEY PLAN & PROFILE

APPROVALS	ENGINEER	DATE	APPROVALS	ENGINEER	DATE
City Engineer	[Signature]	12/30/87	Liquid Waste	NA	12/7/87
ACE - Design	[Signature]	12/30/87	Traffic	7W	12/14/87
ACE - Hydrology	[Signature]	12/15/87	Water	NA	12/7/87

DRAWING NO. 1971 MAP NO. E-19 SHEET 1 OF 1

FINAL SURVEY NOTE BOOK	NO. _____		AREAS CHECKED _____		BY _____	DATE _____
	SURVEYED _____		PLOTTED _____			
	TEMPLATE _____		AREAS _____			
	AREAS _____		CHECKED _____			
	CHECKED _____		_____			

ORIGINAL					
SURVEY	SURVEYED	BY	DATE		
NOTE BOOK	PLOTTED				
	TEMPLATE				
	AREAS				
	AREAS CHECKED				
NO.					

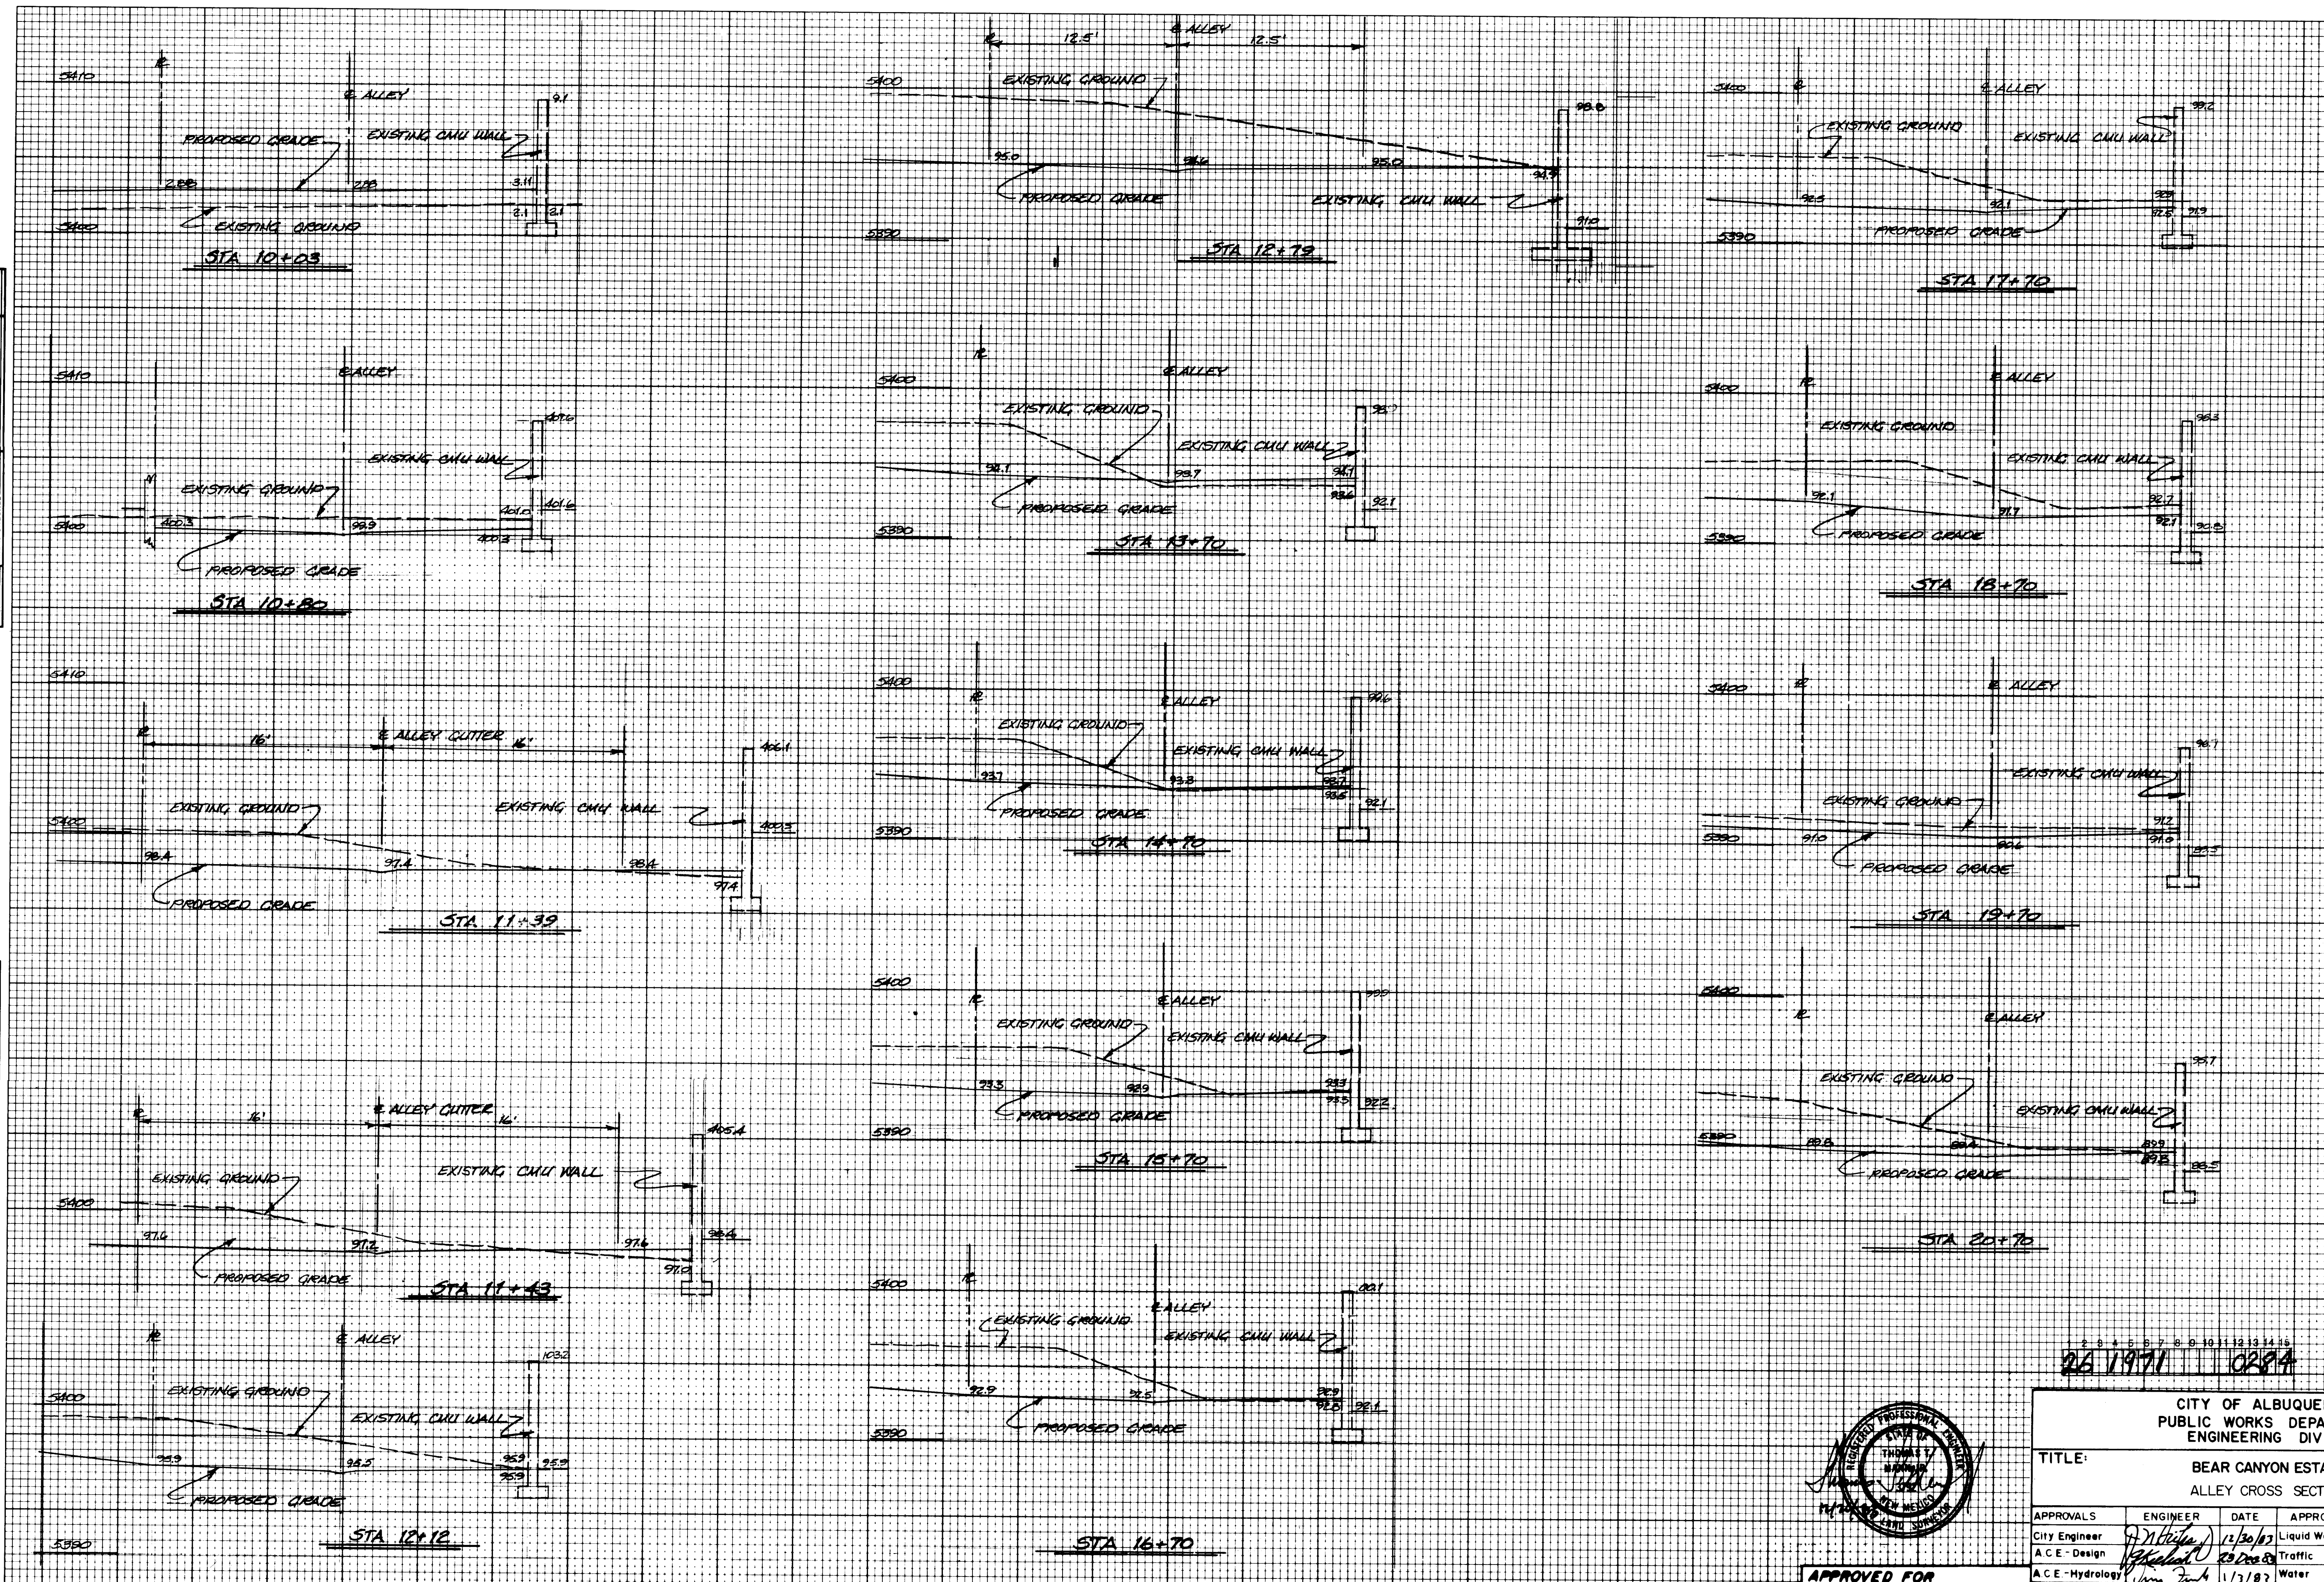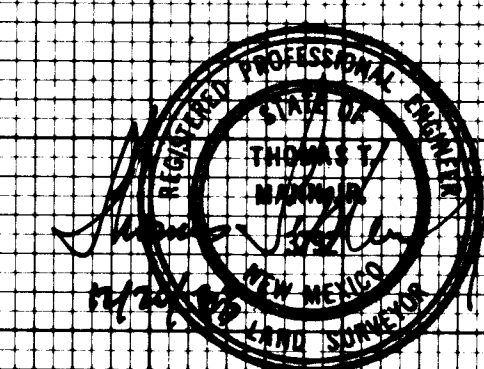[illegible]

APPROVED FOR
CONSTRUCTION
C. N. Hayward
CITY ENGINEER

CITY OF ALBUQUERQUE PUBLIC WORKS DEPARTMENT ENGINEERING DIVISION					
TITLE: BEAR CANYON ESTATES ALLEY CROSS SECTIONS					
APPROVALS	ENGINEER	DATE	APPROVALS	ENGINEER	DATE
City Engineer	<i>[Signature]</i>	12/30/82	Liquid Waste		
A C E - Design	<i>[Signature]</i>	23 Dec 82	Traffic	<i>T.W. Haines</i>	12/30/82
A C E - Hydrology	<i>[Signature]</i>	1/7/83	Water		
DRAWING NO.		MAP NO.		SHEET OF	
1971		E-19		2 2	