


SITE IMPROVEMENTS

IN  
LA CUESTA SUBDIVISION  
SECURITY VILLAGE

WATER , SANITARY SEWER  
and STORM DRAINAGE  
CITY OF ALBUQUERQUE,  
NEW MEXICO

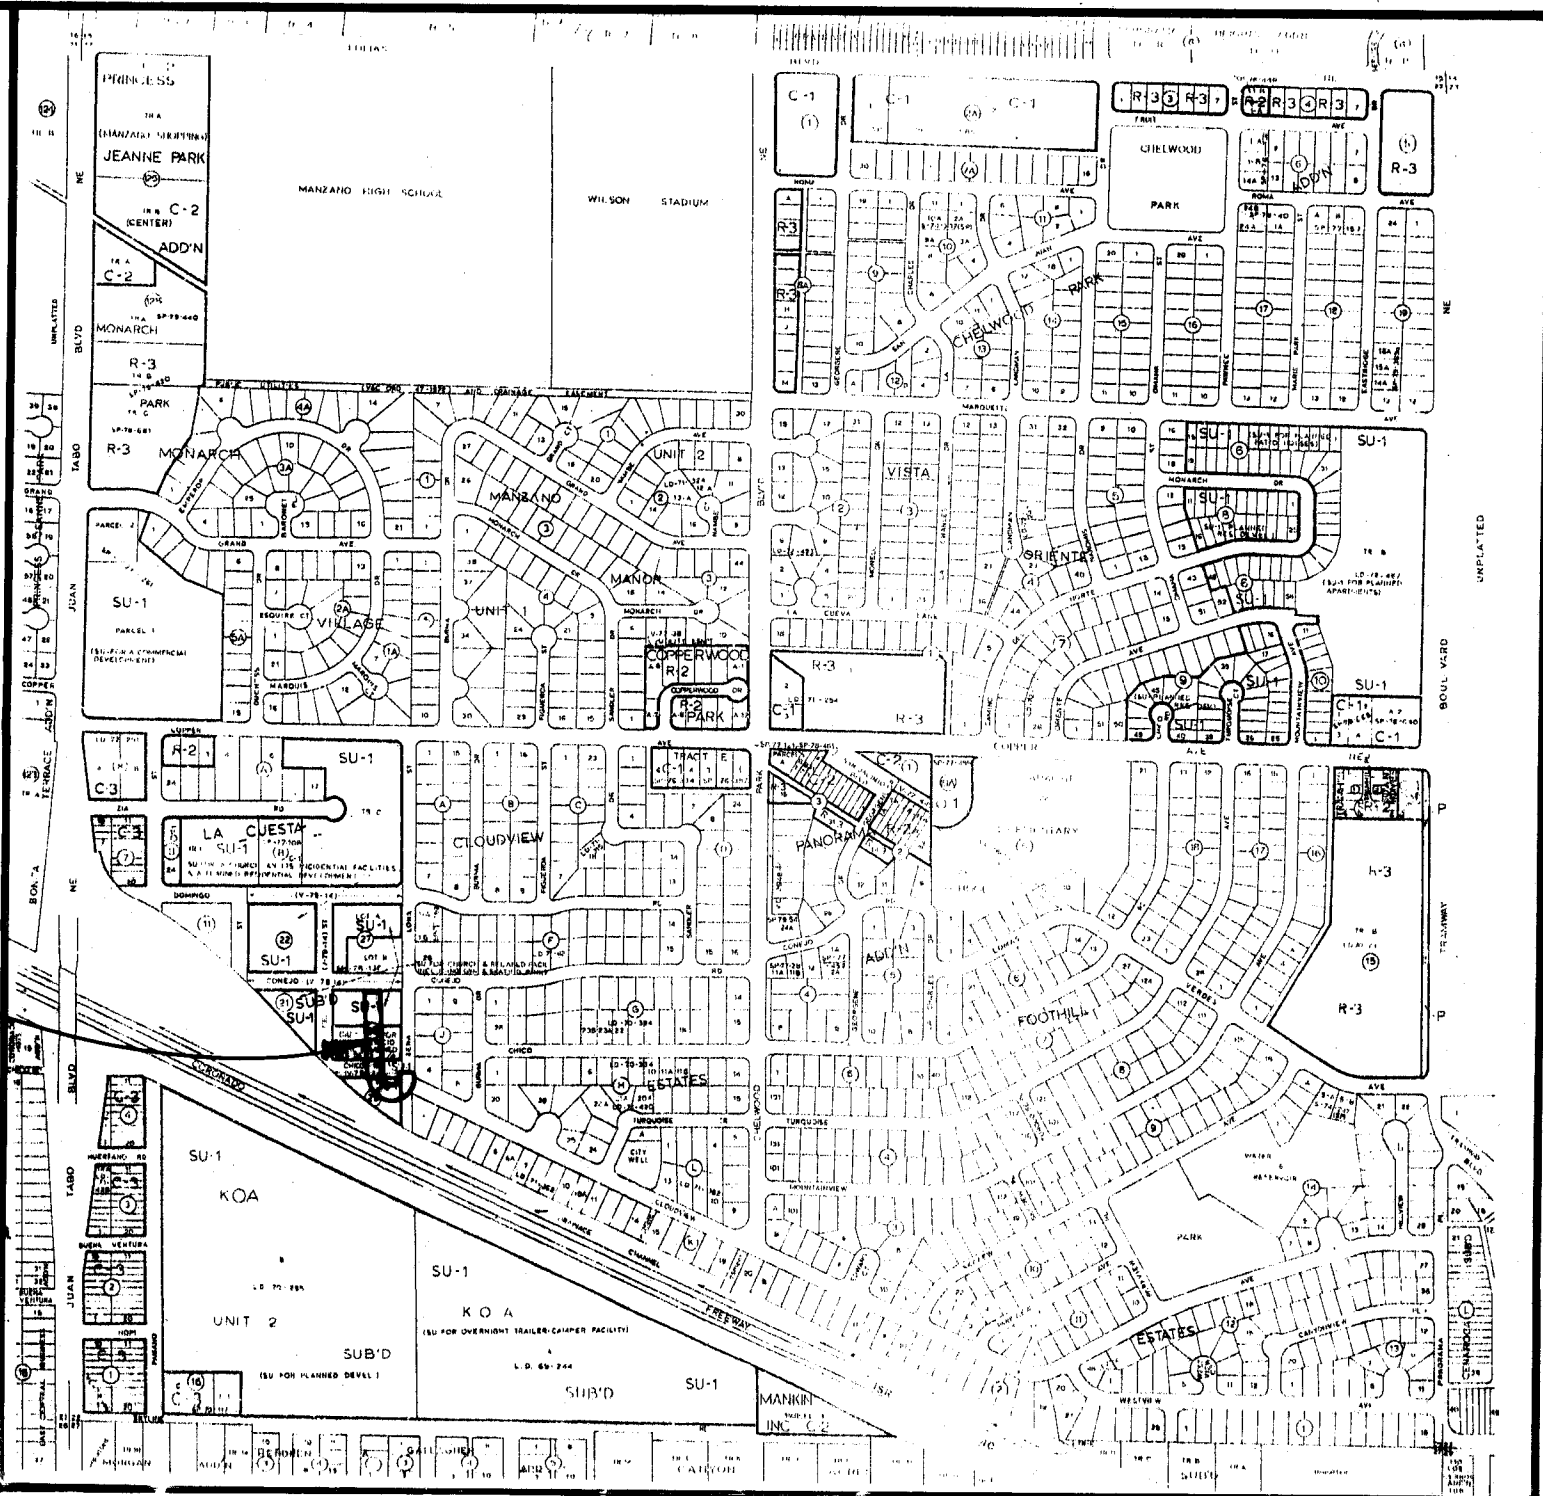

INDEX

|                       |   |
|-----------------------|---|
| COVER SHEET.....      | 1 |
| PLAT.....             | 2 |
| SECURITY VILLAGE..... | 3 |

APPROVAL OF AS BUILT DRAWINGS  
ASST. CITY ENGINEER - FIELD  
*W. J. Borden*  
DATE 5/11/84

26 1972 0184

|                       |        |               |      |      |       |      |      |       |      |
|-----------------------|--------|---------------|------|------|-------|------|------|-------|------|
| REV.                  | SHEETS | CITY ENGINEER | DATE | USER | DEPT. | DATE | USER | DEPT. | DATE |
| APPROVAL OF REVISIONS |        |               |      |      |       |      |      |       |      |




DMJM /  
ADAM, HAMLYN, ANDERSON  
consulting engineers inc.  
4055 MONTGOMERY BOULEVARD, N.E.  
ALBUQUERQUE, NEW MEXICO 87109  
505-951-1808

APPROVED FOR  
CONSTRUCTION

*W. J. Borden* C.E.  
1/10/84

1972

SHEET 1 OF 3

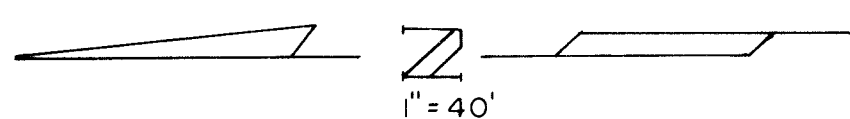


ZENA LONA STREET NE

83 84652

LOTS 1 THRU 18  
SECURITY VILLAGE  
BEING A REPLAT OF  
TRACT D  
LA CUESTA SUBDIVISION  
BERNALILLO COUNTY NEW MEXICO  
JUNE 1983

STATE OF NEW MEXICO )  
COUNTY OF BERNALILLO )  
I, DOLORES C. WALLACE, Clerk & Recorder  
DO NOTS. C. WALLACE, Clerk & Recorder  
JUNE 1983


TRACT C  
LA CUESTA SUBDIVISION  
FILED 4/20/1983  
CIS-45

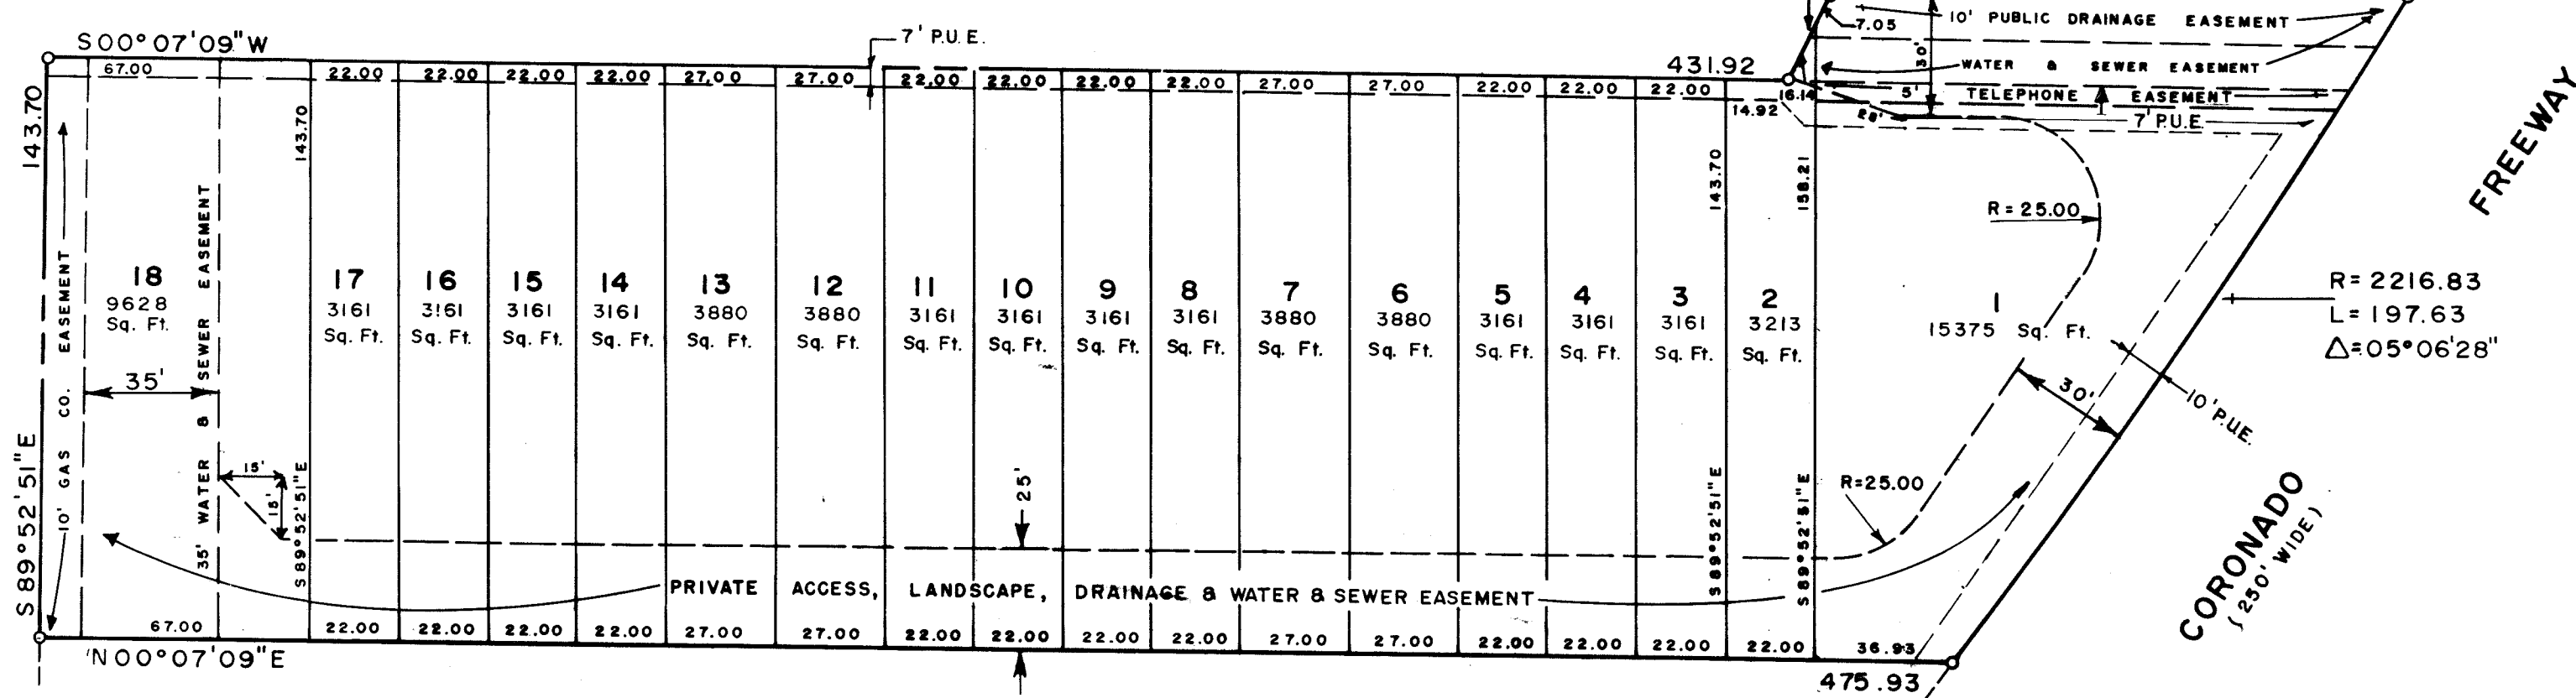

TRACT B  
LANDS OF R.D. & M.J.  
FILED 5/14/1979  
CIS-27

NOTES:

- 1) NO STREETS ARE CREATED BY THIS PLAT.
- 2) TOTAL ACREAGE OF SUBDIVISION: 1.8024.
- 3) NUMBER OF LOTS CREATED: 18.
- 4) THIS PLAT WAS COMPILED FROM A PLAT ENTITLED, "TRACTS A THRU D AND F THRU K AND LOTS 5-A, 6-A, 19-A & 20-A LA CUESTA SUBDIVISION, ALBUQUERQUE, NEW MEXICO" AND NO FIELD WORK WAS DONE AT THIS TIME.
- 5) BEARINGS SHOWN HEREON ARE BASED ON THE ABOVE MENTIONED PLAT.

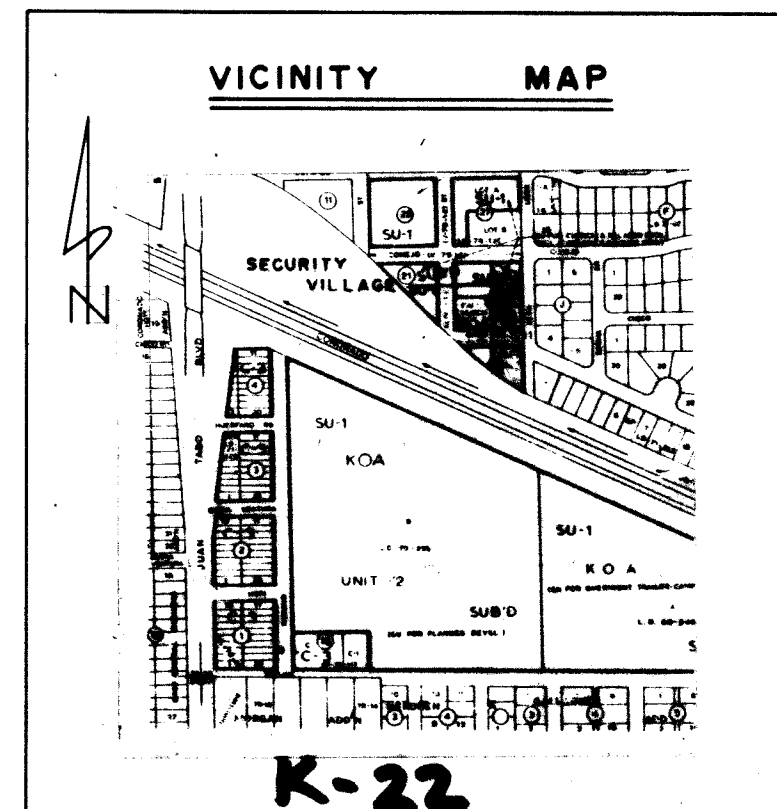

SHEET 1 OF 2

APPROVALS

Hansen 8/17/83  
PROPERTY MANAGEMENT, CITY OF ALBUQUERQUE, NEW MEXICO

Joe J. Jarama 8-30-83  
CITY ENGINEER, CITY OF ALBUQUERQUE, NEW MEXICO

Paul A. Jarama 8-30-83  
TRAFFIC ENGINEER, CITY OF ALBUQUERQUE, NEW MEXICO

Walt J. Jarama 8-30-83  
PARKS & RECREATION DEPT., CITY OF ALBUQUERQUE, NEW MEXICO

Alfred J. Jarama 8/27/83  
CHIEF SURVEYOR, CITY OF ALBUQUERQUE, NEW MEXICO

Alfred J. Jarama 8/27/83  
WATER RESOURCES DEPT., CITY OF ALBUQUERQUE, NEW MEXICO

Prof. J. Jarama 12/1/83  
A.M.A.P.C.A.L.


Frank J. Jarama 8-5-83  
BONHAIN BELL TELEPHONE CO.

Donny Handman 8-25-83  
PUBLIC SERVICE COMPANY OF NEW MEXICO

Donny Handman 8-11-83  
GAS COMPANY OF NEW MEXICO

Eugene Thayer 12-8-83  
PLANNING DEPT., CITY OF ALBUQUERQUE, NEW MEXICO

ZONE ATLAS NO. 1  
PLAT NO. **SP-93-373**  
APPROVED

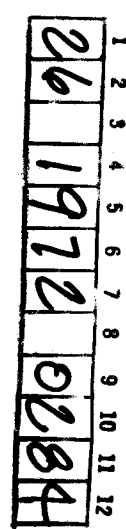

Sheet 2 of 3

83 84652

LOTS 1 THRU 18  
SECURITY VILLAGE  
BEING A REPLAT OF  
TRACT D  
LA CUESTA SUBDIVISION  
BERNALILLO COUNTY NEW MEXICO  
JUNE 1983

STATE OF NEW MEXICO )  
COUNTY OF BERNALILLO )  
I, DOLORES C. WALLACE, Clerk & Recorder  
DO NOTS. C. WALLACE, Clerk & Recorder  
JUNE 1983

LEGAL DESCRIPTION

A CERTAIN PARCEL OF LAND BEING IDENTIFIED AS TRACT D, AS THE SAME IS SHOWN AND DESIGNATED ON THE PLAT ENTITLED "TRACTS A THRU D AND F THRU K, AND LOTS 5-A, 6-A, 19-A, AND 20-A, LA CUESTA SUBDIVISION, ALBUQUERQUE, NEW MEXICO" FILED IN THE OFFICE OF THE COUNTY CLERK OF BERNALILLO COUNTY, NEW MEXICO ON APRIL 20, 1983.

FREE CONSENT


SURVEYED, SUBDIVIDED AND REPLATTED AND NOW COMPRISING LOTS 1 THRU 18, OF SECURITY VILLAGE WITH THE FREE CONSENT AND IN ACCORDANCE WITH THE WISHES AND DESIRES OF THE UNDERSIGNED OWNERS AND PROPRIETORS THEREOF, SAID OWNERS DO HEREBY DEDICATE THE EASEMENTS AS SHOWN HEREON. POWER AND COMMUNICATION EASEMENTS ARE RESERVED WHERE SHOWN BY DASHED LINES AS NOTED, INCLUDING THE RIGHT OF INGRESS AND EGRESS AND THE RIGHT TO TRIM INTERFERING TREES. ALSO INCLUDED ARE EASEMENTS FOR POWER AND COMMUNICATION SERVICE LINES.

RONALD D. MCCONNELL

MARJORIE J. MCCONNELL

STATE OF NEW MEXICO )  
COUNTY OF BERNALILLO )

ON THIS 8 DAY OF August, 1983 THE FOREGOING INSTRUMENT WAS ACKNOWLEDGED BY RONALD D. MCCONNELL & MARJORIE J. MCCONNELL.

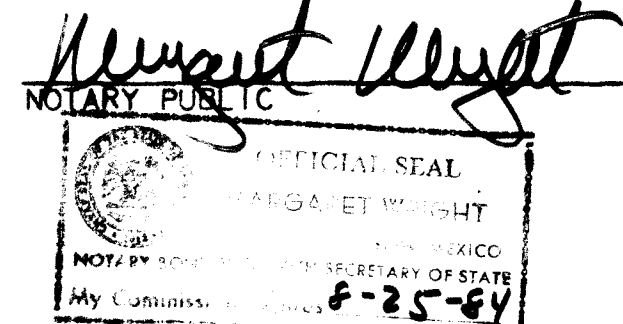

MY COMMISSION EXPIRES 8-25-84

I, RONALD A. FORSTBAUER, REGISTERED NEW MEXICO LAND SURVEYOR NUMBER 6126, DO HEREBY CERTIFY THAT THE PLAT SHOWN HEREON WAS PREPARED BY ME OR UNDER MY DIRECT SUPERVISION FROM A FIELD SURVEY AND THAT THIS PLAT MEETS THE MINIMUM REQUIREMENTS OF THE ALBUQUERQUE SUBDIVISION ORDINANCE AND SHOWS EASEMENTS OF RECORD AS THEY APPEAR ON THE PLAT ENTITLED "TRACTS A THRU D AND F THRU K AND LOTS 5-A, 6-A, 19-A & 20-A, LA CUESTA SUBDIVISION" FILED ON APRIL 20, 1983, AND THAT THE INFORMATION SHOWN HEREON IS TRUE AND CORRECT TO THE BEST OF MY KNOWLEDGE AND BELIEF.

Ronald A. Forstbauer  
RONALD A. FORSTBAUER  
N.M.L.S. NO. 6126

SHEET 2 OF 2

3 OF 3