


CONSTRUCTION PLANS
FOR
GRANT LINE CHANNEL LINING

CONCRETE STORM DRAINAGE CHANNEL

INDEX TO DRAWINGS

- 1. TITLE SHEET
- 2. CHANNEL PLAN & PROFILE
- 3. CHANNEL PLAN & PROFILE
- 4. CHANNEL PLAN & PROFILE
- 5. SECTIONS & DETAILS
- 6. SECTIONS & DETAILS

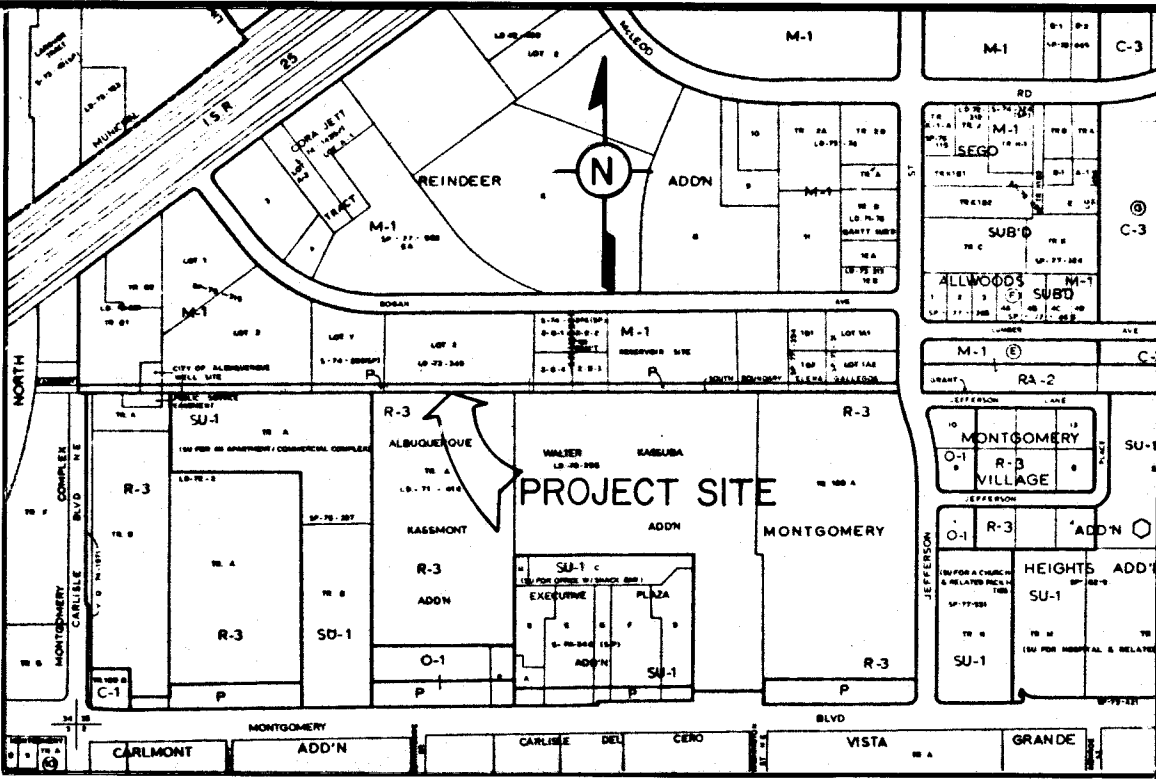

VICINITY MAP (F-17)
Scale: 1" = 750' approx.

- 1. All work detailed on these plans to be performed under contract shall, except as otherwise stated or provided for hereon, be constructed in accordance with the City of Albuquerque Interim Standard Specifications for Public Works Construction - 1985 (referred to herein as the Standard Specifications) and the Contract Documents for City-wide Utilities and Public Works Contract 85-4
- 2. Two (2) working days prior to any excavation, contractor must contact Line Locating Service, 765-1234, for location of existing utilities.
- 3. Prior to construction, the contractor shall excavate and verify the horizontal and vertical locations of all obstructions. Should a conflict exist, the contractor shall notify the engineer or surveyor so that the conflict can be resolved with minimum amount of delay.
- 4. All storm drainage facilities shall be completed prior to final acceptance.


26 19880186

APPROVAL OF ARCHITECT
W. J. McQuinn
3-4-86

REV	SHEETS	CITY ENGR	DATE	USER	DEPT	DATE	USER	DEPT	DATE
Δ	5,6		8/12/85						
Δ	2		7/10/85						
Δ	2,5		8/26/85						

APPROVAL OF REVISIONS

	MSM MSM/SP Group 2601 WYOMING BLVD., NE ALBUQUERQUE, NM 87112 (505) 292-1936	APPROVED FOR CONSTRUCTION 7/11/85
1988		SHEET 1 OF 6

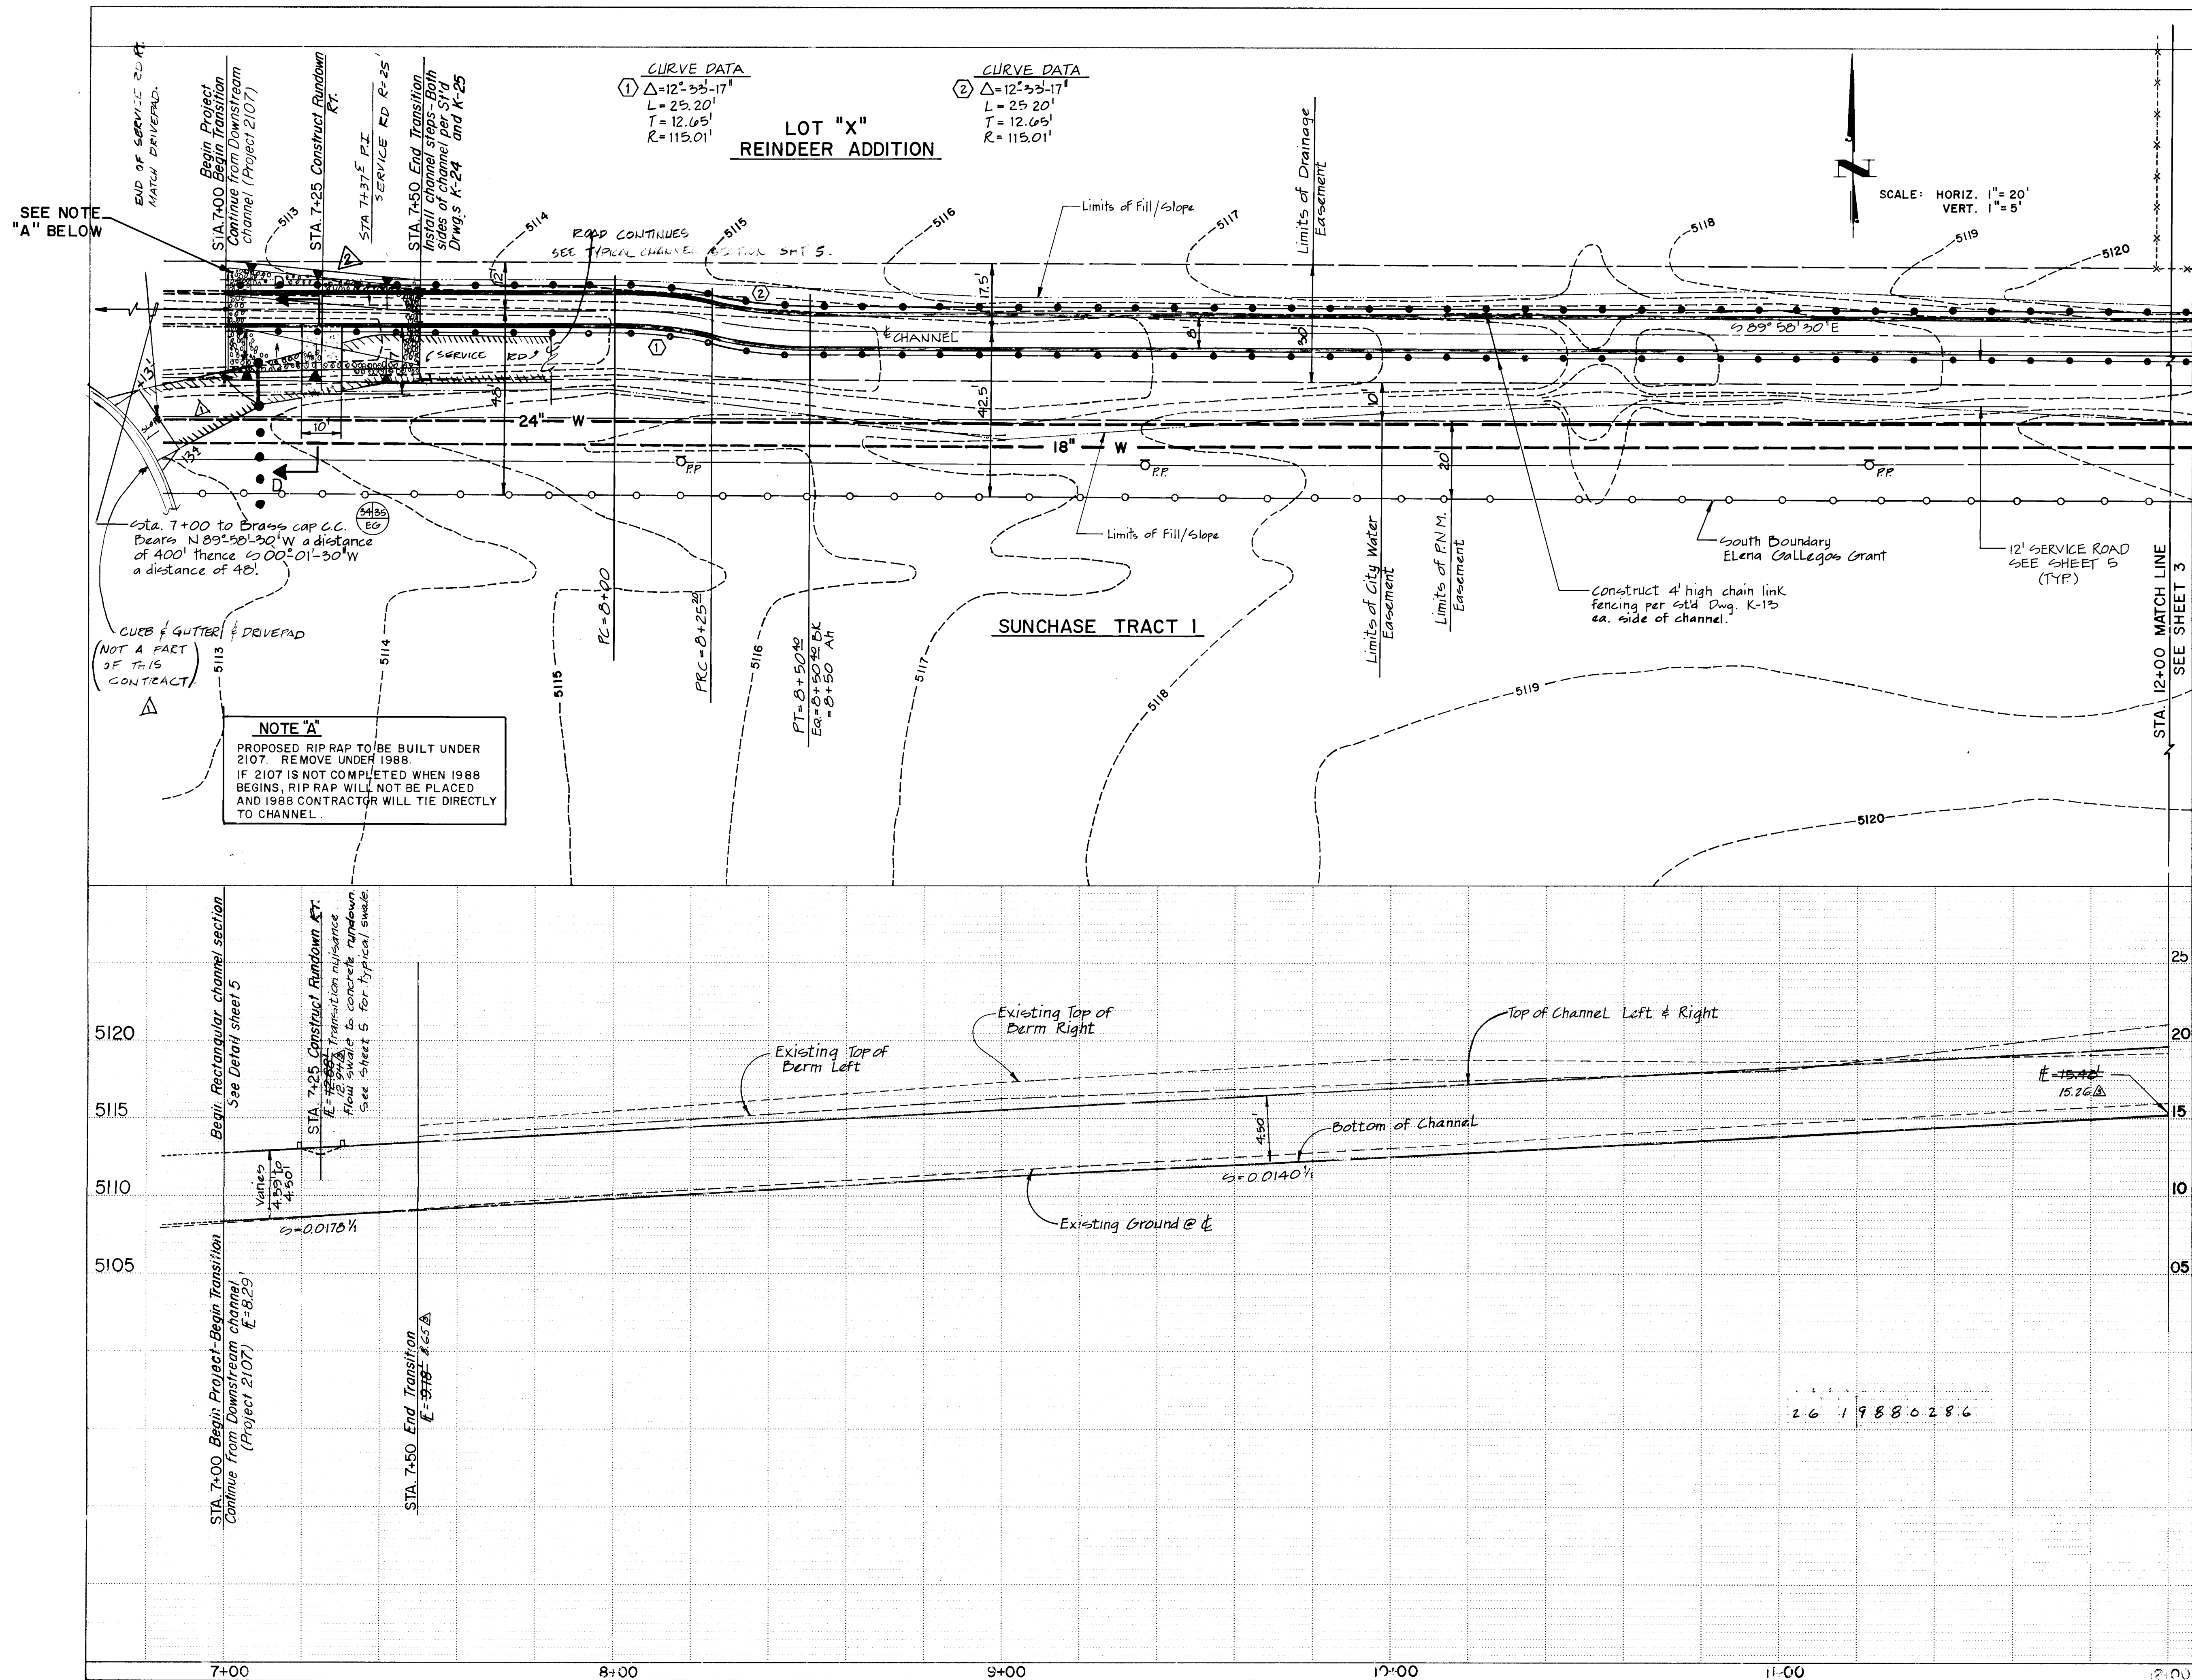


AS BUILT INFORMATION			
DATE	BY	REMARKS	DATE
7/18/84	E. Molina	City Engineer	7/18/84
8/5/84	N. D. H.	A.C.E. - Design	7/18/84
7/18/84	K. L. G.	A.C.E. - Hydrology	7/18/84

ENGINEER'S SEAL			
EX	DE	BY	DATE
			7/18/84
			7/18/84
			7/18/84

REVISIONS			
NO.	DATE	REVISIONS	DESIGN
1	7/18/84	Original Design	
2	8/5/84	Revised Design	
3	7/18/84	Final Design	

CITY OF ALBUQUERQUE MUNICIPAL DEVELOPMENT DEPARTMENT ENGINEERING DIVISION					
TITLE: GRANT LINE CHANNEL LINING PLAN AND PROFILE					
APPROVALS	ENGINEER	DATE	APPROVALS		
City Engineer	E. Molina	7/18/84	City Engineer	E. Molina	7/18/84
A.C.E. - Design	N. D. H.	8/5/84	A.C.E. - Design	N. D. H.	7/18/84
A.C.E. - Hydrology	K. L. G.	7/18/84	A.C.E. - Hydrology	K. L. G.	7/18/84

DRAWING NO. 1988			
MAP NO. F-17			
SHEET 2 OF 6			

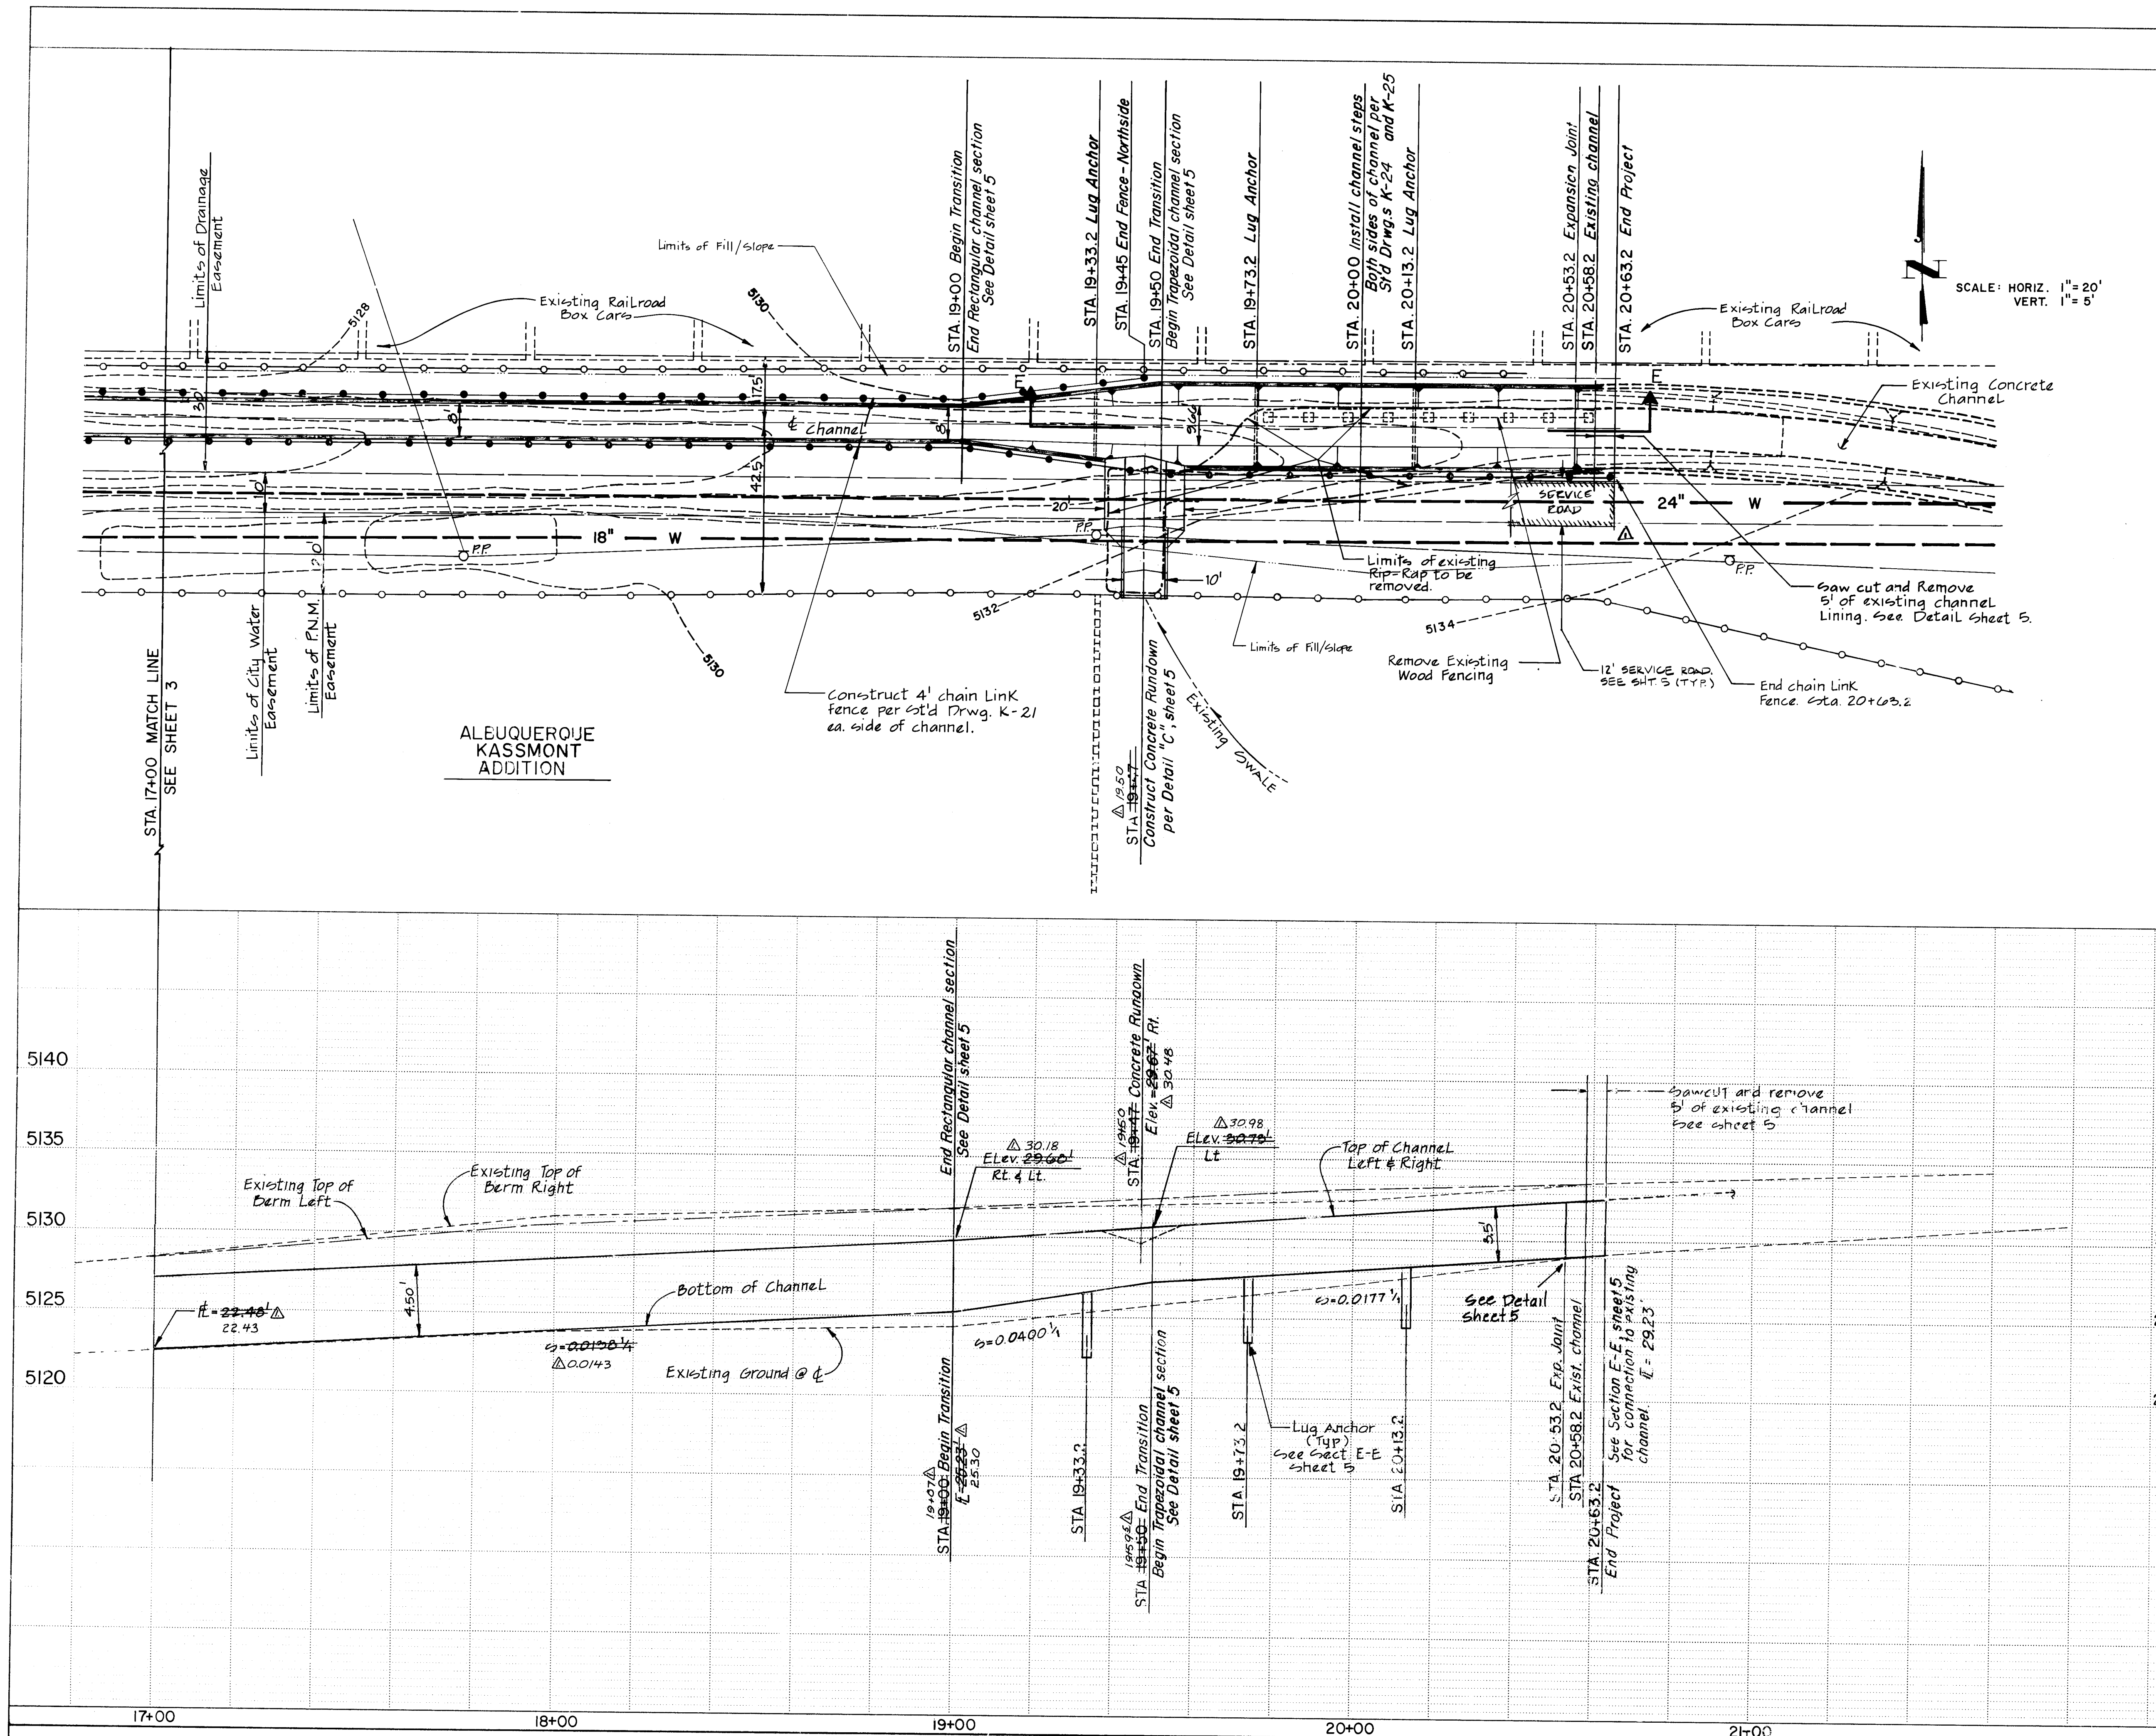

AS BUILT INFORMATION

DATE: 7/18/84
 DRAWN BY: E. Molina
 CHECKED BY: M. Holstad

ENGINEER'S SEAL

[Signature]

LEGEND

- Existing telephone box
- Existing tree
- Existing power pole w/anchor
- Existing water line
- Existing channel side slope
- Existing contour
- Existing chain link fence
- Existing curb and gutter
- Rectangular channel
- Channel side slope
- Curb and gutter
- New chain link fence

REVISIONS

NO.	DATE	REMARKS
1	7/18/84	DESIGN

CITY OF ALBUQUERQUE
 MUNICIPAL DEVELOPMENT DEPARTMENT
 ENGINEERING DIVISION

**TITLE: GRANT LINE CHANNEL LINING
 PLAN AND PROFILE**

APPROVALS

City Engineer: *[Signature]*
 A.C.E. Design: *[Signature]*
 A.C.E. Hydrology: *[Signature]*


APPROVALS

Liquid Waste: *[Signature]*
 Traffic: *[Signature]*
 Water: *[Signature]*

DRAWING NO. **1988**

MAP NO. **F-17**

SHEET **4** OF **6**

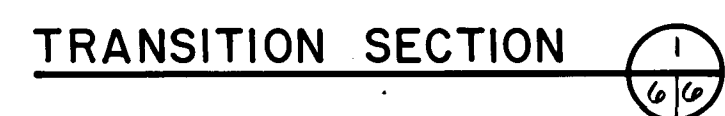

CITY OF ALBUQUERQUE
MUNICIPAL DEVELOPMENT DEPARTMENT
ENGINEERING DIVISION

TITLE:	GRANT LINE CHANNEL LINING SECTIONS AND DETAILS
--------	---

APPROVALS	ENGINEER	DATE	APPROVALS	ENGINEER	DATE
City Engineer	<i>Ed H</i>	<i>7/18/84</i>	Liquid Waste	<i>R. Perna</i>	<i>7/18/84</i>
A.C.E. Design	<i>J. L. Perna</i>	<i>8/5/84</i>	Traffic	<i>N. D. W. H.</i>	<i>7/18/84</i>
A.C.E. - Hydrology	<i>Paul H.</i>	<i>7/18/84</i>	Water	<i>R. Perna</i>	<i>7/18/84</i>

DRAWING NO.	1988	MAP NO.	F-17	SHEET	6	OF	6
-------------	------	---------	------	-------	---	----	---