


SCANNED
BY *CAJON*

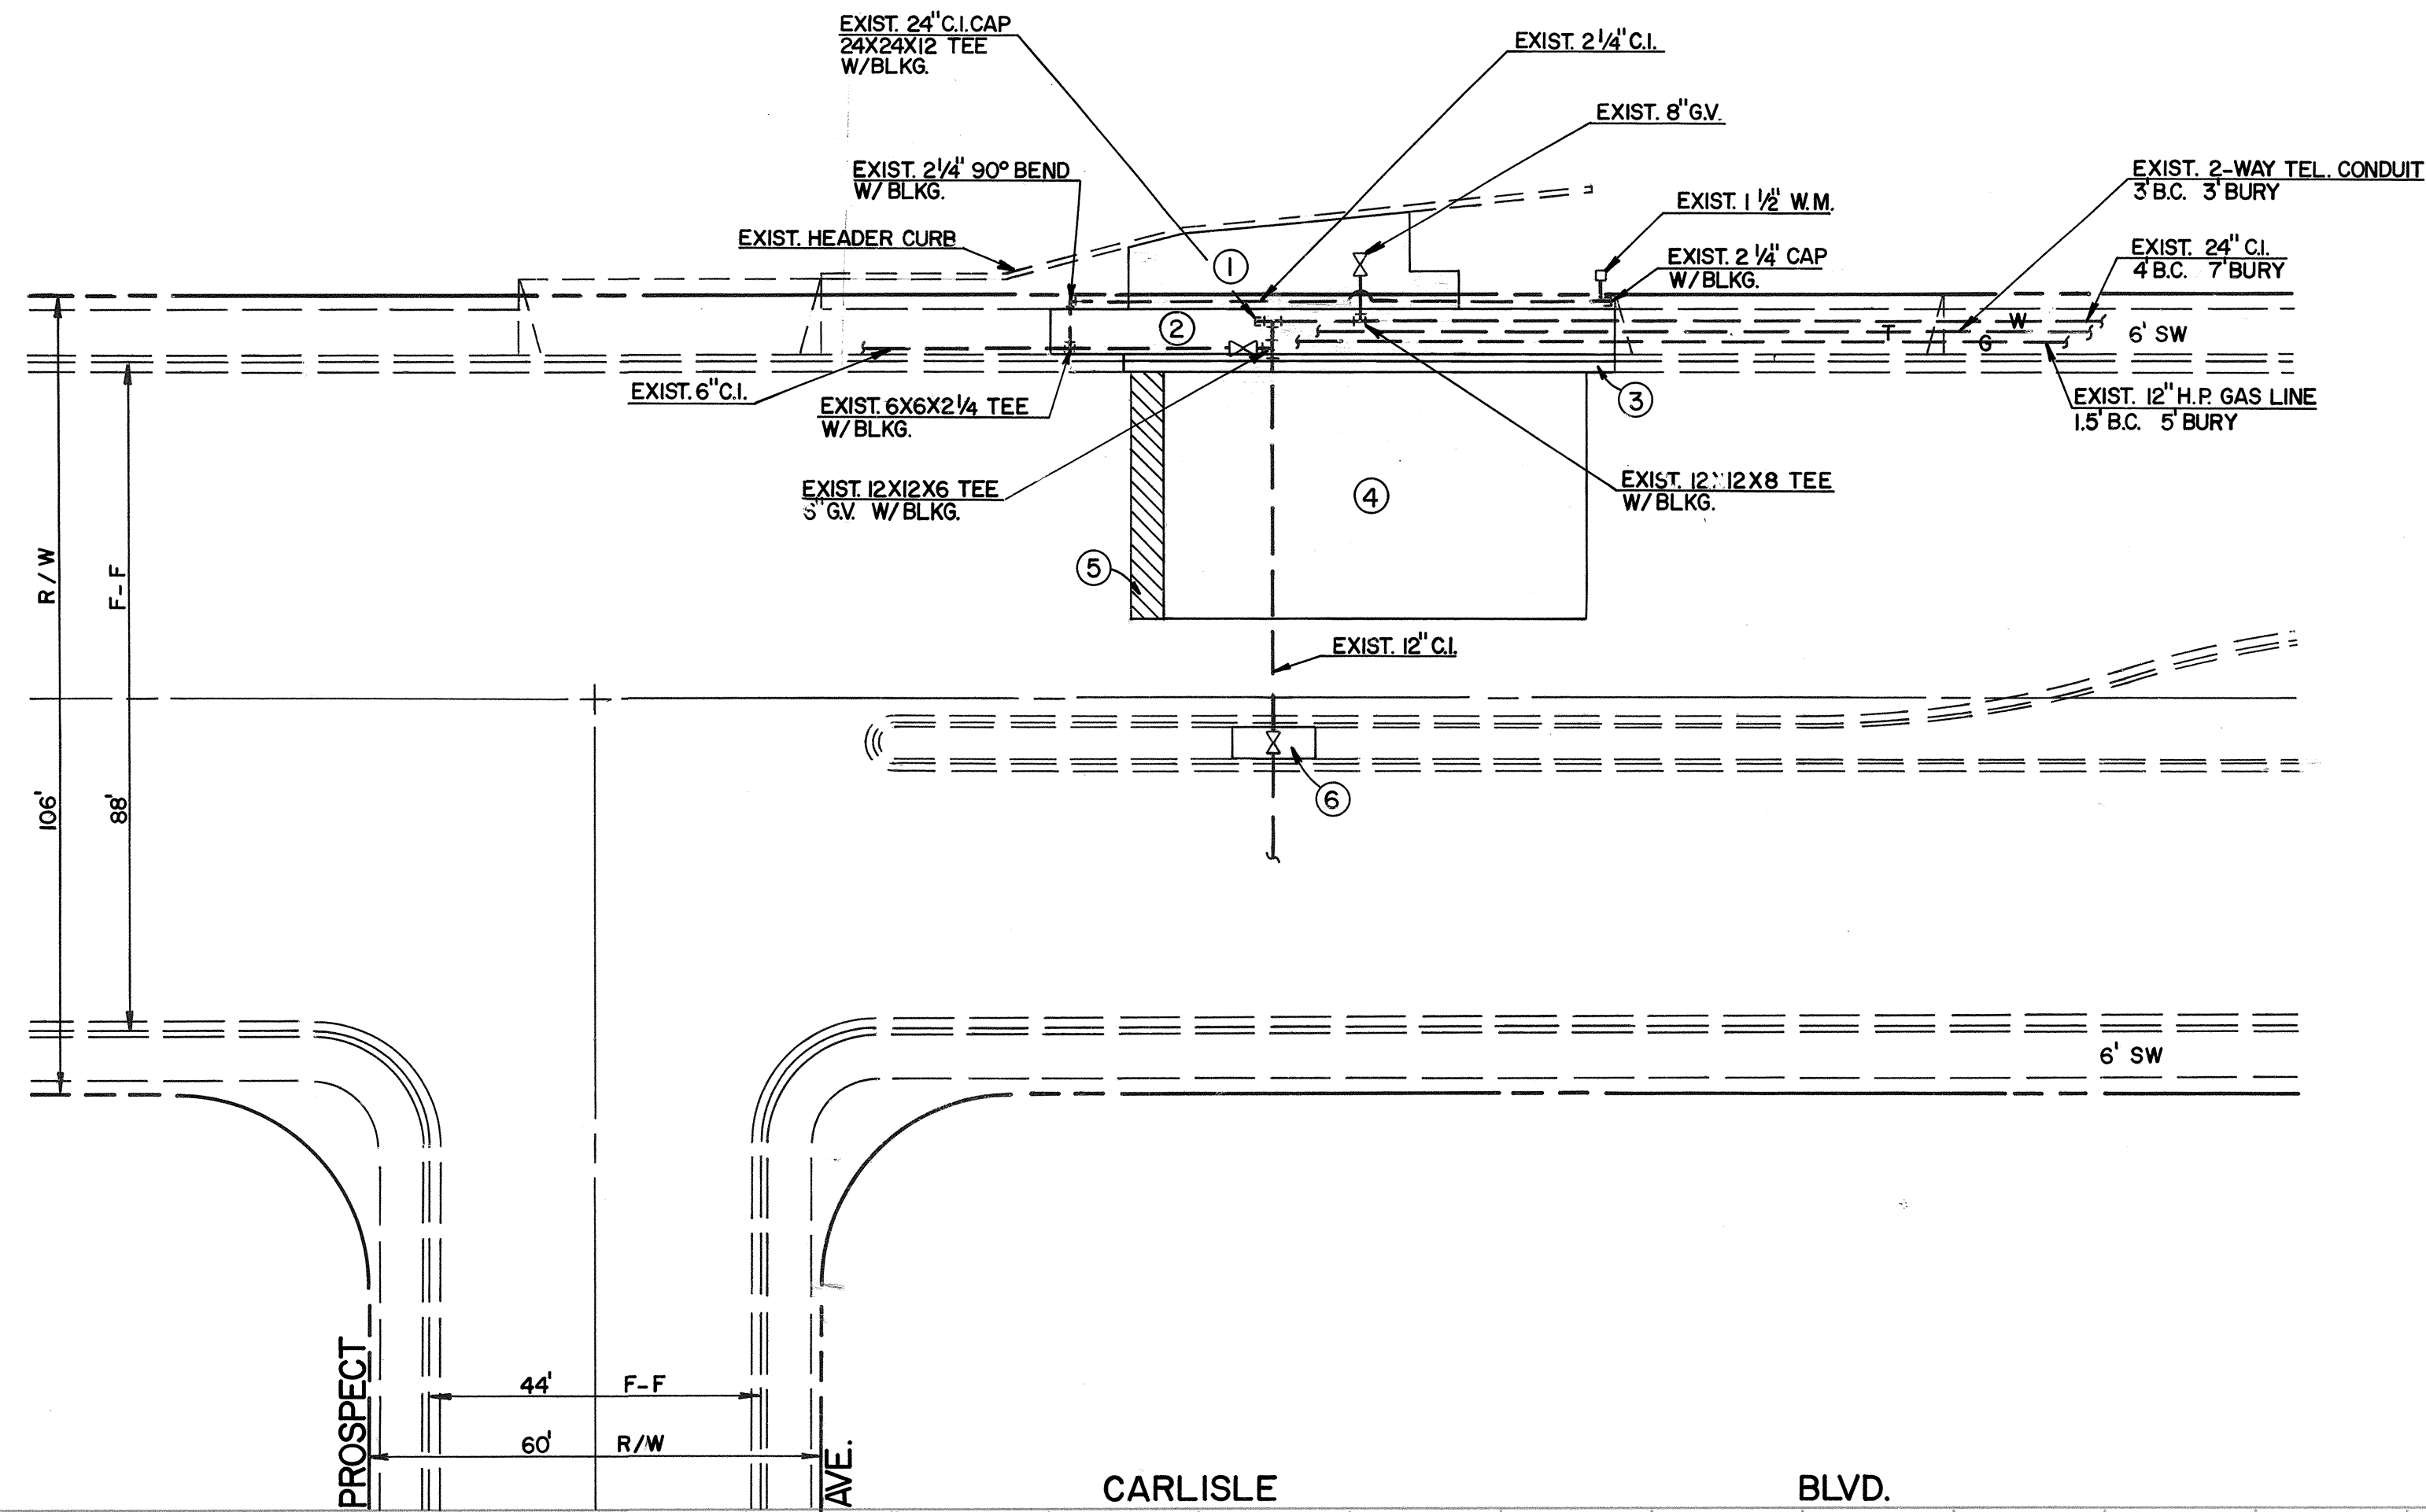

SCALE: 1" = 20'

NOTES

- ① REMOVED & REPLACED 452 S.F. OF SIDEWALK.
- ② REMOVED & REPLACED 76 L.F. OF 6" SIDEWALK (456 S.F.).
- ③ REMOVED & REPLACED 65 L.F. OF CURB & GUTTER.
- ④ REMOVED 56'x32' (189 SY.) CONCRETE PAVEMENT PAVING WITH TEMPORARY ASPHALT PAVEMENT. 3" A.C. BASE (1500^{CS}) 1" A.C. SURFACE (1800^{CS})
- ⑤ REMOVED & REPLACED 4.5'x32' (144 S.F.) OF ARTERIAL PAVING.
- ⑥ REMOVED MEDIAN CONCRETE 11.5'x4.5' (52 S.F.).

LEGEND

= AREA OF RECONSTRUCTION

THIS AS-BUILT COMPILED FROM FIELD
NOTES AND FIELD ENGINEERS INSTRU-
CTIONS AND IS FOR RECORD PURPOSES.

APPROVAL OF AS BUILT DRAWINGS
ASST. CITY ENGINEER - FIELD
W. J. McNamee
DATE 5/30/84

CITY OF ALBUQUERQUE
MUNICIPAL DEVELOPMENT DEPARTMENT
ENGINEERING DIVISION
TITLE: EMERGENCY REPAIR - NORTHBOUND LANE OF
CARLISLE BLVD. SOUTH OF PROSPECT AVE.

APPROVALS	ENGINEER	DATE	APPROVALS	ENGINEER	DATE
City Engineer			Liquid Waste		
A.C.E.-Design			Traffic		
A.C.E.-Hydrology			Water		

DRAWING NO.	1999	MAP NO.	H-16	SHEET	OF
				1	1

[illegible]