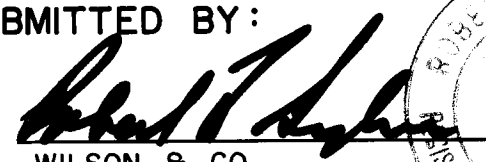



OSO GRANDE SUBDIVISION UNIT 7

ALBUQUERQUE, NEW MEXICO

INDEX

<u>DESCRIPTION</u>	<u>SHEET NO.</u>
COVER SHEET	1
SUBDIVISION PLAT	2
GRADING PLANS	3 & 4
WATER & SEWER LAYOUT	5
PAVING PLAN & PROFILE	6 - 8
SEWER PLAN & PROFILE	9 & 10
WATER PLAN & PROFILE	11 - 13

APPROVED FOR CONSTRUCTION:	
	<u>4/2/04</u>
CITY ENGINEER	DATE
SUBMITTED BY:	
	<u>20 Jun 04</u>
WILSON & CO.	DATE

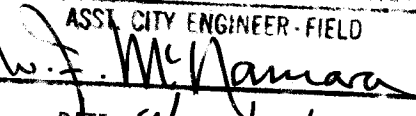APPROVAL OF AS BUILT DRAWINGS
ASS. CITY ENGINEER - FIELD

DATE <u>8/15/04</u>

26 2009 01 04

PROJECT NO. 2009

**WILSON
& COMPANY**
ENGINEERS
& ARCHITECTS
ALBUQUERQUE, NEW MEXICO

83-506 B

UNITS 3, 6, 7 & 8

OSO GRANDE SUBDIVISION

DESCRIPTION

A CERTAIN PARCEL OF LAND SITUATE WITHIN THE EXTERIOR BOUNDARIES OF THE ELLENA GALLEGOS GRANT (PROJECTED SECTION 33, TOWNSHIP 11 NORTH, RANGE 4 EAST, NEW MEXICO PRINCIPAL MERIDIAN) AND BEING TRACT B-1, TRACT B-2, TRACT B-3, OSO GRANDE SUBDIVISION FILED IN THE OFFICE OF THE COUNTY CLERK OF BERNALILLO COUNTY ON DECEMBER 23, 1981, IN VOLUME C19, FOLIO -53 AND BEING MORE PARTICULARLY DESCRIBED BY METES AND BOUNDS AS FOLLOWS:

BEGINNING AT A POINT ON THE SOUTHERLY RIGHT-OF-WAY LINE OF SPAIN ROAD N.E., SAID POINT BEING AN UNMARKED CITY OF ALBUQUERQUE BRASS CAP "06-3", HAVING NEW MEXICO STATE PLANE COORDINATE, CENTRAL ZONE: X = 419,235.14 AND Y = 1,506,653.83, WHENCE ACS BRASS CAP "16F-21 RESET 1980" BEARS N. 41°-41'-17" E., 106.36 FEET;

THENCE, N. 78°-40'-13" E., 348.07 FEET ALONG THE SOUTHERLY RIGHT-OF-WAY
OF SPAIN ROAD TO A POINT OF CURVATURE:

THENCE, NORTHEASTERLY 77.74 FEET ALONG THE ARC OF A CURVE BEARING TO THE LEFT, SAID CURVE HAVING A RADIUS OF 2767.97 FEET, A CENTRAL ANGLE OF $01^{\circ}-36'-33''$ AND A CHORD WHICH BEARS N. $77^{\circ}-51'-57''$ E.. 77.74 FEET TO THE NORTHEAST CORNER OF THE PARCEL:

THENCE, S. 17°-50'-08" E., 1253.01 FEET TO A POINT ON THE NORTHERLY
RIGHT-OF-WAY OF OSUNA ROAD AND BEING THE SOUTHEAST CORNER OF THE PARCEL;

THENCE, S. 71°-58'-56" W., 1632.58 FEET ALONG THE NORTHERLY RIGHT-OF-WAY OF OSUNA ROAD TO A POINT OF CURVATURE;

THEN, SOUTHWESTERLY 90.92 FEET ALONG THE ARC OF CURVE BEARING TO THE LEFT, SAID CURVE HAVING A RADIUS OF 4294.94 FEET, A CENTRAL ANGLE OF 10°-12'-46" AND A CHORD WHICH BEARS S. 71°-22'-33" W., A DISTANCE OF 90.92 FEET TO THE SOUTHWEST CORNER OF THE PARCEL:

THENCE, N. 18°-01'-04" W., 278.60 FEET TO A POINT;

THENCE, N. 71°-58'-56" E., 453.79 FEET TO A POINT;

THENCE, N. 14°-53'-53" E., 320.76 FEET TO A POINT;

THENCE, N. 71°-58'-56" E., 477.03 FEET TO A POINT;

THENCE, N. 18°-01'-04" W.; 683.62 FEET TO A POINT;

THENCE, N. 11°-19'-47" W., 93.72 FEET TO A POINT ON THE SOUTHERLY RIGHT-OF-WAY OF SPAIN ROAD AND BEING THE NORTHWEST CORNER OF THE PARCEL;

THENCE, N. 78°-40'-13", E., 189.70 FEET ALONG THE SOUTHERLY RIGHT-OF-WAY OF SPAIN ROAD TO THE POINT OF BEGINNING.

SAID PARCEL CONTAINS 28.8719 ACRES MORE OR LESS.

NOTE:

7' UTILITY EASEMENT ON FRONTAGE OF ALL LOTS

10' UTILITY EASEMENT ALONG OSUNA ROAD

UNIT 4 OSO GRANDE SUB'D.

UNIT 5
OSO GRANDE SUB'D.

UNIT 6
PROJ. 2008

UNIT 6 - 41 LOTS

UNIT 7/
36 LOTS

UNIT 8 - 49 LOTS

26 2009 0284

PRELIMINARY PLAT APPROVED BY DRB ON NOV. 15, 1983

DRB 83 - 143

DRB 83- 371

DRB 83- 599

APPLICANT, OWNER & AGENT FOR OWNERSHIP INTERESTS:

AMWOOD
P. O. BOX 16019
ALBUQUERQUE, N.M. 87191
ATTN: MR. KLESTON H. LAWS
(505) 881-1804

PLANNER & AGENT FOR SUBMITTALS:

WILSON & COMPANY ENGINEERS & ARCHITECTS
1321 SAN PEDRO N.E.
P. O. BOX 3548
ALBUQUERQUE, N.M. 87190
ATTN: MR. ROBERT F. SYKES
(505) 262-2116

CITY OF ALBUQUERQUE



OSO GRANDE SUBDIVISION
UNIT 3 & UNITS 6, 7 & 8

PRELIMINARY PLAT

APPROVALS	ENGINEER	DATE	APPROVALS	ENGINEER	DATE
City Engineer			Traffic		
Liquid Waste			Water		
A.C.E. - Design			2009 SHEET <u>2</u> OF <u>13</u>		
A.C.E. - Hydrology					

WILSON & COMPANY
ENGINEERS & ARCHITECTS
ALBUQUERQUE NEW MEXICO

33-506

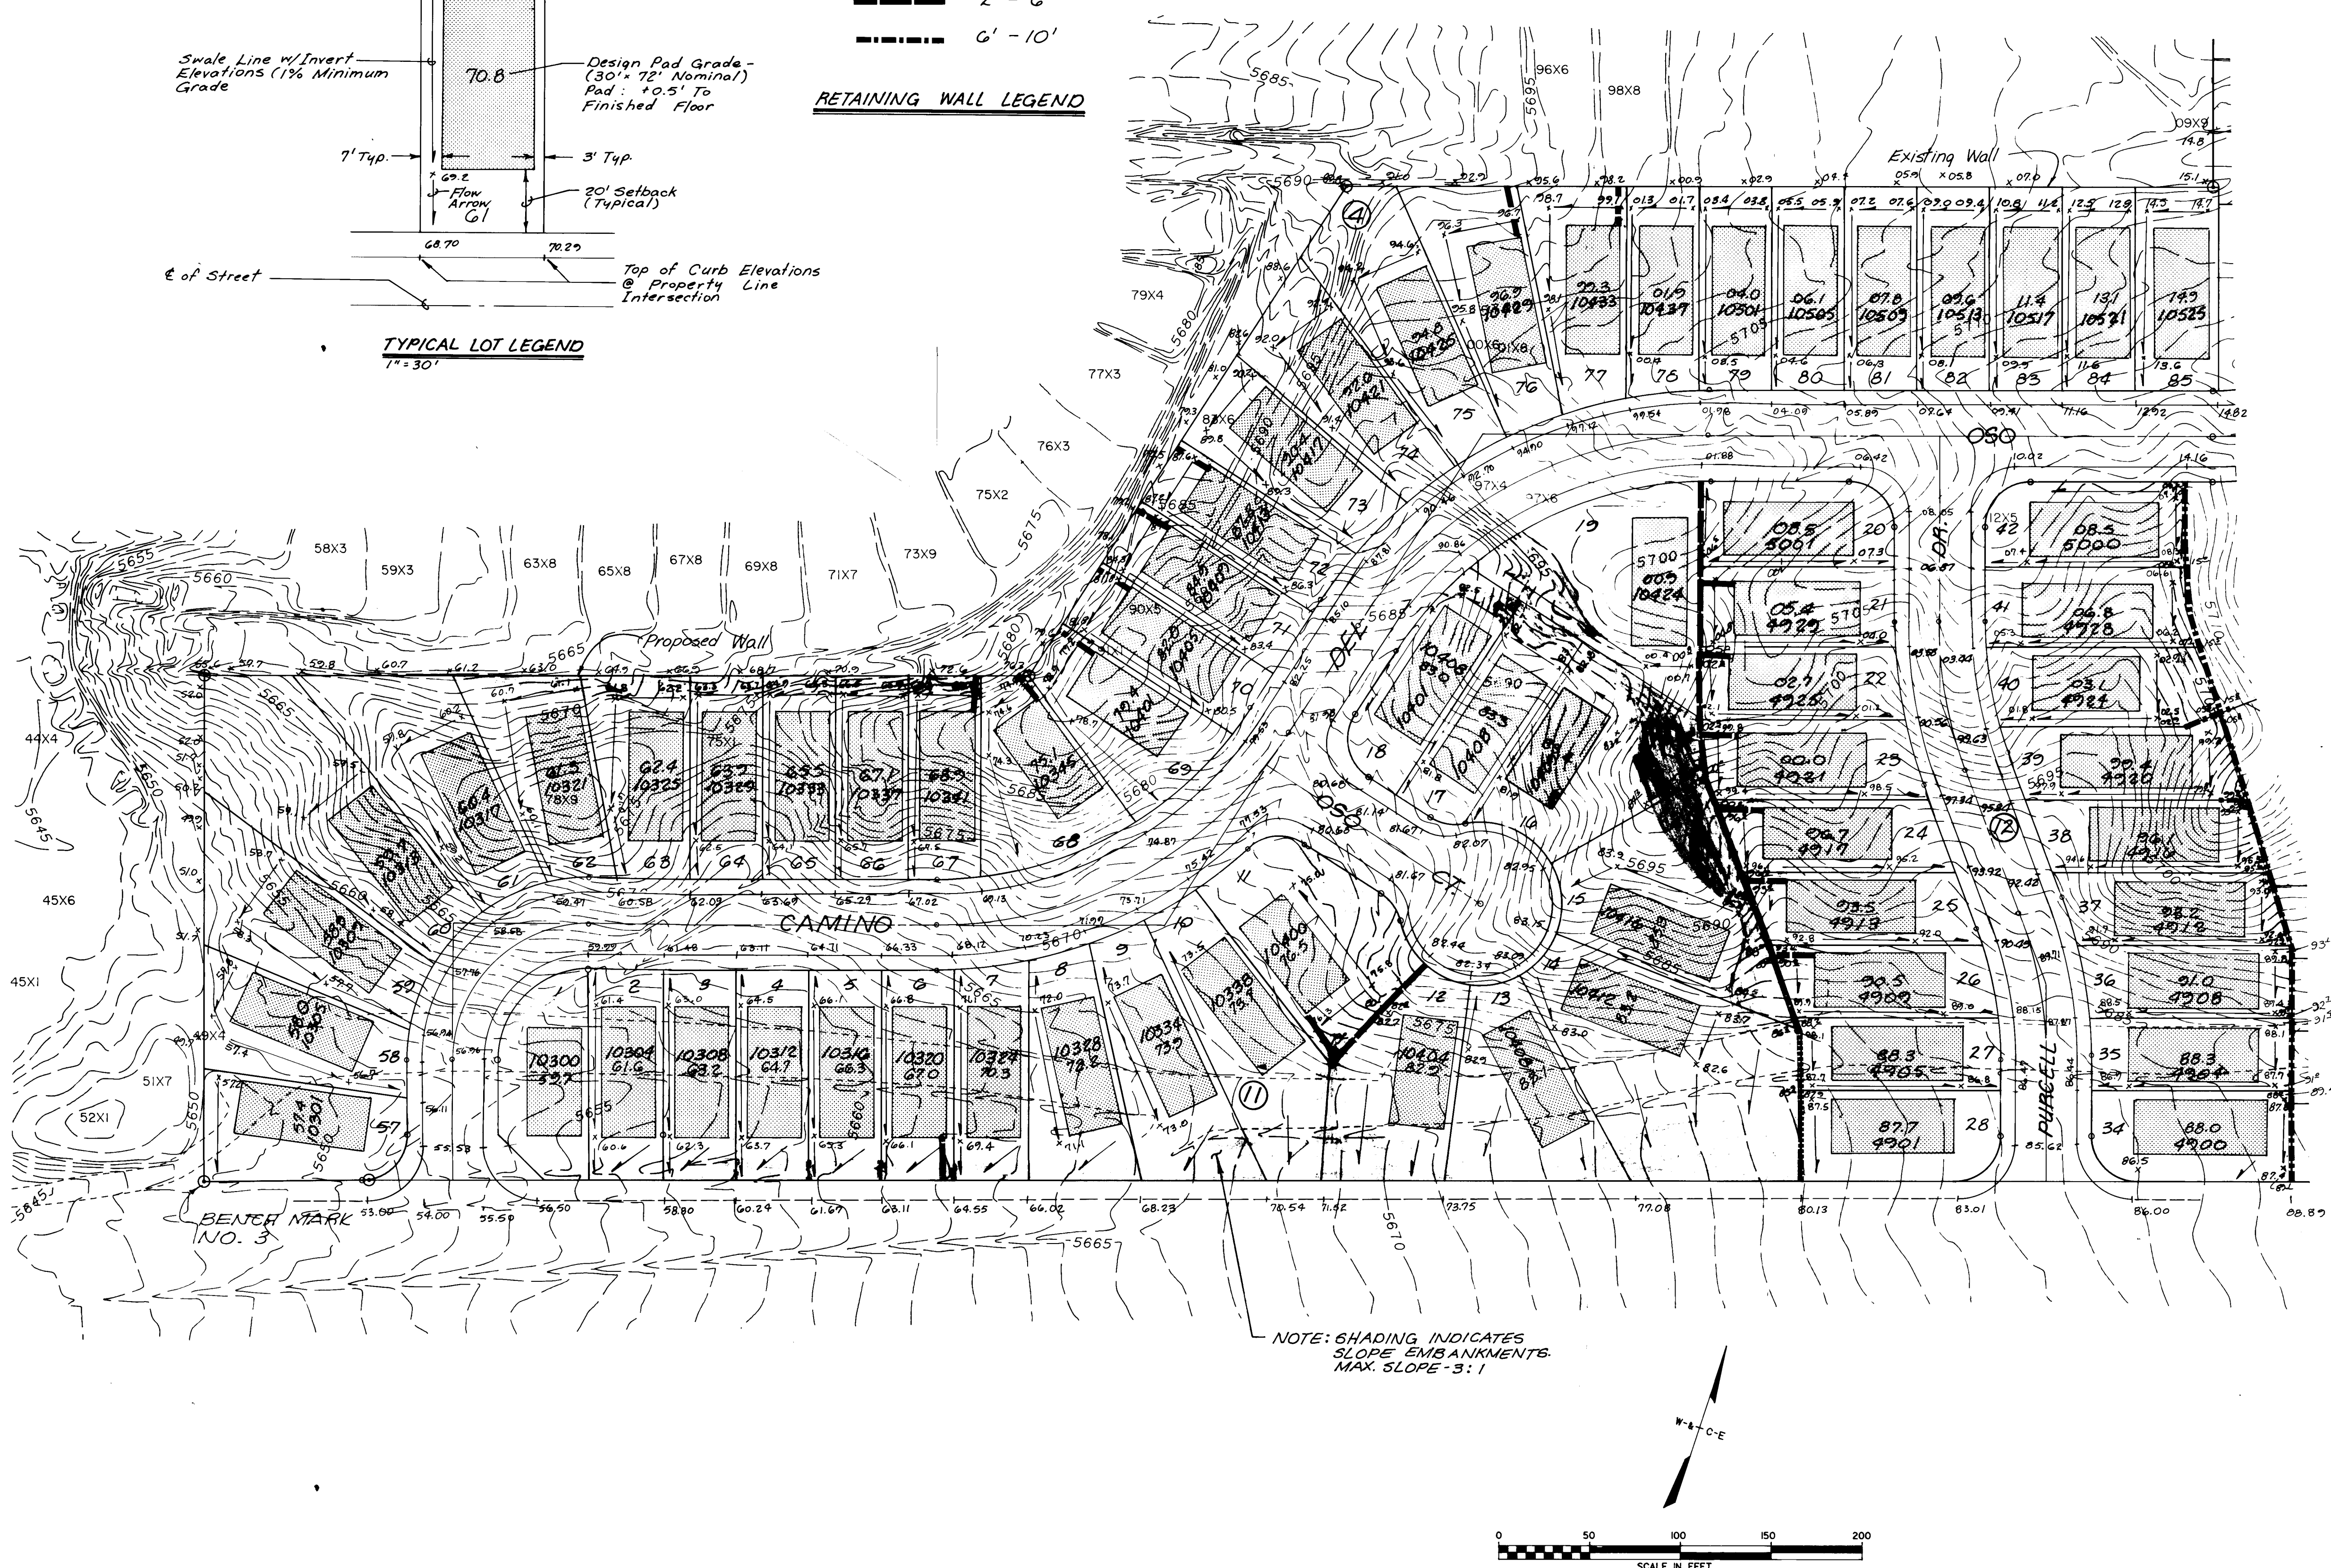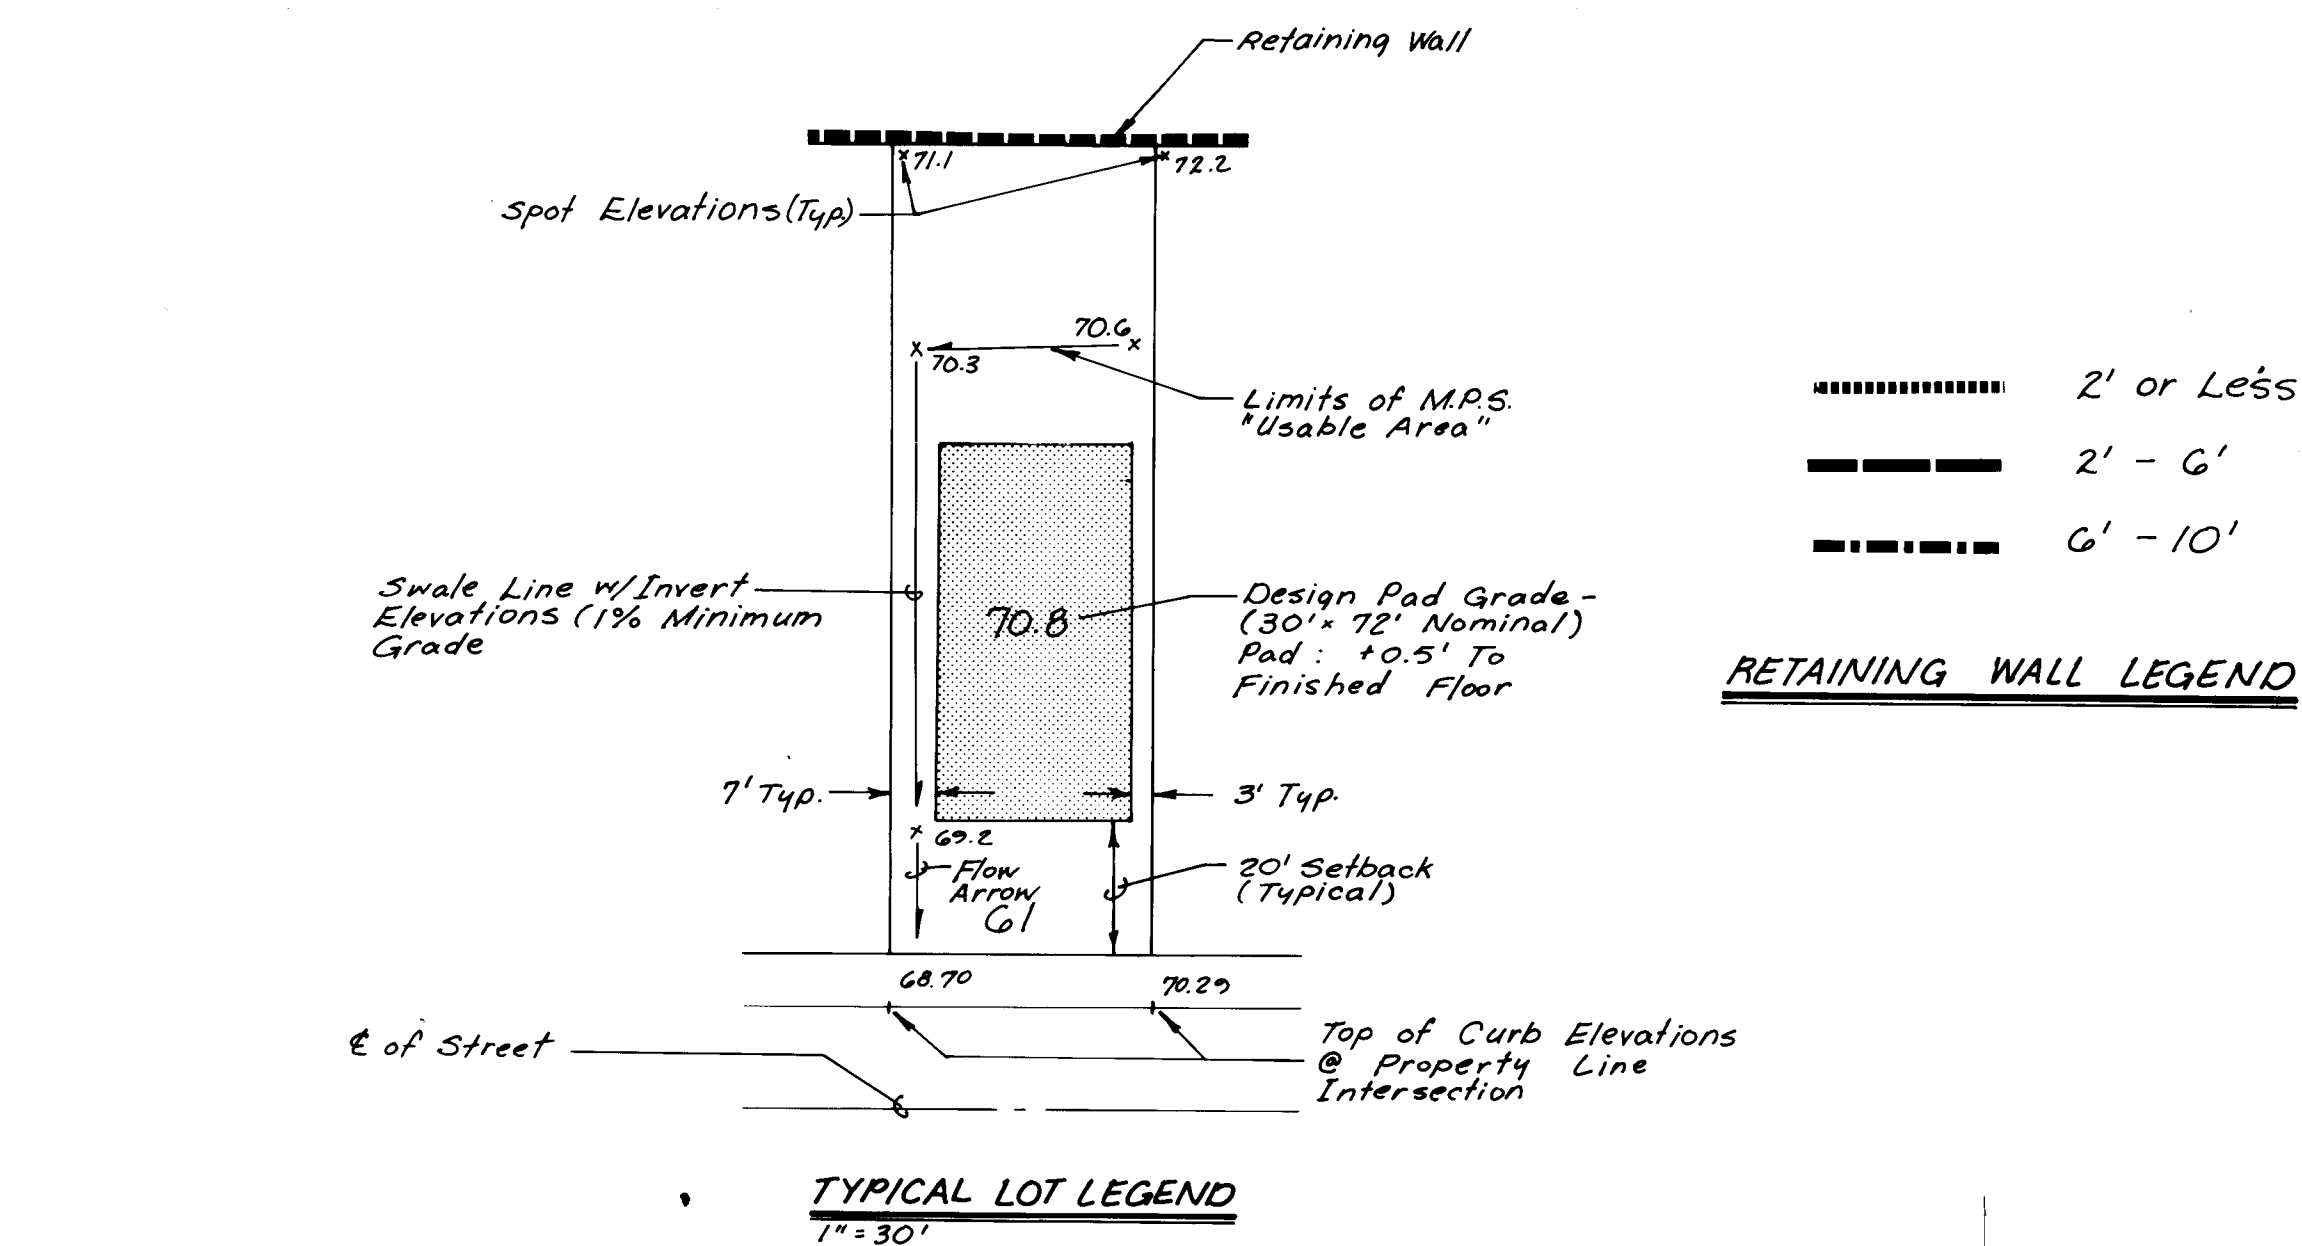

26 2009 0384


CITY OF ALBUQUERQUE					
OSO GRANDE SUBDIVISION UNITS 3, 6, 7, & 8					
GRADING PLAN					
APPROVALS	ENGINEER	DATE	APPROVALS	ENGINEER	DATE
City Engineer	SAH	9/23/04	Traffic	N.A. DMH	1/25/04
Liquid Waste	NA WEG	1-30-04	Water	WEG NA	1-30-04
A.C.E. - Design	SAH	2/2/04	2009	SHEET 3	OF 13
A.C.E. - Hydrology	SAH	2/2/04			

DESIGNED BY: WILSON & CO., INC. DATE: _____
DRAWN BY: _____ DATE: _____
CHECKED BY: _____ DATE: _____


WILSON & COMPANY
ENGINEERS & ARCHITECTS
ALBUQUERQUE, NEW MEXICO

83-506 B

AS BUILT INFORMATION		BENCH MARKS		REFERENCES	
CONTRACTOR	DATE	BENCHMARK NO. 1	ELEV. = 5700.94	MAP NO.	F-21-Z
WORK STARTED BY	DATE	1/16 F-21/Revised 1980			
ACCEPTANCE BY	DATE	BENCHMARK NO. 2	ELEV. = 5705.04	Top of 3/8" Rebar set on E of Osuna Road 30' South of SE Property Corner.	
VERIFIED BY	DATE	BENCHMARK NO. 3	ELEV. = 5648.32	Top of Capped Rebar Set for SW Property Corner marked LS 7270	
RECORDED BY	DATE				

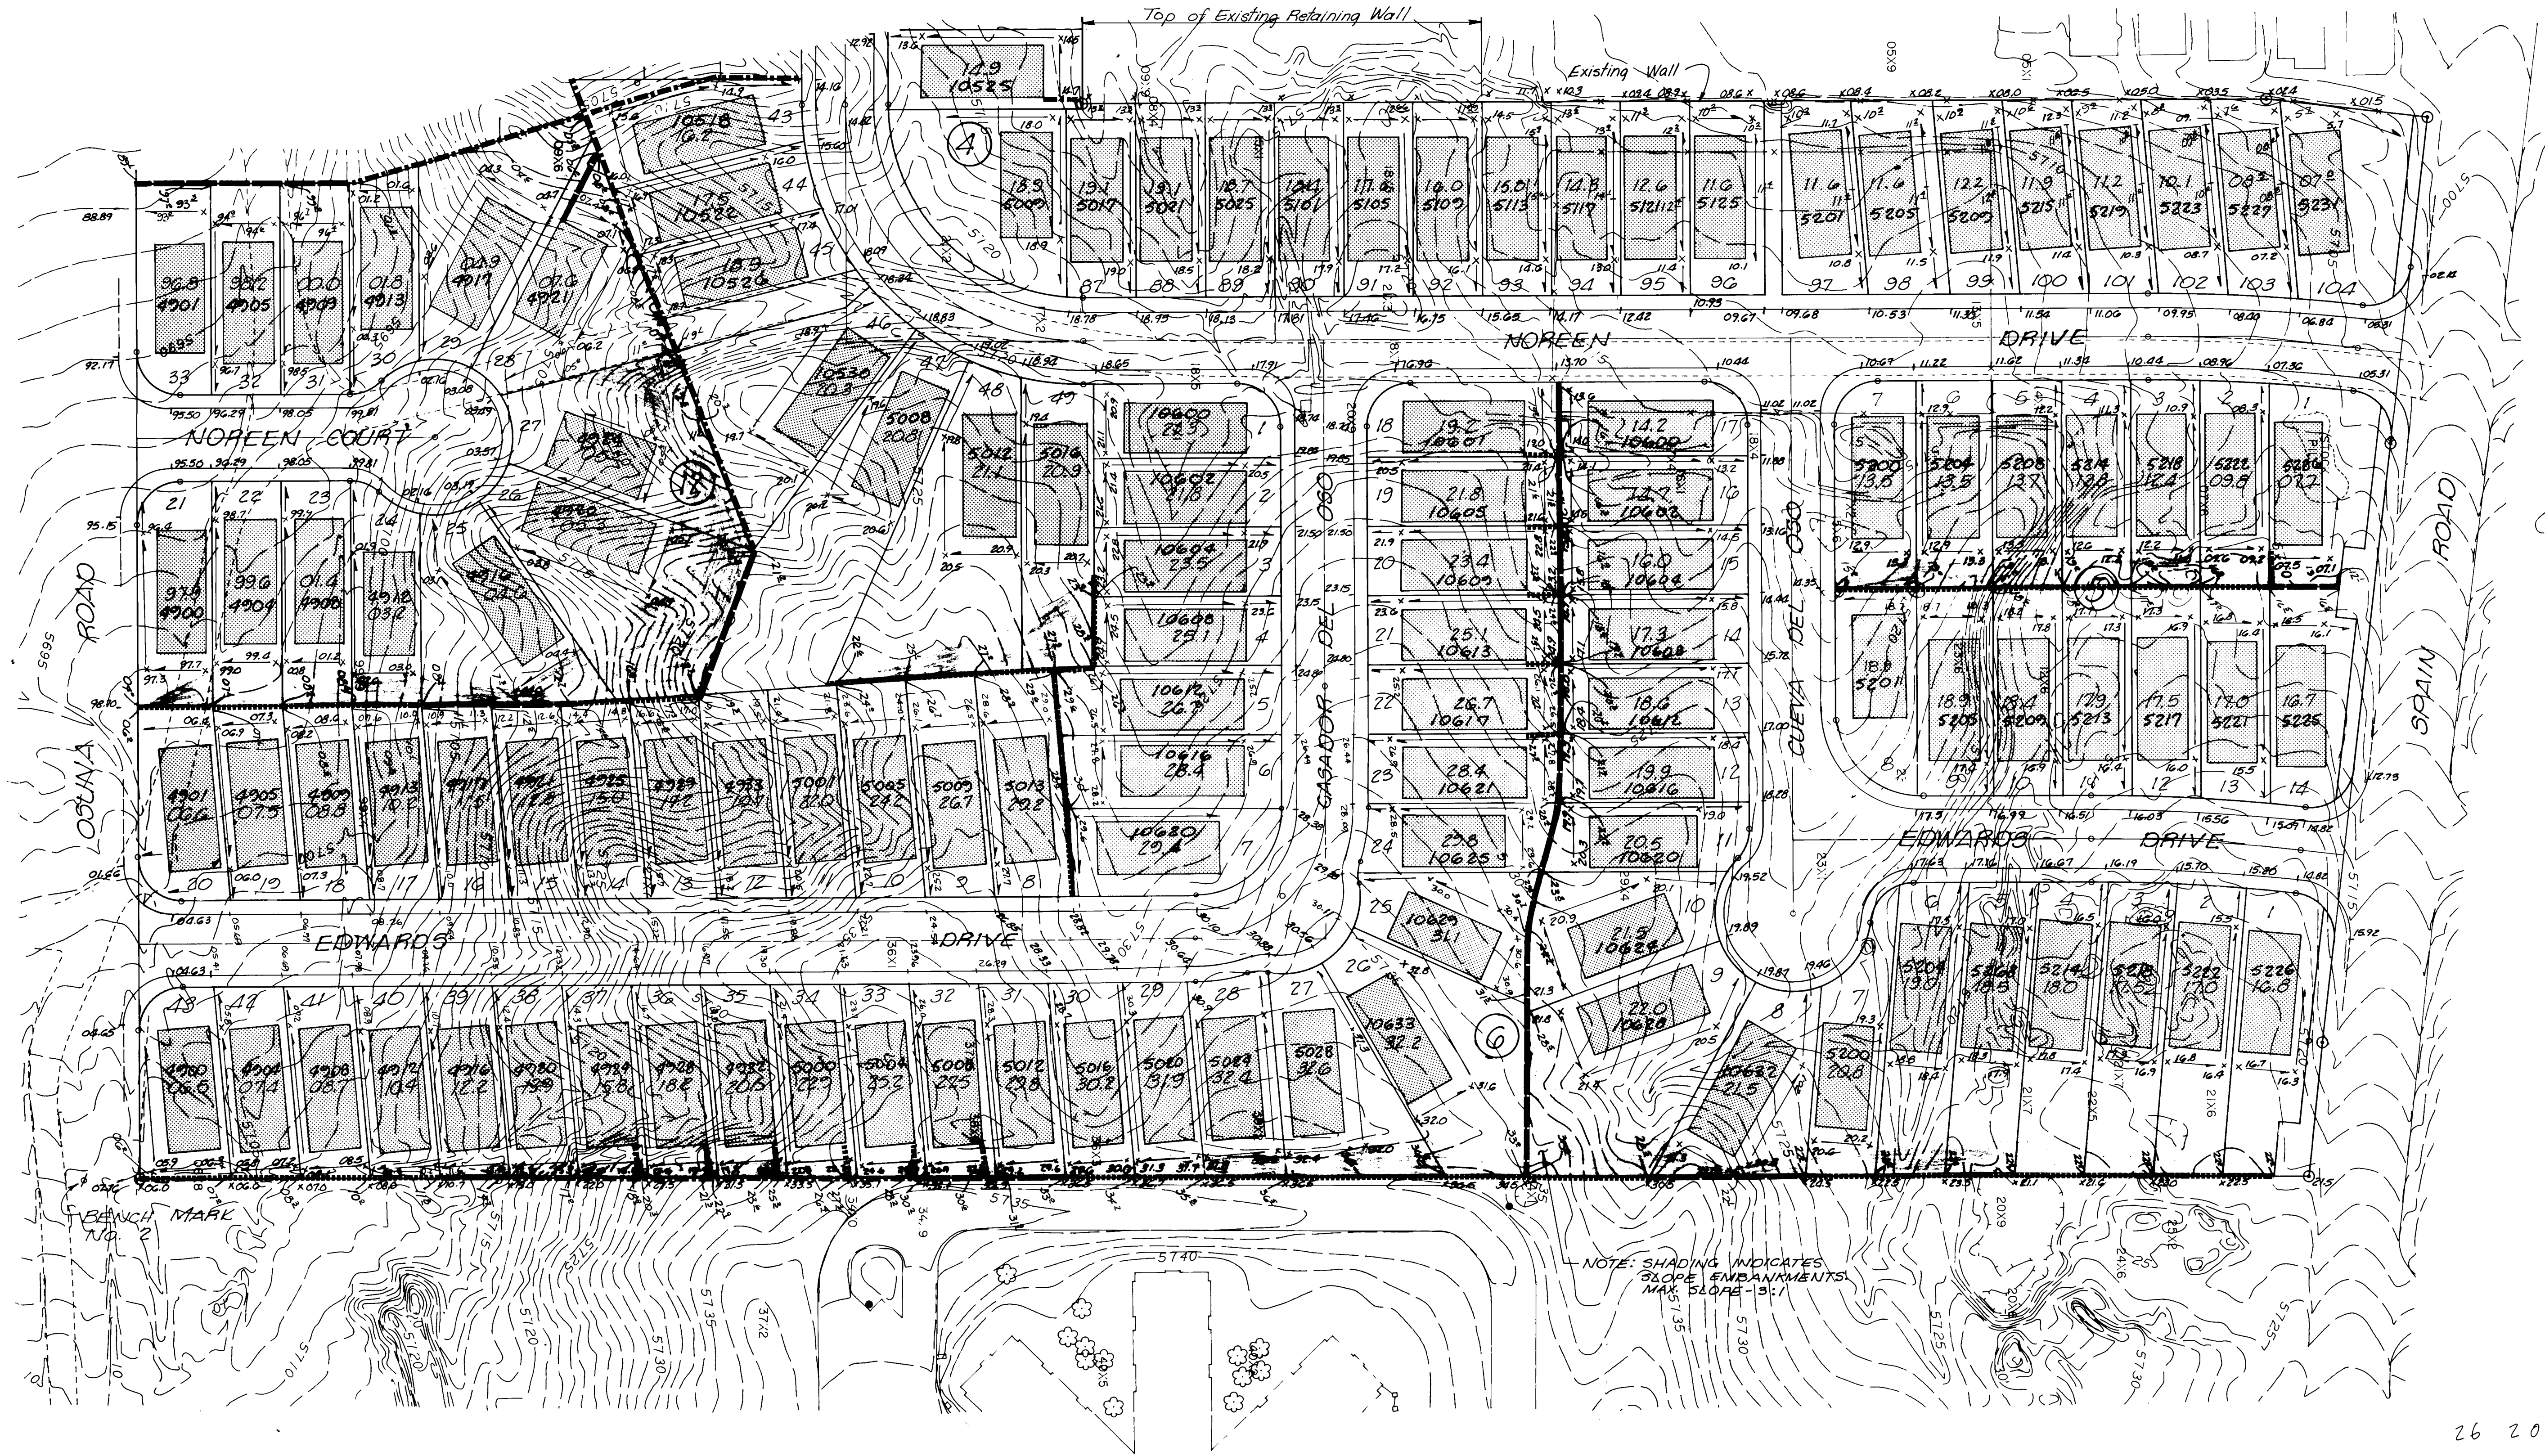

26 2009 0484

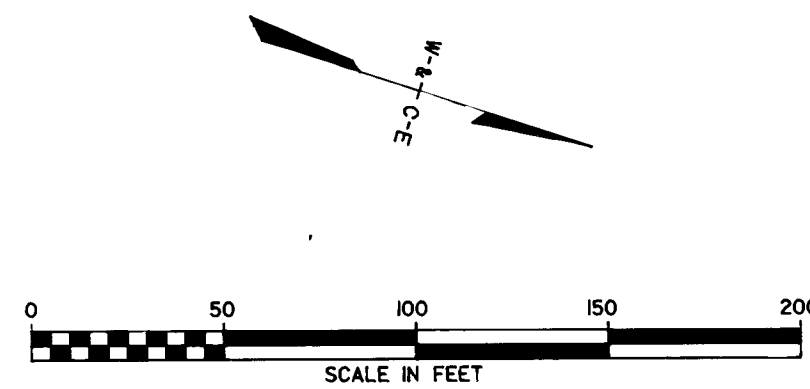


CITY OF ALBUQUERQUE					
OSO GRANDE SUBDIVISION UNITS 3, 6, 7, & 8					
GRADING PLAN					
APPROVALS	ENGINEER	DATE	APPROVALS	ENGINEER	DATE
City Engineer	<i>[Signature]</i>	9/23/04	Traffic	NA DWH	1/25/04
Liquid Waste	NA WSG	1-30-04	Water	NA WSG	1-30-04
A.C.E. - Design	<i>[Signature]</i>	2/2/04	2009	SHEET 4	OF 13
A.C.E. - Hydrology	<i>[Signature]</i>	2/2/04			

WILSON & COMPANY
ENGINEERS & ARCHITECTS
ALBUQUERQUE, NEW MEXICO

83-506 B

AS BUILT INFORMATION			
CONTRACTOR	WORKED BY		
DATE	INSPECTED BY		
DATE	ACCEPTANCE BY		
DATE	VERIFICATION BY		
DATE	REVIEW BY		
DATE	RECORDED BY		
DATE	NO.		
BENCH MARKS			
BENCH MARK NO. 1 - ELEV. = 5700.94 - Top of ACS Brass Cap marked 11 G.F. - 21 Feet 1980"			
BENCH MARK NO. 2 - ELEV. = 5705.04 - Top of 3/4" Rebar set on Osuna Road 30' South of SE Property Corner			
BENCH MARK NO. 3 - ELEV. = 5648.32 - Top of Capped Rebar Set for SW Property Corner marked L.S. 7070			
REFERENCES			
MAP NO. F-21-Z			
DESIGNED BY: WILSON & CO. ENG.			
DRAWN BY:			
CHECKED BY:			
REVISIONS			
NO.	DATE	BY	REMARKS

UNITS 3, 6, 7 & 8 OSO GRANDE SUBDIVISION

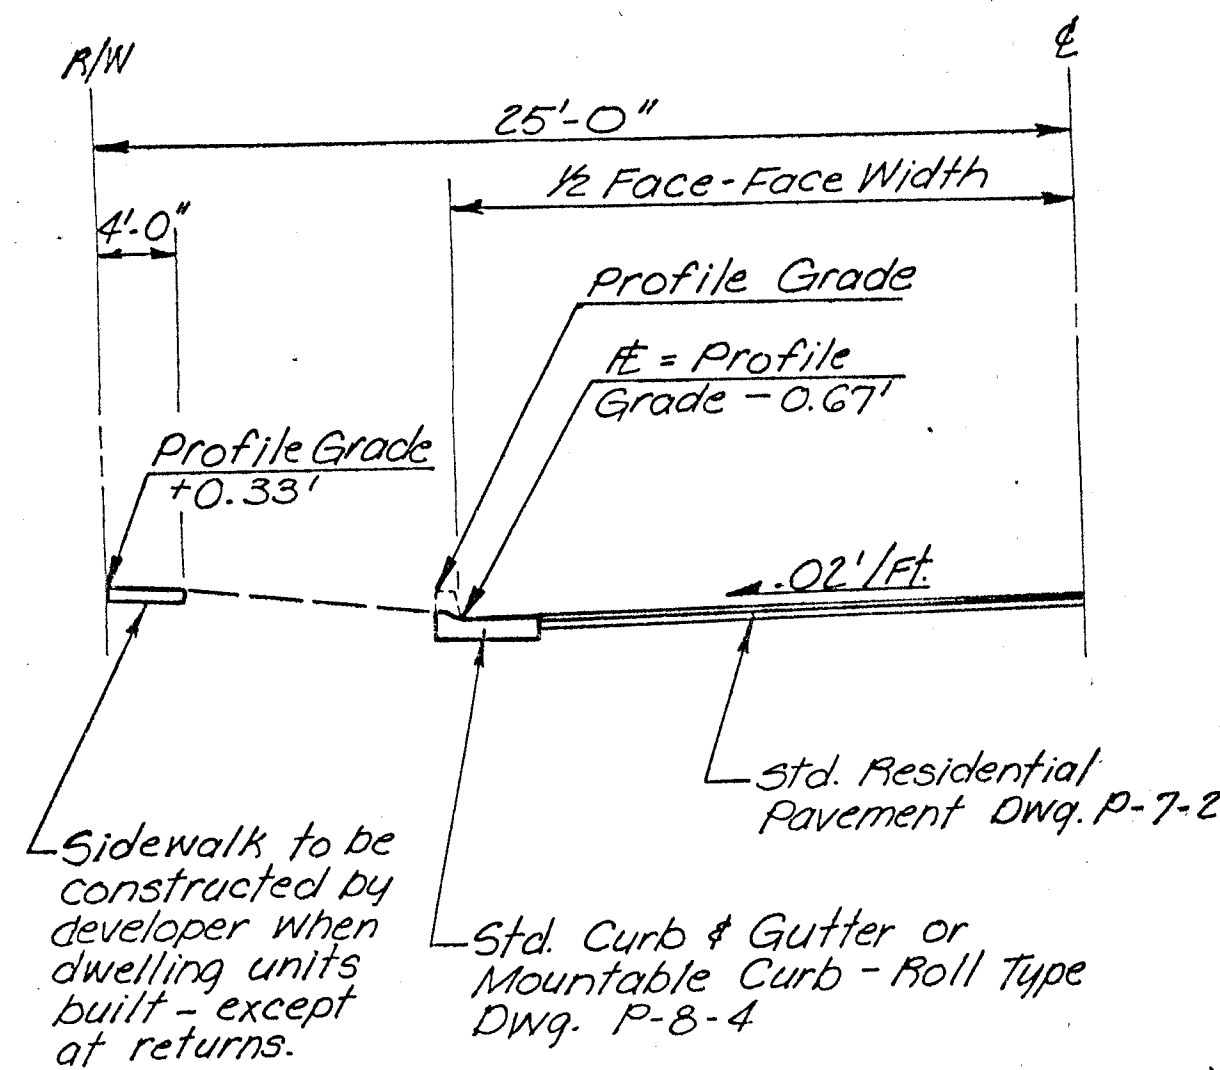

NOTE:
Std. Curb & Gutter w/ Wheel Chair Ramps will be Constructed at all Curb Returns including sidewalks around returns.

WATER PIPE MATERIALS

POLYVINYL CHLORIDE (MAIN)
ASBESTOS CEMENT (MAIN)
DUCTILE IRON (MAIN)

SEWER PIPE MATERIALS

EXTRA STRENGTH V.C.P. (MAIN)
POLYVINYL CHLORIDE PIPE (MAIN)
DUCTILE IRON PIPE (MAIN, SERVICES, & RISERS)
CAST IRON SOIL PIPE (SERVICES & RISERS)

WATER

ZONE BOUNDARY
6" & 24" NEW WATER LINE
EXISTING WATER LINE
FIRE HYDRANT
GATE VALVE
PLUG


SEWER

8" NEW SANITARY SEWER LINE
EXISTING SANITARY SEWER LINE
NEW MANHOLE
EXISTING MANHOLE

PAVING

VALLEY GUTTER FLOW DIRECTION

NOTE:
7' UTILITY EASEMENT ON FRONTAGE OF ALL LOTS
10' UTILITY EASEMENT ALONG OSUNA ROAD

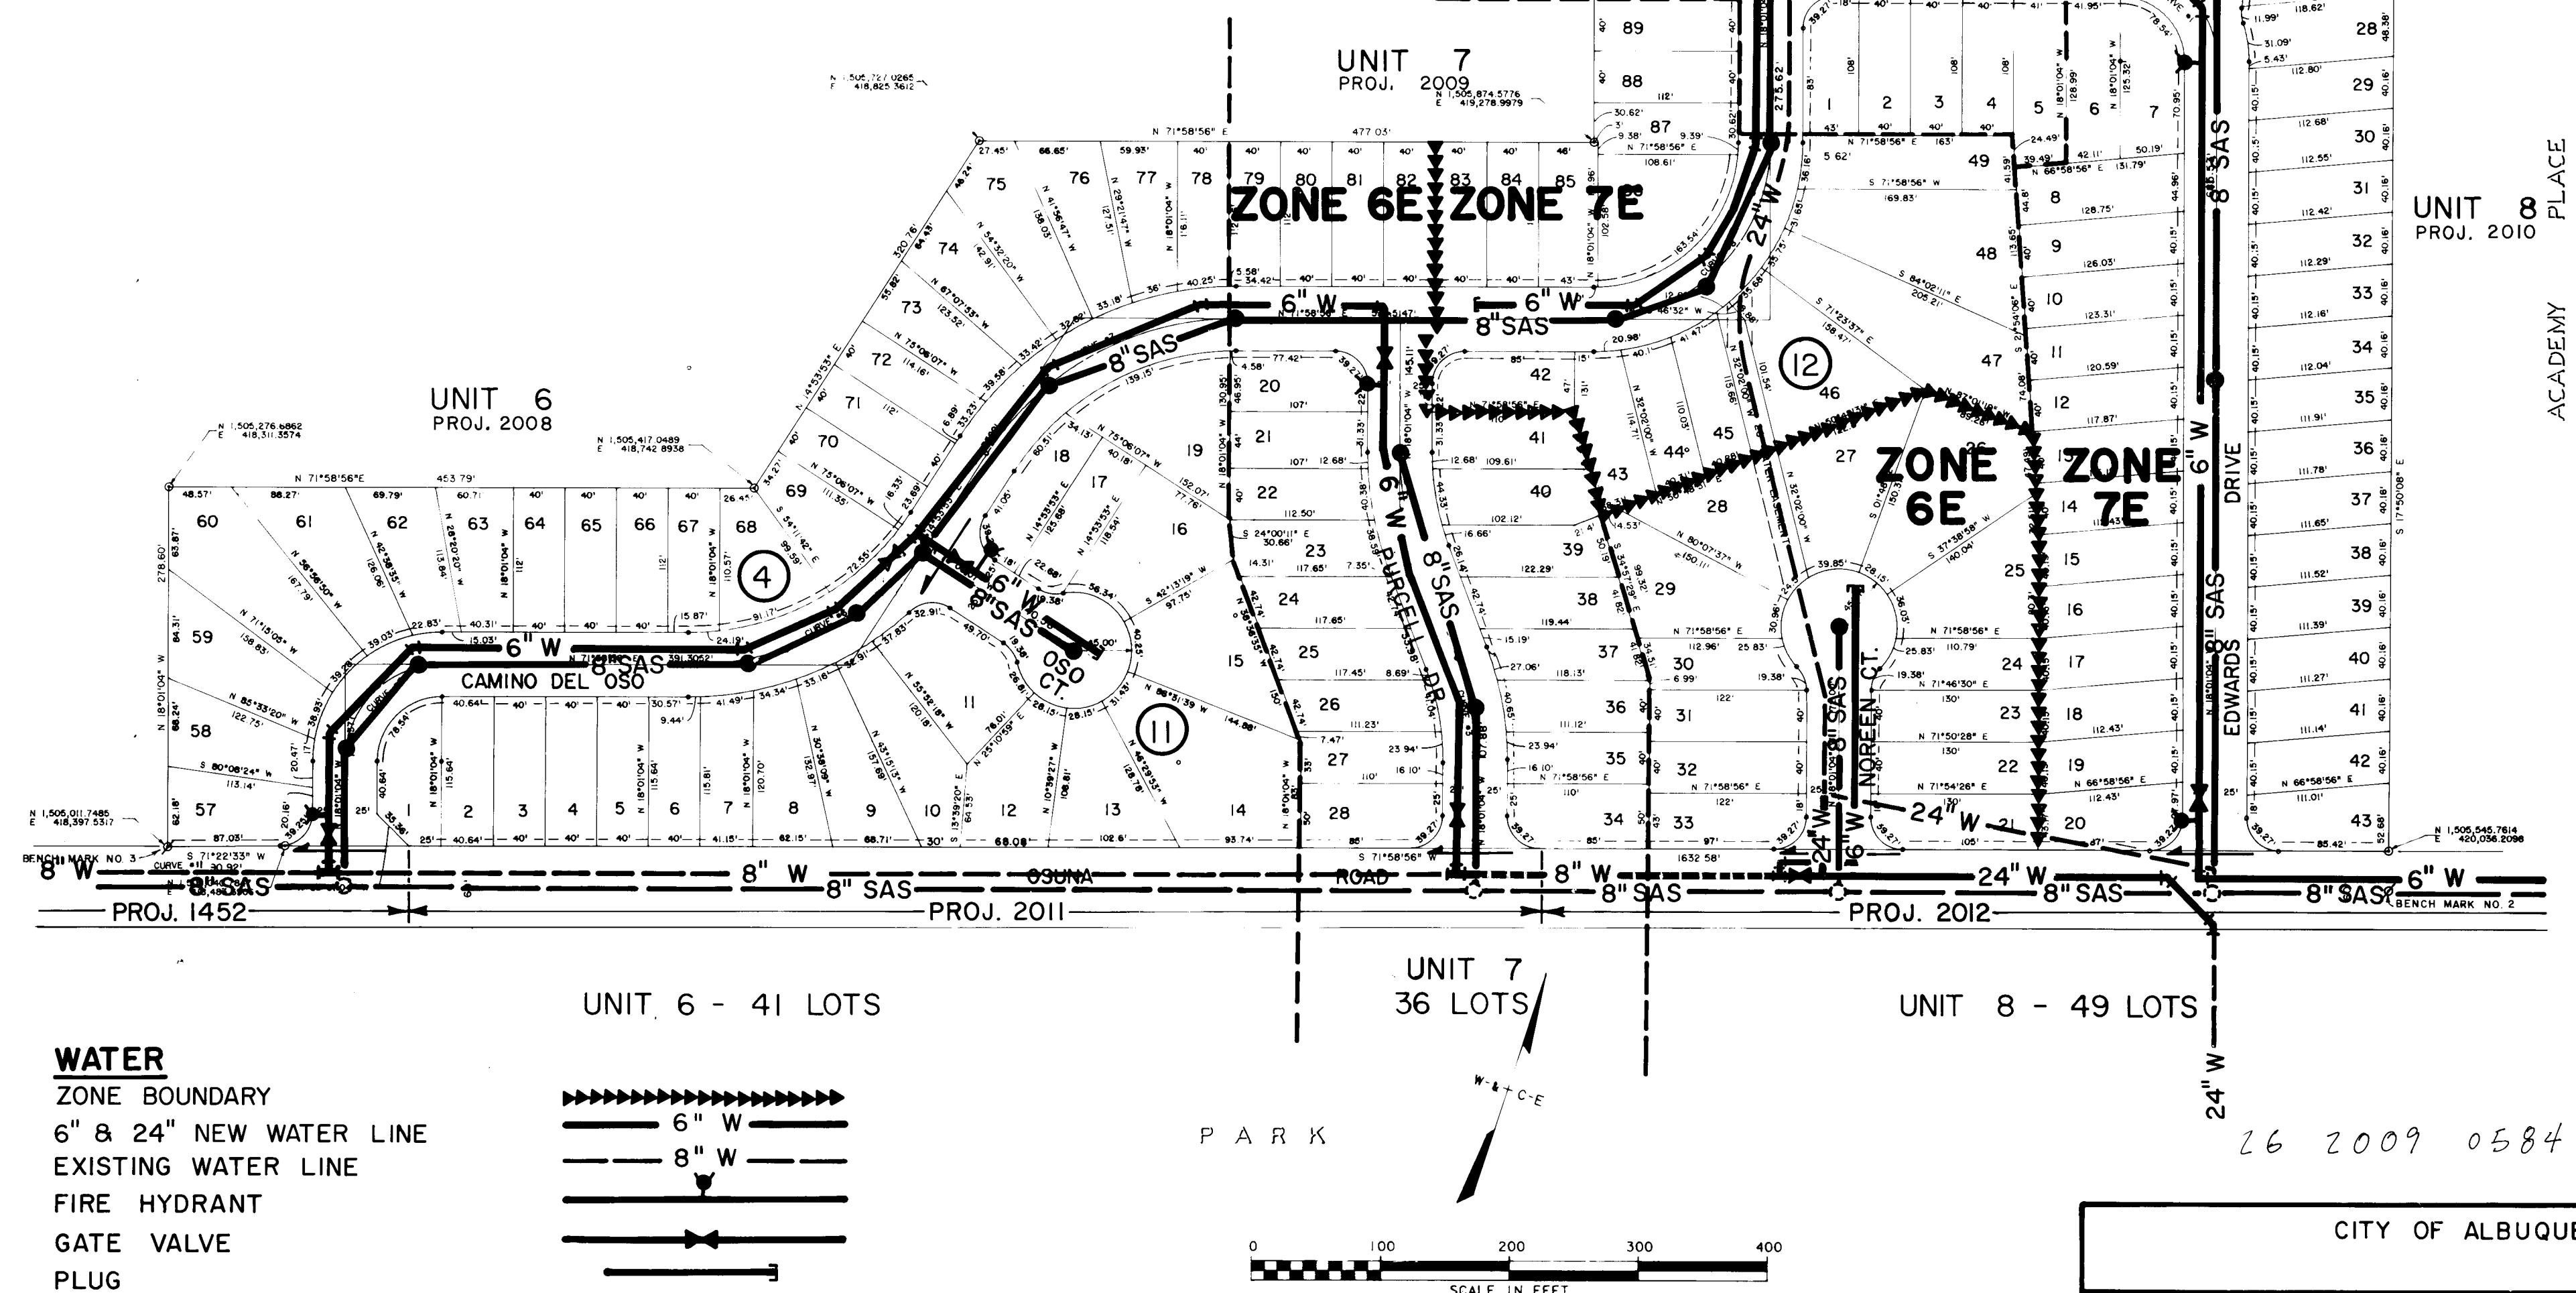

NOTE: 1) MATERIALS AND INSTALLATION FOR WATER & SEWER PIPE SHALL CONFORM TO THE CITY OF ALBUQUERQUE SPECIFICATIONS.
2) ALL APPROVED STREETS WITHIN THE SUBDIVISION ARE 32' FACE-TO-FACE WITH RESIDENTIAL PAVEMENT & MOUNTABLE ROLL TYPE CURB.
3) SIDEWALKS WILL BE CONSTRUCTED AT THE TIME OF BUILDING CONSTRUCTION EXCEPT THE WHEEL CHAIR RAMPS AND RETURNS WHICH WILL BE CONSTRUCTED UNDER THIS CONTRACT.

CITY OF ALBUQUERQUE

OSO GRANDE SUBDIVISION
UNIT 3 & UNITS 6, 7 & 8

WATER & SEWER LAYOUT

APPROVALS	ENGINEER	DATE	APPROVALS	ENGINEER	DATE
City Engineer	W. J. [Signature]	7/23/09	Traffic	N. A. [Signature]	1/25/04
Liquid Waste	W. J. [Signature]	1/30/04	Water	W. J. [Signature]	1/30/04
A.C.E. - Design	W. J. [Signature]	2/2/09			
A.C.E. - Hydrology	W. J. [Signature]	2/2/09			

SHEET 5 OF 13

WILSON & COMPANY
ENGINEERS & ARCHITECTS
ALBUQUERQUE, NEW MEXICO

83-056


RECORD DRAWING

UNITS 7 & 3


Clarence P. Kelly

UNIT 3
PROJECT NO. 1979


UNIT 7
PROJECT NO. 2009

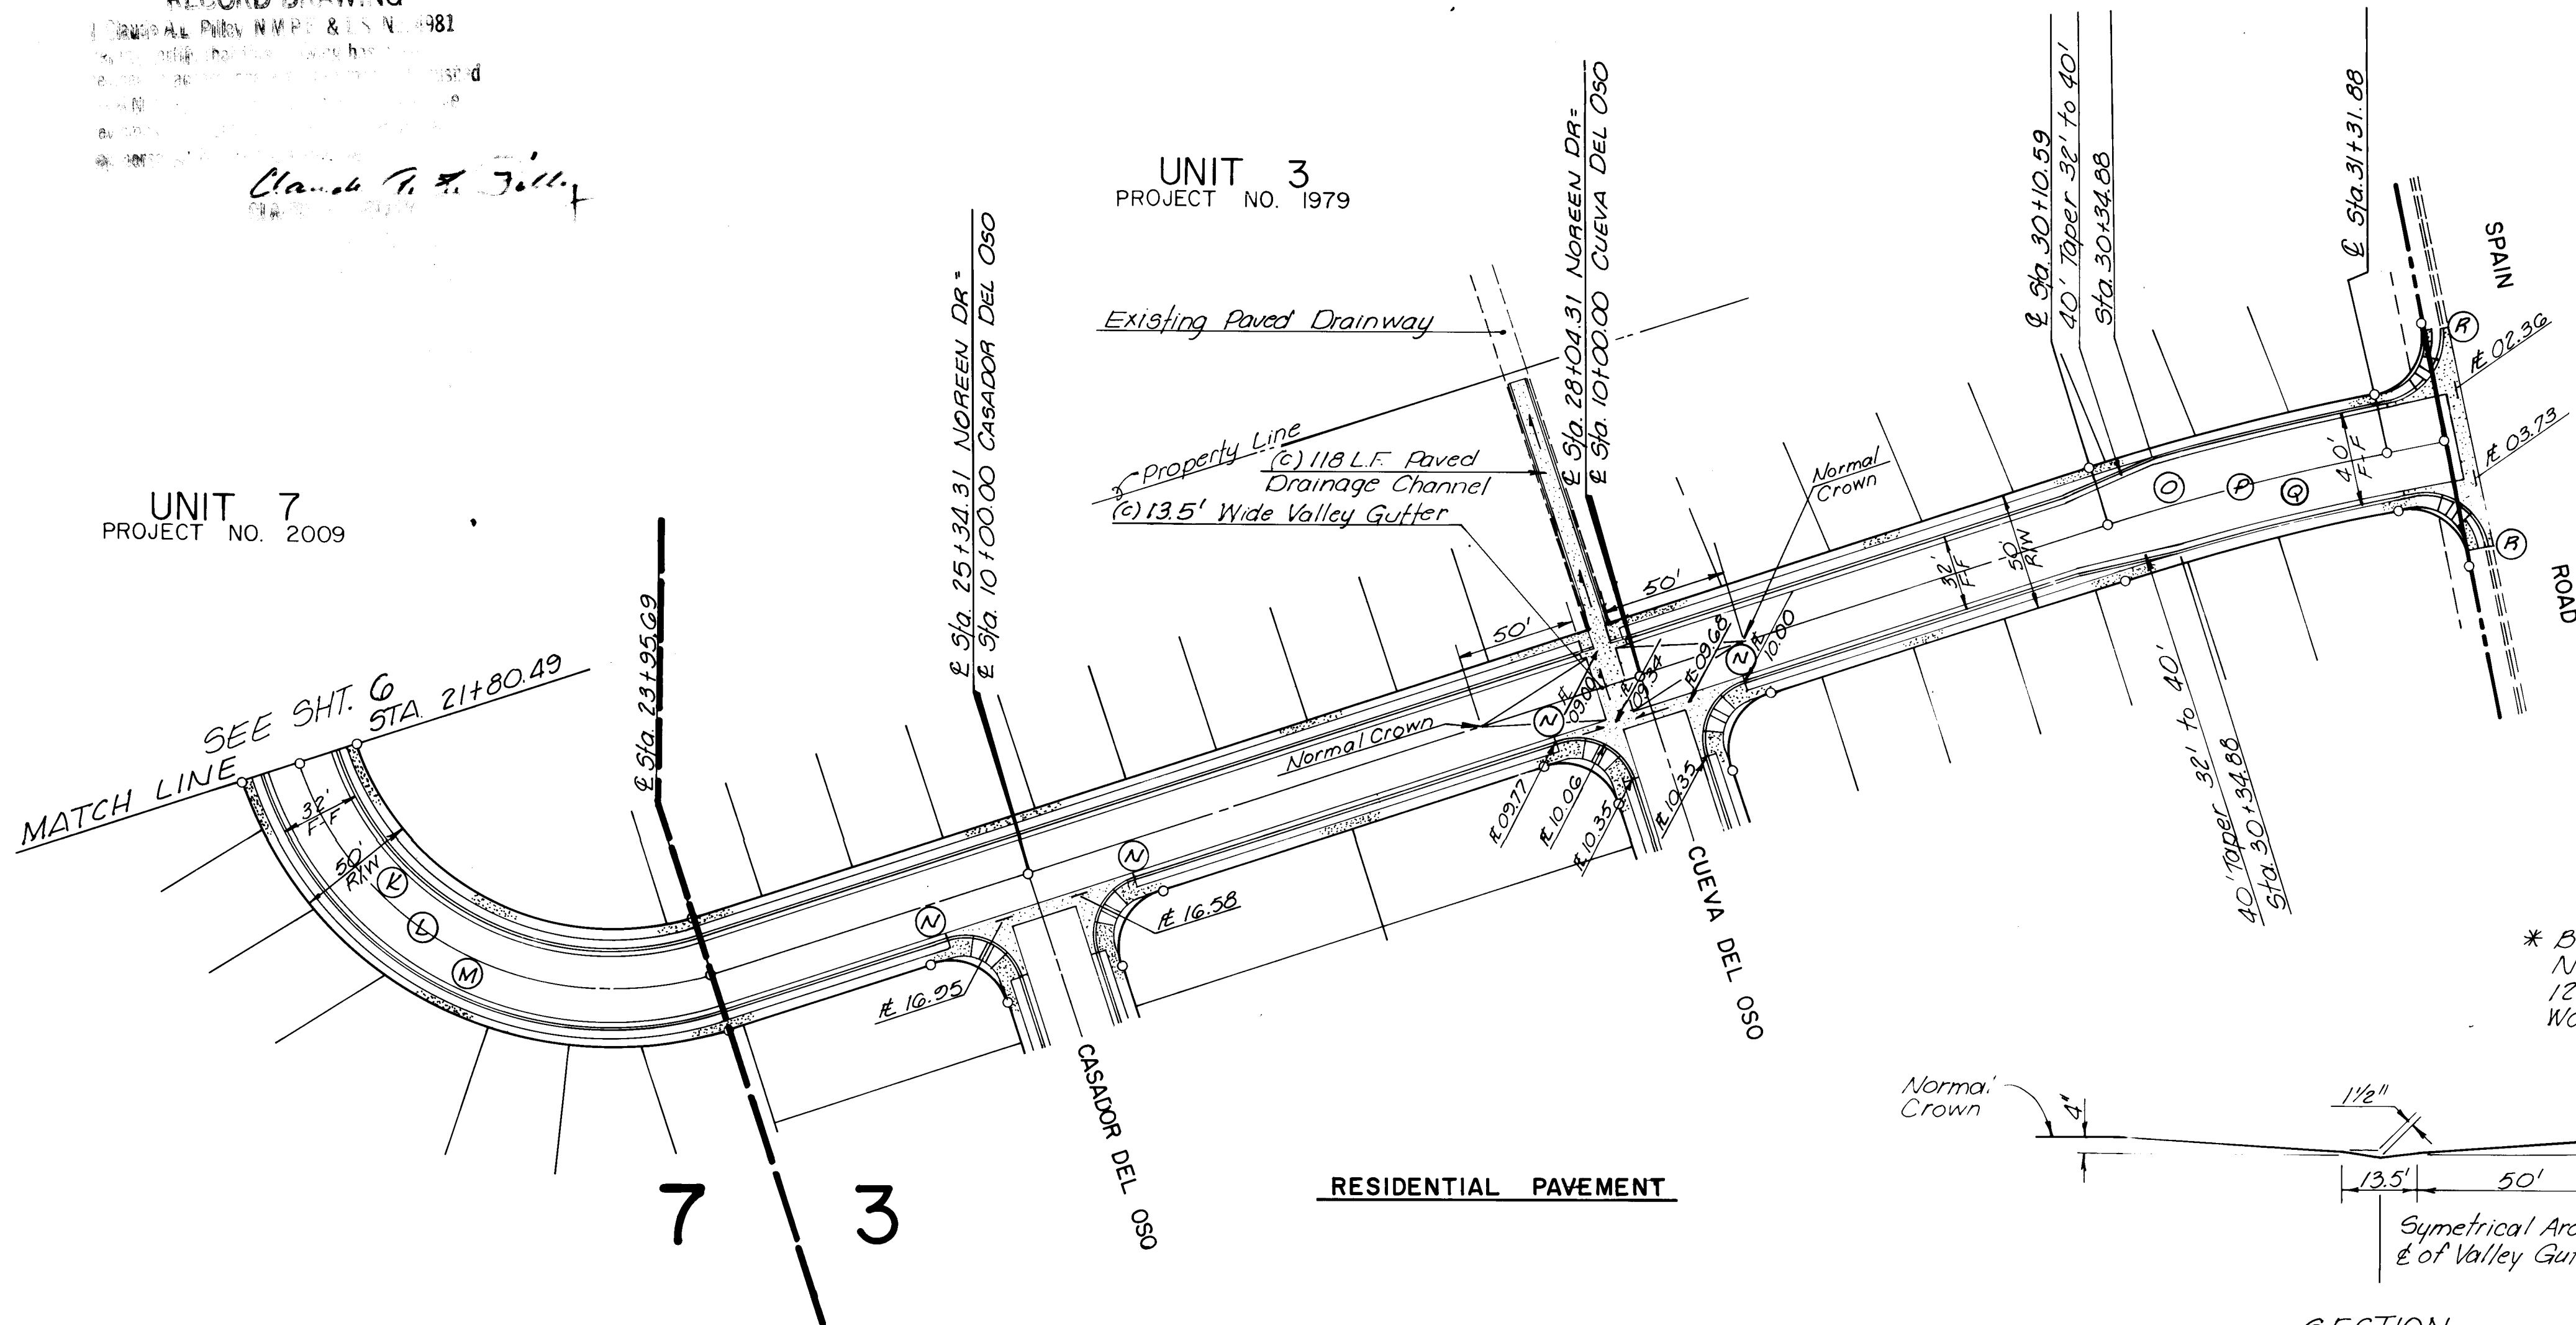

CURVE DATA		
CURVE K	CURVE L	CURVE M
$\Delta = 90^{\circ}00'00''$	$\Delta = 90^{\circ}00'00''$	$\Delta = 90^{\circ}00'00''$
$R = 121.00'$	$R = 137.00'$	$R = 153.00'$
$L = 190.07'$	$L = 215.20'$	$L = 240.33'$
$T = 121.00'$	$T = 137.00'$	$T = 153.00'$
CURVE N	CURVE O	CURVE P
$\Delta = 90^{\circ}00'00''$	$\Delta = 06^{\circ}41'17''$	$\Delta = 06^{\circ}41'17''$
$R = 25.00'$	$R = 1053.10'$	$R = 1039.10'$
$L = 39.27'$	$L = 123.63'$	$L = 121.23'$
$T = 25.00'$	$T = 61.65'$	$T = 60.72'$
CURVE Q	CURVE R	
$\Delta = 06^{\circ}41'17''$	$\Delta = 90^{\circ}00'00''$	
$R = 1019.10'$	$R = 30.00'$	
$L = 118.96'$	$L = 47.12'$	
$T = 59.78'$	$T = 30.00'$	


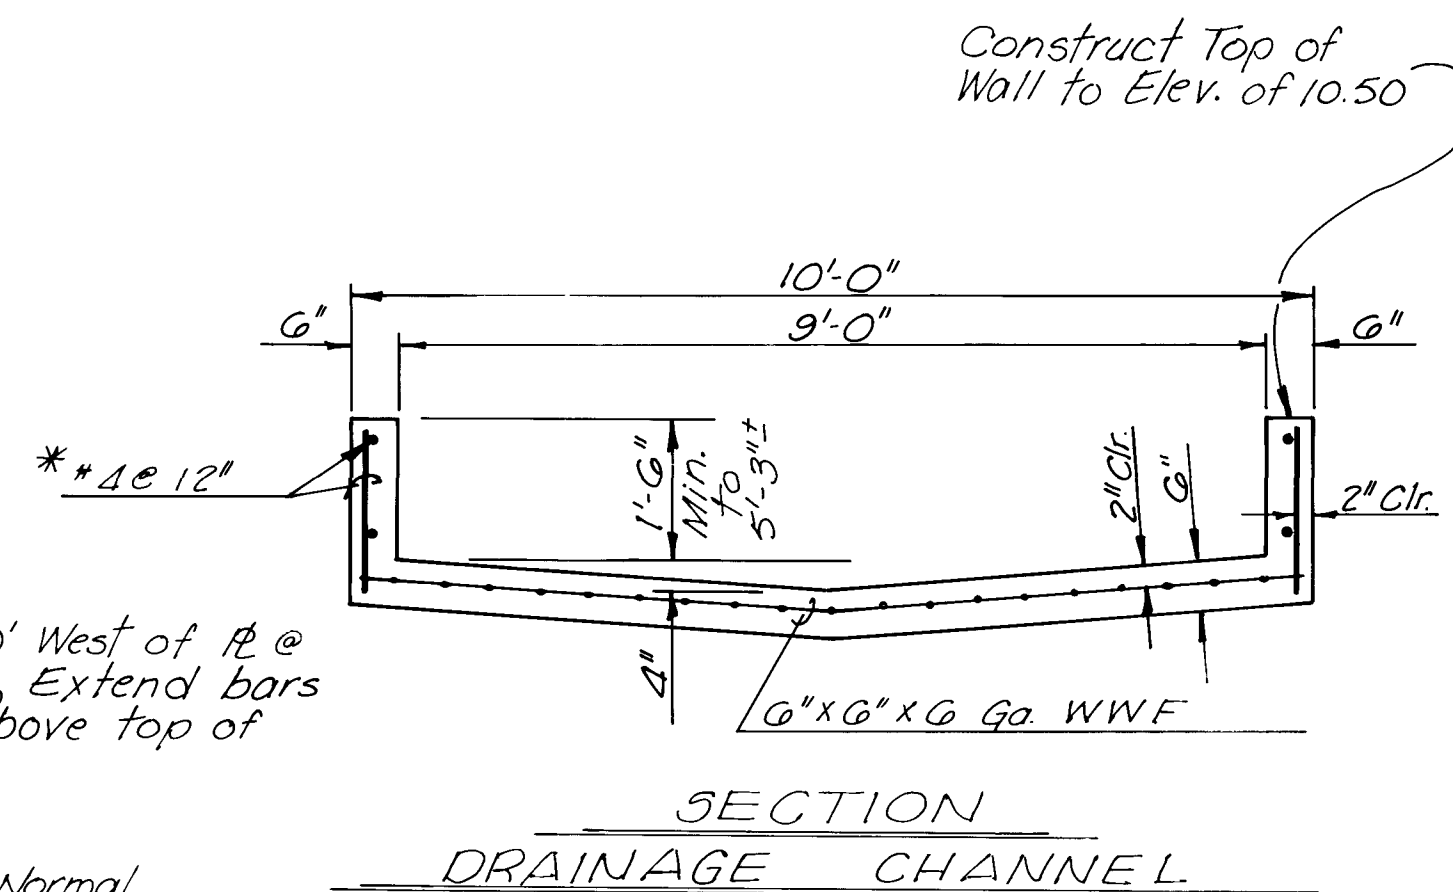


* Beginning 30' West of R @ Nordeen Dr., Extend bars 12" (Min.) Above top of Wall.

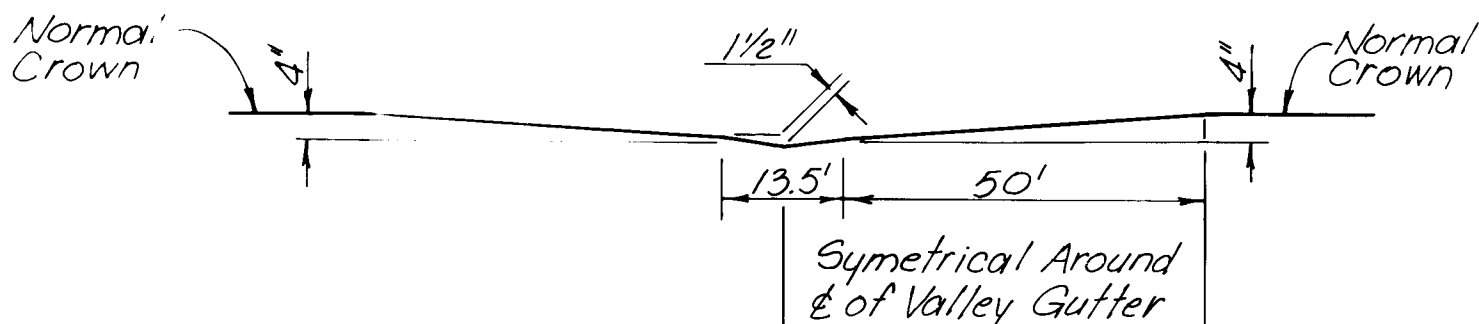

NOREEN DRIVE

SECTION VALLEY GUTTER ACROSS NOREEN DRIVE

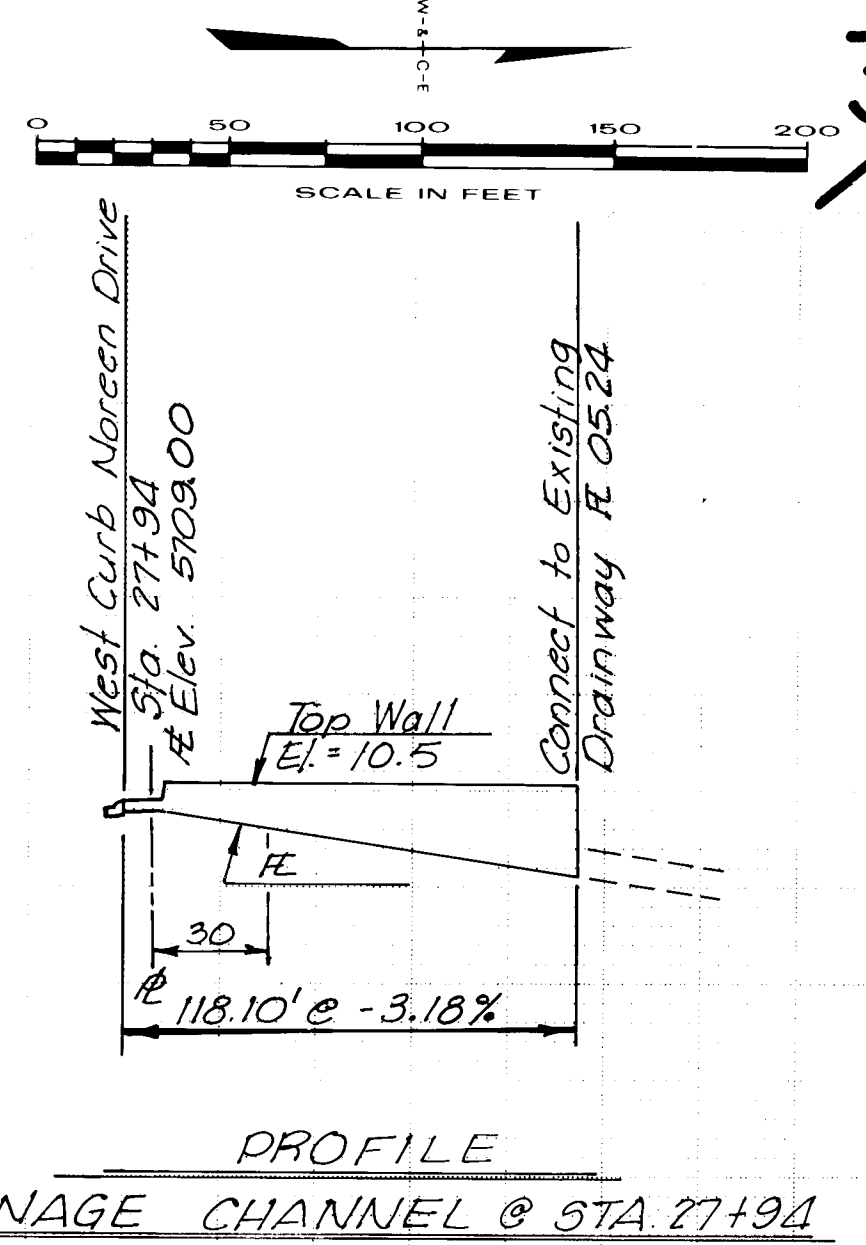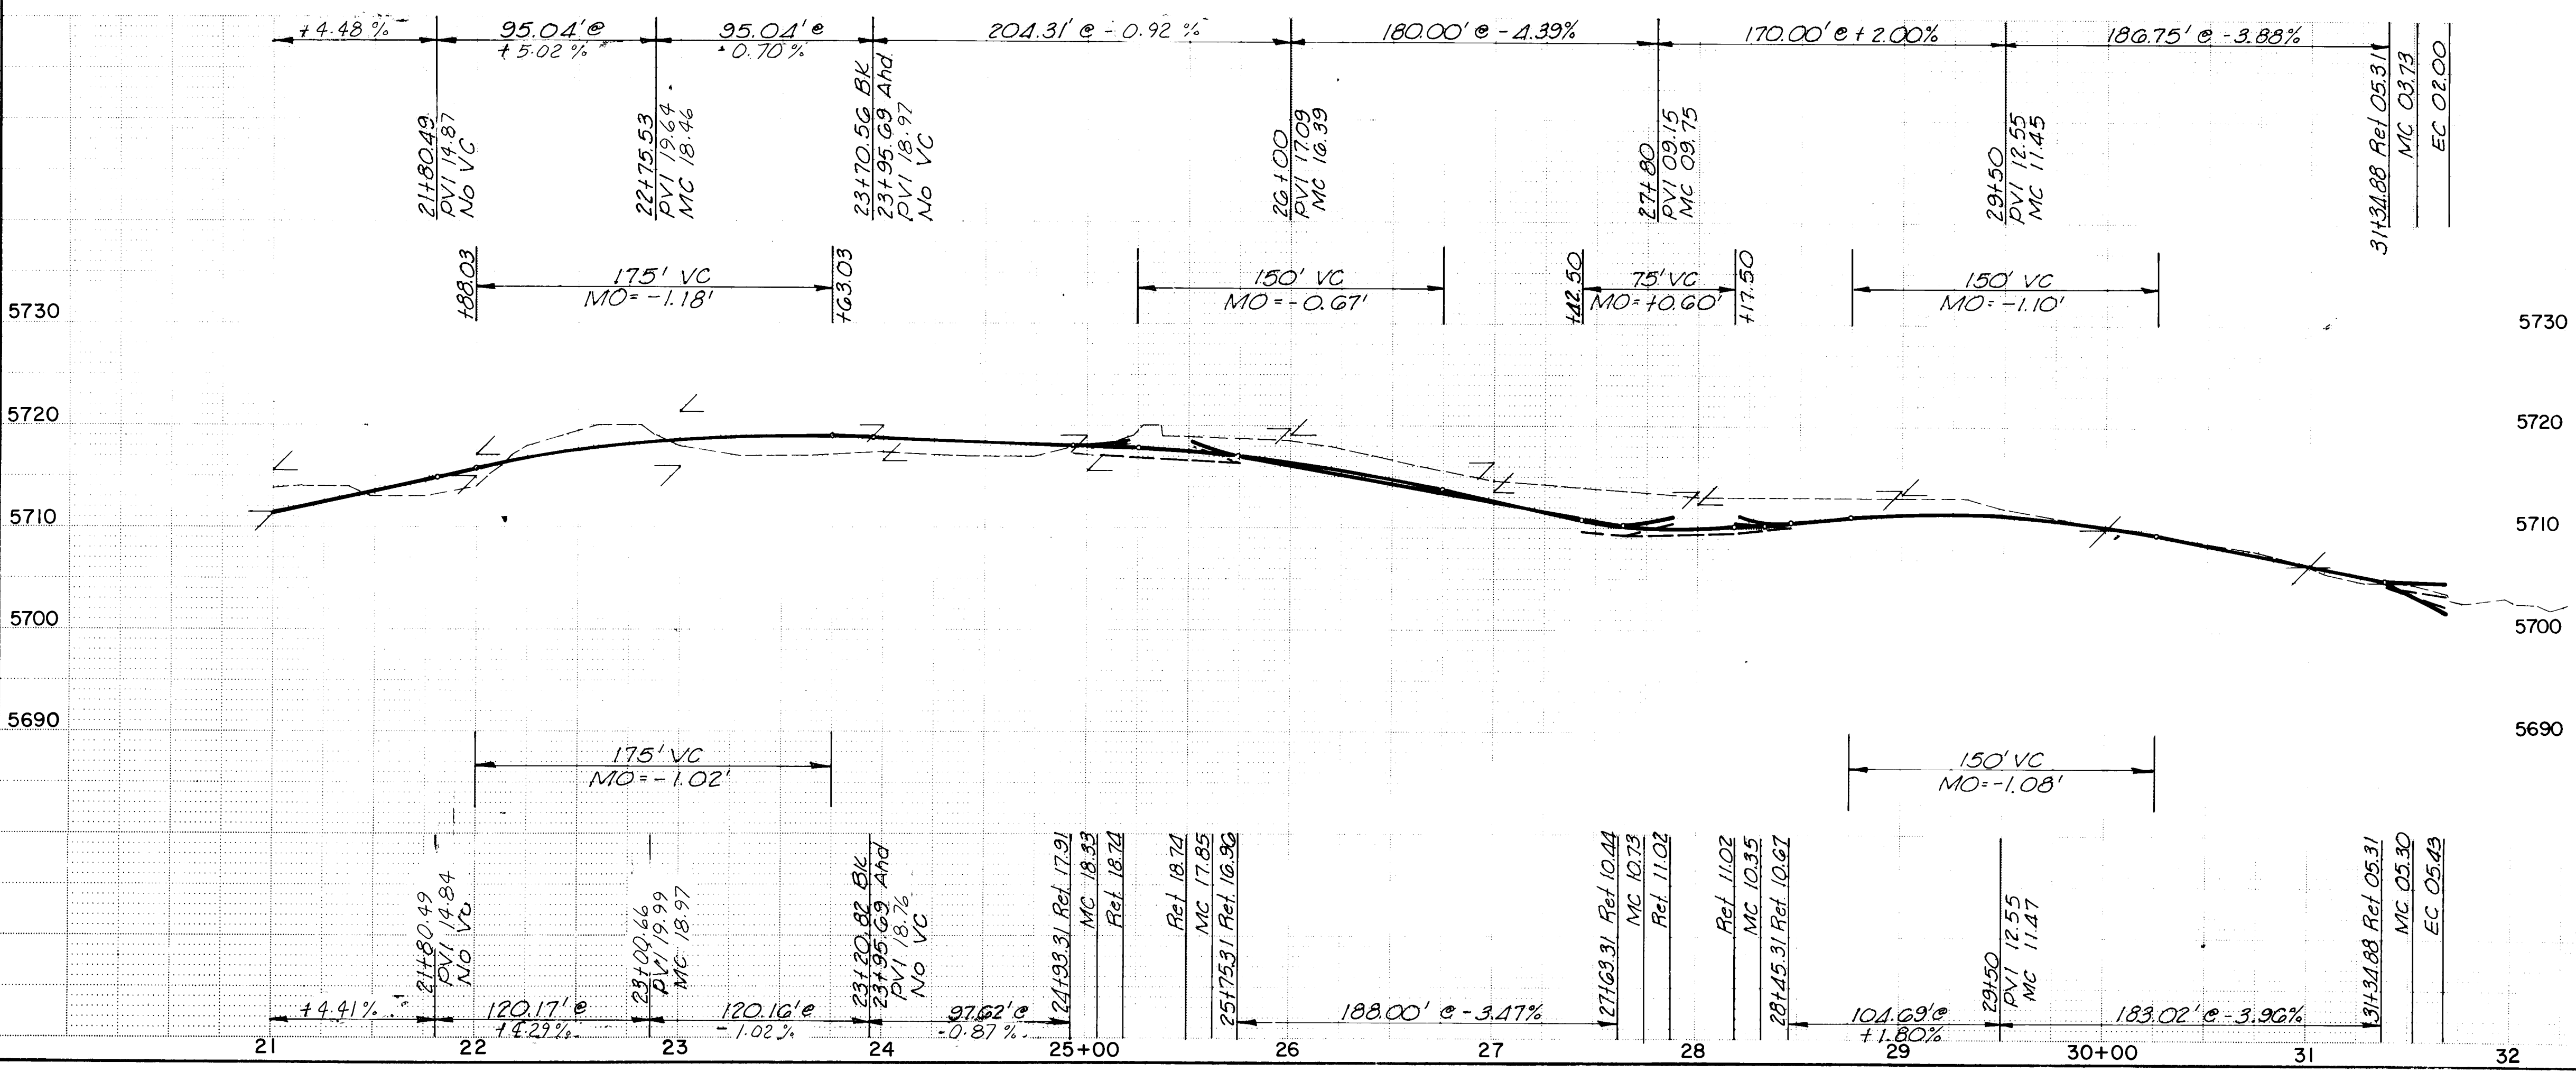

26 2009 0784

APPROVED FOR CONSTRUCTION
CITY ENGINEER DATE


CITY OF ALBUQUERQUE

OSO GRANDE SUBDIVISION

PAVING • NOREEN DRIVE


APPROVALS	ENGINEER	DATE	APPROVALS	ENGINEER	DATE
City Engineer	DA	2/23/04	Traffic	DA	2/23/04
Liquid Waste	DA	2/23/04	Water	DA	2/23/04
A.C.E. Design	DA	2/23/04			
A.C.E. Hydrology	DA	2/23/04			

UNIT 6
PROJECT NO. 2008

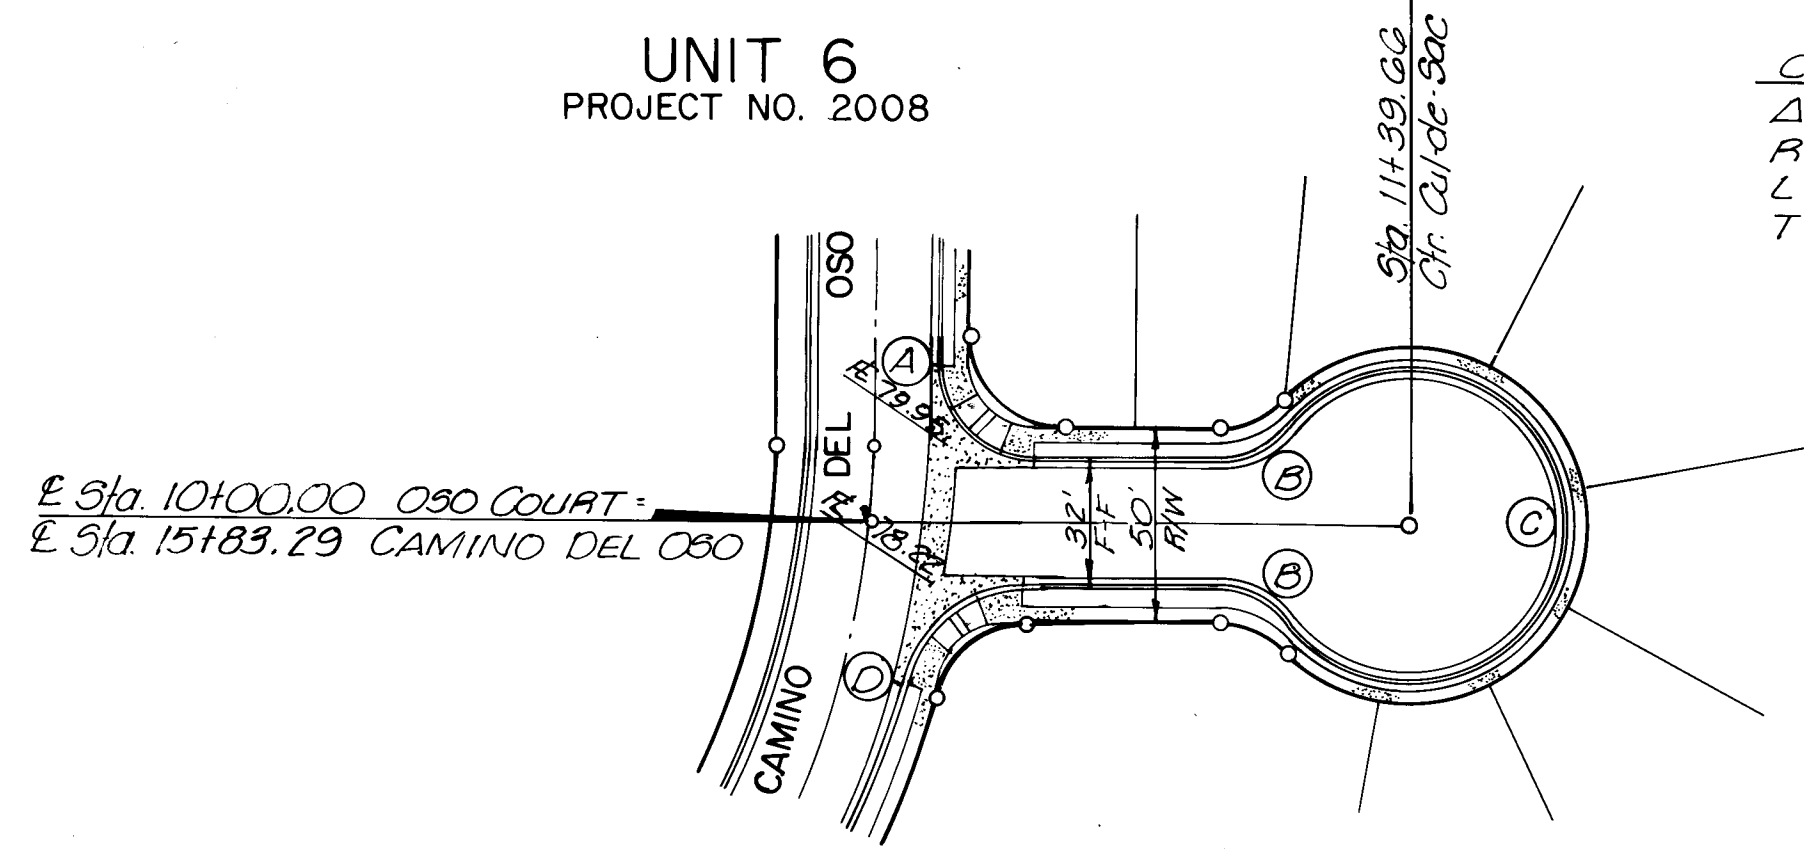


CURVE DATA		
CURVE A	CURVE B	CURVE C
$\Delta = 90^{\circ}00'00''$ $R = 25.00'$ $L = 39.27'$ $T = 25.00'$	$\Delta = 52^{\circ}12'01''$ $R = 22.00'$ $L = 20.04'$ $T = 10.18'$	$\Delta = 284^{\circ}24'02''$ $R = 40.00'$ $L = 198.55'$
CURVE D		
$\Delta = 76^{\circ}53'07''$ $R = 25.00'$ $L = 33.55'$ $T = 19.85'$		

OSO COURT


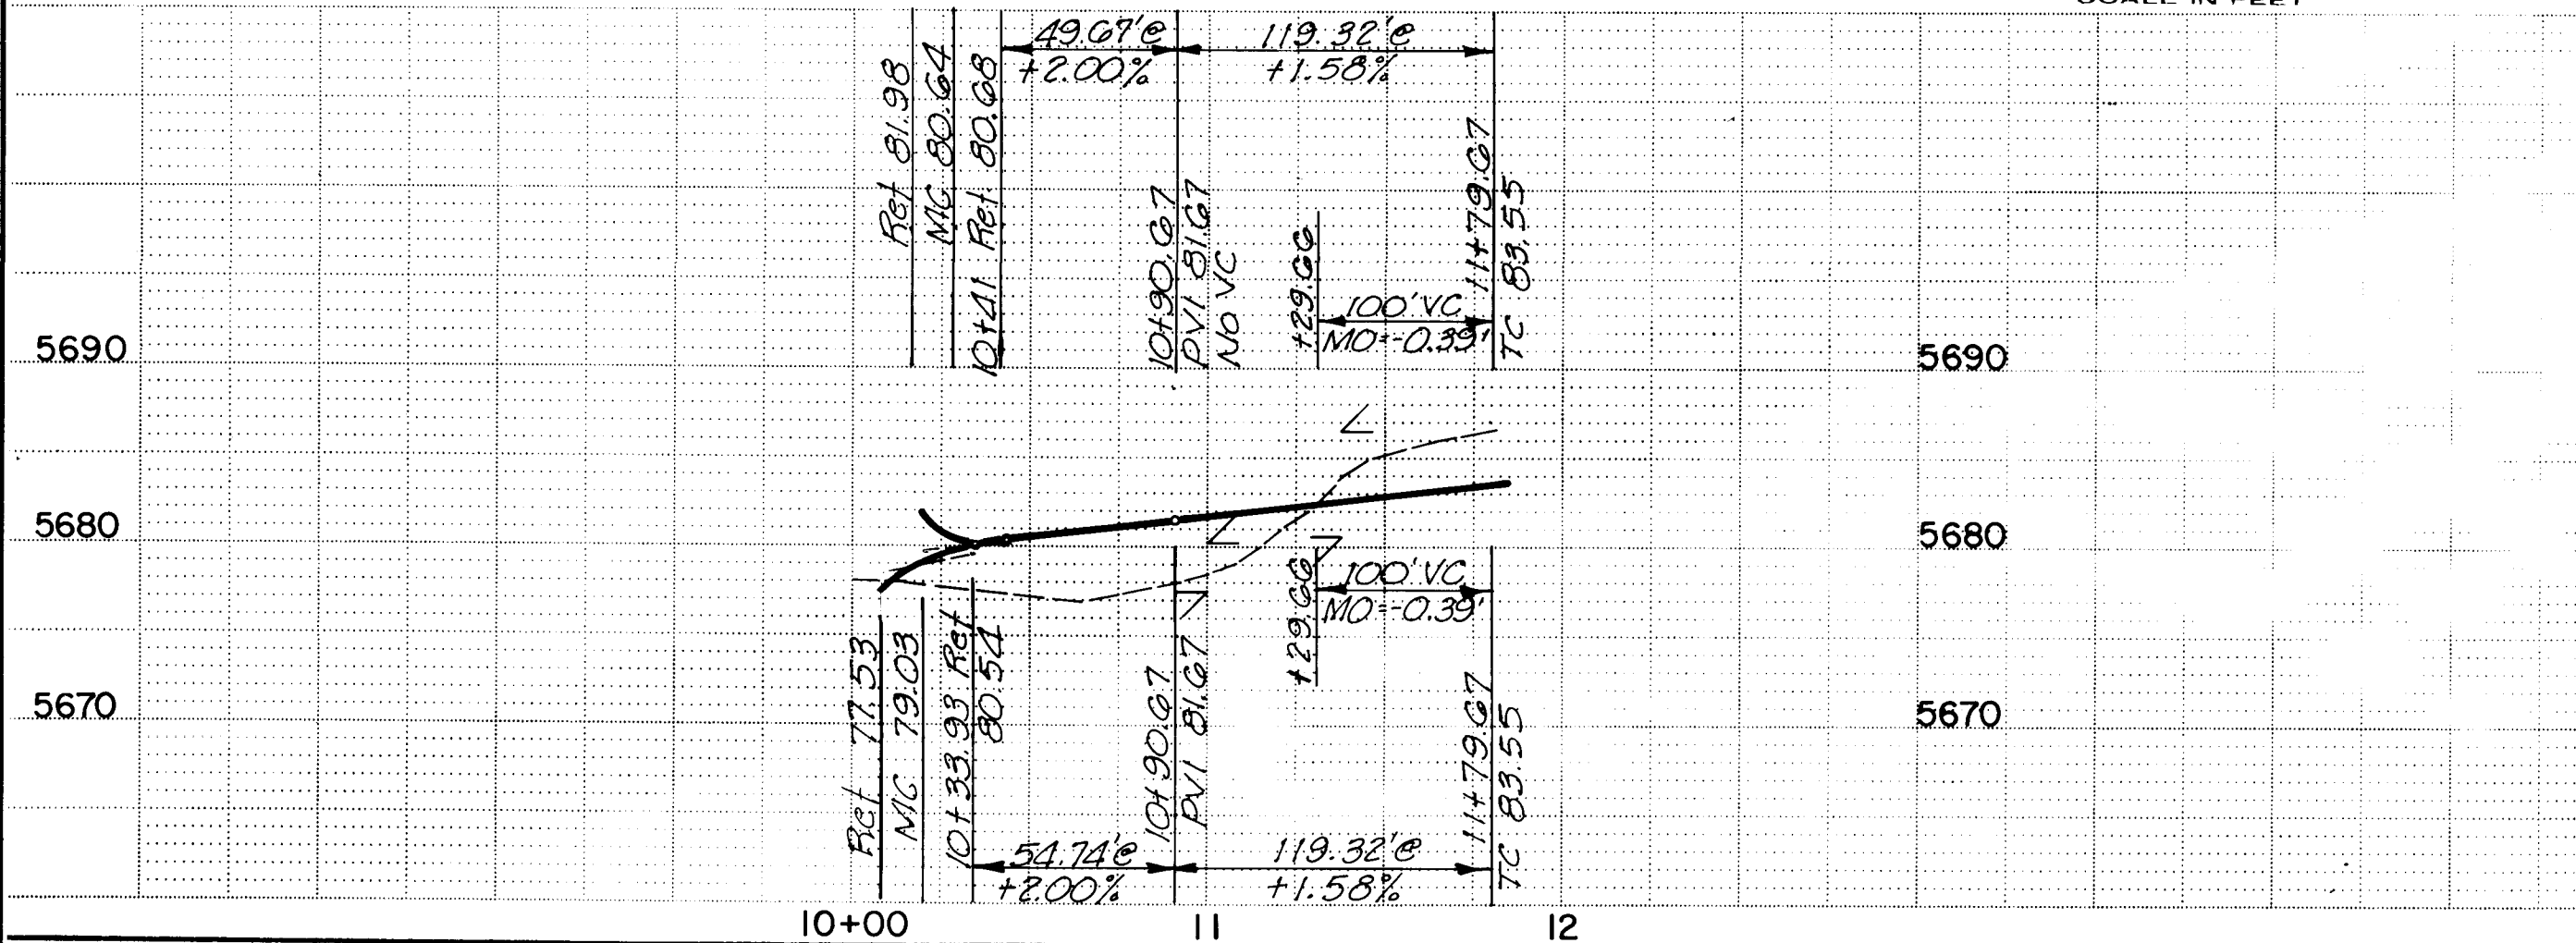


UNIT 8
PROJECT NO. 2010

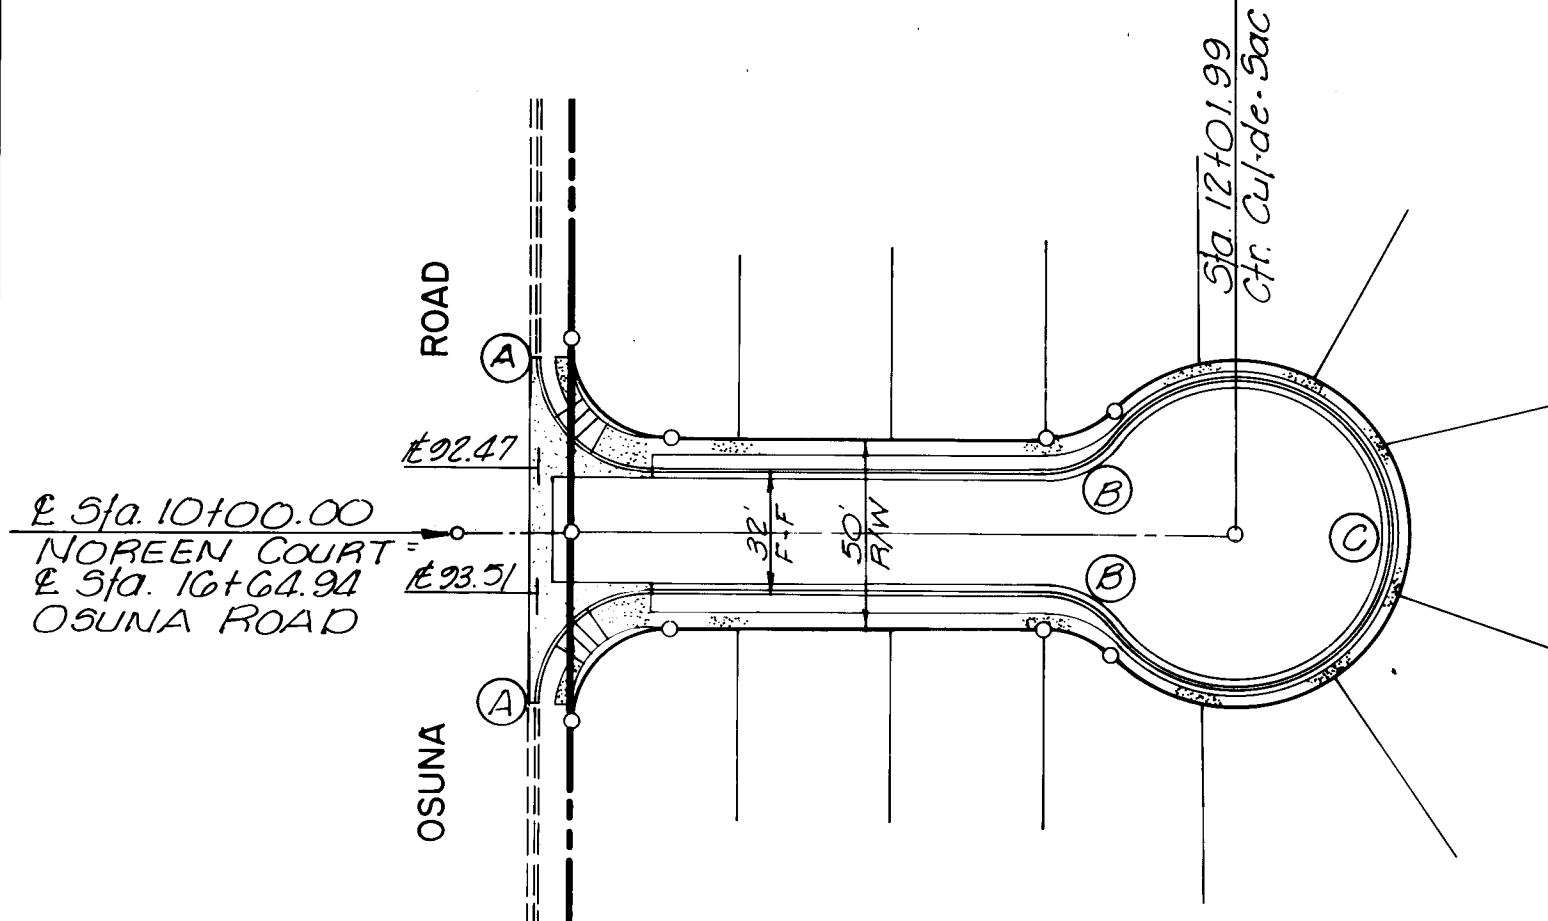

CURVE DATA		
CURVE A	CURVE B	CURVE C
$\Delta = 90^{\circ}00'00''$ $R = 30.00'$ $L = 47.12'$ $T = 30.00'$	$\Delta = 52^{\circ}12'01''$ $R = 22.00'$ $L = 20.04'$ $T = 10.18'$	$\Delta = 284^{\circ}24'02''$ $R = 40.00'$ $L = 198.55'$
CURVE D		
$\Delta = 76^{\circ}53'07''$ $R = 25.00'$ $L = 33.55'$ $T = 19.85'$		

NOREEN COURT

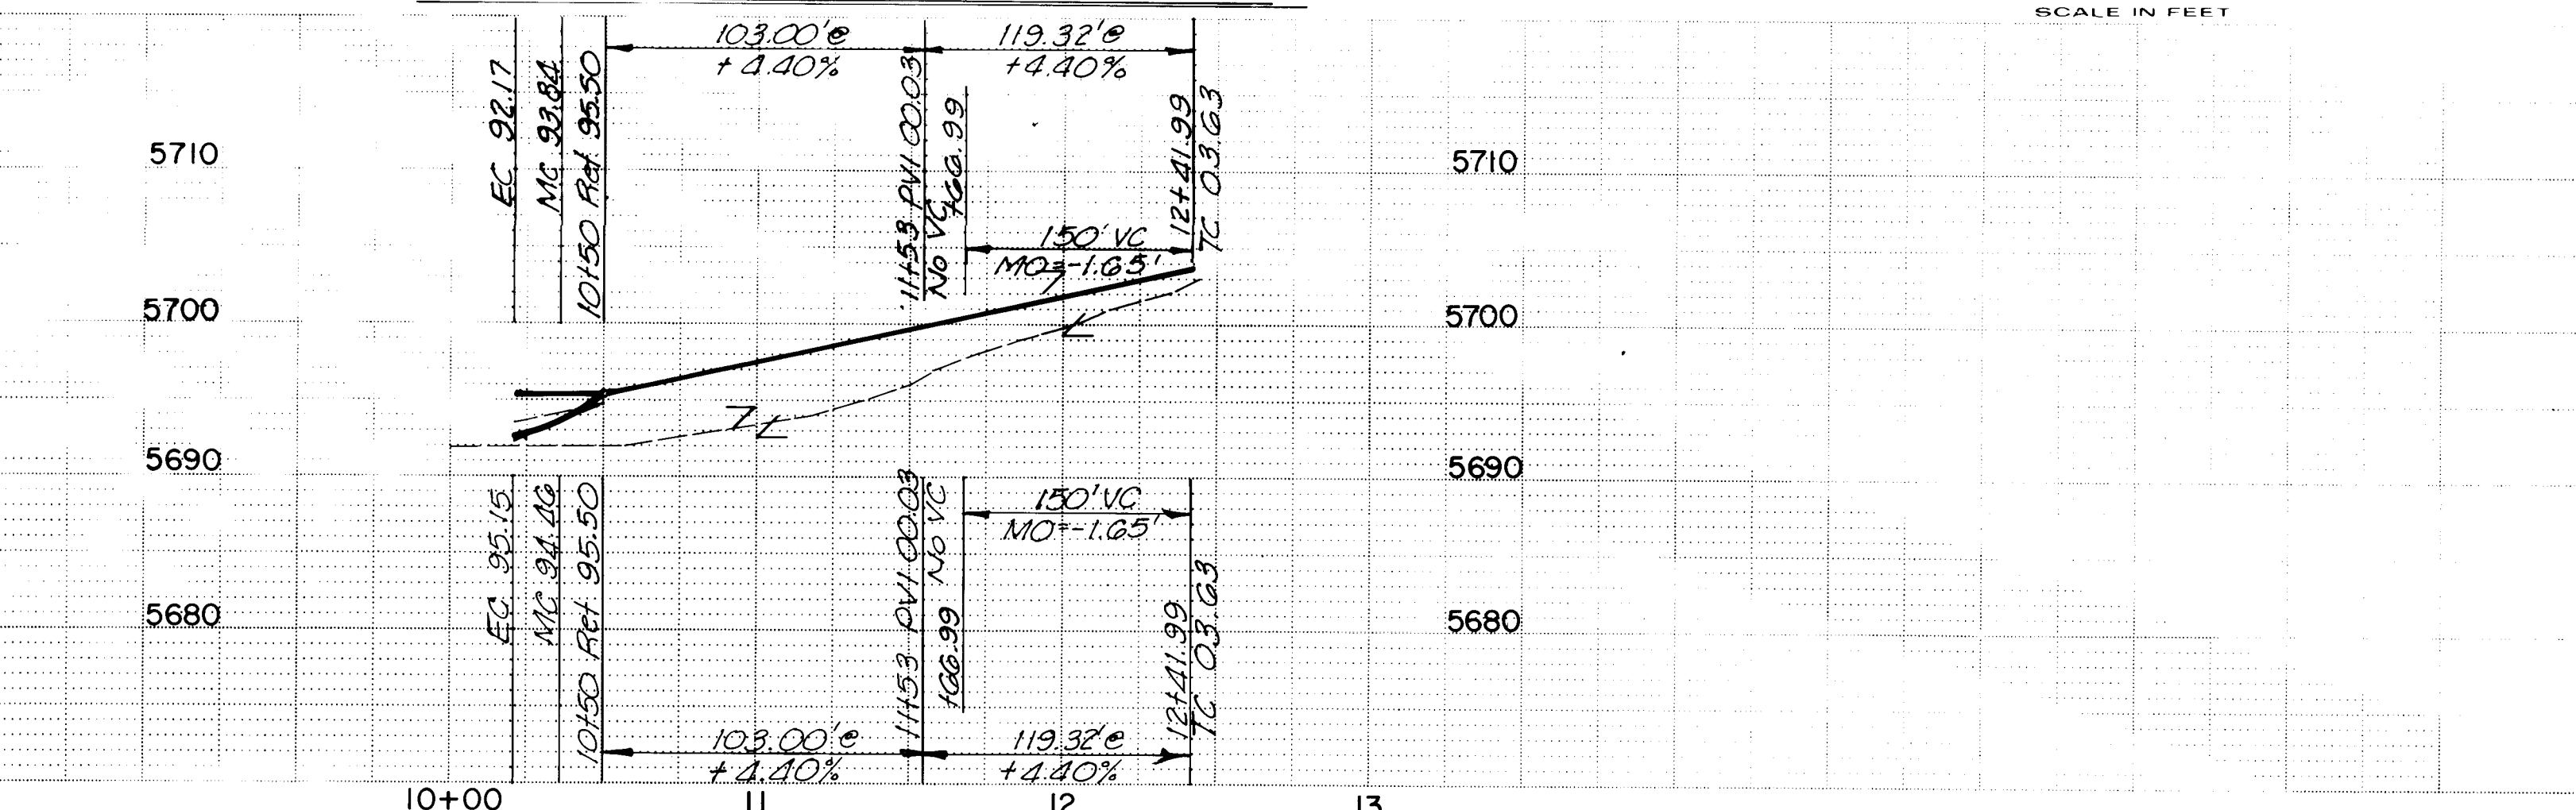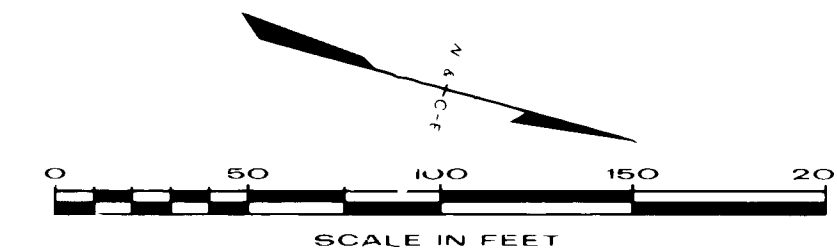

UNIT 7
PROJECT NO. 2009

RECORD

1. Check

2. Check

UNIT 3
PROJECT NO. 1979

UNIT 6
PROJECT NO. 2008

UNIT 7
PROJ. NO. 2009


NOTE

1. Locate all existing utilities both vertically and horizontally prior to starting the installation of water lines and sanitary sewer lines.
2. All service connection based on sanitary sewer manhole stationing.


RECORD DRAWING
No. 4981

Claudio A. Pilling
GRADING ENGINEER

NOREEN DRIVE

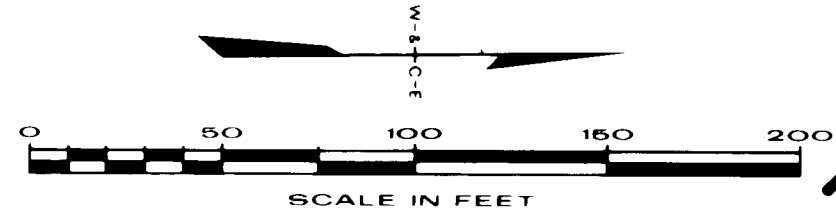

3/7

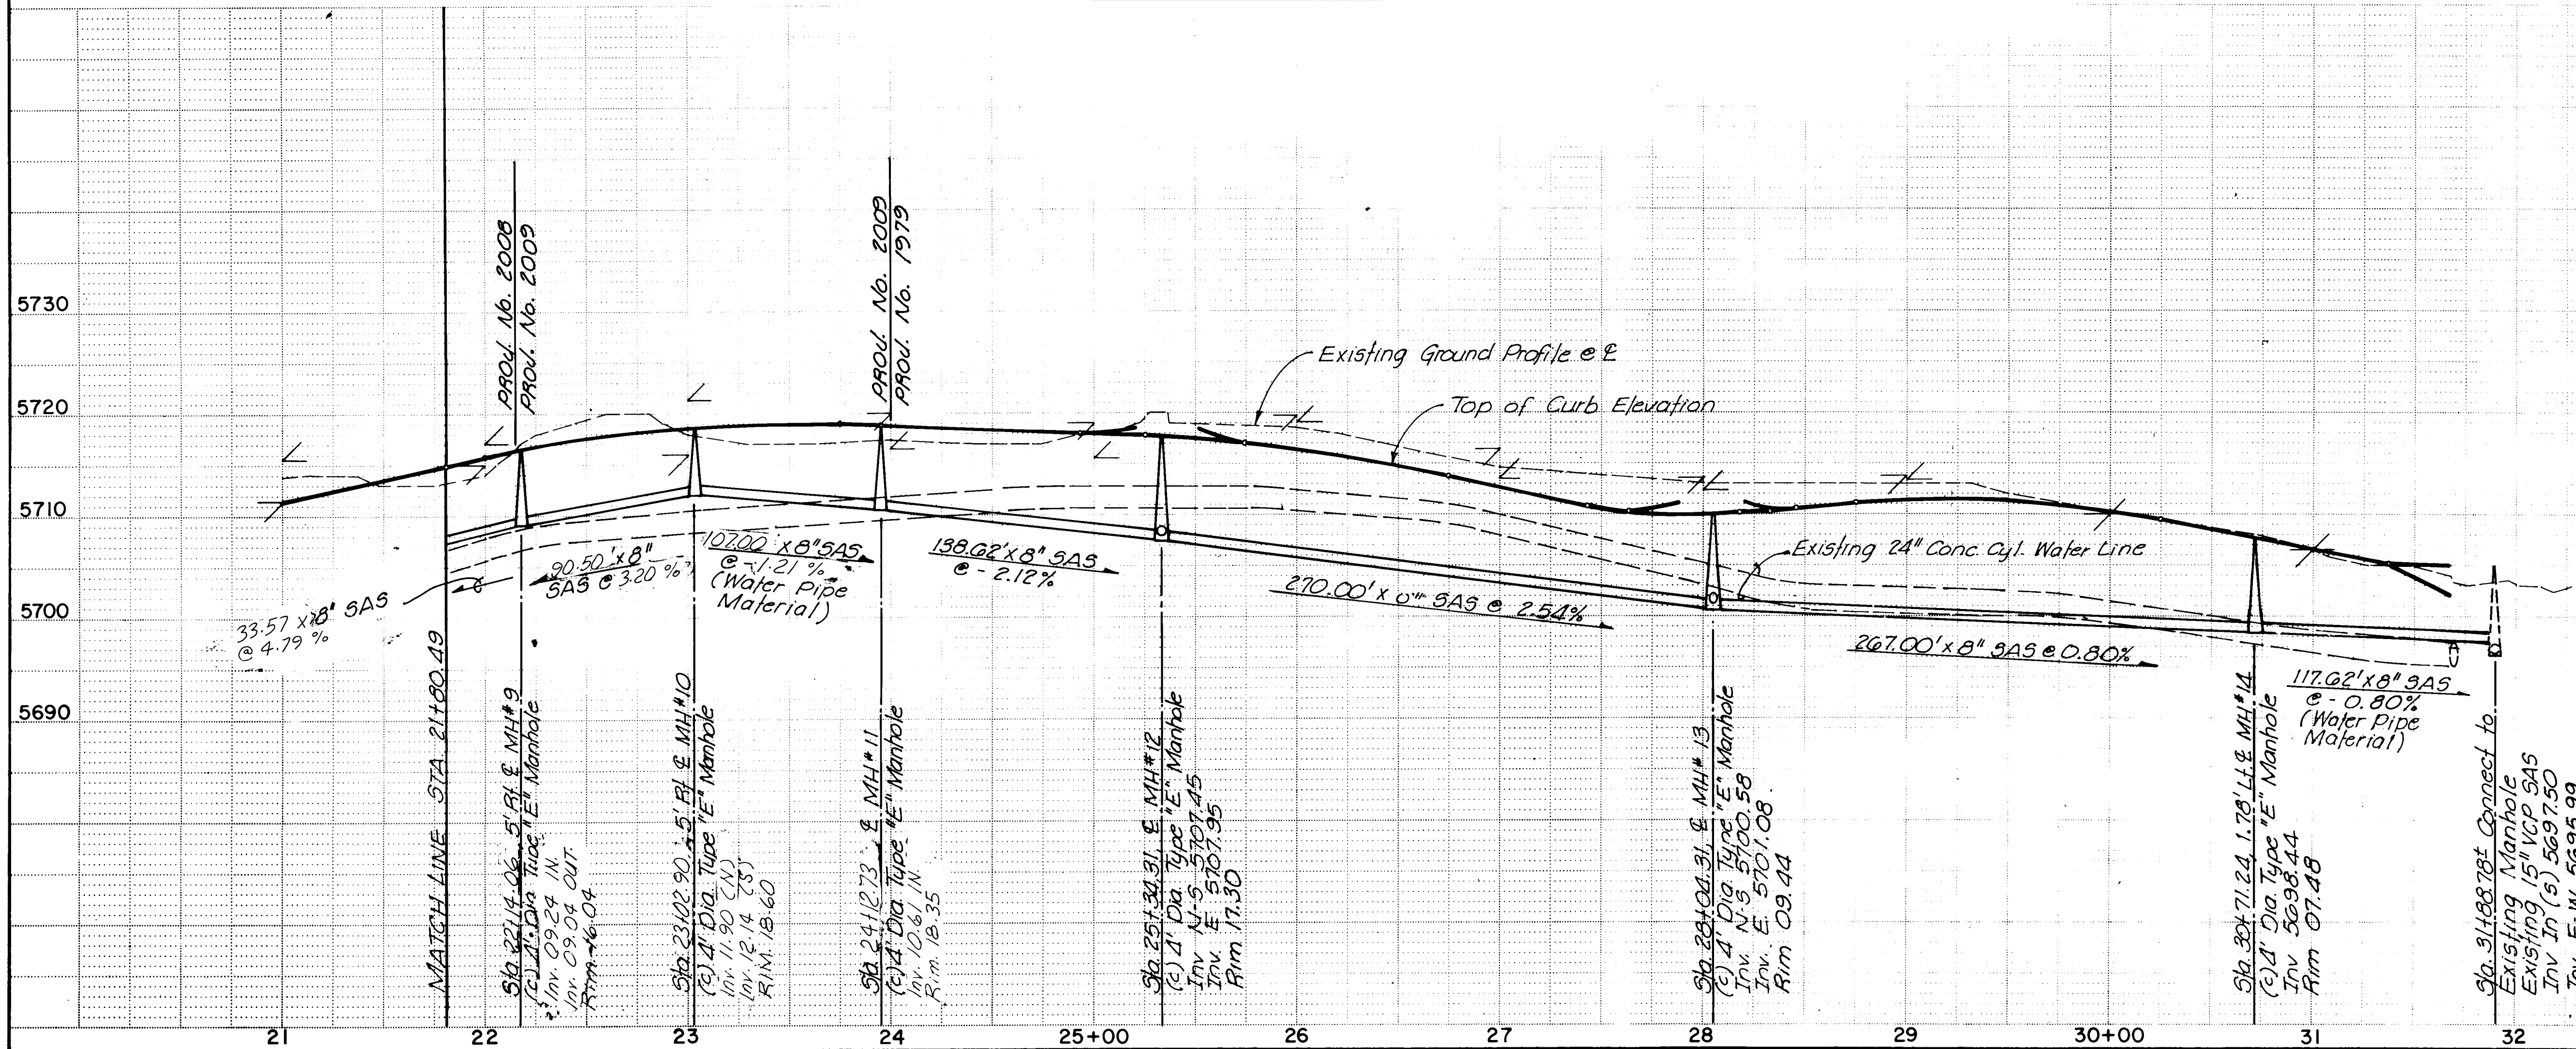

5730
5720
5710
5700
5690

26 2009 09 84

APPROVED FOR
CONSTRUCTION

CITY ENGINEER DATE

CITY OF ALBUQUERQUE

OSO GRANDE SUBDIVISION

SEWER • NOREEN DRIVE


APPROVALS	ENGINEER	DATE	APPROVALS	ENGINEER	DATE
City Engineer	WILSON	7/23/09	Traffic	WILSON	1/28/04
Liquid Waste	WILSON	1-30-04	Water	WILSON	1-30-04
A.C.E. - Design	WILSON	1-30-04	A.C.E. - Hydrology	WILSON	1-30-04

2009 SHEET 9 OF 13


WILSON & COMPANY
ENGINEERS & ARCHITECTS
ALBUQUERQUE, NEW MEXICO

85-506 B


UNIT 6
PROJECT NO. 2008

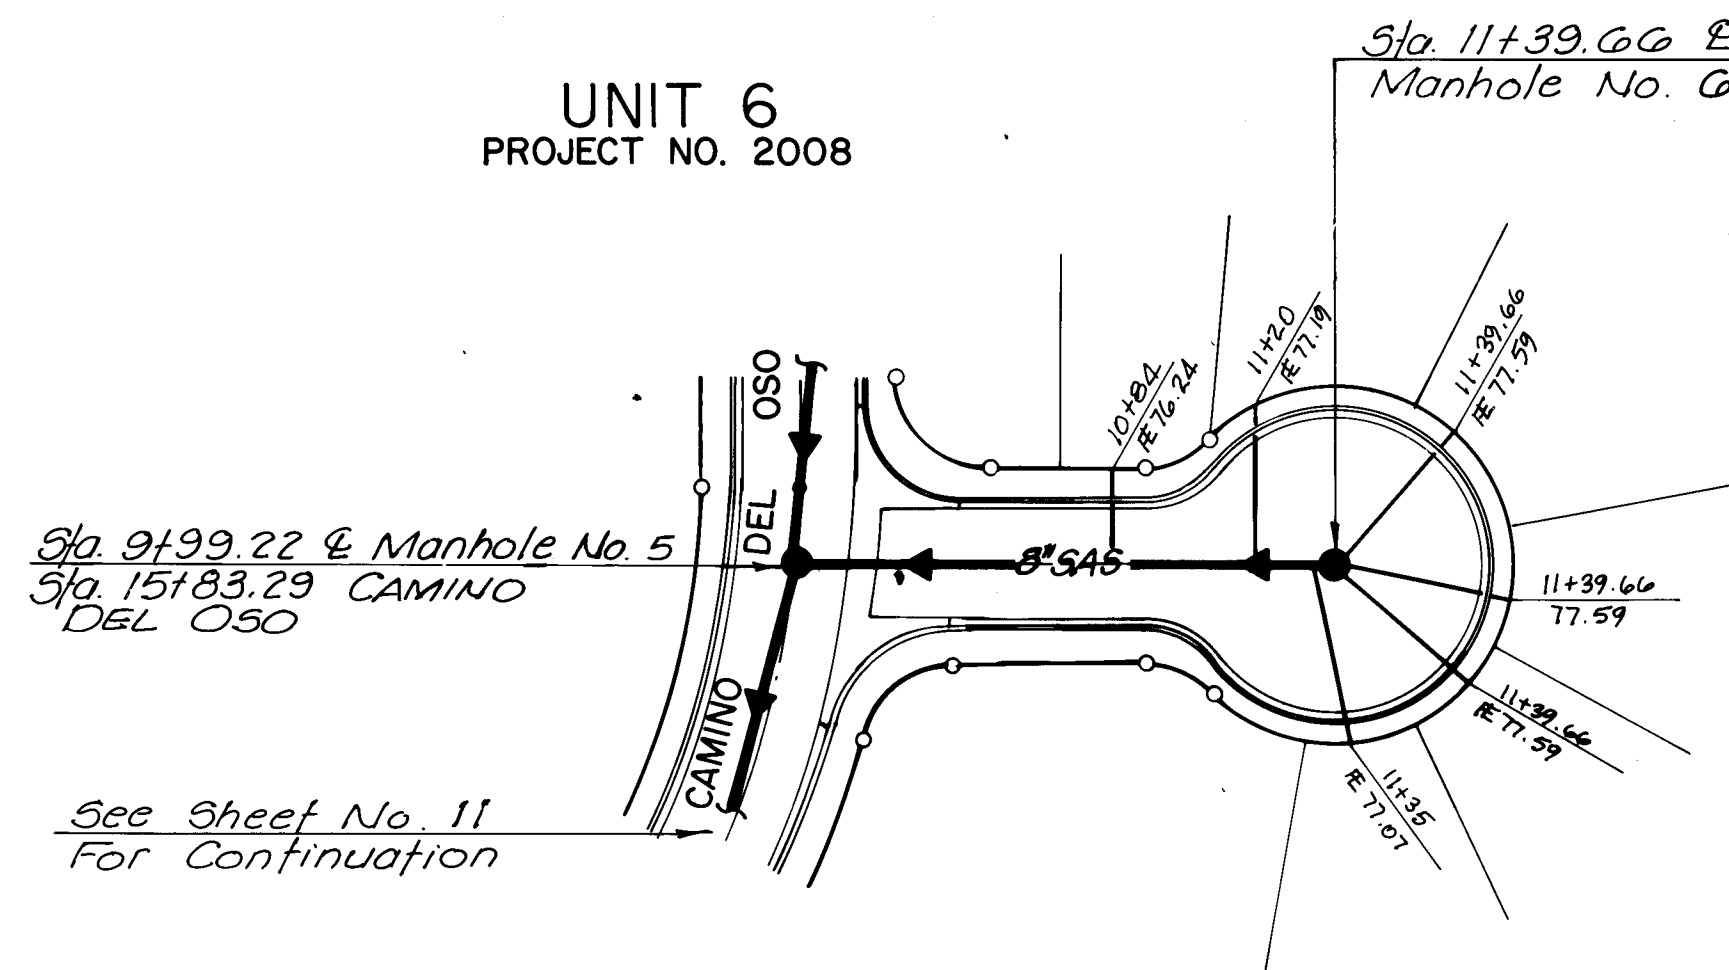

OSO COURT

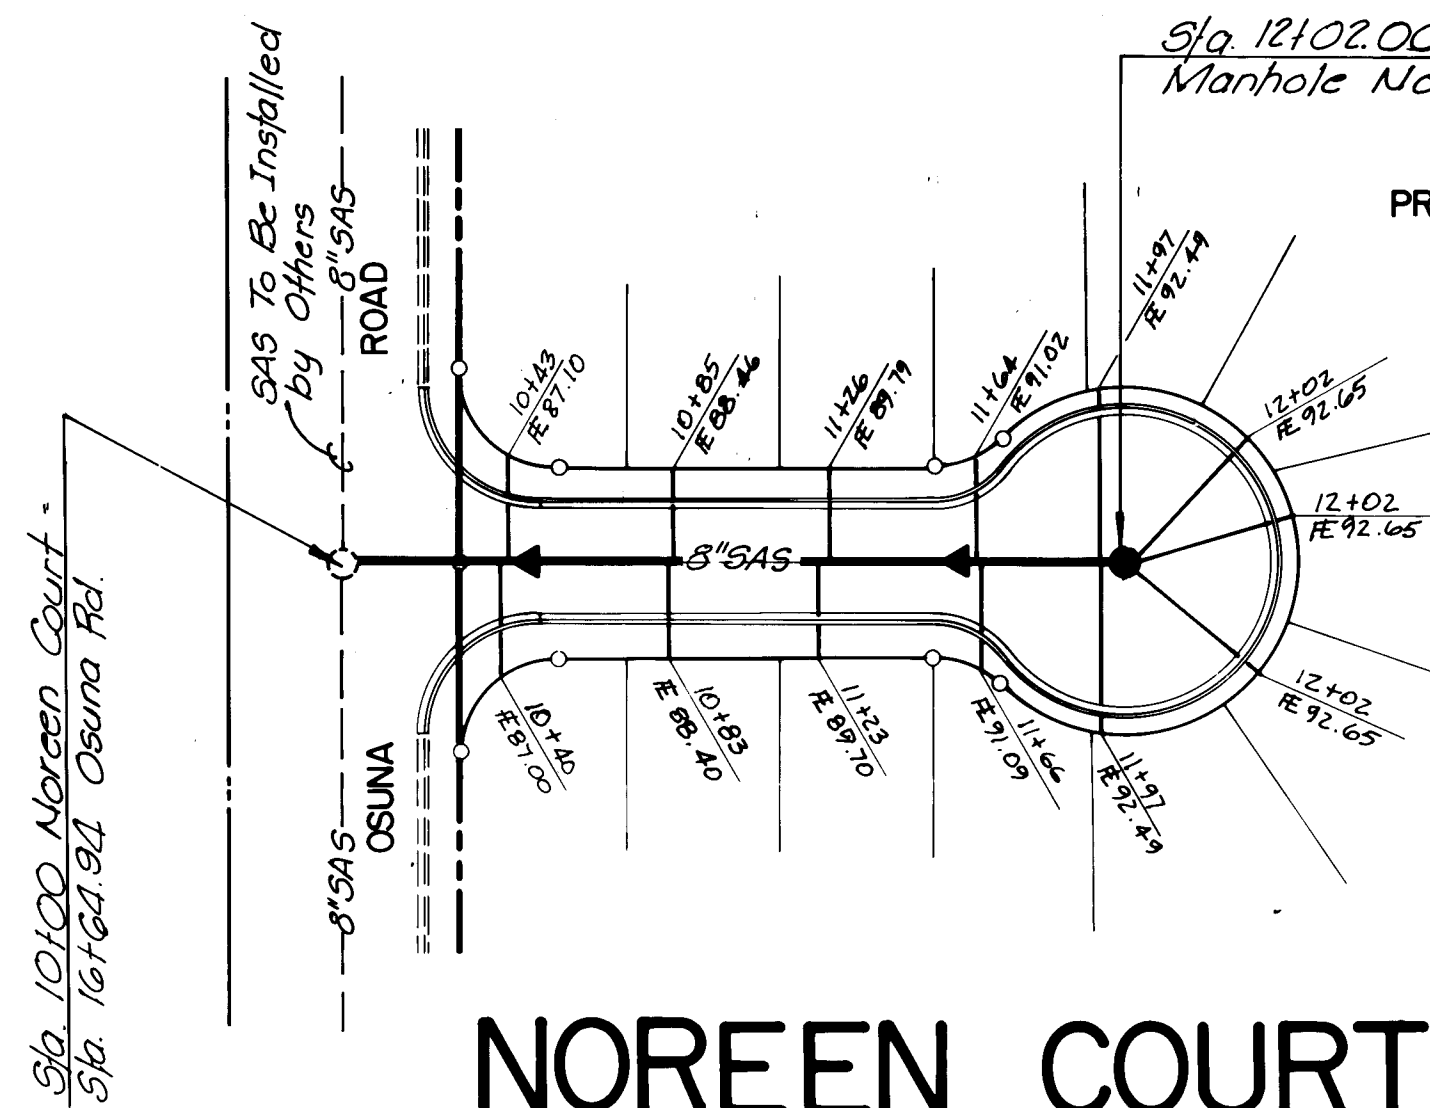

NOREEN COURT

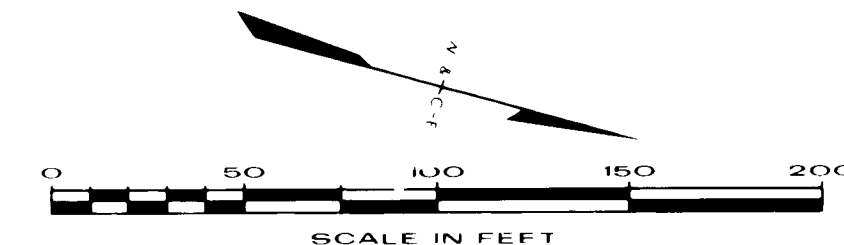


NOTE

1. Locate all existing utilities both vertically and horizontally prior to starting the installation of water lines and sanitary sewer lines.
2. All service connection based on sanitary sewer manhole stationing.


UNIT 8
PROJECT NO. 2010

5690
5680
5670

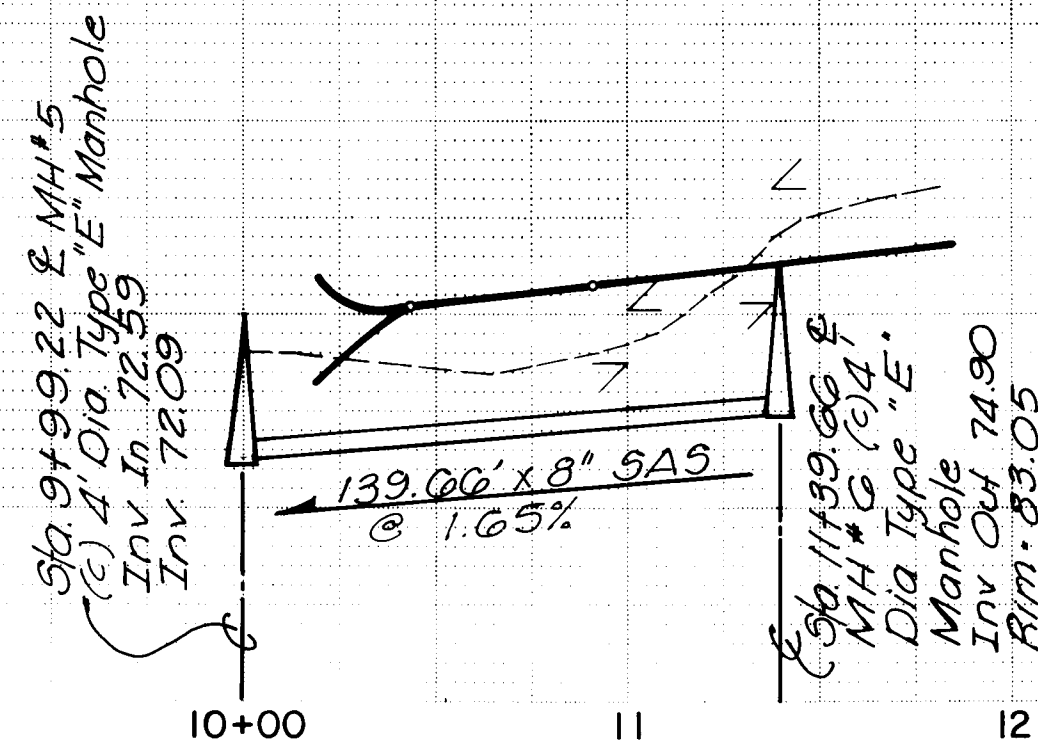


5690
5680
5670

5710
5700
5690
5680

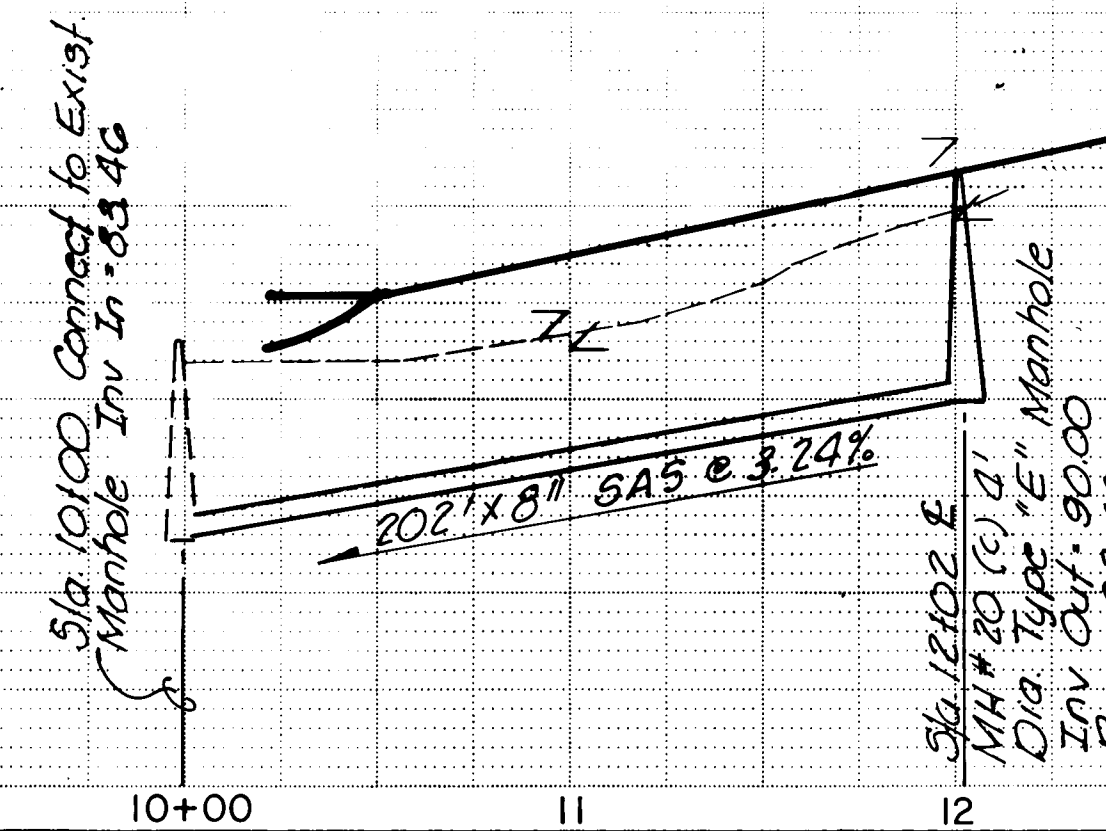

5710
5700
5690
5680

UNIT 7
PROJECT NO. 2009

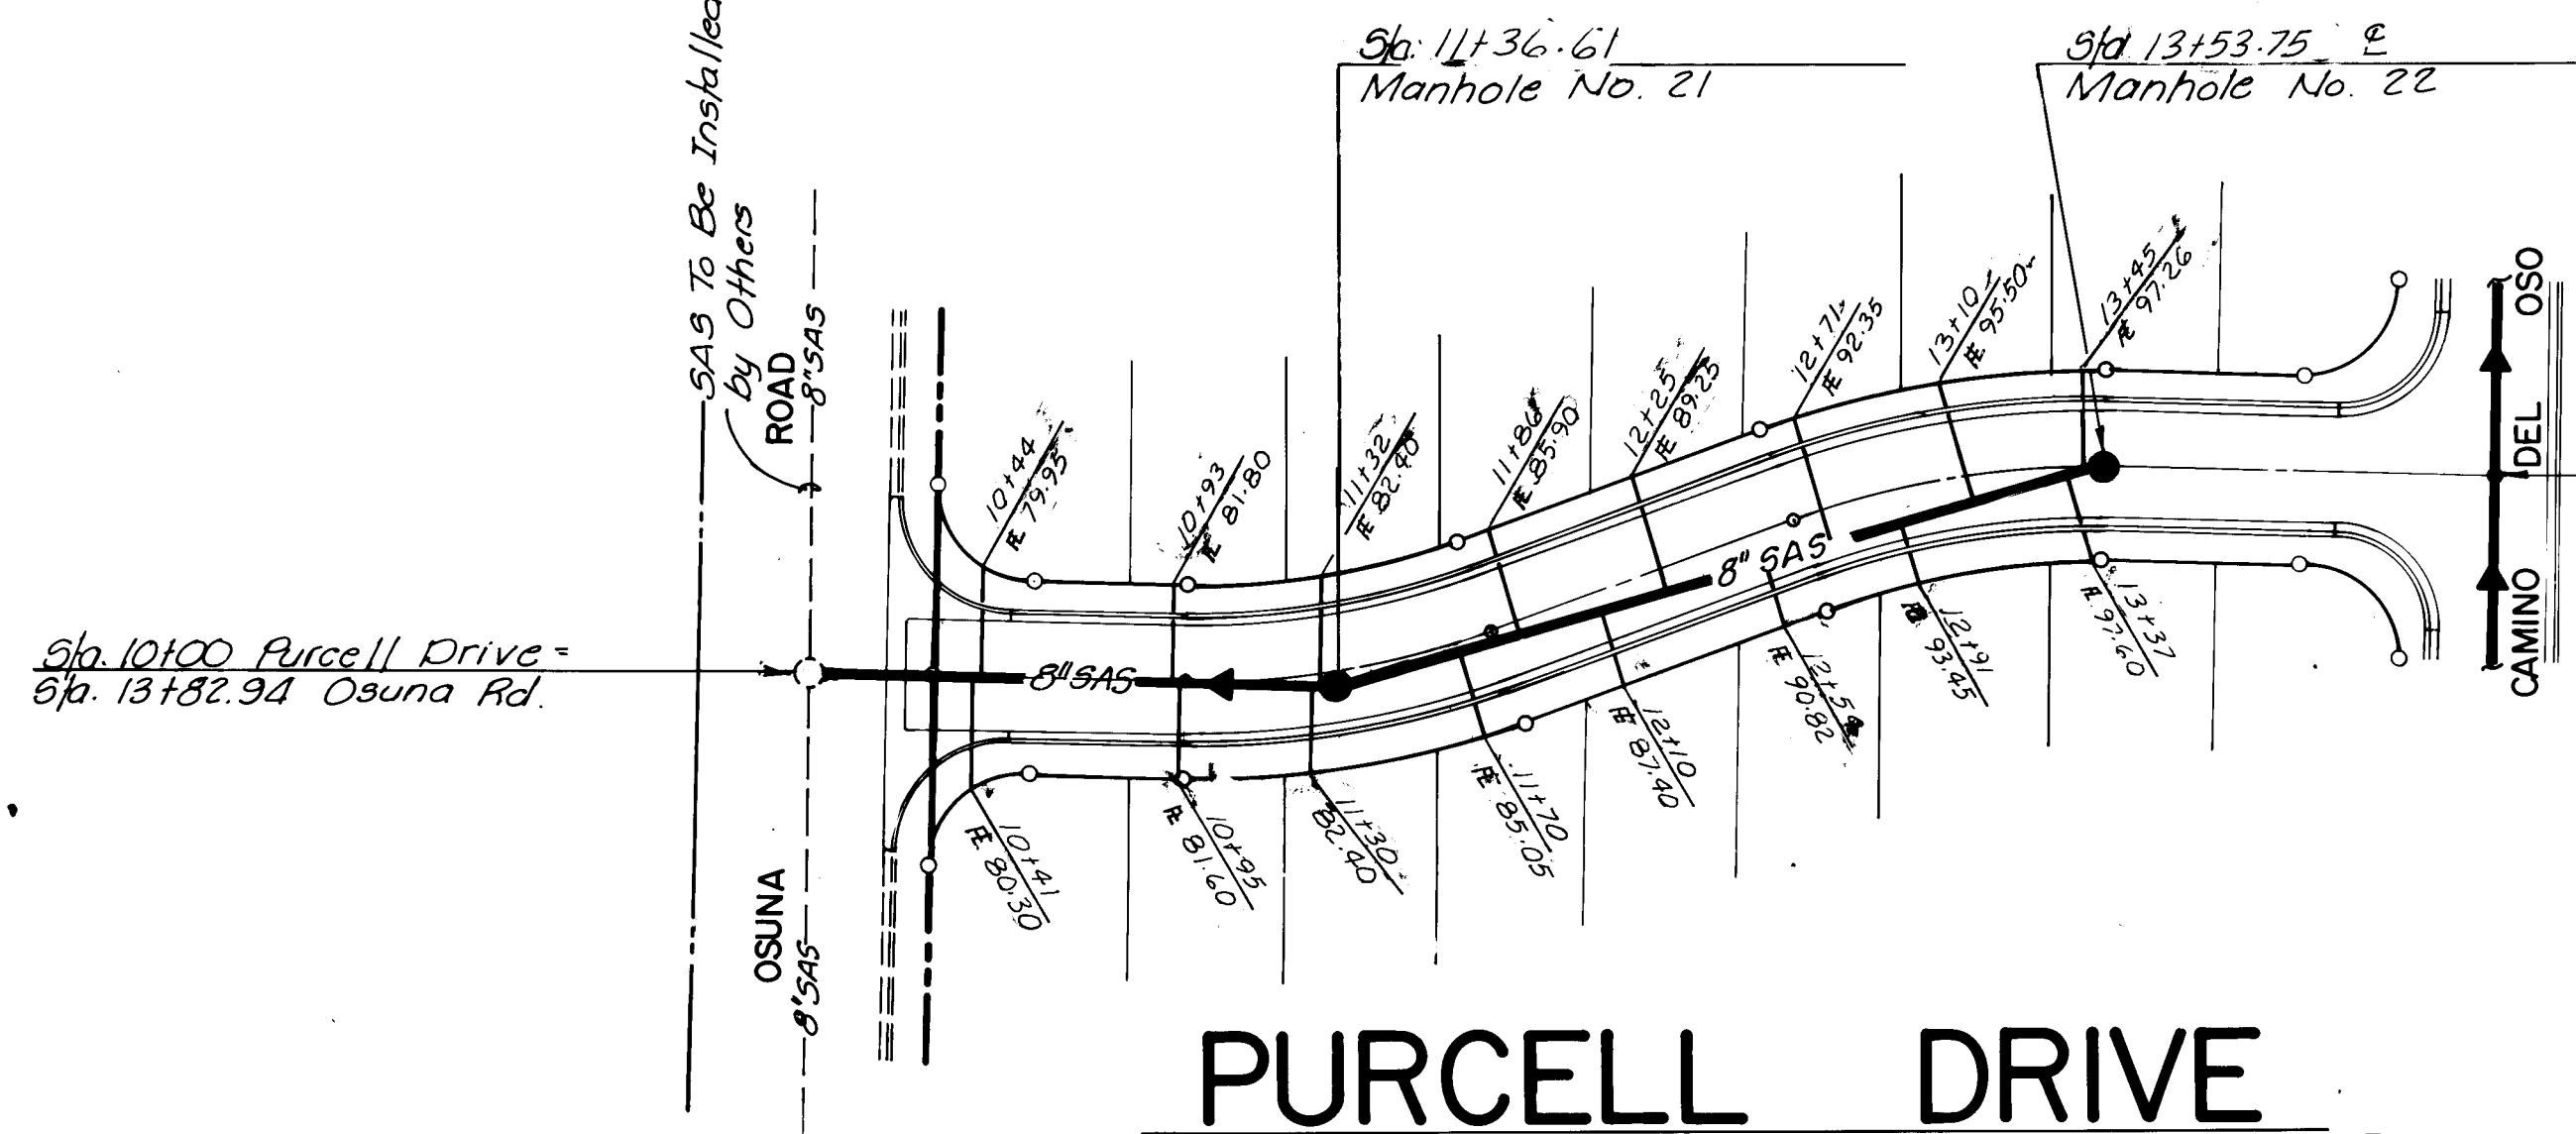


PURCELL DRIVE


See Sheet No. 11
For Continuation

RECORD DRAWING

Clara A. G. Kelly
CITY ENGINEER

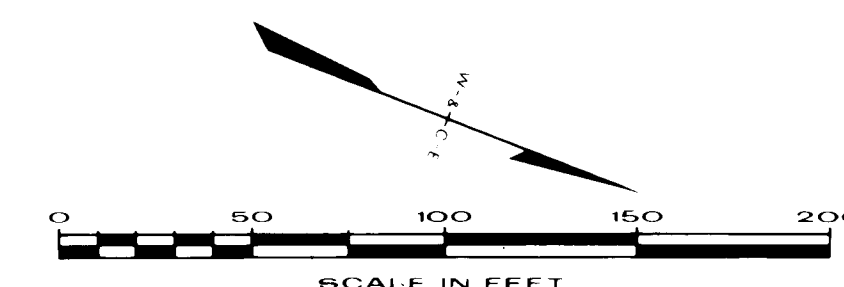

5710
5700
5690
5680

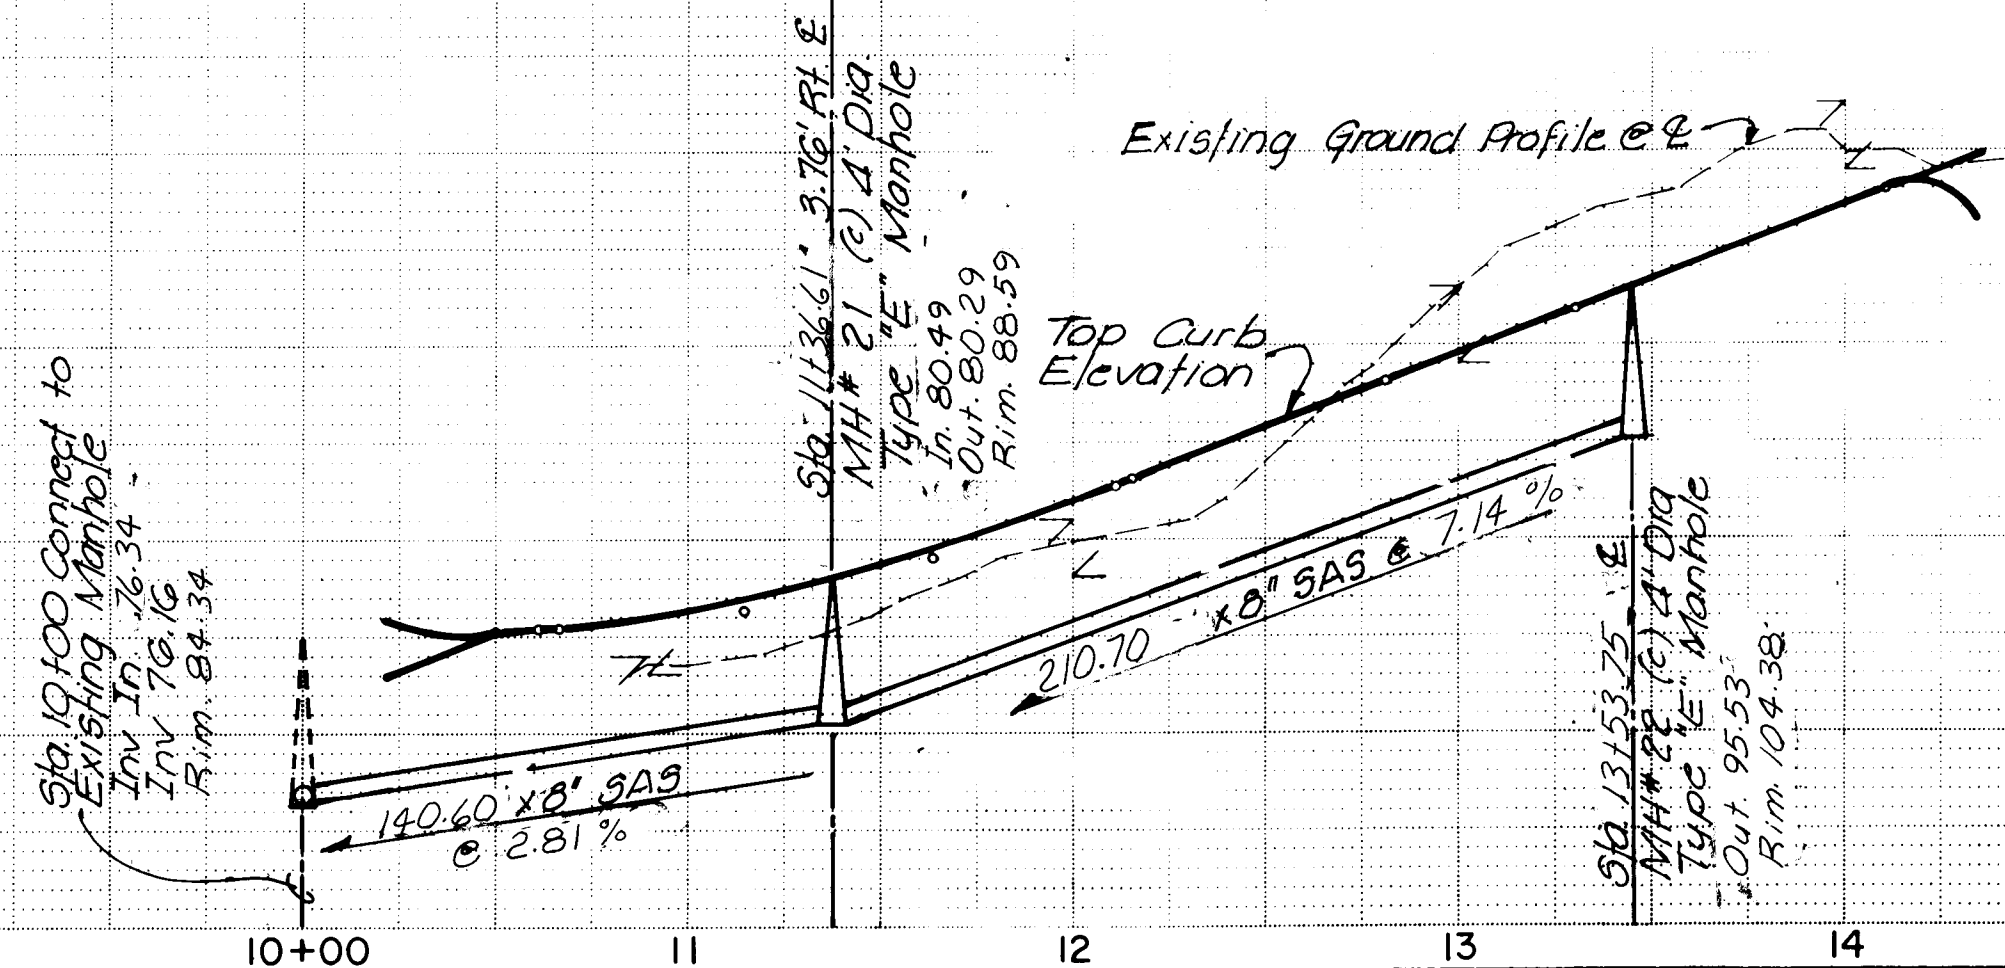

5710
5700
5690
5680

26 2009 1084

APPROVED FOR
CONSTRUCTION

CITY ENGINEER DATE

CITY OF ALBUQUERQUE

OSO GRANDE SUBDIVISION



SEWER • OSO CT. NOREEN CT.
PURCELL DRIVE

APPROVALS	ENGINEER	DATE	APPROVALS	ENGINEER	DATE
City Engineer	W. A. D. W.	1/23/84	Traffic	W. A. D. W.	1/23/84
Liquid Waste	W. A. D. W.	1/23/84	Water	W. A. D. W.	1/23/84
A.C.E. Design	W. A. D. W.	2/2/84	DESIGN	W. A. D. W.	2/2/84
A.C.E. Hydrology	W. A. D. W.	2/2/84	CHECKED BY	W. A. D. W.	2/2/84

WILSON & COMPANY
ENGINEERS & ARCHITECTS
ALBUQUERQUE, NEW MEXICO

83-506 B

Water service lines shall be 3/4" high density polyethylene tubing, SDR 9.

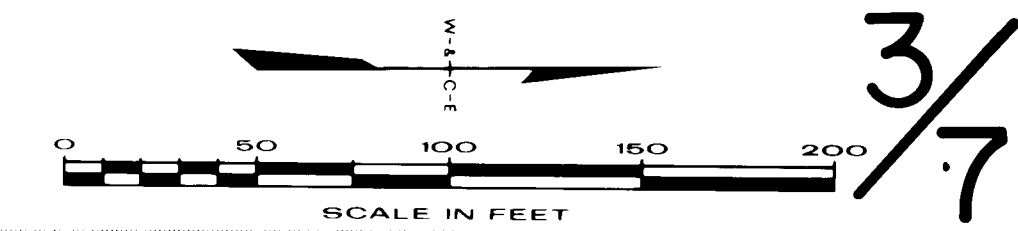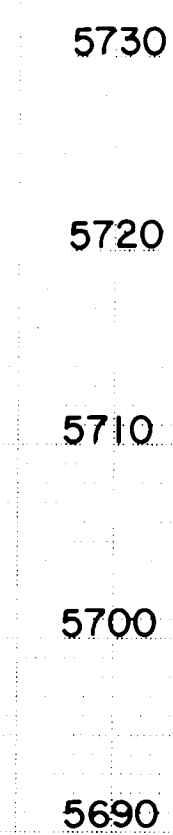
$$\frac{3}{7}$$


APPROVED FOR
CONSTRUCTION

CITY ENGINEER	DATE
---------------	------

CITY OF ALBUQUERQUE

OSO GRANDE SUBDIVISION


WATER • NOREEN DRIVE

APPROVALS	ENGINEER	DATE	APPROVALS	ENGINEER	DATE
City Engineer	<i>[Signature]</i>	2/23/84	Traffic	NADW	1/25/84
Liquid Waste	<i>[Signature]</i>	1-30-84	Water	<i>[Signature]</i>	1-30-84
A.C.E. - Design	<i>[Signature]</i>	25/Jan/84	2009		SHEET 12
A.C.E. - Hydrology	<i>[Signature]</i>	2/2/84			OF 13



WILSON & COMPANY
ENGINEERS & ARCHITECTS

83-506 E

UNIT 6
PROJECT NO. 2008

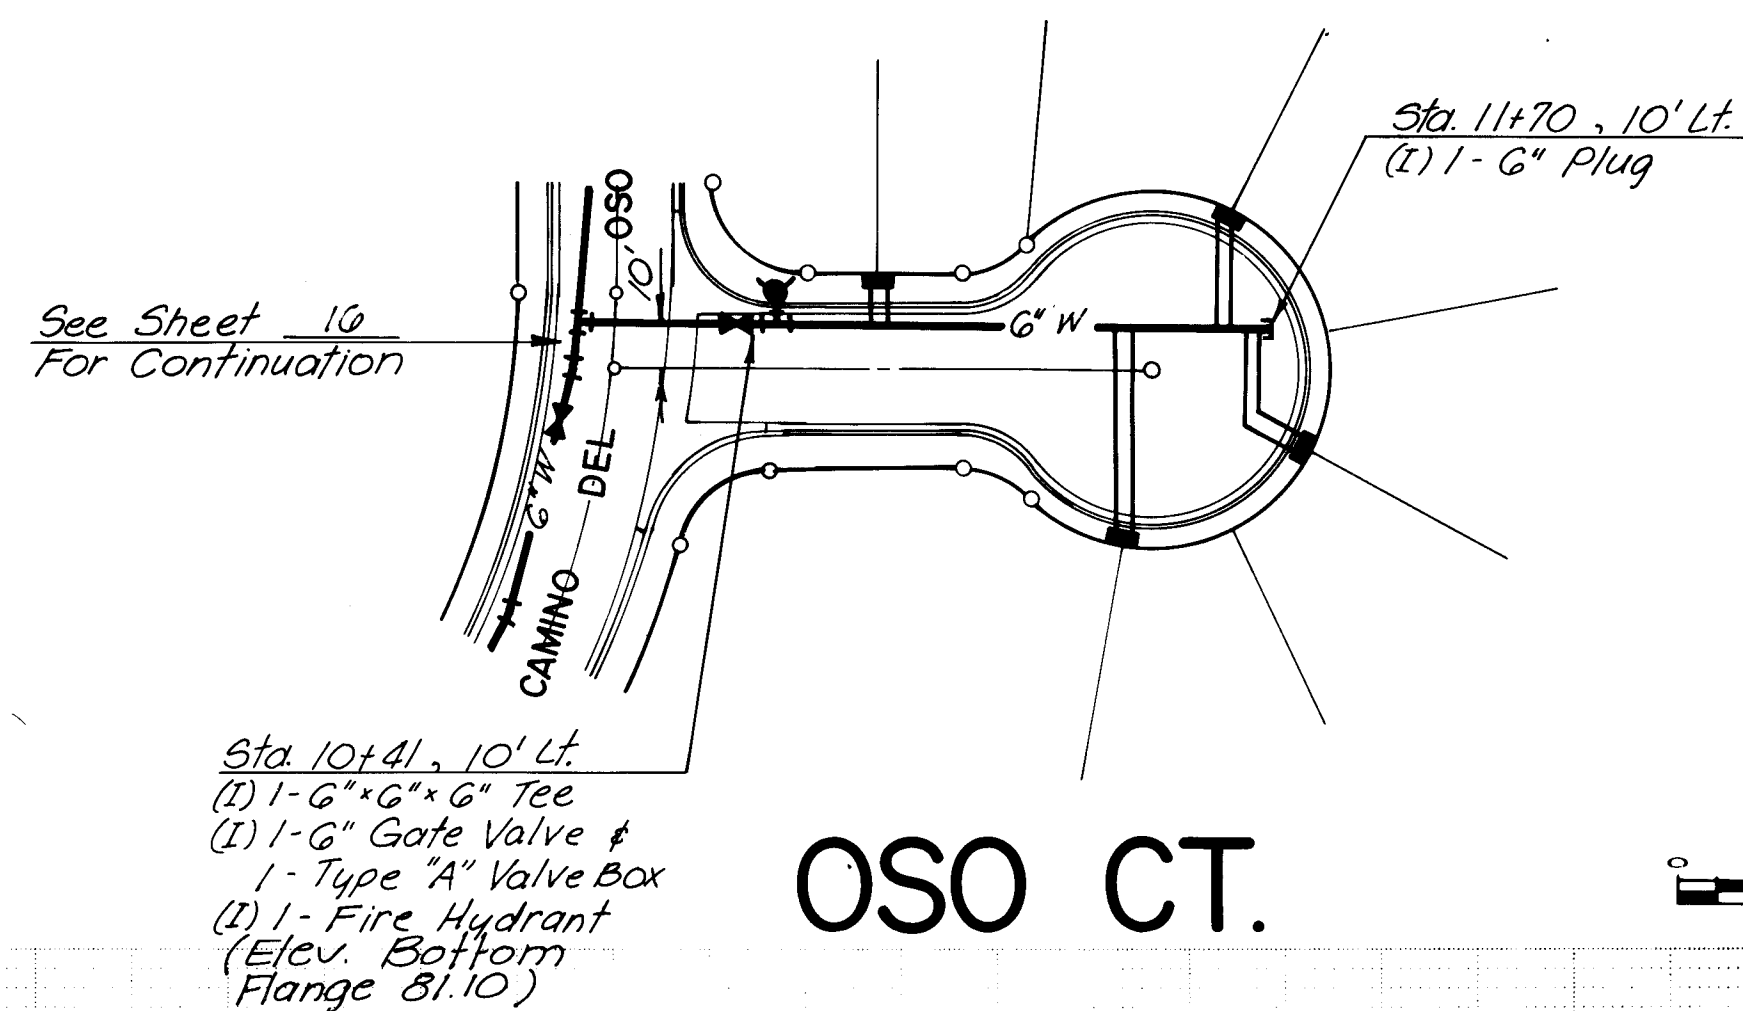


OSO CT.

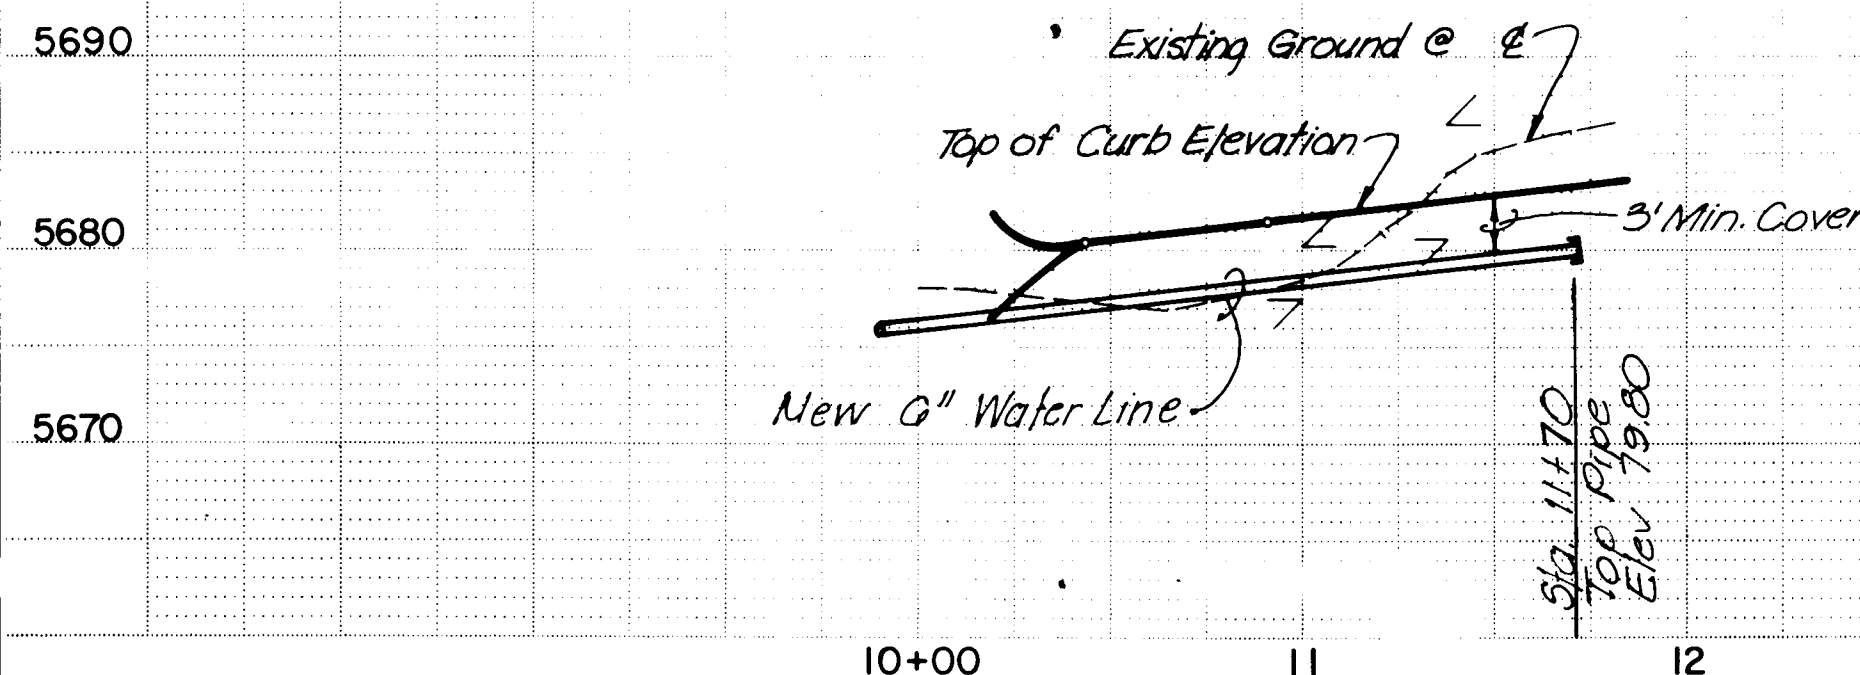
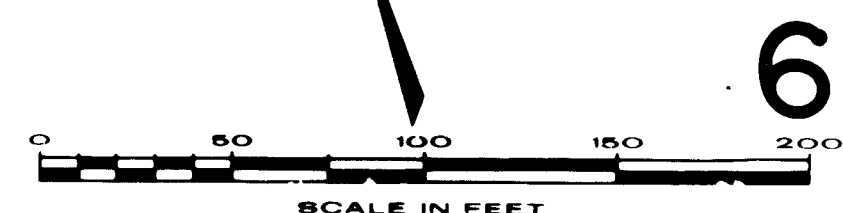


See Sheet 21
For 24" Conc.
Cyl. Water Line
Information

UNIT 8
PROJECT NO. 2010

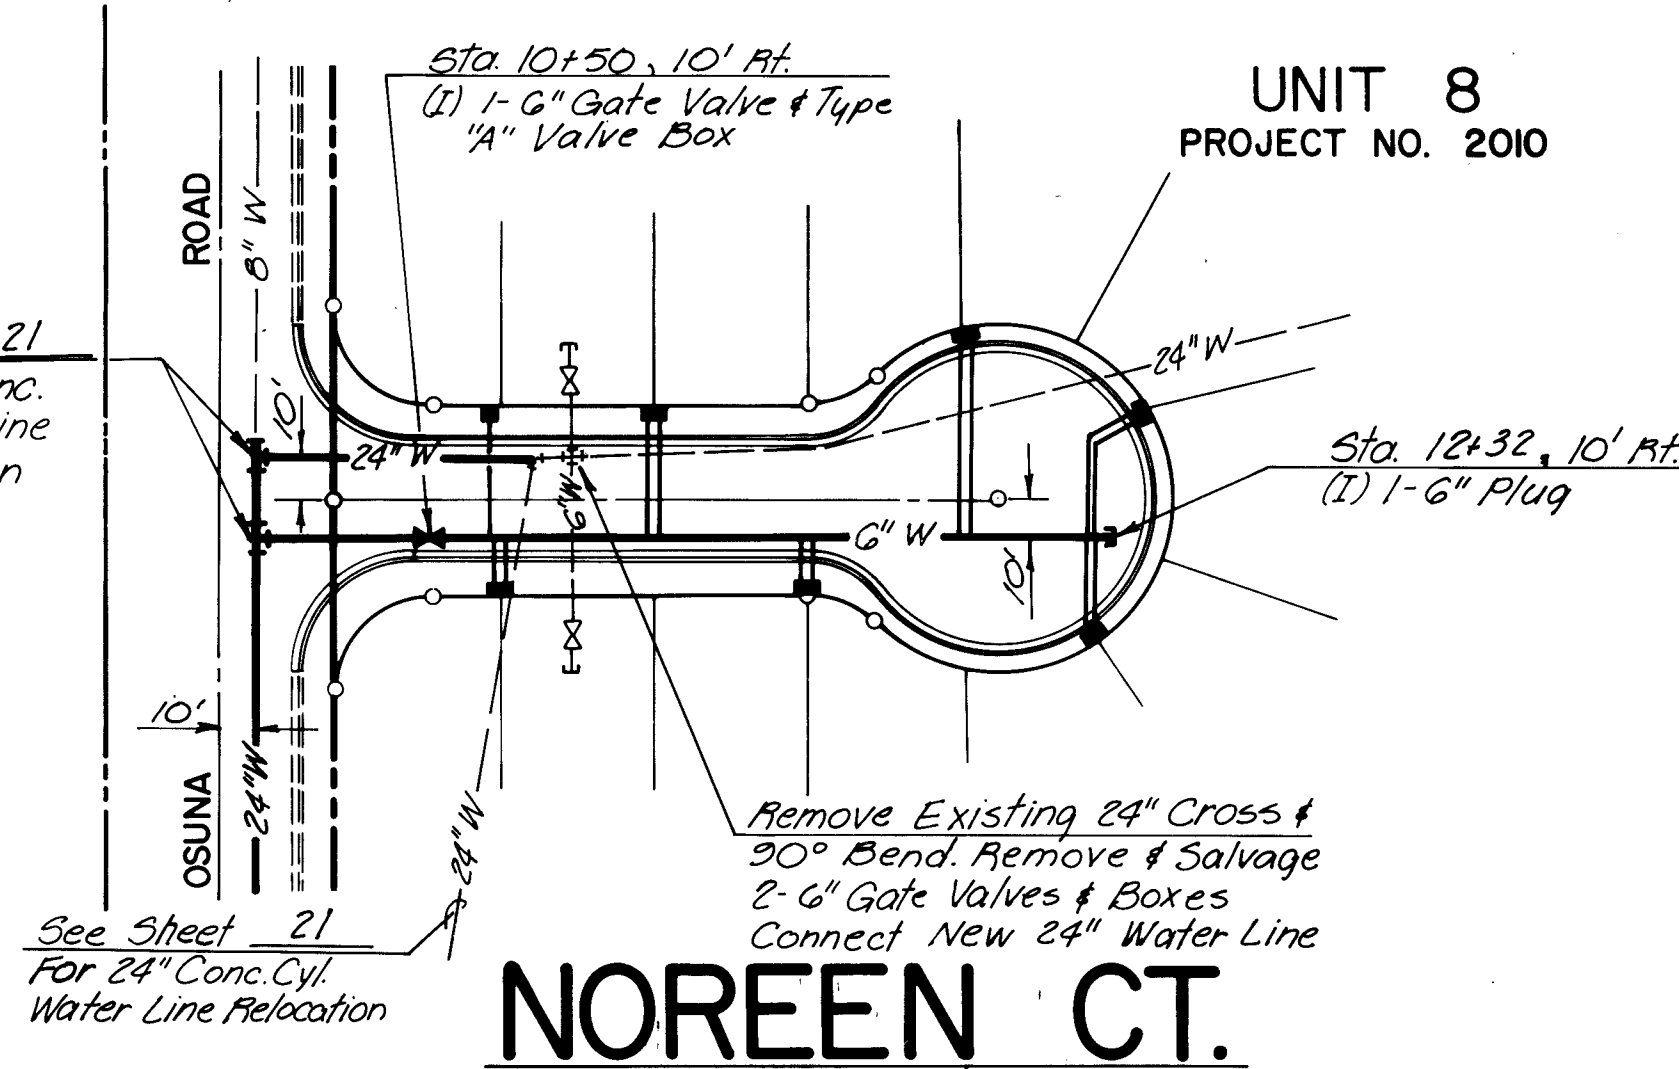


NOREEN CT.

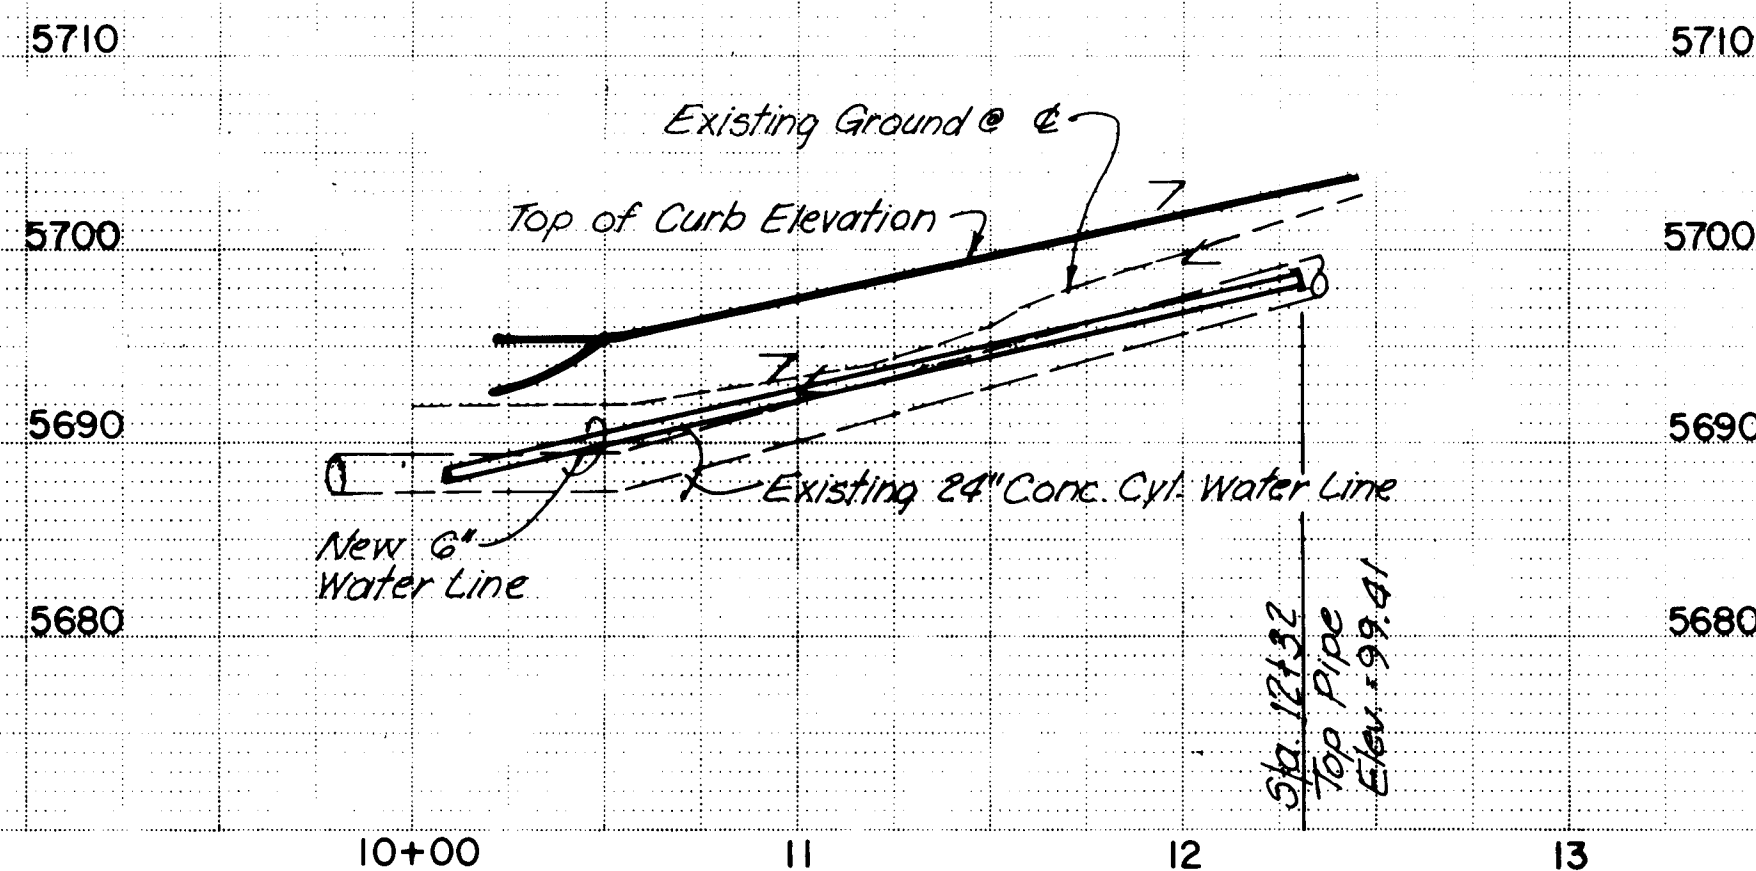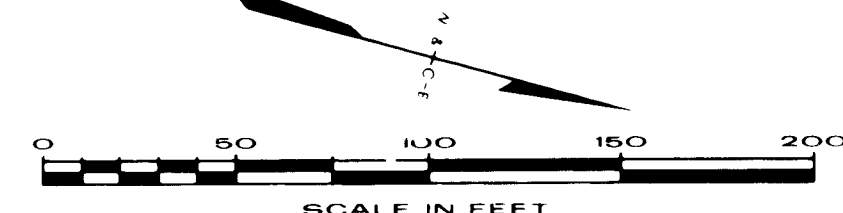

Locate all existing utilities both vertically and horizontally prior to starting the installation of water lines and sanitary sewer lines.

All pipe, fittings, fire hydrants, valves & valve boxes to be removed shall be salvaged & delivered to the City yard.

Water service lines shall be 3/4" high density polyethylene tubing, SDR 9.


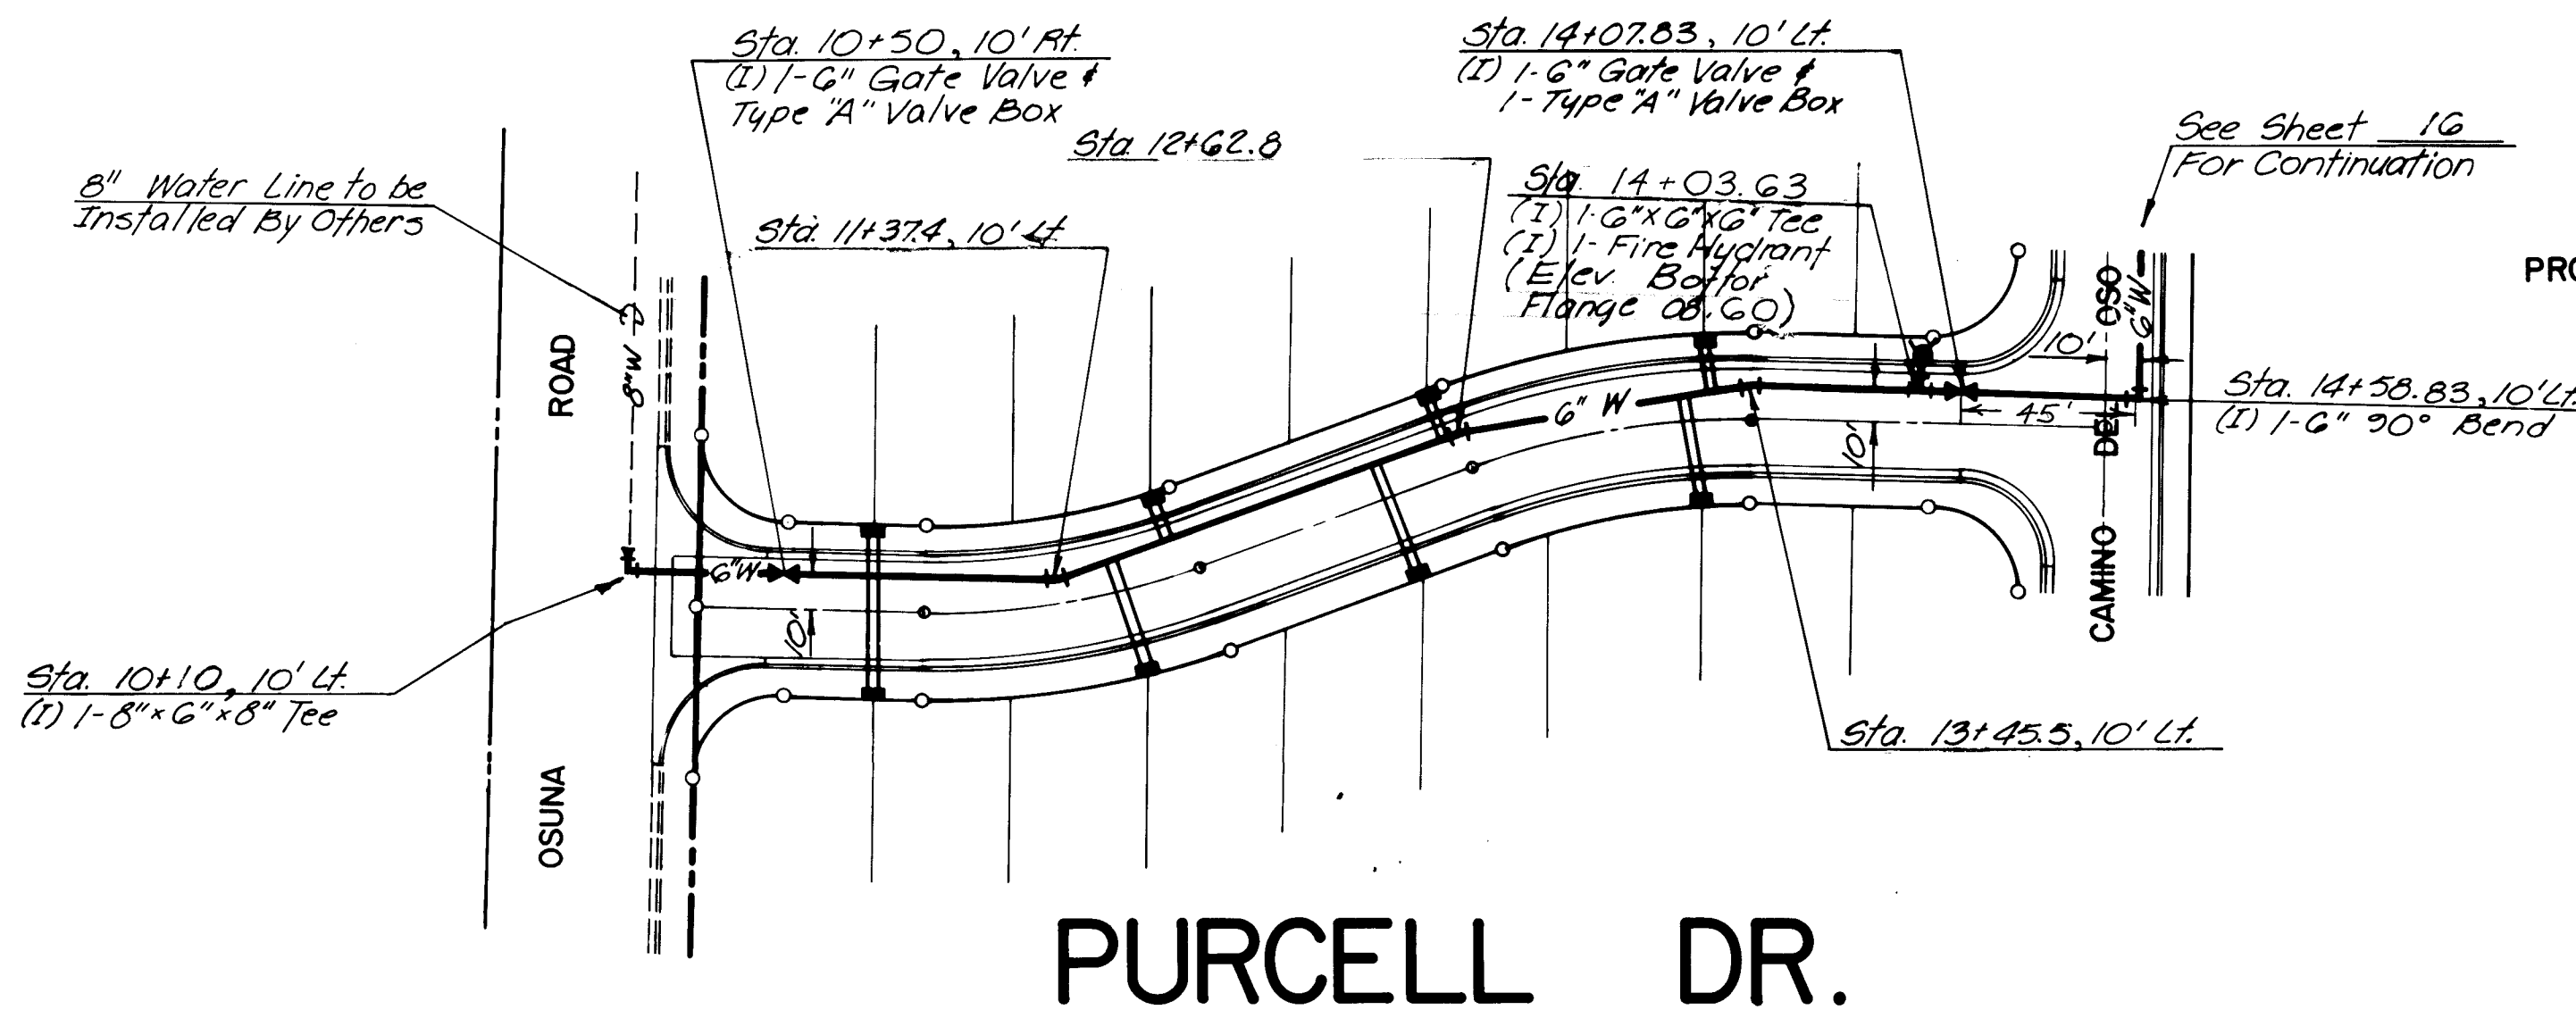


PURCELL DR.

UNIT 7
PROJECT NO. 2009

RECORD DRAWING
I, Claude A.L. Pilley, N.M.P.E. & L.S. No. 4981,
hereby certify that this drawing has been
revised in accordance with information furnished
by the City of Albuquerque, New Mexico, and that the
revisions are correct and complete under
my personal direction and control.

Claude A.L. Pilley
CLAUDE A.L. PILLEY

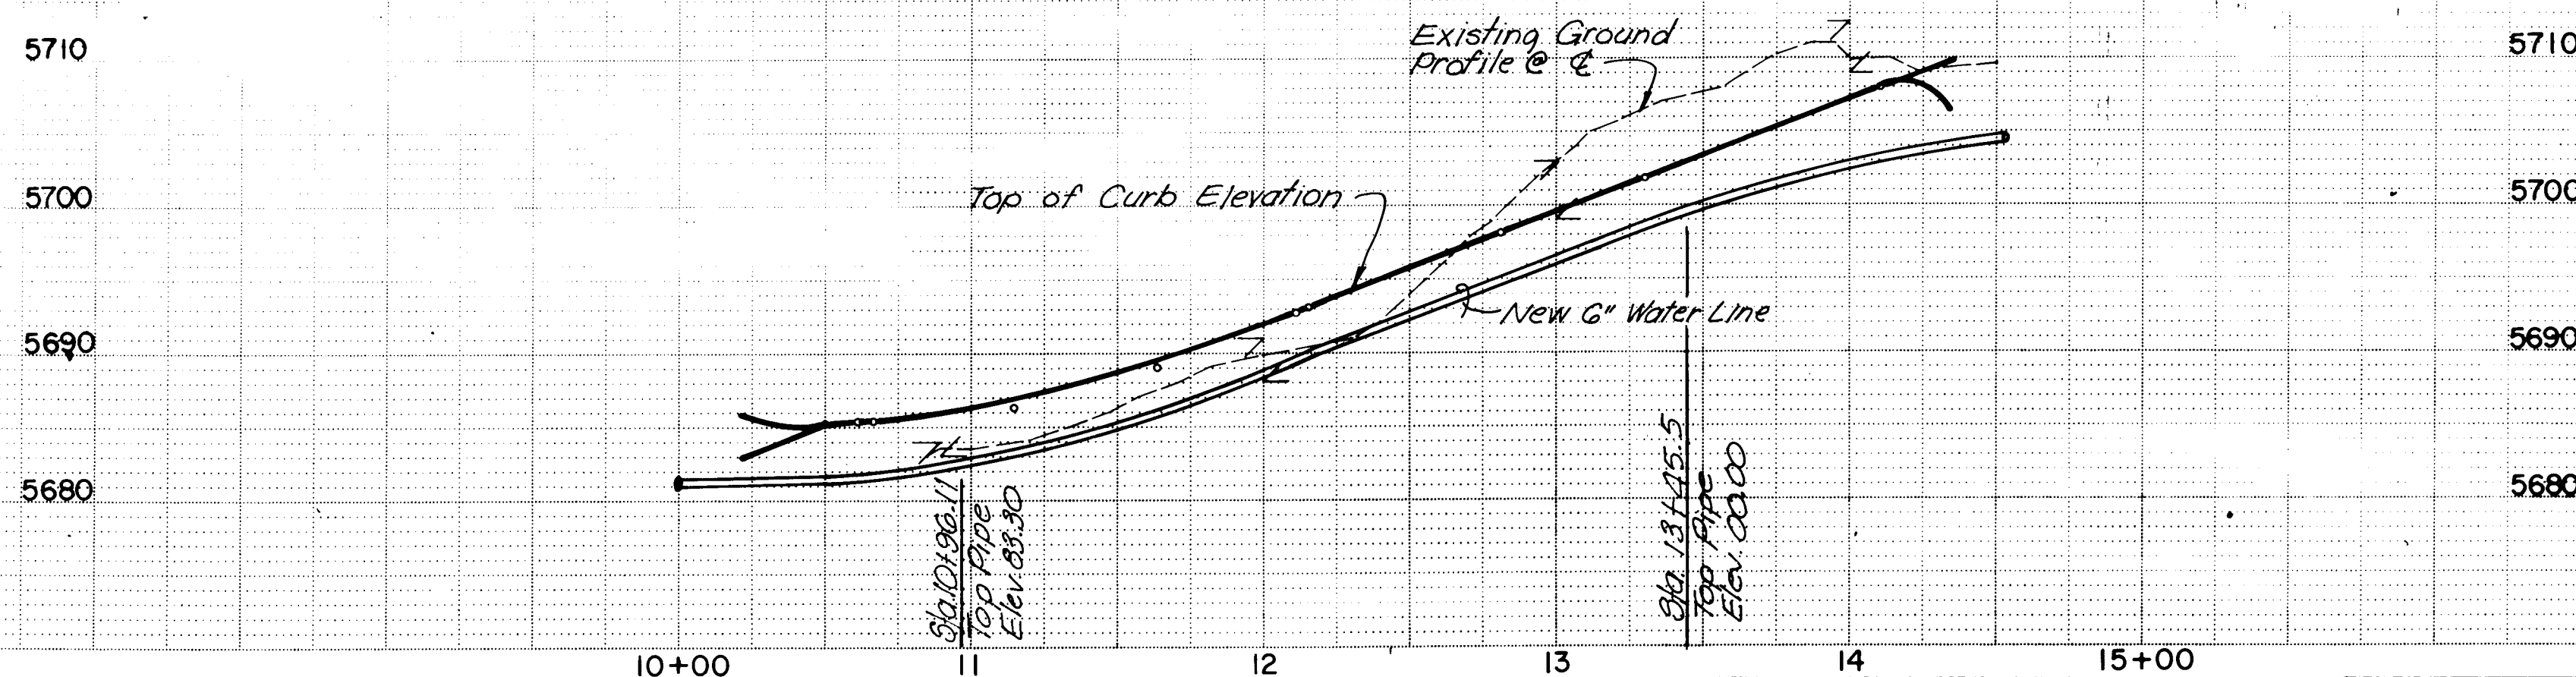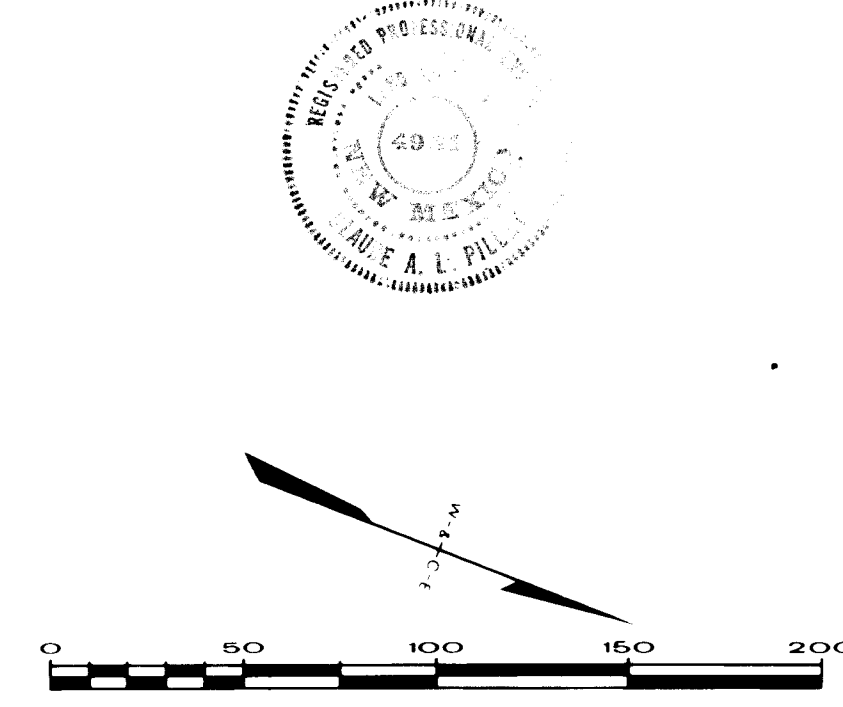

26. 2009 13.84


APPROVED FOR
CONSTRUCTION
CITY ENGINEER DATE

CITY OF ALBUQUERQUE					
OSO GRANDE SUBDIVISION					
WATER • OSO CT. NOREEN CT. PURCELL DRIVE					
APPROVALS	ENGINEER	DATE	APPROVALS	ENGINEER	DATE
City Engineer	NA	2/25/09	Traffic	NA	2/25/09
Liquid Waste	NA	2/25/09	Water	NA	2/25/09
A.C.E. - Design	NA	2/25/09			
A.C.E. - Hydrology	NA	2/25/09			

DESIGNED BY: WILSON & CO., ENG. DATE: 2/25/09
DRAWN BY: DATE: 2/25/09
CHECKED BY: DATE: 2/25/09

WILSON & COMPANY
ENGINEERS & ARCHITECTS
ALBUQUERQUE, NEW MEXICO




83-506 B

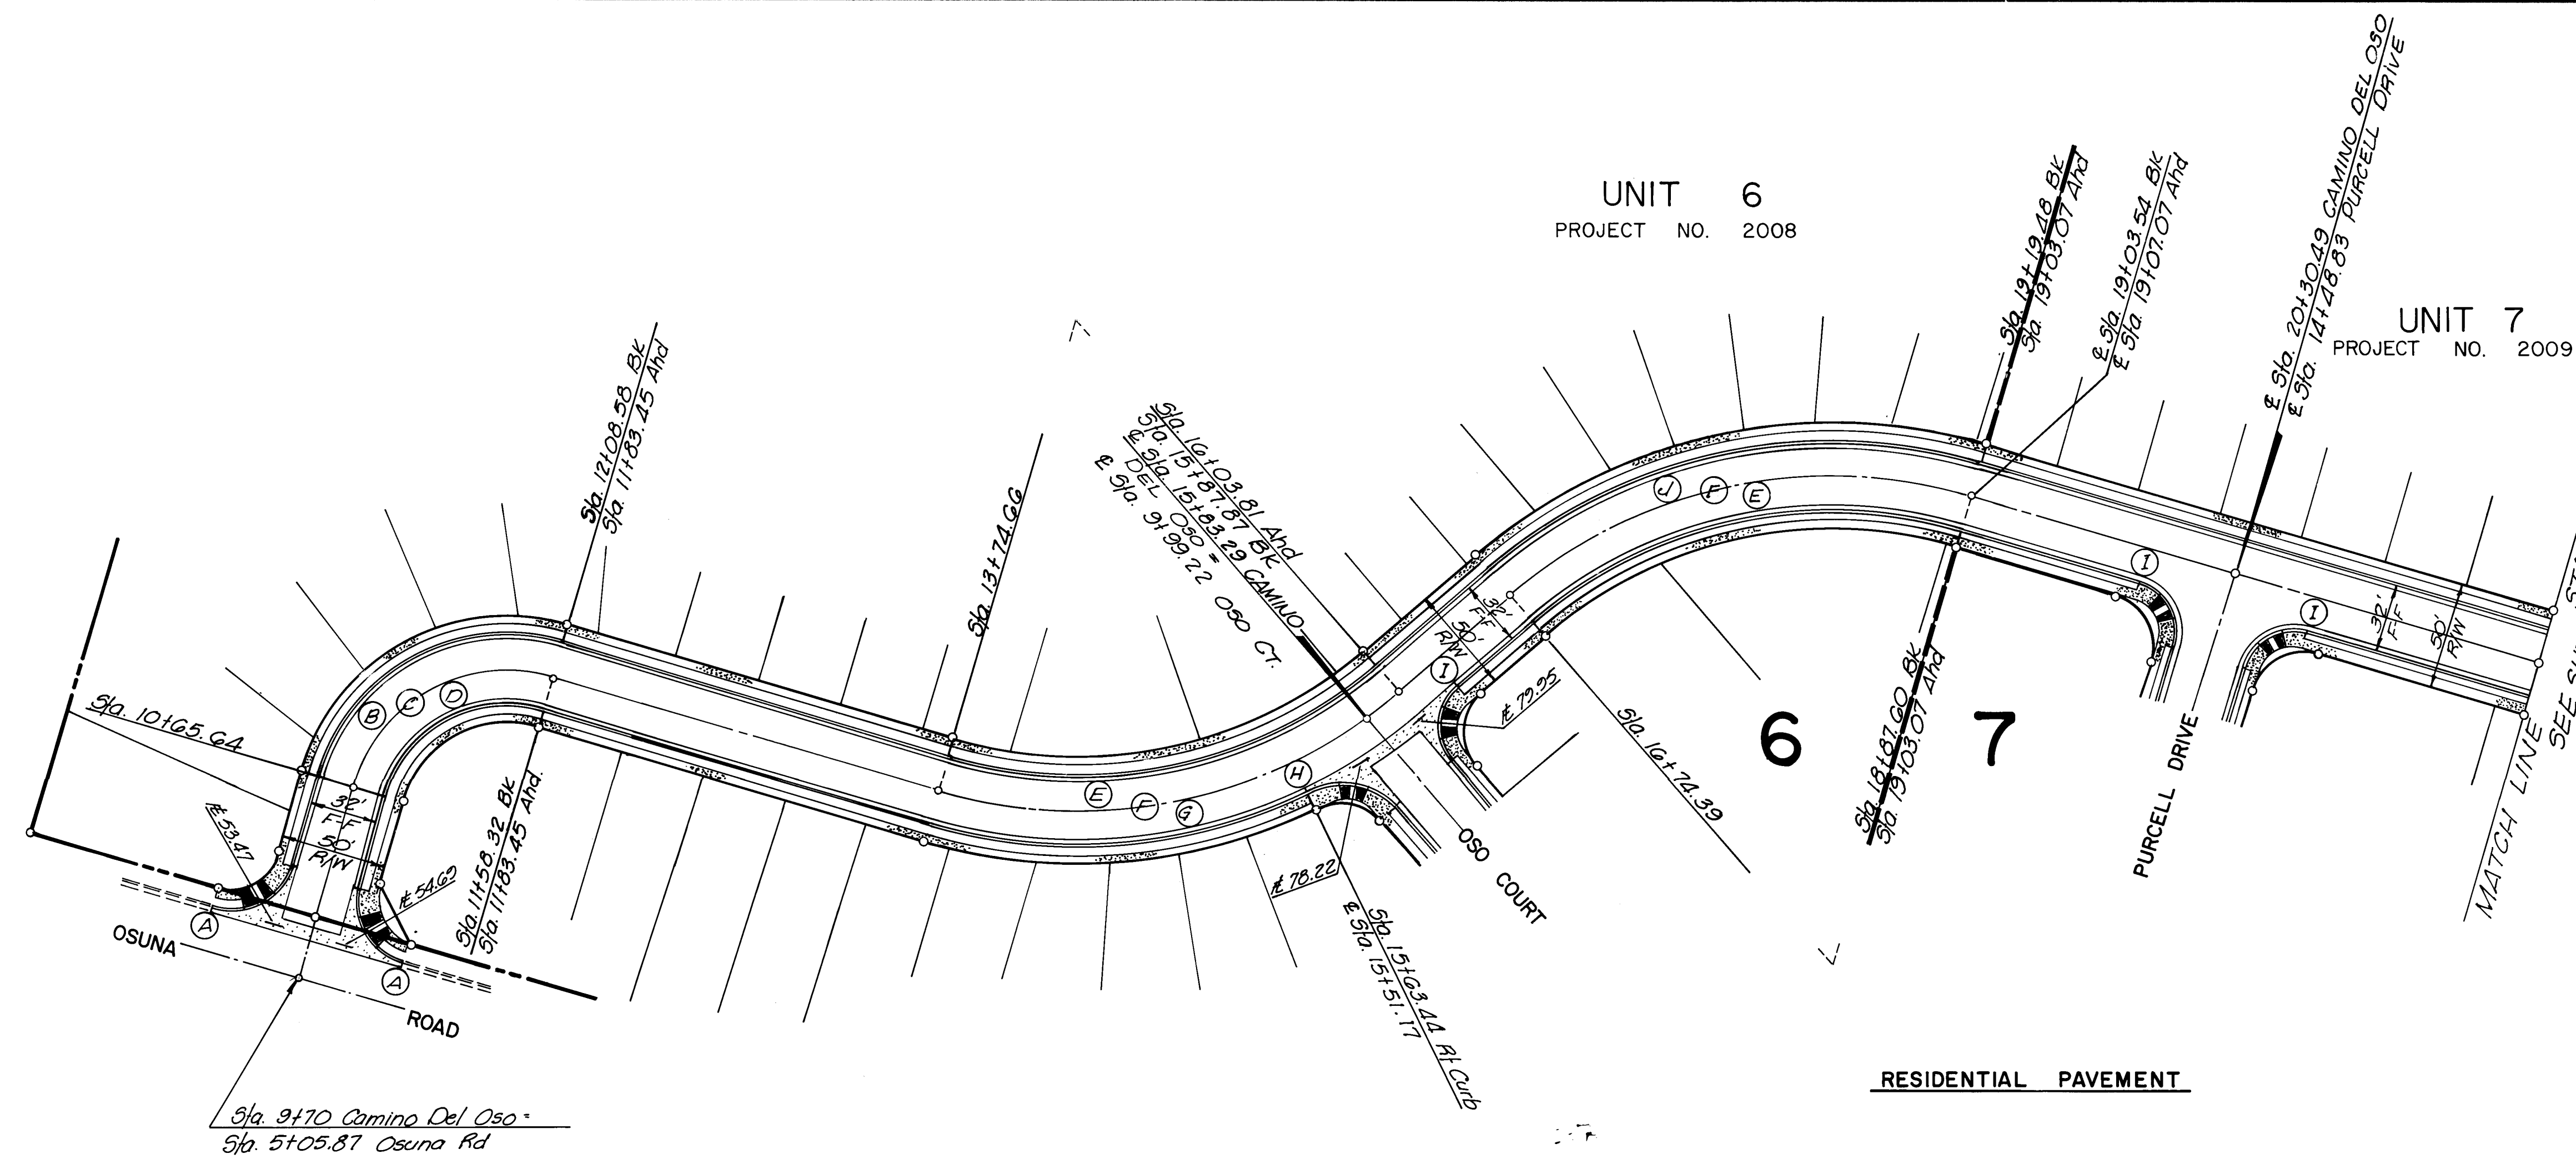

CURVE DATA		
CURVE A $\Delta = 90^{\circ}00'00''$ $R = 30.00'$ $L = 47.12'$ $T = 30.00'$	CURVE B $\Delta = 90^{\circ}00'00''$ $R = 91.00'$ $L = 142.94'$ $T = 91.00'$	CURVE C $\Delta = 90^{\circ}00'00''$ $R = 75.00'$ $L = 117.81'$ $T = 75.00'$
CURVE D $\Delta = 90^{\circ}00'00''$ $R = 59.00'$ $L = 92.68'$ $T = 59.00'$	CURVE E $\Delta = 57^{\circ}05'03''$ $R = 214.00'$ $L = 213.21'$ $T = 116.40'$	CURVE F $\Delta = 57^{\circ}05'03''$ $R = 230.00'$ $L = 229.15'$ $T = 125.10'$
CURVE G $\Delta = 13^{\circ}58'10''$ $R = 246.00'$ $L = 188.78'$ $T = 99.31'$	CURVE H $\Delta = 73^{\circ}53'07''$ $R = 25.00'$ $L = 33.55'$ $T = 19.85'$	CURVE I $\Delta = 90^{\circ}00'00''$ $R = 25.00'$ $L = 39.27'$ $T = 25.00'$
CURVE J $\Delta = 57^{\circ}05'03''$ $R = 246.00'$ $L = 245.09'$ $T = 133.80'$		

RECORD DRAWING
I, Claude A. L. Pilley, N.M.P.E. & L.S. No. 4981, hereby certify that this drawing has been revised in accordance with information furnished by KNC Inc. Field surveys and that both the revisions and field surveys were done under my personal direction and control.

Claude A. L. Pilley
CLAUDE A. L. PILLEY

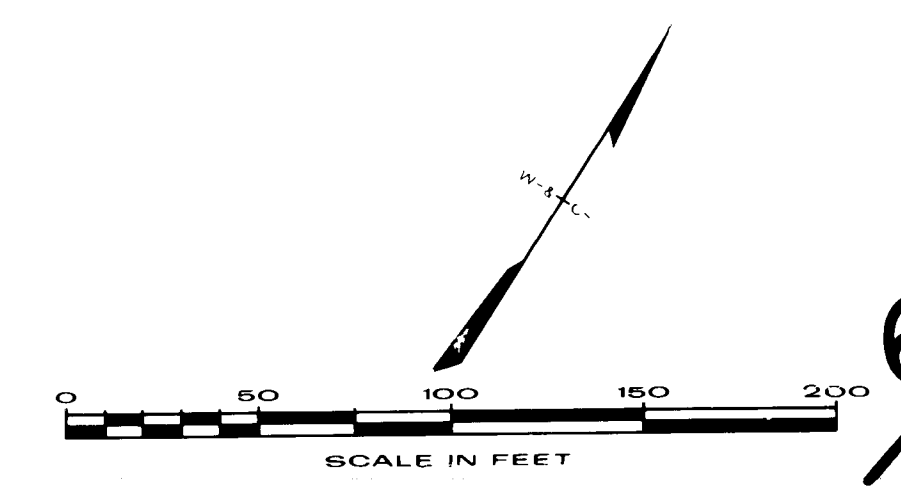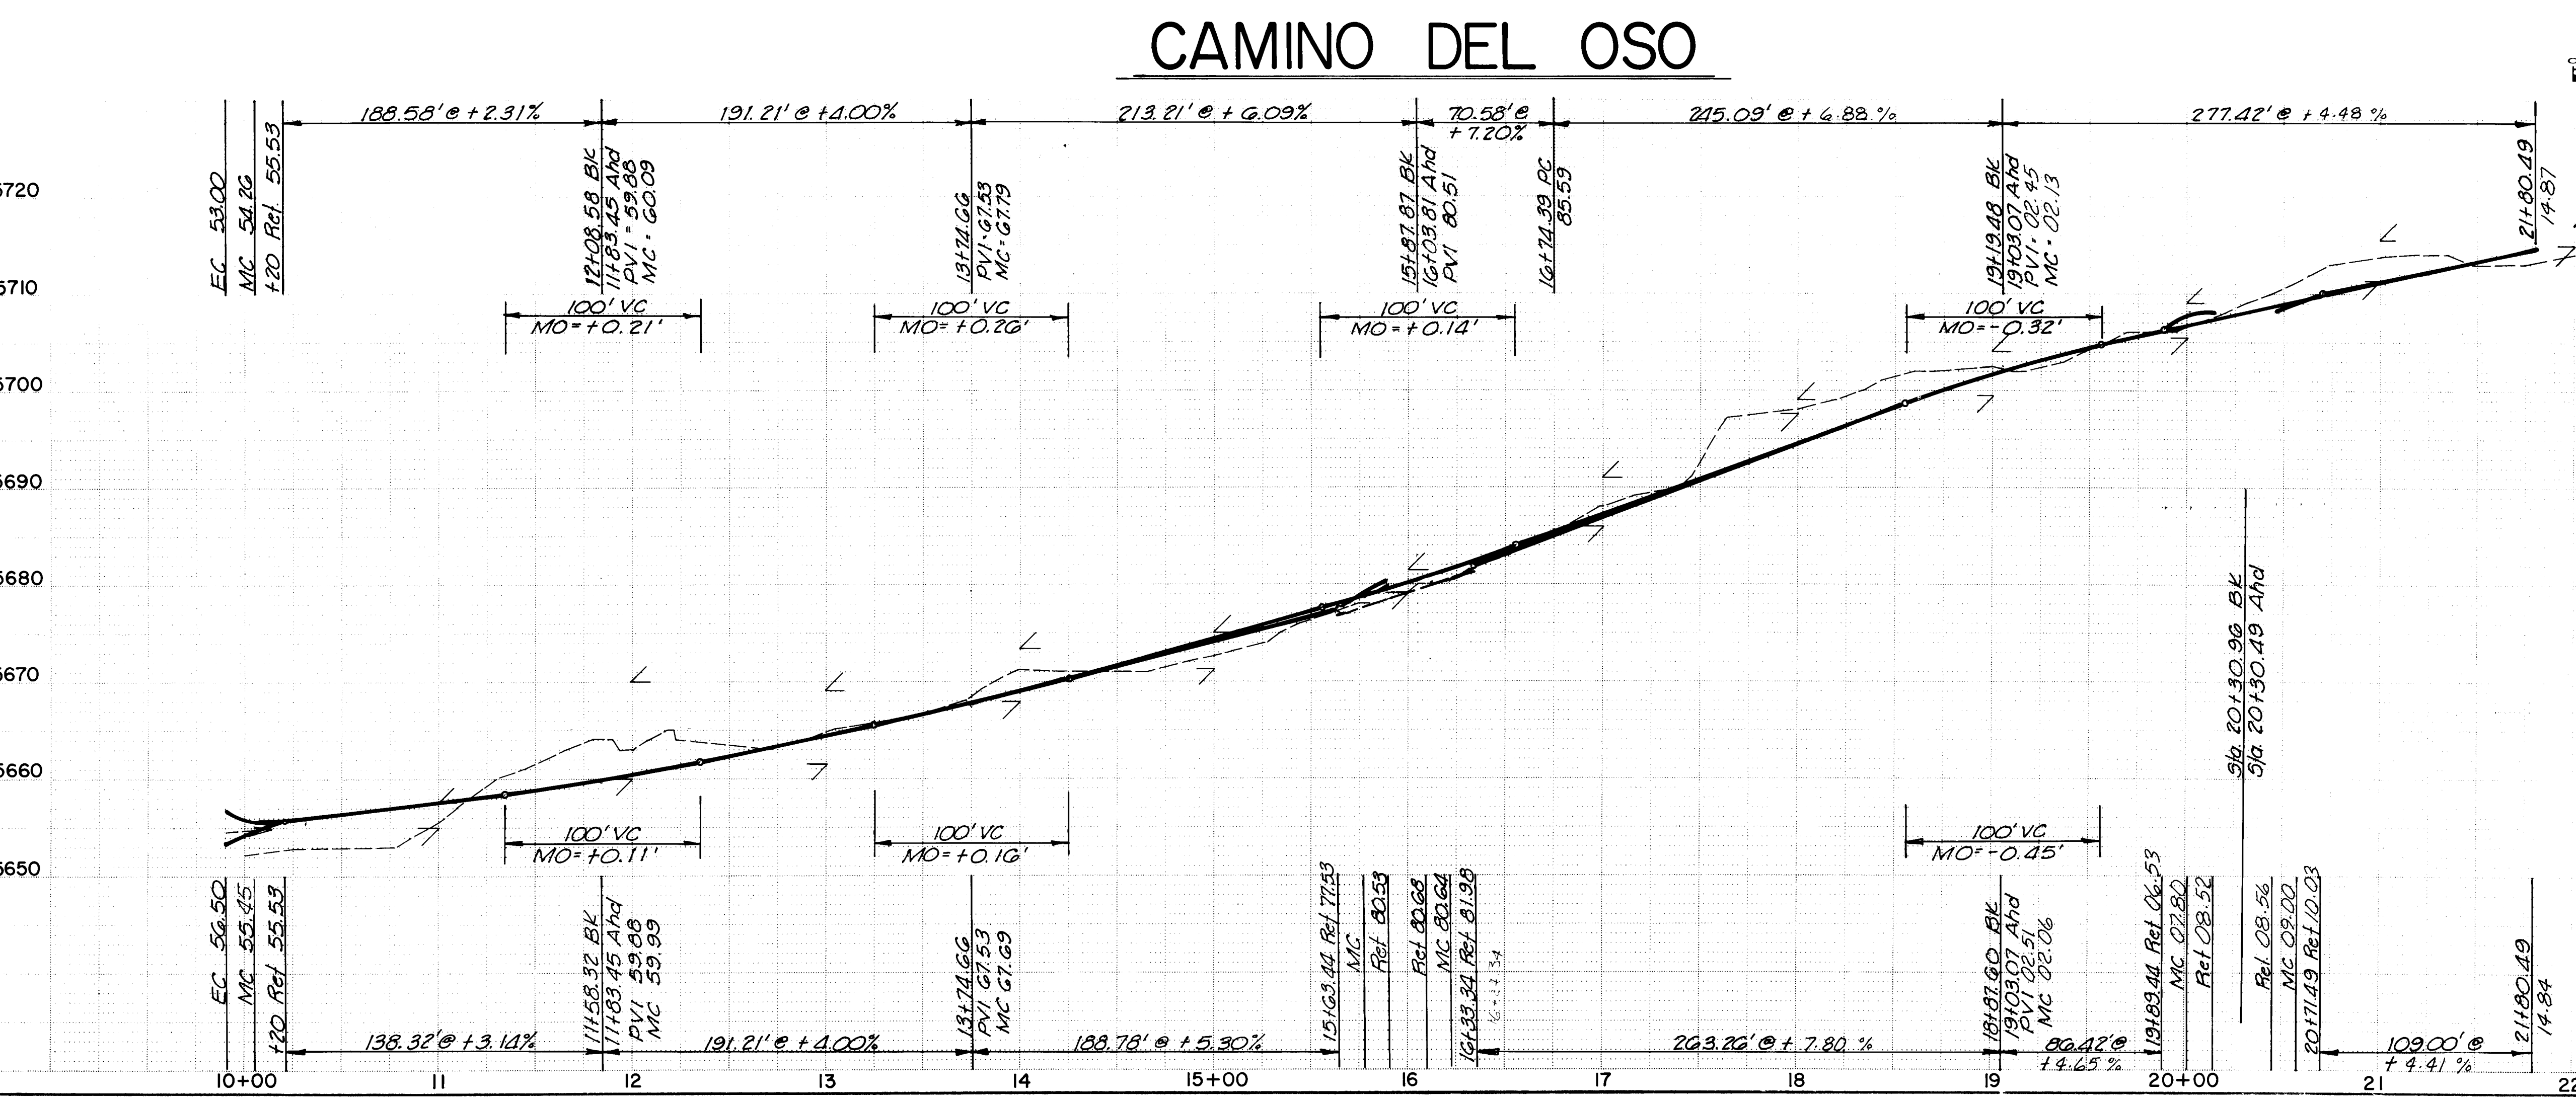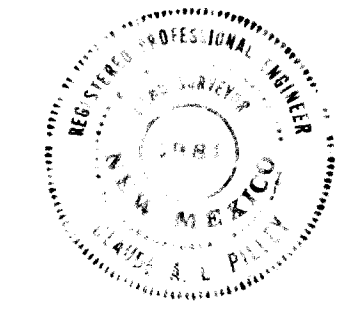

26 2009 0684

APPROVED FOR CONSTRUCTION
CITY ENGINEER _____ DATE _____

CITY OF ALBUQUERQUE					
OSO GRANDE SUBDIVISION					
PAVING • CAMINO DEL OSO					
APPROVALS	ENGINEER	DATE	APPROVALS	ENGINEER	DATE
City Engineer	<i>[Signature]</i>	7/23/09	Traffic	<i>[Signature]</i>	1/15/04
Liquid Waste	NA	1-30-04	Water	NA	1-30-04
A.C.E. - Design	<i>[Signature]</i>	2/15/04			
A.C.E. - Hydrology	<i>[Signature]</i>	2/15/04			
2009			SHEET 6 OF 13		



BENCH MARK NO. 1 • ELEV. = 5708.94 • Top of ACS Brass Cap marked 116 F-21 Reset 1990	
BENCH MARK NO. 2 • ELEV. = 5705.04 • Top of 3/8" Rebar set on E of Osuna Road 30' South of SE Property Corner.	
BENCH MARK NO. 3 • ELEV. = 5648.32 • Top of Capped Rebar Set for SW Property Corner marked L.S. 7270	
REFERENCES MAP NO. F-21-Z	
REVISIONS NO. DATE REVISIONS BY	
DESIGN DESIGNED BY WILSON & CO., ENG. DATE DRAWN BY DATE CHECKED BY DATE	

UNIT 6
PROJECT NO. 2008



UNIT 7
PROJECT NO. 2009

Locate all existing utilities both vertically and horizontally prior to starting the installation of water lines and sanitary sewer lines.
Water service lines shall be 3/4" high density polyethylene tubing, SDR 9.

RECORD DRAWING
I, Claude A.L. Pilley, N.M.P.E. & L.S. No. 4981.
hereby certify that this drawing has been revised in accordance with information furnished by K.N.C. Inc. field surveys and that both the revisions and field surveys were done under my personal direction and control.
Claude A.L. Pilley
CLAUDE A.L. PILLEY

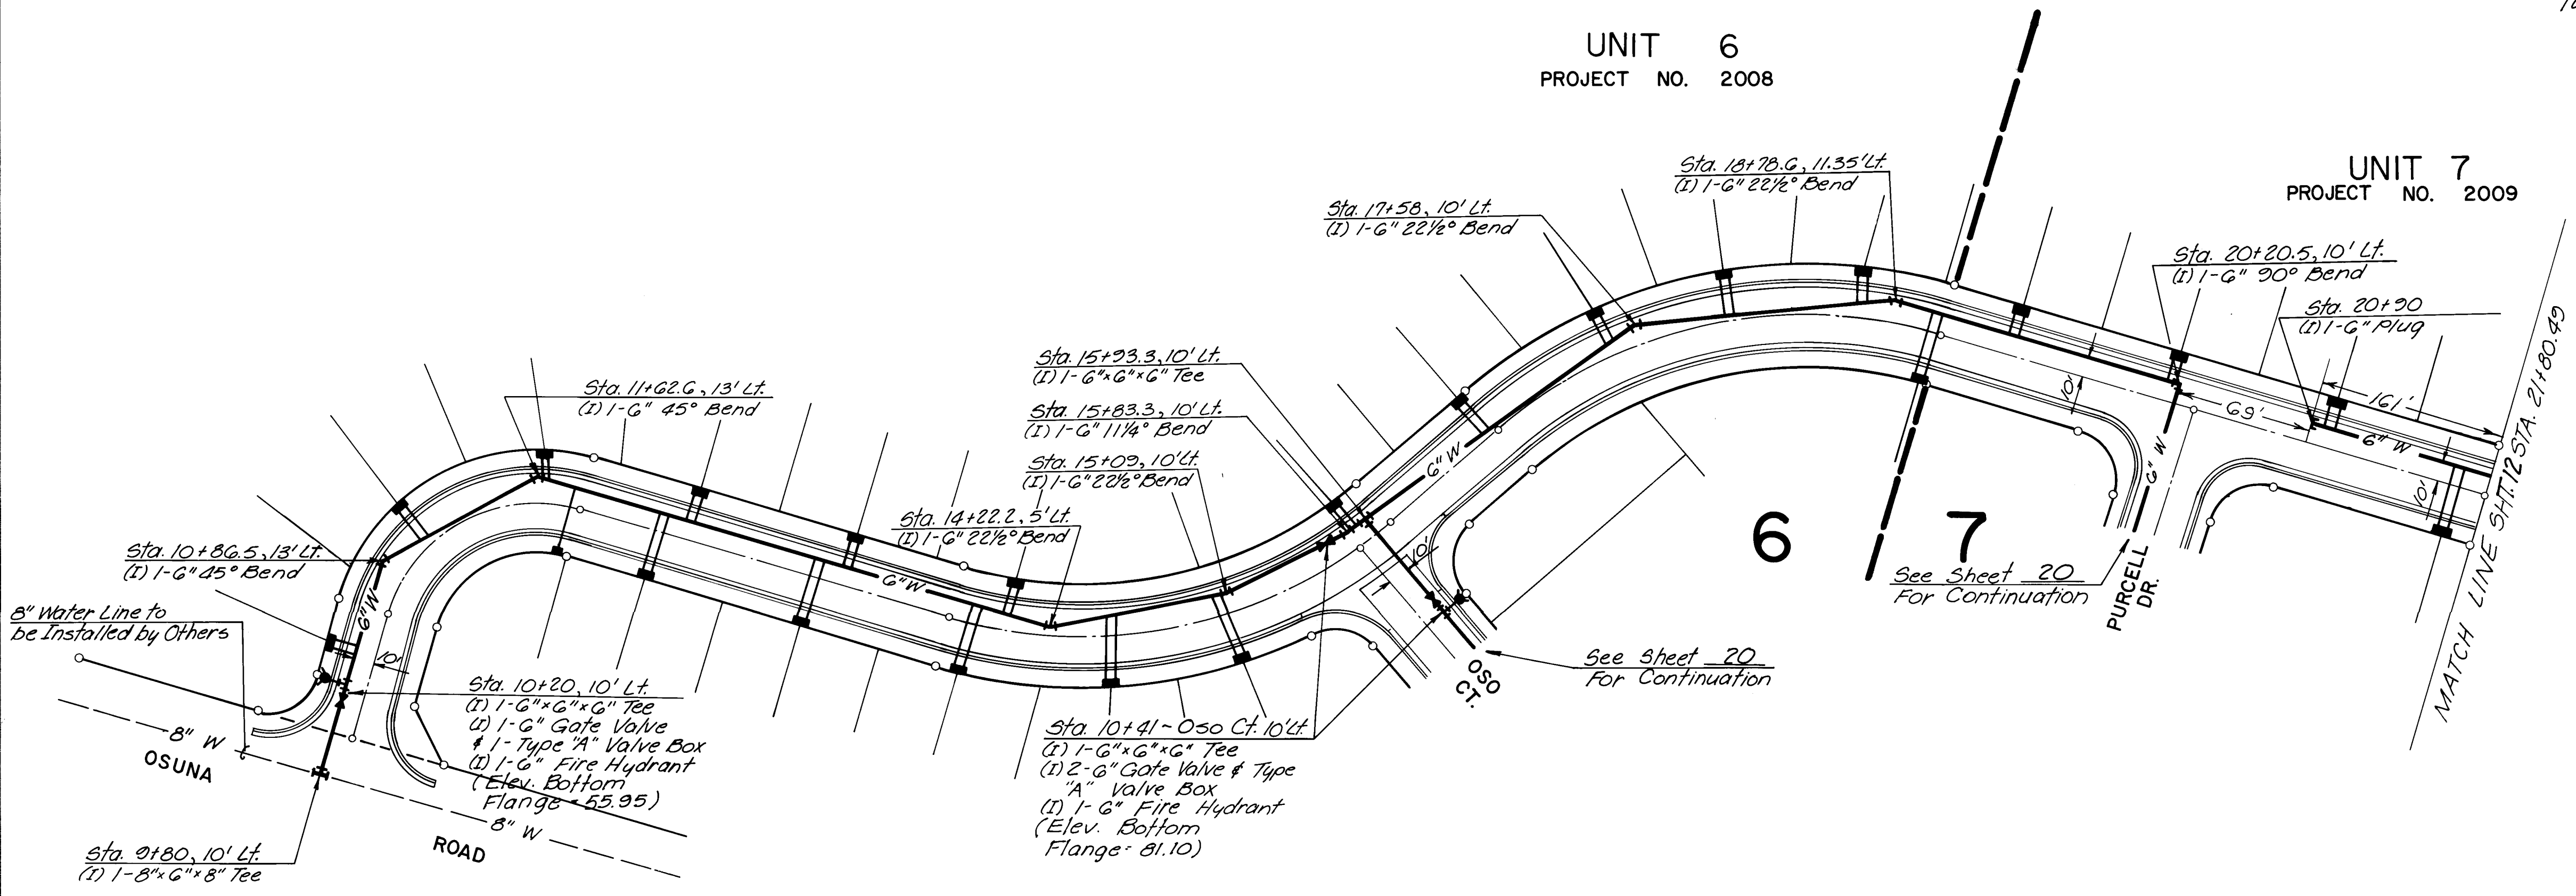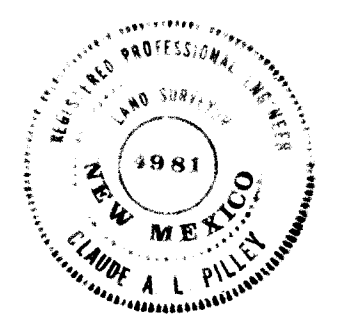

CAMINO DEL OSO

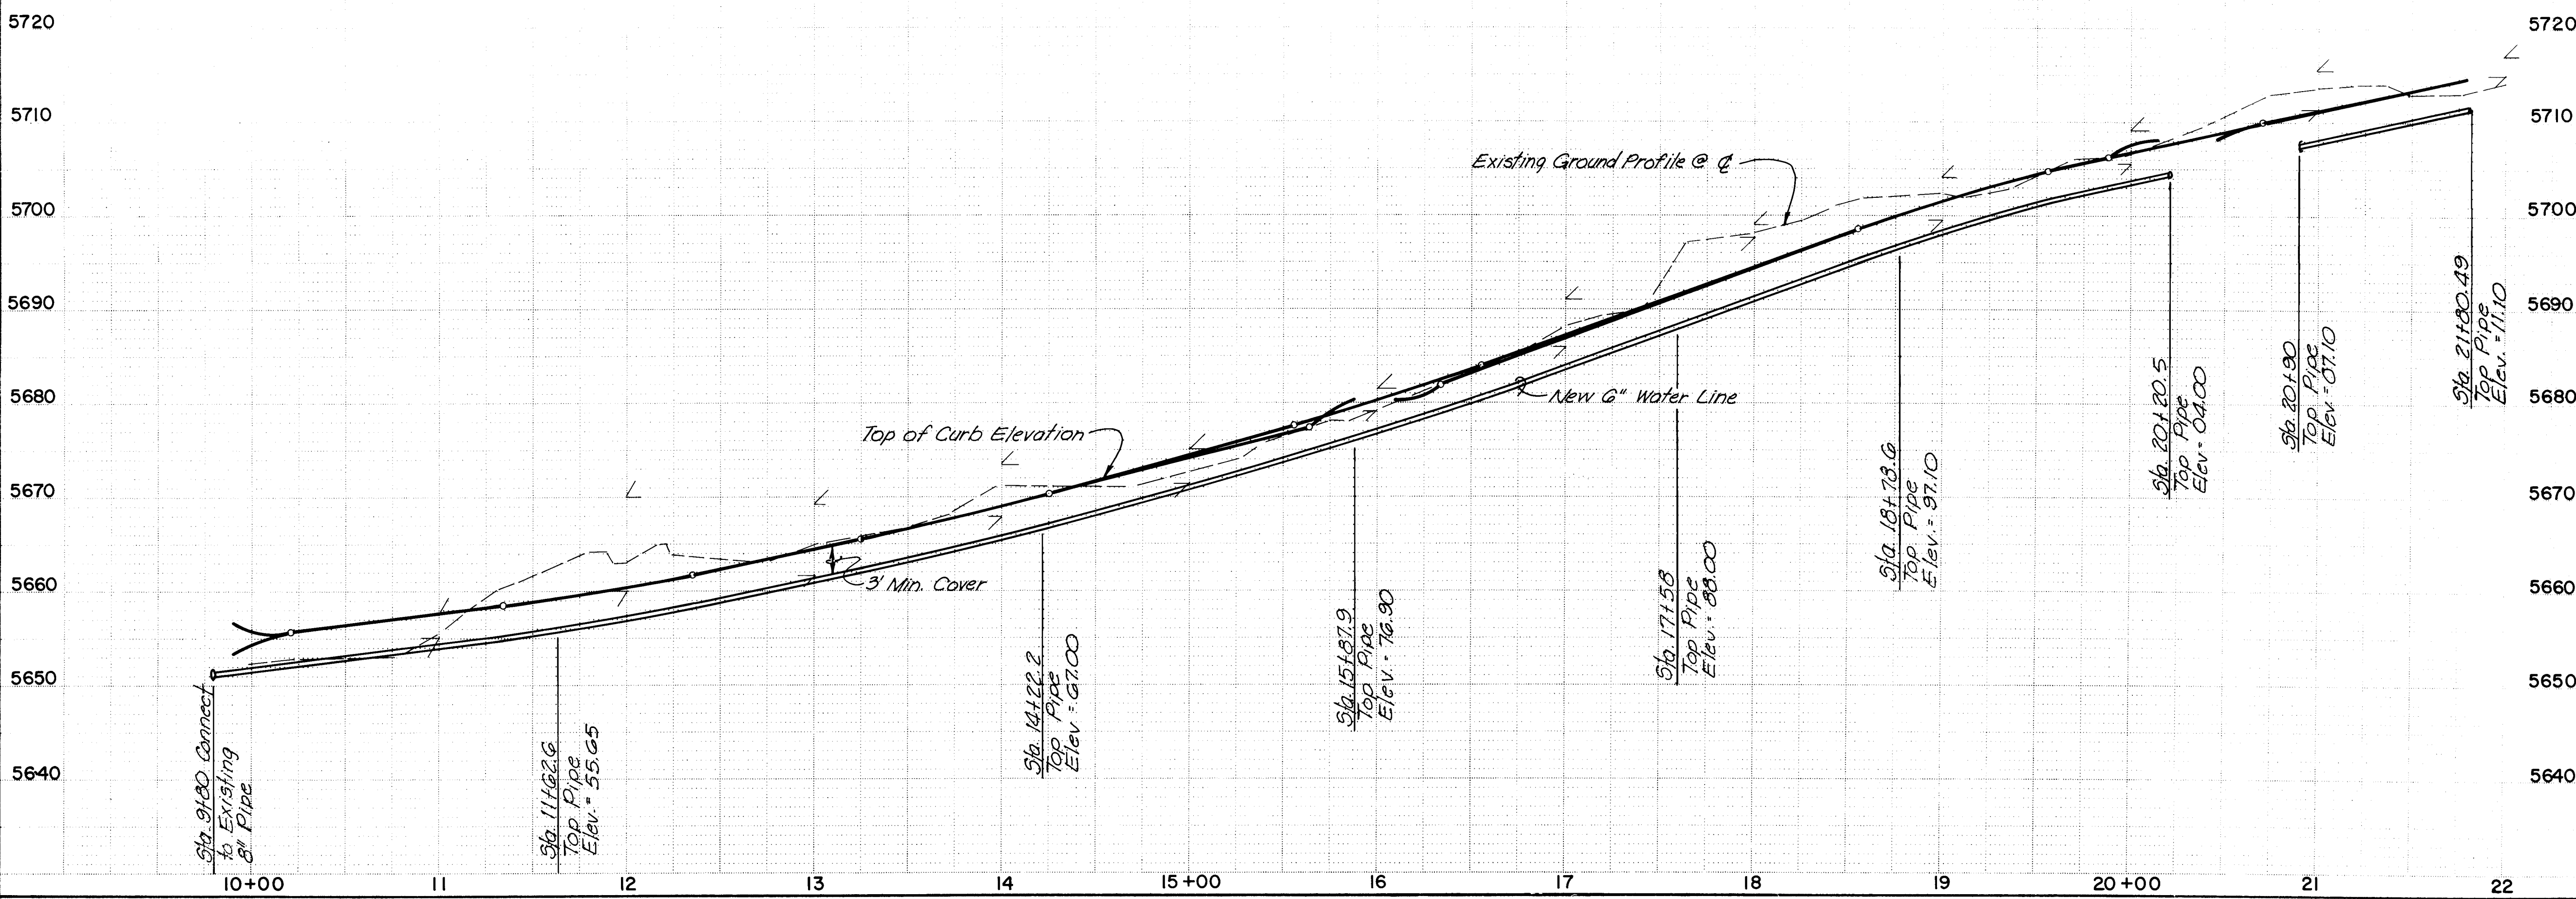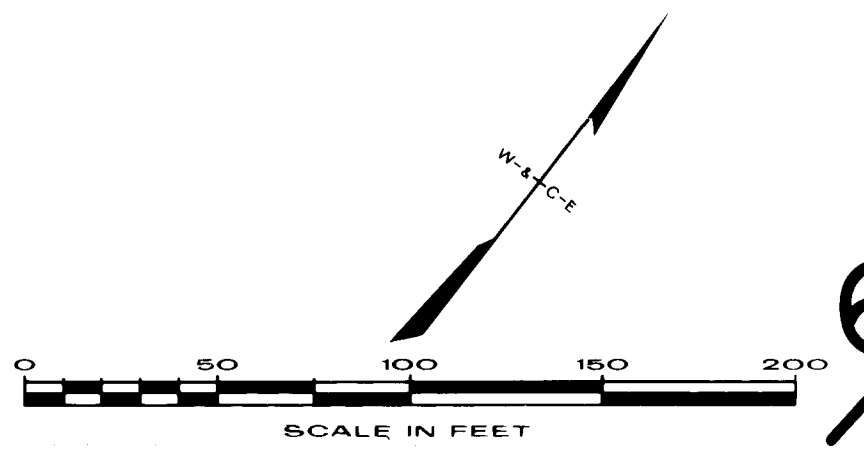

26 2009 1184

APPROVED FOR CONSTRUCTION
CITY ENGINEER _____ DATE _____

CITY OF ALBUQUERQUE					
OSO GRANDE SUBDIVISION					
WATER • CAMINO DEL OSO					
APPROVALS	ENGINEER	DATE	APPROVALS	ENGINEER	DATE
City Engineer	<i>[Signature]</i>	9/27/04	Traffic	NADWH	1/25/84
Liquid Waste	<i>[Signature]</i>	7-30-84	Water	<i>[Signature]</i>	1-30-84
ACE - Design	<i>[Signature]</i>	25/Jan/2009	SHEET 11 OF 13		
ACE - Hydrology	<i>[Signature]</i>	2/2/04	83-506 B		